


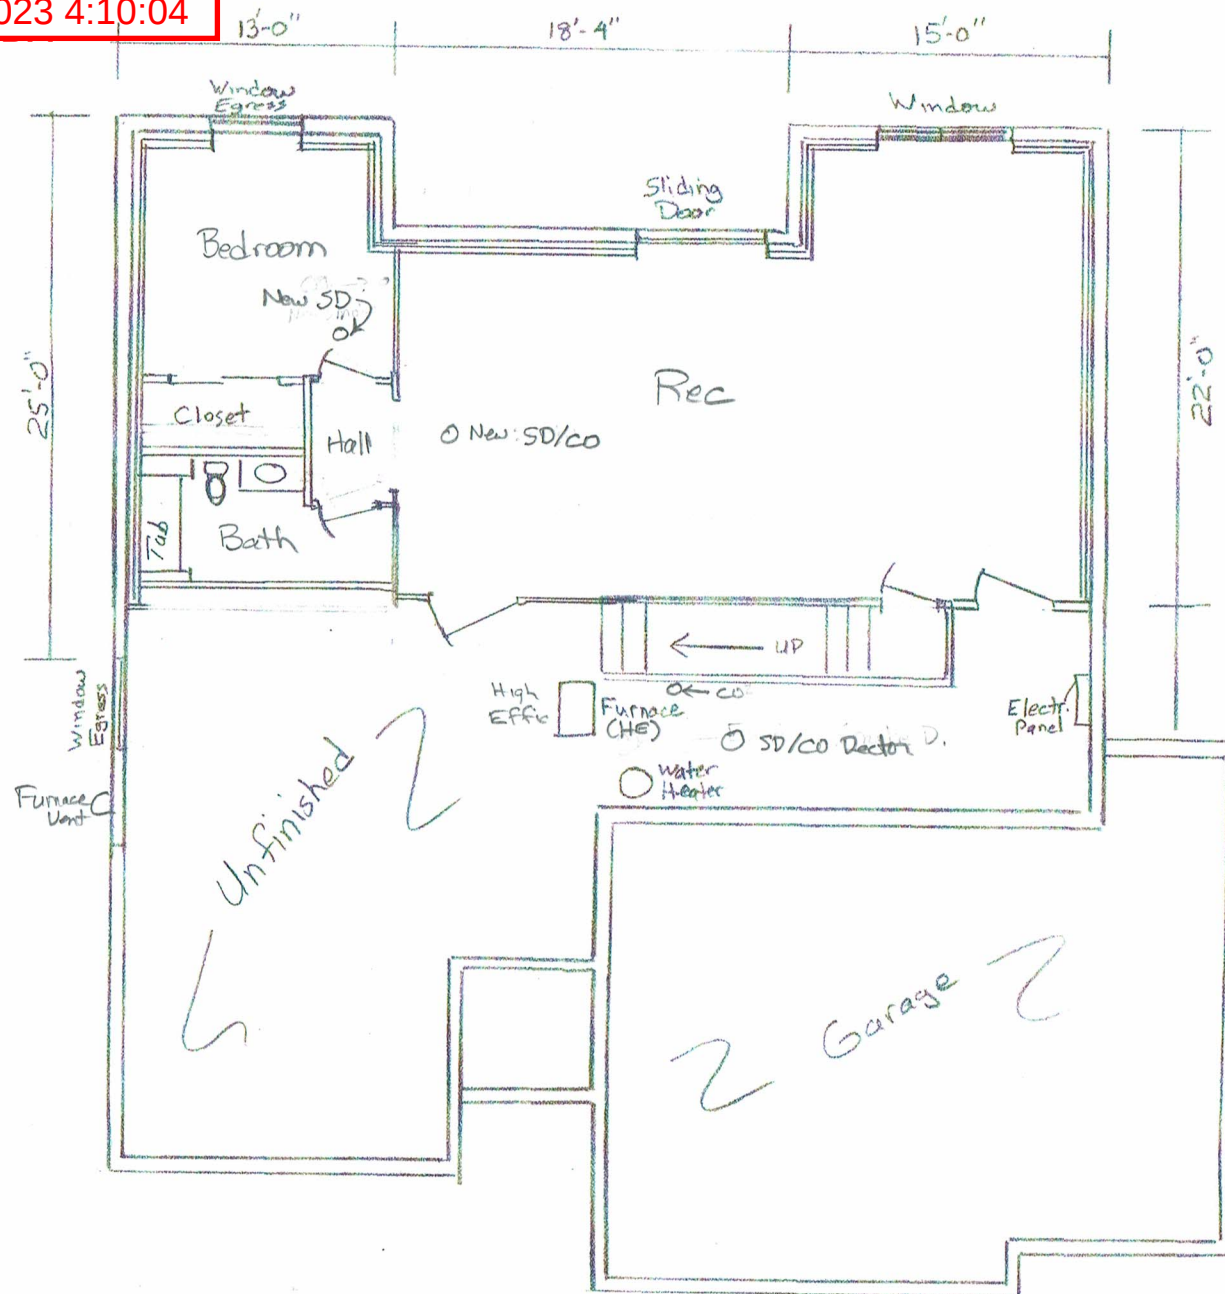

Floorplan (Not Dimensioned)

With Smoke & Monoxide Locations

SD/CO Detector


Furnace Area - Existing

Rec Room - New

SD Detectors


Bedroom - New

Bath - New

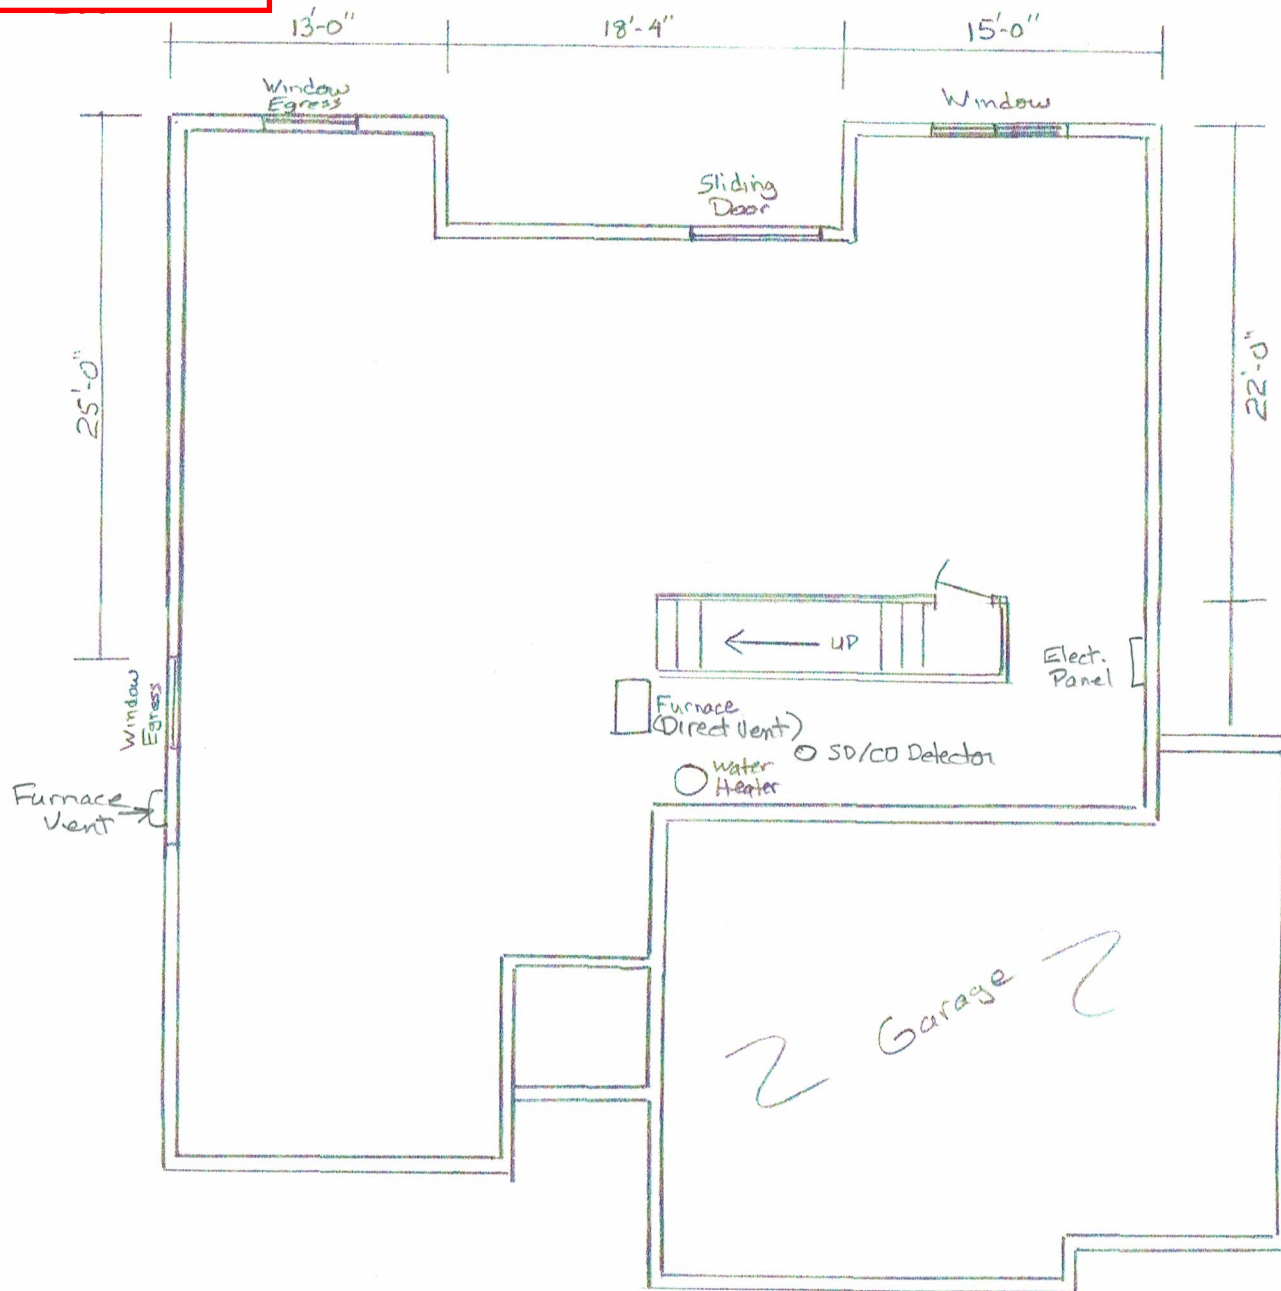

Simple Foundation Plan
As-Built

Floorplan (With Interior Dimensions)

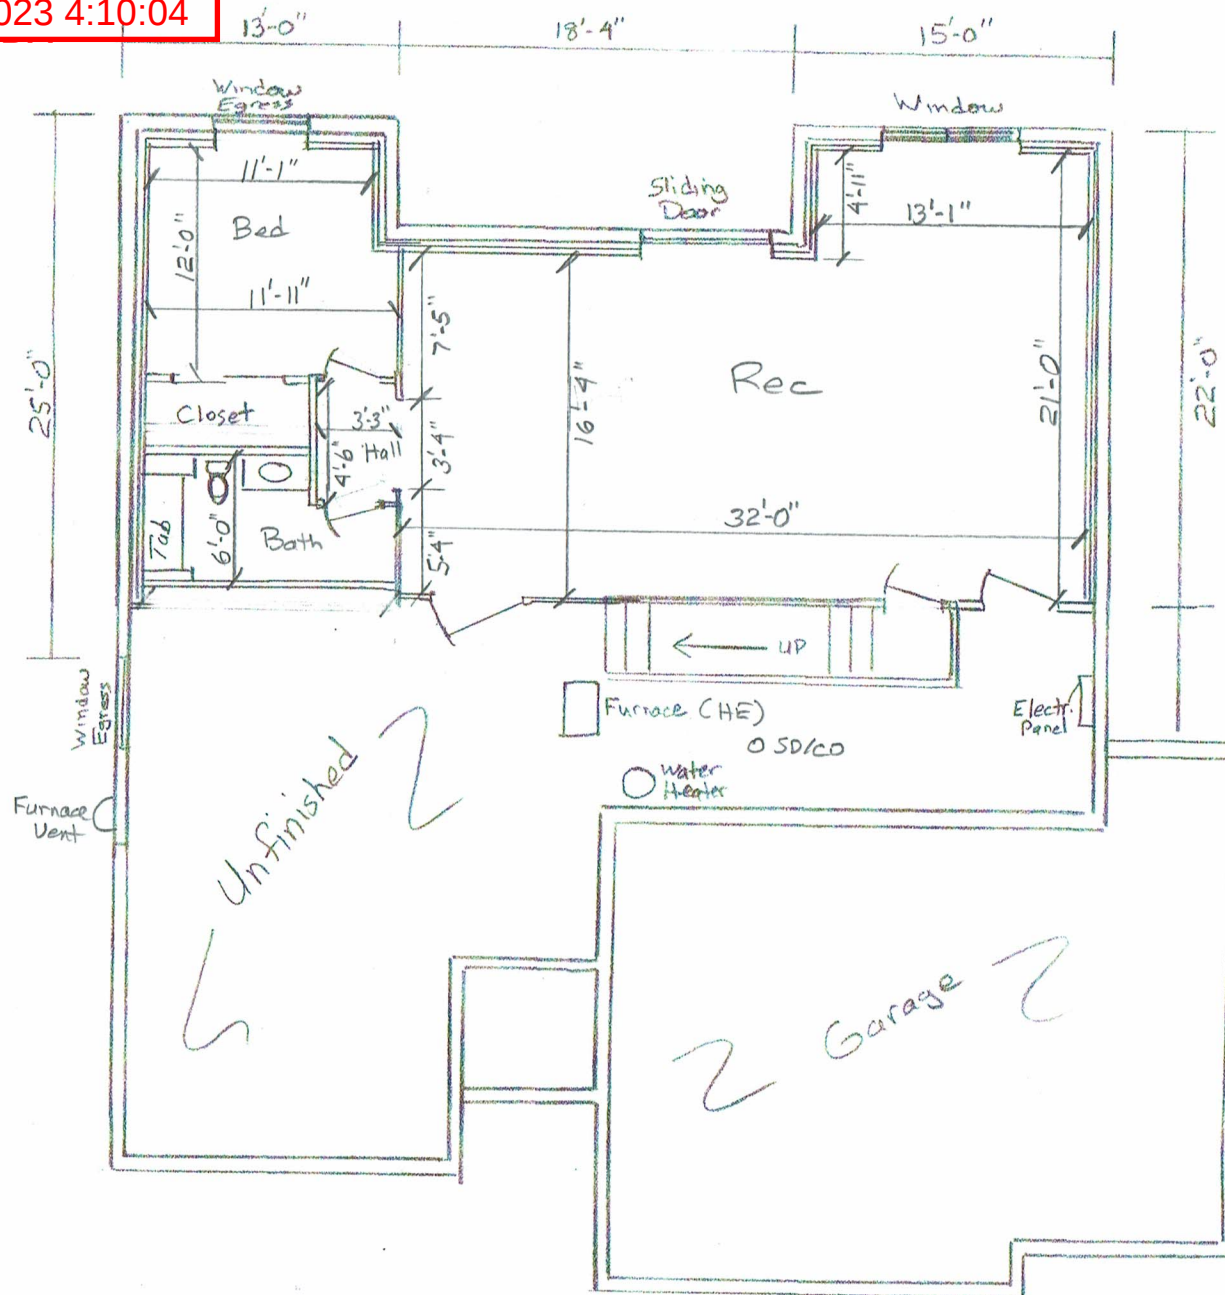

Room Areas

Rec Room	587	ft ²
Bedroom	148	ft ²
Closet	20	ft ²
Bathroom	66	ft ²
Hall	15	ft ²
Total	836	ft²