CONSTRUCTION STAKE PLOT PLAN

ORDERED BY: NEW MARK HOMES

DESCRIPTION: LOT 2 WHISPERING WOODS 1ST PLAT LOTS 1-33 & TRACTS A,B,C, & D

LEE'S SUMMIT, JACKSON COUNTY, MISSOURI


1924 SW RIVER RUN DRIVE

NO DECK CONSTRUCTION WITHOUT A PERMIT

RELEASE FOR CONSTRUCTION AS NOTED ON PLANS REVIEW DEVELOPMENT SERVICES LEE'S SUMMIT, MISSOURI 06/02/2023 11:13:04

AS BUILT PLOT PLAN DONE ON 10/26/2022

WALKOUT BASEMENT

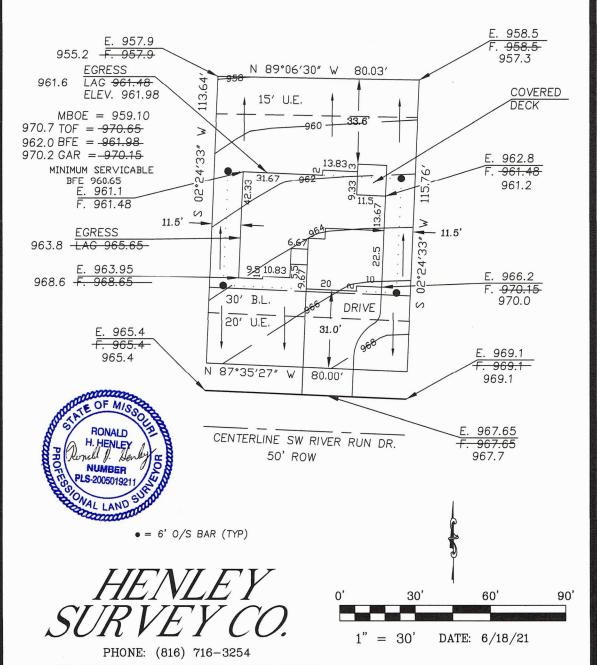

This plot plan was prepared for use before and during foundation construction only. House staked as shown on plot plan. Contractor to check and verify house dimensions and elevations at job site. We are not responsible for unknown or platted easements of any kind unless we are furnished the description of said easements before the field work is performed. NOTE: Cuts shown hereon for excavation are a guide only. Final decision as to cuts and foundation height are to be made by builder on job site.

DIRECTION OF DRAINAGE