

# CONSTRUCTION STAKE PLOT PLAN

Ordered by: TRUMARK HOMES

Description: IOT 163, WOODSIDE RIDGE 2ND PLAT, in Lee's Summit, MO


Address: 362 NW Patch Court

Lot Area = 15953 sf

Digitally signed  
by Lee N. Bodenheimer  
for Construction  
Date: 2022.07.27  
16:03:11 -0500

RELEASE FOR CONSTRUCTION  
AS NOTED ON PLANS REVIEW  
DEVELOPMENT SERVICES  
LEE'S SUMMIT, MISSOURI  
04/18/2023 2:52:44

• Irrigation  
- Irrigation Plan  
Attached

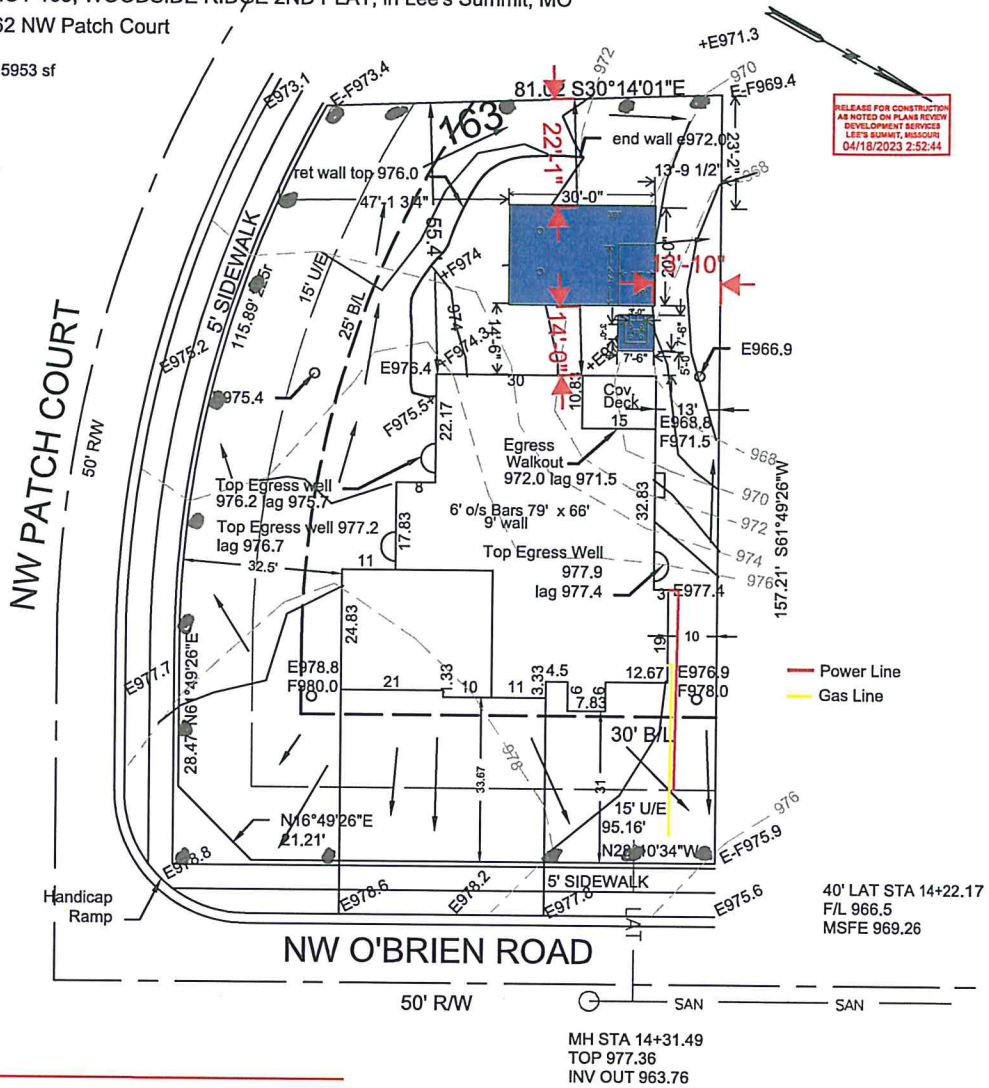

PROPOSED  
TOP FDN 980.7  
GAR FLR 980.0  
BAS FLR 972.0

This plot plan is not an "as-built" survey as the house was staked prior to being built and cannot be used in place of a "Surveyors Real Property Report". This plot plan was prepared for use before and during foundation construction only and should not be used to establish property lines for fences or other structures. House staked as shown on this plot plan. House dimensions may have been assumed and contractor must check house dimensions shown and compare to the final house plans. Contractor to verify all elevations at job site. Builder must make final decision as to cuts and foundation heights at the job site, any floor elevations shown are shown as a guide only. Sanitary sewer and lateral elevations cannot be verified at time of staking, and it may be necessary to verify sanitary sewer elevation and location (BY DIGGING UP THE SEWER LATERAL) prior to excavation for foundation. Underground utilities and un-platted easements may not be shown. This does not constitute a boundary survey and builder must check to make sure description shown is correct with the deed for the property. It is recommended that no work be done until building permits are obtained and plot plan has been verified by local building codes authorities to comply with all setback and other restrictions.

= DRAINAGE PATTERN

CONSTRUCTION ENGINEERING SERVICES, INC.

16810-C East 40 Highway  
Independence, MO 64055  
(816)478-2323

lee@engineeringkc.com

SCALE: 1" = 30'

DATE: 06-20-2022

JOB NO: 18415

LEE BODENHEIMER, L.S.  
Land Surveyor

