




SCALE: 1"=20'
0 20

PREPARED FOR:
NEW MARK HOMES

AS-BUILT GRADING

LOT 121

WOODSIDE RIDGE, FIRST PLAT
305 NW AMBERSHAM DRIVE

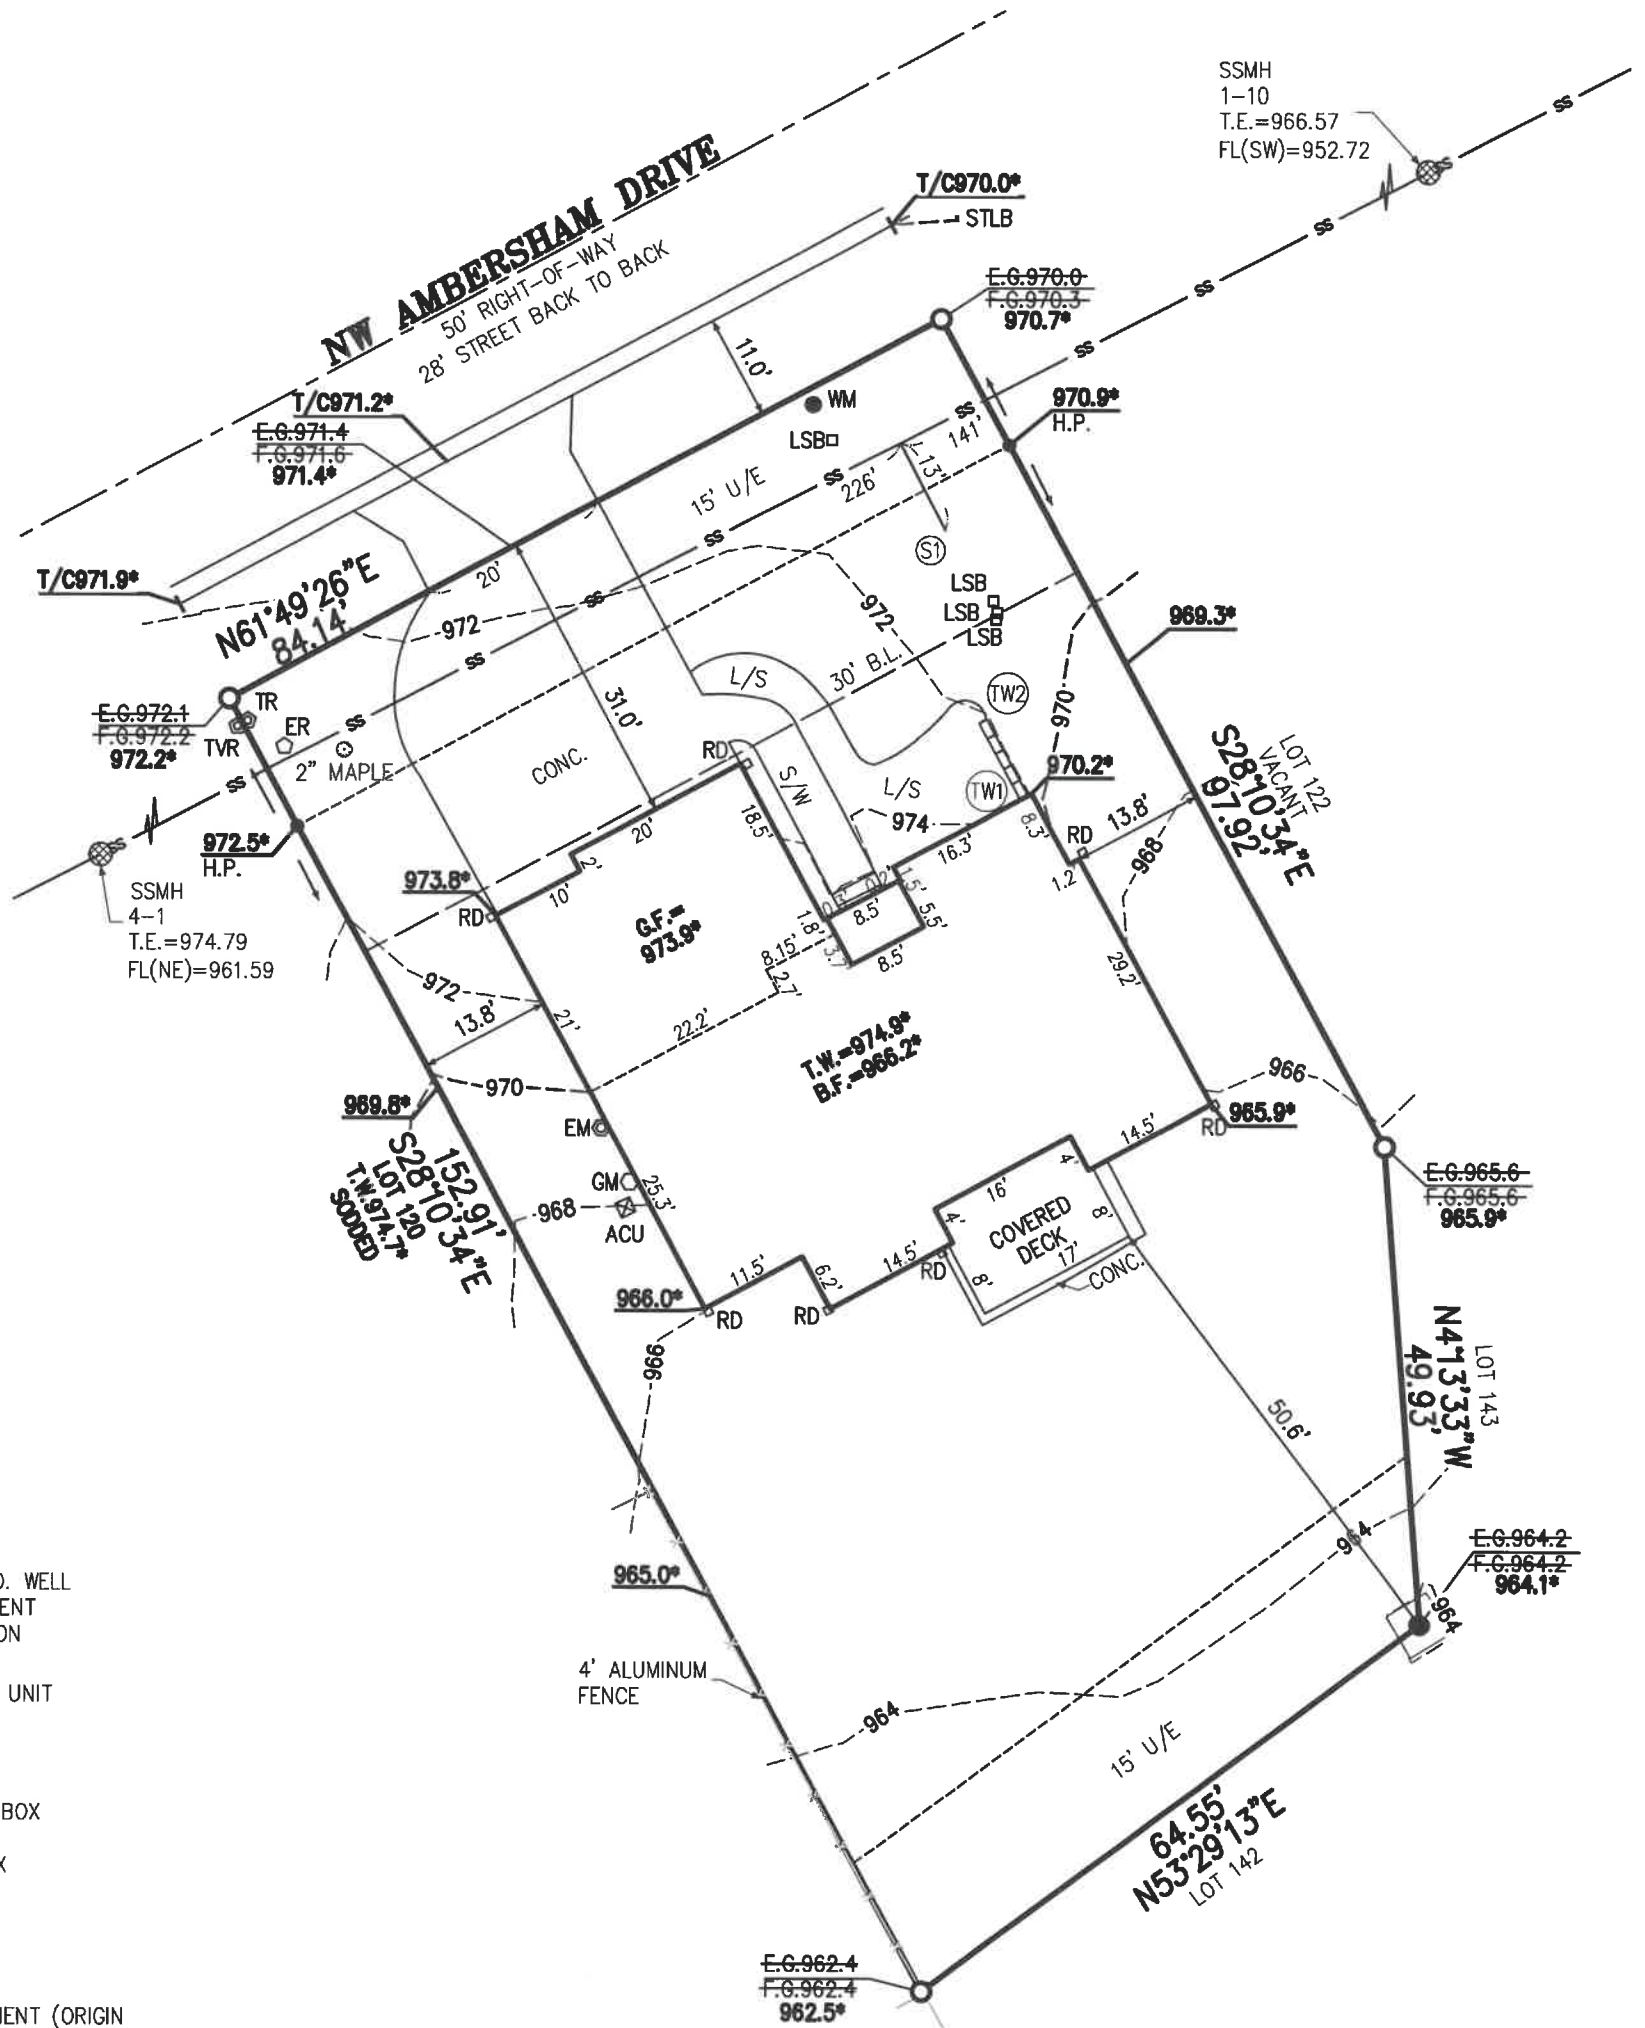

LEGEND

(S1) STA. 11+94.94
MSFE=962.49
6" ON 8" TEE
10 L.F. 6" PVC & 3
L.F. 6" PVC RISER
141' DDS
FL@EOS=959.7

(TW1) T.W.973.3*
F.G.B.W.970.2*
(TW2) T.W.973.3*
F.G.B.W.972.1*

E.G.= EXISTING GRADE
F.G.= FINISHED GRADE
T/C= TOP OF CURB
T.E.= TOP ELEVATION
H.P.= HIGH POINT
B.F.= BASEMENT FLOOR
T.W.= TOP OF WALL
G.F.= GARAGE FLOOR
FL= FLOW LINE
EGL=ENERGY GRADE LEVEL
MLO=MINIMUM LOW OPENING
L/E=LANDSCAPE EASEMENT
P.B.=PERIPHERAL BOUNDARY
WRWW=WATER RESISTANT WND. WELL
S/E=SANITARY SEWER EASEMENT
E/I=ENGINEERING & INSPECTION
L/S=LANDSCAPING

ACU = AIR CONDITIONING UNIT
EM = ELECTRIC METER
ER = ELECTRIC RISER
GM = GAS METER
LSB = LAWN SPRINKLER BOX
RD = ROOF DRAIN
STLB = STREET LIGHT BOX
TR = TELEPHONE RISER
TVR = TELEVISION RISER
WM = WATER METER
I = FOUND CURB CUT
● = FOUND SURVEY MONUMENT (ORIGIN UNKNOWN UNLESS DESCRIBED)
○ = SET 1/2"x24" REBAR WITH "PHELPS CLS-82" PLASTIC CAP

LOT AREA=11,915 SQ. FT.

AS-BUILT GRADING

DATE FIELD VERIFIED: 6/13/23
974.9* DENOTES AS-BUILT ELEVATION

CONTOURS SHOWN HEREON
ARE AS-BUILT.

LEGAL DESCRIPTION:

LOT 121, WOODSIDE RIDGE, FIRST
PLAT, A SUBDIVISION OF LAND IN
THE CITY OF LEE'S SUMMIT,
JACKSON COUNTY, MISSOURI.

NOTES:

1. SQUARE FOOTAGE OF DRIVEWAY AS SHOWN:1,083
2. 6 INCHES OF CLEARANCE IS REQUIRED FROM THE FINISHED GRADE TO THE SILL PLATE OF THE STRUCTURE. THE GRADE SHALL FALL A MINIMUM OF 6 INCHES WITHIN THE FIRST 10 FEET FROM THE FOUNDATION OF THE BUILDING.
3. CLIENT TO VERIFY ALL WALL HEIGHTS AS SHOWN PRIOR TO EXCAVATION AND POURING OF FOUNDATION.
4. AN AS GRADED PLOT PLAN PER SECTION 7-160, CODE OF ORDINANCES IS REQUIRED PRIOR TO OCCUPANCY. AS GRADED PLOT PLAN IS REQUIRED PRIOR TO SODDING
5. REVISED: 9-23-21 CITY COMMENTS ADDRESSED
6. REVISED: 6-20-23 ADDED AS-BUILT ELEVATIONS AT HOUSE CORNERS.

SSMH
1-10
T.E.=966.57
FL(SW)=952.72



PLANNING
ENGINEERING
IMPLEMENTATION

PHELPS ENGINEERING, INC
1270 N. Winchester
Olathe, Kansas 66061
(913) 393-1155
Fax (913) 393-1166

PROJECT NO. 210768
DATE: 6/14/23
BY: DJP

Note: Builder shall obtain a
building permit prior to any
construction to ensure that this
site plan meets City approval.

This plot plan was prepared for
foundation construction only. All
dimensions to be verified by
builder and all grades as shown
shall be verified by builder to
insure proper drainage and
adequate fall to sewer. No title
information was furnished on
this drawing. Not responsible for
unplatted easements.

CERTIFICATE OF AUTHORIZATION
KANSAS
LAND SURVEYING - LS-82
ENGINEERING - E-391
MISSOURI
LAND SURVEYING-2007001128
ENGINEERING-2007005058