
# I-470 BUSINESS & TECHNOLOGY CENTER, LOT 7

## ISSUED FOR PERMIT OWNER REVISIONS

## AUGUST 31, 2022 JUNE 22, 2023

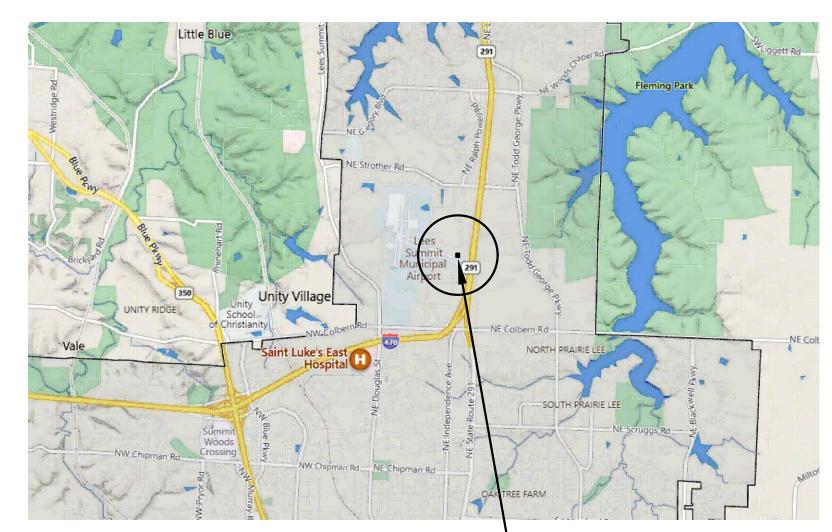

**□** ✓ VICINITY MAP

#### **GENERAL NOTES:**

- 1. THE CONTRACTOR SHALL SECURE AND PAY FOR GOVERNMENT LICENSES, INSPECTIONS, TESTING, TEMPORARY UTILITIES AND PERMITS AS REQUIRED BY THE CONSTRUCTION DOCUMENTS AND/OR REGULATORY BODY HAVING
- 2. CONTRACTORS SHALL VISIT THE SITE WHILE BIDDING AND SHALL FAMILIARIZE THEMSELVES WITH EXISTING CONDITIONS AND THE REQUIREMENTS OF THE PROJECT AND CONSTRUCTION DOCUMENTS PRIOR TO DEVELOPING THEIR BID. FABRICATION / CONSTRUCTION. AND PURCHASING. MATERIAL QUANTITIES SHALL BE BASED ON ACTUAL FIELD CONDITIONS AND MEASUREMENTS. DO NOT RELY ON SCALING DRAWINGS FOR ACCURATE DIMENSIONS. THE CONTRACTOR SHALL IMMEDIATELY NOTIFY THE ARCHITECT OR OWNER'S REPRESENTATIVE OF ANY DISCREPANCIES, CONFLICTS OR OMISSIONS DISCOVERED. THE CONTRACTOR SHALL BE RESPONSIBLE FOR CORRECTIONS AND/OR REPAIRS REQUIRED FOR FAILING TO DO SO.
- 3. THE GENERAL CONTRACTOR SHALL BE RESPONSIBLE TO PROVIDE ALL CONSTRUCTION DOCUMENTS TO THEIR SUBCONTRACTORS AS REQUIRED FOR THEM TO DEVELOP A COMPLETE BID FOR THEIR WORK AND TO HAVE A COMPLETE UNDERSTANDING OF COORDINATION NEEDED WITH OTHER SUBCONTRACTORS FOR RELATED HIDDEN OR EXPOSED WORK TO ENSURE EFFICIENT AND ORDERLY INSTALLATION.
- 4. THE ARCHITECT ASSUMES NO LIABILITY FOR THE SERVICES AND/OR CONSTRUCTION DOCUMENTS OF DESIGN SUB-CONSULTANTS COMPILED INTO THE SET OF DOCUMENTS ISSUED BY THE ARCHITECT. THESE DESIGN SERVICES MAY INCLUDE, BUT ARE NOT LIMITED TO, CIVIL, LANDSCAPE, STRUCTURAL, MECHANICAL, PLUMBING ELECTRICAL, PRE-ENGINEERED METAL BUILDING DESIGN, TILT-UP DESIGN, TRUSS SYSTEM DESIGN, AUTOMATIC FIRE SPRINKLER AND/OR ALARM SYSTEMS, LOW-VOLTAGE ELECTRICAL TELECOMMUNICATION AND SECURITY SYSTEMS AND GUTTER / DOWNSPOUT DESIGN.
- 5. UNLESS SPECIFICALLY NOTED OTHERWISE, THE CONTRACTOR SHALL PROVIDE AND PAY FOR LABOR, MATERIALS, EQUIPMENT, MACHINERY, SCAFFOLDING, SHORING, TOOLS, LAYOUT, ON-SITE DIMENSIONING, TRANSPORTATION, UTILITIES, AND OTHER FACILITIES AND SERVICES NECESSARY FOR PROPER EXECUTION AND COMPLETION OF THE WORK AS REQUIRED BY THE CONSTRUCTION CONTRACT DOCUMENTS. THIS SHALL ALSO INCLUDE NECESSARY CUTTING. PATCHING AND REPAIRING OF EXISTING CONSTRUCTION MATERIALS IN PLACE. ALL WORK AND MATERIAL SHALL COMPLY WITH THE APPLICABLE GOVERNING CODES LISTED.

6. EACH SUBCONTRACTOR SHALL PROVIDE THEIR OWN LIFTING EQUIPMENT AS REQUIRED TO COMPLETE THEIR 

- 7. WHERE DETAILS AND DESIGN INTENT ARE NOT CLEAR, THE CONTRACTOR SHALL CONSULT THE ARCHITECT FOR CLARIFICATION PRIOR TO PROCEEDING WITH THE WORK.
- 8. THE CONTRACTOR SHALL DESIGN AND INSTALL ADEQUATE SHORING AND BRACING FOR STRUCTURAL MODIFICATIONS, INSTALLATIONS AND ERECTION.
- 9. CONTRACTORS SHALL TAKE CARE TO PROTECT ADJACENT AREAS FROM DUST AND DAMAGE DURING THE CONSTRUCTION PROCESS AND SHALL CLEAN UP AFTER THEMSELVES AT THE END OF EACH WORKING DAY. ANY DAMAGE DONE TO ADJACENT AREAS MUST BE REPAIRED TO MATCH ORIGINAL CONDITIONS OR TO THE OWNER'S SATISFACTION. REPAIRS ARE TO BE PAID FOR BY THE CONTRACTOR RESPONSIBLE.
- 10. THE CONTRACTOR SHALL NOTIFY THE ARCHITECT OF ANY ADDITIONAL WORK OR REVISIONS REQUIRED DUE TO
- SITE CONDITIONS OR ADDITIONAL REQUIREMENTS OF ANY REGULATORY BODIES HAVING AUTHORITY. 11. FOR THE DURATION OF THE PROJECT AND AT ALL TIMES OF EACH DAY, THE CONTRACTOR SHALL BE SOLELY

RESPONSIBLE FOR JOB SITE CONDITIONS, SECURITY AND SAFETY FOR WORKERS AND THE GENERAL PUBLIC, AS

- 12. THE GENERAL CONTRACTOR SHALL PURCHASE AND MAINTAIN INSURANCE COVERAGE IN ACCORDANCE WITH THE REQUIREMENTS OF THE OWNER. VERIFY AND COORDINATE WITH THE OWNER'S REPRESENTATIVE FOR ANY
- 13. THE OWNER OR THE OWNER'S SUBCONTRACTORS MAY OCCUPY PORTIONS OF THE PROJECT DURING THE FINAL STAGE OF CONSTRUCTION. COORDINATE AND COOPERATE WITH THE OWNER TO MINIMIZE CONFLICT AND FACILITATE THE OWNER'S OPERATION.
- 14. THE CONTRACTOR SHALL PROVIDE SECURITY OF THE WORK, INCLUDING TOOLS AND UNINSTALLED MATERIALS. PROTECT THE WORK, STORED PRODUCTS, CONSTRUCTION EQUIPMENT, AND OWNER'S PROPERTY FROM THEFT AND VANDALISM, AND PROTECT THE PREMISES FROM ENTRY BY UNAUTHORIZED PERSONNEL UNTIL FINAL ACCEPTANCE BY THE OWNER.
- 15. CONTRACTOR SHALL COORDINATE STAGING AREAS AS REQUIRED BY THE LANDLORD / OWNER.
- 16. THE CONTRACTOR SHALL VERIFY THE SIZE AND LOCATION OF ALL EXISTING UTILITIES.

REQUIRED BY THE REGULATORY BODY HAVING AUTHORITY.

- 17. THE STRUCTURAL ENGINEER AND ARCHITECT MUST BE NOTIFIED AND MUST GIVE APPROVAL PRIOR TO ANY STRUCTURAL MEMBER(S) BEING CUT OR MODIFIED TO ACCOMMODATE THE INSTALLATION OF ANY PIPES, DUCTS OR
- 18. THE STRUCTURAL ENGINEER AND ARCHITECT MUST BE NOTIFIED AND MUST GIVE APPROVAL PRIOR TO ANY MODIFICATION TO THE ROOF SYSTEM OR ADDING ANY ADDITIONAL ROOF-MOUNTED EQUIPMENT.

#### **CONSTRUCTION NOTES:**

- PERFORM ALL WORK IN ACCORDANCE WITH ACCEPTABLE TRADE PRACTICE TO ENSURE THE HIGHEST QUALITY FINISHED PRODUCT - EXPRESSED OR IMPLIED. PERFORM ALL WORK BY SKILLED MECHANICS IN ACCORDANCE WITH ESTABLISHED STANDARDS OF WORKMANSHIP IN EACH OF THE VARIOUS TRADES.
- 2. WHEN THE PROJECT REQUIREMENTS REQUIRE THAT THE INSTALLATION OF WORK SHALL COMPLY WITH MANUFACTURER'S INSTRUCTIONS, PERFORM THE WORK IN STRICT ACCORDANCE WITH THE MOST CURRENT WRITTEN MANUFACTURER'S INSTRUCTIONS.
- 3. ALL PRODUCTS AND EQUIPMENT SHALL BE DELIVERED IN UNDAMAGED CONDITION AND STORED IN ACCORDANCE WITH THE MANUFACTURER'S INSTRUCTIONS TO AVOID DISRUPTION OF THE WORK OR DAMAGE TO THE ITEMS. REPLACE DAMAGED OR UNFIT MATERIALS, AT NO COST TO THE OWNER.
- 4. COORDINATE BLOCKING REQUIREMENTS WITH ADJACENT OR RELATED TRADES, ACCESSORIES, EQUIPMENT AND FIXTURES. INSTALL REQUIRED BLOCKING AT NO ADDITIONAL COST TO THE CONTRACT.
- 5. ALL WEATHER-EXPOSED SURFACES SHALL HAVE A WEATHER-RESISTIVE BARRIER. EXTERIOR OPENINGS SHALL BE FLASHED IN SUCH A MANNER AS TO MAKE THEM WATERPROOF.
- 6. REPAIR PROPERTY DAMAGE BY THE INSTALLERS TO A LIKE NEW CONDITION, OR REPLACE DAMAGED SURFACES
- AND MATERIALS OF THE PREVIOUSLY INSTALLED WORK BY OTHER TRADES, INSTALLERS, AND SUBCONTRACTORS.
- 7. ALLOWABLE TOLERANCES UNLESS OTHERWISE NOTED OR INDICATED, THE FOLLOWING TOLERANCES SHALL g. ALL VERTICAL SURFACES SHALL BE PLUMB OR CONSTRUCTED TO THE EXACT SLOPES OR ANGLES INDICATED.
  - h. ALL HORIZONTAL SURFACES SHALL BE LEVEL OR CONSTRUCTED TO THE EXACT ANGLE INDICATED OR
  - i. WALL AND SOFFIT INTERSECTIONS SHALL BE 90° OR THE EXACT ANGLE INDICATED OR INTENDED.
- j. ALL CORNERS AND EDGES SHALL BE STRAIGHT AND TRUE WITHOUT DENTS, WAVES, BULGES OR OTHER
- k. ALL JOINTS SHALL BE TIGHT, STRAIGHT, EVEN, AND SMOOTH. I. ALL OPERABLE ITEMS SHALL OPERATE SMOOTHLY WITHOUT STICKING OR BINDING AND WITHOUT EXCESSIVE
- 8. THE CONTRACTOR SHALL NOTIFY THE OWNER WHEN THE WORK IS SUBSTANTIALLY COMPLETE AND READY FOR INSPECTION. UPON INSPECTION, PROVIDE WRITTEN OPERATION AND MAINTENANCE INSTRUCTIONS AND GUARANTEES FOR ALL EQUIPMENT AND MATERIALS INSTALLED. PROVIDE WRITTEN GUARANTEES FOR A PERIOD OF ONE (1) YEAR FROM THE DATE OF FINAL ACCEPTANCE OF THE WORK.

#### DISCLAIMER:

THESE DRAWINGS ARE CONSIDERED A "BUILDER'S SET", AND BY BEGINNING CONSTRUCTION, THE CONTRACTOR GUARANTEES TO THE ARCHITECT, THAT THE CONTRACTOR HAS THE COMPETENCE AND SKILL IN CONSTRUCTION NECESSARY TO BUILD THE PROJECT WITH THESE DRAWINGS. THE CONTRACTOR WILL BE REQUIRED TO ADAPT THE DRAWINGS TO ACTUAL FIELD CONDITIONS AND MAKE LOGICAL ADJUSTMENTS IN FIT, FORM, DIMENSION AND QUANTITY. IN THE EVENT ADDITIONAL DETAIL OR GUIDANCE IS NEEDED, THE CONTRACTOR SHALL IMMEDIATELY NOTIFY THE ARCHITECT. FAILURE TO GIVE NOTICE SHALL RELIEVE THE ARCHITECT OF RESPONSIBILITY FOR ANY RESULTANT EXPENSES, REPAIRS OR ADDITIONAL WORK. IT IS UNDERSTOOD AND AGREED THAT IF THE ARCHITECT IS NOT HIRED TO DO CONSTRUCTION OBSERVATION OR ANY OTHER CONSTRUCTION PHASE SERVICES, THAT THE ARCHITECT IS NOT LIABLE FOR ANY CLAIMS THAT MAY BE IN ANY WAY CONNECTED THERETO.

#### SHEET INDEX

C100 CIVIL PLANS COVER SHEET C200 FINAL DEVELOPMENT PLAN

C201 SITE LANDSCAPING PLAN

C301 SITE ESC PHASE 1 AND 2 PLAN

C302 SITE ESC DETAILS

C400 PUBLIC STORM IMPROVEMENT PLAN C401 SITE STORM DRAINAGE PLAN AND CALCULATIONS

C402 STORM LINES 1 & 2

C403 STORM LINE DETAILS C700 SITE UTILITY PLAN

A-001 LIFE SAFETY PLAN AND CODE INFORMATION

A-002 DOOR, WINDOW, & FINISH SCHEDULES AND TYP. DETAILS A-100 OVERALL MAIN LEVEL PLAN, ENCLOSURE DETAILS

A-110 ENLARGED MAIN LEVEL PLAN - SOUTH, PARTITION TYPES

A-111 ENLARGED MAIN LEVEL PLAN - NORTH, PARTITION TYPES A-200 EXTERIOR ELEVATIONS

A-300 WALL SECTIONS AND PLAN DETAIL

A-410 CEILING PLAN - SOUTH A-411 CEILING PLAN - NORTH (ROOF ACCESS

S0.0 NOTES AND DETAILS S1.0 FOUNDATION PLAN

**MECHANICAL / PLUMBING** MP-001 MECHANICAL AND PLUMBING SPECIFICATIONS AND SYMBOLS

MP-002 MECHANICAL AND PLUMBING SCHEDULES AND DETAILS MECHANICAL:

M-101 MECHANICAL PLAN

E-001 ELECTRICAL SPECIFICATIONS AND SYMBOLS E-002 PHOTOMETRIC PLAN

E-003 PHOTOMETRIC PLAN

E-101 ELECTRICAL PLAN E-201 ELECTRICAL EQUIPMENT POWER PLAN

E-301 ELECTRICAL SCHEDULES AND DIAGRAMS E-302 ELECTRICAL SCHEDULES

120 NW Eagle Ridge Blvd. Grain Valley, Missouri 64029

IIDWEST ARCHITECTS 120 NW Eagle Ridge Blvd Grain Valley, Missouri 64029


t: (816) 229-8115

Civil Engineering: Quist Engineering, Inc 821 NE Columbus St. Lee's Summit, Missouri 64063

Structural Engineerin Structura Logica 18901 E. 299th Street Harrisonville, MO 64701

MEP Engineering JSC Engineers 1925 Central Street, Suite 201 Kansas City, MO 64108 t: (816) 272-5289

evisions to technical submissions which are i

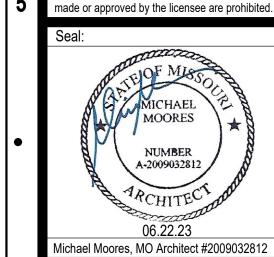

Project Number:

Project Type: NEW CONSTRUCTION Project Name and Address:

2

CENTER, H H B&T

ssued for Permit Plan Review Revisions /<sub>1</sub> \ 11.17.2 Plan Review Revisions 🏒 12.28.22 Plan Review Revisions Owner Comments Owner Comments **\** 06.22.2

Sheet Title:

COVER SHEE


- 2. No geological information is shown on these plans.
- 3. The utility locations shown on these plans are taken from utility company records and are approximate only. They do not constitute actual field locations. The contractor shall verify the location and depth of all utilities prior to construction.
- 4. The contractor shall adhere to the provisions of the Senate Bill Number 583,78th General Assembly of the State of Missouri. The bill requires that any person of firm doing excavation on public right-of-way do so only after giving notice to, and obtaining information from, utility companies. State law requires 48 hours advance notice. The names and telephone numbers of utility companies, even if only remotely involved with this project are provided. Prior to commencement of work, the contractor shall notify all those companies which have facilities in the near vicinity of the construction to be performed.
- 5. All waste material resulting from the project shall be disposed of off-site by the
- 6. All excavation shall be unclassified. No separate payment will be made for rock
- 7. The contractor shall control the erosion and siltation during all phases construction, and he shall keep the streets clean of mud and debris.
- 8. All manholes, catch basins, utility valves and meter pits to be adjusted or rebuilt to grade as required. All existing utilities shall be adjusted as required.
- 9. Subgrade soil for all concrete structures, regardless of the type or location, shall be firm, dense and thoroughly compacted and consolidated: shall be free from muck and mud; and shall be sufficiently stable to remain firm and intact under the feet of the
- 10. workmen or machinery engaged in subgrade surfacing, laying reinforcing steel, and depositing concrete thereon. In all cases where subsoil is mucky or works into mud or muck during such operation, a seal course of either concrete or rock shall be placed below subgrade to provide a firm base for working and for placing the floor slab.
- 11. The contractor is responsible for providing all surveying that may be required.
- 12. Easements indicated on these drawings will be provided for on the final plat and properly dimensions. Easements outside the platted area will be provided for by separate documents prior to issuance of a construction permit.


#### STREETS & STORM SEWER


1. All construction shall follow the City of Lee's Summit Design and Consrtuction Manual as adopted by Ordinace 5813.

### CIVIL PLANS FOR LOT 7 OF

I-470 BUSINESS AND TECHNOLOGY CENTER SECTION 20, TOWNSHIP 48, RANGE 31 LEE'S SUMMIT, JACKSON COUNTY, MISSOURI

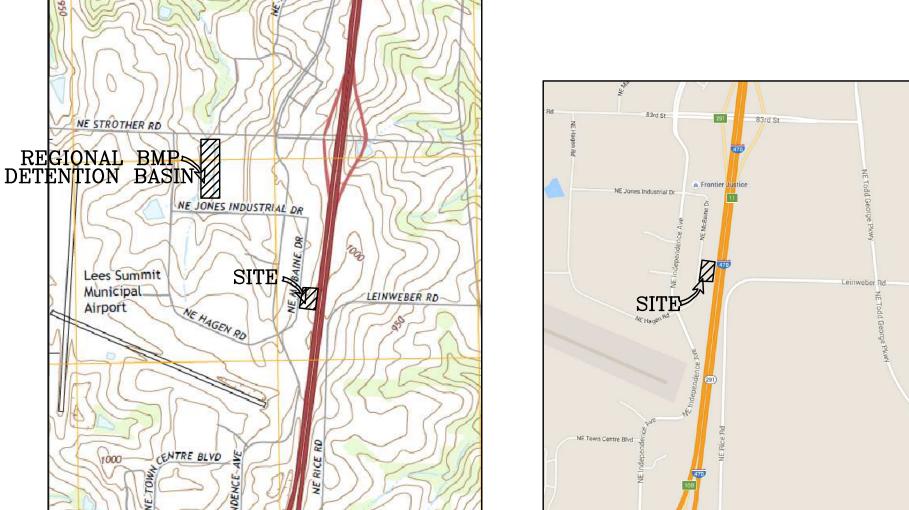

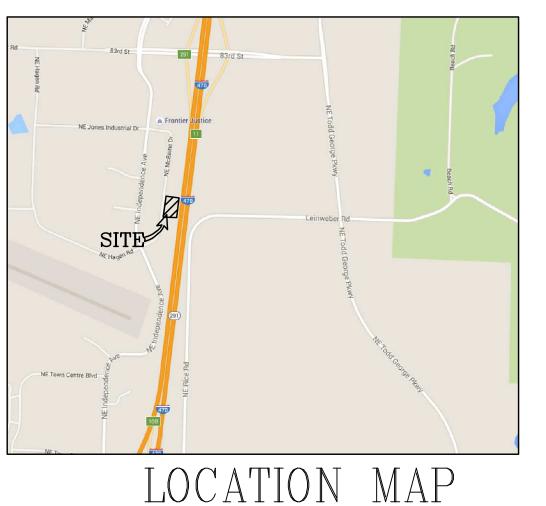

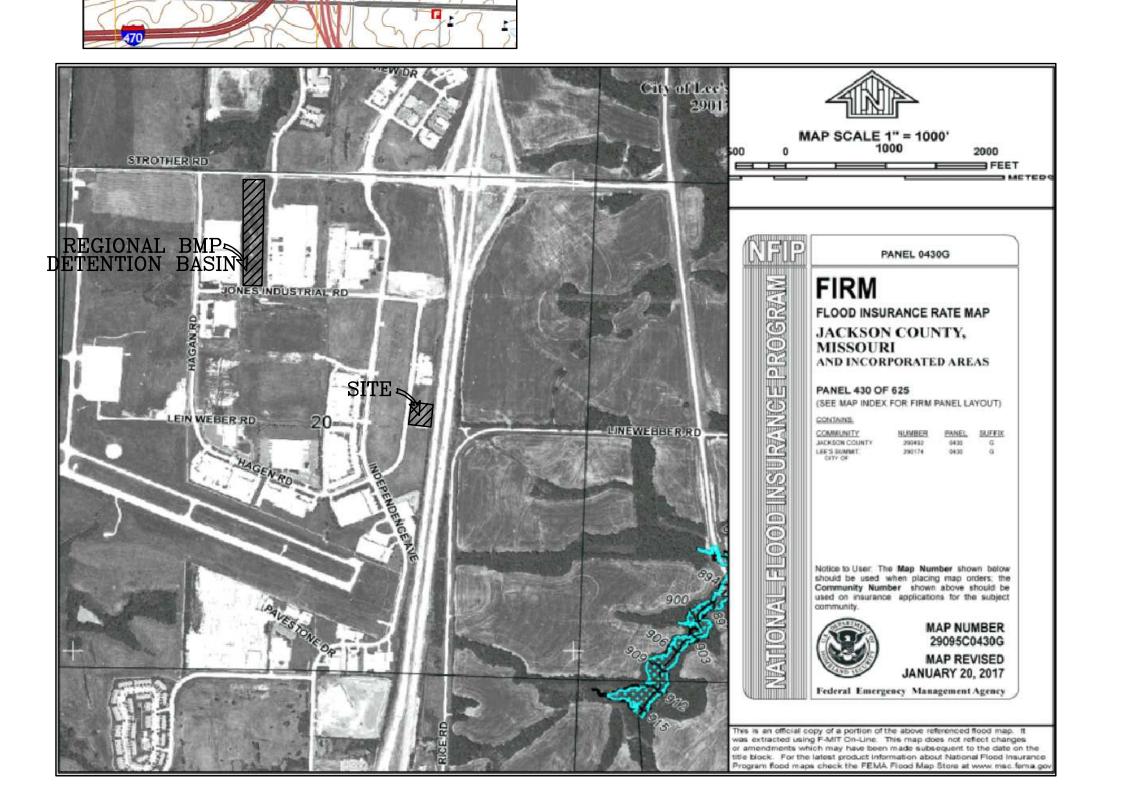

#### UTILITIES

LEE'S SUMMIT PUBLIC WORKS 220 SE GREEN STREET LEE'S SUMMIT, MISSOURI 64063 (816) 969-1800

KANSAS CITY POWER & LIGHT CO. P.O. BOX 219330 KANSAS CITY, MO 64121-9330

(816) 471-5275

MO GAS ENERGY P.O. BOX 219255 KANSAS CITY, MO 64141 (816) 756-5252

TELEPHONE COMAPANY CENTURY LINK P.O. BOX 2961 PHOENIX, AZ 85062 (800) 788-3600

MISSOURI ONE-CALL 1-800-344-7483

#### **DEVELOPER:**

BLUE SPRINGS SAFETY STORAGE LLC 1120 NW EAGLE RIDGE BLVD. GRAIN VALLEY, MISSOURI 64029 Ph.# 816-229-8115

SHEET INDEX

C100 CIVIL PLANS COVER SHEET

SITE LAYOUT

SITE LANDSCAPEING PLAN

SITE DETAIL SHEET CITY DETAILS -

SITE GRADING PLAN & ESC PLAN

SITE ESC DETAILS

PRIVATE STORM IMPROVENT PLAN

STORM DRAINAGE PLAN & CALCULATIONS PRIVATE STORM LINE 1 AND 2

STORM DETAILS

UTILITY PLAN SITE DATA TABLE:

1. NO IMPROVEMENTS ARE PROPOSED WITH THESE PLANS

LEGAL DESCRIPTION:

LOT 7 OF "I-470 BUSINESS AND TECHNOLOGY CENTER

LOTS 1 THRU 22 AND TRACTS A AND B" A SUBDIVISION

IN LEE'S SUMMIT, JACKSON COUNTY, MISSOURI

1. CONTRACTOR SHALL CONTACT THE CITY'S DEVELOPMENT SERVICES ENGINEERING INSPECTORS 48 HOUR PRIOR TO ANY LAND DISTURBANCE WORK. CALL

NONE THIS SHEET 11-17-22

(816)969-1200

1-10-23- REVISED SHEETS C100, C200, C210, ADDED C211, C200 ADDED TEMP ASHPALT CURB TO NORTH

C210 ADDED TEMPORARY ASPHALT CURB C211 ADDED THIS SHEET- CITY DETAILS C300 ADDED DETASILS VIEW AND GRADES FOR CITY ADA

6-22-23 - REVISED SHEETS C100, C200, C300, C400, C401, C402, AND C700

> C200 REMOVED REAR ACCESS ROAD RELOCATED TRASH ENCLOSURE REVISED PARKING ALONG FRONT OF BUILDING

BEFORE YOU



1-800-344-7483 (MISSOURI) 1-800-344-7233 (KANSAS)

PROJECT CONTACTS: ROBERT WALQUIST, P.E.. 821 NE COLUMBUS ST LEE'S SUMMIT, MISSOURI 64063

CIVIL PLANS COVER SHEET

RELEASED FOR CONSTRUCTION As Noted on Plans Review

COPYRIGHT (C) 2022 8-2-22

11-17-22 1-10-23 4 6-22-23

SHEET NO

COPYRIGHT (C) 2022

8-2-22 REVISIONS 11-17-22

1-10-23

SHEET NO

E21-318

12-14-22

4 6-22-23

14 CITY ADA RAMP RE: SEE CITY DETAILS 15 STRAIGHT BACK CURB (CG-1) DRY RE: SEE CITY DETAIL 16 STRAIGHT BACK CURB (CG-1) WET RE: SEE CITY DETAIL

1 HEAVY CONCRETE PAVEMENT RE: SEE SHEET C210 2 LIGHT CONCRETE PAVEMENT RE: SEE SHEET C210

PAINT ACCESSIBLE PARKING SYMBOLS ACCORDING TO APWA PAVEMENT MARKING STANDARDS. RE: SEE SHEET C210

3 30' LIGHT POLE RE: SEE MEP SHEETS

4 ACCESSIBILITY RAMP RE: SEE SHEET C210

6 INSTALL ACCESSIBLE PARKING SIGN "TYPE B" RE: SEE SHEET C210

This is a stripe paving with 4" wide stripe & paint according to apwa pavement marking standards.

10 TRASH ENCLOSURE RE: SEE ARCHITECTURAL PLANS

12 SITE MONUMENT SIGN RE: SEE ARCHITECTURAL PLANS

11 MODULAR RETAINING WALL RE: SEE SHEET C210

6a INSTALL VAN ACCESSIBLE PARKING SIGN RE: SEE SHEET C210

8 CURB WALK RE: SEE SHEET C210

9 SITE SIDEWALK RE: SEE SHEET C210

13 5' CITY SIDWALK RE: SEE CITY DETAILS

17 CONCRETE FLUME RE: SEE SHEET C210 18 TEMPORARY ASPHALT CURB RE: SEE SHEET C210

CONTRACTOR SHALL VERIFY LOCATION

GENERAL NOTES:

OF ALL UTILITIES PRIOR TO CONSTRUCTION. PERFORM TEMPORARY EROSION CONTROL MEASURES IN ACCORDANCE WITH ALL STATE & LOCAL REQUIREMENTS. TEMPORARY EROSION CONTROL
MEASURES SHALL BE MAINTAINED UNTIL PERMANENT IMPROVEMENTS ARE IN PLACE.

ALL PARKING STALLS SHALL BE MARKED W/ A 4" WIDE STRIPE. PARKING STRIPES TO BE PAINTED ACCORDING TO SPECIFICATIONS.

CONSTRUCT ALL SIDEWALKS WITH 2% MAX. CROSS SLOPE AWAY FROM BUILDING UNLESS OTHERWISE SHOWN ON PLANS.

PLACE EXPANSION JOINTS, IN SIDEWALKS AT AND WHEN ADJACENT TO BUILDINGS. ALL DIMENSIONS ARE TO BACK OF CURB UNLESS OTHERWISE NOTED.

UTILITY NOTES:

DEVELOPER:

BLUE SPRINGS SAFETY STORAGE LLC

1120 NW EAGLE RIDGE BLVD. GRAIN VALLEY, MISSOURI 64029 Ph.# 816-229-8115

PLAN NOTES:

LEGAL DESCRIPTION:

LOT 6A

74' CUŔB/CUT

1-470 BUSINESS AND TECHNOLOG

S83°14'56"E 205.04'

LOT 7 OF "I-470 BUSINESS AND TECHNOLOGY CENTER LOTS 1 THRU 22 AND TRCTS A AND B", A SUBDIVISION

IN LEE'S SUMMIT, JACKSON COUNTY, MISSOURI

1. SANITARY SEWER CONTRACTOR SHALL USE EXISTING SEWER STUB ALL EXISTING SEWER STUBS SHALL BE LOCATED AND CAPED PER CITY REQUIREMENTS

2. STORM SYSTEM ALL STORM SEWER WILL GATHERED IN A PRIVATE SYSTEM AND THEN CONNECTED TO A PUBLIC SYSTEM AT AN EXISTING INLET.

**DEVELOPMENT NOTES:** 

1. TOTAL LOT AREA = 54,072sf =1.24ac 2. TOTAL BULDING FOOTAGE=11,900sf 3. ESTIMATED 15% OFFICE = 1,785sf

4. PARKING STALLS REQUIRED STALL = 4 PER 1,000sf OFFICE (1,785 / 1,000) X 4=8 STALLS 1 PER 1,000sf WAREHOUSE

(10,115/1,000) X1=11 STALLS TOTAL REQUIRED = 19 PROPOSED STALLS STANDARD 19'X9' STALLS = 29-27

ADA 19'X9' STALL WITH ISLE = 4 TOTAL= 38 31 STALLS 5. TOTAL GREENS SPACE 19,922sf = 37 % 46% 6. FLOOR AREA RATIO (FAR) = 11,900sf / 54,072sf = 0.22 = 22 % COVERAGE

PERVIOUS VS IMPERVIOUS CALCULATIONS LOT SIZE 54,072 SF

IMPERVIOUS SURFACES BUILDINGS, PORCHES, DRIVES, PARKING, 34,150SF 29,166 sf

WALKS/MISC. TOTAL CALCULATIONS

-/- = 63% 54% IMPERVIOUS

37% 46% PERVIOUS (GREEN) PUBLIC IMPROVEMENTS

30 1. CITY SANITARY MAIN "NONE" 2. WATER MAIN "NONE"


3. CITY SIDEWALK = "NONE" PROJECT CONTACTS: ROBERT WALQUIST, P.E. 821 NE COLUMBUS ST LEE'S SUMMIT, MISSOURI 64063


34,150SF 29,166 sf

FINAL DEVELOPMENT PLAN

\_\_\_\_\_\_



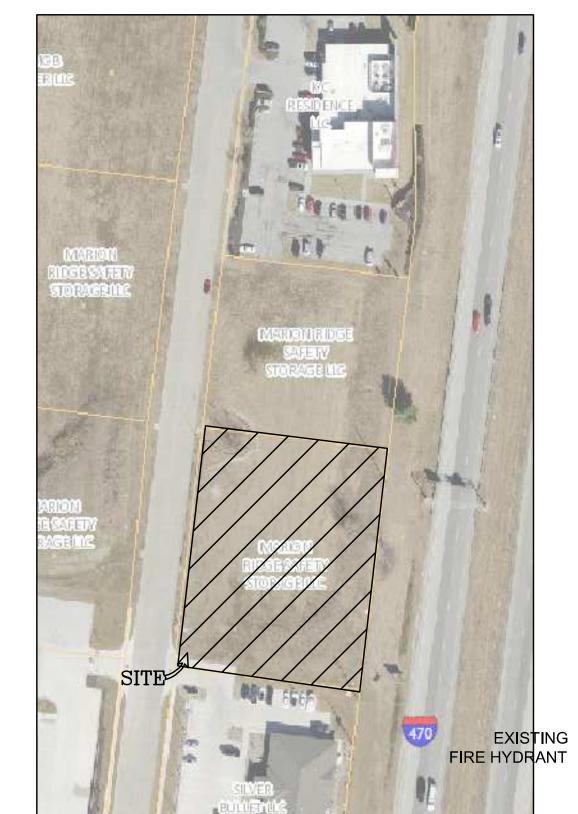

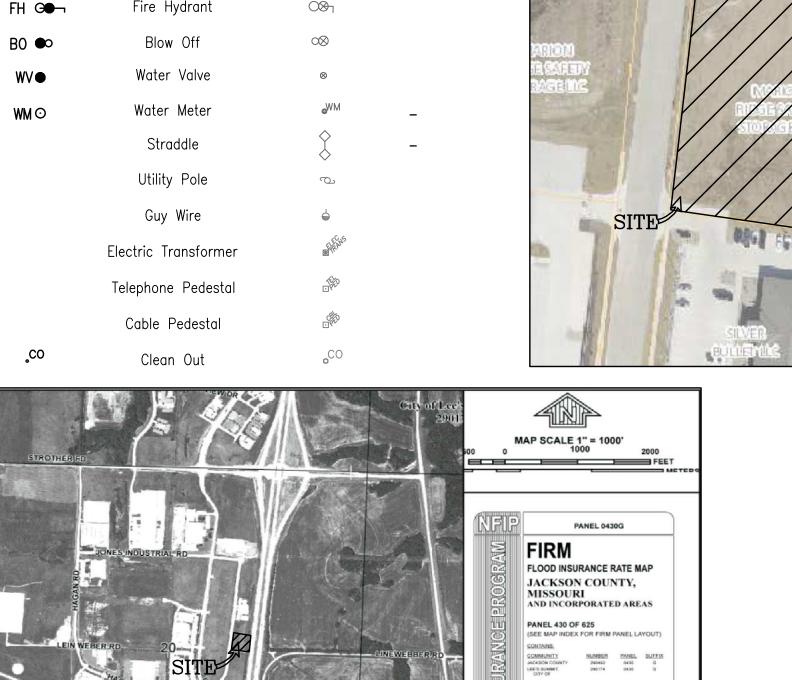

LINE LEGEND

Storm Line

Sanitary Line

Building Line

Easement Line

4'Sidewalk

Tree Line

Fence Line

Gas Line

SYMBOL LEGEND

Curb Inlet

Junction Box

Field Inlet

Flared End Section

Fire Hydrant

<u>EXISTING</u>

JB 🗆

 $\mathsf{FI}\square$ 

FESΔ

<u>PROPOSED</u>

<u>PROPOSED</u>

MH ●

JB 🔣

FI


FES 🔺

**EXISTING** 

\_\_\_\_\_\_BL \_\_\_\_

= = = =

\_\_\_\_\_ x \_\_\_

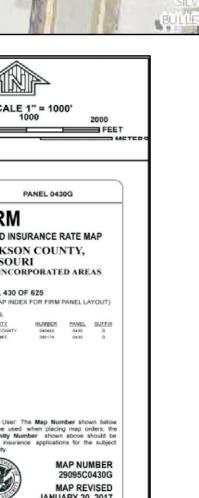

OIL AND GAS WELL NOTE:

1. NO OIL OR GAS WELL WHERE ON RECORD OR OBSERVED ON THE PROPERTY

INSTALL 37,38

4 CURB CUT

FINAL DEVELOPMENT PLAN FOR LOT 7 OF

"I-470 BUSINESS AND TECHNOLOGY CENTER," LOTS 1 THRU 22 AND TRACTS A AND B"

SECTION 20, TOWNSHIP 48, RANGE 31

LEE'S SUMMIT, JACKSON COUNTY, MISSOURI

TYP.

EXISTING\_

WATER MAIN

PROPOSED

LIGHT POLE TYP.

EXISTING


IRE HYDRANT

NONE THIS SHEET 11-17-22

REMOVED REAR ACCESS ROAD REVISED PARKING LAYOUT

REVISED LAYOUT


4. CITY ADA RAMPS = 3

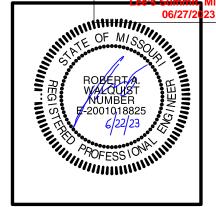

CONSTRUCTION As Noted on Plans Review

COPYRIGHT © 2022 8-2-22

RELEASED FOR CONSTRUCTION As Noted on Plans Review

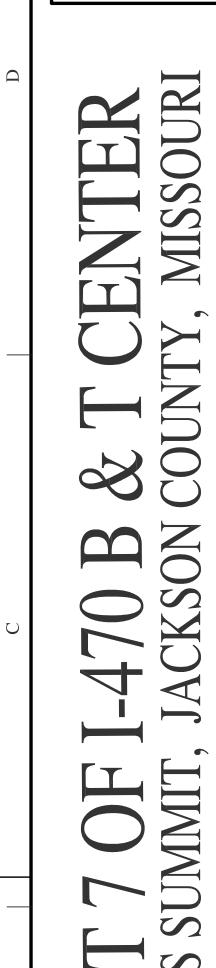

gineering, Inc ingineering for Residential & mercial Site Development NE Columbus St.

NONE THIS SHEET 11-17-22

REMOVED PATIAL PROFILE

NONE THIS SHEET 6-22-23

COPYRIGHT © 2022

1ST ISSUE

8-2-22

COPYRIGHT © 20

1ST ISSUE

8-2-22

REVISIONS

11-17-22

REVISIONS

11-17-22

2 12-14-22

3 1-10-23


4 6-22-23


SHEET NO.

C400


лов NO. E21-318


PRIVATE STORM IMPROVEMENT PLAN

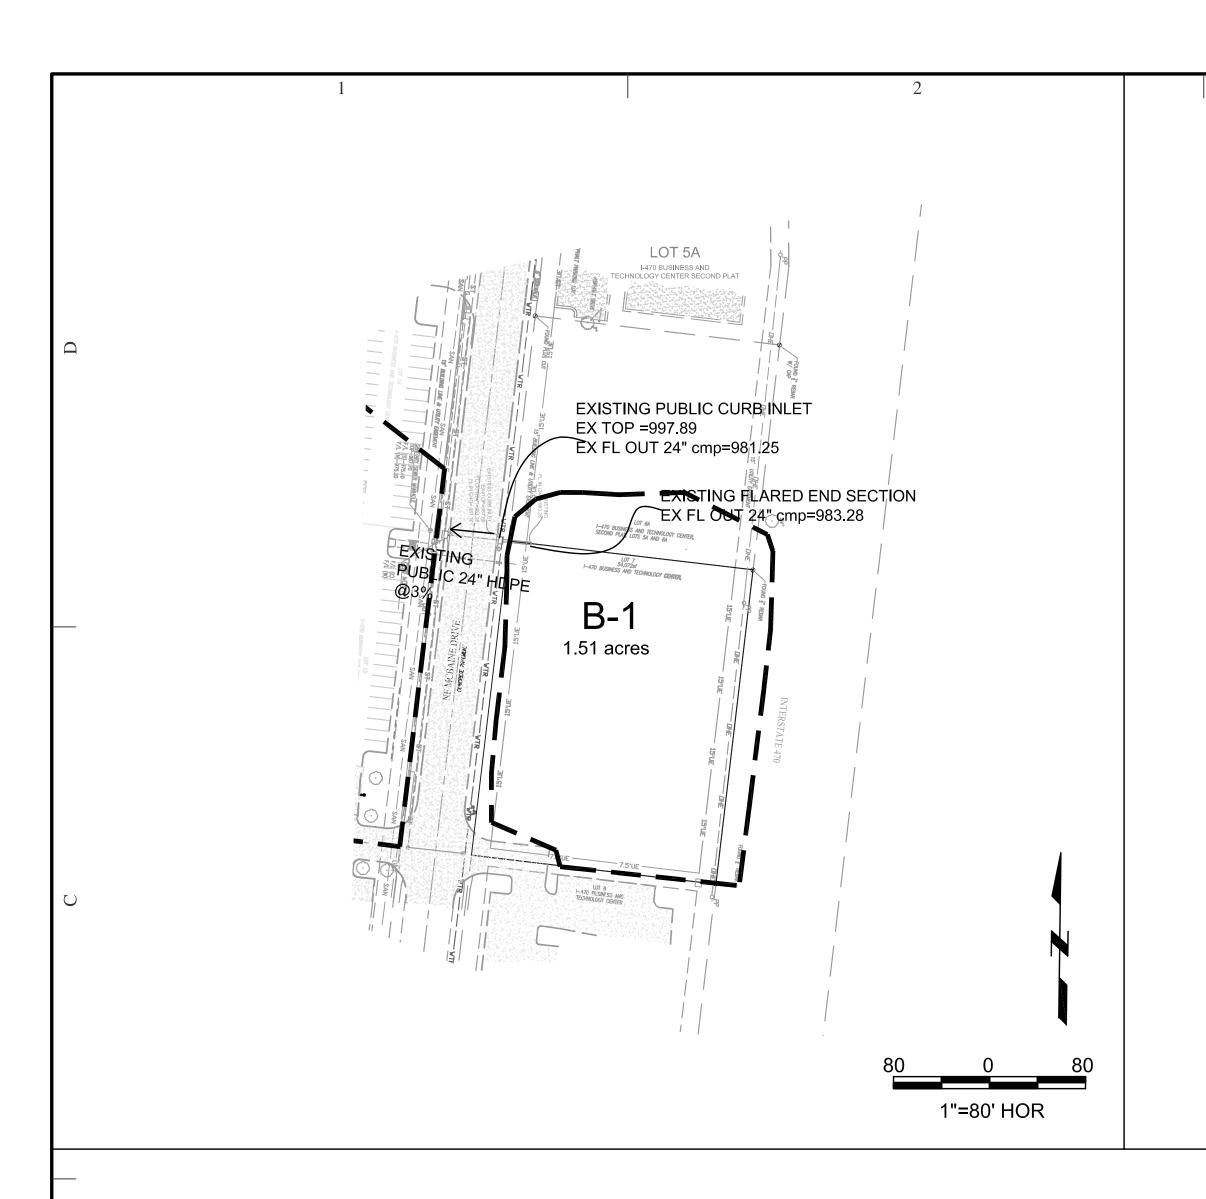

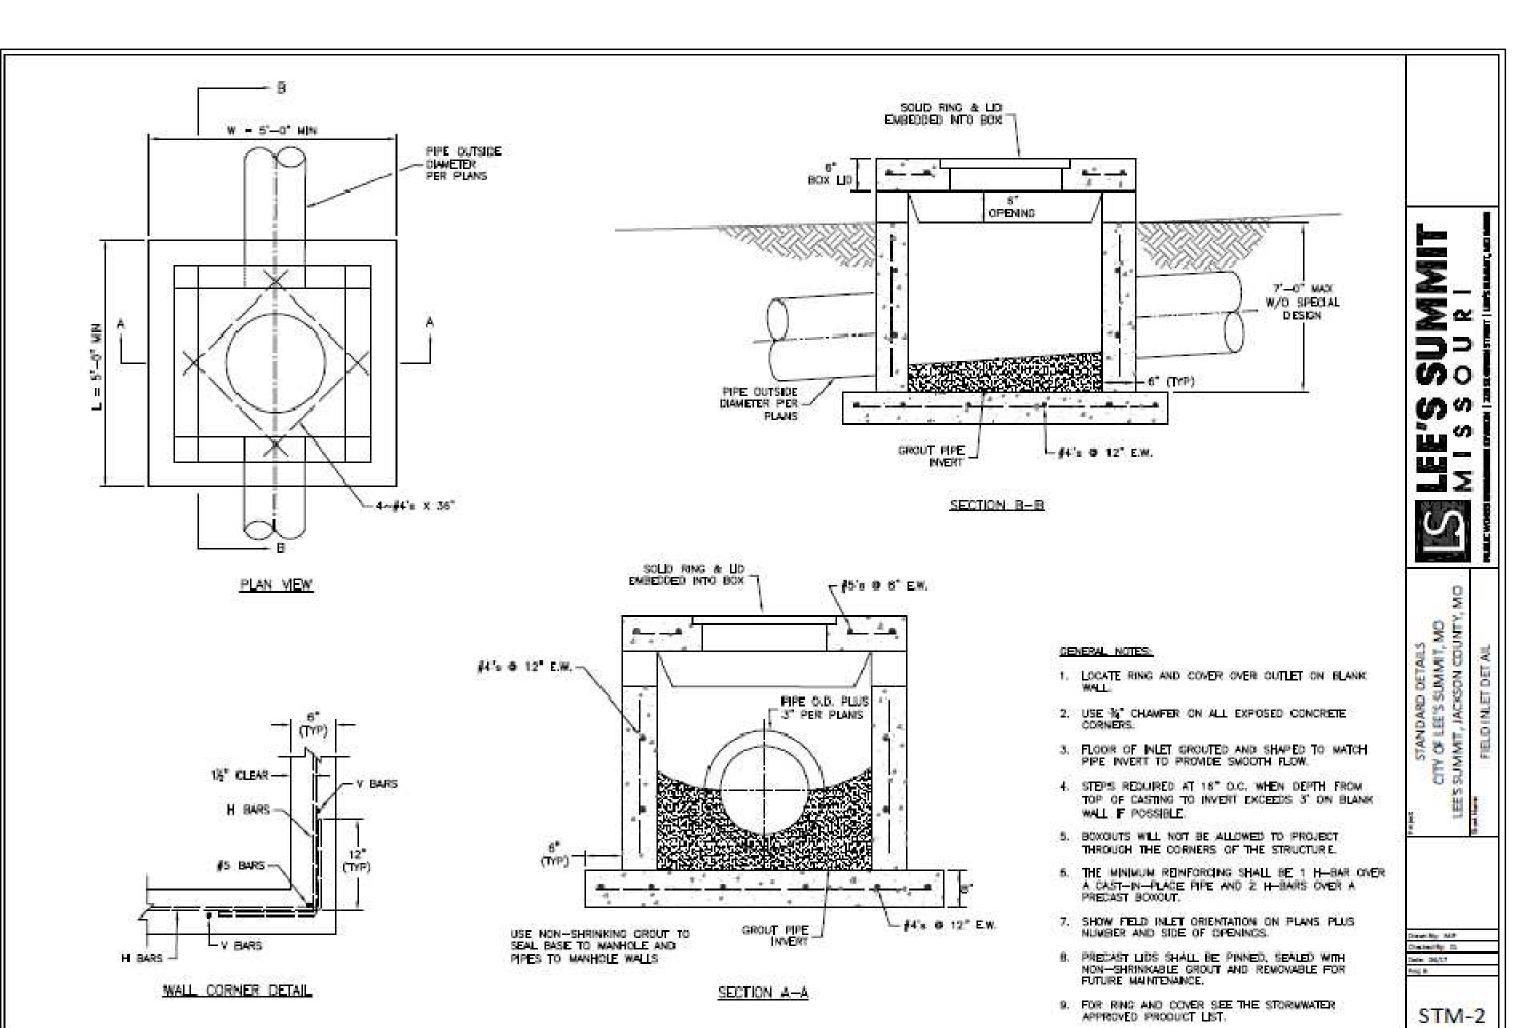



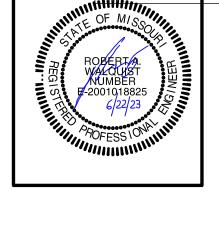

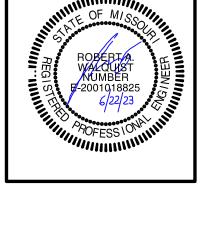

COPYRIGHT © 2022

C401

E21-318

SITE STORM DRAINAGE PLAN AND CALCULATIONS

PRE-DEVELOPMENT

POST-DEVELOPMENT

4.35 0.79

NONE THIS SHEET 11-17-22

	STORM SEWER CALCULATIONS TABLE																													
$\wedge$	Sewer Loca	tion	Draina	ge Area to I	Inlet	Time of Flow						Rainfall Rund	off Flow						Elevation					Sewer Charac	teristics			•	Velocit	ty stats
Line	From	То	Designation	Area	Coef	$T_{\mathrm{C}}$	I100 Intensity	I25 Intensity	I10 Intensity	Inlet 100yr K*I*C*A	Inlet 25yr K*I*C*A	Inlet 10yr K*I*C*A	Additional Flow Lines	Additional cfs	In-pipe 100yr K*I*ΣC*A	In-pipe 25yr K*I*ΣC*A	In-pipe 10yr K*I*ΣC*A	Inlet	Top elevation	Coverage	Pipe Size (in)	FLin	Flout	segment length	slope	pipe area	Pipe Capacity (cfs)	y 100yr overflow	V 10ys	V 100 yr
LINE 1	AI-1-5	AI-1-4	A-1	0.37	0.70	5.00	10.32	8.53	7.35	3.34	2.43	1.90			3.34	2.43	1.90	AI-1-5	992.00	2.00	12.00	989.00	988.00	112.00	0.89	0.79	3.36	Yes	2.43	4.26
	AI-1-4	AI-1-3	A-2	0.29	0.70	5.00	10.32	8.53	7.35	2.62	1.90	1.49			5.96	4.33	3.40	AI-1-4	992.00	2.95	15.00	987.80	987.30	53.00	0.94	1.23	6.27	Yes	2.77	4.86
	AI-1-3	AI-1-2	A-3	0.10	0.70	5.00	10.32	8.53	7.35	0.90	0.66	0.51			6.86	4.99	3.91	AI-1-3	991.50	3.15	15.00	987.10	985.00	142.00	1.48	1.23	7.85	Yes	3.19	5.60
A	AI-1-2	FI-1-1	NA	0.06	0.88	5.00	10.32	8.53	7.35	0.68	0.50	0.39	LINE 2	2.31	9.86	7.80	6.61	AI-1-2	989.00	2.70	18.00	984.80	984.00	27.00	2.96	1.77	18.07	Yes	3.74	5.58
	FI-1-1	EXC-CI	A-6	0.39	0.88	5.00	10.32	8.53	7.35	4.43	3.22	2.52			14.28	11.02	9.13	FI-1-1	987.50	2.77	24.00	982.73	981.76	15.00	6.47	3.14	57.50	Yes	2.91	4.55
																											1			,
																												1		1

LINE 2 CI-2-2 AI-1-1

RELEASED FOR

COPYRIGHT © 2022

REVISIONS

C402

RELEASED FOR CONSTRUCTION As Noted on Plans Review

COPYRIGHT (C) 2022 8-2-22

REVISIONS 1 11-17-22 12-14-22 /3\\_\_\_1-10-23

SHEET NO.

REVISIONS 3 1-10-23

6-22-23

E21-318

120 L.F. OF 6" SCH 40 LINE TIE TO EXISTING MAIN

SEE MED PLANS FOR SIZE

SITE WATER PLAN

DOMESTIC LINE PRIOIR TO THE PROPOSED

5 L.F. OF 3" COPPER SERVICE

IRRAGATION SYSTEM SHALI

90 L.F OF 2"COPPER DOMESTIC SERVICE LINE

INSTALLATION INSTALL

WATER MAIN

FIRE HYDRANT

**METER** 

GAS SERVICE PLAN | SITE SEWER PLAN 1"=50"

1. CONTRACTOR SHALL COORDINATE WITH UTILITY COMPANY PRIOR TO CONSTRUCTION.

ADDED LINE MATERIAL 12-14-22

1. ALL TAPS SHALL BE PER CITY DETAIL

2. IRRIGATION LINE SHALL COME OFF THE

REMOVED FIRE LINE 11-17-22

LEGEND

8 FIRE HYDRANT ₩ WATER VALVE

W WATER METER GAS METER

Y GAS MARKER

MANHOLE

□ STREET LIGHT

☆ YARD LIGHT ▲ CABLE TV PEDESTAL

ELECTRIC TRANSFORMER

T TELEPHONE BOX

-D- POWER POLE


-□- POWER POLE W/TEL.

X ELETRICAL PULL BOX

POWER POLE W/STREET LIGHT

A ELETRICAL PULL BOX ₩ GROUND FLOOD LIGHT

TRAFFIC SIGN

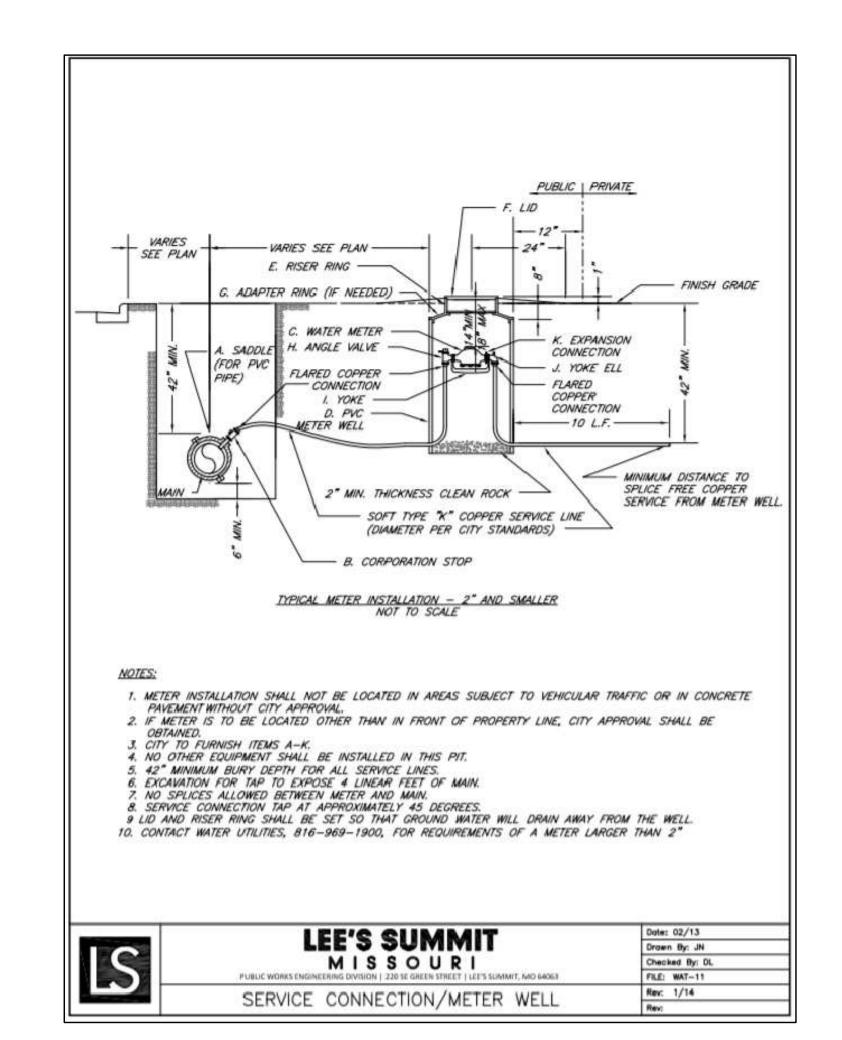

### SITE ELECTRICAL PLAN

**EXISTING STREET** 

ELECTICAL CONDUIT

1. CONTRACTOR SHALL COORDINATE WITH UTILITY COMPANY PRIOR TO CONSTRUCTION.

#### NOTE:

- 1. ENDS OF ALL CONDUITS SHALL BE MARKED WITH 4"X4" WOOD POST.
- 3. CONTRACTOR SHALL COORDINATE WITH UTILITY COMPANY PRIOR TO CONSTRUCTION.


60 L.F. OF SERVICE

CONNECTION


4. SHOP DRAWINGS FOR THE LIGHT POLES SHALL BE SUBMITTED AND APPROVED PRIOR TO CONSTRICTION.





SITE UTILITY PLAN

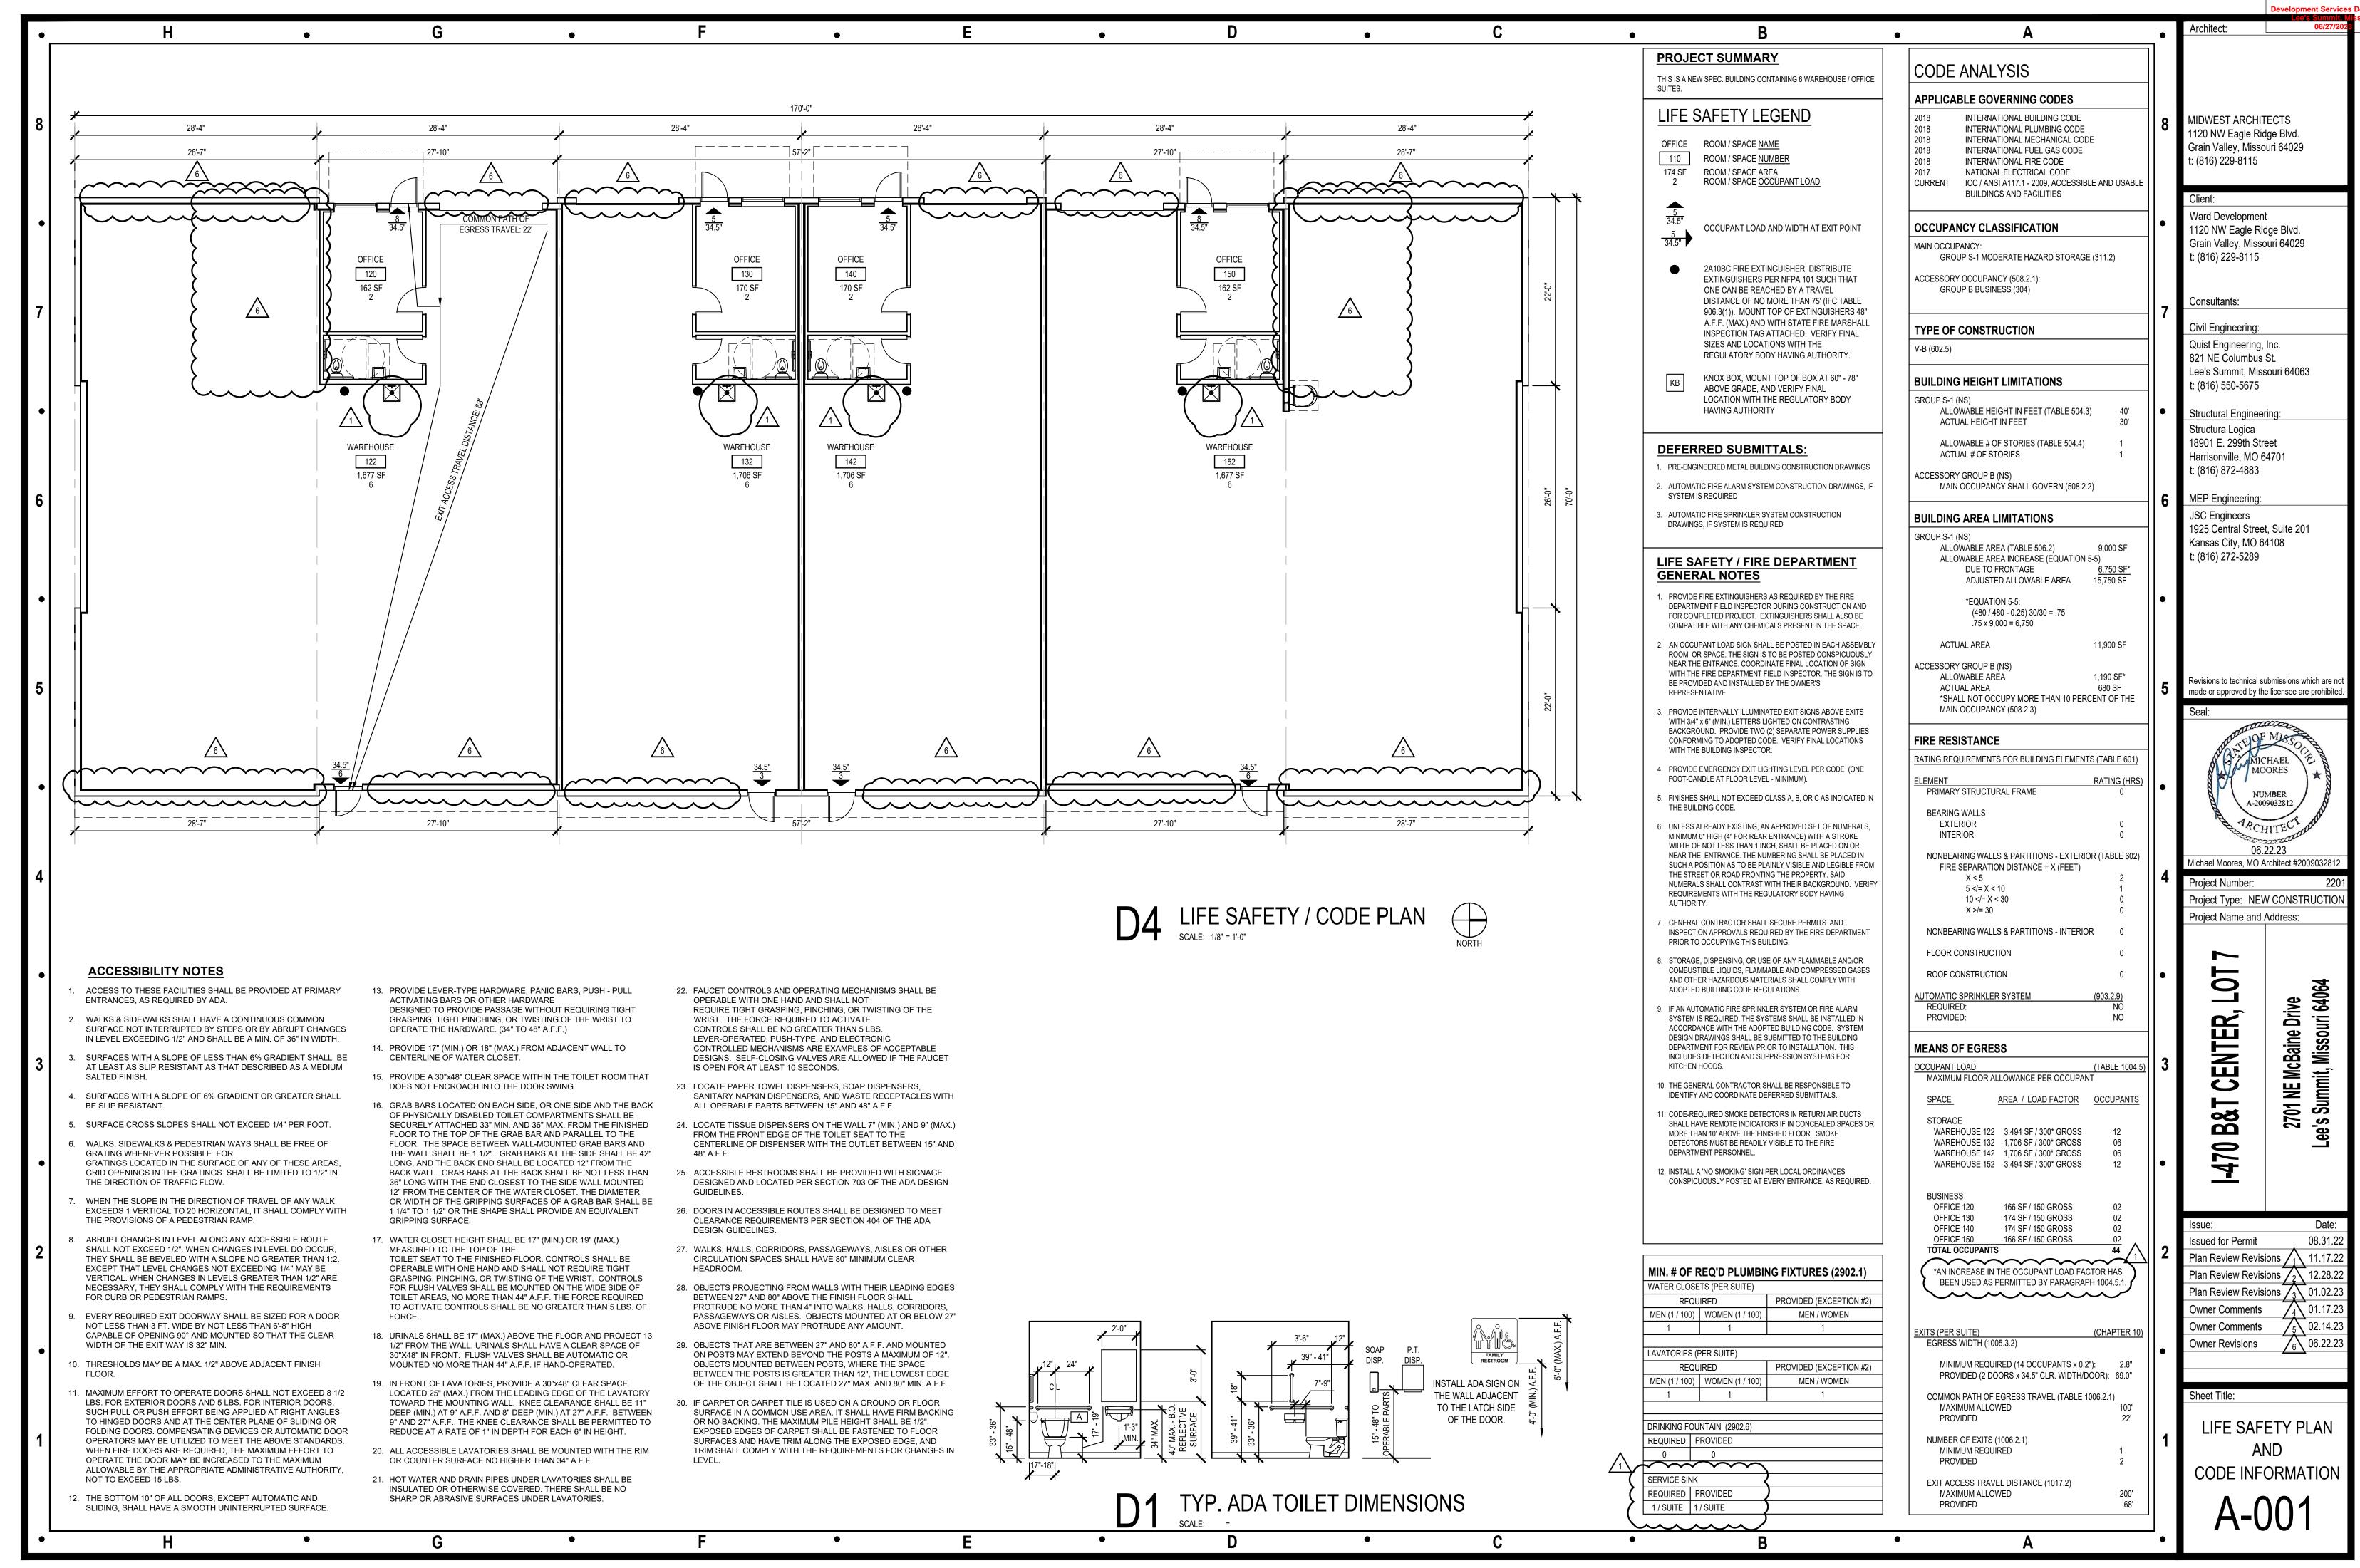



HARDWARE SETS	DOOR SCHEDULE DOOR TYPES	
1 1/2 PAIR BUTT HINGES, 1" PUSH / PULL SET, KEYED	DOOR FRAME DETAILS - (SEE THIS SHEET)	5/8" GYPSUM BOARD  BOARD  BACKER ROD  MIDWEST ARCHITE
CYLINDER LOCK, SURFACE-MOUNTED CLOSER, ALUMINUM THRESHOLD, SWEEP AND PILE WEATHERSEAL SET	TIPE SIZE IMISH FIMISH FIMISH FIMISH FIMISH TIRED JAMID THRESHOLD WARE SOMMENTS	AND SEALANT (BOTH SIDES, Grain Valley, Missour
1 1/2 PAIR BUTT HINGES, LEVER-HANDLE CLASSROOM FUNCTION LOCKSET, WALL STOP	110A A 1.3/4" X 3'-0" X 7'-0" AL ANOD ANOD AL ANOD ANOD (1)  110B B 1.3/4" X 3'-0" X 7'-0" HM PNT PNT PNT (2)	ALL AROUND)  BACKER ROD AND SEALANT (BOTH SIDES,  t: (816) 229-8115
1 1/2 PAIR BUTT HINGES, LEVER-HANDLE PRIVACY FUNCTION LOCKSET, WALL STOP	110 B 13/4 X 3-0 X 7-0 HM PNT PNT HM PNT PNT (3)	1 1/2" EIFS OVER 1 1/4" R-PANEL  ALL AROUND)  1/4" SHIM  Client:
1 1/2 PAIR BUTT HINGES, LEVER-HANDLE ENTRY FUNCTION LOCKSET, SURFACE-MOUNTED CLOSER, ALUMINUM	112A B 13/4" X 3'-0" X 7'-0" HM PNT PNT HM PNT PNT 4	Ward Development 11/4" R-PANEL 1120 NW Eagle Ridg
THRESHOLD, SWEEP AND WEATHERSEAL SET BY MANUFACTURER	112B C 12' X 14' AL ANOD ANOD 5 REF. DETAILS OF OVERHEAD DOOR MANUFACTURER - TO BE SELECTED BY OWNER TYPE 'A' TYPE 'A'	E'B'  Grain Valley, Missour t: (816) 229-8115
BT WANDFACTURER	6 120A A 13/4" X 3'-0" X 7'-0" AL ANOD ANOD AL ANOD ANOD 1	1/4" CONTINUOUS SILICONE SEAL 1/4" - 1/4" SHIM
OOR NOTES	120B B 1 3/4" X 3'-0" X 7'-0"	BACKER ROD AND SEALANT (BOTH SIDES, ALL AROUND) Consultants:  Civil Engineering:
ORS SHALL COMPLY WITH THE FOLLOWING	121 B 13/4 X 3-0 X 7-0 11M PN PN PN PN PN 1 PN 1 PN 1 PN	ALUMINUM STOREFRONT  ALUMINUM STOREFRONT  Quist Engineering, Ir 821 NE Columbus S
QUIREMENTS:  ALL DOOR HANDLES TO BE LEVER TYPE.	122B C 12' X 14' AL ANOD ANOD 5 REF. DETAILS OF OVERHEAD DOOR MANUFACTURER - TO BE SELECTED BY OWNER	JAMB DETAIL  JAMB DETAIL  Lee's Summit, Missor t: (816) 550-5675
EGRESS DOORS SHALL BE READILY OPENABLE FROM THE EGRESS SIDE WITHOUT THE USE OF A	130A A 1 3/4" X 3'-0" X 7'-0" AL ANOD ANOD AL ANOD ANOD 1	Structural Engineerin
KEY OR ANY SPECIAL KNOWLEDGE OR EFFORT.	130B B 1 3/4" X 3'-0" X 7'-0" HM PNT PNT HM PNT PNT 2	Structura Logica
PROVIDE DOOR STOPS OF APPROPRIATE TYPE FOR ALL INTERIOR DOORS, MATCH ADJACENT HARDWARE FINISH.	131 B 1 3/4" X 3'-0" X 7'-0" HM PNT PNT HM PNT PNT (3)	ALUMINUM STOREFRONT  HEAD / SILL DETAILS  1890 1 E. 299th Street Harrisonville, MO 647 t: (816) 872-4883
DOOR CLOSERS SHALL BE ADJUSTED SO THAT FROM AN OPEN POSITION OF 90 DEGREES, THE	132A B 1 3/4" X 3'-0" X 7'-0"	6 MEP Engineering:
TIME REQUIRED TO MOVE THE DOOR TO AN OPEN POSITION OF 12 DEGREES WILL BE 5 SECONDS	132B C 12 X 14 AL ANOD ANOD	JSC Engineers 1925 Central Street,
MINIMUM.  MAXIMUM EFFORT TO OPERATE DOORS SHALL NOT	140B B 13/4" X 3'-0" X 7'-0" HM PNT PNT HM PNT PNT	BACKER ROD AND SEALANT Kansas City, MO 64
EXCEED 8 1/2 POUNDS FOR EXTERIOR DOORS AND 5 POUNDS FOR INTERIOR DOORS, SUCH PULL OR PUSH EFFORT BEING APPLIED AT RIGHT ANGLES TO	141 B 1 3/4" X 3'-0" X 7'-0" HM PNT PNT HM PNT PNT 3	(BOTH SIDES, ALL AROUND)  ALL AROUND  5/8" GYPSUM BOARD
HINGED DOORS AND AT THE CENTER PLANE OF SLIDING OR FOLDING DOORS. COMPENSATING DEVICES OR AUTOMATIC DOOR OPERATORS MAY	142A B 13/4" X 3'-0" X 7'-0" HM PNT PNT HM PNT PNT	BACKER ROD AND SEALANT (BOTH SIDES,
BE UTILIZED TO MEET THE ABOVE STANDARDS. WHEN FIRE DOORS ARE REQUIRED, THE MAXIMUM	142B C 12' X 14' AL ANOD ANOD	1 1/4" R-PANEL  ALL AROUND)  1/4" SHIM
EFFORT TO OPERATE THE DOOR MAY BE INCREASED TO THE MAXIMUM ALLOWABLE BY THE APPROPRIATE ADMINISTRATIVE AUTHORITY, NOT	150B B 13/4" X 3'-0" X 7'-0" HM PNT PNT HM PNT PNT 2	1 1/2" EIFS OVER 1 1/4" R-PANEL
TO EXCEED 15 POUNDS.  THE BOTTOM 10" OF ALL DOORS EXCEPT	151 B 1 3/4" X 3'-0" X 7'-0" HM PNT PNT HM PNT PNT 3	Revisions to technical submade or approved by the li
AUTOMATIC DOORS, POWER ASSISTED DOORS, AND SLIDING DOORS SHALL HAVE A SMOOTH,	152A B 1 3/4" X 3'-0" X 7'-0" HM PNT PNT HM PNT PNT	Seal:
UNINTERRUPTED SURFACE TO ALLOW THE DOOR TO BE OPENED BY A WHEELCHAIR FOOTREST WITHOUT CREATING A TRAP OR HAZARDOUS	152B C 12' X 14' AL ANOD ANOD	MICH MICH
CONDITION.  EXIT DOORS IN ASSEMBLY AND EDUCATION	160A A 1-3/4" X 3'-0" X 7'-0" AL ANOD ANOD AL ANOD ANOD (1)  160B B 1-3/4" X 3'-0" X 7'-0" HM PNT PNT HM PNT PNT (2)	ALUMINUM DOOR FRAME
OCCUPANCIES SERVING AN OCCUPANT LOAD OF 50 OR MORE SHALL BE EQUIPPED WITH PANIC HARDWARE, WITH THE EXCEPTION BELOW (NOTE 7).	161 B 13/4" X 3'-0" X 7'-0" HM PNT PNT HM PNT PNT (3)	JAMB DETAIL
MAIN EXIT DOORS HAVING KEY-OPERATED LOCKING	162A B 13/4" X 3'-0" X 7'-0" HM PNT PNT HM PNT PNT 4	© 06.22
DEVICES ON THE EGRESS SIDE IN GROUP A OCCUPANCIES (SERVING 300 OCCUPANTS OR LESS), GROUPS B, F, M, S, AND PLACES OF	162B C 12' X 14' AL ANOD ANOD 5 REF. DETAILS OF OVERHEAD DOOR MANUFACTURER - TO BE SELECTED BY OWNER	Michael Moores, MO Arc  Project Number:
RELIGIOUS WORSHIP SHALL HAVE DURABLE SIGNAGE ABOVE THE DOOR IN 1" HIGH LETTERS ON CONTRASTING BACKGROUND STATING: "THIS DOOR		Project Type: NEW
TO REMAIN UNLOCKED WHEN THIS SPACE IS OCCUPIED". LOCKING DEVICES SHALL BE READILY DISTINGUISHABLE AS LOCKED.	ROOM FINISH SCHEDULE WINDOW LEGE	
LATCHING AND LOCKING DOORS THAT ARE HAND	ROOM FLOOR BASE WALL FINISH WALL FINISH WALL FINISH WALL FINISH CEILING COMMENTS NUMBER ROOM NAME MATERIAL (NORTH) (EAST) (SOUTH) (WEST) MATERIAL FINISH COMMENTS  5'-0"	ALUMINUM DOOR FRAME HEAD / THRESHOLD DETAILS  • ———————————————————————————————————
ACTIVATED AND WHICH ARE IN THE PATH OF TRAVEL SHALL BE OPERABLE WITH A SINGLE EFFORT BY LEVER TYPE HARDWARE, PANIC BARS,	110 OFFICE CONC RCB PNT-1 PNT-1 PNT-1 ACT-1 -	HEAD / THRESHOLD DETAILS  LINER R-PANEL  LINER R-PANEL
PUSH-PULL ACTIVATING BARS OR OTHER HARDWARE DESIGNED TO PROVIDE PASSAGE WITHOUT REQUIRING THE ABILITY TO GRASP THE	112 WAREHOUSE CONC EXP -	1 1/2" EIFS OVER 1 1/4" R-PANEL
OPENING HARDWARE. LOCKABLE EXIT DOORS SHALL OPERATE AS ABOVE IN EGRESS DIRECTION.	120 OFFICE CONC RCB PNT-1 PNT-1 PNT-1 ACT-1 - [N   1   1   1   1   1   1   1   1   1	1 1/2" EIFS OVER 1 1/4" R-PANEL
HAND-ACTIVATED DOOR OPENING HARDWARE TO BE CENTERED BETWEEN 34" AND 44" ABOVE THE	122 WAREHOUSE CONC EXP -	
FLOOR.  EVERY DOORWAY WHICH IS LOCATED WITHIN AN	130         OFFICE         CONC         RCB         PNT-1         PNT-1         PNT-1         ACT-1         -           131         TOILET         SC         RCB         PNT-1         PNT-1         PNT-1         ACT-1         -	
ACCESSIBLE PATH OF TRAVEL SHALL BE OF A SIZE AS TO PERMIT THE INSTALLATION OF A DOOR NOT LESS THAN 3'-0" IN WIDTH AND NOT LESS THAN 6'-8"	132 WAREHOUSE CONC EXP - 2" x 4 1/2" THERMALLY BROKEN DAR	
IN HEIGHT. WHEN INSTALLED, EXIT DOORS SHALL BE CAPABLE OF OPENING SO THAT THE CLEAR WIDTH OF THE EXIT IS NOT LESS THAT 32".	140 OFFICE CONC RCB PNT-1 PNT-1 PNT-1 ACT-1 - ANODIZED ALUMINUM STOREFRON LOW-E INSULATED CLEAR TEMPERE TUBELITE (OR EQUAL)	
MEASURED BETWEEN THE FACE OF THE OPENED DOOR AND THE OPPOSITE STOP.	142 WAREHOUSE CONC EXP -	1 1/2 EIFS OVER 1 1/4" R-PANEL
MINIMUM MANEUVERING CLEARANCES AT DOORS SHALL BE AS REQUIRED BY THE ICC/ANSI A117.1	150         OFFICE         CONC         RCB         PNT-1         PNT-1         PNT-1         ACT-1         -           151         TOILET         SC         RCB         PNT-1         PNT-1         PNT-1         ACT-1         -	EXTERIOR HOLLOW METAL EXTERIOR HOLLOW METAL Issue:
ACCESSIBILITY CODE. THE FLOOR OR GROUND AREA WITHIN THE REQUIRED CLEARANCES SHALL BE LEVEL AND CLEAR. THE FLOOR OR LANDING	6 152 WAREHOUSE CONC EXP -	DOOR FRAME JAMB DETAIL  DOOR FRAME HEAD DETAIL    Issued for Permit   Plan Review Revision   Plan Revision
SHALL BE NOT MORE THAN 1/2" LOWER THAN THE THRESHOLD OF THE DOORWAY.	160         OFFICE         CONC         RCB         PNT-1         PNT-1         PNT-1         PNT-1         ACT-1         -           161         TOILET         SC         RCB         PNT-1         PNT-1         PNT-1         ACT-1         -	Plan Review Revision  Plan Review Revision  Plan Review Revision
DOORS SHALL NOT PROJECT MORE THAN 7" INTO THE REQUIRED CORRIDOR WIDTH WHEN FULLY	161   TOILET   SC   RCB   PNT-1   PNT-1   PNT-1   ACT-1   -	Owner Comments Owner Comments
OPENED OR MORE THAN ONE HALF INTO THE REQUIRED WIDTH WHEN IN ANY POSITION.		Owner Revisions  2x4 SUB FRAME - AS REQUIRED  Owner Revisions
WHERE A PAIR OF DOORS IS UTILIZED, AT LEAST ONE OF THE DOORS SHALL PROVIDE A CLEAR, UNOBSTRUCTED OPENING WIDTH OF 32" WITH THE		
LEAF POSITIONED AT AN ANGLE OF 90° FROM ITS CLOSED POSITION.		Sheet Title:
EXIT DOORS SHALL SWING IN THE DIRECTION OF EXIT TRAVEL WHEN SERVING 50 OR MORE		DOOR, WII
		FINISH SCH
OCCUPANTS.		HOLLOW METAL DOOR HOLLOW METAL DOOR AND TYP.

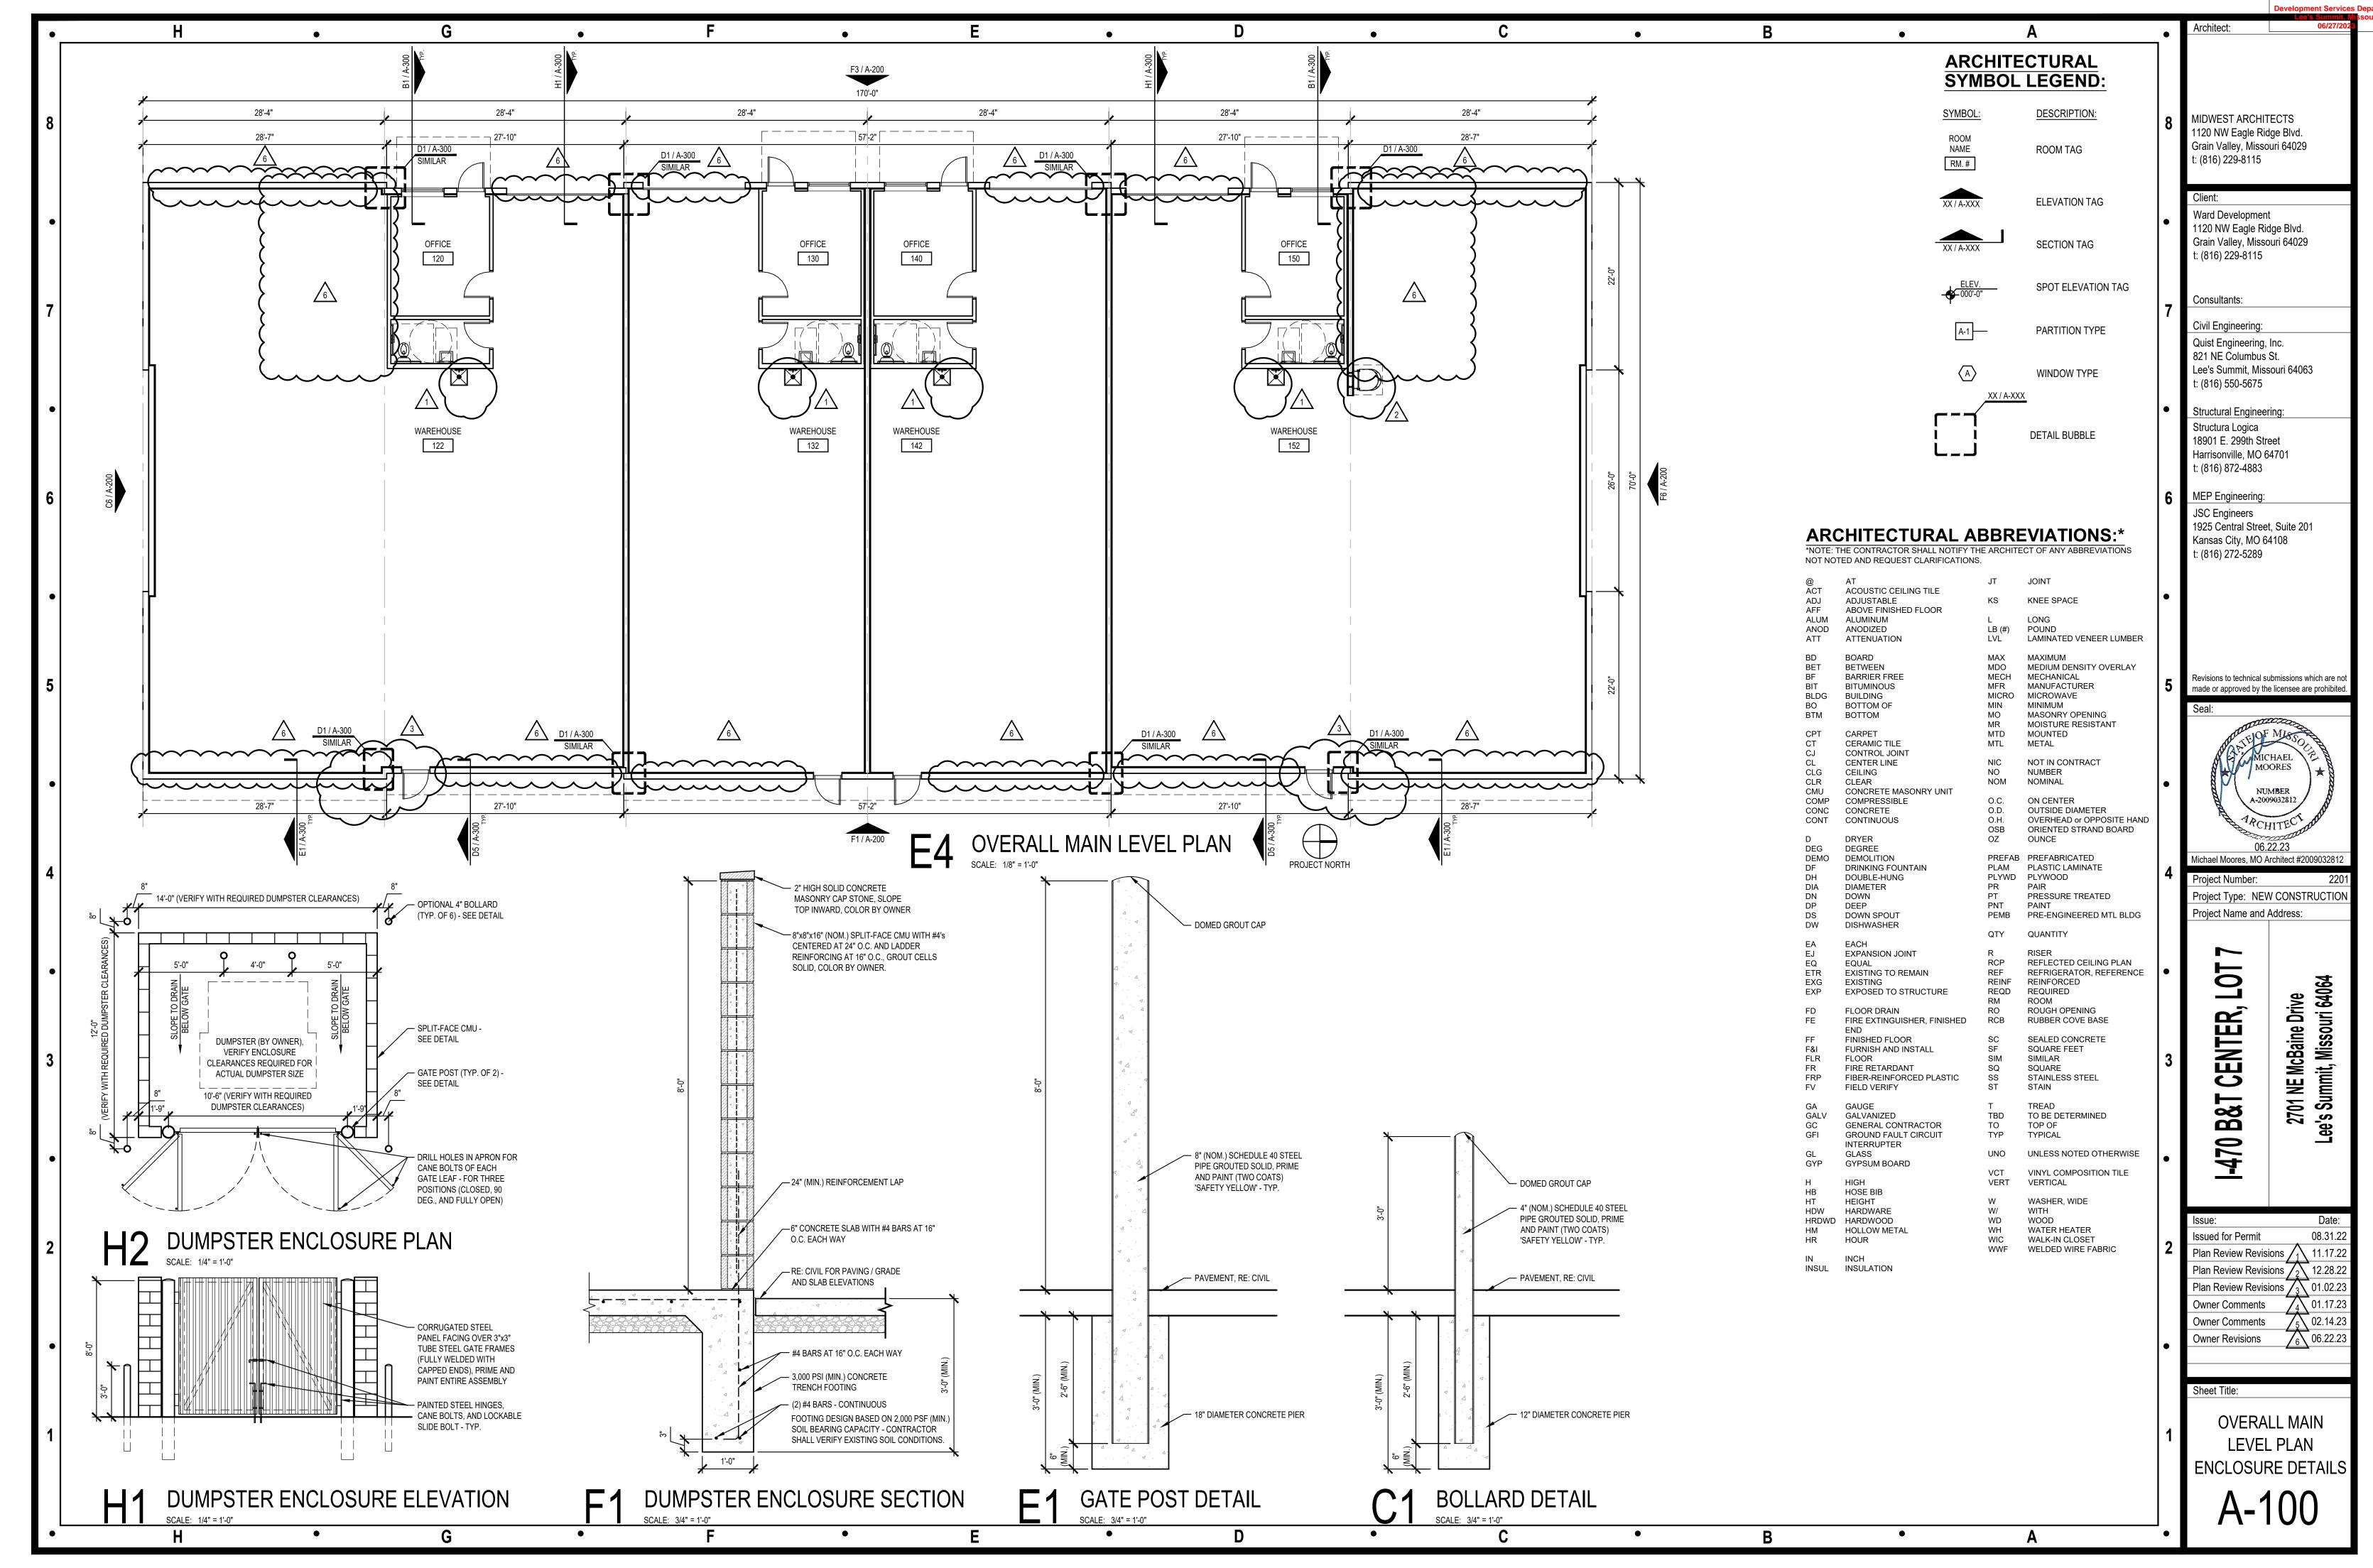


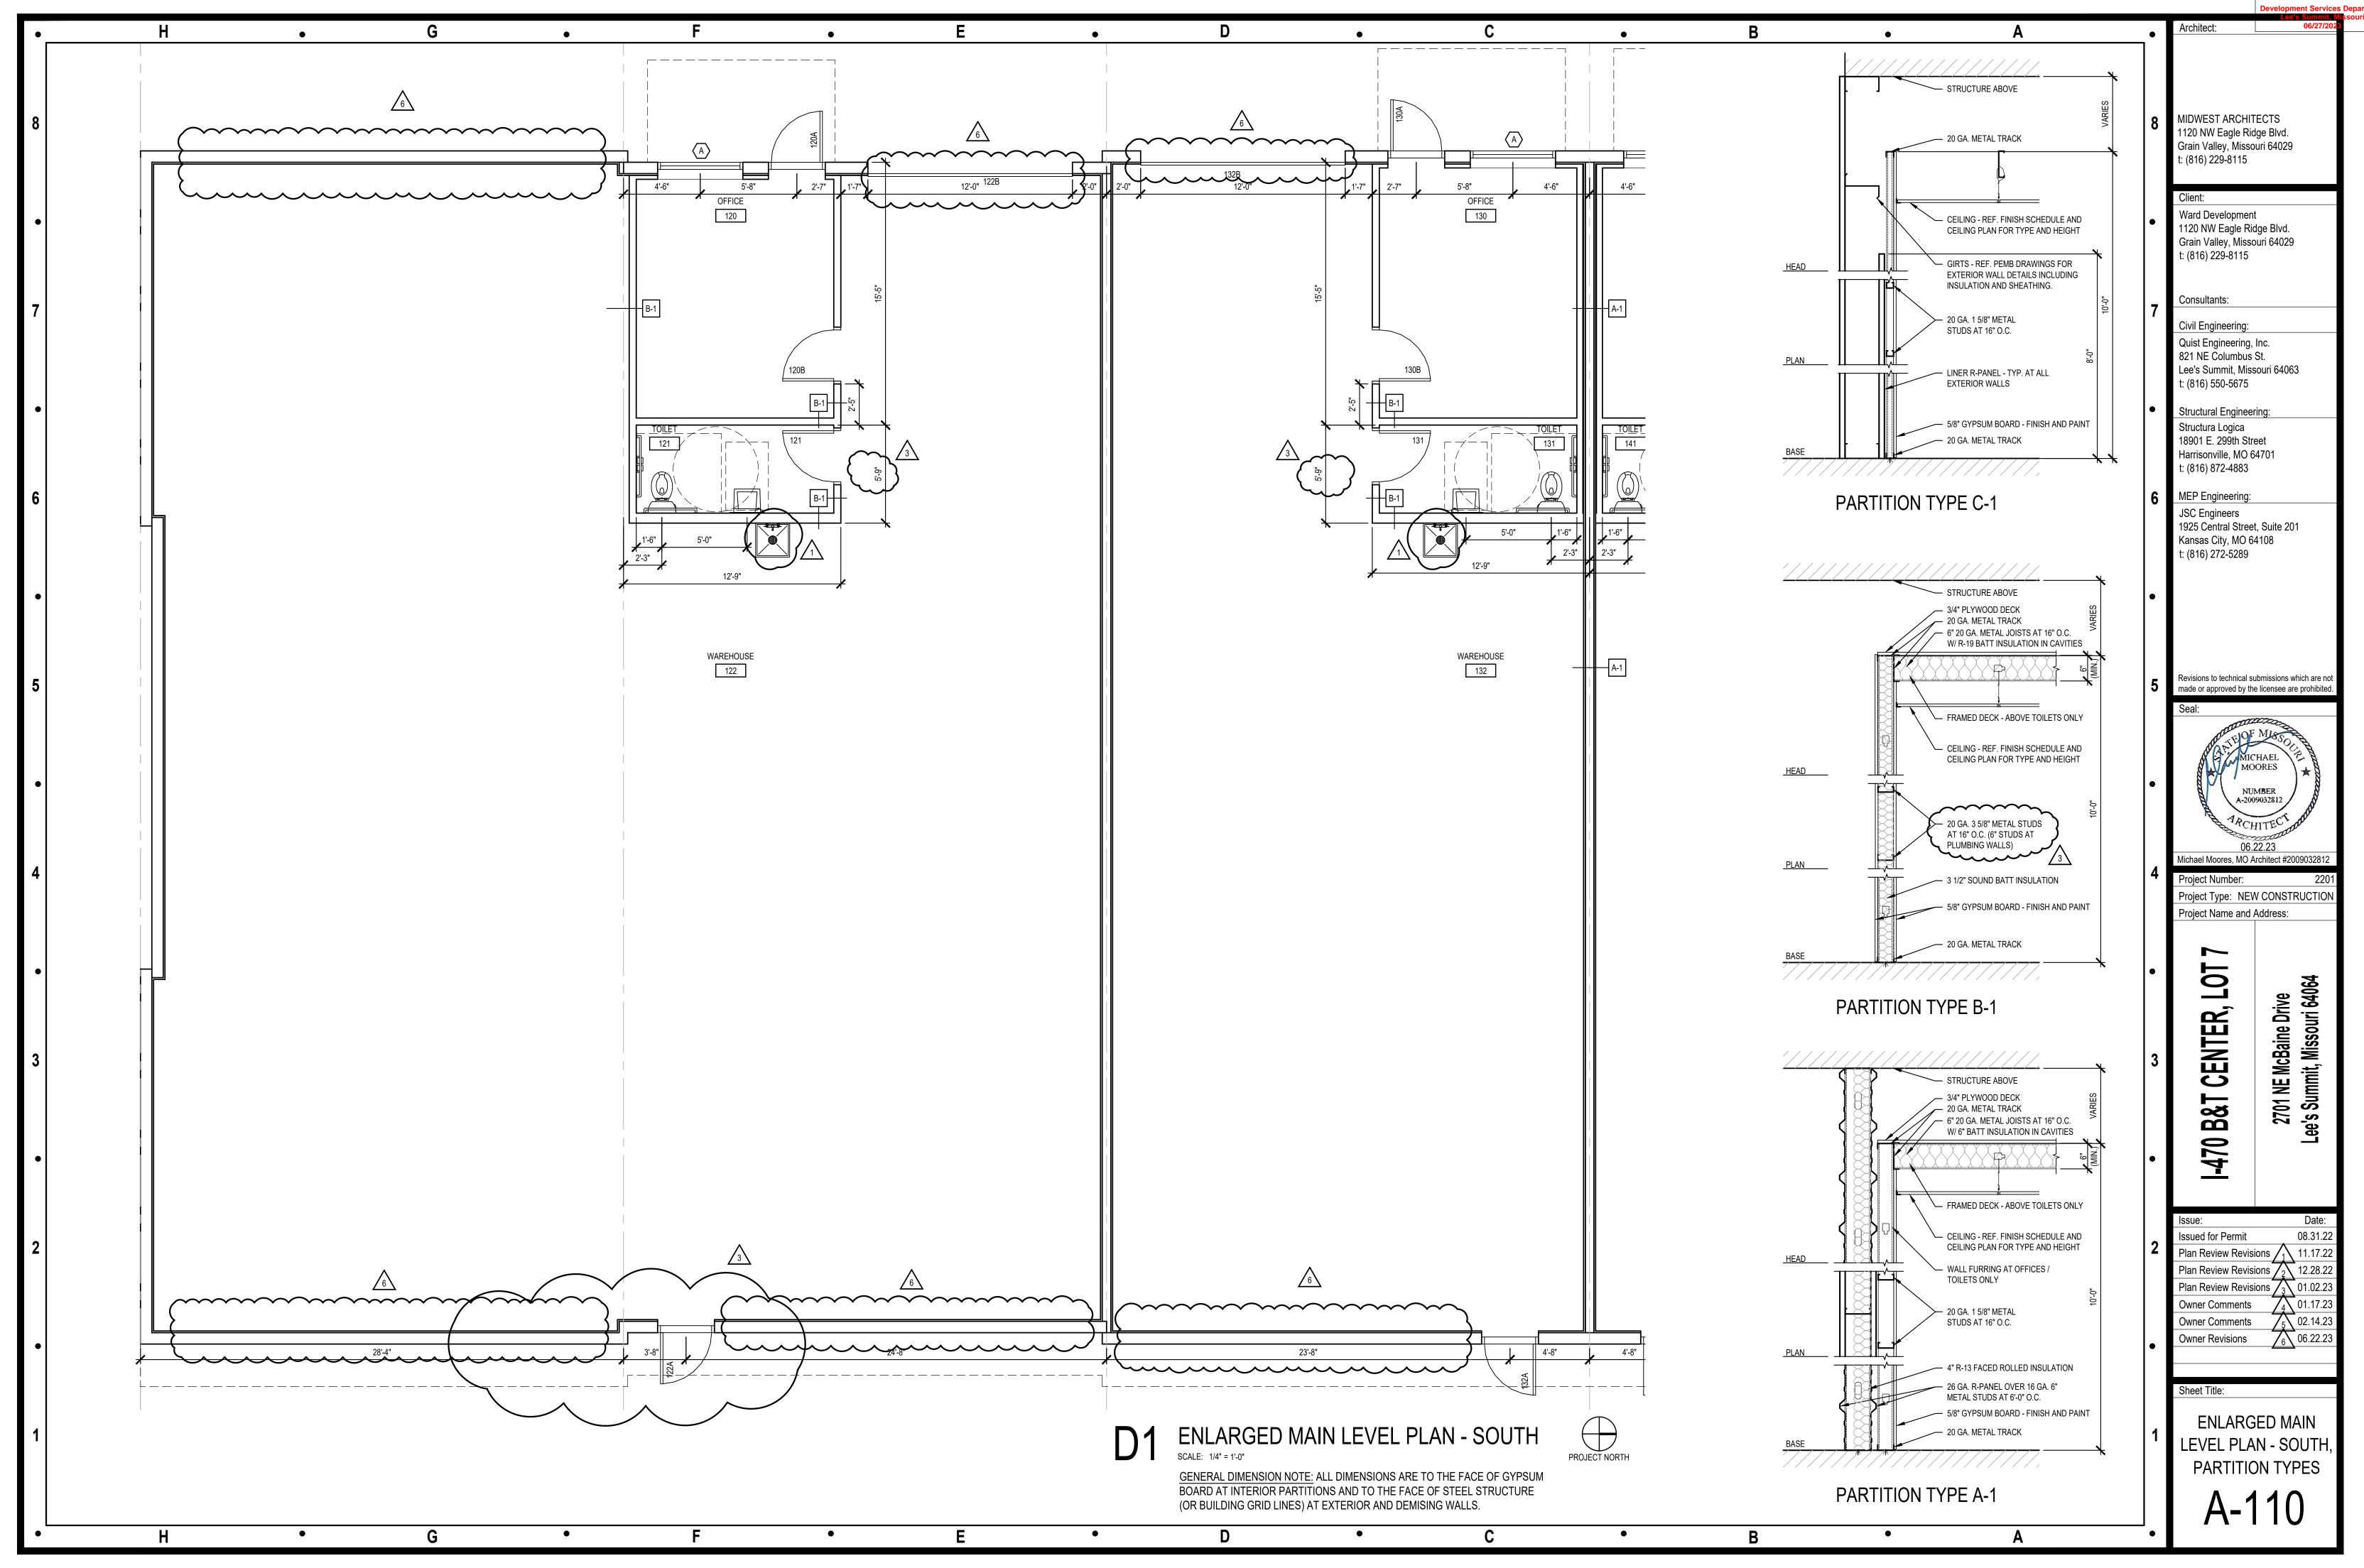


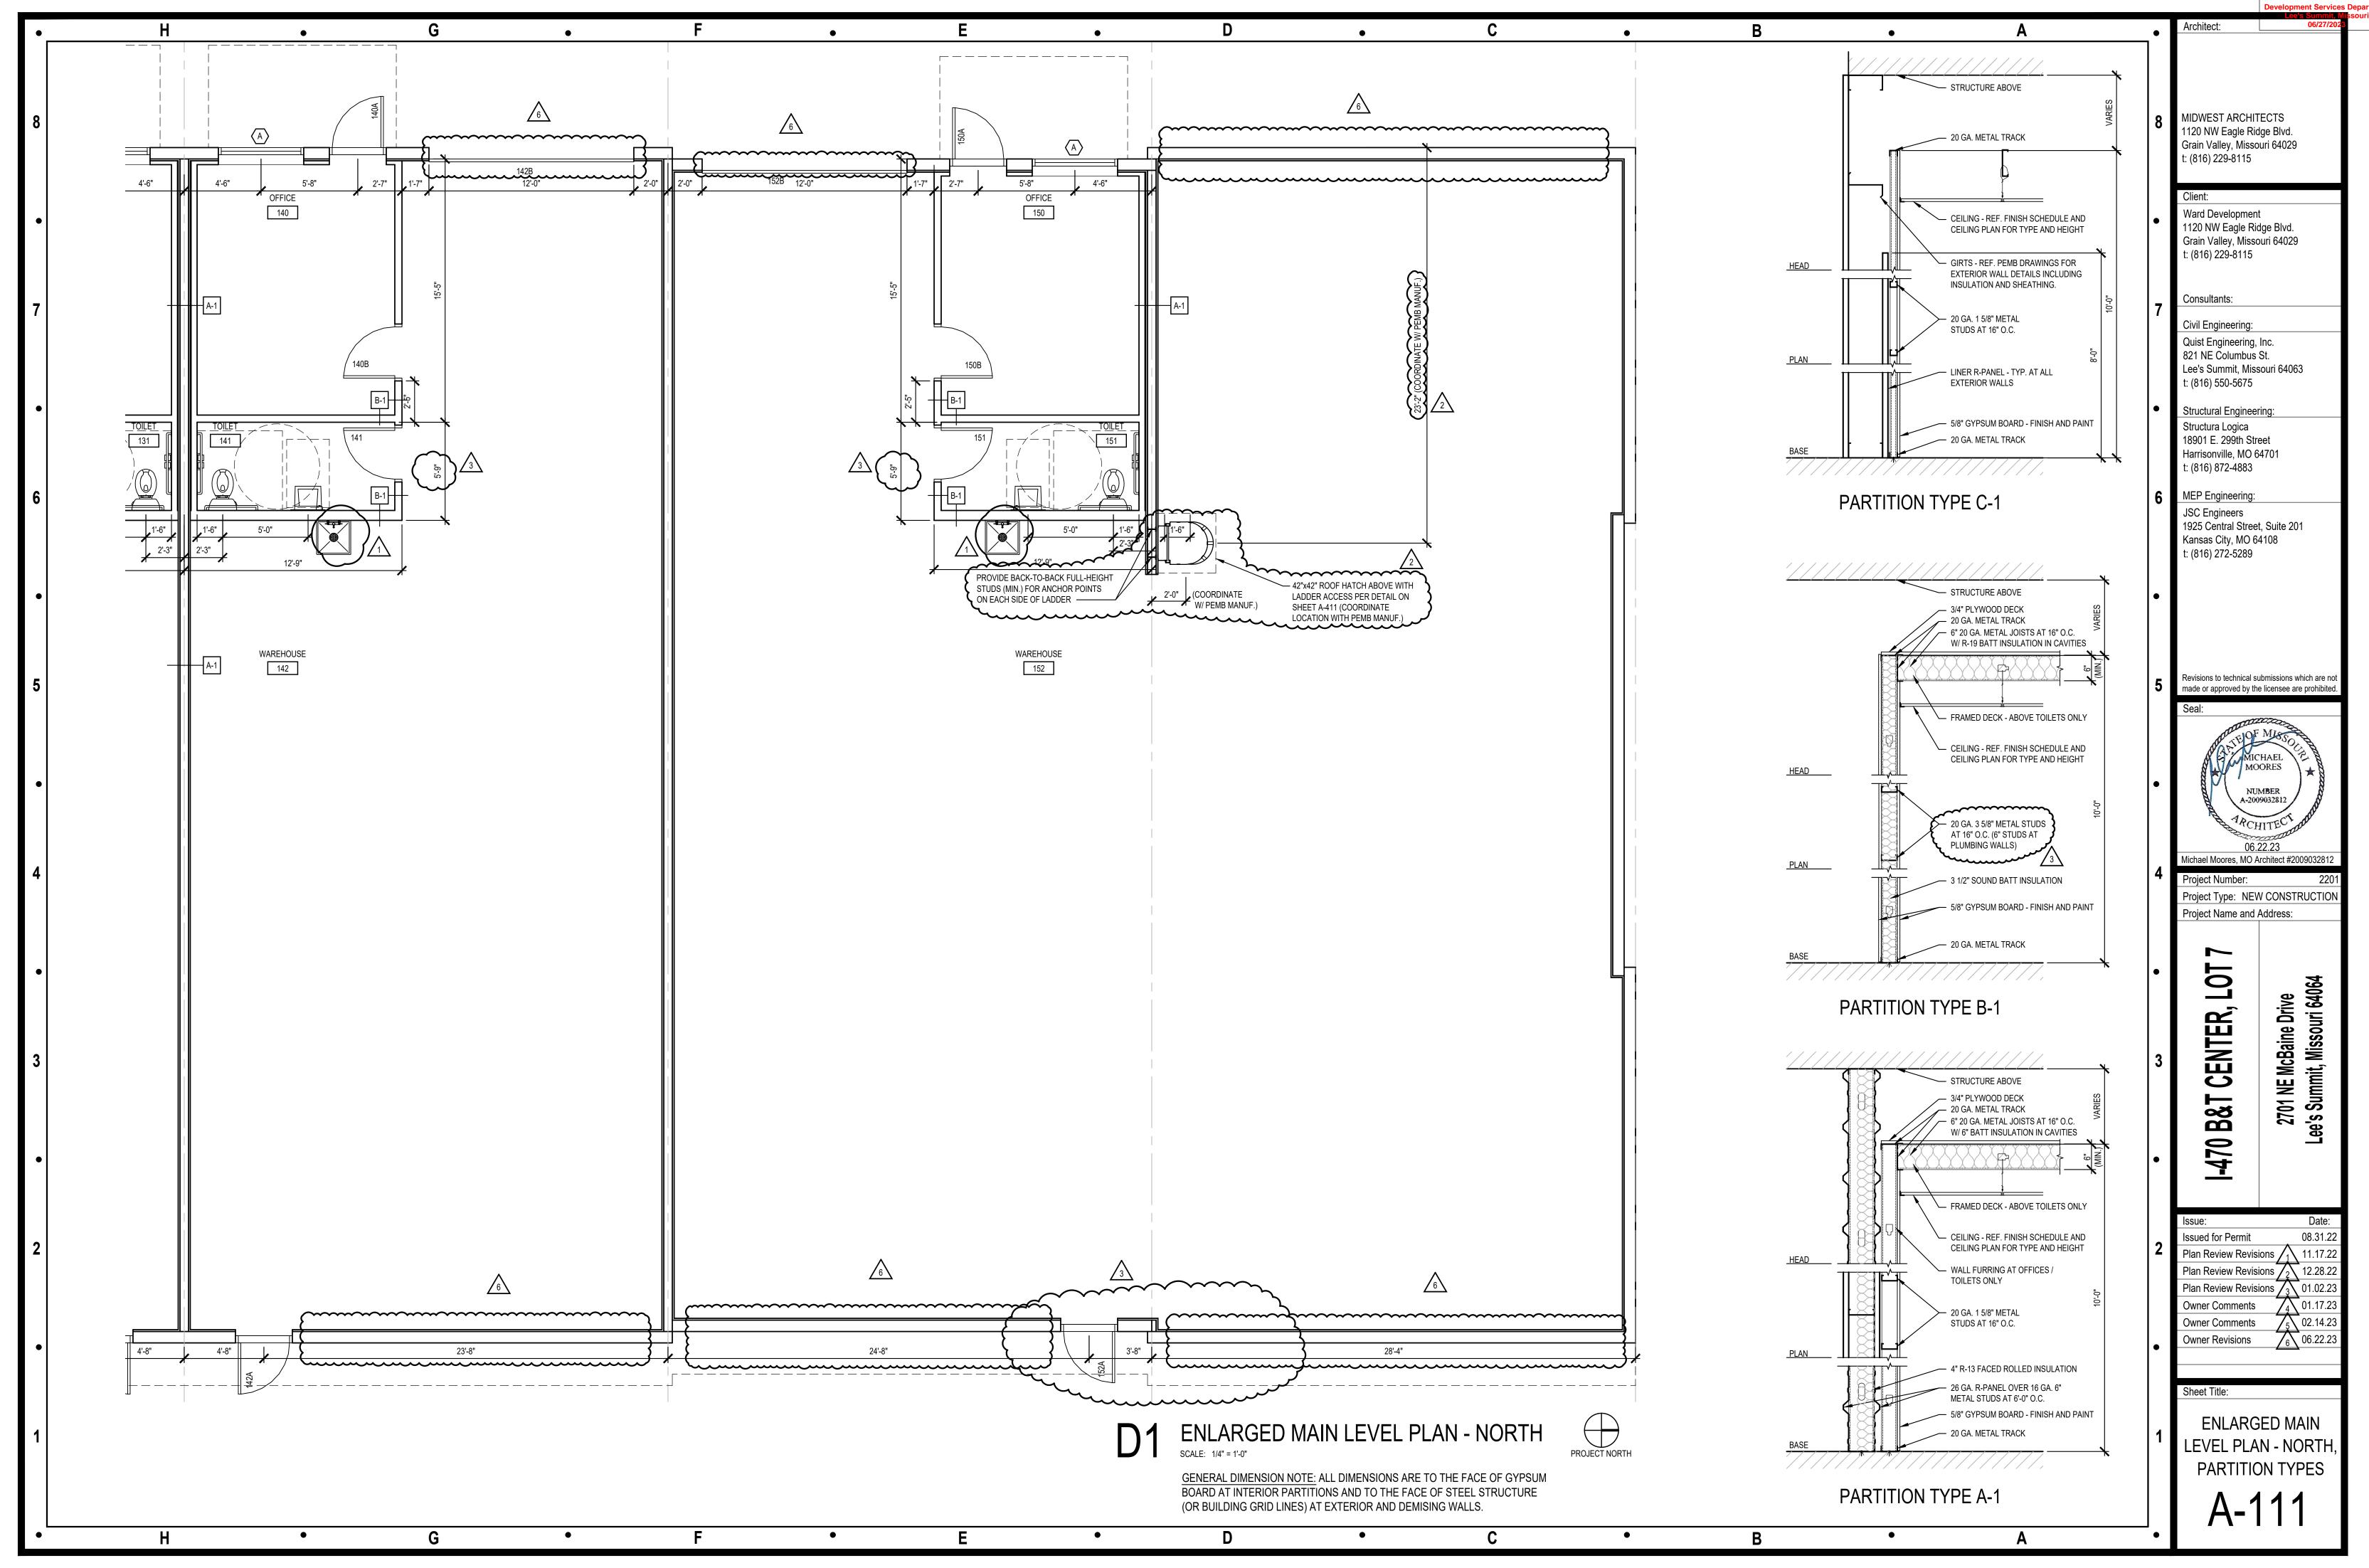


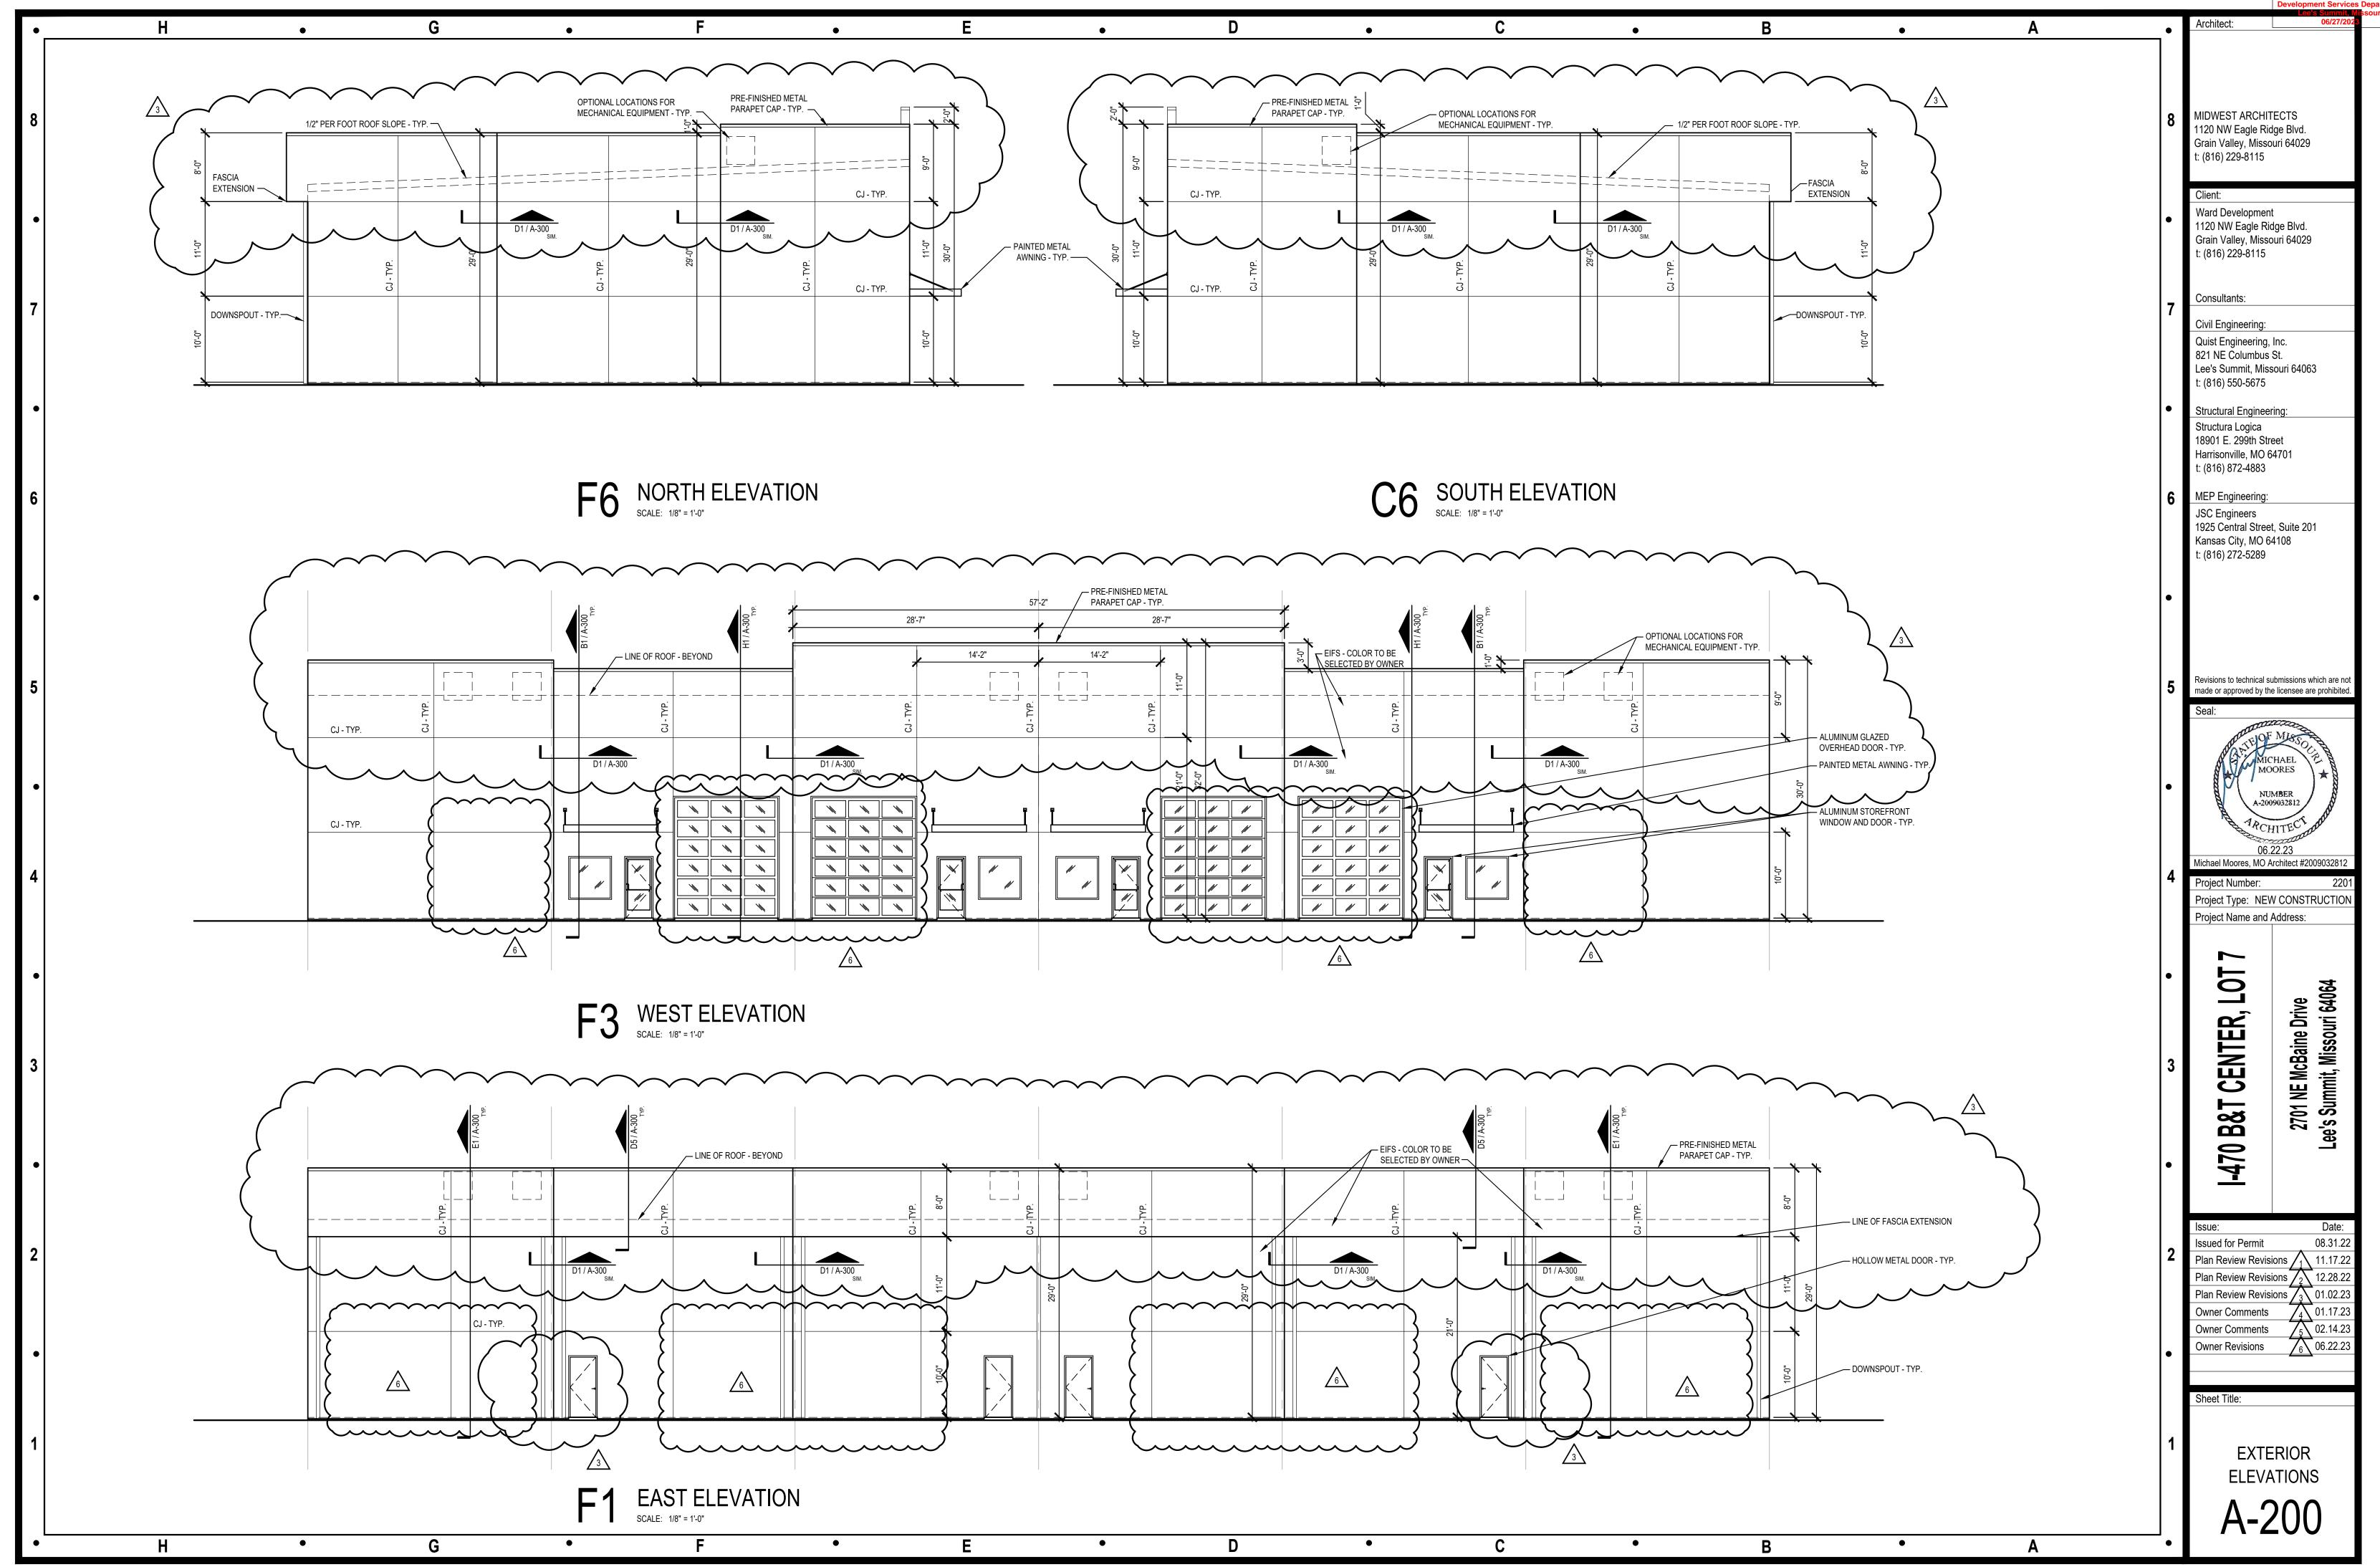

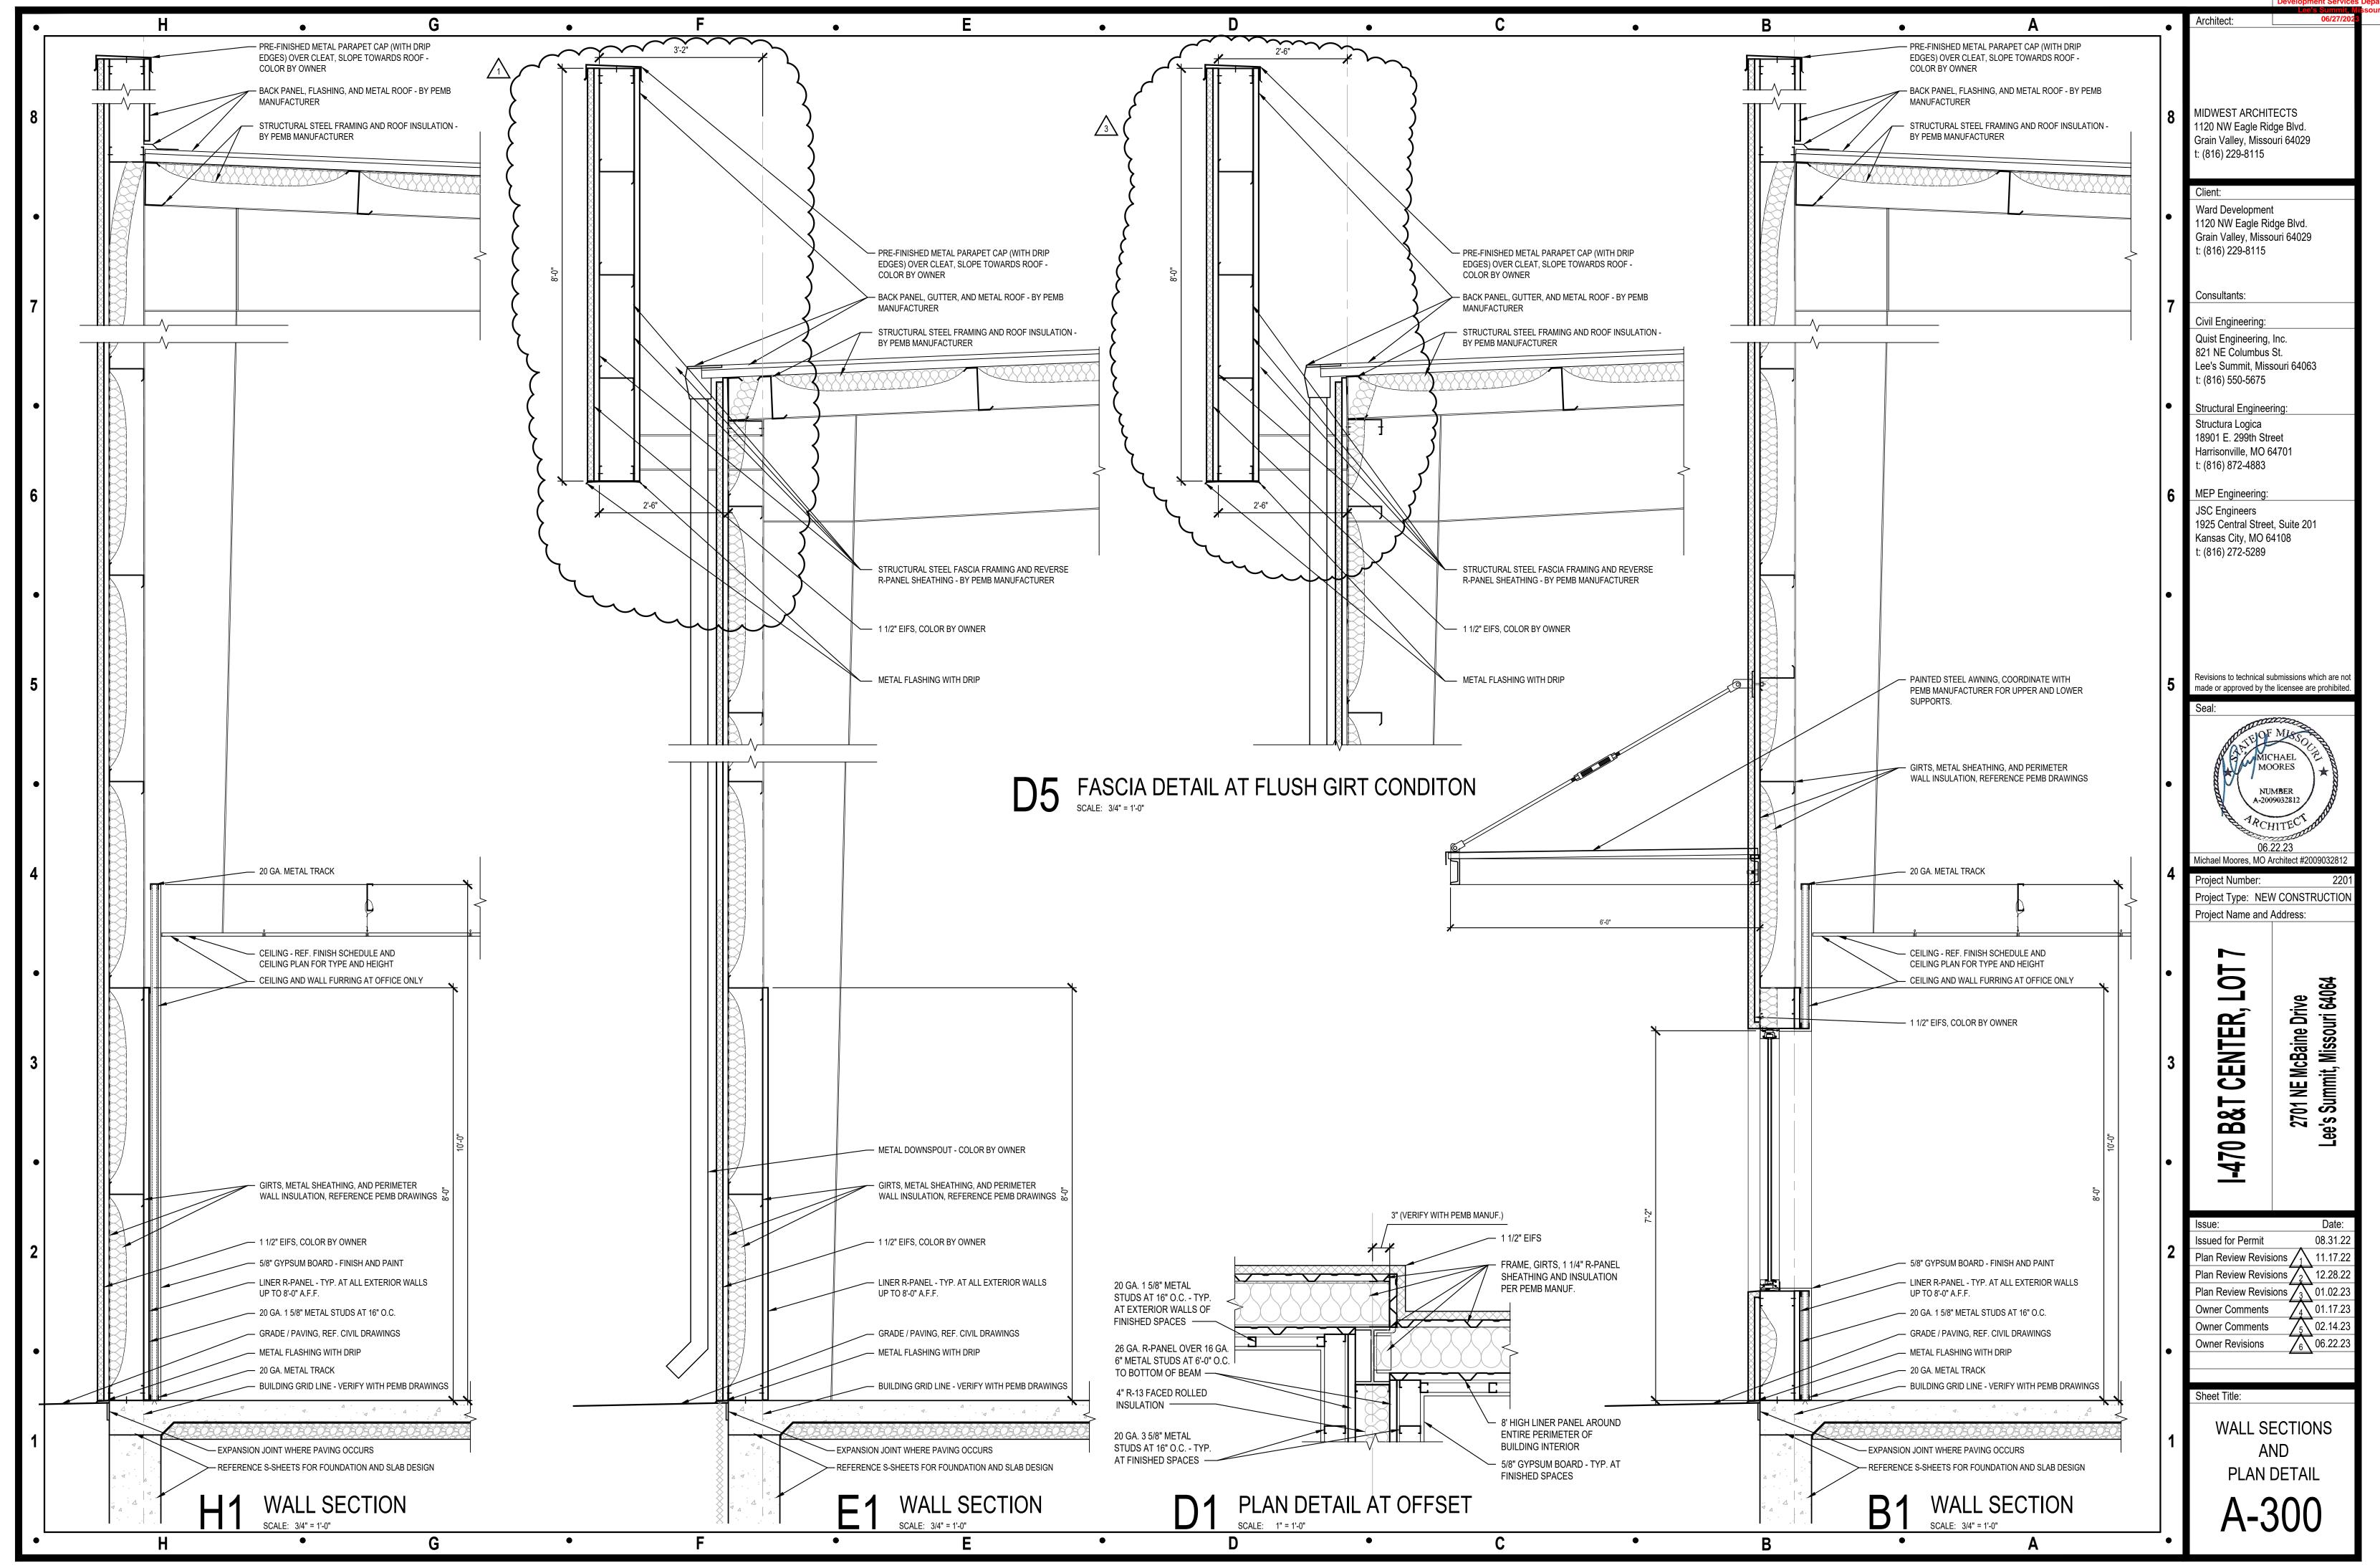


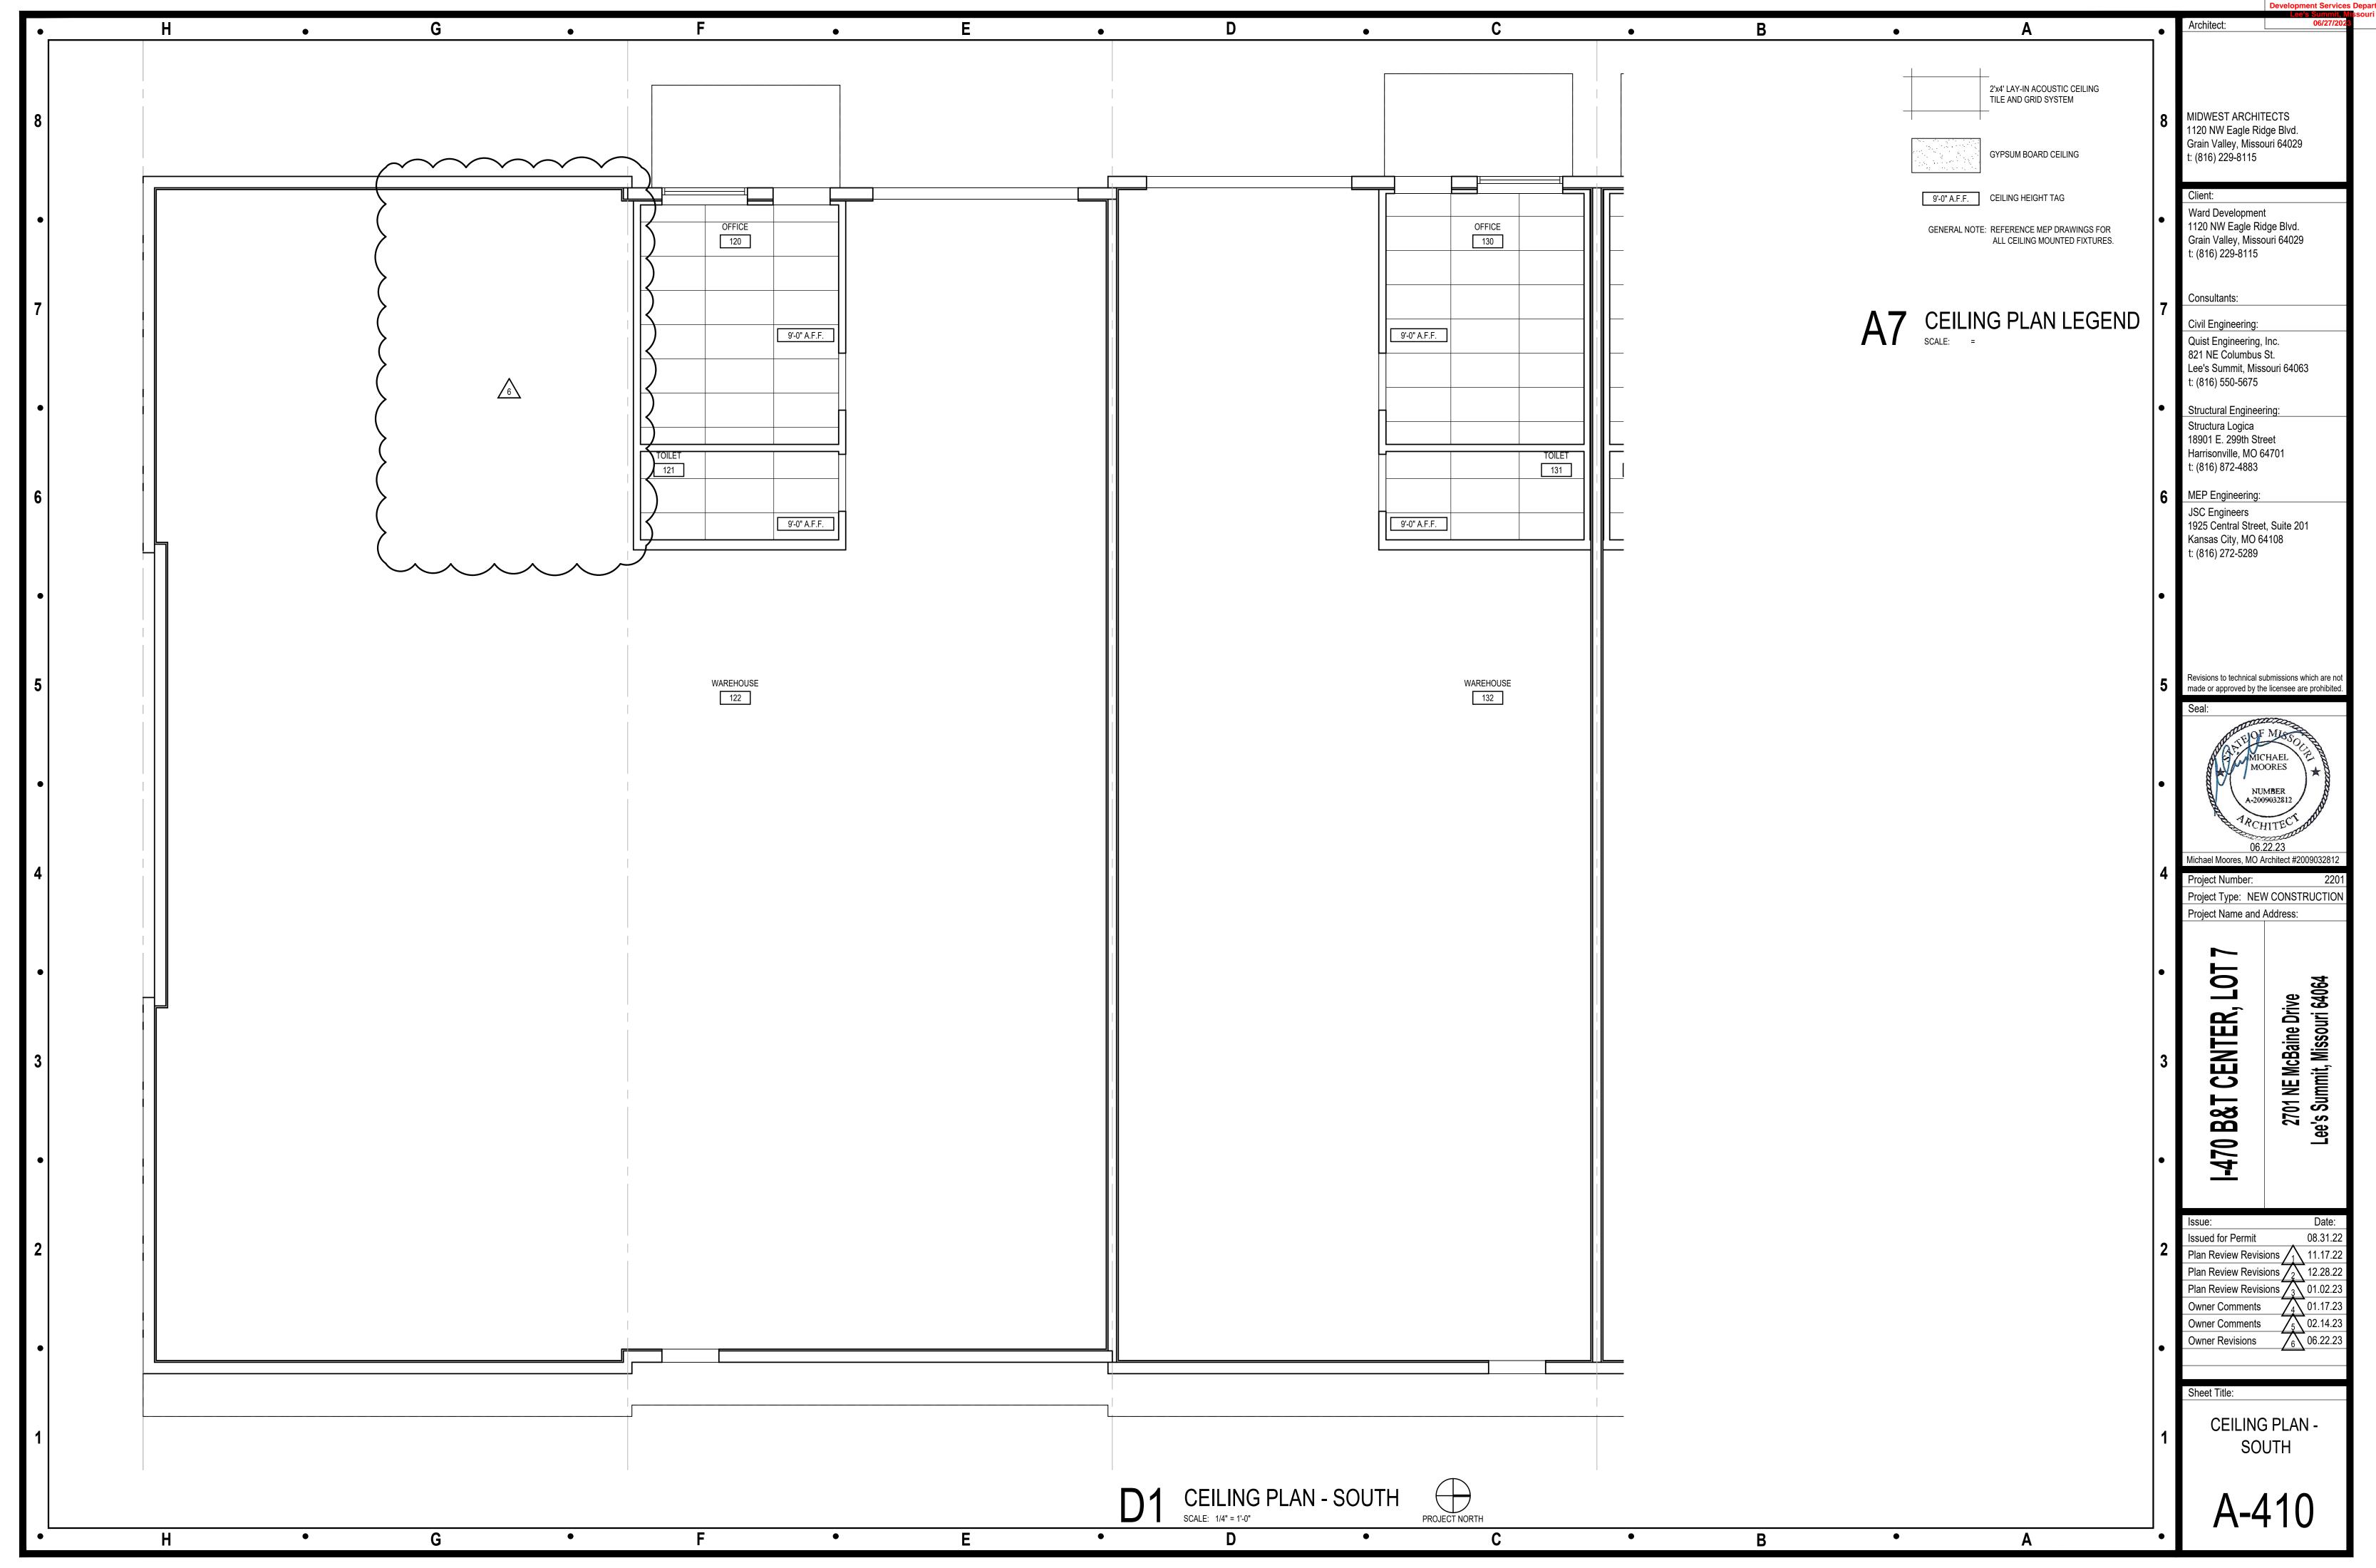


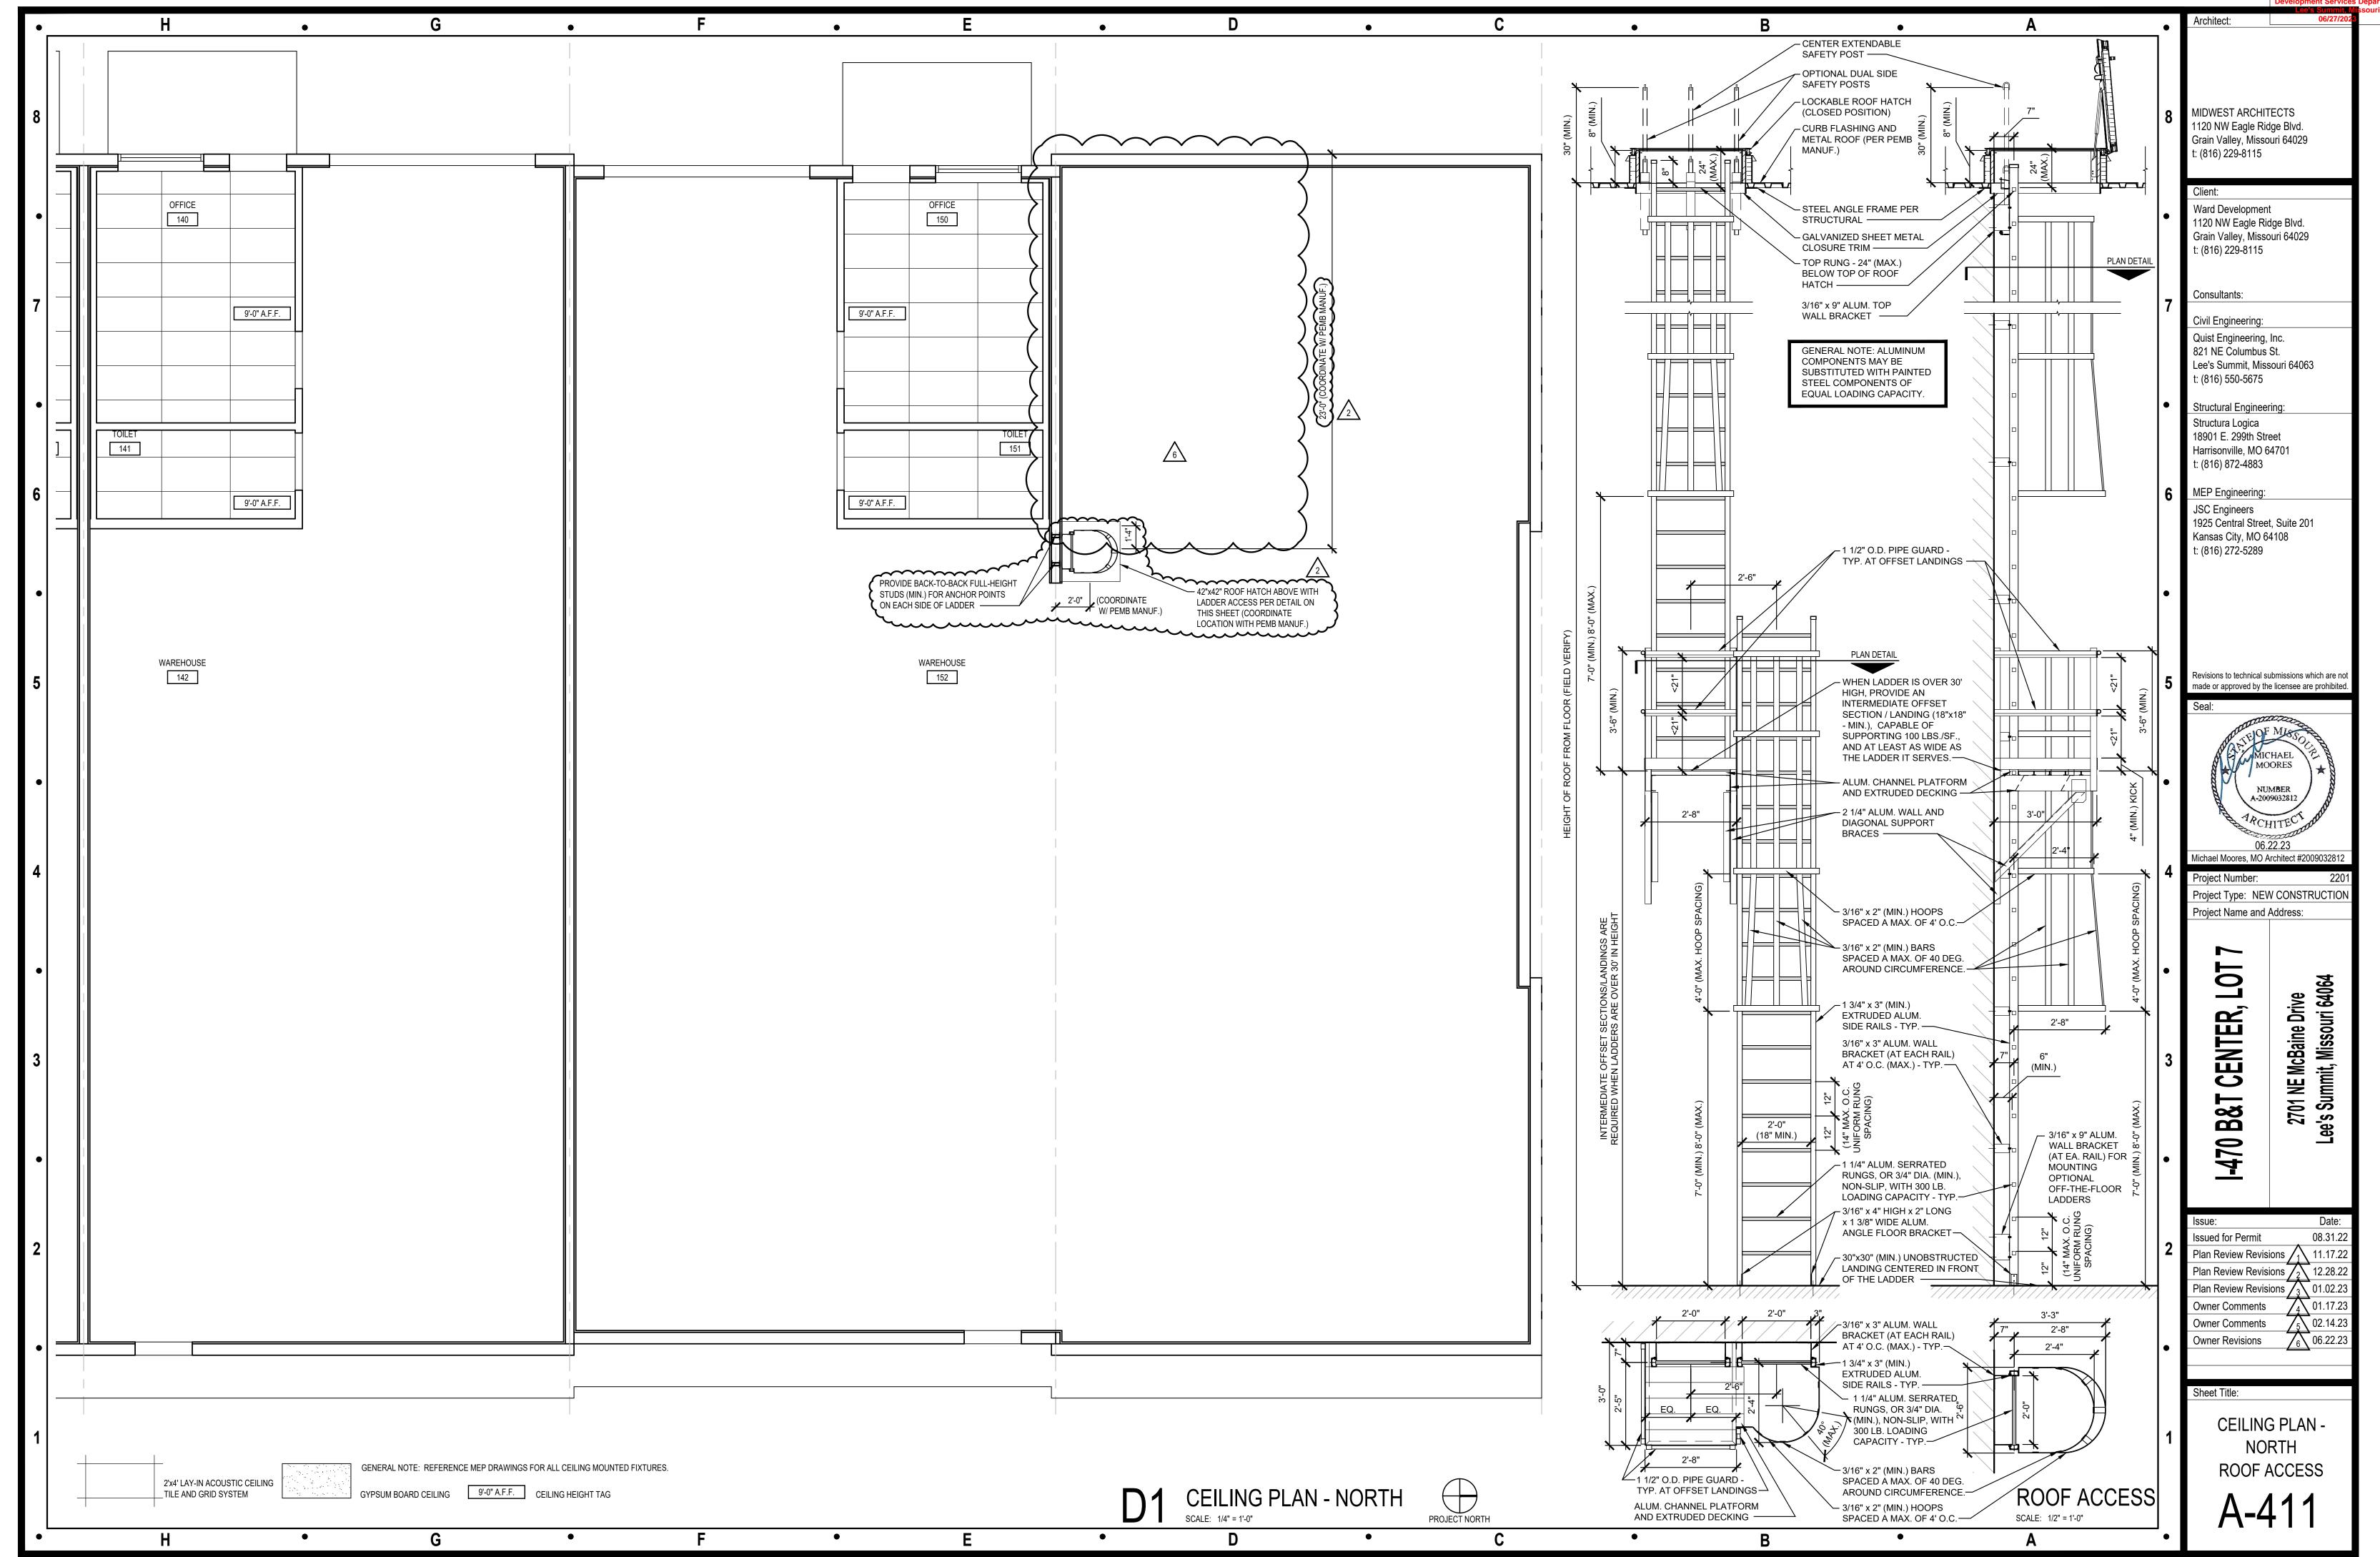


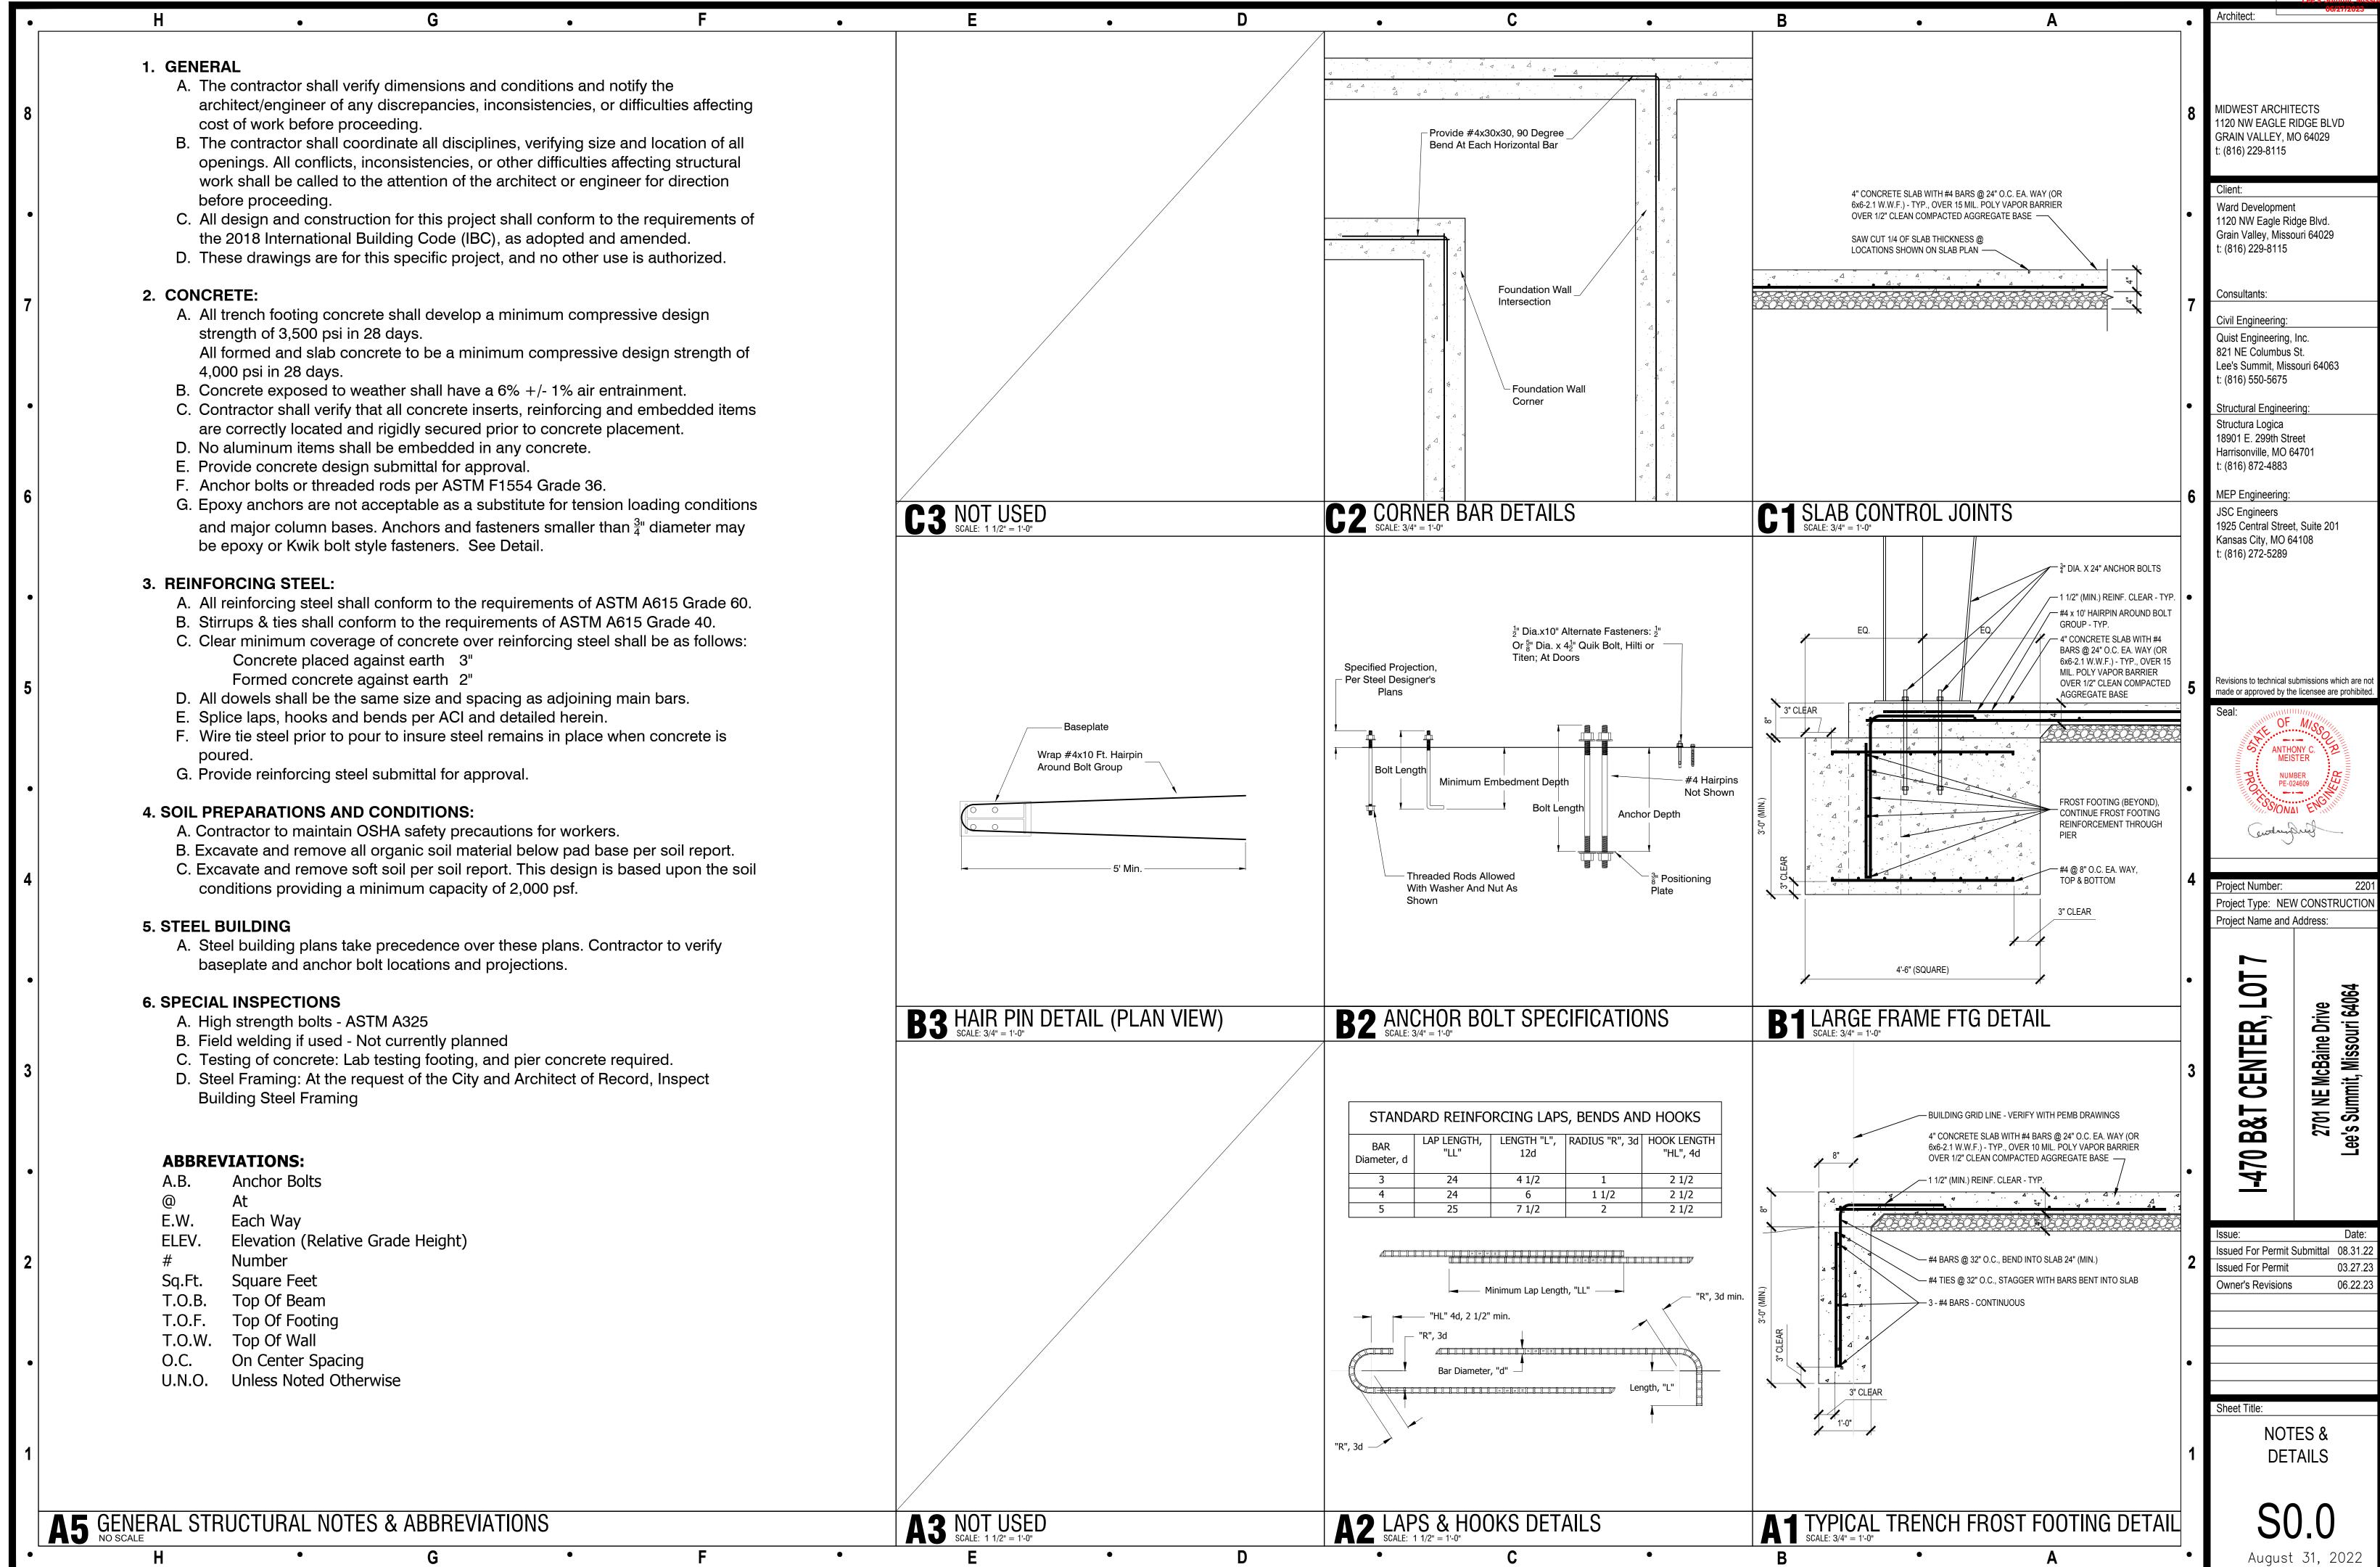


Architect: MECHANICAL AND PLUMBING SPECIFICATIONS M&P SYMBOLS THIS IS A MASTER LEGEND AND NOT ALL SYMBOLS, ETC, ARE RECOMMENDATIONS SUPPLY DIFFUSER OR REGISTER. PROVIDE ACCESS PANELS TO DAMPERS LOCATED ABOVE HARD <u>. GENERAL PROVISIONS</u> NECESSARILY USED ON THE DRAWINGS. MIDWEST ARCHITECTS G. ALL PIPE HANGERS AND SUPPORTS SHALL BE STANDARD PRODUCTS OF GRINNELL, FEE AND MASON. A. PROVIDE ALL LABOR, MATERIALS, AND EQUIPMENT NECESSARY FOR THE COMPLETE INSTALLATION OF 1120 NW EAGLE RIDGE BLVD HVAC EQUIPMENT & DUCTWORK OR ANVIL. HANGER SPACING SHALL BE IN ACCORDANCE WITH MSS-SP-69. I. PROVIDE AUXILIARY STEEL AS REQUIRED TO ADEQUATELY SUPPORT DUCTWORK. THE PLUMBING AND MECHANICAL SYSTEMS OUTLINED. GRAIN VALLEY. MO 64029 B. OBTAIN ALL PERMITS, FEES, LICENSES, INSPECTIONS, AND CERTIFICATIONS OF COMPLIANCE OR H. SLEEVES J. WHERE DUCTS PASS THROUGH FIRE-RATED FLOORS, WALLS, OR PARTITIONS, PROVIDE FIRESTOPPING APPROVAL AS REQUIRED BY AUTHORITIES. PROVIDE, SET, AND PROPERLY LOCATE PIPE SLEEVES AS REQUIRED FOR THIS WORK. ALL t: (816) 229-8115 BETWEEN DUCT AND WALL. K. WHERE DUCTS PASS THROUGH INTERIOR PARTITIONS OR EXTERIOR WALLS. AND ARE EXPOSED TO VIEW. SLEEVES SHALL BE OF SUFFICIENT SIZE TO PERMIT PIPE MOVEMENT DUE TO EXPANSION AND C. ALL WORK SHALL BE PERFORMED IN ACCORDANCE WITH ALL APPLICABLE LAWS, CODES AND SPIN-IN FITTING WITH MANUAL VOLUME DAMPER CONTRACTION AND TO ACCOMMODATE PIPE INSULATION. REGULATIONS OF THE GOVERNMENTAL BODIES HAVING JURISDICTION OVER THE SITE. CONCEAL SPACE BETWEEN OPENING AND DUCT OR DUCT INSULATION WITH SHEET METAL FLANGES OF D. ALL TESTING REQUIRED BY AUTHORITIES SHALL BE CONSIDERED PART OF THIS WORK. INTERIOR PARTITIONS: 16 GAUGE GALVANIZED STEEL, PACK BETWEEN PIPE AND SLEEVE WITH SAME GAUGE AS DUCT. OVERLAP OPENING ON 4 SIDES BY AT LEAST 1-1/2". FASTEN TO DUCT AND Client: E. DURING CONSTRUCTION, ALL FIXTURES, EQUIPMENT, PIPE, DUCT, ETC. SHALL BE COVERED, PLUGGED FIRE SAFING AND CAULK AT EACH END WITH FIRE RESISTANT SEALANT. BRANCH DUCT WITH 45° RECTANGLE-ROUND BRANCH ROOF: PROSET OR EQUAL, MANUFACTURED PVC SCHEDULE 40 PIPE SLEEVE WITH WATERPROOF OR CAPPED AS REQUIRED TO KEEP CLEAN AND UNDAMAGED. ALL DAMAGED ITEMS SHALL BE Ward Development FITTING AND MANUAL VOLUME DAMPER RESTORED TO ORIGINAL CONDITION OR REPLACED. ALL PROTECTIVE COVERING SHALL BE REMOVED SEAL. COORDINATE WITH ROOFING CONTRACTOR AND FLASH AS REQUIRED TO MAINTAIN ROOF 10. FLEXIBLE DUCT: 1120 NW Eagle Ridge Blvd. BEFORE FINAL ACCEPTANCE. ELBOW WITH TURNING VANES A. ATCO #086 (R-6), OR EQUAL. Grain Valley, Missouri 64029 F. PROVIDE ALL NECESSARY CUTTING AND PATCHING OF WALLS, FLOORS, CEILINGS, AND ROOFS AS PLUMBING VENTS: FLASH ROOF VENT INTO ROOFING SYSTEM AS REQUIRED BY THE ROOFING B. FACTORY APPLIED INSULATION AND VAPOR BARRIER, 1-1/2" THICK. t: (816) 229-8115 NECESSARY. PATCH AROUND ALL OPENINGS SHALL MATCH ADJACENT AREA. COORDINATE ALL ROOFING CONTRACTOR TO MAINTAIN THE EXISTING ROOF WARRANTY. ALL PLUMBING VENT TERMINALS C. MAXIMUM LENGTH OF 6'-0". WORK WITH OWNER OR RESPONSIBLE PARTY, SO THAT THE EXISTING ROOFING WARRANTY WILL BE SHALL TERMINATE A MINIMUM OF 12" ABOVE ROOF OR EQUAL TO HEIGHT OF PARAPET, RETURN, EXHAUST, OR OUTSIDE AIR DUCT UP WHICHEVER IS GREATER. G. CONTRACTOR SHALL GUARANTEE ALL WORK AND MATERIALS AGAINST DEFECT FOR A PERIOD OF ONE I. PROVIDE CHROME PLATED ESCUTCHEONS ON ALL PIPE ENTERING FINISHED AREAS. RETURN, EXHAUST, OR OUTSIDE AIR DUCT DOWN A. FLUE FOR GAS FIRED FURNACE SHALL BE AS RECOMMENDED BY THE GAS APPLIANCE MANUFACTURER YEAR FROM FINAL ACCEPTANCE. Consultants: FLUES SHALL BE SCHEDULE 40 PVC OR CPVC PER THE MANUFACTURE'S INSTALLATION REQUIREMENTS. H. INSPECTION OF THE SITE: THIS CONTRACTOR SHALL THOROUGHLY ACQUAINT HIMSELF WITH THE MEP SUPPLY AIR DUCT UP B. PROVIDE MANUFACTURERS STANDARD ACCESSORY ITEMS INCLUDING BIRD PROOF TOP, STORM COLLAR, DRAWINGS, SPECIFICATIONS, DETAIL, AND THE SITE. THIS CONTRACTOR SHALL NOTIFY THE ARCHITECT A. ALL INSULATIONS AND ACCESSORIES SHALL HAVE A FIRE HAZARD CLASSIFICATION WITH A FLAME Civil Engineering: ROOF THIMBLE, ETC. AS REQUIRED FOR A COMPLETE INSTALLATION. ROOF THIMBLES THROUGH THE OF ANY SPECIAL OR UNUSUAL PROBLEMS, CONFLICTS, OR OBSTRUCTIONS THAT AFFECT HIS BID. SPREAD RATING OF NOT OVER 25, A FUEL CONTRIBUTION RATING OF NOT OVER 50, AND A SMOKE SUPPLY AIR DUCT DOWN BUILDING ROOF SHALL BE SUITABLE FOR USE WITH THE ROOF PROVIDED. I. FOR THE PURPOSE OF CLEARNESS AND LEGIBILITY, THE MECHANICAL AND PLUMBING DRAWINGS ARE DEVELOPMENT RATING OF NOT OVER 50, IN ACCORDANCE WITH NFPA. Quist Engineering, Inc. C. FLUES FOR HEATERS SHALL BE DOUBLE WALL TYPE B EQUAL TO METALBESTOS. PROVIDE ESSENTIALLY DIAGRAMMATIC AND DO NOT SHOW ALL OFFSETS AND FITTINGS REQUIRED FOR B. PIPE INSULATION (ABOVE GRADE): EQUIPMENT WITH FLEXIBLE DUCT CONNECTION 821 NE Columbus St. MANUFACTURER'S STANDARD FITTING AND ACCESSORIES (ROOF THIMBLE, STORM COLLAR, COUNTER INSTALLATION. DO NOT SCALE DRAWINGS. THE SIZE AND LOCATION OF EQUIPMENT IS SHOWN TO 1. THE PIPE INSULATION USED SHALL HAVE A THERMAL CONDUCTIVITY OF 0.27 BTU PER Lee's Summit, Missouri 64063 SCALE WHEREVER POSSIBLE. THE CONTRACTOR SHALL VERIFY ALL CONDITIONS AND DATA AS FLASHING, ETC.) AS REQUIRED FOR A COMPLETE INSTALLATION. IN/HR\*SQ-FT\*F OR LESS. t: (816) 550-5675 INDICATED ON THE DRAWINGS AND IN THE SPECIFICATION SECTIONS WHERE MECHANICAL WORK FIBERGLASS INSULATION WITH FACTORY APPLIED VAPOR BARRIER, ASJ JACKET, FACTORY APPLIED INTERFACES WITH OTHER TRADES. MANUAL VOLUME DAMPER PRESSURE SEALING LONGITUDE LAP JOINT, NO STAPLES, ZESTON PREMOLDED PVC FITTING J. IN THE EVENT OF A CONFLICT OR INCONSISTENCY BETWEEN ITEMS INDICATED ON THE PLANS OR WITH A. CENTRIFUGAL CEILING EXHAUSTERS SHALL BE ELECTRICALLY POWERED CENTRIFUGAL TYPE FAN COVERS. INSTALLATION SHALL BE IN ACCORDANCE WITH MANUFACTURER'S RECOMMENDATIONS. Structural Engineering CODE REQUIREMENTS. THE NOTE OR CODE WHICH PRESCRIBES AND ESTABLISHES THE MORE COMPLETE SUITABLE FOR MOUNTING IN THE CEILING WITH A PERFORATED OFF-WHITE METAL GRILLE WITH A SQUARE TO ROUND TRANSITION FLEXIBLE CLOSED CELL ELASTOMERIC THERMAL INSULATION, UNSLIT OR PRESLIT WITH PRESSURE JOB OR HIGHER STANDARD SHALL PREVAIL. THUMBSCREW ATTACHMENT FOR EASY ACCESS TO FAN HOUSING. UNIT SHALL CONSIST OF A Structura Logica SENSITIVE ADHESIVE SYSTEM FOR CLOSURE AND VAPOR SEALING, EQUAL TO ARMSTRONG AP GALVANIZED STEEL HOUSING LINED WITH ACOUSTICAL INSULATION AND SHALL INCLUDE AN INTEGRAL K. INSTALL MATERIALS AND SYSTEMS IN ACCORDANCE WITH MANUFACTURER'S INSTRUCTIONS AND 18901 E 299th Street → DUCT TRANSITION ARMAFLEX OR ARMAFLEX 2000. BACKDRAFT DAMPER ON FAN DISCHARGE. MOTOR SHALL BE A PERMANENT SPLIT-CAPACITOR TYPE APPROVED SUBMITTALS. INSTALL MATERIALS IN PROPER RELATION WITH ADJACENT CONSTRUCTION AND 4. FOR NON CIRCULATING SYSTEMS THE FIRST 8 FEET OF INLET AND OUTLET PIPING BETWEEN THE Harrisonville, MO 64701 MOTOR, PERMANENTLY LUBRICATED WITH THERMAL OVERLOAD PROTECTION, PROVIDE DISCONNECT WITH UNIFORM APPEARANCE FOR EXPOSED WORK. COORDINATE WITH WORK OF OTHER SECTIONS. TANK AND HEAT TRAP (INCLUDING THE HEAT TRAP) MUST BE INSULATED. THERMOSTAT t: (816) 872-4883 COMPLY WITH APPLICABLE REGULATIONS AND CODE REQUIREMENTS. PROVIDE PROPER CLEARANCES FOR SWITCH OR OTHER MEANS OF DISCONNECT AT MOTOR IN FAN HOUSING. INSULATION SCHEDULE: a. DOMESTIC COLD WATER: 13. FURNACE AND CONDENSING UNIT: DUCT MOUNTED SMOKE DETECTOR L. INCLUDE ALL BASIC MATERIALS AND CONSTRUCTION METHODS INCLUDING PIPES, PIPE FITTINGS, AND MEP Engineering: DOMESTIC HOT WATER: A. CONDENSING FURNACES: SPECIALTIES AND SUPPORTING DEVICES, VALVES, PIPE AND VALVE IDENTIFICATION, PUMPS, VIBRATION GAS FIRED FURNACE SHALL BE FACTORY ASSEMBLED, PRE-WIRED UNIT CONSISTING OF ISOLATION, ETC. REFRIGERANT SUCTION: 1-1/2" FOR PIPING UP TO 1-1/2"ø, JSC Engineers - CEILING DIFFUSER W/FLEX SHEETMETAL CASING, SUPPLY FAN, GAS FIRED HEAT EXCHANGER, AND CONTROLS. CAPACITY M. FURNISH ADEQUATE ACCESS PANELS AND DOORS TO ALLOW FOR FUTURE PIPING ALTERATIONS, 2" FOR PIPING 1-1/2" AND LARGER. 1925 Central Street, Suite 201 DUCT (SEE SPECS) SHALL BE AS SCHEDULED. REPLACEMENT, AND MAINTENANCE OF PIPING. PROPERLY IDENTIFY ALL ACCESS PANELS AND DOORS. C. DUCTWORK INSULATION: Kansas City, MO 64108 2. THE PRIMARY HEAT EXCHANGER SHALL BE ALUMINIZED STEEL CONSTRUCTION WITH A STAINLESS DUCT COVERING: 3/4 LB/CF, FIBERGLASS BLANKET WITH FACTORY APPLIED VAPOR BARRIER AND - NECK SIZE RIGID BRANCH DUCT t: (816) 272-5289 STEEL SECONDARY HEAT EXCHANGER. 2. OPERATION AND MAINTENANCE MANUALS: FACING. THICKNESS AS SCHEDULED, INSTALLATION IN ACCORDANCE WITH MANUFACTURERS SAME SIZE AS (INCHES) THE FURNACE SHALL BE OF THE CONDENSING TYPE, UTILIZING A SEALED COMBUSTION CHAMBER. A. DURING THE COURSE OF CONSTRUCTION, COLLECT AND COMPILE OPERATING INSTRUCTIONS, WIRING RECOMMENDATIONS. DUCT COVERING SHALL BE MINIMUM R-6. DIFFUSER NECK. UNIT SHALL INCLUDE FINNED CAST IRON HEAT EXCHANGER, ALUMINIZED STEEL EXHAUST DIAGRAMS, CATALOG CUTS, LUBRICATION AND PREVENTIVE MAINTENANCE INSTRUCTIONS, PARTS LISTS, ─ AIRFLOW (CFM) a. SUPPLY AIR DUCT: DECOUPLER SECTION AND FINNED STAINLESS STEEL TUBE CONDENSER SECTION. ETC. FOR ALL EQUIPMENT FURNISHED UNDER THIS CONTRACT. MO COA NO. 2012006786 / KS COA NO. E-2818 b. RETURN AIR DUCT: B. ALL LITERATURE AND INSTRUCTIONS SHIPPED WITH THE EQUIPMENT SHALL BE SAVED FOR INCLUSION IN 4. THE UNIT SHALL BE EQUIPPED WITH THE MANUFACTURER'S STANDARD CONTROLS INCLUDING 24V 1925 CENTRAL STREET, SUITE 201 THE OPERATING AND MAINTENANCE MANUALS. CONTROL TRANSFORMER, AUTOMATIC SPARK IGNITION, AUTOMATIC GAS VALVE TRAIN, HIGH 8. TESTING, BALANCING AND CLEANING KANSAS CITY, MO 64108 TEMPERATURE LIMIT SWITCH, AND FAN TIMED DELAY RELAY. A. ALL PIPING SHALL BE TESTED FOR LEAKS BEFORE BEING CONCEALED IN WALL CONSTRUCTION OR EXHAUST FAN 3. MANUFACTURERS: RETURN AIR INLET ON UNIT SHALL BE PROVIDED WITH 1" THROWAWAY TYPE FILTER AND SLIDE IN phone: (816) 272-5289 COVERED WITH INSULATION. A. MANUFACTURERS, MODEL NUMBERS, ETC. INDICATED OR SCHEDULED ON THE DRAWINGS SHALL BE FRAME, MOUNTED ON THE UNIT. B. SEWER AND VENT PIPING SHALL BE HYDROSTATICALLY TESTED WITH NO LESS THAN 10 FEET OF HEAD email: jsmothers@jscengineers.com INTERPRETED AS HAVING ESTABLISHED A STANDARD OF QUALITY AND SHALL NOT BE CONSTRUED AS 6. FAN SHALL BE A DIRECT DRIVE MULTI-SPEED BLOWER, RESILIENTLY MOUNTED IN THE CASING. FOR A PERIOD OF NOT LESS THAN 15 MINUTES. PER THE LOCAL PLUMBING CODE, WITH NO LEAKS. - FXHAUST GRILLE LIMITING COMPETITION. ARTICLES, FIXTURES, ETC. OF EQUAL QUALITY BY MANUFACTURERS SHALL BE MOTOR SHALL BE PROVIDED WITH AUTOMATIC THERMAL OVERLOAD PROTECTION. C. DOMESTIC WATER PIPING SHALL BE HYDROSTATICALLY TESTED AT A PRESSURE OF NOT LESS THAN ACCEPTABLE, SUBJECT TO STRUCTURAL AND ELECTRICAL CONSTRAINTS OF THE PROJECT DESIGN. FURNACE SHALL BE AGA APPROVED. 1-1/2 TIMES THE OPERATING PRESSURE, BUT NOT LESS THAN 60 PSI, FOR A PERIOD OF NOT LESS Revisions to technical submissions which are no B. THE ELECTRICAL SYSTEM DESIGN IS BASED IN PART ON THE SPECIFIED EQUIPMENT. IT IS THE HVAC EQUIPMENT & DUCTWORK B. CONDENSING UNIT SHALL BE FACTORY ASSEMBLED AND TESTED AIR-COOLED CONDENSING UNIT made or approved by the licensee are prohibited THAN 2 HOURS, WITH NO LEAKS. RESPONSIBILITY OF THE CONTRACTOR TO COORDINATE THE ELECTRICAL REQUIREMENTS OF THE CONSISTING OF COMPRESSOR, CONDENSER COIL, FAN, MOTOR, REFRIGERANT RESERVOIR, OPERATING D. BEFORE DOMESTIC WATER PIPING IS PLACED IN SERVICE. ALL DOMESTIC WATER DISTRIBUTION SYSTEMS EQUIPMENT BEING FURNISHED. ANY CHANGES TO THE ELECTRICAL SYSTEM DUE TO HVAC EQUIPMENT CONTROLS, ETC. CAPACITY AND ELECTRICAL CHARACTERISTICS SHALL BE AS SCHEDULED. <u>SYMBOL</u> <u>DESCRIPTION</u> INCLUDING THOSE FOR COLD WATER AND HOT WATER SYSTEMS, SHALL BE FLUSHED, STERILIZED AND OTHER THAN THE SPECIFIED EQUIPMENT BEING FURNISHED SHALL BE PROVIDED AT NO ADDITIONAL COMPRESSOR: HERMETICALLY SEALED WITH BUILT—IN OVERLOADS AND VIBRATION ISOLATION. CHLORINATED IN ACCORDANCE WITH THE HEALTH DEPARTMENT REGULATIONS. THE SYSTEMS SHALL BE COST TO THE OWNER. COMPRESSOR MOTOR SHALL HAVE THERMAL AND CURRENT SENSITIVE OVERLOAD DEVICES, SANITARY SEWER (ABOVE GRADE) THOROUGHLY FLUSHED OF ALL DIRT AND FOREIGN MATTER, THEN FILLED WITH WATER TREATED WITH INTERNAL HIGH PRESSURE PROTECTION, HIGH AND LOW PRESSURE CUTOUT SWITCHES, START 50 PPM OF CHLORINE. DURING THE FILLING PROCESS, VALVES AND FAUCETS SHALL BE OPENED CAPACITOR AND RELAY, 2-POLE CONTACTOR, CRANKCASE HEATER, AND TEMPERATURE SANITARY SEWER (BELOW GRADE) SEVERAL TIMES TO ASSURE TREATMENT OF THE ENTIRE SYSTEM. THE TREATED WATER SHALL BE LEFT ———SS——— A. PROVIDE THERMAL OVERLOAD PROTECTION FOR EACH MOTOR PROVIDED BY THIS WORK. ACTUATED SWITCH AND TIMER TO PREVENT COMPRESSOR RAPID CYCLE. IN THE SYSTEM FOR 24 HOURS AFTER WHICH TIME THE SYSTEM SHALL BE FLUSHED; IF THE RESIDUAL JUSTIN R. COIL SHALL BE COPPER TUBING WITH ALUMINUM FINS: COMPLETE WITH LIQUID ACCUMULATOR CHLORINE IS NOT LESS THAN 10 PPM. THE FLUSHING SHALL BE REPEATED. AFTER STERILIZATION SMOTHERS CONDENSATE DRAIN AND LIQUID SUBCOOLER. UNIT SHALL INCLUDE FILTER DRYER, SIGHT GLASS, COMPRESSOR SAMPLES OF WATER FROM THE SYSTEM SHALL BE APPROVED BY THE BOARD OF HEALTH. A. PROVIDE AN APPROVED WATER HAMMER ARRESTOR FOR EACH PLUMBING FIXTURE SUPPLY AS SERVICE VALVE, LIQUID LINE SERVICE VALVE, AND REFRIGERANT PIPING EXTENDED TO EXTERIOR E. NATURAL GAS SYSTEMS SHALL BE TESTED WITH COMPRESSED AIR AT A PRESSURE OF NOT LESS THAN REQUIRED BY FIXTURE MANUFACTURER. -----VENT PIPING OF CASING. PE-2012003568 1-1/2 TIMES THE OPERATING PRESSURE, BUT NOT LESS THAN 50 PSIG FOR A PERIOD OF 2 HOURS B. ALL EXPOSED PIPE IN FINISHED AREAS SHALL BE CHROME PLATED BRASS PIPE, NO FERROUS PIPE. PROVIDE CLEANOUTS AT EACH CHANGE IN DIRECTION AND AT 100 FOOT INTERVALS IN STRAIGHT RUNS. WITH NO LEAKS 14. ELECTRIC WALL HEATERS G = GAS PIPING LESS THAN 2 PSISTONAL ET F. THE INSPECTION AUTHORITY HAVING JURISDICTION SHALL BE NOTIFIED AT LEAST 24 HOURS PRIOR TO D. PROVIDE ACCESS PANELS FOR ALL CONCEALED VALVES AND TRAPS. A. UNIT SHALL INCLUDE ELECTRIC HEATING ELEMENTS WITH SAFETY AND DISCONNECT DEVICES AS PERFORMANCE OF ALL TESTS SO THAT THEY TESTS MAY BE WITNESSED IF DEEMED NECESSARY. E. CLEANOUTS MPG = GAS PIPING 2 PSIREQUIRED BY NEC, INCLUDING RELAYS, CONTROLLERS AND REQUIRED EQUIPMENT TO FORM A G. DUCTWORK AND PIPING SHALL BE BALANCED BY QUALIFIED BALANCING PERSONNEL WHO HAVE UNFINISHED FLOOR (FCO): JR SMITH #4240, OR EQUAL COMPLETE AND FUNCTIONAL HEATER. PREVIOUS EXPERIENCE WITH BALANCING PROCEDURES AND ARE FAMILIAR WITH TESTING AND WALL (WCO): JR SMITH #4472, OR EQUAL, 24" ABOVE THE FLOOR. B. ELEMENTS SHALL BE HEAVY DUTY ALUMINUM-FINNED, COPPER CLAD STEEL SHEATH. PROVIDE COLD WATER PIPING BALANCING PROCEDURES OF THE ASSOCIATED AIR BALANCE COUNCIL (AABC) OR NATIONAL GRADE (GCO): JR SMITH #4256, OR EQUAL, WITH HEAVY DUTY CAST IRON BODY AND COVER. AUTOMATIC RESET THERMAL OVER-HEAT PROTECTION. THERMAL PROTECTOR SHALL BE LINEAR TYPE Project Number 22-215 ENVIRONMENTAL BALANCING BUREAU (NEBB). F. ALL SEWER PIPING LOCATED INSIDE THE BUILDING SHALL BE INSTALLED WITH THE FOLLOWING SLOPES. TO SENSE TEMPERATURES THE ENTIRE LENGTH OF HEATING ELEMENT. ——HW—— — — HOT WATER PIPING Project Type: NEW CONSTRUCTION BALANCING SHALL INCLUDE THE BALANCING OF THE EQUIPMENT AND AIR DISTRIBUTION SYSTEMS INSTALL 2-1/2" AND SMALLER PIPE AT 1/4" PER FOOT FALL. C. FANS SHALL BE DIRECT DRIVE USING PERMANENT SPLIT CAPACITOR TYPE MOTORS WITH BUILT-IN TO PROVIDE DESIGN QUANTITIES INDICATED AND VERIFICATION PERFORMANCE OF ALL EQUIPMENT AUTOMATIC RESET MOTOR OVERLOAD PROTECTION. Project Name and Address: INSTALL 3" AND LARGER PIPE AT 1/8" PER FOOT FALL. AND AUTOMATIC CONTROLS. PIPE ELBOW DOWN CONDENSATE DRAIN SHALL BE INSTALLED AT 1/8" PER FOOT FALL. WITH IN 30 DAYS OF THE COMPLETION OF THE TESTING AND BALANCING WORK, SUBMIT THE G. PROVIDE DIELECTRIC UNIONS WITH APPROPRIATE END CONNECTION TO MATCH THE PIPE SYSTEM IN TEST AND BALANCING REPORT BEARING THE SIGNATURE OF THE TEST AND BALANCE ENGINEER. PIPE ELBOW UP WHICH INSTALLED (SCREWED, SOLDERED, OR FLANGED). PROVIDE DIELECTRIC UNIONS ON ALL PIPING THE REPORTS SHALL BE CERTIFIED PROOF THAT THE SYSTEMS HAVE BEEN TESTED, ADJUSTED, CONNECTIONS TO HOT WATER HEATERS AND EXPANSION JOINTS. AND BALANCED IN ACCORDANCE WITH THE REFERENCED STANDARDS; ARE AN ACCURATE GATE VALVE  $\longrightarrow$ H. ALL SEWER PIPING LOCATED EXTERIOR TO THE BUILDING SHALL BE INSTALLED WITH THE FOLLOWING REPRESENTATION OF HOW THE SYSTEMS HAVE BEEN INSTALLED AND ARE OPERATING. REPORTS cBaine Drive , Missouri 64064 SHALL BE BOUND IN A VINYL BINDER AND THE BINDER LABELLED OR MAY BE AN ELECTRONIC INSTALL 4" AND SMALLER PIPE AT A MINIMUM OF 2% SLOPE. BACKFLOW PREVENTER PDF SUBMITTAL. INSTALL 6" AND LARGER PIPE AT A MINIMUM OF 1% SLOPE. ENTER, BALL VALVE A. ALL DUCTWORK UNLESS OTHERWISE INDICATED SHALL BE FABRICATED FROM GALVANIZED SHEET STEEL COMPLYING WITH ASTM A 527, LOCKFORMING QUALITY, WITH G60 ZINC COATING IN ACCORDANCE WITH A. DOMESTIC COLD, HOT, AND HOT WATER RECIRCULATING (ABOVEGROUND). PLUG VALVE ASTM A 525, AND MILL PHOSPHATIZED FOR EXPOSED LOCATIONS. TYPE L HARD DRAWN COPPER TUBING, ASTM B-88 WITH WROUGHT BRONZE SOLDERED FITTINGS. B. DUCTWORK METAL GAUGES, REINFORCING, ETC SHALL BE CONSTRUCTED IN ACCORDANCE WITH SMACNA GATE VALVE: CRANE #428 OR EQUAL. FLOOR CLEANOUT (FCO) "HVAC DUCT CONSTRUCTION STANDARDS," LATEST EDITION FOR A 2" WATER GAUGE STATIC PRESSURE. BALL VALVE: CRANE #932 OR EQUAL <u>5</u> C. ALL FITTINGS SHALL BE CONSTRUCTED IN ACCORDANCE WITH SMACNA "HVAC DUCT CONSTRUCTION B. DOMESTIC COLD, HOT, AND HOT WATER RECIRCULATING, 1"-3" (UNDERGROUND). 岁 1. TYPE K HARD OR SOFT DRAWN COPPER TUBING, ASTM B-88 WITH WROUGHT BRONZE SOLDERING STANDARDS," LATEST EDITION. WALL CLEANOUT (WCO) 2701 ee's Su D. RECTANGULAR DUCT: ELBOWS, UNLESS INDICATED OTHERWISE, SHALL BE CONSTRUCTED WITH CENTERLINE RADIUS OF C. SANITARY SEWER AND VENTS (UNDERGROUND, INTERIOR TO BUILDING). FLOOR DRAIN NOT LESS THAN 1.5 DUCT WIDTH OR SQUARE ELBOWS WITH DOUBLE WALL STREAMLINE ELBOWS. POLYVINYL CHLORIDE (PVC) DWV PIPE, SCHEDULE 40, SOLVENT JOINT. TAKE-OFF FITTINGS: BRANCH DUCT TAKE-OFF FITTINGS FOR SUPPLY AND EXHAUST SEWER LINES SHALL BE LOCATED IN GENERAL AS SHOWN ON THE DRAWINGS. THE EXACT 2 DIFFUSER/REGISTERS SHALL INCLUDE AN INTEGRAL MANUAL VOLUME DAMPER WITH LOCKING HOSE BIB LOCATIONS SHALL BE DETERMINED BY THE CONTRACTOR IN SUCH A MANNER AS TO MAINTAIN QUADRANT, DAMPER NOT REQUIRED ON RETURN AIR. FOR RECTANGULAR TO ROUND TAKE-OFFS, PROPER CLEARANCES AND SUFFICIENT SLOPE TO ENSURE DRAINAGE. UTILIZE A "BUCKLEY" MODEL 3300 & 3300D OR EQUAL. VENT STACKS SHALL BE EXTENDED FULL SIZE THROUGH THE ROOF AND FLASHED WITH 4 POUND ABBREVIATIONS RETURN AIR ACOUSTIC ELBOWS AND SOUND BOOTS SHALL BE A SQUARE ELBOW WITH NO LEAD SHEETS TURNED DOWN INTO THE STACK AT LEAST 2" AND EXTENDED 12" IN ALL AFF ABOVE FINISHED FLOOR MECHANICAL CONTRACTOR TURNING VANES. DIRECTIONS FROM THE PIPE AT THE ROOF LINE. VENTS THROUGH ROOF SHALL NOT BE LESS BAS BUIDLING AUTOMATION SYSTEM MIN MINIMUM 4. SLOPES FOR TRANSITIONS OR OTHER CHANGES IN DIMENSIONS SHALL BE A MINIMUM 1 TO 3. THAN 3". PVC PIPING SHALL NOT BE USED FOR VENT PIPING THROUGH THE ROOF. WHERE BACKDRAFT NOISE CRITERIA l BD E. ROUND AND OVAL SPIRAL SEAM DUCT: APPLICABLE FOR ROOFING SYSTEM USED, PROVIDE FLASHING VIA PLEATED EPDM CONE IN LIEU CFM CUBIC FEET PER MINUTE OUTSIDE AIR 1. PROVIDE RADIUS TYPE FITTINGS FABRICATED OF MULTIPLE SECTIONS WITH MAXIMUM 15 DEGREE OF LEAD. ALL VENT STACKS IN OR AT OUTSIDE WALLS SHALL BE OFFSET 1'-6" MINIMUM FROM RETURN AIR DDC DIRECT DIGITAL CONTROL CHANGE OF DIRECTION PER SECTION. UNLESS SPECIFICALLY DETAILED OTHERWISE, USE 45 09.30.22 Plan Review OUTSIDE WALLS BEFORE GOING THROUGH THE ROOF, TO FACILITATE FLASHING. DIRECT EXPANSION DEGREE LATERALS FOR BRANCH TAKEOFF CONNECTIONS. WHERE 90 DEGREE BRANCHES ARE SUPPLY AIR D. CONDENSATE DRAIN AND INDIRECT WASTE (ABOVEGROUND) **\** 11.17.22 Plan Review Revisions INDICATED PROVIDE CONICAL TYPE TEES. SMOKE DUCT DETECTOR FXHAUST AIR 1. PVC DWV PIPE, SCHEDULE 40, SOLVENT JOINT. SLOPES FOR TRANSITIONS OR OTHER CHANGES IN DIMENSIONS SHALL BE MINIMUM 1 TO 3. EXISTING TO FLOOR ABOVE **\ 01.02.2**3 Plan Review Revisions E. NATURAL GAS PIPING: TO FLOOR BELOW FROM FLOOR BELOW ROUND LONGITUDINAL SEAM DUCT: USE FOR RIGID METAL DUCT ON LEAVING SIDE OF DUCT IN 1. SCHEDULE 40 BLACK STEEL PIPING: 2" AND SMALLER WITH SCREWED JOINTS AND 150 LB. CONCEALED LOCATIONS FOR EXTENSION TO FLEX FOR DIFFUSERS. GPM GALLONS PER MINUTE TYPICAL Owner Comments MALLEABLE IRON SCREWED FITTINGS. PIPE 2-1/2" AND LARGER SHALL USE STANDARD WEIGHT F. SEAL ALL CONCEALED DUCTWORK JOINTS WITH NON-HARDENING, NON-MIGRATING MASTIC SEALANT, AS IN WC INCHES OF WATER COLUMN UNDER GROUND Owner Comments 02.14.23 BLACK STEEL WELDING FITTINGS WITH WELDED JOINTS. RECOMMENDED FOR SEALING SEAMS AND JOINTS IN DUCTWORK. OIL BASED CAULKING AND GLAZING MAX MAXIMUM WCO WALL CLEANOUT GAS VALVES SHALL BE ROCKWELL 142/143, PLUG VALVE COMPOUNDS SHALL NOT BE ACCEPTABLE. DUCTS SHALL BE SEALED TO THE CLASS LEVEL LISTED MBH 1000 BTU PER HOUR Owner Revisions √ 06.22.2 W/O WITHOUT SUPPORT PIPING AT INTERVALS NOT TO EXCEED THOSE LISTED IN TABLE 415.1 OF THE I.F.G.C. ANNOTATION PROVIDE A.G.A. APPROVED SHUT OFF VALVES AND DIRT LEGS AT CONNECTIONS TO ALL (1) UNCONDITIONED SPACES: CLASS B CLASS C CLASS B (2) CONDITIONED SPACES (PLENUM): CLASS C CLASS B CLASS C 5. EPOXY PAINT ALL EXTERIOR GAS PIPING TO PREVENT CORROSION. SUPPLY 2"WC OR LESS <u>EXHAUST</u> ( # ) PLAN WORK NOTE <u>RETURN</u> F. REFRIGERANT ASTM B 280, TYPE ACR, HARD DRAWN STRAIGHT LENGTHS, AND SOFT-ANNEALED COILS, G. DUCT SIZES SHOWN ON THE DRAWINGS ARE SHEET METAL SIZES. INCREASE SHEET METAL SIZES Sheet Title: MECHANICAL EQUIPMENT DESIGNATION (CONTRACTOR FURNISHED SEAMLESS COPPER TUBING. ACCORDINGLY TO ACCOUNT FOR THICKNESS OF DUCT LINER. AND INSTALLED UNLESS NOTED OTHERWISE) WROUGHT COPPER, ANSI B16.22, STREAMLINED PATTERN, FITTINGS. BRAZED JOINTS, AWS A 5.8 H. WHETHER SHOWN ON PLANS OR NOT, PROVIDE MANUAL VOLUME DAMPERS IN EACH RUNOUT TO EACH CLASSIFICATION BAG-1 (SILVER). MECHANICAL AND TUBING TO BE FACTORY CLEANED, READY FOR INSTALLATION, AND HAVE ENDS CAPPED TO PLUMBING FIXTURE DESIGNATION PROTECT CLEANLINESS OF PIPE INTERIORS PRIOR TO SHIPPING. PLUMBING 4. SIZE AND INSTALLATION OF PIPING SHALL BE IN ACCORDANCE WITH THE MANUFACTURER'S SPECIFICATIONS AND CONNECTION POINT OF NEW WORK TO EXISTING SYMBOLS A DETAIL REFERENCE UPPER NUMBER INDICATED DETAIL NUMBER 

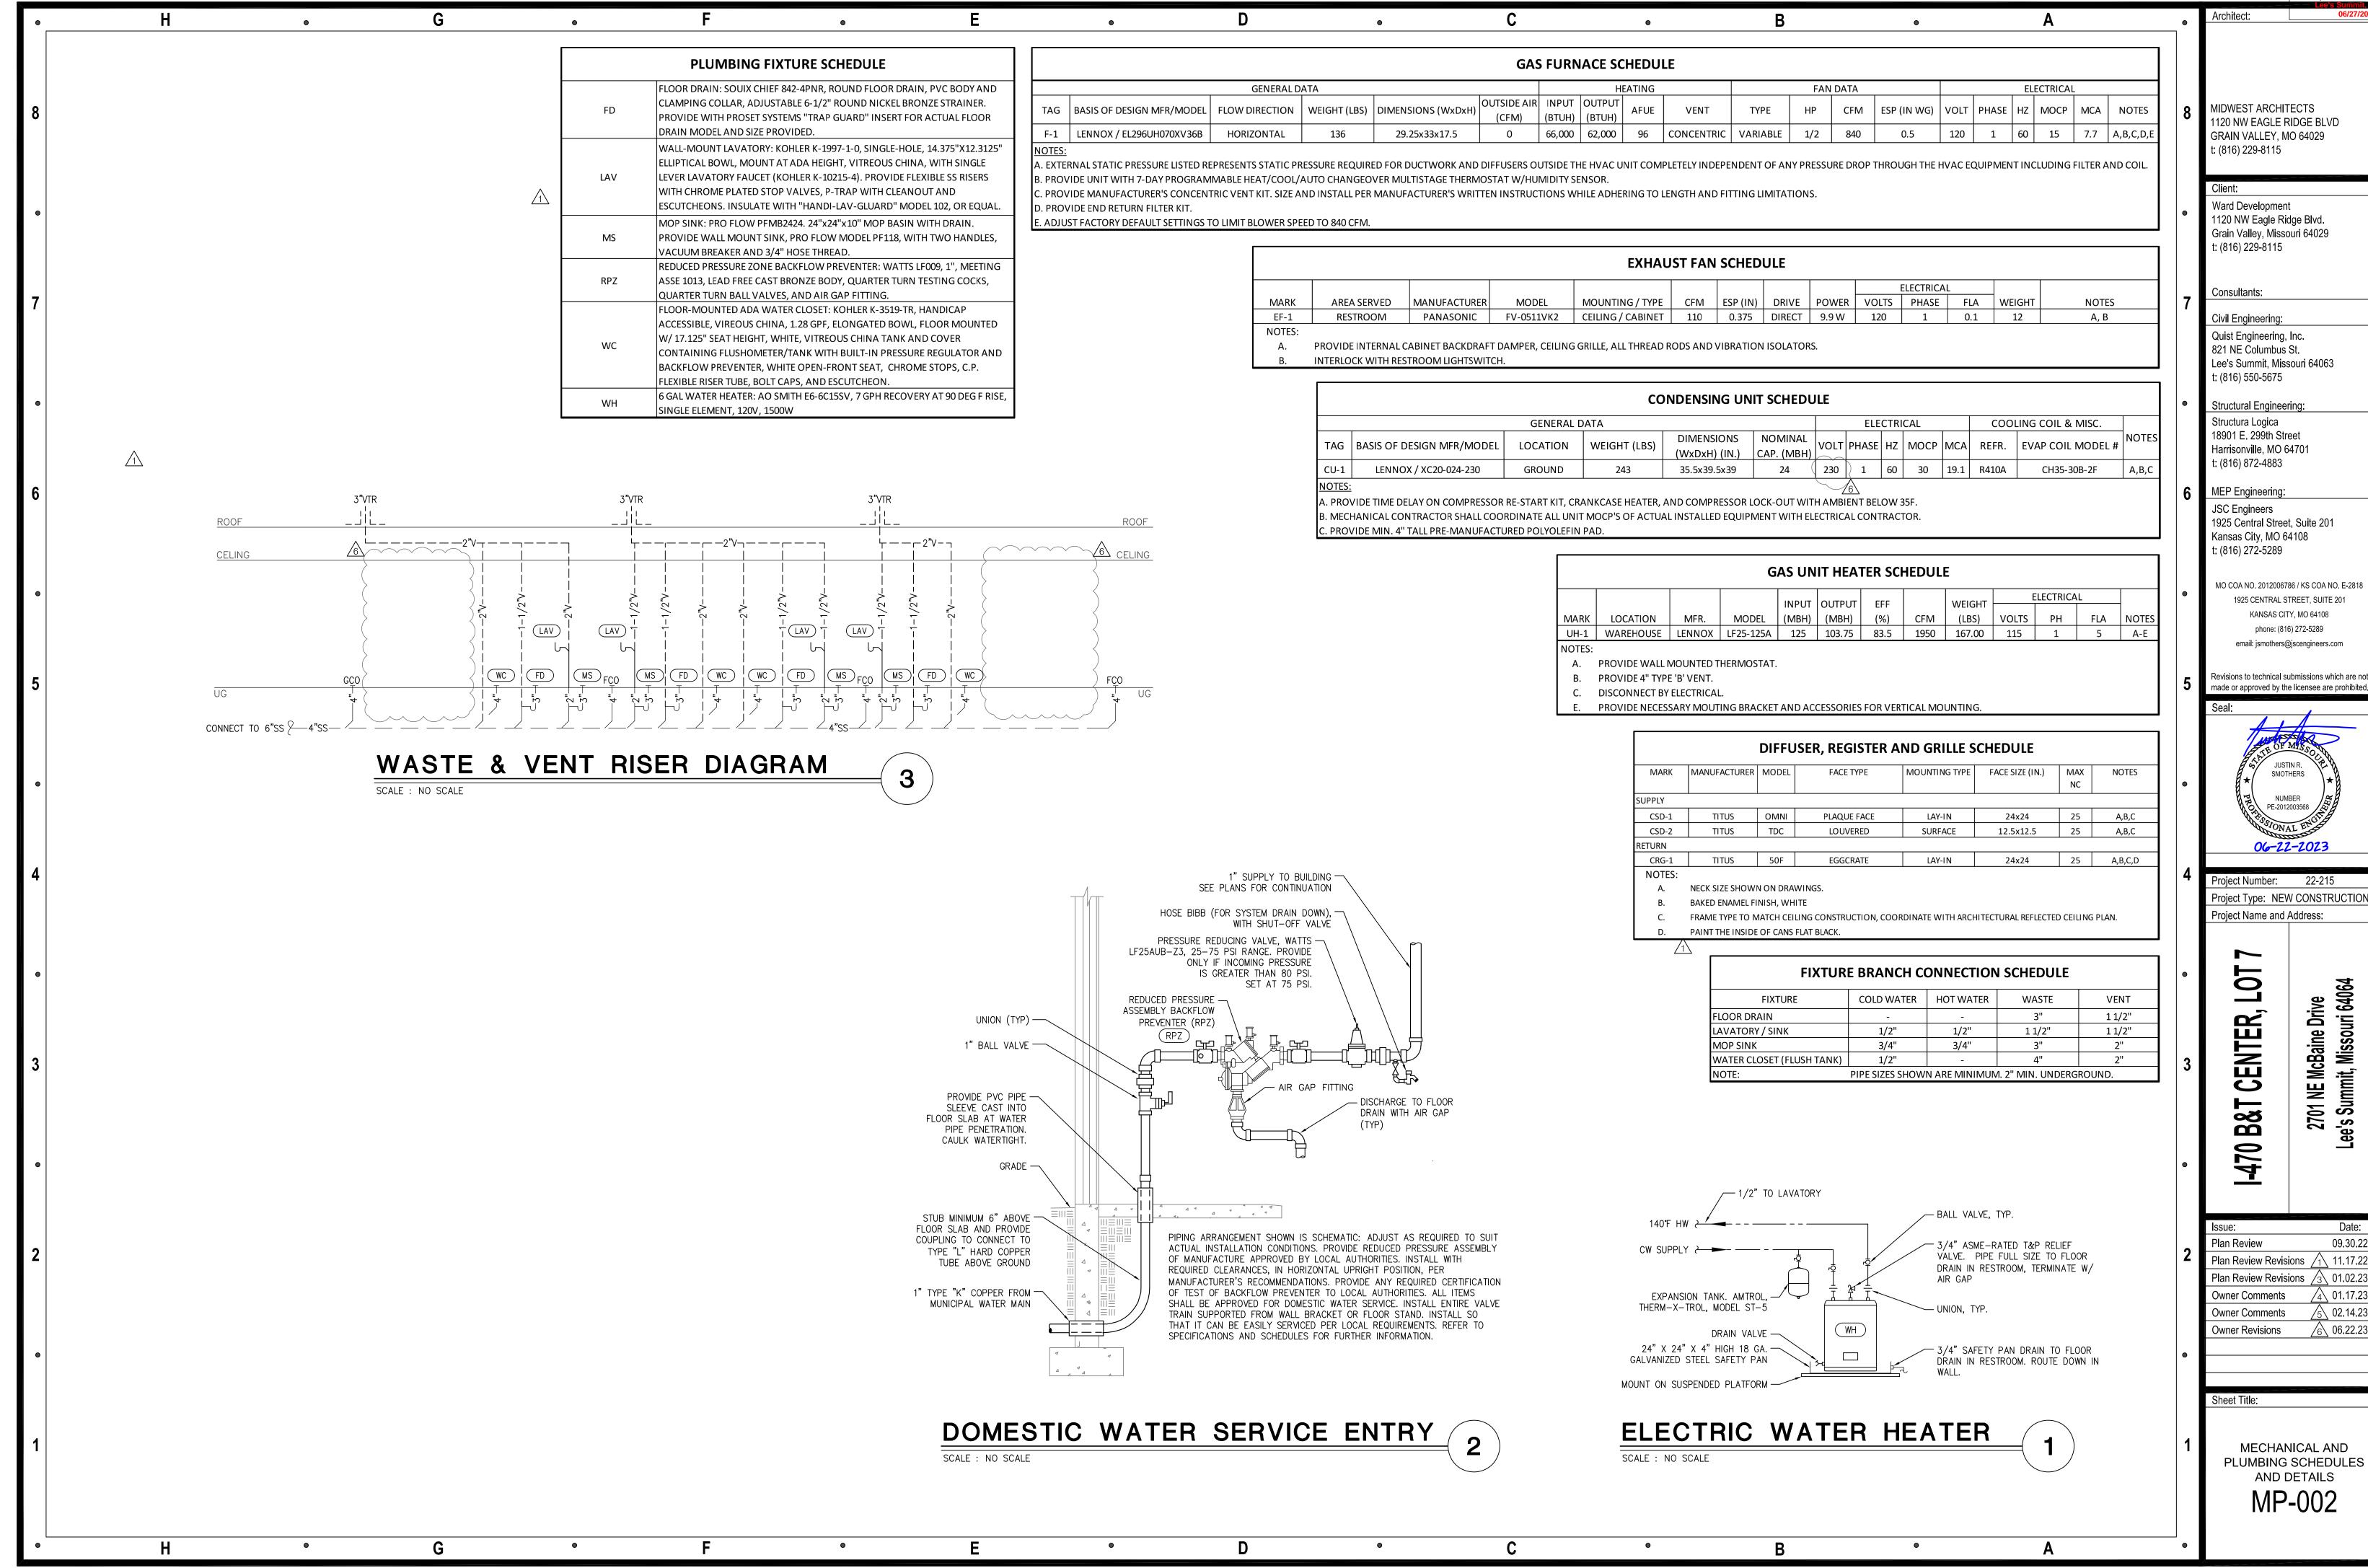


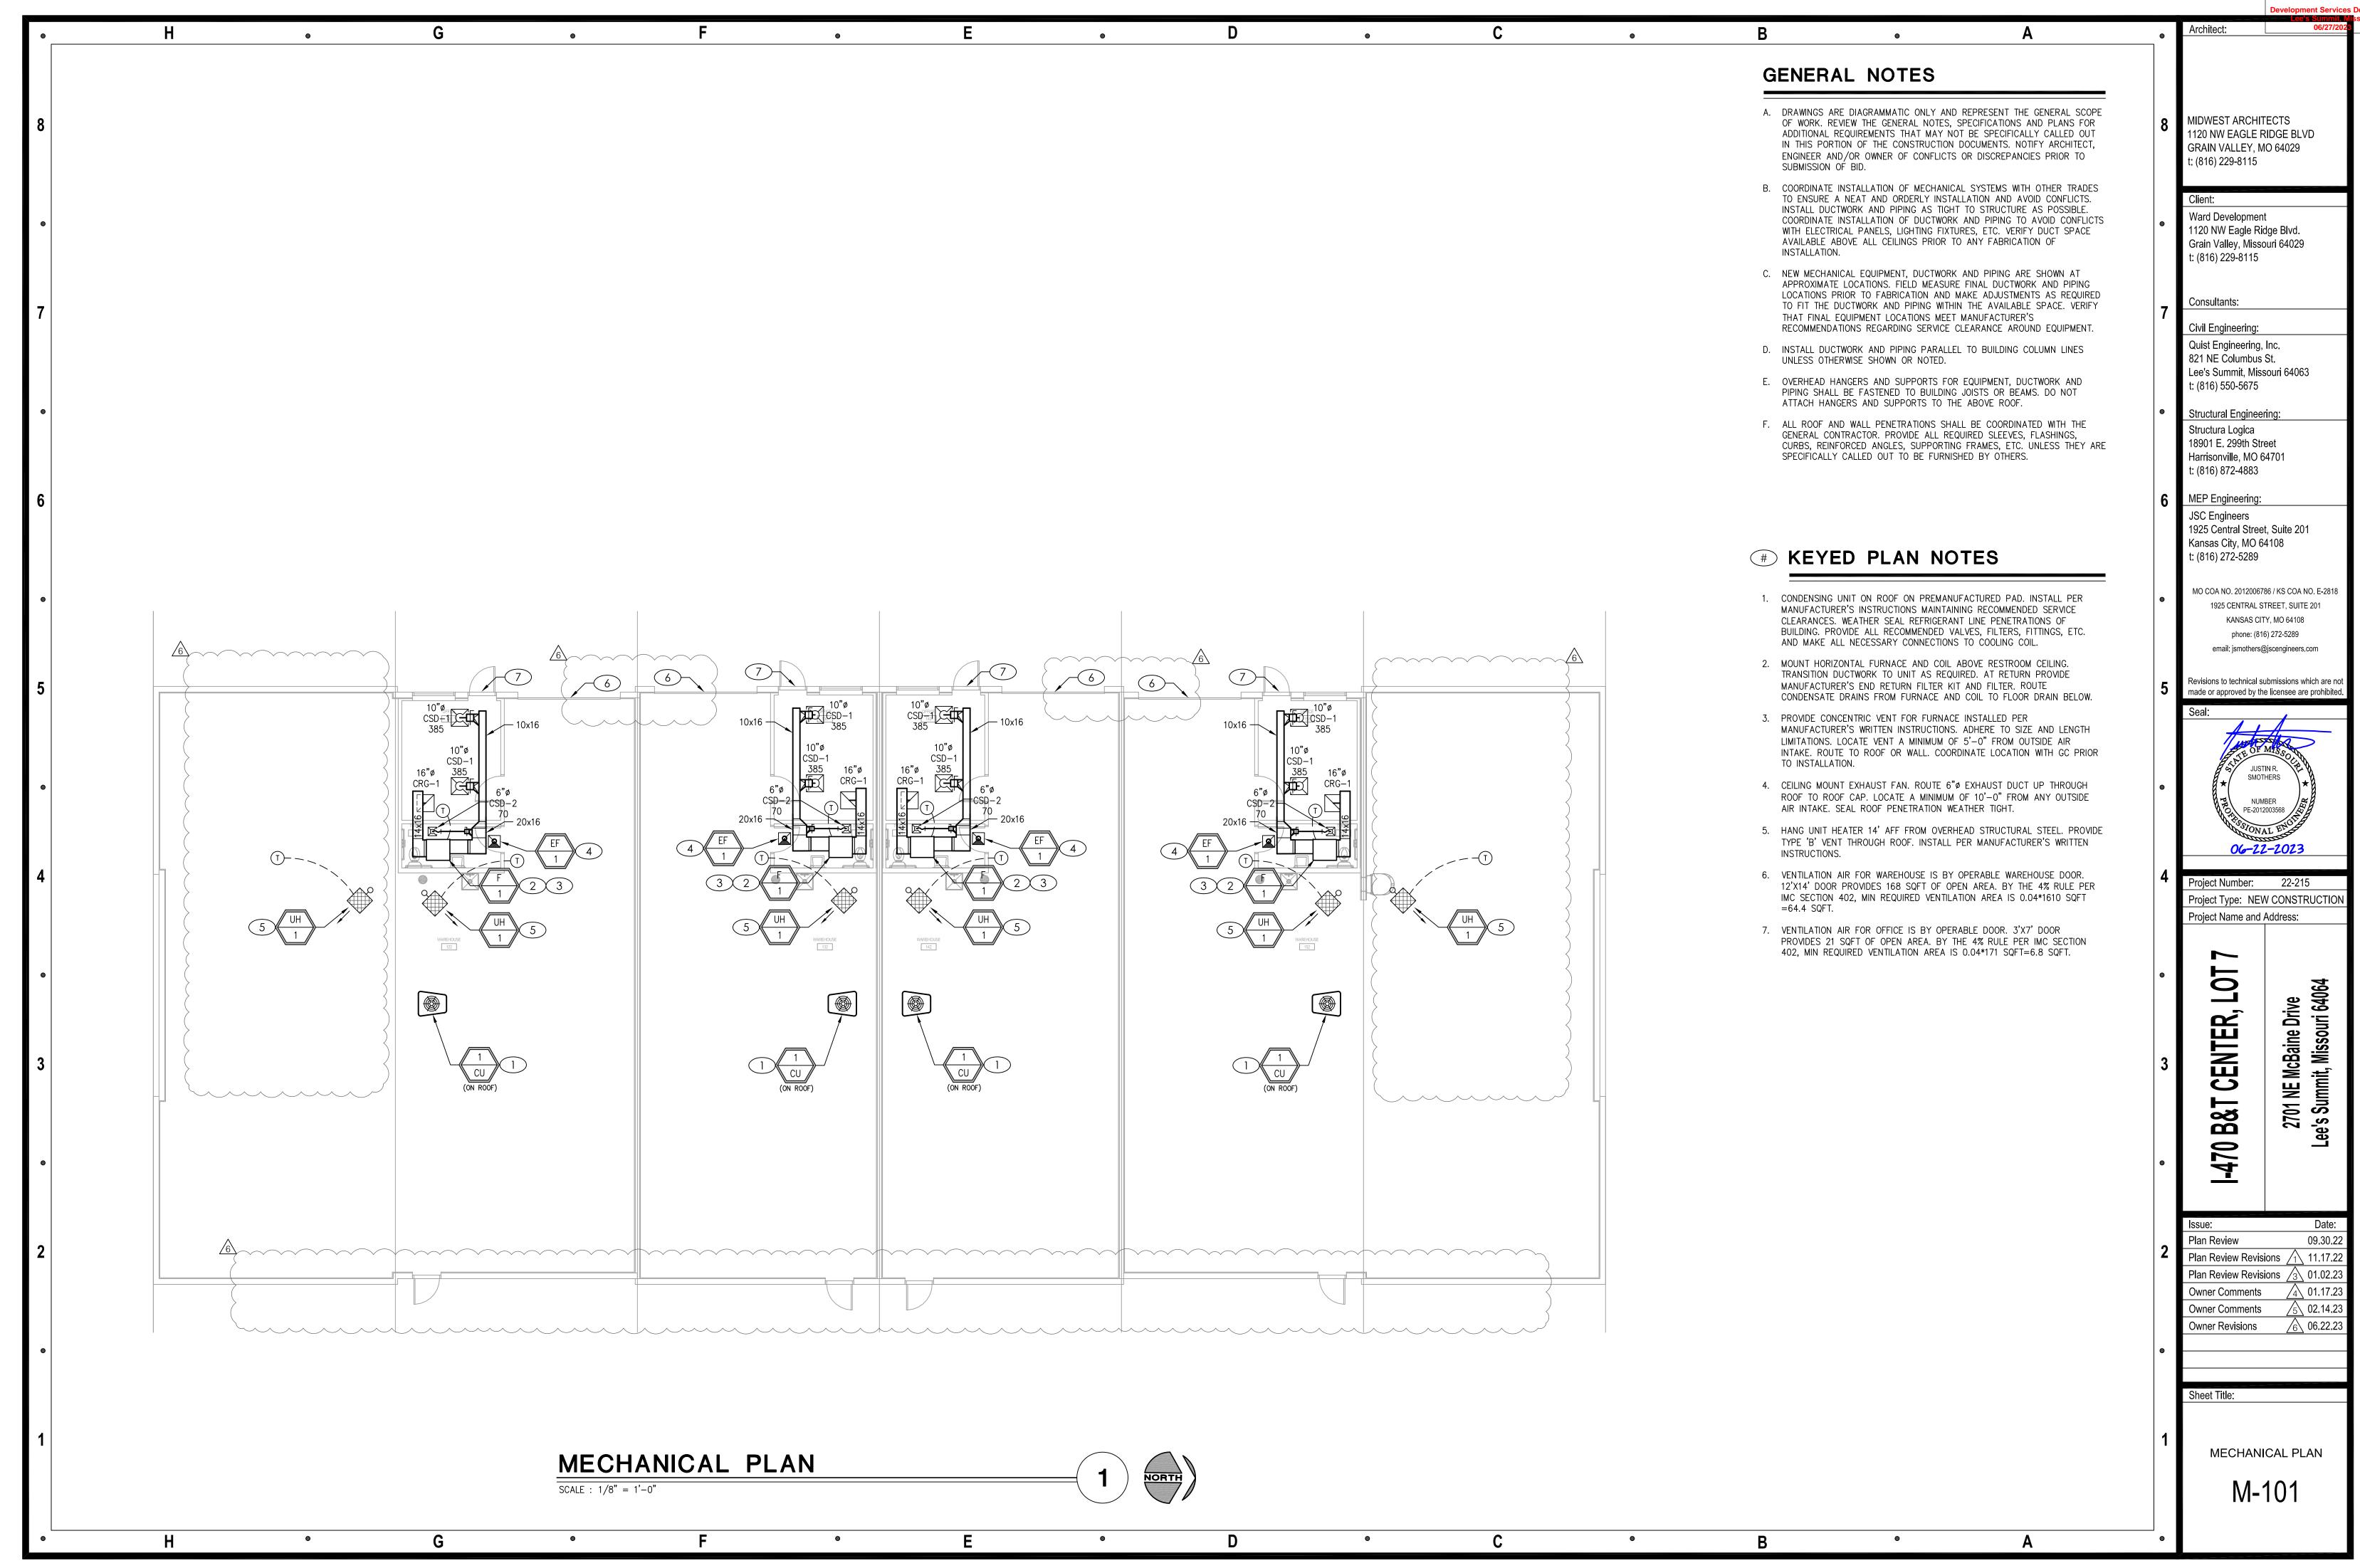


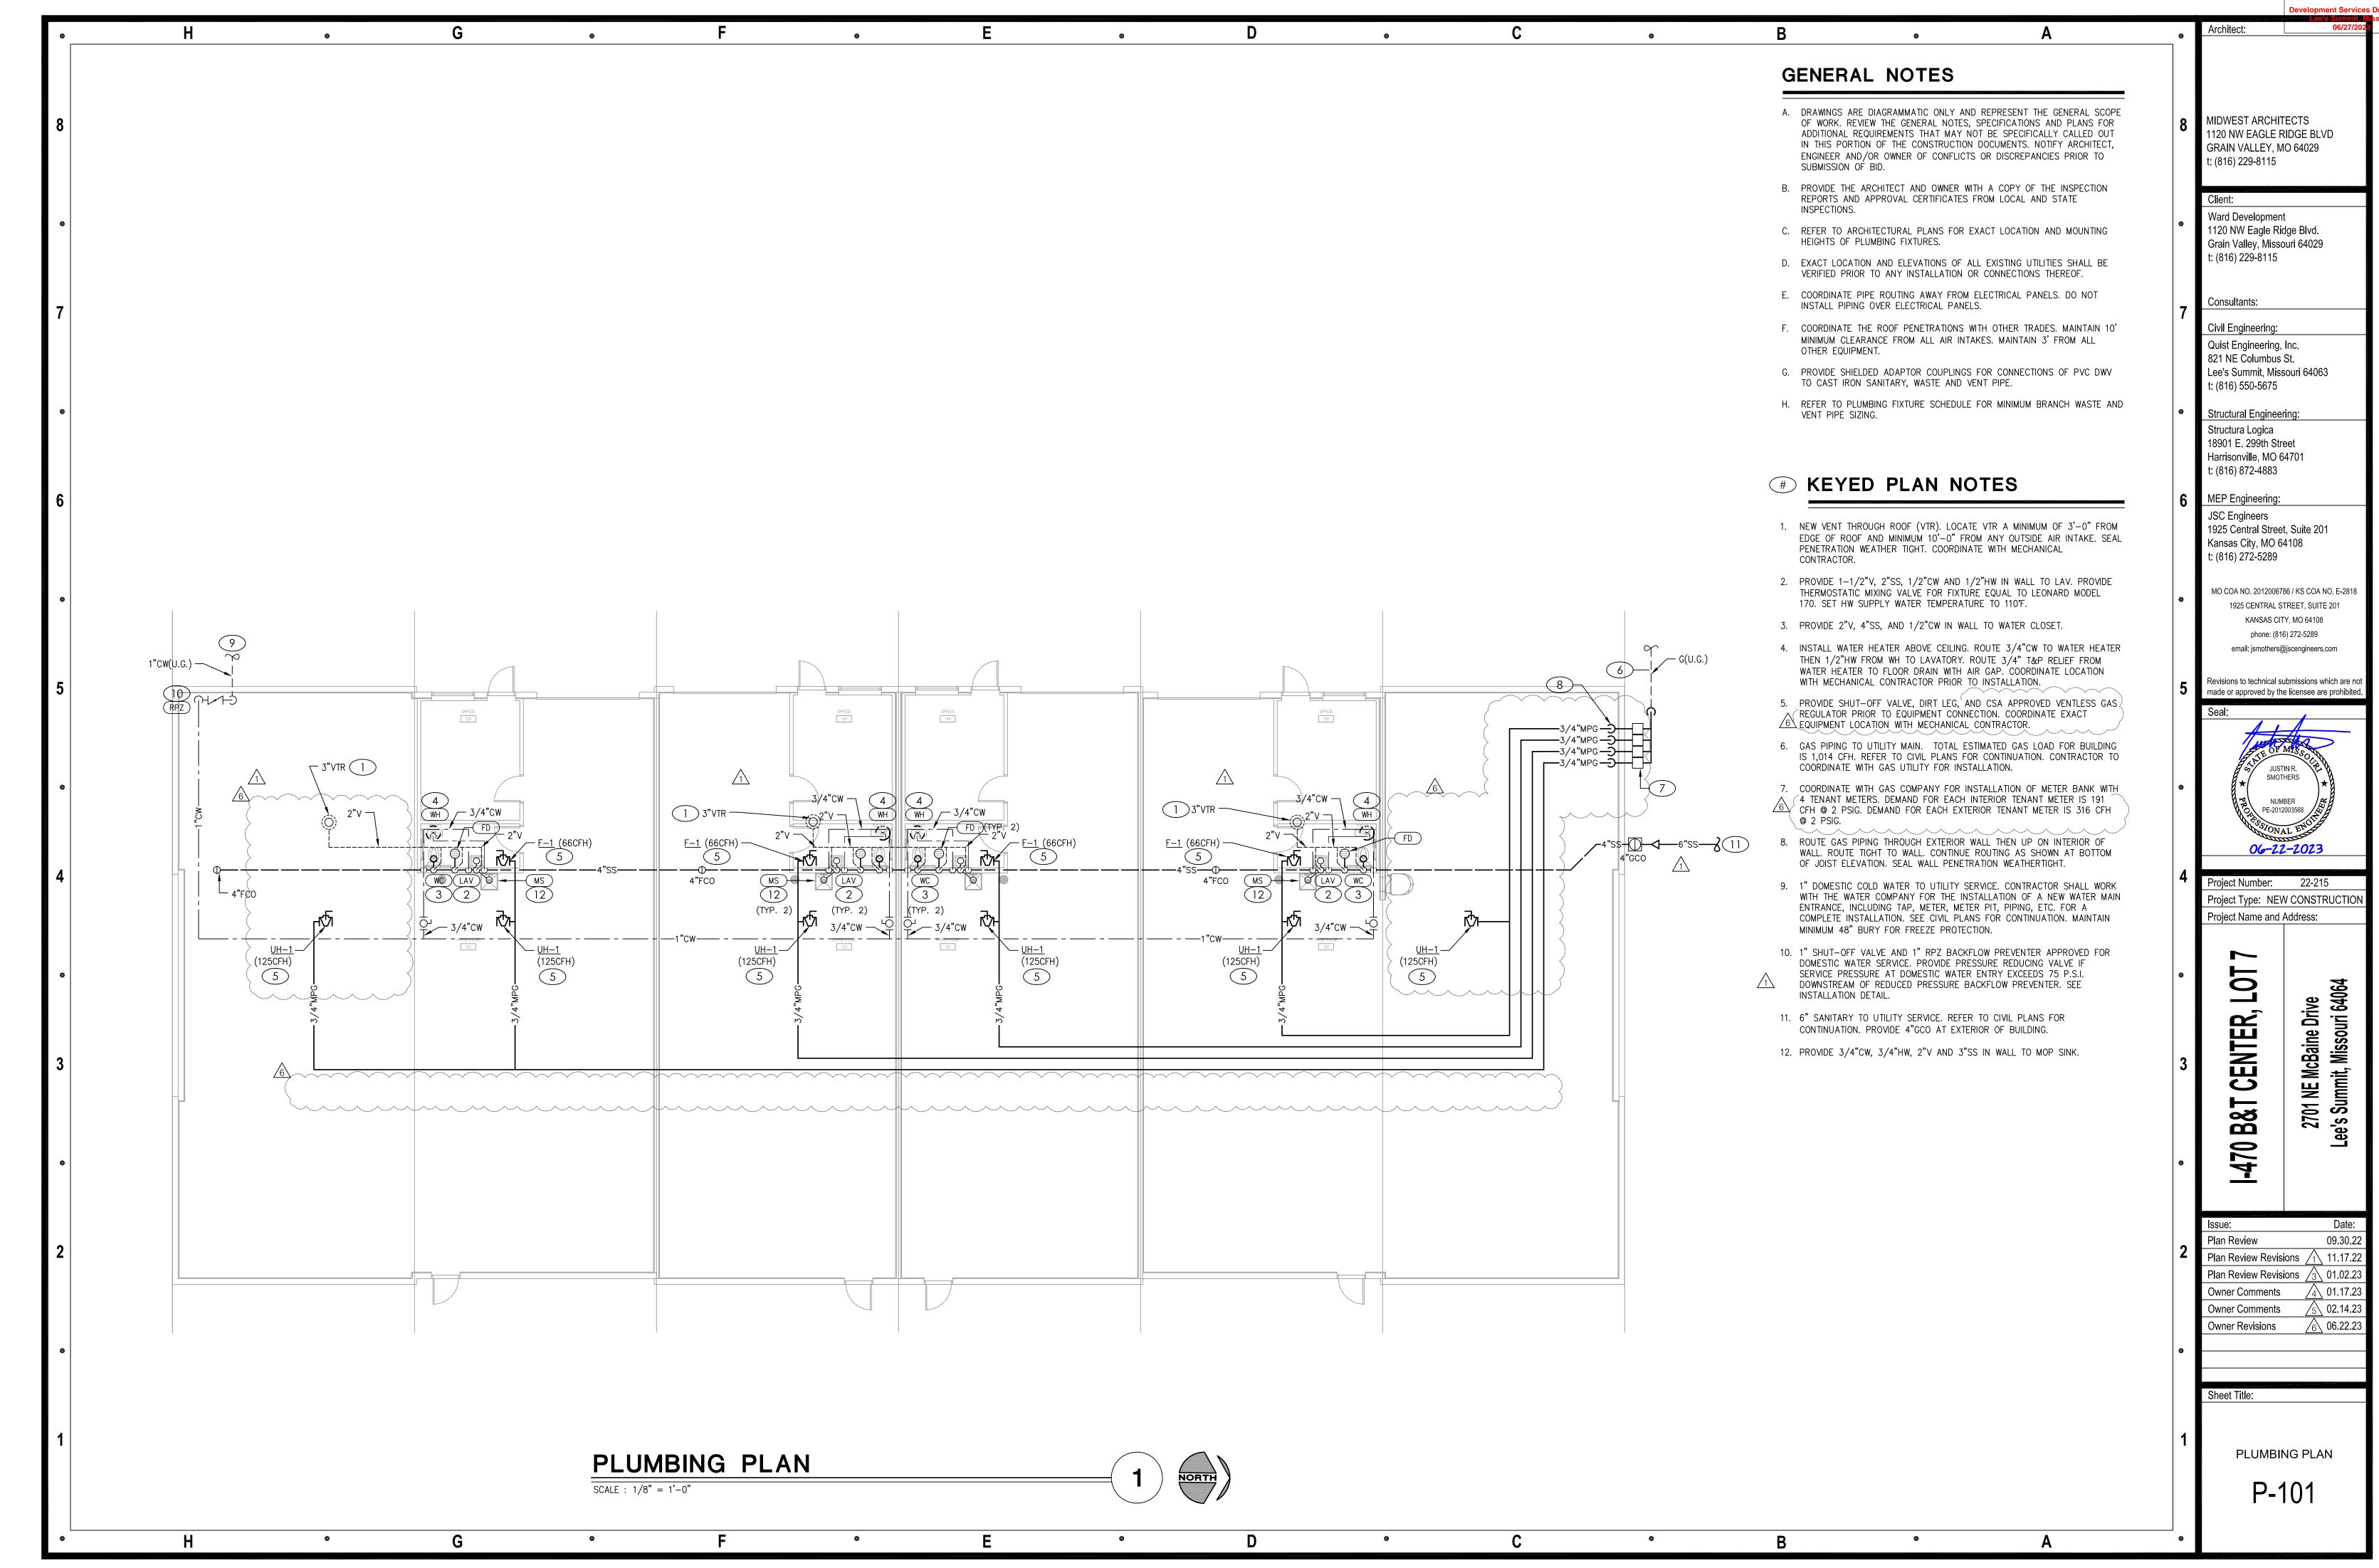



Architect: **ELECTRICAL SPECIFICATIONS** SYMBOLS LEGEND PART I - GENERAL B. SHOP DRAWINGS AND APPROVALS NOTE: THIS IS A MASTER LEGEND AND NOT ALL SYMBOLS, ETC, MIDWEST ARCHITECTS CIRCUIT BREAKER TYPE AS INDICATED ON DRAWINGS. UNLESS INDICATED OTHERWISE, ALL PANELS SHALL THE ITEMS SPECIFIED HEREIN AND ON DRAWINGS ARE USED AS A STANDARD OF QUALITY. ANY ARE NECESSARILY USED ON THE DRAWINGS. 1120 NW EAGLE RIDGE BLVD MATERIALS OF EQUAL QUALITY AND AESTHETIC VALUE WILL BE GIVEN CONSIDERATION AS A SUBSTITUTE HAVE PANEL HAVE PANEL BOARD TYPE CONSTRUCTION WITH BOLT-ON CIRCUIT BREAKERS FOR 30 <u>A. CONDITIONS</u> FURNISH AND INSTALL A COMPLETELY WIRED AND OPERATIONAL ELECTRICAL SYSTEM AS SHOWN ON THE PANELS FOR THE MATERIALS SPECIFIED. NO APPROVAL WILL BE GIVEN TO A SPECIFIC CATALOG NUMBER, MODEL, GRAIN VALLEY. MO 64029 LIGHTING FIXTURES - SYMBOL/LETTER INDICATES LIGHT FIXTURE AS INDICATED ON FIXTURE SCHEDULE DRAWINGS AND SPECIFIED HEREIN, INCLUDING BUT NOT LIMITED TO, THESE MAJOR ITEMS. MANUFACTURERS SHALL BE GENERAL ELECTRIC, SQUARE D, SEIMENS, CUTLER-HAMMER WITH VOLTAGE, OR TYPE OF EQUIPMENT, PRIOR TO BIDDING. AFTER BIDDING, THE DECISION OF THE ARCHITECT AND/OR t: (816) 229-8115 A. LIGHTING FIXTURES AS INDICATED AND SPECIFIED ON THE PLANS SIZES, AND RATINGS AS INDICATED ON DRAWINGS. ENGINEER DETERMINING EQUAL MATERIALS WILL BE FINAL LED FIXTURE (SEE LIGHTING FIXTURE SCHEDULE) B. ELECTRICAL PANELS, SERVICE, CONDUIT, WIRING, ETC., FOR ALL OUTLETS AND EQUIPMENT. THE CIRCUIT BREAKERS SHALL BE OPERABLE IN ANY POSITION AND BE REMOVABLE FROM THE FRONT O 2. THE CONTRACTOR SHALL SUBMIT SEVEN (7) IDENTICAL BOUND SETS OF SHOP DRAWINGS ON THE THE PANEL BOARD WITHOUT DISTURBING THE ADJACENT UNITS. BRANCH BREAKERS SHALL BE OF SUCH C. TELEPHONE, TELEVISION, AND FIRE ALARM. OUTLETS AND CONDUIT AS INDICATED. FOLLOWING ITEMS: DESIGN THAT COMBINATION OF SINGLE-POLE, DOUBLE-POLE, AND THREE-POLE BREAKERS CAN BE Client: A. LIGHTING FIXTURE CUTS AND PERFORMANCE DATA. OBTAIN AND REVIEW ALL OTHER DRAWINGS INCLUDING REFLECTED CEILING PLAN, INTERIOR AND EXTERIOR ASSEMBLED ON THE SAME PANEL. EACH BRANCH CIRCUIT SHALL BE CLEARLY NUMBERED. BRANCH AND B. OUTLINE DRAWINGS AND DATA SHEETS OF EACH PANELBOARD, LOAD CENTERS, AND DISTRIBUTION Ward Development ELEVATIONS, FURNITURE PLANS AND ALL MILL WORK DRAWINGS. COORDINATE INSTALLATION OF ALL MAN TERMINALS SHALL BE SOLDERLESS TYPE. HANDLE TIES TO FORM MULTI-POLE BREAKERS NOT FIXTURE WITH EMERGENCY BATTERY DRIVER UNIT 1120 NW Eagle Ridge Blvd. ELECTRICAL DEVICES AND EQUIPMENT PRIOR TO ROUGH-IN. **ACCEPTABLE** C. OUTLINE DRAWINGS OF ALL SWITCH GEAR COMPONENTS. TRACK LIGHT Grain Valley, Missouri 64029 D. WIRING DEVICES AND COVERPLATES. OBTAIN SUBMITTAL AND SHOP DRAWINGS FROM OTHER TRADES AND EQUIPMENT TO COORDINATE . LIGHTING FIXTURES E. ALL CIRCUIT BREAKERS INSTALLED IN PANELBOARDS, LOAD CENTERS, AND DISTRIBUTION PANELS. t: (816) 229-8115 PROVIDE ALL LIGHTING FIXTURES, WIRED AND CONNECTED. THE DRAWINGS INDICATE THE FIXTURES FOR **Ø** DOWNLIGHT FIXTURE WITH EMERGENCY BATTERY DRIVER UNIT INSTALLATION ACCORDINGLY. SUBMIT ITEMS AT ONE TIME IN A NEAT AND ORDERLY MANNER WITHIN 15 DAYS OF AWARD OF CONTRACT. EACH LOCATION. PROVIDE LAMPS FOR ALL FIXTURES. THE LAMPS SHALL BE BY THE SAME PARTIAL SUBMITTALS WILL NOT BE ACCEPTABLE. WALL MOUNTED FIXTURE WITH EMERGENCY BATTERY DRIVER UNIT 4. INSTALLATION SHALL COMPLY WITH ALL CURRENT APPLICABLE CODES AND GOVERNING AGENCIES HAVING MANUFACTURER. VERIFY CEILING CONSTRUCTION BEFORE ORDERING RECESSED UNITS. PROVIDE PLASTER JURISDICTION. FRAMES AND HANGERS AS REQUIRED. CEILING CONSTRUCTION, ARCHITECTURAL ACCESSORIES, VOLTAGE, PENDANT MOUNTED FIXTURE WITH EMERGENCY BATTERY DRIVER UNIT <u>C. SYSTEM GROUNDING</u> Consultants: AND BALLASTS TO MEET THE EXISTING CEILING CONDITION. GROUNDING SHALL COMPLY WITH REQUIREMENTS OF ARTICLE 250. ALL EXPOSED NONCURRENT CARRYING O DOWNLIGHT FIXTURE FIRE ALARM SYSTEM, IF REQUIRED PER IBC, SHALL BE DESIGN-BUILD BY OWNER'S/GC'S FIRE ALARM METALLIC PARTS OF ELECTRICAL EQUIPMENT, METALLIC RACEWAY SYSTEMS, METALLIC CABLE ARMOR, <u>M. LIGHTING CONTROL</u> OH WALL MOUNTED FIXTURE Civil Engineering: CONTRACTOR, DESIGN SHALL BE IN ACCORDANCE WITH NFPA 72. FIRE ALARM CONTRACTOR SHALL GROUNDING CONDUCTOR OF NONMETALLIC SHEATHED CABLES, GROUNDING CONDUCTOR IN NONMETALLIC FURNISH AND INSTALL TIME SWITCHES, PHOTOCELLS, CONTRACTORS AND FULL LIGHTING CONTROL SUBMIT STAMPED DRAWINGS TO AHJ FOR REVIEW AND APPROVAL. FIRE ALARM CONTRACTOR IS RACEWAYS, AND GROUNDED CONDUCTORS OF THE WIRING SYSTEM SHALL BE GROUNDED. PENDANT MOUNTED FIXTURE Quist Engineering, Inc. SYSTEMS AS REQUIRED FOR LIGHTING CONTROLS INDICATED ON THE DRAWINGS. RESPONSIBLE FOR TESTING AND VERIFYING THAT THE AUDIBILITY OF THE FIRE ALARM SYSTEM MEETS A GROUNDING CONDUCTOR (NEUTRAL) OF THE WIRING SYSTEM SHALL BE CONNECTED TO THE SYSTEM 821 NE Columbus St. TIME SWITCHES SHALL BE EQUAL TO PARAGON, GENERAL ELECTRIC, TORK, OR INTERMATIC AND SHALL MINIMUM OF 15 DBA ABOVE AMBIENT NOISE LEVELS. ADD HORNS WHERE REQUIRED TO MAINTAIN MINIMUM GROUNDING CONDUCTOR AT A SINGLE PLACE IN EACH SYSTEM BY REMOVABLE BONDING JUMPERS, SIZED HAVE SIZE AND NUMBER OF POLES AS REQUIRED. LEVELS. Lee's Summit, Missouri 64063 ACCORDING TO THE APPLICABLE PROVISIONS OF THE NATIONAL ELECTRICAL CODE. THE GROUNDED SINGLE FACE EXIT SIGN — UNIVERSAL MOUNTED PHOTOCELLS SHALL BE EQUAL TO TORK OR INTERMATIC WITH VOLTAGE AS INDICATED. t: (816) 550-5675 CONDUCTOR (NEUTRAL) TO THE GROUNDING CONDUCTOR CONNECTION SHALL BE LOCATED IN THE PROVIDE FIRE STOP ON ALL PIPING THAT PENETRATES RATED WALLS. METHOD OF FIRE STOP SHALL MEET SINGLE FACE EXIT SIGN W/ DIRECTIONAL ARROWS - UNIVERSAL MTD ENCLOSURE FOR THE SYSTEM'S OVERCURRENT PROTECTION OR WHERE OTHERWISE INDICATED ON THE N. TELEPHONE AND CABLE TELEVISION SYSTEMS WALL RATING, REFER TO ARCHITECTURAL DRAWINGS FOR LOCATION OF FIRE RATED WALLS. THIS PLANS OR SPECIFICATIONS. Structural Engineering CONTRACTOR SHALL PROVIDE FIRE RATED ENCLOSURES AROUND ALL ROUGH-IN BOXES, PANELS, ETC. TELEPHONE WALL OUTLETS SHALL CONSIST OF STANDARD BOXES MOUNTED 18" ABOVE THE FLOOR A GROUND BUS SEPARATE FROM THE NEUTRAL BUS SHALL BE PROVIDED IN ALL DISTRIBUTION PANELS DOUBLE FACE EXIT SIGN W/ DIRECTIONAL ARROWS -UNLESS OTHERWISE INDICATED. PROVIDE A TERMINAL MOUNTING BOARD FOR THE INCOMING SERVICE THAT ARE LOCATED IN FIRE RATED WALLS AND SHALL FIRE CAULK ALL OPENINGS IN RATED ASSEMBLIES. AND PANELBOARDS. PROPER TORQUE ON GROUND BUS SHALL BE VERIFIED, PER MANUFACTURER'S Structura Logica RECOMMENDATIONS, PRIOR TO ENERGIZING EQUIPMENT DUAL HEADED EMERGENCY UNIT 18901 E. 299th Street CABLE TELEVISION OUTLETS SHALL CONSIST OF STANDARD BOXES MOUNTED 18" ABOVE THE FLOOR GROUND BUSES AND NEUTRAL BUSES IN ALL DISTRIBUTION PANELS, LOAD CENTERS, PANELBOARDS, AND Harrisonville, MO 64701 THE ELECTRICAL CONTRACTOR SHALL PROVIDE CONDUIT, TRENCH, AND BACKFILL FOR ELECTRICAL SERVICE UNLESS OTHERWISE INDICATED. PROVIDE A TERMINAL MOUNTING BOARD FOR THE INCOMING SERVICE COMBO DUAL HEADED EMERGENCY AND EXIT SIGN UNIT THOSE PROVIDED IN ANY EQUIPMENT SHALL BE ISOLATED EXCEPT WHERE REQUIRED TO BE CONNECTED ENTRANCE FROM THE MAIN SERVICE TO UTILITY POINT OF ELECTRICAL SERVICE. ELECTRICAL t: (816) 872-4883 AS SPECIFIED ABOVE FOR THE SERVICE ENTRANCE CONTRACTOR SHALL COORDINATE THE INSTALLATION OF THE ELECTRICAL SERVICE ENTRANCE WITH WHEN INDICATED ON THE DRAWINGS, EQUIPMENT GROUNDING CONDUCTORS SHALL BE EXTENDED FROM SERVING UTILITY COMPANY. THE GROUND BUS IN THE DISTRIBUTION EQUIPMENT TO THE RECEPTACLE, FIXTURE OR DEVICE LUGS MEP Engineering: 2. THE ELECTRICAL CONTRACTOR SHALL PROVIDE CONDUIT, TRENCH, AND BACKFILL FOR PRIMARY PHONE GUARANTEE ALL MATERIAL FURNISHED AND ALL WORKMANSHIP PERFORMED FOR A PERIOD OF ONE YEAR SINGLE POLE SWITCH @ +48" UNLESS NOTED WHERE THEY ARE PROVIDED. WHERE LUGS ARE NOT PROVIDED. EQUIPMENT GROUNDING CONDUCTORS AND CATV SERVICE FROM THE TELEPHONE TERMINAL BOARD OR CABINET TO THE PHONE COMPANY AND FROM DATE OF FINAL ACCEPTANCE OF WORK. ANY DEFECTS DEVELOPING WITHIN THIS PERIOD, JSC Engineers SHALL BE CONNECTED TO EQUIPMENT ENCLOSURES. THE CONNECTIONS SHALL BE ARRANGED SUCH THAT Sabc SWITCH BANK @ +48" UNLESS NOTED. LOWER CASE CATV COMPANY POINT OF SERVICE COORDINATE WITH LOCAL UTILITY COMPANIES. TRACEABLE TO MATERIAL FURNISHED AS A PART OF THIS SECTION OR WORKMANSHIP PERFORMED REMOVAL OF THE RECEPTACLE, EQUIPMENT GROUND CONDUCTORS, OR GROUND JUMPERS FROM GROUND 1925 Central Street, Suite 201 LETTER INDICATES FIXTURE CONTROLLED HEREUNDER, SHALL BE MADE GOOD AT NO EXPENSE TO THE OWNER. BUSING SHALL NOT AFFECT THE GROUND SYSTEM. C. CODES, REGULATIONS, AND STANDARDS Kansas City, MO 64108 S<sub>3</sub> 3-WAY SWITCH @ +48" UNLESS NOTED RACEWAYS MAY NOT BE USED AS A GROUNDING CONDUCTOR FOR POWER AND LIGHTING CIRCUITS. ALL THE INSTALLATION SHALL COMPLY WITH APPLICABLE LOCAL AND STATE CODES AND ORDINANCES, WITH t: (816) 272-5289 CONDUIT SHALL HAVE SEPARATE CODE SIZED GREEN GROUND WIRE INSTALLED IN THE CONDUIT TO S4 4-WAY SWITCH @ +48" UNLESS NOTED THE REGULATIONS OF THE LATEST EDITION OF THE NATIONAL ELECTRIC CODE AND WITH THE INSURE A CONTINUOUS GROUNDING PATH. REQUIREMENTS OF THE POWER, TELEPHONE, AND CATV COMPANIES FURNISHING SERVICES TO THIS SD DIMMER SWITCH - SIZE AS REQUIRED @ +48" UNLESS NOTED IN INACCESSIBLE LOCATIONS, MAKE CONNECTIONS BY EXOTHERMIC WELD PROCESS. INSTALL ATION. SM MANUAL MOTOR STARTER 8. IN ACCESSIBLE LOCATIONS, CONNECTIONS SHALL BE MADE WITH BOLTED THROUGH, APPROVED MO COA NO. 2012006786 / KS COA NO. E-2818 THE LATEST EDITIONS OF THE FOLLOWING INDUSTRY STANDARDS, SPECIFICATIONS, AND CODES ARE SOLDERLESS BRONZE GROUNDING DEVICES. SOS WALL SWITCH WITH OCCUPANCY SENSOR. DIGITAL LOW VOLTAGE WALL SWITCH. SWITCH @ 1925 CENTRAL STREET, SUITE 201 MINIMUM REQUIREMENTS: A. THE NATIONAL ELECTRICAL MANUFACTURER'S ASSOCIATION STANDARDS. +48" UNLESS NOTED. KANSAS CITY, MO 64108 B. THE NATIONAL ELECTRICAL CODE, INCLUDING LOCAL AMENDMENTS. CONDUCTOR SIZES SHOWN ON THE DRAWINGS ARE BASED ON COPPER WIRE. UNLESS OTHERWISE SLV TWO BUTTON DIGITAL LOW VOLTAGE WALL SWITCH. PROVIDES ON/OFF/0-10V DIMMING. SWITCH phone: (816) 272-5289 C. UNDERWRITER LABORATORIES INCORPORATED STANDARDS. SPECIFIED, ALL WIRE SHALL BE TYPE XHHW OR SE FOR FEEDERS OR BRANCH CIRCUITS LARGER THAN 4 email: jsmothers@jscengineers.com D. AMERICAN NATIONAL STANDARDS INSTITUTE. AWG, TYPE THHN/THWN INSULATION FOR FEEDERS AND BRANCH CIRCUITS 4 AWG AND SMALLER. ALL E. INTERNATIONAL BUILDING CODE. LIGHTING CONTROLS CEILING MOUNT OCCUPANCY SENSOR BRANCH CIRCUIT WIRING SHALL BE COPPER. ALUMINUM CONDUCTORS MAY BE UTILIZED FOR SERVICE ENTRANCE AND PANEL FEEDERS. CONDUCTORS <u>). INSPECTION OF SITE</u> (PP) LIGHTING CONTROLS POWER PACK Revisions to technical submissions which are n SHALL BE ALUMINUM ALLOW AA-8000 SERIES. made or approved by the licensee are prohibited PRIOR TO SUBMITTING A BID FOR ELECTRICAL WORK, THE CONTRACTOR SHALL VISIT THE SITE OF THE THE WIRES SHALL BE MARKED WITH COLOR TO SIMPLIFY CIRCUIT IDENTIFICATION. UNLESS OTHERWISE PHOTOCELI PROPOSED CONSTRUCTION AND SHALL THOROUGHLY ACQUAINT HIMSELF WITH EXISTING UTILITIES, AND REQUIRED BY LOCAL ORDINANCES GROUND WIRES SHALL BE GREEN, NEUTRAL WIRES SHALL BE WORKING CONDITIONS TO BE ENCOUNTERED, ETC. ALLOWANCE WILL NOT BE MADE FOR NONCOMPLIANCE 120V-WHITE, AND LIVE WIRES 208Y/120V AND 120/240 SHALL BE BLACK (PHASE A), RED (PHASE B), WITH THIS CONDITION AFTER BIDDING. AND BLUE (PHASE C). CIRCUIT SHALL BE LABELED IN EACH J-BOX. 2. ELECTRICAL INSTALLATION SHALL MEET THE EXISTING CONDITIONS. ALL CONDUCTORS SHALL BE RATED 600 VOLT. **POWER DISTRIBUTION** 5. SPLICES IN EXTERIOR PULL BOXES AND MANHOLES SHALL BE WEATHERPROOF USING "SCOTCHCAST" <u>E. STORAGE AND HANDLING OF MATERIAL</u> DELIVER MATERIALS AND EQUIPMENT TO THE PROJECT IN THE MANUFACTURER'S ORIGINAL, UNOPENED, SPLICE KIT OR APPROVED EQUAL. SEAL ENDS OF CONDUITS AND DUCTS WITH "DUCTSEAL" OR SWITCHBOARD, MOTOR CONTROL CENTER OR DISTRIBUTION BOARD JUSTIN R. SMOTHERS LABELED CONTAINERS. PROTECT AGAINST MOISTURE, TAMPERING, OR DAMAGE FROM IMPROPER HANDLING 277/480V, 3 PHASE, 4 WIRE PANELBOARD, UNO OR STORAGE. CONTRACTOR SHALL PROTECT AND BE RESPONSIBLE FOR ANY DAMAGE TO WORK OR PROVIDE SOLID CONDUCTOR FOR 12 AWG AND SMALLER. 120/208V, 3 PHASE, 4 WIRE PANELBOARD, UNO NO WIRE SHALL BE INSTALLED IN THE CONDUIT SYSTEM UNTIL THE CONDUIT SYSTEM IS COMPLETE. USE MATERIALS UNTIL FINAL ACCEPTANCE BY THE OWNER, AND SHALL MAKE GOOD WITHOUT COST TO THE OWNER, ANY DAMAGE OR LOSS THAT MAY OCCUR DURING THIS PERIOD. MINERALAC NO. 100 OR EQUIVALENT AS A LUBRICANT TO FACILITATE THE INSTALLATION OF THE PE-2012003568 120/240V, 1 PHASE, 3 WIRE PANELBOARD, UNO CONDUCTORS IN THE CONDUIT SYSTEM. ARRANGE FOR TIMELY DELIVERY OF MATERIALS AND EQUIPMENT TO THE JOB SITE IN ORDER TO MINIMIZE STONAL ET 8. MC CABLE WITH COPPER CONDUCTORS AND GROUND WIRE MAY BE USED WHERE PERMITTED. TRANSFORMER THE LENGTH OF TIME BETWEEN DELIVERY AND INSTALLATION. COVER AND PROTECT ANY MATERIAL WHICH MAY BE AFFECTED BY THE WEATHER WHILE IN TRANSIT OR STORED AT THE PROJECT SITE. ANY MATERIAL FOUND DEFECTIVE OR NOT INSTALLED IN ACCORDANCE <u>POWER DEVICES</u> WITH THE CONTRACT DOCUMENTS MAY BE REJECTED BY THE ENGINEER. 1. ALL WIRING SHALL BE INSTALLED IN LISTED METALLIC CONDUIT EXCEPT AS PERMITTED IN OTHER SECTIONS. RGS, WITH A 20 MIL PVC COATING WILL BE USED WHEN IN CONTACT WITH EARTH. IMC MAY SPECIAL HEAVY DUTY RECEPTACLE - SIZE AS NOTED. Project Number 22-215 BE USED IN INDOOR LOCATIONS NOT IN CONTACT WITH THE EARTH. EMT MAY BE USED IN INDOOR @ +18" UNLESS NOTED LOCATIONS NOT IN CONTACT WITH EARTH, NOT IN CONCRETE SLABS OR WALLS AND NOT SUBJECT TO KEEP THE PREMISES FREE FROM ACCUMULATION OF WASTE MATERIALS, OR RUBBISH CAUSED BY Project Type: NEW CONSTRUCTION 1/2 SWITCHED RECEPTACLE @ +18" UNLESS NOTED DAMAGE. PVC MAY BE USED IN OR BELOW CONCRETE AND DIRECT BURIED IN EARTH. FLEXIBLE STEEL EMPLOYEES OR WORK UNDER THIS DIVISION OF THE SPECIFICATIONS. AT THE COMPLETION OF THE WORK Project Name and Address: CONDUIT SHALL BE USED FOR INDOOR FINAL CONNECTIONS TO EQUIPMENT IN LENGTHS NOT TO EXCEED REMOVE ALL SURPLUS MATERIALS, TOOLS, ETC., AND LEAVE THE PREMISES BROOM-CLEAN. • FIRE RATED POKE THRU WITH TYPE INDICATED 72". LIQUID-TIGHT FLEXIBLE STEEL CONDUIT SHALL BE FOR OUTDOOR FINAL CONNECTIONS TO EQUIPMENT NOT TO EXCEED 48". FLUSH FLOOR BOX WITH TYPE INDICATED PERFORM ALL EXCAVATION AND BACK FILLING REQUIRED FOR WORK PERFORMED UNDER THIS DIVISION OF WHERE CONDUIT ENTERS OUTLET BOXES, FIXTURES OR CABINETS, FIRMLY FASTEN WITH STEEL SET SCREW, THE SPECIFICATIONS. USE EXCAVATED MATERIALS FOR BACKFILL UNLESS OFF SITE MATERIALS ARE → SINGLE RECEPTACLE @ +18" UNLESS NOTED COMPRESSION CONNECTORS, OR DOUBLE LOCKNUTS FOR GRC. ALL CONNECTIONS SHALL HAVE BUSHINGS OR INSULATED THROAT CONNECTORS. FIRMLY FASTEN CONDUIT TO THE BUILDING CONSTRUCTION. RUN DUPLEX RECEPTACLE @ +18" UNLESS NOTED PERFORM THE EXCAVATION, CUTTING, FITTING, REPAIRING, AND FINISHING OF THE WORK NECESSARY FOR EXPOSED CONDUIT PARALLEL TO THE BUILDING LINES, SUPPORTED BY APPROPRIATE HANGERS (UNISTRUT, THE INSTALLATION OF THE EQUIPMENT OF THIS SECTION. HOWEVER, NO CUTTING OF THE WORK OF DOUBLE DUPLEX RECEPTACLE @ +18" UNLESS NOTED T & B OR APPLETON, OR EQUAL). OTHER TRADES OR OF ANY STRUCTURAL MEMBERS SHALL BE DONE WITHOUT THE CONSENT OF THE DUPLEX RECEPTACLE INSTALLED ABOVE COUNTERTOP COVER METALLIC CONDUIT IN CONTACT WITH EARTH WITH POLYETHYLENE TAPED SPIRAL WRAPPED. 1/2 ENTER, cBaine Dri Missouri LAPPED TO PROVIDE 20 MIL. THICKNESS. TAPE SHALL BE SCOTCH NO. 50 TAPE. CONDUIT AND DUCTS GFCI-RATED DUPLEX RECEPTACLE NOT UNDER BUILDINGS AND FEEDER DUCTS SHALL BE INSTALLED PER N.E.C. 300-5. MAKE JOINTS WITH COMPOUND TO BE WATERTIGHT. THE DRAWINGS INDICATE THE GENERAL ARRANGEMENT AND LOCATIONS OF THE ELECTRICAL WORK DATA ARC FAULT RATED DUPLEX RECEPTACLE SCHEDULE 40 PVC CONDUIT SHALL BE PERMITTED UNDERGROUND WITH PROPER FITTINGS. ALL UL PRESENTED ON THESE DRAWINGS ARE AS ACCURATE AS PLANNING CAN DETERMINE. BUT FIELD APPROVED AND CEMENTED JOINTS. PENETRATIONS THROUGH FLOOR SLABS AND BENDS GREATER THAN VERIFICATION OF ALL DIMENSIONS, LOCATIONS, LEVELS, ETC., TO SUIT FIELD CONDITIONS IS REQUIRED. 22° SHALL BE WRAPPED RIGID GALVANIZED STEEL ELBOWS. €\_ TAMPER RESISTANT RATED DUPLEX RECEPTACLE REVIEW ALL ARCHITECTURAL, STRUCTURAL, AND MECHANICAL DRAWINGS AND ADJUST ALL WORK TO MEET FITTINGS AND CONDUIT BODIES SHALL BE STEEL. DIECAST FITTINGS ARE NOT ACCEPTABLE. 岁 THE REQUIREMENTS OF CONDITIONS SHOWN. THE ARCHITECTURAL DRAWINGS SHALL TAKE PRECEDENCE DUPLEX RECEPTACLE WITH WEATHERPROOF COVERPLATE CONDUIT SIZES SHALL BE AS REQUIRED BY CODE AND AS INDICATED OR SPECIFIED. OVER ALL OTHER DRAWINGS. DISCREPANCIES BETWEEN DIFFERENT PLANS, OR BETWEEN DRAWINGS AND WP @ 18" UNLESS NOTED る 2 2 2 ALL EMPTY CONDUIT SYSTEMS SHALL HAVE A 200 LB. TEST NYLON PULL STRING TO FACILITATE SPECIFICATIONS, OR REGULATIONS AND CODES GOVERNING THE INSTALLATION SHALL BE BROUGHT TO THE INSTALLATION OF FUTURE WIRE. 27( .ee's JUNCTION BOX ATTENTION OF THE ENGINEER IN WRITING BEFORE THE DATE OF BID OPENING. IF DISCREPANCIES ARE  $\mathbf{\Omega}$ WIRING, CONDUITS, AND OUTLETS SHALL BE CONCEALED WITH THE BUILDING STRUCTURE, EXCEPT THAT NOT REPORTED, THE CONTRACTOR SHALL BID THE GREATER QUANTITY OR BETTER QUALITY, AND CERTAIN MOTOR AND LIGHTING FEEDER CONDUITS MAY BE RUN EXPOSED IN CERTAIN AREAS AS ☐☐ DISCONNECT SWITCH — SIZE AND TYPE NOTED APPROPRIATE ADJUSTMENTS WILL BE MADE AFTER CONTRACT AWARD. CONTRACTOR SHALL BE 2 INDICATED ON THE DRAWINGS. RESPONSIBLE TO FIELD MEASURE AND CONFIRM MOUNTING HEIGHTS AND LOCATION OF ELECTRICAL COMBINATION FUSED STARTER DISCONNECT SWITCH FUSE SIZE AS INDICATED, STARTER SIZE '1' 9. CONDUIT PENETRATION THROUGH ROOF SHALL HAVE ROOF FLASHING WITH CAULK TYPE COUNTER EQUIPMENT WITH RESPECT TO COUNTERS, RADIATION, ETC. DO NOT SCALE DISTANCES OFF THE FLASHING SLEEVE. INSTALLATION SHALL BE WATERTIGHT. ELECTRICAL DRAWINGS, USE ACTUAL BUILDING DIMENSIONS. 10. CONDUITS SHALL BE ROUTED PARALLEL AND PERPENDICULAR TO THE STRUCTURE. **AUXILIARY SYSTEMS** COOPERATION WITH OTHER CONTRACTORS F. OUTLET, PULL, AND JUNCTION BOXES COOPERATE WITH THE OTHER TRADES SO THAT THE INSTALLATION OF THE ELECTRICAL OUTLETS AND MECHANICAL EQUIP. CONNECTION, SEE SCHED. ON MECH. PLAN ALL JUNCTION AND OUTLET BOXES CONCEALED IN WALLS SHALL BE STEEL. EQUIPMENT WILL BE PROPERLY COORDINATED. CONDUIT, LIGHTING FIXTURES, AND OTHER EQUIPMENT BOXES INSTALLED IN POURED CEMENT FLOORS SHALL BE FLUSH TYPE CAST IRON OR STEEL WITH LOCATIONS SHALL BE VERIFIED WITH OTHER TRADES TO AVOID CONFLICT WITH THE PIPING, DUCTWORK, WATERTIGHT GASKETED COVERS. WHERE BOXES ARE INSTALLED IN FLOORS WITH TILE OR CARPET FLOOR STEEL, BEAMS, OR OTHER OBSTRUCTIONS TELEPHONE OUTLET@ +18" UNLESS NOTED Plan Review COVERING, COVERS SHALL BE OF THE RECESSED TYPE TO ACCOMMODATE THE FLOOR COVERING. CAREFULLY VERIFY THE LOCATIONS OF THE OUTLET BOXES AND DETERMINE THAT THEY HAVE NOT BOXES INSTALLED FOR THE ALARM, COMPUTER, AND SECURITY SYSTEM SHALL BE PROVIDED WITH ₁∖ 11.17.22 DATA OUTLET @ +18" UNLESS NOTED Plan Review Revisions BEEN DISTURBED DURING THE INSTALLATION OF MATERIALS OF OTHER TRADES. APPROPRIATE COVER PLATES. COORDINATE THE LOCATION OF THE TRENCHES AND CONDUITS FOR ELECTRICAL AND TELEPHONE UTILITY Plan Review Revisions ∖ 01.02.23 BOXES FOR TELEPHONE, COMPUTER, T.V., FIRE ALARM, SECURITY, AND SIMILAR SYSTEMS SHALL BE COMBINATION TELEPHONE/DATA OUTLET @ +18" UNLESS NOTED SERVICES WITH THE GENERAL CONTRACTOR. MINIMUM 2-1/8" DEEP. COORDINATE HVAC AND PLUMBING EQUIPMENT CONNECTION REQUIREMENTS WITH HVAC AND PLUMBING Owner Comments TELEVISION OUTLET @ +60" UNLESS NOTED CONTRACTORS. 、02.14.23 **G WIRING DEVICES (COMMERCIAL)** Owner Comments SMOKE DETECTOR WALL SWITCHES SHALL BE SPECIFICATION GRADE AC SILENT TYPE SWITCHES, 20A 120/277 VOLT. THE ELECTRICAL CONTRACTOR SHALL MAINTAIN A SET OF DRAWINGS AT THE JOB SITE FOR THE Owner Revisions √ 06.22.2 RECEPTACLES SHALL BE SPECIFICATION GRADE, DUPLEX TYPE. NEMA5-20R, 20 AMPERE, 120VOLT EXCLUSIVE PURPOSE OF MAINTAINING A RECORD OF ALL WORK INSTALLED AND TO SHOW ANY DEVIATIONS HEAT DETECTOR GROUNDED TYPE. SPECIAL APPLICATION RECEPTACLES SHALL BE INDICATED ON PLANS. MOUNT WITH THE FROM THE WORK INDICATED ON THE DRAWINGS. DUCT SMOKE DETECTOR GROUND DOWN. AT THE COMPLETION OF THE PROJECT, ONE SET OF REPRODUCIBLE DRAWINGS, SHOWING ALL RECORD 3. DEVICE PLATES SHALL BE EQUAL TO SIERRA SMOOTH-LINE PLASTIC WALL PLATES. COLOR SHALL BE CONDITIONS, SHALL BE DELIVERED TO THE OWNER FOR ACCEPTANCE PRIOR TO FINAL PAYMENT. WHITE, UNLESS OTHERWISE NOTED. REMOTE TEST STATION WITH INDICATING LIGHT. MOUNT AT 48" AFF UNO. 4. RECEPTACLES IN OUTDOOR AND WET LOCATIONS SHALL BE INSTALLED WITH A HINGED OUTLET PART II - PRODUCTS AND EXECUTION AUXILIARY SYSTEM TERMINAL CABINET Sheet Title: COVER/ENCLOSURE CLEARLY MARKED AND U.L. LISTED SUITABLE FOR WET LOCATIONS WHILE IN USE, EQUAL TO TAYMAC SPECIFICATION GRADE. ALL MATERIALS SHALL BE NEW AND OF QUALITY AS SPECIFIED ON THE PLANS OR SPECIFICATIONS AND MUST CARRY THE UNDERWRITER'S LABORATORIES APPROVAL COVERING THE PURPOSE FOR WHICH THEY **ELECTRICAL** THE SERVICE ENTRANCE EQUIPMENT SHALL BE AS INDICATED ON THE DRAWINGS. EQUIPMENT SHALL ARE USED, IN ADDITION TO MEETING ALL REQUIREMENTS OF THE CURRENT APPLICABLE CODES AND ———— CONDUIT RUN CONCEALED IN WALL OR ABOVE CEILING CARRY THE U.L. LABEL AND SHALL CONFORM TO THE POWER COMPANY REGULATIONS. SPECIFICATIONS AND — — — CONDUIT RUN BELOW FLOOR OR GRADE 2. SERVICE ENTRANCE EQUIPMENT SHALL BE PROVIDED WITH A FULLY RATED COPPER OR ALUMINUM BUS. SYMBOLS HORIZONTALLY TAPERED BUSSING SHALL NOT BE ALLOWED. ` HOMERUN TO PANELBOARD, INFORMATION AT ARROWS ARE CIRCUIT NUMBERS AND PANELBOARD FOR TERMINATION. REFER TO ASSOCIATED NOTE FOR BRANCH CIRCUIT CONDUCTOR SIZES. (E) OR ETR: DENOTES EXISTING ITEM/EQUIPMENT TO REMAIN

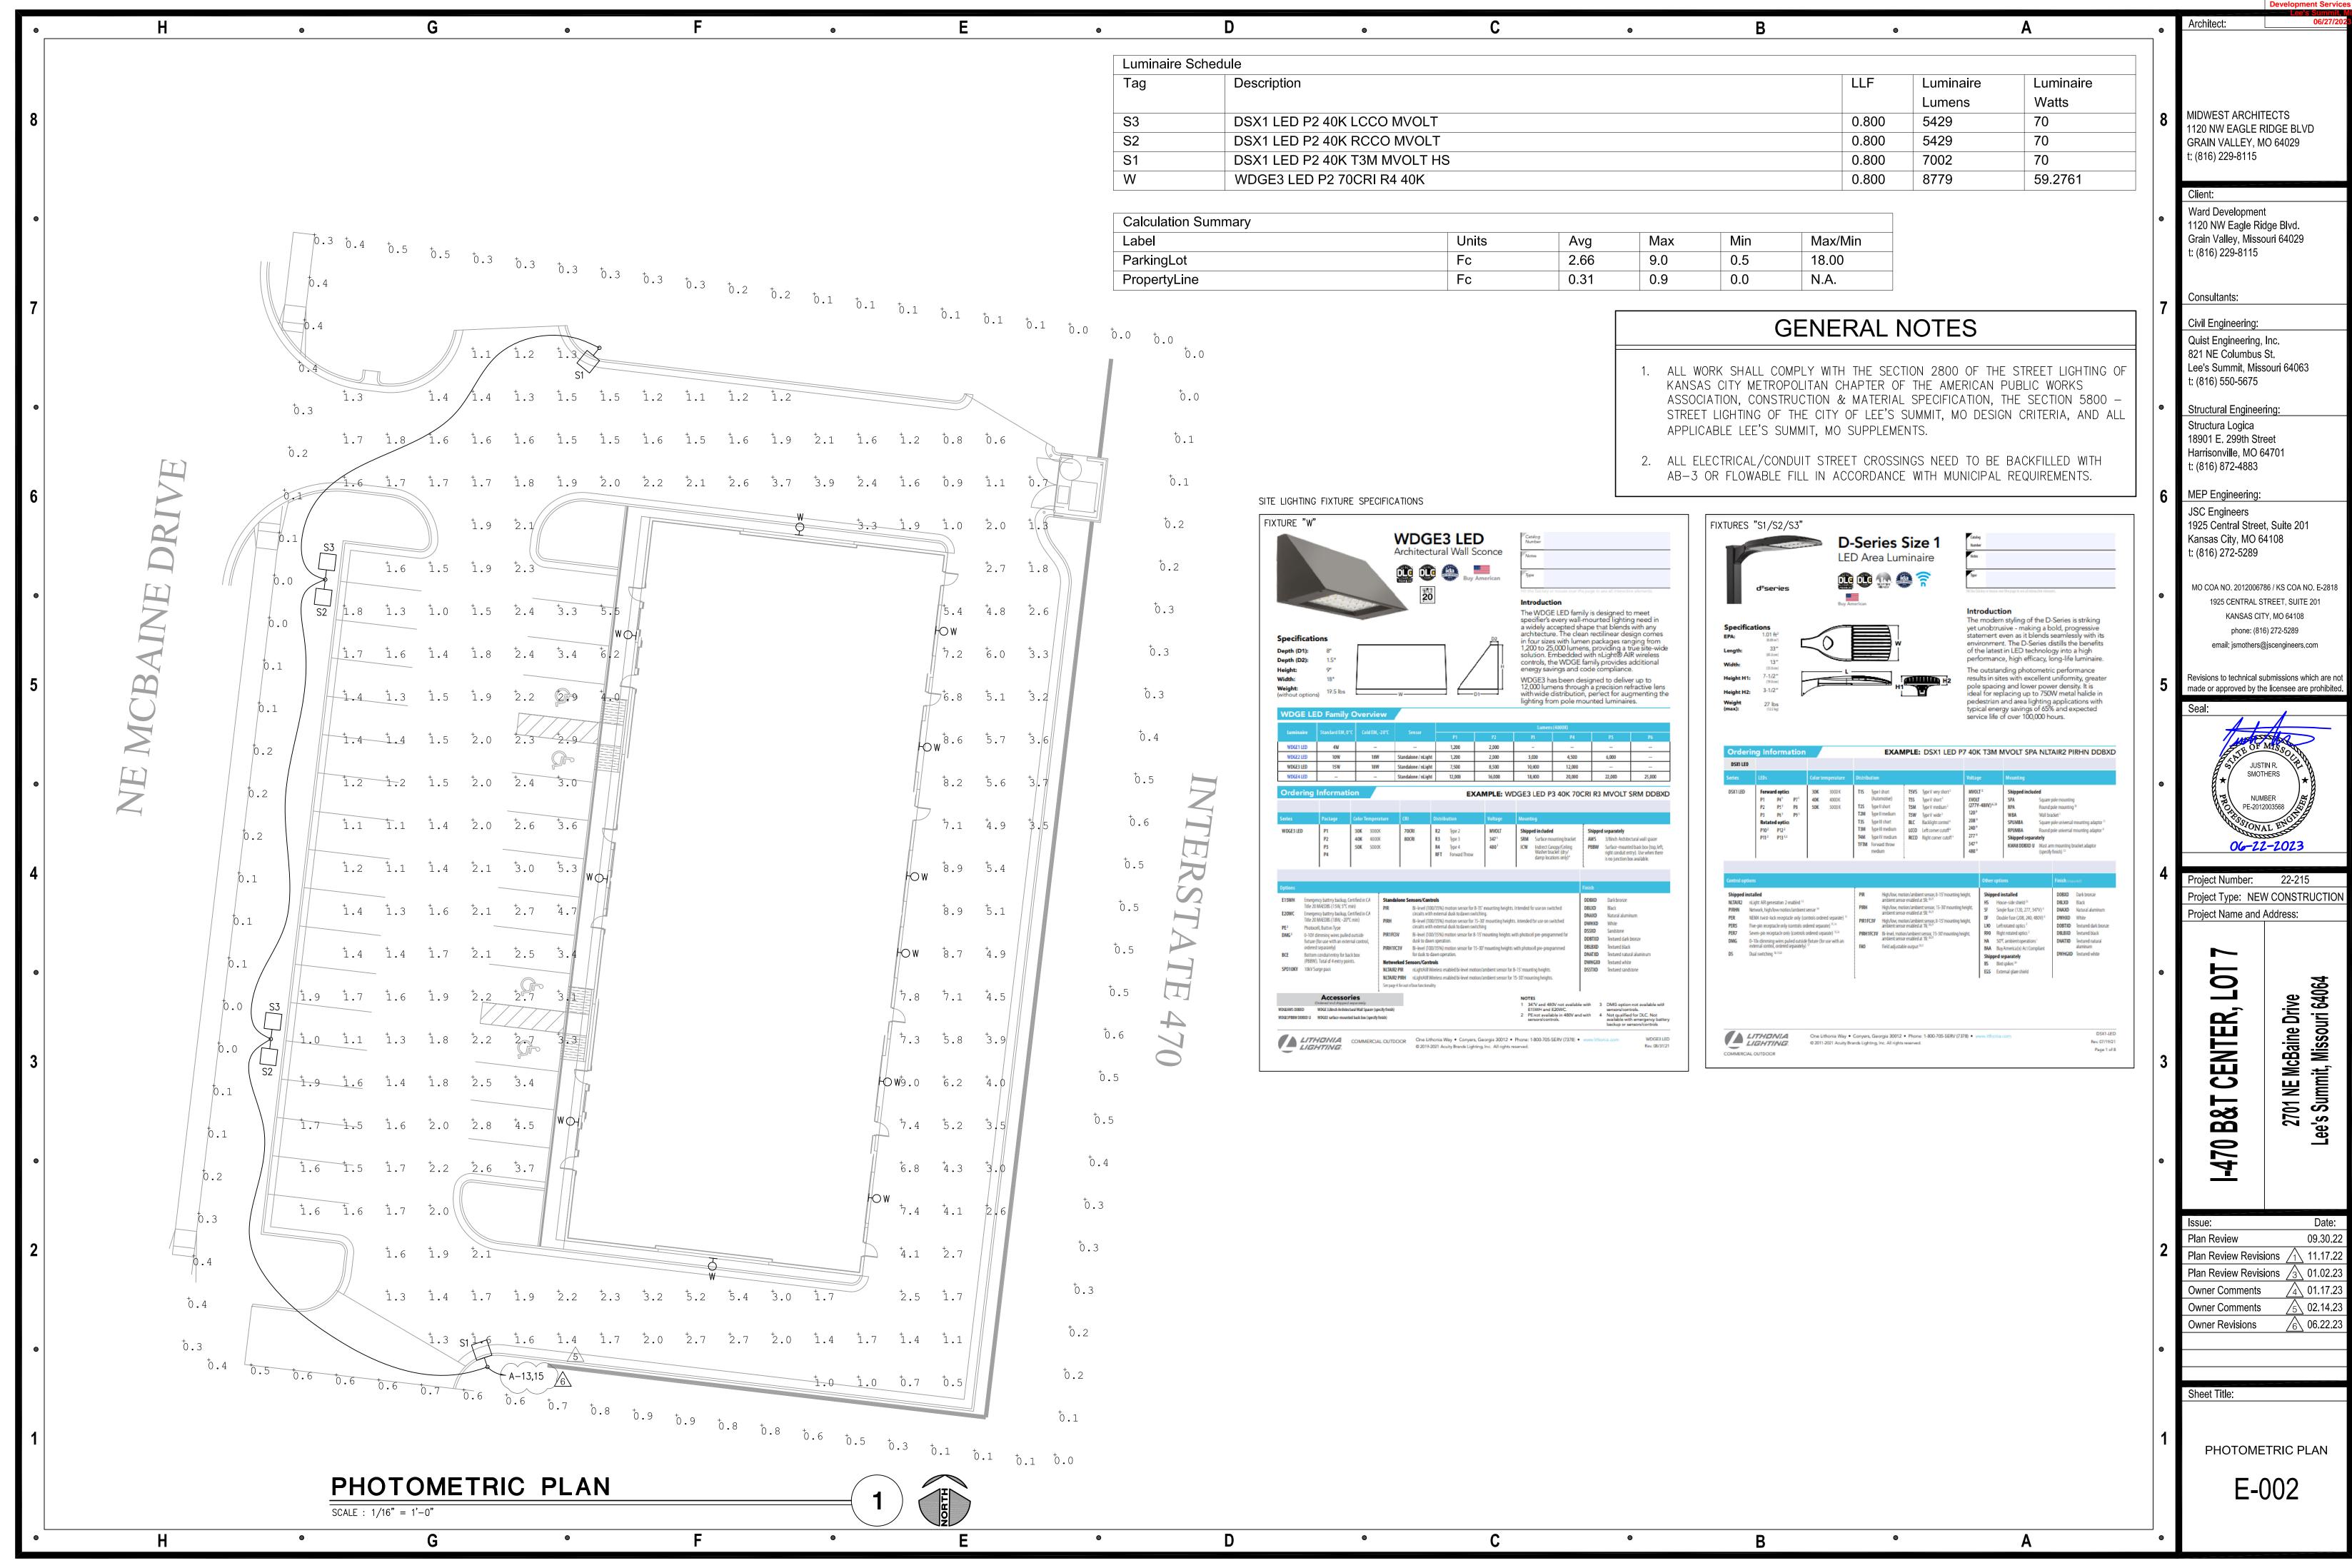

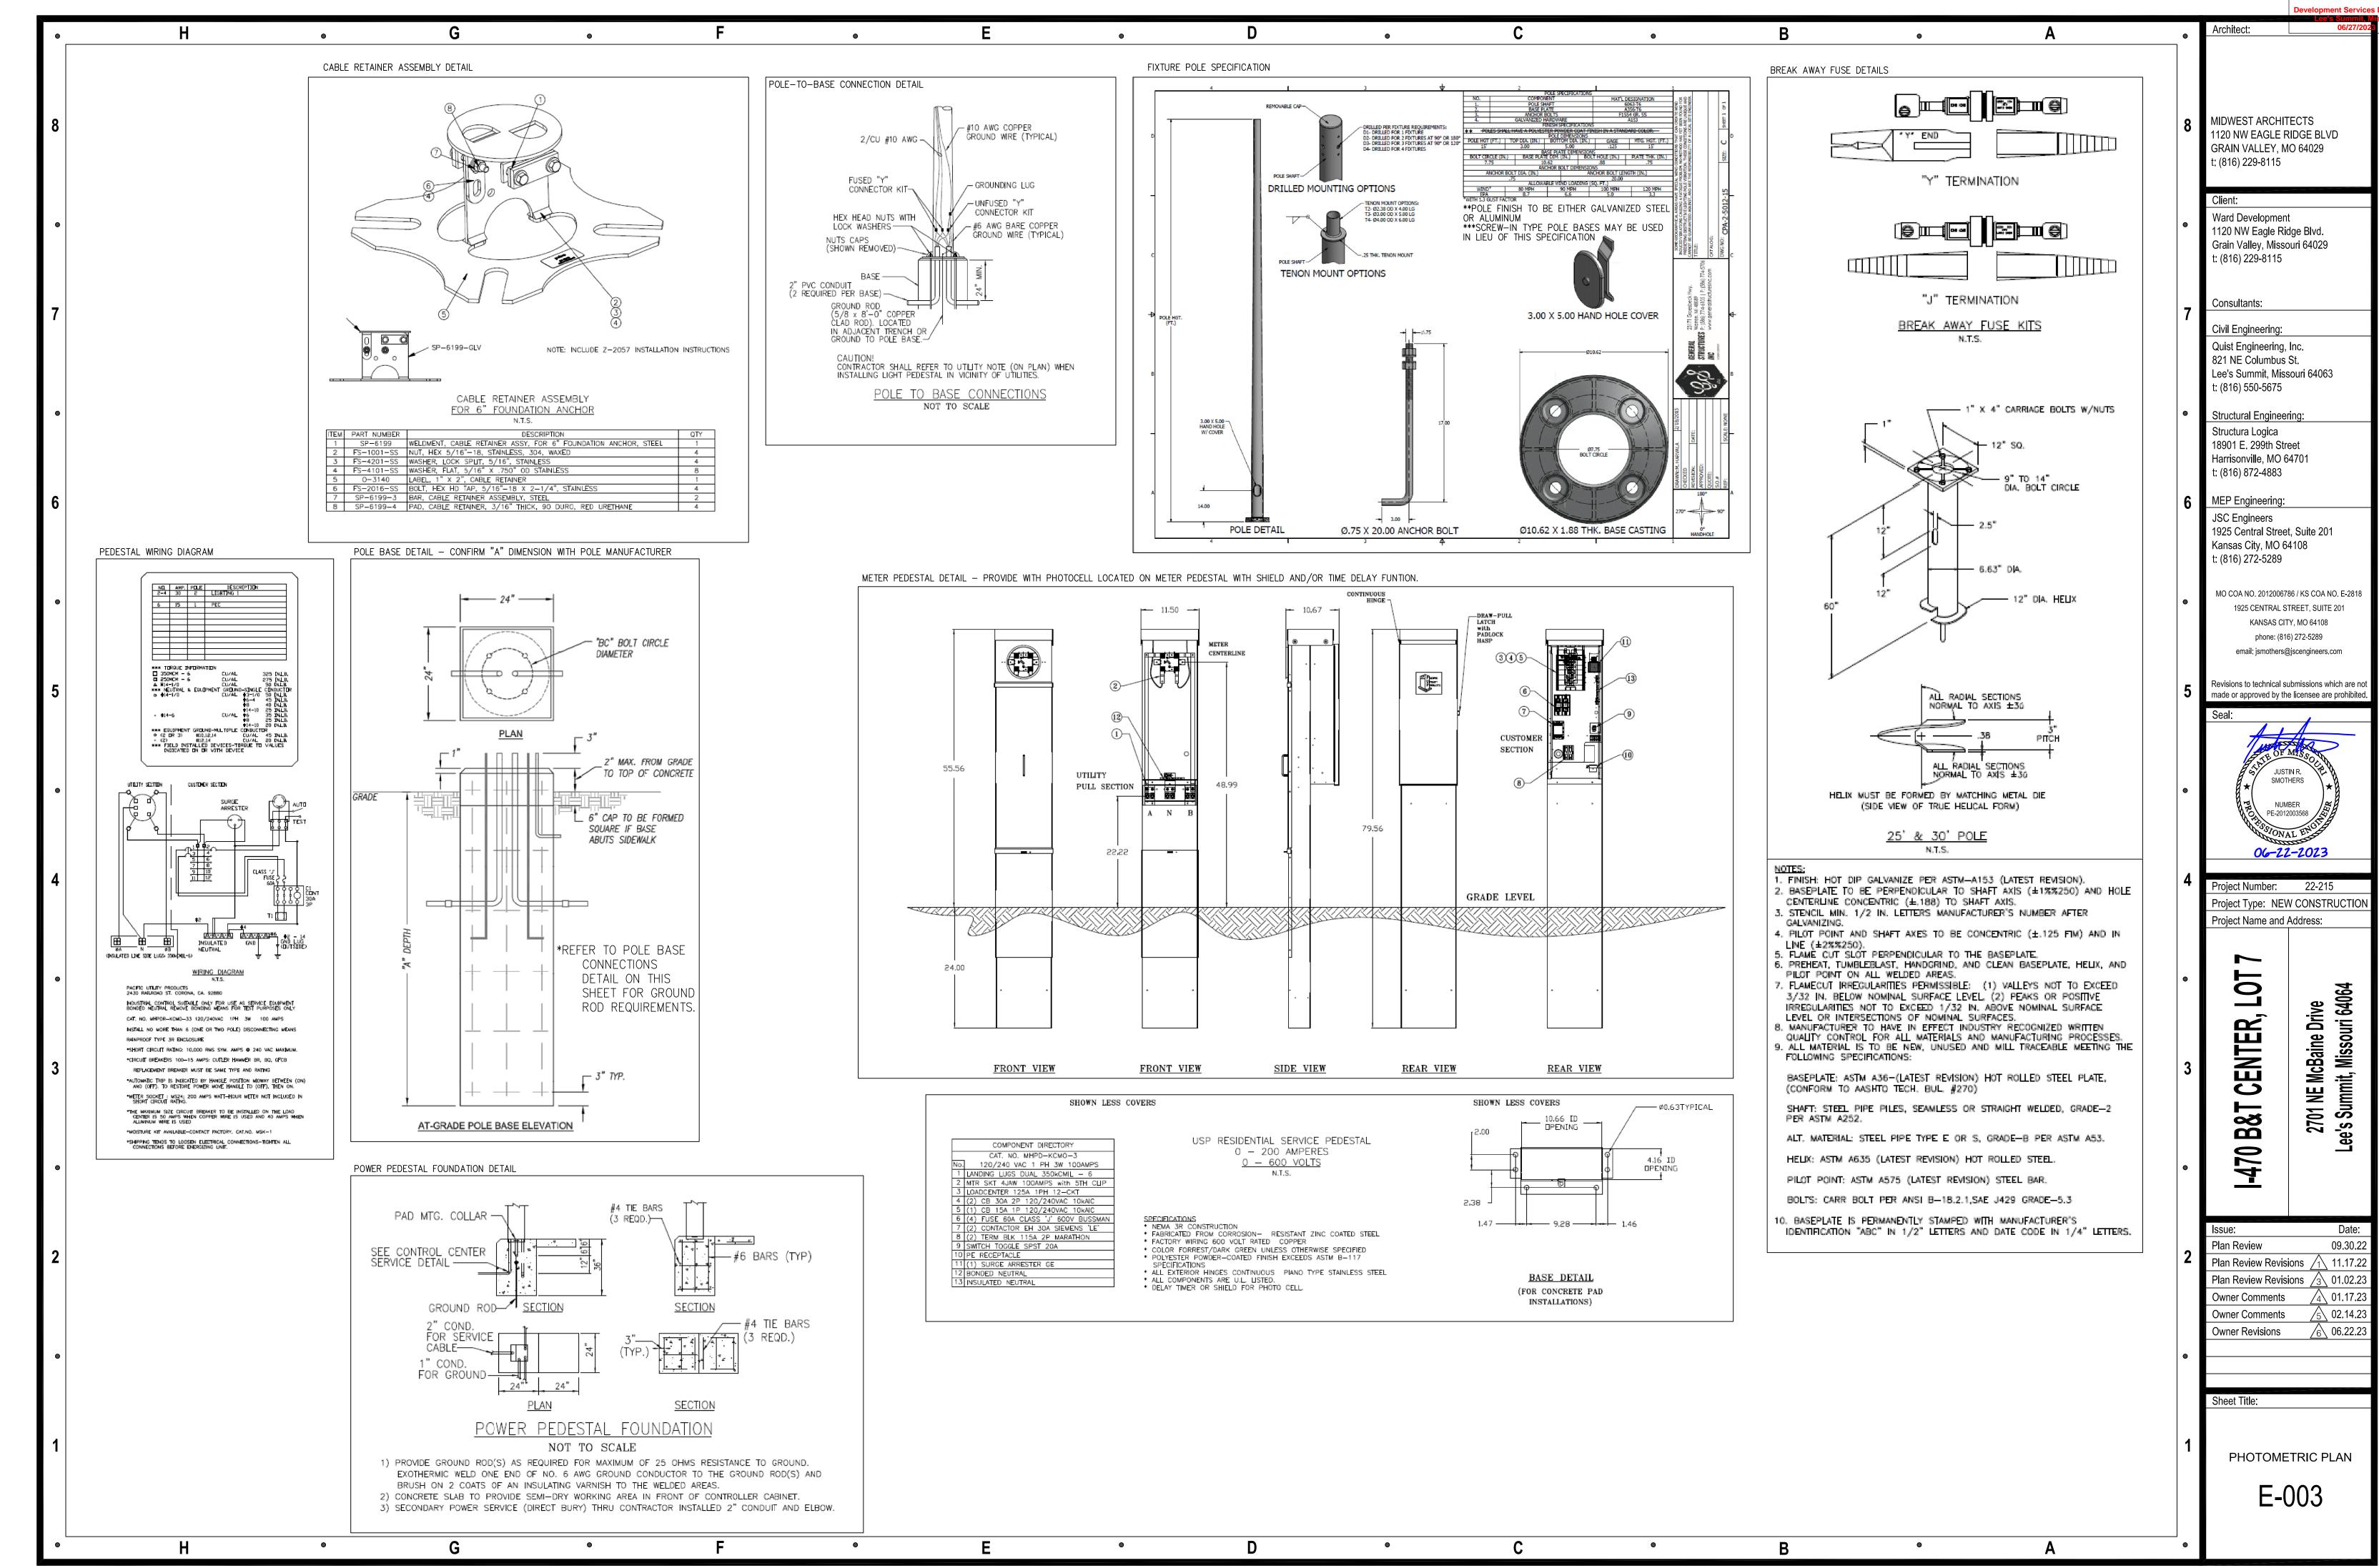

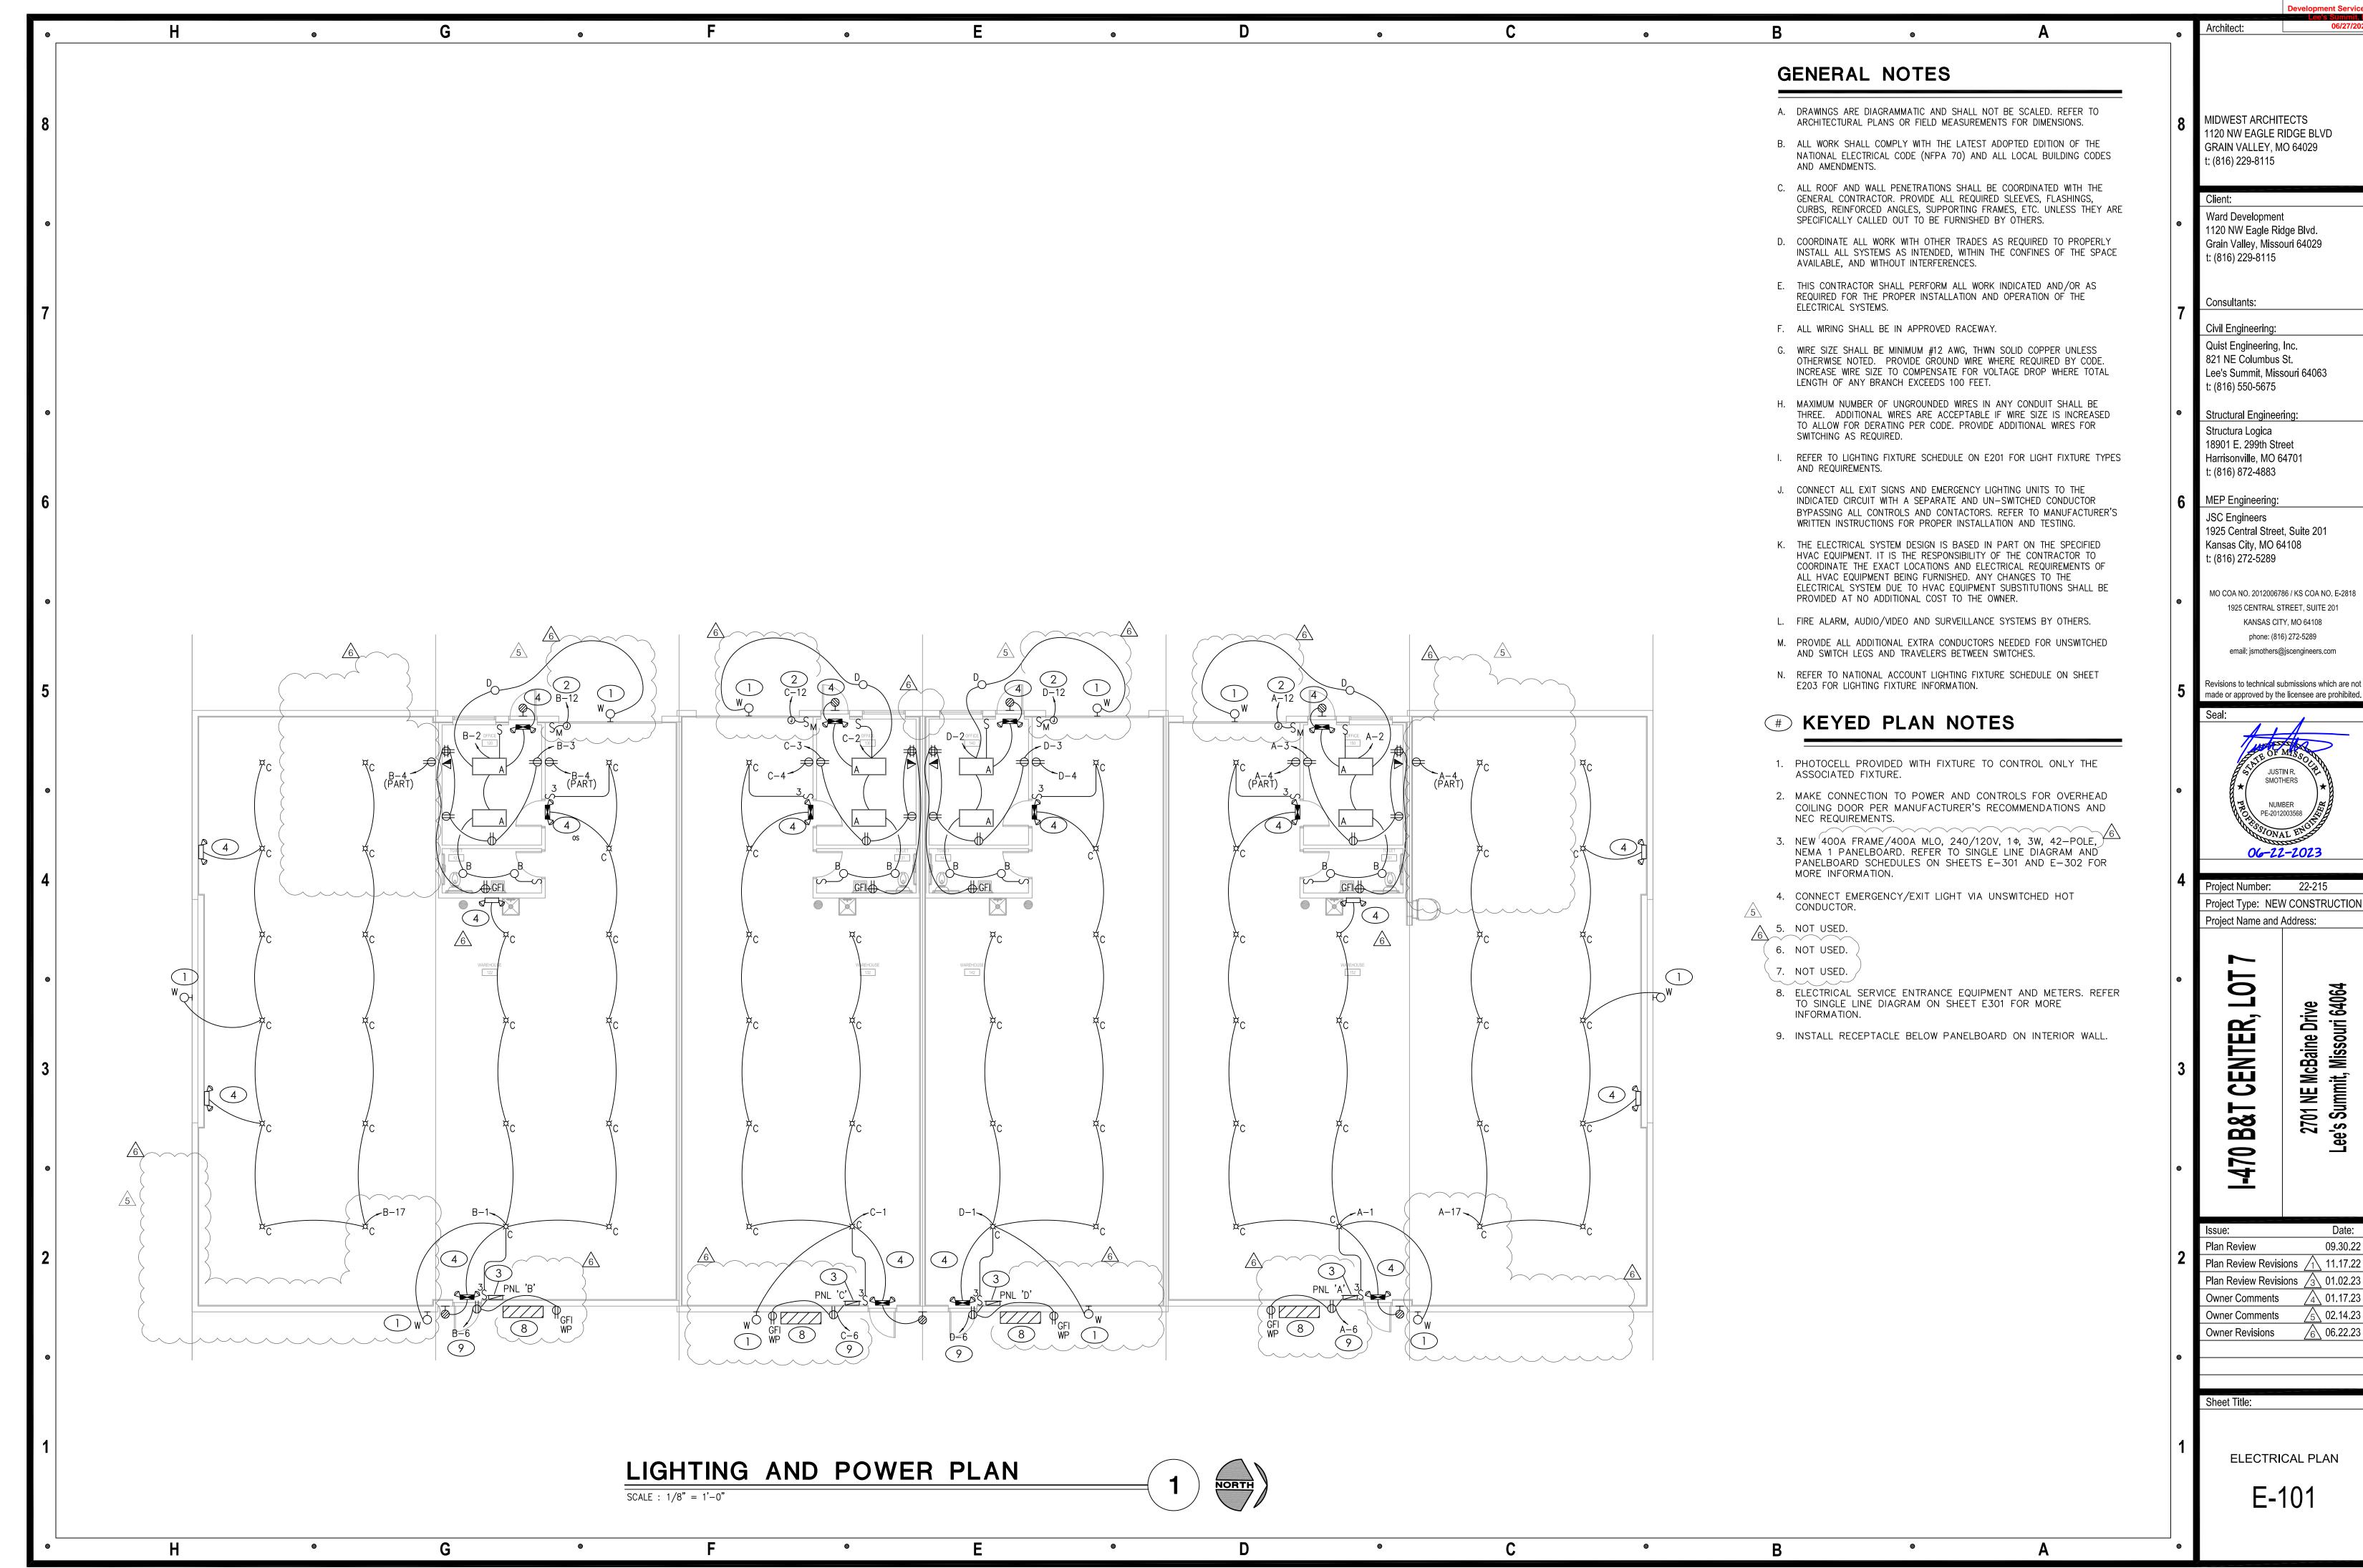

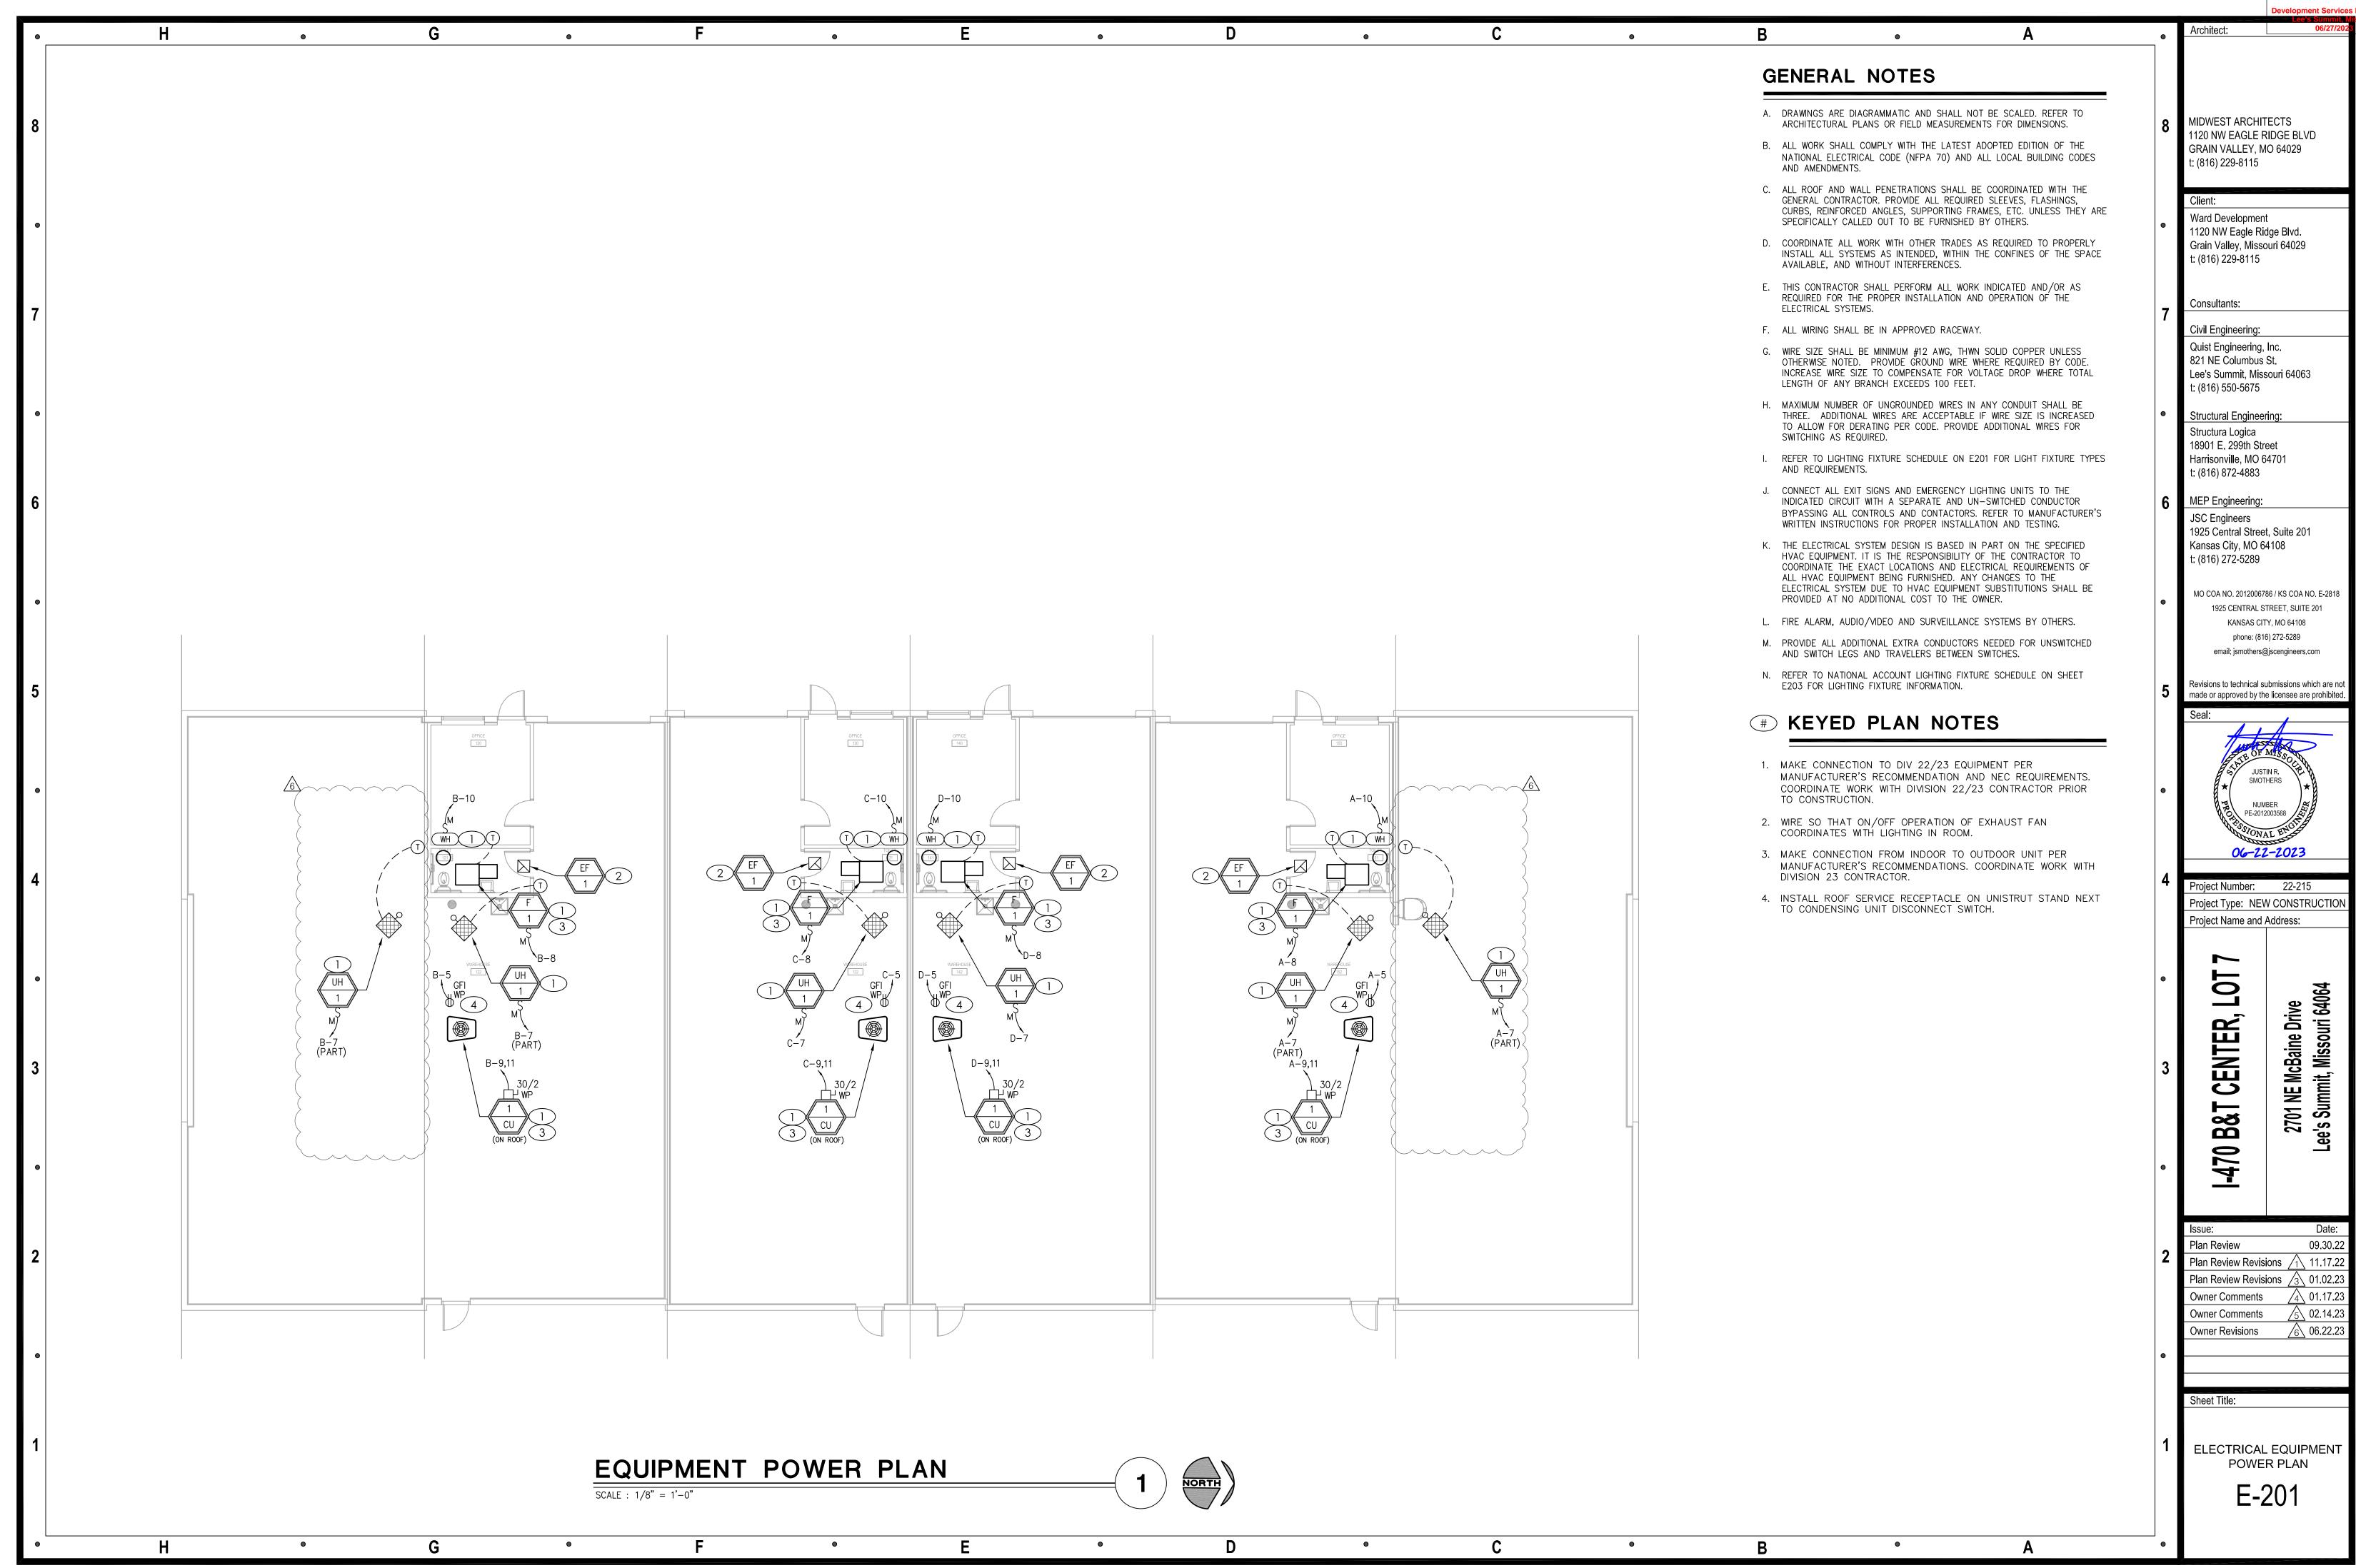

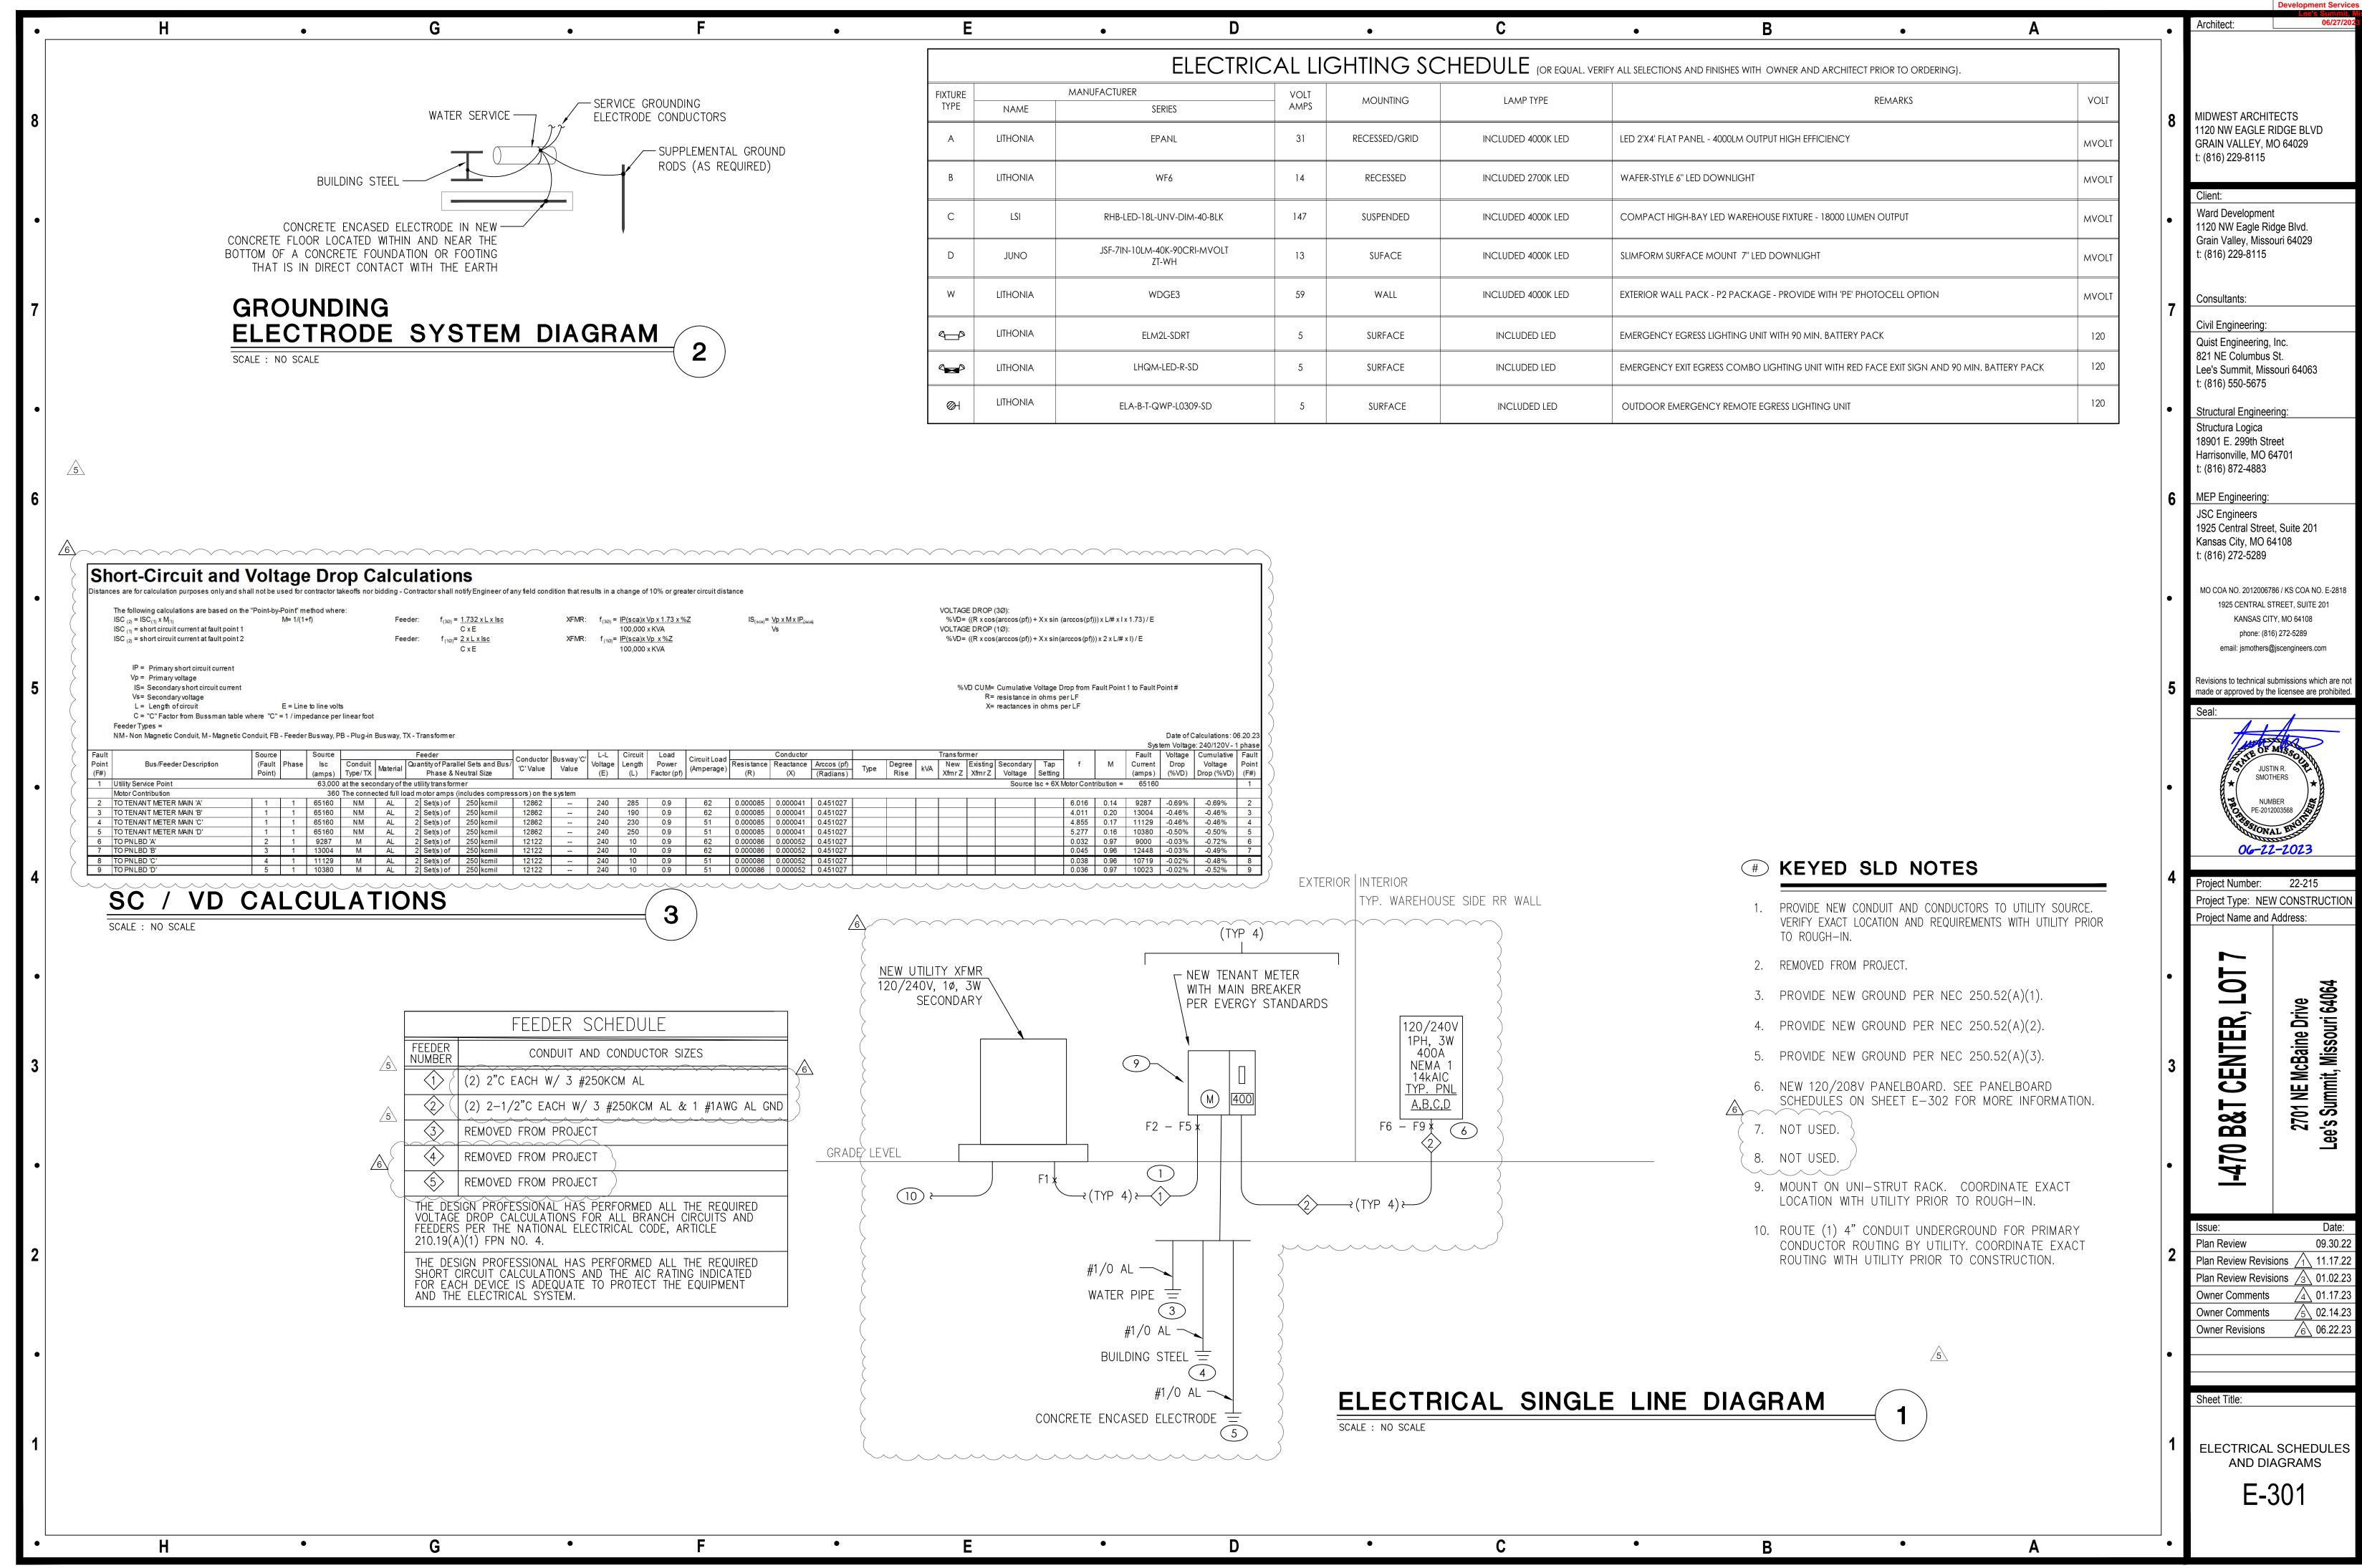

RELEASED FOR
CONSTRUCTION
As Noted on Plans Review

										Development Services D Lee's Summit, Mis
•	H •	G • F	•	<b>E</b> •	D •	С	• B	• A	•	Architect: 06/27/2023
8									8	MIDWEST ARCHITECTS
										1120 NW EAGLE RIDGE BLVD GRAIN VALLEY, MO 64029
										t: (816) 229-8115
										Client:
•									•	Ward Development 1120 NW Eagle Ridge Blvd.
										Grain Valley, Missouri 64029 t: (816) 229-8115
										,
7									7	Consultants:
										Civil Engineering:
										Quist Engineering, Inc. 821 NE Columbus St.
										Lee's Summit, Missouri 64063 t: (816) 550-5675
•									•	Structural Engineering:
										Structura Logica 18901 E. 299th Street
										Harrisonville, MO 64701 t: (816) 872-4883
		<b>\^6</b>							5	
<b>0</b>			>			•			$\left  \begin{array}{c} 6 \end{array} \right $	MEP Engineering:  JSC Engineers
									<b>\</b>	1925 Central Street, Suite 201 Kansas City, MO 64108
			> >						}	t: (816) 272-5289
<b>I</b> .									\ \ \ \ \ \ \ \ \ \ \ \ \ \ \ \ \ \ \	MO COA NO. 2012006786 / KS COA NO. E-2818 1925 CENTRAL STREET, SUITE 201
										KANSAS CITY, MO 64108
			>							phone: (816) 272-5289 email: jsmothers@jscengineers.com
-										Revisions to technical submissions which are not
5			> >						5	made or approved by the licensee are prohibited.
			<b>\</b>						<b>\</b>	A A
										THE OF MISSOLIA
										JUSTIN R. SMOTHERS
										NUMBER PE-2012003568
									}	WAS TOWAL ENGLY
										06-22-2023
4										Project Number: 22-215
			PANELBOARD: A,B (TYP) (NEW) BUS AMPS: 400A	FED FROM: UTILITY METER/MAIN AIC RATING: 14000 FULLY RATED	LINE-SIDE LUGS: MECHANICAL EQUIPMENT GROUND BUS	PANELBOARD: C,D (TYP) (NE	AIC RATING: 14000 FULLY RATED	LINE-SIDE LUGS: MECHANIC. EQUIPMENT GROUND BU		Project Type: NEW CONSTRUCTION Project Name and Address:
			MAIN SIZE/TYPE: MLO VOLTS/PHASE: 120/240V, 1PH, 3W SECTION: 1	SERVES: END WH & OFFICE  MOUNTING: SURFACE  LOCATION: WAREHOUSE SIDE REAR WALL	SERVICE ENTRANCE RATED	MAIN SIZE/TYPE: MLO VOLTS/PHASE: 120/240V, 1PH, 3W SECTION: 1	SERVES: CENTRAL WH & OFFICE MOUNTING: SURFACE LOCATION: WAREHOUSE SIDE REAR WA	LL SERVICE ENTRANCE RATE	-n	
			CKT DESCRIPTION VOLTAMPS	B NO. AMP AMP NO. A B	DESCRIPTION CKT		VOLTAMPS/PHASE WRE BKR P P BKR WIRE VOLTAMPS		KT O	0T 7
			1   LTG - WAREHOUSE 1   1,549		DFFICE / RESTROOM 2 - WAREHOUSE 4	1 LTG - WAREHOUSE 3 RCPT - OFFICE	1,490 10 20 1 1 20 12 167	LTG - OFFICE / RESTROOM  180 RCPT - WAREHOUSE	2 4	— 9 9 € 1
			5 RCPT - ROOF SERVICE 180 7 *PWR - UNIT HTRS	12 20 1 1 20 12 360 RCPT- 1,200 12 20 1 1 20 12 924 *PWR-	- PANELBOARD 6 - FURNACE 8	5 RCPT - ROOF SERVICE 7 *PWR - UNIT HEATER	180     12     20     1     1     20     12     360       600     12     20     1     1     20     12	RCPT - PANELBOARD  924 *PWR - FURNACE	6 8	ER, ne Driv Souri 6
			9 *PWR - CU-1 2,292 11 210 210	2,292 1 20 12 1,500 *PWR - C 1 20 12 800 PWR - C	- WATER HEATER 10 OVERHEAD DOOR 12	9 *PWR - CU-1 11 13 SPARE	2,292     10     30     2     1     20     12     1,500       2,292     20     1     1     20     12	*PWR - WATER HEATER  800 PWR - OVERHEAD DOOR  SPARE	10 12 144	NTE Baine Misso
3			> <del>                                    </del>	210         1         20         SPARE           10         20         1         1         20         SPARE	16	15 SPARE 17 SPARE	20 1 1 20	SPARE .	3	Ĭ Ĭ Ĭ Ĭ
		,	19 SPARE 21 PROVISIONAL SPACE		SIONAL SPACE 22	19 SPARE 21 PROVISIONAL SPACE	20 1 1 20	SPARE 2 PROVISIONAL SPACE 2	20 222	
			23 PROVISIONAL SPACE 25 PROVISIONAL SPACE 27 PROVISIONAL SPACE	1 1 PROVIS	SIONAL SPACE 24 SIONAL SPACE 26 SIONAL SPACE 28	23 PROVISIONAL SPACE 25 PROVISIONAL SPACE 27 PROVISIONAL SPACE	1 1 1	PROVISIONAL SPACE PROVISIONAL SPACE PROVISIONAL SPACE	24 26 28	<b>8</b> 27
			29 PROVISIONAL SPACE 31 PROVISIONAL SPACE	1 1 PROVIS 1 1 PROVIS	SIONAL SPACE 30 SIONAL SPACE 32	29 PROVISIONAL SPACE 31 PROVISIONAL SPACE	1 1 1	PROVISIONAL SPACE :	30	-470 L
			33 PROVISIONAL SPACE 35 PROVISIONAL SPACE 37 PROVISIONAL SPACE	1 1 PROVIS	SIONAL SPACE 34 SIONAL SPACE 36 SIONAL SPACE 38	<ul><li>33 PROVISIONAL SPACE</li><li>35 PROVISIONAL SPACE</li><li>37 PROVISIONAL SPACE</li></ul>	1 1 1	PROVISIONAL SPACE PROVISIONAL SPACE  PROVISIONAL SPACE  ;	34 36 39	<del>'</del>
			37 PROVISIONAL SPACE 39 PROVISIONAL SPACE 41 PROVISIONAL SPACE	1 1 PROVIS	SIONAL SPACE 38 SIONAL SPACE 40 SIONAL SPACE 42	37 PROVISIONAL SPACE 39 PROVISIONAL SPACE 41 PROVISIONAL SPACE	1 1 1 1 1 1 1 1 1 1 1 1 1 1 1 1 1 1 1 1	PROVISIONAL SPACE  PROVISIONAL SPACE  PROVISIONAL SPACE	10 10 10 10 10 10 10 10 10 10 10 10 10 1	legue
			SUBTOTAL 6,054		SUBTOTAL	SUBTOTAL  TOTAL PHASE A - VA   5,989   LOAD	3,962 4,152 2,027			Issue: Date: Plan Review 09.30.22
2			AMPS 67 COOLING HEATING	5,508         1.00         REFRIG         1.00           1,200         0         SIGN/DISP         1.25		AMPS 50 COOLING TOTAL PHASE B - VA 6,056 HEATING	G 5,508 1.00 REFRIG SIGN/DISP	1.00 1.25	$  \rangle $	Plan Review Revisions 11.17.22 Plan Review Revisions 3 01.02.23
			AMPS 59 LIGHTING TOTAL PNLBD - VA 15,127 RECEPTACLES	3,959 1.25 KITCHEN 1.00 2,160 1.0/.5 EXISTING 1.00		AMPS 50 LIGHTIN TOTAL PNLBD - VA 12,045 RECEPT AMPS 50 MOTORS	ACLES 1,980 1.0/.5 EXISTING	1.00 1.00 1.25 TOTAL DEMAND		Owner Comments $4$ 01.17.23
			AMPS 63 MOTORS SUPP HEAT MISC EQUIP	800     1.00     LRG MOTOR     1.25       1,500     1.00     SHOW WNDW     1.25       1.00     LTG TRACK     1.00	14,917 VA	AMPS 50 MOTORS SUPP HI MISC EQ	EAT 1.00 SHOWWNDW 1	1.25 TOTAL DEMAND 500 1.25 12,234 VA 1.00 51 A		Owner Comments $\sqrt{5}$ 02.14.23 Owner Revisions $\sqrt{6}$ 06.22.23
•			PANELBOARD NOTES  * = HACR-TYPE CIRCUIT BREAKER			PANELBOARD NOTES  * = HACR-TYPE CIRCUIT BREAKER				707 00:22:20
										Sheet Title:
						FIFCTDIC	AL PANEL SCHED		1	ELECTRICAL SCHEDULES
						SCALE : NO SCALE	AL I AILL GOILD	(1)		E-302
										L-30Z
•	Н •	G • F	· •	E •	D •	С	• R	• Δ	•	
	••	<u>-</u>		_	_		D	^		