


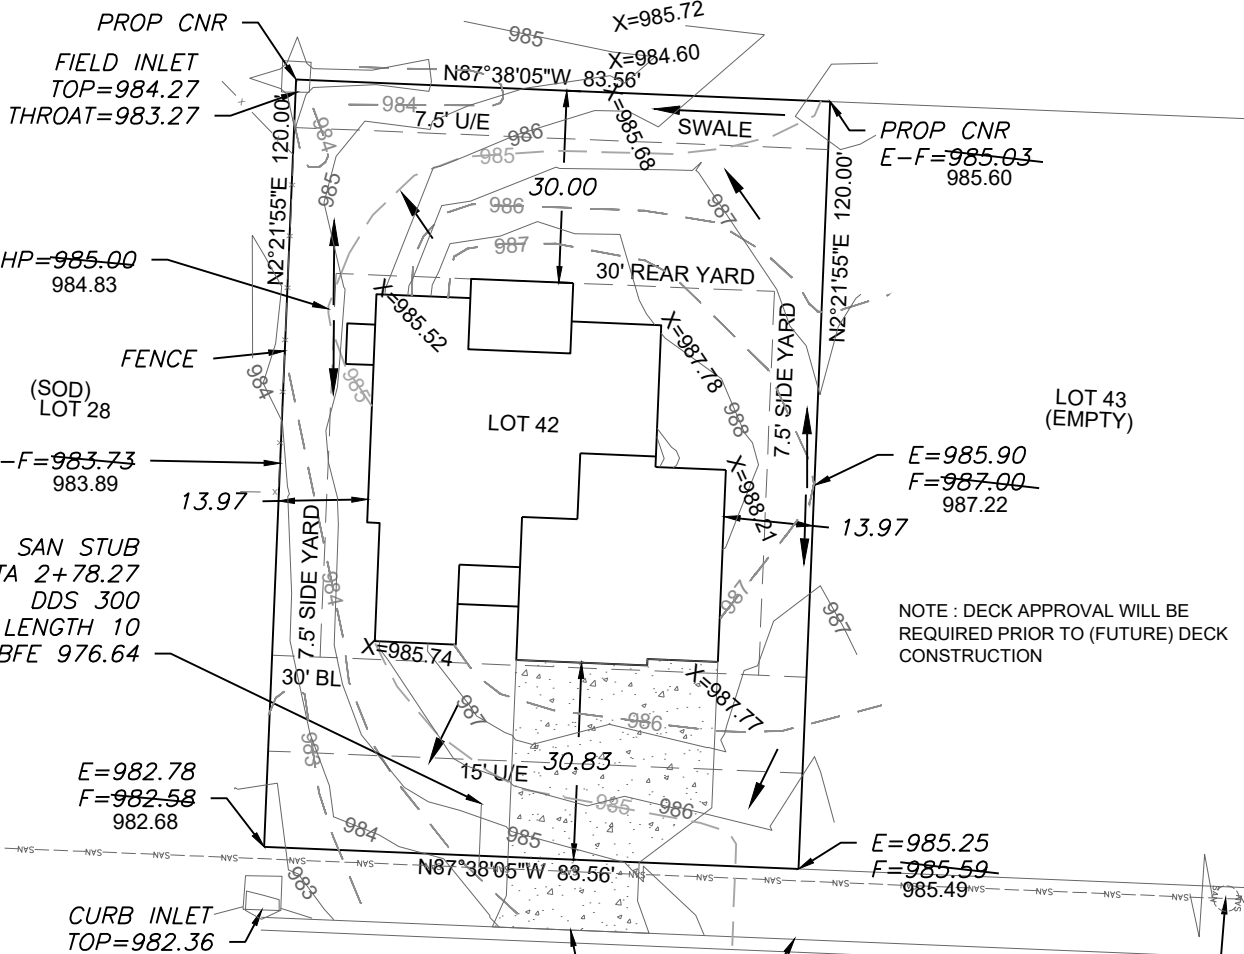

MH B-3
STA 0+00.00
TOP 972.33
FL 964.00
FL 965.00

LEGEND

- Gas Meter
- Telephone or Fiber-Optic Pedestal
- Cable TV Pedestal
- Electric Pedestal
- Light Pole
- Mailbox
- Fire Hydrant
- Water Valve

PROPOSED HOUSE

TOP FOUNDATION = 988.25
GARAGE FLOOR = 986.75
TOP FOOTING = 979.25
BASEMENT FLOOR = 979.58
DRIVE SLOPE = 7.6%

E = EXISTING ELEVATION
F = PROPOSED FINAL ELEVATION
G = ADJACENT GRADE AT EGRESS
U/E = UTILITY EASEMENT
B/L = BUILDING LINE
S/Y/S = SIDE YARD SETBACK
R/Y/S = REAR YARD SETBACK



NOTES

- BUILDER TO VERIFY ALL BUILDING ELEVATIONS AND DIMENSIONS.
- THIS PLOT PLAN DOES NOT CONSTITUTE A BOUNDARY SURVEY.
- THE EASEMENTS SHOWN ON THIS PLOT PLAN ARE TAKEN FROM THE FINAL PLAT. EASEMENTS MAY EXIST.

PROPOSED CONTOURS
AS-GRADED CONTOURS

X=###.## = Actual asbuilt ground shots taken on June 27, 2023

Contours shown are asbuilt.

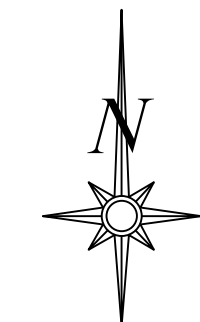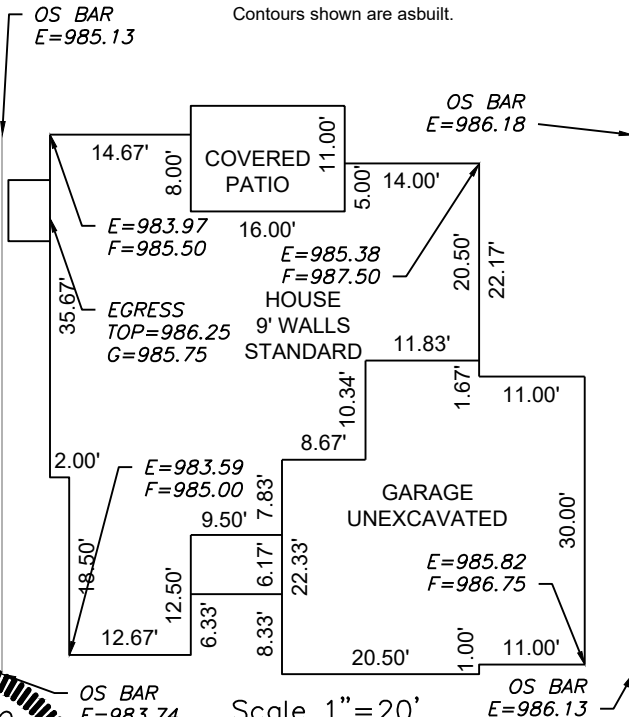

Scale 1"=30'


LOT INFORMATION

10,027 SQ. FT.
MBE = 976.64
ADDRESS
1700 SW 27TH ST

LEGAL DESCRIPTION

LOT 42, WHISPERING WOODS
SECOND PLAT, A SUBDIVISION
AS RECORDED IN LEE'S
SUMMIT, JACKSON COUNTY,
MISSOURI.

ENGINEERING SOLUTIONS
ENGINEERING & SURVEYING
50 SE 30TH STREET
LEE'S SUMMIT, MO 64082
P:(816) 623-9888 F:(816) 623-9849
WWW.ENGINEERINGSOLUTIONSKC.COM

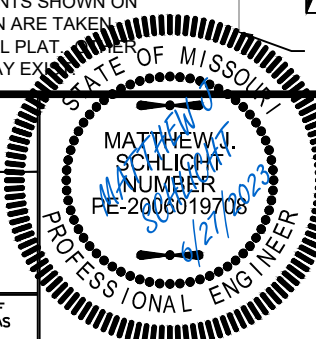

AS-GRADED PLOT PLAN - LOT 42

WHISPERING WOODS SECOND PLAT
LEE'S SUMMIT, JACKSON COUNTY, MISSOURI

WALKER CUSTOM HOMES LLC
PO BOX 3194
INDEPENDENCE, MO 64064

PROJECT NO.	FILE NAME	DATE	SHEET	OF
1	LOT 42, WHISPERING WOODS	10/12/2021	1	1

THIS DRAWING IS NOT VALID UNLESS THE SIGNATURE, DATE AND SEAL OF THE ENGINEER WHO SUPERVISED THE PREPARATION OF THIS DRAWING HAS BEEN AFFIXED HERETO.