

GRID-TYPE CEILINGS

**GENERAL INFORMATION** 

. CONSTRUCTION TO BE IN STRICT ACCORDANCE WITH ALL APPLICABLE BUILDING CODES, LOCAL RULES AND REGULATIONS, AND ALL OTHER CODES, REGULATIONS AND GOVERNING AGENCIES HAVING JURISDICTION WITH ALL APPLICABLE AMENDMENTS UNLESS ALTERED OR CHANGED

THROUGH VARIANCES OF OTHER LEGAL PROCEDURES. . UNLESS OTHERWISE INDICATED, ALL MATERIALS AND EQUIPMENT ON THE DRAWINGS IS TO BE FURNISHED AND INSTALLED BY THE CONTRACTOR.

. COORDINATE ALL CONSTRUCTION PRIOR TO BEGINNING WORK AND SUBMIT PROPOSED WORK SCHEDULE TO THE OWNER & ARCHITECT FOR APPROVAL.

CONTRACTOR SHALL COORDINATE THE WORK OF ALL TRADES, SECURE AND PAY FOR ALL PERMITS, FEES, TAXES, INSPECTIONS & TESTING REQUIRED FOR COMPLETE RELATED WORK. THE GENERAL CONTRACTOR SHALL ALSO BE IN CHARGE OF THE OPERATION FROM THE TIME OF COMMENCEMENT UNTIL THE COMPLETION OF WORK AND TO WHOM ALL ORDERS AND DIRECTIONS SHALL BE GIVEN. . ALL TRADES SHALL BE RESPONSIBLE TO READ ALL

DRAWINGS, DETAILS, & PLANS ASSOCIATED WITH ALL PACKAGES INCLUDING ARCHITECTURAL, STRUCTURAL, MECHANICAL, ELECTRICAL AND PLUMBING ASSOCIATED WITH THIS PROJECT TO ENSURE PROPER COORDINATION. IF ANY CONFLICTS EXIST, THAT TRADE SHALL NOTIFY THE CONTRACTOR OF THE SAME PRIOR TO CONSTRUCTION WHO

SHALL IN TURN NOTIFY THE G.C. . CONTRACTOR SHALL DIRECT ANY DISCREPANCIES TO THE ARCHITECT PRIOR TO CONSTRUCTION, AND CONTRACTOR SHALL BE RESPONSIBLE FOR ANY WORK WHICH PROCEEDS WITHOUT DUE COURSE AND COORDINATION.

. ALL MATERIALS SHOWN OR CALLED FOR ON THESE CONSTRUCTION DOCUMENTS TO BE NEW AND INSTALLED IN ACCORDANCE WITH MANUFACTURER'S RECOMMENDATIONS AND SPECIFICATIONS.

. THE GENERAL CONTRACTOR SHALL SUPPLY DETAILED COMPARISON OF SUBSTITUTION ITEMS REQUESTED FOR ARCHITECT APPROVAL. COMPARISON INFORMATION SHALL INCLUDE & NOT LIMITED TO SIGNIFICANT PRODUCT QUALITIES WHICH MAY ALTER VISUAL AND/OR PERFORMANCE OF A PRODUCT INCLUDING WEIGHT, SIZE, DURABILITY, & SPECIFIC FEATURES & REQUIREMENTS OF SUCH PRODUCT. ALL CEILING HEIGHTS ARE REFERENCED FROM NEAREST FINISHED FLOOR. ALL BEARING ELEVATIONS ARE BASED ON 100'-0" (REFERENCED ELEVATION) TYPICAL UNLESS NOTED

BD. UNLESS NOTED OTHERWISE. 11. ALL EXTERIOR MASONRY WALLS ARE DIMENSIONED FROM EXTERIOR FACE OF MASONRY TO FINISHED FACE OF INTERIOR GYPSUM BOARD UNLESS NOTED OTHERWISE. 12. ALL EXTERIOR CLADDED WALLS (VINYL SIDING, CEMENT BOARD SIDING, WOOD SIDING AND METAL WALL PANELS) A

DIMENSIONED FROM EXTERIOR FACE OF SHEATHING TO FINISHED FACE OF INTERIOR GYPSUM BOARD UNLESS NOTED 3. NO BACK TO BACK JUNCTION BOXES SHALL BE PERMITTED IN SOUND PARTITIONS. 14. ELECTRICAL CONTRACTOR TO PROVIDE ALL SMOKE

DETECTORS, EXIT SIGNS, EMERGENCY LIGHT AND FIRE ALARM SYSTEM IN ACCORDANCE WITH ALL APPLICABLE

ОШ

**COPYRIGHT © BY COLLINS WEBB** ARCHITECTURE, LLC **REVISION DATES:** 


1 City Comments & 08.08.2023



COLLINS WEBB #: 23033

SHEET INDEX / GENERAL INFORMATION

ON REFLECTED CEILING PLAN.

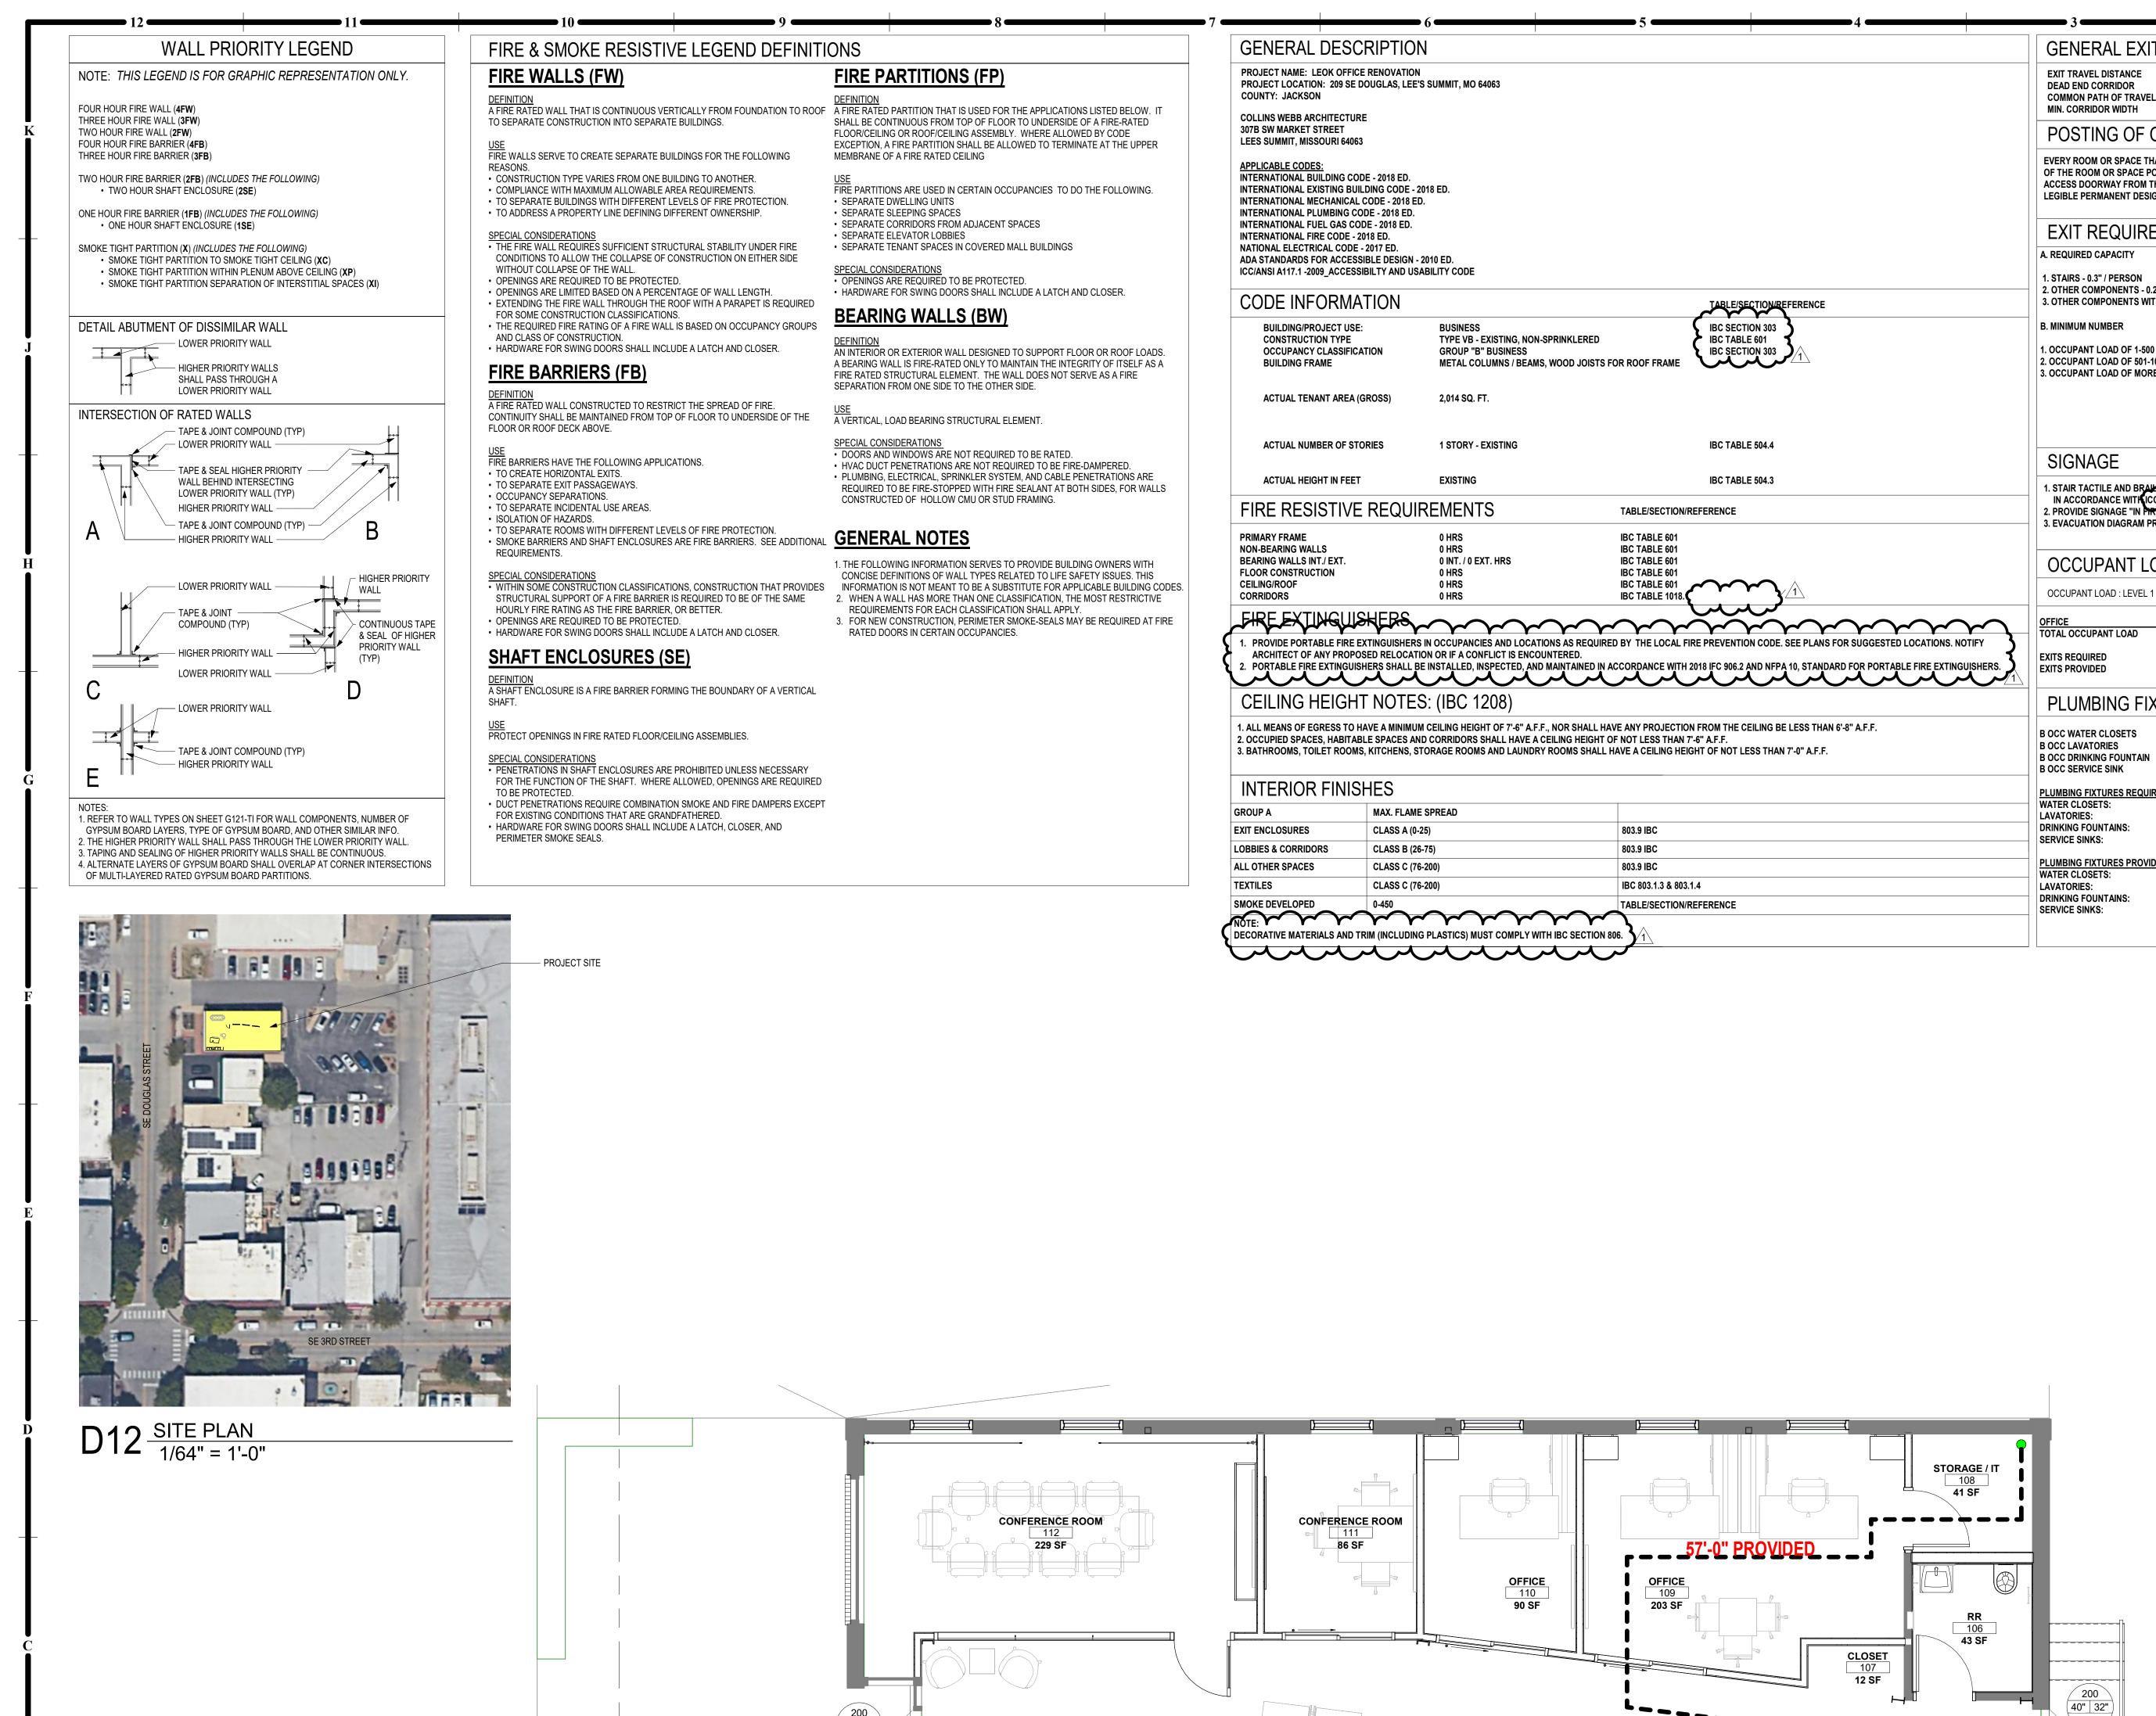

GENERAL EXITING REQUIREMENTS TABLE/SECTION/REFERENCE 250 FEET **SECTION 12.2.6.2** 20 FEET **SECTION 12.2.2.5.1.3** 20' FEET, OR 75' IF OCC. < 50 COMMON PATH OF TRAVEL **SECTION 12.2.5.1.2** 44", OR 36" IF OCC. < 50 **SECTION 12.2.3.8** POSTING OF OCCUPANT LOAD EVERY ROOM OR SPACE THAT IS AN ASSEMBLY OCCUPANCY SHALL HAVE THE OCCUPANT LOAD OF THE ROOM OR SPACE POSTED IN A CONSPICUOUS PLACE, NEAR THE MAIN EXIT OR EXIT ACCESS DOORWAY FROM THE ROOM OR SPACE. POSTED SIGNS SHALL BE OF AN APPROVED LEGIBLE PERMANENT DESIGN AND SHALL BE MAINTAINED BY THE OWNER OR AUTHORIZED AGENT. EXIT REQUIREMENTS TABLE/SECTION/REFERENCE **TABLE 7.3.3.1** 2. OTHER COMPONENTS - 0.2" / PERSON **TABLE 12.2.3.2** 3. OTHER COMPONENTS WITHIN THEATER ROOMS - 0.22" / PERSON 1. OCCUPANT LOAD OF 1-500 PERSONS - 2 EXITS PER STORY **SECTION 7.4.1.1** 2. OCCUPANT LOAD OF 501-1000 PERSONS - 3 EXITS PER STORY **SECTION 7.4.1.2** 3. OCCUPANT LOAD OF MORE THAN 1000 PERSONS - 4 EXITS PER STORY 1. STAIR TACTILE AND BRANCE SIGNAGE ON EACH FLOOR FOR EXIT STAIRWELL, FLOOR DISCHARGE, AND ROOF TOP ACCESS IN ACCORDANCE WITH ICC A117.1

2. PROVIDE SIGNAGE "IN PIRE EMERGENCY DO NOT USE ELEVATOR, USE EXIT STAIRS" IN ACCORDANCE WITH IBC (3002.3)

3. EVACUATION DIAGRAM PROVIDED IN ACCORDANCE WITH IBC 1001.2 OCCUPANT LOAD TABLE/SECTION/REFERENCE OFFICE 14 OCC 150 SF/OCC GROSS @2,014 SF (BUSINESS)
TOTAL OCCUPANT LOAD 14 OCCUPANTS IBC TABLE 1004.5 **IBC TABLE 1006.3.2** 2 EXITS PLUMBING FIXTURE REQUIREMENTS **IBC TABLE 2902.1 B OCC DRINKING FOUNTAIN** = 1/100 PLUMBING FIXTURES REQUIRED 14/40 = 1 REQUIRED 14/100 = 1 REQUIRED = 1 REQUIRED = 2 PROVIDED = 2 PROVIDED = 0 PROVIDED (BOTTLED WATER AND KITCHENETTE WITH SINK ARE PROVIDED) = 1 PROVIDED

MAX. EXIT

**DISTANCE** 

**TRAVEL** 

MAX: 250' - 0"

PROVIDED: 57' - 0"

2BW 2BW 2BW 2BW 2 HOUR BEARING WALL BW 1BW 1BW 1BW 1 HOUR BEARING WALL NUMBER OF OCCUPANTS EXITING 200 40" 

← CALCULATED EXIT EXIT WIDTH WIDTH REQ'D (IN.) PROVIDED (IN.) NUMBER OF OCCUPANTS EXITING 200 CALCULATED EXIT 40" 32" MIN. WIDTH OF **MEANS OF EGRESS** WIDTH REQ'D (IN.) COMPONENT (IN.) EXIT WIDTH -PROVIDED (IN.) FROM ROOM OR LEVEL X = CLEAR WIDTH OF OPENING IN INCHES FIRE RISER CABINET FIRE ALARM CONTROL PANEL FIRE DEPARTMENT CONNECTION KNOX BOX AREA OF RESCUE ASSISTANCE ACCESSIBLE EGRESS COMPONENT **← ← ←** EGRESS PATH INDICATES FIRE EXTINGUISHER CABINET(FE) LOCATION WITH 75'-0" RADIUS COVERAGI DOOR RATING LEGEND (REFER TO DOOR SCHEDULE 20 MIN. DOOR 45 MIN. DOOR

90 MIN. DOOR

FIRE RESISTIVE LEGEND

3FW 3FW 3FW 3 HOUR FIRE WALL

2FW 2FW 2FW 2FW 2 HOUR FIRE WALL

2FB 2FB 2FB 2FB 2 HOUR FIRE BARRIER

1FB 1FB 1FB 1FB 1 HOUR FIRE BARRIER

2S 2S 2S 2 2S 2 HOUR SHAFT ENCLOSURE

1SE 1SE 1SE 1SE 1 HOUR SHAFT ENCLOSURE

**1FP 1FP 1FP 1FP** 1 HOUR FIRE PARTITION


0.5FP 0.5FP 0.5FP 0.5FP 0.5 HOUR FIRE PARTITION

SB SB SB SB 1 HOUR SMOKE BARRIER

0.5X 0.5X 0.5X 0.5X 0.5X 0.5 HOUR CORRIDOR PARTITION


20 LE **COPYRIGHT** © BY **COLLINS WEBB** 

ARCHITECTURE, LLC **REVISION DATES:** 1 City Comments & 08.08.2023 VE Revisions

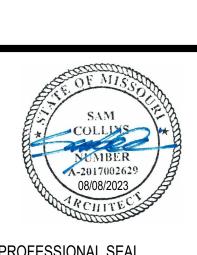

LIFE SAFETY PLANS AND PROJECT INFO.

A10 1ST FLOOR - LIFE SAFETY 1/4" = 1'-0"

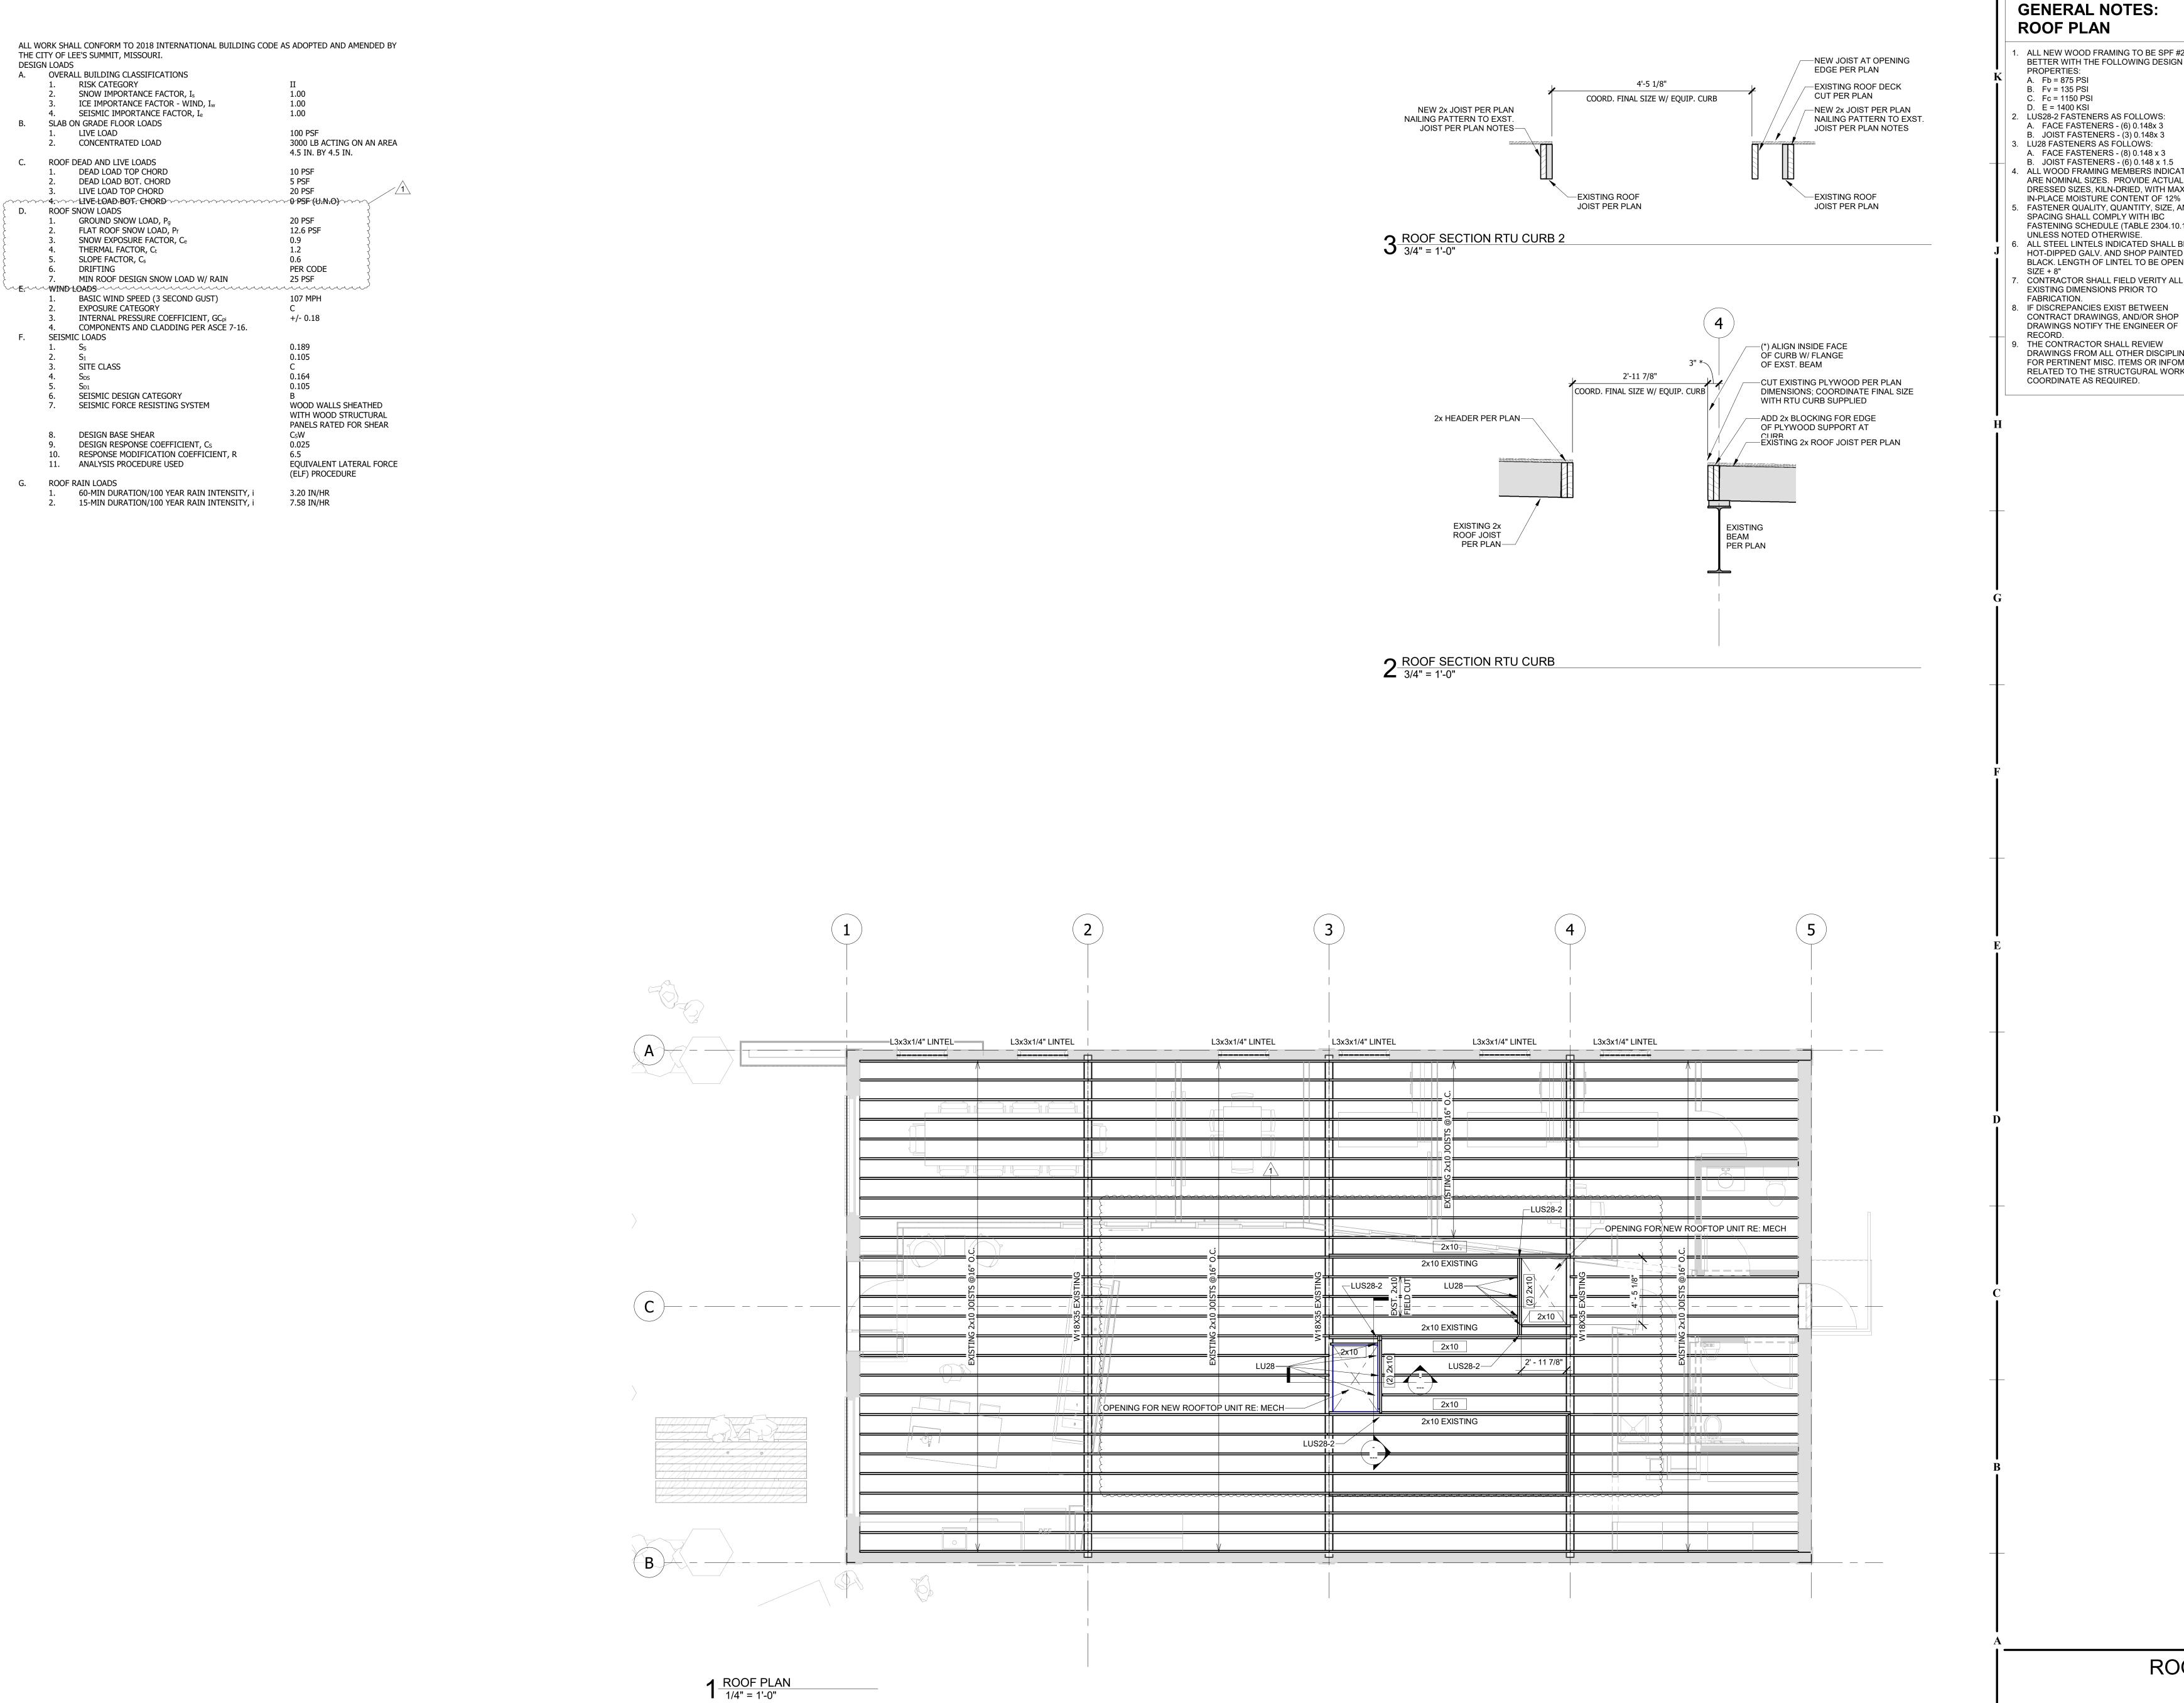

**GENERAL NOTES:** 

. ALL NEW WOOD FRAMING TO BE SPF #2 OR BETTER WITH THE FOLLOWING DESIGN

PROPERTIES: A. Fb = 875 PSI

B. Fv = 135 PSI C. Fc = 1150 PSI D. E = 1400 KSI 2. LUS28-2 FASTENERS AS FOLLOWS:

A. FACE FASTENERS - (6) 0.148x 3 B. JOIST FASTENERS - (3) 0.148x 3 3. LU28 FASTENERS AS FOLLOWS: A. FACE FASTENERS - (8) 0.148 x 3 B. JOIST FASTENERS - (6) 0.148 x 1.5 4. ALL WOOD FRAMING MEMBERS INDICATED

ARE NOMINAL SIZES. PROVIDE ACTUAL DRESSED SIZES, KILN-DRIED, WITH MAXIMUM IN-PLACE MOISTURE CONTENT OF 12% . FASTENER QUALITY, QUANTITY, SIZE, AND SPACING SHALL COMPLY WITH IBC FASTENING SCHEDULE (TABLE 2304.10.1)

UNLESS NOTED OTHERWISE. 6. ALL STEEL LINTELS INDICATED SHALL BE HOT-DIPPED GALV. AND SHOP PAINTED BLACK. LENGTH OF LINTEL TO BE OPENING

. CONTRACTOR SHALL FIELD VERITY ALL EXISTING DIMENSIONS PRIOR TO FABRICATION. 8. IF DISCREPANCIES EXIST BETWEEN CONTRACT DRAWINGS, AND/OR SHOP


9. THE CONTRACTOR SHALL REVIEW DRAWINGS FROM ALL OTHER DISCIPLINES FOR PERTINENT MISC. ITEMS OR INFOMATION RELATED TO THE STRUCTGURAL WORK AND COORDINATE AS REQUIRED.

DRAWINGS


COPYRIGHT © BY **COLLINS WEBB** ARCHITECTURE, LLC

**REVISION DATES:** CITY COMMENTS &

**REVISIONS** 

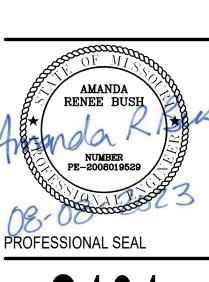

ROOF PLAN/DETAILS

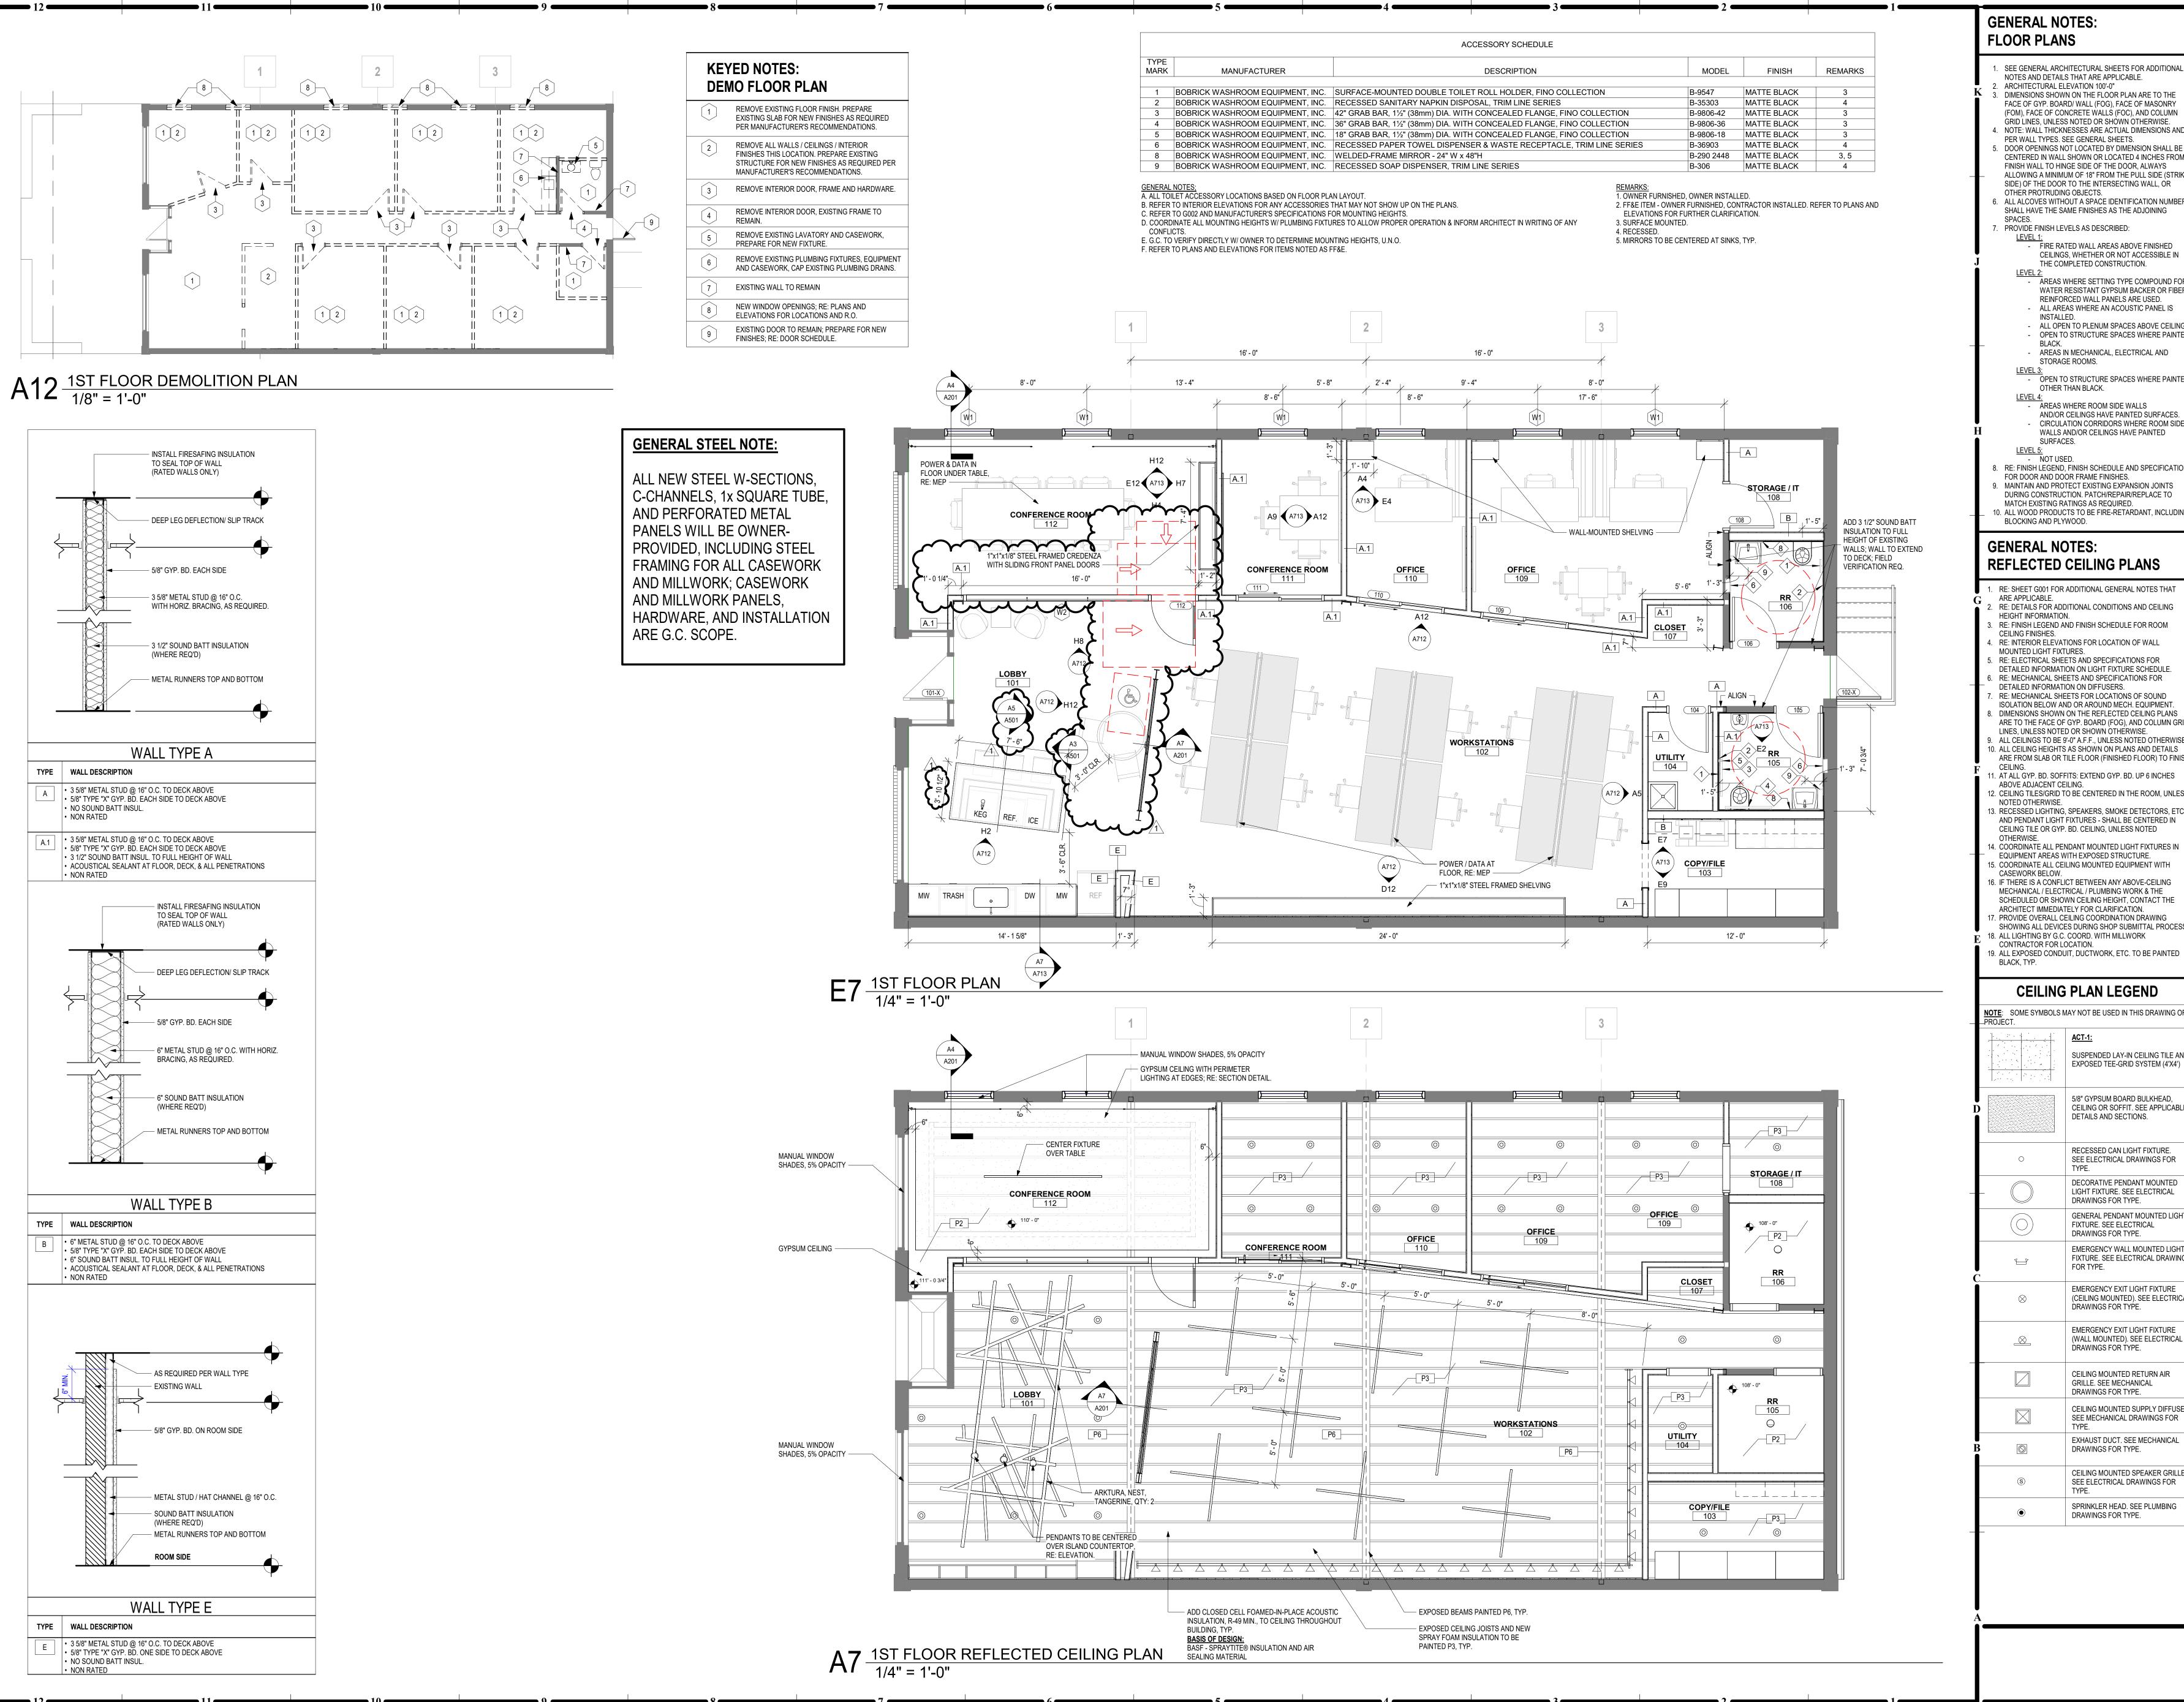

**GENERAL NOTES: FLOOR PLANS** 

- . SEE GENERAL ARCHITECTURAL SHEETS FOR ADDITIONAL NOTES AND DETAILS THAT ARE APPLICABLE. . ARCHITECTURAL ELEVATION 100'-0" B. DIMENSIONS SHOWN ON THE FLOOR PLAN ARE TO THE FACE OF GYP. BOARD/ WALL (FOG), FACE OF MASONRY
- (FOM), FACE OF CONCRETE WALLS (FOC), AND COLUMN GRID LINES, UNLESS NOTED OR SHOWN OTHERWISE. I. NOTE: WALL THICKNESSES ARE ACTUAL DIMENSIONS AND
- PER WALL TYPES. SEE GENERAL SHEETS. 5. DOOR OPENINGS NOT LOCATED BY DIMENSION SHALL BE CENTERED IN WALL SHOWN OR LOCATED 4 INCHES FROM FINISH WALL TO HINGE SIDE OF THE DOOR, ALWAYS ALLOWING A MINIMUM OF 18" FROM THE PULL SIDE (STRIKE SIDE) OF THE DOOR TO THE INTERSECTING WALL, OR OTHER PROTRUDING OBJECTS.
- 6. ALL ALCOVES WITHOUT A SPACE IDENTIFICATION NUMBER SHALL HAVE THE SAME FINISHES AS THE ADJOINING PROVIDE FINISH LEVELS AS DESCRIBED:
- CEILINGS, WHETHER OR NOT ACCESSIBLE IN THE COMPLETED CONSTRUCTION. AREAS WHERE SETTING TYPE COMPOUND FOR

FIRE RATED WALL AREAS ABOVE FINISHED

- WATER RESISTANT GYPSUM BACKER OR FIBER REINFORCED WALL PANELS ARE USED. ALL AREAS WHERE AN ACOUSTIC PANEL IS INSTALLED.
- ALL OPEN TO PLENUM SPACES ABOVE CEILINGS. OPEN TO STRUCTURE SPACES WHERE PAINTED
- AREAS IN MECHANICAL. ELECTRICAL AND STORAGE ROOMS.
- OPEN TO STRUCTURE SPACES WHERE PAINTED OTHER THAN BLACK.
- AREAS WHERE ROOM SIDE WALLS AND/OR CEILINGS HAVE PAINTED SURFACES. CIRCULATION CORRIDORS WHERE ROOM SIDE WALLS AND/OR CEILINGS HAVE PAINTED SURFACES.
- LEVEL 5: NOT USED. RE: FINISH LEGEND, FINISH SCHEDULE AND SPECIFICATIONS FOR DOOR AND DOOR FRAME FINISHES.
- 9. MAINTAIN AND PROTECT EXISTING EXPANSION JOINTS DURING CONSTRUCTION. PATCH/REPAIR/REPLACE TO MATCH EXISTING RATINGS AS REQUIRED. 0. ALL WOOD PRODUCTS TO BE FIRE-RETARDANT, INCLUDING BLOCKING AND PLYWOOD.

## **GENERAL NOTES: REFLECTED CEILING PLANS**

- 1. RE: SHEET G001 FOR ADDITIONAL GENERAL NOTES THAT ARE APPLICABLE. RE: DETAILS FOR ADDITIONAL CONDITIONS AND CEILING HEIGHT INFORMATION. 3. RE: FINISH LEGEND AND FINISH SCHEDULE FOR ROOM
- CEILING FINISHES. 4. RE: INTERIOR ELEVATIONS FOR LOCATION OF WALL MOUNTED LIGHT FIXTURES. . RE: ELECTRICAL SHEETS AND SPECIFICATIONS FOR
- DETAILED INFORMATION ON LIGHT FIXTURE SCHEDULE. RE: MECHANICAL SHEETS AND SPECIFICATIONS FOR DETAILED INFORMATION ON DIFFUSERS. 7. RE: MECHANICAL SHEETS FOR LOCATIONS OF SOUND
- ISOLATION BELOW AND OR AROUND MECH. EQUIPMENT. DIMENSIONS SHOWN ON THE REFLECTED CEILING PLANS ARE TO THE FACE OF GYP. BOARD (FOG), AND COLUMN GRID LINES, UNLESS NOTED OR SHOWN OTHERWISE. 9. ALL CEILINGS TO BE 9'-0" A.F.F., UNLESS NOTED OTHERWISE
- ARE FROM SLAB OR TILE FLOOR (FINISHED FLOOR) TO FINISH 1. AT ALL GYP. BD. SOFFITS: EXTEND GYP. BD. UP 6 INCHES ABOVE ADJACENT CEILING.
- 12. CEILING TILES/GRID TO BE CENTERED IN THE ROOM, UNLESS NOTED OTHERWISE. RECESSED LIGHTING, SPEAKERS, SMOKE DETECTORS, ETC AND PENDANT LIGHT FIXTURES - SHALL BE CENTERED IN
- CEILING TILE OR GYP. BD. CEILING, UNLESS NOTED 14. COORDINATE ALL PENDANT MOUNTED LIGHT FIXTURES IN EQUIPMENT AREAS WITH EXPOSED STRUCTURE. 15. COORDINATE ALL CEILING MOUNTED EQUIPMENT WITH
- 16. IF THERE IS A CONFLICT BETWEEN ANY ABOVE-CEILING MECHANICAL / ELECTRICAL / PLUMBING WORK & THE SCHEDULED OR SHOWN CEILING HEIGHT, CONTACT THE ARCHITECT IMMEDIATELY FOR CLARIFICATION. 7. PROVIDE OVERALL CEILING COORDINATION DRAWING
- SHOWING ALL DEVICES DURING SHOP SUBMITTAL PROCESS. 18. ALL LIGHTING BY G.C. COORD. WITH MILLWORK CONTRACTOR FOR LOCATION. 19. ALL EXPOSED CONDUIT, DUCTWORK, ETC. TO BE PAINTED

# **CEILING PLAN LEGEND OTE**: SOME SYMBOLS MAY NOT BE USED IN THIS DRAWING OR

SUSPENDED LAY-IN CEILING TILE AND EXPOSED TEE-GRID SYSTEM (4'X4') 5/8" GYPSUM BOARD BULKHEAD, CEILING OR SOFFIT. SEE APPLICABLE DETAILS AND SECTIONS. RECESSED CAN LIGHT FIXTURE. SEE ELECTRICAL DRAWINGS FOR DECORATIVE PENDANT MOUNTED LIGHT FIXTURE. SEE ELECTRICAL DRAWINGS FOR TYPE. GENERAL PENDANT MOUNTED LIGHT FIXTURE. SEE ELECTRICAL DRAWINGS FOR TYPE. **EMERGENCY WALL MOUNTED LIGHT** FIXTURE. SEE ELECTRICAL DRAWINGS FOR TYPE. EMERGENCY EXIT LIGHT FIXTURE (CEILING MOUNTED). SEE ELECTRICAL DRAWINGS FOR TYPE. EMERGENCY EXIT LIGHT FIXTURE (WALL MOUNTED). SEE ELECTRICAL

DRAWINGS FOR TYPE. CEILING MOUNTED RETURN AIR GRILLE. SEE MECHANICAL DRAWINGS FOR TYPE. CEILING MOUNTED SUPPLY DIFFUSER. SEE MECHANICAL DRAWINGS FOR EXHAUST DUCT. SEE MECHANICAL

CEILING MOUNTED SPEAKER GRILLE.

SEE ELECTRICAL DRAWINGS FOR

SPRINKLER HEAD. SEE PLUMBING

DRAWINGS FOR TYPE.

DRAWINGS FOR TYPE.

TYPE.

08/08/2023 PROFESSIONAL SEAL

COLLINS WEBB #:

A-2017002629

ОШ

**COPYRIGHT © BY** 

**REVISION DATES:** 


ARCHITECTURE, LLC

VE Revisions

1 City Comments & 08.08.2023

**COLLINS WEBB** 


PLAN & RCP

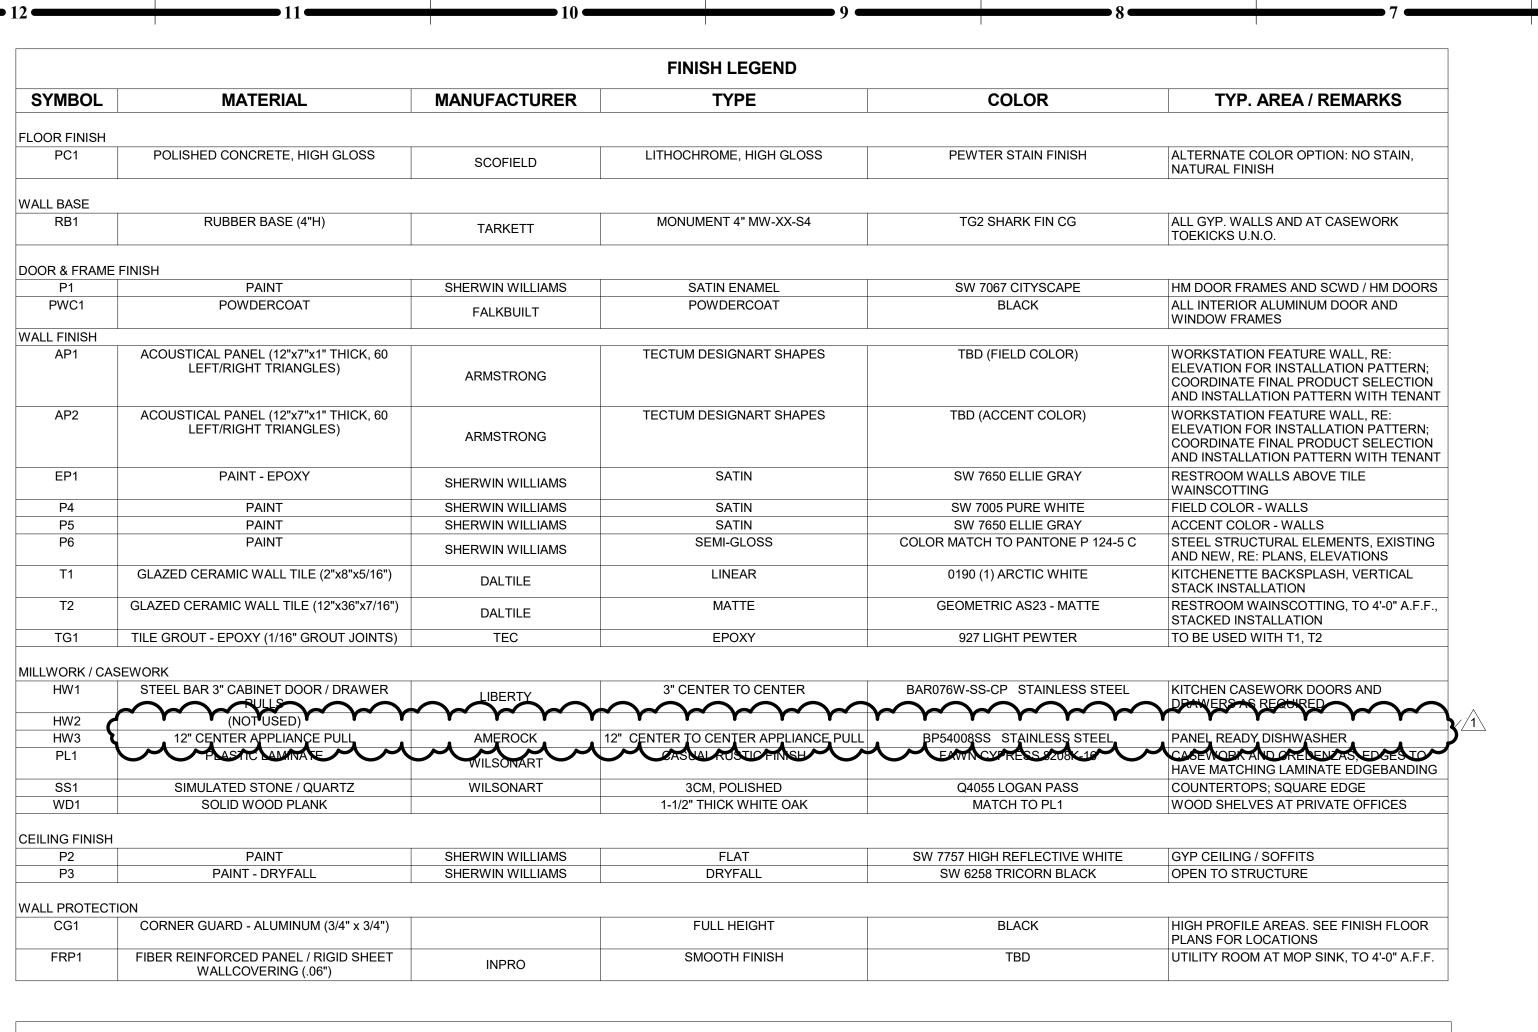


					ROOM	I FINISH SCHEDULE						
		FLO	ORS		WAI	LL FINISH			С	ASEWORK		
RM. NO.	ROOM NAME	FLOOR	WALL BASE	NORTH WALL	EAST WALL	SOUTH WALL	WEST WALL	CEILING FINISH	COUNTERTOP	BASE CABINET	UPPER CABINET	REMARKS
101	LOBBY	PC1	RB1	P3,P4,P6	P3,P4,P6	P3,T1	P3,P4,P6	P3	SS1	PL1	PL1	_
102	WORKSTATIONS	PC1	RB1	P3,P4,P6	P3,P4,P6	P3, AP1, AP2	P3,P4,P6	P3	PL1	PL1	-	
103	COPY/FILE	PC1	RB1	P3,P4	P3,P4	P3,P4	P3,P4	P3	SS1	PL1	PL1	
104	UTILITY	PC1	RB1	P3,P4	P3,P4	P3,P4, FRP1	P3,P4, FRP1	P3	-	-	-	1
105	RR	PC1	-	EP1, T2	EP1, T2	EP1, T2	EP1, T2	P2	-	-	-	
106	RR	PC1	-	EP1, T2	EP1, T2	EP1, T2	EP1, T2	P2	-	-	-	
107	CLOSET	PC1	RB1	P3	P3	-	P3	P3	-	-	-	
108	STORAGE / IT	PC1	RB1	P3,P4	P3,P4	P3,P4	P3,P4	P3	-	-	-	
109	OFFICE	PC1	RB1	P3,P4	P3,P4	P3,P4	P3,P4	P3	-	-	-	
110	OFFICE	PC1	RB1	P3,P4	P3,P4	P3,P4	P3,P4	P3	-	-	-	
111	CONFERENCE ROOM	PC1	RB1	P3,P4	P3,P4	P3,P4	P3,P4	P3	-	-	-	
112	CONFERENCE ROOM	PC1	RB1	P3	P3	P3	P3	P2	PL1	PL1	-	

## **GENERAL NOTE:**

FINISH MATERIALS TO BE PROCURRED FROM OWNER SELECTED / SPECIFIED VENDOR, AS LISTED ABOVE. ALTERNATES OR SUBSTITUTIONS WILL NOT BE ACCEPTED.

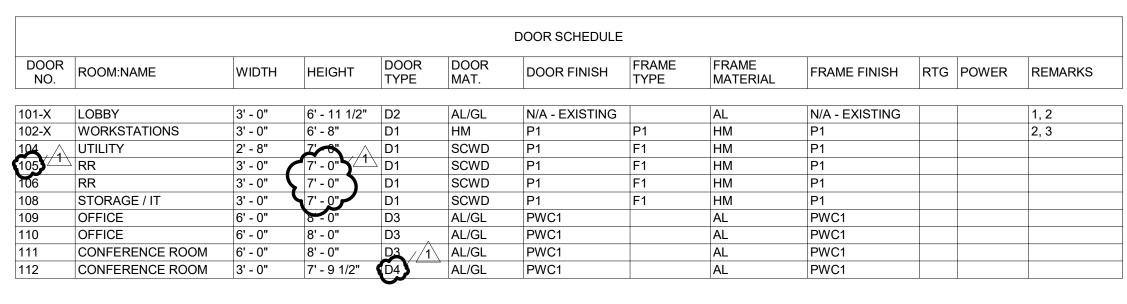


**DOOR SCHEDULE REMARKS:** I. EXISTING DOOR TO REMAIN. PROTECT DOOR AND FRAME FROM DAMAGE THROUGHOUT CONSTRUCTION. ANY DAMAGE TO BE REPAIRED/REPLACED PER OWNER DISCRETION. 2. PROVIDE DOOR ACCESS SYSTEM; COORDINATE WITH OWNER TO INTEGRATE WITH SYSTEM AT ADJACENT SOUTH BUILDING GARAGE DOOR. 3. EXISTING DOOR AND FRAME TO BE REFINISHED; RE: FINISH LEGEND.

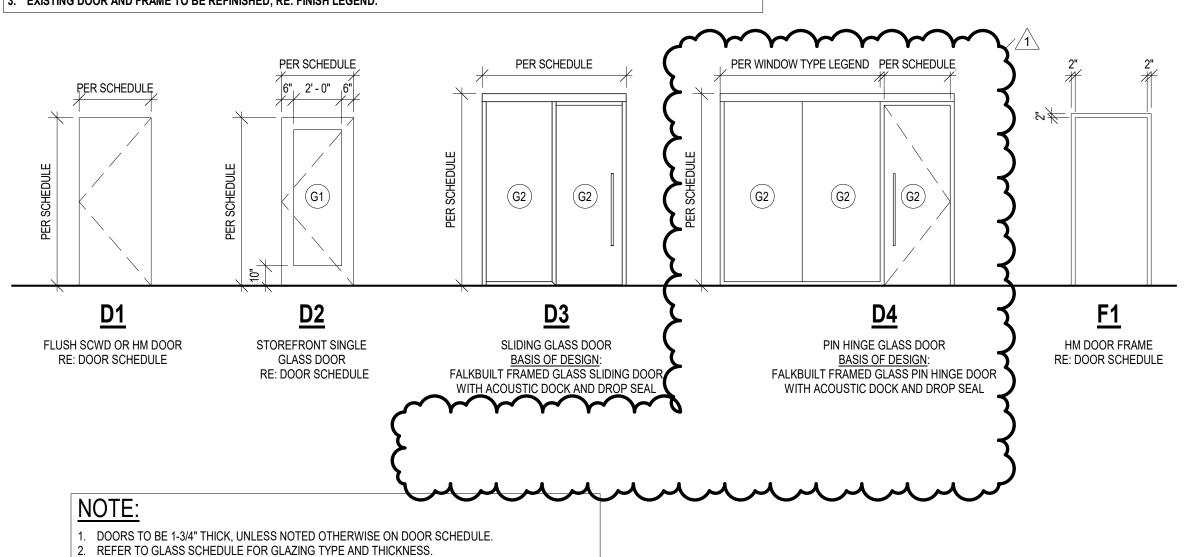

G5 DOOR & FRAME TYPE ELEVATIONS


1/4" = 1'-0"

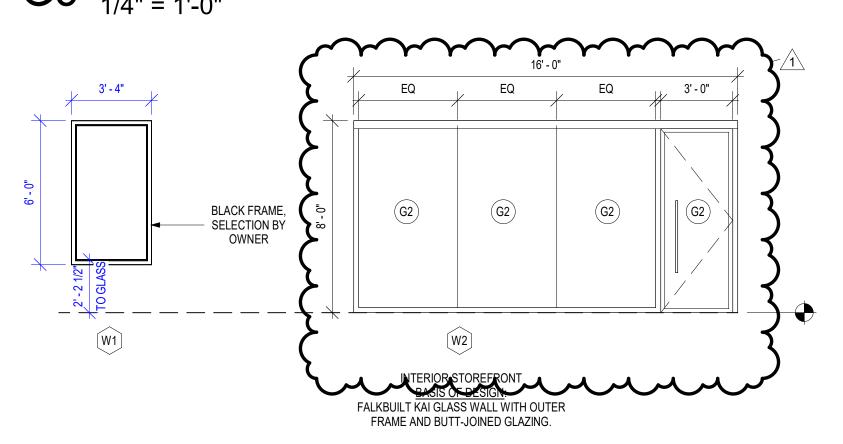

E5 WINDOW TYPE LEGEND
1/4" = 1'-0"



A12 1ST FLOOR - FINISH PLAN 1/4" = 1'-0"

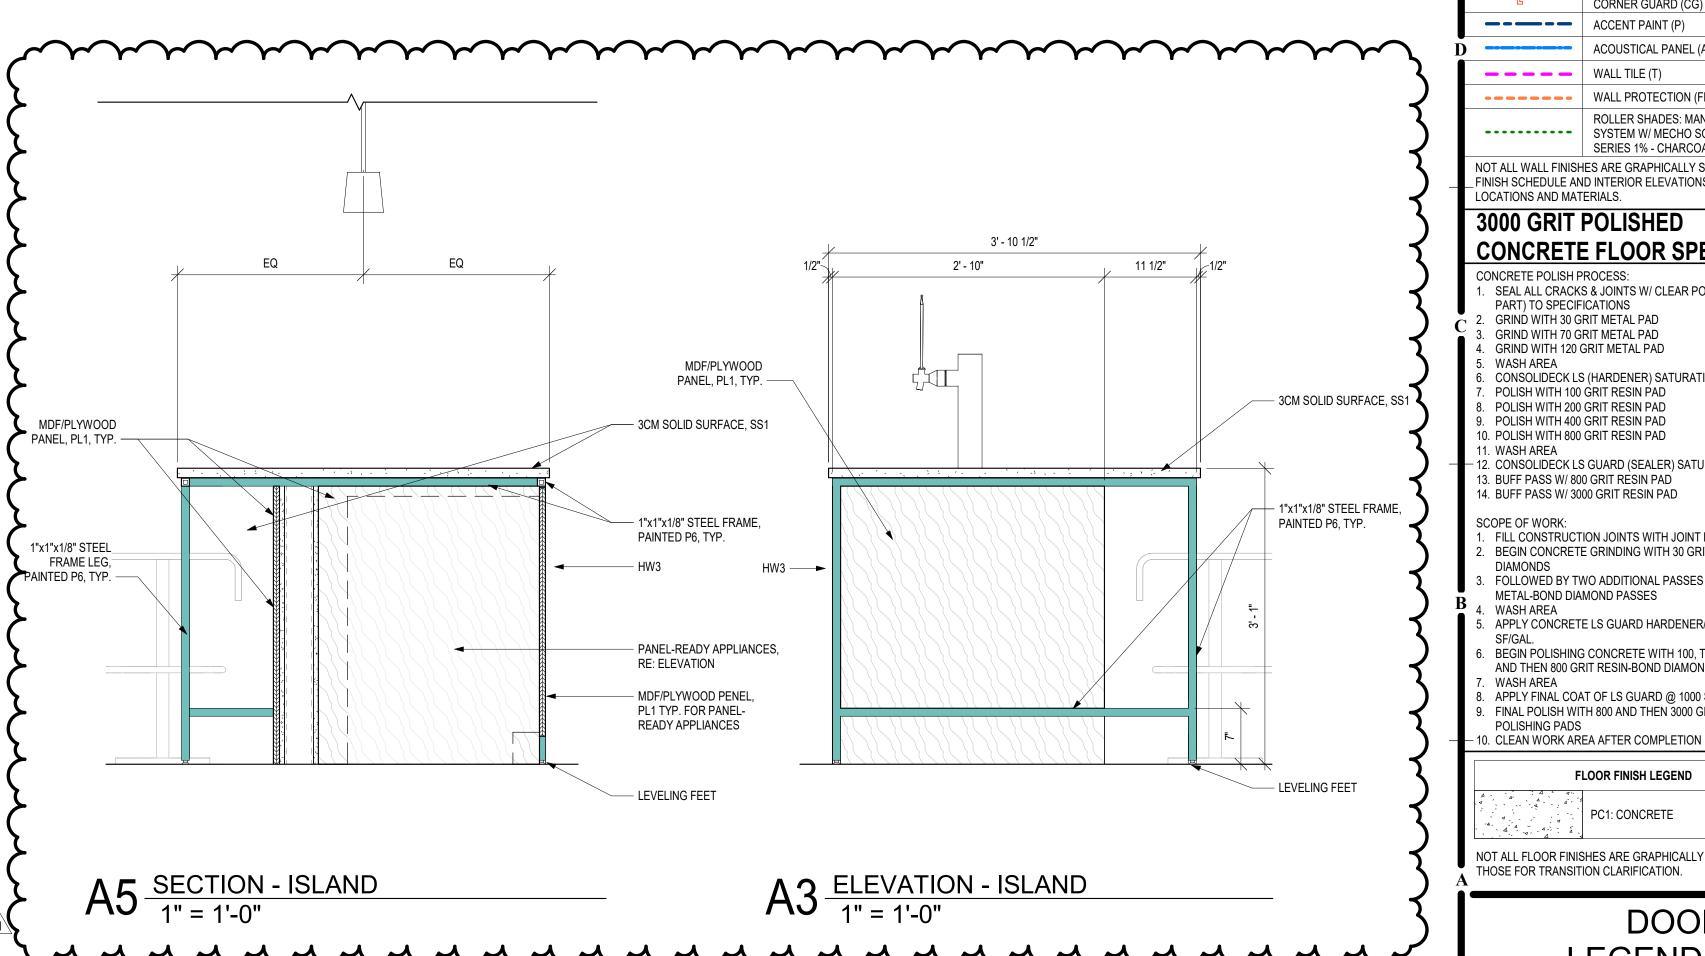

**GENERAL NOTES:** 

DOOR SCHEDULE

HM REFERS TO HOLLOW METAL 2. AL REFERS TO ALUMINUM 8. WD REFERS TO WOOD

4. SCWD REFERS TO SOLID CORE WOOD 5. ALL EXTERIOR ALUMINUM DOORS & FRAMES ARE TO BE FINISHED TO MATCH ADJACENT ALUMINUM WINDOW FRAME,

6. FOR FINISH COLOR DESIGNATION FOR INTERIOR DOOR AND FRAMES, REFER TO FINISH LEGEND.

REFER TO SPECIFICATION FOR DOOR HARDWARE SET DESIGNATIONS.

8. 2 HOUR FIRE BARRIED DOORS = 90 MINUTE RATING 1 HOUR FIRE BARRIED DOORS = 45 MINUTE RATING 1 HOUR SMOKE BARRIER = 20 MINUTE RATING PROTECT ALL DOORS & FRAMES FROM DAMAGE THROUGHOU CONSTRUCTION PHASES. 10. ALL EGRESS DOORS TO BE PROVIDED WITH PANIC HARDWA

GLASS TYPE LEGEND

DESIGNATION DESCRIPTION NUMBER " INSULATED TEMPERED GLAZING 1/4" TEMPERED GLAZING, CLEAR

#### **GENERAL NOTES: INTERIOR FINISHES**

RE: SHEET G001 FOR ADDITIONAL GENERAL NOTES THAT ARE APPLICABLE.

RE: G002 FOR ACCESSIBILITY GUIDELINES. . RE: A700 SERIES SHEETS FOR ADDITIONAL WALL FINISH

CLARIFICATION. HOLLOW METAL FRAMES SHALL RECEIVE SEMI-GLOSS FINISH WHERE WALL COLOR IS DIFFERENT ON EACH SIDE OF THE HOLLOW METAL FRAME, PAINT FRAME TO MATCH CORRIDOR

WALL, UNLESS NOTED OR SHOWN OTHERWISE. CONTINUE WALL FINISH AS SCHEDULED BEHIND EQUIPMENT. CONTRACTOR SHALL VERIFY ALL DIMENSIONS PRIOR TO CASEWORK FABRICATION AND INSTALLATION.

ALL EXPOSED CASEWORK SURFACES SHALL BE FINISHED PLASTIC LAMINATE AS SCHEDULED, U.N.O. . ALL PLASTIC LAMINATE DOOR AND DRAWERS TO RECEIVE 1MM PVC EDGEBAND AND ALL COUNTERTOPS TO RECEIVE 3MM PVC EDGEBANDING. 9. ALL BACKSPLASH MATERIAL SHALL MATCH COUNTERTOP

10. WHERE TWO MODULAR TILES (PORCELAIN, MARBLE, OR QUARRY) OF VARYING THICKNESSES MEET, THE SETTING BED FOR THE THINNER TILE SHALL BE BUILT UP TO ENSURE THAT THE FACES OF THE DIFFERENT TILES ARE FLUSH. TRANSITION ALL WALL FINISHES/COLOR CHANGES AT INSIDE CORNERS, UNLESS NOTED OTHERWISE (U.N.O.) . TRANSITION WALL BASE AT INSIDE CORNERS, U.N.O. 13. INSTALL METAL TRANSITION STRIP WHERE WALL TILE MEETS PAINTED GYP. BD. WALL IN ALL VERTICAL AND/ OR

#### **ROOM FINISH** SCHEDULE REMARKS:

HORIZONTAL CONDITIONS, U.N.O.

AREAS WITH MULTIPLE DESIGNATED FINISHES. RE: FINISH FLOOR PLANS & INTERIOR ELEVATIONS FOR ADDITIONAL

1. PROVIDE FRP TO 4'-0" AFF.

CLARIFICATION.

#### GENERAL NOTES: FLOOR FINISH PLANS

. RE: SHEET G001-TI - FOR ADDITIONAL GENERAL NOTES THAT ARE APPLICABLE. RE: FINISH LEGEND, FINISH SCHEDULE, AND FLOOR FINISH

PLANS FOR SPECIFIC FLOOR FINISH INFORMATION AND FLOOR FINISHES SHOWN ARE FOR ACCENT CLARIFICATION ONLY. RE: FINISH SCHEDULE FOR ADDITIONAL INFORMATION.

FLOOR FINISH PATTERN SHALL BE CENTERED IN ROOM, UNLESS NOTED OTHERWISE. ALIGN ALL WALL TILE JOINTS WITH FLOOR TILE JOINTS, UNLESS NOTED OR SHOWN OTHERWISE. FLOOR FINISH MATERIAL AND/ OR PATTERN SHALL BE INSTALLED UNDER TOE KICKS OF CASEWORK/MILLWORK,

UNDER OPEN COUNTERTOPS, AND UNDER EQUIPMENT. FLOOR MATERIAL/ COLOR TRANSITIONS TO ALIGN WITH ROOM SIDE OF DOOR STOP, UNLESS NOTED OR SHOWN INSTALL TRANSITION STRIPS AT ALL FLOOR FINISH MATERIAL

#### **WALL FINISH / WALL PROTECTION PLANS:**

CHANGES, UNLESS NOTED OTHERWISE.

. RE: G-SHEETS - FOR ADDITIONAL GENERAL NOTES THAT ARE APPLICABLE RE: FINISH LEGEND & FINISH SCHEDULE FOR SPECIFIC FINISH INFORMATION & LOCATIONS. CONTRACTOR SHALL PROVIDE ALL NECESSARY BLOCKING FOR WALL PROTECTION ATTACHMENT. THIS INCLUDES, BUT I NOT LIMITED TO: HANDRAILS, POSTER CASES, TV MONITORS,

BATHROOM ACCESSORIES, FIRE EXTINGUISHERS AND EQUIPMENT. RE: ROUGH CARPENTRY SPECIFICATION SECTION FOR CLARIFICATION. CONTRACTOR SHALL PROVIDE MANUFACTURER'S STANDARD

ACCESSORY MOLDING OR TRIM FOR WALL PROTECTION ITEMS, UNLESS NOTED OTHERWISE.

**WALL FINISH LEGEND** WALL PROTECTION CORNER GUARD (CG) ACCENT PAINT (P) ACOUSTICAL PANEL (AP) WALL TILE (T) WALL PROTECTION (FRP) ROLLER SHADES: MANUAL MECHO®/5 SYSTEM W/ MECHO SOHO 1100

SERIES 1% - CHARCOAL (1612) NOT ALL WALL FINISHES ARE GRAPHICALLY SHOWN . REFER TO FINISH SCHEDULE AND INTERIOR ELEVATIONS FOR SPECIFIC LOCATIONS AND MATERIALS. 3000 GRIT POLISHED

## **CONCRETE FLOOR SPECS:** CONCRETE POLISH PROCESS:

. SEAL ALL CRACKS & JOINTS W/ CLEAR POLYUREAPE-85 (TWO PART) TO SPECIFICATIONS . GRIND WITH 30 GRIT METAL PAD GRIND WITH 70 GRIT METAL PAD

4. GRIND WITH 120 GRIT METAL PAD 5. WASH AREA 6. CONSOLIDECK LS (HARDENER) SATURATION POLISH WITH 100 GRIT RESIN PAD 8. POLISH WITH 200 GRIT RESIN PAD 9. POLISH WITH 400 GRIT RESIN PAD

10. POLISH WITH 800 GRIT RESIN PAD - 12. CONSOLIDECK LS GUARD (SEALER) SATURATION 13. BUFF PASS W/ 800 GRIT RESIN PAD 14. BUFF PASS W/ 3000 GRIT RESIN PAD

FILL CONSTRUCTION JOINTS WITH JOINT FILLER 2. BEGIN CONCRETE GRINDING WITH 30 GRIT METAL-BOND 8. FOLLOWED BY TWO ADDITIONAL PASSES WITH 70 & THEN 120 METAL-BOND DIAMOND PASSES

4. WASH AREA 5. APPLY CONCRETE LS GUARD HARDENER/SEALER @ 400

6. BEGIN POLISHING CONCRETE WITH 100, THEN 200, THEN 400 AND THEN 800 GRIT RESIN-BOND DIAMOND PADS 8. APPLY FINAL COAT OF LS GUARD @ 1000 SF/GAL. 9. FINAL POLISH WITH 800 AND THEN 3000 GRIT RESIN-BOND

FLOOR FINISH LEGEND

NOT ALL FLOOR FINISHES ARE GRAPHICALLY SHOWN, ONLY THOSE FOR TRANSITION CLARIFICATION.

COLLINS WEBB #: DOOR SCHEDULE, FINISH LEGEND & FINISH SCHEDULE

ОШ

**COPYRIGHT © BY** 

**REVISION DATES:** 

ARCHITECTURE, LLC

1 City Comments & 08.08.2023


\* COLLUS

PROFESSIONAL SEAL

A-2017002629

08/08/2023

**COLLINS WEBB** 

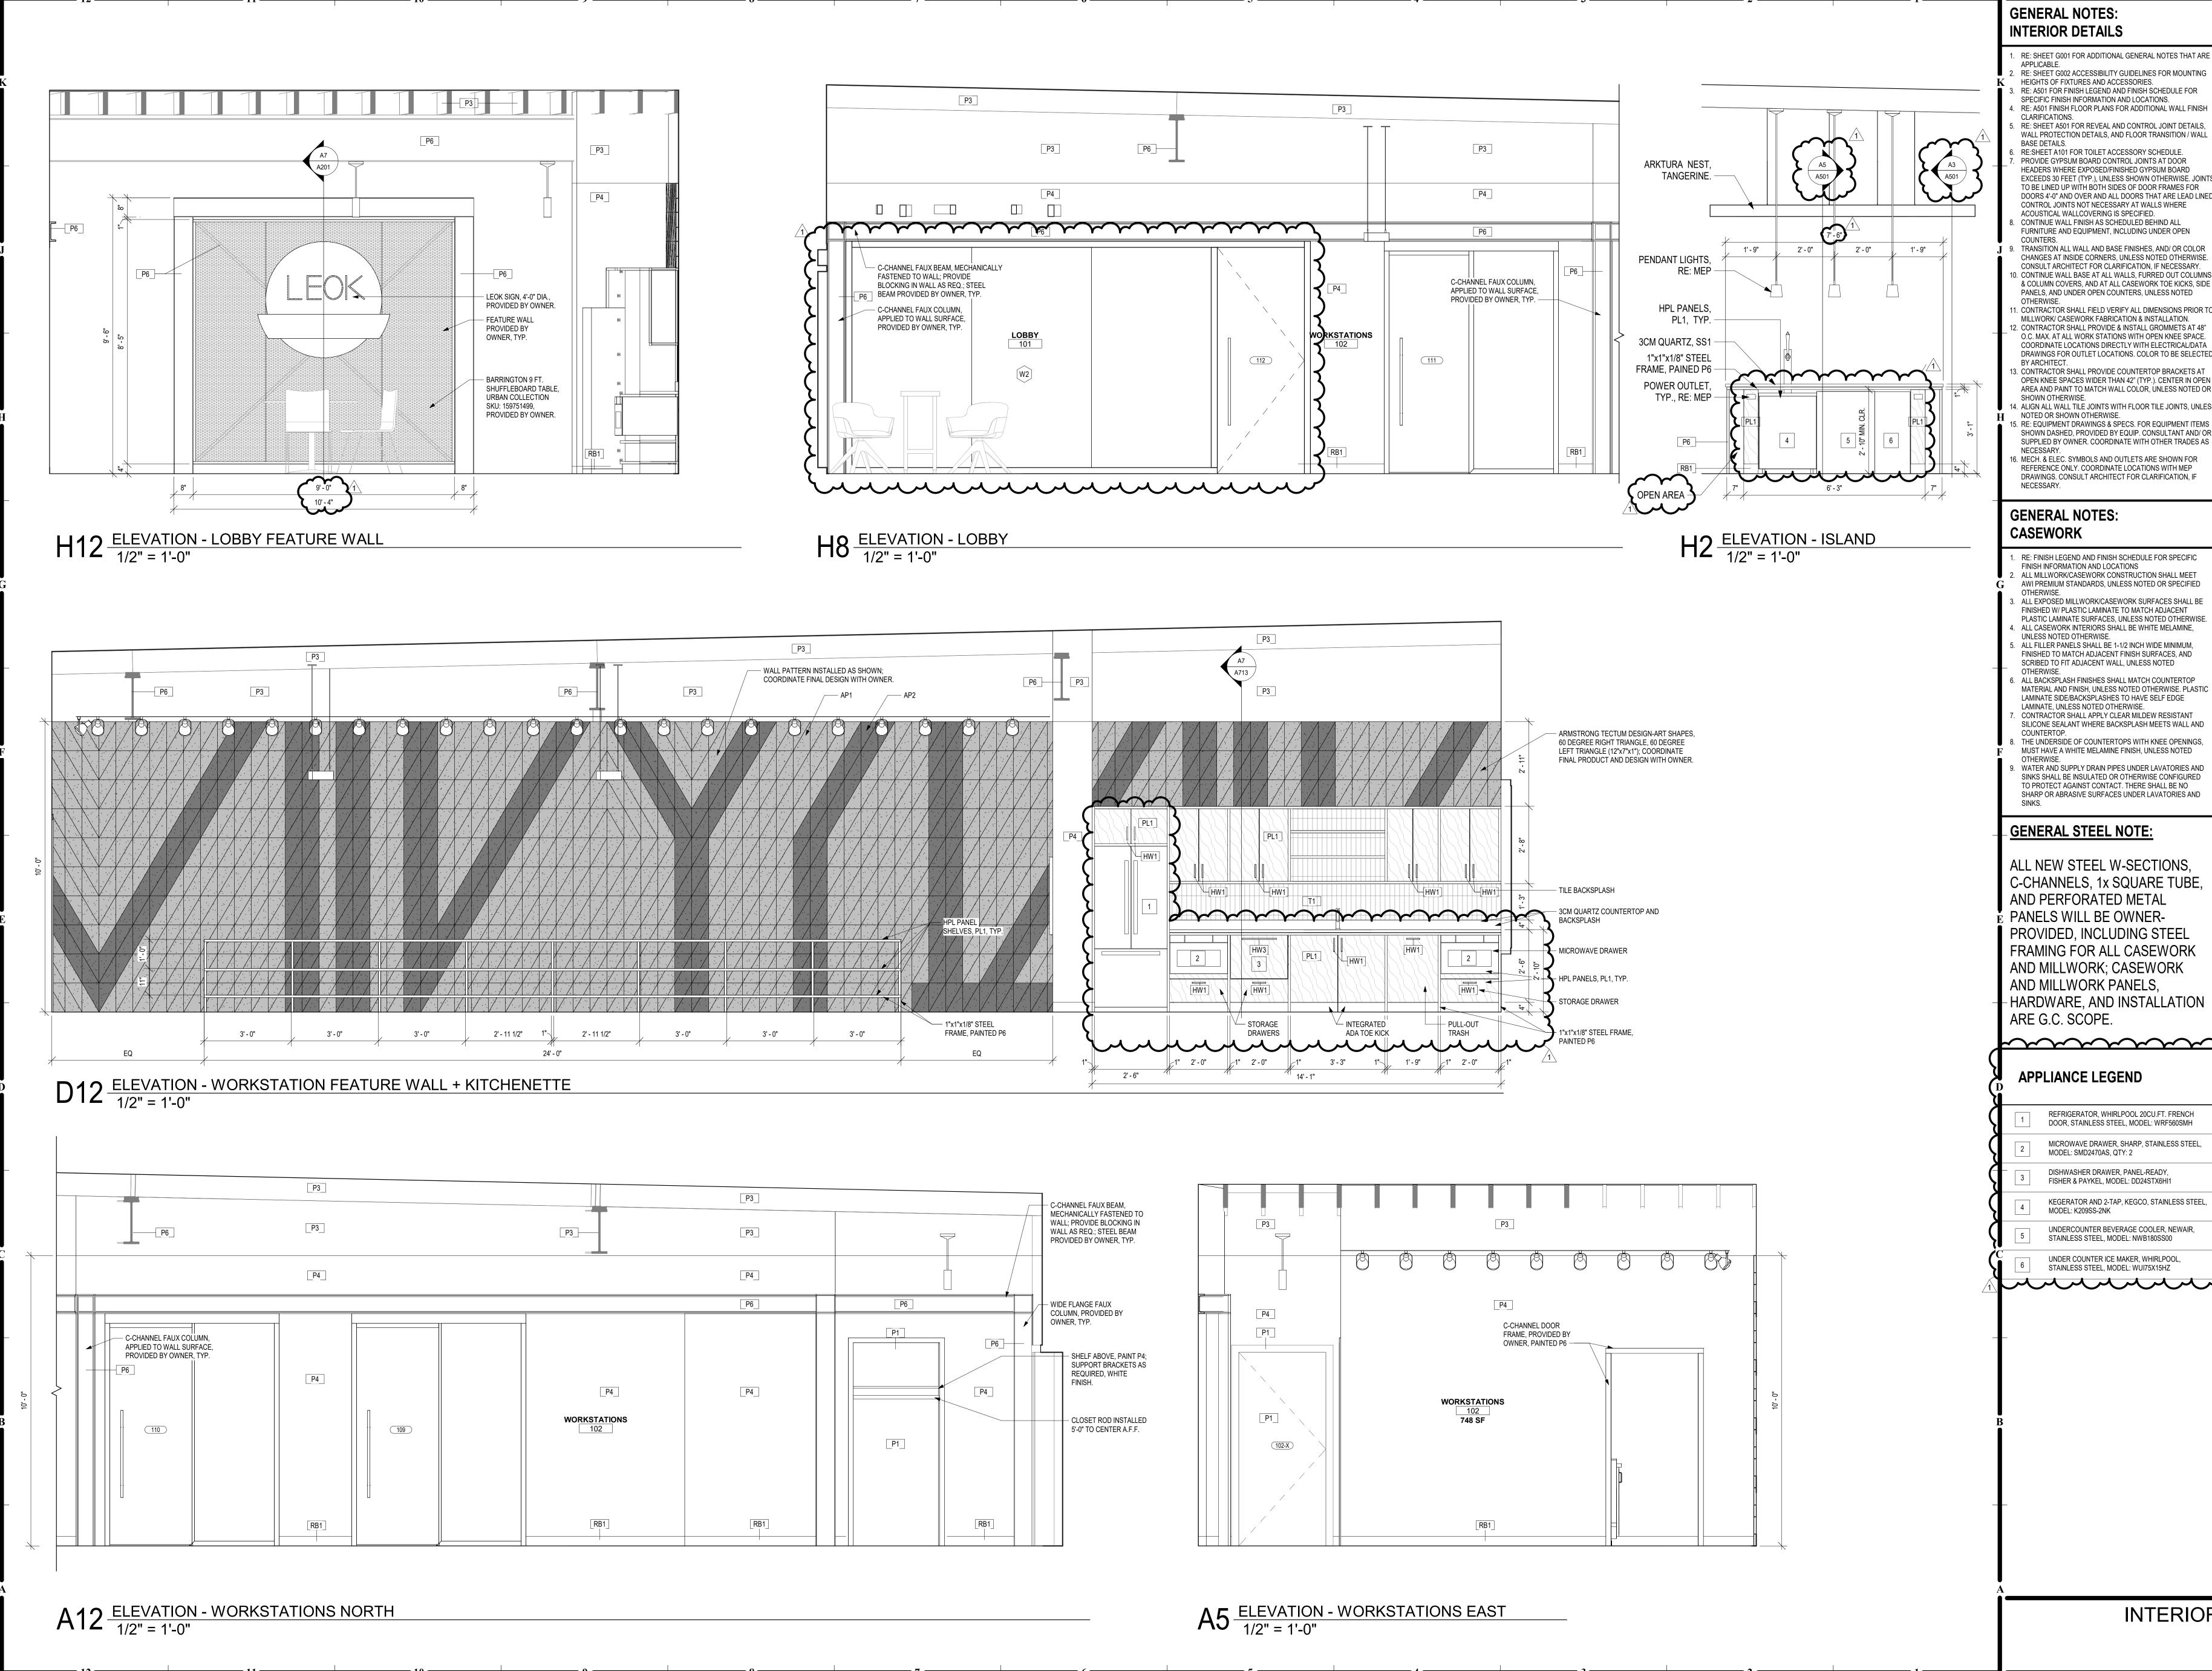

COllins | Webb ARCHI1

ERMIT SE

OFFICE RENOV

LLCCR 209 SE DOUGILEE'S SUMMIT

COPYRIGHT © BY
COLLINS WEBB
ARCHITECTURE, LLC
REVISION DATES:

1 City Comments & 08.08.2023 VE Revisions

SAM
COLLDS


WAIBER
A-2017002629
08/08/2023

PROFESSIONAL SEAL

A712

ISSUE DATE: JULY 17

INTERIOR ELEVATIONS

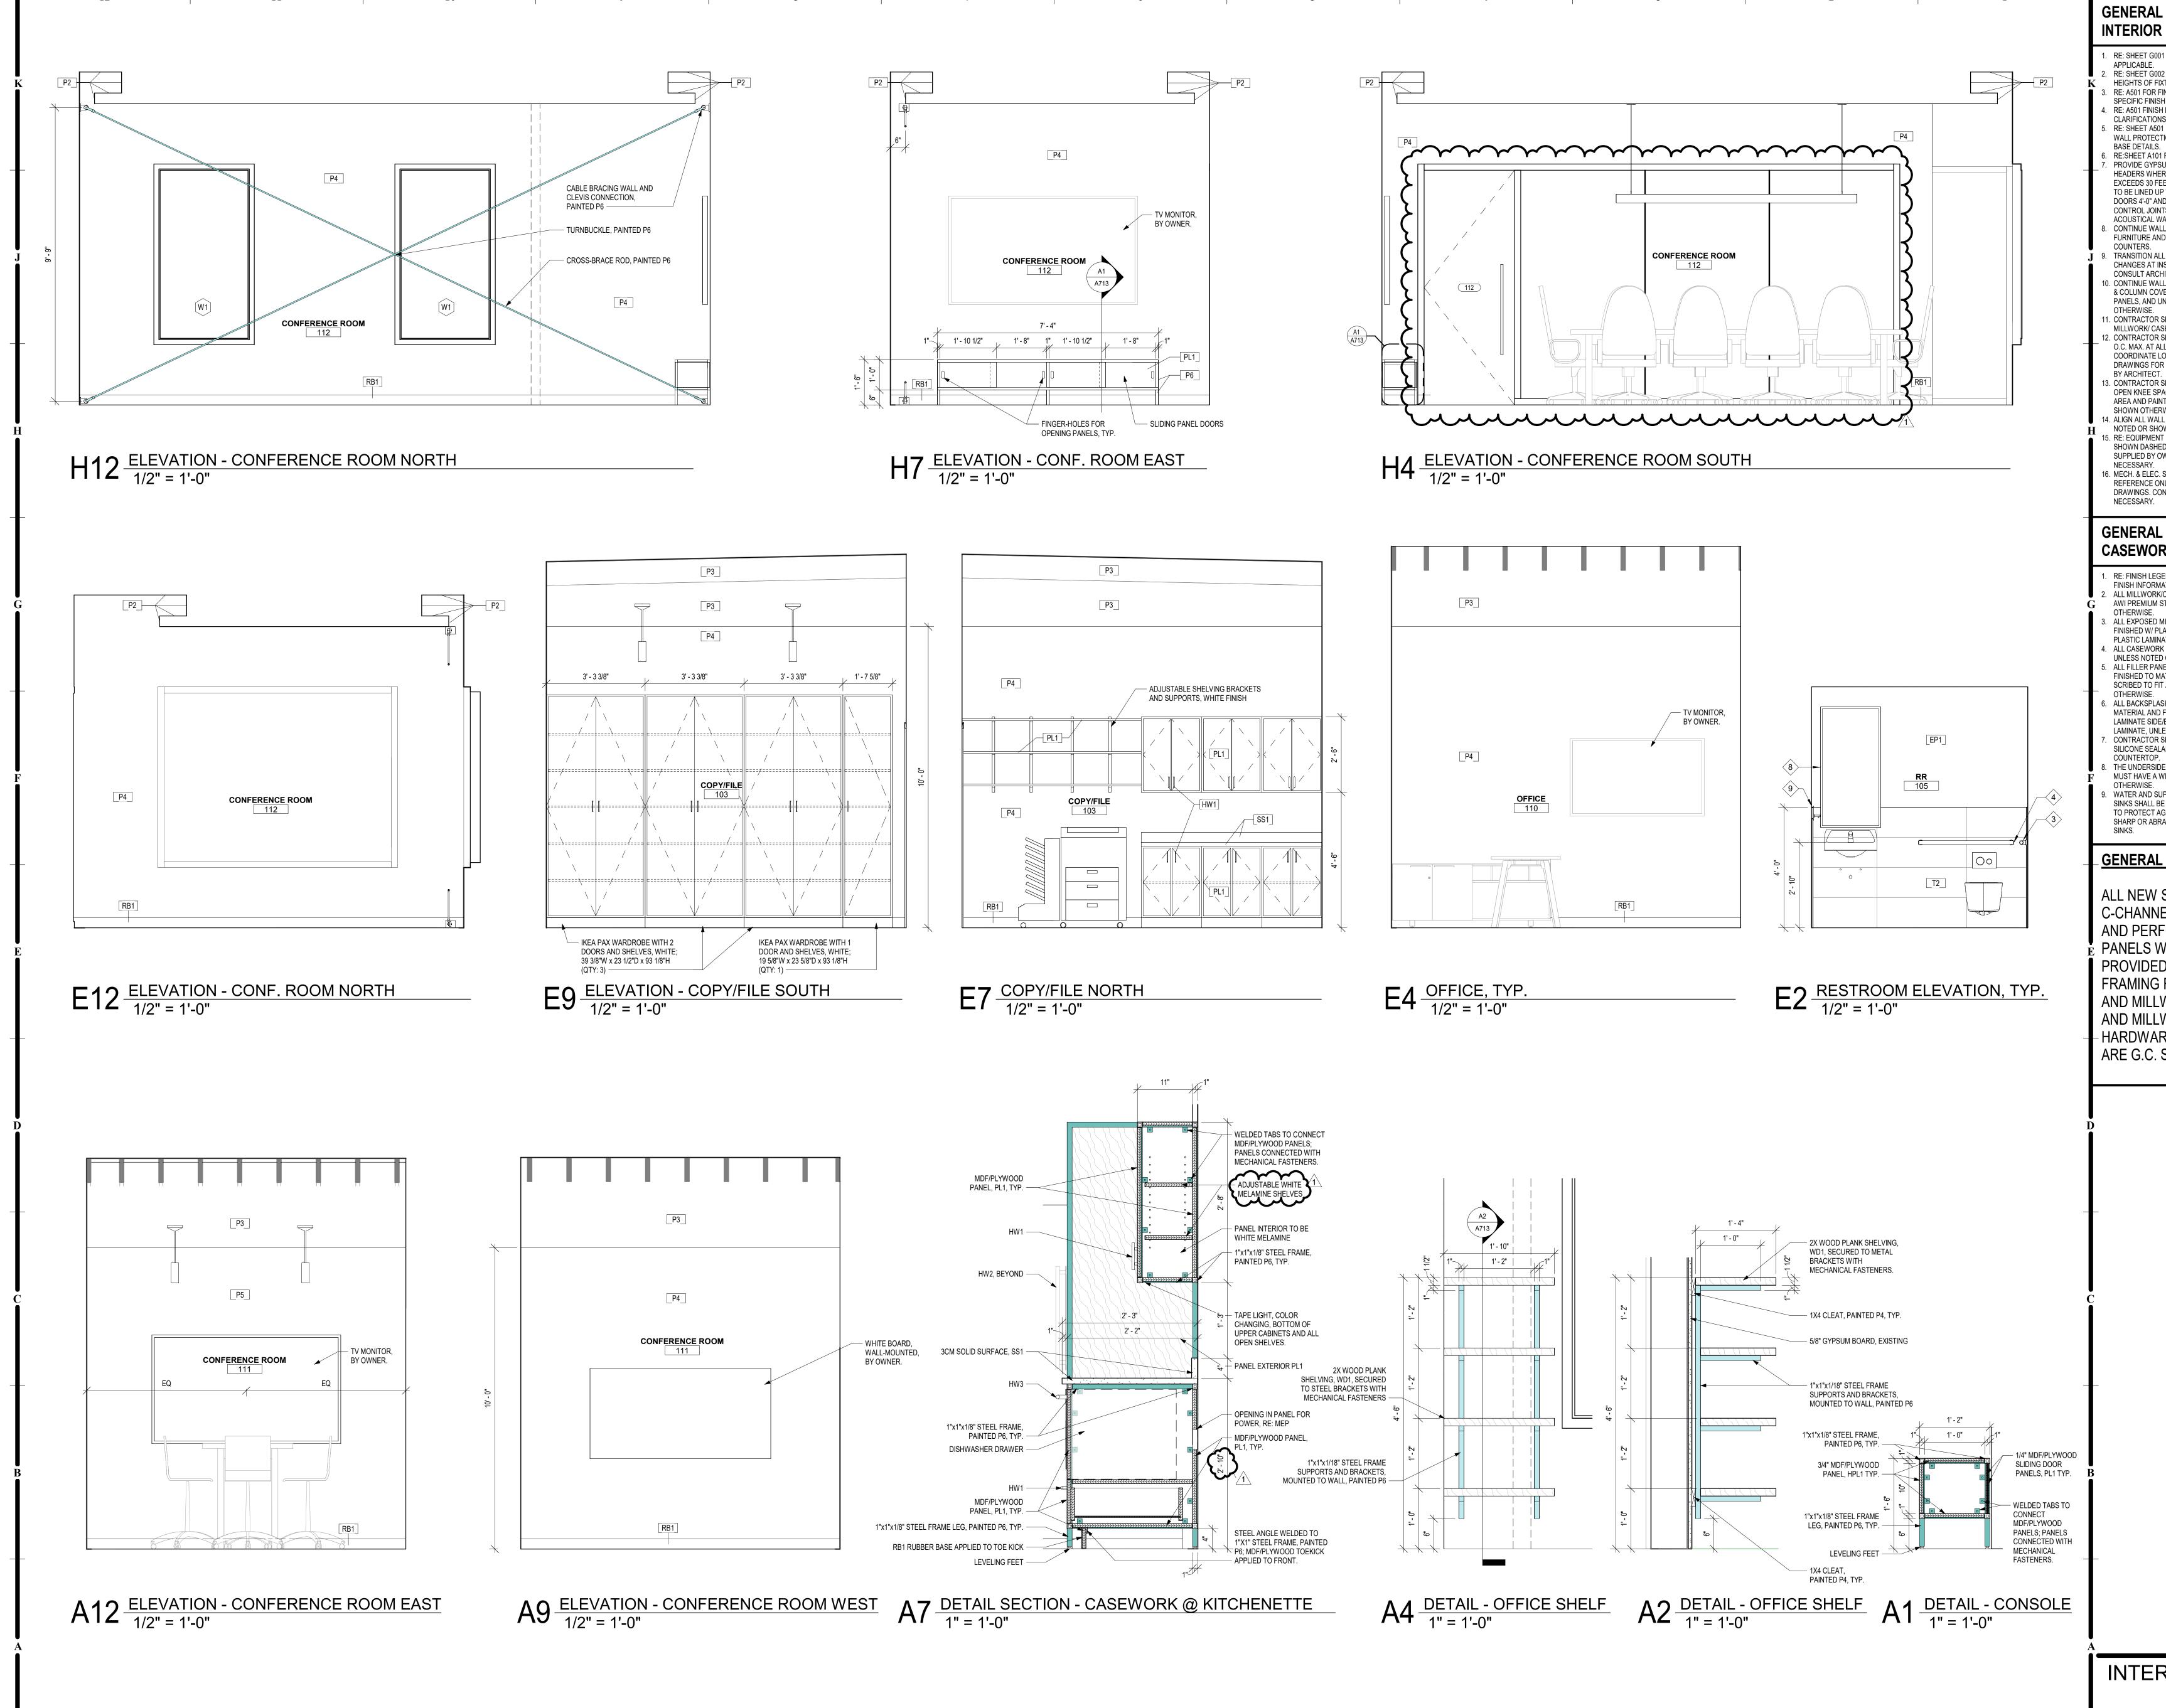

**GENERAL NOTES: INTERIOR DETAILS** 

> 1. RE: SHEET G001 FOR ADDITIONAL GENERAL NOTES THAT ARE 2. RE: SHEET G002 ACCESSIBILITY GUIDELINES FOR MOUNTING HEIGHTS OF FIXTURES AND ACCESSORIES. RE: A501 FOR FINISH LEGEND AND FINISH SCHEDULE FOR SPECIFIC FINISH INFORMATION AND LOCATIONS. 4. RE: A501 FINISH FLOOR PLANS FOR ADDITIONAL WALL FINISH CLARIFICATIONS. 5. RE: SHEET A501 FOR REVEAL AND CONTROL JOINT DETAILS,

WALL PROTECTION DETAILS, AND FLOOR TRANSITION / WALL 6. RE:SHEET A101 FOR TOILET ACCESSORY SCHEDULE.

. PROVIDE GYPSUM BOARD CONTROL JOINTS AT DOOR HEADERS WHERE EXPOSED/FINISHED GYPSUM BOARD EXCEEDS 30 FEET (TYP.), UNLESS SHOWN OTHERWISE. JOINTS TO BE LINED UP WITH BOTH SIDES OF DOOR FRAMES FOR DOORS 4'-0" AND OVER AND ALL DOORS THAT ARE LEAD LINED. CONTROL JOINTS NOT NECESSARY AT WALLS WHERE ACOUSTICAL WALLCOVERING IS SPECIFIED. B. CONTINUE WALL FINISH AS SCHEDULED BEHIND ALL FURNITURE AND EQUIPMENT, INCLUDING UNDER OPEN 9. TRANSITION ALL WALL AND BASE FINISHES, AND/ OR COLOR CHANGES AT INSIDE CORNERS, UNLESS NOTED OTHERWISE.

CONSULT ARCHITECT FOR CLARIFICATION, IF NECESSARY. 10. CONTINUE WALL BASE AT ALL WALLS, FURRED OUT COLUMNS & COLUMN COVERS, AND AT ALL CASEWORK TOE KICKS, SIDE PANELS, AND UNDER OPEN COUNTERS, UNLESS NOTED 11. CONTRACTOR SHALL FIELD VERIFY ALL DIMENSIONS PRIOR T MILLWORK/ CASEWORK FABRICATION & INSTALLATION. 12. CONTRACTOR SHALL PROVIDE & INSTALL GROMMETS AT 48" O.C. MAX. AT ALL WORK STATIONS WITH OPEN KNEE SPACE. COORDINATE LOCATIONS DIRECTLY WITH ELECTRICAL/DATA

DRAWINGS FOR OUTLET LOCATIONS. COLOR TO BE SELECTE BY ARCHITECT. CONTRACTOR SHALL PROVIDE COUNTERTOP BRACKETS AT OPEN KNEE SPACES WIDER THAN 42" (TYP.). CENTER IN OPEN AREA AND PAINT TO MATCH WALL COLOR, UNLESS NOTED OF SHOWN OTHERWISE. 14. ALIGN ALL WALL TILE JOINTS WITH FLOOR TILE JOINTS, UNLES

NOTED OR SHOWN OTHERWISE. 5. RE: EQUIPMENT DRAWINGS & SPECS. FOR EQUIPMENT ITEMS SHOWN DASHED, PROVIDED BY EQUIP. CONSULTANT AND/ OF SUPPLIED BY OWNER. COORDINATE WITH OTHER TRADES AS 16. MECH. & ELEC. SYMBOLS AND OUTLETS ARE SHOWN FOR

REFERENCE ONLY. COORDINATE LOCATIONS WITH MEP DRAWINGS. CONSULT ARCHITECT FOR CLARIFICATION, IF

## **GENERAL NOTES:** CASEWORK

1. RE: FINISH LEGEND AND FINISH SCHEDULE FOR SPECIFIC FINISH INFORMATION AND LOCATIONS 2. ALL MILLWORK/CASEWORK CONSTRUCTION SHALL MEET AWI PREMIUM STANDARDS, UNLESS NOTED OR SPECIFIED

3. ALL EXPOSED MILLWORK/CASEWORK SURFACES SHALL BE FINISHED W/ PLASTIC LAMINATE TO MATCH ADJACENT PLASTIC LAMINATE SURFACES, UNLESS NOTED OTHERWISE 4. ALL CASEWORK INTERIORS SHALL BE WHITE MELAMINE, UNLESS NOTED OTHERWISE. 5. ALL FILLER PANELS SHALL BE 1-1/2 INCH WIDE MINIMUM, FINISHED TO MATCH ADJACENT FINISH SURFACES, AND SCRIBED TO FIT ADJACENT WALL, UNLESS NOTED

6. ALL BACKSPLASH FINISHES SHALL MATCH COUNTERTOP MATERIAL AND FINISH, UNLESS NOTED OTHERWISE, PLASTIC LAMINATE SIDE/BACKSPLASHES TO HAVE SELF EDGE LAMINATE, UNLESS NOTED OTHERWISE. CONTRACTOR SHALL APPLY CLEAR MILDEW RESISTANT SILICONE SEALANT WHERE BACKSPLASH MEETS WALL AND

THE UNDERSIDE OF COUNTERTOPS WITH KNEE OPENINGS, MUST HAVE A WHITE MELAMINE FINISH, UNLESS NOTED WATER AND SUPPLY DRAIN PIPES UNDER LAVATORIES AND SINKS SHALL BE INSULATED OR OTHERWISE CONFIGURED TO PROTECT AGAINST CONTACT. THERE SHALL BE NO SHARP OR ABRASIVE SURFACES UNDER LAVATORIES AND

## **GENERAL STEEL NOTE:**

ALL NEW STEEL W-SECTIONS, C-CHANNELS, 1x SQUARE TUBE AND PERFORATED METAL PANELS WILL BE OWNER-PROVIDED, INCLUDING STEEL FRAMING FOR ALL CASEWORK AND MILLWORK; CASEWORK AND MILLWORK PANELS, HARDWARE, AND INSTALLATION ARE G.C. SCOPE.


209 LE **COPYRIGHT** © BY **COLLINS WEBB** ARCHITECTURE, LLC **REVISION DATES:** 

1 City Comments & 08.08.2023 VE Revisions



COLLINS WEBB #:

INTERIOR ELEVATIONS & DETAILS

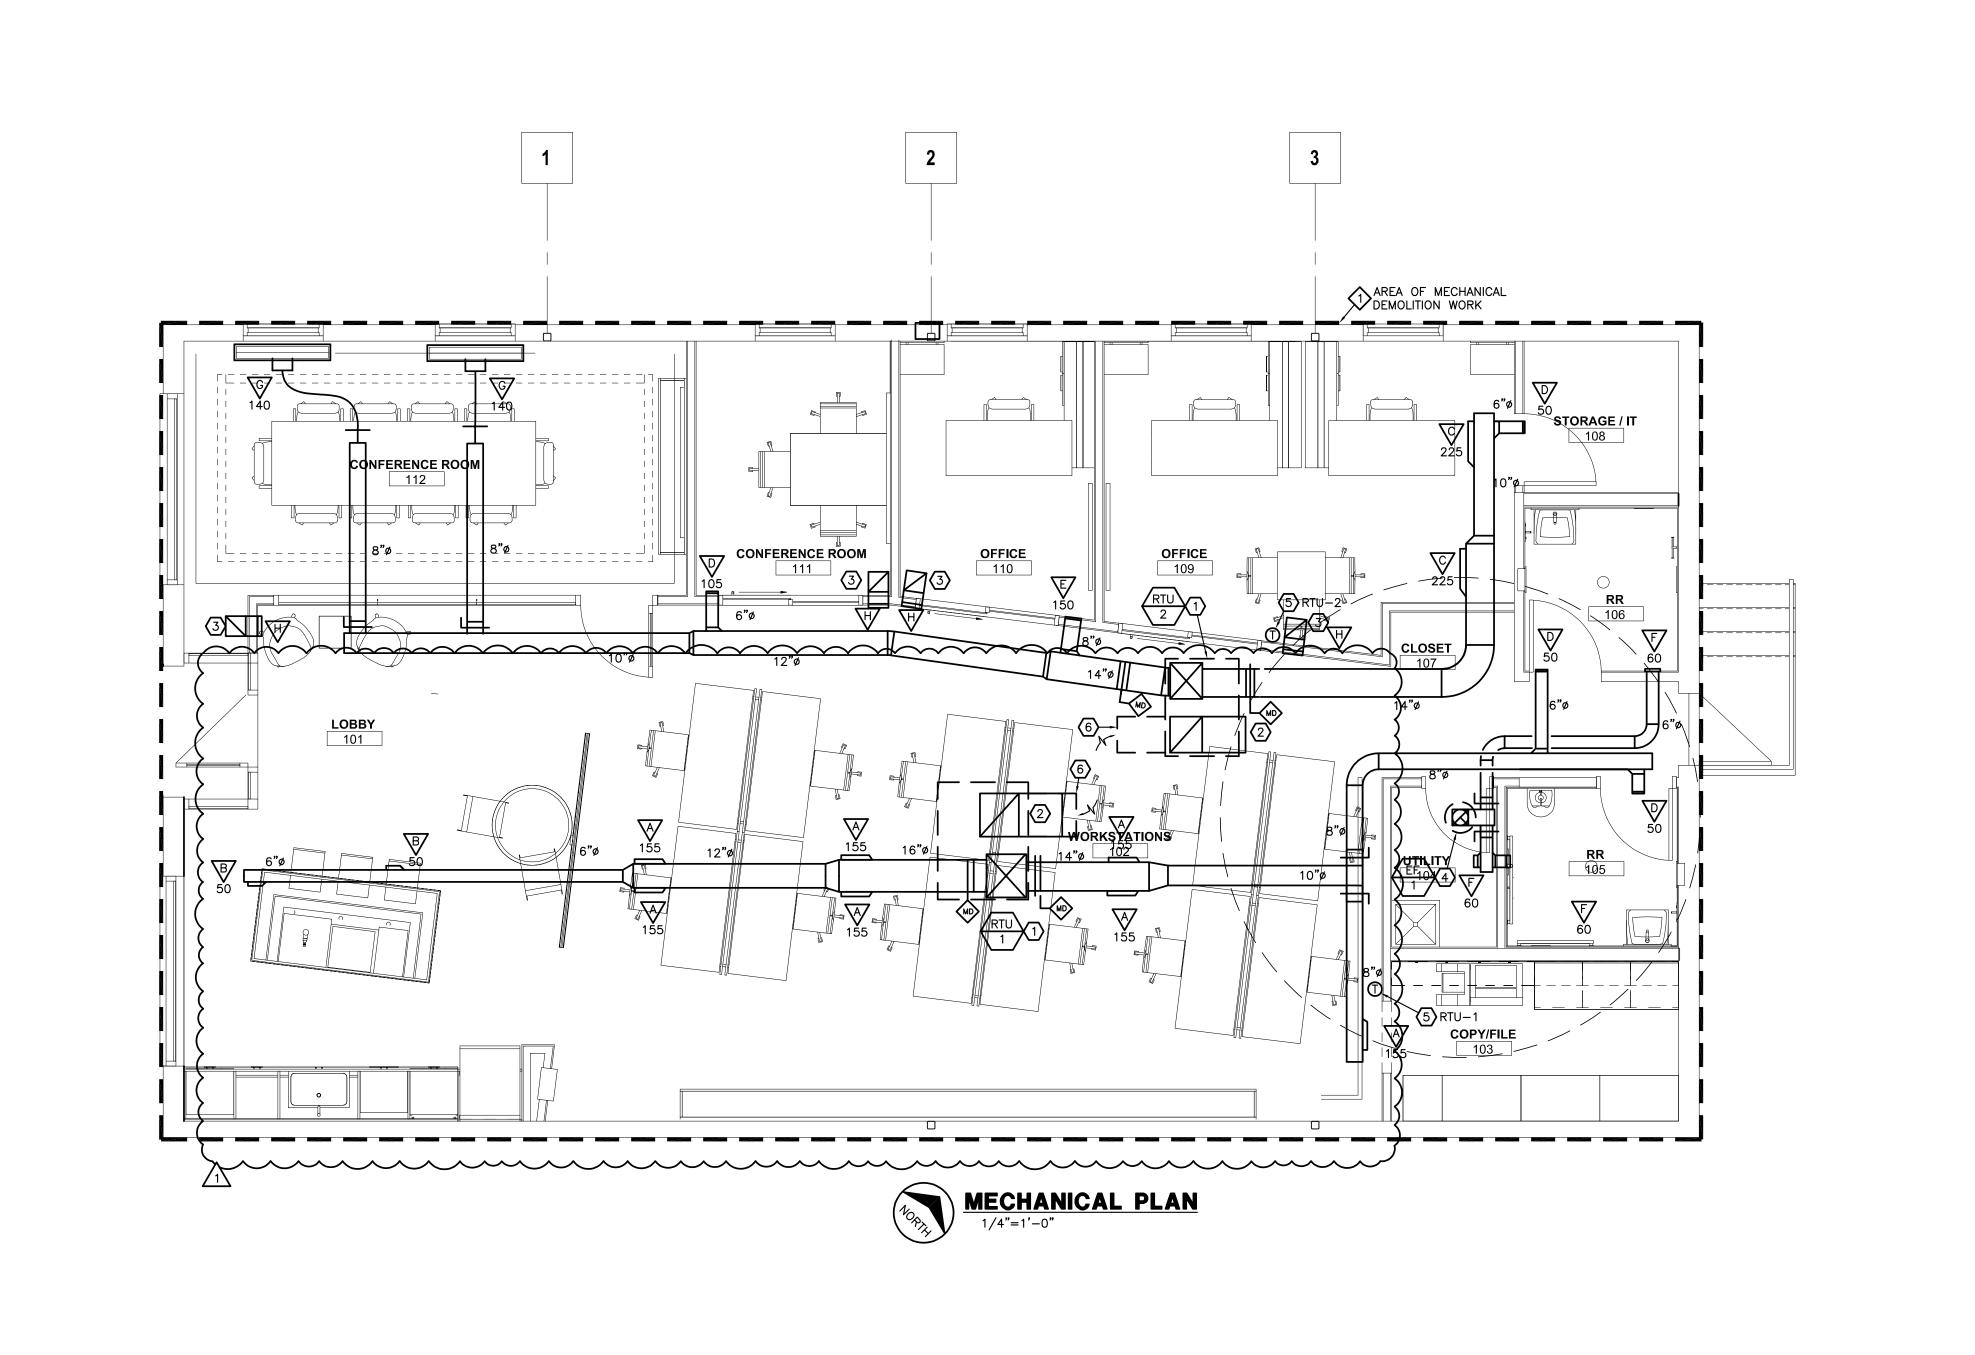

#### MECHANICAL GENERAL NOTES

A. CONTRACTORS AND SUB-CONTRACTORS SHALL CAREFULLY REVIEW THE CONSTRUCTION DOCUMENTS. INFORMATION REGARDING THE COMPLETE WORK IS DISPERSED THROUGHOUT THE DOCUMENT SET AND CANNOT BE ACCURATELY DETERMINED WITHOUT REFERENCE TO THE COMPLETE DOCUMENT SET.

B. COORDINATE WITH THE WORK OF OTHER SECTIONS, EQUIPMENT FURNISHED BY OTHERS, REQUIREMENTS OF THE OWNER, AND WITH THE CONSTRAINTS OF THE EXISTING CONDITIONS OF THE PROJECT SITE. PROVIDE DUCT RISES AND DROPS AS REQUIRED FOR FIELD INSTALLATION AND TRADE COORDINATION. NOTIFY ARCHITECT OF ANY DISCREPANCIES BEFORE STARTING WORK.

C. DRAWINGS FOR HVAC WORK ARE DIAGRAMMATIC, SHOWING THE GENERAL LOCATION, TYPE, LAYOUT, AND EQUIPMENT REQUIRED. THE DRAWINGS SHALL NOT BE SCALED FOR EXACT MEASUREMENT. REFER TO ARCHITECTURAL DRAWINGS FOR DIMENSIONS. REFER TO MANUFACTURER'S STANDARD INSTALLATION DRAWINGS FOR EQUIPMENT CONNECTIONS AND INSTALLATION REQUIREMENTS. PROVIDE DUCTWORK, CONNECTIONS, ACCESSORIES, OFFSETS, AND MATERIALS NECESSARY FOR A COMPLETE

D. ALL WORK SHALL COMPLY WITH STATE AND LOCAL CODE REQUIREMENTS AS APPROVED AND AMENDED BY THE GOVERNING CITY, INCLUDING APPLICABLE SECTIONS OF NFPA, OSHA, INTERNATIONAL BUILDING CODES, OR ANY INTERIM AMENDMENTS AT THE TIME OF THE PROPOSAL. PURCHASE ALL PERMITS ASSOCIATED WITH THE WORK. OBTAIN ALL INSPECTIONS REQUIRED BY CODE.

E. DUCTWORK DIMENSIONS LISTED ON PLANS INDICATE INTERNAL FREE

## MECHANICAL PLAN DEMOLITION NOTES

DISCONNECT AND REMOVE ALL EXISTING MECHANICAL EQUIPMENT, DUCTWORK, AND ACCESSORIES. PATCH AND REPAIR AND EXTERIOR WALL AND ROOFTOP PENETRATIONS PER ARCHITECTURAL SPECIFICATIONS.

#### **MECHANICAL PLAN NOTES**

PROVIDE NEW ROOFTOP UNIT AND CURB ON ROOF. COORDINATE FINAL LOCATION WITH STRUCTURAL ENGINEER. ROUTE 1/2" LINED SUPPLY AND RETURN DUCTWORK DOWN THROUGH CURB TO SPACE BELOW. 2 PROVIDE 1/2" LINED RETURN BOOT ON UNIT RETURN.

3 PROVIDE 1/2" LINED 10X10 RETURN AIR TRANSFER BOOT POINTED UP TOWARDS CEILING.

PROVIDE NEW EXHAUST FAN AND CURB ON ROOF. COORDINATE FINAL LOCATION WITH STRUCTURAL ENGINEER. ROUTE EXHAUST DUCTWORK DOWN THROUGH CURB TO SPACE BELOW


PROVIDE THERMOSTAT AND CONTROL WIRING FOR ROOFTOP UNIT. MOUNT THERMOSTAT AT SAME ELEVATION AS ADJACENT LIGHT SWITCHES AND WALL ACCESSORIES. COORDINATE FINAL LOCATION AND FINISH WITH ARCHITECT ARCHITECT (6) OUTSIDE AIR INTAKE HOOD ON ROOFTOP EQUIPMENT.

209 LEE

**COPYRIGHT © BY COLLINS WEBB** ARCHITECTURE, LLC

REVISION DATES:

1 City Comments & 08.08.2023 VE Revisions

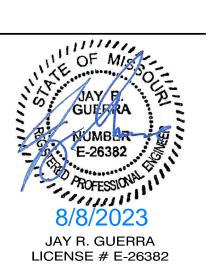

PRINTED COPIES OF THIS DOCUMENT ARE NOT CONSIDERED SIGNED AND SEALED AND THE SIGNATURE MUST BE VERIFIED ON ANY ELECTRONIC COPIES PROFESSIONAL SEAL

MECHANICAL PLAN

COLLINS WEBB #: 23033

THIS DRAWING IS A SINGLE PART OF AN INTEGRATED SET OF CONSTRUCTION CONTRACT DOCUMENTS. REFER TO DRAWING AND SPECIFICATION SHEETS INCLUDING, BUT NOT LIMITED TO, ALL "GENERAL CONDITIONS", "SUMMARY OF WORK", AND APPLICABLE SPECIFICATION SECTIONS WHICH APPLY TO THIS DRAWING. REFER TO ALL DOCUMENTS FOR THE COMPLETE SCOPE OF WORK. THE CONTRACTOR WILL BE RESPONSIBLE FOR ALL INFORMATION CONTAINED IN THE "SET" OF DOCUMENTS ISSUED. THIS DRAWING IS SCHEMATIC AND IS NOT DIE USED AS A SHOP DRAWING. ALTERATIONS FROM THAT SHOWN REQUIRED TO COORDINATE WITH OTHER TRADES OR TO CONFORM TO ACTUAL SITE CONDITIONS ARE THE CONTRACTOR'S RESPONSIBILITY. VERIFY THE LOCATIONS OR DIMENSIONS OF ALL ARCHITECTURAL AND STRUCTURAL AND STRUCTURAL AND STRUCTURAL AND STRUCTURAL AND STRUCTURAL DRAWINGS ISSUED. THE SHOWING OF THESE ELEMENTS ARE FOR REFERENCE ONLY AND ARE TO BE VERIFIED PRIOR TO DESIGN OR CONSTRUCTION. NO LIABILITY IS ASSUMED BY THE INDICATION OF ELEMENTS IN THESE DRAWINGS. THE ACCOMPANYING PROFESSIONAL SEAL INDICATES THAT THE PERSON WHOSE NAME APPEARS ON THE SEAL HAS PREPARED OR SUPERVISED PREPARATION OF THE DOCUMENT ON WHICH THE SEAL APPEARS. THAT PERSON AND THE FIRM FOR WHICH THAT PERSON IS EMPLOYED BY DISCLAIM RESPONSIBILITY FOR ANY PORTIONS OF THE WORK ON WHICH THEIR SEAL DOES NOT APPEAR. THIS DOCUMENT SHALL NOT BE USED FOR ANY OTHER PROJECTS, FOR ADDITIONS TO THIS PROJECT, OR FOR COMPLETION OF THE PROJECT BY OTHERS WITHOUT THE PRIOR WRITTEN CONSENT OF GIBBENS DRAKE SCOTT. ANY INDIVIDUAL AND/OR COMPANY THAT USES THIS DOCUMENT UNAUTHORIZED, AGREES TO THE FULLEST EXTENT OF THE LAW, TO INDEMNIFY AND HOLD HARMLESS GIBBENS DRAKE SCOTT, INC., IT'S OFFICERS, DIRECTORS AND EMPLOYEES AGAINST ANY DAMAGES, LIABILITIES OR COSTS, INCLUDING REASONABLE ATTORNEY'S FEES AND COSTS OF DEFENSE, ARISING OUT OF THE MISUSE OF THIS DOCUMENT.

PROVIDE ONE EXPANSION TANK WITH ASME RATING AND CAPACITY OF 10 GALS. AMTROL THERM-X-ROL ST-25V-C. SET OPERATING TEMPERATURE OF WATER HEATER AT 140°F AND CIRCULATE 140°F HOT WATER THRU SYSTEM. PROVIDE POINT OF USE MIXING VALVES ON HOT WATER SUPPLY TO FAUCETS. PROVIDE A 210'F TEMPERATURE AND 150 PSI PRESSURE RELIEF VALVE WITH TEST LEVER SIZED WITH AGA/CGA TEMPERATURE STEAM RATING 10% OVER HEATER INPUT.

PUN	MP SCHED	ULE										
MARK	MANUFACTURER	MODEL	TYPE	DESIGN COND	ITIONS			MOTOR D	ATA	ELECTRICAL	SERVICE	REMARKS
PP				FLUID	FLOW	PRESSURE	CONTROL	MOTOR	MOTOR	VOLTS/ø/HZ	]	
$\left\langle \begin{array}{c} \\ \end{array} \right\rangle$	<b>'</b>	'		TEMP ('F)	(GPM)	HEAD (FT)	HEAD (FT)	RPM	WATTS			
$\square$												
PP-1	BELL & GOSSETT	ECOCIRC 20-18	INLINE CIRCULATOR	140	4	10	3	3638	70	120/1/60	DOMESTIC WATER CIRCULATION	NOTES 1,2,&3
NOTES	•			•		•	•	•	•	•		

FURNISH COMBINATION MOTOR STARTER/DISCONNECT SWITCH TO ELECTRICAL CONTRACTOR FOR INSTALLATION. PROVIDE CONTROL FOR DOMESTIC HOT WATER CIRCULATION TO MAINTAIN A MINIMUM OF 135°F RETURN WATER TEMPERATURE.

PROVIDE ISOLATION VALVES, STRAINER, AND CHECK VALVE. REFER TO DETAIL.

CONSTRAINTS OF THE EXISTING CONDITIONS OF THE PROJECT SITE. PROVIDE DUCT RISES AND DROPS AS REQUIRED FOR FIELD INSTALLATION AND TRADE COORDINATION. NOTIFY ARCHITECT OF ANY DISCREPANCIES BEFORE STARTING WORK.
AFTER REMOVING PIPING SUSPENDED FROM STRUCTURE ABOVE CEILING, AND DOWN IN PARTITIONS TO SERVE FIXTURE AND EQUIPMENT — REPAIR ALL WALLS, CEILINGS, AND FLOORS, THAT ARE TO REMAIN AFTER THE REMODELING IS FINISHED.
ALL PIPING NOT EXISTING TO REMAIN SHALL BE DISCONNECTED AND REMOVED FROM EXISTING PLUMBING SYSTEM.
ALL WORK SHALL COMPLY WITH STATE AND LOCAL CODE REQUIREMENTS AS APPROVED AND AMENDED BY THE GOVERNING CITY, INCLUDING APPLICABLE SECTIONS OF NFPA, OSHA, INTERNATIONAL BUILDING CODES, OR ANY INTERIM AMENDMENTS AT THE TIME OF THE PROPOSAL. PURCHASE ALL PERMITS ASSOCIATED WITH THE WORK. OBTAIN ALL INSPECTIONS REQUIRED BY CODE.

**GENERAL PLUMBING DEMO NOTES** 

CONTRACTORS AND SUB-CONTRACTORS SHALL CAREFULLY REVIEW THE

WORK IS DISPERSED THROUGHOUT THE DOCUMENT SET AND CANNOT BE

FURNISHED BY OTHERS, REQUIREMENTS OF THE OWNER, AND WITH THE

CONSTRUCTION DOCUMENTS. INFORMATION REGARDING THE COMPLETE

ACCURATELY DETERMINED WITHOUT REFERENCE TO THE COMPLETE

COORDINATE WITH THE WORK OF OTHER SECTIONS, EQUIPMENT

DOCUMENT SET.

***	PLUMBI	NG FIXTUR	RE SCHEDULE
MARK	MANUF.	MODEL NO.	DESCRIPTION
FD-1	SIOUX CHIEF	822 SERIES	FINISH-LINE HALO SYSTEM, ENAMEL-COATED DUCTILE IRON BODY WITH NO-HUB CONNECTION, WITH 18 GAUGE STAINLESS STEEL DECK MOUNTING FLANGE 9 1/2" IN DIAMETER. WITH BRONZE HEEL-PROOF GRATE WITH VANDAL PROOF SCREWS. WITH 0" TO 3/4" ADJUSTABLE STRAINER. FOR USE IN SUSPENDED SLABS WITH TOP OF DRAIN FLUSH WITH FINISHED FLOOR.
FCO	SIOUX CHIEF	822 SERIES	FINISH-LINE HALO SYSTEM, ENAMEL-COATED DUCTILE IRON BODY WITH NO-HUB CONNECTION, WITH 18 GAUGE STAINLESS STEEL DECK MOUNTING FLANGE 9 1/2" IN DIAMETER. WITH BRONZE FLOOR CLEANOUT COVER WITH VANDAL PROOF SCREWS. WITH 0" TO 3/4" ADJUSTABLE STRAINER. FOR USE IN SUSPENDED SLABS WITH TOP OF DRAIN FLUSH WITH FINISHED FLOOR.
TG-1	RECTORSEAL	SURESEAL	TRAP GUARD: INLINE HDPE HOUSING WITH INLINE DIAPHRAGM AND SOFT EPDM RUBBER SEALING GASKET PER ASSE 1072.
LV-1	тото	LT307.4	WALL HUNG SINK (SINGLE): $20-7/8" \times 18"$ VITREOUS CHINA LAVATORY BASIN, WITH CONCEALED CARRIER ARM, 4" CENTERS, 4" TAIL PIECE, AND $1-1/2"$ GRID STRAINER OPENING, ADA COMPLIANT.
	KOHLER	K-99760-4N	FAUCET: SINGLE LEVER OPERATED 0.5 GPM, MATTE BLACK FINISH 4-1/4" TALL 4-3/16" REACH RIGID SPOUT WITH SINGLE HOLE MOUNT. CERAMIC DISK VALVES. MEETS NSF/ANSI 61.
MXV	WATTS	SERIES LM495	THERMOSTATIC TEMPERING VALVE CONSTRUCTED OF SOLID BRASS. ALL INTERNAL COMPONENTS SHALL BE CORROSION—RESISTANT. VALVE SHALL FEATURE INTERNAL CHECK TO PREVENT CROSS—FLOW AND INLET SCREENS TO FILTER OUT DEBRIS. VALVE SHALL BE CSA B125 CERTIFIED, ASSE 1016 AND 1070 LISTED. 1/2" INLETS, 1/2" OUTLET.
			PROVIDE OFF-SET GRID STRAINER AND TAILPIECE WITH 1-1/2" 17-GAUGE CHROME-PLATED SEMI-CAST BRASS OFF-SET P-TRAP WITH CLEANOUT AND WASTE ARM TO WALL WITH ESCUTCHEON, RISERS WITH LEAD FREE CHECK VALVES AND LEAD FREE QUARTER TURN LOOSE KEY ANGLE STOPS. WHERE PIPING AND ACCESSORIES ARE EXPOSED BELOW COUNTERTOP, PROVIDE ADA COMPLIANT VANDAL RESISTANT INSULATED COVERS.
			REFER TO ARCHITECTURAL DRAWINGS FOR MOUNTING HEIGHT.
S-1	ELKAY	ELUH281610PD	SINK: UNDER COUNTER MOUNTED 30-3/4"x18-1/2"x10" DEEP SINGLE COMPARTMENT 18 GAUGE 304 STAINLESS STEEL WITH SATIN FINISH, 1.5" DRAIN OPENING, HEAVY DUTY SOUND GUARD UNDERCOATING. SEAL LIP OF SINK BASIN TO UNDERSIDE OF COUNTERTOP WITH SILICONE CAULK. PROVIDE UNDERMOUNT BRACKETS.
	DELTA	TRINSIC (LS)9159—ARLS—DST	FAUCET: MANUAL, MATTE BLACK FINISH, 16-5/8" TALL 9" REACH GOOSENECK, 140° LIMITED SWIVEL SPOUT, 1-HOLE CENTER DECK MOUNT, LEVER HANDLE, LEAD-FREE, WITH A FLOW RATE OF 1.5 GPM, AND INTEGRAL NECK PULL DOWN SPRAYER. PROVIDE ASSE 1070 COMPLIANT TEMPERATURE MIXING VALVE. MEETS NSF/ANSI COMPLIANT.
MXV	WATTS	SERIES LM495	THERMOSTATIC TEMPERING VALVE CONSTRUCTED OF SOLID BRASS. ALL INTERNAL COMPONENTS SHALL BE CORROSION—RESISTANT. VALVE SHALL FEATURE INTERNAL CHECK TO PREVENT CROSS—FLOW AND INLET SCREENS TO FILTER OUT DEBRIS. VALVE SHALL BE CSA B125 CERTIFIED, ASSE 1016 AND 1070 LISTED. 1/2" INLETS, 1/2" OUTLET.
	INSINKERATOR	BADGER 5	GARBAGE DISPOSAL: CONTINUOUS FEED WITH WALL SWITCH ON/OFF CONTROL. 120V/1 PHASE/60 HZ, 1/2 HP MOTOR WITH MANUAL RESET OVERLOAD. PERMANENTLY LUBRICATED UPPER AND LOWER BEARINGS. STAINLESS STEEL GRINDING ELEMENTS WITH TWO 360 DEGREE SWIVEL LUGS. OVERALL HEIGHT OF 11-1/2". 1-1/2" CUSHIONED SLIP JOINT DRAIN CONNECTION. PROVIDE DISHWASHER DRAIN CONNECTION AND FACTORY INSTALLED POWER CORD.
			PROVIDE OFF-SET GRID STRAINER AND TAILPIECE WITH 1-1/2" 17-GAUGE CHROME-PLATED SEMI-CAST BRASS OFF-SET P-TRAP WITH CLEANOUT AND WASTE ARM TO WALL WITH ESCUTCHEON, RISERS WITH LEAD FREE CHECK VALVES AND LEAD FREE QUARTER TURN LOOSE KEY ANGLE STOPS. WHERE PIPING AND ACCESSORIES ARE EXPOSED BELOW COUNTERTOP, PROVIDE ADA COMPLIANT VANDAL RESISTANT INSULATED COVERS.
WC-1	тото	CWT427227CMEC#MS	REFER TO ARCHITECTURAL DRAWINGS FOR MOUNTING HEIGHT.  WATER CLOSET: WHITE VITREOUS CHINA WITH ANTI-MICROBIAL CERAMIC GLAZE, 1.28/.09 GPF
WC-1		"	DUAL FLUSH SYSTEM, D-SHAPE BOWL, WALL MOUNTED, COMPACT.
	тото	WT172M	CARRIER: IN-WALL CARRIER AND TANK UNIT, 1.28/0.9 GPF DUAL FLUSH SYSTEM. 1/2" NPT WATER SUPPLY CONNECTION FOR WASHLET. RATED FOR 880 LB. MEETS ASME A112.6.2. PROVIDE WITH FLUSH SYSTEM PUSH PLATE IN WHITE FINISH.
	тото	SS227#01	TOILET SEAT: SOLID PLASTIC D—SHAPED SEAT WITH SOFTCLOSE SYSTEM. INTEGRAL BUMPERS. HINGES TO BE COLOR MATCHED WITH METAL STUD AND NUT. PROVIDE MANUFACTURER'S MOUNTING HARDWARE
			REFER TO ARCHITECTURAL DRAWINGS FOR MOUNTING HEIGHT.
WB-1	SIOUX CHIEF	696 SERIES	ICE MAKER WALL BOX: NSF-372 COMPLIANT, WITH ASSE1010 MINI ARRESTOR. STANDARD PACK WITH WHITE FRAME.PROVIDE BOX WITH EXTENSION COLLAR AND TRIM RING. MOUNT WITHIN CASEWORK.
UR-1	тото	UT105UVG	URINAL: WHITE VITREOUS CHINA WITH ANTI-MICROBIAL CERAMIC GLAZE, WALL HUNG, WASHOUT FIXTURE. 0.125 GPF WITH 3/4" BACK SPUD.
	тото	TEU2UA11#SS	FLUSH VALVE: CONCEALED CHROME FINISH, 0.125 GPF, POWERED WITH SENSOR OPERATED PISTON TYPE FLUSH VALVE, WITH MANUAL MECHANICAL OVERRIDE BUTTON. PROVIDE MANUFACTURER'S HYDROPOWERED ENERGY GENERATING ACCESSORY. BRASS PISTON WITH CHLORAMINE RESISTANT EPDM SEAT AND SEALS, SELF CLEANING MECHANISM, ESCUTCHEON, INTEGRAL QUARTER TURN LOOSE KEY ANGLE STOP, VACUUM BREAKER, AND SWEAT ADAPTER KIT.
			FLOOR MOUNTED CARRIER WITH HANGER PLATE AND BEARING PLATE BY J.R. SMITH. REFER TO ARCHITECTURAL DRAWINGS FOR MOUNTING HEIGHT.
MB-1	STERN-WILLIAMS	SB-902	24"x24"x12" MOP SERVICE BASIN, CAST BRASS DRAIN, STAINLESS STEEL DOME STRAINER, 3" DRAIN CONNECTION, WITH STAINLESS STEEL BUMPER GUARD ON ALL SIDES, 10" STAINLESS STEEL BACK PANEL ON TWO SIDES. WILLIAMS NO. T-35 3 FT. RUBBER HOSE WITH STAINLESS STEEL WALL BRACKET. PROVIDE WALL HUNG MOP RACK.
	ZURN	Z8431M1-RC	SERVICE SINK FAUCET, POLISHED CHROME FINISH, BUILT—IN STOPS, LEVER HANDLES, LOWER WALL BRACE ASSEMBLY, VACUUM BREAKER, 3/4" HOSE THREAD ON SPOUT, PAIL HOOK, AND INTEGRAL STOPS.

INTEGRAL STOPS.

#### ----- EXISTING TO REMAIN — — — — EXISTING TO BE REMOVED ————— COLD WATER (CW) ———— HOT WATER (HW) SAN SANITARY WASTE, ABOVE GRADE STORM LINE, ABOVE GRADE — ST — STORM LINE, BELOW GRADE ---- PLUMBING VENT ——D—— INDIRECT DRAIN PITCH UP/DN IN FLOW OF ARROW FLOW ARROW TEMPERED WATER + HB HOSE BIBB (HB) OR WALL HYDRANT (WH) FLOOR CLEANOUT WALL CLEANOUT —— wco <u>—</u>со FLOOR DRAIN, ROUND FLOOR SINK **C**→ ELBOW DOWN O+---- ELBOW UP <del>C C TEE</del> DOWN **├───** TEE UP END CAP CHECK VALVE REDUCER - CONCENTRIC REDUCER - ECCENTRIC → UNION – SCREWED DEMOLITION PLUMBING PLAN NOTE PLUMBING PLAN NOTE FIRE PROTECTION PLAN NOTE FIXTURE IDENTIFICATION REVISION NOTE

POINT OF CONNECTION NEW/EXISTING

AFF/AFG ABOVE FINISHED FLOOR/GRADE

EXISTING TO REMAIN

GARBAGE DISPOSER

FILTERED WATER

HOT WATER

LAVATORY

MOP BASIN

MIXING VALVE

SANITARY WASTE

WATER CLOSET

NOTE: NOT ALL SYMBOLS AND ABBREV. ARE APPLICABLE TO THIS PROJECT.

MARK DESCRIPTION C.W. H.W. WASTE VENT REMARKS

WC WATER CLOSET 3/4" - 3" 2" FLUSH TANK FLOOR MOUNTED

LV | LAVATORY | 1/2" | 1/2" | 1 1/2" | 1 1/2" | WALL HUNG

MB | MOP BASIN | 1/2" | 1/2" | 3" | 2" | FLOOR MOUNTED

URINAL 3/4" - 2" 2"

NOTE: PIPE SIZES SHOWN ARE MINIMUM AND REQUIRED UNLESS NOTED

SINK | 1/2" | 1/2" | 1 1/2" | COUNTER MOUNTED

WALL HUNG

WALL HYDRANT

FIXTURE BRANCH SCHEDULE

FD | FLOOR DRAIN | - | - | \* | 2" |

OTHERWISE.

ELECTRIC WATER COOLER

HOT WATER CIRCULATION

NON- POTABLE COLD WATER

TEMPERED HOW WATER

TR TEMPERED HOT WATER RETURN

CW COLD WATER

ETR

PLUMBING SYMBOLS LEGEND

## PLUMBING GENERAL NOTES

SPECIFICATIONS, REFER TO "MECHANICAL" AND "PLUMBING" SECTION SERIES "GENERAL CONDITIONS"/ "SUMMARY OF WORK" SECTIONS AND ELSEWHERE I DRAWINGS FOR FURTHER INFORMATION AND REQUIREMENTS FOR PLUMBING CONTRACTOR.

- . CONTRACTORS AND SUB-CONTRACTORS SHALL CAREFULLY REVIEW THE CONSTRUCTION DOCUMENTS AND FIELD VERIFY ALL EXISTING UTILITY CONSTRUCTION DOCUMENTS AND FIELD VERIFY ALL EXISTING UTILITY
  CONNECTIONS & COORDINATE WORK WITH OTHER TRADES PRIOR TO FLOOR
  CUTTING, LAYOUT OF PIPING, SUBMITTAL OF SHOP DRAWINGS OR ORDERING
  OF EQUIPMENT. IF ITEMS ARE DISCOVERED THAT AFFECT THE COMPLETION
  OF PROJECT WORK, THEY SHALL BE BROUGHT TO THE ATTENTION OF THE
  CONSTRUCTION MANAGER AT THIS TIME. INFORMATION REGARDING THE
  COMPLETE WORK IS DISPERSED THROUGHOUT THE DOCUMENT SET AND
  CANNOT BE ACCURATELY DETERMINED WITHOUT REFERENCE TO THE
  COMPLETE DOCUMENT SET COMPLETE DOCUMENT SET.
- ALL WORK SHALL COMPLY WITH STATE AND LOCAL CODE REQUIREMENTS AS APPROVED AND AMENDED BY THE GOVERNING CITY, INCLUDING APPLICABLE SECTIONS OF NFPA, OSHA, BUILDING, MECHANICAL, PLUMBING AND FIRE CODES, OR ANY INTERIM AMENDMENTS AT THE TIME OF THE PROPOSAL. PURCHASE ALL PERMITS ASSOCIATED WITH THE WORK. OBTAIN ALL INSPECTIONS REQUIRED BY CODE.
- O. COORDINATE WITH THE WORK OF OTHER SECTIONS, EQUIPMENT FURNISHED BY OTHERS, REQUIREMENTS OF THE OWNER, AND WITH THE CONSTRAINTS OF THE EXISTING CONDITIONS OF THE PROJECT SITE. PROVIDE PIPE RISES AND DROPS AS REQUIRED FOR FIELD INSTALLATION AND TRADE COORDINATION. NOTIFY ARCHITECT OF ANY DISCREPANCIES BEFORE
- DRAWINGS FOR PLUMBING WORK ARE DIAGRAMMATIC, SHOWING THE GENERAL LOCATION, TYPE, LAYOUT, AND EQUIPMENT REQUIRED. THE DRAWINGS SHALL NOT BE SCALED FOR EXACT MEASUREMENT. REFER TO ARCHITECTURAL DRAWINGS FOR DIMENSIONS. REFER TO MANUFACTURER'S STANDARD INSTALLATION DRAWINGS FOR EQUIPMENT CONNECTIONS AND INSTALLATION REQUIREMENTS. PROVIDE PIPE, CONNECTIONS, ACCESSORIES, AND MATERIALS NECESSARY FOR A COMPLETE SYSTEM.
- REFER TO ARCHITECTURAL DRAWINGS FOR EXACT LOCATIONS OF PLUMBING
- REFER TO PLUMBING DETAIL SHEETS FOR SCHEDULES, DETAILS, AND FIXTURE CONNECTION SCHEDULES FOR FINAL PIPE CONNECTION SIZES TO FIXTURES. . SUSPEND ALL HORIZONTAL SERVICE PIPING SHOWN ON THIS PROJECT SUCH AS, BUT NOT LIMITED TO, WATER, CHEM WASTE/ VENT, SAN. WASTE/VENT, GAS, ETC. FROM UNDERSIDE OF ROOF AND/OR FLOOR STRUCTURE, UNLESS OTHERWISE NOTED OR INDICATED. HOLD SUCH PIPING HIGH AS POSSIBLE. EXTEND PIPING DOWN IN WALLS, PARTITIONS, CHASES, ETC.. TO SERVE
- FIXTURES AND EQUIPMENT AS SHOWN ON PLANS. PROVIDE GUARD (TG-1) ON ALL FLOOR DRAINS AND FLOOR SINKS.

M. DEAD LEGS LONGER THAN 24" ARE PROHIBITED IN DOMESTIC HOT WATER

- REFER TO LABORATORY EQUIPMENT DRAWINGS FOR FINAL EQUIPMENT
- CONNECTION REQUIREMENTS, I.E. LOCATION AND SIZE. ALL VALVES FOR MAINTENANCE SHUT OFF SHALL BE IN AN ACCESSIBLE
- SEAL ALL PIPE PENETRATIONS THROUGH FLOOR WITH A WATER TIGHT SEAL. REFER TO PIPE THROUGH CONCRETE FLOOR DETAIL ON DETAIL SHEET.




99 EE 7

**COPYRIGHT © BY COLLINS WEBB** ARCHITECTURE, LLC

REVISION DATES:

1 City Comments & 08.08.2023 VE Revisions

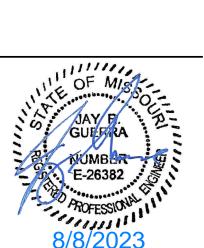

LICENSE # E-26382 PRINTED COPIES OF THIS DOCUMENT ARE NOT CONSIDERED SIGNED AND SEALED AND THE SIGNATURE MUST BE VERIFIED ON ANY ELECTRONIC COPIES PROFESSIONAL SEAL

JAY R. GUERRA

PLUMBING LEGEND AND SCHEDULES

COLLINS WEBB #:

THIS DRAWING IS A SINGLE PART OF AN INTEGRATED SET OF CONSTRUCTION CONTRACT DOCUMENTS. REFER TO DRAWING AND SPECIFICATION SHEETS INCLUDING, BUT NOT LIMITED TO, ALL "GENERAL CONDITIONS", "SUMMARY OF WORK", AND APPLICABLE SPECIFICATION SECTIONS WHICH APPLY TO THIS DRAWING. REFER TO ALL DOCUMENTS FOR THE COMPLETE SCOPE OF WORK. THE CONTRACTOR WILL BE RESPONSIBLE FOR ALL INFORMATION CONTAINED IN THE "SET" OF DOCUMENTS ISSUED. THIS DRAWING IS SCHEMATIC AND IS NOT TO BE USED AS A SHOP DRAWING. ALTERATIONS FROM THAT SHOWN REQUIRED TO COORDINATE WITH OTHER TRADES OR TO CONFORM TO ACTUAL SITE CONDITIONS ARE THE CONTRACTOR'S RESPONSIBILITY. VERIEY THE LOCATIONS OR DIMENSIONS OF ALL ARCHITECTURAL AND STRUCTURAL ELEMENTS WITH THE ARCHITECTURAL AND STRUCTURAL DRAWINGS ISSUED. THE SHOWING OF THESE ELEMENTS IN THESE DRAWINGS. THE ACCOMPANYING PROFESSIONAL SEAL INDICATES THAT THE PERSON WHOSE NAME APPEARS ON THE SEAL HAS PREPARED OR SUPERVISED PREPARATION OF THE DOCUMENT ON WHICH THE SEAL APPEARS. THAT PERSON AND THE FIRM FOR WHICH THAT PERSON IS EMPLOYED BY DISCLAIM RESPONSIBILITY FOR ANY PORTIONS OF THE WORK ON WHICH THEIR SEAL DOES NOT APPEAR. THIS DOCUMENT SHALL NOT BE USED FOR ANY OTHER PROJECTS, FOR ADDITIONS TO THIS PROJECT, OR FOR COMPLETION OF THE PROJECT BY OTHERS WITHOUT THE PRIOR WRITTEN CONSENT OF GIBBENS DRAKE SCOTT. ANY INDIVIDUAL AND/OR COMPANY THAT USES THIS DOCUMENT UNAUTHORIZED, ACREES TO THE FULLEST EXTENT OF THE LAW, TO INDEMNIFY AND HOLD HARMLESS GIBBENS DRAKE SCOTT, INC., IT'S OFFICERS, DIRECTORS AND EMPLOYEES AGAINST ANY DAMAGES, LIABILITIES OR COSTS, INCLUDING REASONABLE ATTORNEY'S FEES AND COSTS OF DEFENSE, ARISING OUT OF THE MISUSE OF THIS DOCUMENT

#### **PLUMBING GENERAL NOTES**

- A. CONTRACTORS AND SUB-CONTRACTORS SHALL CAREFULLY REVIEW THE CONSTRUCTION DOCUMENTS. INFORMATION REGARDING THE COMPLETE WORK IS DISPERSED THROUGHOUT THE DOCUMENT SET AND CANNOT BE ACCURATELY DETERMINED WITHOUT REFERENCE TO THE COMPLETE
- B. SPECIFICATIONS, REFER TO "MECHANICAL" AND "PLUMBING" SECTION SERIES, "GENERAL CONDITIONS"/ "SUMMARY OF WORK" SECTIONS AND ELSEWHERE IN DRAWINGS FOR FURTHER INFORMATION AND REQUIREMENTS FOR PLUMBING CONTRACTOR.
- C. CONTRACTORS AND SUB-CONTRACTORS SHALL CAREFULLY REVIEW THE CONSTRUCTION DOCUMENTS AND FIELD VERIFY ALL EXISTING UTILITY CONNECTIONS & COORDINATE WORK WITH OTHER TRADES PRIOR TO FLOOR CUTTING, LAYOUT OF PIPING, SUBMITTAL OF SHOP DRAWINGS OR ORDERING OF EQUIPMENT. IF ITEMS ARE DISCOVERED THAT AFFECT THE COMPLETION OF PROJECT WORK, THEY SHALL BE BROUGHT TO THE ATTENTION OF THE CONSTRUCTION MANAGER AT THIS TIME. INFORMATION REGARDING THE COMPLETE WORK IS DISPERSED THROUGHOUT THE DOCUMENT SET AND CANNOT BE ACCURATELY DETERMINED WITHOUT REFERENCE TO THE COMPLETE DOCUMENT SET.
- D. ALL WORK SHALL COMPLY WITH STATE AND LOCAL CODE REQUIREMENTS AS APPROVED AND AMENDED BY THE GOVERNING CITY, INCLUDING APPLICABLE SECTIONS OF NFPA, OSHA, INTERNATIONAL BUILDING CODES, OR ANY INTERIM AMENDMENTS AT THE TIME OF THE PROPOSAL. PURCHASE ALL PERMITS ASSOCIATED WITH THE WORK. OBTAIN ALL INSPECTIONS REQUIRED BY CODE.
- E. COORDINATE WITH THE WORK OF OTHER SECTIONS, EQUIPMENT FURNISHED BY OTHERS, REQUIREMENTS OF THE OWNER, AND WITH THE CONSTRAINTS OF THE EXISTING CONDITIONS OF THE PROJECT SITE. PROVIDE DUCT RISES AND DROPS AS REQUIRED FOR FIELD INSTALLATION AND TRADE COORDINATION. NOTIFY ARCHITECT OF ANY DISCREPANCIES BEFORE STARTING WORK.
- F. DRAWINGS FOR PLUMBING WORK ARE DIAGRAMMATIC, SHOWING THE GENERAL LOCATION, TYPE, LAYOUT, AND EQUIPMENT REQUIRED. THE DRAWINGS SHALL NOT BE SCALED FOR EXACT MEASUREMENT. REFER TO ARCHITECTURAL DRAWINGS FOR DIMENSIONS. REFER TO MANUFACTURER'S STANDARD INSTALLATION DRAWINGS FOR EQUIPMENT CONNECTIONS AND INSTALLATION REQUIREMENTS. PROVIDE PIPE, CONNECTIONS, ACCESSORIES, AND MATERIALS NECESSARY FOR A COMPLETE SYSTEM.
- G. SUSPEND ALL HORIZONTAL SERVICE PIPING SHOWN ON THIS PROJECT SUCH AS, BUT NOT LIMITED TO, WATER, CHEM WASTE/ VENT, SAN. WASTE/VENT, GAS, ETC. FROM UNDERSIDE OF ROOF AND/OR FLOOR STRUCTURE, UNLESS OTHERWISE NOTED OR INDICATED. HOLD SUCH PIPING HIGH AS POSSIBLE. EXTEND PIPING DOWN IN WALLS, PARTITIONS, CHASES, ETC.. TO SERVE FIXTURES AND EQUIPMENT AS SHOWN ON

## **PLUMBING PLAN DEMOLITION NOTES**

(1) DISCONNECT AND REMOVE ALL ABOVE GRADE PLUMBING PIPING, EQUIPMENT, AND ACCESSORIES. SANITARY PIPING TO BE REMOVED TO BELOW FLOOR LINE AND CAPPED. PATCH AND REPAIR FLOOR PER ARCHITECTURAL SPECIFICATIONS.

#### **PLUMBING PLAN NOTES**

(1) EXISTING BELOW GRADE SANITARY PIPING IS UNKNOWN. CONTRACTOR MAY CHOOSE TO USE EXISTING BELOW GRADE SANITARY PIPING UPON VERIFICATION OF SUFFICIENT SIZE (3" OR LARGER), DEPTH, AND HAS


INSPECTED AND IDENTIFIED ANY DEFICIENCIES IN THE LINE.

- (2) CONTRACTOR TO FIELD VERIFY EXISTING DOMESTIC WATER ENTRY. PREVENTER. IF BACKFLOW PREVENTER IS NOT INSTALLED, PROVIDE AND INSTALL NEW BACKFLOW PREVENTER AT WATER ENTRY PER WATER ENTRY DETAIL ON DETAIL SHEETS.
- (3) SAW CUT FLOOR AS REQUIRED FOR NEW BELOW GRADE PIPING INDICATED. FIELD VERIFY EXISTING CONDITIONS PRIOR TO SAW CUTTING. PATCH AND REPAIR FLOOR PER ARCHITECTURAL SPECIFICATIONS.
- 4) PROVIDE FLOOR DRAIN FD-1 AT SIZE INDICATED ON PLANS. INSTALL PER COMBINATION WASTE & VENT CRITERIA UNLESS A DRY VENT CONNECTION IS SHOWN. REFER TO PLUMBING FIXTURE SCHEDULE AND FIXTURE BRANCH SCHEDULE FOR ADDITIONAL INFORMATION
- (5) PROVIDE NEW ELECTRIC WATER HEATER EWH-1 SUSPENDED FROM STRUCTURE ABOVE. PROVIDE 1" DOMESTIC COLD WATER AND 1" DOMESTIC HOT WATER CONNECTIONS WITH ISOLATION VALVES. PROVIDE HARD COPPER T&P RELIEF AND DRAIN LINES FROM WATER HEATER TO ADJACENT MOP SINK AND TERMINATE WITH INDIRECT WASTE. REFER TO DETAILS SHEETS.
- (6) PROVIDE NEW HOT WATER CIRCULATION PUMP PP-1. REFER TO DETAILS
- (7) ROUTE 2" VENT, 3/4" DOMESTIC COLD WATER, 3/4" DOMESTIC HOT WATER, AND 3/4" RECIRCULATION LINE DOWN IN CHASE, THROUGH CASEWORK TO SINK S-1.
- (8) provide 3/4" domestic cold water drop down in chase to within |CASEWORK UNDER SINK S-1. PROVIDE 1/2" CONNECTION FOR SINK S-1 AND 3/4" CONNECTION WITH ACCESSORIES TO SERVE ICE MAKER (BY OTHERS). REFER TO DETAILS SHEETS.
- (9) ROUTE 3/4" FILTERED DOMESTIC WATER BELOW GRADE TO SERVE ICE MAKER (BY OTHERS). INSULATE BELOW GRADE PIPING WITH 1-1/2" CELLULAR GLASS INSULATION RATED FOR DIRECT-BURY (FOAMGLAS OR APPROVED EQUIVILENT). STUB UP IN CASEWORK AND CONNECT TO WALL BOX WB-1.
- (10) PROVIDE NEW COUNTER MOUNT SINK S-1. PROVIDE 1/2" DOMESTIC HOT AND COLD WATER CONNECTIONS, 2" SANITARY WASTE, AND 2" VENT. REFER TO FIXTURE BRANCH SCHEDULE AND PLUMBING FIXTURE SCHEDULE. DEAD LEGS LONGER THAN 24" ARE PROHIBITED IN HOT WATER SYSTEM.
- (11) Provide New Wall mounted flush valve water closet WC-1. PROVIDE 3/4" COLD WATER CONNECTION WITH ISOLATION VALVE IN CEILING ABOVE AND STOP VALVE AT WALL. PROVIDE 3" SANITARY WASTE TO BELOW GRADE AND 2" VENT TO CEILING ABOVE. REFER TO FIXTURE BRANCH SCHEDULE AND PLUMBING FIXTURE SCHEDULE.
- (12) PROVIDE NEW WALL MOUNTED LAVATORY L-1. PROVIDE 1-1/2" SANITARY WASTE TO BELOW GRADE, 1-1/2" VENT TO CEILING ABOVE. PROVIDE 1/2" DOMESTIC HOT AND COLD WATER CONNECTIONS. REFER TO FIXTURE BRANCH SCHEDULE AND PLUMBING FIXTURE SCHEDULE. DEAD LEGS LONGER THAN 24" ARE PROHIBITED IN HOT WATER SYSTEM.
- (13) PROVIDE NEW WALL MOUNTED FLUSH VALVE WATER CLOSET WC-1. CONNECT INTO EXISTING DOMESTIC COLD WATER AND SANITARY WASTE AND VENT CONNECTIONS. INSPECT EXISTING PIPING PRIOR TO INSTALLATION OF NEW WATER CLOSET AND REPAIR/REPLACE AS
- 14 PROVIDE NEW WALL MOUNTED LAVATORY L-1. PROVIDE NEW 1/2" DOMESTIC HOT WATER CONNECTION FOR LAVATORY. CONNECT INTO EXISTING DOMESTIC COLD WATER AND SANITARY WASTE AND VENT CONNECTIONS. INSPECT EXISTING PIPING PRIOR TO INSTALLATION OF NEW WATER CLOSET AND REPAIR/REPLACE AS REQUIRED.
- (15) PROVIDE NEW WALL MOUNTED URINAL UR-1. PROVIDE 3" SANITARY WASTE TO BELOW GRADE AND 2" VENT TO CEILING ABOVE. PROVIDE 3/4" DOMESTIC COLD WATER CONNECTION WITH ISOLATION VALVE IN CEILING ABOVE REFER TO FIXTURE BRANCH SCHEDULE AND PLUMBING FIXTURE SCHEDULE.
- (16) ROUTE EXPOSED PIPING TIGHT TO STRUCTURE AND AND WALL. COORDINATE WITH ARCHITECT FOR PAINTING AND COLOR REQUIREMENTS.
- (17) EXISTING NATURAL GAS SERVICE TO REMAIN. DISCONNECT AND REMOVE ALL PIPING DOWNSTREAM OF METER AND REGULATOR PER PLUMBING DEMOLITION NOTE 1. PROVIDE NEW 1" NATURAL GAS PIPING UP TO ROOF ABOVE.
- (18) PROVIDE 3/4" NATURAL GAS CONNECTION TO ROOFTOP UNIT WITH REGULATOR AND ISOLATION VALVE. REFER TO ROOFTOP UNIT CONNECTION ON DETAILS SHEET.
- (19) PROVIDE 3/4" DOMESTIC HOT WATER PIPING DOWN IN CHASE TO WITHIN | R CASEWORK UNDER SINK S-1. PROVIDE 1/2" BRANCH TEE CONNECTION FOR SINK S-1 AND 1/2" BRANCH TEE CONNECTION FOR DISHWASHER (BY OTHERS). DEAD LEGS LONGER THAN 24" ARE PROHIBITED. REFER

ОШ 7

**COPYRIGHT © BY COLLINS WEBB** ARCHITECTURE, LLC

REVISION DATES: 1 City Comments & 08.08.2023 VE Revisions

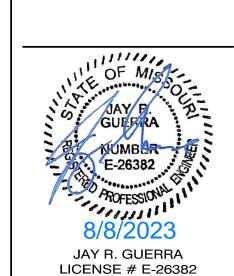

PRINTED COPIES OF THIS DOCUMENT ARE NOT CONSIDERED SIGNED AND SEALED AND THE SIGNATURE MUST BE VERIFIED ON ANY ELECTRONIC COPIES PROFESSIONAL SEAL


PLUMBING PLAN

COLLINS WEBB #: 23033

THIS DRAWING IS A SINGLE PART OF AN INTEGRATED SET OF CONSTRUCTION CONTRACT DOCUMENTS. REFER TO DRAWING AND SPECIFICATION SHEETS INCLUDING, BUT NOT LIMITED TO, ALL "GENERAL CONDITIONS". "SUMMARY OF WORK", AND APPLICABLE SPECIFICATION SECTIONS WHICH APPLY TO THIS DRAWING. REFER TO ALL DOCUMENTS FOR THE COMPLETE SCOPE OF WORK. THE CONTRACTOR WILL BE RESPONSIBLE FOR ALL INFORMATION CONTAINED IN THE "SET" OF DOCUMENTS ISSUED. THIS DRAWING IS SCHEMATIC AND IS NOT TO BE USED AS A SHOP DRAWING. ALTERATIONS FROM THAT SHOWN REQUIRED TO COORDINATE WITH OTHER TRADES OR TO CONFORM TO ACTUAL SITE CONDITIONS ARE THE CONTRACTOR'S RESPONSIBILITY. VERIEY THE LOCATIONS OR DIMENSIONS OF ALL ARCHITECTURAL AND STRUCTURAL ELEMENTS WITH THE ARCHITECTURAL AND STRUCTURAL DRAWINGS ISSUED. THE SHOWING OF THESE ELEMENTS IN THESE DRAWINGS. THE ACCOMPANYING PROFESSIONAL SEAL INDICATES THAT THE PERSON WHOSE NAME APPEARS ON THE SEAL HAS PREPARED OR SUPERVISED PREPARATION OF THE DOCUMENT ON WHICH THE SEAL APPEARS. THAT PERSON AND THE FIRM FOR WHICH THAT PERSON IS EMPLOYED BY DISCLAIM RESPONSIBILITY FOR ANY PORTIONS OF THE WORK ON WHICH THEIR SEAL DOES NOT APPEAR. THIS DOCUMENT SHALL NOT BE USED FOR ANY OTHER PROJECTS, FOR ADDITIONS TO THIS PROJECT, OR FOR COMPLETION OF THE PROJECT BY OTHERS WITHOUT THE PRIOR WRITTEN CONSENT OF GIBBENS DRAKE SCOTT. ANY INDIVIDUAL AND/OR COMPANY THAT USES THIS DOCUMENT UNAUTHORIZED, ACREES TO THE FULLEST EXTENT OF THE LAW, TO INDEMNIFY AND HOLD HARMLESS GIBBENS DRAKE SCOTT, INC., IT'S OFFICERS, DIRECTORS AND EMPLOYEES AGAINST ANY DAMAGES, LIABILITIES OR COSTS, INCLUDING REASONABLE ATTORNEY'S FEES AND COSTS OF DEFENSE, ARISING OUT OF THE MISUSE OF THIS DOCUMENT



	<sup>-</sup> S/PHASE: 240/120V, 1PH, 3\ T <b>ION: 1</b>	N								SSED RESTROC	M			
CKT	DESCRIPTION		,	VOLTAME	PS/PHASE					VOLTAM			DESCRIPTION	CI
NO.				Α	В	AMP	ľ		AMP	Α	В	Ī		N
1	RTU-1			3,816	11111111111111111	50	2	1	20	900	1111111111111111	Small C	Office, Hall Recept.	7
3							_	1					Office Recept.	<del>  </del>
	RTU-2					40	2		20				Restroom Recept.	1
7				<u>,</u>			_	1			720		ation Power	1
-	EF-1			150	111111111111111111111111111111111111111	20	1	1	20			Worksta	ation Power	1
11	EWH-1			111111111111111111111111111111111111111		30	2			111111111111111111111111111111111111111	720	Worksta	ation Power	1
13					111111111111111111111111111111111111111	ļ		1	20		111111111111111111111111111111111111111	Worksta	ation Power	1
15	PP-1			111111111111111111111111111111111111111	78	20	1	1		111111111111111111111111111111111111111	720	Worksta	ation Power	1
17	Fridge Recept.			1,500	111111111111111111111111111111111111111	20	1	1	20	720	111111111111111111111111111111111111111	Worksta	ation Power	1
19	Microwave Recept.			111111111111111111111111111111111111111	1,500	20	1	1	20	111111111111111111111111111111111111111	180	Rooftop	Recept.	2
21	Dishwasher Recept.			1,500	111111111111111111111111111111111111111	20	1	1	20	726	111111111111111111111111111111111111111	Lights -	Conference Rooms, Offices, Sto	ora 2
23	Garbage Disposal, Counter	Top, I	Lobby Rec	111111111111111111111111111111111111111	1,740	20	1	1	20		701		Lobby, Kitchen, Track Lights, Ba	
25	Microwave Recept.			1,500	111111111111111111111111111111111111111	20	1	1	20	914	111111111111111111111111111111111111111	Lights -	Workstations, Utility, New Restro	00 2
27	Ice Maker Recept.			111111111111111111111111111111111111111	1,500	20	1	1	20			SPARE		2
29	Kitchen Counter, Open Office		,	,	111111111111111111111111111111111111111	20	1	1	20		111111111111111111111111111111111111111			3
31	Breakroom Table, Beverage				1,080	20	1	1	20			SPARE		3
33	Utility, New Restroom, Copy/	File F	Recept.	1,080		20	1	1	20					3
35	Copier Recept.					20	1	1				SPARE		3
37	Small Conf. Room Recept.			900		20	1	1	20		111111111111111111			3
39	Large Conf. Room Recept.			111111111111111111111111111111111111111		20	1	1				SPARE		4
41	Storage/IT Recept.			720		20	1	1	20			SPARE		4
	SUBTOTAL			18,390	19,158					5,060	4,301		SUBTOTAL	
	TOTAL PHASE A - VA 23,4		LOAD		CONN. V	DF		LO		С	ONN. VA			
	AMPS 195		COOLIN		13,920	1.00	1		FRIG			1.00		
	TOTAL PHASE B - VA 23,4		HEATING			0			SNAGE			1.25		
	AMPS 195	_	LIGHTIN			1.25		KIT	CHEN	l		1.00		
	TOTAL PNLBD - VA 46,9	_	RECEPT		24,420				STING	3		1.00		_
	AMPS 195	5	MOTORS			1.00			MTR			1.25	TOTAL DEMAND	_
			SUPP HE		6,000				WIN			1.25	40,284 V	
			MISC EQ	UIP		1.00		LTO	3 TRK			1.00	168	Α

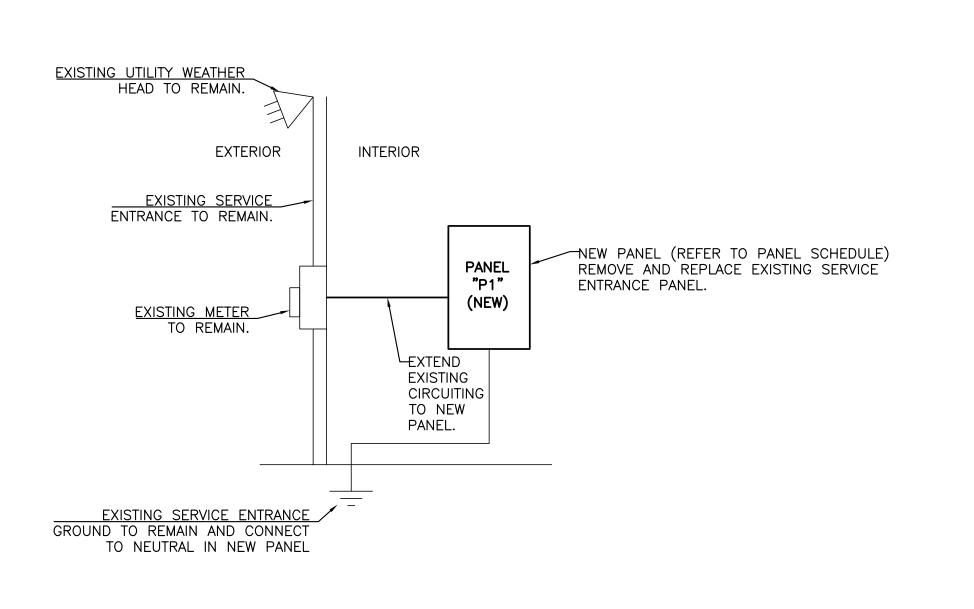

ELECTRICAL RISER DIAGRAM

**ELECTRICAL GENERAL NOTES** 

(SEE SHEET E000 FOR ELECTRICAL GENERAL NOTES)

## **POWER PLAN NOTES**


- 1 PROVIDE A 1-1/4" CONDUIT WITH PULL STRING FROM FLOOR BOX TO UP ABOVE ACCÉSSIBLE CEILING SPACE OF DATA CABLING. TRENCH FLOOR TO THE NEAREST WALL TO INSTALL CONDUIT. MINIMIZE TRENCH QUANTITIES AND LENGTHS TO THE EXTENT POSSIBLE. PATCH FLOOR TO MATCH ARCHITECTURAL FINISHES.
- 2 COORDINATE DEVICE MOUNTING HEIGHT WITH ARCHITECTURAL PLANS.
- 3 PROVIDE RECEPTACLE MOUNTED 12" ABOVE ROOF TO RIGID METAL CONDUIT OR SUITABLE STEEL UNISTRUT SUPPORTS. SEAL ROOF PENETRATION AND PROVIDE FLASHING AS REQUIRED.
- 4 PROVIDE ON-GRADE LISTED, 2-GANG, FLUSH FLOOR BOX WITH FURNITURE CONNECTION COVER PLATE. WIREMOLD RFBA2C300G—RFB24FF
  OR EQUAL. SAW CUT FLOOR AS REQUIRED TO INSTALL BOX. PATCH
  FLOOR TO MATCH ARCHITECTURAL FINISHES. COORDINATE ROUGH—IN LOCATION WITH FURNITURE VENDOR.
- 5 PROVIDE ON-GRADE LISTED, 4-GANG, FLUSH FLOOR BOX WITH RECESSED POWER AND DATA OUTLETS, AND 6" COVER. PROVIDE WITH TWO(2) DUPLEX RECEPTACLES AND ONE DATA OUTLET. WIREMOLD RFBÀ4C300G-6CTC2 OR EQUAL. SAW CUT FLOOR AS REQUIRED TO INSTALL BOX. PATCH FLOOR TO MATCH ARCHITECTURAL FINISHES. COORDINATE ROUGH-IN LOCATION WITH FURNITURE VENDOR.
- 6 TRENCH FLOOR TO NEAREST WALL TO INSTALL CONDUIT FOR ROUTING POWER TO ISLAND. PROVIDE 1#12 HOT, 1#12 NEUTRAL, 1#12G, 3/4" CONDUIT. COORDINATE EXACT ROUGH-IN HEIGHT LOCATION WITH FURNITURE INSTALLER. PATCH FLOOR TO MATCH ARCHITECTURAL FINISHES.
- 7 INSTALL 12" ABOVE FINISHED FLOOR. COORDINATE INSTALLATION WITH MANUFACTURER DETAILS.
- 8 CONTRACTOR TO REPLACE AND PROVIDE WITH NEW PANEL. SEE PANEL SCHEDULE AND ELECTRICAL RISER DIAGRAM.

209 LEE'

**COPYRIGHT © BY COLLINS WEBB** 

ARCHITECTURE, LLC REVISION DATES:

1 City Comments & 08.08.2023 VE Revisions

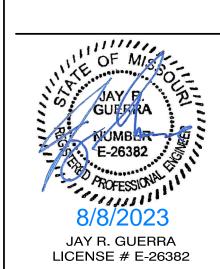

PRINTED COPIES OF THIS DOCUMENT ARE NOT CONSIDERED SIGNED AND SEALED AND THE SIGNATURE MUST BE VERIFIED ON ANY ELECTRONIC COPIES PROFESSIONAL SEAL ELECTRICAL POWER PLAN

COLLINS WEBB #:

THIS DRAWING IS A SINGLE PART OF AN INTEGRATED SET OF CONSTRUCTION CONTRACT DOCUMENTS. REFER TO DRAWING AND SPECIFICATION SHEETS INCLUDING, BUT NOT LIMITED TO, ALL "GENERAL CONDITIONS", "SUMMARY OF WORK", AND APPLICABLE SPECIFICATION SECTIONS WHICH APPLY TO THIS DRAWING. REFER TO ALL DOCUMENTS FOR THE COMPLETE SCOPE OF WORK. THE CONTRACTOR WILL BE RESPONSIBLE FOR ALL INFORMATION CONTAINED IN THE "SET" OF DOCUMENTS ISSUED. THIS DRAWING IS SCHEMATIC AND IS NOT TO BE USED AS A SHOP DRAWING. ALTERATIONS FROM THAT SHOWN REQUIRED TO FORDINATE WITH OTHER TRADES OR TO CONFORM TO ACTUAL SITE CONDITIONS ARE THE CONTRACTOR'S RESPONSIBILITY. VERIFY THE LOCATIONS OR DIMENSIONS OF ALL ARCHITECTURAL AND STRUCTURAL ELEMENTS WITH THE ARCHITECTURAL AND STRUCTURAL DRAWINGS ISSUED. THE SHOWING OF THESE ELEMENTS IN THESE DRAWINGS. THE ACCOMPANYING PROFESSIONAL SEAL INDICATES THAT THE PERSON HOSE NAME APPEARS ON THE SEAL HAS PREPARED OR SUPERVISED PREPARATION OF THE DOCUMENT ON WHICH THE SEAL APPEARS. THAT PERSON AND THE FIRM FOR WHICH THAT PERSON IS EMPLOYED BY DISCLAIM RESPONSIBILITY FOR ANY PORTIONS OF THE WORK ON WHICH THEIR SEAL DOES NOT APPEAR. THIS DOCUMENT SHALL NOT BE USED FOR ANY OTHER PROJECTS, FOR ADDITIONS TO THIS PROJECT, OR FOR COMPLETION OF THE PROJECT BY OTHERS WITHOUT THE PRIOR WRITTEN CONSENT OF GIBBENS DRAKE SCOTT. ANY INDIVIDUAL AND/OR COMPANY THAT USES THIS DOCUMENT UNAUTHORIZED, AGREES TO THE FULLEST EXTENT OF THE LAW, TO INDEMNIFY AND HOLD HARMLESS GIBBENS DRAKE SCOTT, INC., IT'S OFFICERS, DIRECTORS AND EMPLOYEES AGAINST ANY DAMAGES, LIABILITIES OR COSTS, INCLUDING REASONABLE ATTORNEY'S FEES AND COSTS OF DEFENSE, ARISING OUT OF THE MISUSE OF THIS DOCUMENT.

			SHT FIXTURE	SCHEDULE
TYPE	MANUFACTURER	LAMP	VOLTS WATTS	DESCRIPTION
Α	HE WILLIAMS - #4CR-L15/935-BLK-DIM -UNV-LM-CS-AD-(xx)	LED 3500°K. 1500LM	27 <u>7/1</u> 20 17.7	4" CYLINDER PENDANT. 0-10V DIMMING DRIVER. 40° DISTRIBUTION. COORDINATE WITH ARCHITECT ON MOUNTING TYPE AND LENGTH. TEXTURED BLACK FINISH.
	OR EQUAL			
В	AXIS LIGHTING - TB2DLEDPAT-X(3x3x3x3)- 750-90-35-SO-X-W- 120-DP-1-CTS(#)-OS(#) OR EQUAL	LED 3500°K 750LM/FT	120 91.2	CEILING MOUNTED LINEAR LED PENDANT. FLUSH SPOTLESS LENS. X—JUNCTION INSTALLATION AS INDICATED ON PLANS. 0—10V DIMMING DIVER. SCREW SLOT MOUNTING TYPE. 36" CABLE LENGTH. WHITE FINISH.
С	AXIS LIGHTING - #TB2DILED-1000-300-90 -35-BW-SO-8-BLK-120 -DP-1-CA(#)-OS(#)		12 <u>0</u> –277 106.4	CEILING MOUNTED 8FT LINEAR LED PENDANT. FLUSH SPOTLESS LENS. 0-10V DIMMING DIVER. DRYWALL MOUNTING TYPE. 36" CABLE LENGTH. BLACK FINISH.
	OR EQUAL			
D	GOTHAM — #EVO6-35/20-AR-MWD-L -MVOLT- GZ10-TRW OR EQUAL	LED D 3500°K 85CRI 1500LM	12 <u>0</u> –277 19.7	6" CIRCULAR DOWNLIGHT. LINEAR DIMMING TO 10% MIN. FIXTURES ARE WET LOCATION, COVERED CEILING. CLEAR REFLECTOR COLOR. WHITE PAINTED FLANGE. MATTE—DIFFUSE FINISH.
			100 077	
Е	EUREKA LIGHTING — #4038-LED.4-35-120- DV-S6-(xx)-RC-BLK-WH	LED 3500°K 85CRI 425LM	12 <u>0-2</u> 77 4	CEILING MOUNTED LED PENDANT. 0-10V DIMMNING. COORDINATE WITH ARCHITECT ON MOUNTING TYPE AND STEM LENGTH. STEEL HOUSING. BLACK STRUCTURE FINISH. WHITE BAFFLE FINISH.
F	PRIZM - #PZM-TLH-65-24V-RGBW -(xx) #PZM-SLOTLENS-(x)M OR EQUAL	LED 3000°K 90CRI 240LM/FT	2 <u>4VD</u> C 4.4W/FT	RGBW LED TAPE LIGHT. 10MM WIDTH. 22FT MAX RUN. CONTROL VIA DMX FOR COLOR AND DIMMING USING DMX RECEIVER. CUTTABLE EVERY 6.56". COORDINATE WITH ARCHITECT ON TAPE LIGHT LENGTH. IP65 RATING. MINI FLANGE FROSTED POLYCARBONATE LENS. ANODIZED ALUMINUM FINISH.
G	GARDCO - PWS-196L-1150-WW-G2 -3-UNV-DD-MMRI-PCB- F1-BK  OR EQUAL BY: MCGRAW-EDISON LITHONIA	LED 3000°K 85CRI 5,712 NOMINAL LUMENS	12 <u>0-2</u> 77 51	EXTERIOR WALL SCONCE WITH INTEGRAL MOTION SENSOR, INTEGRAL PHOTOCELL AND TYPE 3 DISTRIBUTION. PROVIDE 0-10V DIMMING DRIVER. MOUNT FIXTURE AT 9' AFF. COORDINATE EXACT MOUNTING HEIGHT WITH ARCHITECT. BLACK FINISH. PROVIDE WITH BATTERY PACK REMOTE MOUNTED INSIDE THE BUILDING ABOVE ACCESSIBLE CEILING.
Н	COOPER LIGHTING HALO — #L815MED10FL935MB	LED 3500°K 90CRI 1104LM	12 <u>0-2</u> 77 12.7	4 INCH LED TRACK LIGHT HEAD. 45 DEGREE BEAM. BLACK PAINTED FINISH.
<u> </u>	OR EQUAL			
НТ	COOPER LIGHTING HALO — #L65(x)MBL902L980MB L983MB OR EQUAL	TRACK	12 <u>0-2</u> 77 3.6	1 CIRCUIT TRACK FOR LED LIGHT TRACK HEADS.
M	DUAL LITE - #LZ2B-03L OR EQUAL	LED	12 <u>0-2</u> 77 1.3	10 WATT CAPACITY LED LAMPS. LOW-VOLTAGE BATTERY DISCONNECT. WALL MOUNTING TYPE. LEAD-CALCIUM BATTERY TYPE. NFPA 70 AND NFPA 101 RATINGS. BLACK THERMOPLASTIC HOUSING.
Х	DUAL LITE - #LECSGXNE OR EQUAL	LED	12 <u>0</u> –277 3.6	CEILING MOUNT, EDGE—LIT LED EXIT SIGN. SATIN ALUMINUM HOUSING. SINGLE FACE AS INDICATED ON PLANS. INJECTION—MOLDED ACRYLIC EXIT PLAQUE, CLEAR. GREEN LETTERING. EMERGENCY BATTERY.

## LIGHT FIXTURE SCHEDULE NOTES: 1. VERIFY CEILING CONDITIONS AND COORDINATE LIGHT FIXTURE MOUNTING HARDWARE AND TRIMS NEEDED TO SUIT CEILING CONDITIONS PRIOR TO ORDERING. PROVIDE ALL NECESSARY HARDWARE, TRIM, AND CABLES. VERIFY QUANTITIES MODEL NUMBERS AND DESCRIPTIONS WITH MANUFACTURER PRIOR TO ORDERING.

- 3. VERIFY FINISH AND COLOR WITH ARCHITECT PRIOR TO PLACING ORDER.


  4. REFER TO ARCHITECTURAL DRAWINGS AND DETAILS FOR EXACT LOCATIONS, MOUNTING HEIGHTS AND ADDITIONAL MOUNTING INFORMATION. CONTACT ARCHITECT IMMEDIATELY IF THERE ARE DISCREPANCIES BETWEEN THE ARCHITECTURAL AND ELECTRICAL LIGHTING PLANS.
  5. INSTALL ALL REQUIRED 0-10V DIMMING WIRE FOR LIGHT FIXTURES CONTROLLED BY 0-10V DIMMERS OR DIMMING
- ROOM CONTROLLERS.
- 6. FOR ALL FIXTURES REPRESENTED WITH THE EMERGENCY LIGHT FIXTURE SYMBOL (HALF-HATCHED) OR LABELED "EM" PROVIDE AN INTEGRAL EMERGENCY BATTERY PACK AND CONNECT IT TO AN UNSWITCHED HOT CONDUCTOR. BATTERY SHALL PROVIDE A MINIMUM OF 1000 LUMENS. . CONNECT EMERGENCY EXIT SIGNS TO UNSWITCHED HOT CONDUCTOR OF THE CIRCUIT SERVING NEARBY LIGHT FIXTURES.

#### **ELECTRICAL GENERAL NOTES**

(SEE SHEET E000 FOR ELECTRICAL GENERAL NOTES)

## **LIGHTING PLAN NOTES**

- 1 COORDINATE WITH ARCHITECT ON INSTALLATION.
- 2 UNDERCOUNTER TAPE LIGHTS TO BE PLACED AT UPPER CABINETS AND EACH SHELF.
- MOUNT DMX DRIVER CONTROL RECESSED IN WALL AND ROUTE CONDUIT UNDERGROUND AND OVERHEAD IN CONDUIT WHERE REQUIRED FOR ALL 'F' TYPE FIXTURES.
- 4 INSTALL DRIVER IN AN ENCLOSURE ON THE UNDERSIDE OF THE COUNTER. COORDINATE WITH ARCHITECT ON EXACT INSTALLATION. PAINT TO MATCH ARCHITECTURAL FINISHES. ROUTE CONDUIT CONCEALED THROUGH THE WALL. TRENCH THE CONDUIT THROUGH THE FLOOR.

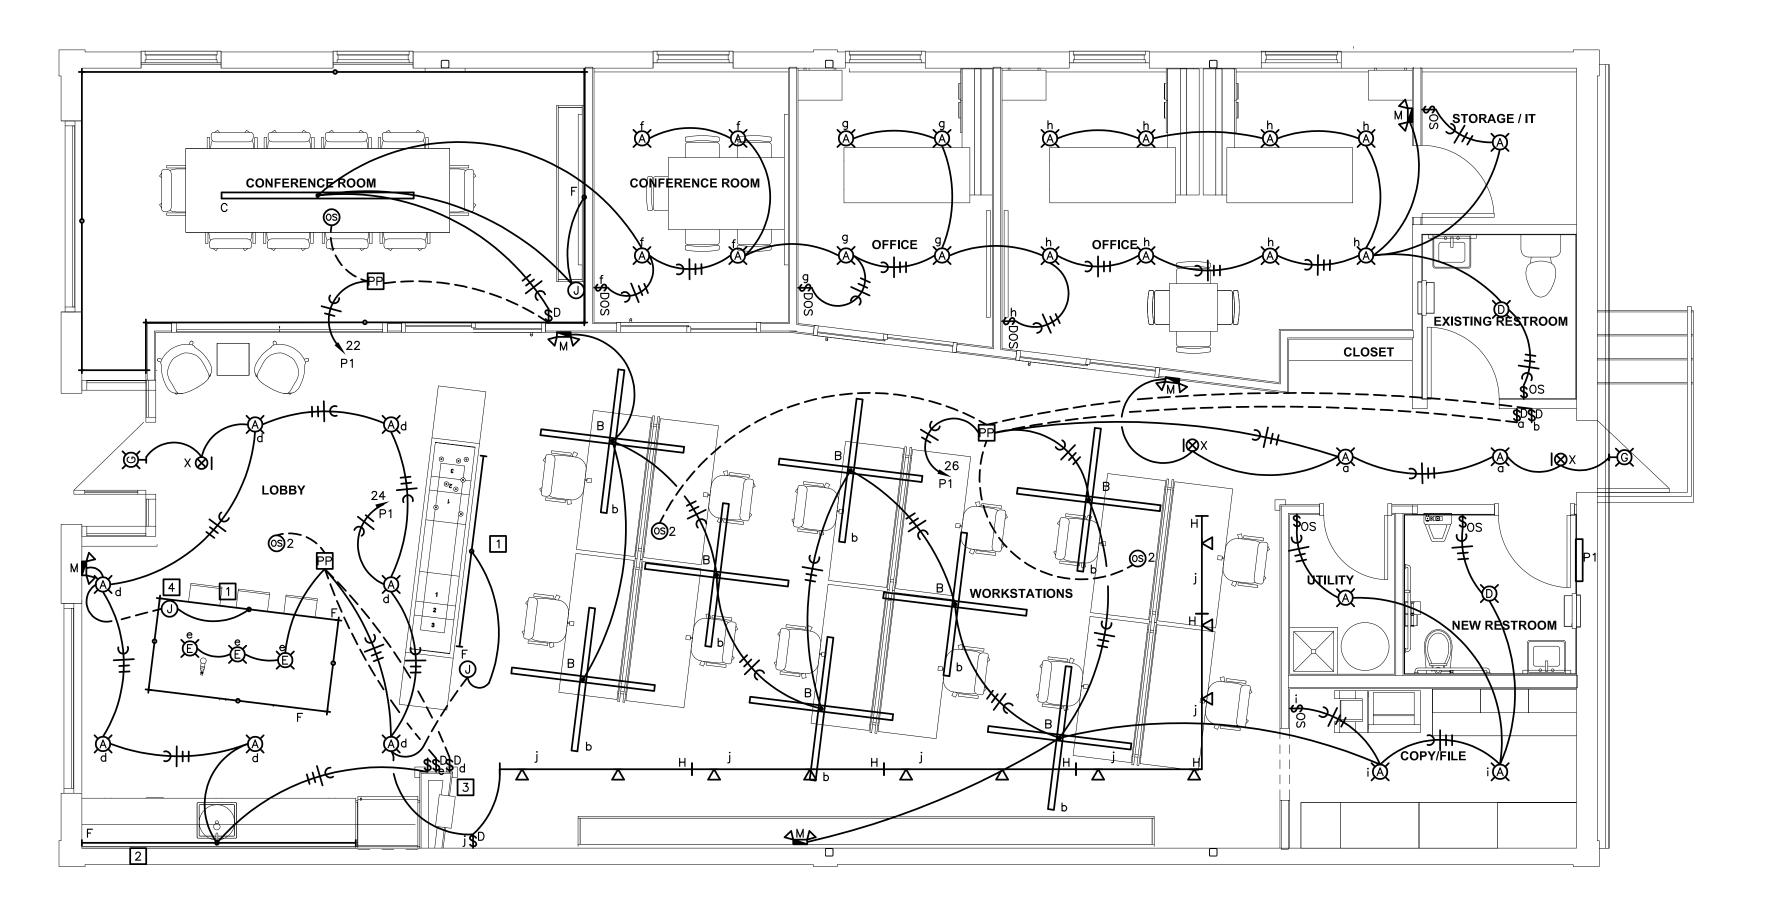

LIGHTING PLAN

1/4"=1'-0"





209 LEE

COPYRIGHT © BY **COLLINS WEBB** ARCHITECTURE, LLC

**REVISION DATES:** 

1 City Comments & 08.08.2023 VE Revisions



LICENSE # E-26382 PRINTED COPIES OF THIS DOCUMENT ARE NOT CONSIDERED SIGNED AND SEALED AND THE SIGNATURE MUST BE VERIFIED ON ANY ELECTRONIC COPIES

PROFESSIONAL SEAL LIGHTING PLAN

COLLINS WEBB #: 23033

THIS DRAWING IS A SINGLE PART OF AN INTEGRATED SET OF CONSTRUCTION CONTRACT DOCUMENTS. REFER TO DRAWING AND SPECIFICATION SHEETS INCLUDING, BUT NOT LIMITED TO, ALL "GENERAL CONDITIONS", "SUMMARY OF WORK", AND APPLICABLE SPECIFICATION SECTIONS WHICH APPLY TO THIS DRAWING. REFER TO ALL DOCUMENTS FOR THE COMPLETE SCOPE OF WORK. THE CONTRACTOR WILL BE RESPONSIBLE FOR ALL INFORMATION CONTAINED IN THE "SET" OF DOCUMENTS ISSUED. THIS DRAWING IS SCHEMATIC AND IS NOT TO BE USED AS A SHOP DRAWING. ALTERATIONS FROM THAT SHOWN REQUIRED TO COORDINATE WITH OTHER TRADES OR TO CONFORM TO ACTUAL SITE CONDITIONS ARE THE CONTRACTOR'S RESPONSIBILITY. VERIFY THE LOCATIONS OR DIMENSIONS OF ALL ARCHITECTURAL AND STRUCTURAL ORAWINGS ISSUED. THE SHOWING OF THESE ELEMENTS ARE FOR REFERENCE ONLY AND ARE TO BE VERIFIED PRIOR TO DESIGN OR CONSTRUCTION. NO LIABILITY IS ASSUMED BY THE INDICATION OF ELEMENTS IN THESE DRAWINGS. THE ACCOMPANYING PROFESSIONAL SEAL INDICATES THAT THE PERSON WHOSE NAME APPEARS ON THE SEAL HAS PREPARED OR SUPERVISED PREPARATION OF THE DOCUMENT ON WHICH THE SEAL APPEARS. THAT PERSON AND THE FIRM FOR WHICH THAT PERSON IS EMPLOYED BY DISCLAIM RESPONSIBILITY FOR ANY PORTIONS OF THE WORK ON WHICH THEIR SEAL DOES NOT APPEAR. THIS DOCUMENT SHALL NOT BE USED FOR ANY OTHER PROJECTS, FOR ADDITIONS TO THIS PROJECT, OR FOR COMPLETION OF THE PROJECT BY OTHERS WITHOUT THE PRIOR WRITTEN CONSENT OF GIBBENS DRAKE SCOTT. ANY INDIVIDUAL AND/OR COMPANY THAT USES THIS DOCUMENT UNAUTHORIZED, AGREES TO THE FULLEST EXTENT OF THE LAW, TO INDEMNIFY AND HOLD HARMLESS GIBBENS DRAKE SCOTT, INC., IT'S OFFICERS, DIRECTORS AND EMPLOYEES AGAINST ANY DAMAGES, LIABILITIES OR COSTS, INCLUDING REASONABLE ATTORNEY'S FEES AND COSTS OF DEFENSE, ARISING OUT OF THE MISUSE OF THIS DOCUMENT.