




FRONT ELEVATION
SCALE: 1/4" = 1'-0"

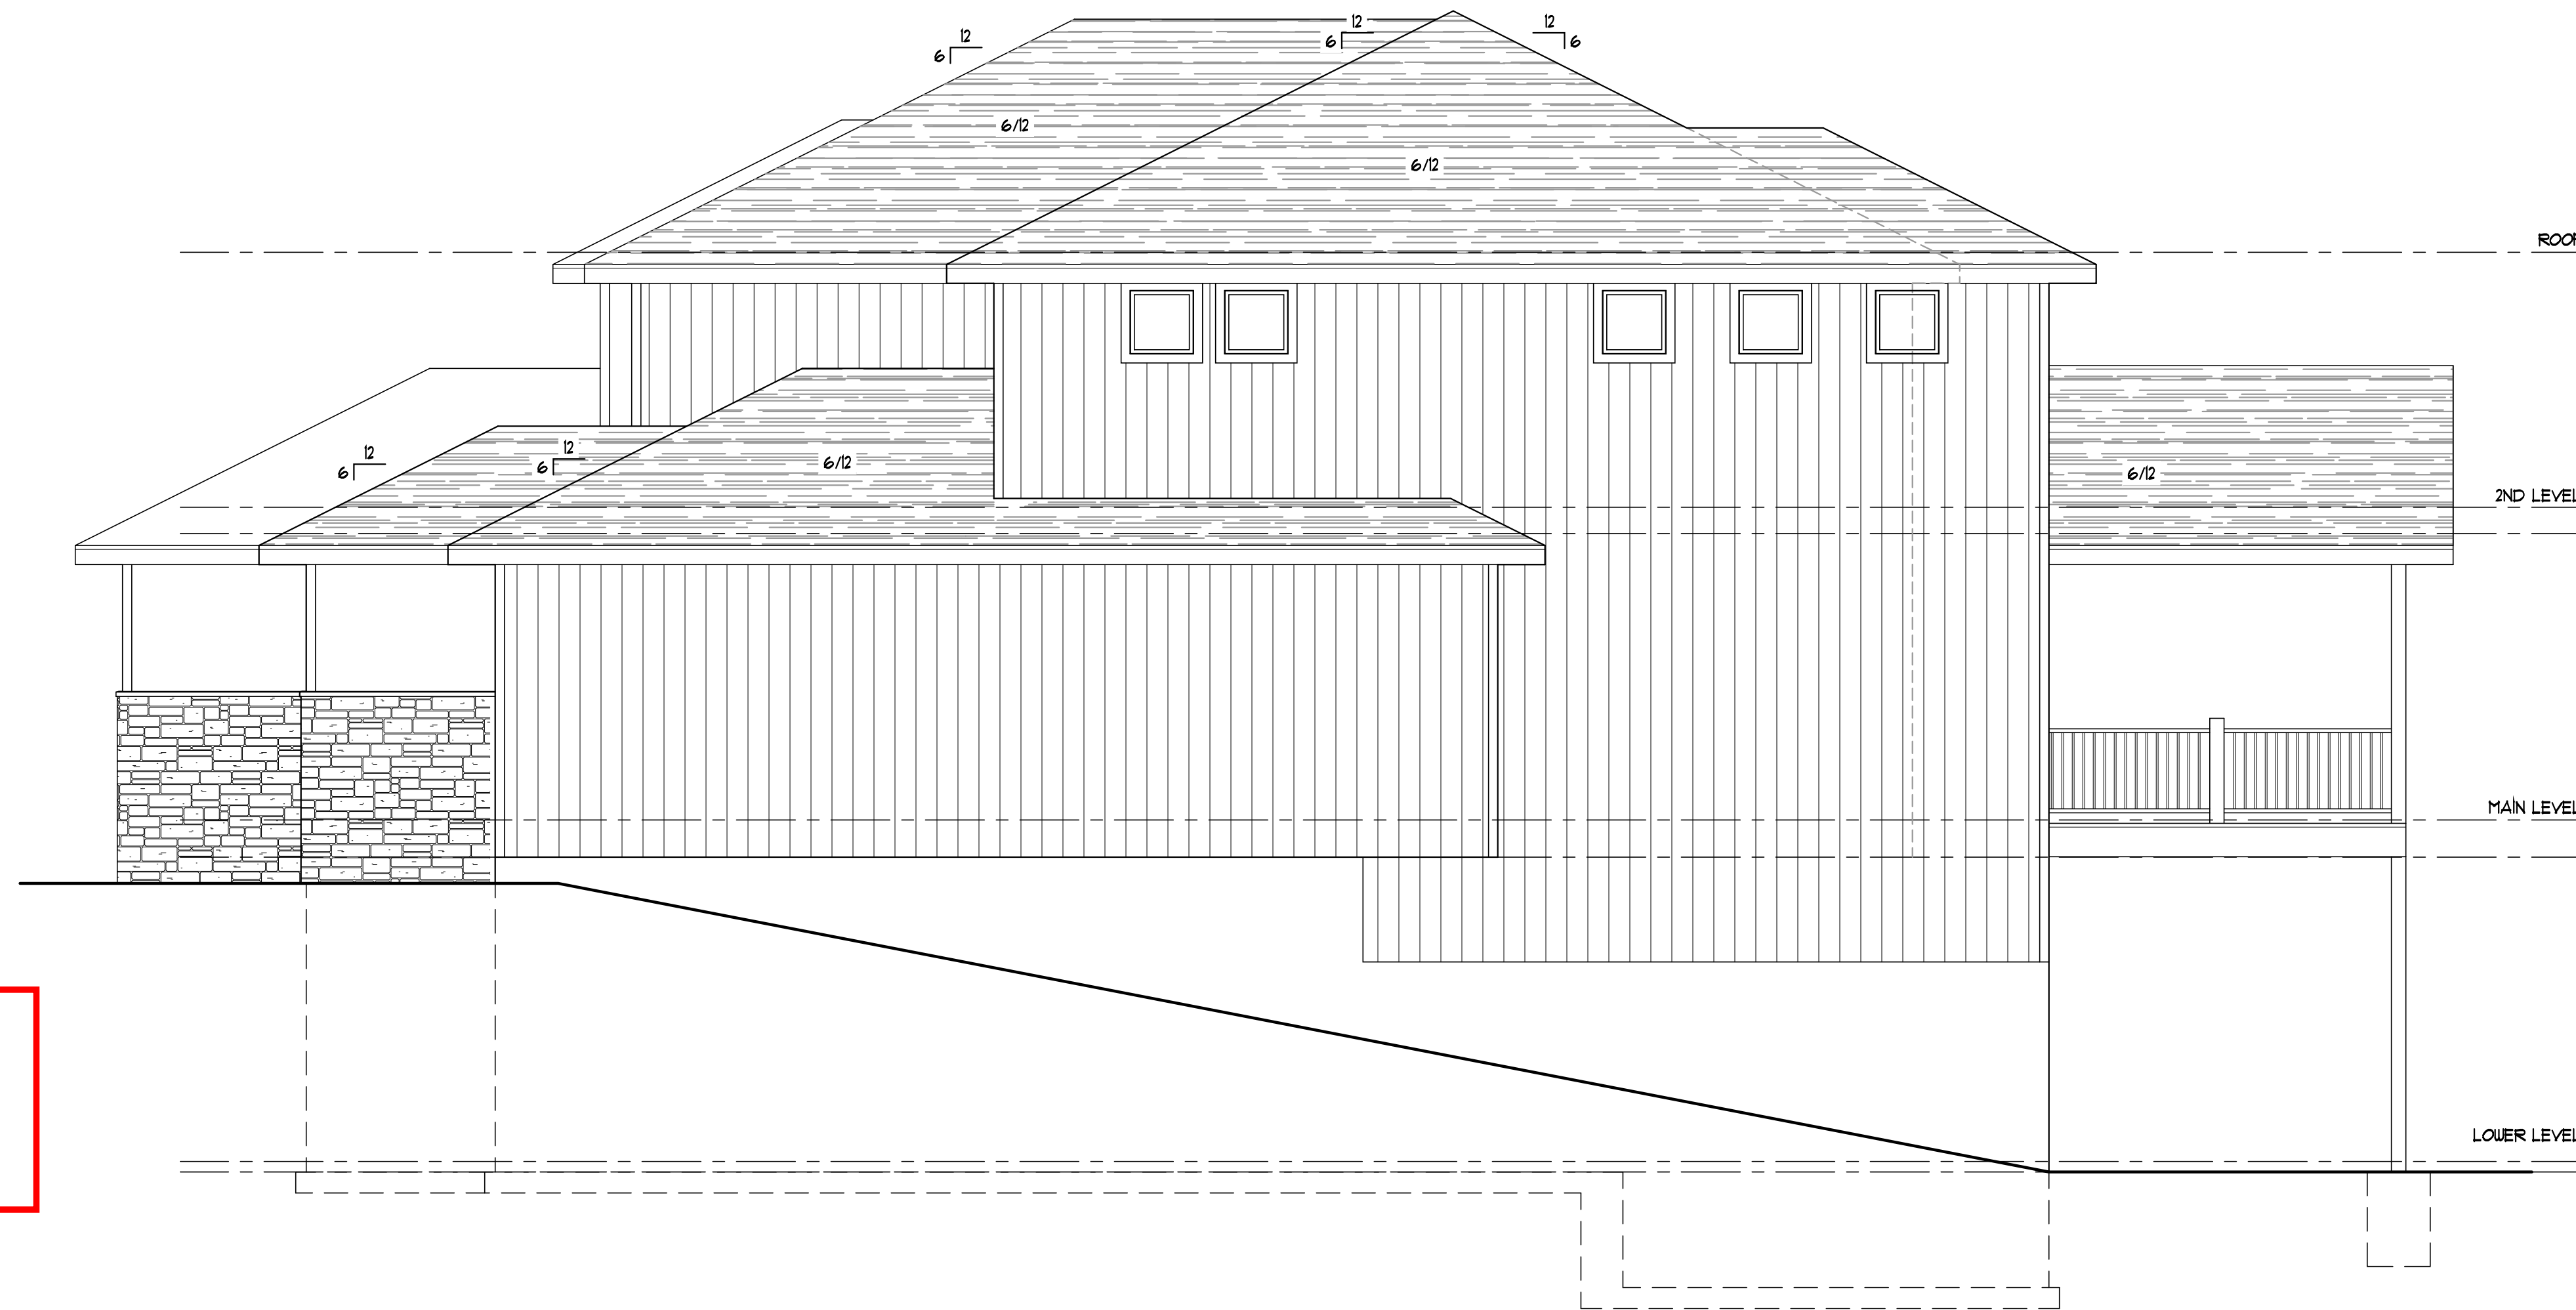

RIGHT ELEVATION
SCALE: 1/4" = 1'-0"

RELEASE FOR CONSTRUCTION
AS NOTED FOR PLAN REVIEW
DEVELOPMENT SERVICES
LEE'S SUMMIT, MISSOURI
08/22/2023

RELEASE FOR CONSTRUCTION
AS NOTED FOR PLAN REVIEW
DEVELOPMENT SERVICES
LEE'S SUMMIT, MISSOURI
08/22/2023



© COPYRIGHT 2023

JFE CONSTRUCTION INC.
1314 SW Market Street
Lee's Summit, MO 64081
v. 816.786.4008
jfeconstruction.com



Van Deurzen and Associates, P.A. © 2023



THE MAPLEWOOD III
Keith Murrell
2109 NW O'Brien Road, Lee's Summit, MO
Lot 171 - Woodside Ridge

Project #: 8083-XXXX


DATE:

For Permit: 8/18/2023

GAI



REAR ELEVATION
SCALE: 1/4" = 1'-0"

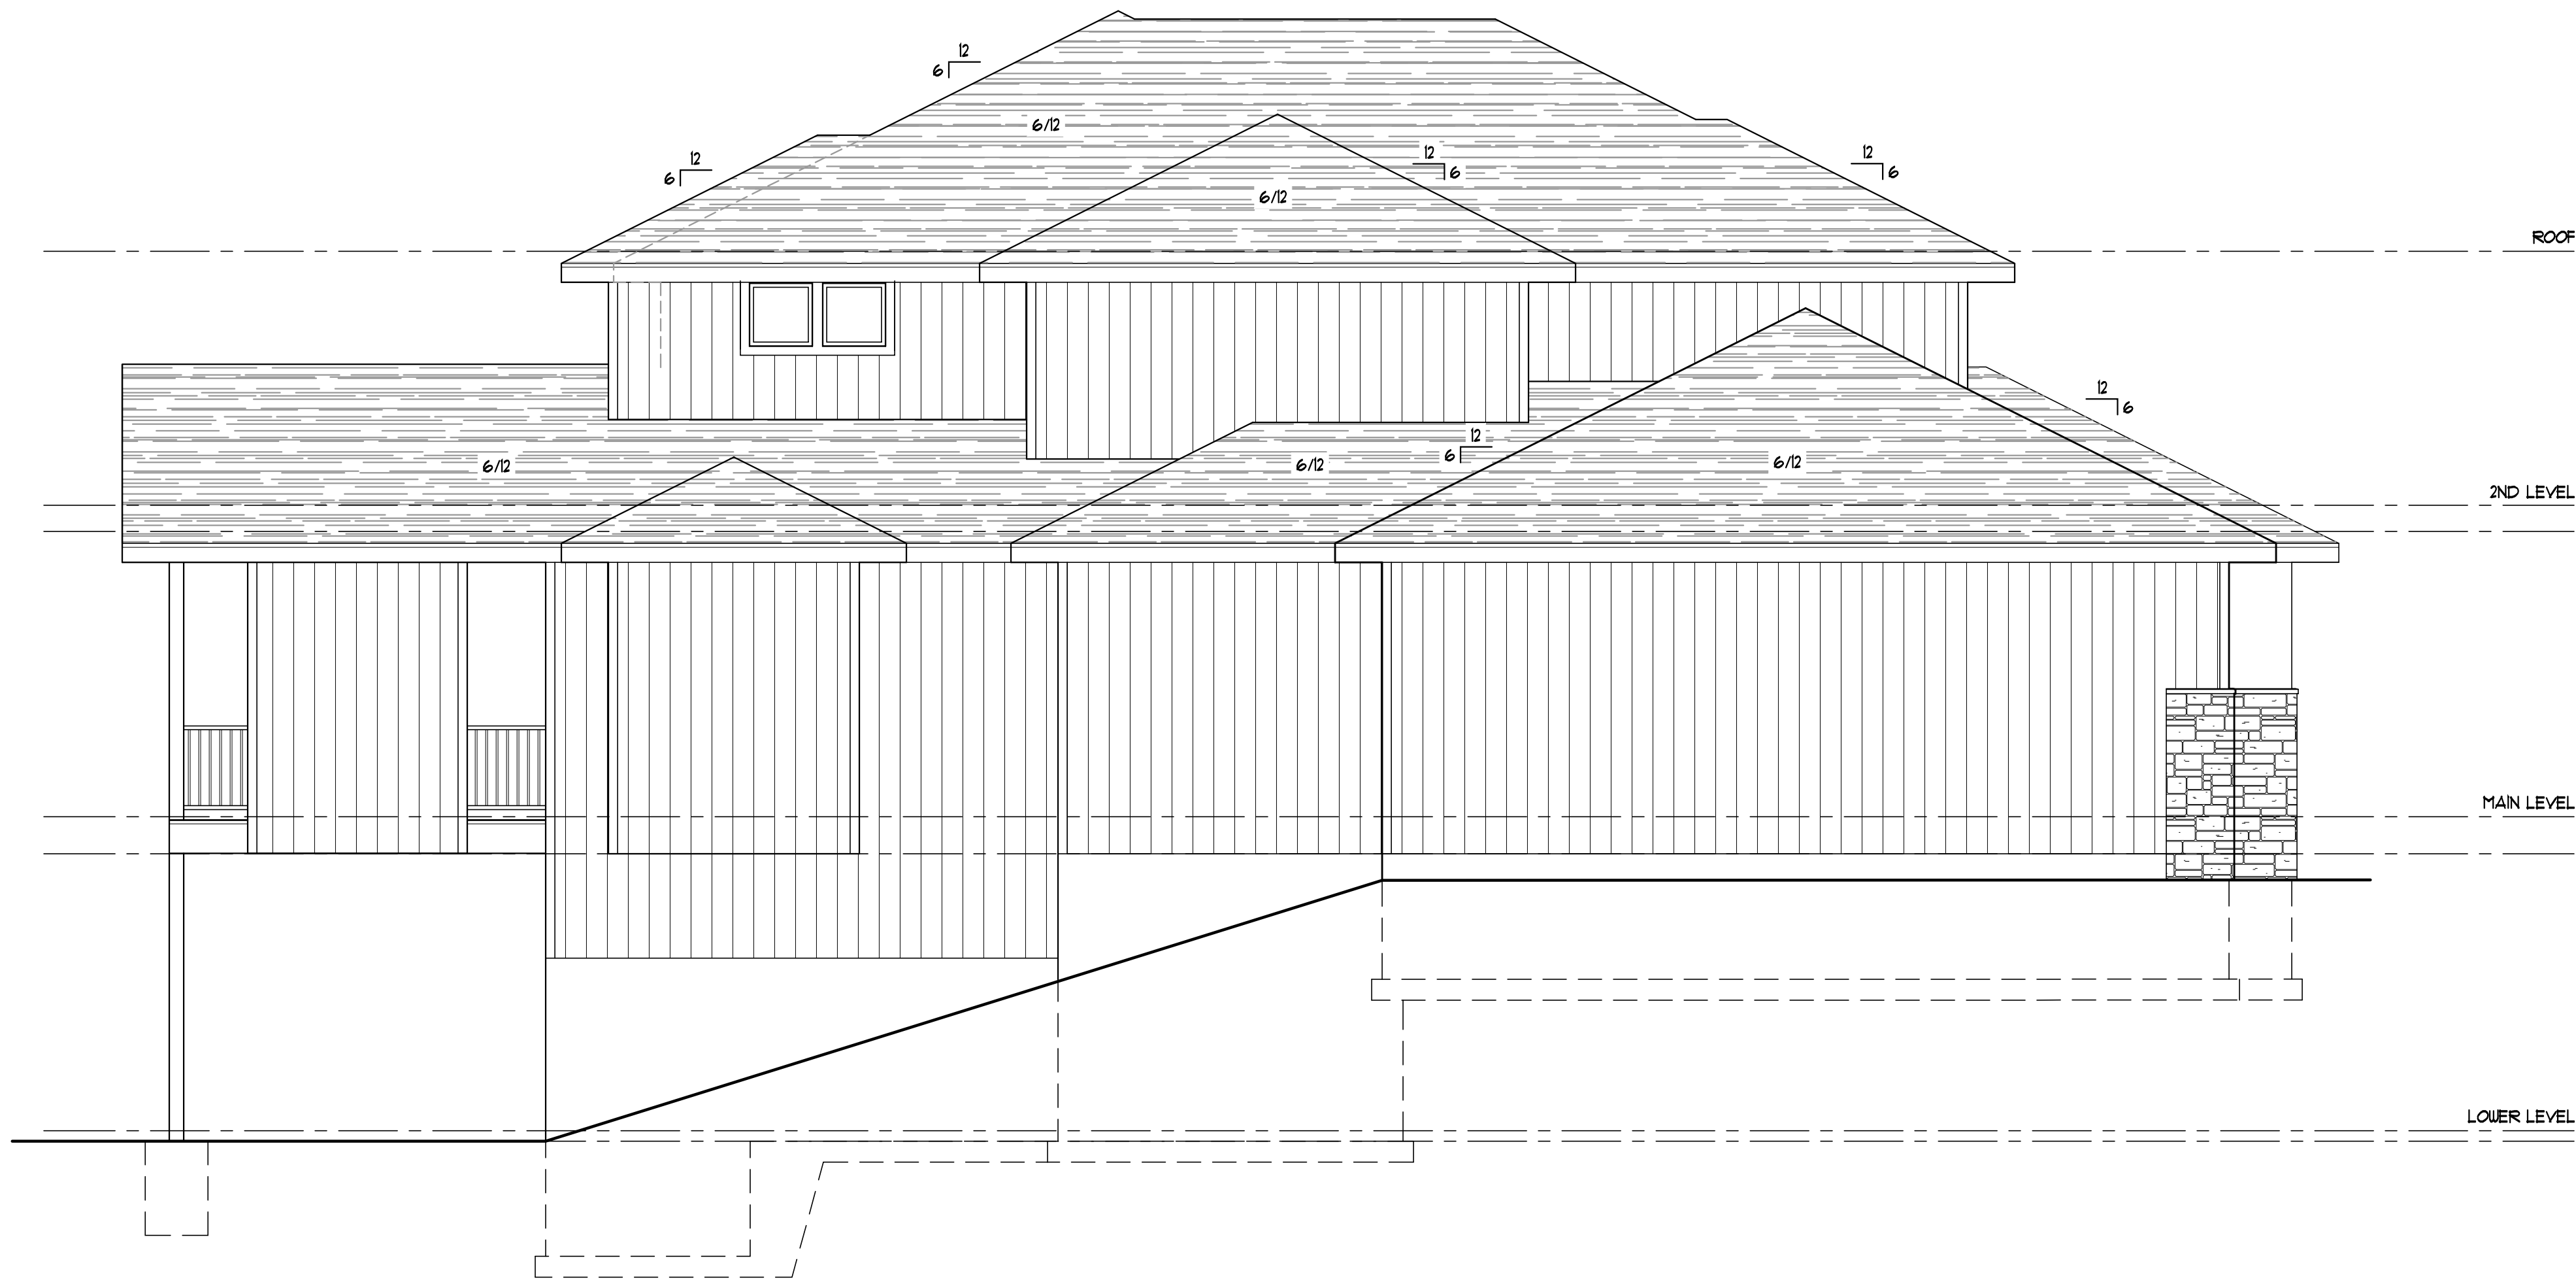

LEFT ELEVATION
SCALE: 1/4" = 1'-0"



© COPYRIGHT 2023
JFE CONSTRUCTION INC.
1314 SW Market Street
Lee's Summit, MO 64081
v: 816.786.4008
jfeconstruction.com



Van Deurzen and Associates, P.A. © 2023



THE MAPLEWOOD III
Keith Murrell
2109 NW O'Brien Road, Lee's Summit, MO
Lot 171 - Woodside Ridge


Project #: 8083-XXXX

DATE: 8/18/2023

For Permit: 8/18/2023

G/A2

RELEASE FOR CONSTRUCTION
AS NOTED FOR PLAN REVIEW
DEVELOPMENT SERVICES
LEE'S SUMMIT, MISSOURI
08/22/2023

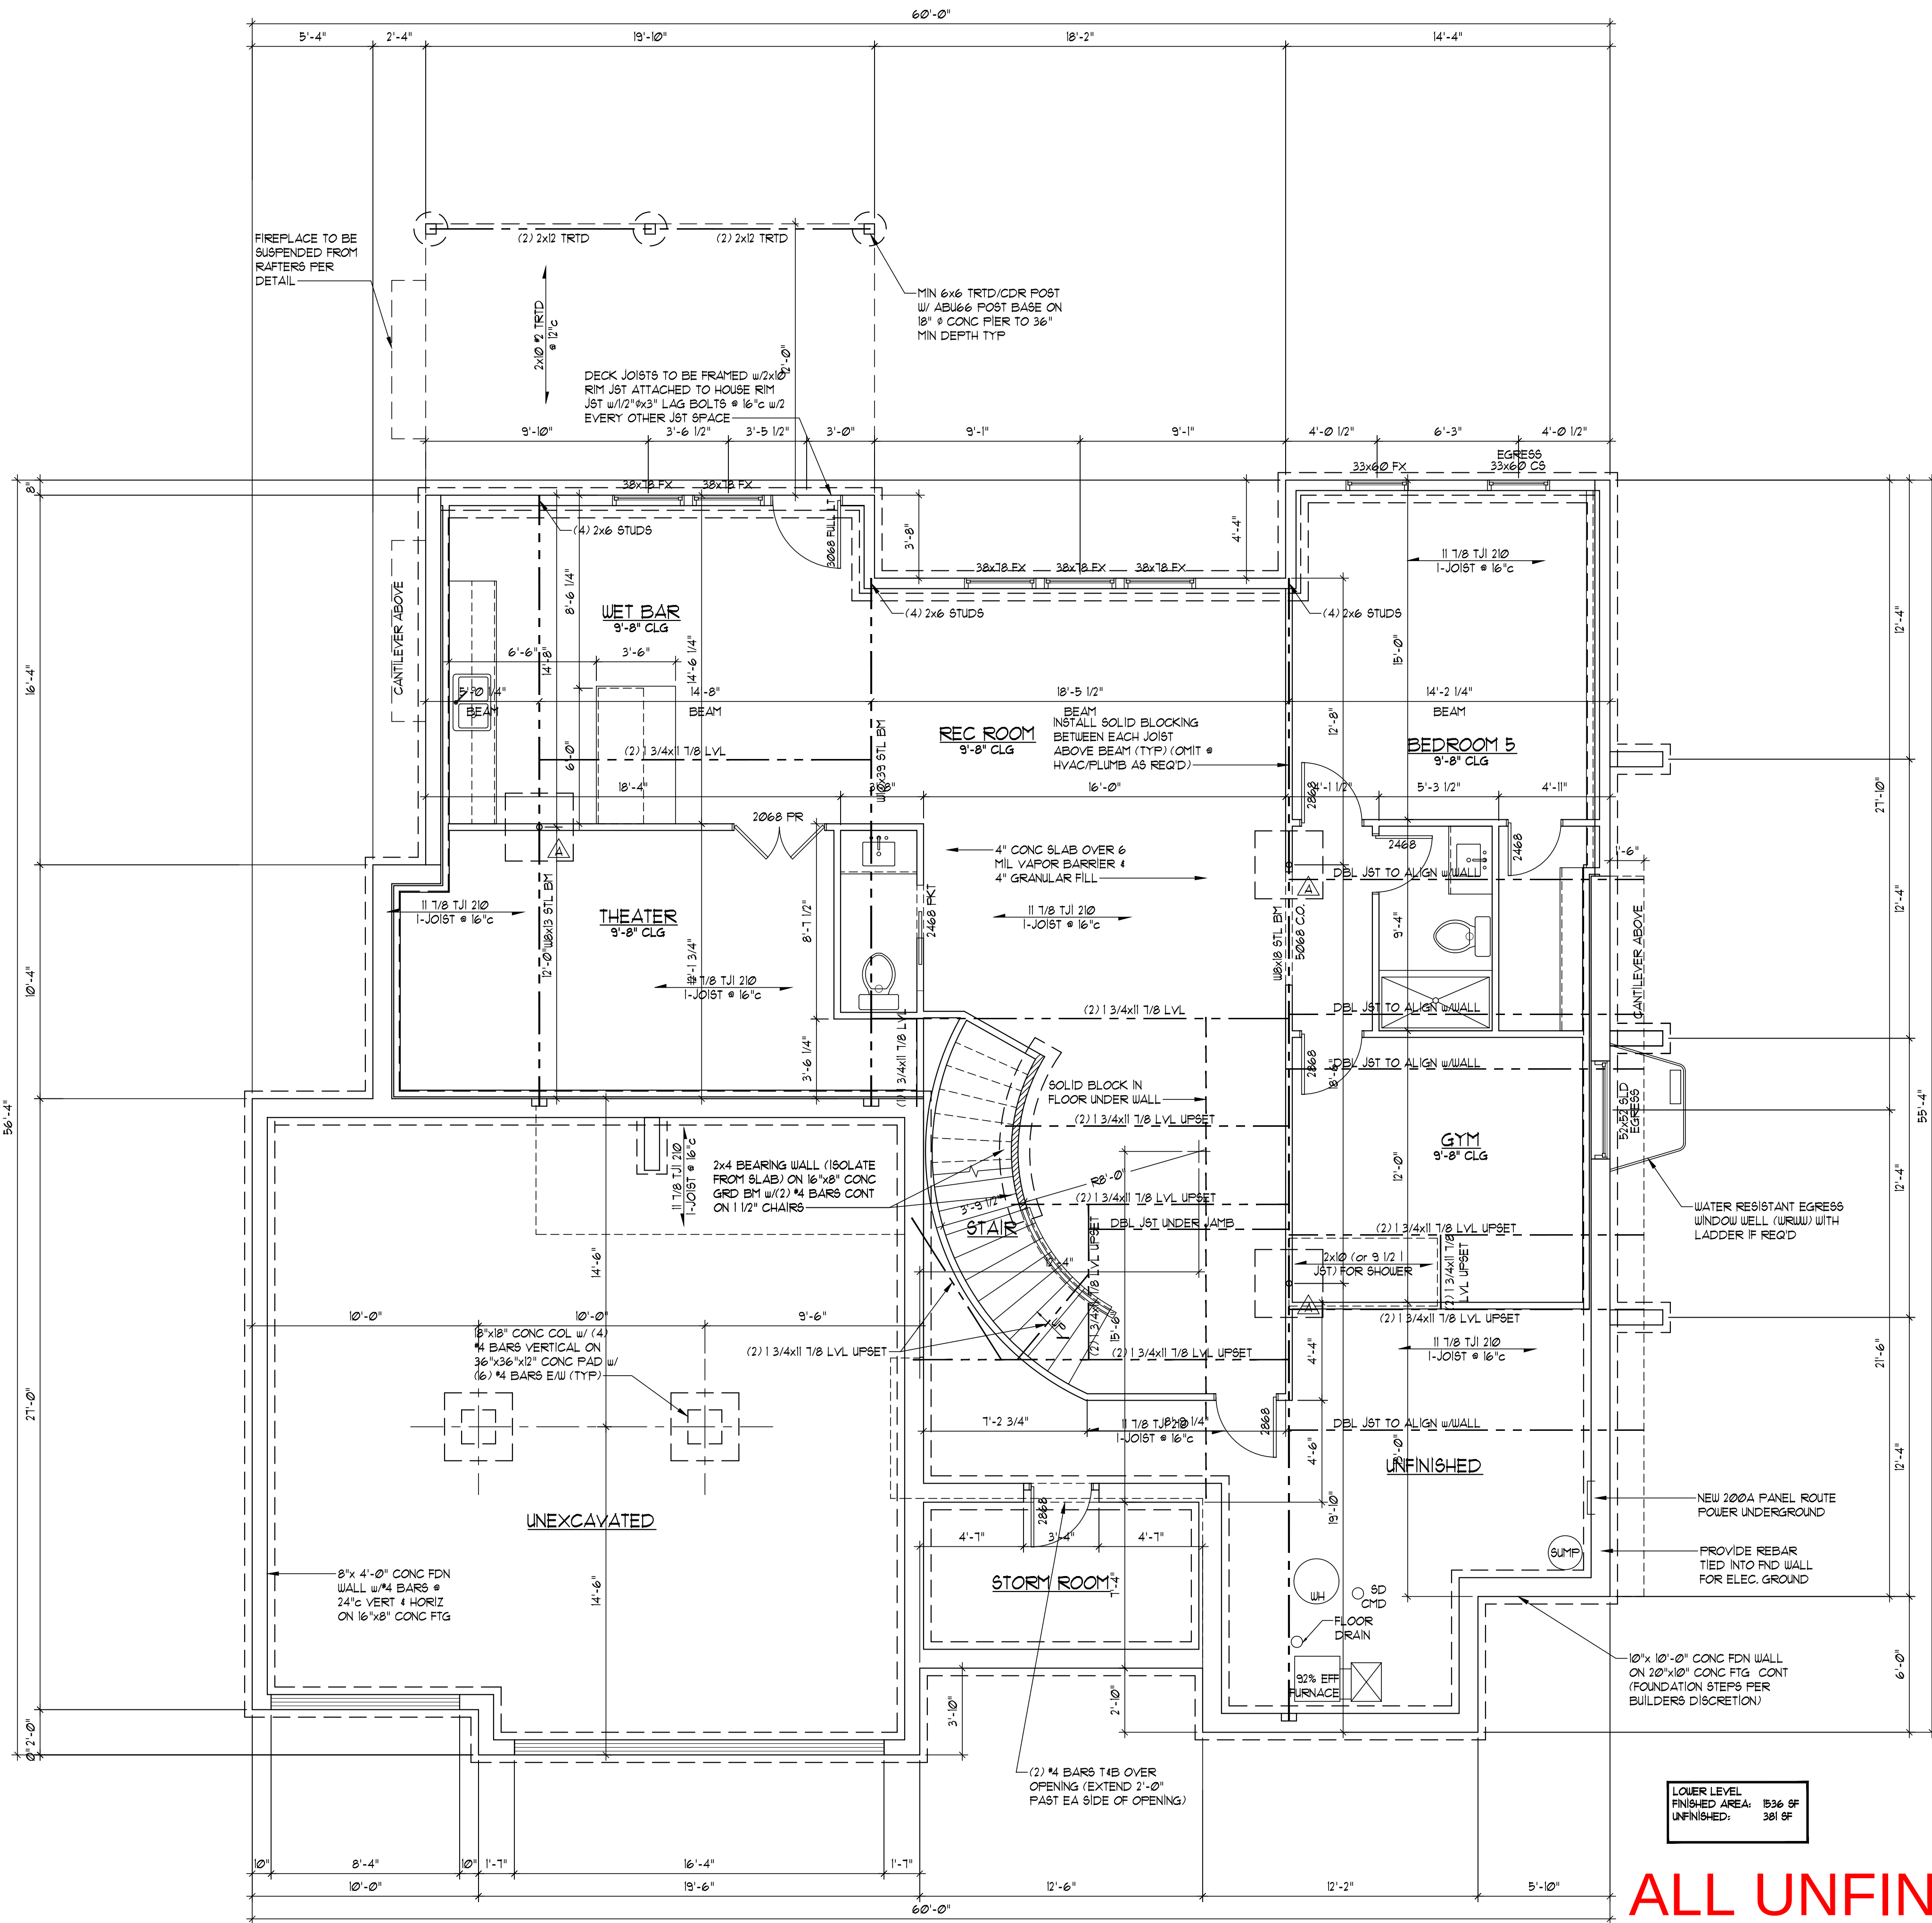

FOUNDATION PLAN
SCALE: 1/4" = 1'-0"

GENERAL NOTES

- BUILDING PERMIT WILL BE REQUIRED FOR THE PROJECT. THIS SET OF DOCUMENTS TO BE SUBMITTED AS A PERMIT SET OF DRAWINGS.
- ALL CONTRACTORS SHALL VISIT THE JOB SITE AND SHALL REVIEW THE PERMIT DRAWINGS TO FAMILIARIZE HIMSELF WITH THE REQUIREMENTS AND INTENT OF THE SCOPE OF WORK. ANY DEFICIENCIES OR DISCREPANCIES DISCOVERED SHALL BE REPORTED FOR REVIEW AND CLARIFICATION PRIOR TO COMMENCING ANY WORK.
- ALL NEW CONSTRUCTION SHALL MEET LATEST EDITIONS OF ALL APPLICABLE NATIONAL, STATE, AND LOCAL BUILDING CODES - INTERNATIONAL RESIDENTIAL CODE.
- WORKMANSHIP SHALL BE OF THE HIGHEST QUALITY. QUALITY MATERIALS SHALL BE USED THROUGHOUT. ALL WORK SHALL BE DONE IN A MANNER SO AS TO MATCH ADJACENT WORK AND FINISHES AND APPROVED BY OWNER.
- CONTRACTORS SHALL REMOVE ALL CONSTRUCTION DEBRIS. ALL CONSTRUCTION DEBRIS SHALL BE CONTAINED PER CITY REQUIREMENTS. AREAS FOR MATERIAL STORAGE, TRASH DISPOSAL, WORKMEN'S PARKING, ETC, SHALL BE COORDINATED WITH THE CITY.
- ALL DIMENSIONS TO BE VERIFIED BY CONTRACTOR.
- IT IS THE RESPONSIBILITY OF THE CONTRACTORS TO COORDINATE WITH THE OWNER THE QUANTITY AND LOCATION FOR ALL LIGHTING, ELECTRICAL OUTLETS, TELEPHONE OUTLETS, AND MECHANICAL AND PLUMBING SYSTEMS AS REQUIRED.
- THE CONTRACTORS SHALL ADHERE TO THE STATE OF KANSAS ONE CALL SYSTEM, 1-800-344-7233 (MISSOURI ONE CALL SYSTEM, 1-800-344-7483). THE PERSON OR FIRM DOING EXCAVATION ON PUBLIC RIGHT OF WAY MUST GIVE NOTICE TO, AND OBTAIN INFORMATION FROM, UTILITY COMPANIES. THE CONTRACTORS SHALL NOTIFY THOSE COMPANIES WHICH HAVE FACILITIES IN THE NEAR VICINITY OF THE CONSTRUCTION TO BE PERFORMED WHEN WORK COMMENCES.

GENERAL FOUNDATION REQUIREMENTS

- ALL FOOTINGS ARE TO BE EXTENDED TO MIN 36" BELOW FINISHED GRADE.
- ALL INTERIOR FOOTINGS FOR LOAD BEARING WALLS AND COLUMNS SHALL BE ISOLATED FROM THE BASEMENT FLOOR SLAB.
- FOR ALL CONC WALL OPENINGS, FOOTING & WALL STEPS, PROVIDE ONE #4 BAR 48" LONG DIAGONALLY AS CLOSE AS PRACTICAL TO CORNER.
- ALL REINFORCEMENT SHALL BE LAPPED A MIN OF 24" AT ENDS & PLACES AND AROUND CORNERS.
- ANCHOR BOLTS ARE TO BE SPACED @ 36" WITH 1" MIN EMBED. A BOLT SHALL BE PLACED WITHIN 12" OF THE END OF EACH PLATE SECTION.
- FASTEN JOISTS TO SILL PLATES WITH (3) 8d CORN NAILS.
- WHERE JOIST IS PARALLEL TO FOUNDATION, PROVIDE SOLID BLOCKING @ 32" C FOR (3) JST SPACES. FASTEN TO SILL PLATE PER NOTE 6.
- VAPOR BARRIER: 6 MIL PE VAPOR RETARDER WITH JOINTS LAPPED A MIN OF 6" BETWEEN SLAB & BASE.
- DAMP PROOFING: ONE COAT (MIN) OF DAMP PROOFING OR EQUIVALENT FOUNDATION MEMBRANE SHALL BE APPLIED TO EXTERIOR WALL SURFACES BELOW GRADE. SEAL TIE HOLES, VOIDS BEFORE APPLICATION.
- FOUNDATION DRAIN: INSTALL CONT 4" PERFORATED PVC DRAIN TILE. DRAIN TILE TO BE EXTENDED TO SQUARE SUMP PIT WHICH EXTENDS A MIN 24" BELOW BASEMENT FLOOR.
- ALL FRAMING MEMBERS IN CONTACT WITH CONCRETE SHALL BE ACQ TREATED LUMBER.
- ALL STEEL FASTENERS (INCLUDING FOUND. ANCHOR BOLTS) ON ACQ TO BE (DOUBLE HOT-DIPPED) GALVANIZED.
- PROVIDE A "USER" GROUND PER IRC 3608.1.
- EGRESS WELL REQUIREMENTS:
 - A. IF THE VERTICAL DISTANCE FROM THE WINDOW SILL TO ADJACENT GRADE IS GREATER THAN 44", PROVIDE A LADDER.
 - B. ADD DRAIN TO DAYLIGHT OR SUMP PUMP.
- RECESS FOUNDATION WALLS AND POUR SLAB THRU AT ALL GARAGE DOORS TO MEET 15 MPH REQUIREMENTS (MIN 8" STEM WALL).

COLUMN & PIER PAD SCHEDULE			
COLUMN MARK	PAD SIZE	REINFORCEMENT	COLUMN SIZE
A	36" x 36" x 12"	(6) #4 BAR E.W.	3" SCHED 40
B	42" x 42" x 14"	(7) #4 BAR E.W.	3" SCHED 40
C	48" x 48" x 16"	(8) #4 BAR E.W.	3" SCHED 40
D	54" x 54" x 16"	(9) #4 BAR E.W.	3 1/2" SCHED 40
E	60" x 60" x 18"	(10) #4 BAR E.W.	3 1/2" SCHED 40

- COLUMN & PIER PAD SIZES SHOWN ARE BASED ON AN ASSUMED MINIMUM ALLOWABLE SOIL BEARING CAPACITY OF 1500 psf.
- GARAGE FOOTINGS PER DETAIL, COLUMN NOT REQUIRED UNLESS NOTED ON PLANS

I JOIST AND TRUSS NOTES

- FLOOR TRUSS OR I-JOIST LOADING SHALL BE PER THE GENERAL NOTES.
- I-JOISTS MAY BE SHOWN AS SIMPLE SPAN TO DEFINE SPANS AND BEARING POINTS, TRUSS MFG TO RUN CONTINUOUS WHERE POSSIBLE.
- COORDINATE I-JOISTS LOCATIONS WITH PLUMBING DRAIN LINES AT ALL TOILET LOCATIONS.
- EXACT I-JOIST OR FLOOR TRUSS LAYOUT TO BE PROVIDED BY TRUSS MANUFACTURER. DESIGN AND LAYOUT TO BE SUBMITTED TO VAN DEURZEN AND ASSOCIATES TO REVIEW FOR GENERAL CONFORMANCE TO THE DESIGN OF THE BUILDING PRIOR TO SUBMITTAL TO THE CODES ADMINISTRATION FOR PERMITTING.
- IF A CONFLICT EXISTS BETWEEN SHOP DRAWINGS AND CONTRACT SET, THE CONTRACT SET SUPERCEDES THE JOIST/TRUSS LAYOUT.
- IF BUILDING CODE HAS NOT BE AMENDED BY LOCAL JURISDICTION, ALL I-JOIST AND OPEN WEB TRUSSES OVER UNFINISHED SPACE EXCEEDING 80 SQUARE FEET IN AGGREGATE AREA TO BE PROTECTED BY ONE OF THE FOLLOWING METHODS:
 - a. 1 LAYER 1/2" GYP SHEETROCK - NO MUD AND TAPE REQ'D.
 - b. PLUMBER INSTALLED RESIDENTIAL SPRINKLER SYSTEM.
 - c. FACTORY APPLIED, FIRE-PROTECTIVE COATING BY I-JOIST MANUFACTURER.
 - d. 3" MINERAL ROCK WOOL COVERING BOTH CHORD AND NETTING PER AFA FORT R425 METHOD 4.



© COPYRIGHT 2023

JFE CONSTRUCTION INC.
1314 SW Market Street
Lee's Summit, MO 64081
v: 816.786.4008
jfeconstruction.com



Van Deurzen and Associates, P.A. © 2023



THE MAPLEWOOD III
Keith Murrell
2109 NW O'Brien Road, Lee's Summit, MO
Lot 171 - Woodside Ridge

Project #: 8083-XXXX


DATE:

For Permit: 8/18/2023

GA3

RELEASE FOR CONSTRUCTION
AS NOTED FOR PLAN REVIEW
BY DEVELOPMENT SERVICES
LEE'S SUMMIT, MISSOURI
08/22/2023

ALL UNFINISHED

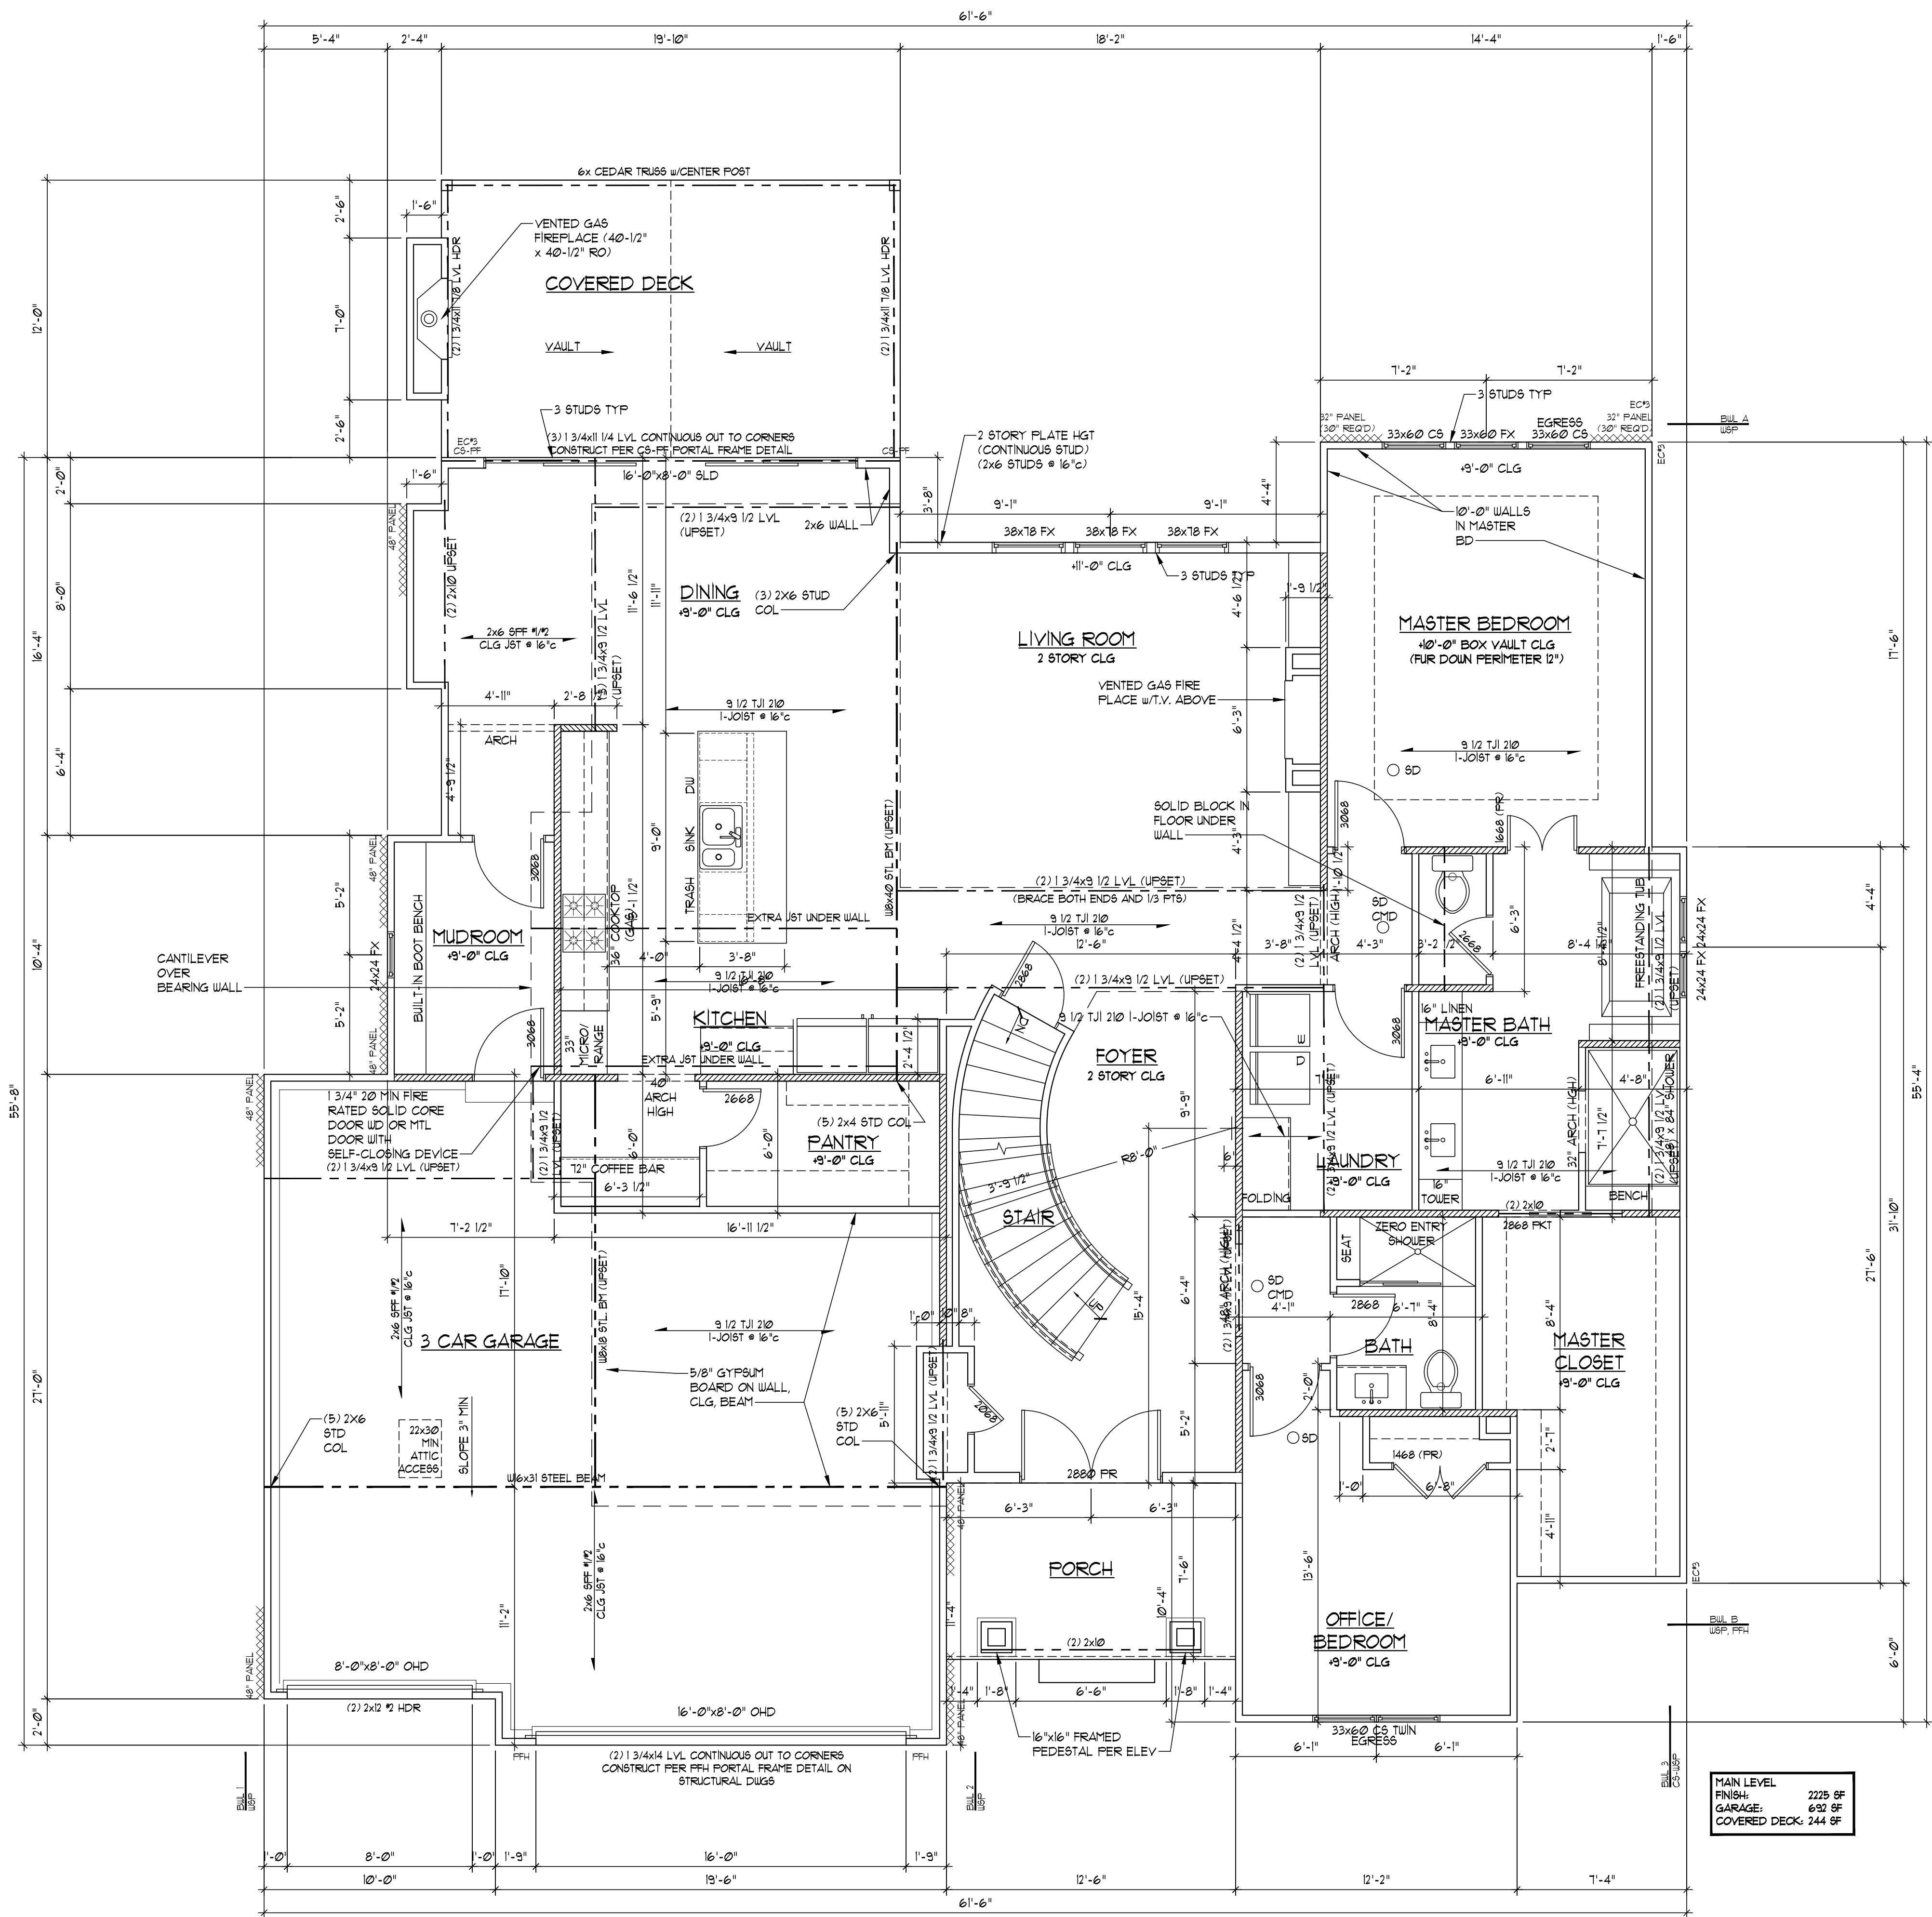

MAIN FLOOR PLAN
SCALE: 1/4" = 1'-0"

GENERAL PLAN REQUIREMENTS

- ALL STUD WALL FRAMING SHALL BE CONTINUOUS FROM THE FLOOR TO ROOF OR CEILING DIAPHRAGM, UNO. ALL WALLS OVER 10'-0" ARE TO BE 2x6 @ 16" UNO.
- PROVIDE WATER-RESISTANT EXTERIOR WALL COVERING ON ALL FRAMED WALLS TO COMPLY WITH IRC SECTION 103.2.
- PROVIDE GFCI ELECTRICAL OUTLETS ON EXTERIOR, IN UNFINISHED BASEMENT, IN BATHROOMS, ABOVE KITCHEN COUNTERS, IN GARAGE, AND WITHIN 6'-0" OF ANY SINK.
- ALL EXTERIOR DOORS SERVED BY LANDING.
- INSTALL CARBON MONOXIDE DETECTORS PER IRC SECTION 315 OUTSIDE OF EACH SLEEPING AREA.
- INSTALL SMOKE DETECTORS IN EACH SLEEPING ROOM, OUTSIDE OF EACH SLEEPING AREA, WITH A MINIMUM OF ONE ON EACH FLOOR PER IRC SECTION 314.
- PROVIDE A "UFER" GROUND PER IRC 360.8.
- REFER TO SHEET 55 FOR ALL WALL BRACING DETAILS AND/OR CALCULATIONS.
- INSTALL BLOCKING FOR T/F HOLDERS, TOILET BARS, AND TRIM BEAMS.
- GARAGE DOOR H-FRAME: THE H-FRAME FOR ATTACHMENT OF THE TRACK AND COUNTER BALANCE SHALL CONSIST OF THE FOLLOWING: 2x6 VERTICAL JAMBS RUNNING FROM FLOOR TO CEILING ATTACHED WITH 3 1/4"x120 NAILS @ 1" C STAGGERED WITH (1) 3 1/4"x120 NAILS THRU JAMB INTO HEADER, MINIMUM 2x8 HEADER FOR ATTACHMENT OF COUNTER BALANCE SYSTEM.
- OVERHEAD GARAGE DOORS TO MEET 15% WIND LOAD RESISTANCE REQUIREMENTS OF DASHA 108-11 AND ASTM E 330-02.
- MAXIMUM RISER HEIGHT OF STAIRWAYS SHALL NOT EXCEED 1 3/4" AND THE TREADS SHALL PROVIDE A MINIMUM TREAD DEPTH OF 10".
- ALL EXTERIOR AND LOAD BEARING WINDOW AND DOOR HEADERS TO BE (2) 2x10 DFR 2 UNLESS NOTED OTHERWISE ON PLANS.
- ALL HEADER BEARINGS (OTHER THAN WINDOWS) TO BE (2) 2x4 STUDS UNLESS NOTED OTHERWISE. WINDOW HEADER BEARING TO BE (1) 2x4 EA END UNLESS NOTED OTHERWISE.
- SLOPING VAULTS SHALL BE FURRED DOWN WITH 2x MATERIAL & AFFIXED WITH 1/2" OSB FLITCH PLATE TO PROVIDE REQUIRED DEPTH FOR INSULATION (RE: ENERGY REQUIREMENTS and/or FRAMING DETAILS)

////////// DENOTES LOAD BEARING STUD WALL

WINDOW AND DOOR NOTES

- ALL WINDOWS ARE SHOWN IN INCHES (I.E. 30x60 IS A 30"x60" WINDOW). ALL DOORS SHOWN IN FEET AND INCHES (I.E. 28x8 DOOR IS A 2'-8"x6'-8" DOOR). CONTRACTOR/INSTALLER TO VERIFY R.O. DIMENSIONS WITH BUILDER SUPPLIED CUT SHEET PRIOR TO FRAMING.
- ALL WINDOWS TO BE LOW-E GLASS TO MEET ALL LOCAL ENERGY CODE REQUIREMENTS.
- PROVIDE EGRESS WINDOW IN ALL SLEEPING ROOMS. WINDOWS SHALL COMPLY WITH THE FOLLOWING:
 - A. MINIMUM OPEN AREA: 5.7 SF
 - B. MINIMUM OPENING HEIGHT: 24 INCHES
 - C. MINIMUM OPENING WIDTH: 20 INCHES
 - D. SILL HEIGHT 44" MAX ABOVE FLOOR
- ALL WINDOW SILLS ARE TO BE 24" MIN ABOVE FINISH FLOOR, OR SHALL BE FIXED/INOPERABLE.
- ALL WINDOWS AND GLAZED DOORS SHALL COMPLY WITH IRC SECTION R308. IRC SECTION R308.4. GLAZING IN HAZARDOUS LOCATIONS SHALL BE OF APPROVED SAFETY GLAZING MATERIALS. GLASS IN STORM DOORS, INDIVIDUAL FIXED OR OPERABLE PANELS ADJACENT TO A DOOR WHERE THE NEAREST VERTICAL EDGE IS WITHIN A 24" ARC OF THE DOOR IN A CLOSED POSITION AND WHOSE BOTTOM EDGE IS WITHIN 60" OF THE FLOOR WALLS ENCLOSING STAIRWAYS AND LANDINGS WHERE THE GLAZING IS WITHIN 60" OF THE TOP OR BOTTOM OF STAIR ENCLOSURES FOR BALCONIES, SHOWERS AND WHIRLPOOLS. GLAZING IN FIXED OR OPERABLE PANELS EXCEEDING 9 SF AND WHOSE BOTTOM EDGE IS LESS THAN 18" ABOVE THE FLOOR OR WALKING SURFACE WITHIN 36".
- ALL OPERABLE WINDOWS SHALL HAVE FALL PROTECTION PER IRC R312.2.
- ALL GLAZING IN WINDOWS AND DOORS SHALL COMPLY WITH THE TEST CRITERIA FOR CATEGORY II IN ACCORDANCE WITH CPSC 16 CFR 1201.
- WINDOW MANUFACTURER TO CONFIRM EXACT SAFETY AND EGRESS WINDOW LOCATIONS PER LOCAL CODES.

ENERGY REQUIREMENTS

CONTRACTOR TO PROVIDE ENERGY AUDIT USING THE HERS ENERGY RATING SYSTEM. IN LIEU OF AN ENERGY AUDIT, THE FOLLOWING PRESCRIPTIVE REQUIREMENTS MAY BE FOLLOWED:

- ALL DUCTS, AIR HANDLERS, FILTER BOXES, AND BUILDING CAVITIES TO BE SEALED PER IRC SECTION N103.1.
- THE BUILDING THERMAL ENVELOPE IS REQUIRED TO BE SEALED PER IRC SECTION N102.4.
- CONTRACTOR TO SUBMIT "MANUAL J" AND "MANUAL D" CALCULATIONS FOR THE HVAC SYSTEM.
- INSULATION TO COMPLY WITH IECC AS FOLLOWS:
 - WALLS: R-13
 - CEILING (FLAT): R-49
 - CEILING (VAULTED): R-38 (NOTE: VAULTED AREA NOT TO EXCEED 500sq ft. OR 20% OF ROOF AREA, WHICHEVER IS LESS)

FLOORS OVER UNCONDITIONED SPACE	R-19
CRAWL SPACE WALLS	R-13 (or R-10 CONTINUOUS)
BASEMENT WALLS	R-13 (or R-10 CONTINUOUS)
SLABS	N/R
DUCTWORK	R-8
WINDOWS	U 0.32 (MAX)
U-FACTOR	0.40 (MAX)
SKYLIGHTS	U 0.32 (MAX)
U-FACTOR	0.40 (MAX)

WALL BRACING NOTES:

- ALL WALLS ARE TYPE "CS-W8P" AND ARE CONTINUOUSLY SHEATHED UNLESS NOTED OTHERWISE. THE BRACED WALL NOTATIONS (IF SHOWN) REFLECT THE MINIMUM SHEATHING REQUIREMENTS PER CODE.
- IF NO NOTATIONS ARE SHOWN FOR WALLS TYPE "CS-W8P" ON PLAN, WALL IS FULLY SHEATHED AND MEETS ALL REQUIREMENTS WITH END CONDITION #1, #3, OR #4.
- EC # - END CONDITION PER IRC FIGURE R602.10.1. (FOR CONDITIONS #1, #3, & #4 NO HOLDDOWN REQUIRED)
- INTERIOR WALL BRACING NOT REQUIRED

XXXXXXXXXXXX DENOTES EXTERIOR BRACED WALL WOOD STRUCTURAL PANEL (W8P OR CS-W8P) ATTACHED PER DETAILS AND GENERAL NOTES



© COPYRIGHT 2023

JFE CONSTRUCTION INC.
1314 SW Market Street
Lee's Summit, MO 64081
v: 816.786.4008
jfeconstruction.com



Van Deuren and Associates, P.A. © 2023



THE MAPLEWOOD III


Keith Murrell
2109 NW O'Brien Road, Lee's Summit, MO
Lot 171 - Woodside Ridge

Project #: 8083-XXXX

DATE:

For Permit: 8/18/2023

GA4

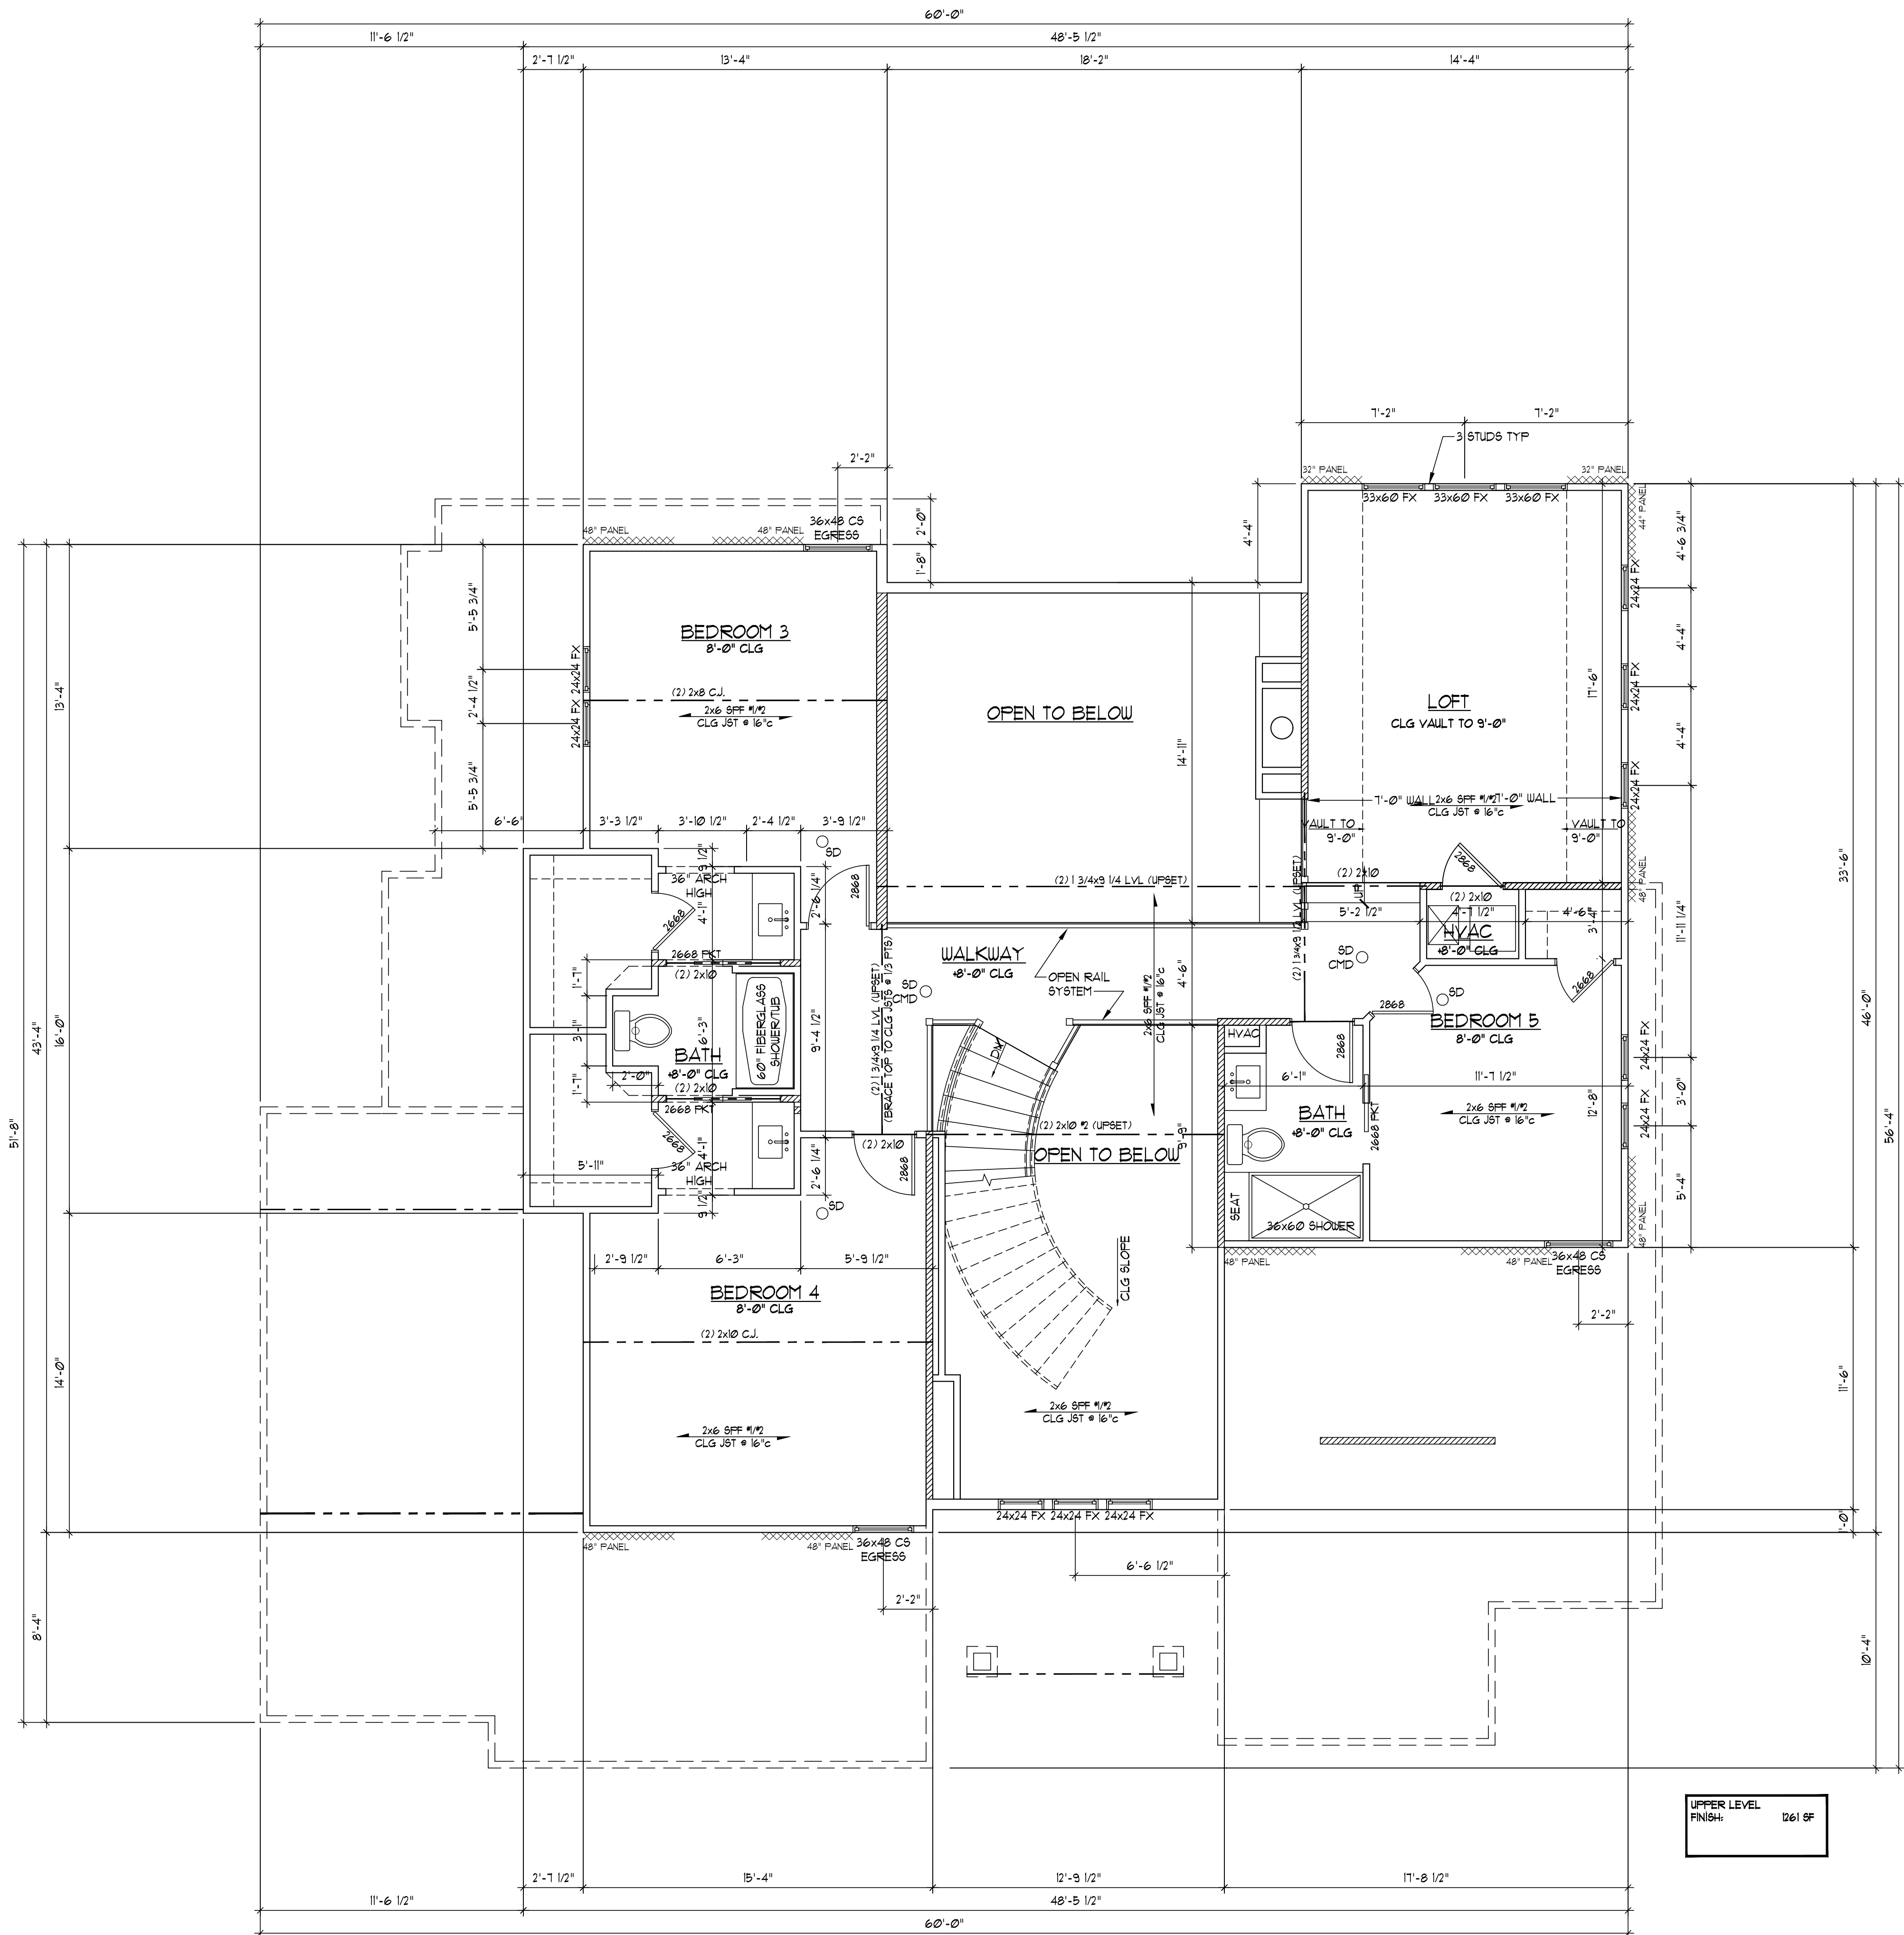

SECOND FLOOR PLAN
SCALE: 1/4" = 1'-0"

GENERAL PLAN REQUIREMENTS

- ALL STUD WALL FRAMING SHALL BE CONTINUOUS FROM THE FLOOR TO ROOF OR CEILING DIAPHRAGM, UNO. ALL WALLS OVER 10'-0" ARE TO BE 2x6 @ 16" c UNO.
- PROVIDE WATER-RESISTANT EXTERIOR WALL COVERING ON ALL FRAMED WALLS TO COMPLY WITH IRC SECTION 103.2.
- PROVIDE GFCI ELECTRICAL OUTLETS ON EXTERIOR, IN UNFINISHED BASEMENT, IN BATHROOMS, ABOVE KITCHEN COUNTERS, IN GARAGE, AND WITHIN 6'-0" OF ANY SINK.
- ALL EXTERIOR DOORS SERVED BY LANDING.
- INSTALL CARBON MONOXIDE DETECTORS PER IRC SECTION 315 OUTSIDE OF EACH SLEEPING AREA.
- INSTALL SMOKE DETECTORS IN EACH SLEEPING ROOM, OUTSIDE OF EACH SLEEPING AREA, WITH A MINIMUM OF ONE ON EACH FLOOR PER IRC SECTION 314.
- PROVIDE A "UFER" GROUND PER IRC 3608.1.
- REFER TO SHEET S3 FOR ALL WALL BRACING DETAILS AND/OR CALCULATIONS.
- INSTALL BLOCKING FOR TP HOLDERS, TOILET BARS, AND TRIM BEAMS.
- GARAGE DOOR H-FRAME: THE H-FRAME FOR ATTACHMENT OF THE TRACK AND COUNTER BALANCE SHALL CONSIST OF THE FOLLOWING: 2x6 VERTICAL JAMBS RUNNING FROM FLOOR TO CEILING ATTACHED WITH 3 1/4"x120 NAILS @ 1" c STAGGERED WITH (1) 3 1/4"x120 NAILS THRU JAMB INTO HEADER, MINIMUM 2x8 HEADER FOR ATTACHMENT OF COUNTER BALANCE SYSTEM.
- OVERHEAD GARAGE DOORS TO MEET 15 MPH WIND LOAD RESISTANCE REQUIREMENTS OF DASHA 108-11 AND ASTM E 330-02.
- MAXIMUM RISER HEIGHT OF STAIRWAYS SHALL NOT EXCEED 1 3/4" AND THE TREADS SHALL PROVIDE A MINIMUM TREAD DEPTH OF 10".
- ALL EXTERIOR AND LOAD BEARING WINDOW AND DOOR HEADERS TO BE (2) 2x10 DFR 2 UNLESS NOTED OTHERWISE ON PLANS.
- ALL HEADER BEARINGS (OTHER THAN WINDOWS) TO BE (2) 2x4 STUDS UNLESS NOTED OTHERWISE. WINDOW HEADER BEARING TO BE (1) 2x4 EA END UNLESS NOTED OTHERWISE.
- SLOPING VAULTS SHALL BE FURRED DOWN WITH 2x MATERIAL & AFFIXED WITH 1/2" OSB FLITCH PLATE TO PROVIDE REQUIRED DEPTH FOR INSULATION (RE: ENERGY REQUIREMENTS and/or FRAMING DETAILS)

////////// DENOTES LOAD BEARING STUD WALL

WINDOW AND DOOR NOTES

- ALL WINDOWS ARE SHOWN IN INCHES (I.E. 30x60 IS A 30"x60" WINDOW). ALL DOORS SHOWN IN FEET AND INCHES (I.E. 28x8 DOOR IS A 2'-8"x6'-8" DOOR). CONTRACTOR/INSTALLER TO VERIFY R.O. DIMENSIONS WITH BUILDER SUPPLIED CUT SHEET PRIOR TO FRAMING.
- ALL WINDOWS TO BE LOW-E GLASS TO MEET ALL LOCAL ENERGY CODE REQUIREMENTS.
- PROVIDE EGRESS WINDOW IN ALL SLEEPING ROOMS. WINDOWS SHALL COMPLY WITH THE FOLLOWING:
 - A. MINIMUM OPEN AREA 5.7 SF
 - B. MINIMUM OPENING HEIGHT 24 INCHES
 - C. MINIMUM OPENING WIDTH 20 INCHES
 - D. SILL HEIGHT 44" MAX ABOVE FLOOR
- ALL WINDOW SILLS ARE TO BE 24" MIN ABOVE FINISH FLOOR, OR SHALL BE FIXED/INOPERABLE.
- ALL WINDOWS AND GLAZED DOORS SHALL COMPLY WITH IRC SECTION R308. IRC SECTION R308.4: GLAZING IN HAZARDOUS LOCATIONS SHALL BE OF APPROVED SAFETY GLAZING MATERIALS. GLASS IN STORM DOORS, INDIVIDUAL FIXED OR OPERABLE PANELS ADJACENT TO A DOOR WHERE THE NEAREST VERTICAL EDGE IS WITHIN A 24" ARC OF THE DOOR IN A CLOSED POSITION AND WHOSE BOTTOM EDGE IS WITHIN 60" OF THE FLOOR WALLS ENCLOSING STAIRWAYS AND LANDINGS WHERE THE GLAZING IS WITHIN 60" OF THE TOP OR BOTTOM OF STAIR ENCLOSURES FOR TUBS, SHOWERS AND whirlpools. GLAZING IN FIXED OR OPERABLE PANELS EXCEEDING 9 SF AND WHOSE BOTTOM EDGE IS LESS THAN 18" ABOVE THE FLOOR OR WALKING SURFACE WITHIN 36".
- ALL OPERABLE WINDOWS SHALL HAVE FALL PROTECTION PER IRC R302.2.
- ALL GLAZING IN WINDOWS AND DOORS SHALL COMPLY WITH THE TEST CRITERIA FOR CATEGORY II IN ACCORDANCE WITH CPSC 16 CFR 1201.
- WINDOW MANUFACTURER TO CONFIRM EXACT SAFETY AND EGRESS WINDOW LOCATIONS PER LOCAL CODES.

ENERGY REQUIREMENTS

CONTRACTOR TO PROVIDE ENERGY AUDIT USING THE HERS ENERGY RATING SYSTEM. IN LIEU OF AN ENERGY AUDIT, THE FOLLOWING PRESCRIPTIVE REQUIREMENTS MAY BE FOLLOWED:

- ALL DUCTS, AIR HANDLERS, FILTER BOXES, AND BUILDING CAVITIES TO BE SEALED PER IRC SECTION N102.1.
- THE BUILDING THERMAL ENVELOPE IS REQUIRED TO BE SEALED PER IRC SECTION N102.4.
- CONTRACTOR TO SUBMIT "MANUAL J" AND "MANUAL D" CALCULATIONS FOR THE HVAC SYSTEM.
- INSULATION TO COMPLY WITH IECC AS FOLLOWS:

WALLS	R-13
CEILING (FLAT)	R-49
CEILING (VAULTED)	R-38 (NOTE: VAULTED AREA NOT TO EXCEED 500sq ft OR 20% OF ROOF AREA, WHICHEVER IS LESS)
FLOORS OVER UNCONDITIONED SPACE	R-19
CRAWL SPACE WALLS	R-13 (or R-10 CONTINUOUS)
BASEMENT WALLS	R-13 (or R-10 CONTINUOUS)
SLABS	N/R
DUCTWORK	R-8
WINDOWS	U 0.32 (MAX)
U-FACTOR	0.40 (MAX)
SHGC	0.40 (MAX)
SKYLIGHTS	U 0.32 (MAX)
U-FACTOR	0.40 (MAX)
SHGC	0.40 (MAX)

WALL BRACING NOTES:

- ALL WALLS ARE TYPE "CS-USP" AND ARE CONTINUOUSLY SHEATHED UNLESS NOTED OTHERWISE. THE BRACED WALL NOTATIONS (IF SHOWN) REFLECT THE MINIMUM SHEATHING REQUIREMENTS PER CODE.
- IF NO NOTATIONS ARE SHOWN FOR WALLS TYPE "CS-USP" ON PLAN, WALL IS FULLY SHEATHED AND MEETS ALL REQUIREMENTS WITH END CONDITION #1, #3, OR #4.
- EC # - END CONDITION PER IRC FIGURE R602.10.7. (FOR CONDITIONS #1, #3, & #4 NO HOLDDOWN REQUIRED)
- INTERIOR WALL BRACING NOT REQUIRED

XXXXXXXXXXXXX DENOTES EXTERIOR BRACED WALL WOOD STRUCTURAL PANEL (USP OR CS-USP) ATTACHED PER DETAILS AND GENERAL NOTES



© COPYRIGHT 2023

JFE CONSTRUCTION INC.
1314 SW Market Street
Lee's Summit, MO 64081
v: 816.786.4008
jfeconstruction.com



Van Deuren and Associates, P.A. © 2023



THE MAPLEWOOD III

Keith Murrell

2109 NW O'Brien Road, Lee's Summit, MO
Lot 171 - Woodside Ridge


Project #: 8083-XXXX

DATE:

For Permit: 8/18/2023

GA5

RELEASE FOR CONSTRUCTION
AS NOTED FOR PLAN REVIEW
DEVELOPMENT SERVICES
LEE'S SUMMIT, MISSOURI
08/22/2023

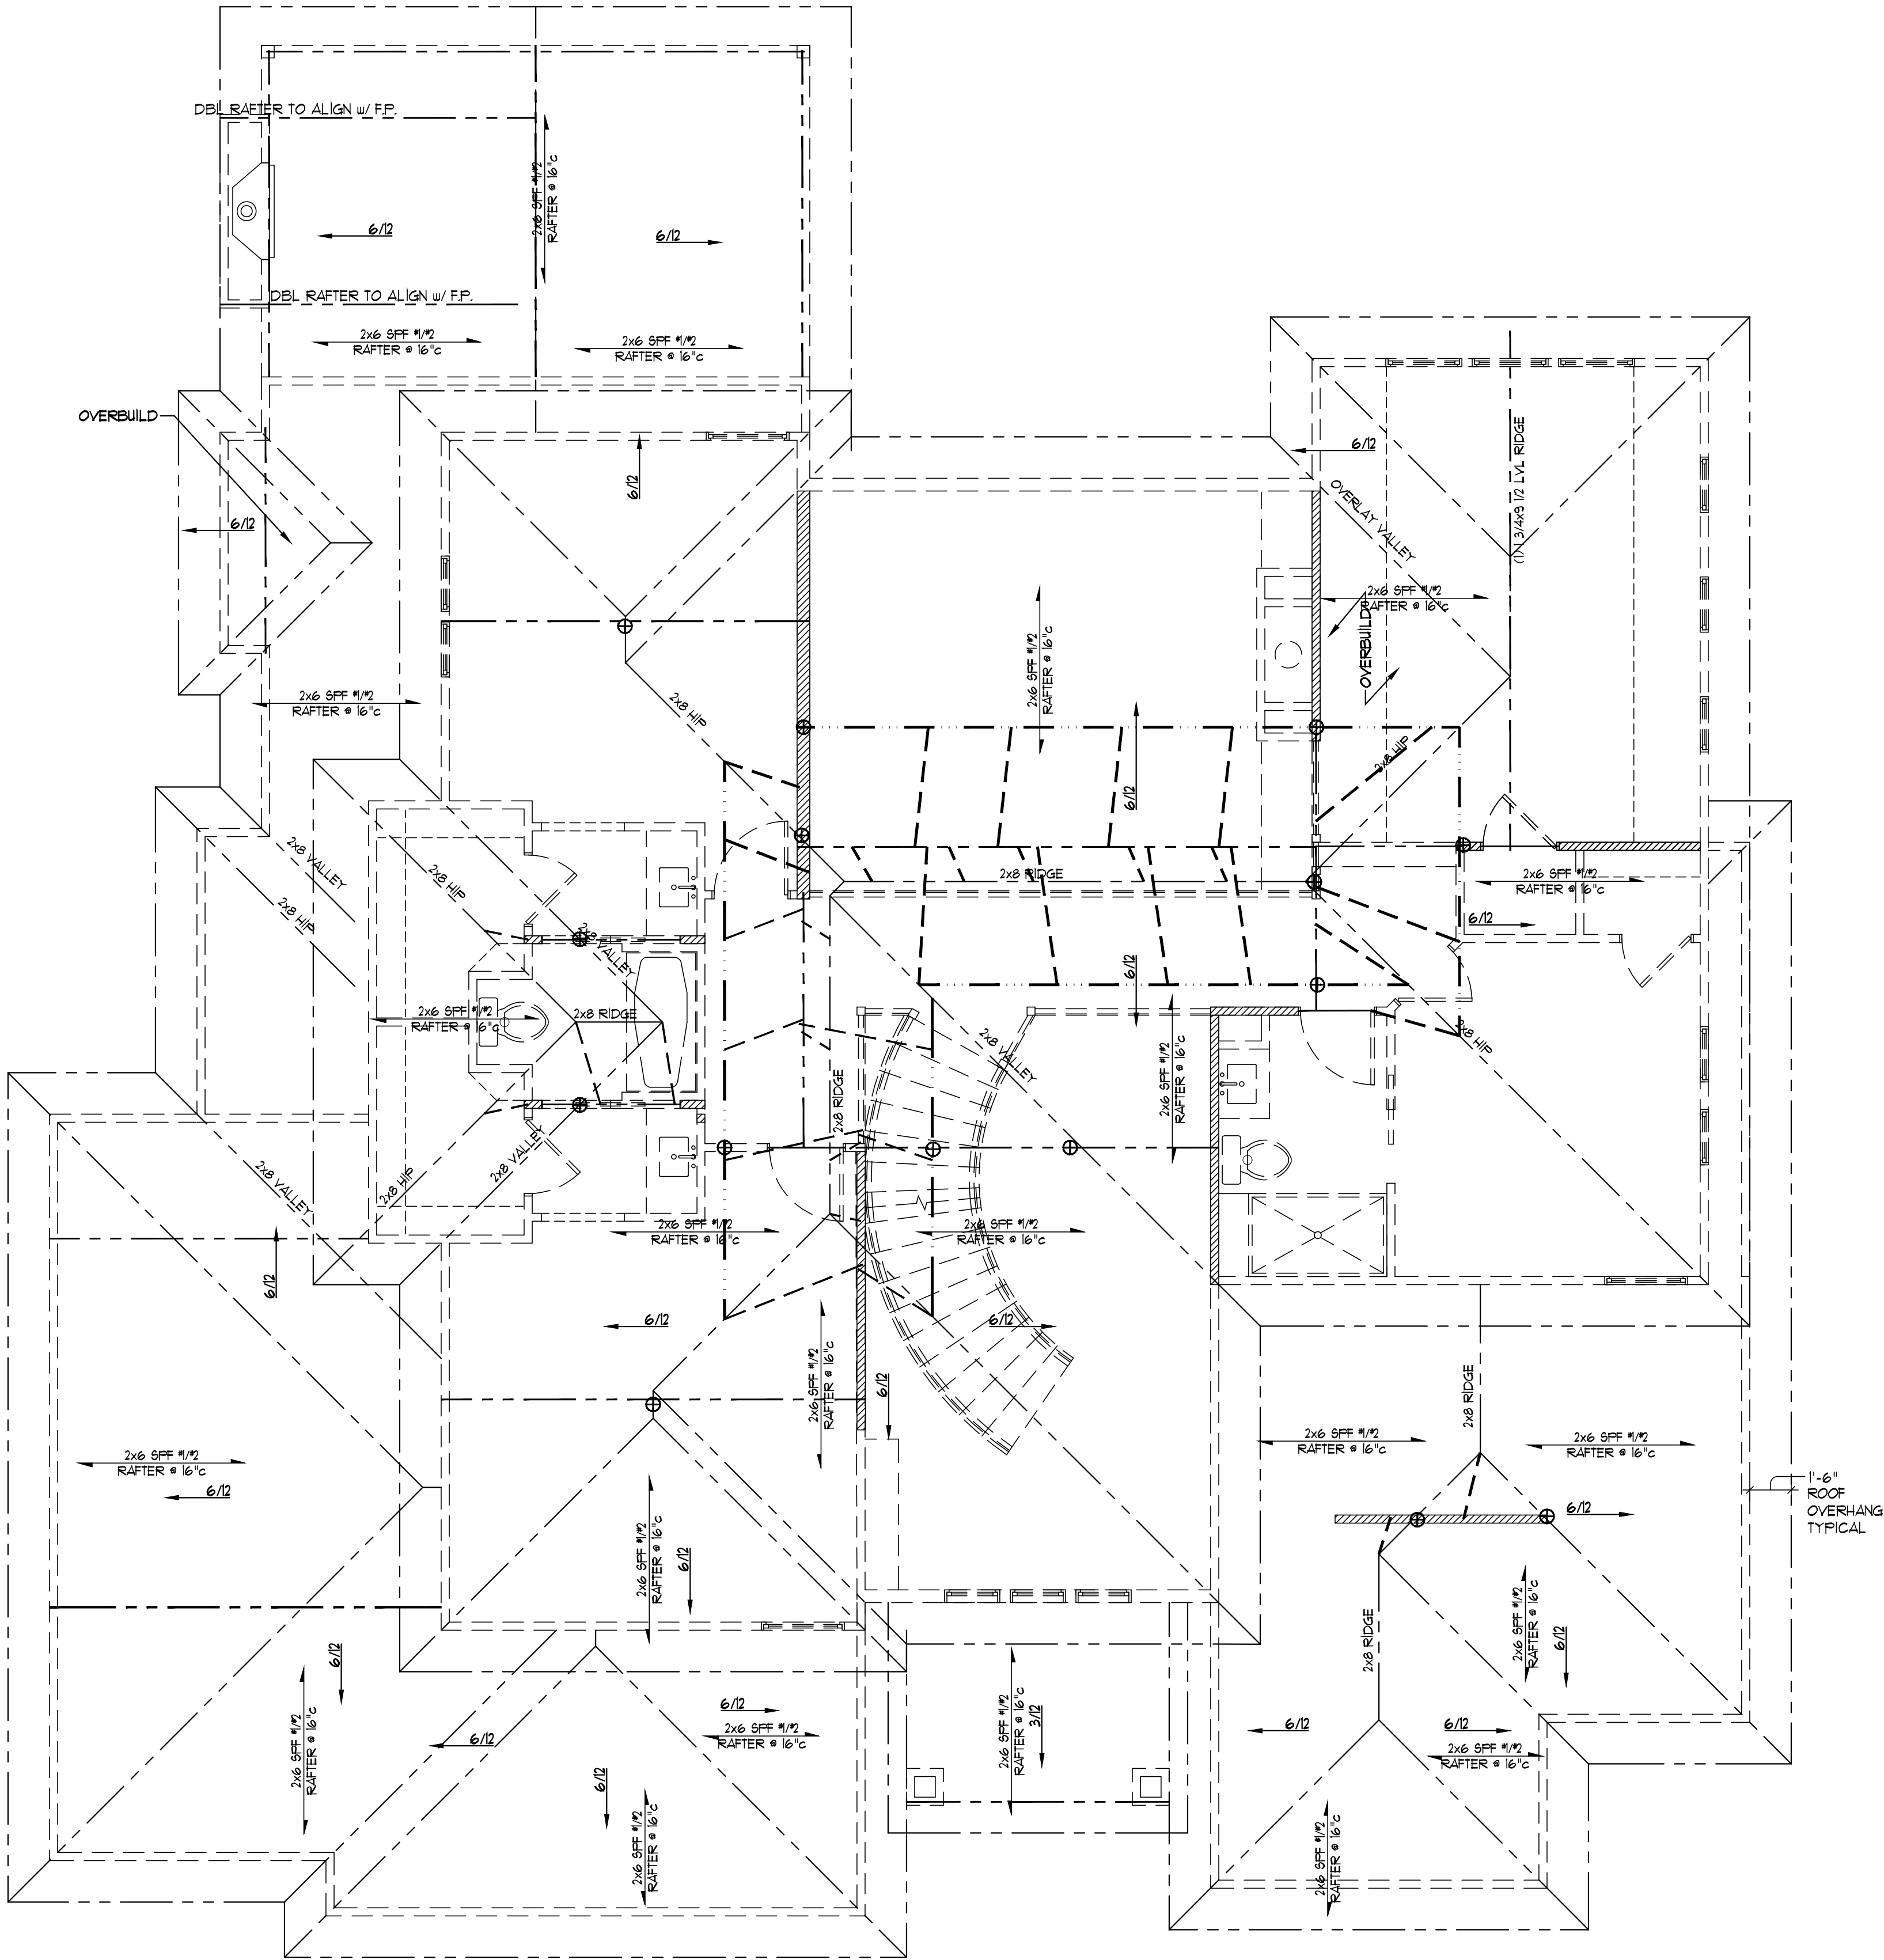

ROOF PLAN
SCALE: 1/4" = 1'-0"

ROOF PLAN NOTES

- ALL ROOF RAFTERS NOT CALLED OUT ARE TO BE 2x6 SFF #1/2 @ 16" c
- ALL CEILING JOISTS NOT CALLED OUT ARE TO BE 2x6 SFF #1/2 @ 16" c
- ALL VAULTS TO BE FURRED DOWN w/2x MATERIAL TO PROVIDE FOR R-38 INSULATION
- ALL EXTERIOR AND LOAD BEARING WINDOW AND DOOR HEADERS TO BE (2) 2x10 D FIR # UNLESS NOTED OTHERWISE ON PLANS
- ALL RIDGES, HIPs, AND VALLEYS NOT MARKED SHALL BE (1) NOMINAL SIZE LARGER THAN THE INTERSECTING RAFTERS
- CEILING JOISTS AND RAFTERS SHALL BE NAILED TO EACH OTHER WITH (3) 16d COM (3 1/2"x0.62") NAILS AND THE RAFTER SHALL BE NAILED TO THE TOP WALL PLATE WITH (3) 8d COM (2 1/2"x0.31") NAILS. CEILING JOISTS SHALL BE CONTINUOUS OR SECURELY JOINED WITH (3) 16d COM (3 1/2"x0.62") NAILS WHERE THEY MEET OVER INTERIOR PARTITIONS AND ARE NAILED TO ADJACENT RAFTERS TO PROVIDE A CONTINUOUS TIE ACROSS THE BUILDING WHEN SUCH JOISTS ARE PARALLEL TO THE RAFTERS
- WHERE CEILING JOISTS ARE NOT CONNECTED TO THE RAFTERS AT THE TOP WALL PLATE (or AT LOCATIONS WHERE C.J. ARE PERPENDICULAR TO RAFTERS), INSTALL 2x4 RAFTER TIES @ 16" c WITH (3) 16d COM (3 1/2"x0.62") NAILS EA END.
- ADDITIONAL NOTE: ROOFS WITH SLOPE OF 4:12 OR SHALL OVER SHALL HAVE (5) 16d COM NAILS AT THE CONNECTIONS LISTED IN NOTE #6 AND #7.
- RAFTER CONNECTIONS DESIGNED TO RESIST UPLIFT FORCES PER IRC TABLE 602.11. ROOF HEADERS DO NOT HAVE NOTABLE UPLIFT TO REQUIRE HOLD DOWNS. REFER TO STRUCTURAL DETAIL SHEET S1 CONNECTION TABLE FOR FASTENERS
- INSTALL 2x4 COLLAR TIES @ 48" c IN UFFER 1/3rd OF ROOF RAFTER.
- IF COLLAR TIES CAN NOT BE INSTALLED (AND FOR VAULTED/ CATHEDRAL ROOFS) INSTALL 1 1/4"x 12g8 RIDGE STRAP (SIMPSON LSTA2 or EQUIV.) PER FASTENER SCHEDULE.
- PROVIDE METAL FLASHING OR CLOSED CUT CORNER VALLEY w/ICE & WATER SHIELD AT ALL ROOF VALLEYS.
- ROOF AND SOFFIT VENTS PER LOCAL CODES. WHERE POSSIBLE, PROVIDE ROOF VENTING ON BACK SIDE OF ROOF. BATH VENTS TO VENT DIRECTLY TO THE OUTSIDE.
- PER IRC SECTION R802.3 - FOR ROOF PITCHES 3/12 OR GREATER, STRUCTURAL MEMBERS THAT SUPPORT RAFTERS AND CEILING JOISTS SUCH AS RIDGE BEAMS, HIPs AND VALLEYS THAT ARE SUPPORTED BY BRACES AND/OR FURLING AT THE ENDS ARE NOT REQUIRED TO BE DESIGNED AS BEAMS AND ARE TO BE FRAMED USING LUMBER THAT IS NOMINALLY 2" WIDE BY ONE SIZE GREATER THAN ATTACHING FRAMING MEMBER (NOTE #5). THERE IS NO STRUCTURAL LINE LOADING ON THE MEMBER.
- ALL HIPs AND HIP TO RIDGE CONNECTIONS SHOULD BE INSTALLED AND TIED PER THE ATTACHED DETAILS ON SHEET S2. THIS INCLUDES ADDITIONAL 2x8 CEILING JOISTS AND COLLAR TIES.
- EXACT GUTTER AND DOWNSPOUT LOCATION BY GUTTER INSTALLER.

ROOF BRACING

- ROOF FURLING TO BE PLACED APPROXIMATELY WHERE SHOWN ON PLANS, USE 2x6 STUD GRADE FURLIN PLACED PERPENDICULAR TO RAFTERS (UNLESS NOTED OTHERWISE ON PLANS)
- RIDGE, HIP, VALLEY, AND FURLIN BRACE STRUTS TO BE PLACED AS SHOWN ON PLANS. STRUTS TO BE 2x4 STUD GRADE w/ MAXIMUM UNBRACED LENGTH OF 8'-0" AND AT A 45° ANGLE w/ HORIZONTAL OR GREATER (VERTICAL WHERE POSSIBLE)
- BRACES LONGER THAN 8'-0" SHALL BE 2x4 STRONG BACK BRACES

NOMENCLATURE

- CEILING HEADERS AND BEAMS
- - - 2x6 ROOF FURLING (UNLESS NOTED OTHERWISE ON PLANS)
- - - 2x4 FURLIN/RIDGE BRACING @ 4'-0" c (STRONG BACK IF OVER 8'-0" LONG)
- ⊕ 2x4 STRONGBACK HIP, VALLEY, OR RIDGE RAFTER SUPPORT
- /// LOAD BEARING STUD WALLS



© COPYRIGHT 2023
JFE CONSTRUCTION INC.
1314 SW Market Street
Lee's Summit, MO 64081
v: 816.786.4008
jfeconstruction.com



Van Deurzen and Associates, P.A. © 2023



THE MAPLEWOOD III
Keith Murrell
2109 NW O'Brien Road, Lee's Summit, MO
Lot 171 - Woodside Ridge

Project #: 8083-XXXX

DATE:

For Permit: 8/18/2023



RELEASE FOR CONSTRUCTION
AS NOTED FOR PLAN REVIEW
DEVELOPMENT SERVICES
LEE'S SUMMIT, MISSOURI
08/22/2023

STRUCTURAL GENERAL NOTES

DIVISION 1 - GENERAL REQUIREMENTS

1. Design and construction work for this project shall conform to the requirements of the 2018 International Residential Code as amended by the City of Lee's Summit, MO

2. Furnish all labor, materials and equipment necessary to complete the work as shown or referred by the drawings.

3. Design Loads:
A. Elevated Floors:
Residential (Live Loads) 40 PSF
Sleeping rooms (Live Loads) 30 PSF
Floor Dead Load 10 PSF
Floor Joist Deflection (Total) L/240
Floor Joist Deflection (Live) L/360
Attic Storage (Live Loads) 10 PSF
Ceiling Dead Load 5 PSF
Ceiling Joist Deflection L/240
20 PSF
C. Roof Live Load
Ground Snow Load, pg 20 PSF
Flat Roof Snow Load, pf 20 PSF
Snow Exposure Factor, Ce 1.0
Snow Load Importance Factor, Is 1.0
Thermal Factor, Ct 1.0
D. Wind Load:
Basic Wind Speed (Vult) 115 MPH
Risk Category II
Exposure B
Internal Pressure Coefficient 0.18
4. The contractor shall establish and be responsible for verifying all dimensions and elevations shown on structural plans with those shown on architectural and mechanical drawings. If errors, omissions or discrepancies are found they be reported to the engineer before proceeding with the work.
5. Plans indicate size, location and general arrangement of construction. Dimensions lacking or not drawn to scale shall not be scaled but referred to the designer for interpretation.

DIVISION 2 - EARTHWORK

1. It is recommended that the contractor employ the services of a geotechnical engineer to observe, test and approve all excavation, fill and backfill work and to determine that subsurface conditions are compatible with those used in the design.
2. The minimum soil bearing capacity is 1500 PSF in accordance with Table 1804.2 of the International Building Code. All footings are designed to bear on natural undisturbed soil or controlled fill capable of adequately sustaining a maximum bearing pressure of 1500 PSF. If suitable bearing capacity is not encountered at the elevation indicated on the drawing, contractor shall notify the architect immediately.
3. All topsoil, organic material and existing structures shall be removed from building area and from areas to be paved. Stockpile all topsoil for reuse.
4. Controlled Fill Materials:
A. Granular Fill - Granular fill shall consist of washed, evenly graded mixture of crushed stone, or crushed or uncrushed gravel, with 100 percent passing a 1 1/2 inch sieve and not more than 5 percent passing a no. 4 sieve.
B. Shrinkage-Swell controlled fill - Shrinkage-swell controlled fill shall consist of material having a relatively low plasticity with a liquid limit of less than 45 percent and a plasticity index of less than 21 percent.
C. Controlled Fill - Controlled fill shall be either granular or shrinkage-swell controlled fill as specified above and as approved by the geotechnical engineer.
5. Controlled fill shall consist of material having a relatively low plasticity with a liquid limit of less than 45 percent and a plasticity index of less than 21 percent.
6. Foundation Preparation:
A. Proofroll site to identify soft or disturbed areas. If areas are found to be unsuitable for support of footings and/or slab-on-grade please contact the Engineer of Record.
B. Backfill directly under slab-on-grade with minimum of 4 inches of granular fill consisting of washed, evenly graded mixture of crushed stone, or crushed or uncrushed gravel, with 100 percent passing a 1 1/2 inch sieve and not more than 5 percent passing a no. 4 sieve.

2. Controlled Fill and Backfill Compaction:
A. All controlled fill and backfill shall be placed in lifts having maximum loose lift thickness of 9 inches.
B. Granular Fill - Compact granular fill below footing bearing elevation to a minimum of 96 percent of material's maximum dry density as determined by ASTM D 698 and to a minimum of 95 percent for material founded above footing bearing elevation.
C. Shrinkage-swell controlled fill - Compact shrinkage-swell controlled fill below footing bearing elevation to minimum of 96/95 percent of the material's maximum dry density as determined by ASTM D 698 and to a minimum of 95 percent for material founded above footing bearing elevation.
D. Controlled Fill - Compact controlled fill at a moisture content within a range of 0 to 4 percent above optimum moisture content.

DIVISION 3 - CONCRETE

1. All concrete work shall conform to the requirements of ACI 318 "Building Code Requirements for Reinforced Concrete" and ACI 301 "Specification for Structural Concrete Buildings."
2. Concrete materials shall comply with:
A. Cement - ASTM C 150 Type I
B. Aggregate - ASTM C 33, maximum aggregate size 3/4 inch
C. Water - Potable
D. Air-entraining admixture - ASTM C 260
E. Water-reducing admixture - ASTM C 494, including superplasticizers.
F. Fly ash - ASTM C 618, Class C
3. Concrete shall develop the following minimum 28 day design compressive strength (f'c):
Type of Construction Compressive Strength(f'c)
A. Footings, walls and basement slab 3000 PSI
B. Garage Slab 3000 PSI
C. Exterior slabs, steps, and curbs (air-entrained concrete) 4000 PSI
4. Concrete proportions shall be established on the basis of field experience and/or trial mixtures in accordance with ACI 318-88 Sections 5.2 and 5.3. When fly ash is utilized in the mix, mix shall contain a water-reducer. Fly ash shall be added at the rate of not more than 100 pounds per cubic yard and cement shall be reduced by not more than 15 percent by weight.
5. Proportion and design mixes to result in concrete slump at point of placement of not more than 4 inches, except grout for masonry of not more than 6 inches.
6. Use air-entraining admixture in exterior exposed concrete to result in concrete at point of placement having an air content of 5 to 7 percent entrained air.
7. Reinforcing Steel:
A. Reinforcing bars - ASTM A 615, grade 40, deformed.
B. Welded wire fabric - ASTM A 1064, lap at least one full mesh and lace splices with wire.
C. Supports for reinforcement - comply with CRSI recommendations.
8. Concrete Work Execution:
A. Minimum concrete cover for reinforcement shall be, unless noted otherwise on the drawings:
Cast against and exposed to earth - 3 inches
Exposed to earth or weather - 2 inches
Not exposed to earth or weather - 1 1/2 inches
B. All concrete is reinforced, reinforce concrete not indicated with same reinforcement as similar sections.
C. Protect concrete work from physical damage or reduced strength due to weather extremes:
A. Granular Fill - Granular fill shall consist of washed, evenly graded mixture of crushed stone, or crushed or uncrushed gravel, with 100 percent passing a 1 1/2 inch sieve and not more than 5 percent passing a no. 4 sieve.
B. Shrinkage-Swell controlled fill - Shrinkage-swell controlled fill shall consist of material having a relatively low plasticity with a liquid limit of less than 45 percent and a plasticity index of less than 21 percent.
C. Controlled Fill - Controlled fill shall be either granular or shrinkage-swell controlled fill as specified above and as approved by the geotechnical engineer.
5. Controlled fill shall consist of material having a relatively low plasticity with a liquid limit of less than 45 percent and a plasticity index of less than 21 percent.
6. Foundation Preparation:
A. Proofroll site to identify soft or disturbed areas. If areas are found to be unsuitable for support of footings and/or slab-on-grade please contact the Engineer of Record.
B. Backfill directly under slab-on-grade with minimum of 4 inches of granular fill consisting of washed, evenly graded mixture of crushed stone, or crushed or uncrushed gravel, with 100 percent passing a 1 1/2 inch sieve and not more than 5 percent passing a no. 4 sieve.

DIVISION 5.5 - MISCELLANEOUS STRUCTURAL STEEL

1. All miscellaneous structural steel work shall conform to the requirements of AISC "Specifications for Design, Fabrication, and Erection of Structural Steel for Buildings".
2. Miscellaneous structural steel material shall comply with:
A. Structural Steel - ASTM A 36
B. Cold-formed Steel Purlins - ASTM A 500 Grade B
C. Anchor Rods - ASTM F-1554, non-headed type unless otherwise noted.

DIVISION 6 - ROUGH CARPENTRY

1. All rough carpentry work shall conform to the requirements of NFOPA "National Design Specification of Wood Construction", TPI "Design Specifications for Light Metal Plate Connected Wood Trusses", APA Plywood Design Specifications, DCC PS 1 "Product Standard for Construction and Industrial Plywood", DCC PS 56 "Structural Glued Laminated Timber" and Chapter 23 of the International Building Code.
2. Rough carpentry materials shall comply with:
A. Lumber - S4S, surface dry, grade marked, complying with PS 20; graded under WMPA or SPIB rules:
Joist: Stud Grade - Spruce-Pine-Fir
Joist: No. 2 Douglas Fir No. 2 Hem Fir
Header: No. 2 Douglas Fir
Rafter: No. 3 Douglas Fir No. 2 Spruce-Pine-Fir
Plates: No. 3 Spruce-Pine-Fir
Blocking: No. 3 Spruce-Pine-Fir
B. Metal framing fasteners - ASTM A 153, hot-dip galvanized fasteners; equal to Simpson strong-tie connectors complying with UDO No. 1258.
C. Plywood - APA rated sheathing, complying to PS 1.
D. LVL - Laminated veneer lumber shall be grade 2800 F-2, OE and shall meet the requirements of NER-442, NER-472 or ER-4521.
E. Joist - LVL shall be fabricated from APA rated sheathing board webs, LVL flanges, utilizing waterproof type glue and shall meet requirements of NER-450, NER-446, NER-476 or ICBO PFC-3754.
F. Glulam Beams - Combination 20F-V3 in accordance with Table No. 25-C-1 Part A of Chapter 23 of the International Building Code.
G. Fiberboard Sheathing - DCC Standard PS 57-7.
H. Gypsum Sheathing Board - ASTM C 77 and USC Standard No. 47-10.
I. Gypsum Wallboard - ASTM C 36 and USC Standard No. 47-11.
3. Roof sheathing for standard asphalt roofing shall be 1/2 inch APA rated sheathing 24/0 exterior glued and fastened. Roof sheathing for Conc Tite shall be 5/8 inch APA rated 32/16 exterior glued and clipped. Lay sheathing with face grain perpendicular to support members and stagger end joints 4'-0". FASTEN PER SCHEDULE BELOW.
4. Floor sheathing shall be 3/4 inch APA rated sheathing 48/24 exterior glued. Lay sheathing with face grain perpendicular to support members and stagger end joints 4'-0". FASTEN PER SCHEDULE BELOW.
5. Exterior wall sheathing shall be 1/2 inch APA Rated sheathing 24/0 or 7/16 inch LP Smart Siding exterior glaze. Provide solid blocking at all unsupported panel edges. FASTEN PER SCHEDULE BELOW. For LP Siding, fasten through both panels at edge supports.
6. Interior shear wall sheathing where noted shall be 1/2 inch gypsum wallboard. FASTEN PER SCHEDULE BELOW.
7. Attach metal framing fasteners to framing members with minimum number and size of nails listed in ICBO Report No. 1258.
8. Provide full depth solid blocking, 1 X 4 cross bracing, or 16 gage metal cross bracing bridging at ends of members and at 8'-0" intervals along members.

ATTIC ACCESS HATCH

SCALE: 3/4" = 1'-0"

WOOD HEADER TO WALL CONNECTION

SCALE: 3/4" = 1'-0"

UPSET STEEL BEAM TO WALL CONN.

SCALE: 3/4" = 1'-0"

DUCT INSTALLATION

WRAP DUCT w/R-8 BATT INSULATION IN ALL UNCONDITIONED LOCATIONS

ALL JOINTS AND CONNECTIONS TO BE SEALED USING 2 1/2" FOIL TAPE OR APPROVED FOR SEALING CLASS 1 RIGID (181A-F) OR CLASS 1 FLEXIBLE (181B-FX) DUCT JOINTS AND CONNECTIONS

UPSET HEADER TO HEADER CONNECTION (UPSET HDR TO WALL SIM)

SCALE: 3/4" = 1'-0"

STEEL BEAM TO WALL CONNECTION

SCALE: 3/4" = 1'-0"

FURRING CONNECTION

SCALE: 3/4" = 1'-0"

DECK ROOF AND/OR OPEN DECK HDR CONN

SCALE: 3/4" = 1'-0"

COVERED DECK POST CONN

SCALE: 3/4" = 1'-0"

COVERED DECK POST CONN

SCALE: 3/4" = 1'-0"

STEEL POST CAP AND MISC POST CONN DETAILS

SCALE: 3/4" = 1'-0"

COVERED DECK POST CONN

SCALE: 3/4" = 1'-0"

ITEM

DESCRIPTION OF BUILDING ELEMENTS

NUMBER AND TYPE OF FASTENER^{a, b, c}

SPACING AND LOCATION

COMMON NAIL

PNEUMATIC NAIL

ROOF

1. Blocking between ceiling joists or rafters to top plate
(4) 8d box
(3) 8d common
(3) 10d box

(4) 2 1/2" x 0.113"
(3) 2 1/2" x 0.131"
(3) 3" x 0.128"
(3) 3" x 0.131"

Toe nail

2. Ceiling joists to top plate
(4) 8d box
(3) 8d common
(3) 10d box

(4) 2 1/2" x 0.113"
(3) 2 1/2" x 0.131"
(3) 3" x 0.128"
(3) 3" x 0.131"

Per joist, toe nail

3. Ceiling joist not attached to parallel rafter, laps over partitions
(4) 10d box
(3) 16d common

(4) 3" x 0.128"
(3) 3 1/2" x 0.162"
(4) 3" x 0.131"

Face nail

4. Ceiling joist attached to parallel rafter (heel joint)
Note: Fasteners listed IRC Table R802.5.2 assuming 16" Rafters / Joists, & spans less than 12'-0"
Collar tie to rafter, face nail or 11/4" x 20ga. ridge strap to rafter
(4) 10d box
(3) 16d common

(4) 3" x 0.128"
(3) 3" x 0.148"
(4) 3" x 0.131"

Face nail each rafter

5. Rafter or roof truss to plate
(3) 16d box
(3) 10d common
(4) 10d box

(3) 3 1/2" x 0.135"
(3) 3" x 0.148"
(4) 3" x 0.128"
(4) 3" x 0.131"

2 toe nails on one side and 1 toe nail on opposite side of each rafter or truss

6. Roof rafters to ridge, valley or hip rafters or roof rafter to minimum 2" rafter beam
(4) 16d
(3) 10d common
(4) 10d box

(4) 3 1/2" x 0.135"
(3) 3 1/2" x 0.148"
(4) 3" x 0.128"
(4) 3" x 0.131"

Toe nail

7. Continuous header to stud
(3) 16d box
(2) 16d common
(3) 10d box

(3) 3 1/2" x 0.135"
(2) 3 1/2" x 0.162"
(3) 3" x 0.128"
(3) 3" x 0.131"

End nail

WALL

8. Stud to stud (not at braced wall panels)
16d common
10d box

3 1/2" x 0.162"
3" x 0.128"
3" x 0.131"

24" face nail
16" face nail

9. Stud to stud and abutting studs at intersecting wall panels
16d box
16d common

3 1/2" x 0.135"
3" x 0.131"
3 1/2" x 0.162"

16" face nail

10. Built-up header (2" to 2" header with 1/2" spacer)
16d common
16d box

3 1/2" x 0.162"
3 1/2" x 0.135"
3 1/2" x 0.135"

16" each edge face nail
12" each edge face nail

11. Continuous header to stud
(5) 8d box
(4) 8d common
(4) 10d box

(5) 2 1/2" x 0.113"
(4) 2 1/2" x 0.131"
(4) 3" x 0.128"

Toe nail

12. Top plate to top plate
16d common
10d box

3 1/2" x 0.162"
3" x 0.128"
3" x 0.131"

16" face nail
12" face nail

13. Double top plate splice for SDGs A-D2 with seismic braced wall line spacing < 25'
(6) 16d common
(12) 16d box
(12) 10d box

(8) 3 1/2" x 0.162"
(12) 3 1/2" x 0.135"
(12) 3" x 0.128"
(12) 3" x 0.131"

Face nail on each side of end joint (minimum 24" lap splice length each side of end joint)

14. Double top plate splice SDGs DO, D1, or D2, and braced wall line spacing < 25'
Bottom plate to joist, rim joist, band joist or blocking (not at braced wall panels)
16d common
16d box

3 1/2" x 0.162"
3 1/2" x 0.135"
3" x 0.131"

16" face nail
12" face nail

15. Bottom plate to joist, rim joist, band joist or blocking (at braced wall panels)
(3) 16d box
(2) 16d common

(3) 3 1/2" x 0.135"
(2) 3 1/2" x 0.162"
(4) 3" x 0.128"
(4) 3" x 0.131"

3 each 16" face nail
2 each 16" face nail
4 each 16" face nail

16. Top or bottom plate to stud
(4) 8d box
(3) 16d box
(4) 8d common
(4) 10d box

(4) 2 1/2" x 0.113"
(3) 3 1/2" x 0.135"
(4) 2 1/2" x 0.131"
(4) 3" x 0.128"
(4) 3" x 0.131"

Toe nail

17. Top plates, laps at corners and intersections
(3) 10d box
(2) 16d common

(3) 3 1/2" x 0.135"
(2) 3 1/2" x 0.113"
(3) 3" x 0.128"
(3) 3" x 0.131"

End nail

18. Top plates, laps at corners and intersections
(3) 10d box
(2) 16d common

(3) 3 1/2" x 0.135"
(2) 3 1/2" x 0.113"
(3) 3" x 0.128"
(3) 3" x 0.131"

End nail

19. 1" x 6" sheathing to each bearing
(3) 10d box
(2) 16d common

(3) 3 1/2" x 0.135"
(2) 3 1/2" x 0.113"
(3) 3" x 0.128"
(3) 3" x 0.131"

End nail

20. 1" x 8" and wider sheathing to each bearing
(3) 10d box
(2) 16d common

(3) 3 1/2" x 0.135"
(2) 3 1/2" x 0.113"
(3) 3" x 0.128"
(3) 3" x 0.131"

End nail

ITEM

DESCRIPTION OF BUILDING ELEMENTS

NUMBER AND TYPE OF FASTENER^{a, b, c}

SPACING AND LOCATION

COMMON NAIL

PNEUMATIC NAIL

FLOOR

21. Joist to sill, top plate or girder
(4) 8d box
(3) 8d common
(3) 10d box

(4) 2 1/2" x 0.113"
(3) 2 1/2" x 0.131"
(3) 3" x 0.128"
(3) 3" x 0.131"

Toe nail

22. Rim joist, band joist or blocking to sill or top plate (roof applications also)
(4) 8d box
(3) 8d common
(3) 10d box

(4) 2 1/2" x 0.113"
(3) 2 1/2" x 0.131"
(3) 3" x 0.128"
(3) 3" x 0.131"

4" c toe nail
6" c toe nail

23. 1" x 6" subfloor or less to each joist
(3) 8d box
(2) 8d common
(3) 10d box
(2) Staples

(3) 2 1/2" x 0.113"
(2) 2 1/2" x 0.131"
(3) 3" x 0.128"

Face nail

24. 2" subfloor to joist or girder
(3) 16d box
(2) 16d common
(3) 10d box

(3) 3 1/2" x 0.135"
(2) 3 1/2" x 0.162"
(3) 3" x 0.128"

Blind and face nail

25. 2" planks (plank & beam-floor & roof)
(3) 16d box
(2) 16d common
(3) 10d box

(3) 3 1/2" x 0.135"
(2) 3 1/2" x 0.162"
(3) 3" x 0.128"

At each bearing, face nail

26. Band or rim joist to joist
(3) 16d box
(2) 16d common
(3) 10d box

(3) 3 1/2" x 0.135"
(2) 3 1/2" x 0.162"
(3) 3" x 0.128"

End nail

27. Built-up girders and beams, (2) inch lumber layers
20d common
10d box

4" x 0.192"
3" x 0.128"
3" x 0.131"

Nail each layer as follows:
32" at top and bottom and staggered on opposite sides
24" face nail at top and bottom staggered on opposite sides
Face nail at ends and at each splice

28. Ledger strip supporting joists or rafters
(4) 16d box
(3) 16d common
(4) 10d box

(4) 3 1/2" x 0.135"
(3) 3 1/2" x 0.162"
(4) 3" x 0.128"
(4) 3" x 0.131"

At each joist or rafter, face nail

29. Bridging to joist
(2) 10d

(2) 3" x 0.128"

Ea end, toe nail

ITEM

DESCRIPTION OF BUILDING ELEMENTS

NUMBER AND TYPE OF FASTENER^{a, b, c}

SPACING AND LOCATION

COMMON NAIL

PNEUMATIC NAIL

WOOD STRUCTURAL PANELS, SUBFLOOR, ROOF AND INTERIOR WALL SHEATHING TO FRAMING AND PARTICLEBOARD WALL SHEATHING TO FRAMING

30. 3/8" - 1/2"
8d common
8d common (roof)

2" x 0.113"
2 1/2" x 0.131"

6 12'

31. 19/32" - 1"
8d common

2 1/2" x 0.131"

6 12'

32. 1 1/8" - 1 1/4"
10d common
8d deformed nail

3" x 0.148"
2 1/2" x 0.131"

6 12

OTHER WALL SHEATHING

33. 1/2" structural cellulose fiberboard sheathing
1 1/2" galv. roofing nail, 7/16" D head, or 1" crown staple 16 ga., 1 1/4" long

3 6

34. 25/32" structural cellulose fiberboard sheathing
1 3/4" galv. roofing nail, 7/16" D head, or 1" crown staple 16 ga., 1 1/4" long

3 6

35. 1/2" gypsum sheathing^d
1 1/2" galv. roofing nail, staple galv., 1 1/2" long, 1.58" screws, Type W or S

7 7

36. 5/8" gypsum sheathing^d
1 3/4" galv. roofing nail, staple galv., 1 5/8" long, 1.58" screws, Type W or S

7 7

WOOD STRUCTURAL PANELS, COMBINATION SUBFLOOR UNDERLAYMENT TO FRAMING

37. 3/4" and less
6d deformed
8d common

2" x 0.120"
2 1/2" x 0.131"

6 12

38. 7/8" - 1"
8d common
8d deformed

2 1/2" x 0.131"
2 1/2" x 0.120"

6 12

39. 1 1/8" - 1 1/4"
10d common
8d deformed

3" x 0.148"
2 1/2" x 0.120"

6 12

Notes:

a. Nails are smooth-common, box or deformed shanks except where otherwise stated. Nails used for framing and sheathing connections shall have minimum average bending yield strength as shown: 80 ksi for shank diameter of 0.192 inch (20d common nail), 90 ksi for shank diameters larger than 0.142 inch but not larger than 0.177 inch, and 100 ksi for shank diameters of 0.142 inch or less.

b. Staples are 16 gage wire and have a minimum 7/16-inch on diameter crown width.

c. Fasteners shall be spaced at not more than 6 inches on center at all supports where spans are 48 inches or greater.

d. Face nail by 8-foot or 4-foot by 8-foot panels shall be applied vertically.

e. Spacing of fasteners not included in this table shall be based on Table R602.3.2.

f. Where the ultimate design wind speed is 130 mph or less, nails for attaching wood structural panel roof sheathing to gable end wall framing shall be spaced 8 inches on center. Where the ultimate design wind speed is greater than 130 mph, nails for attaching panel roof sheathing to intermediate supports shall be spaced 5 inches on center for minimum 48-inch distance from ridges, eaves and gable end walls, and 4 inches on center to gable end wall framing.

g. Gypsum sheathing shall conform to ASTM C 1396 and shall be installed in accordance with G-253. Fiberboard sheathing shall conform to ASTM C 208.

h. Spacing of fasteners on roof sheathing panel edges applies to panel edges supported by framing members and required blocking and at floor perimeters only. Spacing of fasteners on roof sheathing panel edges applies to panel edges supported by framing members and required blocking. Blocking of roof or floor sheathing panel edges perpendicular to the framing members need not be provided except as required by other provisions of this code. Floor perimeter shall be provided by framing members or solid blocking.

i. Where a rafter is fastened to an adjacent parallel ceiling joist in accordance with this schedule, provide two toe nails on one side of the rafter and toe nails from the ceiling joist to the gable in accordance with this schedule. The toe nail on the opposite side of the rafter shall not be required.

k. Staples to be 1" crown, 16ga., 1 3/4" long.

ITEM

DESCRIPTION OF BUILDING ELEMENTS

NUMBER AND TYPE OF FASTENER^{a, b, c}

SPACING AND LOCATION

COMMON NAIL

PNEUMATIC NAIL

WALL

8. Stud to stud (not at braced wall panels)
16d common
10d box

3 1/2" x 0.162"
3" x 0.128"
3" x 0.131"

24" face nail
16" face nail

9. Stud to stud and abutting studs at intersecting wall panels
16d box
16d common

3 1/2" x 0.135"
3" x 0.131"
3 1/2" x 0.162"

16" face nail

10. Built-up header (2" to 2" header with 1/2" spacer)
16d common
16d box

3 1/2" x 0.162"
3 1/2" x 0.135"
3 1/2" x 0.135"

16" each edge face nail
12" each edge face nail

11. Continuous header to stud
(5) 8d box
(4) 8d common
(4) 10d box

(5) 2 1/2" x 0.113"
(4) 2 1/2" x 0.131"
(4) 3" x 0.128"

Toe nail

12. Top plate to top plate
16d common
10d box

3 1/2" x 0.162"
3" x 0.128"
3" x 0.131"

16" face nail
12" face nail

13. Double top plate splice for SDGs A-D2 with seismic braced wall line spacing < 25'
(6) 16d common
(12) 16d box
(12) 10d box

(8) 3 1/2" x 0.162"
(12) 3 1/2" x 0.135"
(12) 3" x 0.128"
(12) 3" x 0.131"

Face nail on each side of end joint (minimum 24" lap splice length each side of end joint)

14. Double top plate splice SDGs DO, D1, or D2, and braced wall line spacing < 25'
Bottom plate to joist, rim joist, band joist or blocking (not at braced wall panels)
16d common
16d box

3 1/2" x 0.162"
3 1/2" x 0.135"
3" x 0.131"

16" face nail
12" face nail

15. Bottom plate to joist, rim joist, band joist or blocking (at braced wall panels)
(3) 16d box
(2) 16d common

(3) 3 1/2" x 0.135"
(2) 3 1/2" x 0.162"
(4) 3" x 0.128"
(4) 3" x 0.131"

3 each 16" face nail
2 each 16" face nail
4 each 16" face nail

16. Top or bottom plate to stud
(4) 8d box
(3) 16d box
(4) 8d common
(4) 10d box

(4) 2 1/2" x 0.113"
(3) 3 1/2" x 0.135"
(4) 2 1/2" x 0.131"
(4) 3" x 0.128"
(4) 3" x 0.131"

Toe nail

17. Top plates, laps at corners and intersections
(3) 10d box
(2) 16d common

(3) 3 1/2" x 0.135"
(2) 3 1/2" x 0.113"
(3) 3" x 0.128"
(3) 3" x 0.131"

End nail

18. Top plates, laps at corners and intersections
(3) 10d box
(2) 16d common

(3) 3 1/2" x 0.135"
(2) 3 1/2" x 0.113"
(3) 3" x 0.128"
(3) 3" x 0.131"

End nail

19. 1" x 6" sheathing to each bearing
(3) 10d box
(2) 16d common

(3) 3 1/2" x 0.135"
(2) 3 1/2" x 0.113"
(3) 3" x 0.128"
(3) 3" x 0.131"

End nail

20. 1" x 8" and wider sheathing to each bearing
(3) 10d box
(2) 16d common

(3) 3 1/2" x 0.135"
(2) 3 1/2" x 0.113"
(3) 3" x 0.128"
(3) 3" x 0.131"

End nail

ITEM

DESCRIPTION OF BUILDING ELEMENTS

NUMBER AND TYPE OF FASTENER^{a, b, c}

SPACING AND LOCATION

COMMON NAIL

PNEUMATIC NAIL

WOOD STRUCTURAL PANELS, SUBFLOOR, ROOF AND INTERIOR WALL SHEATHING TO FRAMING AND PARTICLEBOARD WALL SHEATHING TO FRAMING

30. 3/8" - 1/2"
8d common
8d common (roof)

2" x 0.113"
2 1/2" x 0.131"

6 12'

31. 19/32" - 1"
8d common

2 1/2" x 0.131"

6 12'

32. 1 1/8" - 1 1/4"
10d common
8d deformed nail

3" x 0.148"
2 1/2" x 0.131"

6 12

OTHER WALL SHEATHING

33. 1/2" structural cellulose fiberboard sheathing
1 1/2" galv. roofing nail, 7/16" D head, or 1" crown staple 16 ga., 1 1/4" long

3 6

34. 25/32" structural cellulose fiberboard sheathing
1 3/4" galv. roofing nail, 7/16" D head, or 1" crown staple 16 ga., 1 1/4" long

3 6

35. 1/2" gypsum sheathing^d
1 1/2" galv. roofing nail, staple galv., 1 1/2" long, 1.58" screws, Type W or S

7 7

36. 5/8" gypsum sheathing^d
1 3/4" galv. roofing nail, staple galv., 1 5/8" long, 1.58" screws, Type W or S

7 7


WOOD STRUCTURAL PANELS, COMBINATION SUBFLOOR UNDERLAYMENT TO FRAMING

37. 3/4" and less
6d deformed
8d common


2" x 0.120"
2 1/2" x 0.131"

6 12


38. 7/8" - 1"
8d common
8d deformed

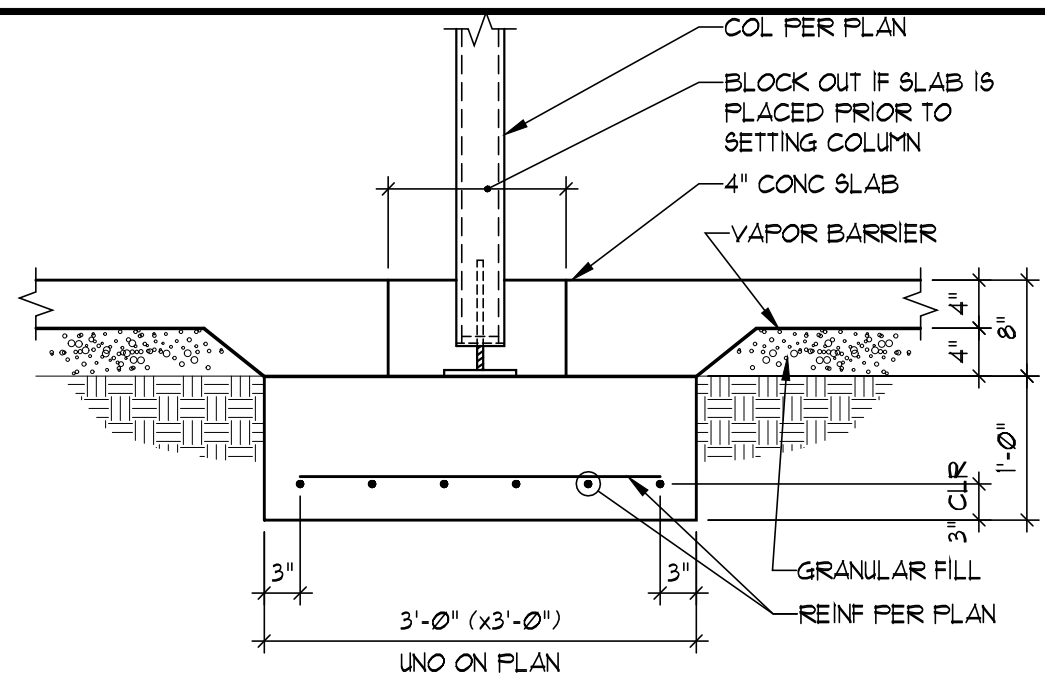


TYPICAL INTERIOR COLUMN
SCALE: 3/4" = 1'-0"

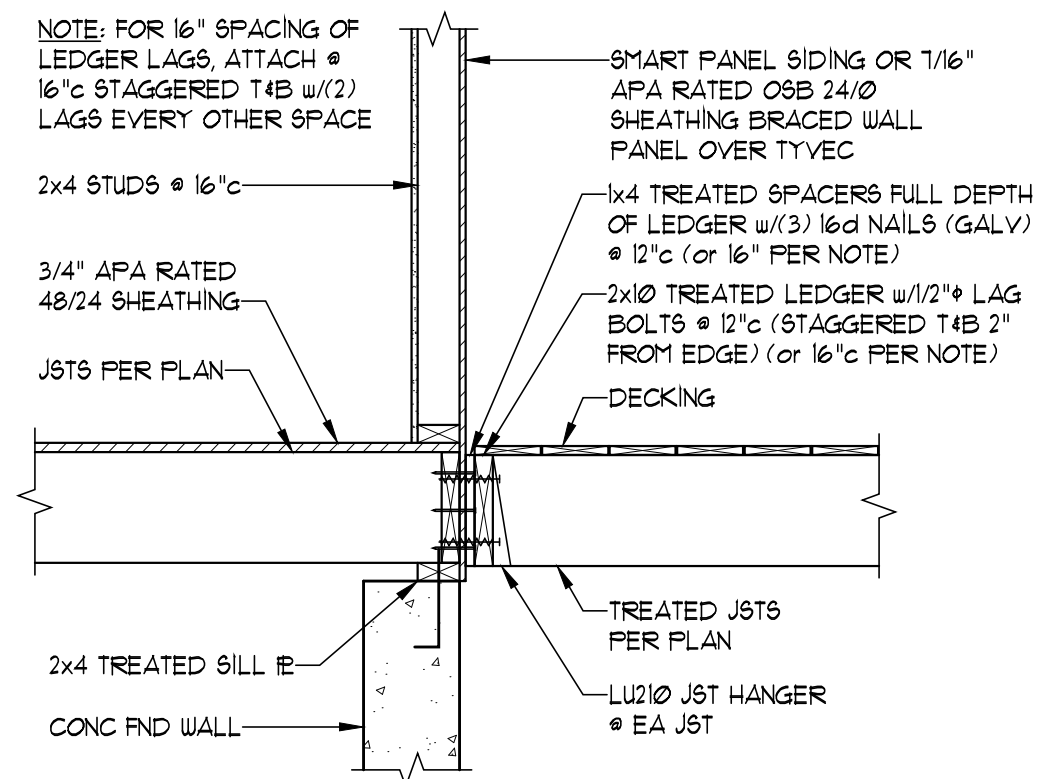


DECK ATTACHMENT
SCALE: 3/4" = 1'-0"

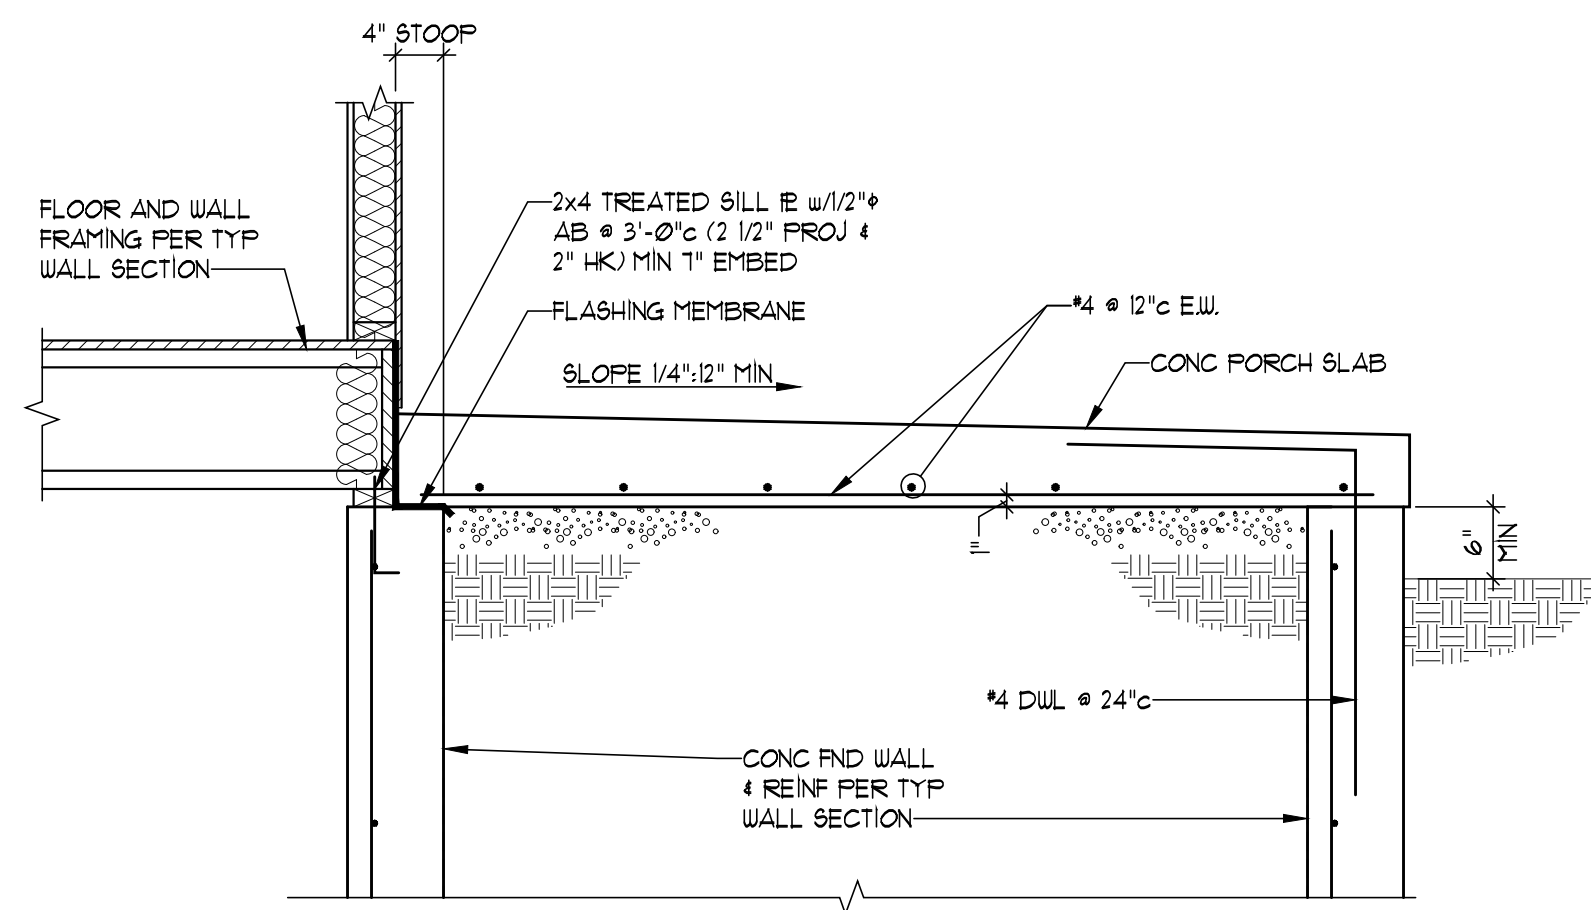


TYPICAL SECTION THRU PORCH
SCALE: 3/4" = 1'-0"

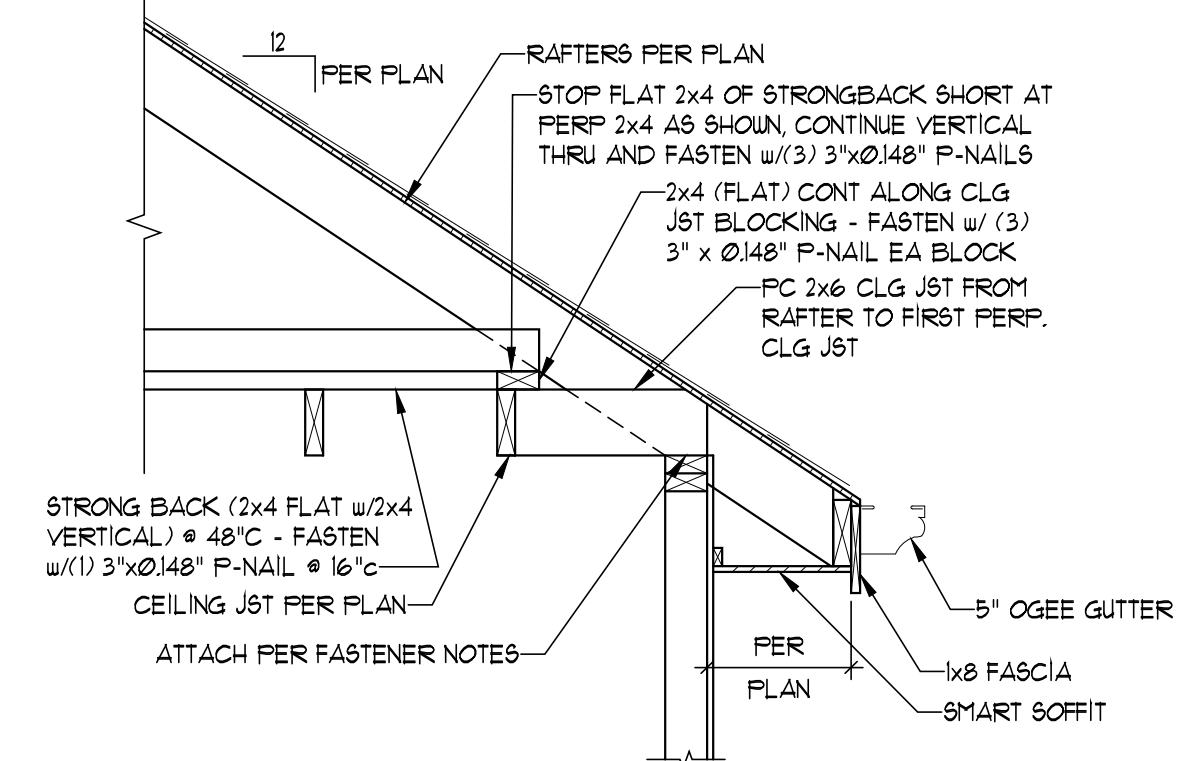


RAFTER ATTACHMENT AT PERPENDICULAR CONDITIONS
SCALE: 3/4" = 1'-0"

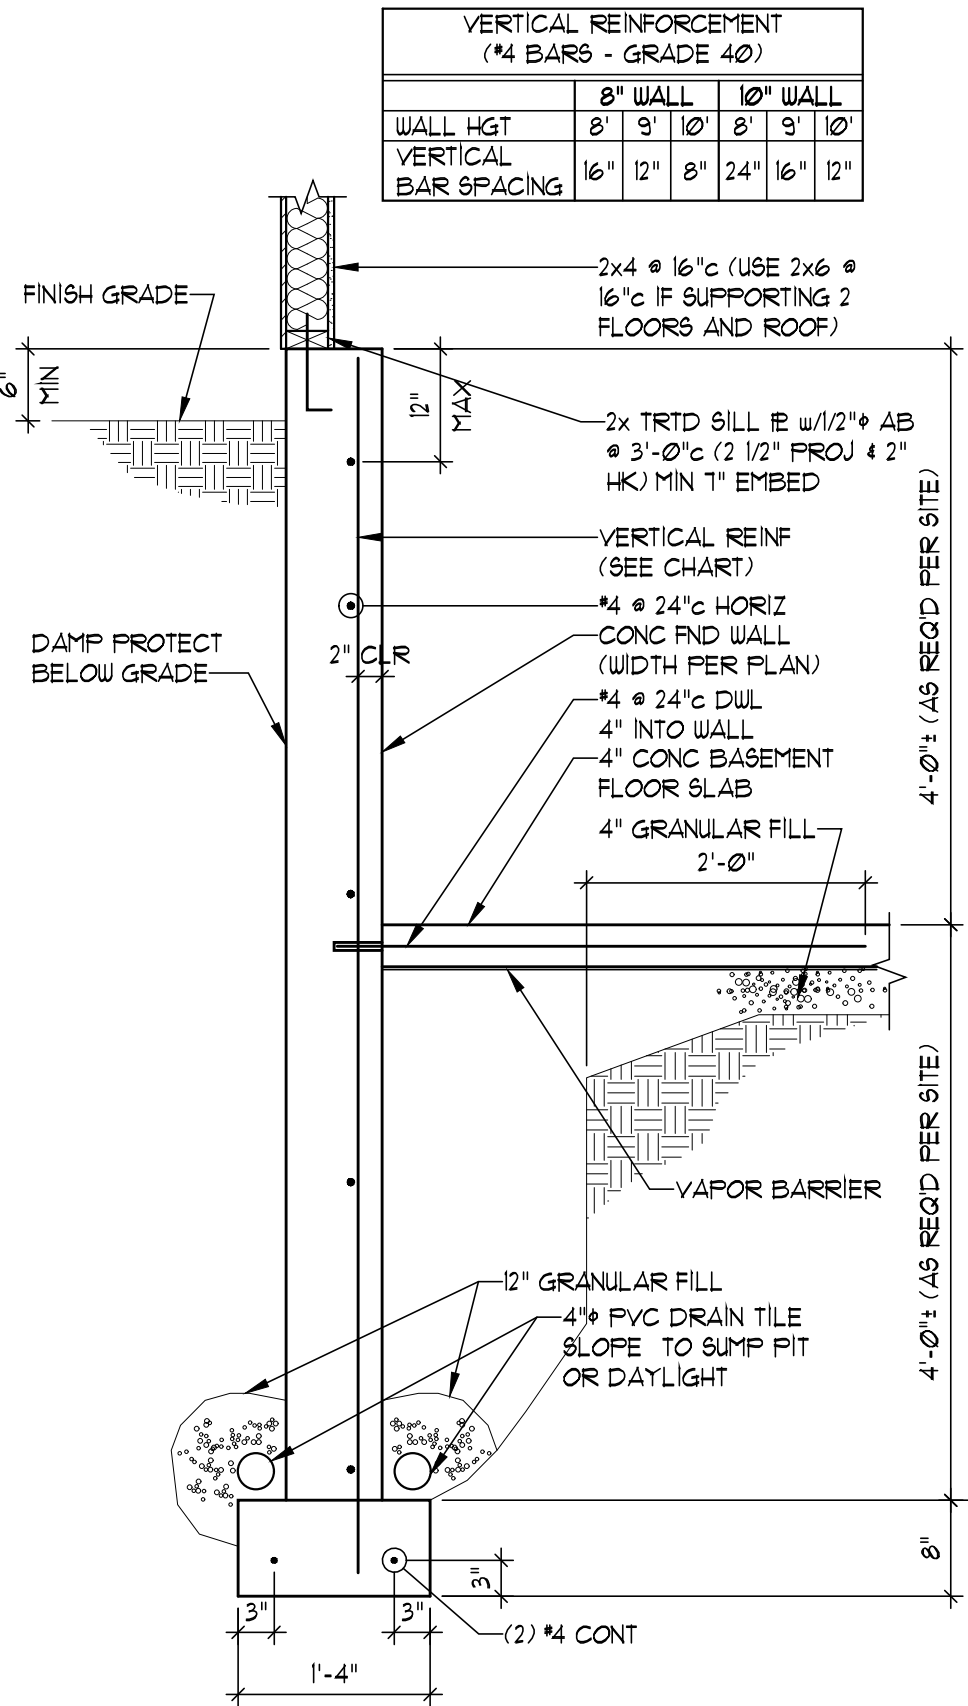


TYPICAL DAYLIGHT SECTION
SCALE: 3/4" = 1'-0"

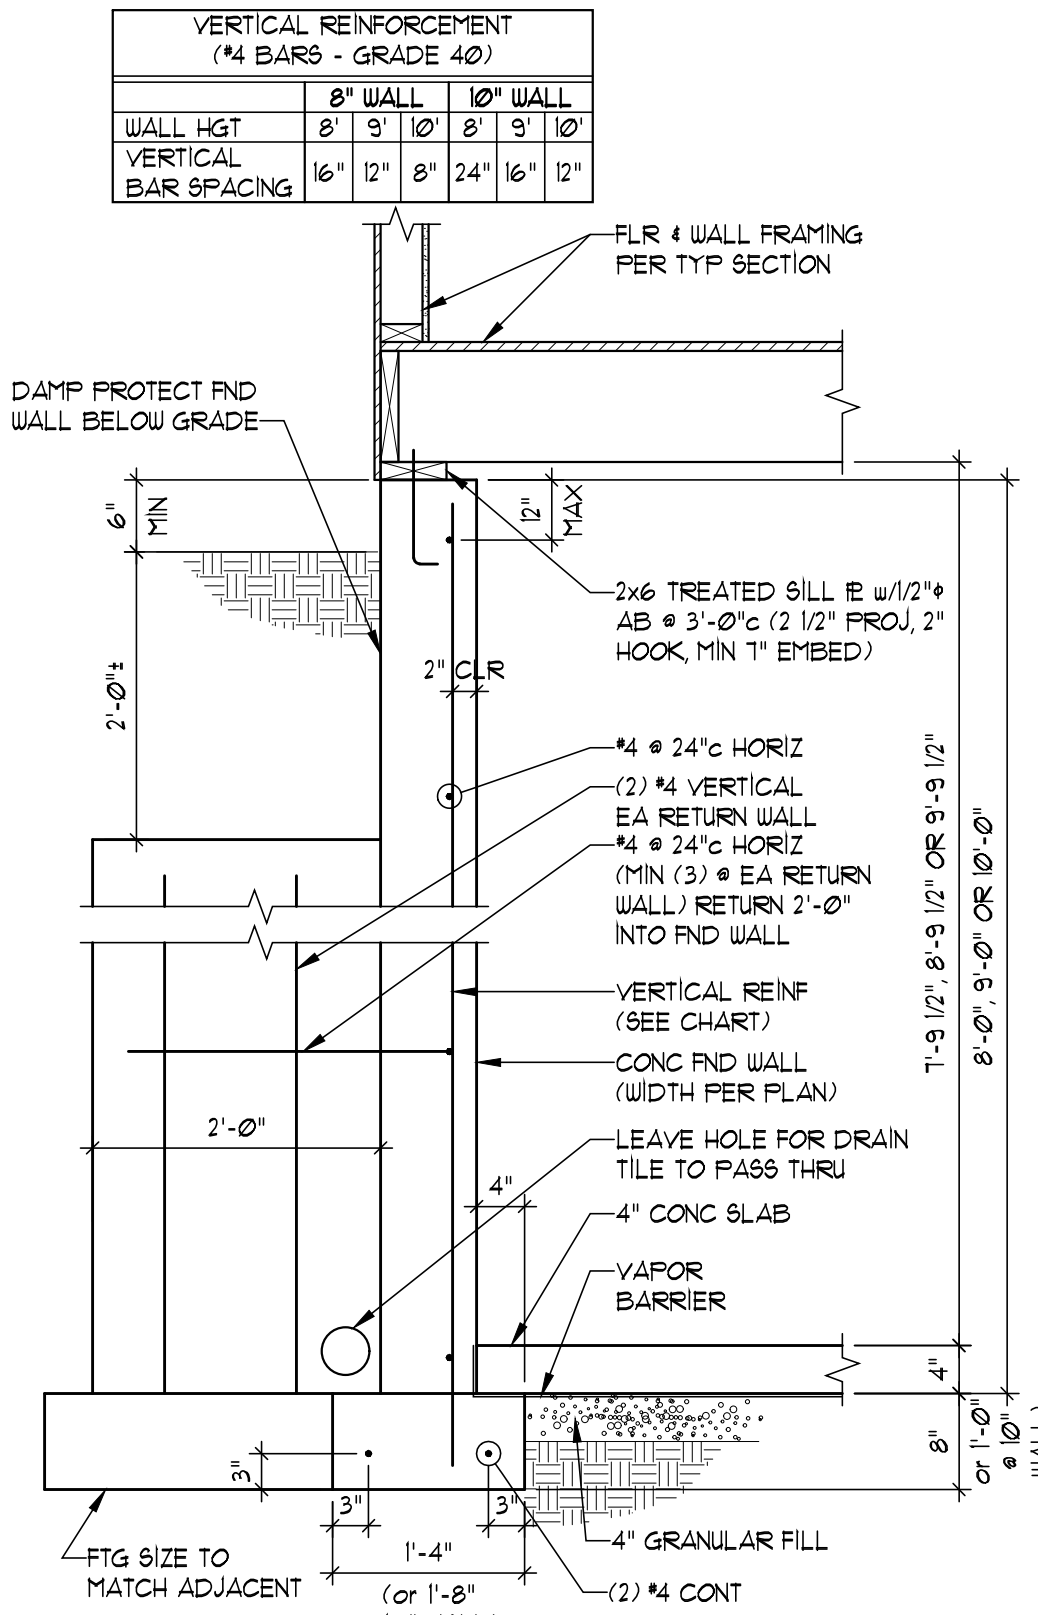


TYPICAL PILASTER SECTION
SCALE: 3/4" = 1'-0"

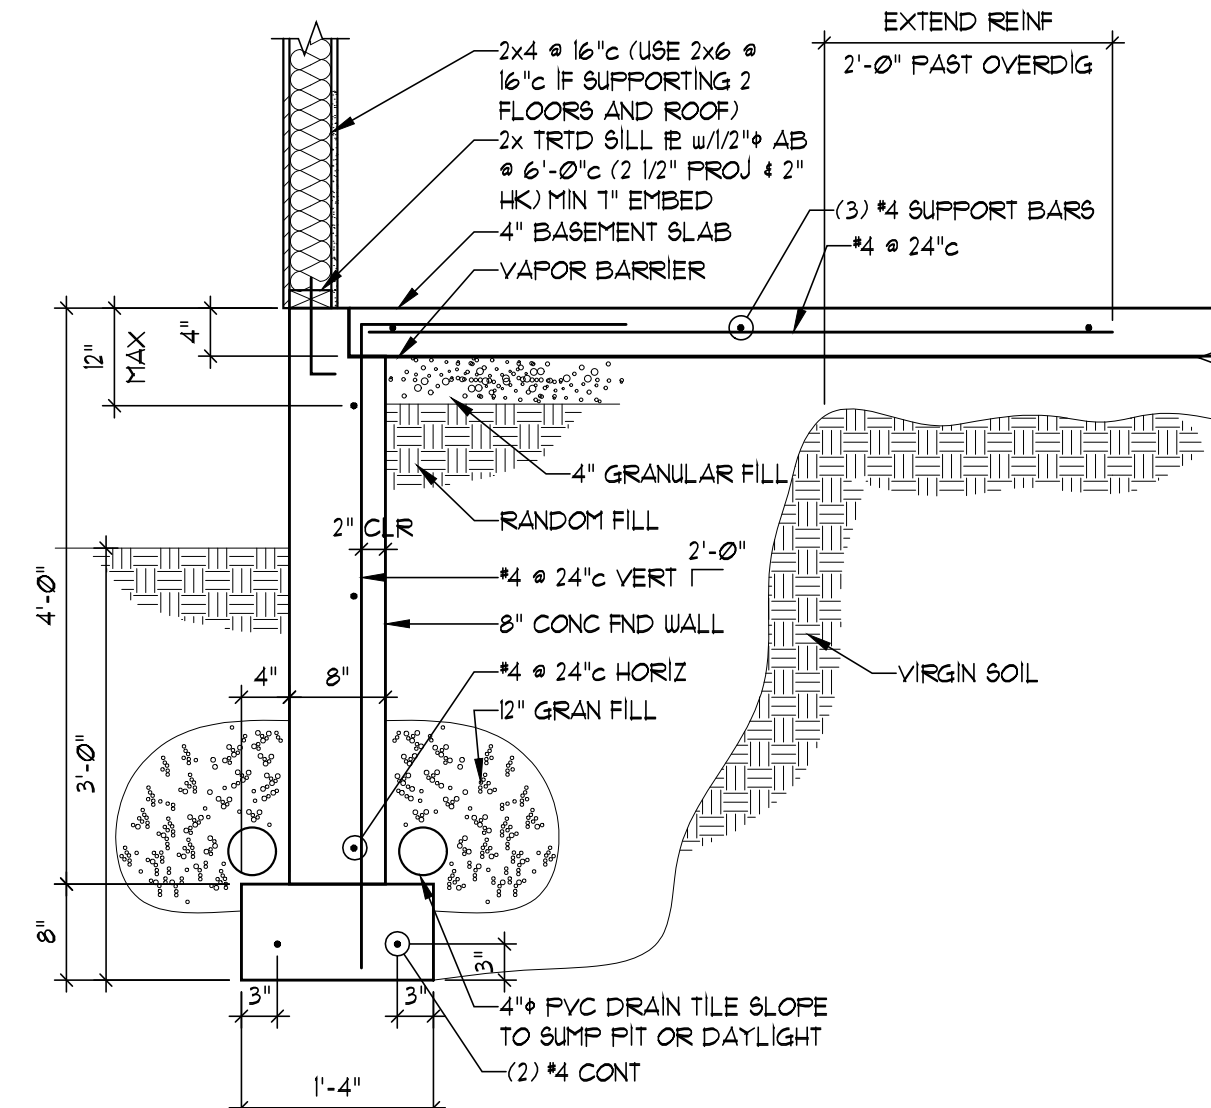


TYPICAL WALKOUT SECTION
SCALE: 3/4" = 1'-0"

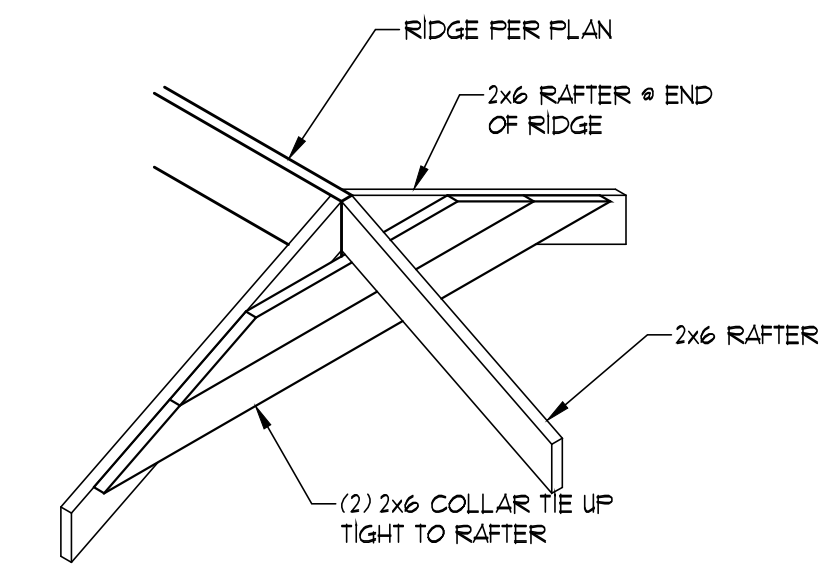


HIP RIDGE SUPPORT
SCALE: 1/2" = 1'-0"

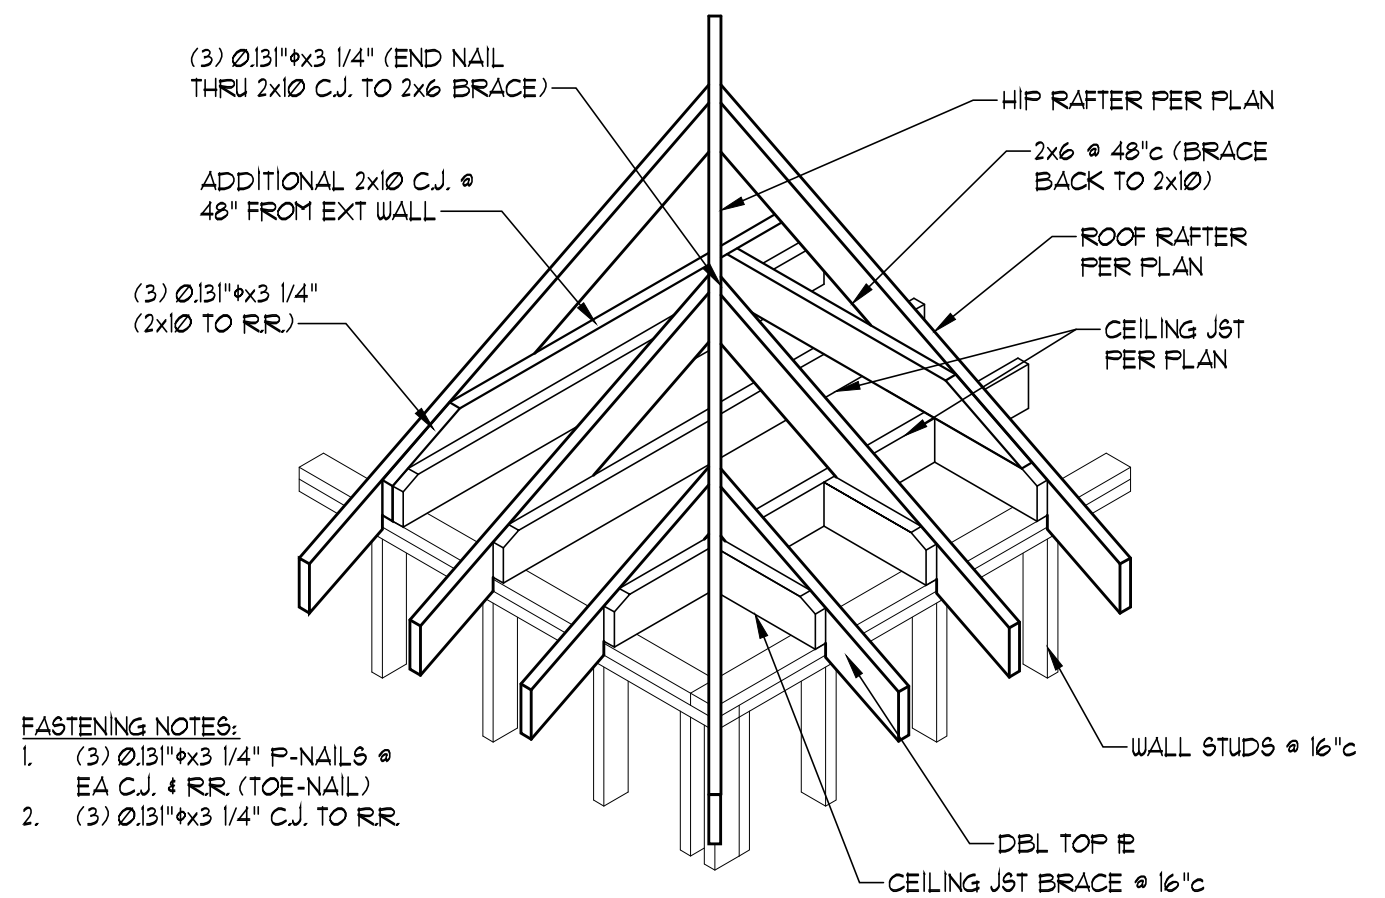

CEILING JOIST AND ROOF RAFTER CONNECTION @ HIP
SCALE: 1/2" = 1'-0"

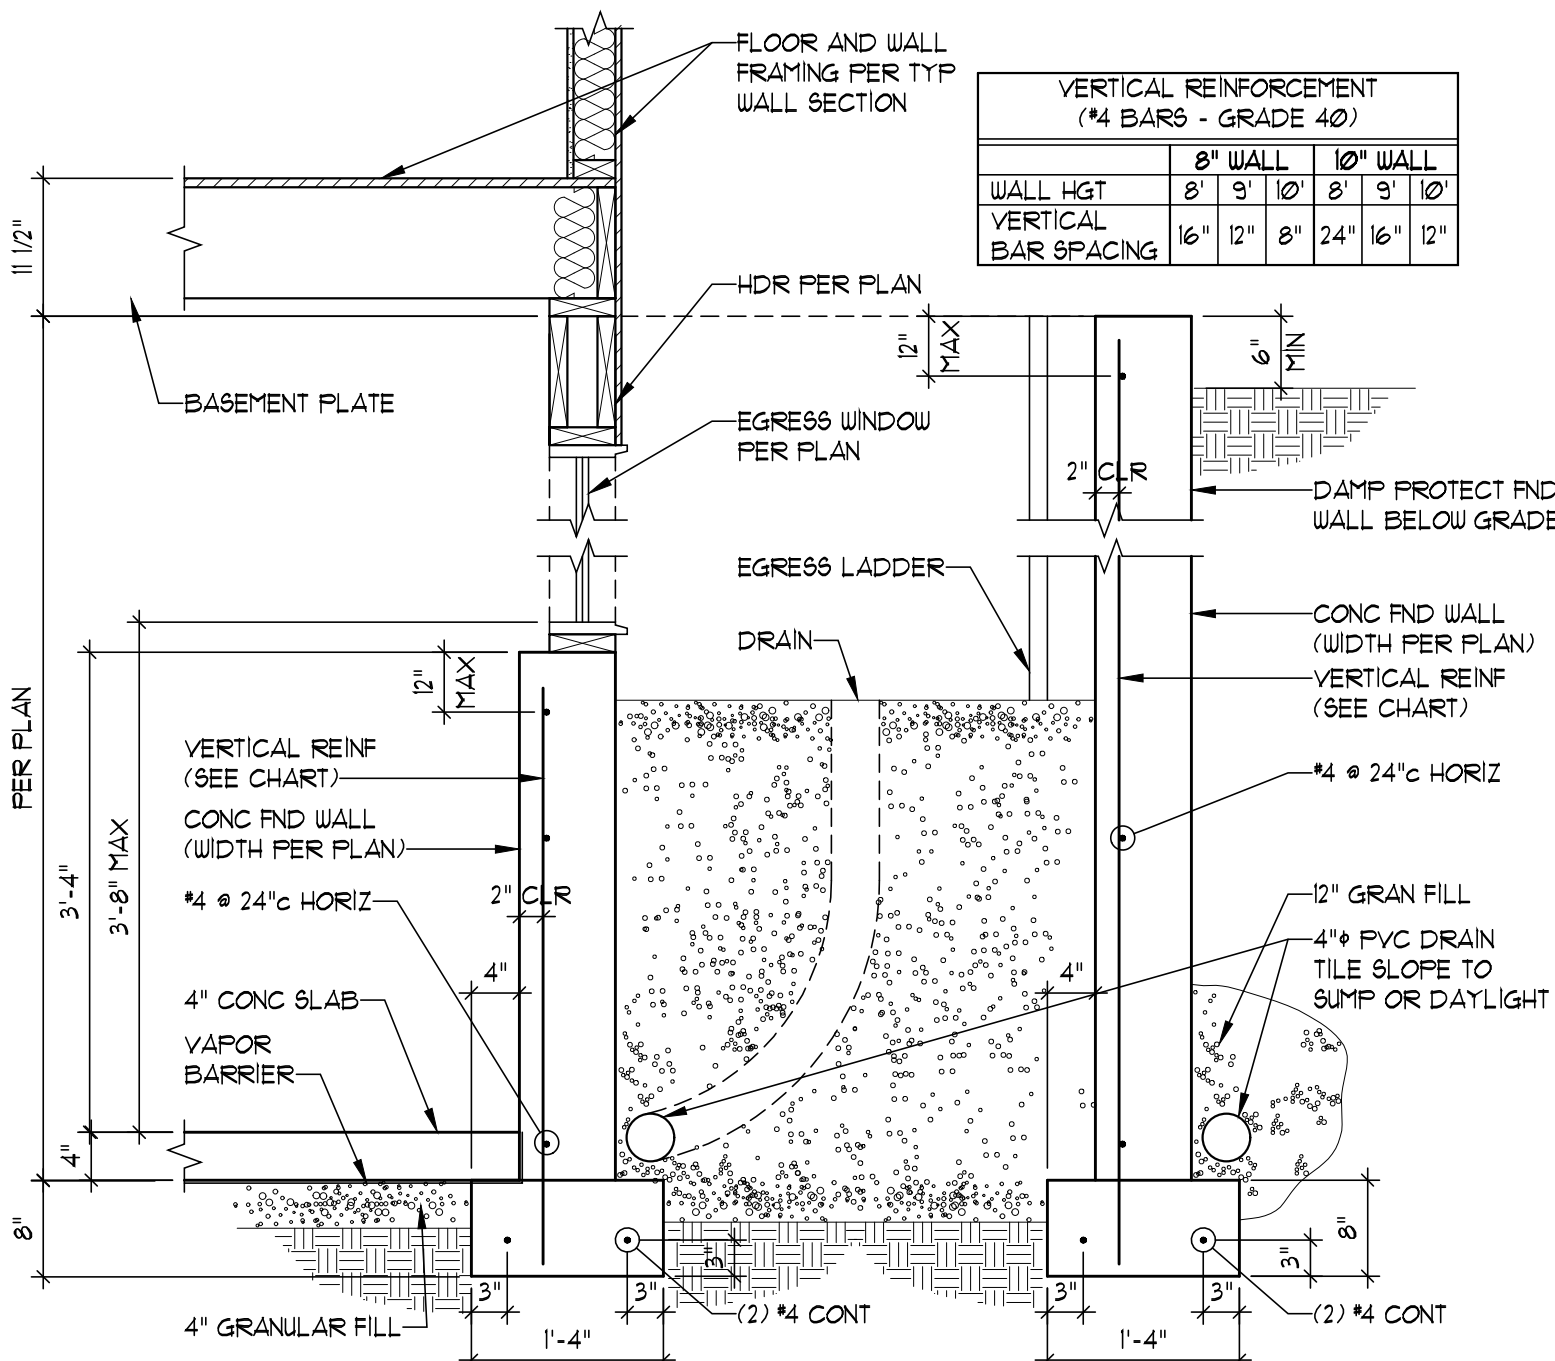

TYPICAL WINDOW WELL
SCALE: 3/4" = 1'-0"

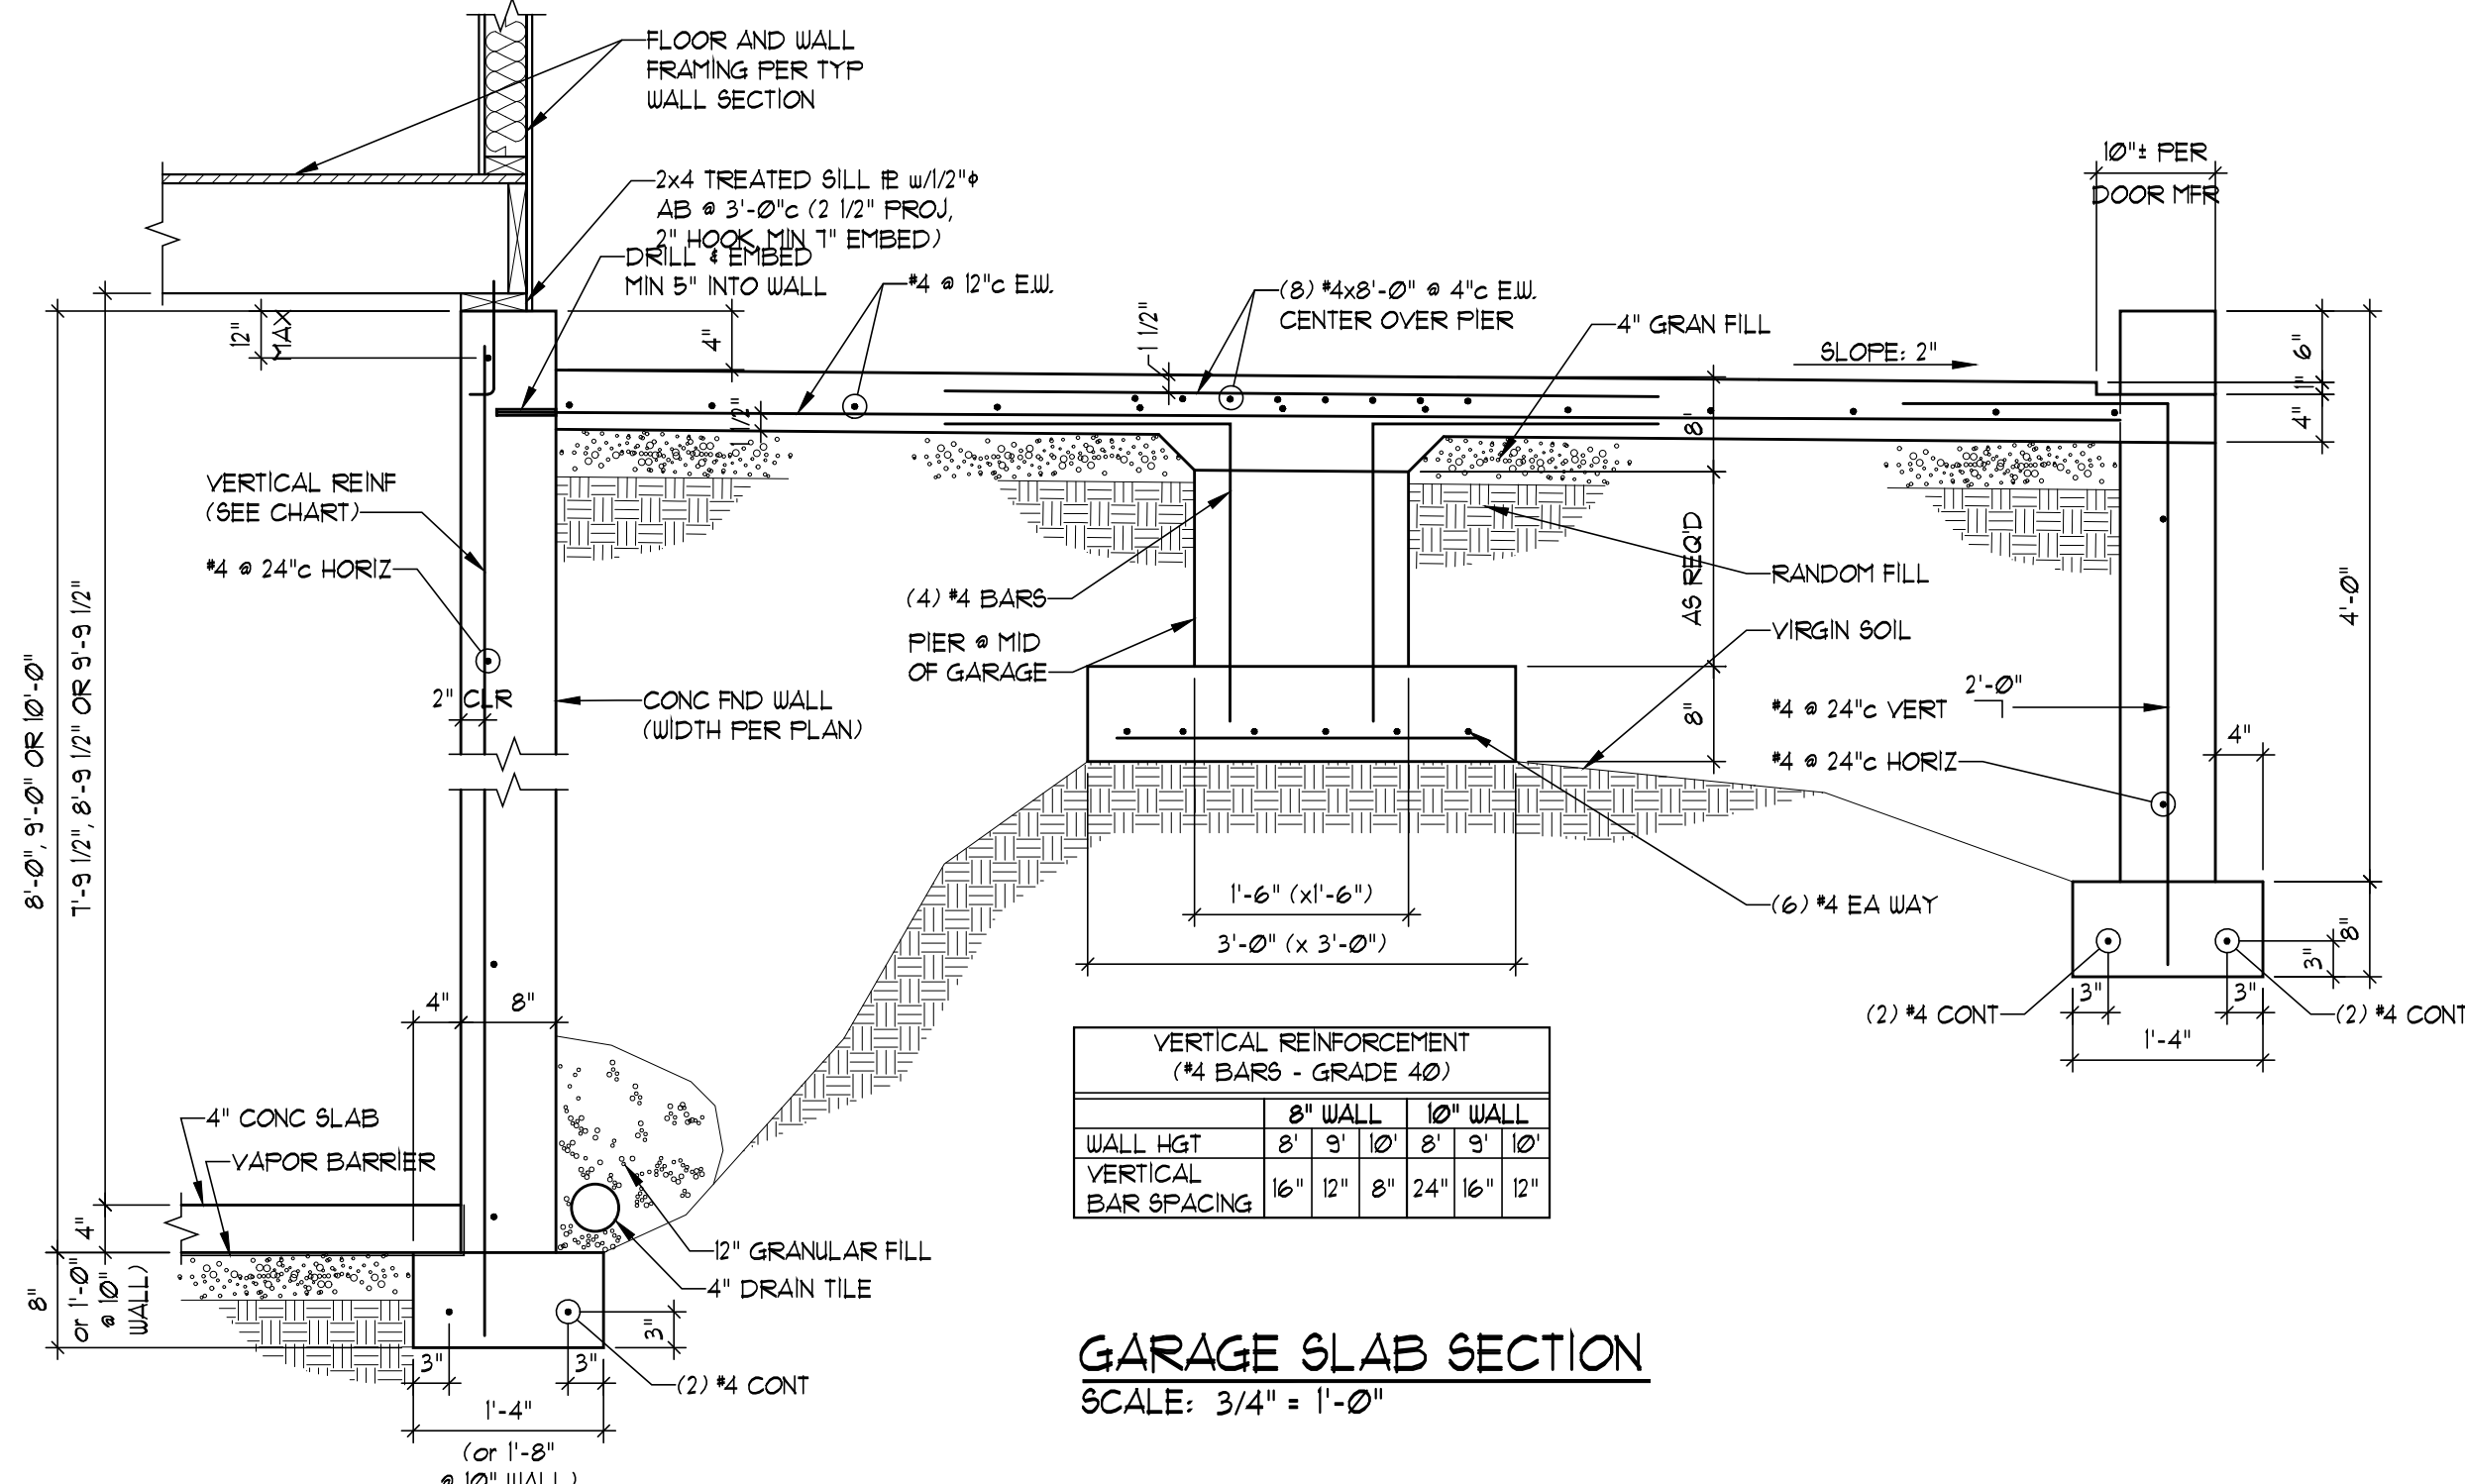

GARAGE SLAB SECTION
SCALE: 3/4" = 1'-0"



© COPYRIGHT 2023
JFE CONSTRUCTION INC.
1314 SW Market Street
Lee's Summit, MO 64081
v. 816.786.4008
jfeconstruction.com



Van Deuren and Associates, P.A. © 2023




THE MAPLEWOOD III
Keith Murrell
2109 NW O'Brien Road, Lee's Summit, MO
Lot 171 - Woodside Ridge

Project #: 8083-XXXX


DATE: 8/18/2023

For Permit: 8/18/2023

82
RELEASE FOR CONSTRUCTION
AS NOTED FOR PLAN REVIEW
DEVELOPMENT SERVICES
LEE'S SUMMIT, MISSOURI
08/22/2023

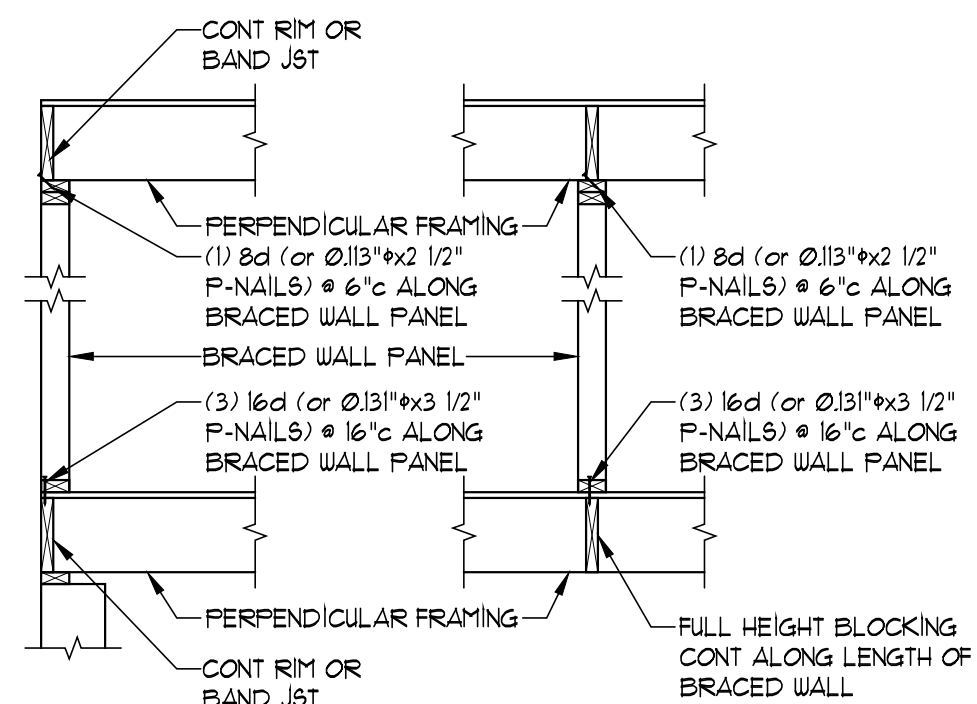

IRC FIGURE R602.10.8(1)
BRACED WALL PANEL CONNECTION WHEN
PERPENDICULAR TO FLOOR/CEILING FRAMING

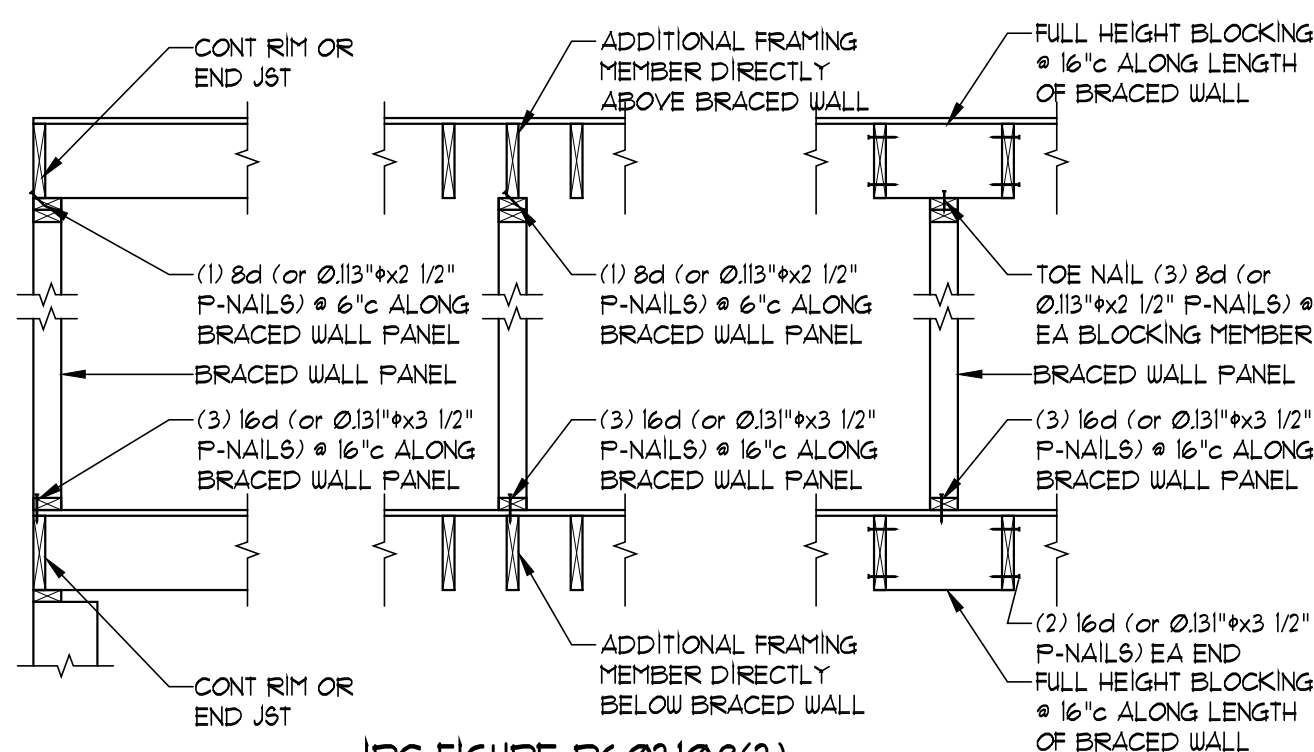

IRC FIGURE R602.10.8(2)
BRACED WALL PANEL CONNECTION WHEN
PARALLEL TO FLOOR/CEILING FRAMING


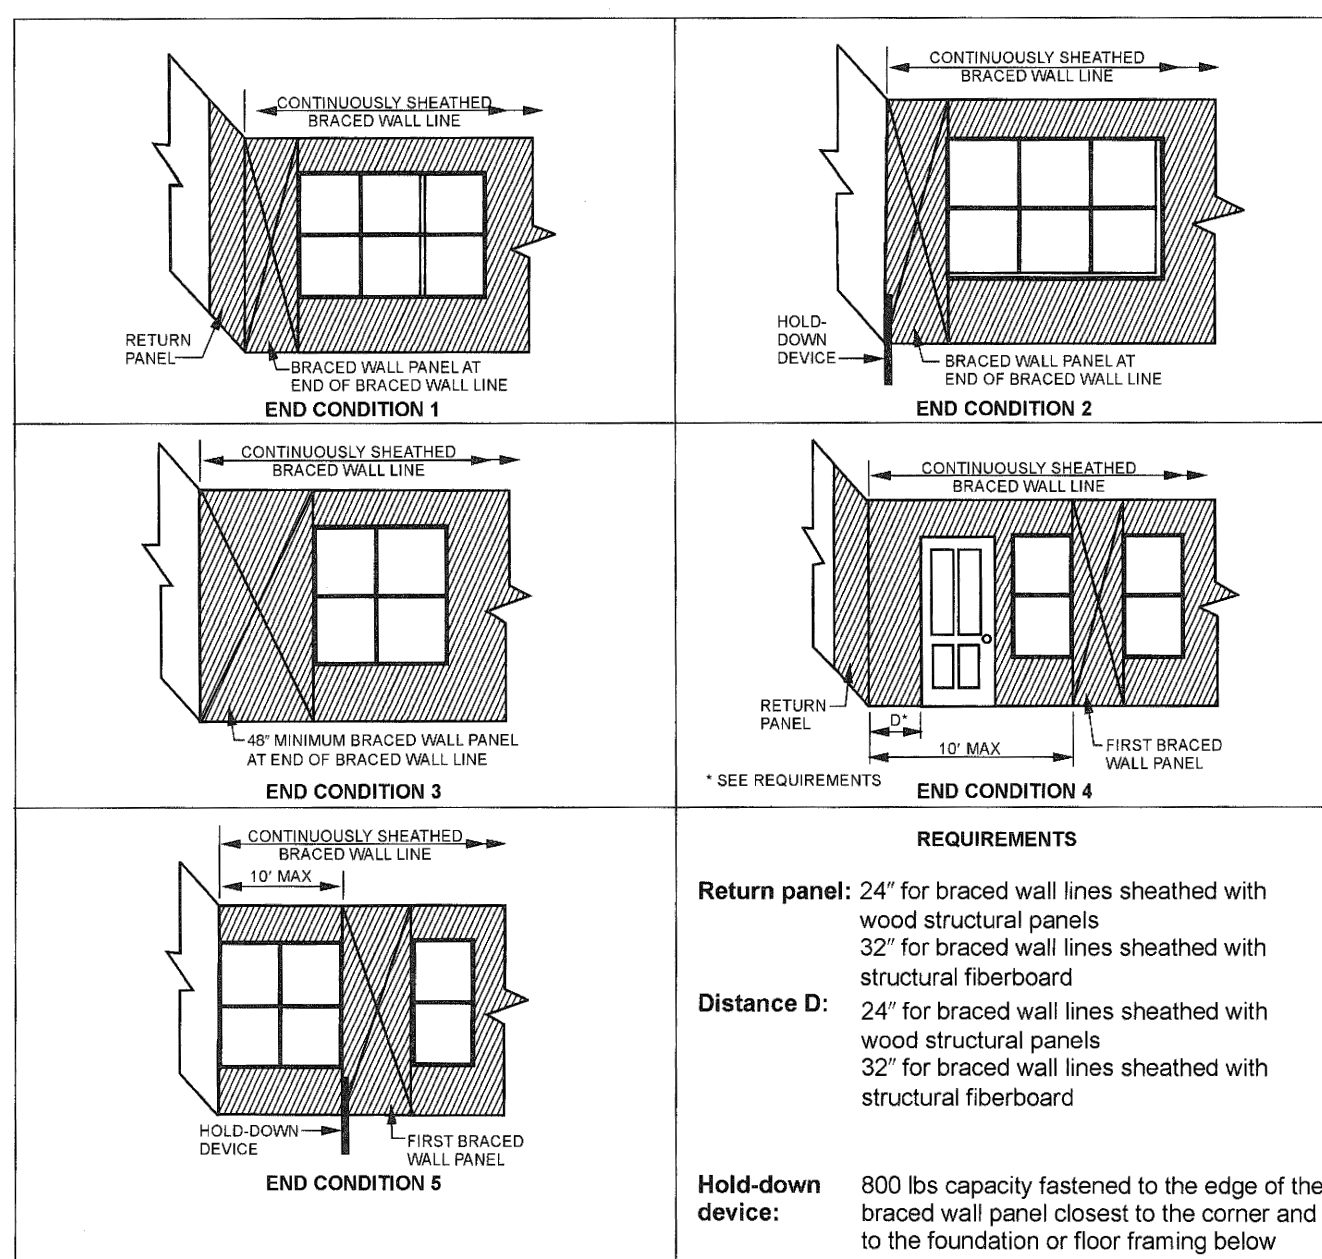



FIGURE R602.10.7
END CONDITIONS FOR BRACED WALL LINES WITH CONTINUOUS SHEATHING

TABLE R602.10.6.4
TENSION STRAP CAPACITY REQUIRE FOR RESISTING WIND PRESSURES
PERPENDICULAR TO METHOD PFH, FTG, AND CS-PF BRACED WALL PANELS


MINIMUM WALL STUD FRAMING NOMINAL SIZE AND GAGE	MAXIMUM PONY WALL HEIGHT (FEET)	MAXIMUM TOTAL WALL HEIGHT (FEET)	MAXIMUM OPENING WIDTH (FEET)	TENSION STRAP CAPACITY REQUIRED (LBS) FOR V _{ult} = 15mph	
				EXPOSURE B	EXPOSURE C
2x4 1/2 GRADE	0	10	10	1000	1000
	1	10	9	1000	1000
			10	1025	2500
			11	1215	2850
			12	1405	3175
	2	10	16	2175	4125
			18	2500	DESIGN
			19	1500	3175
	2	12	16	3375	DESIGN
			18	3975	DESIGN
	4	12	9	2175	DESIGN
			12	3175	DESIGN
2x6 STUD GRADE	2	12	9	1000	2025
			16	2500	3675
			18	2550	DESIGN
			19	1750	DESIGN
	4	12	9	2400	DESIGN
			18	3800	DESIGN

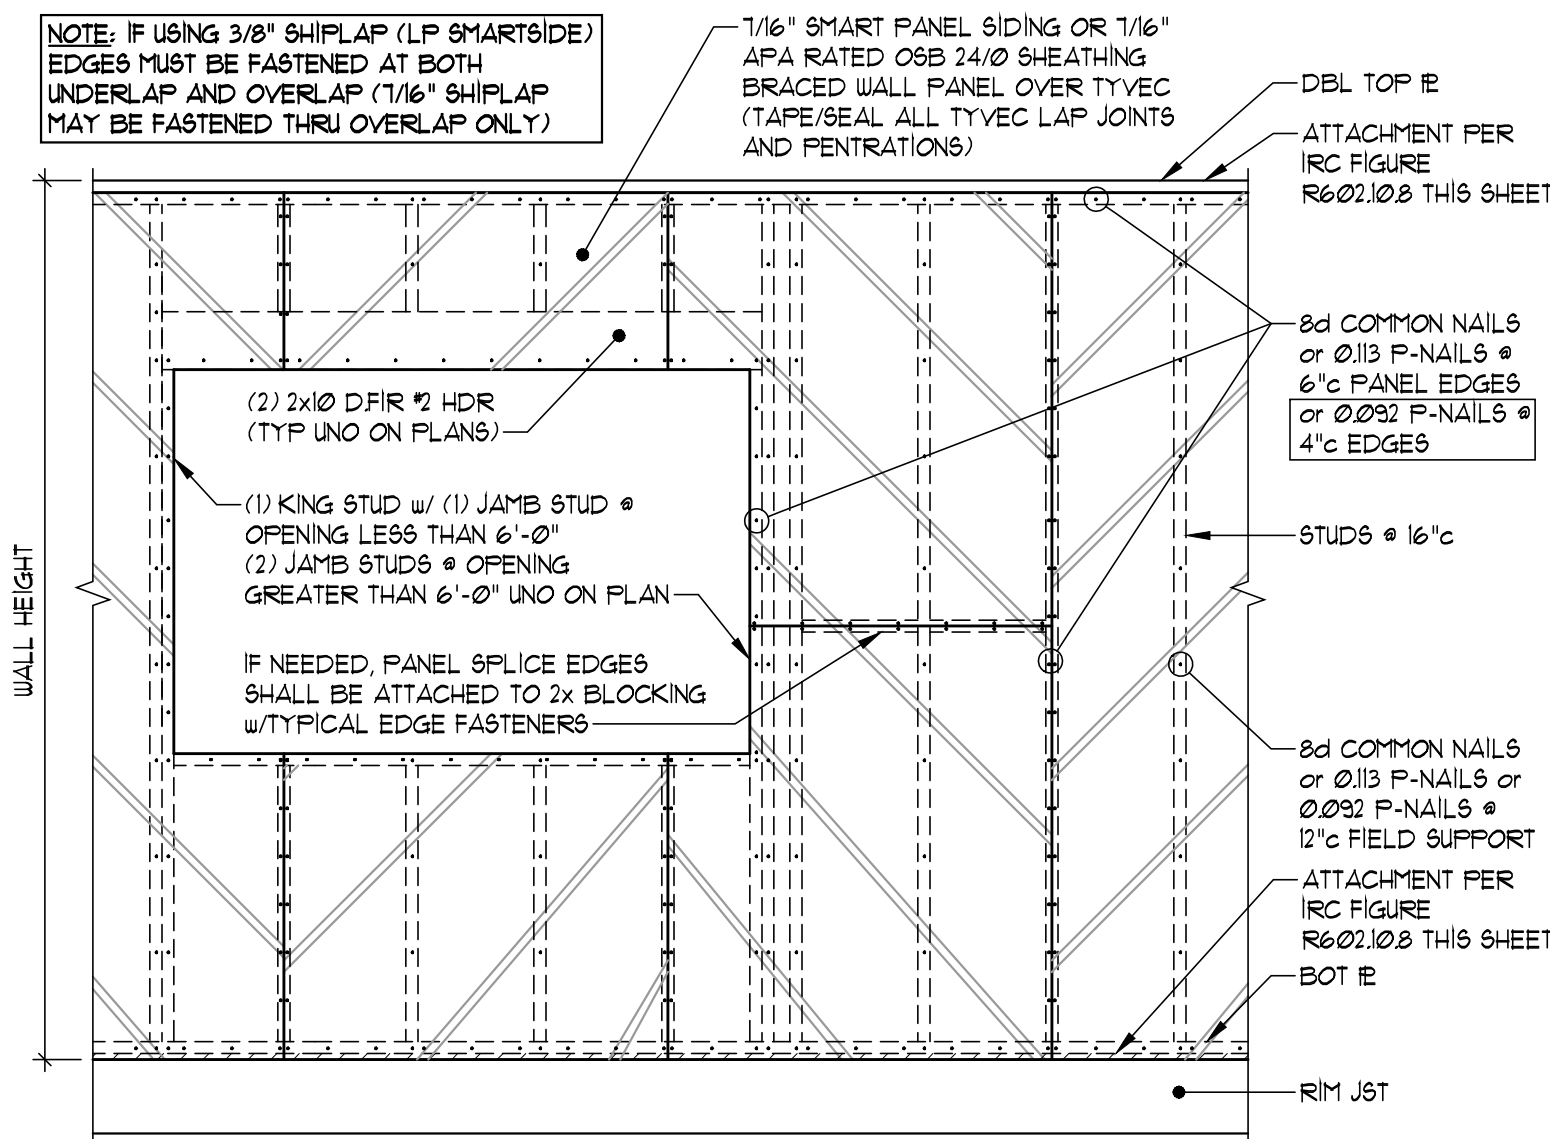


TYPICAL EXTERIOR SHEATHING
INSTALLATION (METHOD WSP & CS-WSP)
SCALE: 1/2" = 1'-0"

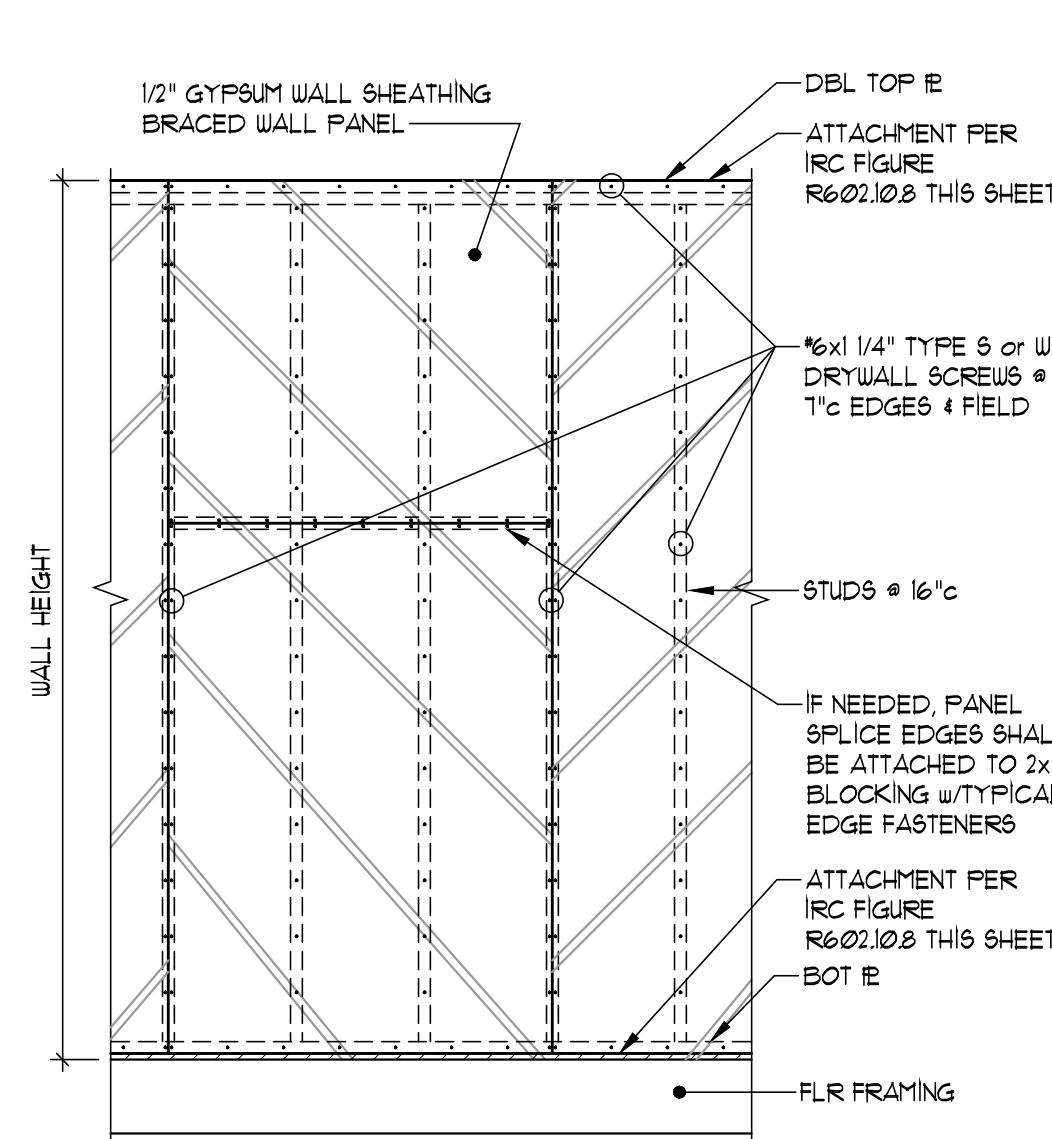


TYPICAL INTERIOR SHEATHING
INSTALLATION (METHOD GB)
SCALE: 1/2" = 1'-0"

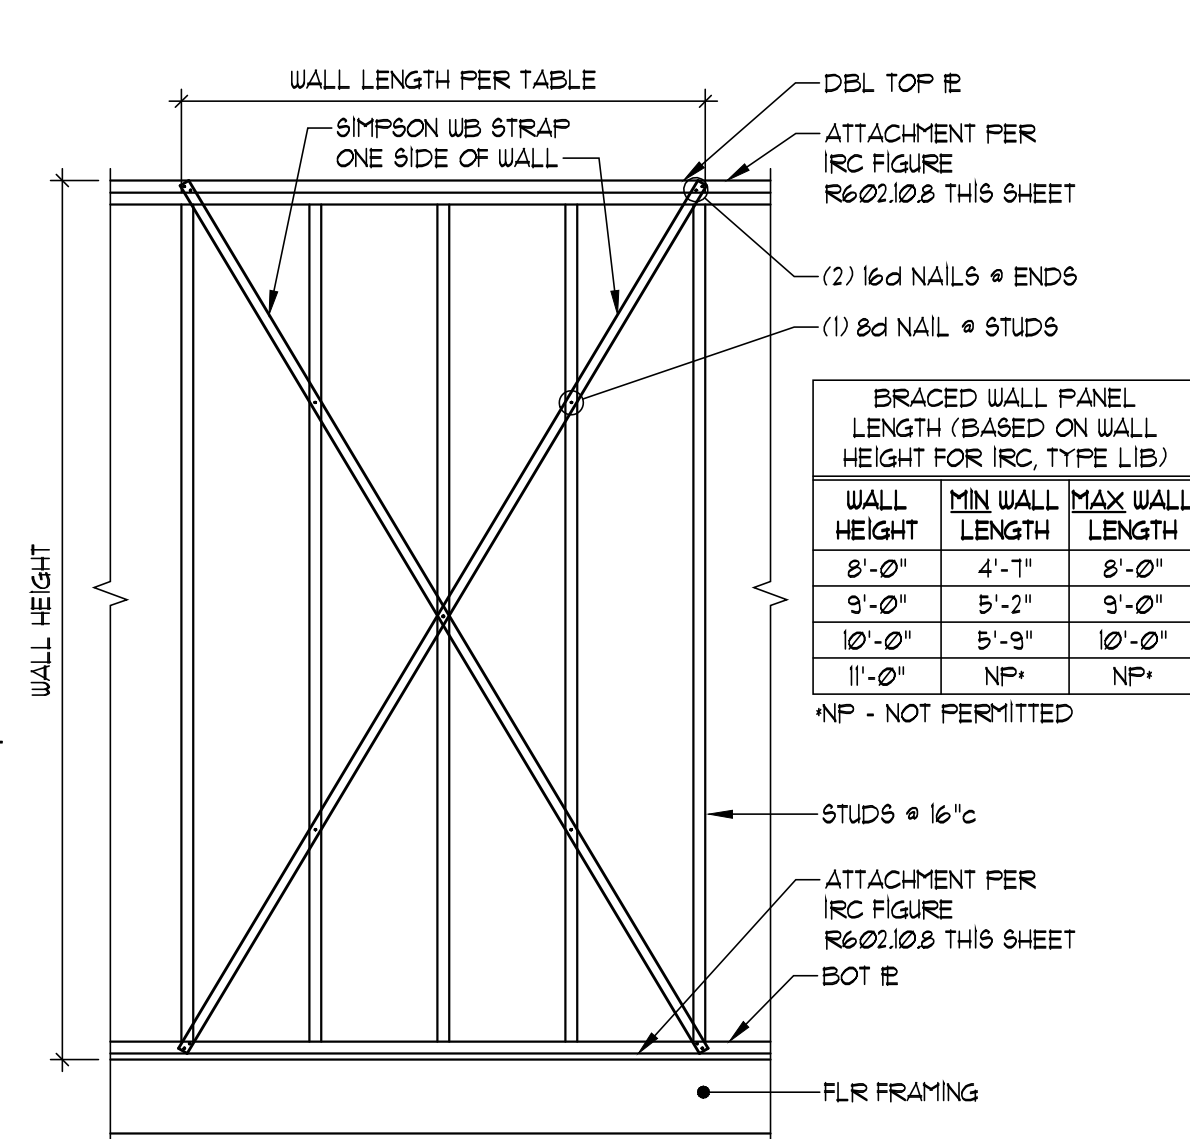


INTERIOR SHEATHING
INSTALLATION (METHOD LIB)
SCALE: 1/2" = 1'-0"

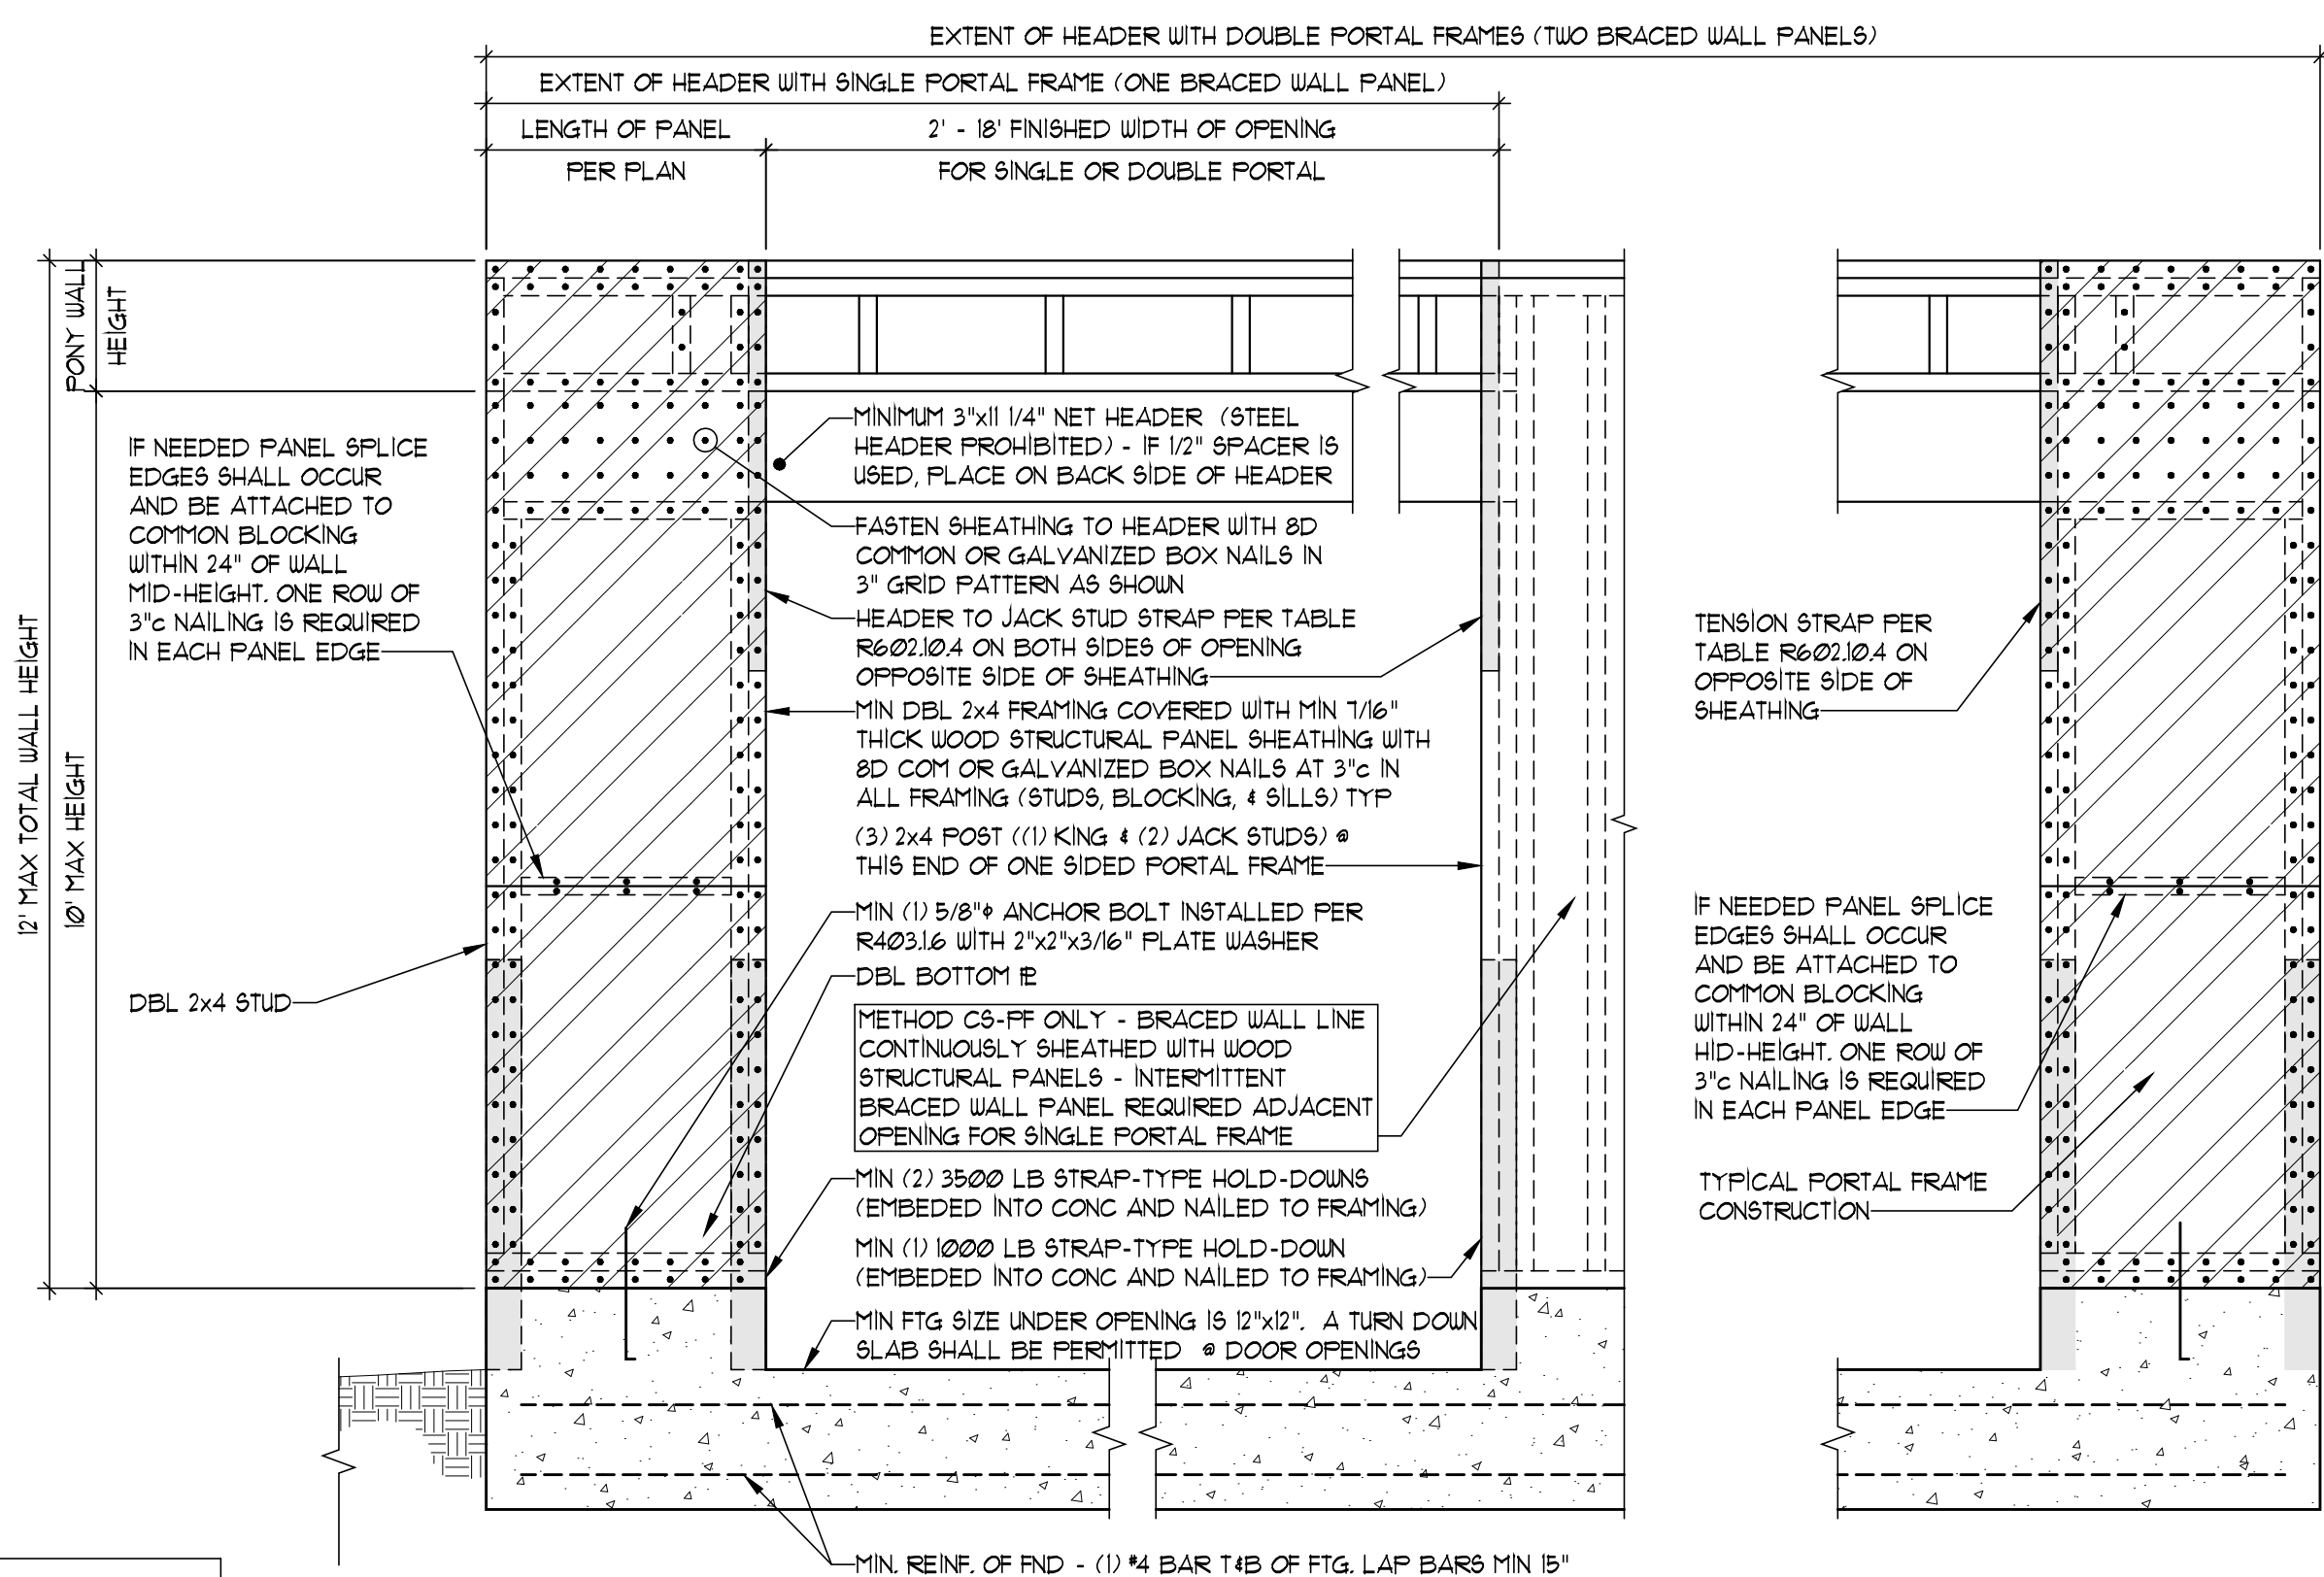


BRACED WALL METHOD "PFH" (also HEADER ATTACHMENT FOR CS-PF)
SCALE: 3/4"=1'-0"

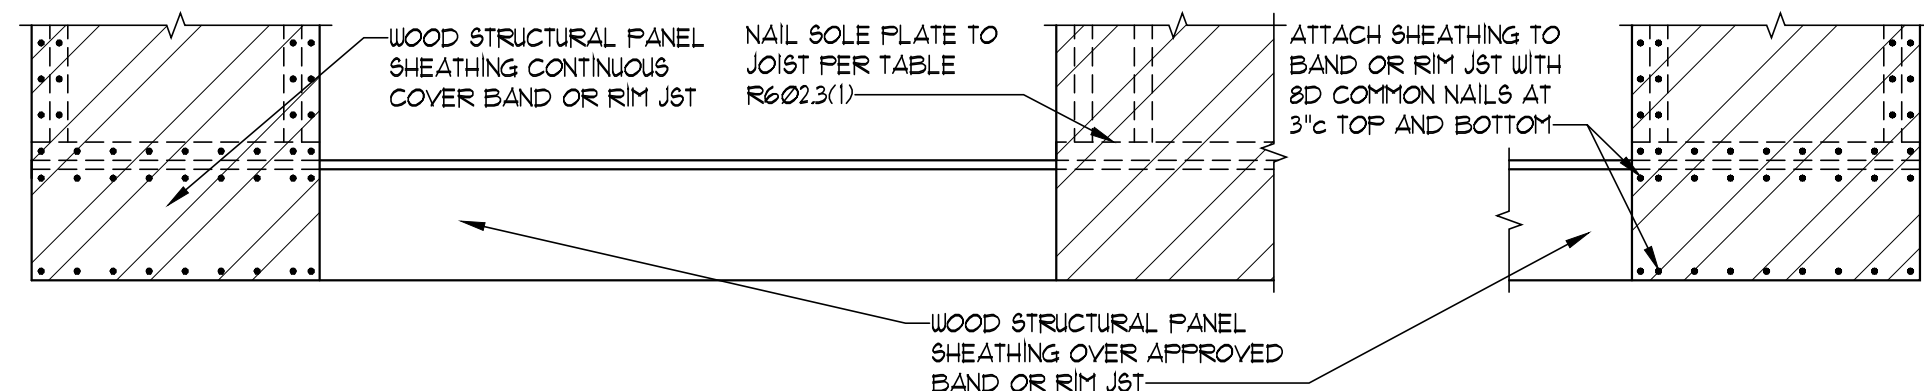

BRACED WALL METHOD "CS-PF" (ATTACHMENT TO WOOD FLOOR)
(REFER TO BRACED WALL METHOD "PFH" FOR HEADER ATTACH)
SCALE: 3/4"=1'-0"

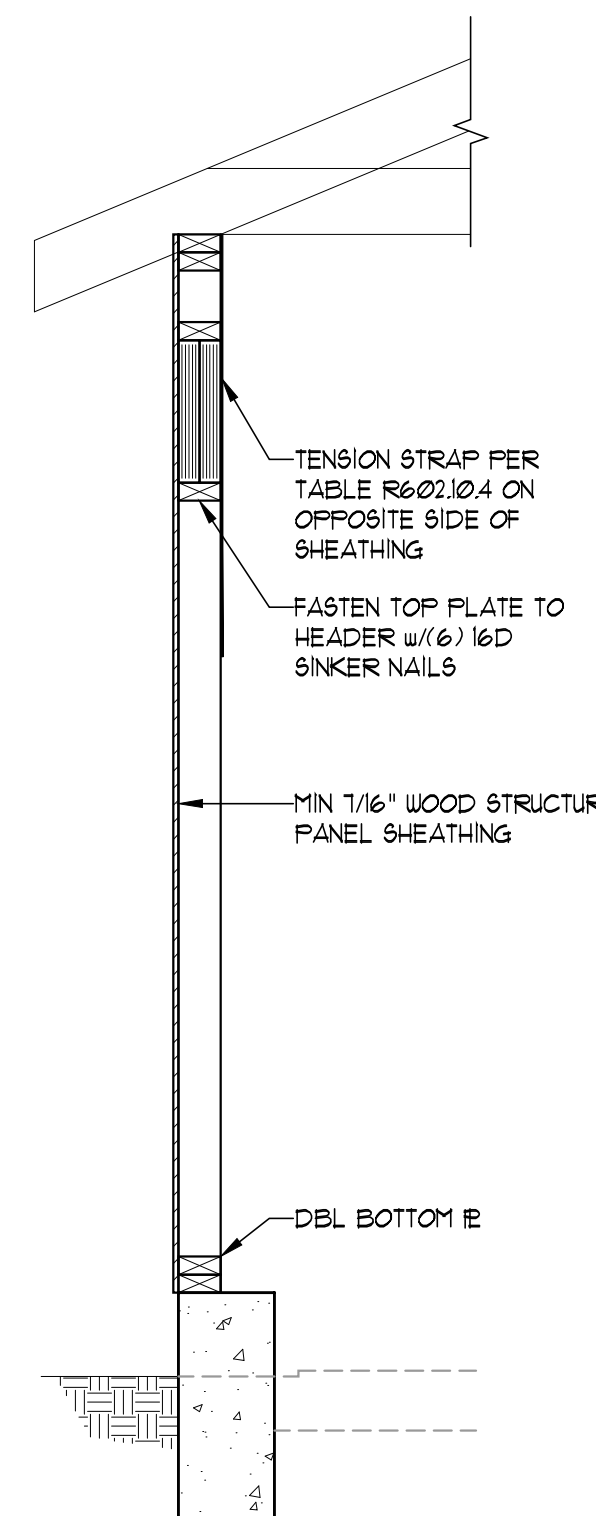

SECTION

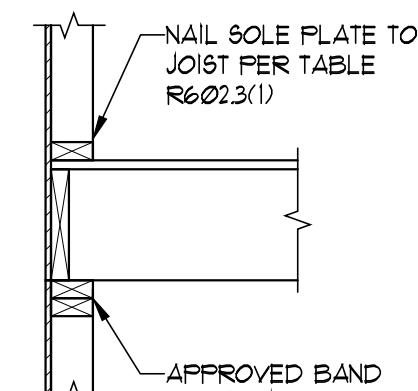

SECTION



© COPYRIGHT 2023

JFE CONSTRUCTION INC.
1314 SW Market Street
Lee's Summit, MO 64081
v: 816.786.4008
jfeconstruction.com



Van Deuren and Associates, P.A. © 2023



THE MAPLEWOOD III

Keith Murrell
2109 NW O'Brien Road, Lee's Summit, MO
Lot 171 - Woodside Ridge

Project #: 8083-XXXX

DATE:

For Permit: 8/18/2023