

Customer  
**Starr Homes**

Job Name:  
**Milligan Residence**


Address:  
**10720 West 142nd Street**

Salesperson:  
**Jim Anderson**

Designer:  
**Anthony**

Date: 5/23/2023 Job #: P210577 Scale: NTS

**FLOOR TRUSS PLACEMENT DIAGRAM**

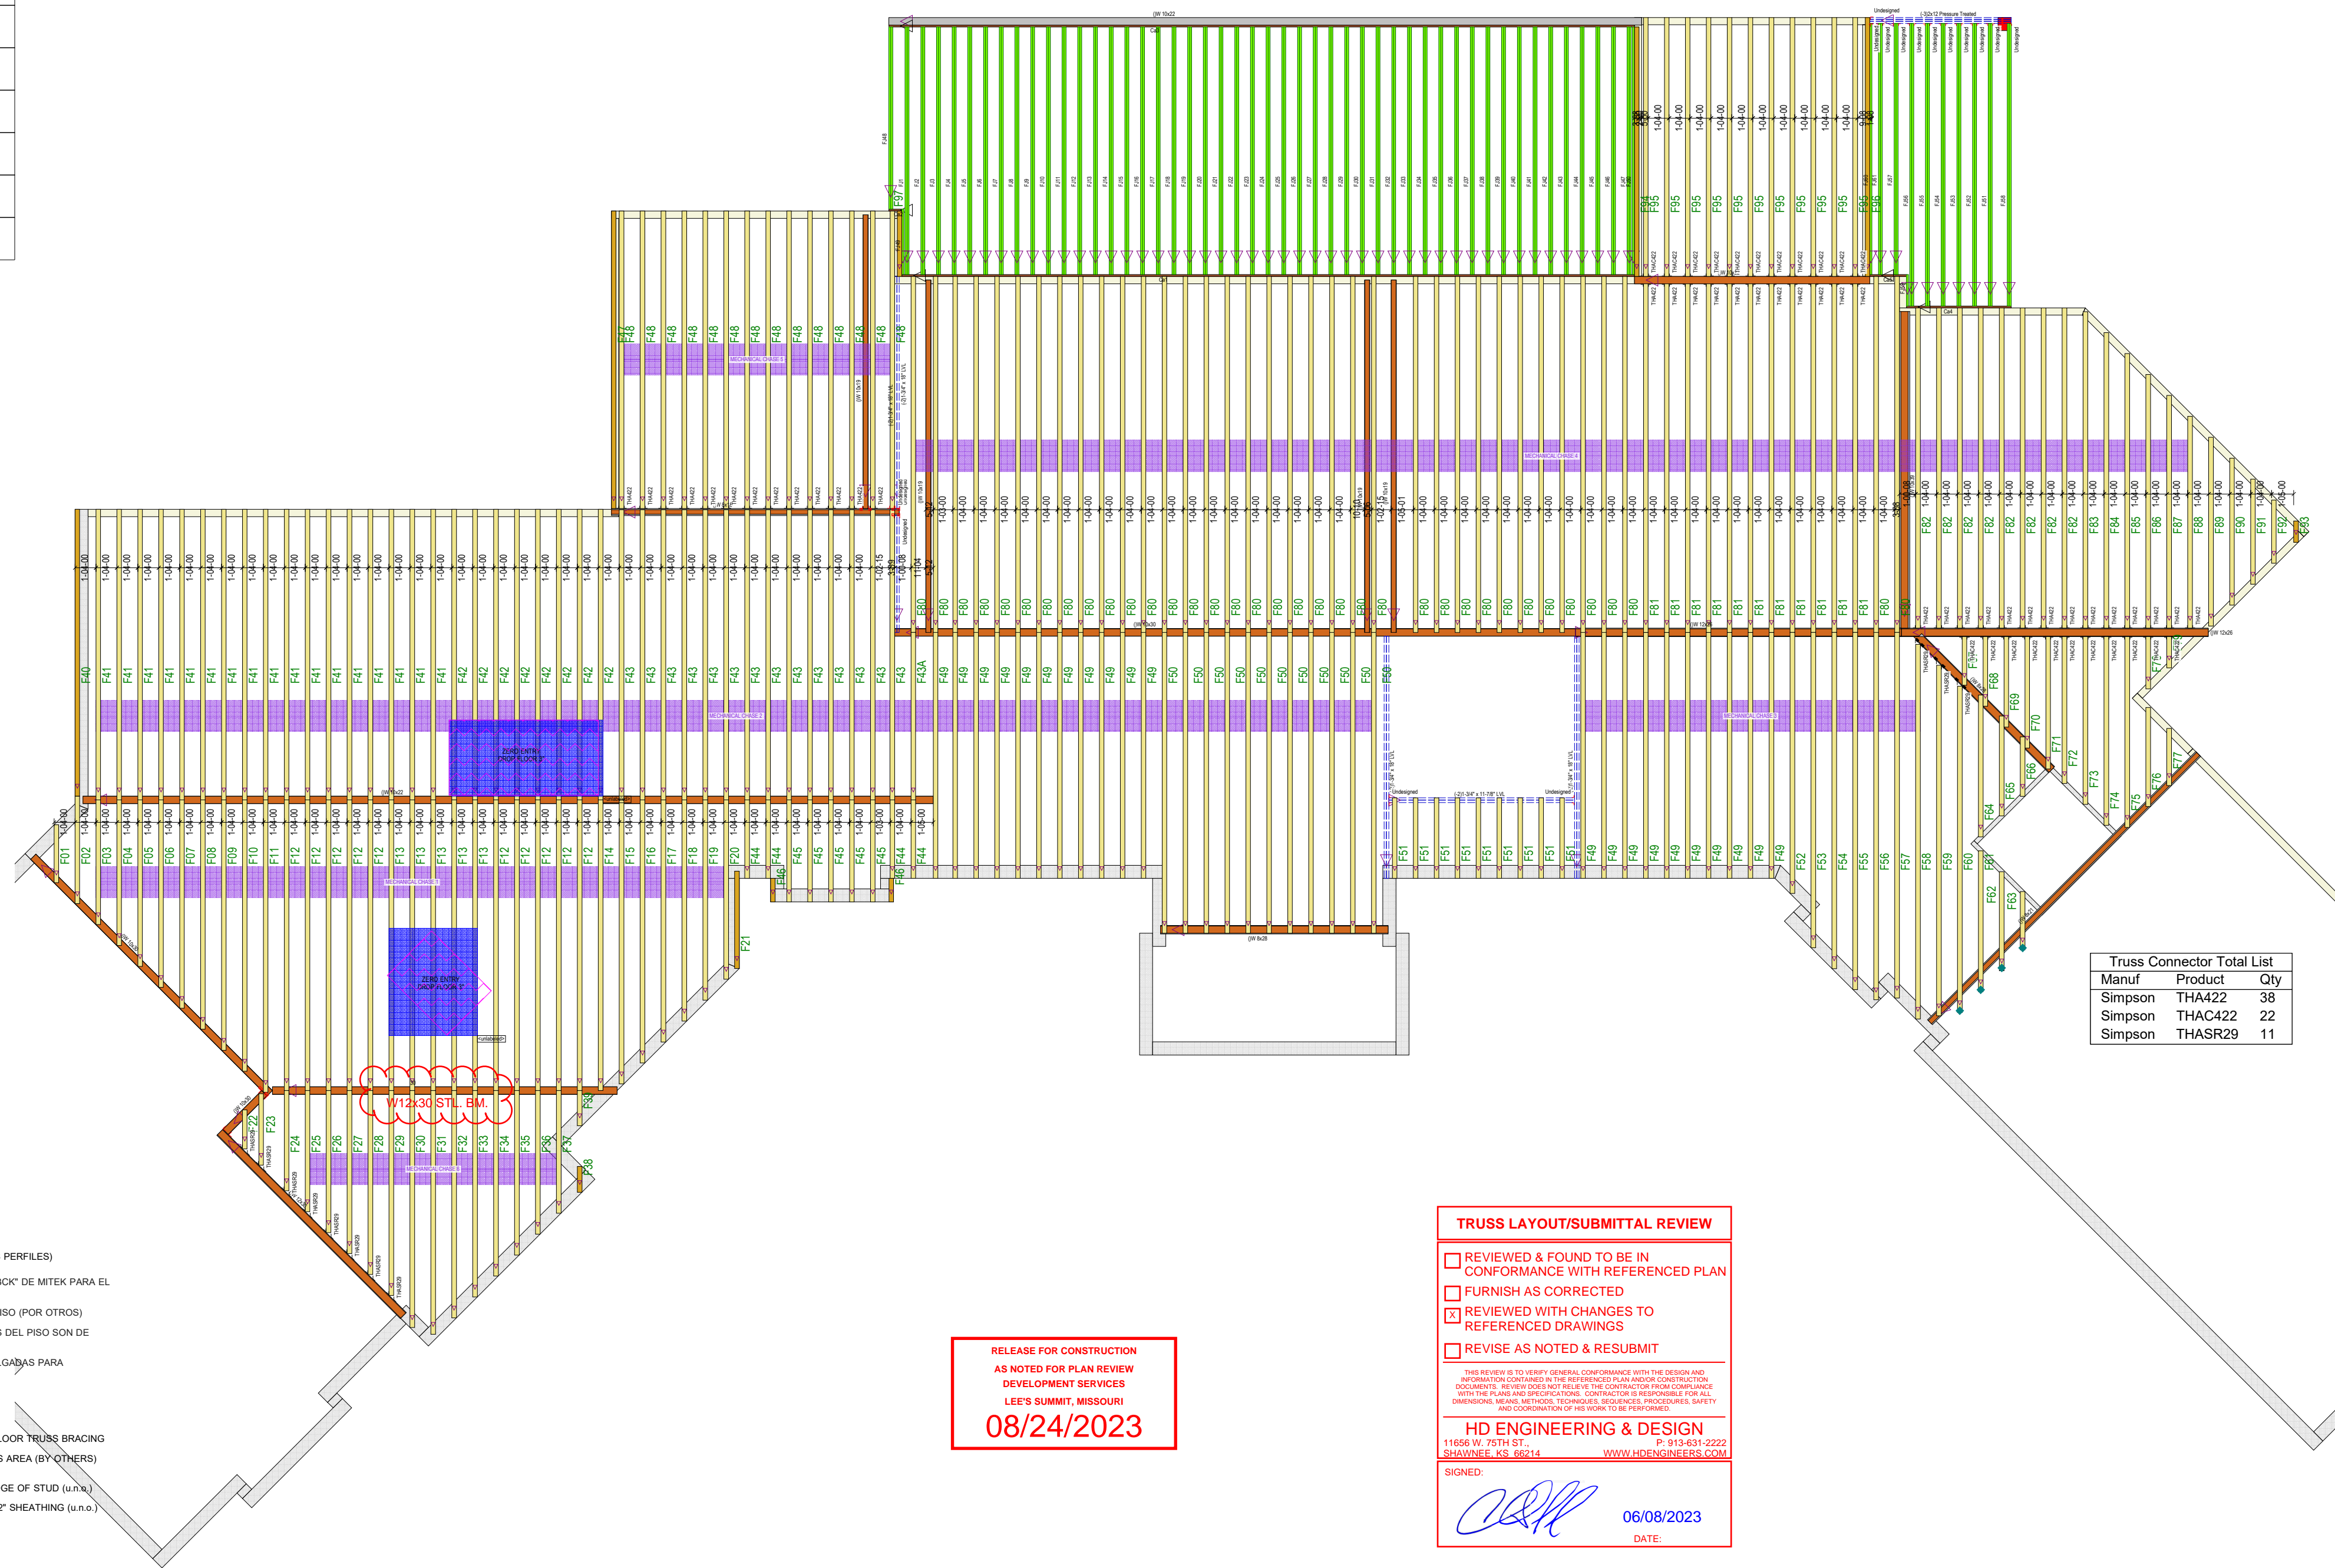

◀ - INDICA EXTREMO IZQUIERDO DE LOS TRUSSES (VEA LOS PERFILES)

CONSULTE EL DETALLE ESTÁNDAR DE BRACING DE "ST-STRGBCK" DE MITEK PARA EL BRACING DE TRUSS DEL PISO

\*DRAFTSTOP\* NECESARIO PARA CADA 1000 S.F. DE AREA DE PISO (POR OTROS)

TODAS LAS DIMENSIONES PARA EL FRAMING DE LOS TRUSSES DEL PISO SON DE FUERA DE LA MADERA

ESTABLECER LOS TRUSSES DEL PRIMER PISO ADENTRO 2 PULGADAS PARA EL 2x10 RIM Y LA HOJA DE 1/2"

◀ LEFT END OF TRUSS (SEE TRUSS PROFILES)

SEE MITEK "ST-STRGBCK" STANDARD BRACING DETAIL FOR FLOOR TRUSS BRACING

DRAFTSTOP REQUIRED FOR EVERY 1000 S.F. OF FLOOR TRUSS AREA (BY OTHERS)

ALL 1ST FLOOR FRAMING DIMENSIONS ARE FROM OUTSIDE EDGE OF STUD (u.n.s.)

SET 1ST FLOOR FRAMING TRUSSES IN 2" FOR 2x10 RIM AND 1/2" SHEATHING (u.n.o.)

**WARNING:** Trusses must be handled with care to prevent damage and injury.

This truss placement diagram is to be used only as an installation aid; it is not a structural diagram. These trusses are designed as individual building components to be incorporated into the building design at the specification of the building designer. See individual design sheets for each truss design identified on the placement drawing.

Professional advice should be sought regarding handling, installation, temporary and permanent bracing before erecting trusses. Temporary and permanent bracing is required during installation of trusses to prevent possible collapse.

For general guidance regarding bracing, consult "BCSI-06" available jointly from WTCA & TPI.

Premier Building Supply must be notified of any issues requiring a back charge prior to any work being done. Premier Building Supply reserves the right to use its service staff in lieu of being back charged.

RELEASE FOR CONSTRUCTION  
AS NOTED FOR PLAN REVIEW  
DEVELOPMENT SERVICES  
LEE'S SUMMIT, MISSOURI  
**08/24/2023**

**TRUSS LAYOUT/SUBMITTAL REVIEW**

REVIEWED & FOUND TO BE IN CONFORMANCE WITH REFERENCED PLAN


FURNISH AS CORRECTED

REVIEWED WITH CHANGES TO REFERENCED DRAWINGS

REVISE AS NOTED & RESUBMIT

THIS REVIEW IS TO VERIFY GENERAL CONFORMANCE WITH THE DESIGN AND INFORMATION CONTAINED IN THE REFERENCED PLAN AND/OR CONSTRUCTION DOCUMENTS. REVIEW DOES NOT RELIEVE THE CONTRACTOR FROM COMPLIANCE WITH THE PLANS AND SPECIFICATIONS. CONTRACTOR IS RESPONSIBLE FOR ALL DIMENSIONS, MEANS, METHODS, TECHNIQUES, PROCEDURES, SAFETY AND COORDINATION OF HIS WORK TO BE PERFORMED.

**HD ENGINEERING & DESIGN**  
11656 W. 75TH ST., P: 913-631-2222  
SHAWNEE, KS 66214 WWW.HDENGINEERS.COM

SIGNED:  DATE: 06/08/2023

20300 W 207TH ST  
Spring Hill, KS 66083

**PREMIER**  
BUILDING SUPPLY OF KANSAS CITY

Phone: 913.686.1812  
www.premierbuildingsupply.com

Since 1923

Customer  
**Starr Homes**

Job Name:  
**Milligan Residence**

Address:  
**Lots 3A/4A Tiffany Woods**

Salesperson:  
**Jim Anderson**

Designer:  
**Anthony**

Date: 6/5/2023 Job #: P210577 Scale: NTS

**ROOF TRUSS PLACEMENT DIAGRAM**

1 - SDWC 15600 REQUIRED AT ALL BEARING LOCATIONS (u.n.o.)  
ALL TRUSS TO TRUSS CONNECTIONS = 'NAILED' (u.n.o.)

1 - SDWC 15600 NECESARIO EN TODO LOS PUNTOS DE APOYO (u.n.o.)  
TODAS LAS CONEXIONES DE TRUSS A TRUSS = 'CLAVADAS' (u.n.o.)

**TRUSS LAYOUT/SUBMITTAL REVIEW**

REVIEWED & FOUND TO BE IN CONFORMANCE WITH REFERENCED PLAN


FURNISH AS CORRECTED


REVIEWED WITH CHANGES TO REFERENCED DRAWINGS

REVISE AS NOTED & RESUBMIT

THIS REVIEW IS TO VERIFY GENERAL CONFORMANCE WITH THE DESIGN AND INFORMATION CONTAINED IN THE REFERENCED PLAN AND/OR CONSTRUCTION DOCUMENTS. REVIEW DOES NOT RELIEVE THE CONTRACTOR FROM COMPLIANCE WITH THE PLANS AND SPECIFICATIONS. CONTRACTOR IS RESPONSIBLE FOR ALL DIMENSIONAL, MEANS, METHODS, TECHNIQUES, SEQUENCE, PROCEDURES, SAFETY AND COORDINATION OF HIS WORK TO BE PERFORMED.

**HD ENGINEERING & DESIGN**  
11656 W. 75TH ST. P: 913-631-2222  
SHAWNEE, KS. 66214 WWW.HDENGINEERS.COM

SIGNED:  DATE: 07/13/2023

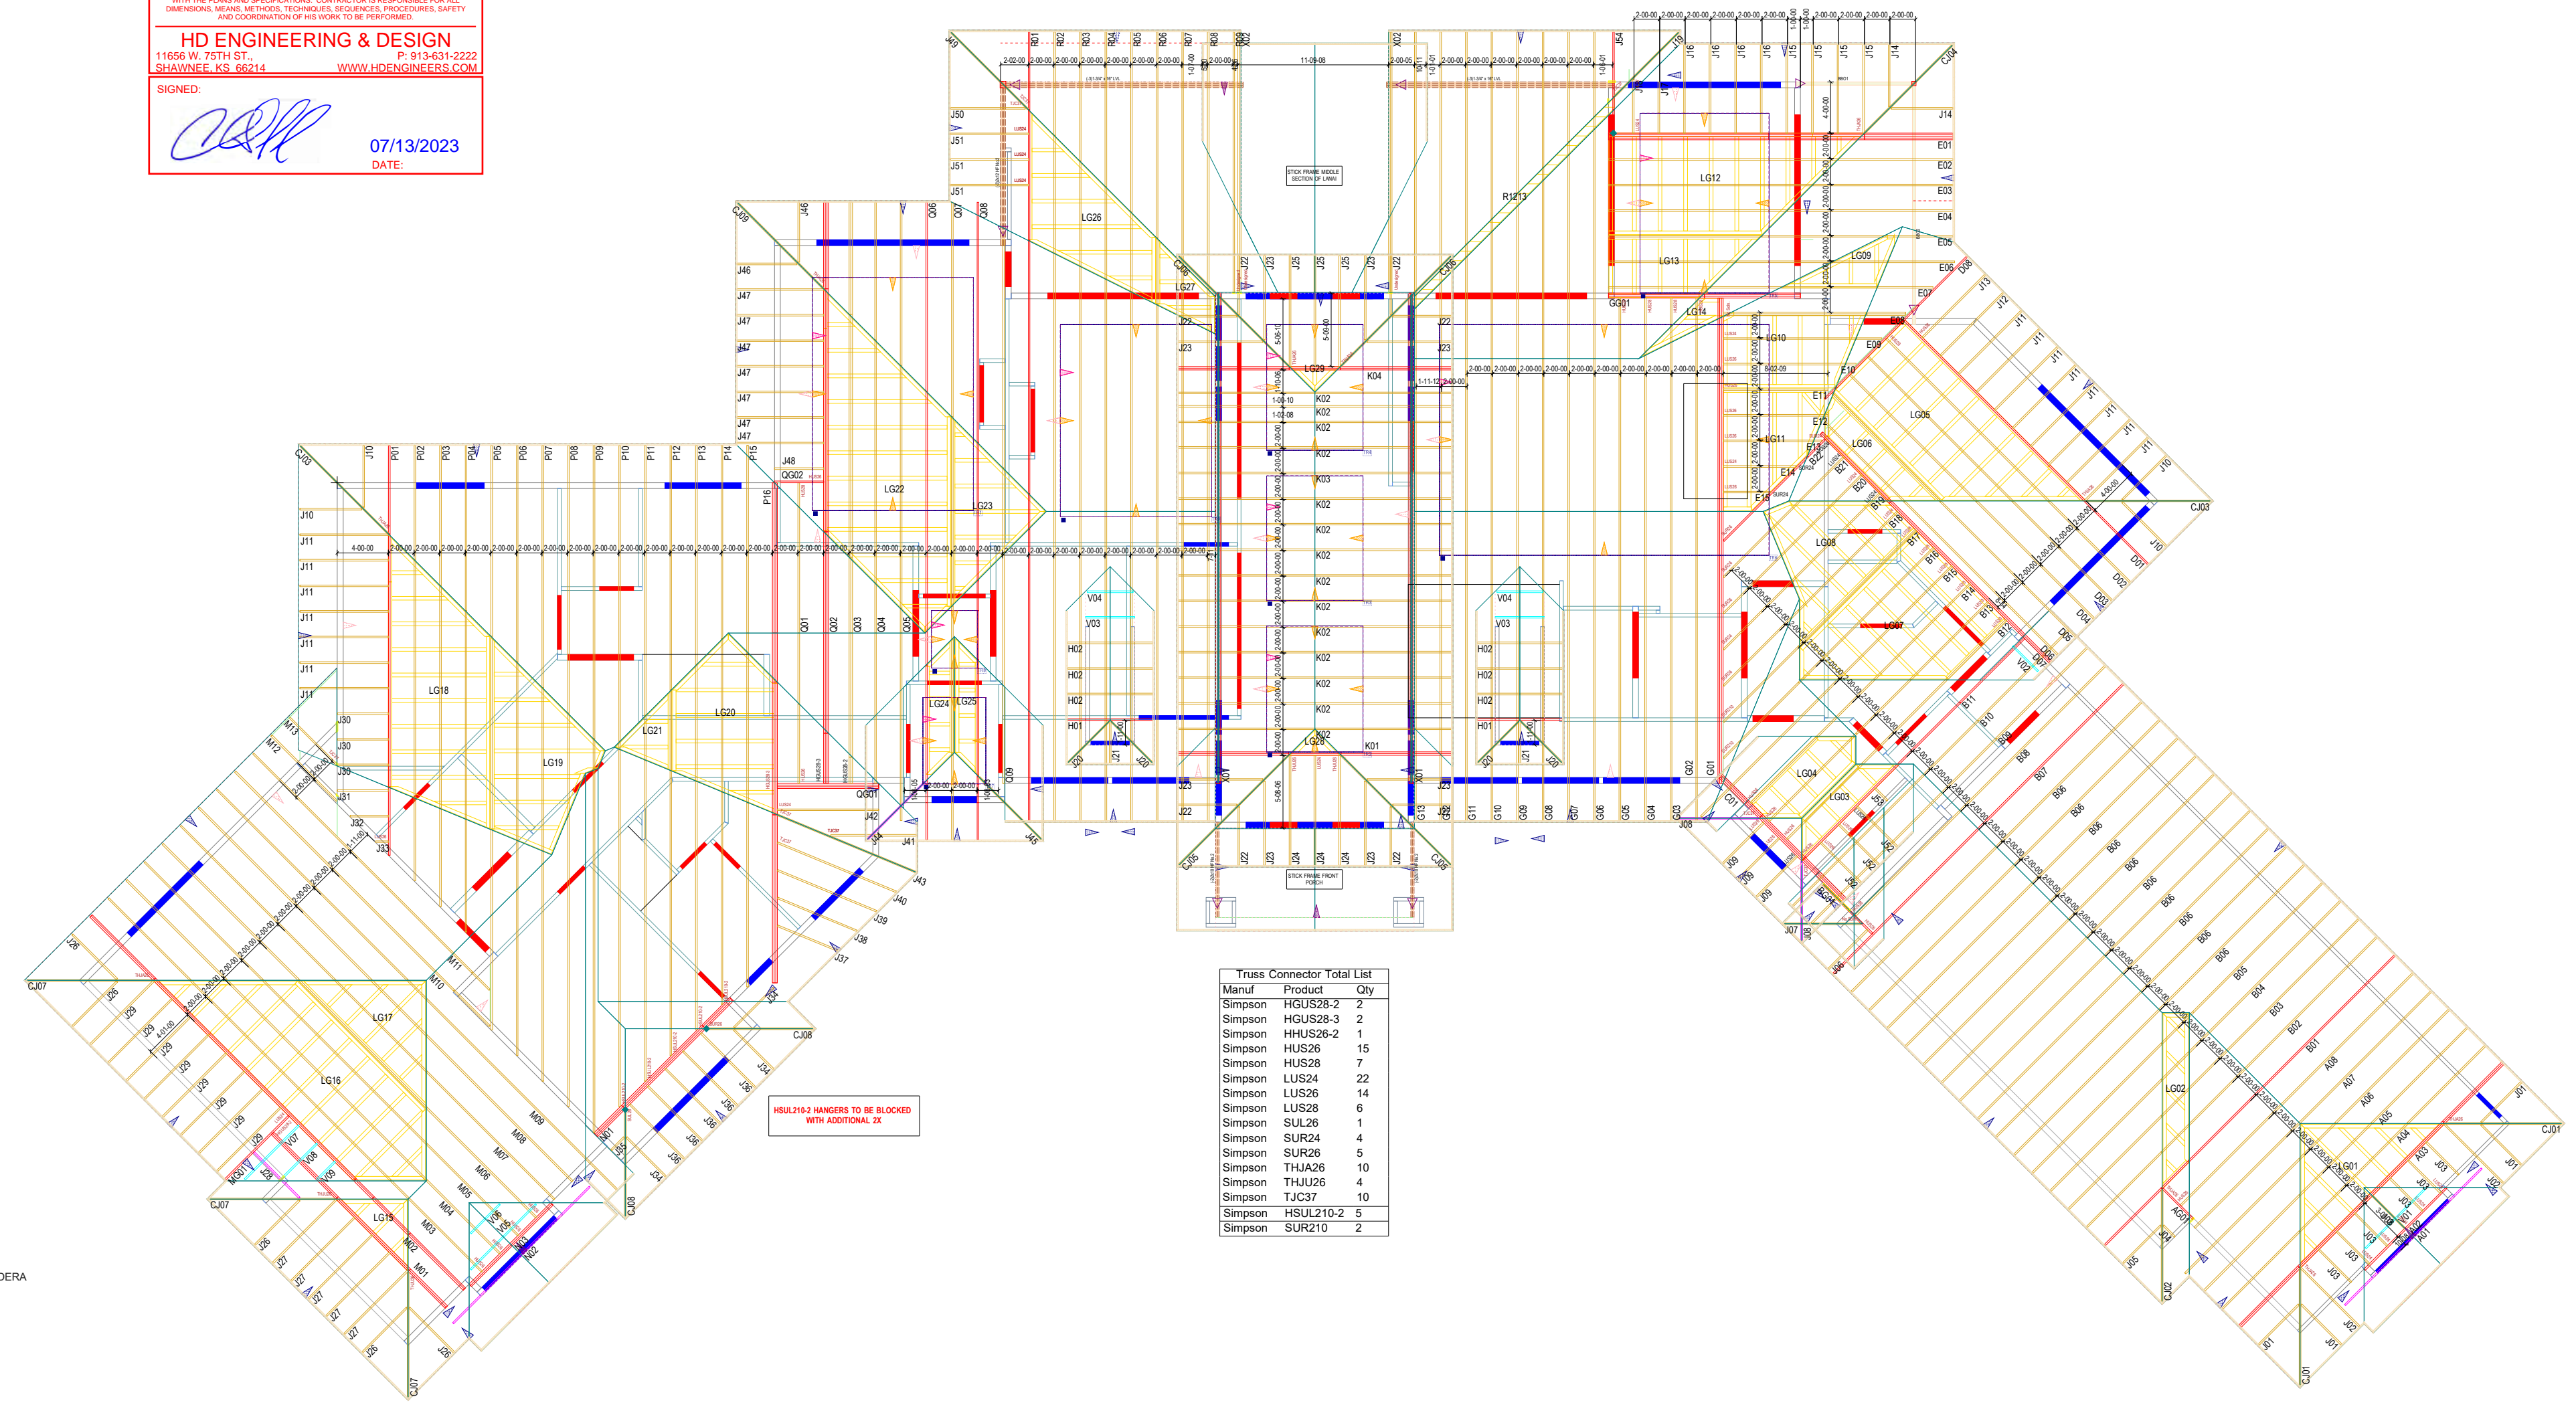

**Truss Connector Total List**

Manuf	Product	Qty
Simpson	HGUS28-2	2
Simpson	HGUS28-3	2
Simpson	HHUS26-2	1
Simpson	HUS26	15
Simpson	HUS28	7
Simpson	LUS24	22
Simpson	LUS26	14
Simpson	LUS28	6
Simpson	SUL26	1
Simpson	SUR24	4
Simpson	SUR26	5
Simpson	THJA26	10
Simpson	THJU26	4
Simpson	TJC37	10
Simpson	HSUL210-2	5
Simpson	SUR210	2

◀ - EL EXTREMO IZQUIERDO DE LOS TRUSSES (VEA LOS PERFILES)

TODAS LAS DIMENSIONES PARA LAS TRUSSES SON DE FUERA DE LA MADERA (u.n.o.)

ESTABLECER LOS TRUSSES NIVELADOS CON LA ESTRUCTURA (u.n.o.)

◀ - LEFT END OF TRUSS (SEE TRUSS PROFILES)

ALL ROOF TRUSS DIMENSIONS ARE FROM OUTSIDE EDGE OF STUD (u.n.o.)

SET ROOF TRUSSES FLUSH WITH FRAMING (u.n.o.)

**WARNING:** Trusses must be handled with care to prevent damage and injury.

This truss placement diagram is to be used only as an installation aid; it is not a structural diagram. These trusses are designed as individual building components to be incorporated into the building design at the specification of the building designer. See individual design sheets for each truss design identified on the placement drawing.

Professional advice should be sought regarding handling, installation, temporary and permanent bracing before erecting trusses. Temporary and permanent bracing is required during installation of trusses to prevent possible collapse.

For general guidance regarding bracing, consult "BCSI-06" available jointly from WTCA & TPI.

Premier Building Supply must be notified of any issues requiring a back charge prior to any work being done. Premier Building Supply reserves the right to use its service staff in lieu of being back charged.

RELEASE FOR CONSTRUCTION  
AS NOTED FOR PLAN REVIEW  
DEVELOPMENT SERVICES  
LEE'S SUMMIT, MISSOURI  
**08/24/2023**