



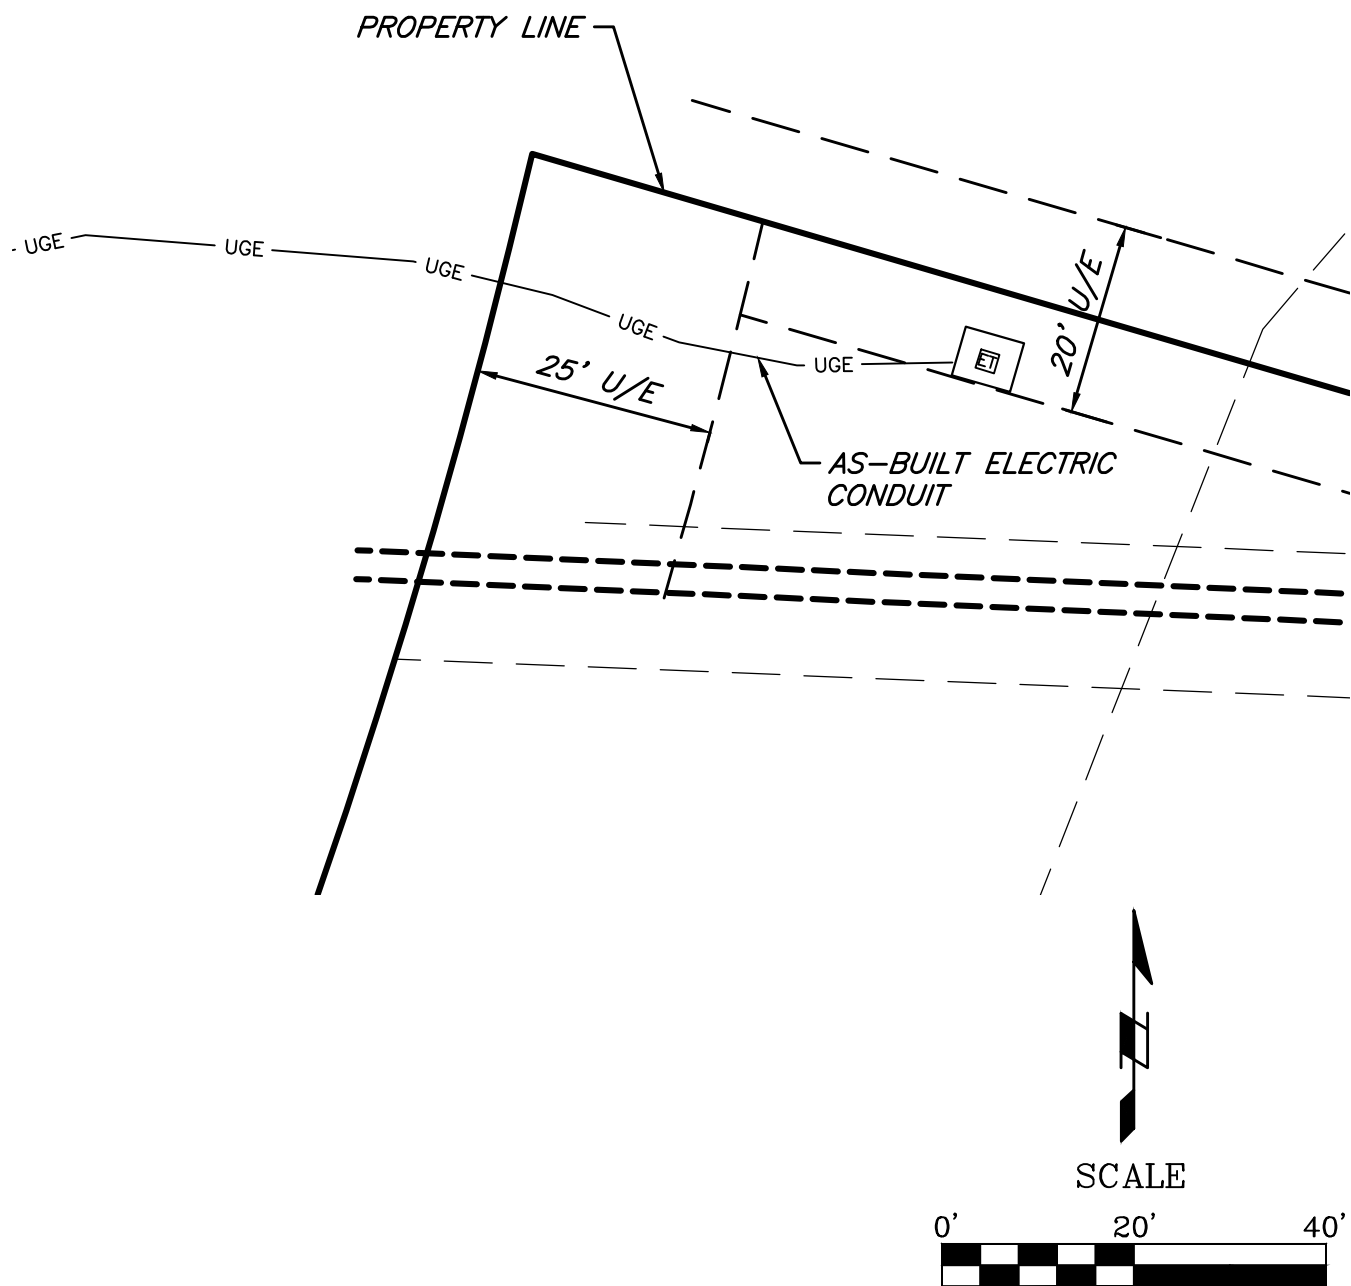

Location: S:\22.463 A - Lee's Summit Fire Station 4\IMPORTS\22.463A EVERGY IMPORT.dwg-Sep 07, 2023-11:44am

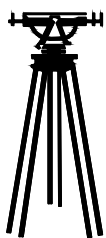

J & J
SURVEY
LLC

8680A N. GREEN HILLS ROAD • KANSAS CITY, MO 64154
PHONE (816)741-1017 • FAX (816)741-1018

EVERGY AS-BUILT SURVEY

LEE'S SUMMIT FIRE STATION # 4