

PUBLIC STREET PLANS FOR
SCANNELL DEVELOPMENT LEE'S SUMMIT LOGISTICS AT
NORTHWEST CORNER OF TUDOR ROAD AND MAIN STREET

CITY OF LEE'S SUMMIT
JACKSON COUNTY, MISSOURI

LEGEND

	SURVEY CONTROL POINT		TRAFFIC SIGNAL BOX
	SURVEY BENCHMARK		TRAFFIC SIGNAL MANHOLE
	SURVEY TEMPORARY BENCHMARK		TRAFFIC SIGNAL POLE W/ ARM
	GAS METER		TRAFFIC SIGNAL POLE
	GAS RISER		TRAFFIC SIGNAL CONTROL BOX
	GAS MANHOLE		TRAFFIC SIGNAL PEDESTAL
	GAS REGULATOR		ELECTRIC MANHOLE
	TELEVISION PEDESTAL		ELECTRIC METER
	FIBER BOX		ELECTRIC RISER
	FIBER PEDESTAL		ELECTRIC BOX
	CABLE BOX		ELECTRIC CABINET
	CABLE VAULT		ELECTRIC JUNCTION BOX
	TELEPHONE PEDESTAL		SPRINKLER HEAD
	STORM MANHOLE		SPRINKLER CONTROL VALVE
	STORM GRATE		WATER METER PIT
	SANITARY MANHOLE		FIRE HYDRANT
	YARD LIGHT		WATER METER
	LIGHT POLE		WATER VALVE
	POWER POLE		FLAG POLE
	POWER POLE W/ LIGHT		SIGN
	GUY WIRE		BOLLARD
	STUMP		WOOD POST
	BUSH		STEEL POST
	EVERGREEN TREE		COLUMN
	DECIDUOUS TREE		BORE HOLE
	MAILBOX		FIBER OPTIC VAULT

	SECTION LINE
	PROPERTY LINE
	CENTER LINE
	PROPOSED ROW LINE
	EXISTING ROW LINE
	UTILITY EASEMENT
	EXISTING MAJOR CONTOUR
	EXISTING MINOR CONTOUR
	PROPOSED MAJOR CONTOUR
	PROPOSED MINOR CONTOUR
	EXISTING TELEPHONE LINE
	EXISTING SANITARY LINE
	EXISTING STORM LINE
	EXISTING GAS LINE
	EXISTING WATER LINE
	EXISTING CHAIN LINK FENCE
	EXISTING OVERHEAD ELECTRIC
	EXISTING UNDERGROUND ELECTRIC
	GRADING LIMITS
	TEMPORARY CONSTRUCTION EASEMENT
	PROPOSED CHAIN LINK FENCE
	PROPOSED WOOD PRIVACY FENCE
	EXISTING TREELINE
	EXISTING FIBER OPTIC LINE
	EXISTING CATV LINE
	PROPOSED UNDERDRAIN

ABBREVIATION TABLE

M.G.	MATCH GRADE
P	PAVEMENT
TC	TOP OF CURB
BC	BACK OF CURB
EP	EDGE OF PAVEMENT
R/W	RIGHT-OF-WAY
TCE	TEMPORARY CONSTRUCTION EASEMENT
PROP.	PROPOSED
EXIST.	EXISTING
TYP.	TYPICAL
(R)	REMOVAL
CONST.	CONSTRUCT
TBM	TEMPORARY BENCHMARK
CPT	CONTROL POINT
D.N.D.	DO NOT DISTURB
U.I.P.	USE IN PLACE
ADJ.	ADJUST
EL.	ELEVATION
ESMT.	EASEMENT
B-B	BACK OF CURB TO BACK OF CURB DIMENSION
SP.	SPECIAL
DT.	DITCH
STD.	STANDARD
PERM.	PERMANENT



1-800-DIG-RITE or 811
www.mo1call.com

THE EXISTING UTILITY LOCATIONS SHOWN ON THE PLANS ARE APPROXIMATE AND MAY NOT INCLUDE ALL LINES PRESENT. THE CONTRACTOR SHALL BE RESPONSIBLE TO CALL "1-800-DIG-RITE", AND COORDINATE FIELD LOCATION OF EXISTING UNDERGROUND UTILITIES PRIOR TO BEGINNING GRADING ACTIVITIES. !!STOP!! CALL BEFORE YOU DIG!!

WATER - LEE'S SUMMIT WATER UTILITIES
1200 SE HAMBLER ROAD
LEE'S SUMMIT, MO 64081
(816) 969-1900

WASTEWATER - LEE'S SUMMIT WATER UTILITIES
1200 SE HAMBLER ROAD
LEE'S SUMMIT, MO 64081
(816) 969-1900

ELECTRIC - EVERGY
1300 SE HAMBLER ROAD
LEE'S SUMMIT, MO 66219
(888) 471-5275


UTILITY COMPANIES

GAS - SPIRE GAS
3025 SE CLOVER DR
LEE'S SUMMIT, MO 64082
(816) 969-2200

TELEPHONE - AT&T
1636 SE BLUE PKWY
LEE'S SUMMIT, MO 64063
(816) 600-5552

CABLE - SPECTRUM
188 NW OLDFHAM PKWY
LEE'S SUMMIT, MO 64081
(866) 874-2389

FIBER OPTIC - GOOGLE FIBER
908 BROADWAY BLVD.
KANSAS CITY, MO 64105.
(913) 663-1900

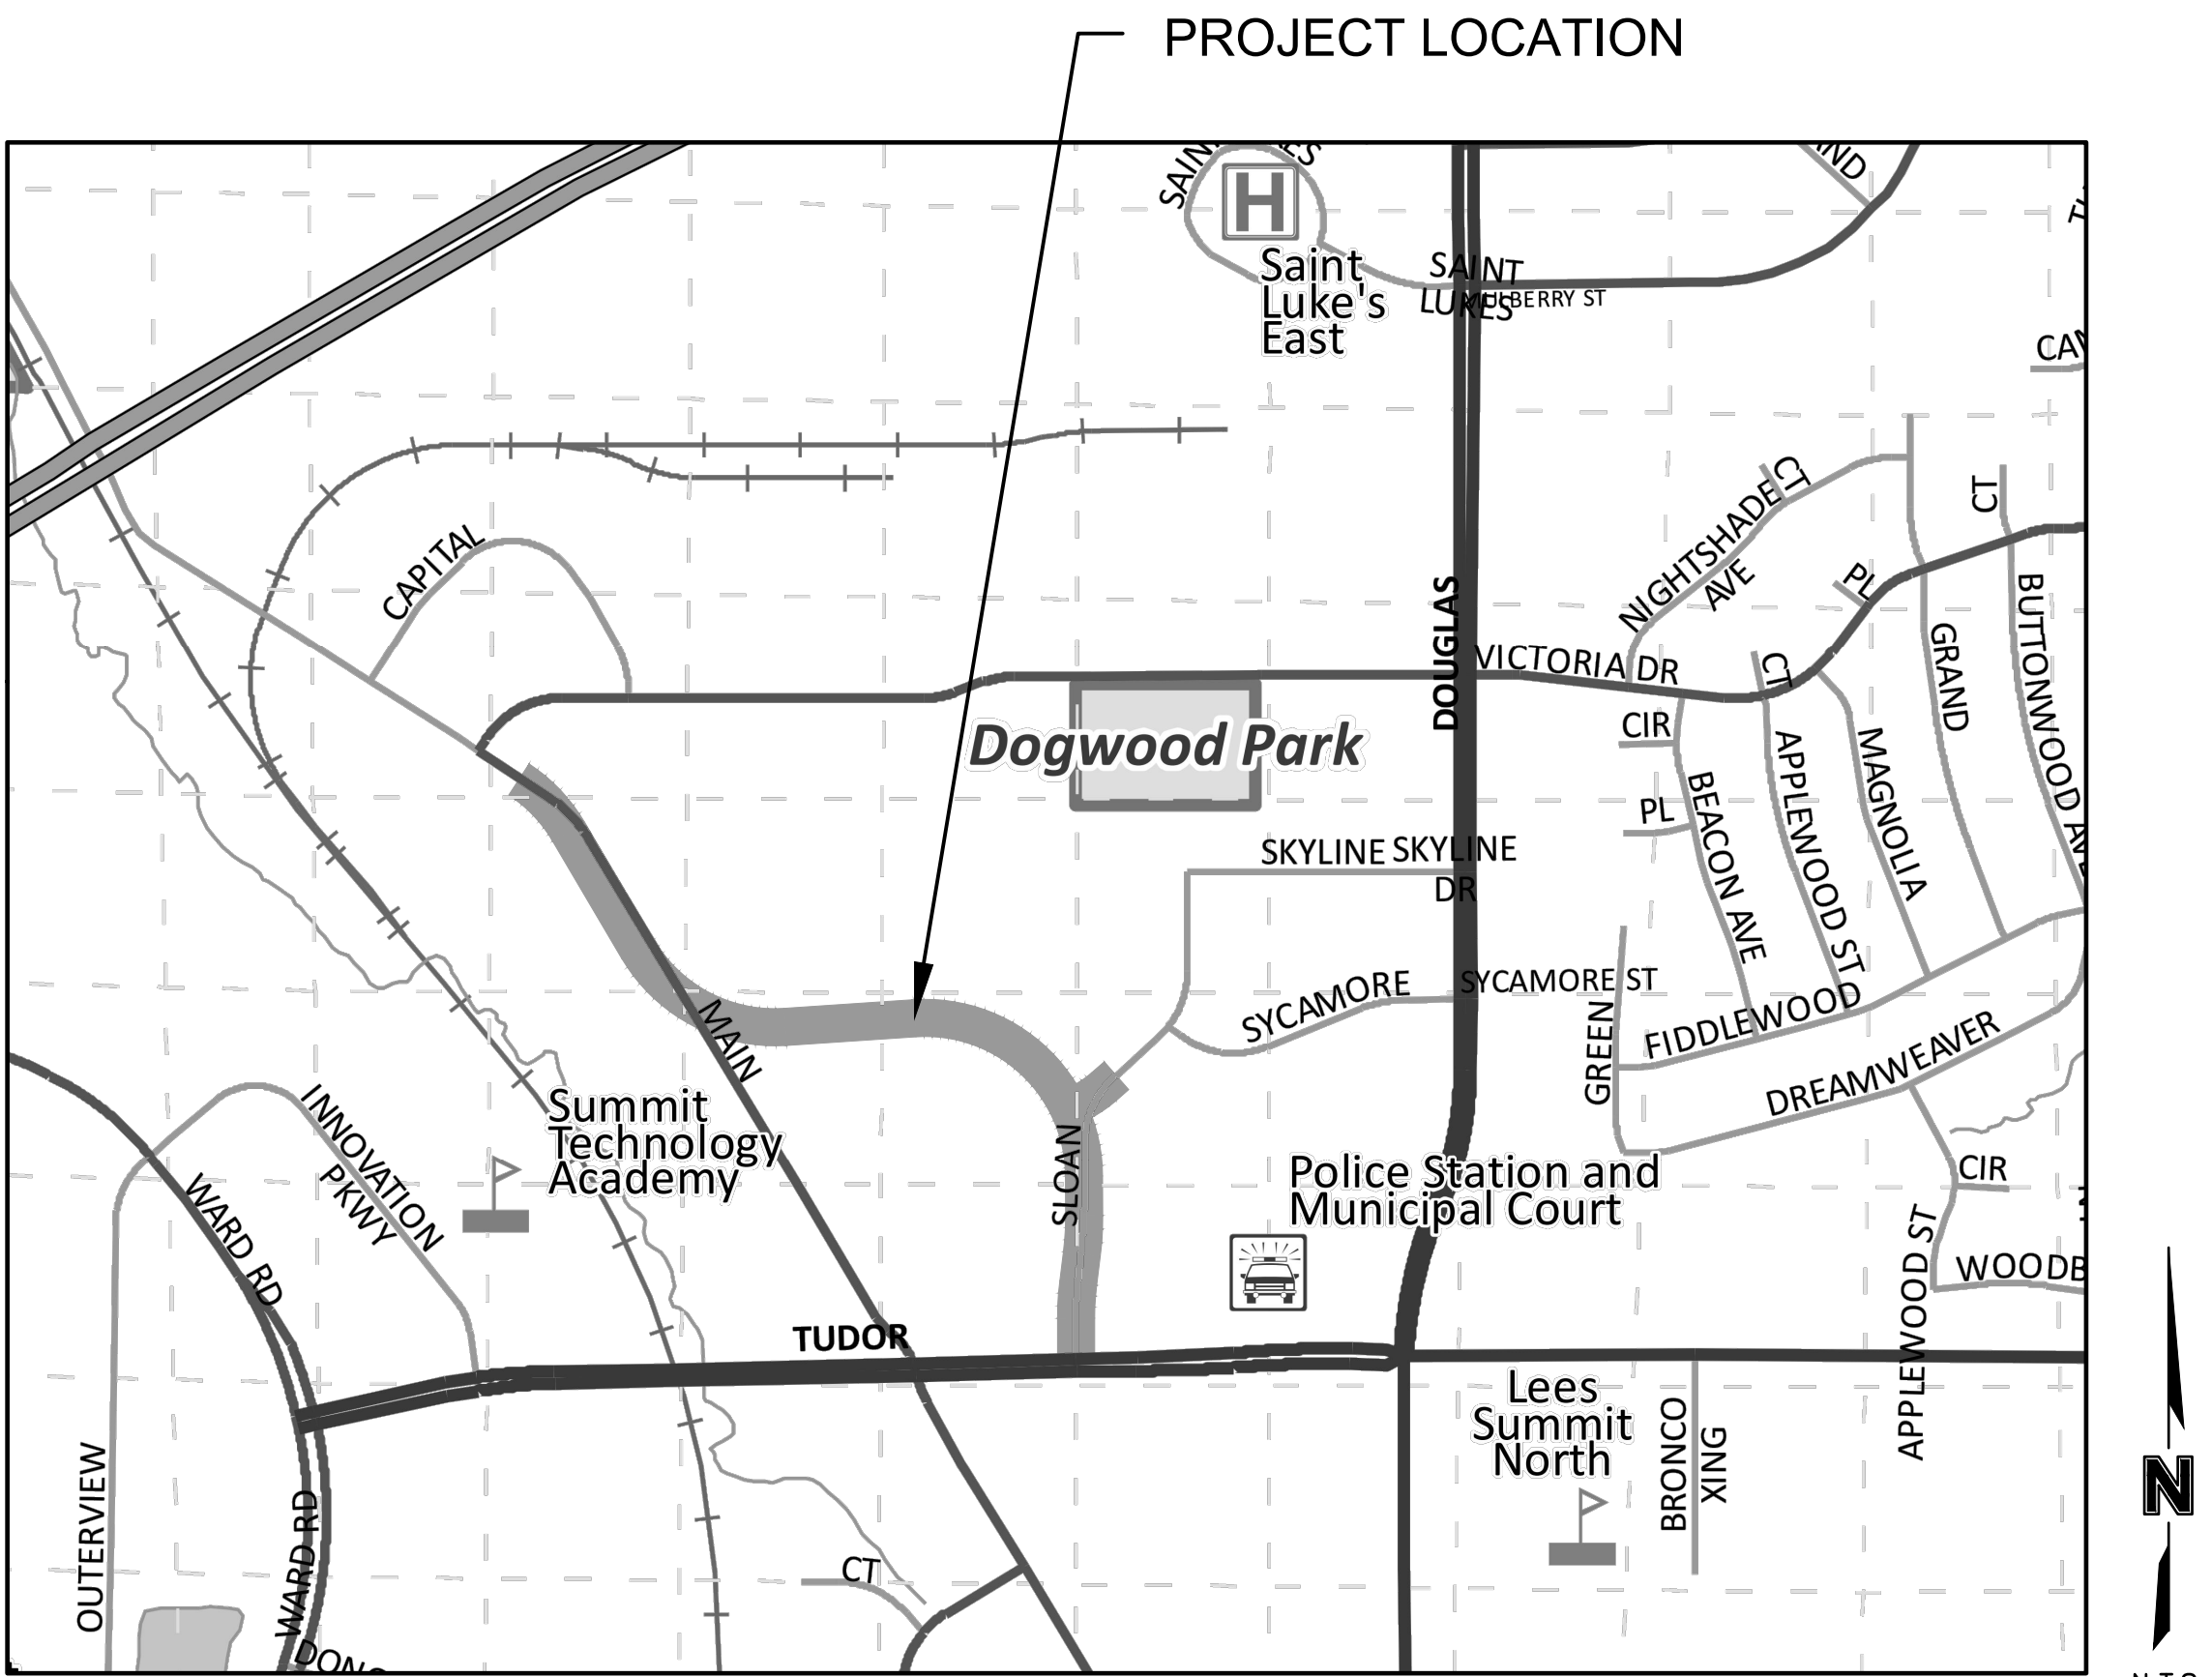

LOCATION MAP

NOT TO SCALE

DESIGN/POSTED SPEED:

MAIN STREET = 35 MPH
SLOAN STREET = 25 MPH

INDEX OF SHEETS

SHEET NO. TITLE

1	TITLE SHEET
2	GENERAL LAYOUT
3	SURVEY CONTROL
4-5	ALIGNMENT DATA
6	GENERAL NOTES
7	RECAPITULATION OF QUANTITIES
8-13	DEMOLITION AND REMOVALS
14	TYPICAL SECTIONS
15-18	RIGHT OF WAY PLANS
19-24	PLAN & PROFILES - MAIN STREET
25	PLAN & PROFILES - NW SLOAN STREET
26	PLAN & PROFILES - NE TUDOR ROAD
27	INTERSECTION LAYOUT
28	SIDEWALK RAMP LAYOUT
29-32	STORM SEWER PROFILES
33-34	DRAINAGE MAP & STORM SEWER CALCULATIONS
35-38	STANDARD DETAILS
39-42	STORM SEWER DETAILS
43-47	REINFORCED CONCRETE BOX DETAILS
48-53	EROSION CONTROL PLANS
54-58	EROSION CONTROL DETAILS
59	STREET LIGHTING GENERAL NOTES
60-62	STREET LIGHTING
63-70	PAVEMENT MARKING & SIGNING PLANS AND DETAILS
71	TRAFFIC CONTROL PLAN
72-74	DETOUR PLANS
75	TRAFFIC CONTROL DETAILS
76-103	CROSS SECTIONS - MAIN STREET
104	CROSS SECTIONS - NW SLOAN STREET
105	CROSS SECTIONS - NE TUDOR ROAD

PREPARED & SUBMITTED BY:

olsson

7301 W. 133RD STREET, SUITE 200
OVERLAND PARK, KANSAS 66213

Ryan B. Fleming
11/16/21
RYAN B. FLEMING, P.E. DATE
I CERTIFY THESE PLANS WERE PREPARED BY ME OR UNDER MY IMMEDIATE PERSONAL SUPERVISION. THE FOLLOWING DRAWINGS ARE INTENDED TO BE AUTHENTICATED BY MY SEAL: PE-2002003161

Shannon Jeffries
11/16/21
SHANNON JEFFRIES, P.E. DATE
I CERTIFY THESE PLANS WERE PREPARED BY ME OR UNDER MY IMMEDIATE PERSONAL SUPERVISION. THE FOLLOWING DRAWINGS ARE INTENDED TO BE AUTHENTICATED BY MY SEAL: PE-2008000069

olsson

**RECORD
DRAWINGS**

RYAN B. FLEMING
MO. NO. PE-2002003161

REV. NO.	DATE	REVISIONS DESCRIPTION	BY
1	11/16/2021	CITY COMMENTS	ARJ

TITLE SHEET	SCANNELL DEVELOPMENT LEE'S SUMMIT LOGISTICS NORTHWEST CORNER OF TUDOR ROAD AND MAIN STREET	2021
-------------	---	------

C.O.A. NO.:	_____
DRAWN BY:	ARJ/AMW
CHECKED BY:	XXX
APPROVED BY:	RBE
QA/QC BY:	RBE
PROJECT NO.:	021-04157
DWG NO.:	T_TTL01_02104157
DATE:	2021-10-12

SHEET
1 OF 105

Olsson Engineering - MO State Certificate of Authority #001592
7301 West 133rd Street, Suite 200 TEL 913.381.1170
Overland Park, KS 66213-4750 FAX 913.381.1174
www.olson.com

CTR Section 31-48-31
 Found 1/2" Rebar with "2" Aluminum Cap. Flush 0.12" East of N/S barbed wire fence on West side of Sloan St. Shot X cut at center of cap.
 Elevation: 1004.97'
 1. E 83.90' to chainlink fence at end E side of Sloan St (set)
 2. SE 33.73' to found X cut on top of curb
 3. NE 31.77' to found X cut on top of curb
 4. E 10.63' to back of curb
 5. E 48.83' to found X cut on top of curb

Found 1/2" Rebar with 2" Aluminum Cap. Flush 0.12' East of N/S barbed wire fence on West side of Sloan St. Shot X cut at center of cap.
Elevation: 1004.97

1. E 83.90' to chainlink fence at end E side of Sloan St (set)
2. SE 33.73' to found X cut on top of curb
3. NE 31.77' to found X cut on top of curb
4. E 10.63' to back of curb
5. E 48.83' to found X cut on top of curb

Set 1/2" Rebar with Olsson Control Cap. Set on top of
berm East of Sloan St between asphalt path and sidewalk
N: 52055.35
E: 56148.63

1. NW 87.42' Northmost arrow turn signal at tip
2. W 52.80' to middle arrow turn signal at tip
3. SW 42.91' to center of curb inlet manhole
4. E 13.57' to P.C. of W edge of asphalt path




Set 1/2" Rebar with Olsson Control Cap. Set on top of
berm on East side of Sloan St.
N: 52321.10
E: 56167.20

Ties:

1. SW 19.87' to back of curb at P.C.
2. W 13.90' to East edge of sidewalk at P.C.
3. E 14.00' to West Edge of asphalt path
4. S 264.21' to Olsson #101

Set chiseled square cut on top of curb 11' NW of power pole where power line splits to South and East. Also on East curb line of Main St.
Elevation: 978.11

Set chiseled square cut on top of curb at flume in parking lot of 1292 Sloan St.
Elevation: 988.89

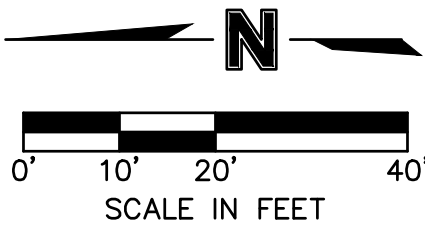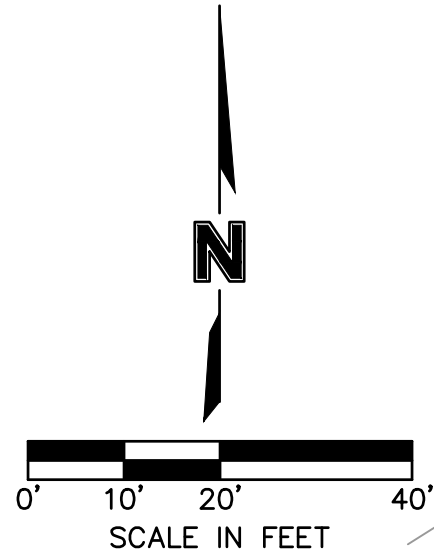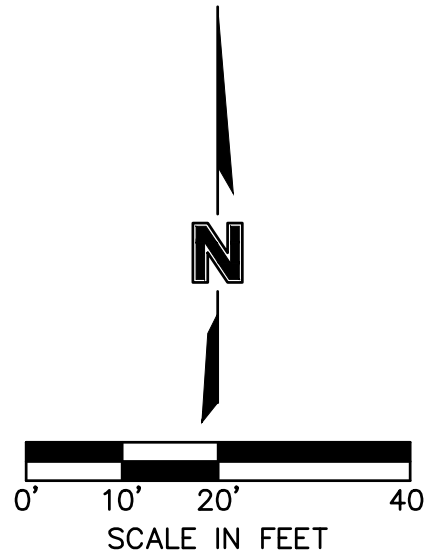

SCANNELL DEVELOPMENT LEE'S SUMMIT LOGISTICS

2021

[illegible]

RYAN B. FLEMING
D. NO. PE-2002003161




RECORD
DRAWINGS

Olsson Engineering - MO State Certificate of Authority #001592
7301 West 133rd Street, Suite 200 TEL 913.381.1170
Overland Park, KS 66213-4750 FAX 913.381.1174 www.olsson.com

olson

SHEET
OF 105

DWG: F:\2021\04001-04500\21-04157\40-Design\AutoCAD\Final Plans\Sheets\RDBR\T_ALI01_02104157.dwg
XREFS: V_XB00_02104157 V_XTOPO_02104157 T_PTBK_02104157
DATE: Oct 30, 2023 3:45pm

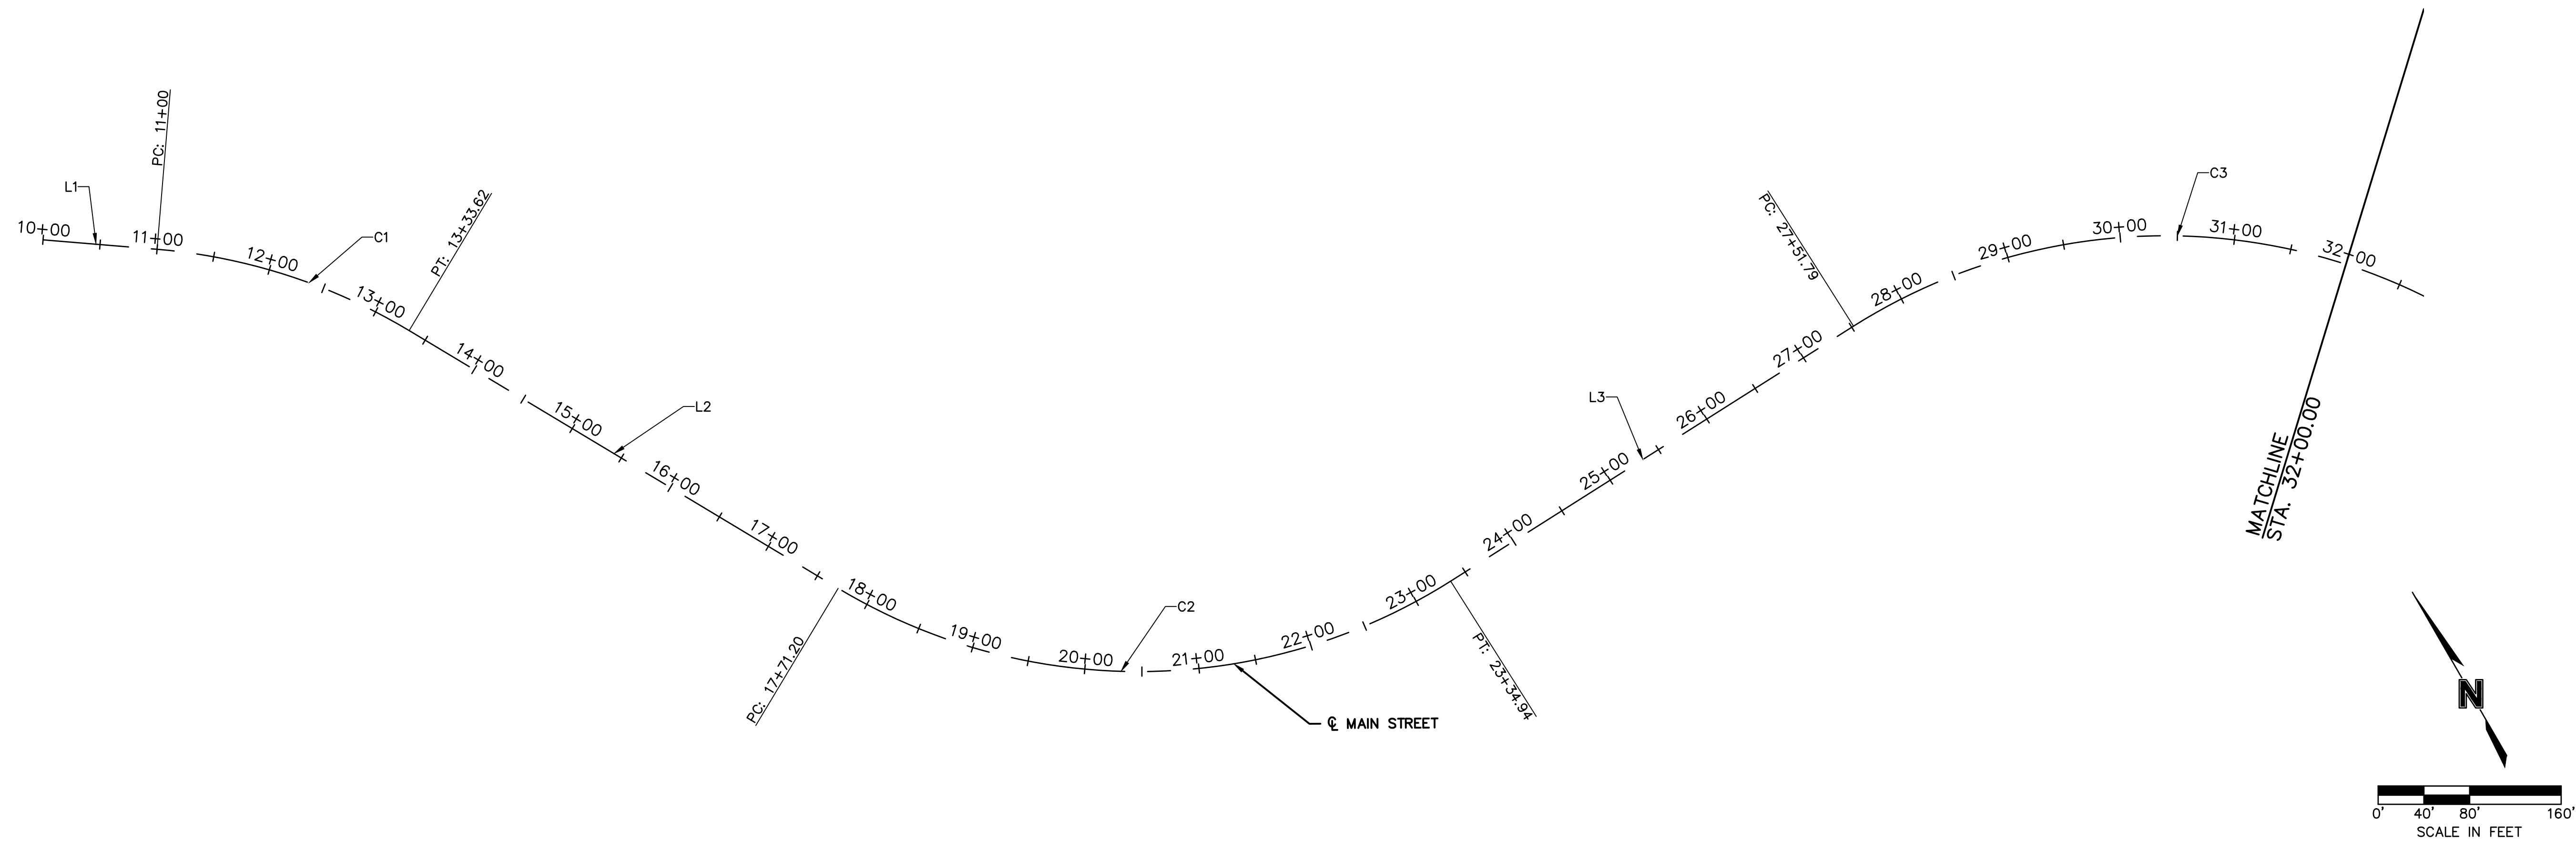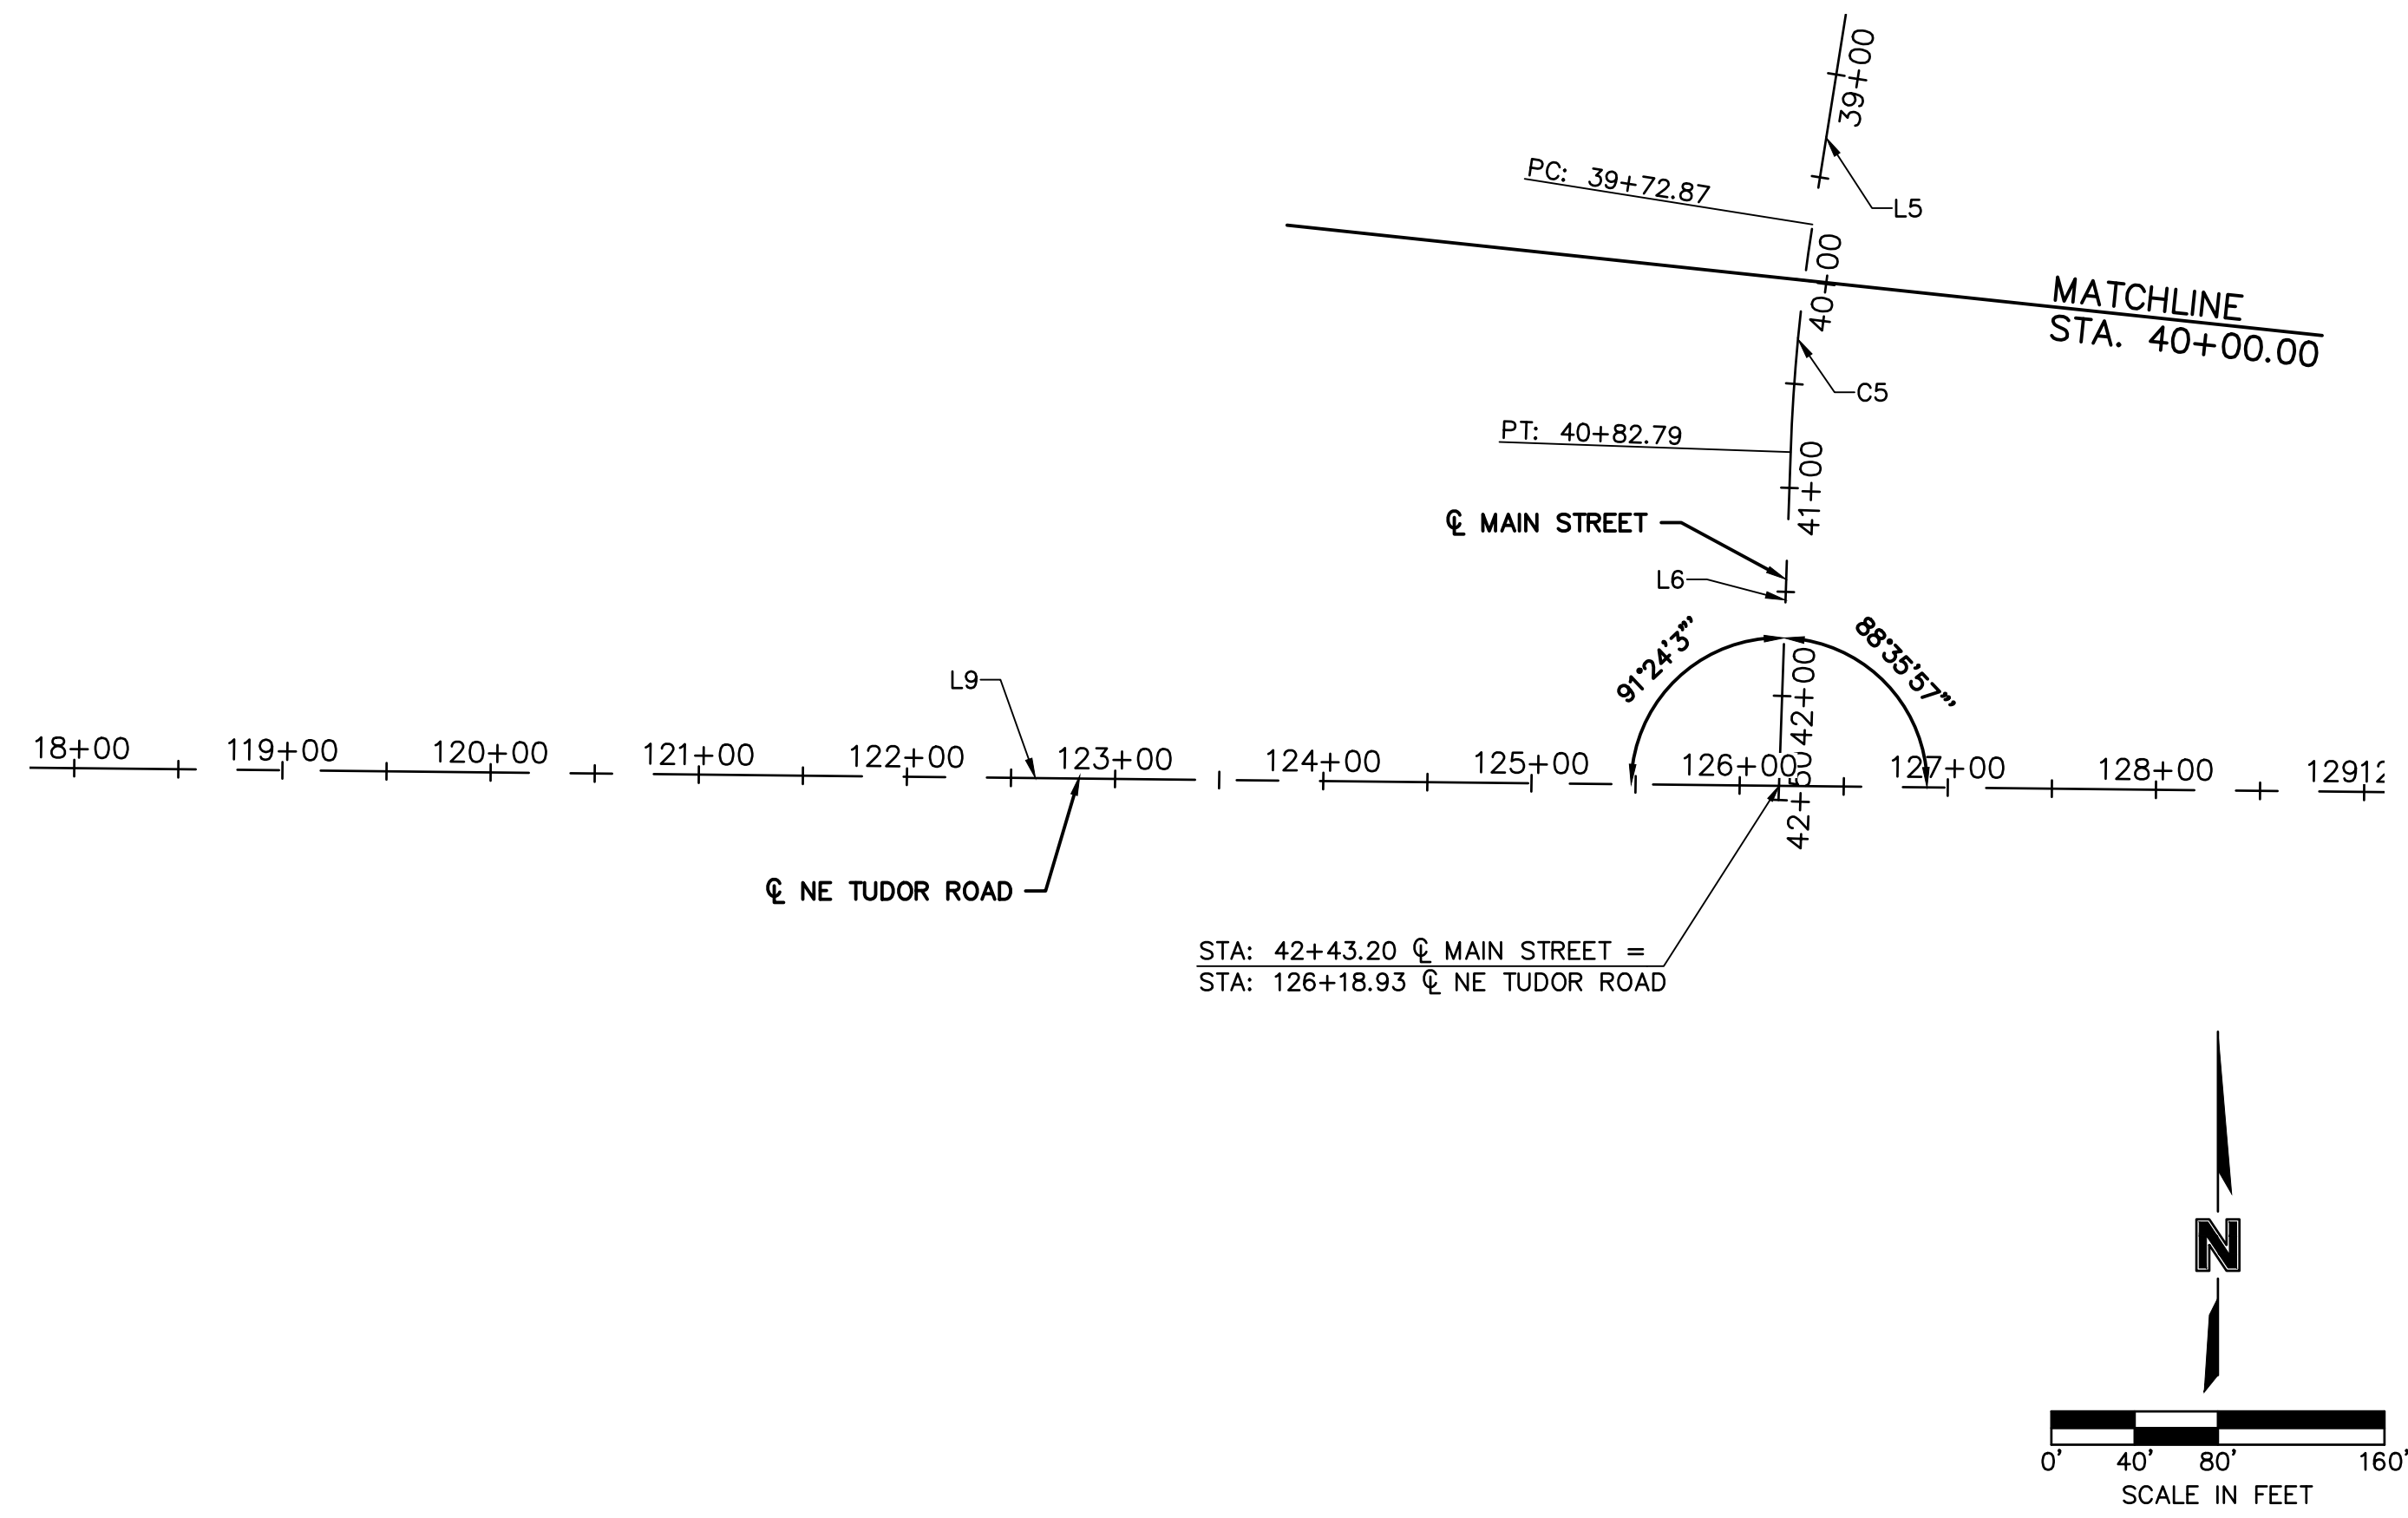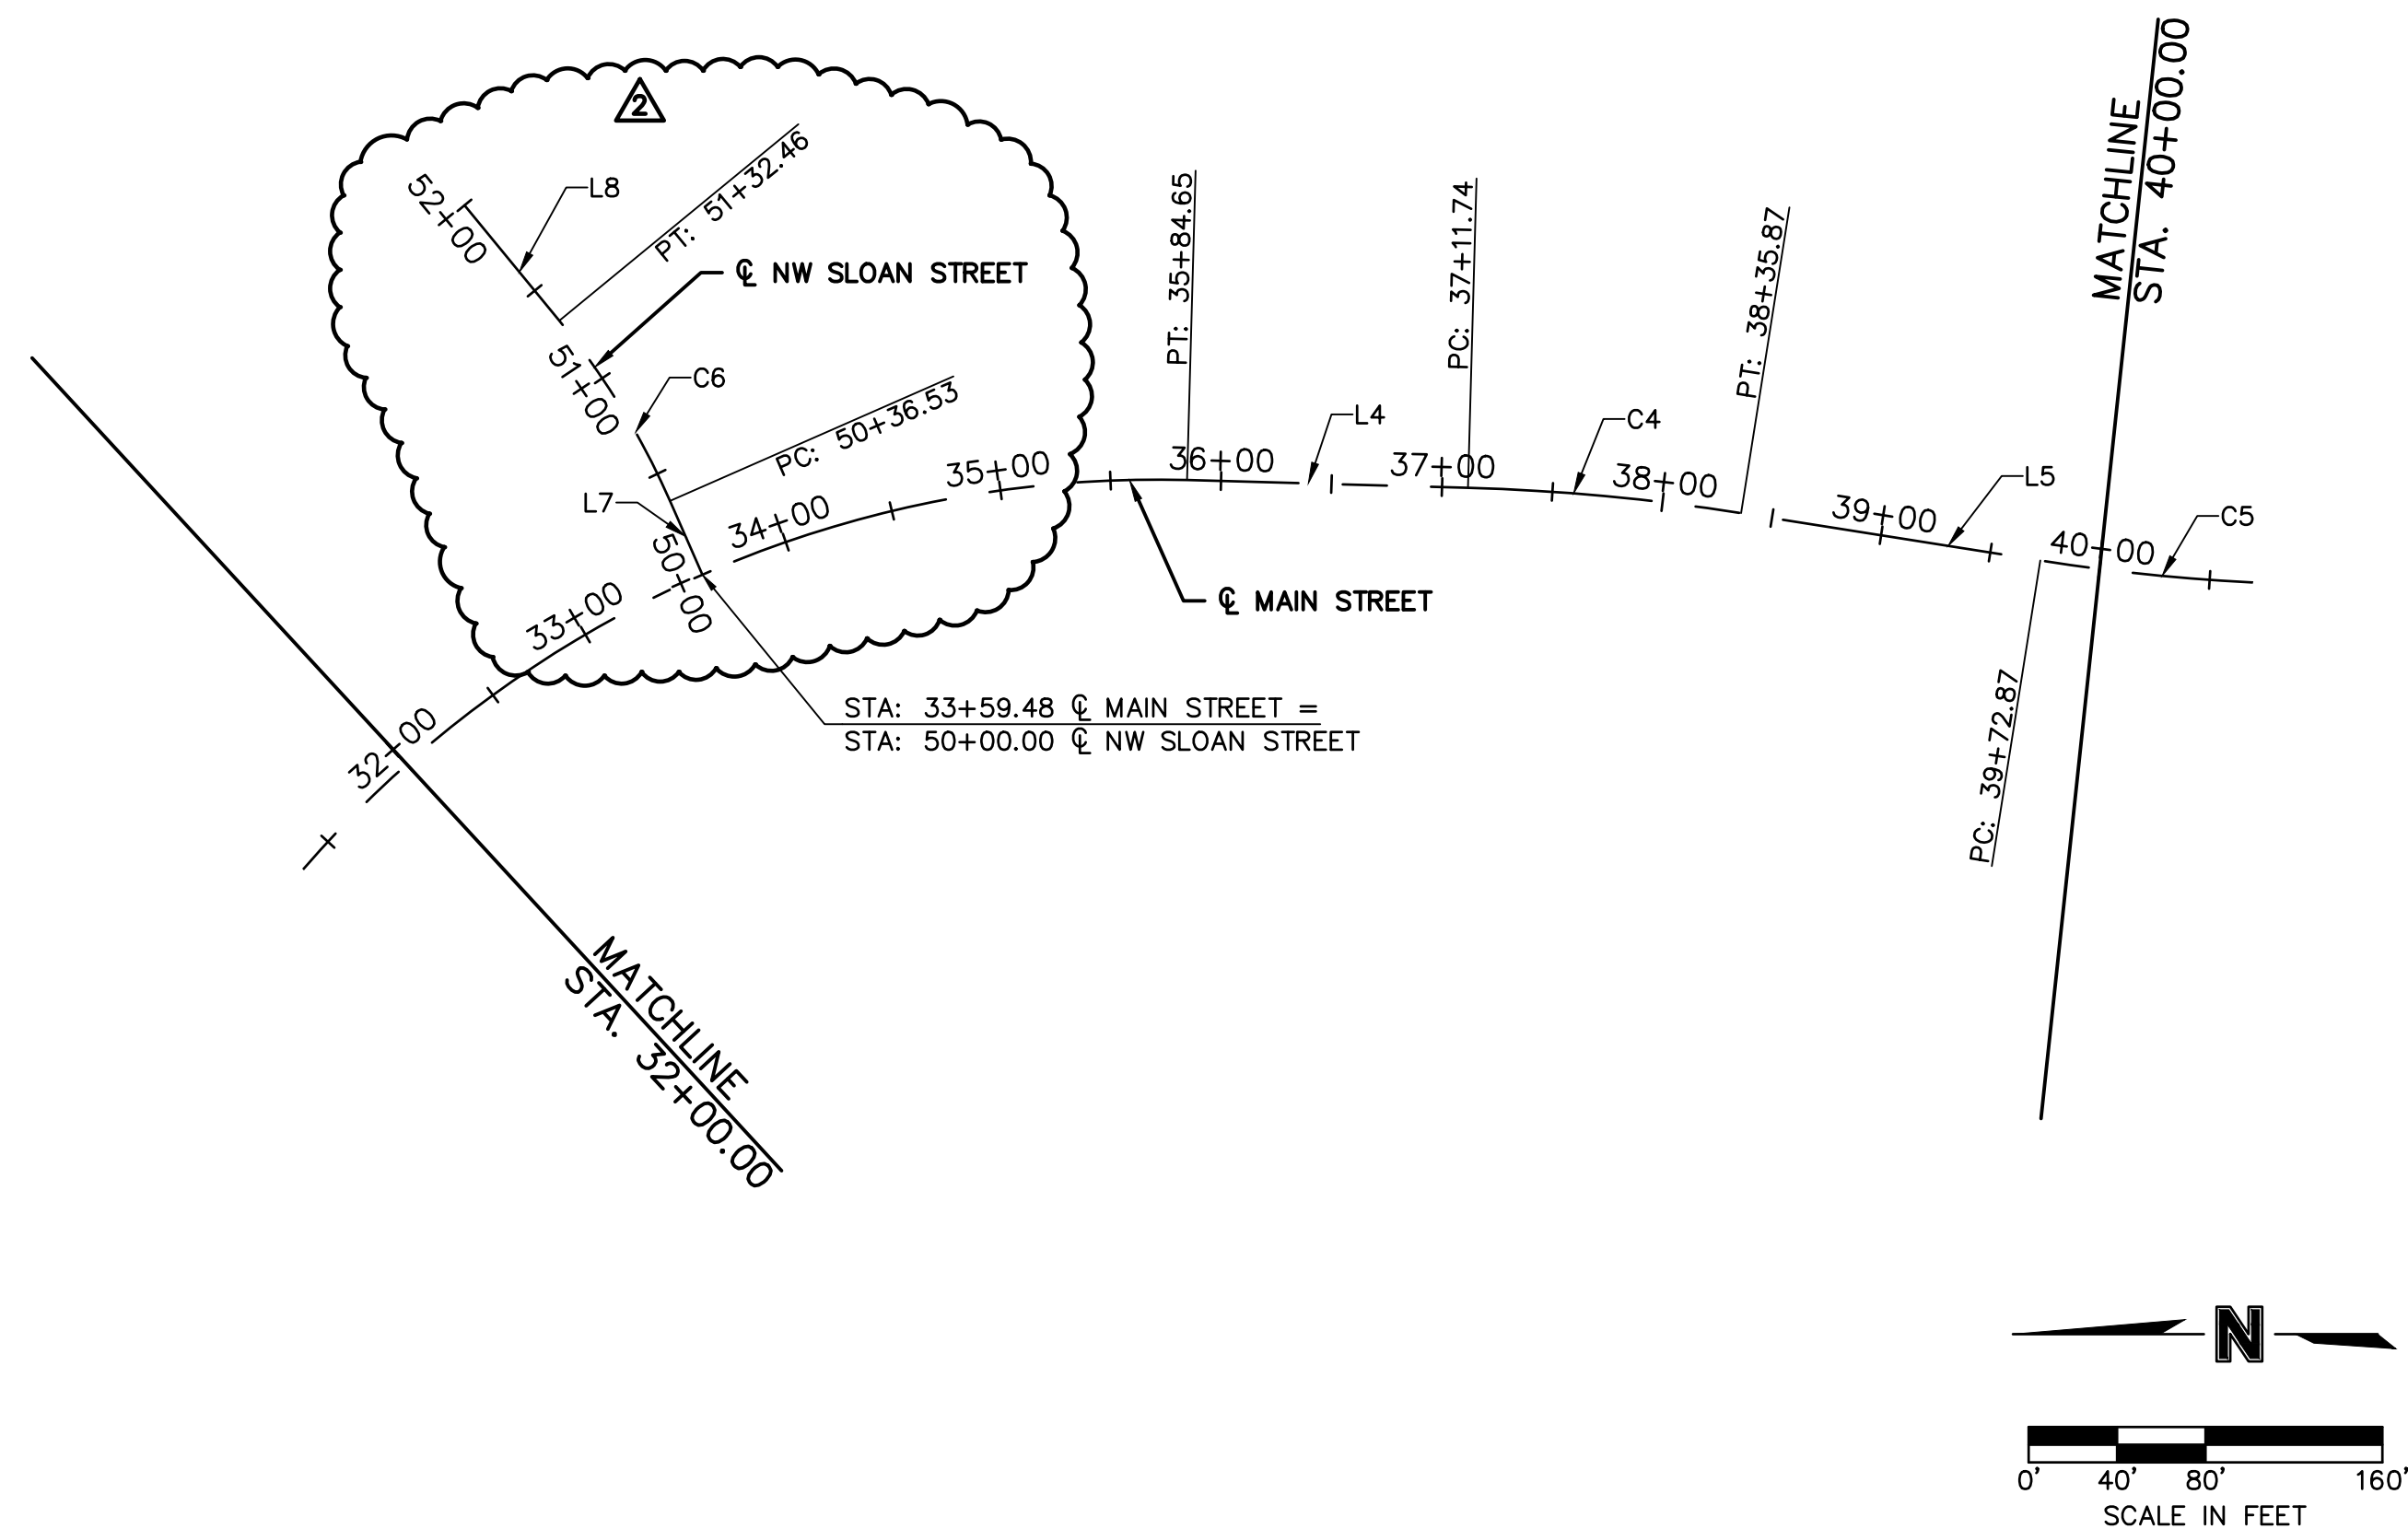

ALIGNMENT DATA

SCANNELL DEVELOPMENT LEE'S SUMMIT LOGISTICS NORTHWEST CORNER OF TUDOR ROAD AND MAIN STREET LEE'S SUMMIT, MISSOURI	2020
---	------

C.O.A. NO.: _____ -
DRAWN BY: _____ ARJ/AMW
CHECKED BY: _____ XXX
APPROVED BY: _____ RBF
QA/QC BY: _____ RBF
PROJECT NO.: _____ 021-04157
DWG NO.: _____ T_ALI01_02104157
DATE: _____ 2021-10-12

SHEET
4 OF 105

RYAN B. FLEMING
MO. NO. PE-2002003161

RECORD
DRAWINGS

REV. NO.	DATE	REVISIONS DESCRIPTION	BY
2	01/05/2022	DESIGN REVIEW	ARJ
REVISIONS			

[illegible]

olsson

Olsson Engineering - MO State Certificate of Authority #001592
7301 West 133rd Street, Suite 200 TEL 913.381.1170
Overland Park, KS 66213-4750 FAX 913.381.1174 www.olsson.com

		MAIN STREET							
NO.		STATION	NORTHING	EASTING	LENGTH	LINE/CHORD BEARING	DELTA	TANGENT	RADIUS
L1		10+00.00 11+00.00	53972.7352 53915.2275	54288.1193 54369.9292	100.00'	S54°53'42"E			
C1	PC= PI= PT=	11+00.00 12+18.90 13+33.62	53915.2275 53846.8517 53742.5091	54369.9292 54467.1999 54524.2041	233.62'	S41°46'18"E	26°14'47"	118.90'	510.00'
L2		13+33.62 17+71.20	53742.5091 53358.4997	54524.2041 54733.9951	437.58'	S28°38'55"E			
C2	PC= PI= PT=	17+71.20 20+85.77 23+34.94	53358.4997 53082.4388 53093.3169	54733.9951 54884.8120 55199.1956	563.74'	S60°18'54"E	63°19'59"	314.57'	510.00'
L3		23+34.94 27+51.79	53093.3169 53107.7318	55199.1956 55615.7955	416.85'	N88°01'06"E			
C3	PC= PI= PT=	27+51.79 32+94.57 35+84.65	53107.7318 53126.5015 52583.9306	55615.7955 56158.2495 56143.2365	832.85'	S45°11'54"E	93°34'00"	542.78'	510.00'
L4		35+84.65 37+11.74	52583.9306 52456.8896	56143.2365 56139.7213	127.09'	S1°35'06"W			
C4	PC= PI= PT=	37+11.74 37+73.89 38+35.87	52456.8896 52394.7589 52333.3686	56139.7213 56138.0022 56128.2857	124.14'	S5°17'22"W	7°24'32"	62.15'	960.00'
L5		38+35.87 39+72.87	52333.3686 52198.0525	56128.2857 56106.8689	137.00'	S8°59'38"W			
C5	PC= PI= PT=	39+72.87 40+27.90 40+82.79	52198.0525 52143.7028 52088.7099	56106.8689 56098.2668 56096.3499	109.92'	S5°29'42"W	6°59'51"	55.03'	900.00'
L6		40+82.79 42+50.00	52088.7099 51921.5991	56096.3499 56090.5250	167.21'	S1°59'47"W			

NW SLOAN STREET									
NO.		STATION	NORTHING	EASTING	LENGTH	LINE/CHORD BEARING	DELTA	TANGENT	RADIUS
L7		50+00.00 50+36.53	52803.1190 52817.8082	56100.3806 56133.8264	36.53'	N66°17'21"E			
C6	PC= PI= PT=	50+36.53 50+84.80 51+32.46	52817.8082 52837.2177 52867.8642	56133.8264 56178.0195 56215.3095	95.93'	N58°26'14"E	15°42'14"	48.27'	350.00'
L8		51+32.46 52+00.00	52867.8642 52910.7478	56215.3095 56267.4893	67.54'	N50°35'07"E			

NE TUDOR ROAD									
NO.	STATION	NORTHING	EASTING	LENGTH	LINE/CHORD BEARING	DELTA	TANGENT	RADIUS	
L9	110+00.00 129+36.82	51945.2172 51925.0900	54471.9213 56408.6330	1936.82'	S89°24'16"E				

RECORD
DRAWINGS

RYAN B. FLEMING
MO. NO. PE-200200316

[illegible]

ALIGNMENT DATA	
SCANNELL DEVELOPMENT LEE'S SUMMIT LOGISTICS NORTHWEST CORNER OF TUDOR ROAD AND MAIN STREET	2021
LEE'S SUMMIT, MISSOURI	

C.O.A. NO.: _____
DRAWN BY: _____ ARJ/AMW
CHECKED BY: _____ XXX
APPROVED BY: _____ RBF
QA/QC BY: _____ RBF
PROJECT NO.: _____ 021-04157
DWG NO.: _____ T_ALI01_02104157
DATE: _____ 2021-10-12

GENERAL NOTES FOR CAPITAL IMPROVEMENTS PROJECTS
(REV. FEBRUARY 10, 2010)

1)PRELIMINARY INFORMATION:

- a) CONSULT PARAGRAPH 6.12 OF THE EJCDC GENERAL CONDITIONS (C-700) FOR A COMPLETE LIST OF RECORD DOCUMENTS THAT THE CONTRACTOR SHALL MAINTAIN ON SITE.
- b) PERMITS REQUIRED FOR THE WORK CAN BE FOUND IN SECTION 1010 OF THE GENERAL REQUIREMENTS (DIVISION 1).
- c) CONSTRUCTION OF THE WORK SHOWN OR IMPLIED BY THIS SET OF DRAWINGS SHALL NOT BE INITIATED UNLESS ALL PRELIMINARY CONTRACT OBLIGATIONS ARE MET, AND THE OWNER IS NOTIFIED OF THE INTENT TO START THE WORK. SEE SECTION 1020 OF DIVISION 1.
- d) ALL WORK SHALL BE CONFINED WITHIN THE CONSTRUCTION LIMITS OR AS OTHERWISE DIRECTED BY THE OWNER.
- e) ANY WORK PERFORMED PRIOR TO ENGINEER'S REVIEW AND APPROVAL OF THE PERTINENT SUBMITTAL WILL BE AT THE SOLE EXPENSE AND RESPONSIBILITY OF CONTRACTOR. SUBMITTAL PROCEDURES AND REQUIREMENTS CAN BE FOUND IN PARAGRAPH 6.17 OF C-700 AND SECTIONS 1115 AND 1116 OF DIVISION 1.
- f) OWNER IS DEFINED AS THE CITY OF LEE'S SUMMIT.

2) COORDINATION AND NOTIFICATIONS:

- a) ANY TIME REFERENCES LISTED IN PARAGRAPH 2 ARE TYPICAL TIMELINES. CONSULT SECTION 1105 OF DIVISION 1 FOR PROJECT SPECIFIC TIMELINES, COORDINATION AND NOTIFICATION PROCESSES.
- b) PRIOR TO ANY STREET CLOSURES, APPROPRIATE NOTIFICATIONS WILL BE DISTRIBUTED. THE CLOSURES OF ARTERIAL AND COLLECTOR STREETS WILL TYPICALLY CAUSE THE OWNER TO GENERATE A PRESS RELEASE AND DETOUR MAP. THIS IS TYPICALLY 14 CALENDAR DAYS.
- c) THE REMOVAL OF TREES, SHEDS, FENCING OR OTHER ITEMS ON PRIVATE PROPERTY, NOT OTHERWISE SHOWN ON THESE PLANS, ARE NOT AUTHORIZED ON THIS PROJECT. CONTRACTOR SHALL NOTIFY THE OWNER IMMEDIATELY IF ANY SUCH WORK IS PROPOSED. THE OWNER REQUIRES AT LEAST 14 CALENDAR DAYS TO NOTIFY PROPERTY OWNER RESIDENT, IN ORDER TO GIVE THEM OPPORTUNITY TO SALVAGE THESE ITEMS.
- d) PRIOR TO DRIVEWAY DEMOLITION AND RECONSTRUCTION, CONTRACTOR SHALL NOTIFY AND COORDINATE WITH THE PROPERTY OWNER OR RESIDENT. THIS IS TYPICALLY 2 WORKING DAYS.
- e) PRIOR TO SHUTTING DOWN A WATER MAIN, CONTRACTOR SHALL NOTIFY AND COORDINATE WITH THE PROPERTY OWNER OR RESIDENT. THIS IS TYPICALLY 2 WORKING DAYS.
- f) CONTRACTOR SHALL NOT BE ALLOWED TO WORK WEEKENDS OR HOLIDAYS WITHOUT REQUESTING PRIOR APPROVAL FROM OWNER THREE WORKING DAYS IN ADVANCE.
- g) BY ORDINANCE 17-42, WORKING HOURS WITHIN THE CITY OF LEE'S SUMMIT ARE 7:00 A.M. TO 10:00 P.M. REQUESTS TO WORK BEYOND THESE HOURS MUST BE FILED WITH THE OWNER ONE WEEK IN ADVANCE.

3) SURVEY:

- a) IN ACCORDANCE WITH PARAGRAPH 4.05 OF C-700, OWNER OR ENGINEER SHALL PROVIDE ENGINEERING SURVEYS TO ESTABLISH REFERENCE POINTS FOR CONSTRUCTION WHICH IN THEIR JUDGMENT ARE NECESSARY TO ENABLE CONTRACTOR TO PERFORM THE WORK. CONTRACTOR IS RESPONSIBLE FOR LAYING OUT THE WORK AND SHALL SET THOSE STAKES NECESSARY TO CONSTRUCT THIS PROJECT. NO DIRECT PAYMENT WILL BE MADE FOR THIS WORK, UNLESS LISTED IN THE BID TAB.
- b) IN ACCORDANCE WITH PARAGRAPH 4.05 OF C-700, CONTRACTOR SHALL RESET ANY PERMANENT REFERENCE POINTS, PROPERTY CORNERS AND PROPERTY MONUMENTS THAT ARE DISTURBED DURING CONSTRUCTION. THESE POINTS AND MONUMENTS SHALL BE RESET BY A REGISTERED LAND SURVEYOR IN ACCORDANCE WITH STATE LAW. NO DIRECT PAYMENT WILL BE MADE FOR THIS WORK.

4) UNDERGROUND FACILITIES:

- a) INFORMATION REGARDING UNDERGROUND FACILITIES IS APPROXIMATE AND WAS COMPILED USING INFORMATION PROVIDED BY THE FACILITY OWNER. CONSULT PARAGRAPH 4.04 OF C-700 FOR FURTHER INFORMATION.
- b) UNLESS BORED, ALL UNDERGROUND UTILITIES (INCLUDING THE CONTRACTOR'S WORK) THAT CROSS UNDER PROPOSED STREET PAVEMENTS SHALL BE IN PLACE PRIOR TO THE PLACEMENT OF THE NEW PAVEMENT.

5) WATER, STORM & SANITARY SEWER:

- a) WATER CAN BE PURCHASED FROM THE CITY'S WATER UTILITIES DEPARTMENT.
- b) ALL MANHOLES, VALVE LIDS, METER LIDS, FIRE HYDRANTS AND AIR RELIEF ASSEMBLIES WITHIN THE CONSTRUCTION LIMITS SHALL BE RELOCATED OR ADJUSTED TO GRADE BY THE CONTRACTOR IN ACCORDANCE WITH THE SPECIFICATIONS. ALL VALVE RISERS IN PAVEMENT (WHETHER ADJUSTED, REPLACED OR PLACED) SHALL BE CAST IRON AND CONFORM TO THE SPECIFICATIONS. NO DIRECT PAYMENT WILL BE MADE FOR THIS WORK, UNLESS LISTED IN THE BID TAB.
- c) CONTRACTOR SHALL PROVIDE BYPASS PUMPING OF SEWAGE FLOWS AROUND EACH SEGMENT OF PIPE THAT IS TO BE REPLACED OR REFURBISHED. CONTRACTOR SHALL HAVE ALL MATERIALS, EQUIPMENT AND LABOR NECESSARY TO COMPLETE WORK ON THE PIPE SEGMENT PRIOR TO ISOLATING THE SEWER SEGMENT AND BEGINNING BYPASS PUMPING OPERATIONS. NO DIRECT PAYMENT WILL BE MADE FOR THIS WORK, UNLESS LISTED IN THE BID TAB.

6) ENVIRONMENTAL & SAFETY:

- a) CONTRACTOR SHALL USE ADEQUATE DUST CONTROL MEASURES DURING ALL PHASES OF THE WORK. CONSULT SECTION 1145 IN DIVISION 1.
- b) SILTATION AND EROSION CONTROL SHALL BE THE RESPONSIBILITY OF THE CONTRACTOR. CONTRACTOR SHALL BE RESPONSIBLE FOR MAINTAINING EROSION CONTROL SYSTEMS, REPLACING DAMAGED OR FAILED EROSION CONTROL DEVICES AND INSPECTING THE SITE IN ORDER TO REPAIR THE EROSION CONTROL SYSTEMS WITHIN 24 HOURS AFTER A SIGNIFICATION RAIN EVENT. GRADING ADJACENT TO PAVEMENTS SHALL BE LEFT THREE INCHES BELOW THE TOP OF PAVEMENT UNTIL IMMEDIATELY BEFORE SOD OR SEED IS PLACED. EROSION AND SEDIMENT CONTROL MUST BE IN PLACE PRIOR TO THE DISTURBANCE OF THE GROUND. FIELD ADJUSTMENTS TO EROSION AND SEDIMENT CONTROL MAY BE REQUIRED DEPENDING ON THE SITE CONDITIONS.
- c) UNLESS WAIVED IN SECTION 1010, CONTRACTOR SHALL MAINTAIN THE STORM WATER POLLUTION PREVENTION PLAN (SWPPP) ON SITE IN ACCORDANCE WITH DNR REGULATIONS.
- d) PROPERTY MAINTENANCE INFORMATION CAN BE FOUND IN SECTION 1145 OF DIVISION 1.

7) GRADING, REMOVALS & DAMAGED ITEMS:

- a) INFORMATION ON SALVAGED MATERIAL CAN BE FOUND IN SECTION 1150 OF DIVISION 1.
- b) NO BURNING IS ALLOWED ON THE SITE.
- c) DRIVEWAYS, PARKING LOTS, SIDEWALKS, FENCES, IRRIGATION SYSTEMS AND OTHER ITEMS DISTURBED OR DAMAGED BY THE CONTRACTOR SHALL BE RESTORED AT THE CONTRACTOR'S EXPENSE TO A CONDITION EQUAL TO OR BETTER THAN EXISTING BEFORE DAMAGE OCCURRED. UNLESS WAIVED BY OWNER, ALL ITEMS REQUIRING REPLACEMENT SHALL BE REPLACED WITH NEW MATERIALS, AND ALL MATERIALS ARE SUBJECT TO OWNER'S APPROVAL. NO DIRECT PAYMENT WILL BE MADE FOR THIS WORK, UNLESS LISTED IN THE BID TAB.
- d) ALL FENCE REPLACEMENT SHOULD BE RELOCATED TO THE PROPERTY LINES, UNLESS THE EXISTING FENCE WAS LOCATED INSIDE OF THE PROPERTY LINES. FENCE INSIDE OF PROPERTY LINES SHOULD BE PLACED IN ITS ORIGINAL LOCATION. GATES AND FENCE CORNERS SHALL BE RE-ESTABLISHED AT THE ORIGINAL LOCATIONS, UNLESS INDICATED BY THE DRAWINGS. REMOVALS SHALL BE AS SHOWN ON THE DRAWINGS OR AS APPROVED BY OWNER. REMOVALS NOT APPROVED BY OWNER WILL BE REPLACED AT THE CONTRACTOR'S EXPENSE.
- e) ROOF DRAINS, UNDER DRAINS, SEPTIC LINES AND OTHER SMALL DRAINAGE LINES NOT SHOWN ON THE DRAWINGS THAT ARE UNCOVERED OR DAMAGED SHALL BE REPAIRED, AND THE POINT OF DISCHARGE SHALL BE PLACED NO CLOSER THAN FIVE FEET TO ANY ADJOINING PROPERTY LINE INCLUDING THE RIGHT-OF-WAY LINE (SECTION 16-413 OF THE CODE OF ORDINANCES). UNLESS DIRECTED BY THE CITY ENGINEER, NO DRAIN LINES SHALL BE CONNECTED TO THE STORM SEWER SYSTEM. MATERIALS AND LOCATION ARE SUBJECT TO OWNER'S APPROVAL. IF NO UNIT PRICE IS IN THE BID, THEN PAYMENT WILL BE NEGOTIATED PER THE CONTRACT DOCUMENTS.
- f) MATERIALS THAT MAY BE CLASSIFIED AS UNSUITABLE OR REQUIRE UNDERGRADING SHALL BE DETERMINED BY THE OWNER OR THE OWNER'S REPRESENTATIVE. CONTRACTOR SHALL NOT MAKE THIS DETERMINATION.
- g) ALL WASTE MATERIAL SHALL BE DISPOSED OF ON SITES PROVIDED BY THE CONTRACTOR AND APPROVED BY THE ENGINEER. ALL MATERIALS SHALL BE DISPOSED OF BY THE CONTRACTOR AT HIS OWN EXPENSE. SAWCUTTING SHALL BE SUBSIDIARY TO OTHER BID ITEMS.

8) TRAFFIC:

- a) UNLESS DIRECTED IN THE CONTRACT DOCUMENTS OR DRAWINGS, CONTRACTOR SHALL MAINTAIN TRAFFIC AND PEDESTRIAN ACCESS AT ALL TIMES.
- b) APPROPRIATE TRAFFIC CONTROL DEVICES, SIGNAGE AND PAVEMENT MARKINGS SHALL BE ESTABLISHED AND MAINTAINED THROUGHOUT THE PROJECT IN ACCORDANCE WITH THE CONTRACT DOCUMENTS AND THE MUTCD.

ADDITIONAL GENERAL NOTES:

1) ALL TREES TO BE GRUBBED ARE MARKED THUS "X". SPARE ALL TREES THAT ARE MARKED DND (DO NOT DISTURB) OR ANY TREES NOT MARKED AT ALL. EXCEPTIONALLY GOOD TREES SHALL BE SPARED BY ADJUSTING BACKSLOPE LINES DURING CONSTRUCTION AS DIRECTED BY THE ENGINEER. ALL TREES WITHIN THE CONSTRUCTION LIMITS TO BE SAVED SHALL HAVE HEIR TRUNKS AND ROOT ZONE PHYSICALLY PROTECTED PRIOR TO CONSTRUCTION OPERATIONS BY METHODS APPROVED BY THE ENGINEER.

2) THE CONTRACTOR SHALL POTHOLE ALL UTILITY CROSSINGS PRIOR TO CONSTRUCTION OF ANY PORTION OF THE STORM SEWER, UNDERDRAINS, CONDUIT, AND ANY OTHER SUBSURFACE ELEMENTS OF THE PROJECT. THIS SURVEY INFORMATION SHALL BE FORWARDED TO THE ENGINEER FOR REVIEW. THE CONTRACTOR SHALL NOT BEGIN CONSTRUCTION ON ANY SUBSURFACE ELEMENT ON THE PROJECT WITHOUT THE APPROVAL OF THE ENGINEER. THIS ITEM SHALL BE SUBSIDIARY TO OTHER BID ITEMS.

3) THE CONTRACTOR SHALL CONTACT THE CITY'S DEVELOPMENT SERVICES ENGINEERING INSPECTION TO SCHEDULE A PRE-CONSTRUCTION MEETING WITH A FIELD ENGINEERING INSPECTOR PRIOR TO ANY LAND DISTURBANCE WORK AT (816)969-1200.

olsson

Olsson Engineering - MO State Certificate of Authority #001592
7301 West 133rd Street, Suite 200
Overland Park, KS 66213-4750
TEL 913.381.1170
FAX 913.381.1174
www.olsson.com

RECORD
DRAWINGS

RYAN B. FLEMING
MO. NO. PE-2002003161

REV. NO.	DATE	REVISONS DESCRIPTION	BY					
1	11/16/2021	CITY COMMENTS	ARJ					

REVISIONS

GENERAL NOTES


SCANNELL DEVELOPMENT LEE'S SUMMIT LOGISTICS
NORTHWEST CORNER OF TUDOR ROAD AND MAIN STREET

LEE'S SUMMIT, MISSOURI

2021



C.O.A. NO.: _____
DRAWN BY: _____ ARJ/AMW
CHECKED BY: _____ XXX
APPROVED BY: _____ RBE
QA/QC BY: _____ RBE
PROJECT NO.: 021-04157
DWG NO.: T_GEN01_02104157
DATE: 2021-10-12

DWG: F:\2021\
DATE: Oct 30,

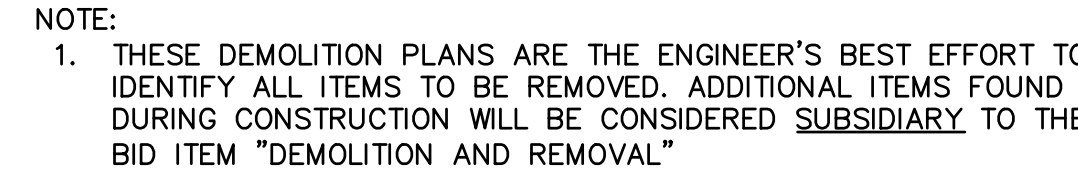

SCANNELL D NORTHWEST CO LEE'S SUMMIT, MISSOURI	C.O.A. NO.:	
	DRAWN BY:	ARJ/AMW
	CHECKED BY:	XXX
	APPROVED BY:	RBE
	QA/QC BY:	RBE
	PROJECT NO.:	021-04157
DWG NO.:	T_DEMO1_02104157	
DATE:	2021-10-12	


DWG: F:\2021\04001-04500\021-04157\40-Design\AutoCAD\Final Plans\Sheets\ROBR\T_DEM01_02104157.dwg
DATE: Oct 30, 2023 3:46pm
XREFS: T_PBASE_02104157 T_PPAT1_02104157 V_XB01_02104157
USER: asaoavedra
T_PTBLK_02104157 C_PROW_02104157
V_XTOPO_02104157

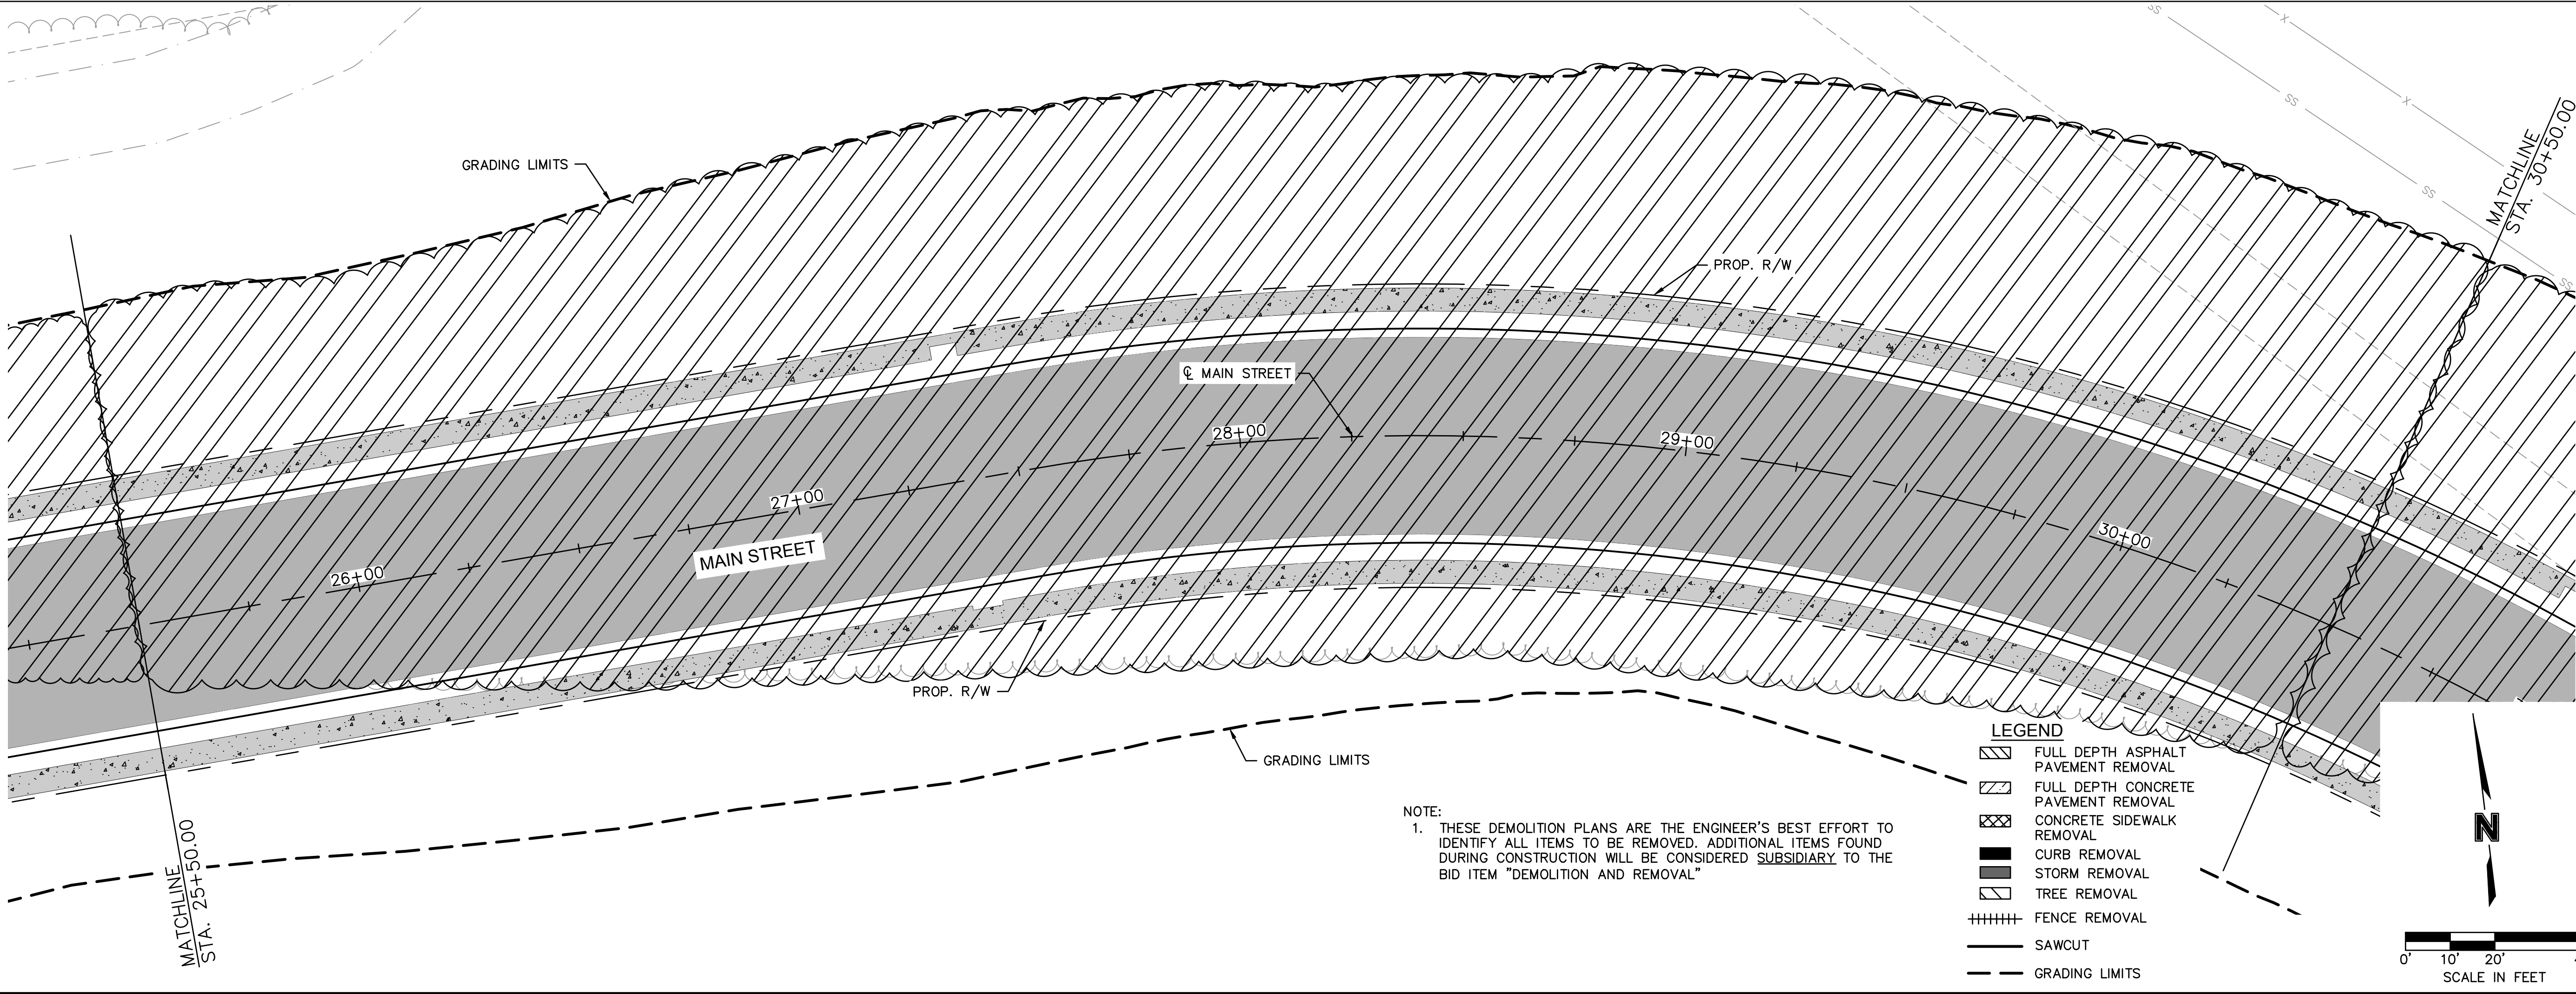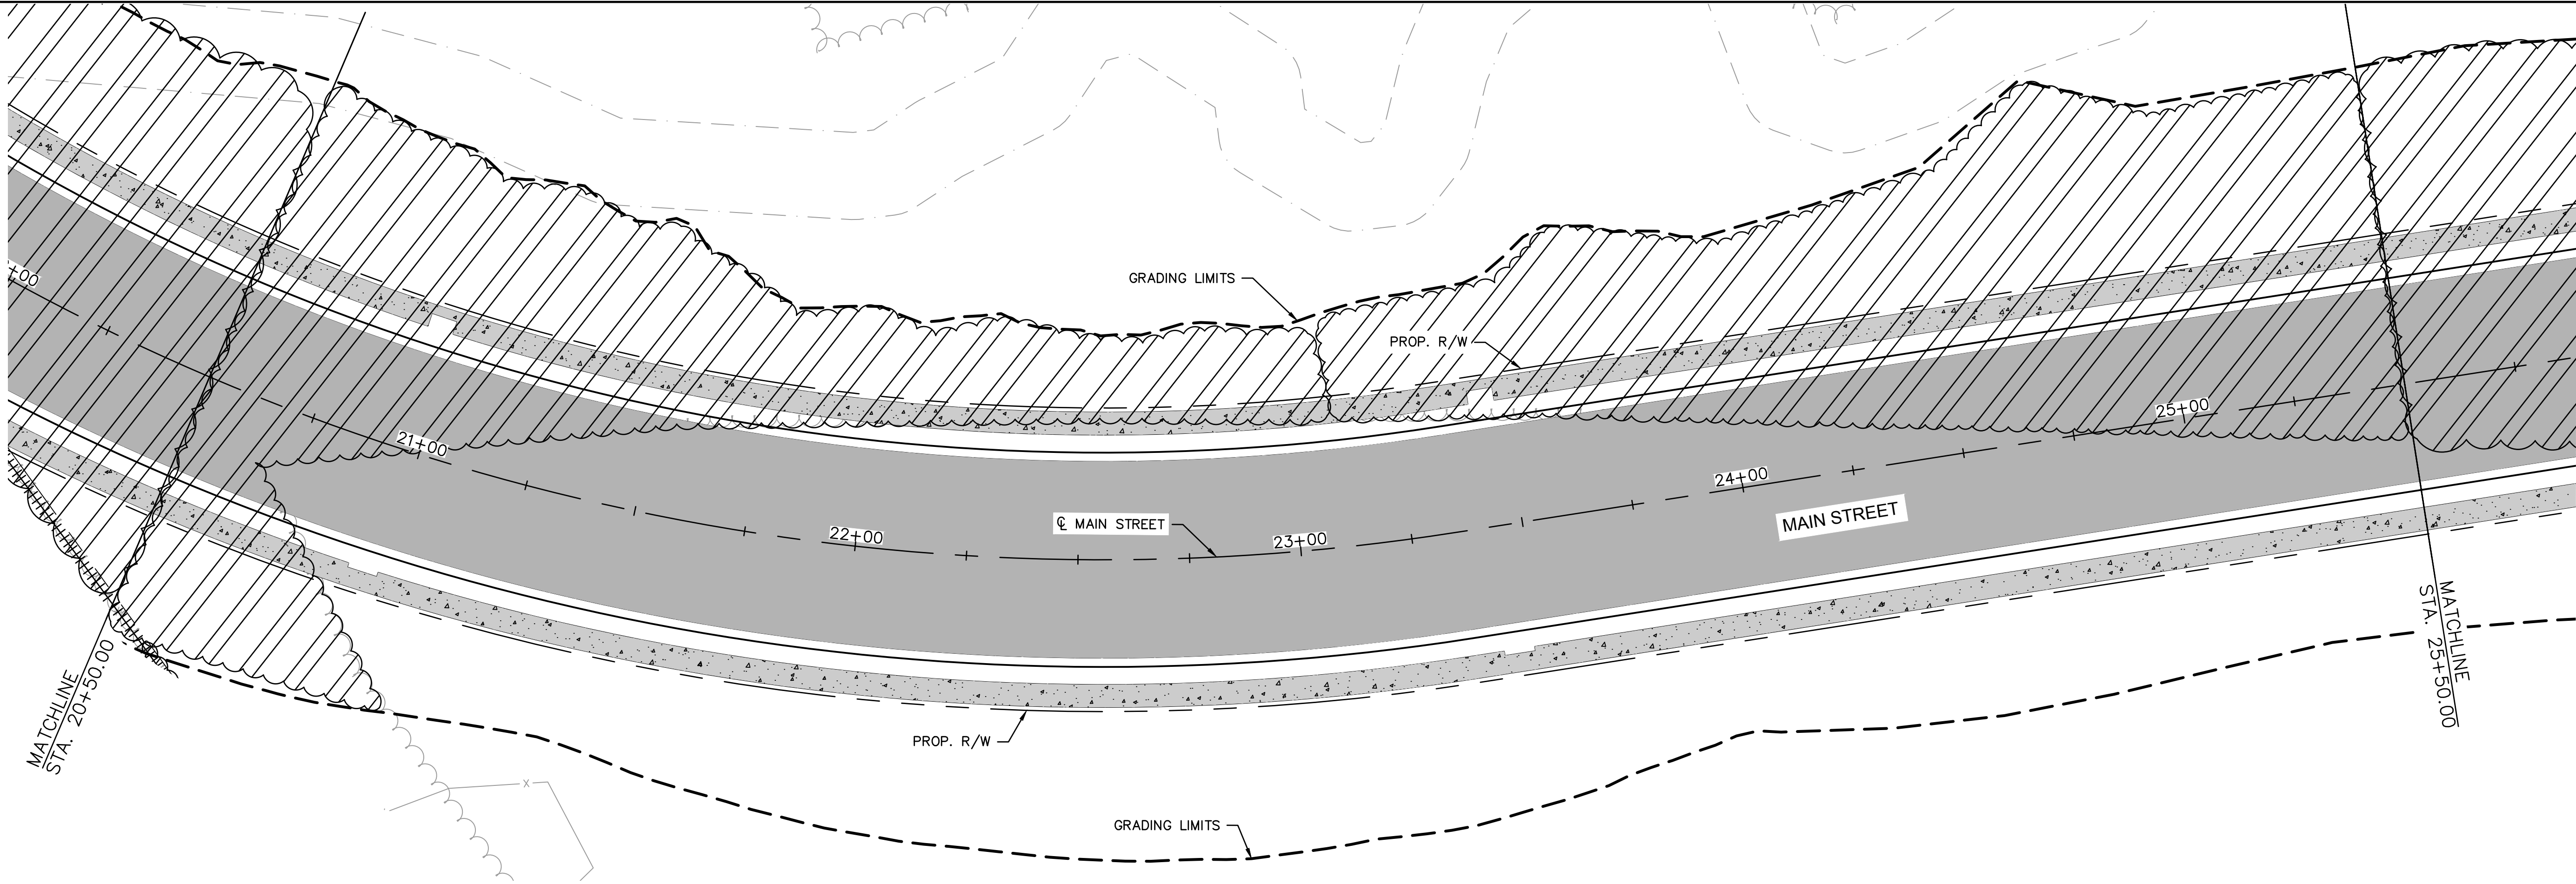

NOTE:
1. THESE DEMOLITION PLANS ARE THE ENGINEER'S BEST EFFORT TO IDENTIFY ALL ITEMS TO BE REMOVED. ADDITIONAL ITEMS FOUND DURING CONSTRUCTION WILL BE CONSIDERED SUBSIDIARY TO THE BID ITEM "DEMOLITION AND REMOVAL"

LEGEND

- FULL DEPTH ASPHALT PAVEMENT REMOVAL
- FULL DEPTH CONCRETE PAVEMENT REMOVAL
- CONCRETE SIDEWALK REMOVAL
- CURB REMOVAL
- STORM REMOVAL
- TREE REMOVAL
- FENCE REMOVAL
- SAWCUT
- GRADING LIMITS

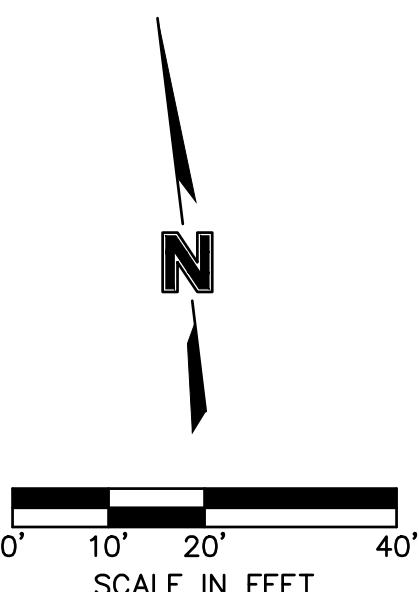

Olsson Engineering - MO State Certificate of Authority #001592
7301 West 133rd Street, Suite 200 TEL 913.381.1170
Overland Park, KS 66213-4750 FAX 913.381.1174 www.olson.com

RECORD DRAWINGS

RYAN B. FLEMING
MO. NO. PE-2002003161

REV. NO.	DATE	REVISIONS DESCRIPTION	BY

REVISIONS

DEMOLITION & REMOVALS
MAIN STREET

SCANNELL DEVELOPMENT LEE'S SUMMIT LOGISTICS
NORTHWEST CORNER OF TUDOR ROAD AND MAIN STREET


LEE'S SUMMIT, MISSOURI

2021

C.O.A. NO.:
DRAWN BY: ARJ/AMW
CHECKED BY: XXX
APPROVED BY: RBE
QA/QC BY: RBE
PROJECT NO.: 021-04157
DWG NO.: T_DEM01_02104157
DATE: 2021-10-12


SHEET
9 OF 105

DWG: F:\2021\04001-04500\021-04157\40-Design\AutoCAD\Final Plans\Sheets\ROBR\T_DEM01_02104157.dwg
DATE: Oct 30, 2023 3:46pm
XREFS: T_PBASE_02104157 T_PPAT_02104157 V_XBOL_02104157
USER: asoavedra
T_PTBLK_02104157
C_PROW_02104157

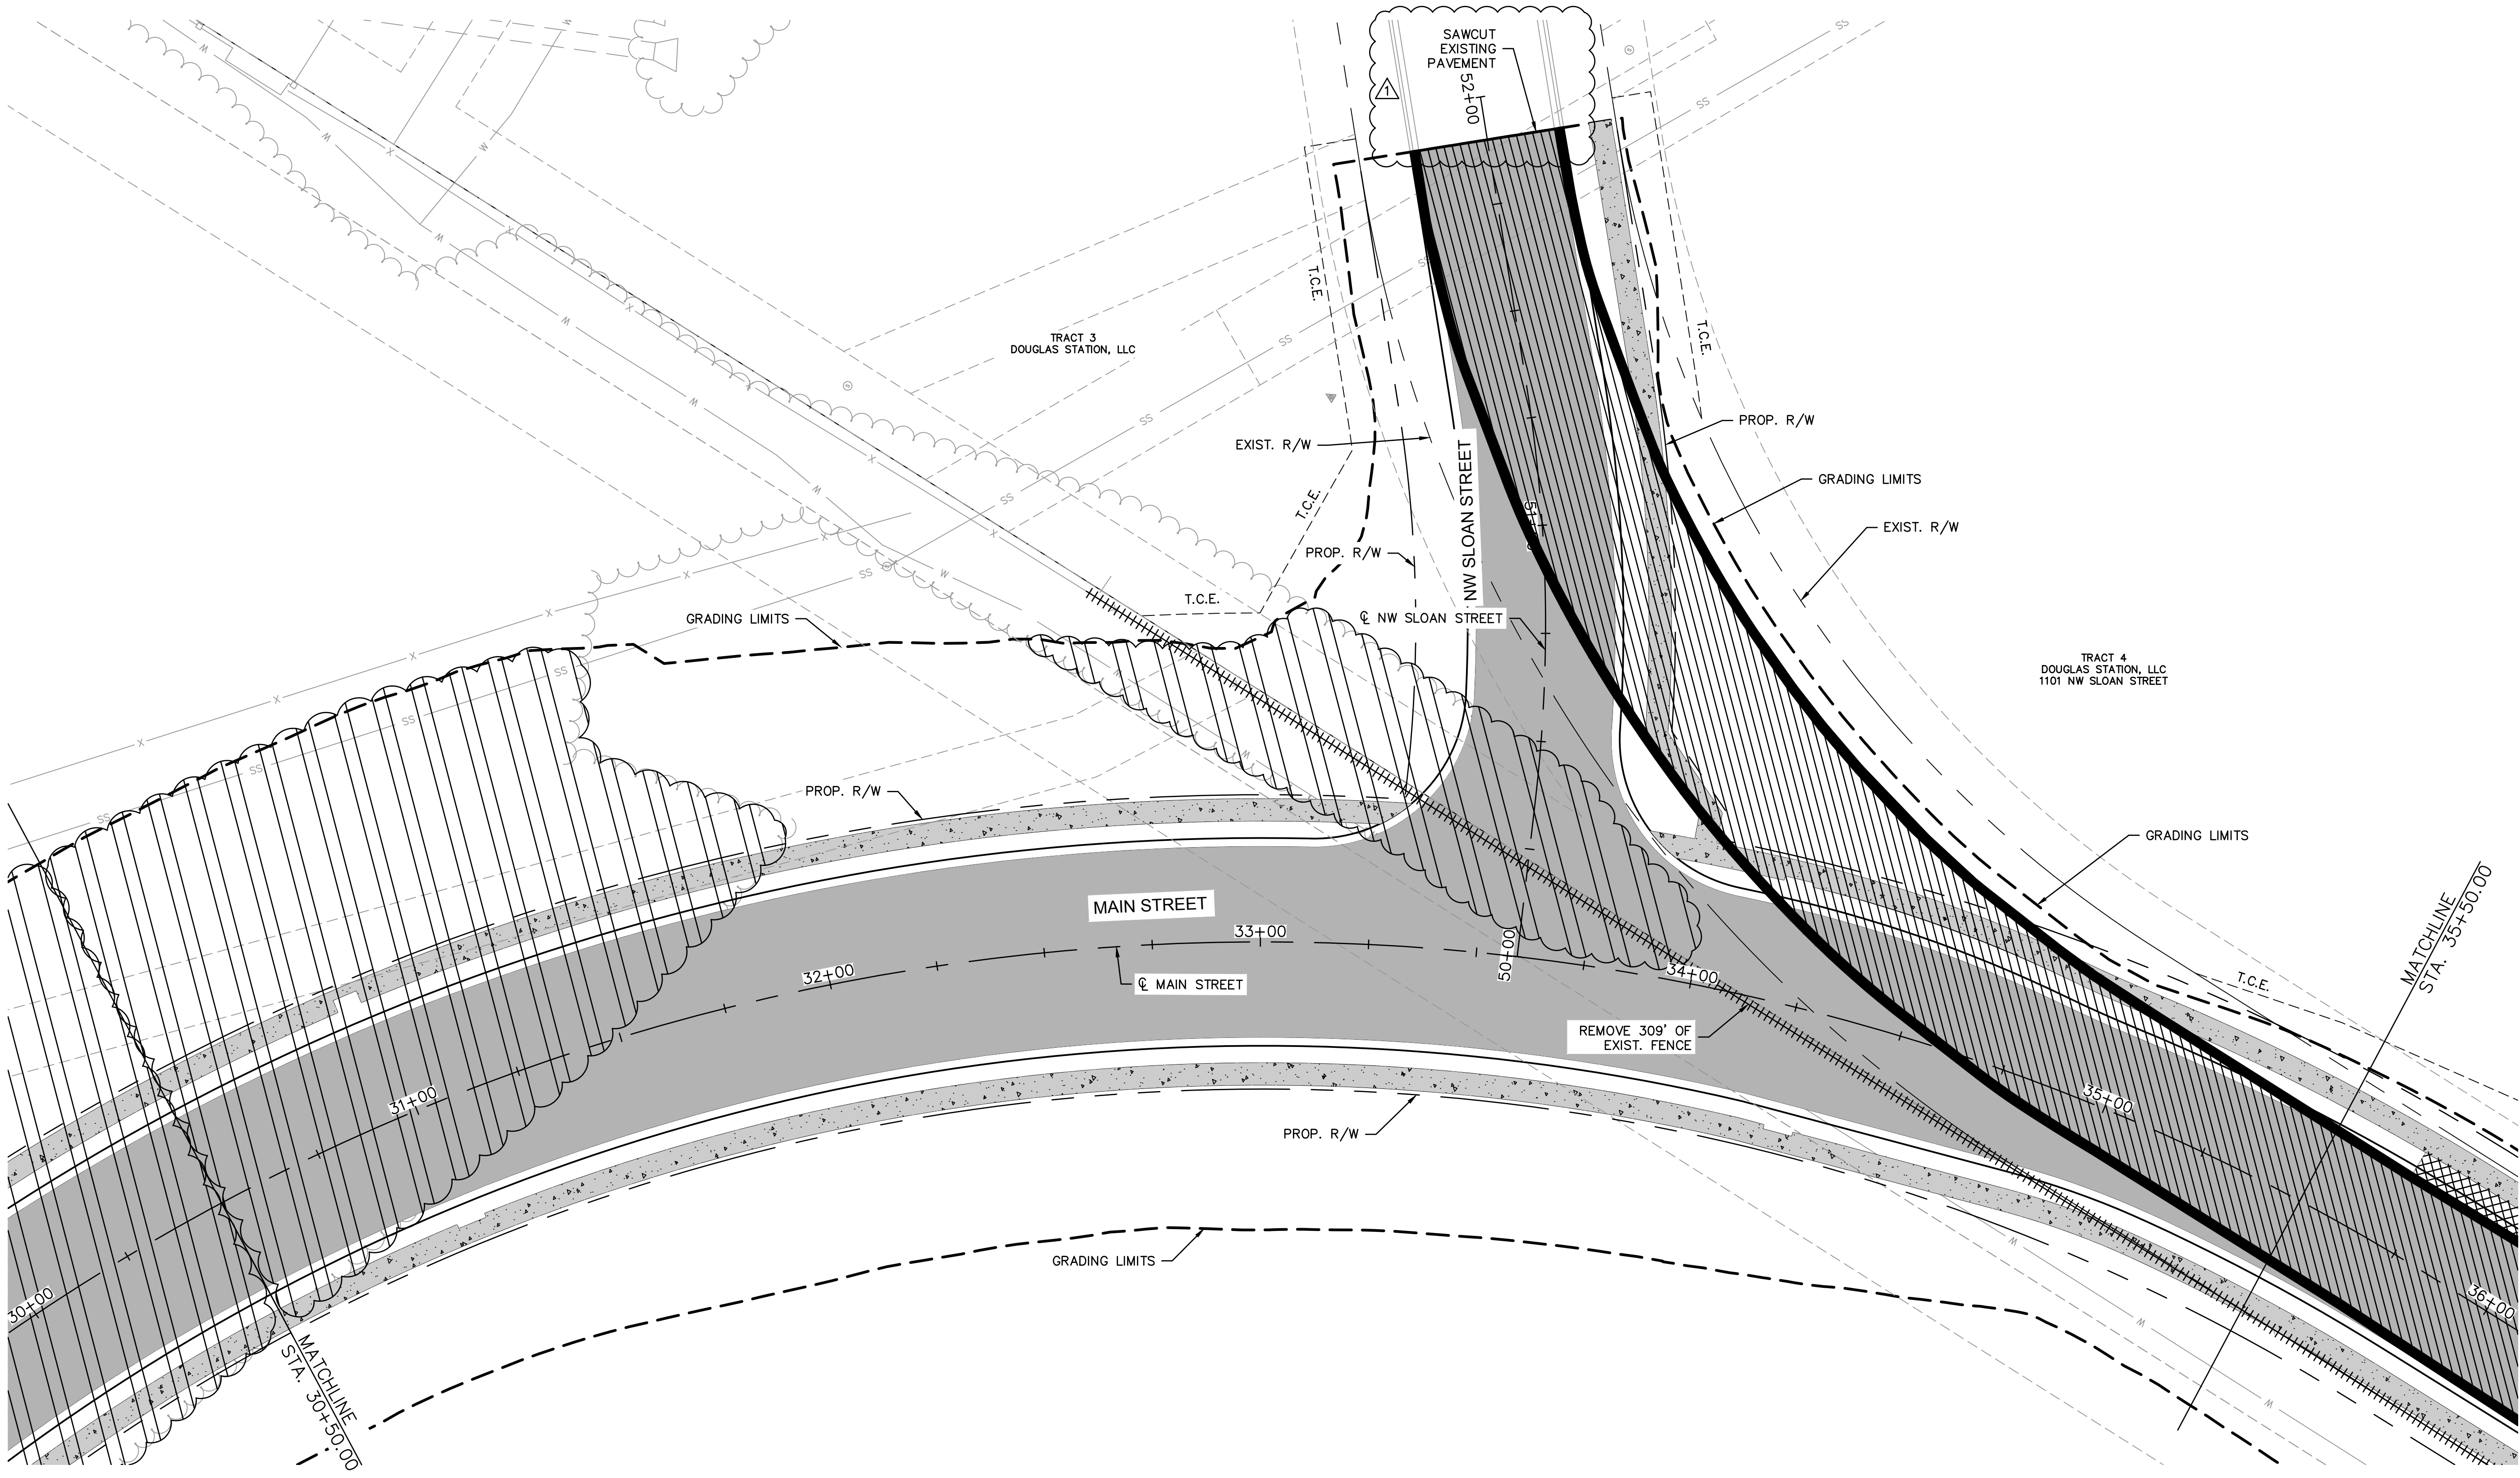

NOTE:
1. THESE DEMOLITION PLANS ARE THE ENGINEER'S BEST EFFORT TO IDENTIFY ALL ITEMS TO BE REMOVED. ADDITIONAL ITEMS FOUND DURING CONSTRUCTION WILL BE CONSIDERED SUBSIDIARY TO THE BID ITEM "DEMOLITION AND REMOVAL"

- LEGEND**
- FULL DEPTH ASPHALT PAVEMENT REMOVAL
 - FULL DEPTH CONCRETE PAVEMENT REMOVAL
 - CONCRETE SIDEWALK REMOVAL
 - CURB REMOVAL
 - STORM REMOVAL
 - TREE REMOVAL
 - FENCE REMOVAL
 - SAWCUT
 - GRADING LIMITS

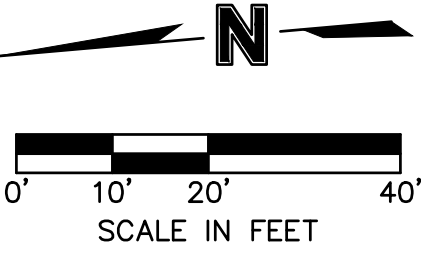

Olsson Engineering - MO State Certificate of Authority #001592
7301 West 133rd Street, Suite 200
Overland Park, KS 66213-4750
TEL 913.381.1170
FAX 913.381.1174
www.olson.com

RECORD DRAWINGS

RYAN B. FLEMING
MO. NO. PE-2002003161

REV. NO.	DATE	REVISIONS DESCRIPTION	CITY COMMENTS
1	11/16/2021		

REVISIONS

DEMOLITION & REMOVALS
MAIN STREET & NW SLOAN STREET

SCANNELL DEVELOPMENT LEE'S SUMMIT LOGISTICS
NORTHWEST CORNER OF TUDOR ROAD AND MAIN STREET


LEE'S SUMMIT, MISSOURI

2021

C.O.A. NO.:
DRAWN BY: ARJ/AMW
CHECKED BY: XXX
APPROVED BY: RBE
QA/QC BY: RBE
PROJECT NO.: 021-04157
DWG NO.: T_DEM01_02104157
DATE: 2021-10-12

SHEET
10 OF 105


C_PROW_02104157

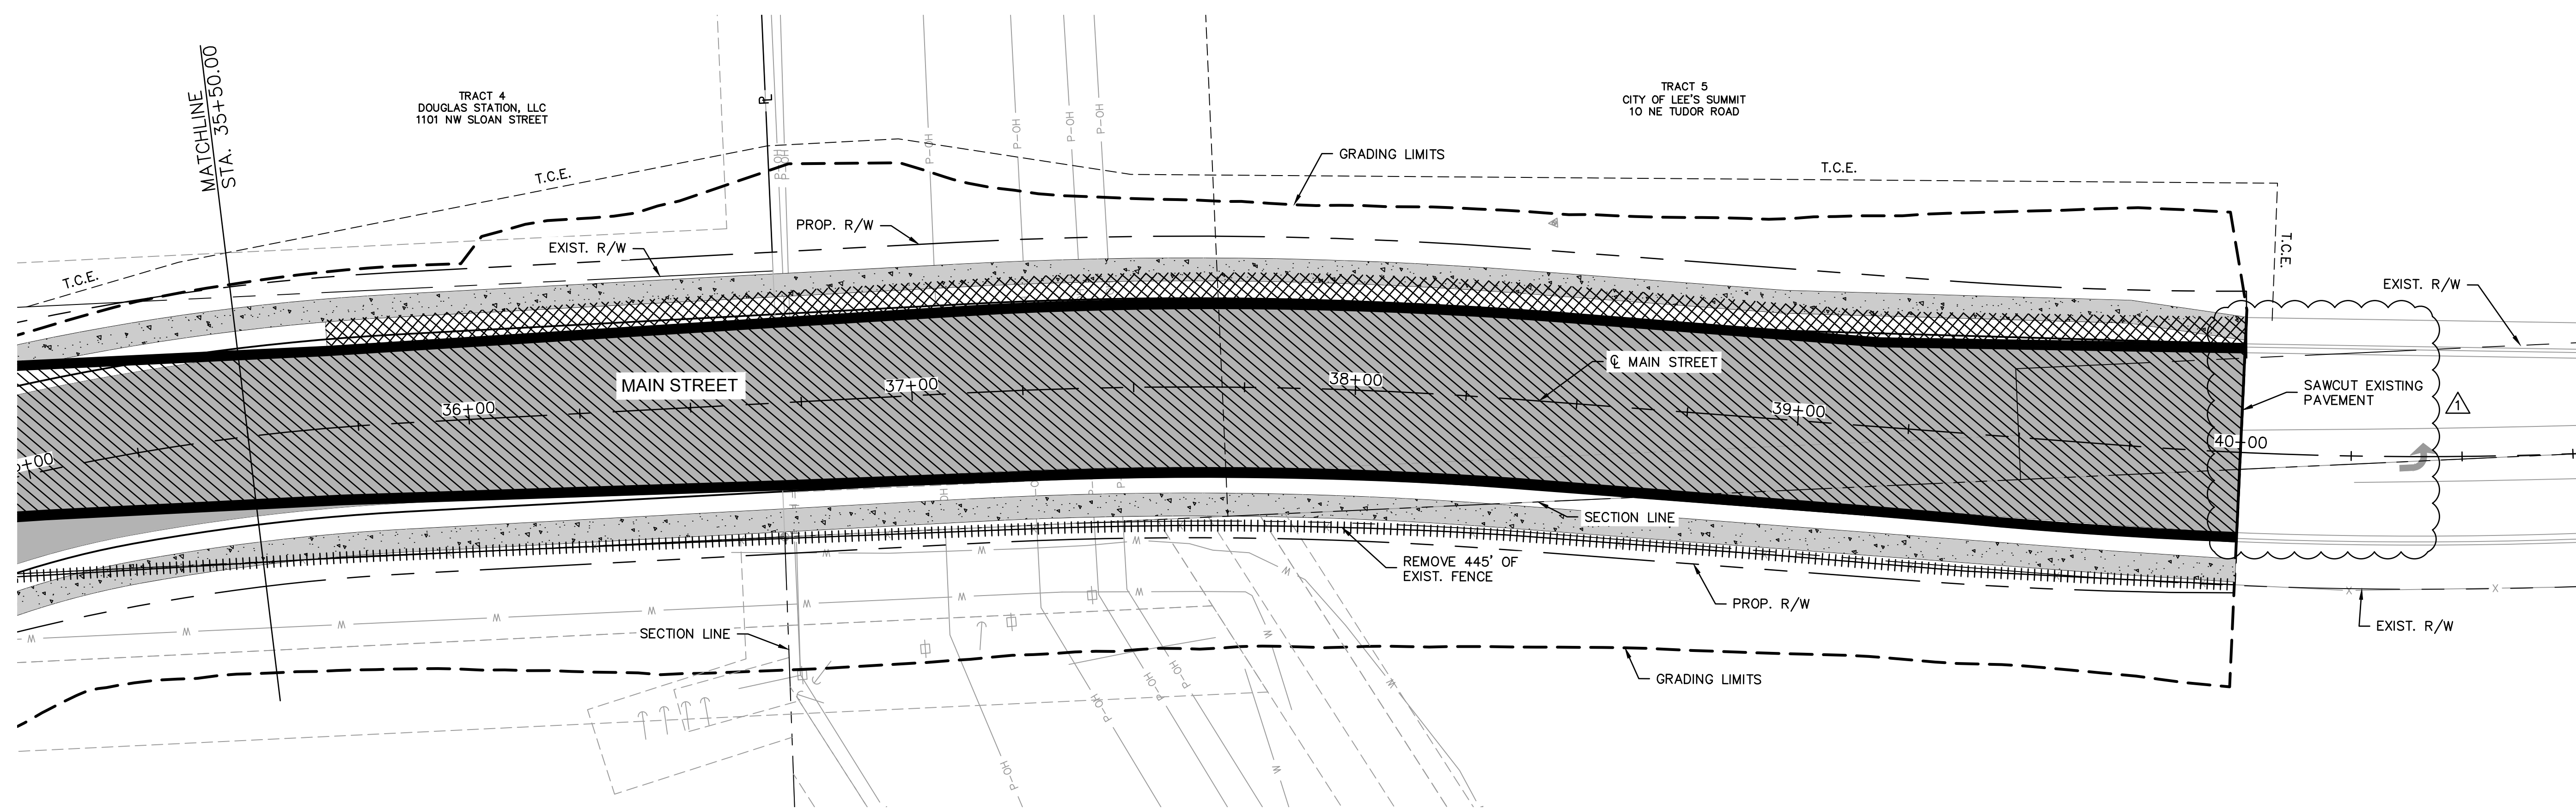

NOTE:

1. THESE DEMOLITION PLANS ARE THE ENGINEER'S BEST EFFORT TO IDENTIFY ALL ITEMS TO BE REMOVED. ADDITIONAL ITEMS FOUND DURING CONSTRUCTION WILL BE CONSIDERED SUBSIDIARY TO THE BID ITEM "DEMOLITION AND REMOVAL"

- LEGEND**
- | | |
|---|--------------------------------------|
|  | FULL DEPTH ASPHALT PAVEMENT REMOVAL |
|  | FULL DEPTH CONCRETE PAVEMENT REMOVAL |
|  | CONCRETE SIDEWALK REMOVAL |
|  | CURB REMOVAL |
|  | STORM REMOVAL |
|  | TREE REMOVAL |
|  | FENCE REMOVAL |
|  | SAWCUT |
|  | GRADING LIMITS |

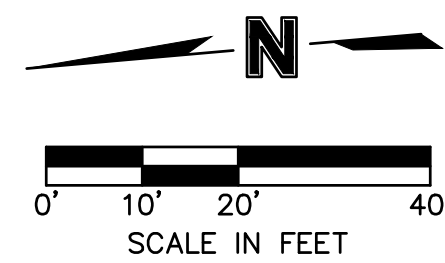

DEMOLITION & REMOVALS
MAIN STREET

SCANNELL DEVELOPMENT LEE'S SUMMIT LOGISTICS
NORTHWEST CORNER OF TUDOR ROAD AND MAIN STREET

LEE'S SUMMIT, MISSOURI

RYAN B. FLEMING
MO. NO. PE-2002003161

[illegible]

REVISIONS



RECORD
DRAWINGS

olsson

Olsson Engineering - MO State Certificate of Authority #001592
7301 West 133rd Street, Suite 200 TEL 913.381.1170
Overland Park, KS 66213-4750 FAX 913.381.1174 www.olsson.com

C.O.A. NO.: _____
 DRAWN BY: _____ ARJJ/AMV
 CHECKED BY: _____ XXJ
 APPROVED BY: _____ RBJ
 QA/QC BY: _____ RBJ
 PROJECT NO.: _____ 021-0415
 DWG NO.: T_DEM01_0210415
 DATE: _____ 2021-10-12

SHEET
11 OF 105

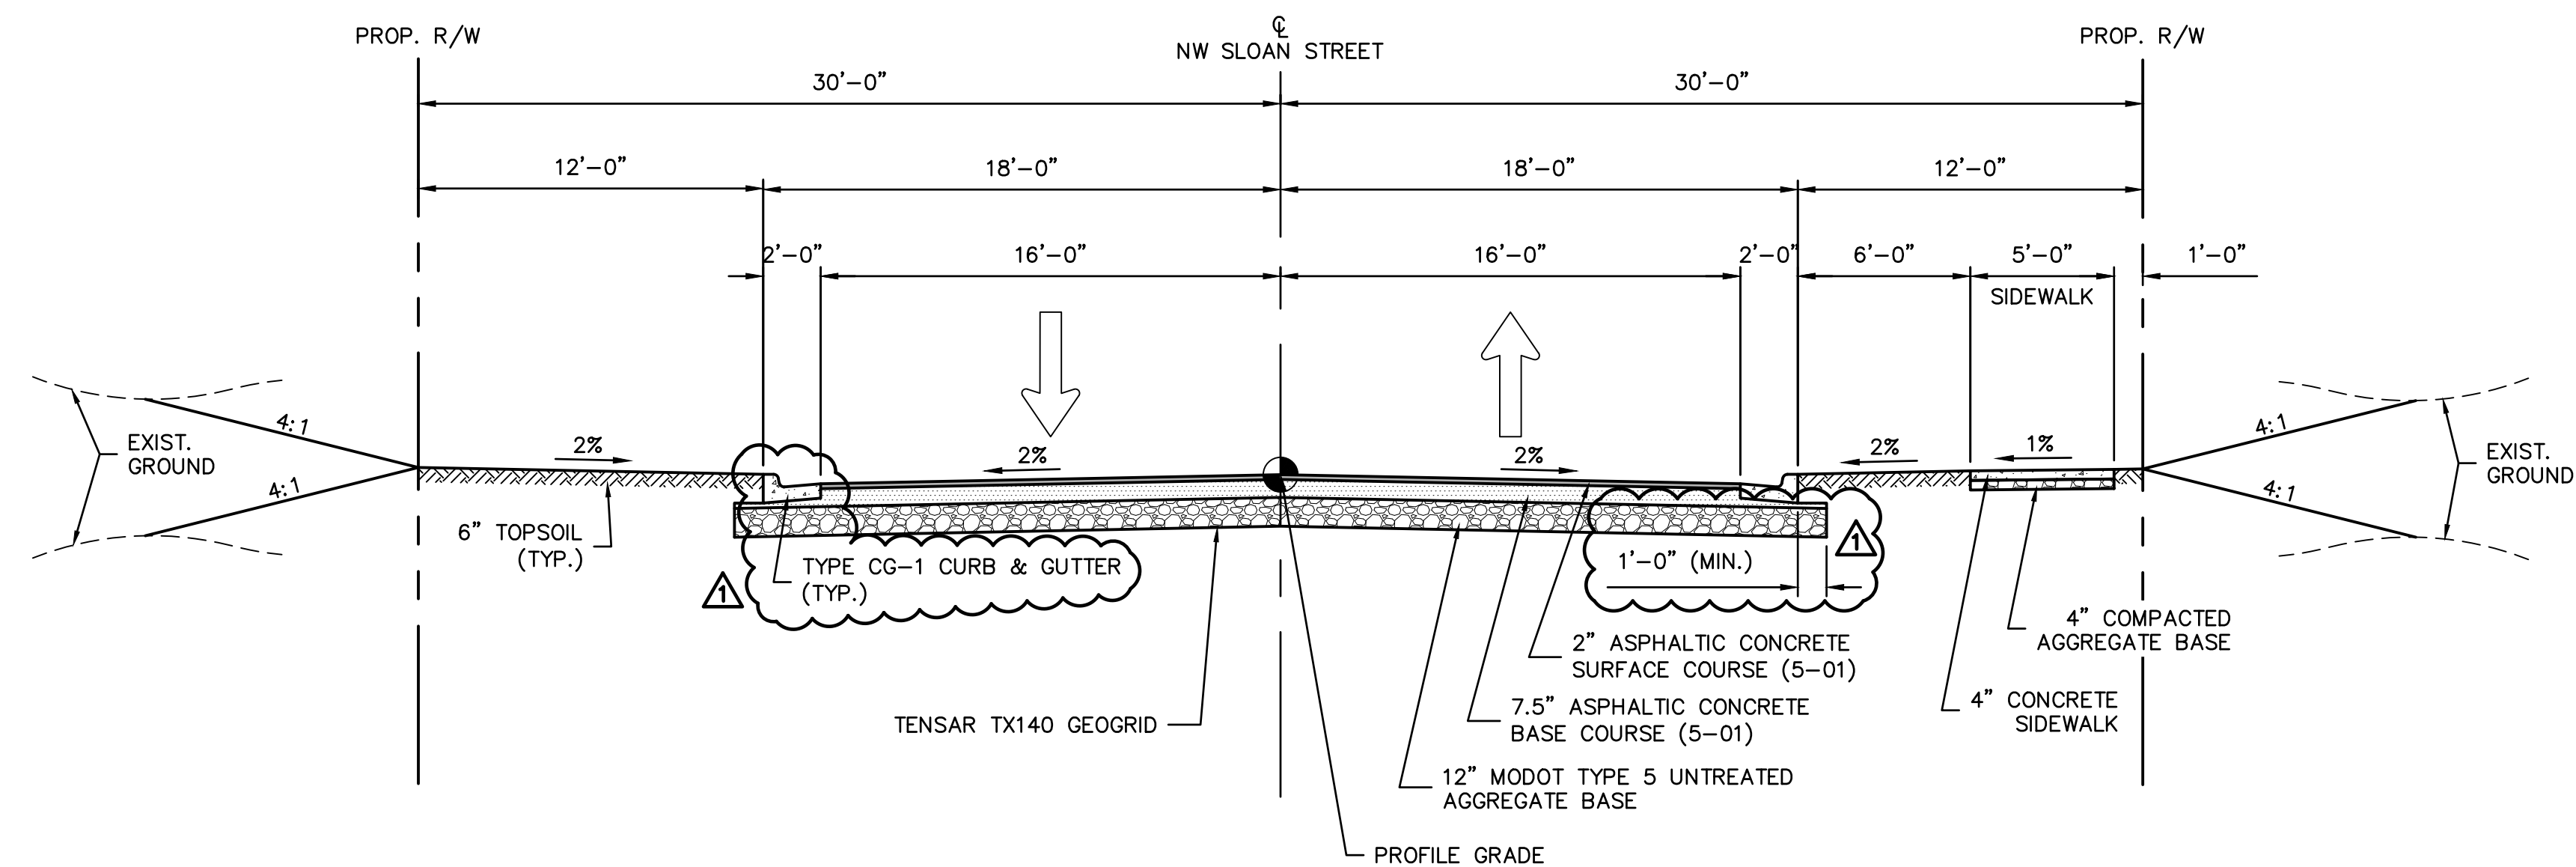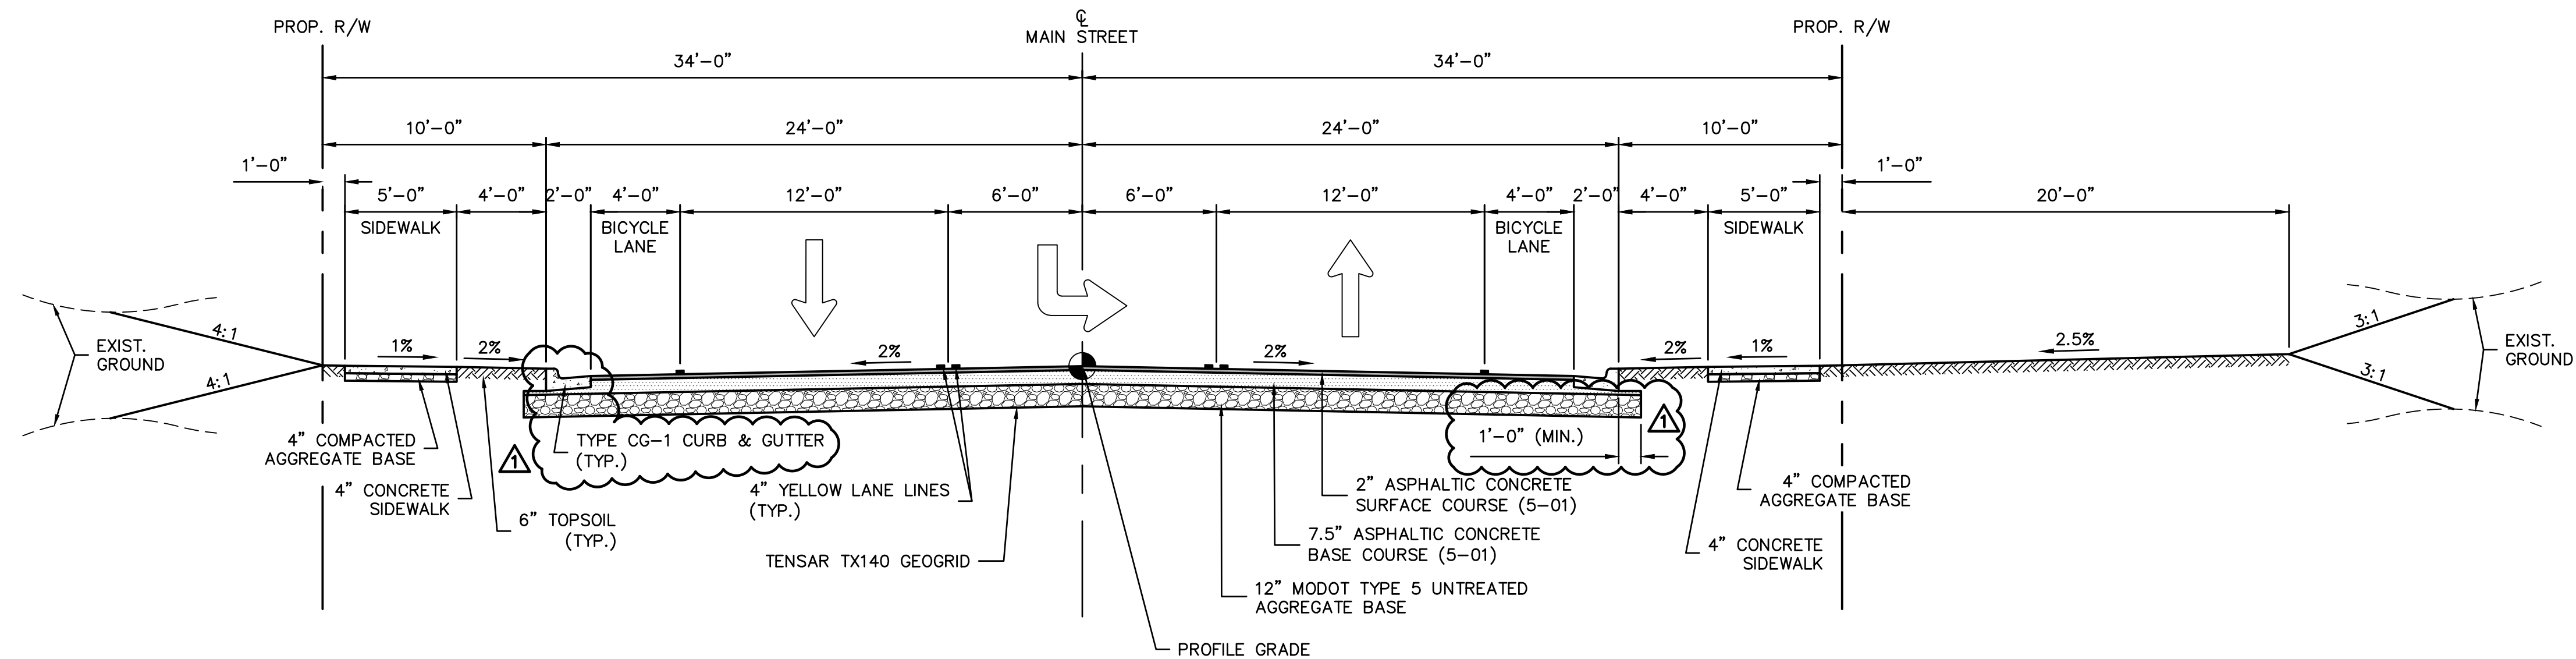

DWG: F:\2021\04001-04500\021-04157\40-Design\AutoCAD\Final Plans\Sheets\ROBR\I_TYP_02104157.dwg
DATE: Oct 30, 2023 3:47pm XREFS: T_PTBK_02104157 USER: asaravedra

olson

Olsson Engineering - MO State Certificate of Authority #001592
7301 West 133rd Street, Suite 200 TEL 913.381.1170
Overland Park, KS 66213-4750 FAX 913.381.1174 www.olsson.com

RECORD
DRAWINGS

RYAN B. FLEMING
MO. NO. PE-2002003161


[illegible]

TYPICAL SECTIONS

SCANNELL DEVELOPMENT LEE'S SUMMIT LOGISTICS NORTHWEST CORNER OF TUDOR ROAD AND MAIN STREET	201
LEE'S SUMMIT, MISSOURI	

C.O.A. NO.: _____
DRAWN BY: _____ ARJ/AMW
CHECKED BY: _____ XXX
APPROVED BY: _____ RBF
QA/QC BY: _____ RBF
PROJECT NO.: _____ 021-04157
DWG NO.: _____ T_TYP 02104157
DATE: _____ 2021-10-12

SHEET
14 OF 105

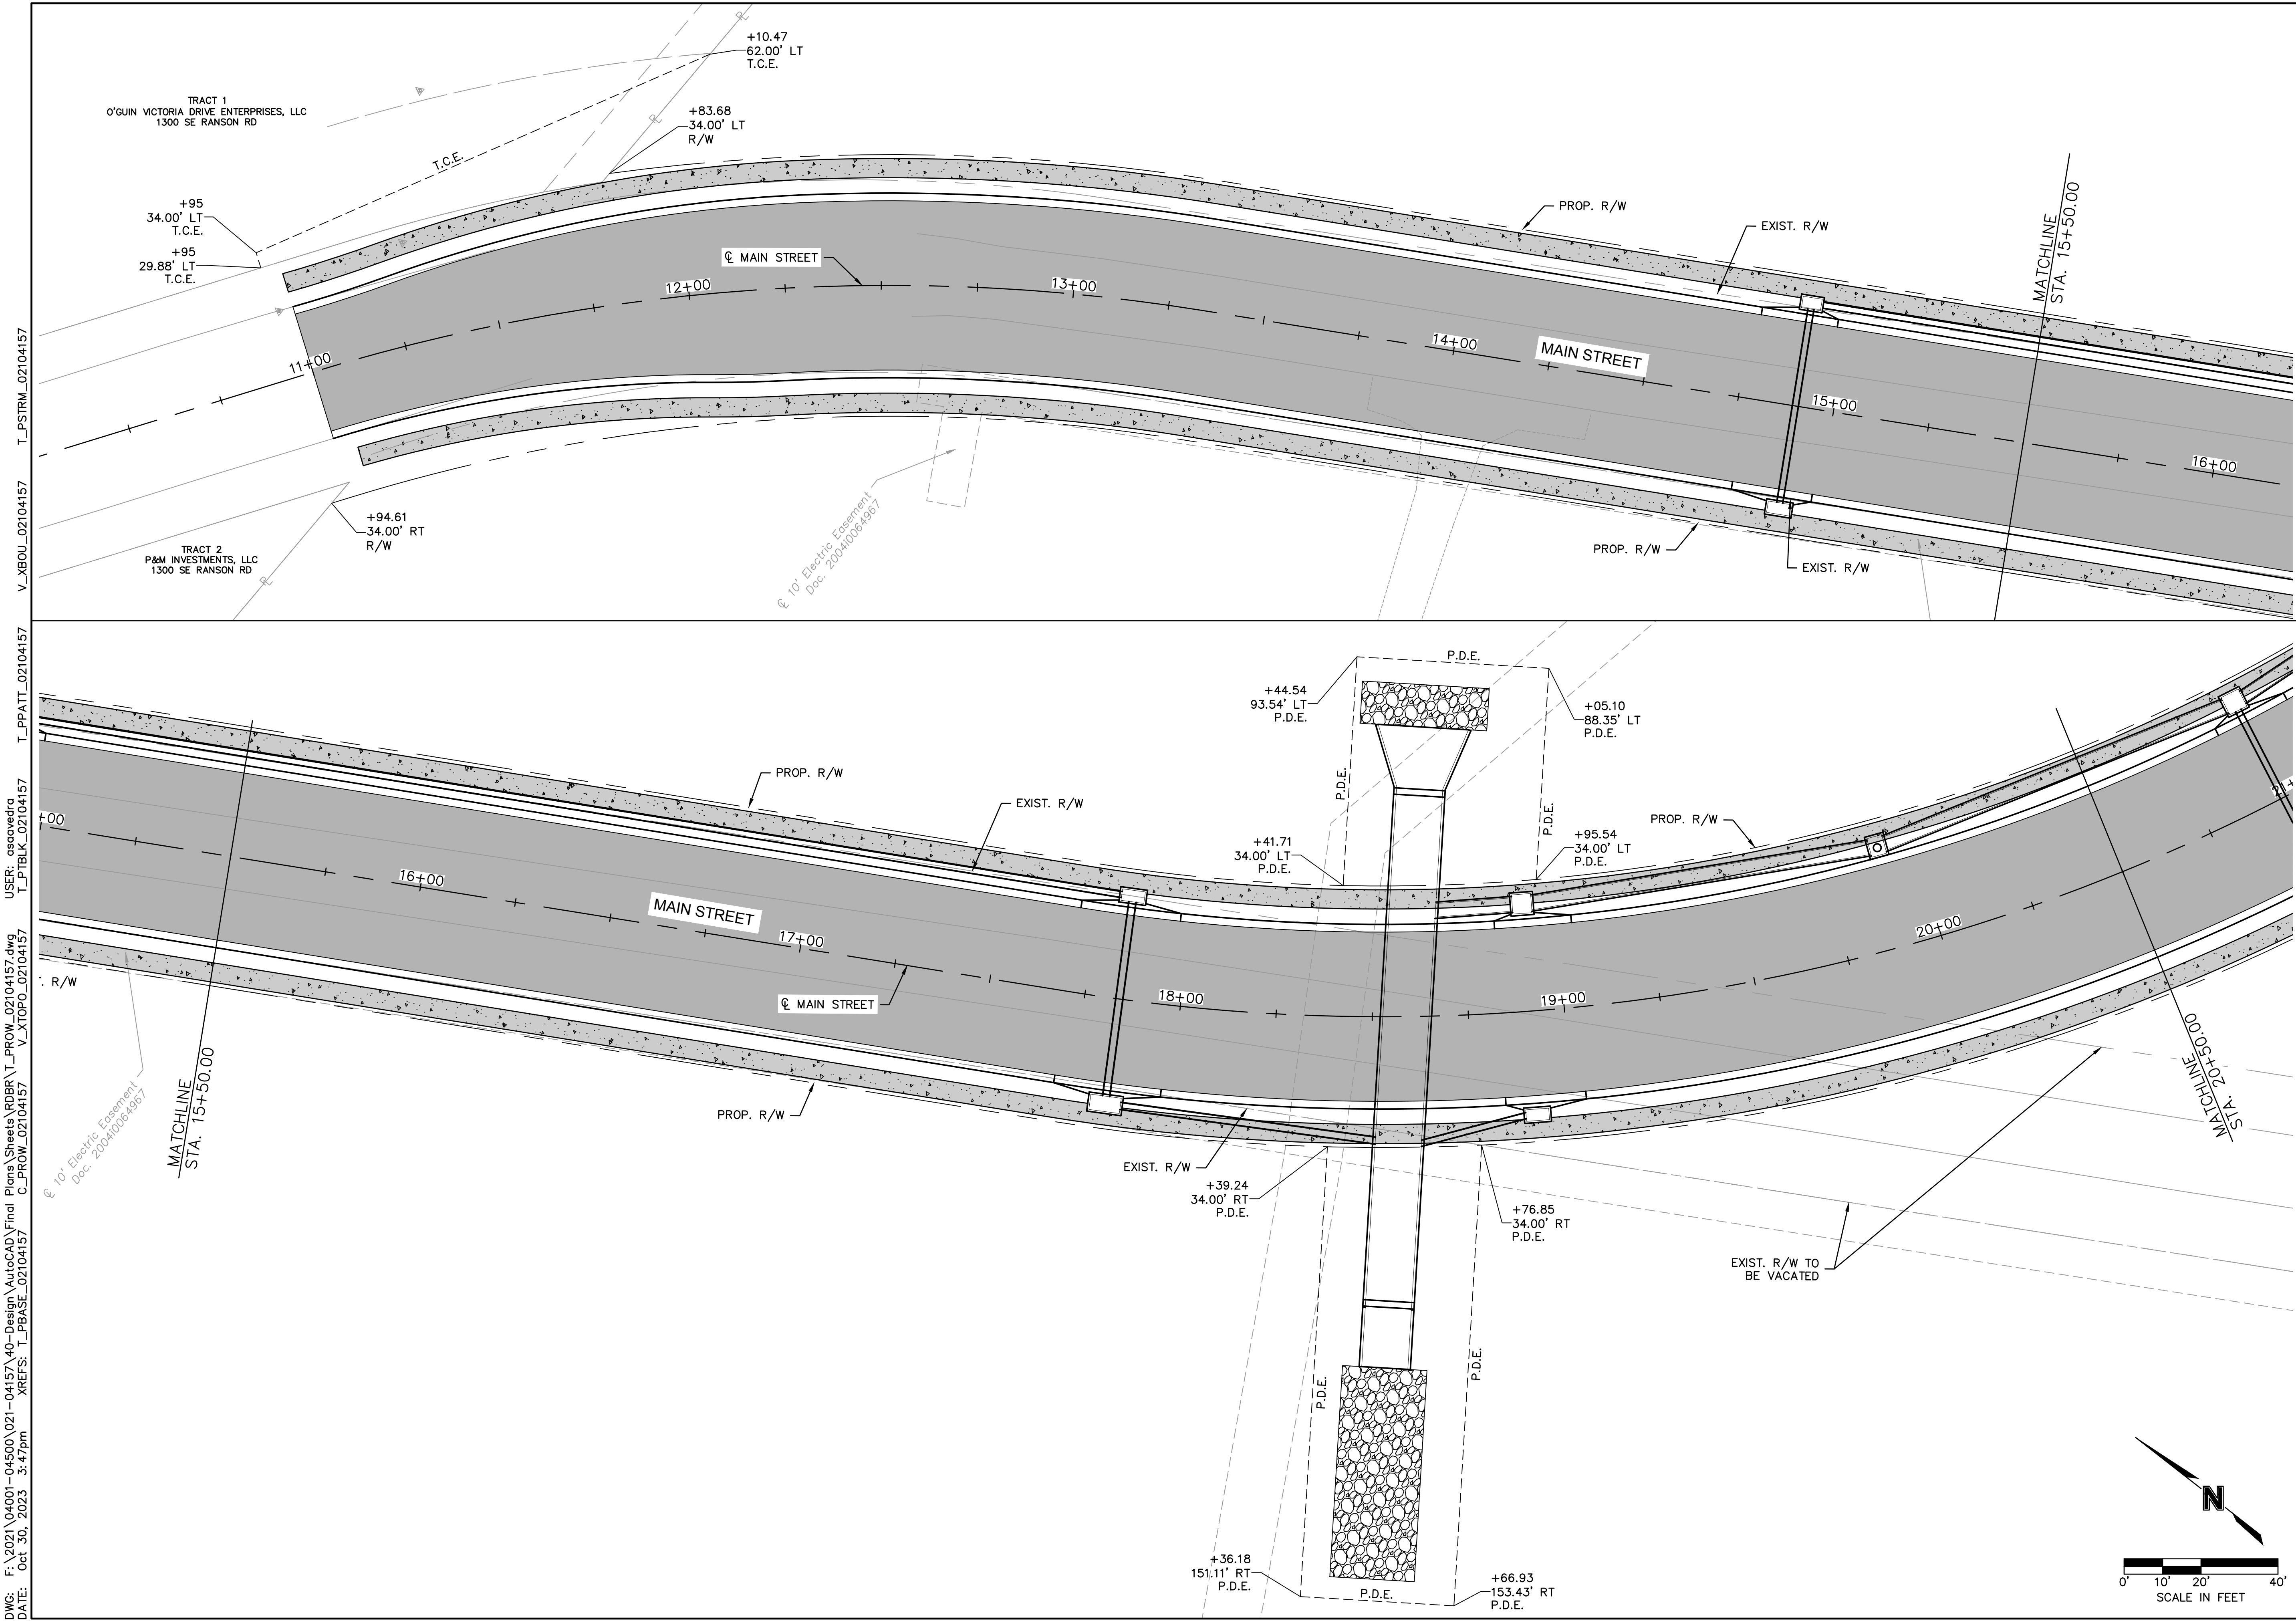

DWG: F:\2021\04001-04500\021-04157\40-Design\AutoCAD\Final Plans\Sheets\ROBR\T_PROW_02104157.dwg
DATE: Oct 30, 2023 3:47pm
XREFS: T_PBASE_02104157 V_XTOP_02104157 T_PBLK_02104157 T_PPATT_02104157 V_XBOU_02104157 T_PSTRM_02104157
USER: oscavedra

Olsson Engineering - MO State Certificate of Authority #001592
7301 West 133rd Street, Suite 200 TEL 913.381.1170
Overland Park, KS 66213-4750 FAX 913.381.1174 www.olson.com

RECORD DRAWINGS

RYAN B. FLEMING
MO. NO. PE-2002003161

REV. NO.	DATE	REVISIONS DESCRIPTION	BY

RIGHT OF WAY PLANS
MAIN STREET


SCANNELL DEVELOPMENT LEE'S SUMMIT LOGISTICS
NORTHWEST CORNER OF TUDOR ROAD AND MAIN STREET

LEE'S SUMMIT, MISSOURI

C.O.A. NO.:
DRAWN BY: ARJ/AMW
CHECKED BY: XXX
APPROVED BY: RBE
QA/QC BY: RBE
PROJECT NO.: 021-04157
DWG NO.: T_PROW_02104157
DATE: 2021-10-12

SHEET
15 OF 105

DWG: F:\2021\04001-04500\021-04157\40-Design\AutoCAD\Final Plans\Sheets\ROBR\T_PROW_02104157.dwg
DATE: Oct 30, 2023 3:47pm XREFS: T_PBASE_02104157 C_PROW_02104157 V_XTOP_02104157 T_PATT_02104157 V_XBOU_02104157 T_PSTRM_02104157
USER: asoavedra T_PBLK_02104157

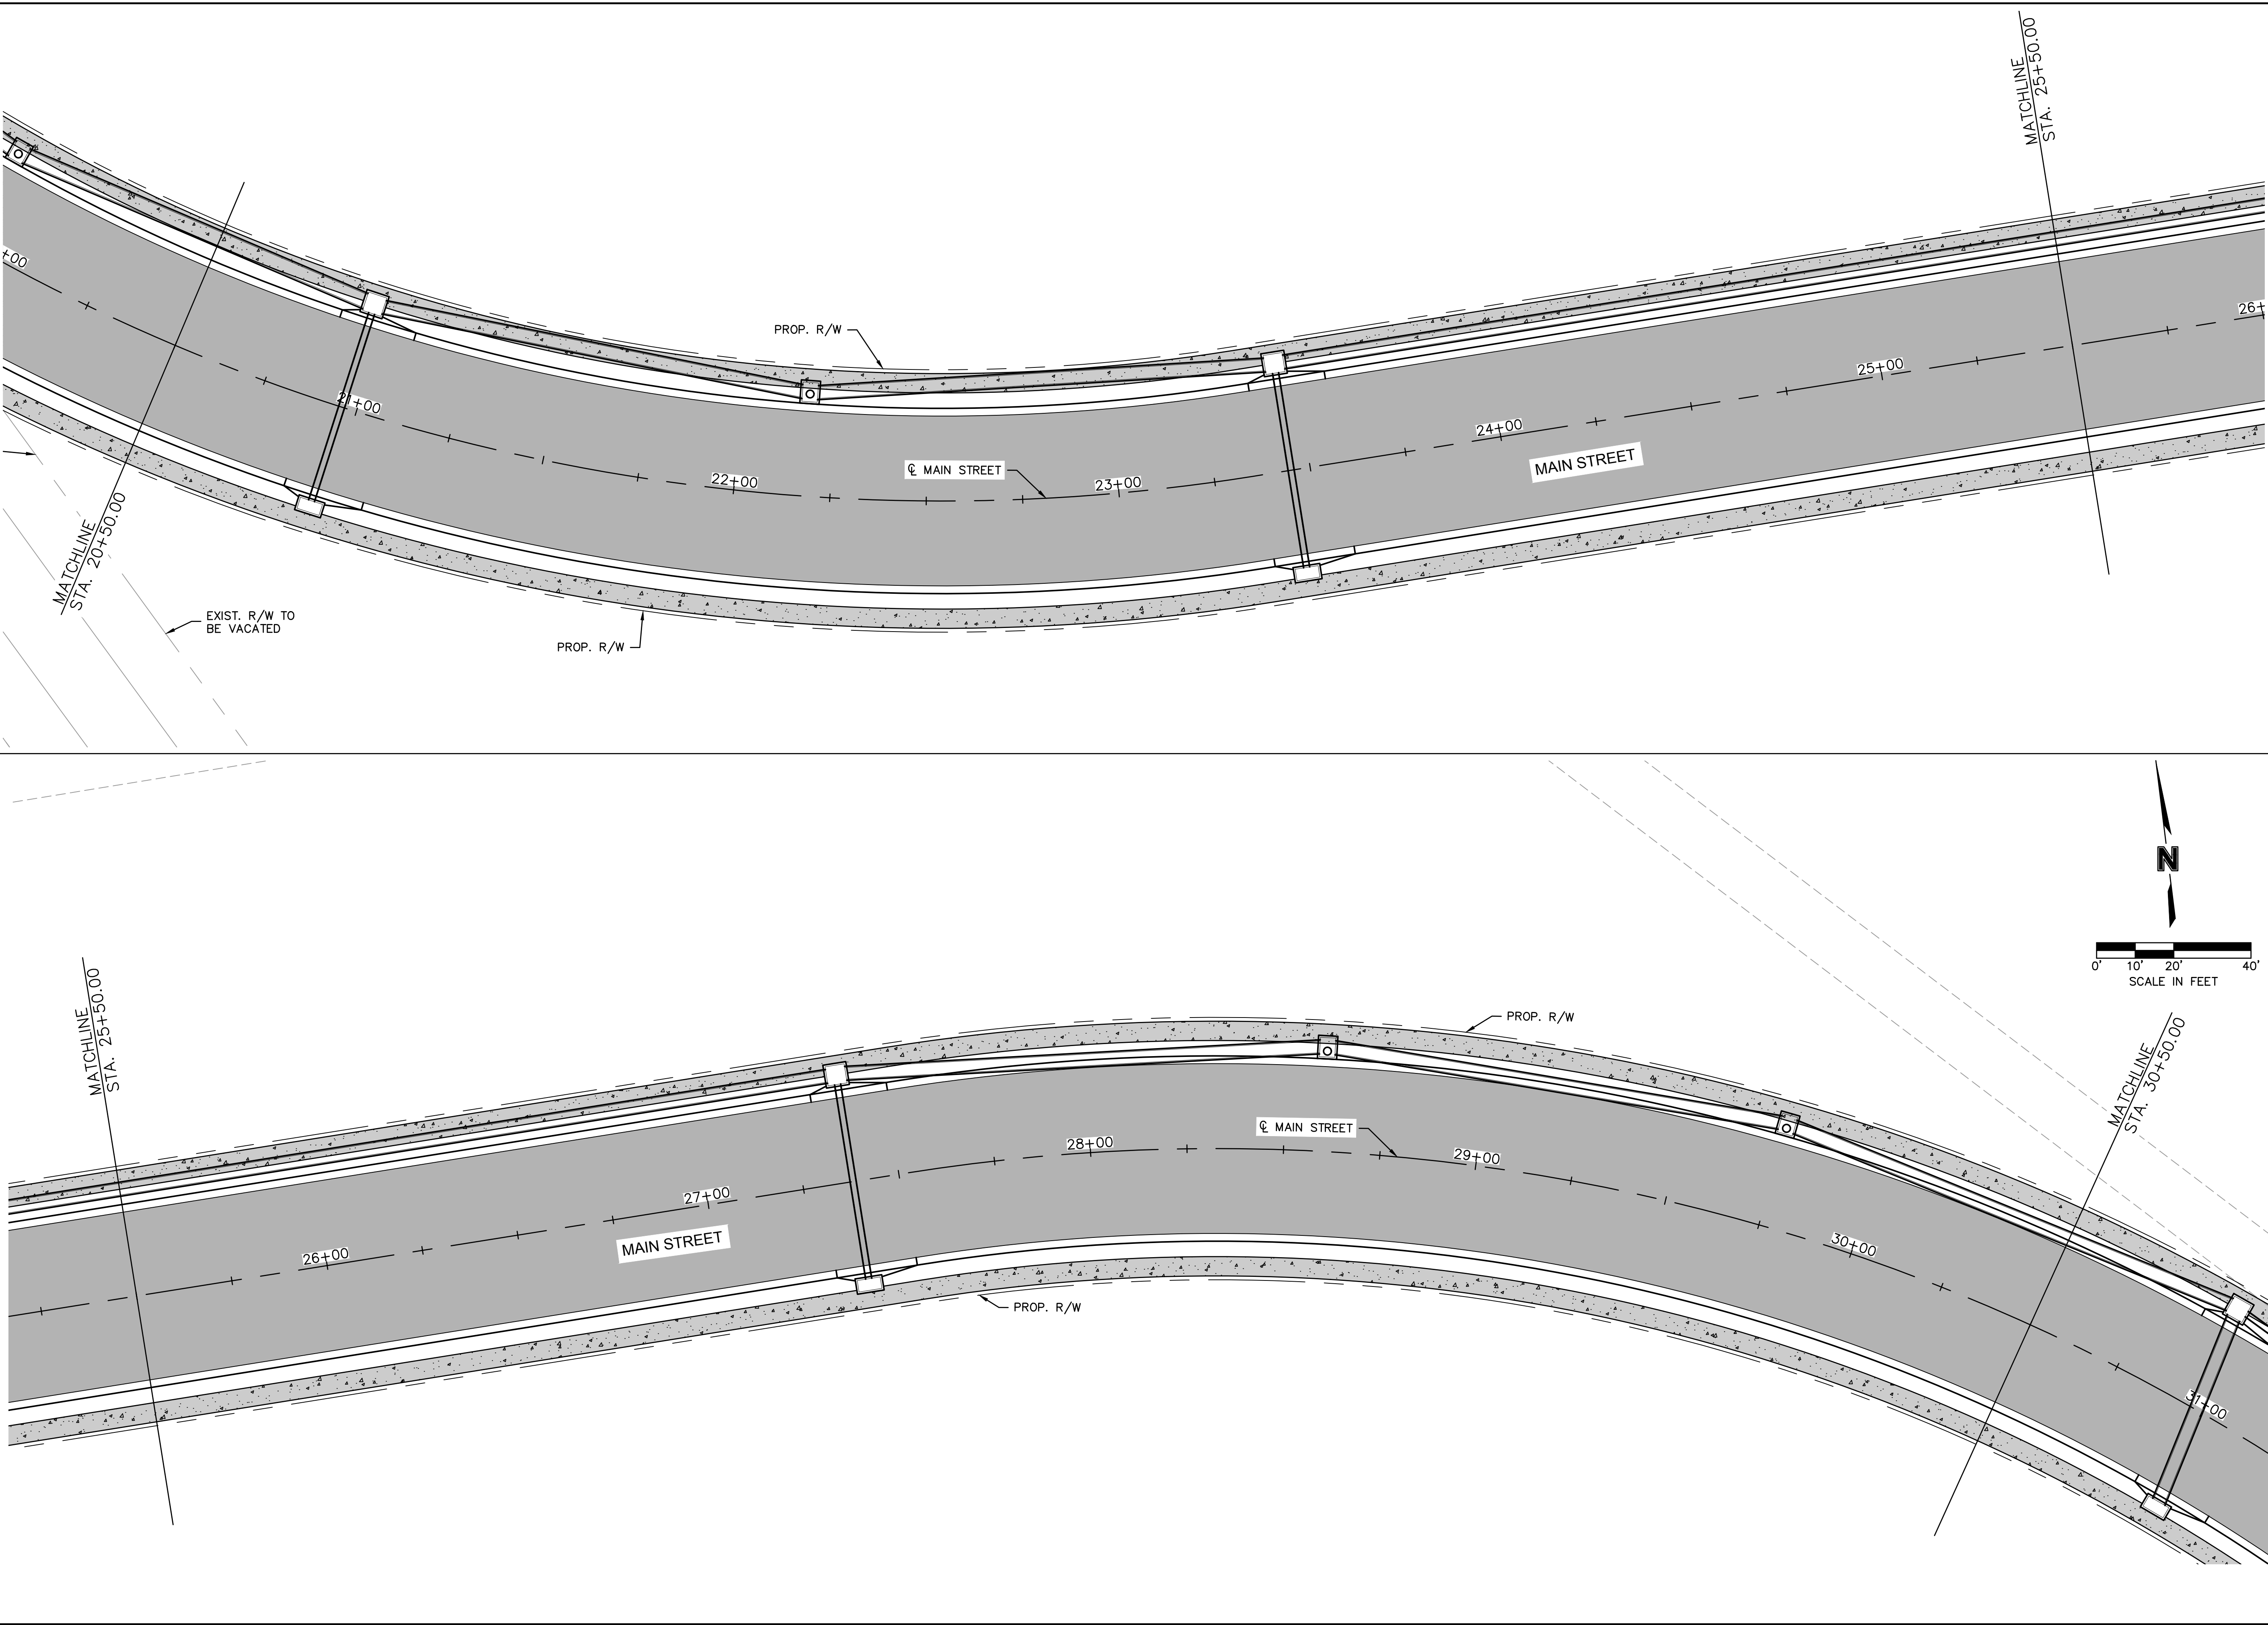

olsson

Olsson Engineering - MO State Certificate of Authority #001592
7301 West 133rd Street, Suite 200
Overland Park, KS 66213-4750
TEL 913.381.1170
FAX 913.381.1174
www.olsson.com

RECORD
DRAWINGS

RYAN B. FLEMING
MO. NO. PE-2002003161

REV. NO.	DATE	REVISIONS DESCRIPTION	BY

REVISIONS

RIGHT OF WAY PLANS
MAIN STREET


SCANNELL DEVELOPMENT LEE'S SUMMIT LOGISTICS
NORTHWEST CORNER OF TUDOR ROAD AND MAIN STREET
LEE'S SUMMIT, MISSOURI

2021

C.O.A. NO.:
DRAWN BY: AR/JI/MW
CHECKED BY: XXX
APPROVED BY: RBE
QA/QC BY: RBE
PROJECT NO.: 021-04157
DWG NO.: T_PROW_02104157
DATE: 2021-10-12

SHEET
16 OF 105

DWG: F:\2021\04001-04500\021-04157\40-Design\AutoCAD\Final Plans\Sheets\ROBR\T_PROW_02104157.dwg
DATE: Oct 30, 2023 3:47pm XREFS: T_PBASE_02104157 C_PROW_02104157 V_XTOPO_02104157 T_PBLK_02104157 T_PATT_02104157 V_XBOU_02104157 T_PSTRM_02104157
USER: asoavedra

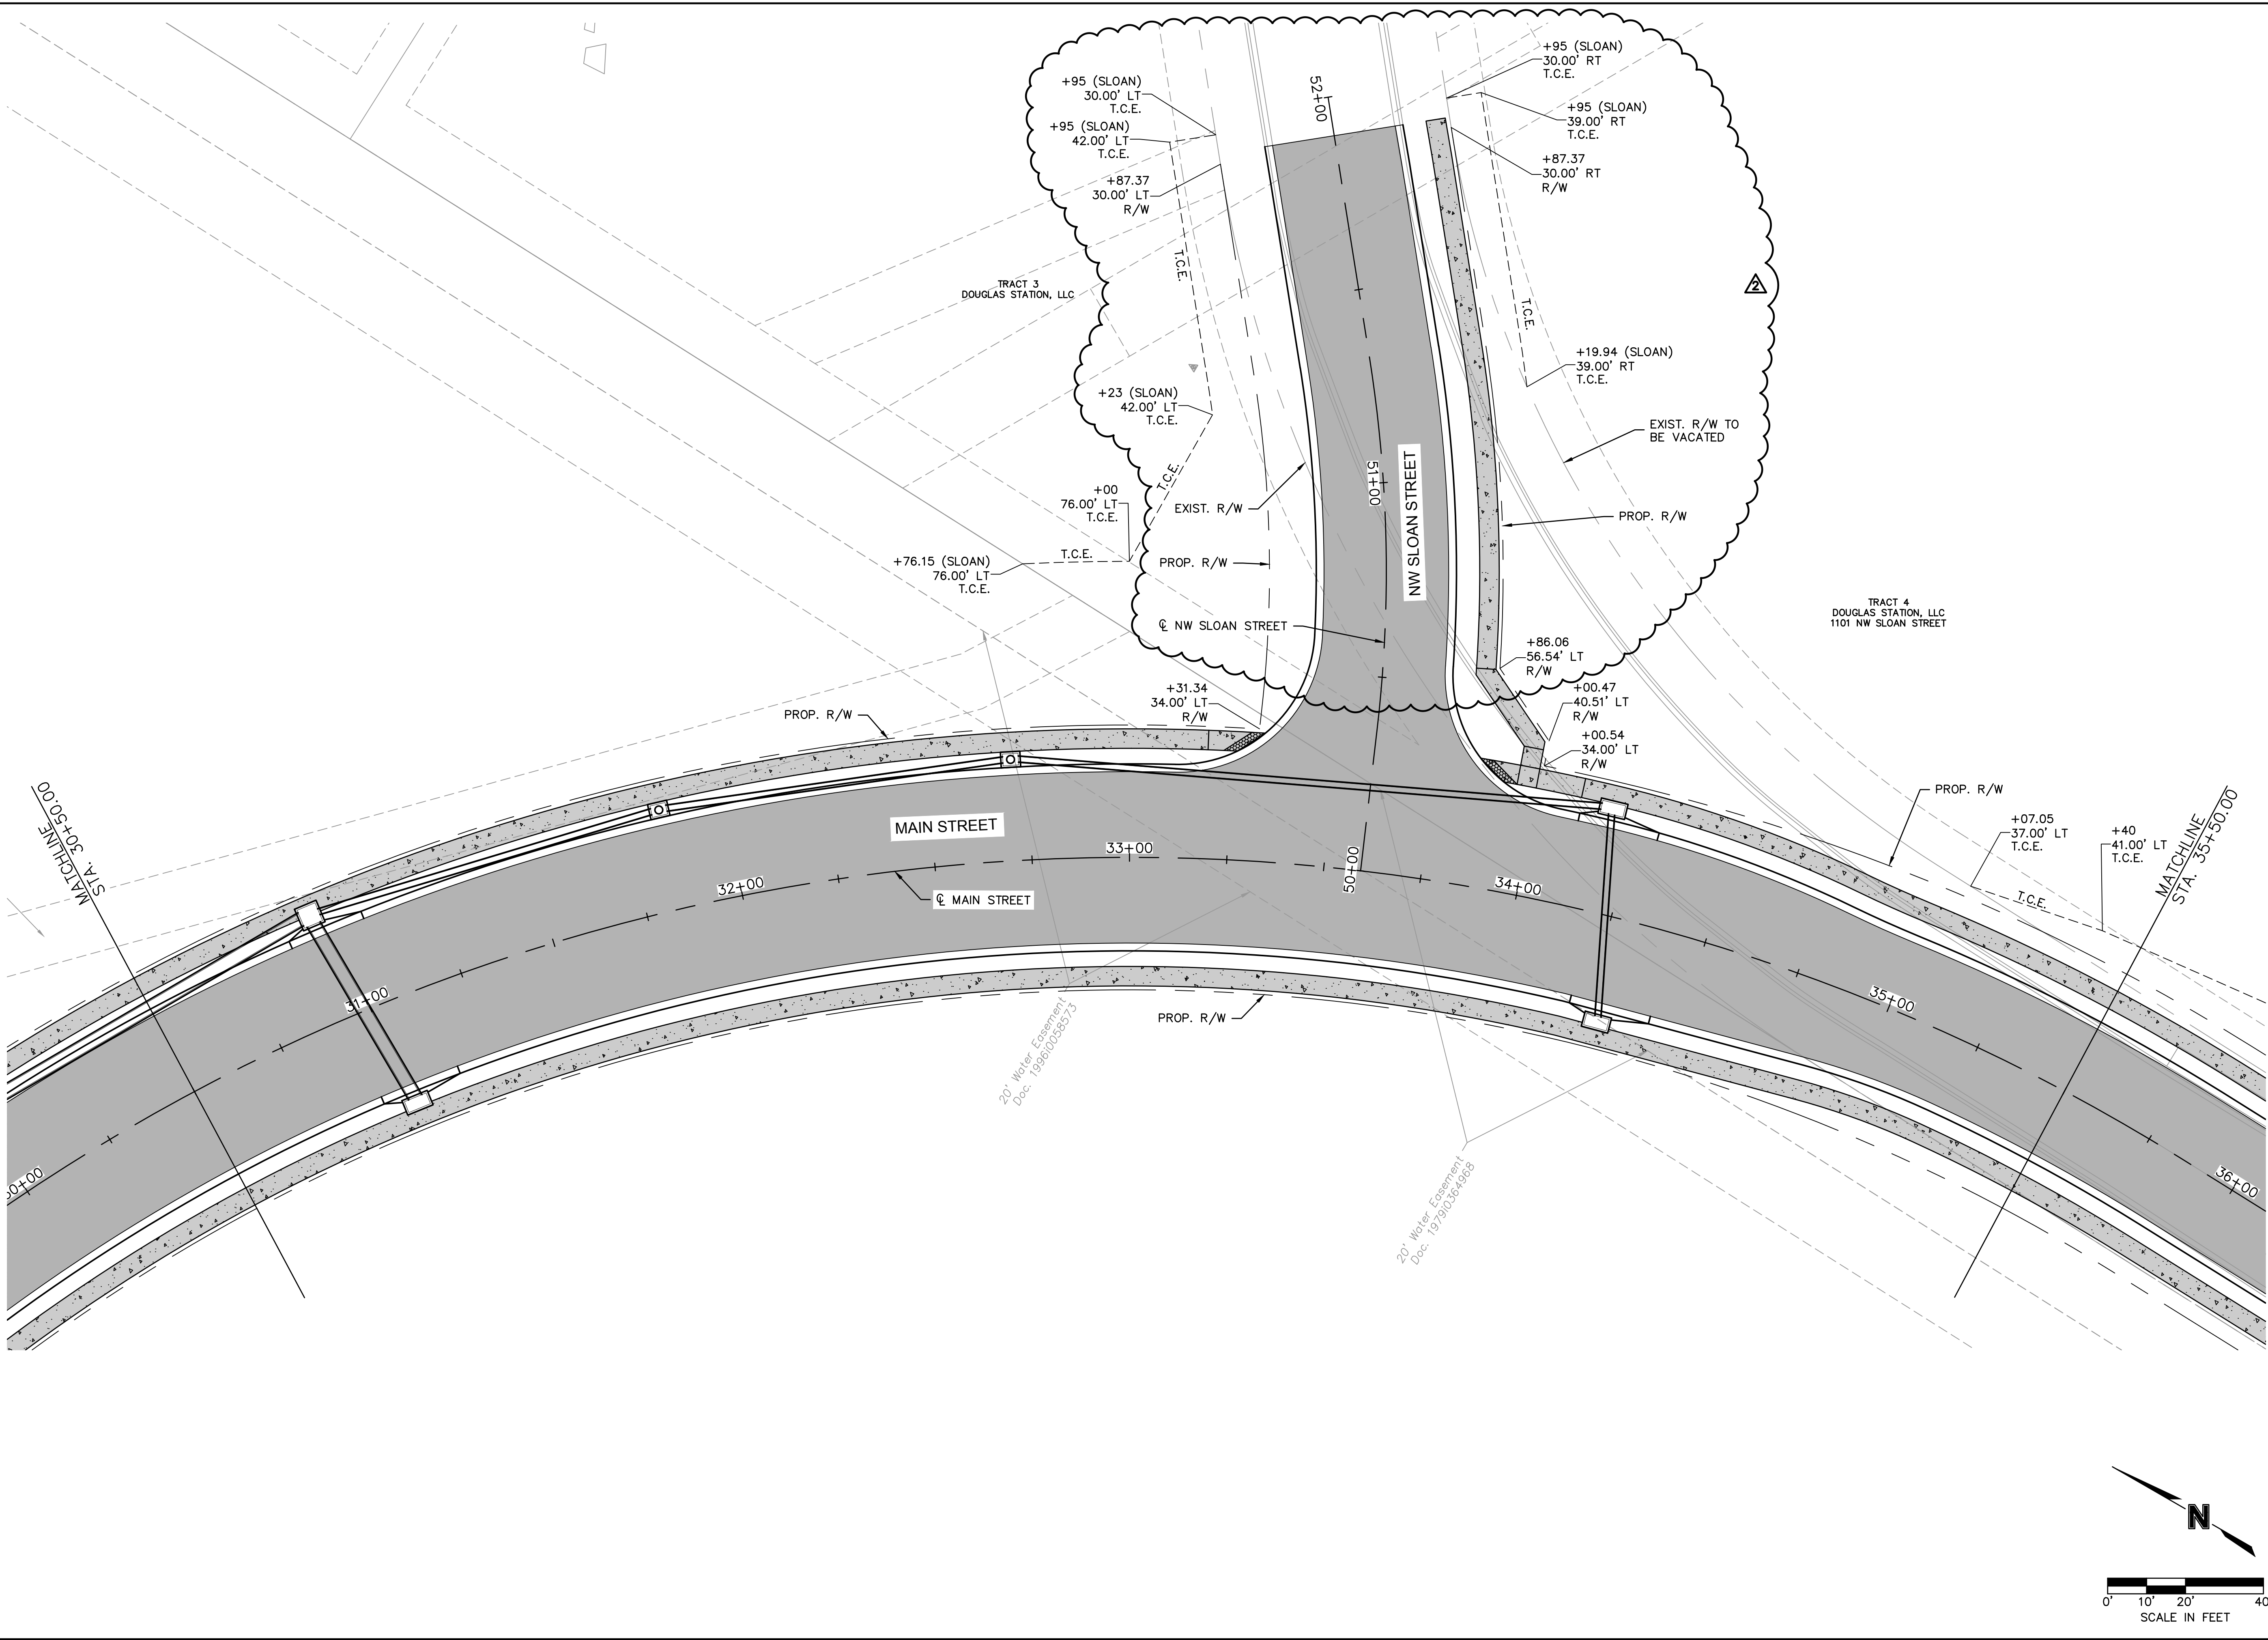

olsson

Olsson Engineering - MO State Certificate of Authority #001592
7301 West 133rd Street, Suite 200 TEL 913.381.1170
Overland Park, KS 66213-4750 FAX 913.381.1174 www.olsson.com

RECORD
DRAWINGS

RYAN B. FLEMING
MO. NO. PE-2002003161

REV. NO.	DATE	REVISIONS DESCRIPTION	BY
2	07/05/2022	DESIGN REVIEW	ARJ

REVISIONS

RIGHT OF WAY PLANS
MAIN STREET AND SLOAN STREET


SCANNELL DEVELOPMENT LEE'S SUMMIT LOGISTICS
NORTHWEST CORNER OF TUDOR ROAD AND MAIN STREET

LEE'S SUMMIT, MISSOURI

C.O.A. NO.:
DRAWN BY: ARJ/AMW
CHECKED BY: XXX
APPROVED BY: RBE
QA/QC BY: RBE
PROJECT NO.: 021-04157
DWG NO.: T_PROW_02104157
DATE: 2021-10-12



SHEET
17 OF 105

DWG: F:\20
DATE: Oct 3

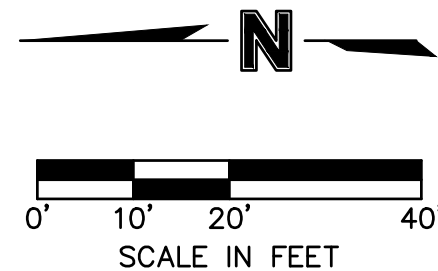

Olsson Engineering - MO State Certificate of Authority #001592
7301 West 133rd Street, Suite 200 TEL 913.381.1170
Overland Park, KS 66213-4750 FAX 913.381.1174 www.olsson.com

DWG: F:\2021\04001-04500\021-04157\40-Design\AutoCAD\Final Plans\Sheets\ROBR\T_RPP01_02104157.dwg
 V_XTOP0_02104157 C_PROW_02104157
 XREFS: T_PTBLK_02104157
 DATE: Oct 30, 2023 3:48pm

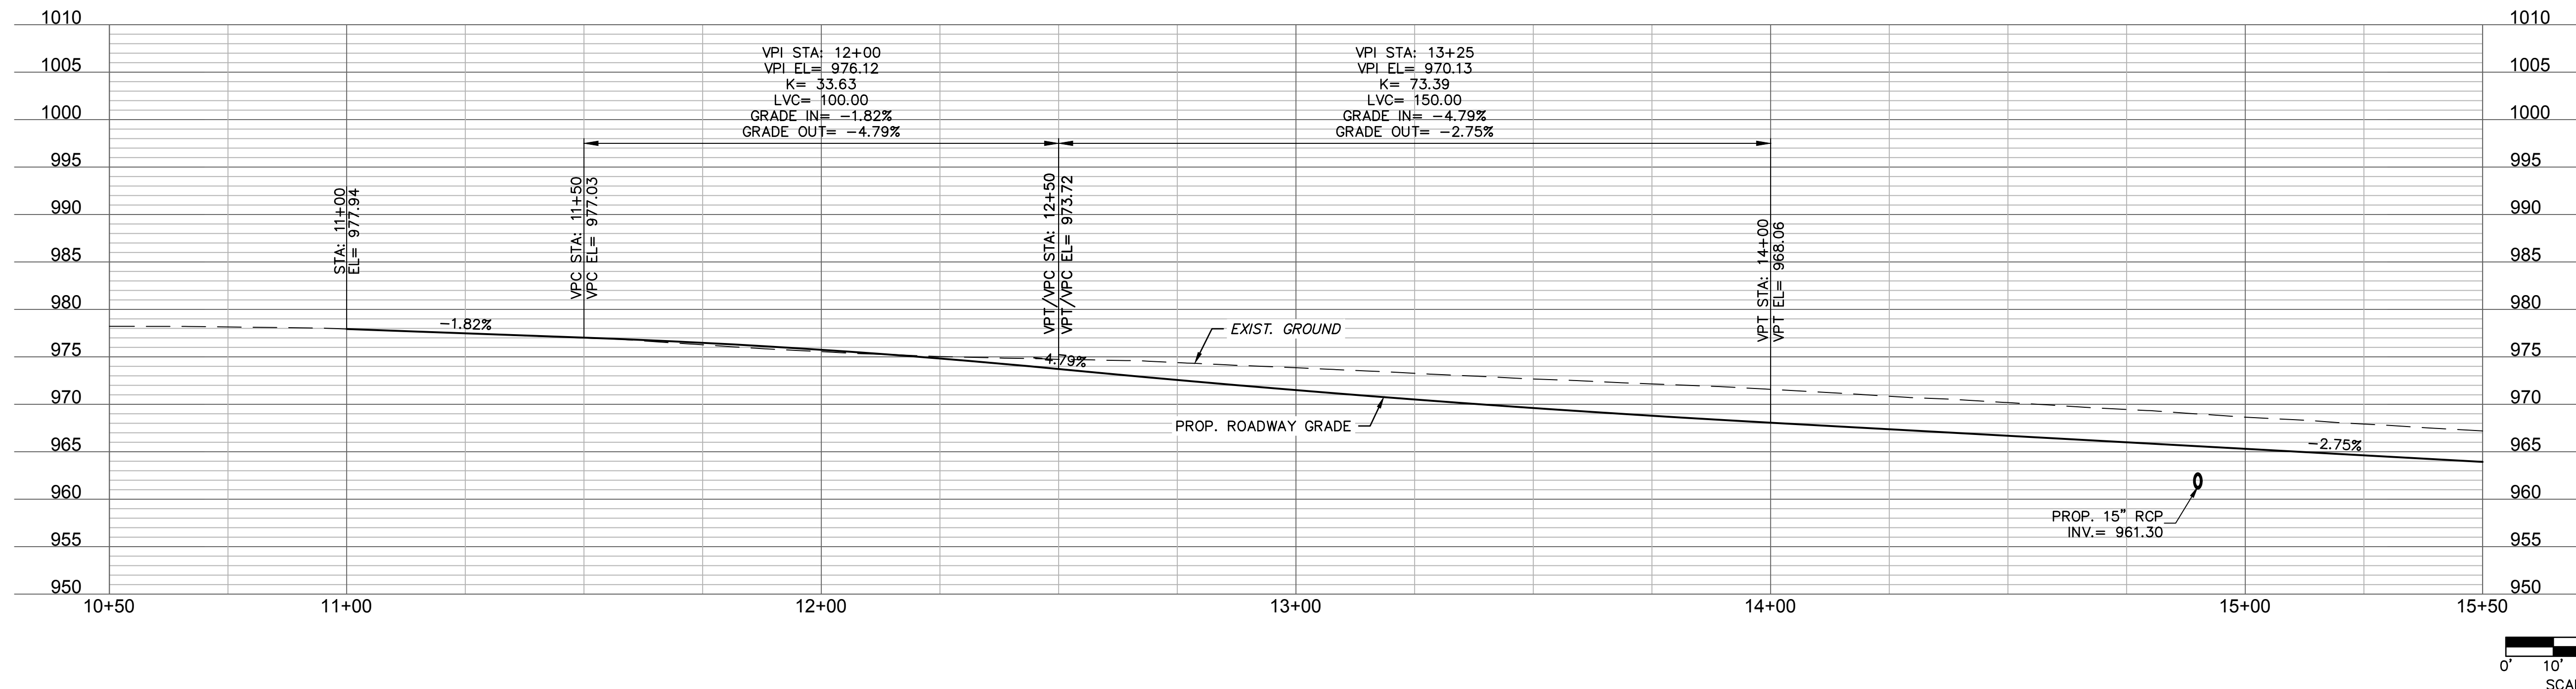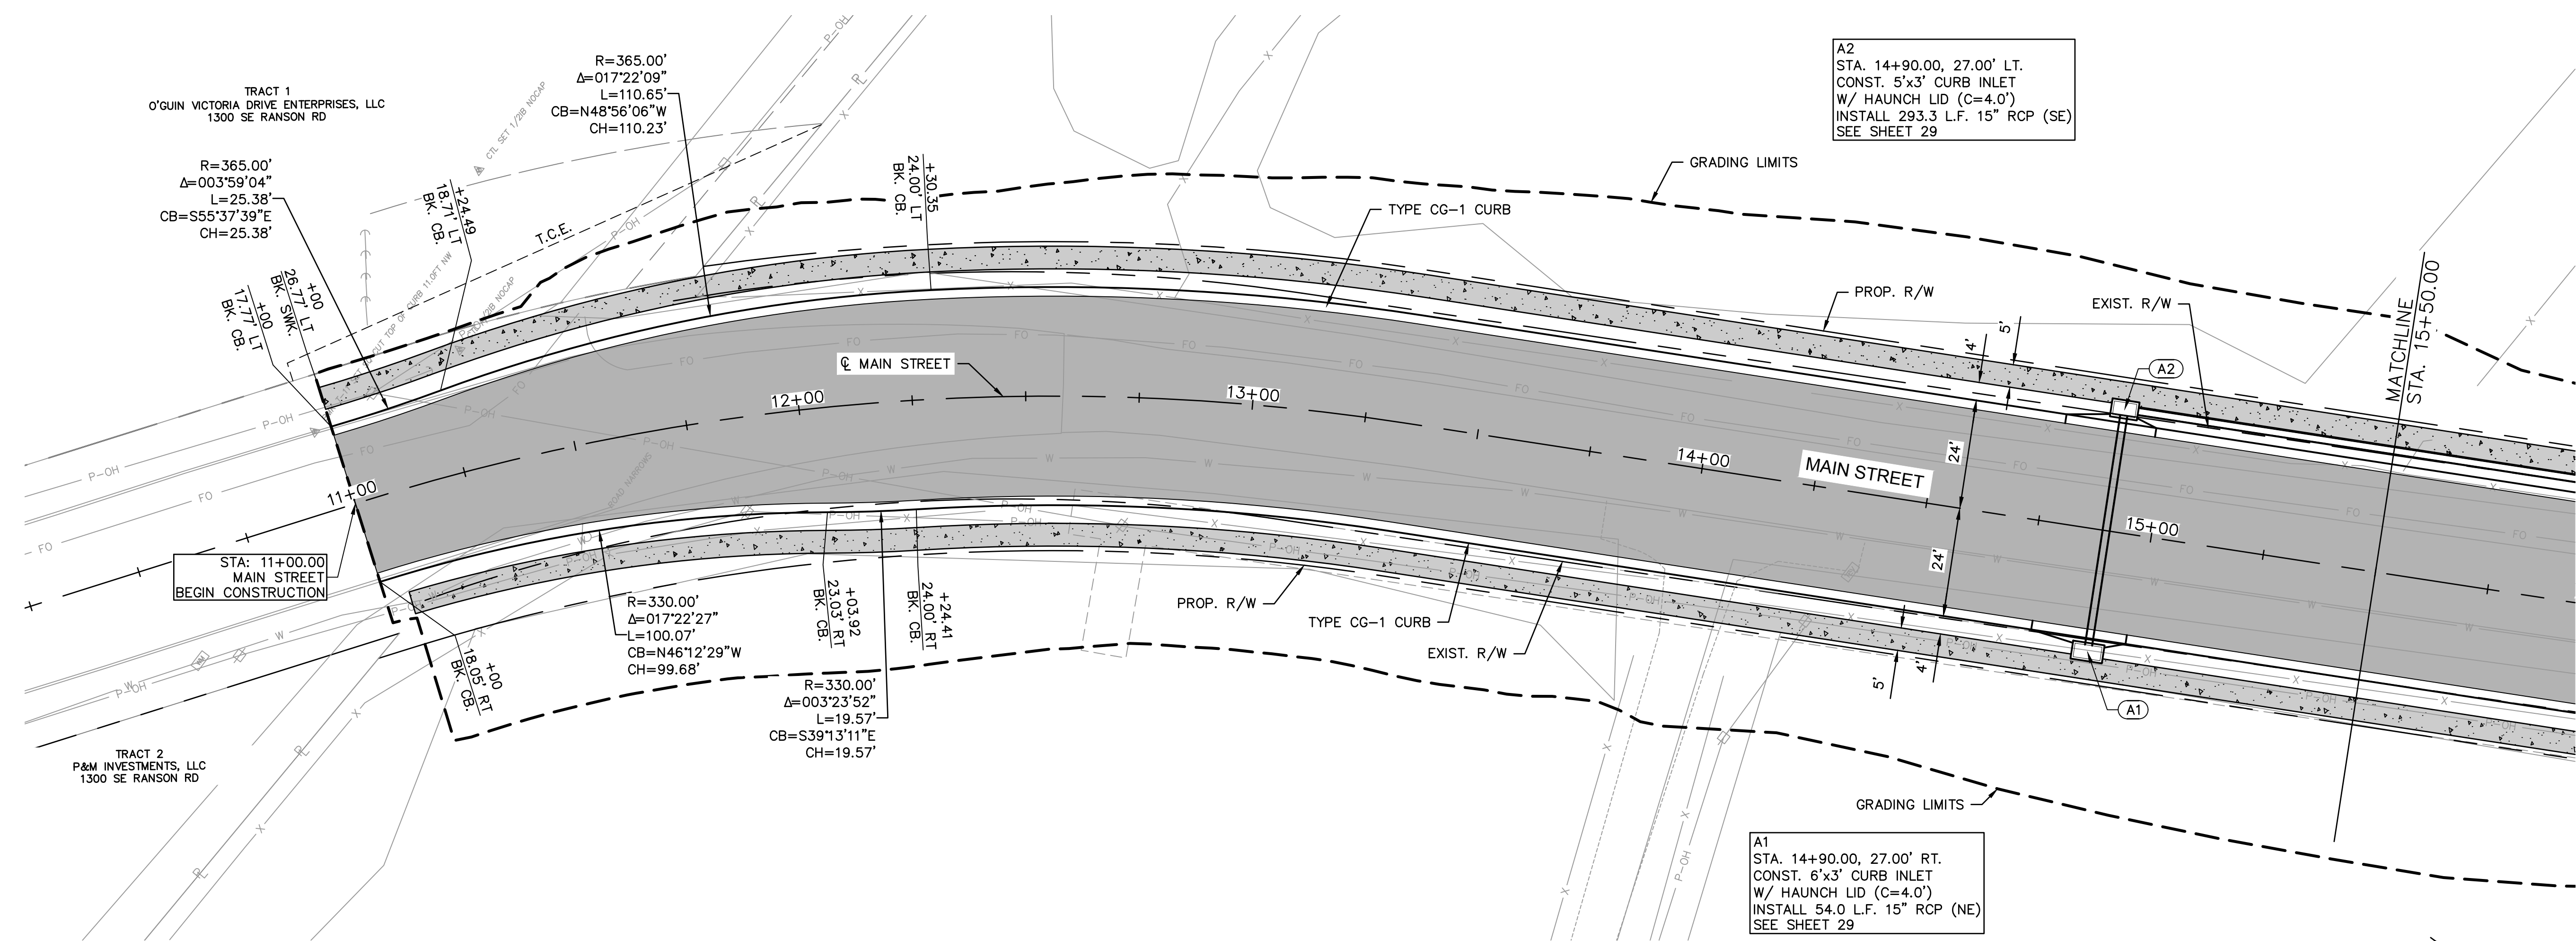

olson

Olsson Engineering - MO State Certificate of Authority #001592
 7301 West 133rd Street, Suite 200 TEL 913.381.1170
 Overland Park, KS 66213-4750 FAX 913.381.1174 www.olsson.com

RECORD
DRAWINGS

RYAN B. FLEMING
MO. NO. PE-2002003161



[illegible]

PLAN AND PROFILE MAIN STREET	SCANNELL DEVELOPMENT LEE'S SUMMIT LOGISTICS NORTHWEST CORNER OF TUDOR ROAD AND MAIN STREET	2021
LEE'S SUMMIT, MISSOURI!		

C.O.A. NO.: _____
DRAWN BY: _____ ARJ/AMW
CHECKED BY: _____ XXX
APPROVED BY: _____ RBF
QA/QC BY: _____ RBF
PROJECT NO.: _____ 021-04157
DWG NO.: T_RPP01_02104157
DATE: _____ 2021-10-12

SHEET
19 OF 105

DWG: F:\2021\04001-04500\021-04157\40-Design\AutoCAD\Final Plans\Sheets\ROBR\T_RPP01_02104157.dwg
DATE: Oct 30, 2023 3:48pm XREFS: T_PTBK_02104157 C_PROW_02104157 T_PBASE_02104157 T_PPAIT_02104157 V_XBOL_02104157 T_PSTRM_02104157
USER: asaavedra T_PBASE_02104157

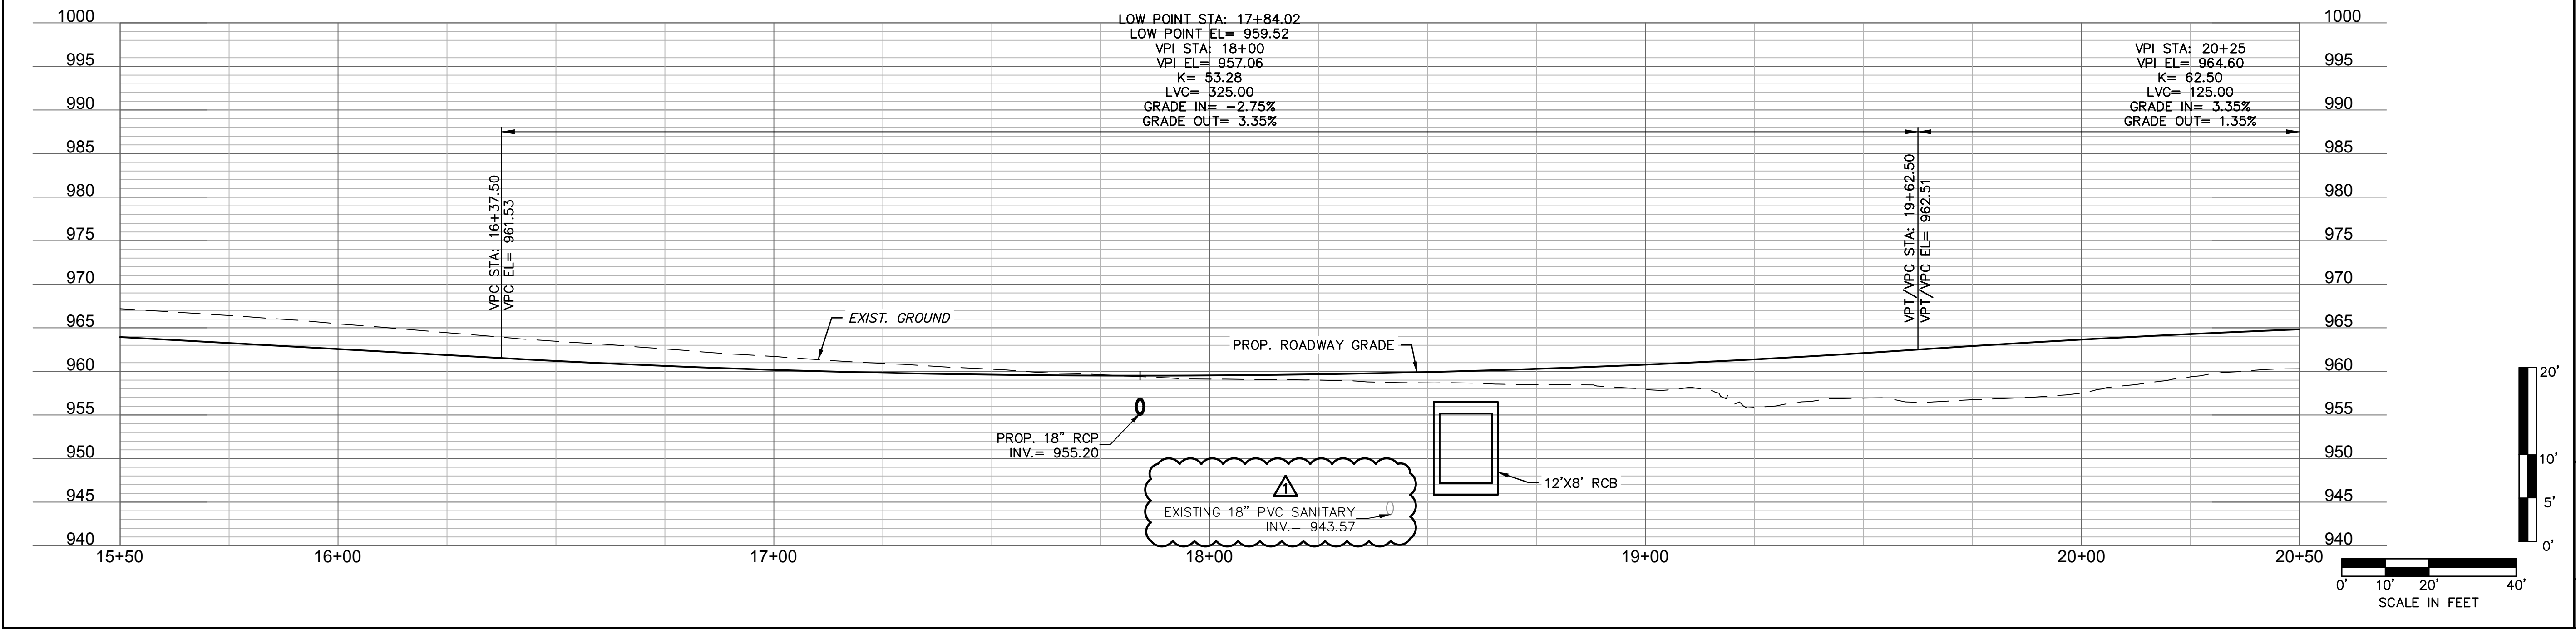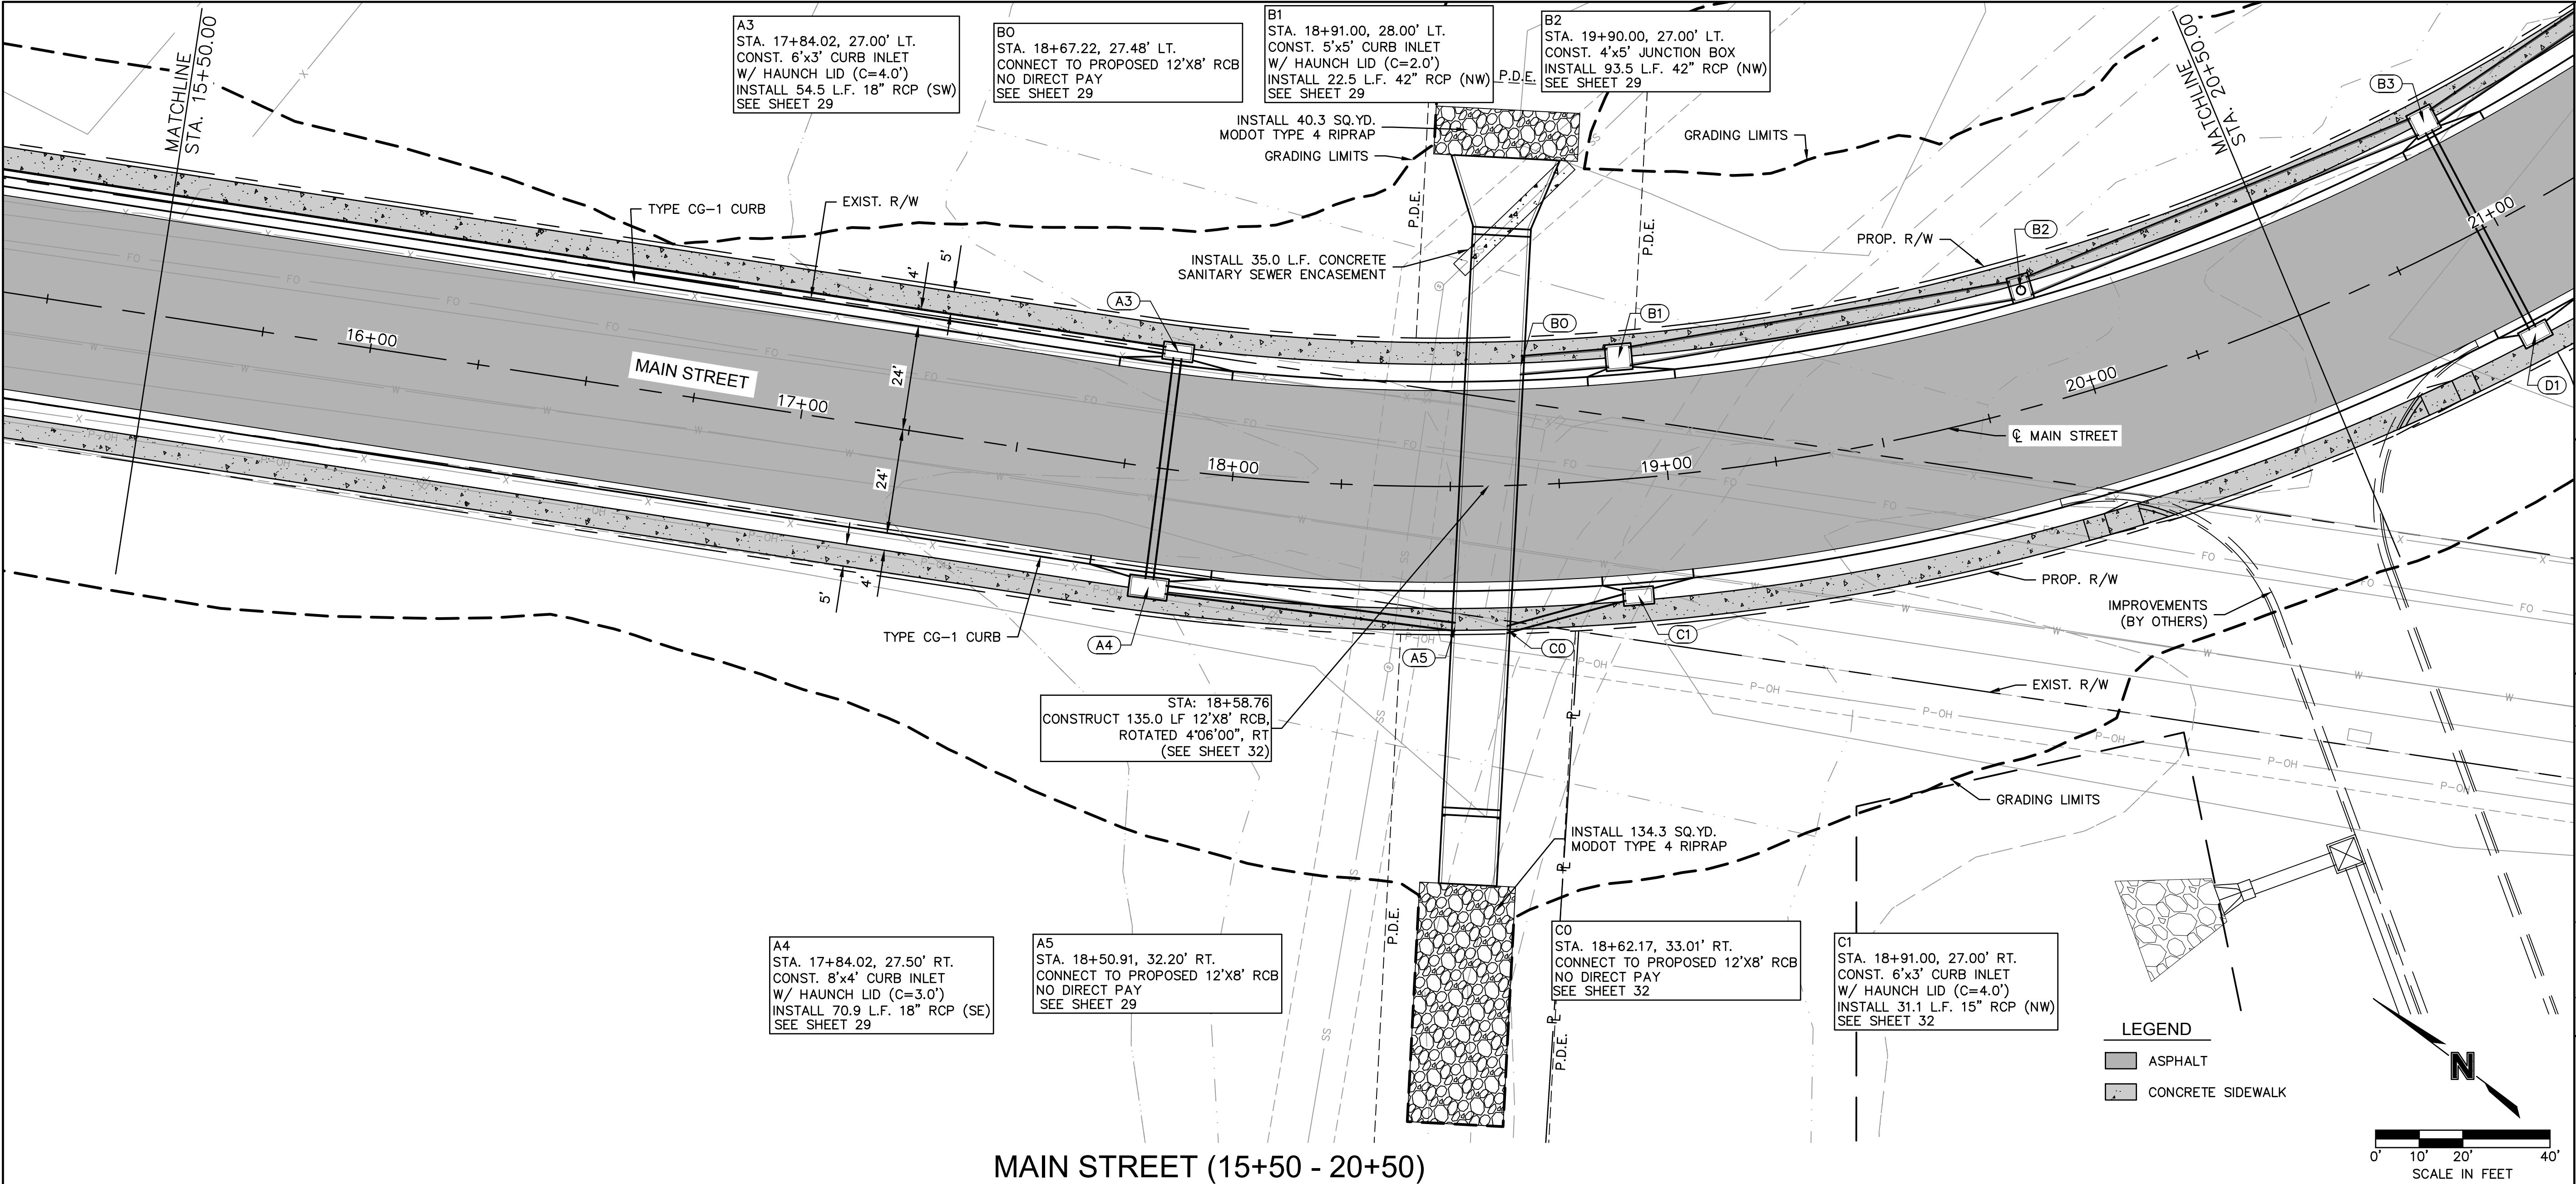

Olsson Engineering - MO State Certificate of Authority #01592
7301 West 133rd Street, Suite 200
Overland Park, KS 66213-4750
TEL 913.381.1170
FAX 913.381.1174
www.olsson.com

RECORD
DRAWINGS

RYAN B. FLEMING
MO. NO. PE-2002003161

REV.	NO.	DATE	REVISIONS DESCRIPTION	CITY COMMENTS
1		11/16/2021		

PLAN AND PROFILE
MAIN STREET



SCANNELL DEVELOPMENT LEE'S SUMMIT LOGISTICS
NORTHWEST CORNER OF TUDOR ROAD AND MAIN STREET

LEE'S SUMMIT, MISSOURI

2021



C.O.A. NO.:
DRAWN BY: ARJ/AMW
CHECKED BY: XXX
APPROVED BY: RBE
QA/QC BY: RBE
PROJECT NO.: 021-04157
DWG NO.: T_RPP01_02104157
DATE: 2021-10-12

SHEET
20 OF 105

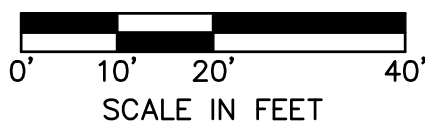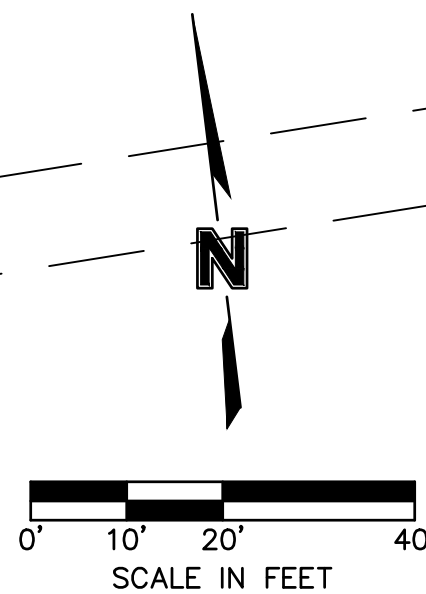

Olsson Engineering - MO State Certificate of Authority #001592
7301 West 133rd Street, Suite 200 TEL 913.381.1170
Overland Park, KS 66213-4750 FAX 913.381.1174 www.olsson.com

DWG: F:\202104001-04500\021-04157\40-Design\AutoCAD\Final Plans\Sheets\ROBR\T_RPP01_02104157.dwg
DATE: Oct 30, 2023 3:48pm XREFS: T_PTBULK_02104157 V_XTOPO_02104157 C_PROW_02104157 T_PBASE_02104157 C_PBASE_02104157 T_PPATT_02104157 V_XBOL_02104157 T_PSTRM_02104157

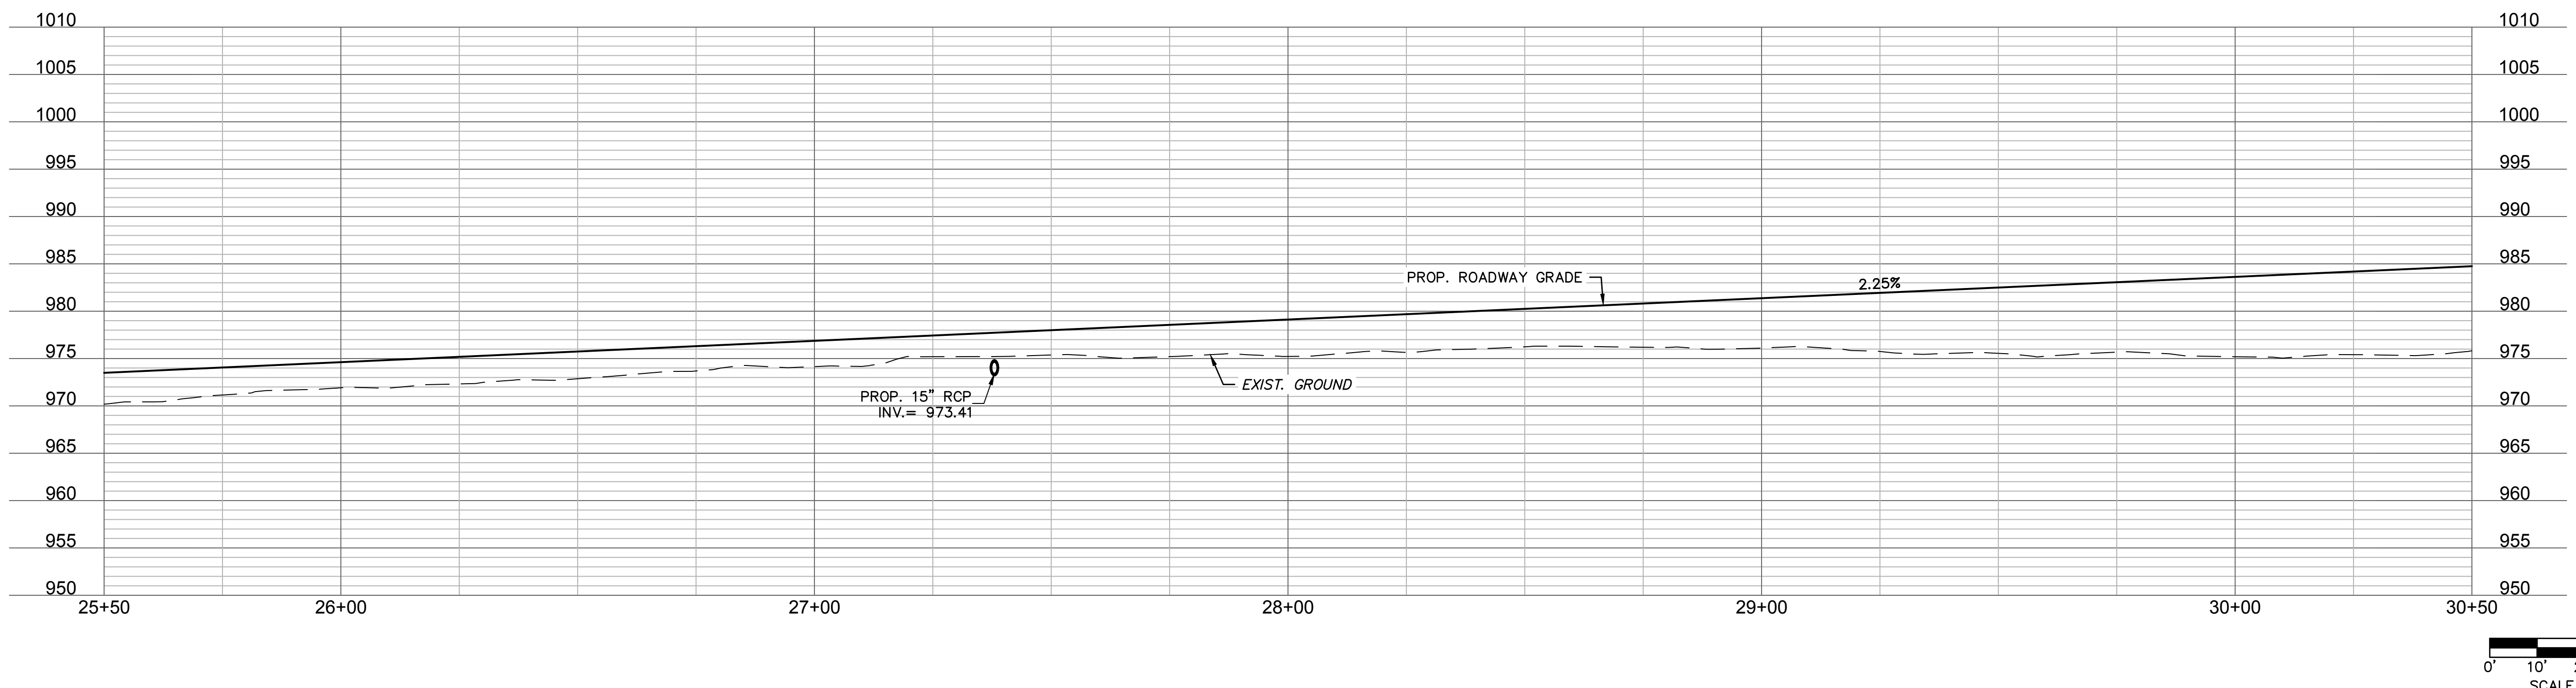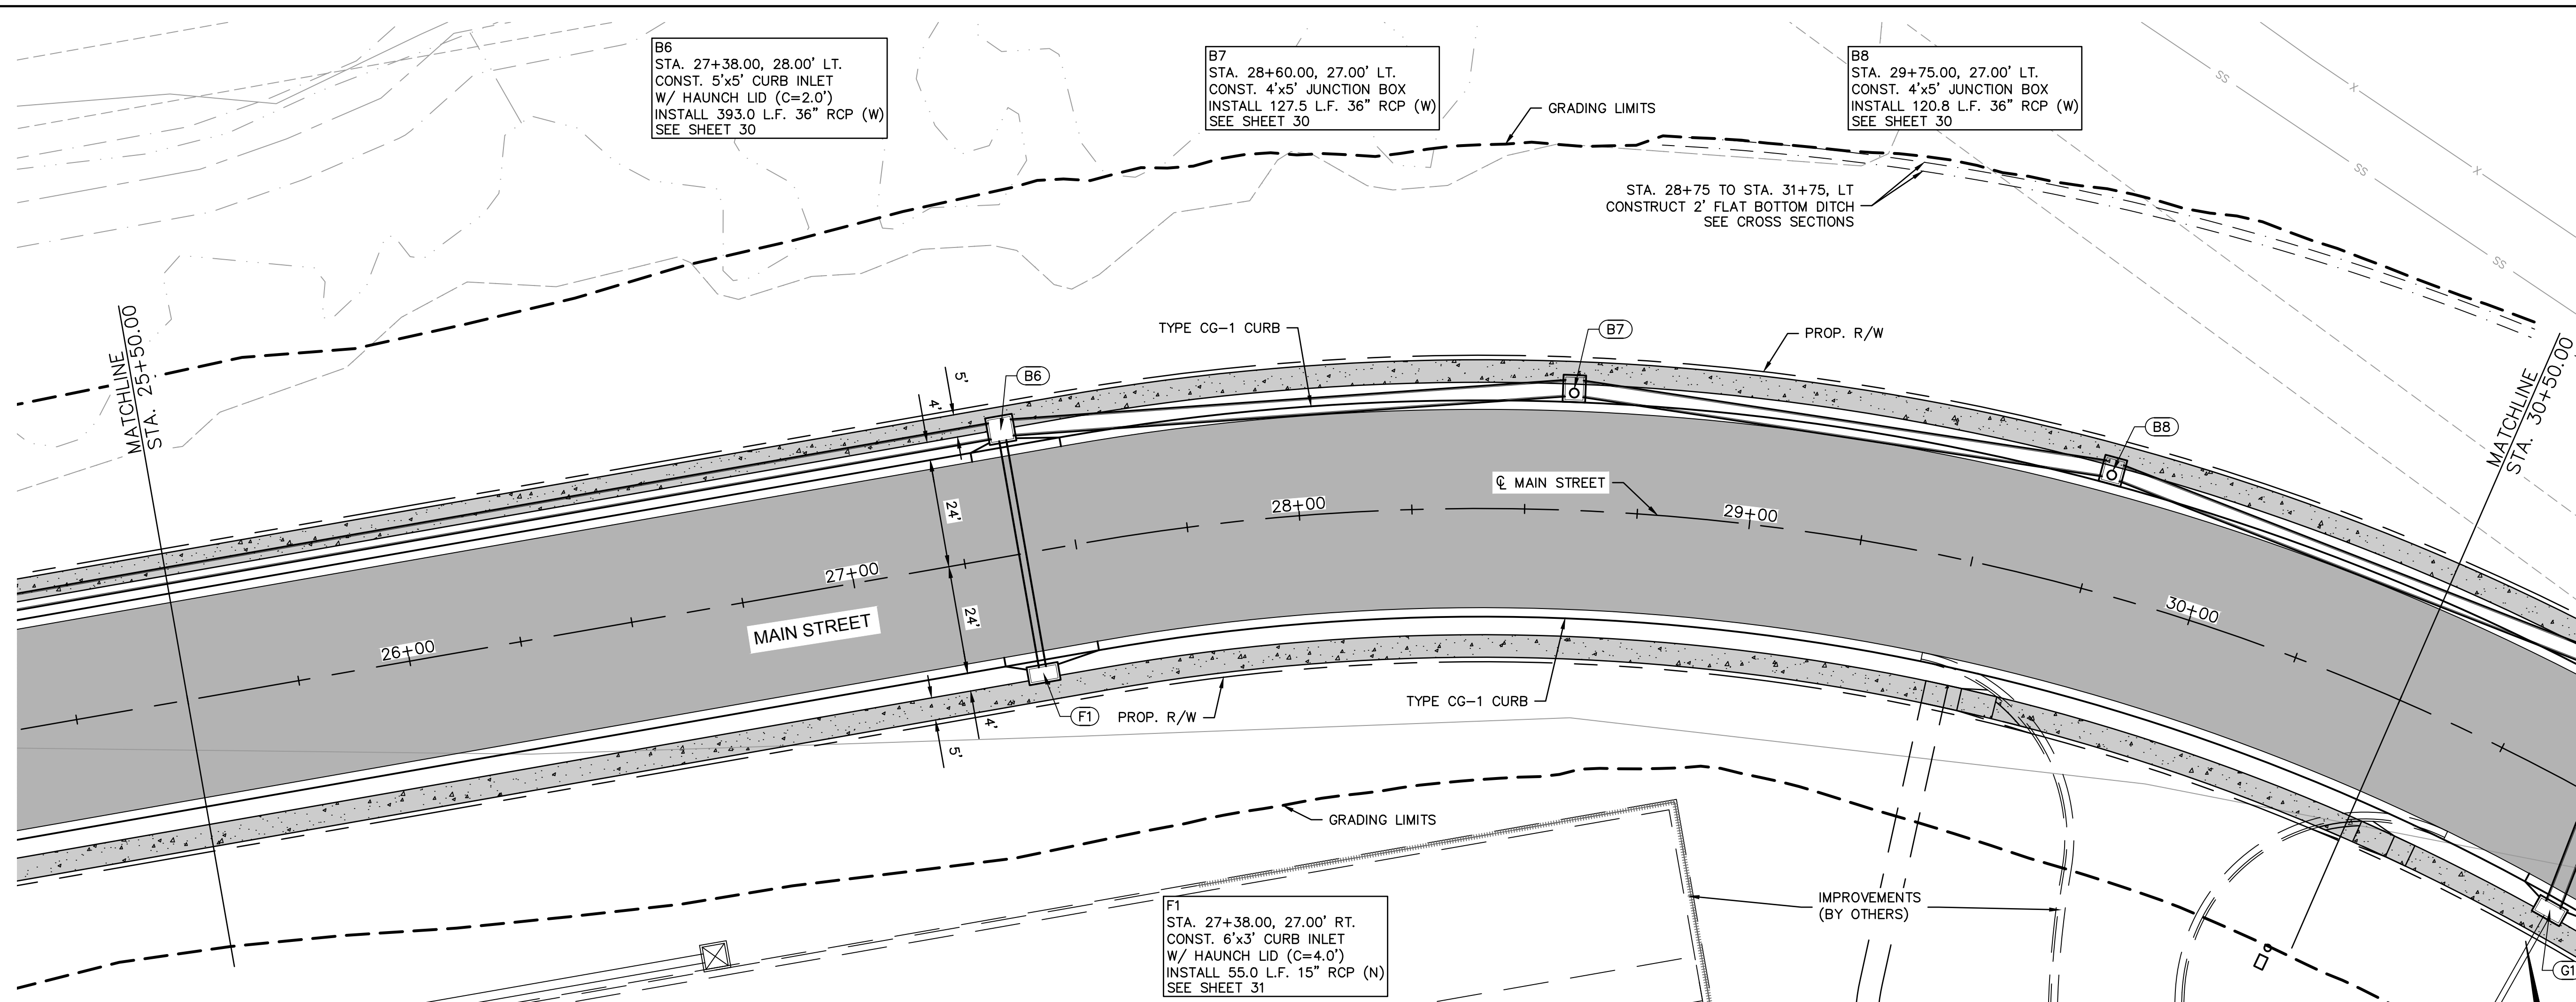

PLAN AND PROFILE MAIN STREET		SCANNELL DEVELOPMENT LEE'S SUMMIT LOGISTICS NORTHWEST CORNER OF TUDOR ROAD AND MAIN STREET		LEE'S SUMMIT, MISSOURI		2021		REVISIONS		RYAN B. FLEMING MO. NO. PE-2002003161		RECORD DRAWINGS				Olsson Engineering - MO State Certificate of Authority #001592 7301 West 133rd Street, Suite 200 TEL 913.381.1170 Overland Park, KS 66213-4750 FAX 913.381.1174 www.olsson.com	
C.O.A. NO.: _____		DRAWN BY: _____ ARJ/AMW		CHECKED BY: _____ XXX		APPROVED BY: _____ RBF		QA/QC BY: _____ RBF		PROJECT NO.: _____ 021-04157		DWG NO.: _____ T_RPP01_02104157		DATE: _____ 2021-10-12			
SHEET																	
22														OF 105			

DWG: F:\2021\04001-04500\021-04157\40-Design\AutoCAD\Final Plans\Sheets\ROBR\T_RPP01_02104157.dwg
DATE: Oct 30, 2023 3:48pm XREFS: T_PTBK_02104157 V_XTOPO_02104157 C_PROW_02104157



USER: asaavedra
T_PBASE_02104157

C_PBASE_02104157

T_PPATTI_02104157

V_XBOL_02104157

T_PSTRM_02104157

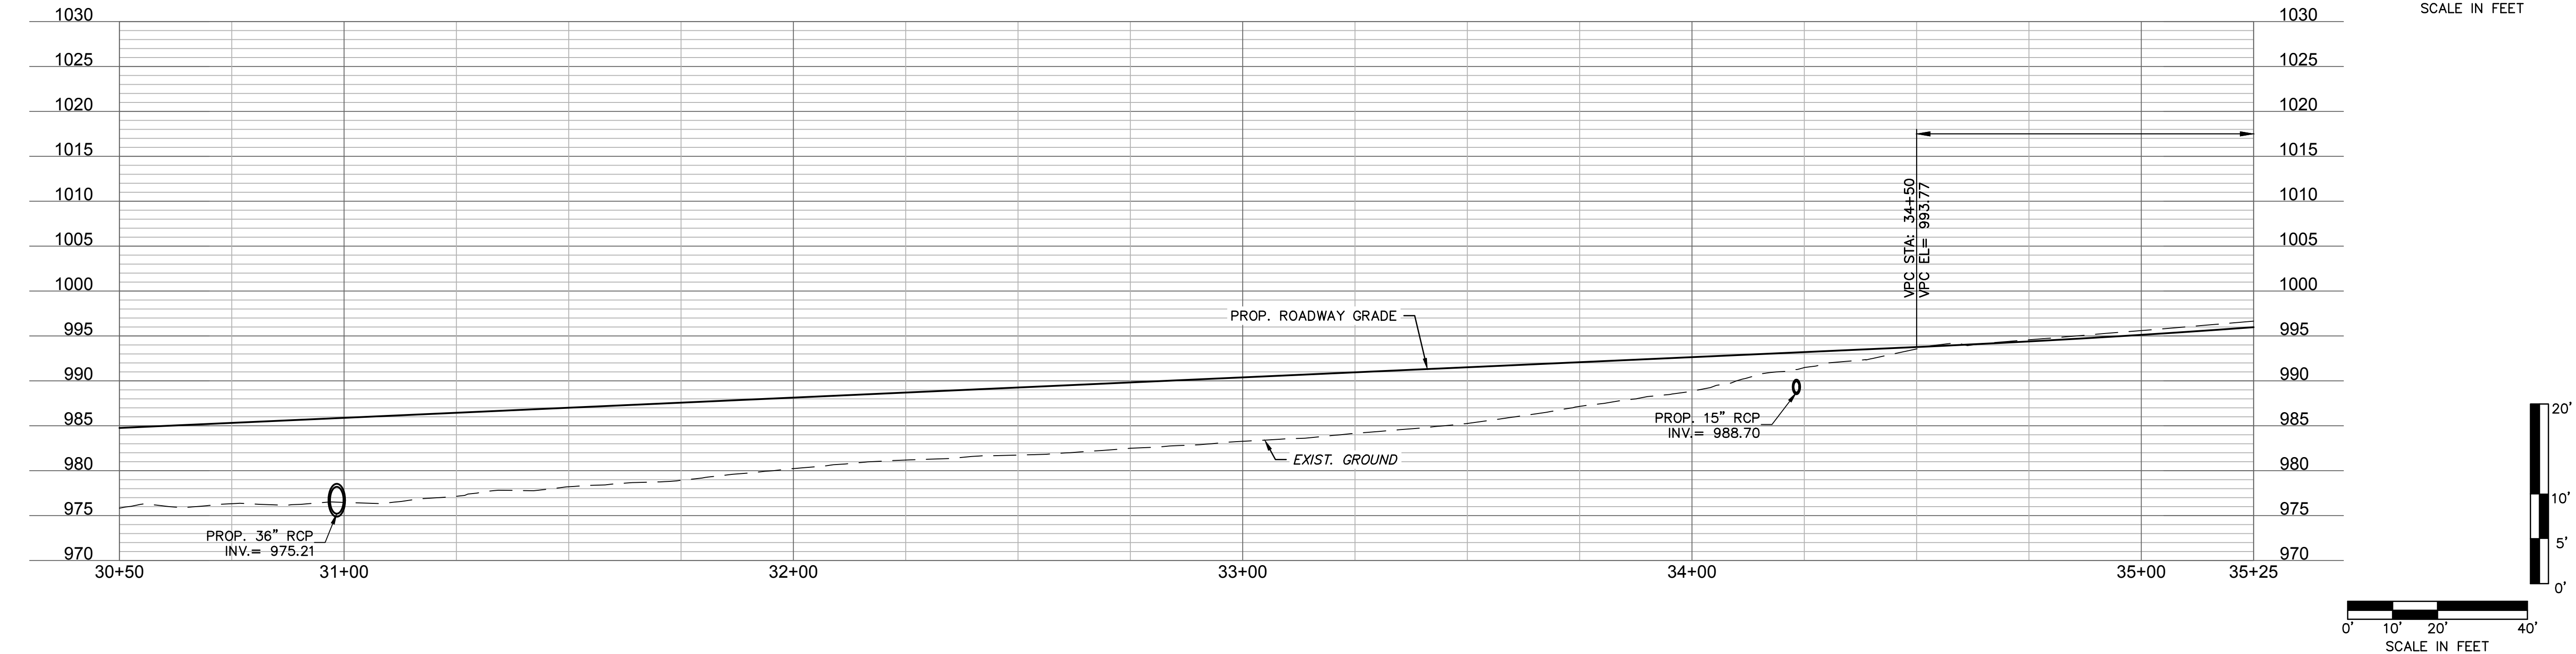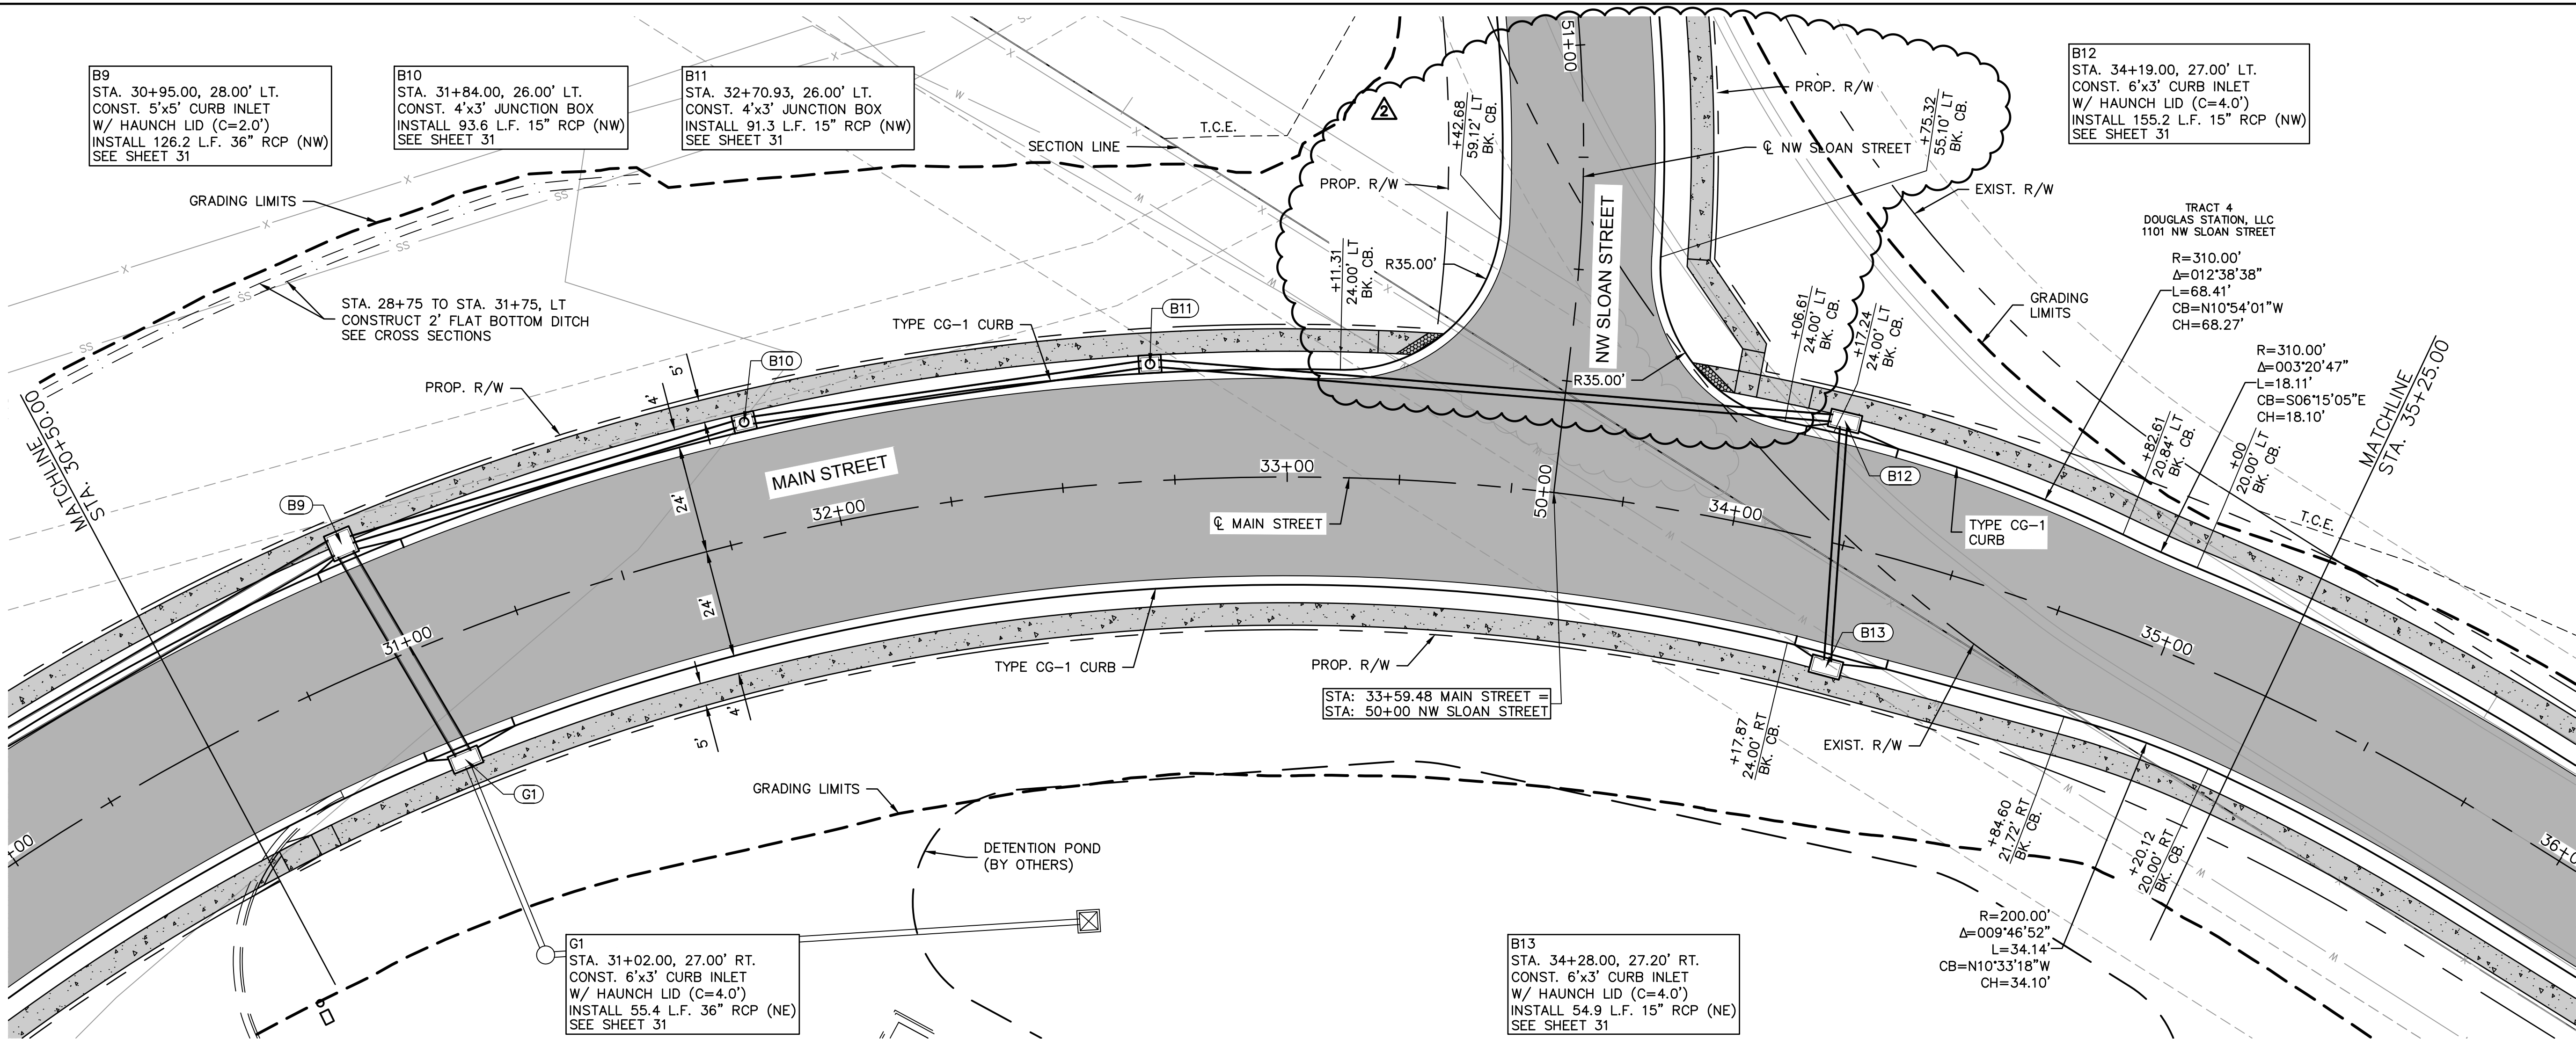

olsson

Olsson Engineering - MO State Certificate of Authority #01592
7301 West 133rd Street, Suite 200 TEL 913.381.1170
Overland Park, KS 66213-4750 FAX 913.381.1174 www.olsson.com

RECORD DRAWINGS

RYAN B. FLEMING
MO. NO. PE-2002003161

REV. NO.	DATE	REVISIONS DESCRIPTION	BY
2	07/05/2022	DESIGN REVIEW	ARJ

PLAN AND PROFILE
MAIN STREET

SCANNELL DEVELOPMENT LEE'S SUMMIT LOGISTICS
NORTHWEST CORNER OF TUDOR ROAD AND MAIN STREET

LEE'S SUMMIT, MISSOURI

C.O.A. NO.:
DRAWN BY: ARJ/AMW
CHECKED BY: XXX
APPROVED BY: RBE
QA/QC BY: RBE
PROJECT NO.: 021-04157
DWG NO.: T_RPP01_02104157
DATE: 2021-10-12

SHEET
23 OF 105

DWG: F:\2021\04001-04500\021-04157\40-Design\AutoCAD\Final Plans\Sheets\ROBR\T_RPP01_02104157.dwg
DATE: Oct 30, 2023 3:48pm XREFS: T_PTBK_02104157 C_PROW_02104157

USER: asaavedra
T_PBASE_02104157


V_XBOL_02104157 T_PSTRM_02104157

T_PPATT_02104157




C_PBASE_02104157

C_PBASE_02104157

MAIN STREET (35+25 - 40+25)

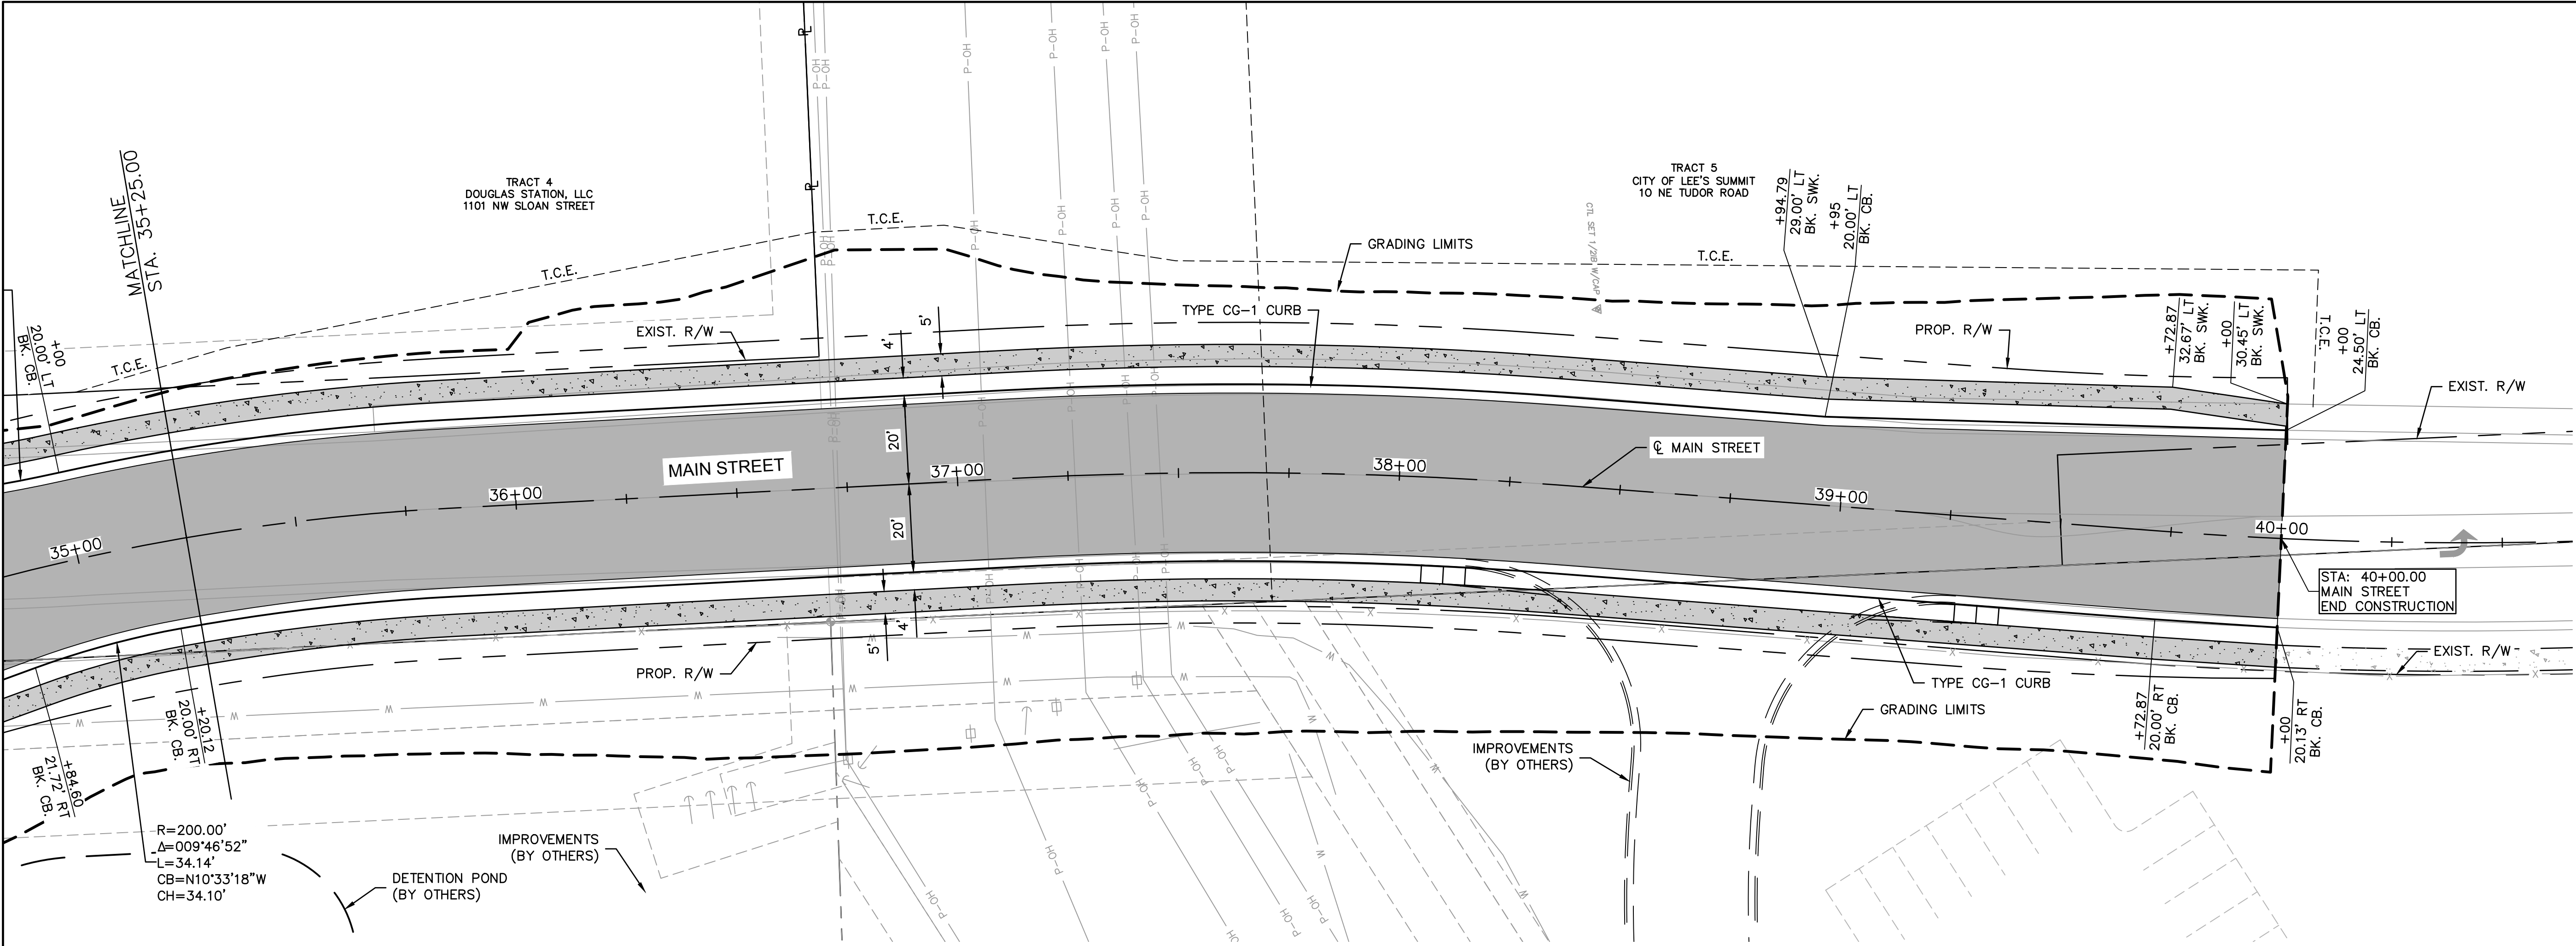

- LEGEND
- ASPHALT
 - CONCRETE SIDEWALK

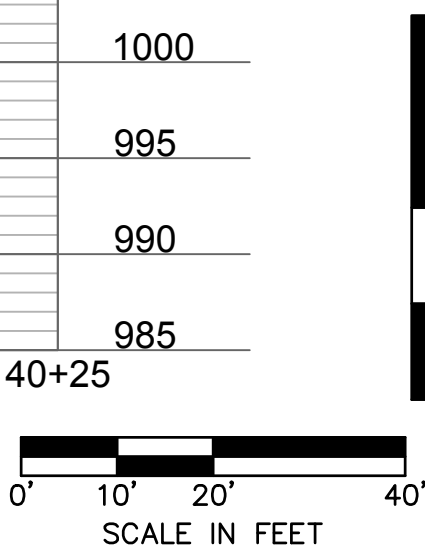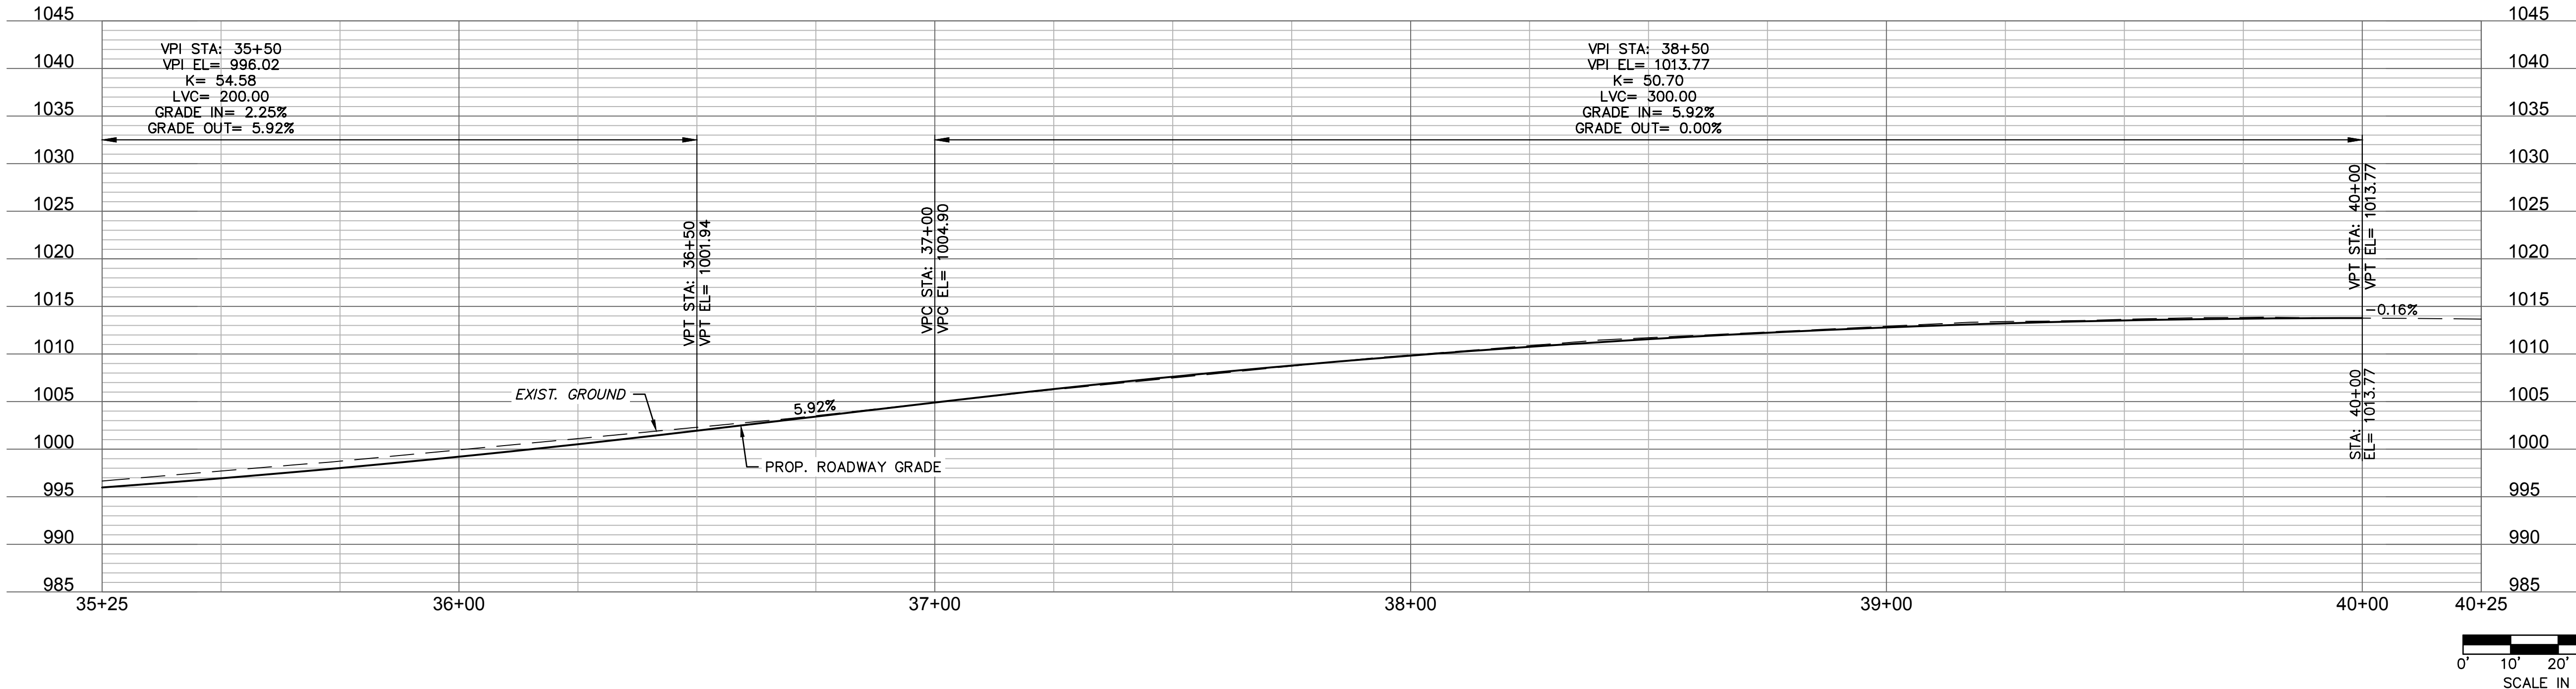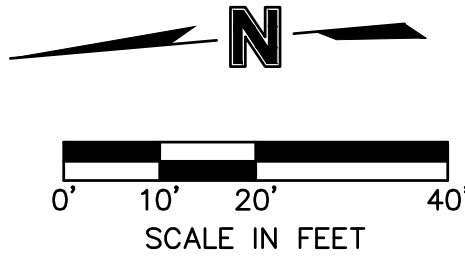

olsson

Olsson Engineering - MO State Certificate of Authority #001592
7301 West 133rd Street, Suite 200 TEL 913.381.1170
Overland Park, KS 66213-4750 FAX 913.381.1174 www.olson.com

RECORD
DRAWINGS

RYAN B. FLEMING
MO. NO. PE-2002003161

REV. NO.	DATE	REVISIONS DESCRIPTION	BY

REVISIONS

PLAN AND PROFILE
MAIN STREET





SCANNELL DEVELOPMENT LEE'S SUMMIT LOGISTICS
NORTHWEST CORNER OF TUDOR ROAD AND MAIN STREET





LEE'S SUMMIT, MISSOURI

2021

C.O.A. NO.:
DRAWN BY: ARJ/AMW
CHECKED BY: XXX
APPROVED BY: RBE
QA/QC BY: RBE
PROJECT NO.: 021-04157
DWG NO.: T_RPP01_02104157
DATE: 2021-10-12

SHEET
24 OF 105

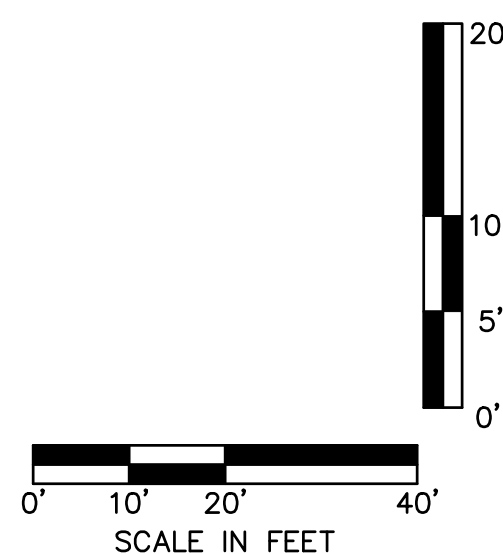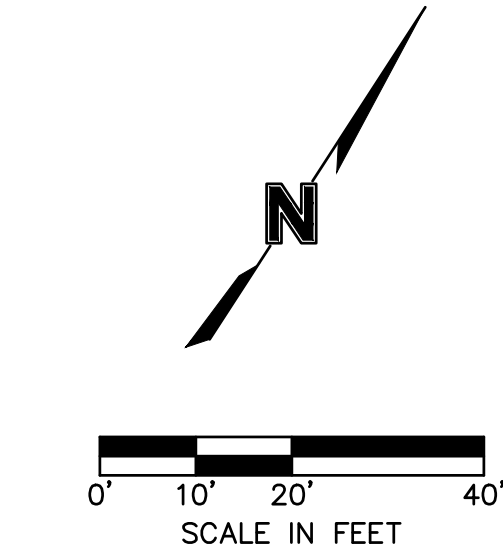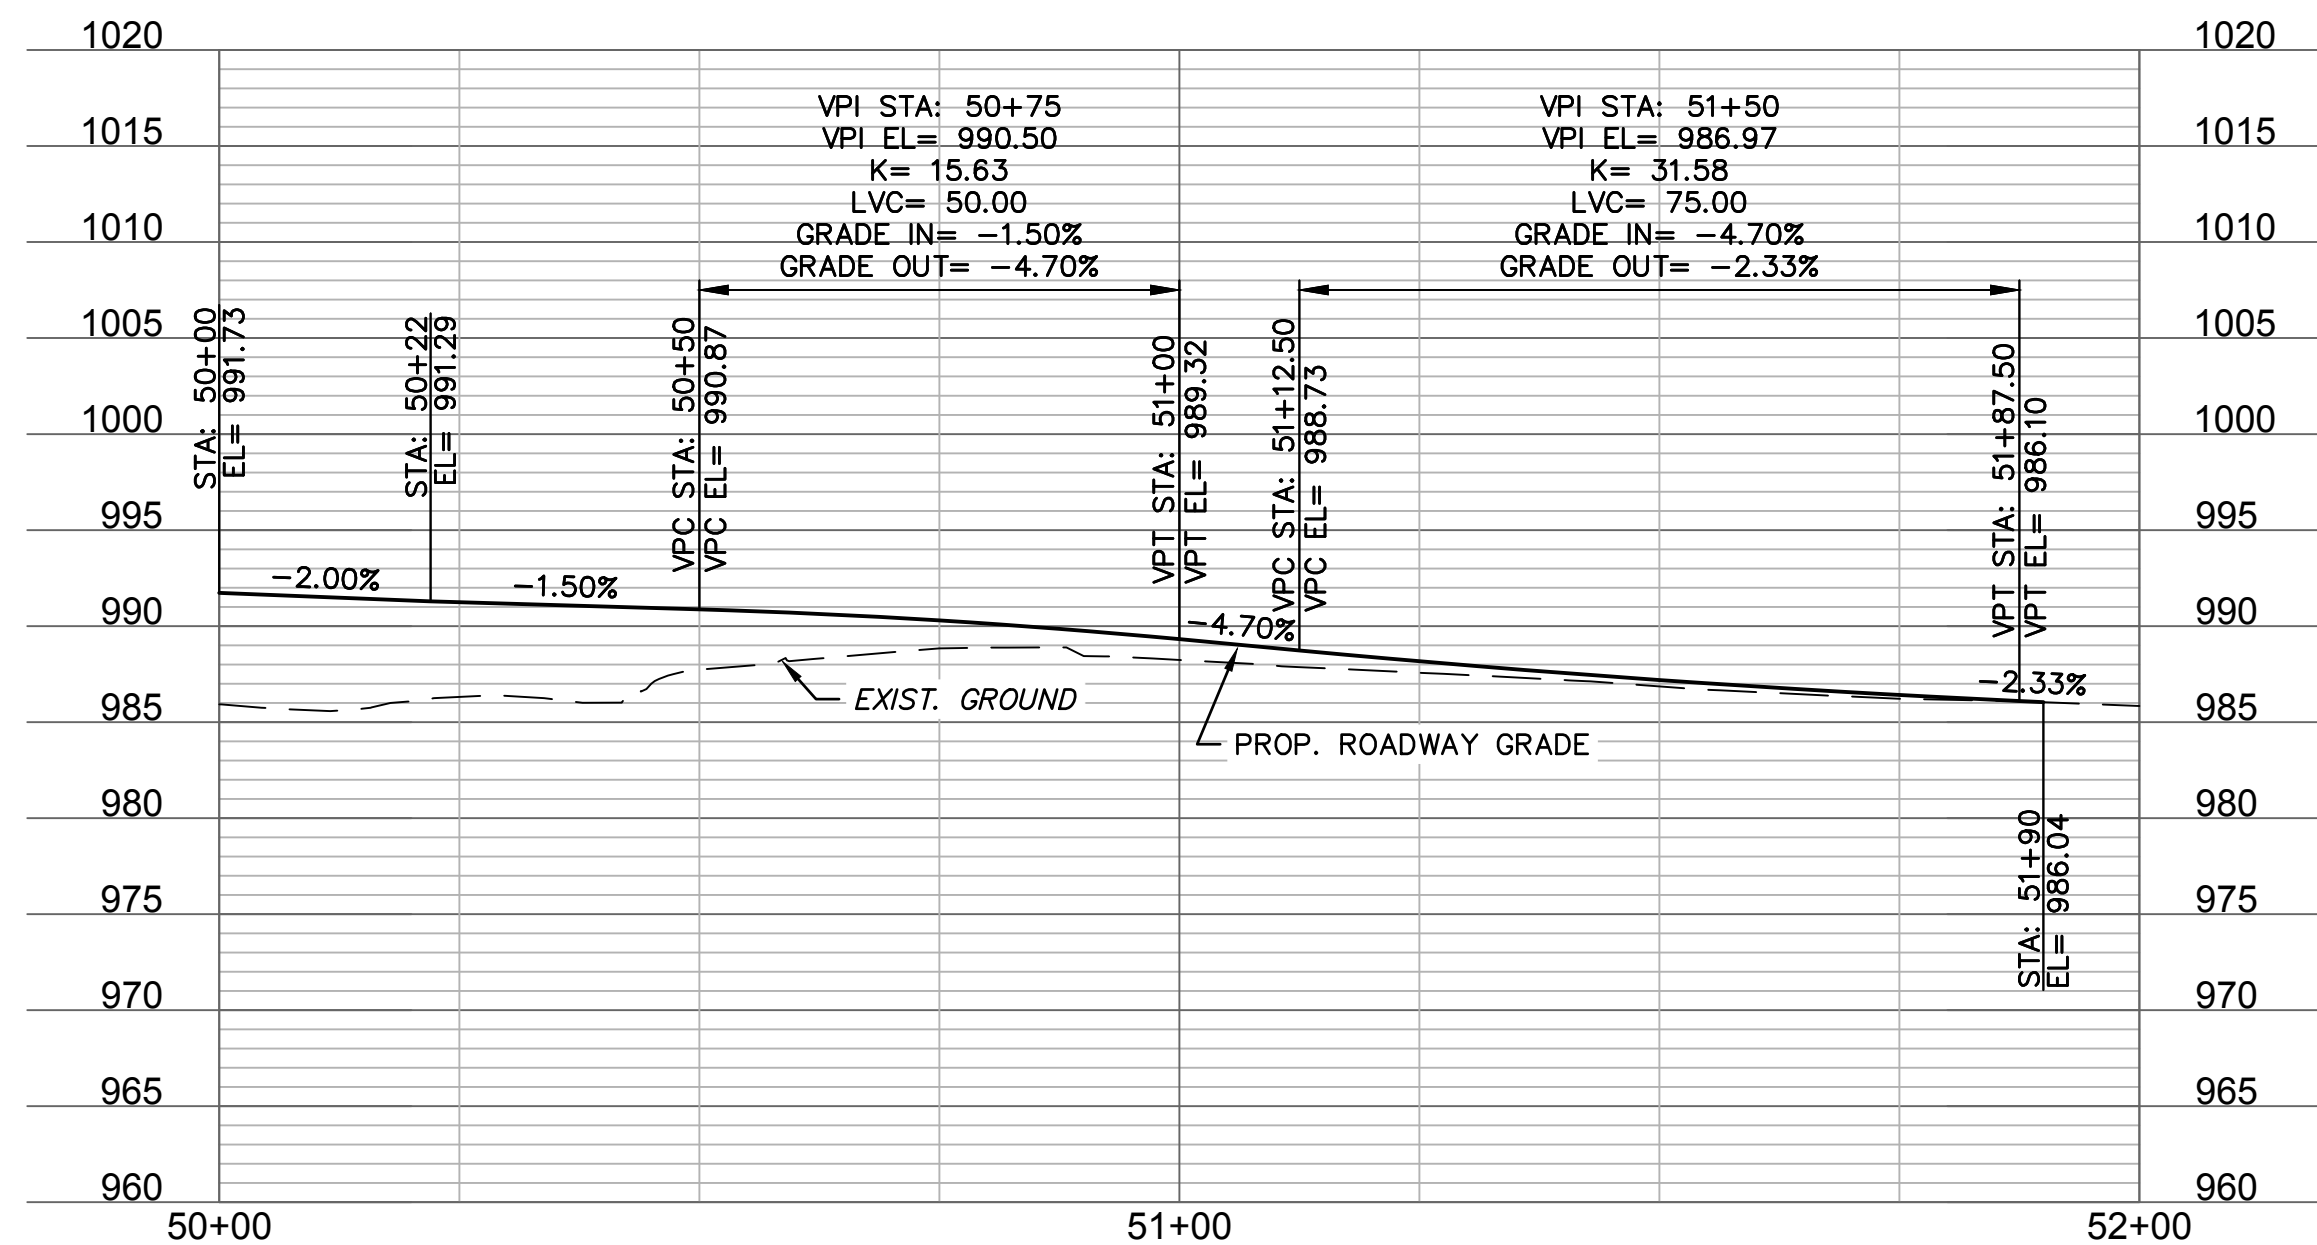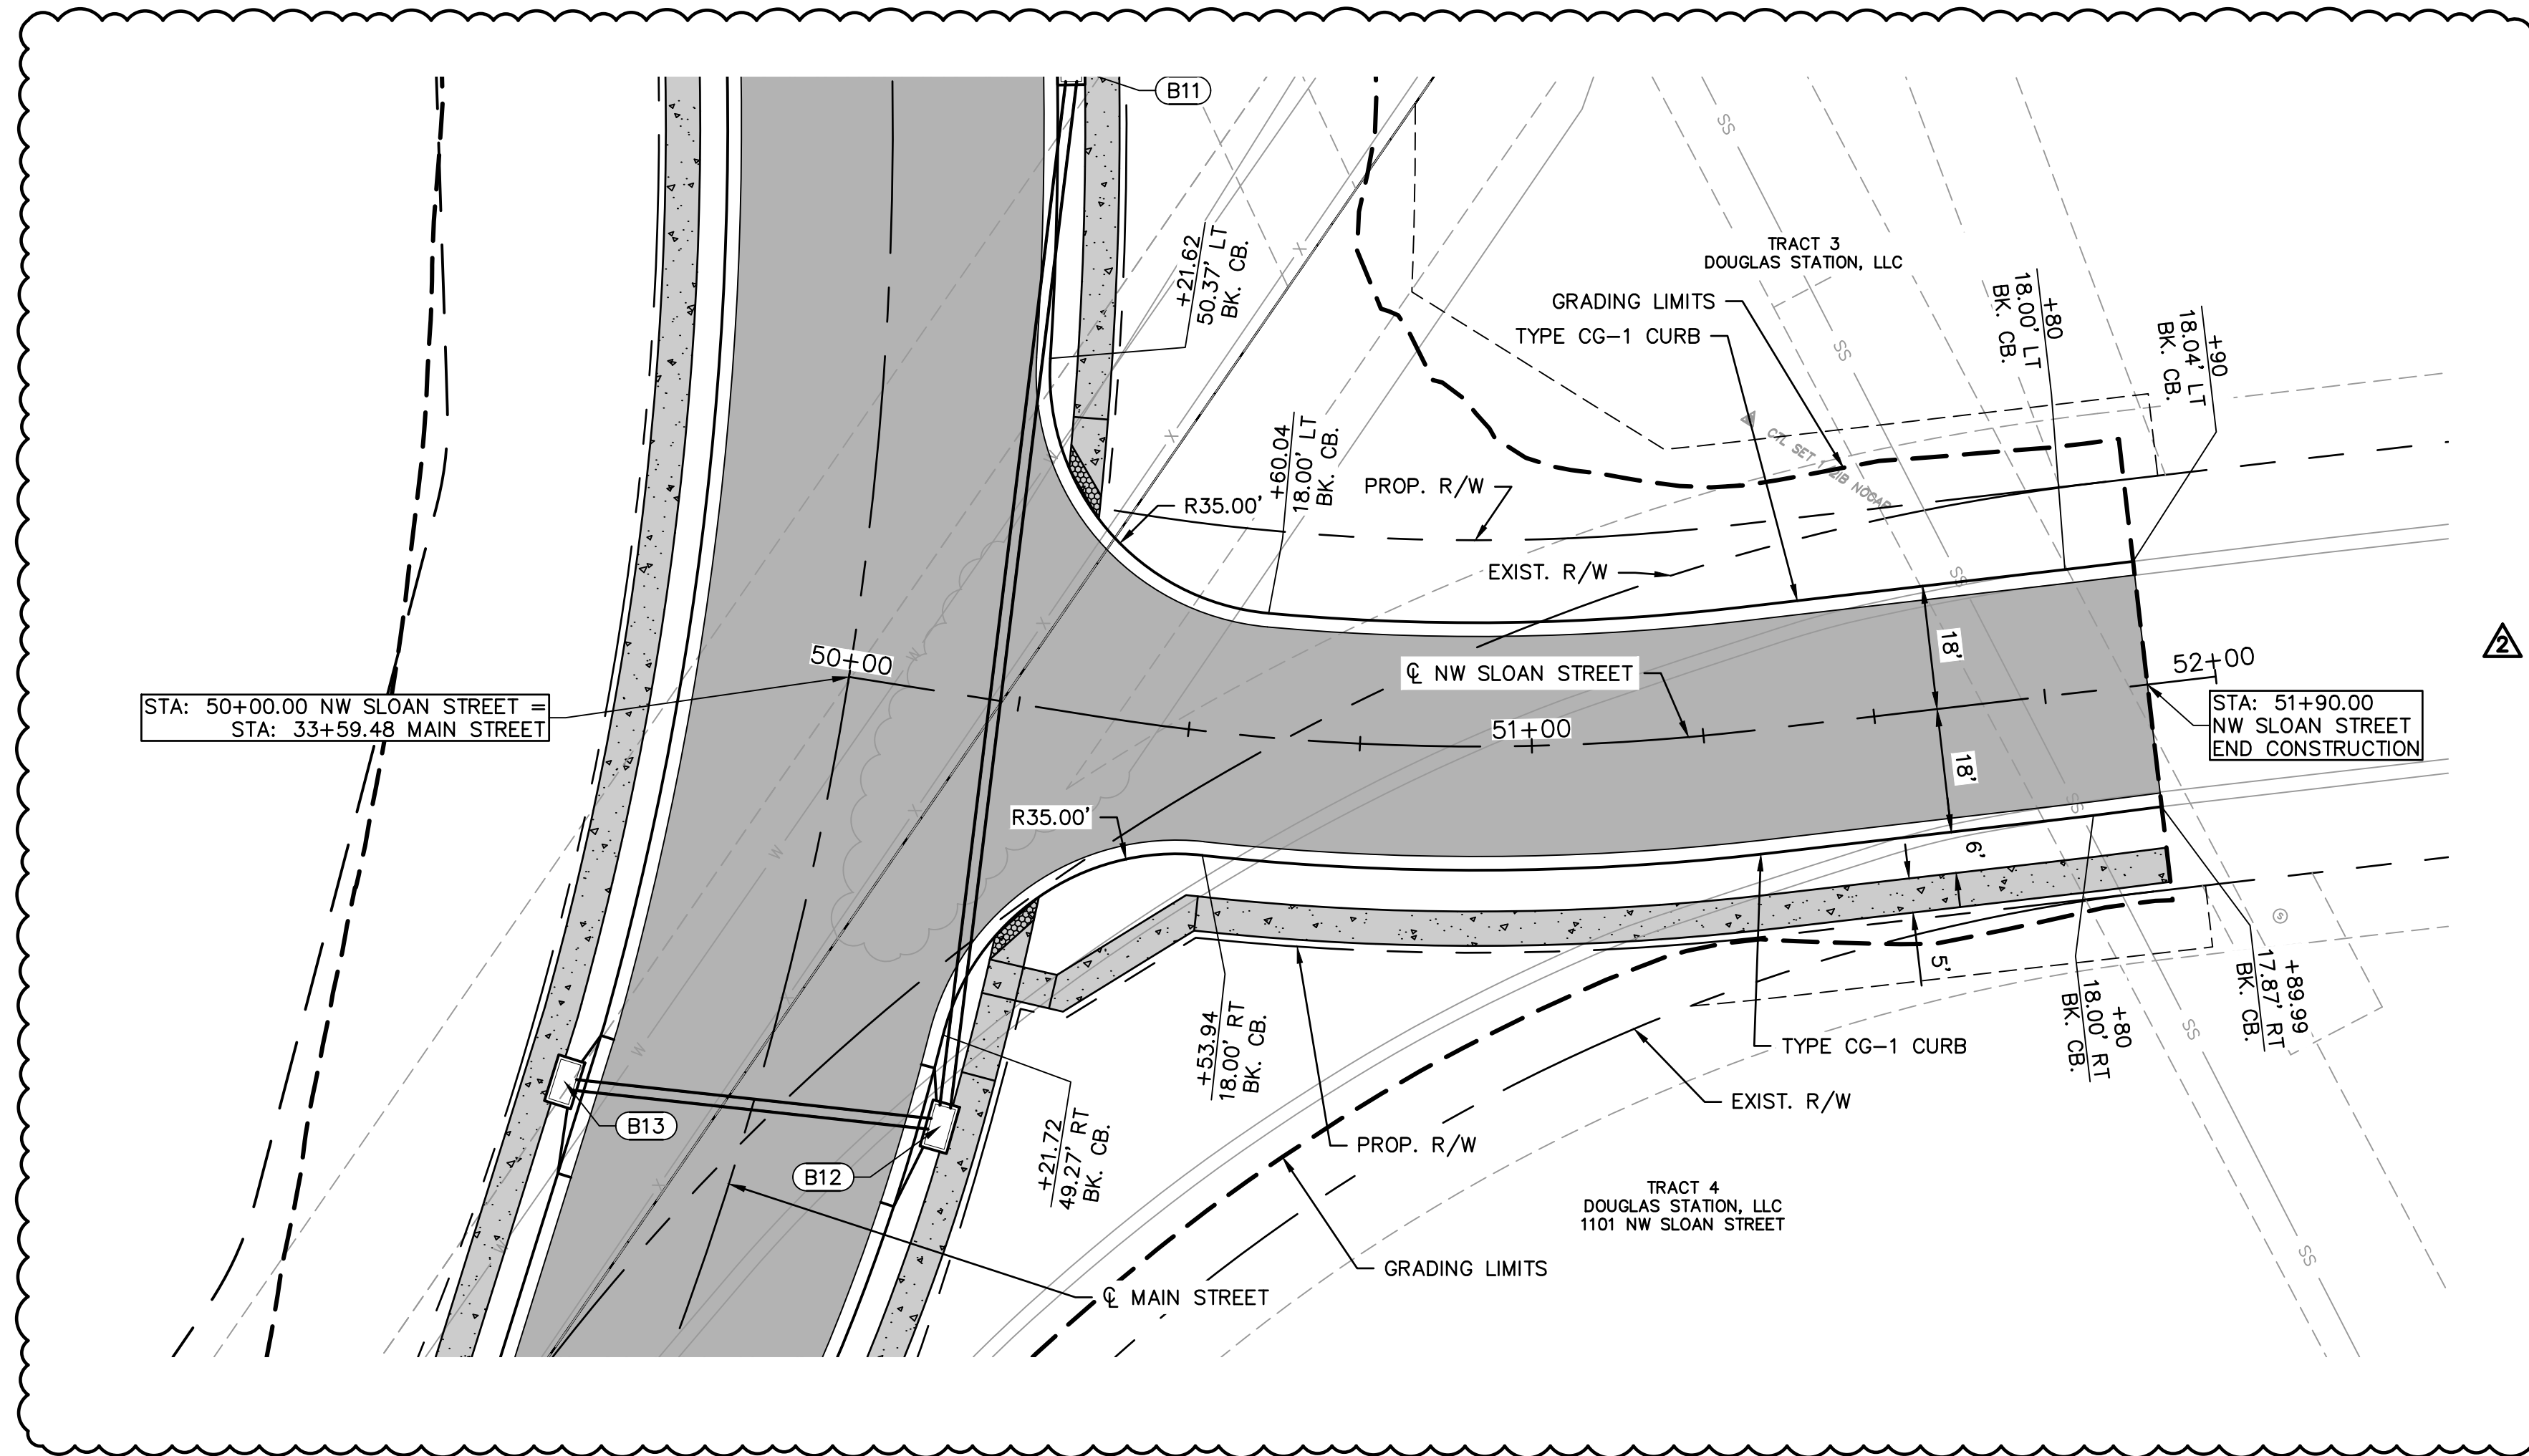


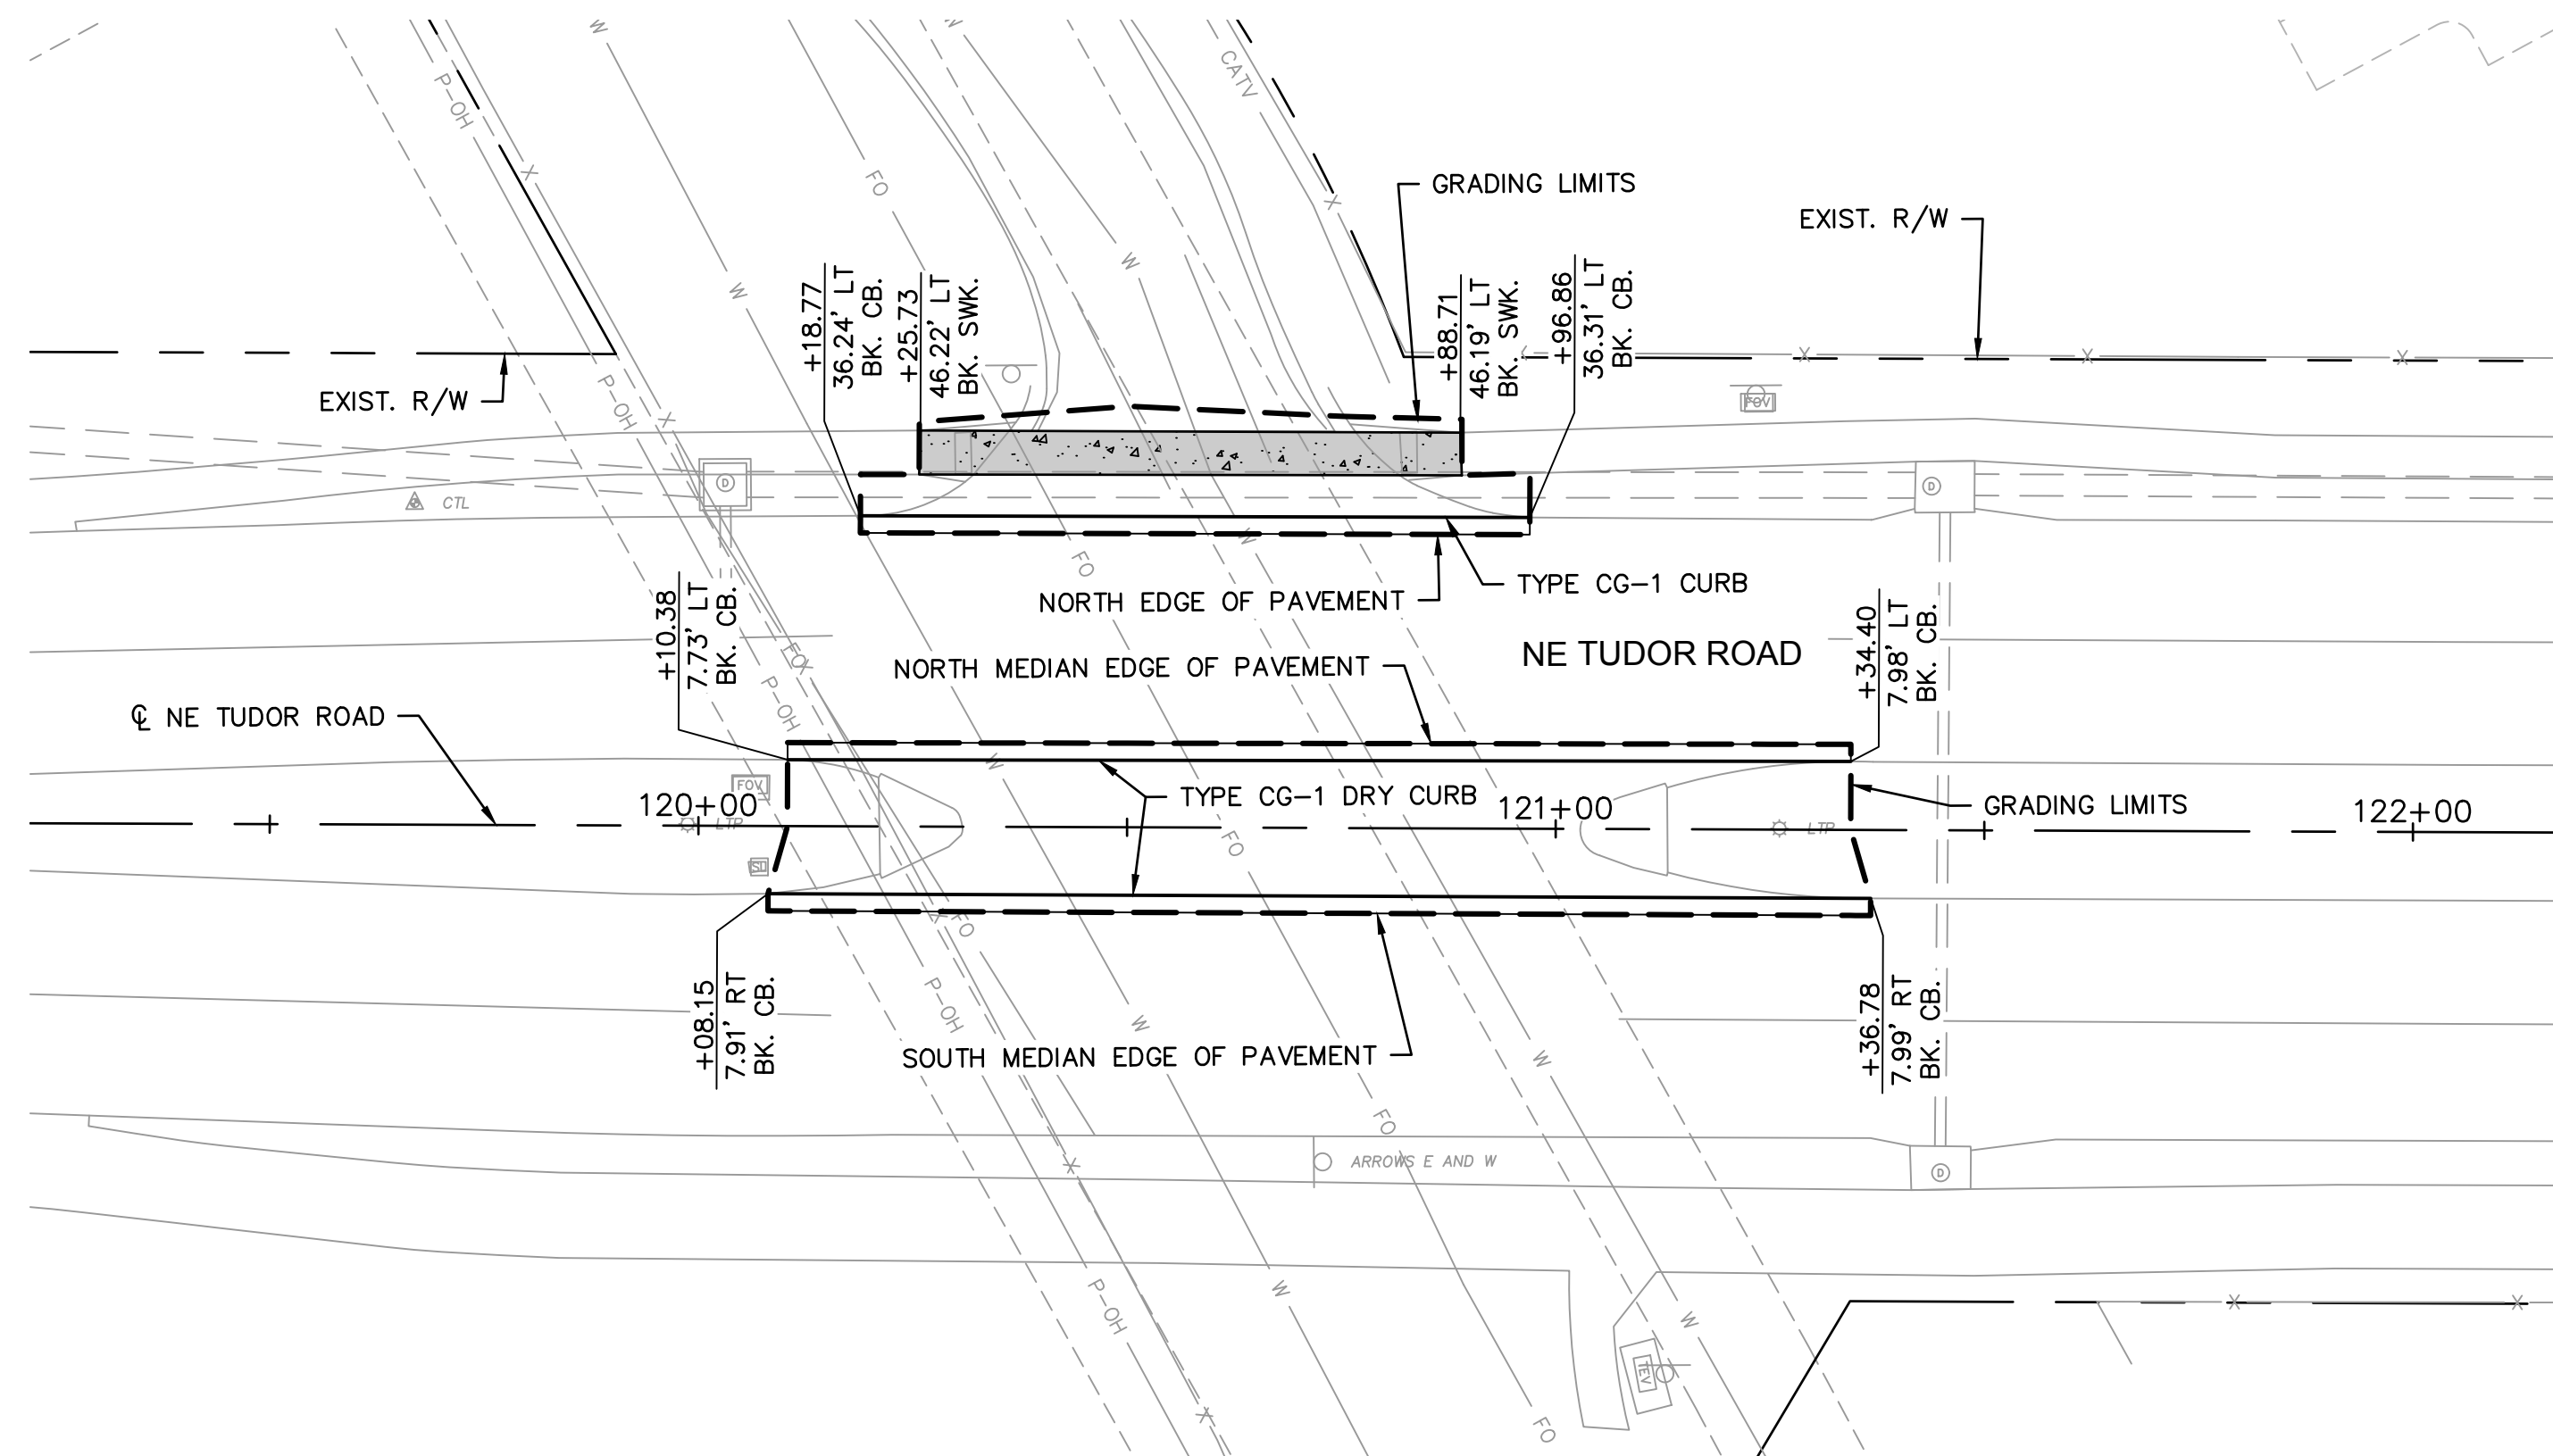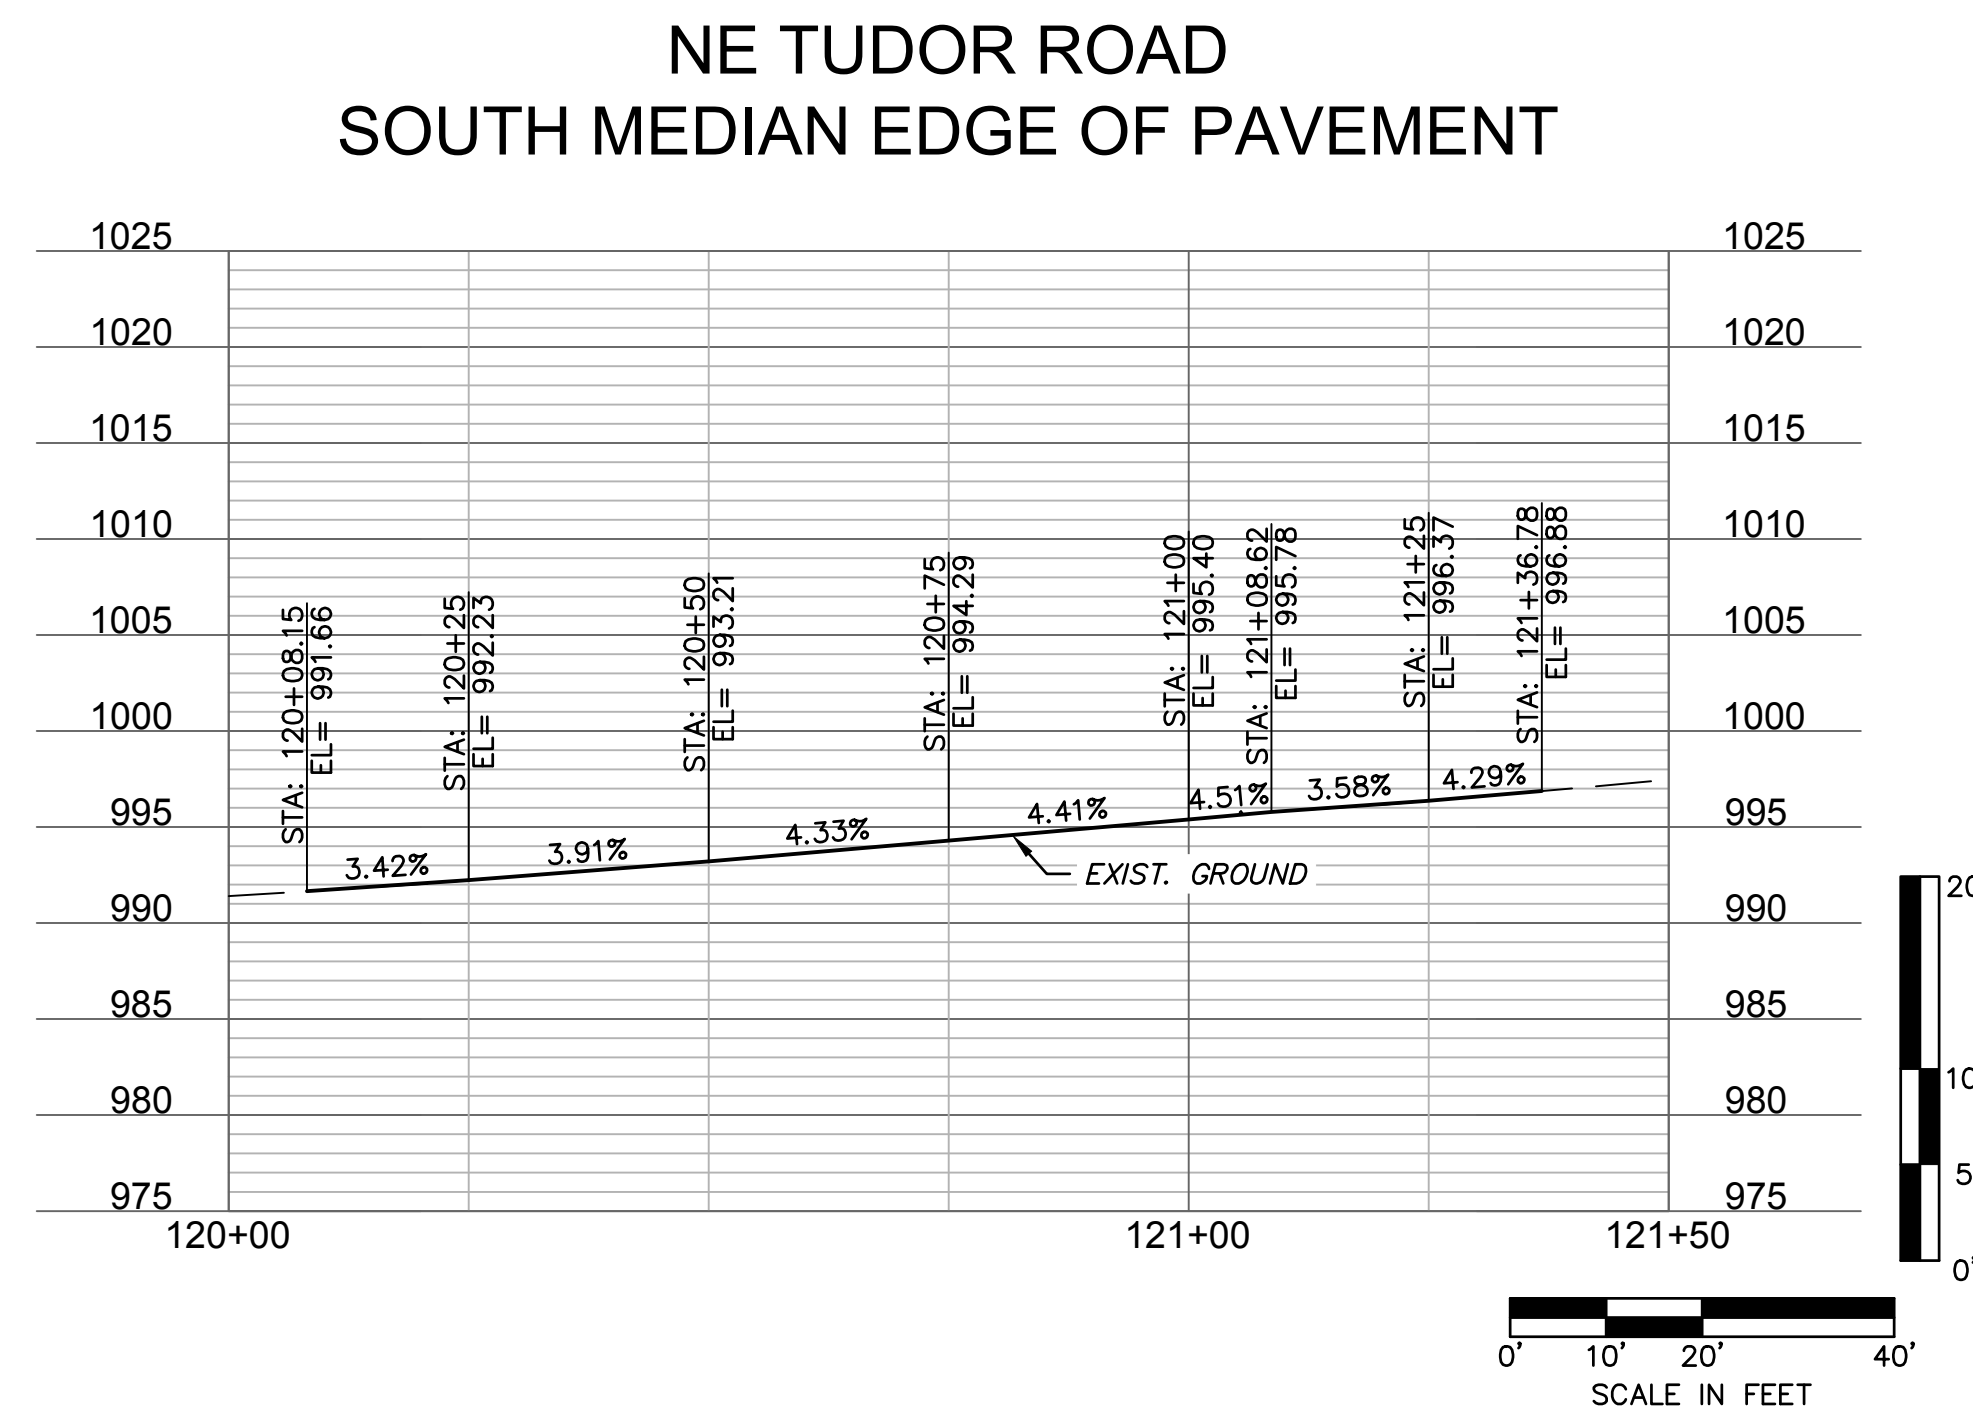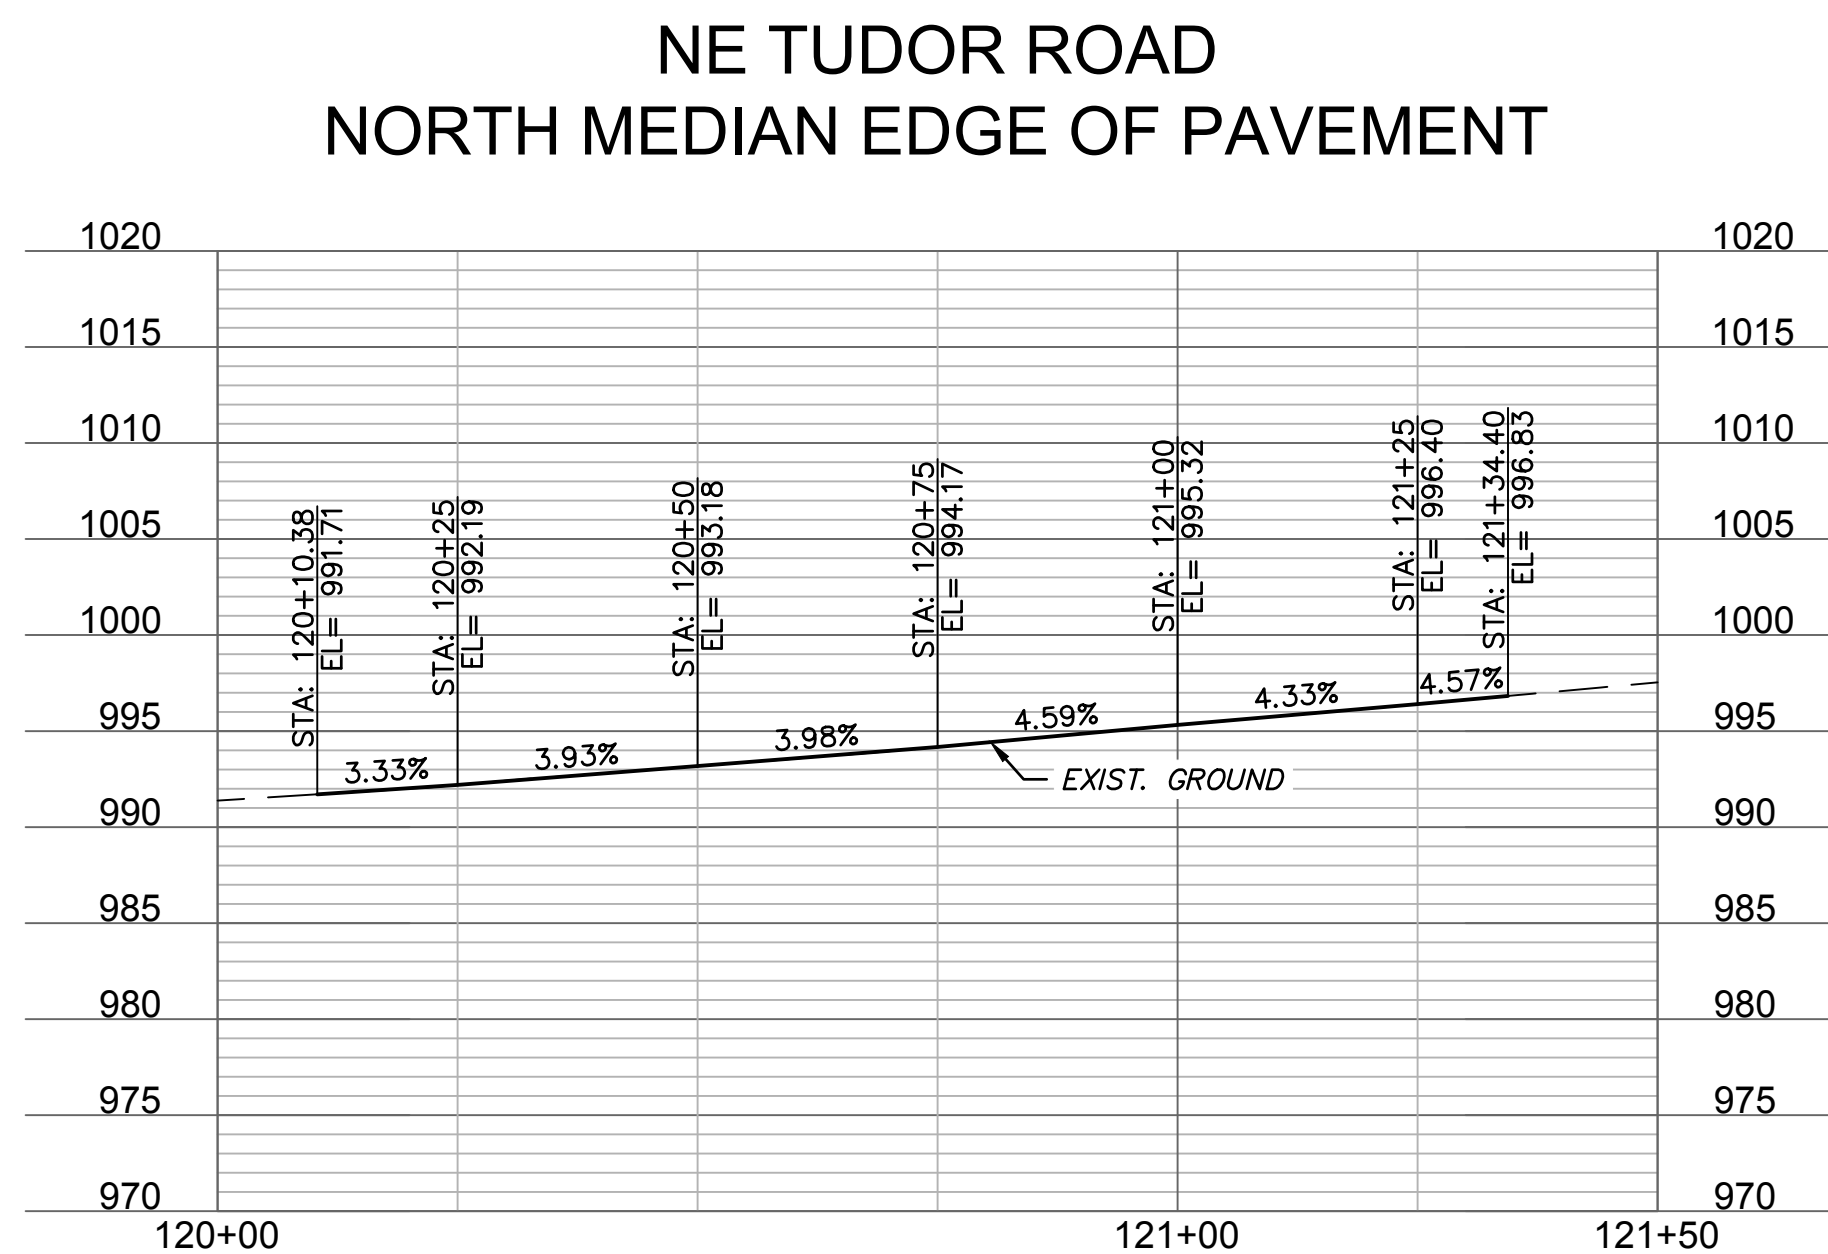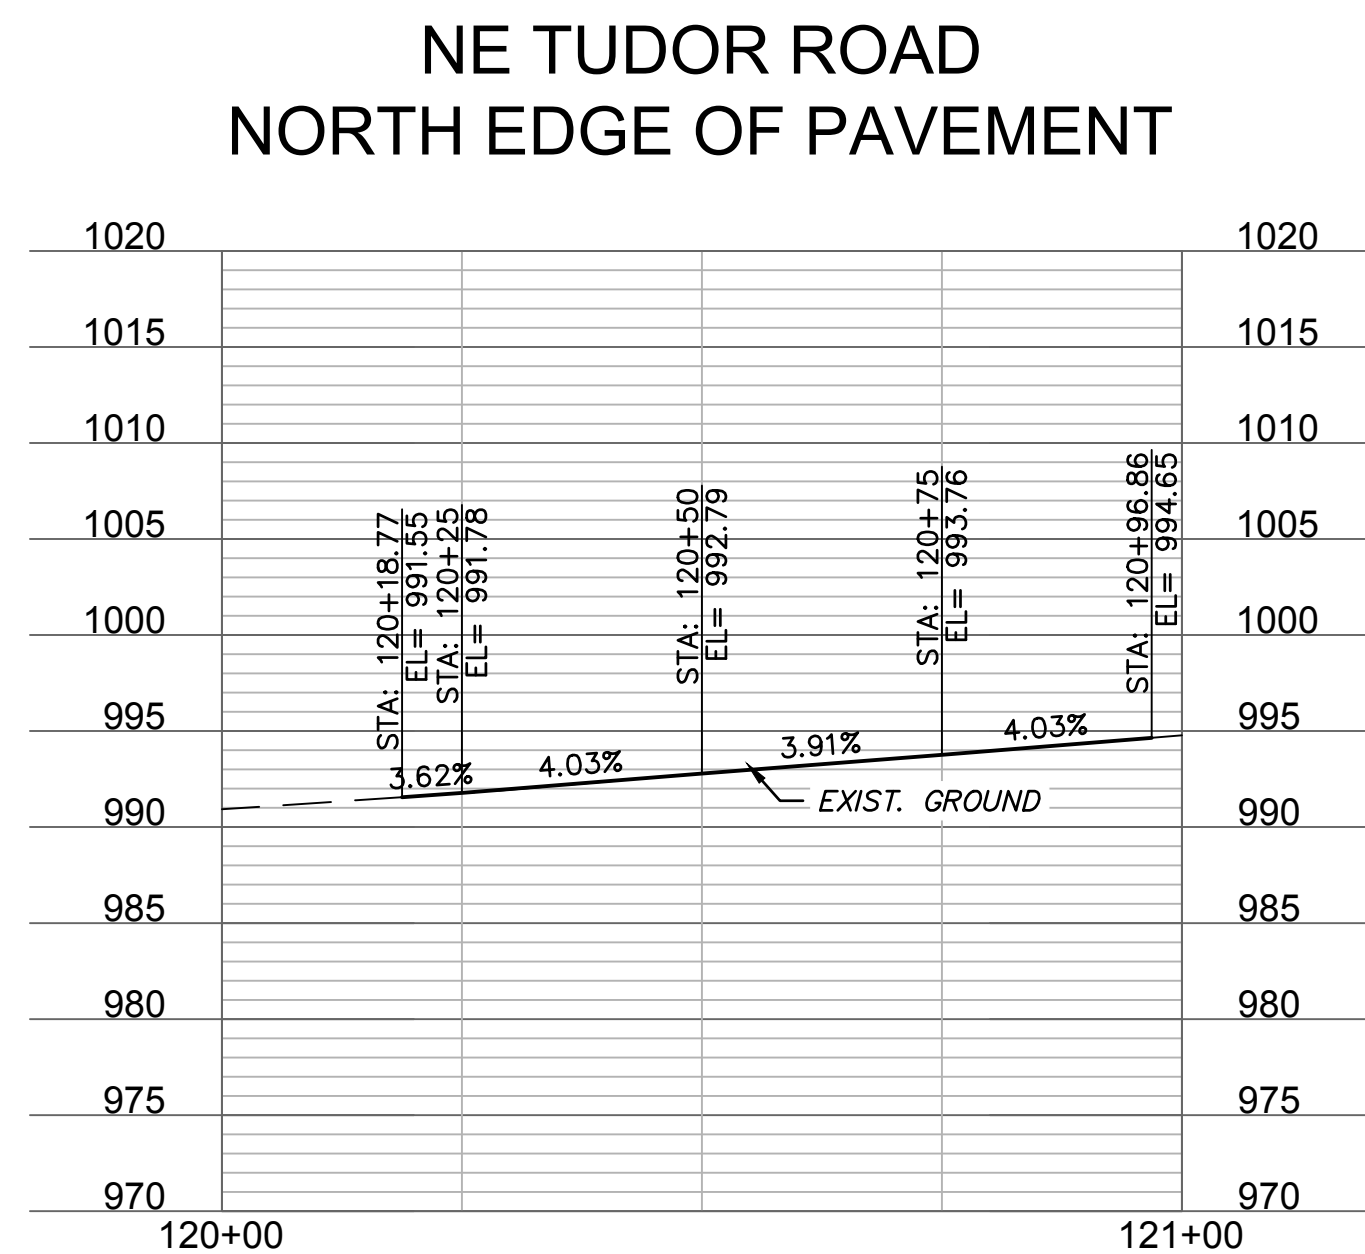

LEGEND

 ASPHALT

 CONCRETE SIDEWALK

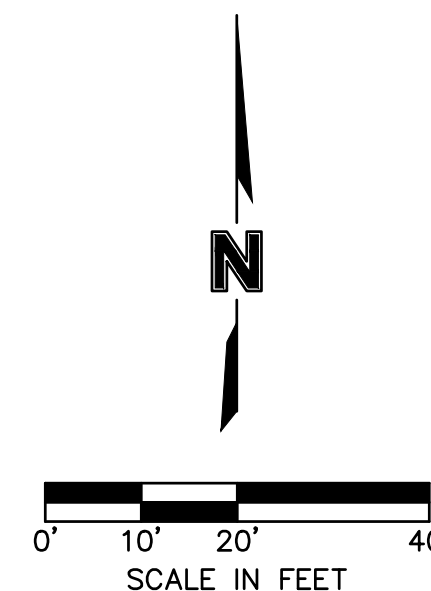

RECORD
DRAWINGS

RYAN B. FLEMING
MO. NO. PE-200200316


[illegible]

PLAN AND PROFILE NE TUDOR ROAD	
SCANNELL DEVELOPMENT LEE'S SUMMIT LOGISTICS NORTHWEST CORNER OF TUDOR ROAD AND MAIN STREET	
LEE'S SUMMIT, MISSOURI	2021


C.O.A. NO.: _____ -
 DRAWN BY: _____ ARJ/AMW
 CHECKED BY: _____ XXX
 APPROVED BY: _____ RBF
 QA/QC BY: _____ RBF
 PROJECT NO.: _____ 021-04157
 DWG NO.: T_RPP01_02104157
 DATE: _____ 2021-10-12

SHEET
26 OF 105


DWG: F:\20104001-04500\021-04157\40-Design\AutoCAD\Final Plans\Sheets\ROBR\T_PINT_02104157.dwg
DATE: Oct 30, 2023 3:49pm XREFS: T_PBASE_02104157 C_PROW_02104157 V_TPO_02104157 T_PTBK_02104157 USER: qscavedra V_XBOU_02104157

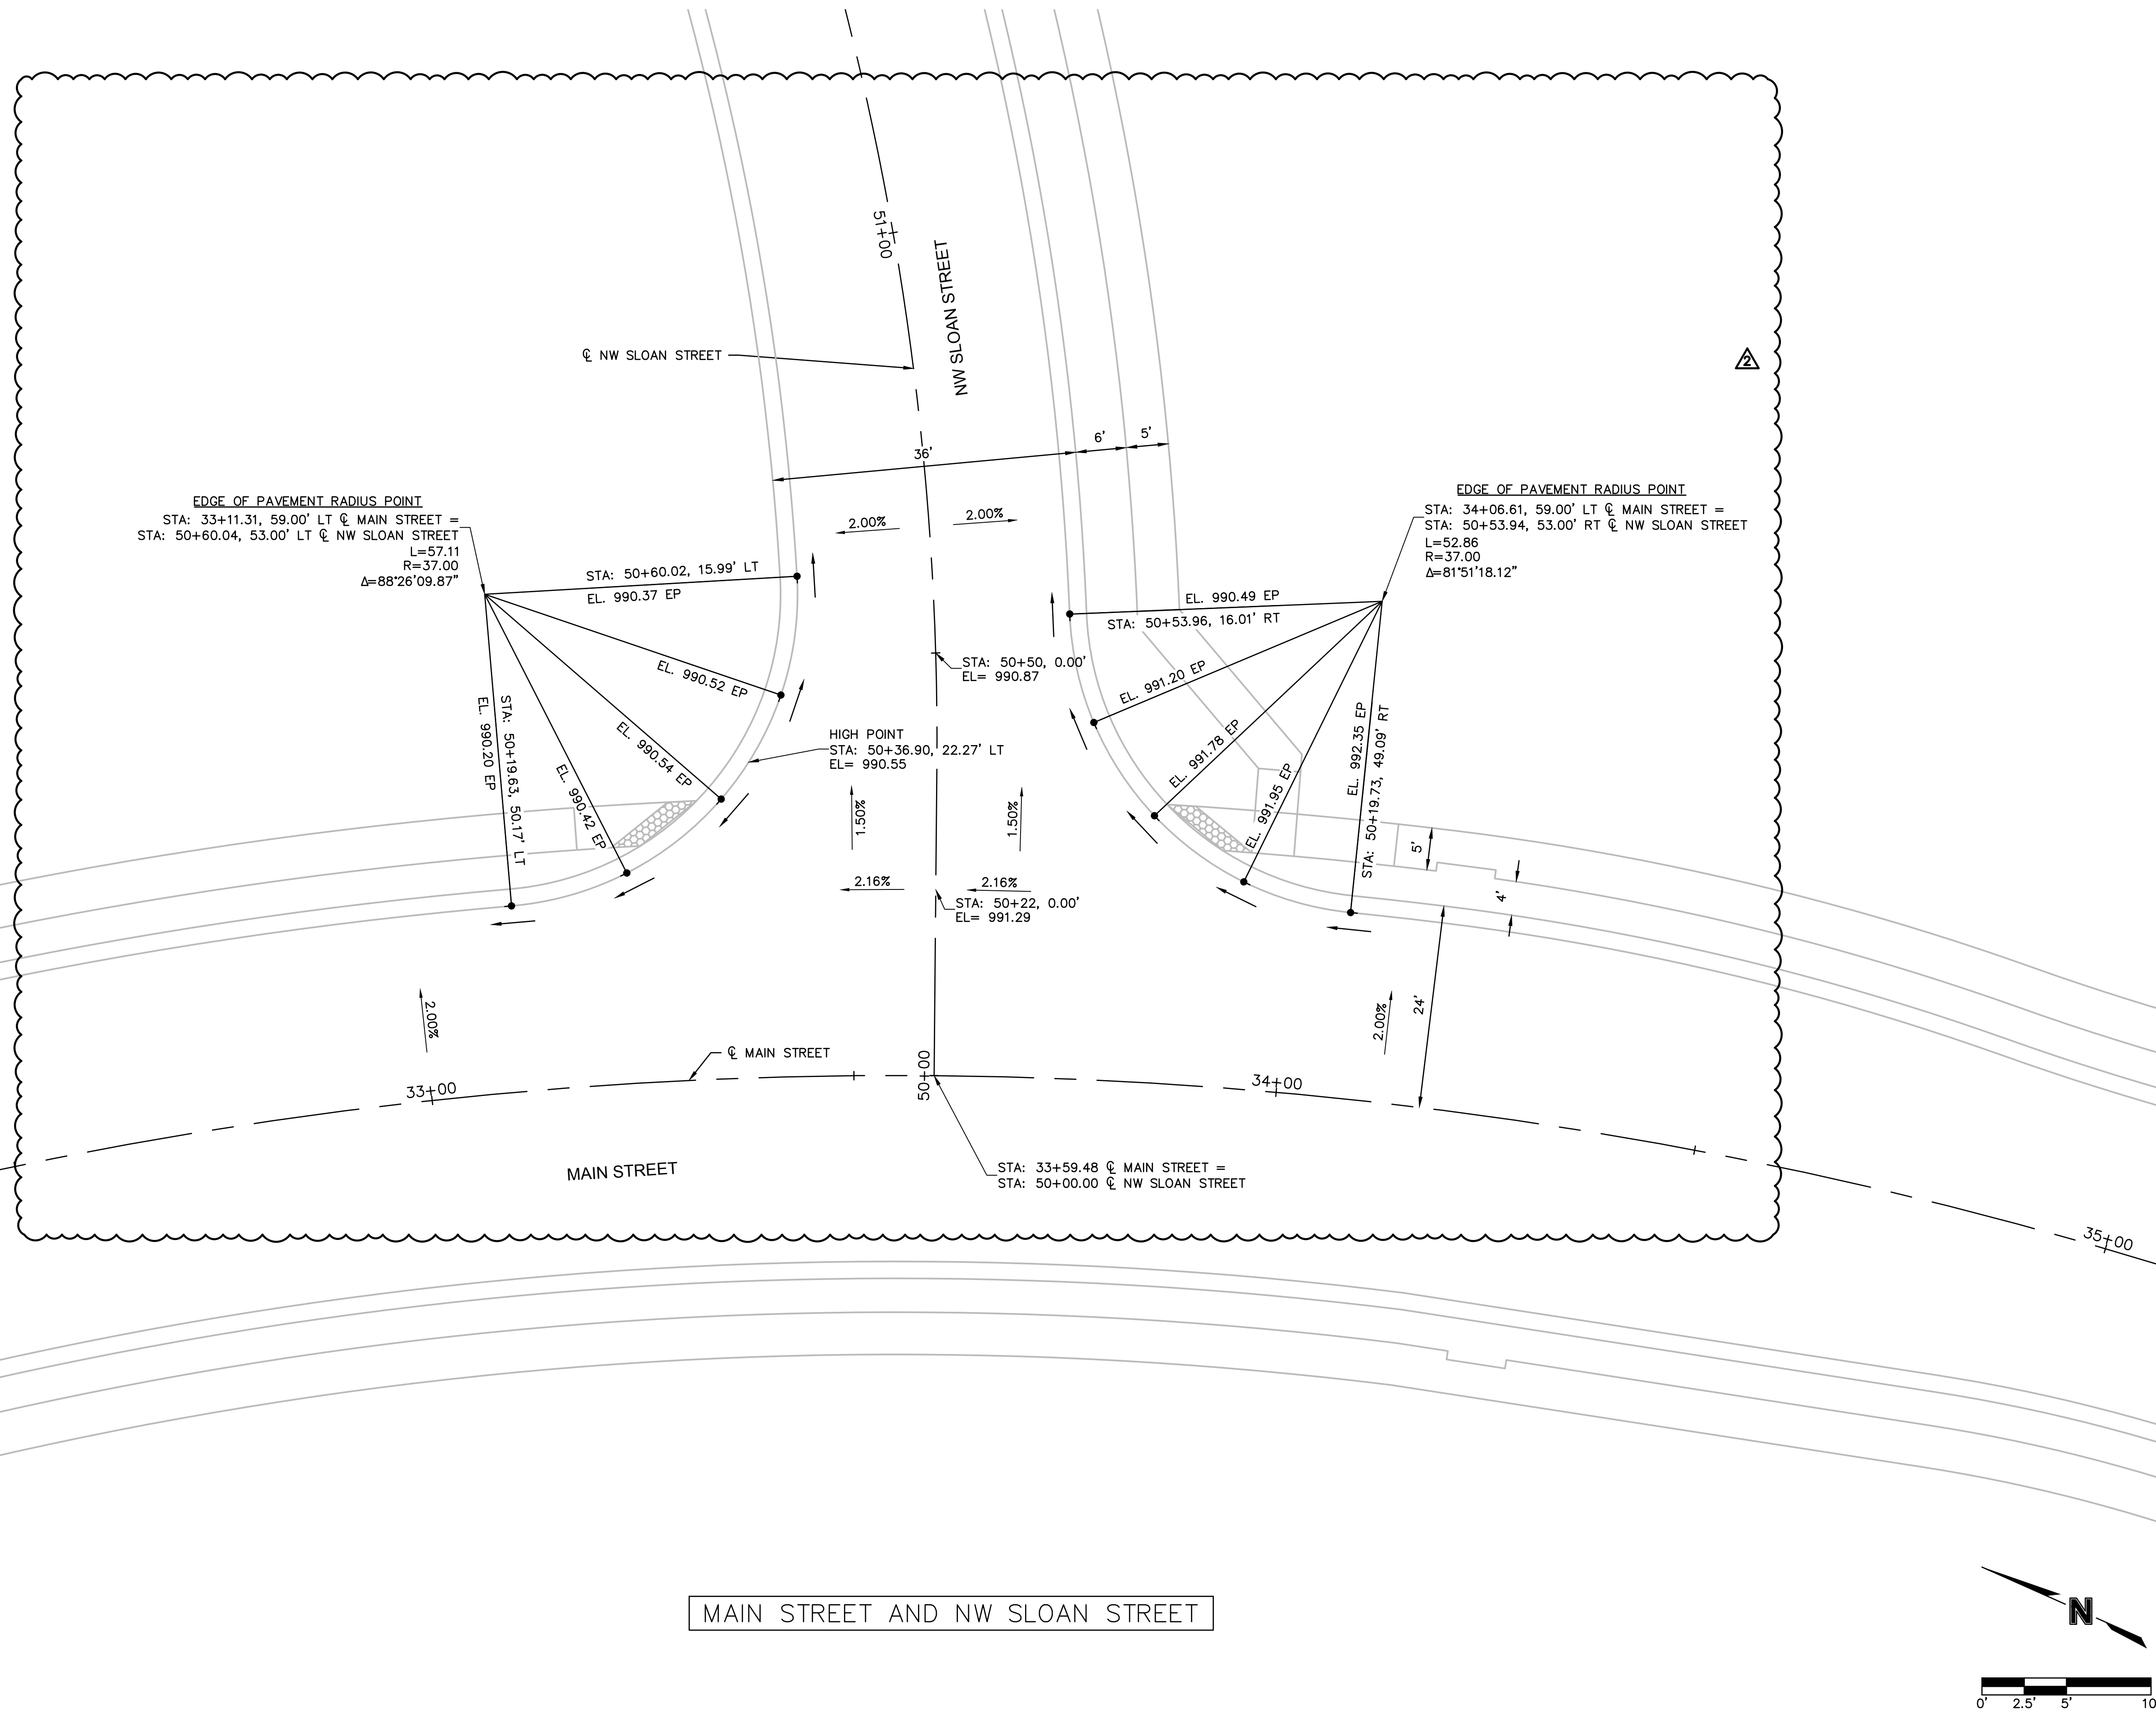


USER: asaavedra

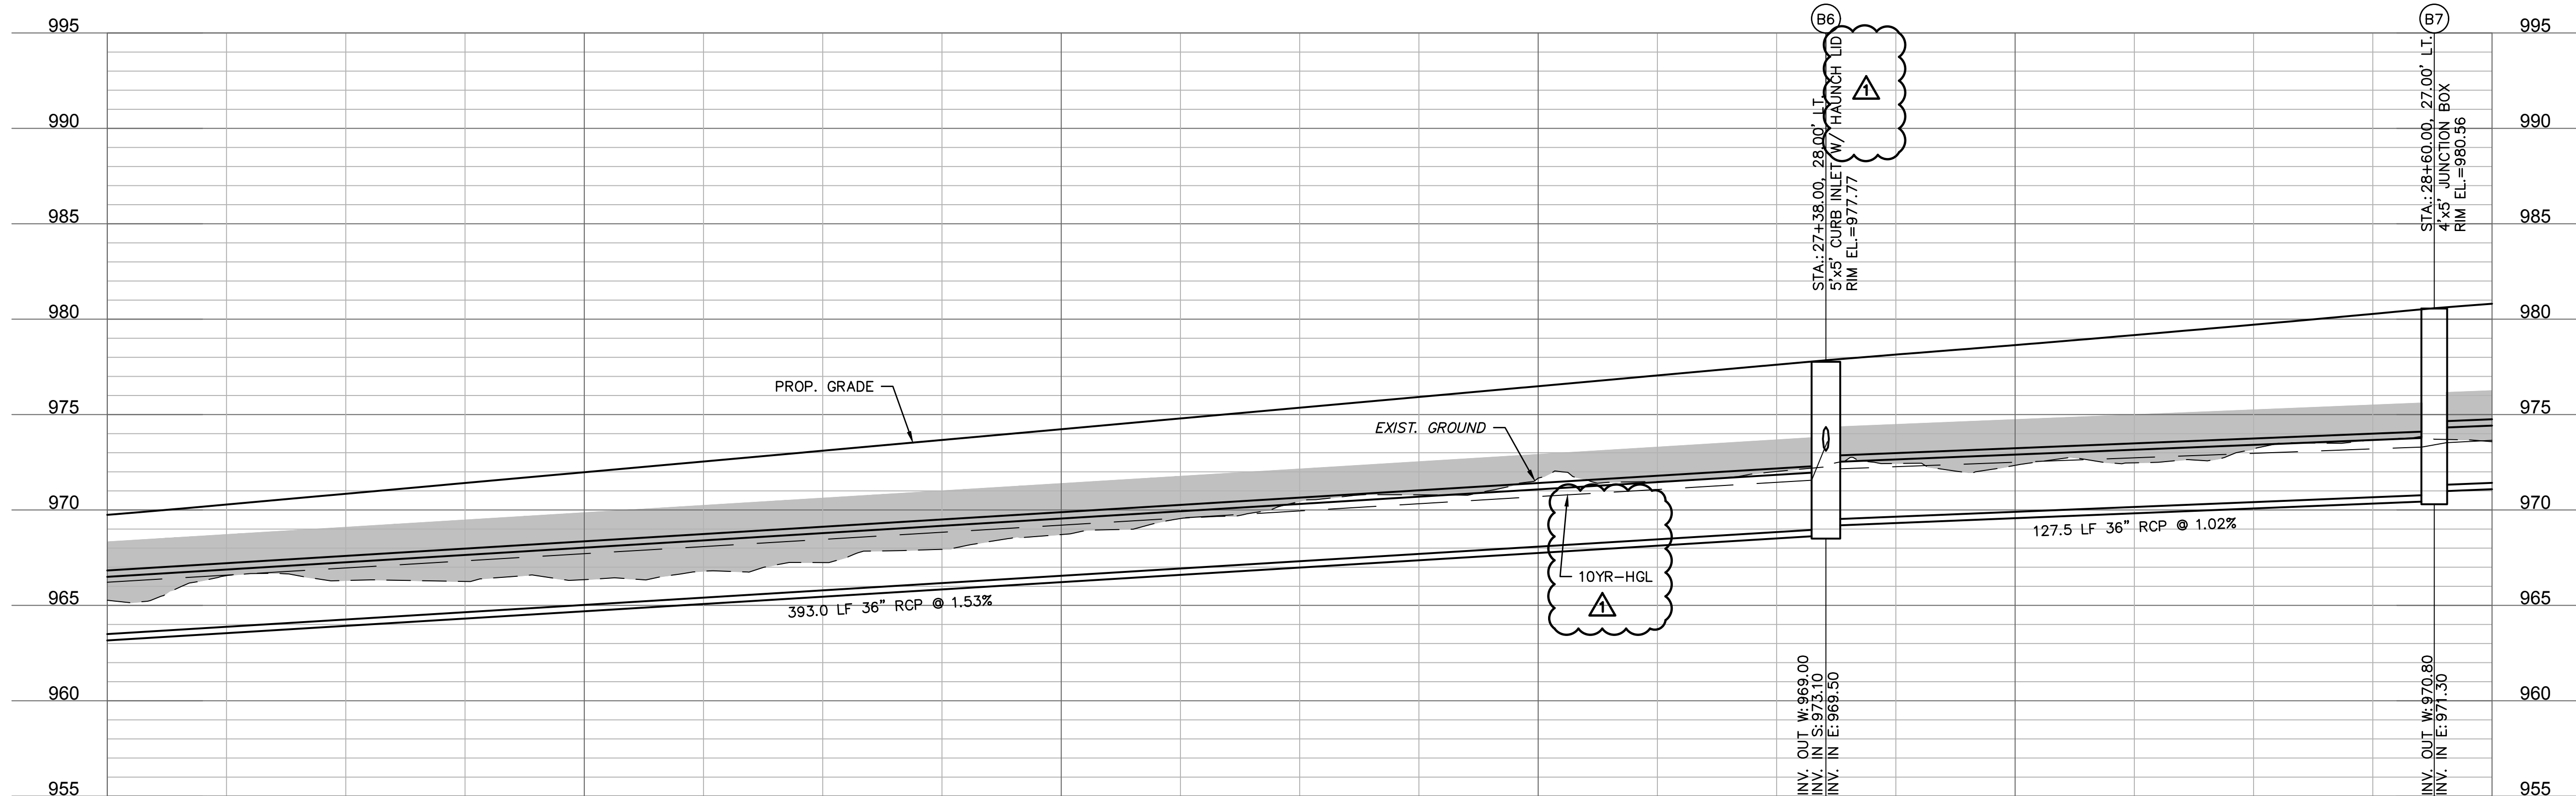

STORM LINE B

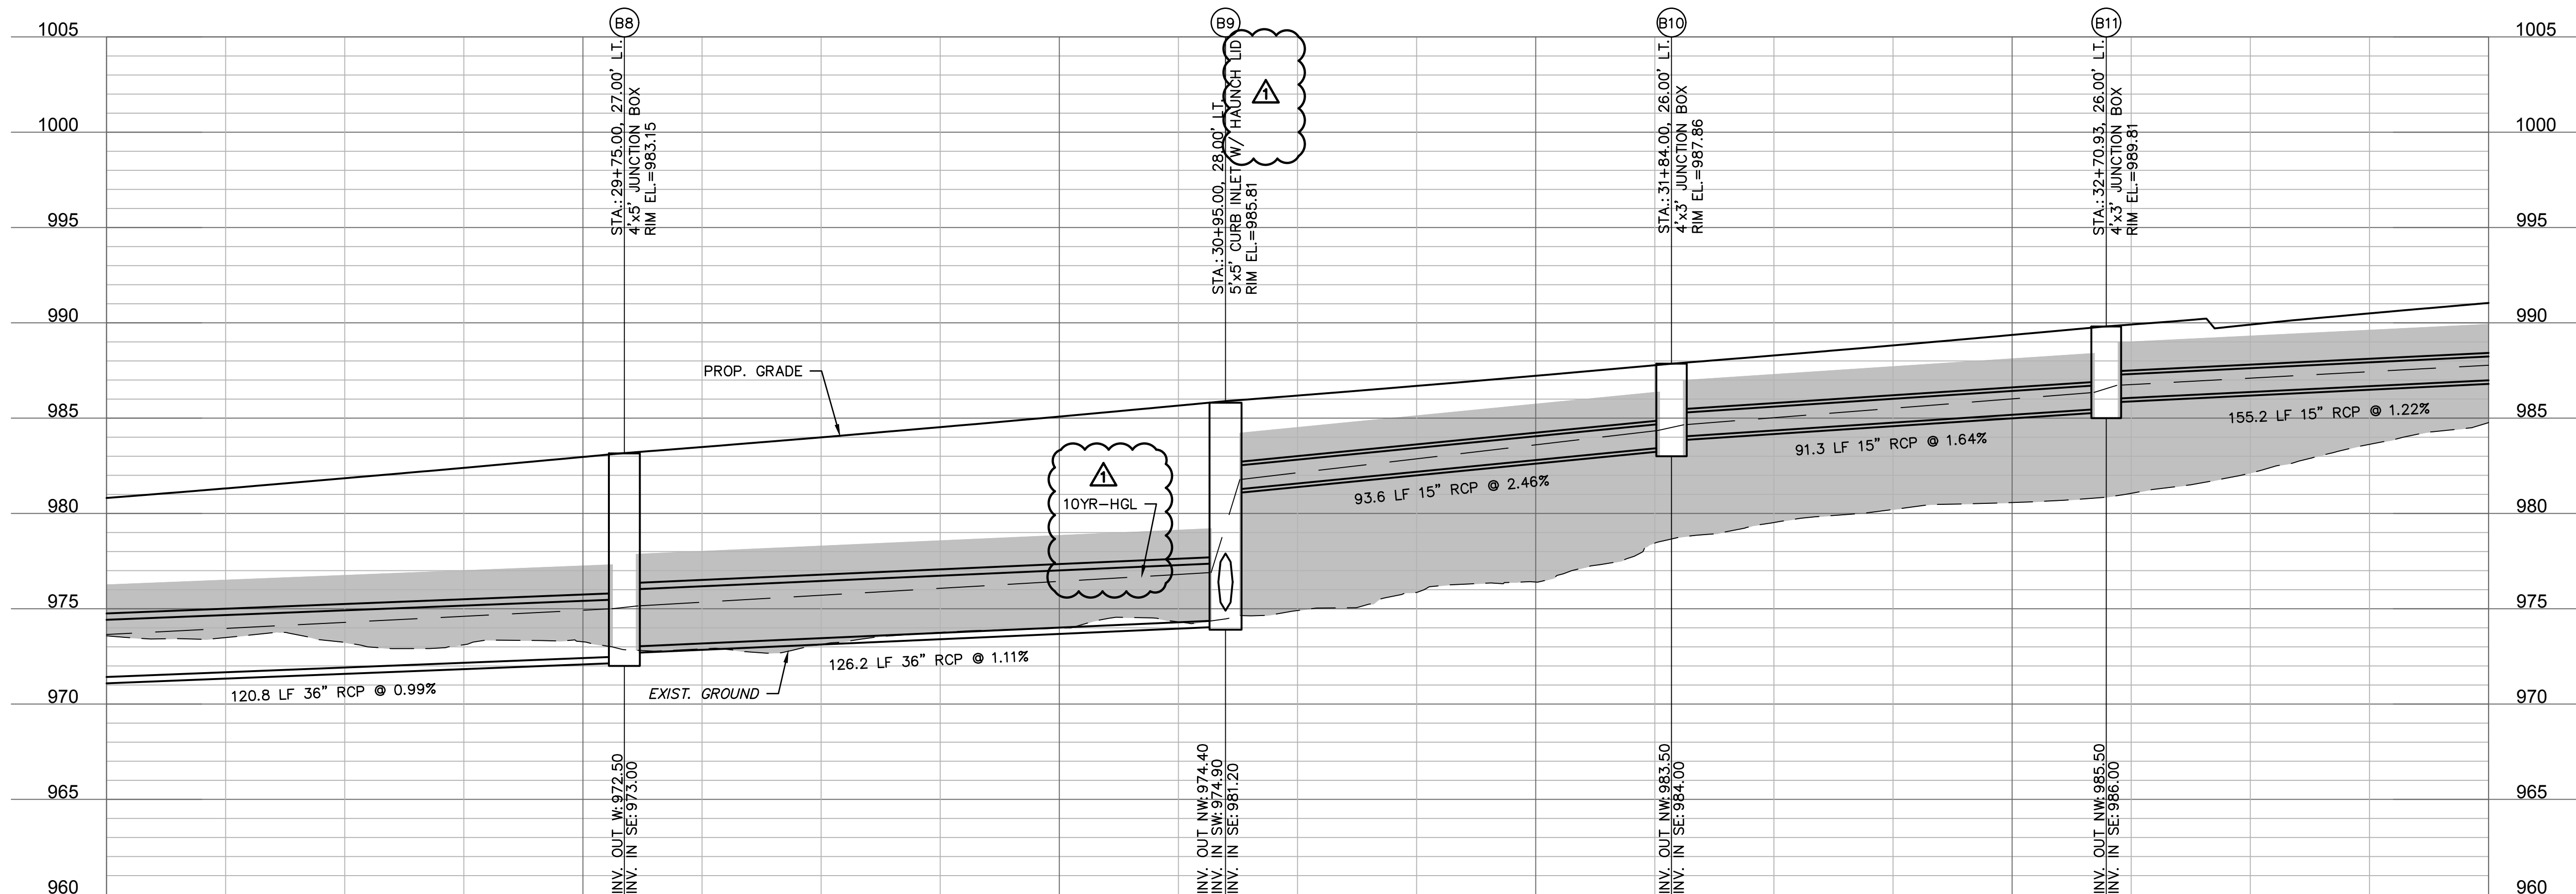

 COMPACTED FILL SHALL BE PLACED TO A MINIMUM OF 18" ABOVE THE TOP OF THE PIPE PRIOR TO INSTALLATION.

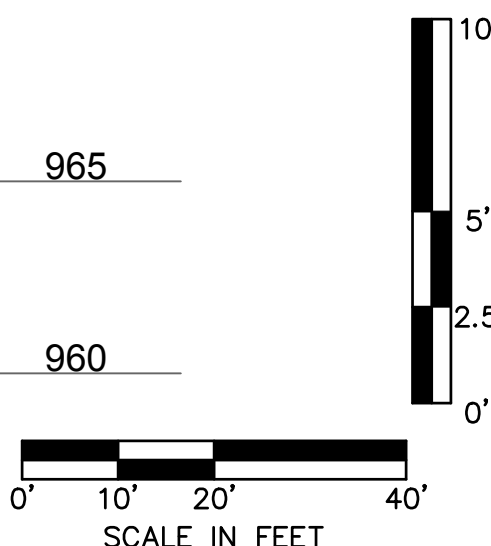

STORM SEWER PROFILES

SCANNELL DEVELOPMENT LEE'S SUMMIT LOGISTICS
NORTHWEST CORNER OF TUDOR ROAD AND MAIN STREET

LEE'S SUMMIT	MISSOURI	2017
--------------	----------	------

C.O.A. NO.: _____
 DRAWN BY: _____ ARJ/AMW
 CHECKED BY: _____ XXX
 APPROVED BY: _____ RBF
 QA/QC BY: _____ RBF
 PROJECT NO.: _____ 021-04157
 DWG NO.: T_STM01_02104157
 DATE: 2021-10-12

SHEET
30 OF 105

RECORD
DRAWINGS







RYAN B. FLEMING
MO. NO. PE-200200316

[illegible]


ET	2021
----	------

oson

Olsson Engineering - MO State Certificate of Authority #001592
7301 West 133rd Street, Suite 200 TEL 913.381.1170
Overland Park, KS 66212 4750 FAX 913.381.1171 www.olsson.com

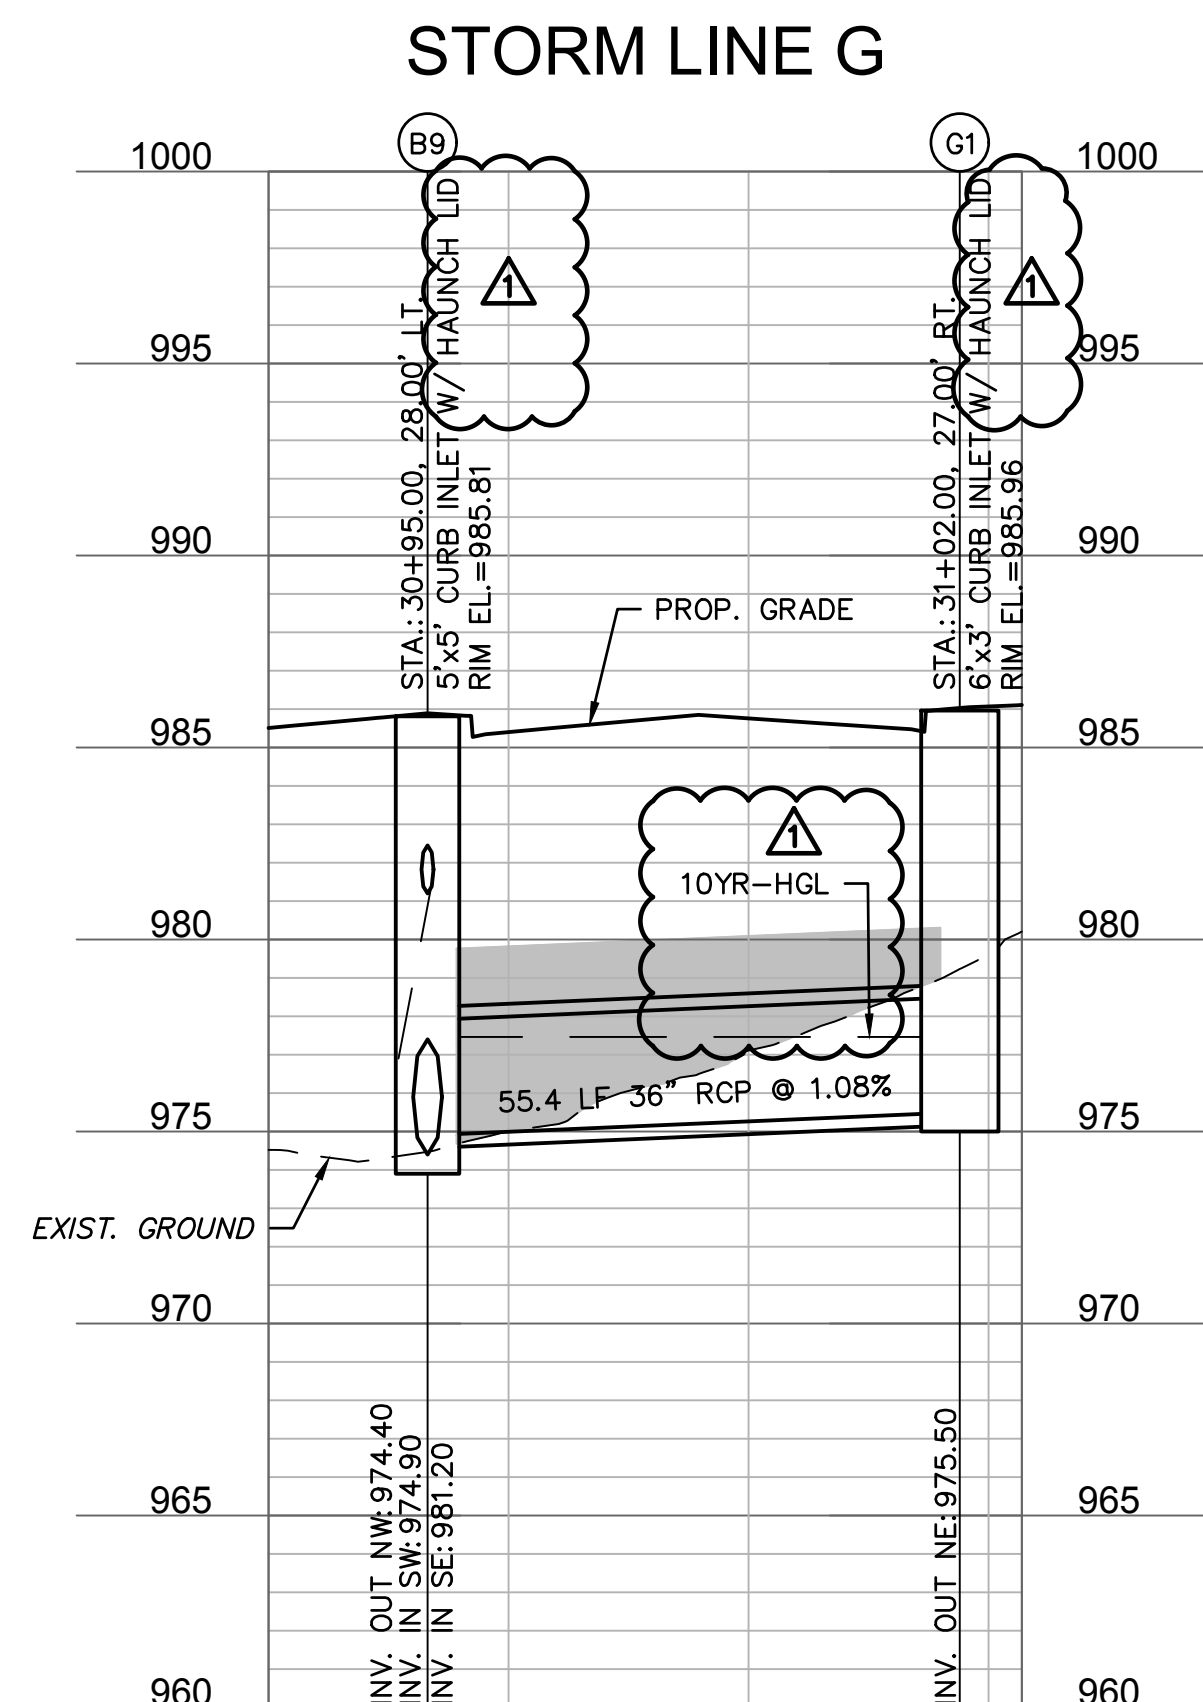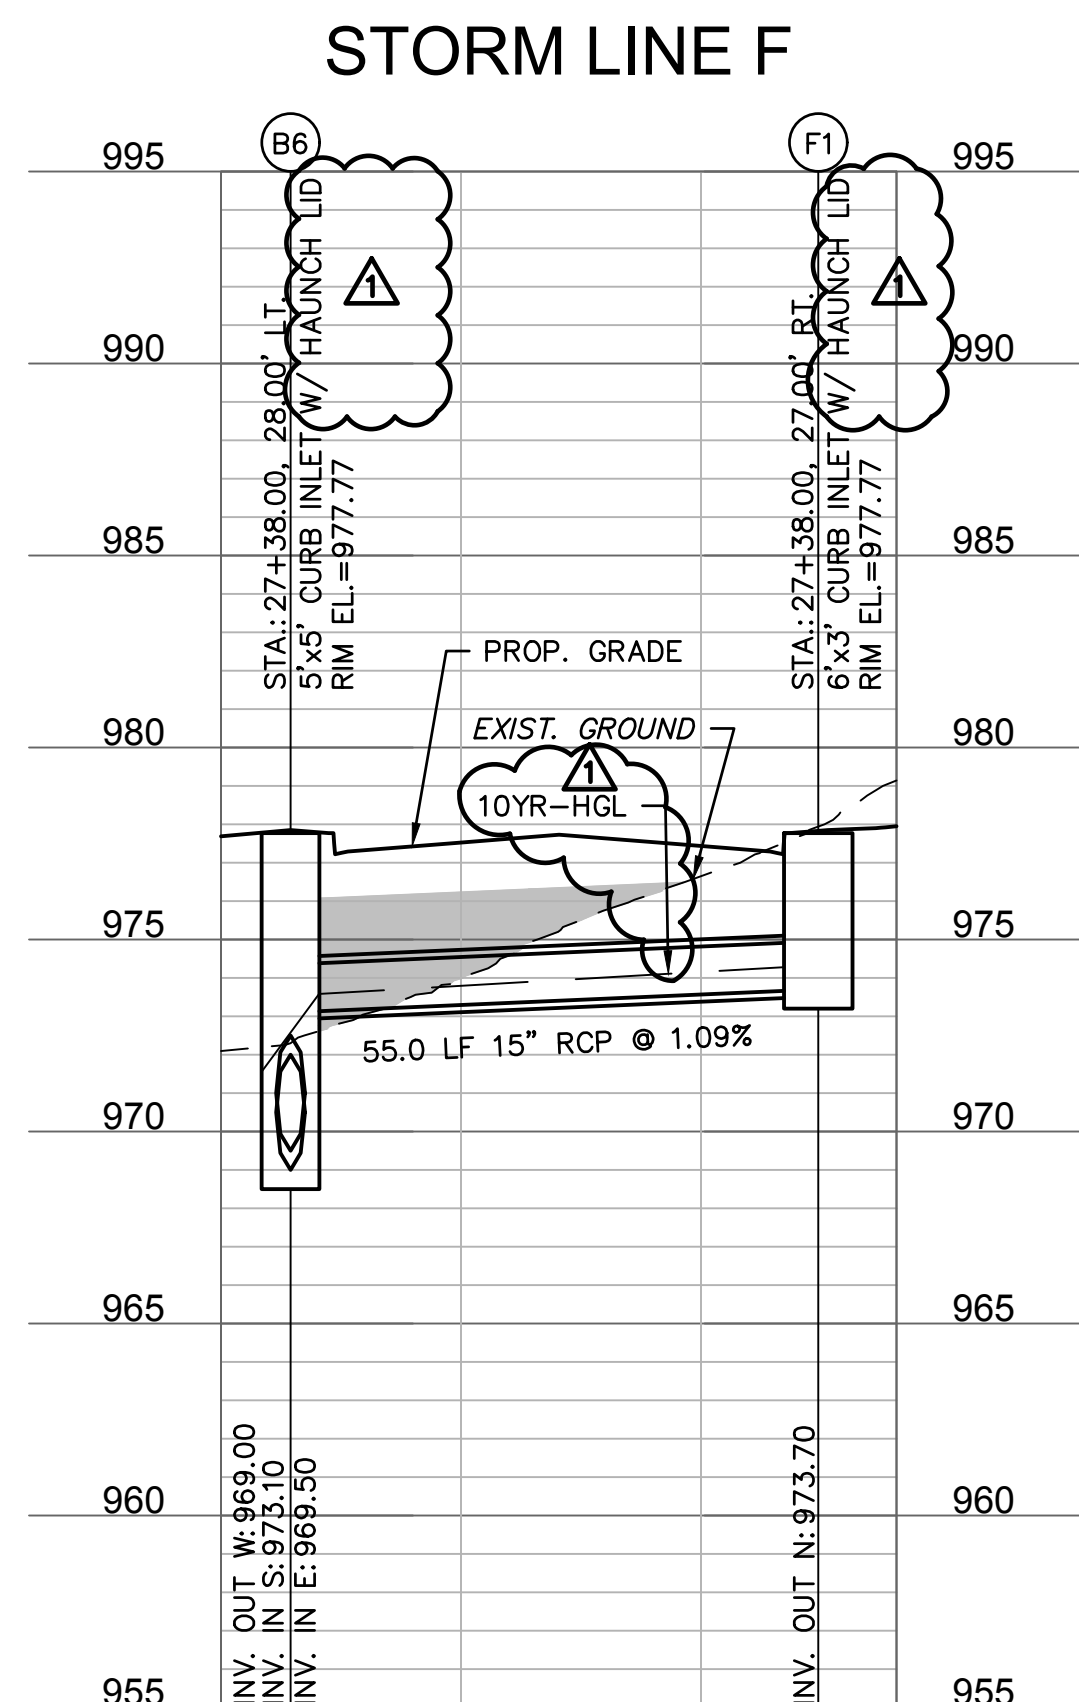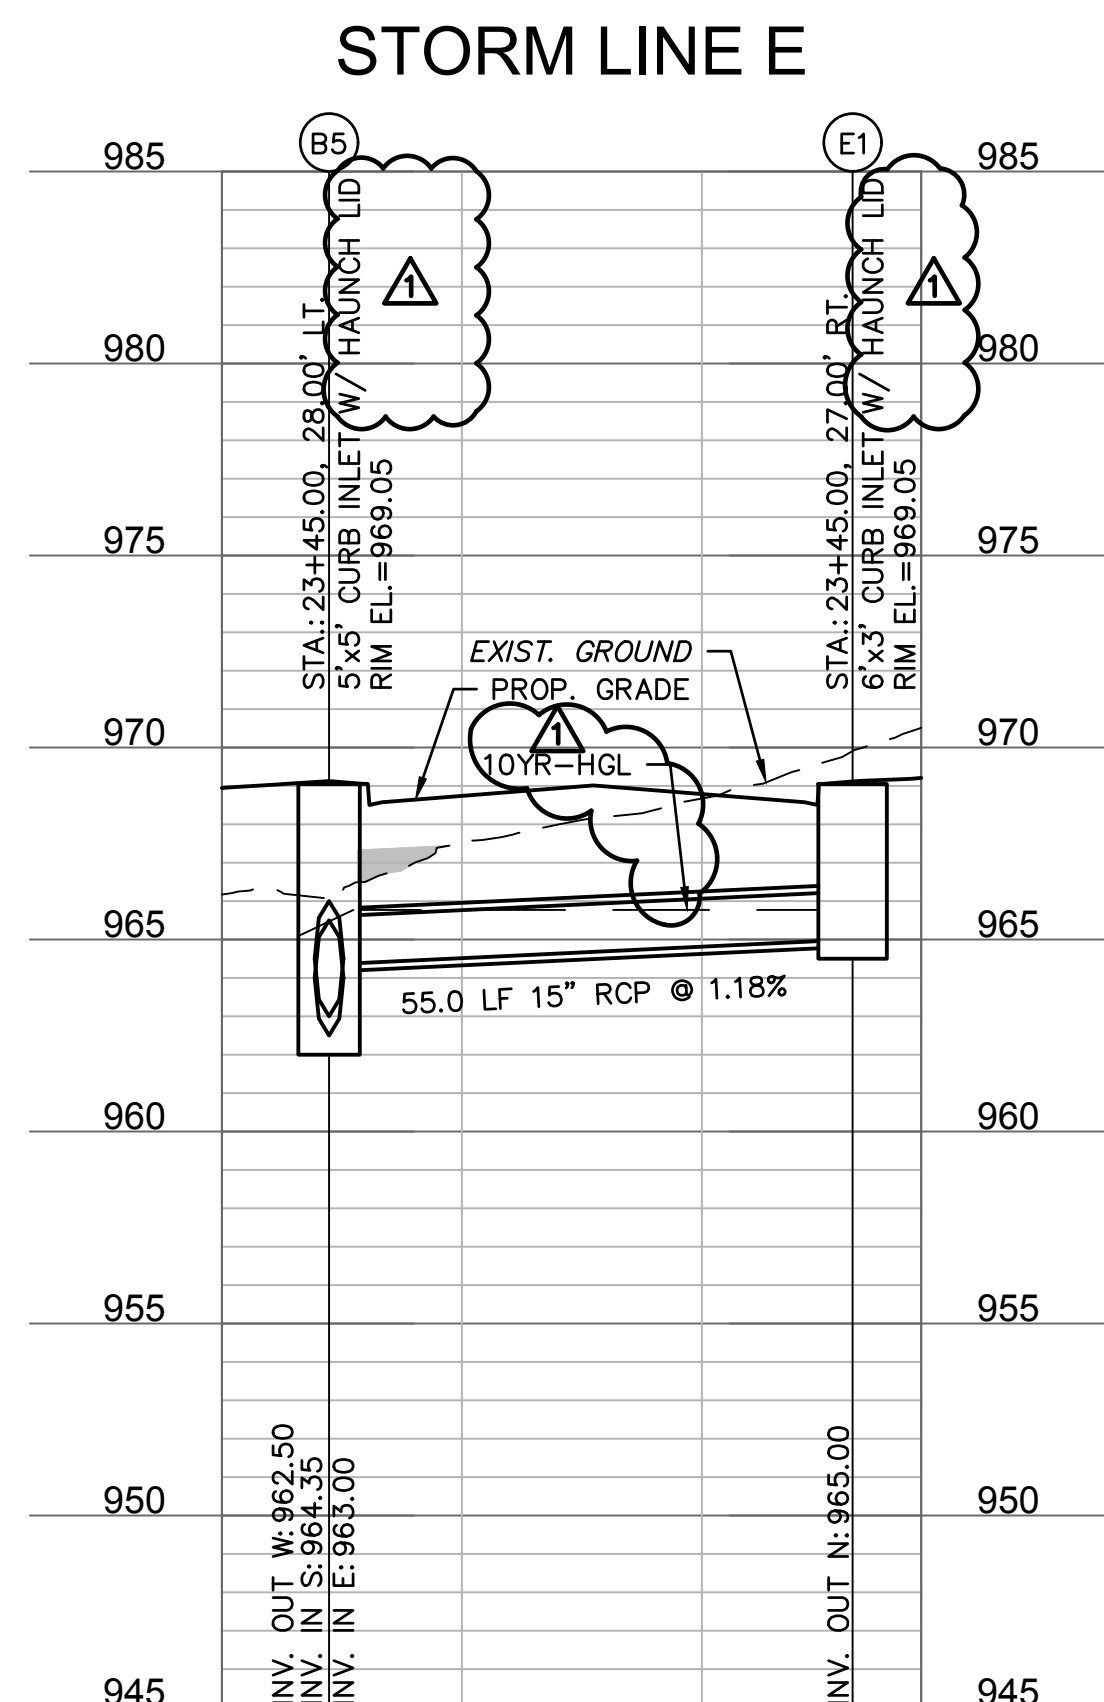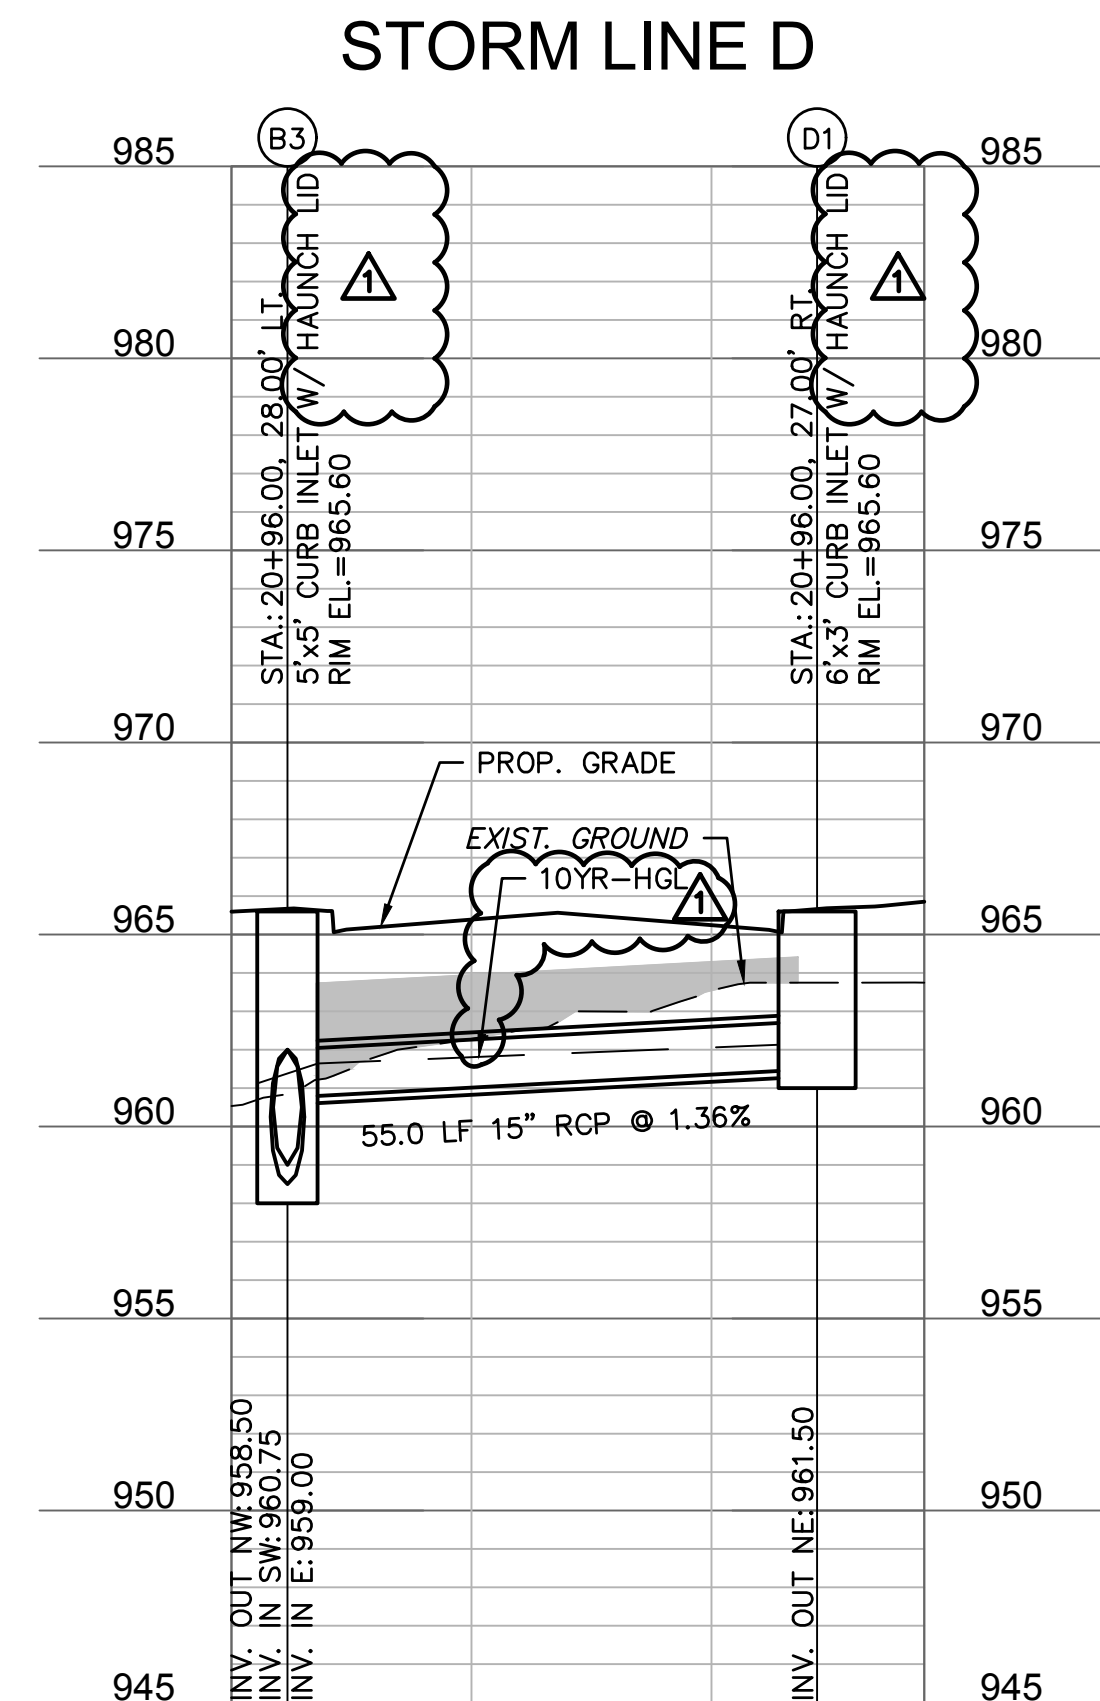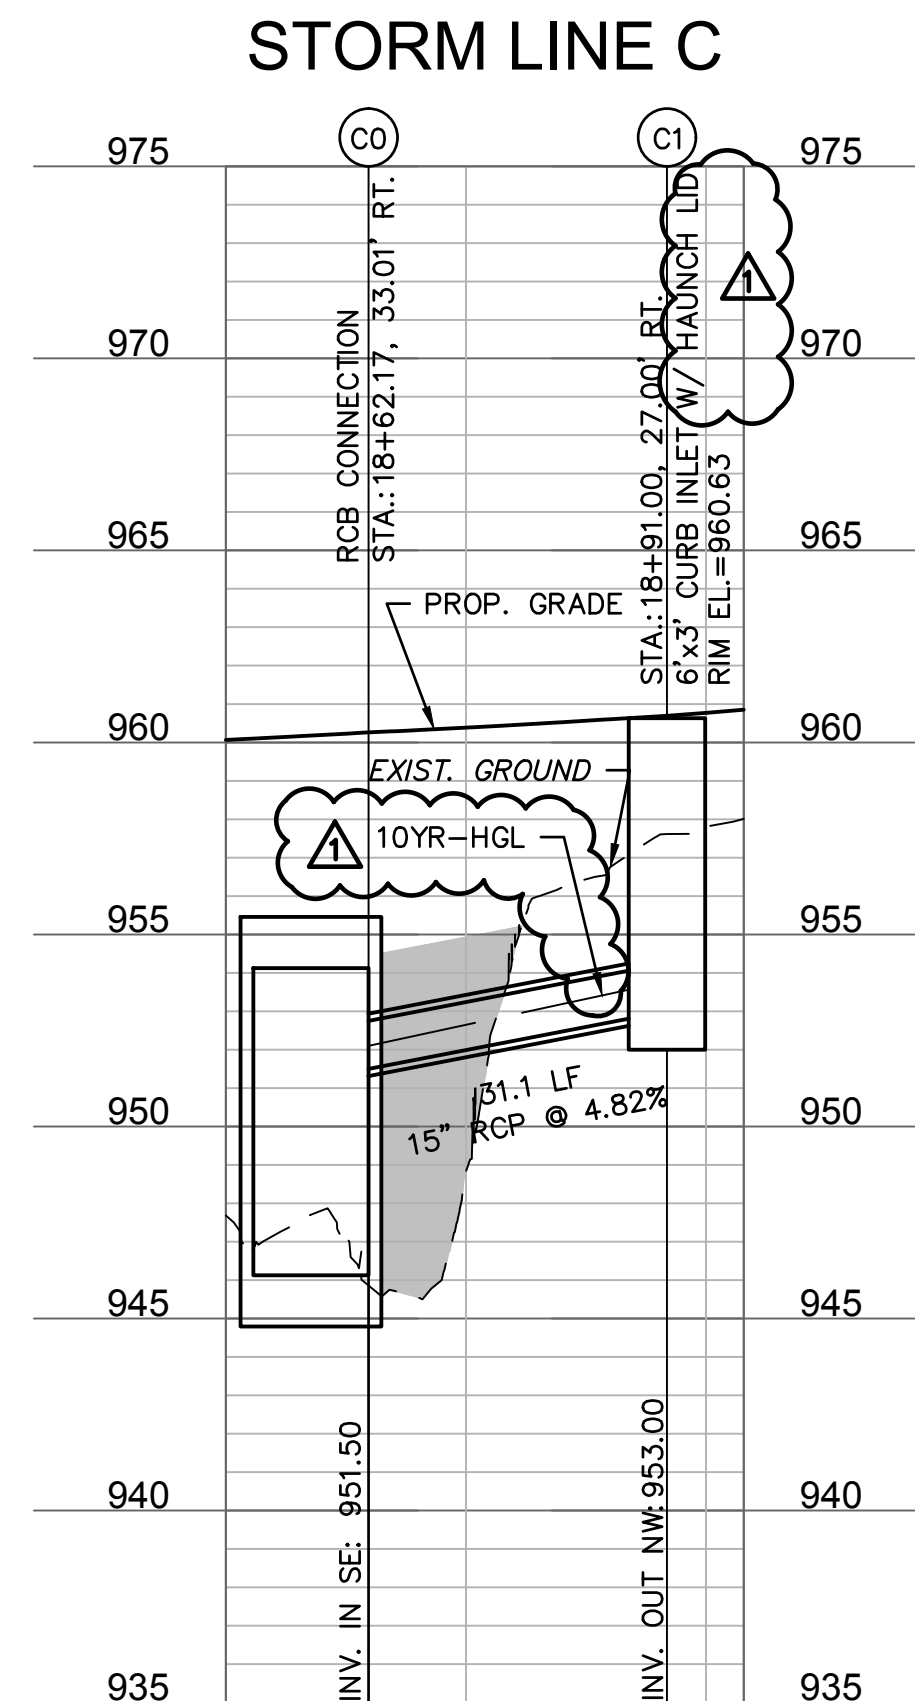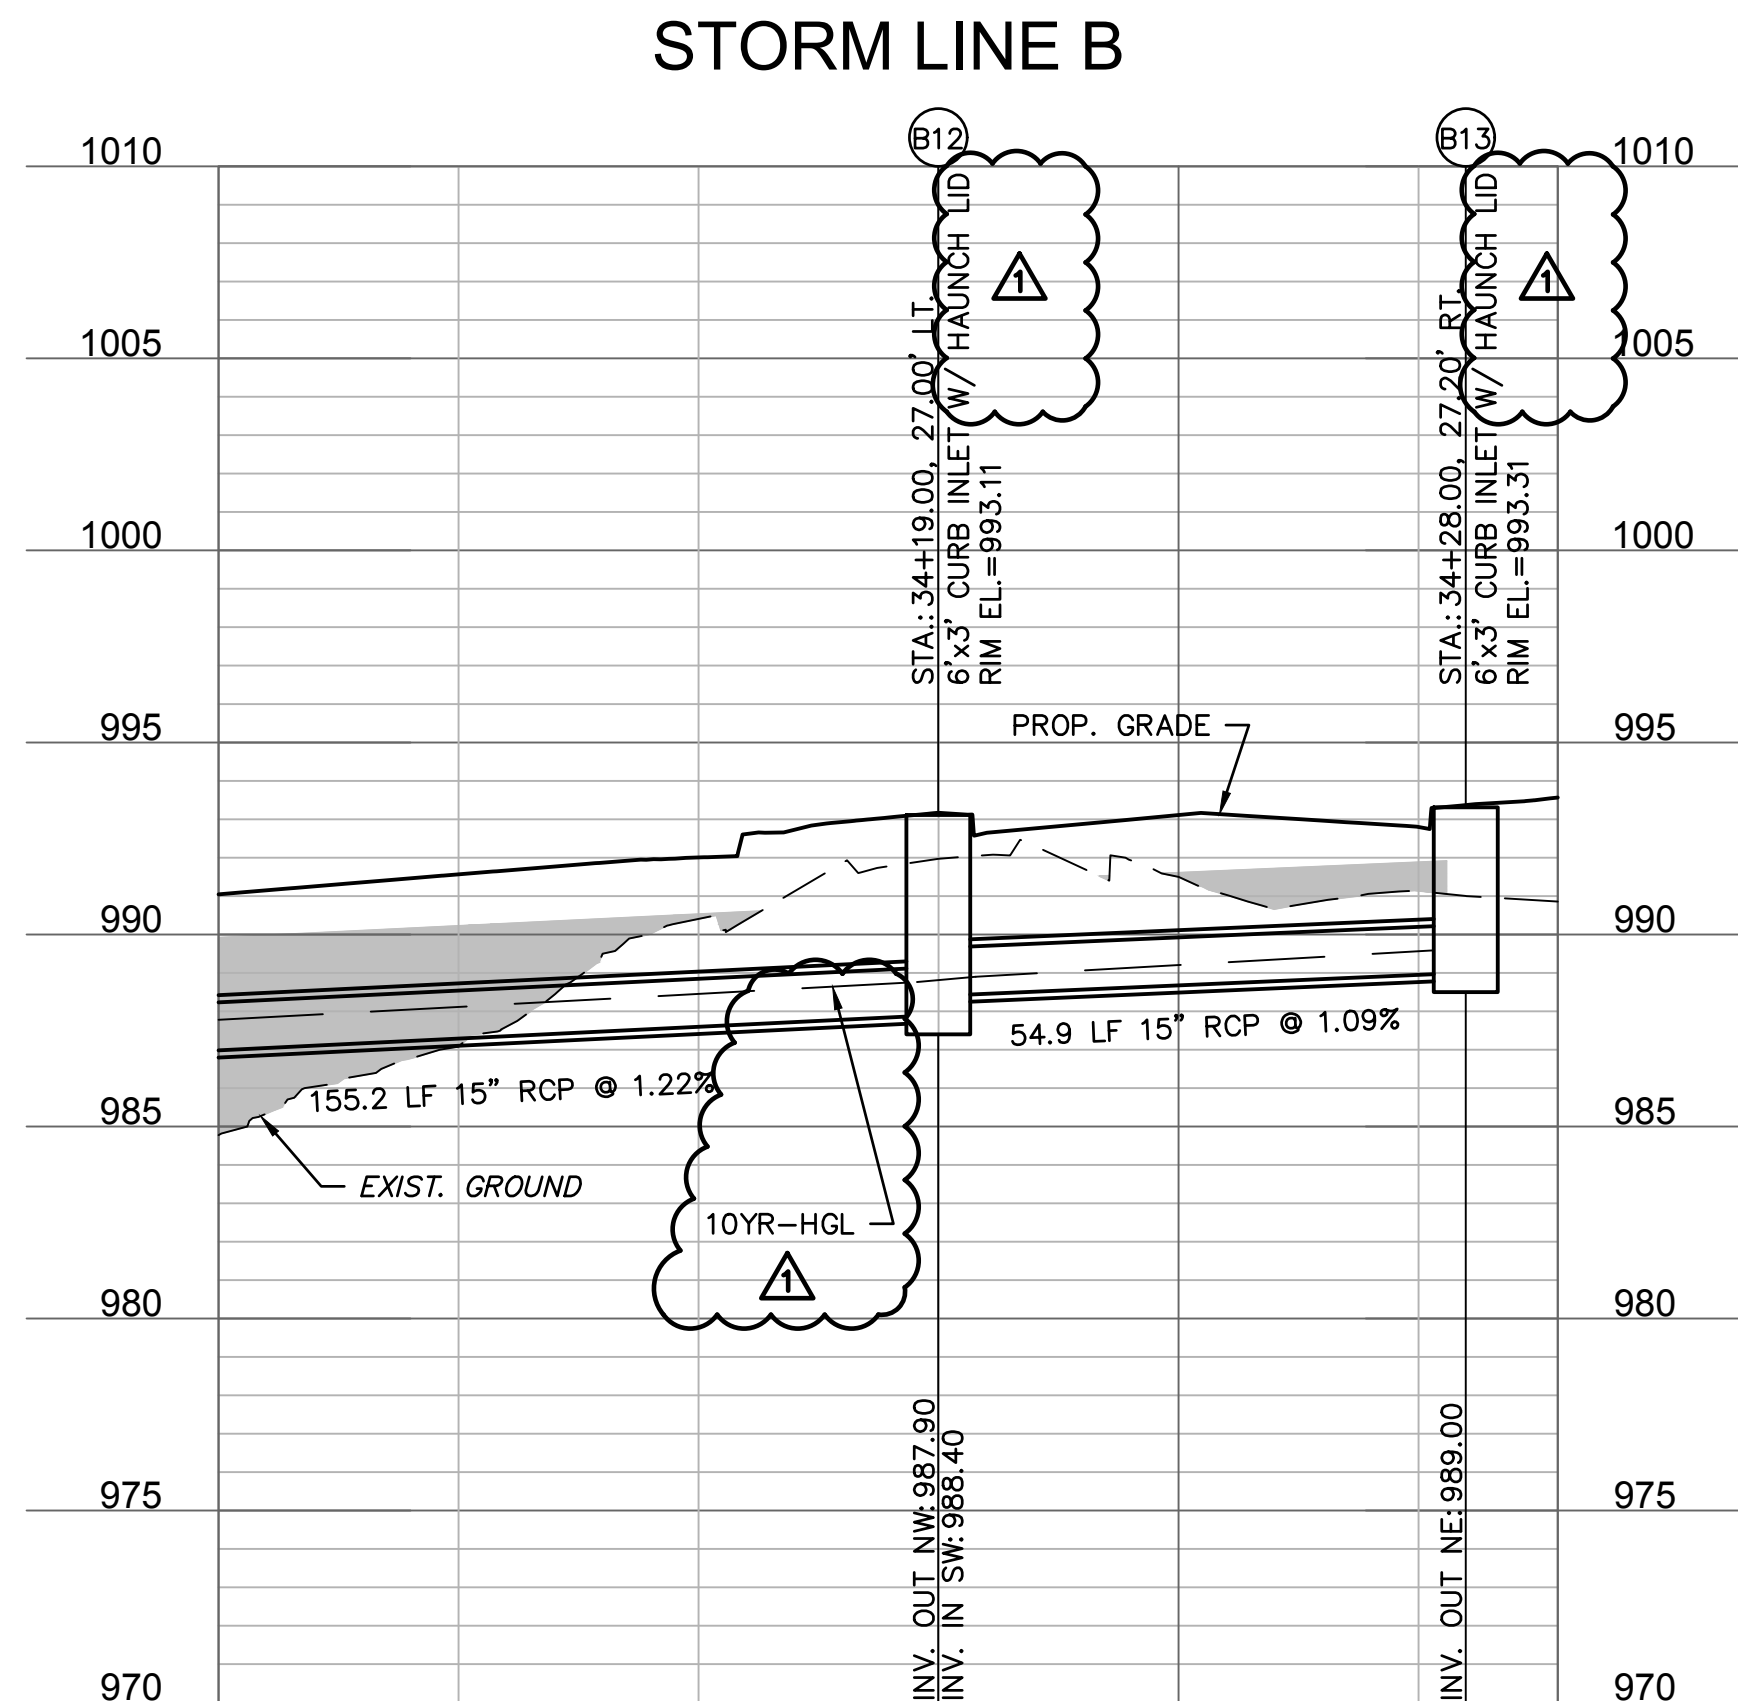

 COMPACTED FILL SHALL BE PLACED TO A MINIMUM OF 18" ABOVE THE TOP OF THE PIPE PRIOR TO INSTALLATION.

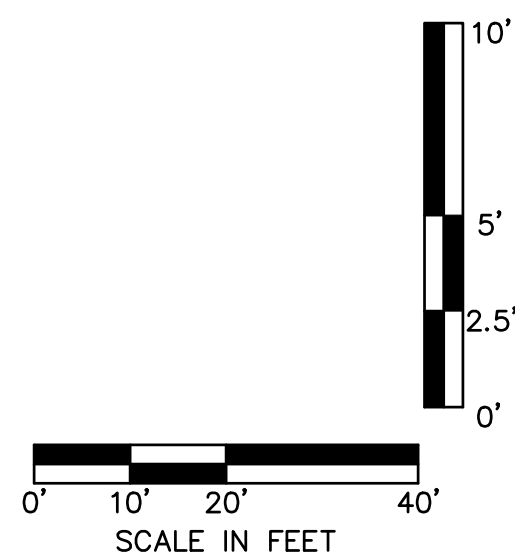

USER: asaavedra



C.O.A. NO.: _____
DRAWN BY: _____ ARJ/AMW
CHECKED BY: _____ XXX
APPROVED BY: _____ RBF
QA/QC BY: _____ RBF
PROJECT NO.: _____ 021-04157
DWG NO.: T_STM01 02104157
DATE: _____ 2021-10-12

LEE'S SUMMIT, MISSOURI

2021


DEVIATIONS

RYAN B. FLEMING
D. NO. PE-200200316

RECORD
DRAWINGS

Olsson Engineering - MO State Certificate of Authority #001592
7301 West 133rd Street, Suite 200 TEL 913.381.1170
Overland Park, KS 66213-4750 FAX 913.381.1174 www

DWG: F:\202
DATE: Oct 3

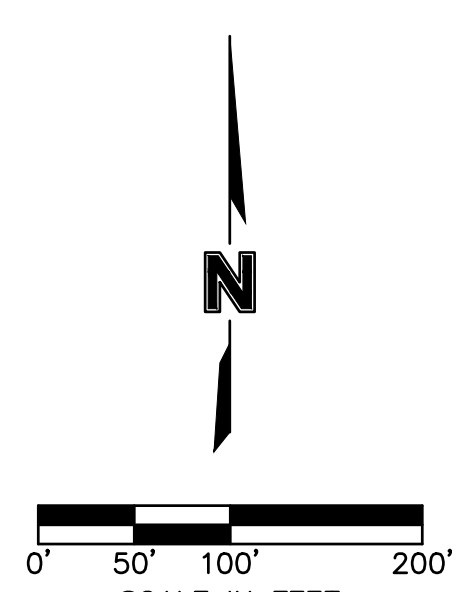

olsson

Olsson Engineering - MO State Certificate of Authority #001592
7301 West 133rd Street, Suite 200 TEL 913.381.1170
Overland Park, KS 66213-4750 FAX 913.381.1174
www.olsson.com

SHEET
33 OF 105












DWG: F:\2021\04001-04500\021-04157\40-Design\AutoCAD\Final Plans\Sheets\ROBR\T_CALCS_02104157.dwg
DATE: Oct 30, 2023 3:51pm XREFS: T_PTBK_02104157 USER: asoavedra

100-YEAR STORM SEWER CALCULATIONS																												
Label*	Inlet Area (acres)	System Drainage Area (acres)	Upstream Inlet C	System CA (acres)	Inlet Tc (min)	System Intensity (in/h)	Capacity (Design) (cfs)	Flow (cfs)	Diameter (in)	Length (Scaled) (ft)	Material	Manning's n	Invert (Start) (ft)	Invert (Stop) (ft)	Slope (Calculated) (%)	Flow / Capacity (Design) (%)	Velocity (ft/s)	Spread / Top Width (ft)	Depth (Gutter) (in)	Flow (Total Bypassed) (cfs)	Bypass Target	Headloss Coefficient	Headloss (ft)	Hydraulic Grade Line (In) (ft)	Hydraulic Grade Line (Out) (ft)	Elevation (Rim) (ft)	Rim Elevation-HGL(In) (ft)	Notes
A1	0.50	0.50	0.70	0.21	5.00	12.90	6.81	2.74	15.00	54.00	Concrete	0.013	961.60	961.00	1.11	40.30	5.25	9.70	2.30	1.81	A4	1.00	0.71	962.26	961.55	965.63	3.37	
A2	0.59	1.10	0.61	0.40	5.00	12.81	8.00	5.10	15.00	293.30	Concrete	0.013	960.50	956.00	1.53	63.80	6.91	9.80	2.40	2.28	A3	0.40	4.09	961.42	957.33	965.63	4.21	
A3	0.38	1.50	0.73	0.97	5.00	12.46	11.02	12.15	18.00	54.50	Concrete	0.013	955.50	954.90	1.10	110.20	6.88	24.70	5.90	(N/A)	(N/A)	0.40	0.70	957.04	956.34	959.56	2.52	
A4	0.51	2.00	0.63	1.71	5.00	12.40	15.73	21.32	18.00	70.90	Concrete	0.013	952.60	951.00	2.26	135.60	12.07	26.40	6.30	(N/A)	(N/A)	0.40	2.96	955.43	952.47	959.56	4.13	
B1	0.16	4.70	0.79	2.60	5.00	11.67	174.31	103.53	42.00	22.50	Concrete	0.013	950.70	950.00	3.11	59.40	18.89	9.60	2.30	1.55	A3	0.40	0.69	953.80	953.11	960.63	6.83	
B2	(N/A)	4.60	(N/A)	2.42	0.00	11.71	139.57	101.58	42.00	93.50	Concrete	0.013	956.30	954.50	1.93	72.80	15.82	(N/A)	(N/A)	(N/A)	(N/A)	0.20	2.49	959.39	956.90	963.46	4.07	J.B.
B3	0.20	4.60	0.81	2.42	5.00	11.76	131.10	101.70	42.00	100.10	Concrete	0.013	958.50	956.80	1.70	77.60	15.05	11.40	2.70	2.17	B1	0.40	2.32	961.59	959.26	965.60	4.01	
B4	(N/A)	3.80	(N/A)	1.89	0.00	11.82	81.04	95.54	36.00	115.20	Concrete	0.013	960.70	959.00	1.48	117.90	13.52	(N/A)	(N/A)	(N/A)	(N/A)	0.20	2.36	964.75	962.38	967.30	2.55	J.B.
B5	0.31	3.80	0.80	1.89	5.00	11.89	69.30	95.66	36.00	120.40	Concrete	0.013	962.50	961.20	1.08	138.00	13.53	11.60	2.80	2.86	B3	0.40	2.48	967.79	965.31	969.05	1.26	
B6	0.29	2.70	0.82	1.37	5.00	12.12	82.41	89.69	36.00	393.00	Concrete	0.013	969.00	963.00	1.53	108.80	12.69	10.60	2.50	2.54	B5	0.40	7.11	976.04	968.93	977.77	1.73	
B7	(N/A)	1.90	(N/A)	0.91	0.00	12.20	67.33	84.15	36.00	127.50	Concrete	0.013	970.80	969.50	1.02	125.00	11.90	(N/A)	(N/A)	(N/A)	(N/A)	0.20	2.03	979.07	977.04	980.56	1.49	J.B.
B8	(N/A)	1.90	(N/A)	0.91	0.00	12.28	66.47	84.22	36.00	120.80	Concrete	0.013	972.50	971.30	0.99	126.70	11.91	(N/A)	(N/A)	(N/A)	(N/A)	0.20	1.93	981.44	979.51	983.15	1.71	J.B.
B9	0.21	1.90	0.81	0.91	5.00	12.36	70.25	84.30	36.00	126.20	Concrete	0.013	974.40	973.00	1.11	120.00	11.93	10.20	2.40	2.06	B6	0.40	2.02	983.89	981.88	985.81	1.92	
B10	(N/A)	1.30	(N/A)	0.48	0.00	12.51	10.12	6.05	15.00	93.60	Concrete	0.013	983.50	981.20	2.46	59.80	4.93	(N/A)	(N/A)	(N/A)	(N/A)	0.20	0.82	985.60	984.78	987.86	2.26	J.B.
B11	(N/A)	1.30	(N/A)	0.48	0.00	12.62	8.28	6.10	15.00	91.30	Concrete	0.013	985.50	984.00	1.64	73.70	7.38	(N/A)	(N/A)	(N/A)	(N/A)	0.20	0.83	986.50	985.67	989.81	3.31	J.B.
B12	0.69	1.30	0.61	0.48	5.00	12.82	7.15	6.20	15.00	155.20	Concrete	0.013	987.90	986.00	1.22	86.70	6.56	10.90	2.60	2.31	B9	0.40	2.01	988.91	986.90	993.11	4.20	
B13	0.65	0.60	0.63	0.24	5.00	12.90	6.75	3.07	15.00	54.90	Concrete	0.013	989.00	988.40	1.09	45.50	5.37	10.70	2.60	2.25	G1	1.00	0.59	989.71	989.12	993.31	3.60	
C1	0.61	0.60	0.51	0.29	5.00	12.90	14.09	3.82	15.00	31.10	Concrete	0.013	953.00	951.50	4.82	27.10	9.76	12.60	3.00	3.63	A4	0.40	1.82	953.79	951.97	960.63	6.84	
D1	0.58	0.60	0.49	0.31	5.00	12.90	7.54	4.09	15.00	55.00	Concrete	0.013	961.50	960.75	1.36	54.20	6.27	13.50	3.20	3.40	C1	1.00	0.18	962.56	962.38	965.60	3.04	
E1	0.72	0.70	0.52	0.30	5.00	12.90	7.02	3.93	15.00	55.00	Concrete	0.013	965.00	964.35	1.18	56.00	3.20	12.90	3.10	3.79	D1	1.00	0.20	969.13	968.93	969.05	-0.08	
F1	0.52	0.50	0.59	0.26	5.00	12.90	6.75	3.36	15.00	55.00	Concrete	0.013	973.70	973.10	1.09	49.80	2.74	11.40	2.70	2.86	E1	1.00	0.15	977.19	977.04	977.77	0.58	
G1	0.38	0.40	0.62	0.24	5.00	12.90	69.38	76.09	36.00	55.40	Concrete	0.013	975.50	974.90	1.08	109.70	10.76	10.70	2.60	2.22	F1	1.00	0.72	985.50	984.78	985.96	0.46	

* LABEL REPRESENTS STRUCTURE & DOWNSTREAM PIPES



50-YEAR STORM SEWER CALCULATIONS																												
Label*	Inlet Area (acres)	System Drainage Area (acres)	Upstream Inlet C	System CA (acres)	Inlet Tc (min)	System Intensity (in/h)	Capacity (Design) (cfs)	Flow (cfs)	Diameter (in)	Length (Scaled) (ft)	Material	Manning's n	Invert (Start) (ft)	Invert (Stop) (ft)	Slope (Calculated) (%)	Flow / Capacity (Design) (%)	Velocity (ft/s)	Spread / Top Width (ft)	Depth (Gutter) (in)	Flow (Total Bypassed) (cfs)	Bypass Target	Headloss Coefficient	Headloss (ft)	Hydraulic Grade Line (In) (ft)	Hydraulic Grade Line (Out) (ft)	Elevation (Rim) (ft)	Rim Elevation-HGL(In) (ft)	Notes
A1	0.50	0.50	0.70	0.22	5.00	11.27	6.81	2.54	15.00	54.00	Concrete	0.013	961.60	961.00	1.11	37.40	5.15	9.30	2.20	1.43	A4	1.00	0.71	962.24	961.53	965.63	3.39	
A2	0.59	1.10	0.61	0.42	5.00	11.20	8.00	4.75	15.00	293.30	Concrete	0.013	960.50	956.00	1.53	59.30	6.80	9.40	2.20	1.86	A3	0.40	4.37	961.38	957.01	965.63	4.25	
A3	0.38	1.50	0.73	0.95	5.00	10.89	11.02	10.37	18.00	54.50	Concrete	0.013	955.50	954.90	1.10	94.10	7.09	21.30	5.10	(N/A)	(N/A)	0.40	0.68	956.74	956.06	959.56	2.82	
A4	0.51	2.00	0.63	1.62	5.00	10.83	15.73	17.64	18.00	70.90	Concrete	0.013	952.60	951.00	2.26	112.20	9.98	22.60	5.40	(N/A)	(N/A)	0.40	2.04	954.49	952.45	959.56	5.07	
B1	0.16	4.70	0.79	2.68	5.00	10.16	175.57	89.46	42.00	22.50	Concrete	0.013	950.70	950.00	3.11	51.00	18.33	8.70	2.10	0.96	A3	0.40	1.33	953.64	952.31	960.63	6.99	
B2	(N/A)	4.60	(N/A)	2.51	0.00	10.20	139.57	87.80	42.00	93.50	Concrete	0.013	956.30	954.50	1.93	62.90	15.33	(N/A)	(N/A)	(N/A)	(N/A)	0.20	2.53	959.21	956.68	963.46	4.25	J.B.
B3	0.20	4.60	0.81	2.51	5.00	10.24	131.10	87.91	42.00	100.10	Concrete	0.013	958.50	956.80	1.70	67.10	14.61	10.40	2.50	1.47	B1	0.40	2.38	961.41	959.04	965.60	4.19	
B4	(N/A)	3.80	(N/A)	1.97	0.00	10.30	81.04	82.48	36.00	115.20	Concrete	0.013	960.70	959.00	1.48	101.80	11.67	(N/A)	(N/A)	(N/A)	(N/A)	0.20	1.76	963.83	962.07	967.30	3.47	J.B.
B5	0.31	3.80	0.80	1.97	5.00	10.37	69.30	82.61	36.00	120.40	Concrete	0.013	962.50	961.20	1.08	119.20	11.69	10.70	2.60	2.09	B3	0.40	1.85	966.10	964.25	969.05	2.95	
B6	0.29	2.70	0.82	1.43	5.00	10.60	82.41	77.28	36.00	393.00	Concrete	0.013	969.00	963.00	1.53	93.80	10.93	9.80	2.40	1.88	B5	0.40	5.28	972.23	966.95	977.77	5.54	
B7	(N/A)	1.90	(N/A)	0.96	0.00	10.69	67.33	72.29	36.00	127.50	Concrete	0.013	970.80	969.50	1.02	107.40	10.23	(N/A)	(N/A)	(N/A)	(N/A)	0.20	1.50	974.47	972.97	980.56	6.09	J.B.
B8	(N/A)	1.90	(N/A)	0.96	0.00	10.77	66.47	72.36	36.00	120.80	Concrete	0.013	972.50	971.30	0.99	108.90	10.24	(N/A)	(N/A)	(N/A)	(N/A)	0.20	1.42	976.22	974.79	983.15	6.93	J.B.
B9	0.21	1.90	0.81	0.96	5.00	10.85	70.25	72.45	36.00	126.20	Concrete	0.013	974.40	973.00	1.11	103.10	10.25	9.50	2.30	1.54	B6	0.40	1.49	978.03	976.54	985.81	7.78	
B10	(N/A)	1.30	(N/A)	0.51	0.00	10.93	10.12	5.62	15.00	93.60	Concrete	0.013	983.50	981.20	2.46	55.50	8.47	(N/A)	(N/A)	(N/A)	(N/A)	0.20	2.60	984.46	981.87	987.86	3.40	J.B.
B11	(N/A)	1.30	(N/A)	0.51	0.00	11.02	8.28	5.67	15.00	91.30	Concrete	0.013	985.50	984.00	1.64	68.50	7.27	(N/A)	(N/A)	(N/A)	(N/A)	0.20	1.70	986.46	984.76	989.81	3.35	J.B.
B12	0.69	1.30	0.61	0.51	5.00	11.20	7.15	5.76	15.00	155.20	Concrete	0.013	987.90	986.00	1.22	80.60	6.48	10.40	2.50	1.84	B9	0.40	2.02	988.87	986.85	993.11	4.24	
B13	0.65	0.60	0.63	0.25	5.00	11.27	6.75	2.86	15.00	54.90	Concrete	0.013	989.00	988.40	1.09	42.30	5.27	10.10	2.40	1.79	G1	1.00	0.71	989.68	988.97	993.31	3.63	
C1	0.61	0.60	0.51	0.30	5.00	11.27	14.09	3.39	15.00	31.10	Concrete	0.013	953.00	951.50	4.82	24.00	9.44	11.60	2.80	2.53	A4	0.40	1.81	953.74	951.94	960.63	6.89	
D1	0.58	0.60	0.49	0.32	5.00	11.27	7.54	3.65	15.00	55.00	Concrete	0.013	961.50	960.75	1.36	48.30	6.10	12.50	3.00	2.39	C1	1.00	0.20	962.27	962.07	965.60	3.33	
E1	0.72	0.70	0.52	0.31	5.00	11.27	7.02	3.55	15.00	55.00	Concrete	0.013	965.00	964.35	1.18	50.60	2.90	12.00	2.90	2.81	D1	1.00	0.17	967.12	966.95	969.05	1.93	
F1	0.52	0.50	0.59	0.27	5.00	11.27	6.75	3.04	15.00	55.00	Concrete	0.013	973.70	973.10	1.09	45.00	5.35	10.60	2.50	2.11	E1	1.00	0.71	974.40	973.69	977.77	3.37	
G1	0.38	0.40	0.62	0.25	5.00	11.27	69.38	64.81	36.00	55.40	Concrete	0.013	975.50	974.90	1.08	93.40	9.17	10.00	2.40	1.66	F1	1.00	0.52	979.21	978.68	985.96	6.75	

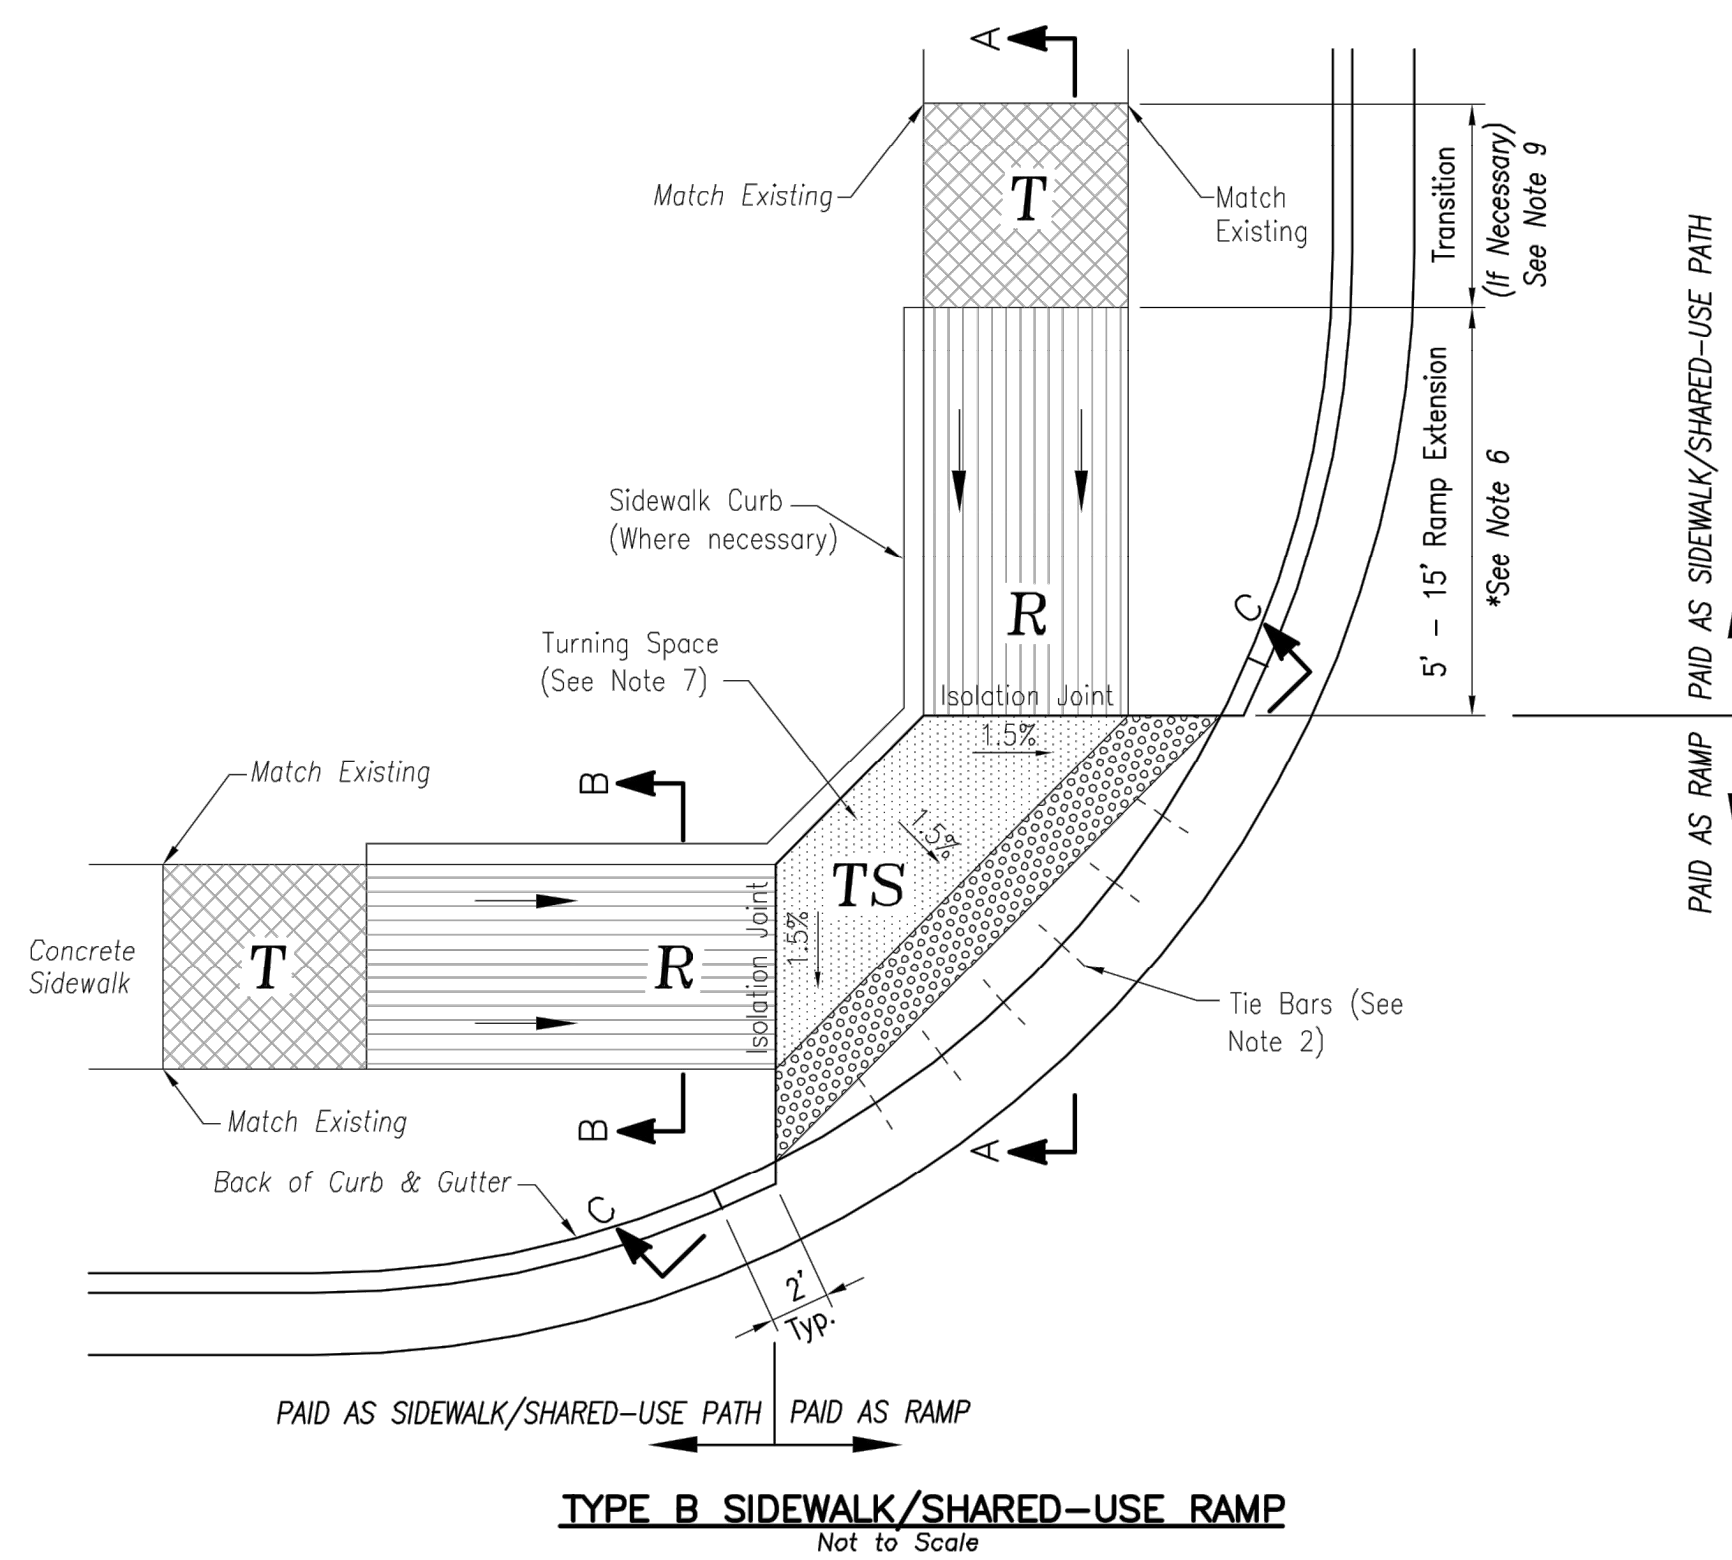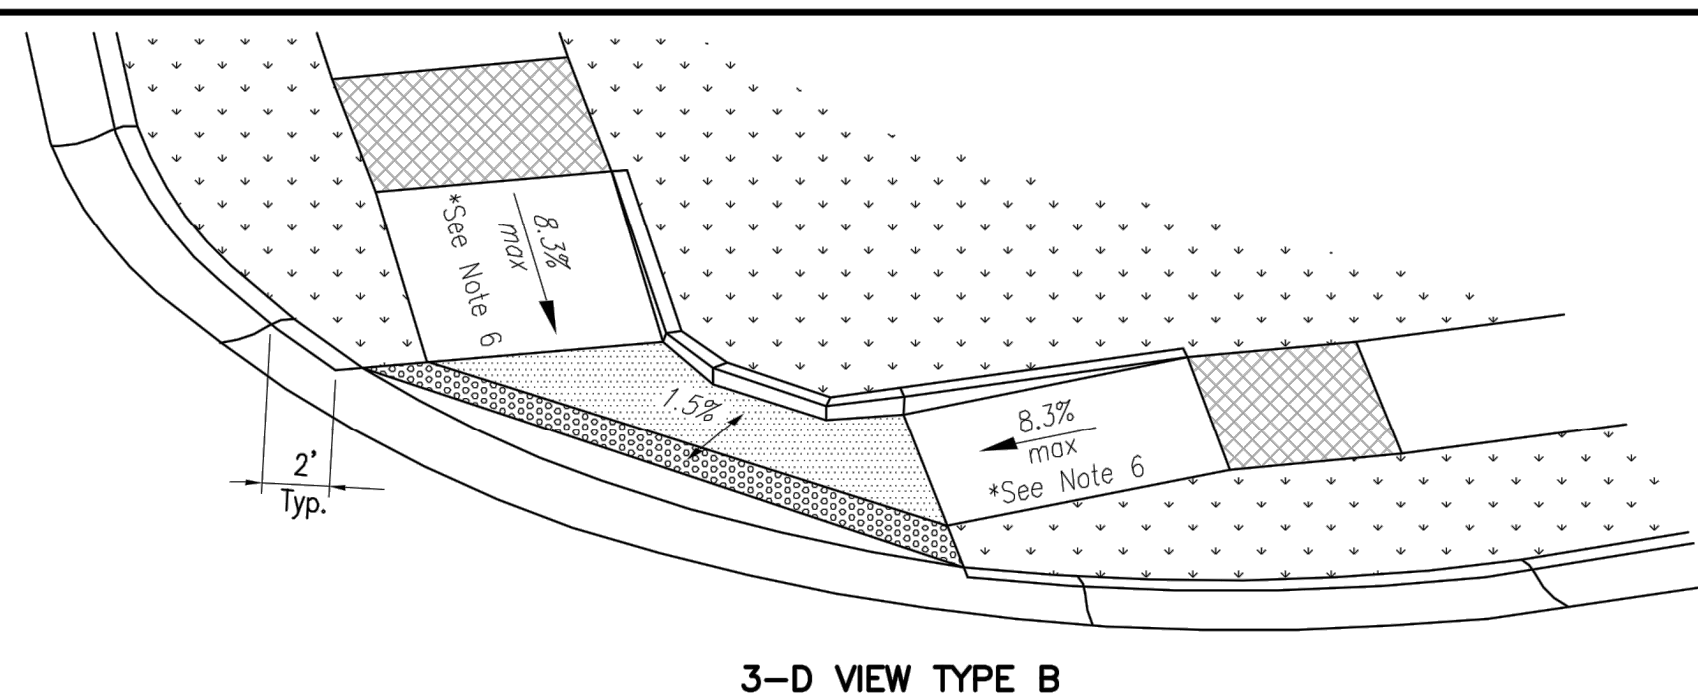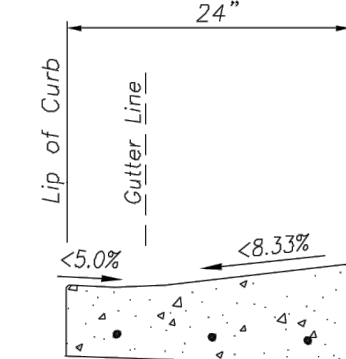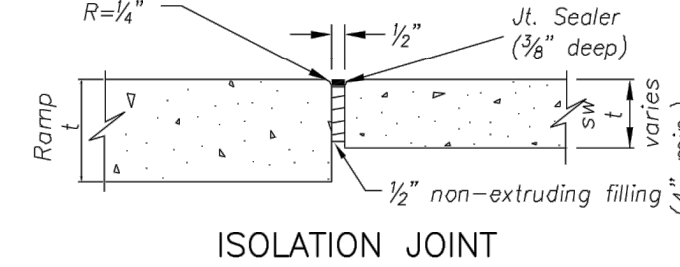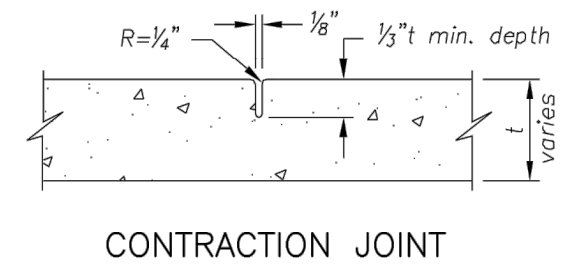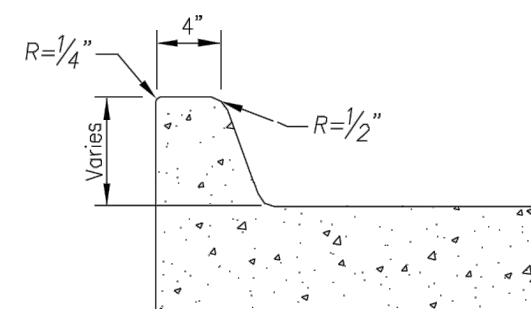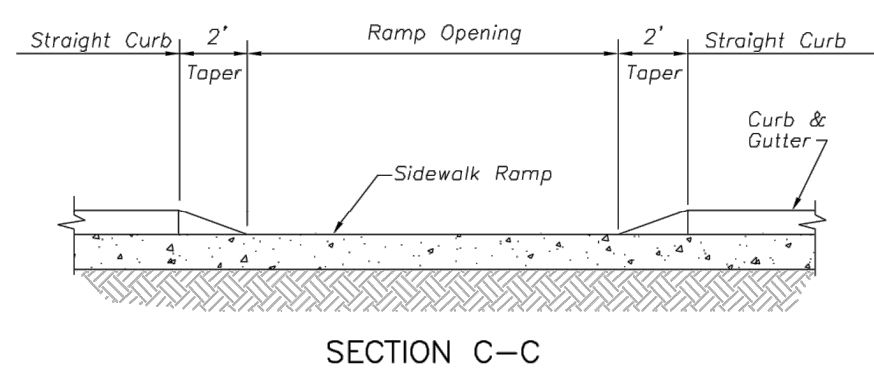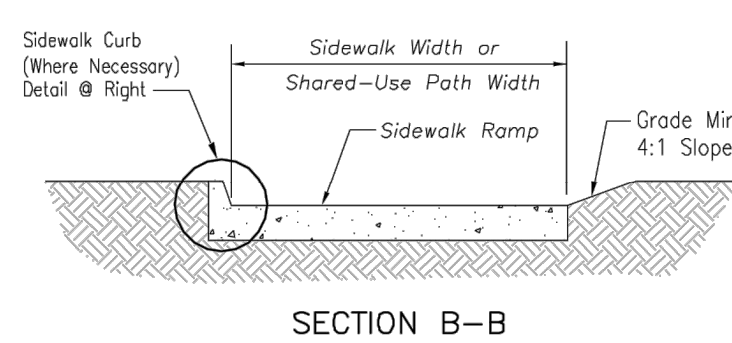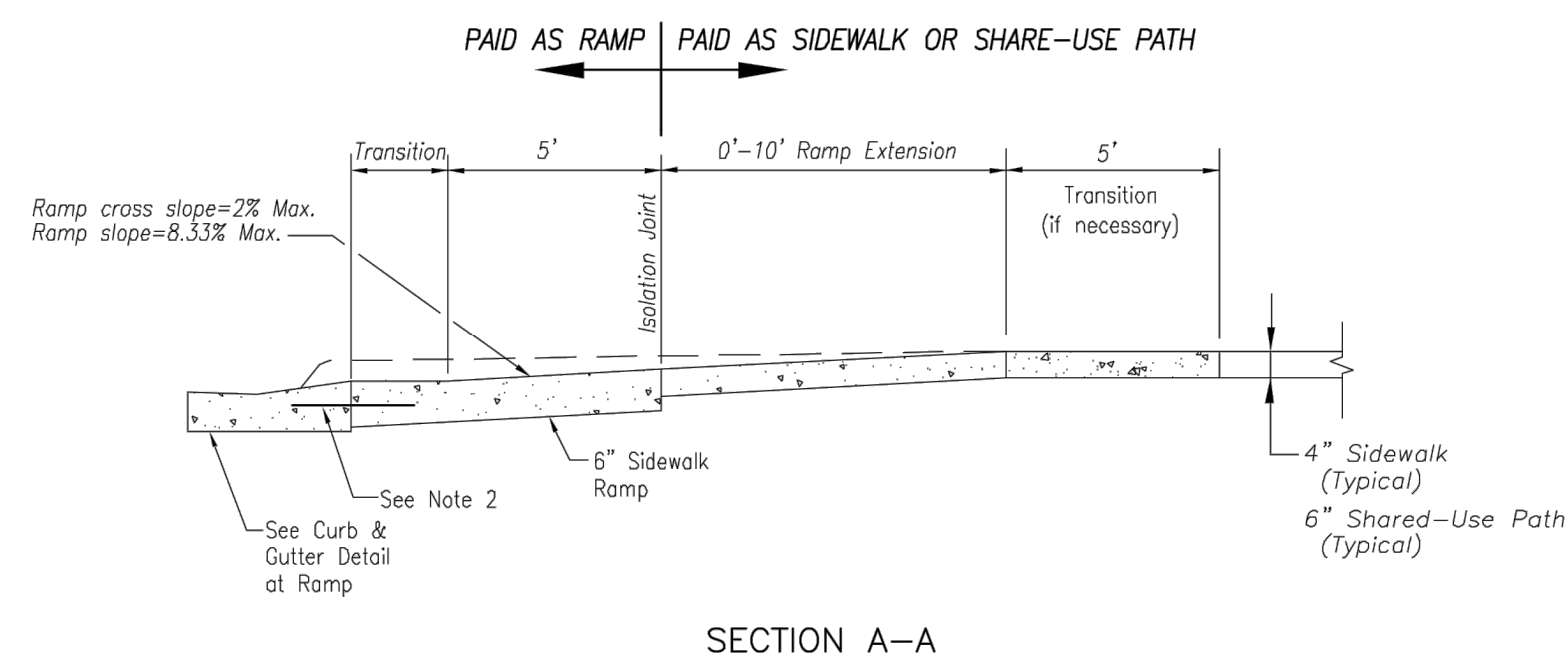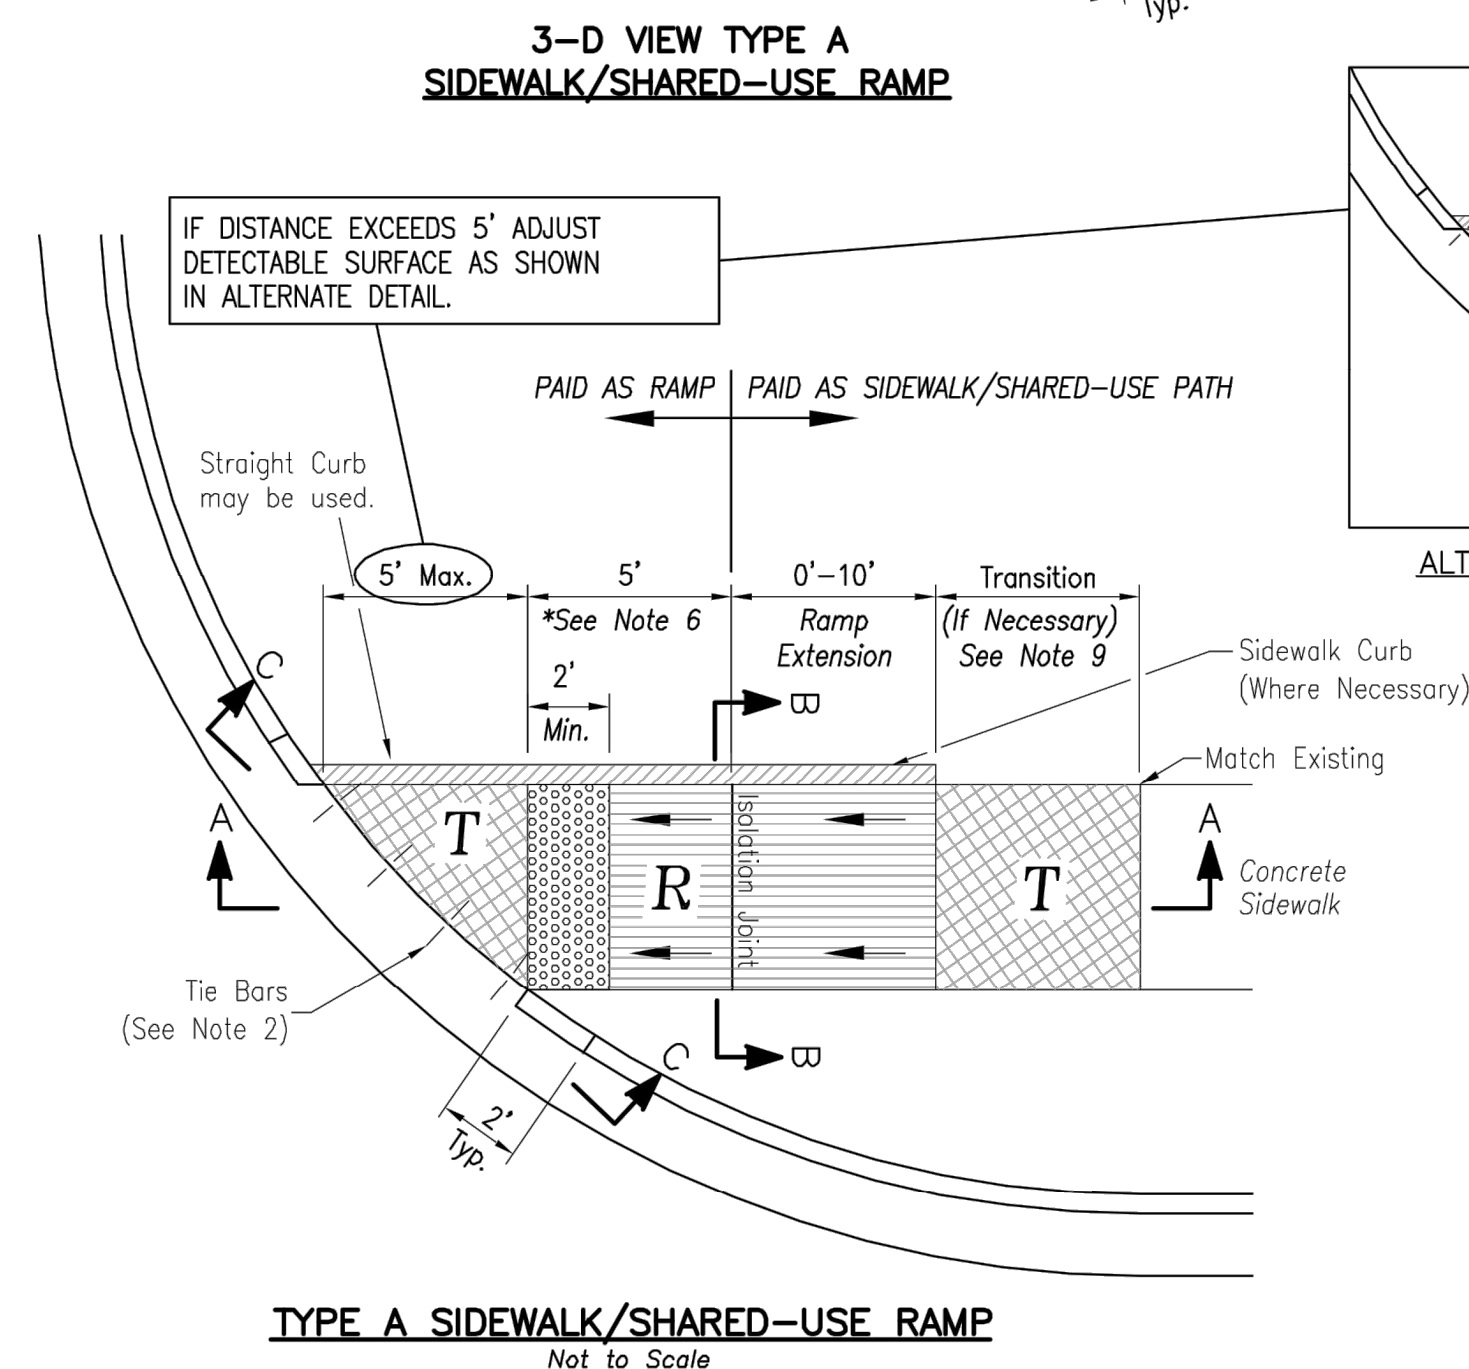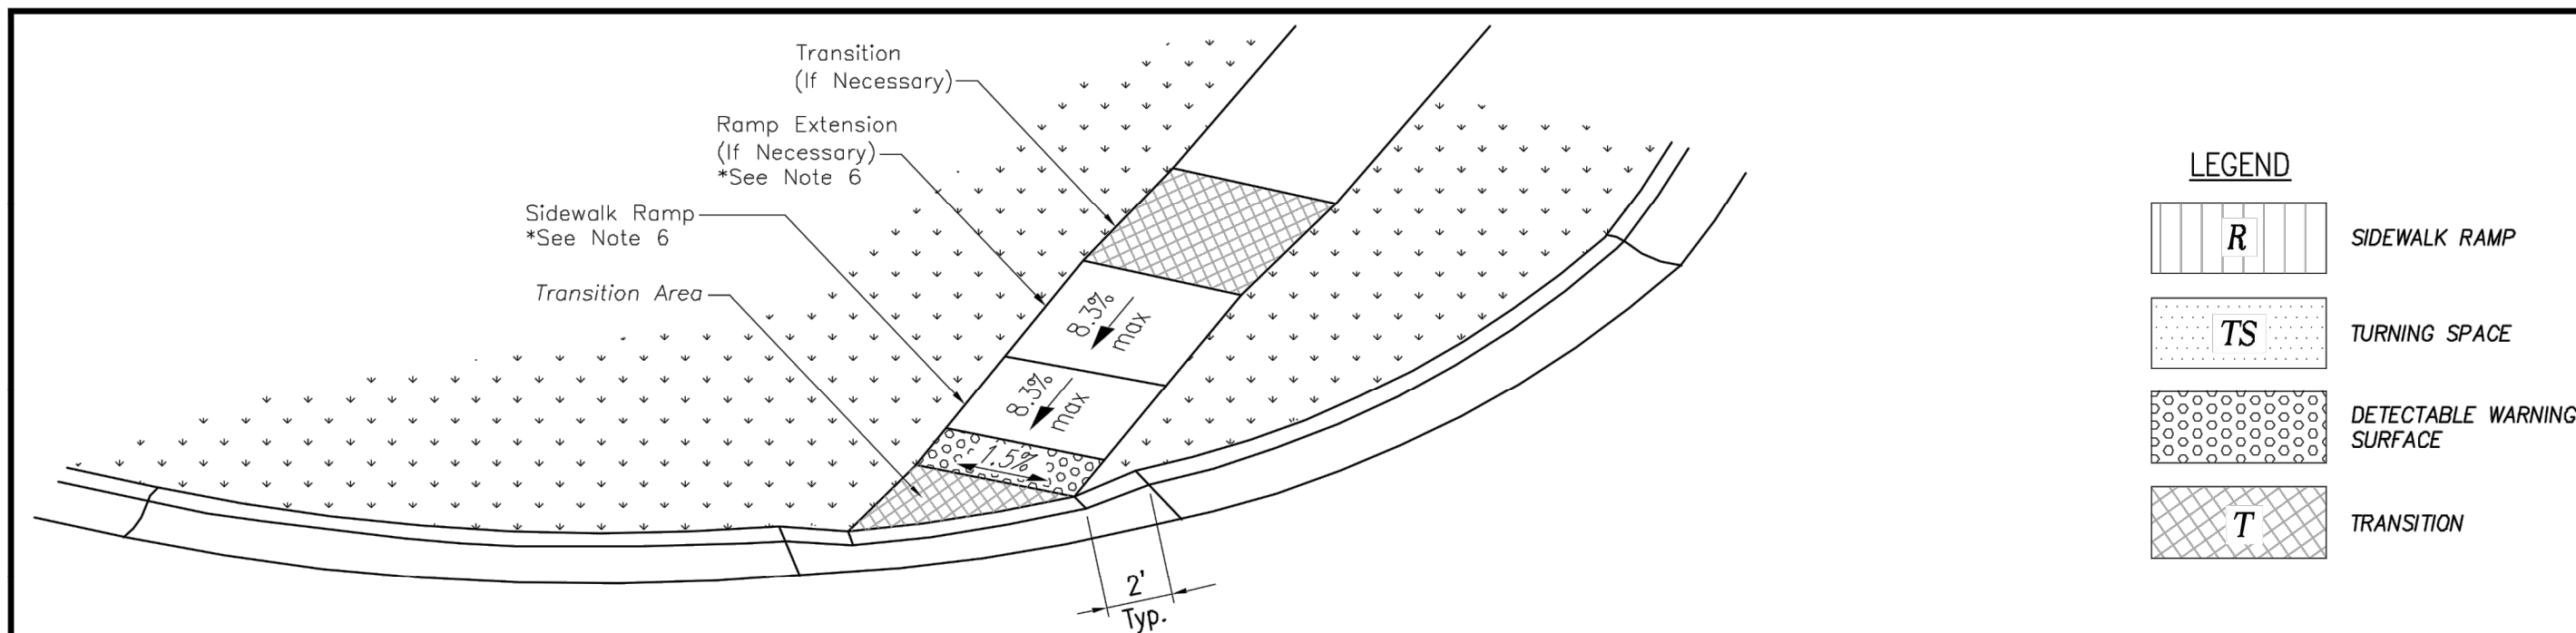

- SIDEWALK/SHARED—USE PATH & SIDEWALK/SHARED—USE RAMP NOTES:
1. CURB RAMP OPENING, NOT INCLUDING FLARES, SHALL MATCH EXISTING SIDEWALK WIDTH AND OPENING SHALL BE AT LEAST 48" WIDE.
 2. USE 18" LONG #4 EPOXY COATED TIE BARS @ 24" O.C. EMBED TIE BARS 9" IN EACH DIRECTION.
 3. ALL RAMPS, SIDEWALKS, SHARED—USE PATHS SUBGRADE MUST BE OF STABLE, COMPACTED EARTH AND SHALL BE OVERLAYED WITH 4" COMPACTED DENSE GRADED AGGREGATE BASE.
 4. LONGITUDINAL JOINT SPACING TO MATCH WIDTH OF SIDEWALK.
 5. ISOLATION JOINTS SHALL BE PLACED WHERE WALK ABUTS DRIVEWAYS AND SIMILAR STRUCTURES, AND 150" CENTERS MAX.
 6. ADA MAXIMUM RAMP SLOPE = 8.33%
ADA MAXIMUM CROSS SLOPE = 2.0%
- *ROADWAY EXCEPTION: WHERE EXISTING ROAD PROFILE GRADE DOES NOT ALLOW RAMP TO MEET RAMP SLOPE REQUIREMENT OF 8.33% OR LESS, THE RAMP SHALL BE EXTENDED TO A LENGTH OF 15 FEET TO MATCH EXISTING SIDEWALK. CROSS SLOPE OF RAMP SHALL BE 1.5%, $\pm 0.5\%$.
7. TURNING SPACES SHALL BE 1.5%, $\pm 0.5\%$, SLOPE IN ANY DIRECTION. TURNING SPACES SHALL HAVE A MINIMUM 4'x4' TURNING AREA. TURNING SPACES, WITH A SIDEWALK CURB, SHALL HAVE A 5' TURNING AREA PERPENDICULAR TO THE SIDEWALK CURB.
 8. FOR RETROFIT WORK, SLOPES TO BE DETERMINED IN FIELD BY CONTRACTOR AND APPROVED BY CITY INSPECTOR
 9. RAMP EXTENSION AREA SHALL NOT BE USED AS TRANSITION TO EXISTING SIDEWALK. ANY TRANSITIONS REQUIRED TO MATCH RAMPS TO EXISTING SIDEWALK SHALL REQUIRE REMOVAL AND REPLACEMENT OF ADDITIONAL SIDEWALK BEYOND THE RAMP AREA. SIDEWALK TRANSITION LENGTH SHALL BE EQUAL TO OR GREATER THAN THE WIDTH OF THE EXISTING SIDEWALK. RAMP EXTENSIONS SHALL BE A CONTINUOUS SLOPE.
 10. ALL SIDEWALK AND RAMP CONSTRUCTION SHALL MEET CURRENT PUBLIC RIGHT OF WAY ACCESSIBILITY GUIDELINES (PROWAG).

LS **LEE'S SUMMIT**
MISSOURI

Project: STANDARD DETAILS
CITY OF LEE'S SUMMIT, MO
LEE'S SUMMIT, JACKSON COUNTY, MO

Drawn By: MJF
Checked By: DL
Date: 04/17
Proj. #:

GEN-3A

STANDARD DETAILS

SCANNELL DEVELOPMENT LEE'S SUMMIT LOGISTICS

LEE'S SUMMIT, MISSOURI

RECORD
DRAWINGS






RYAN B. FLEMING
MO. NO. PE-2002003161

[illegible]

STANDARD DETAILS	
SCANNELL DEVELOPMENT LEE'S SUMMIT LOGISTICS NORTHWEST CORNER OF TUDOR ROAD AND MAIN STREET	
LEE'S SUMMIT, MISSOURI!	2021

C.O.A. NO.: _____ -
DRAWN BY: _____ ARJ/AMW
CHECKED BY: _____ XXX
APPROVED BY: _____ RBF
QA/QC BY: _____ RBF
PROJECT NO.: _____ 021-04157
DWG NO.: _____ T_PDET_02104157
DATE: _____ 2021-10-12

SHEET
35 OF 105

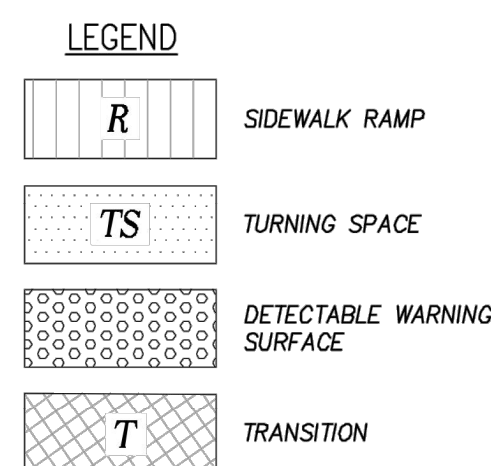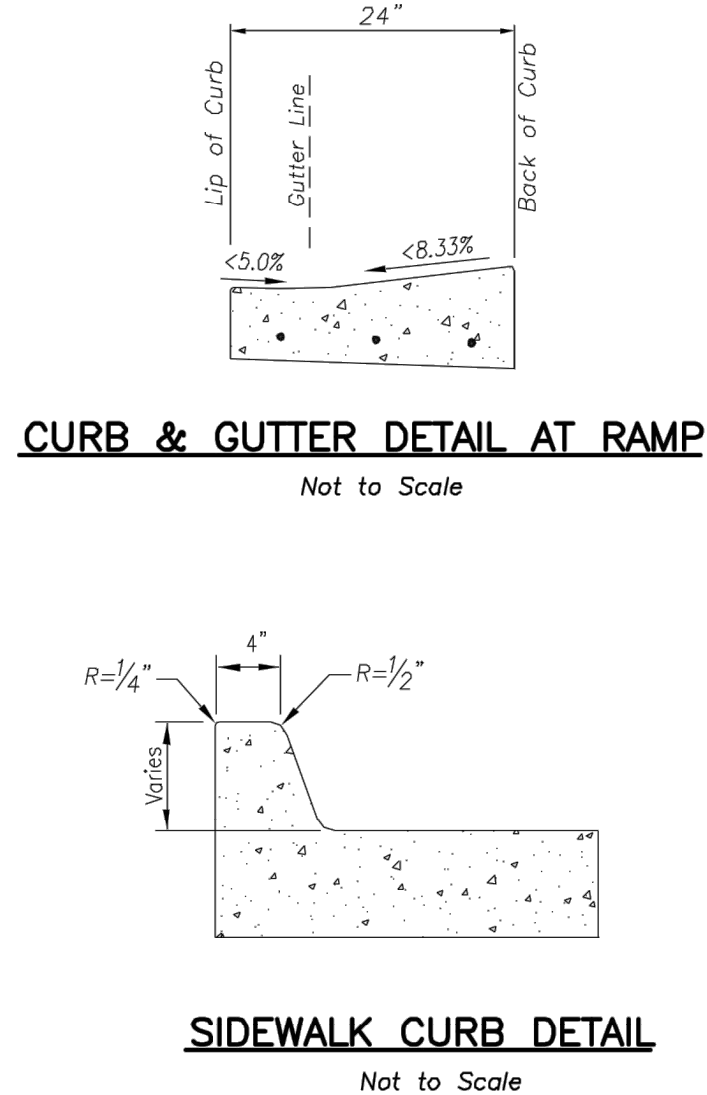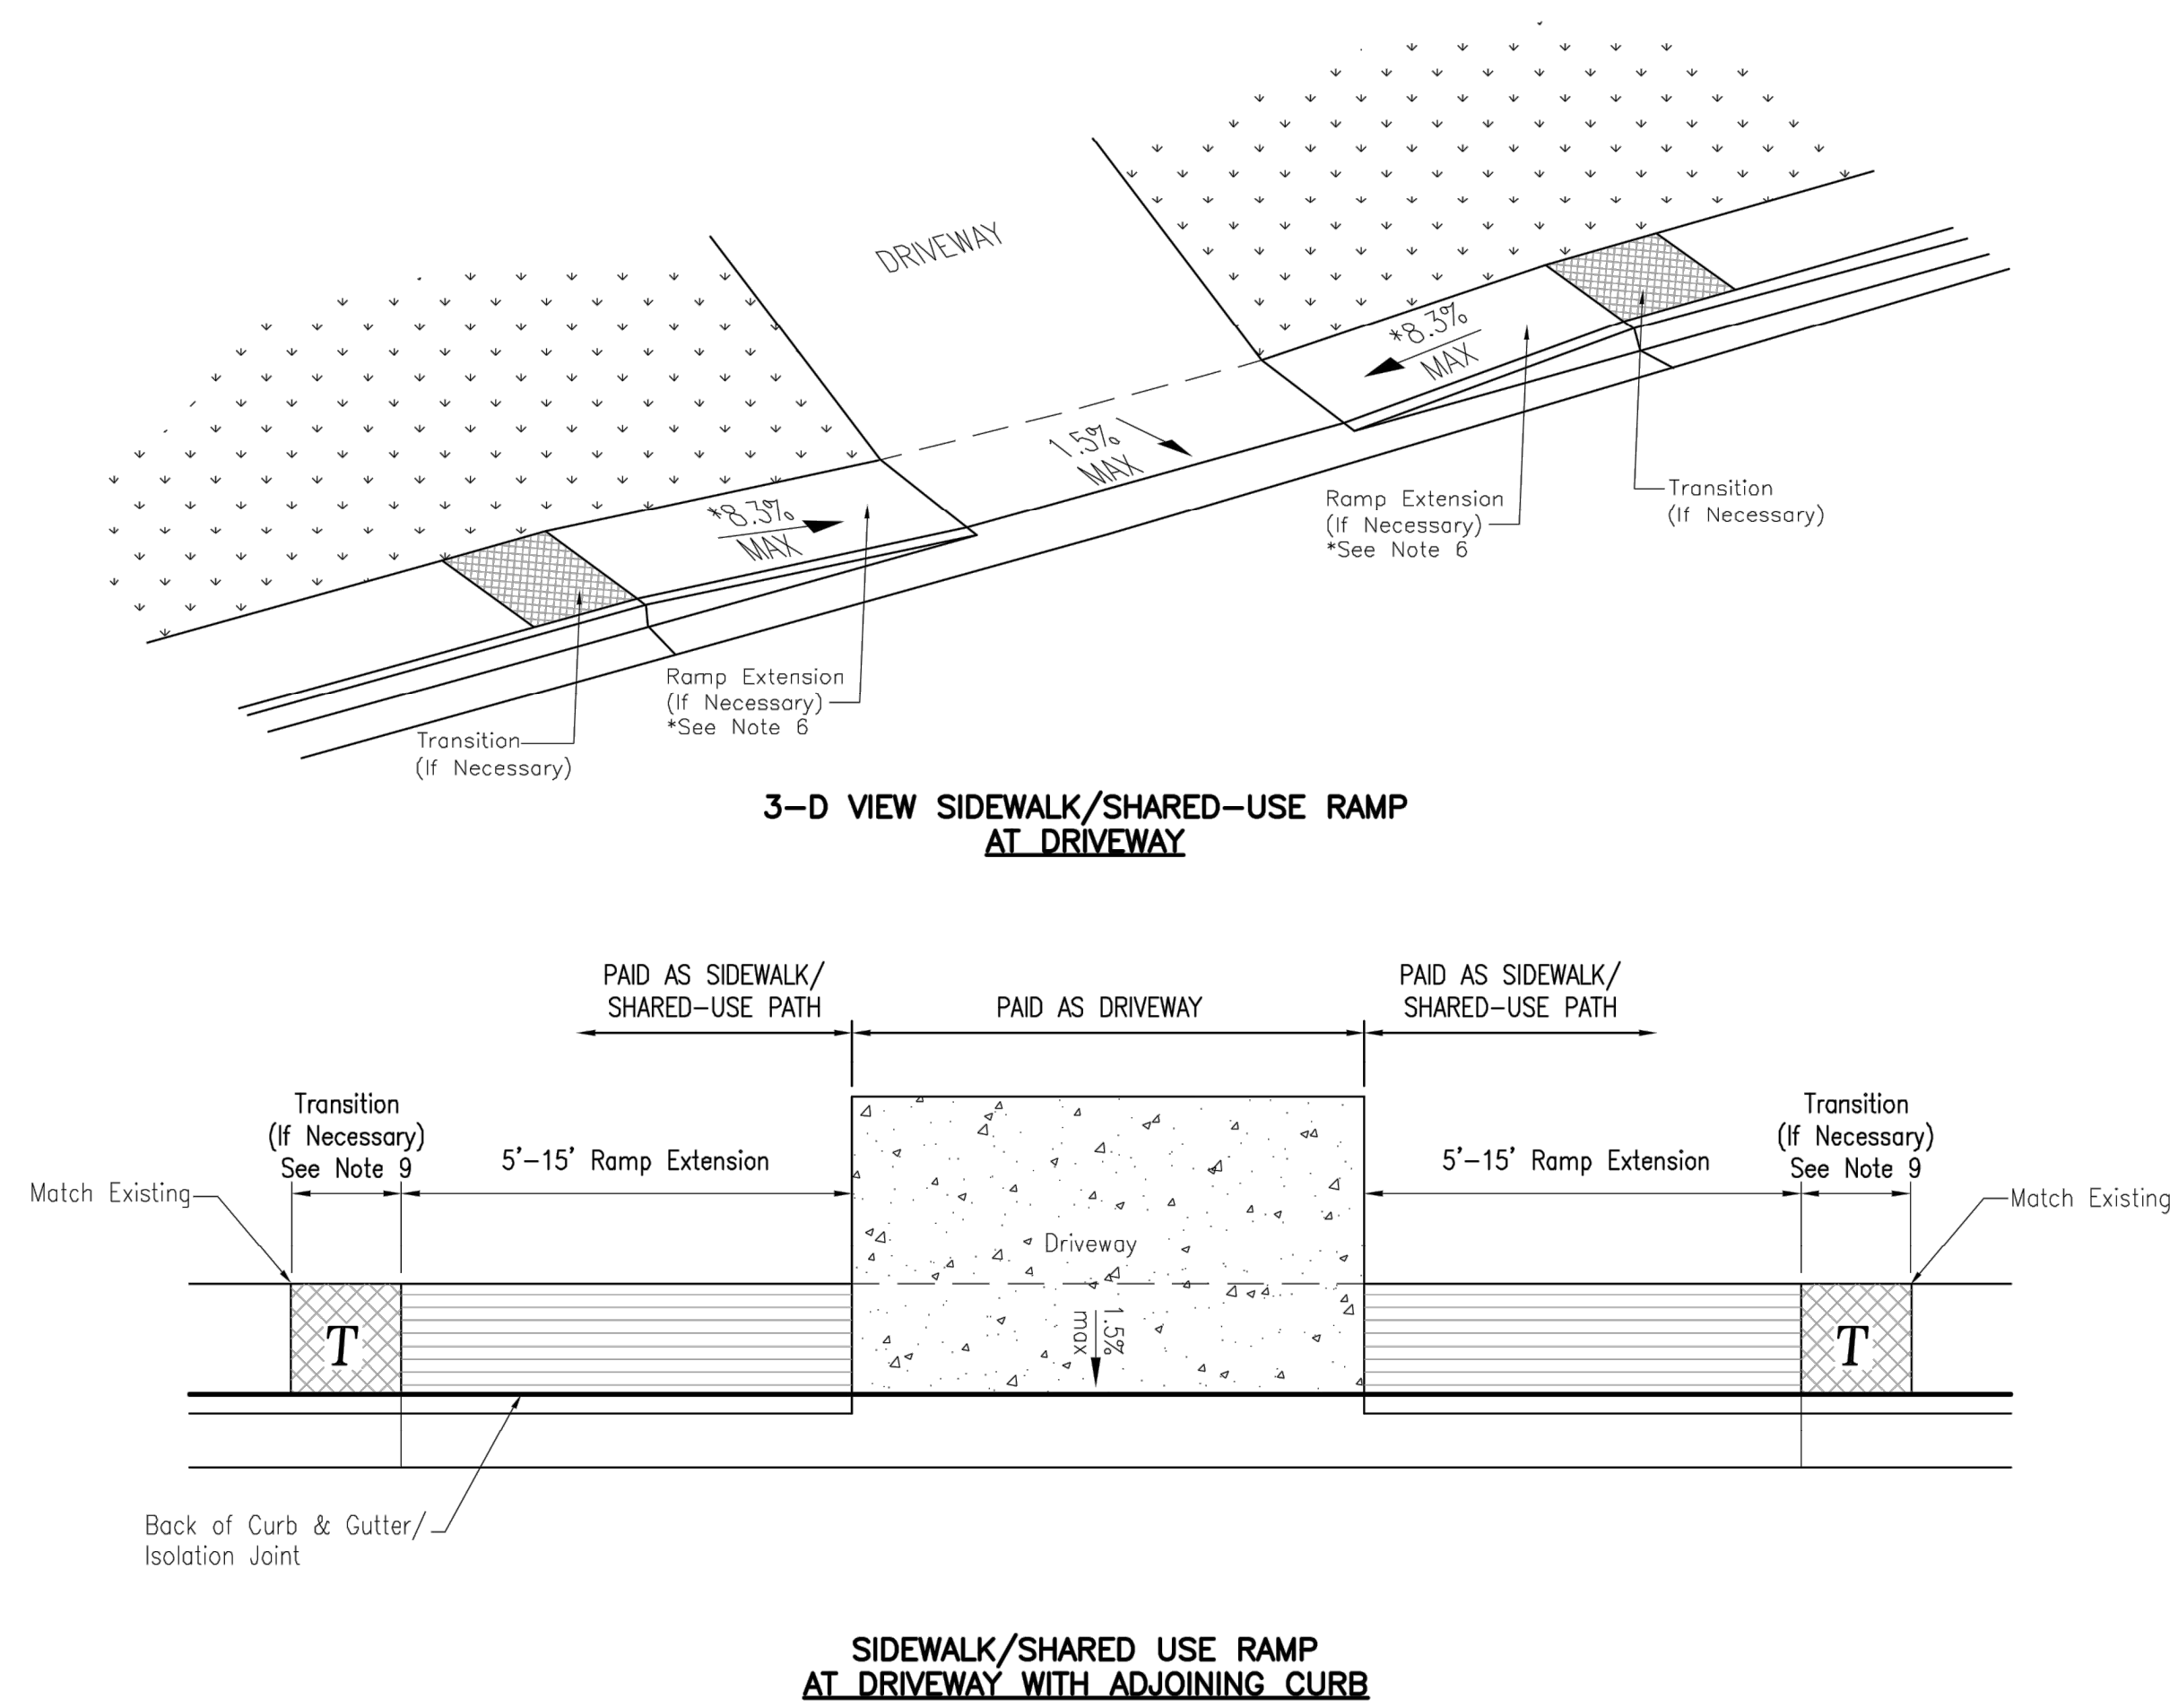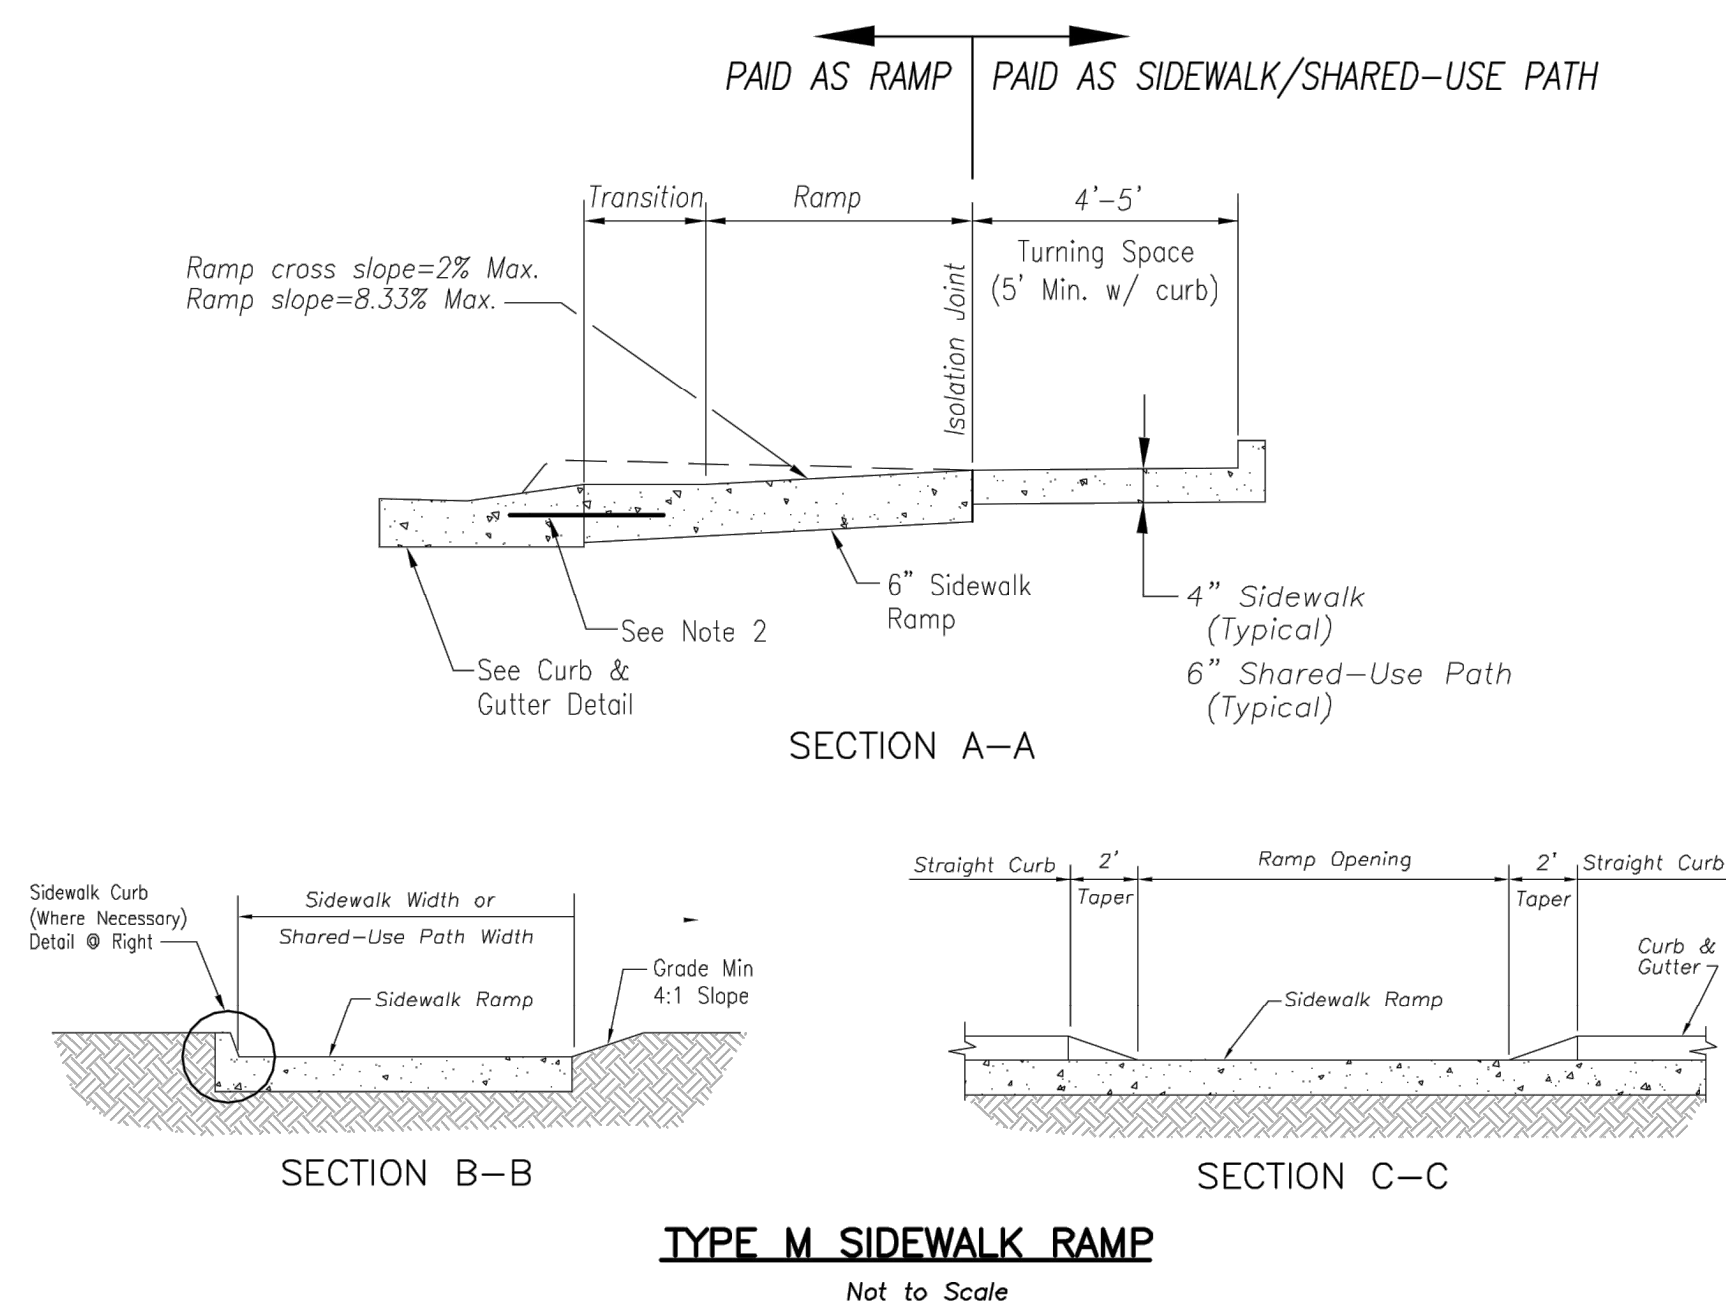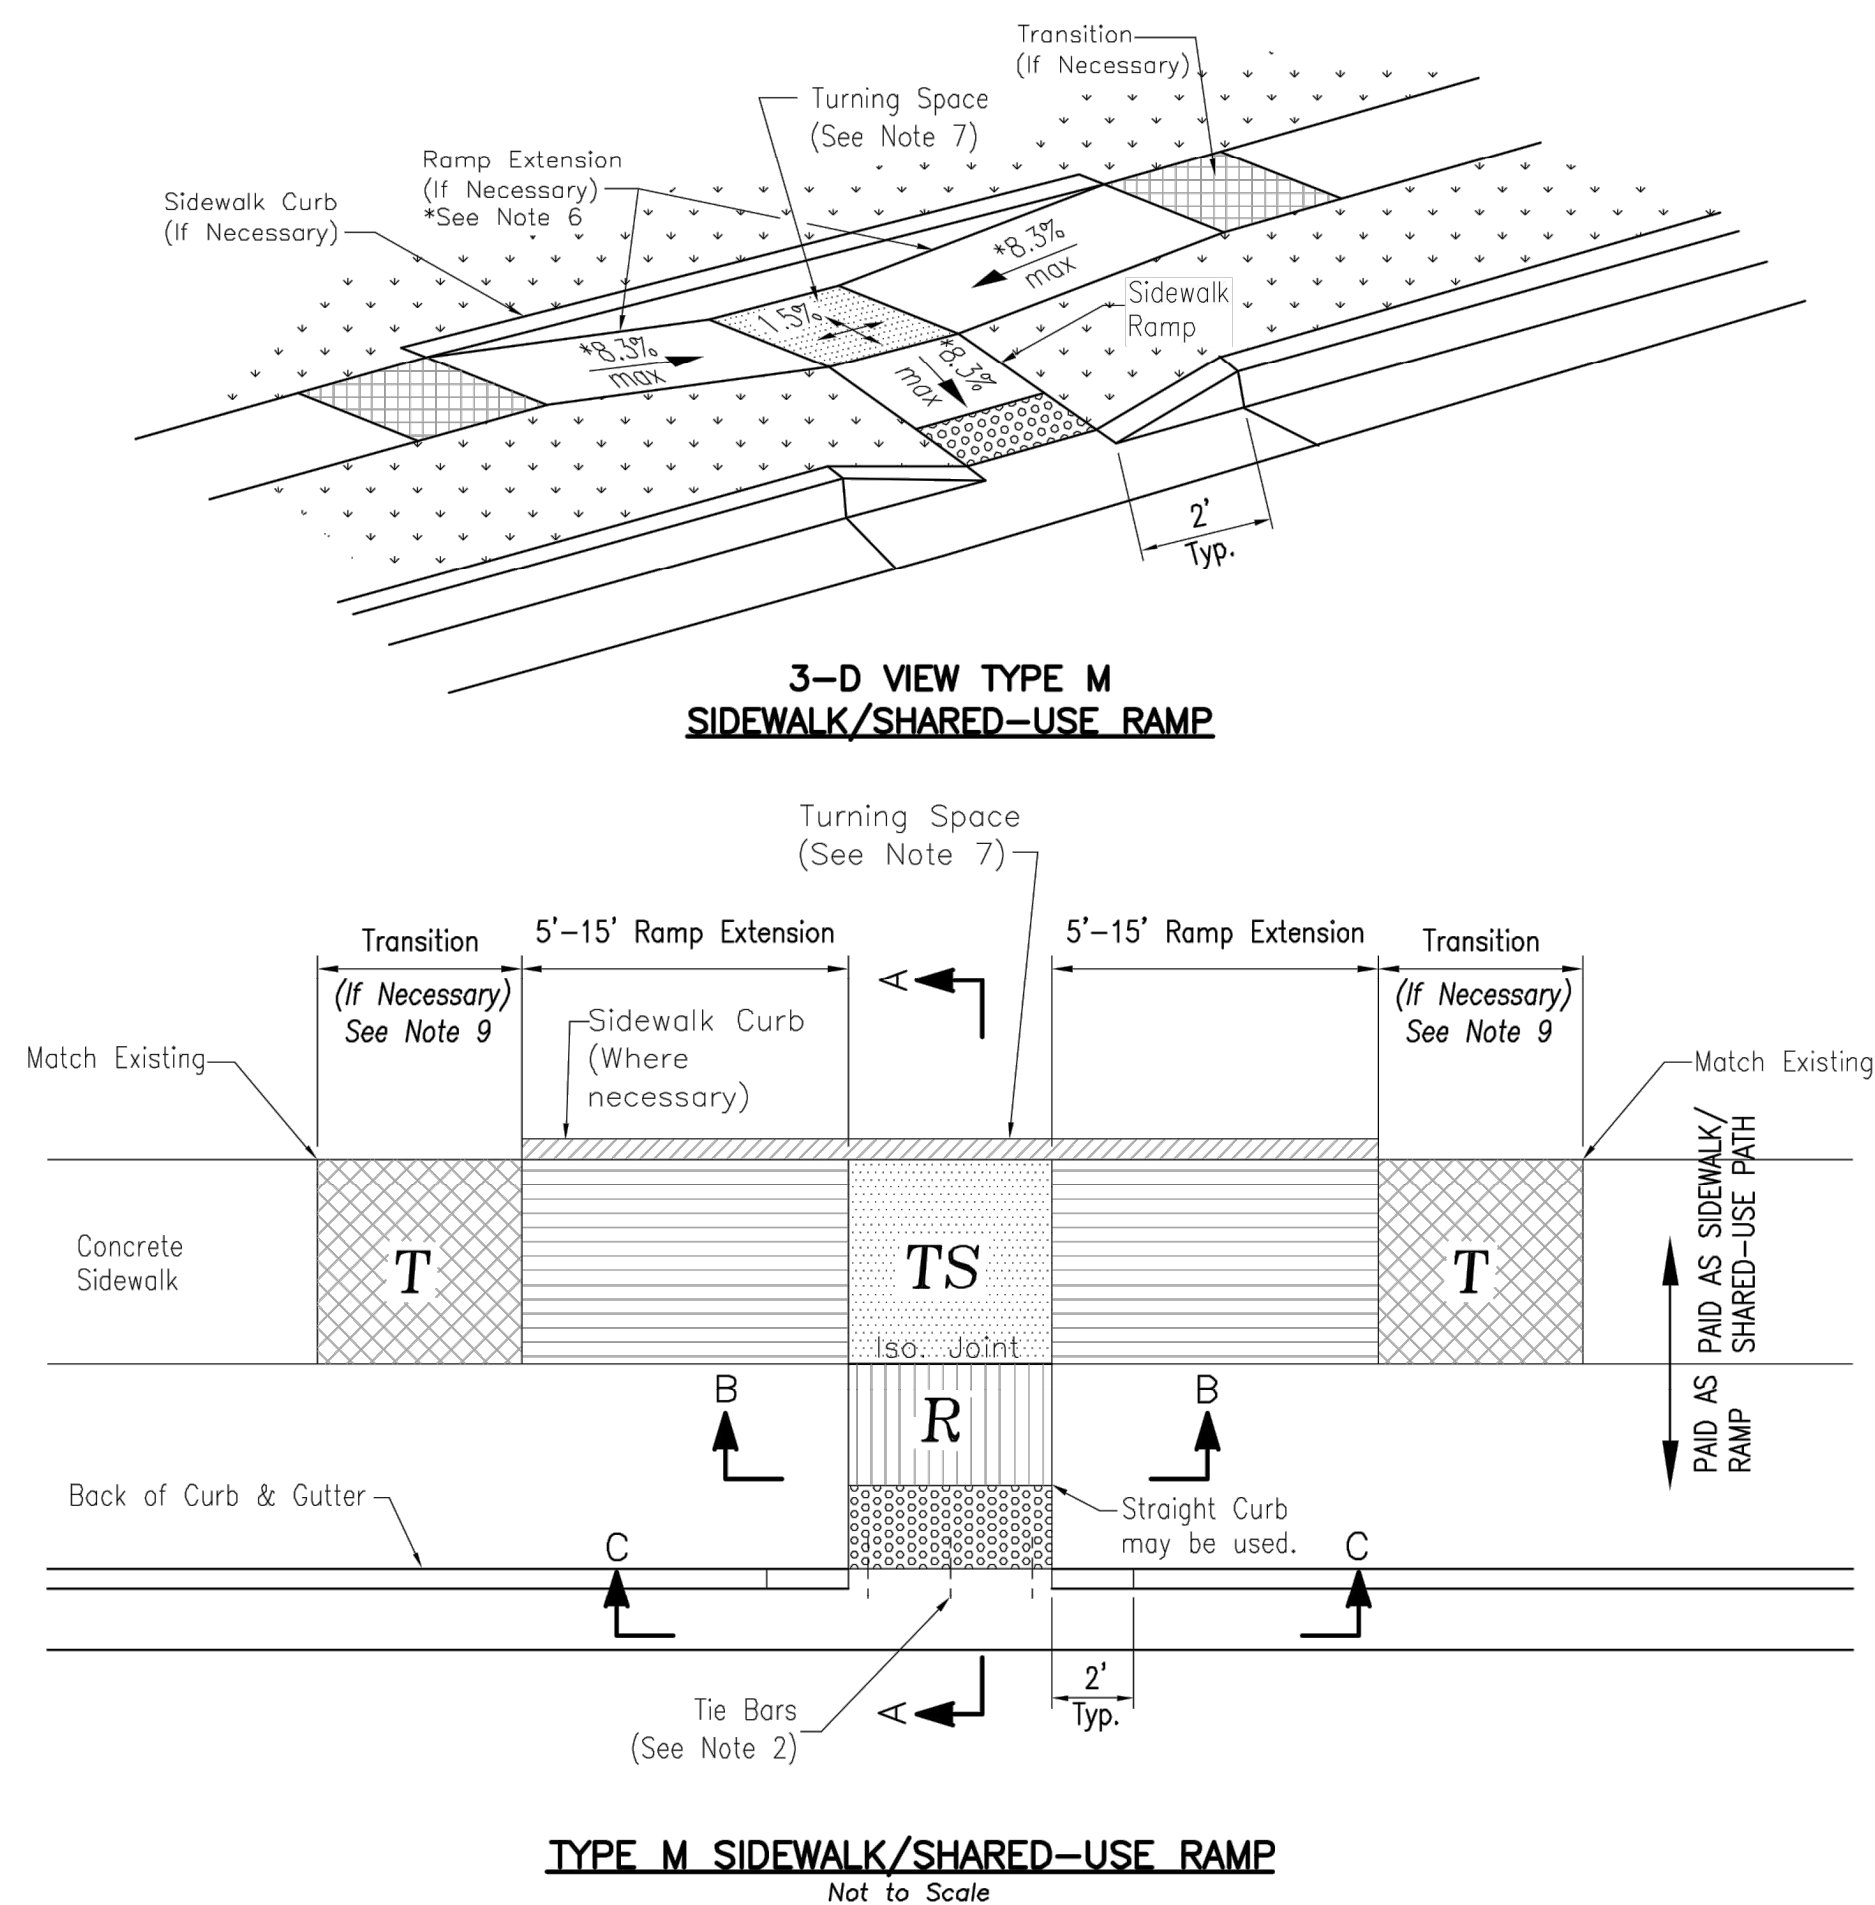

- SIDEWALK/SHARED—USE PATH & SIDEWALK/SHARED—USE RAMP NOTES:
1. CURB RAMP OPENING, NOT INCLUDING FLARES, SHALL MATCH EXISTING SIDEWALK WIDTH AND OPENING SHALL BE AT LEAST 48" WIDE.
 2. USE 18" LONG #4 EPOXY COATED TIE BARS @ 24" O.C. EMBED TIE BARS 9" IN EACH DIRECTION.
 3. ALL RAMPS, SIDEWALKS, SHARED—USE PATHS SUBGRADE MUST BE OF STABLE, COMPACTED EARTH AND SHALL BE OVERLAYED WITH 4" COMPACTED DENSE GRADED AGGREGATE BASE.
 4. LONGITUDINAL JOINT SPACING TO MATCH WIDTH OF SIDEWALK.
 5. ISOLATION JOINTS SHALL BE PLACED WHERE WALK ABUTS DRIVEWAYS AND SIMILAR STRUCTURES, AND 150' CENTERS MAX.
 6. ADA MAXIMUM RAMP SLOPE = 8.33%
ADA MAXIMUM CROSS SLOPE = 2.0%
- *ROADWAY EXCEPTION: WHERE EXISTING ROAD PROFILE GRADE DOES NOT ALLOW RAMP TO MEET RAMP SLOPE REQUIREMENT OF 8.33% OR LESS, THE RAMP SHALL BE EXTENDED TO A LENGTH OF 15 FEET TO MATCH EXISTING SIDEWALK. CROSS SLOPE OF RAMP SHALL BE 1.5%, $\pm 0.5\%$.
7. TURNING SPACES SHALL BE 1.5%, $\pm 0.5\%$, SLOPE IN ANY DIRECTION. TURNING SPACES SHALL HAVE A MINIMUM 4'x4' TURNING AREA. TURNING SPACES, WITH A SIDEWALK CURB, SHALL HAVE A 5' TURNING AREA PERPENDICULAR TO THE SIDEWALK CURB.
 8. FOR RETROFIT WORK, SLOPES TO BE DETERMINED IN FIELD BY CONTRACTOR AND APPROVED BY CITY INSPECTOR
 9. RAMP EXTENSION AREA SHALL NOT BE USED AS TRANSITION TO EXISTING SIDEWALK. ANY TRANSITIONS REQUIRED TO MATCH RAMPS TO EXISTING SIDEWALK SHALL REQUIRE REMOVAL AND REPLACEMENT OF ADDITIONAL SIDEWALK BEYOND THE RAMP AREA. SIDEWALK TRANSITION LENGTH SHALL BE EQUAL TO OR GREATER THAN THE WIDTH OF THE EXISTING SIDEWALK. RAMP EXTENSIONS SHALL BE A CONTINUOUS SLOPE.
 10. ALL SIDEWALK AND RAMP CONSTRUCTION SHALL MEET CURRENT PUBLIC RIGHT OF WAY ACCESSIBILITY GUIDELINES (PROWAG).

 LEE'S SUMMIT MISSOURI	Project: STANDARD DETAILS CITY OF LEE'S SUMMIT, MO LEE'S SUMMIT, JACKSON COUNTY, MO
	Sheet Name: ADA RAMP RETROFIT DETAIL

Drawn By: MJF


Checked By: DL

Date: 04/17

Proj. #:

GEN-3B

STANDARD DETAILS		C.O.A. NO.: _____		DATE: _____	
		DRAWN BY: _____ ARJ/AMW		PROJECT NO.: 021-04157	
SCANNELL DEVELOPMENT LEE'S SUMMIT LOGISTICS NORTHWEST CORNER OF TUDOR ROAD AND MAIN STREET		CHECKED BY: _____		DWG NO.: T PD/ET 02104157	
		APPROVED BY: _____ RBF		DATE: 0201-10-12	
LEE'S SUMMIT, MISSOURI		QA/QC BY: _____ RBF		SHEET 36 OF 105	
		PROJECT NO.: 021-04157		REVISIONS	
REV. NO.		DATE		REVISIONS	
BY		RYAN B. FLEMING		Olsson Engineering - MO State Certificate of Authority #001592	
REVISIONS DESCRIPTION		MO. NO. PE-2002003161		7301 West 133rd Street, Suite 200 TEL 913.381.1170	
REVISIONS				Overland Park, KS 66213-4750 FAX 913.381.1174 www.olsson.com	

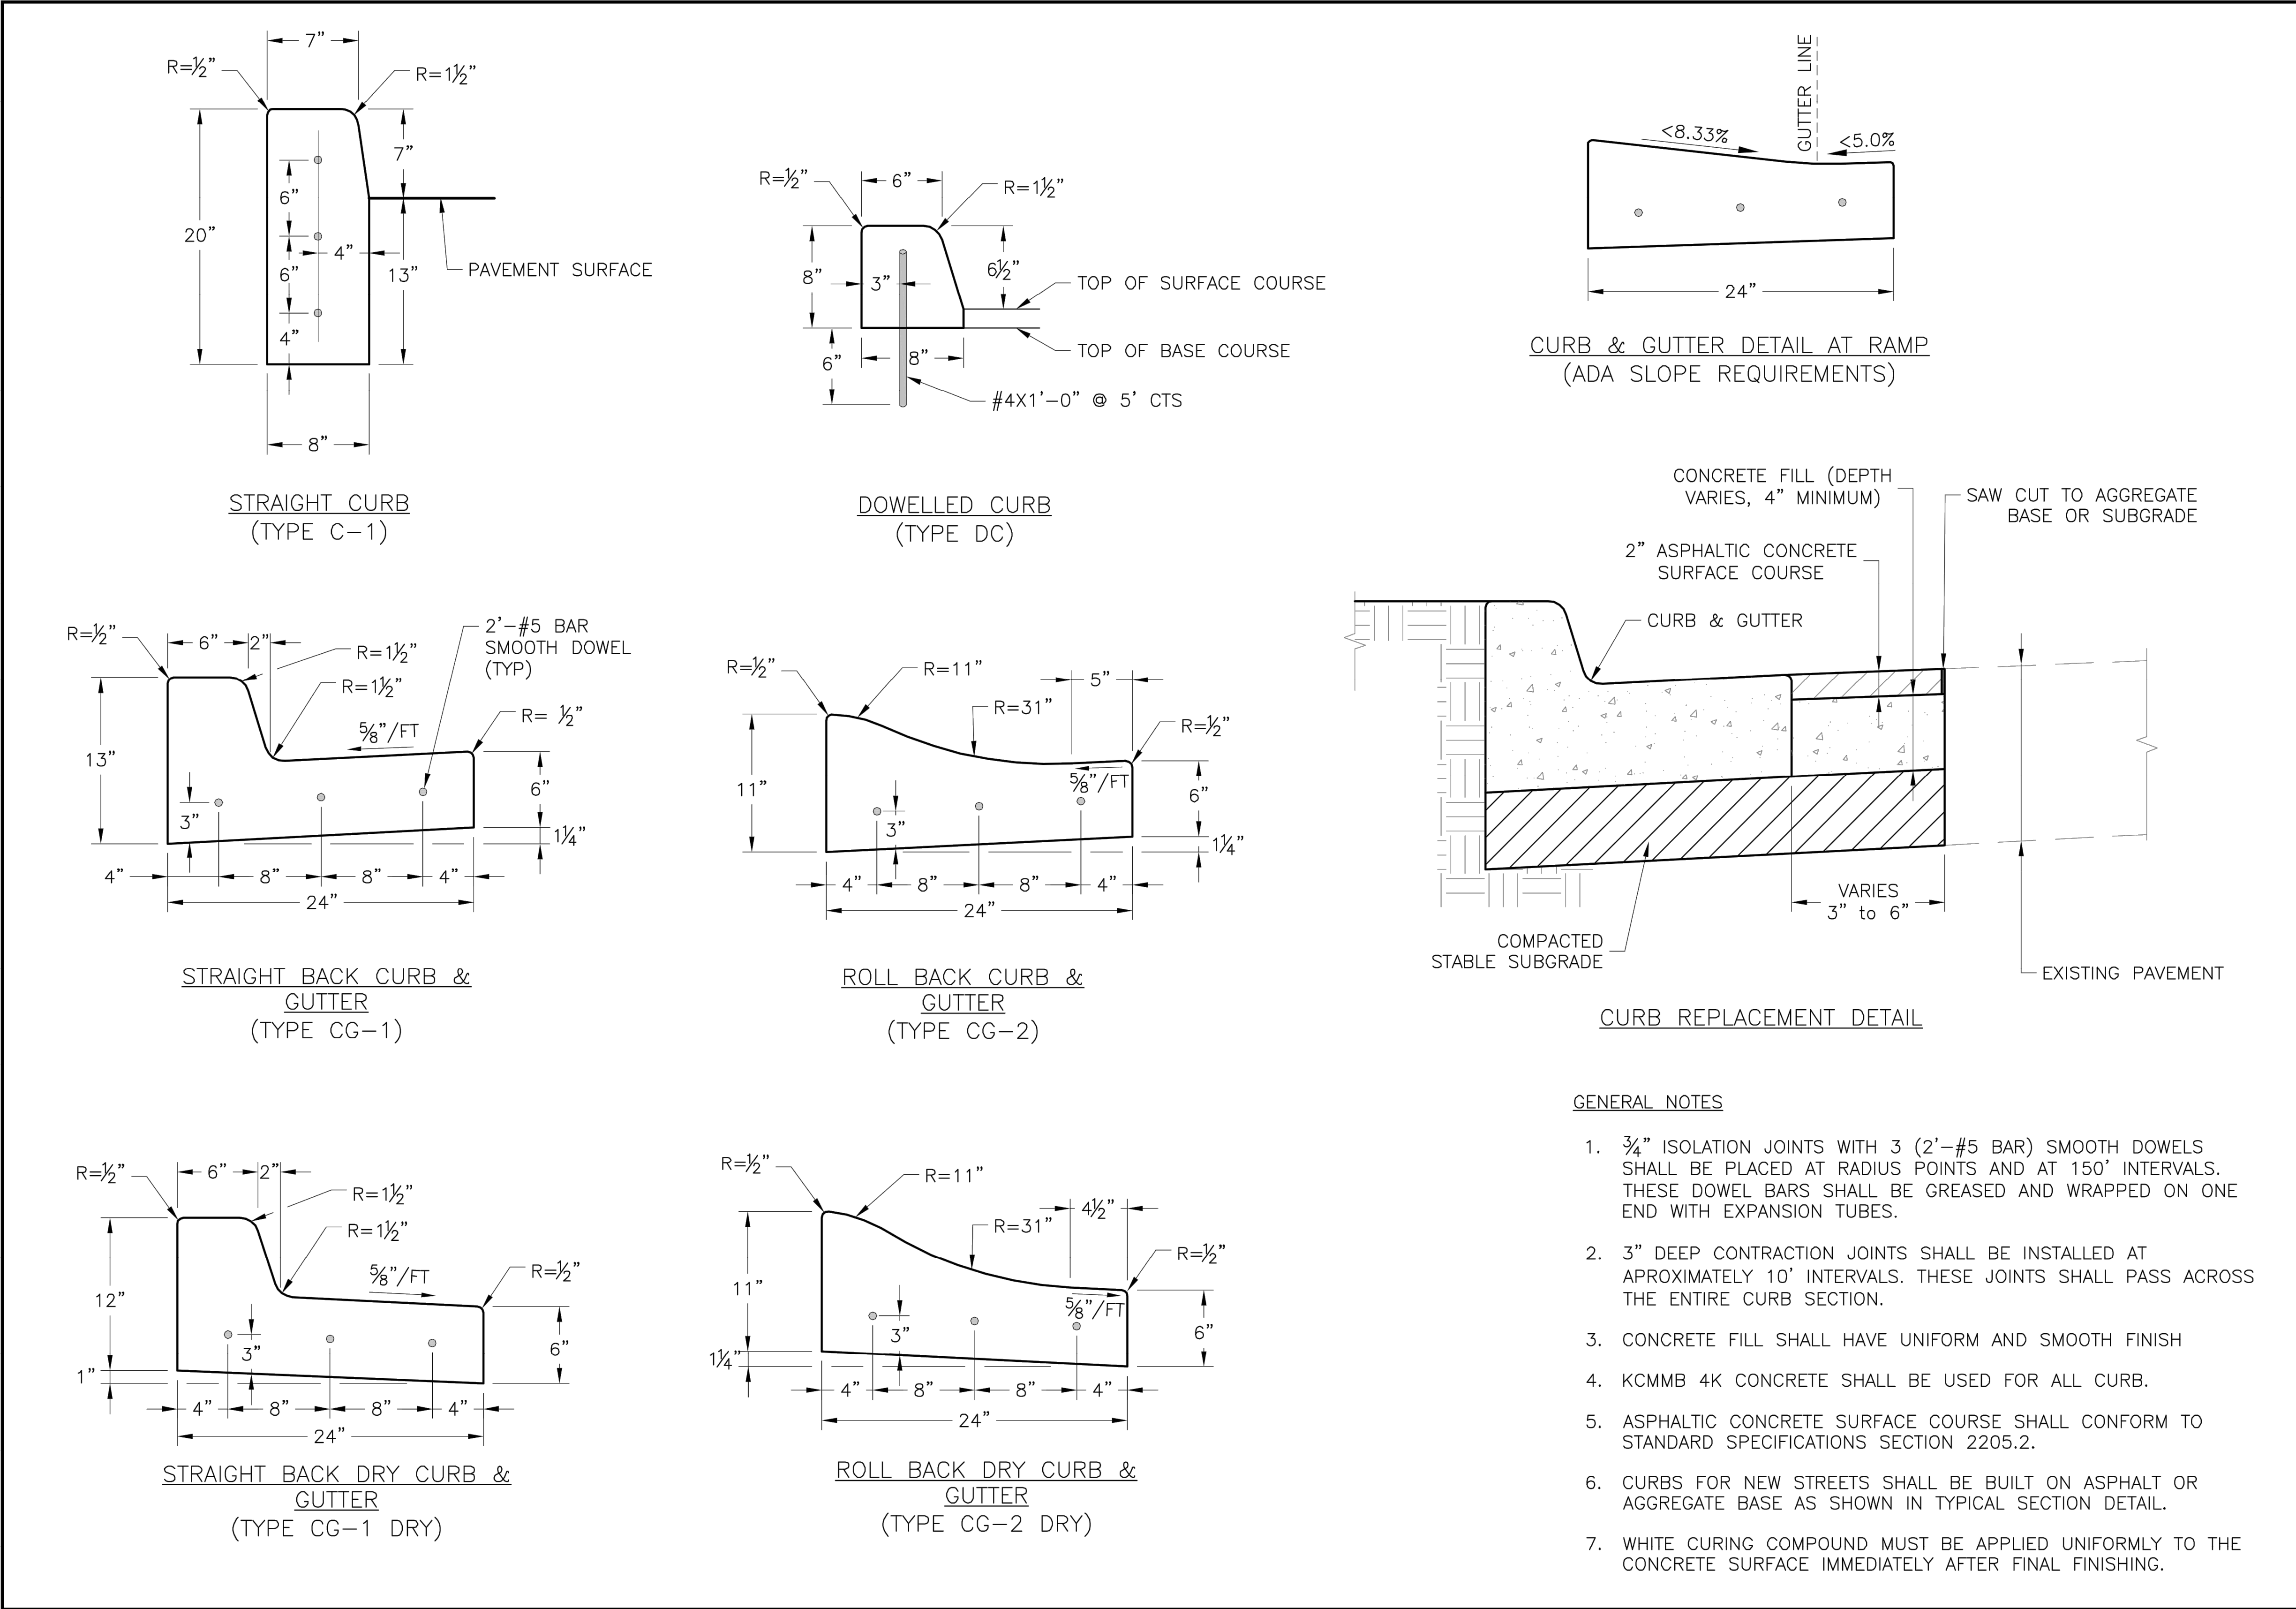

LEE'S SUMMIT
MISSOURI

PUBLIC WORKS ENGINEERING DIVISION | 220 SE GREEN STREET | LEE'S SUMMIT, MO 64063

STANDARD DETAILS

CITY OF LEE'S SUMMIT, MO
LEE'S SUMMIT, JACKSON COUNTY, MO

CURB & GUTTER DETAIL

Project:


Drawn By: MJF

Checked By: DL


Date: 04/17

Proj. #:

GEN-4

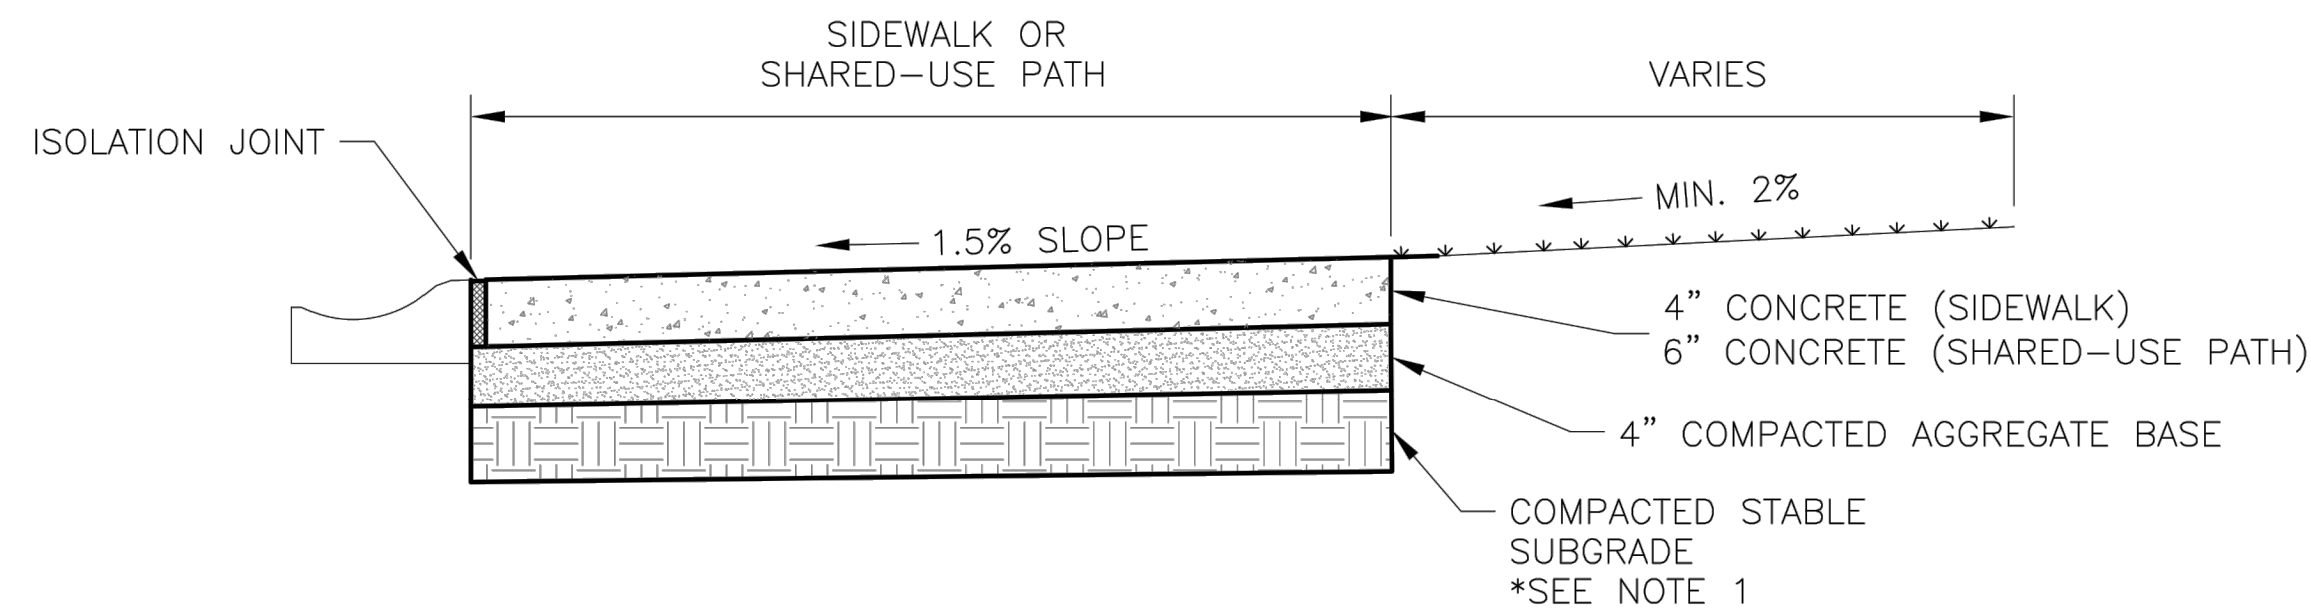


SIDEWALK/SHARED-USE PATH WITHOUT BUFFER
NOT TO SCALE

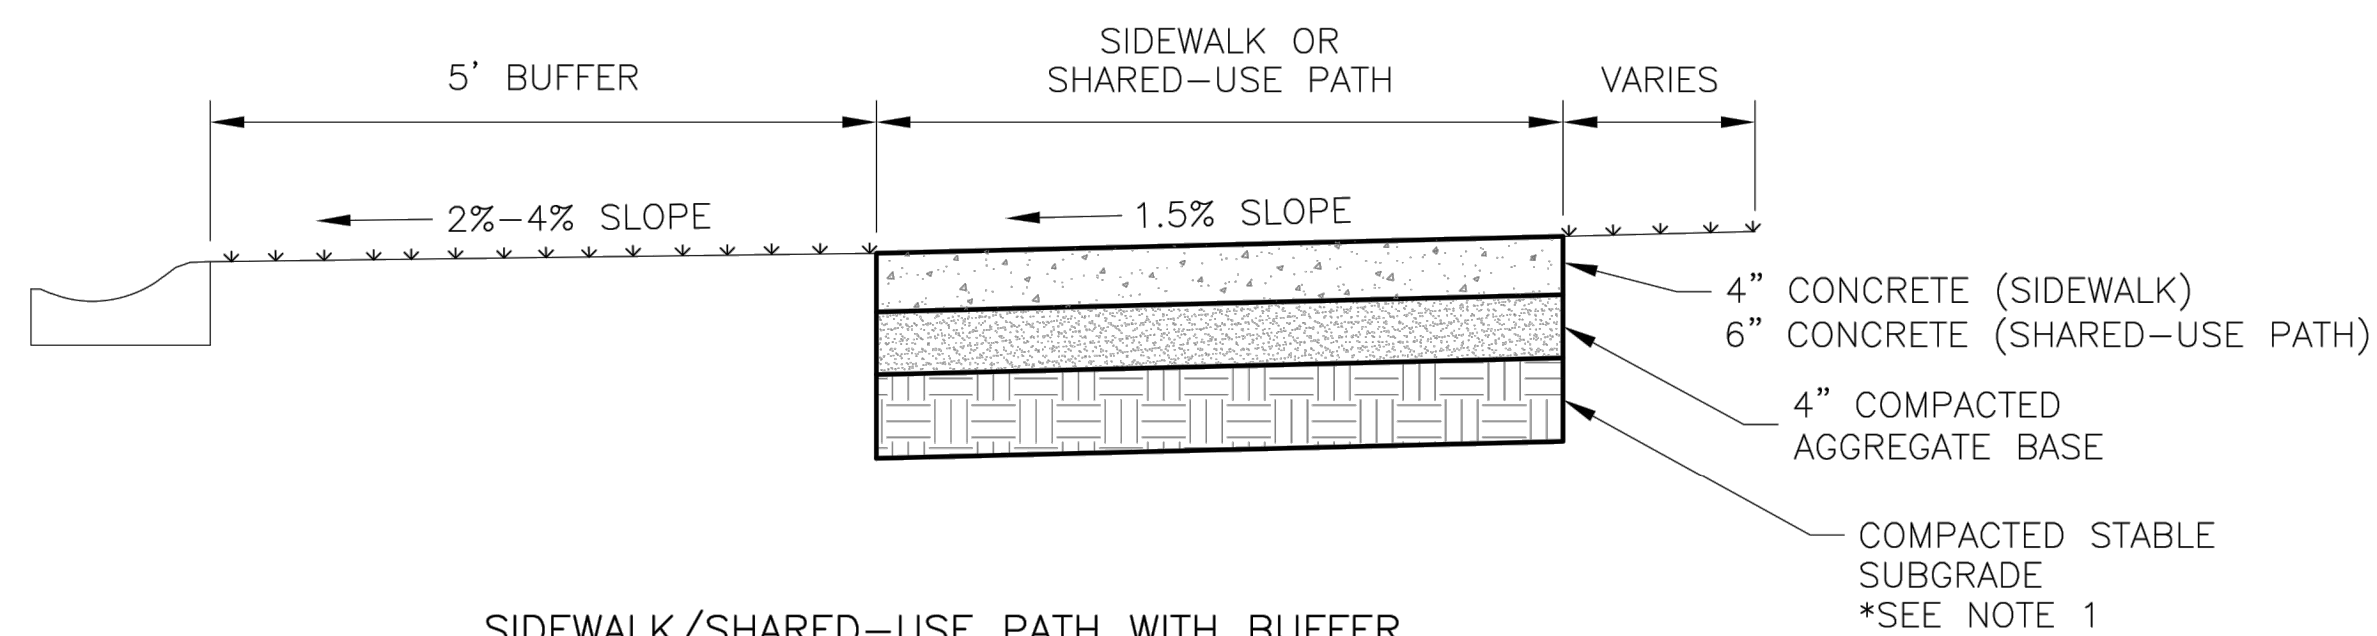

SIDEWALK/SHARED-USE PATH WITH BUFFER
NOT TO SCALE

GENERAL NOTES:

1. SUBGRADE MUST BE OF STABLE, COMPACTED EARTH AND SHALL BE OVERLAYED WITH 4" COMPACTED DENSE GRADED AGGREGATE BASE.
2. 1.5% CROSS SLOPE MUST BE MAINTAINED THROUGH DRIVEWAYS.
3. KCMMB 4K CONCRETE MIX SHALL BE REQUIRED FOR ALL SIDEWALKS/SHARED-USE PATHS OR AS APPROVED BY THE CITY INSPECTOR.
4. ALL SIDEWALK/SHARED-USE PATHS SHALL MEET CURRENT PUBLIC RIGHT OF WAY ACCESSIBILITY GUIDELINES (PROWAG).
5. AN ISOLATION JOINT SHALL BE PLACED AT A MAXIMUM OF 150 FT. CONSTRUCTION JOINTS SHALL BE PLACED THE SAME WIDTH OF SIDEWALK/SHARED-USE PATHS, BUT NO GREATER THAN 10 FT.
6. AN ISOLATION JOINT SHALL BE PLACED WHERE THE SIDEWALK/SHARED-USE PATHS MEETS A RESIDENTIAL DRIVEWAY.
7. SHARED-USE PATHS WIDTH SHALL BE 10 FT. WIDE.
8. SIDEWALK/SHARED-USE PATHS FINISHING SHALL BE FULL BROOM FINISH OR AS DIRECTED BY CITY INSPECTOR.
9. WHITE CURING COMPOUND MUST BE APPLIED UNIFORMLY TO THE CONCRETE SURFACE IMMEDIATELY AFTER FINAL FINISHING.

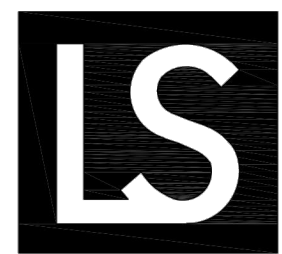

LEE'S SUMMIT
MISSOURI

PUBLIC WORKS ENGINEERING DIVISION | 220 SE GREEN STREET | LEE'S SUMMIT, MO 64063


SIDEWALK/SHARED-USE PATH DETAIL

Date: 04/17

Drawn By: MJF

Checked By: DL

GEN-2

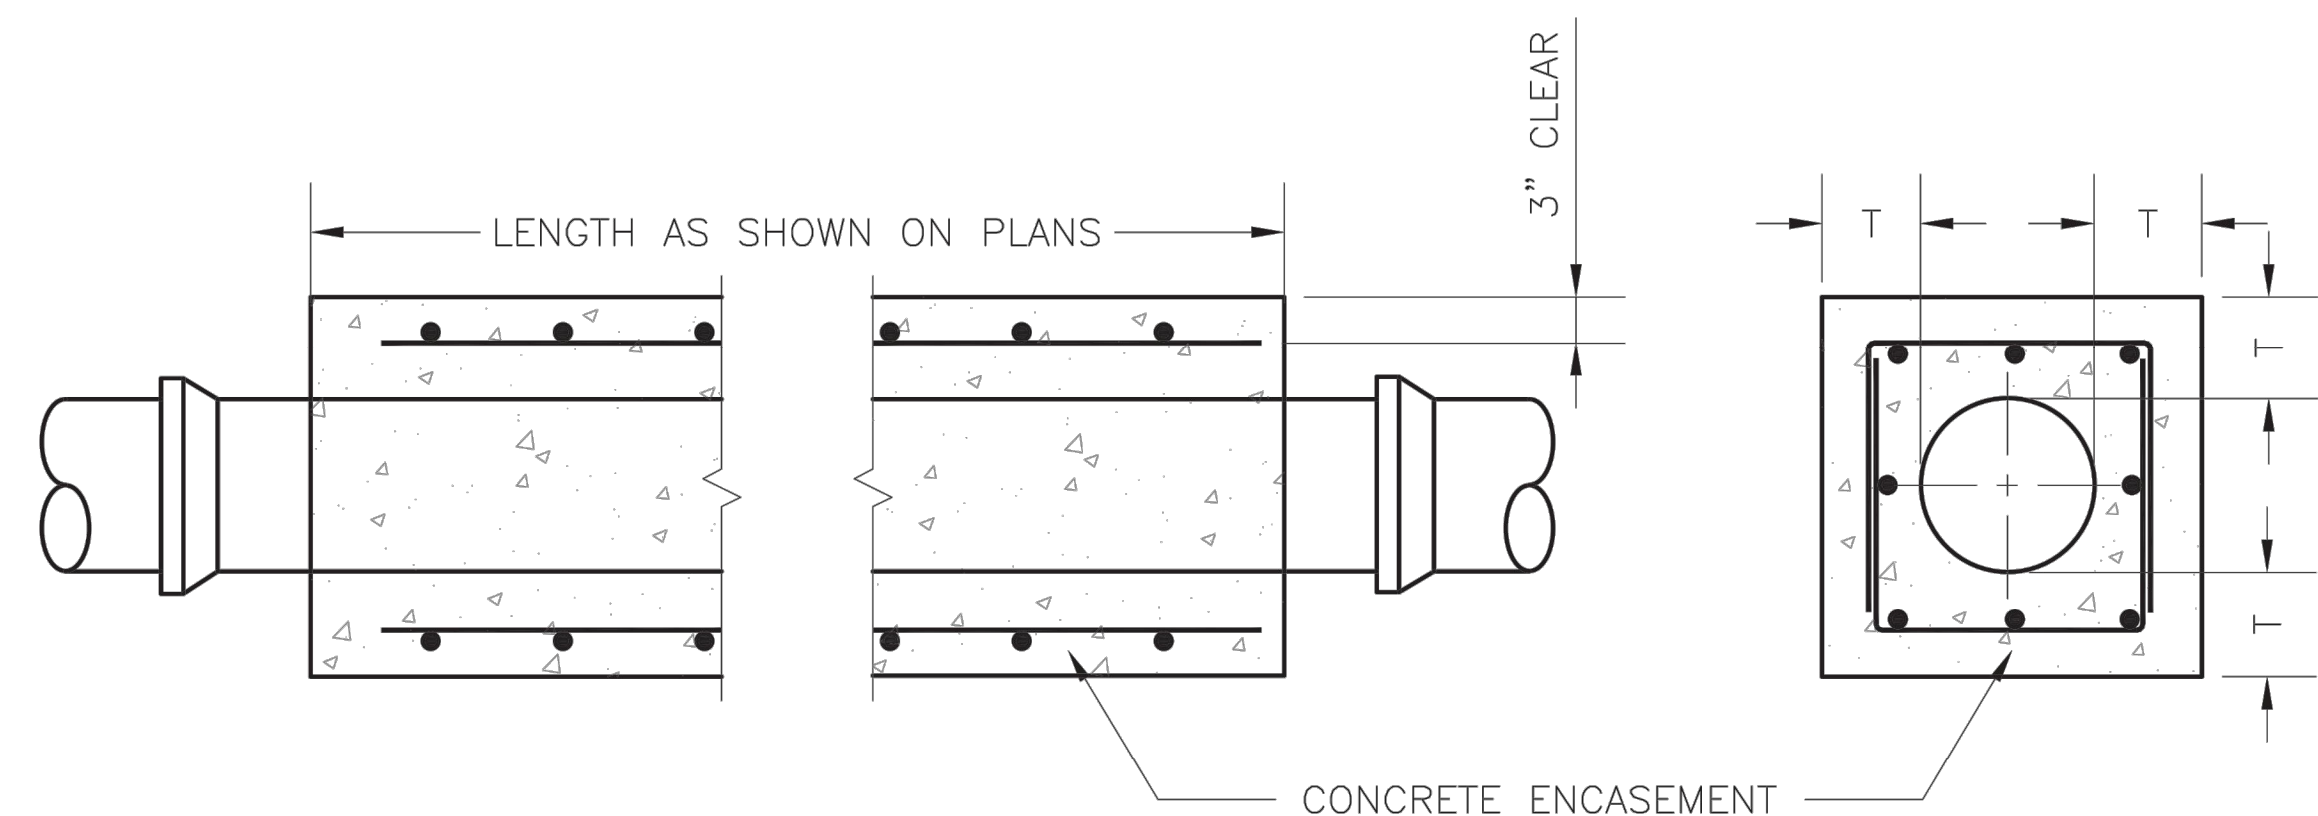

NOTES:

1. FOR PIPES LESS THAN 15", T = 6" MIN.
2. FOR PIPES 15" THRU 36", T = 8" MIN.
3. INTERMEDIATE BELLS SHALL BE ENCASED.
4. REINFORCING STEEL SHALL BE #4 @ 12" O.C. EACH WAY WITH A MINIMUM REBAR LAP OF 12".



LEE'S SUMMIT

MISSOURI

PUBLIC WORKS ENGINEERING DIVISION | 220 SE GREEN STREET | LEE'S SUMMIT, MO 64063

PIPE ENCASEMENT DETAIL

Date: 01/2016

Drawn By: JN

Checked By: DL

SAN-7

STANDARD DETAILS

SCANNELL DEVELOPMENT LEE'S SUMMIT LOGISTICS
NORTHWEST CORNER OF TUDOR ROAD AND MAIN STREET

LEE'S SUMMIT, MISSOURI

2021


REVISIONS

RYAN B. FLEMING
MO. NO. PE-2002003161

RECORD
DRAWINGS


Olsson

Olsson Engineering - MO State Certificate of Authority #001592
7301 West 133rd Street, Suite 200 TEL 913.381.1170
Overland Park, KS 66213-4750 FAX 913.381.1174 www.olsson.com

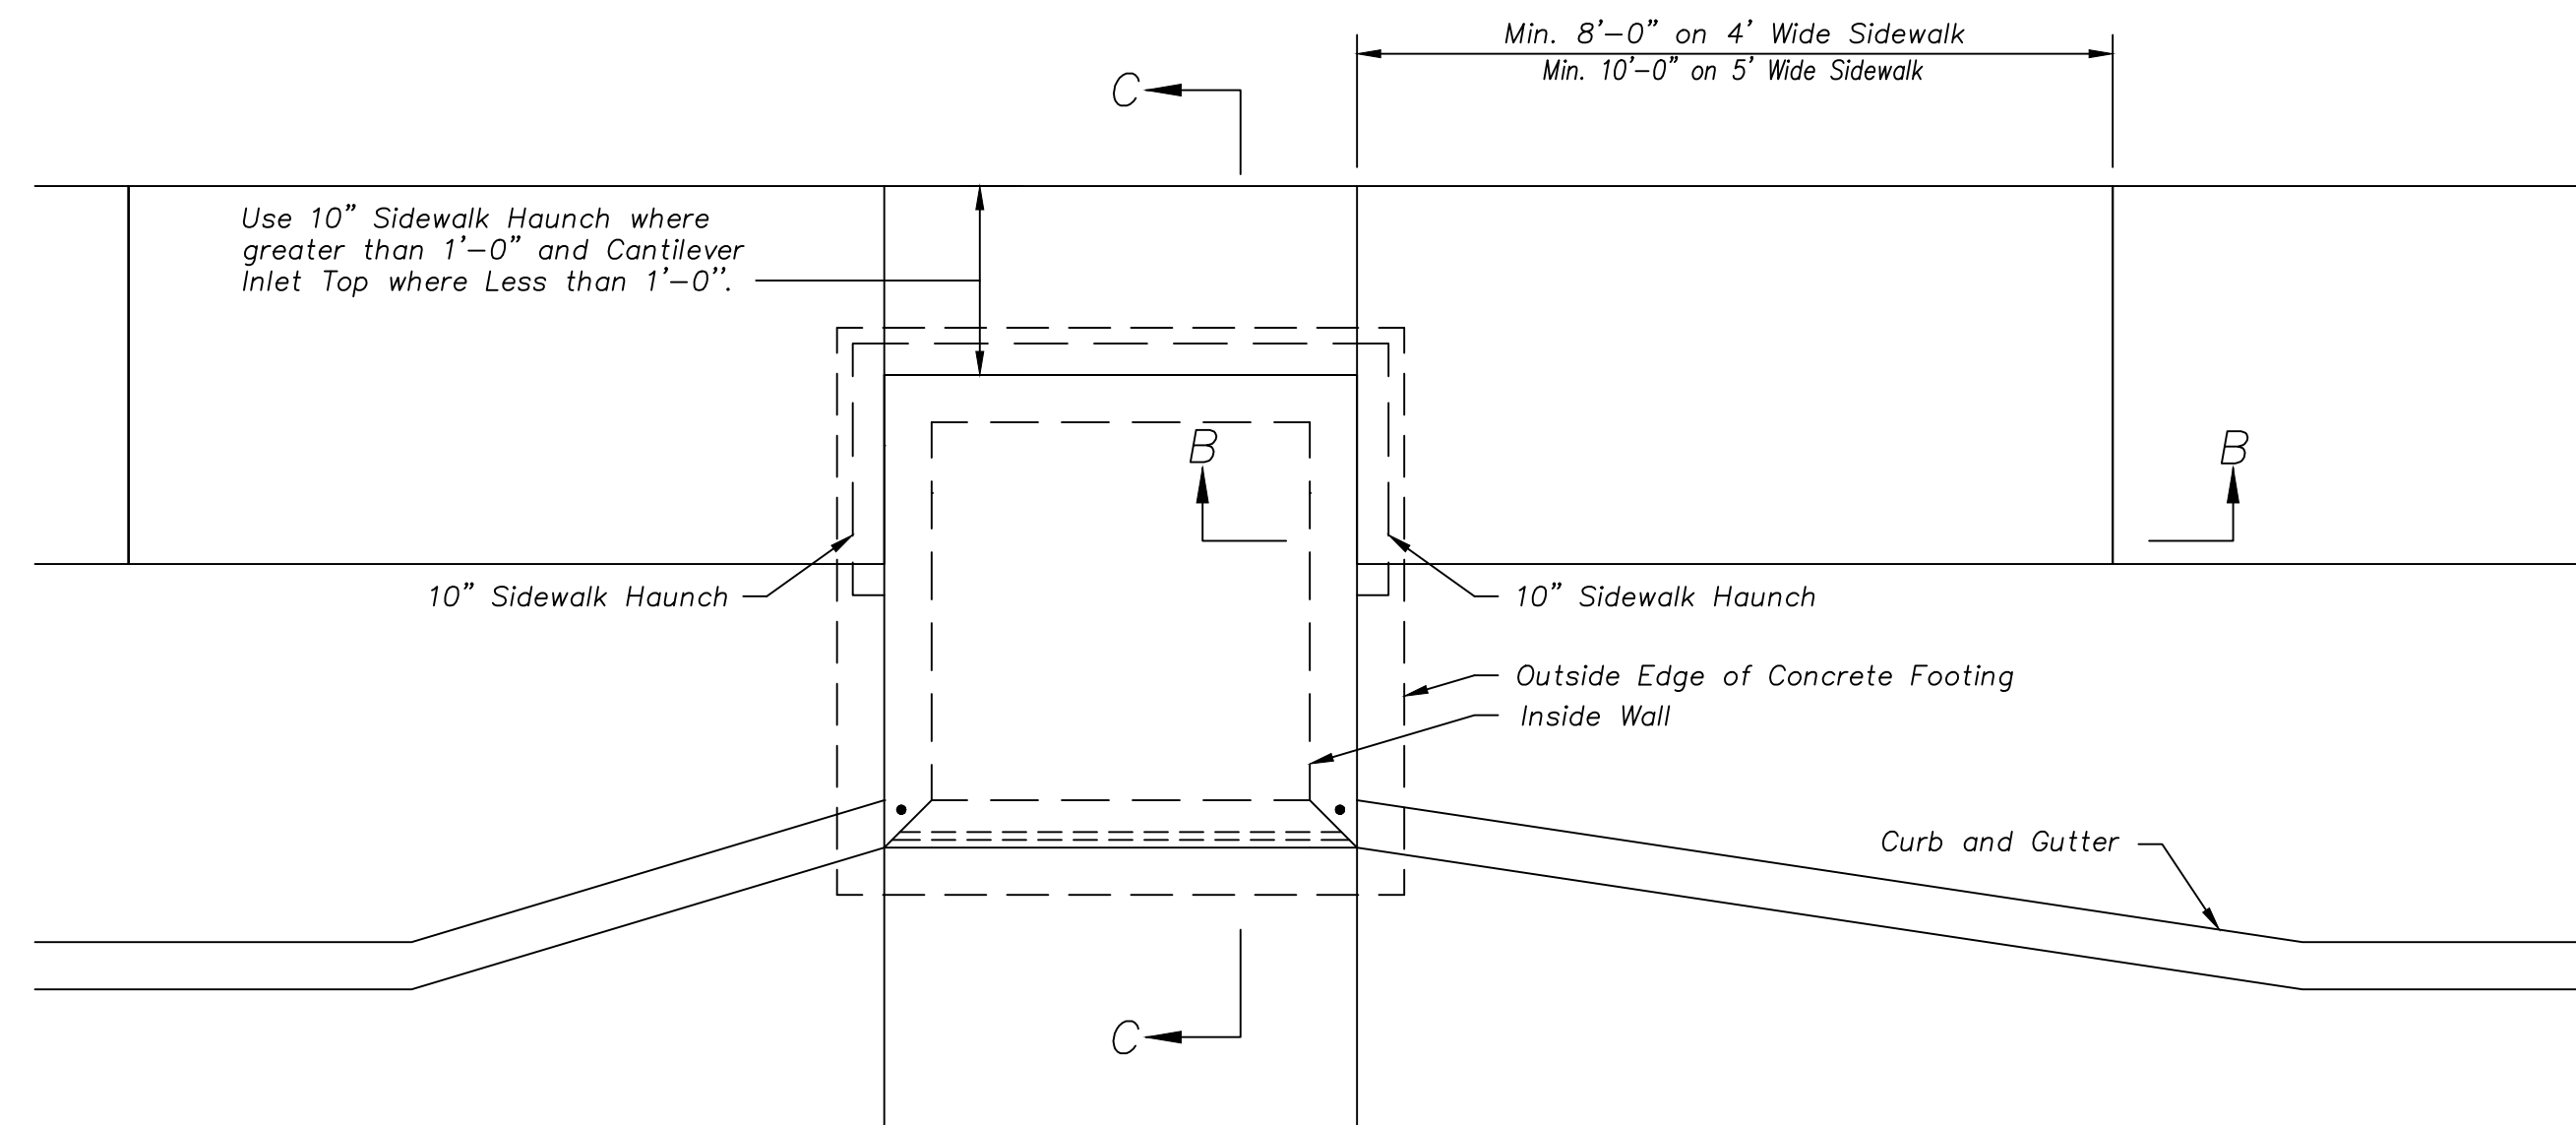


Plan

Not to Scale

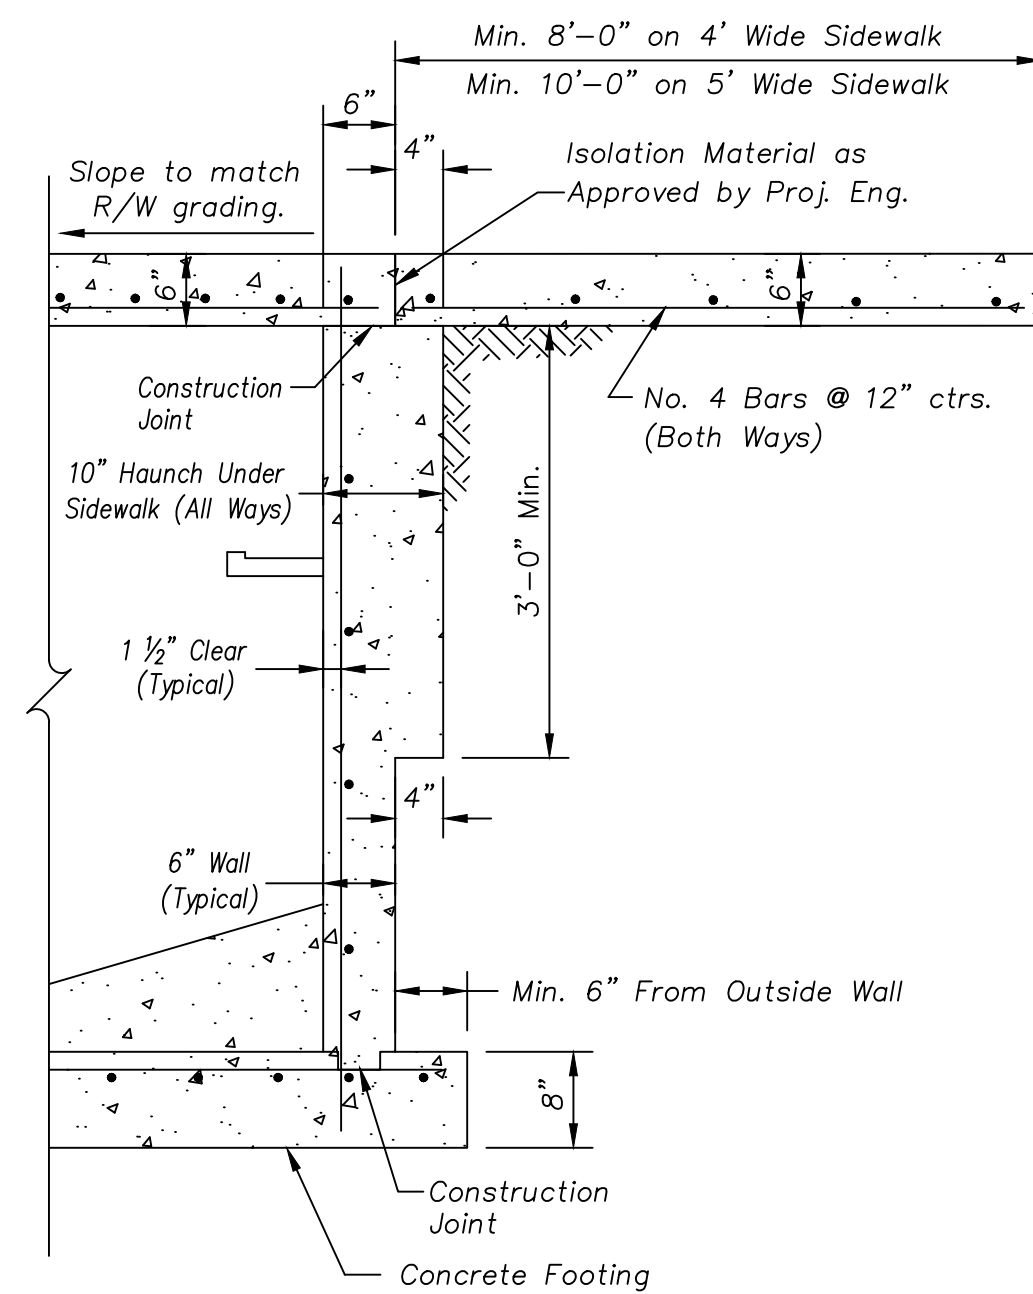


Section B-B
With Sidewalk Haunch

NOTE: Sidewalk Haunch is Subsidiary
to the Curb Inlet Construction.

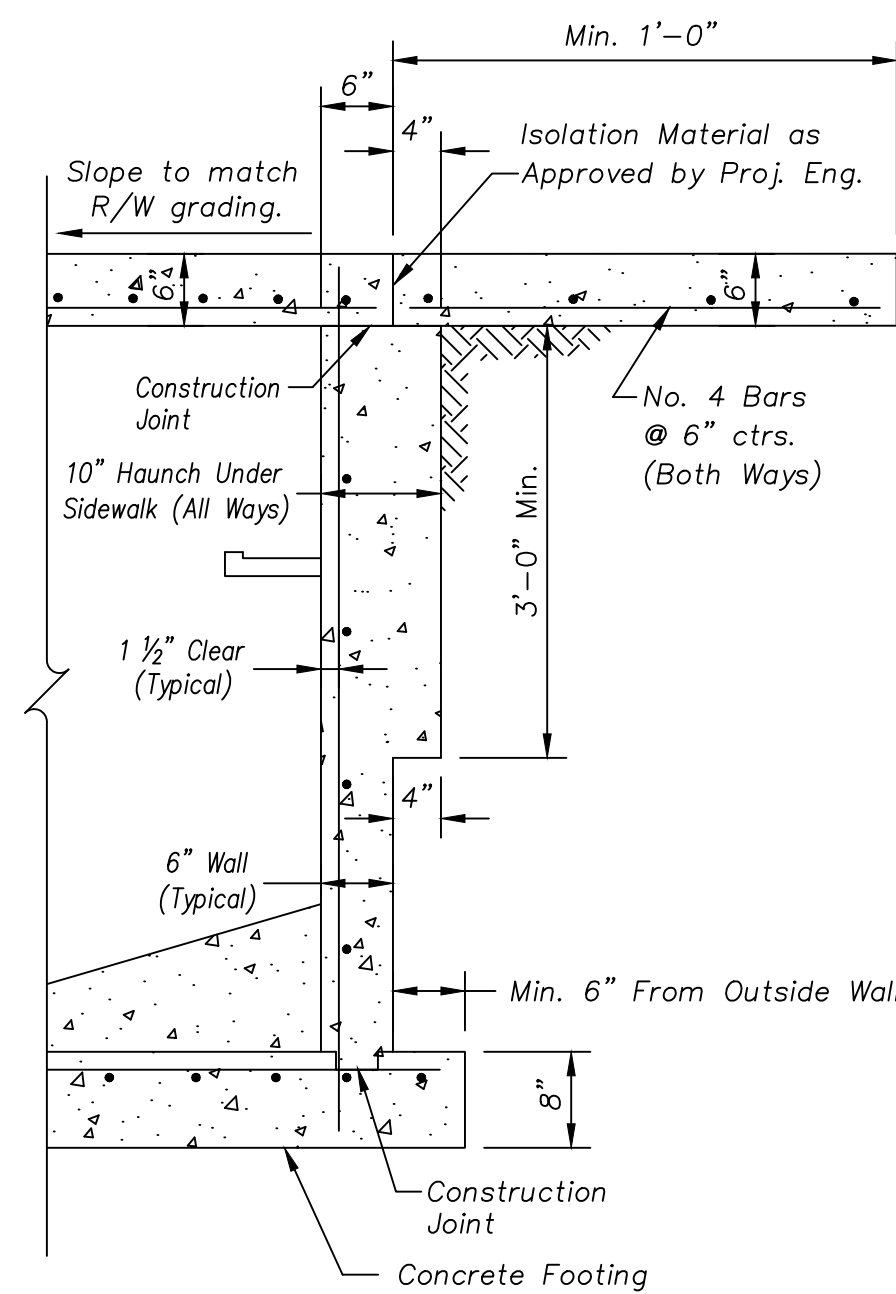

Section C-C
With Sidewalk Haunch Where Sidewalk
Width > 1' Along Back of Inlet




NOTE: Sidewalk Haunch is Subsidiary to the Curb Inlet Construction.

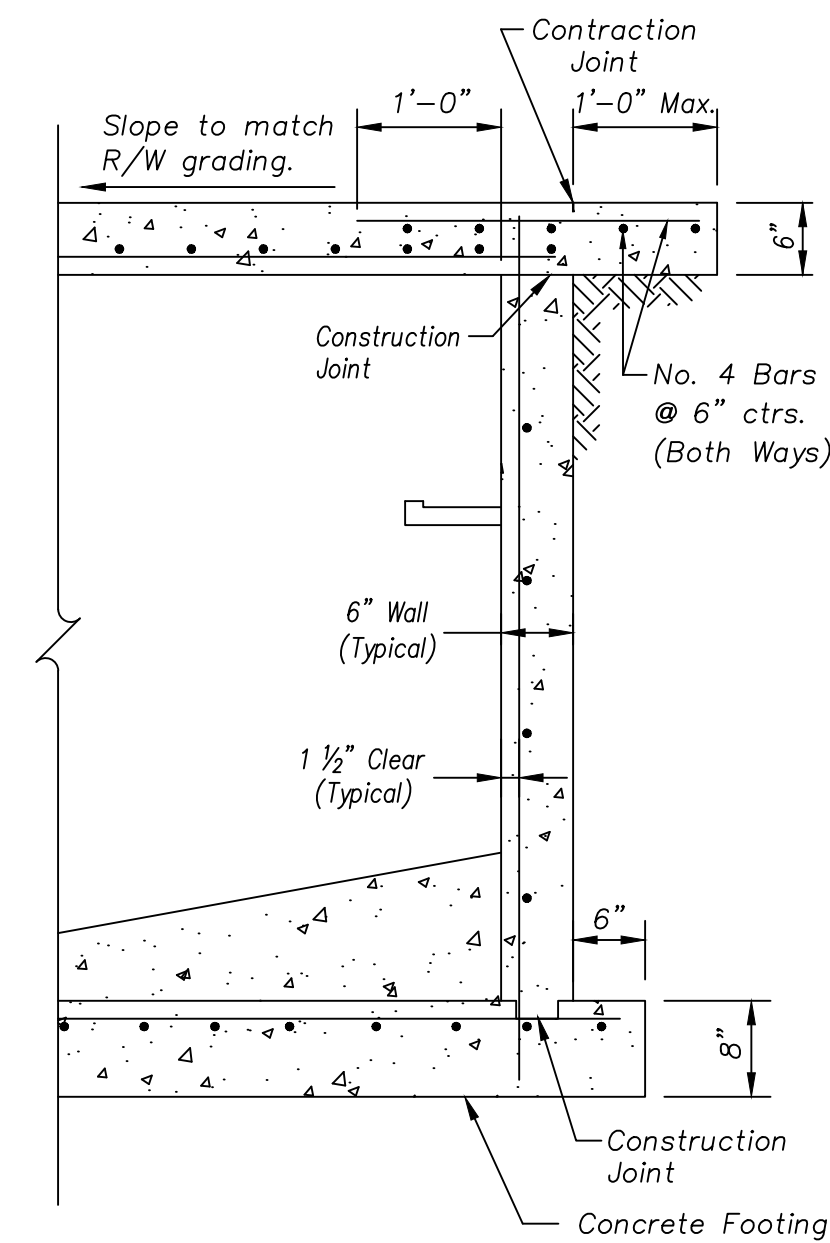

Section C-C
With Cantilever Inlet Top Where Sidewalk
Width < 1' Along Back of Inlet




NOTE: Sidewalk Haunch is Subsidiary to the Curb Inlet Construction.

DWG: F:\2021\04001-04500\021-04157\40-Design\AutoCAD\Final Plans\Sheets\ROBR\T_DTL02_02104157.dwg
DATE: Oct 30, 2023 3:52pm XREFS: T_PTBK_02104157 USER: asaavedra

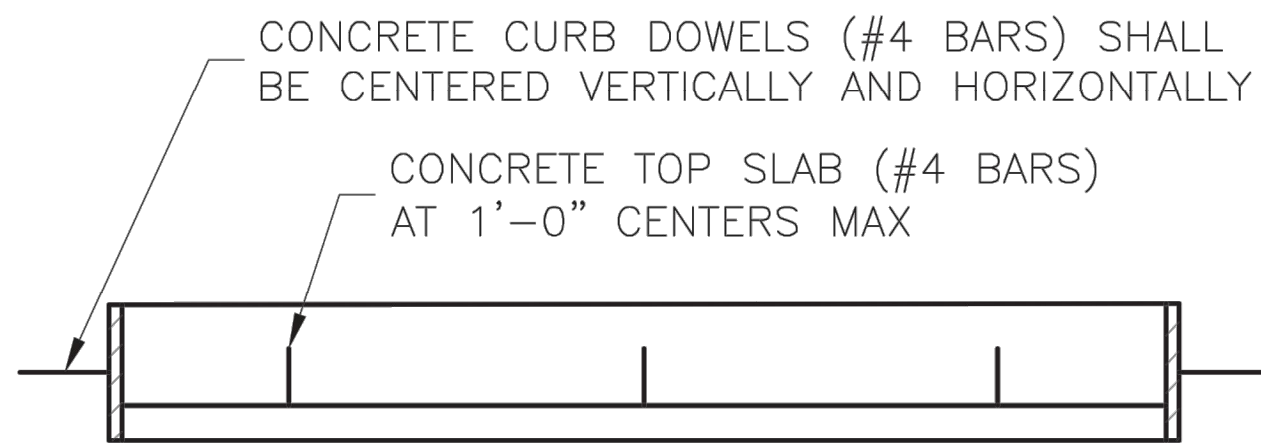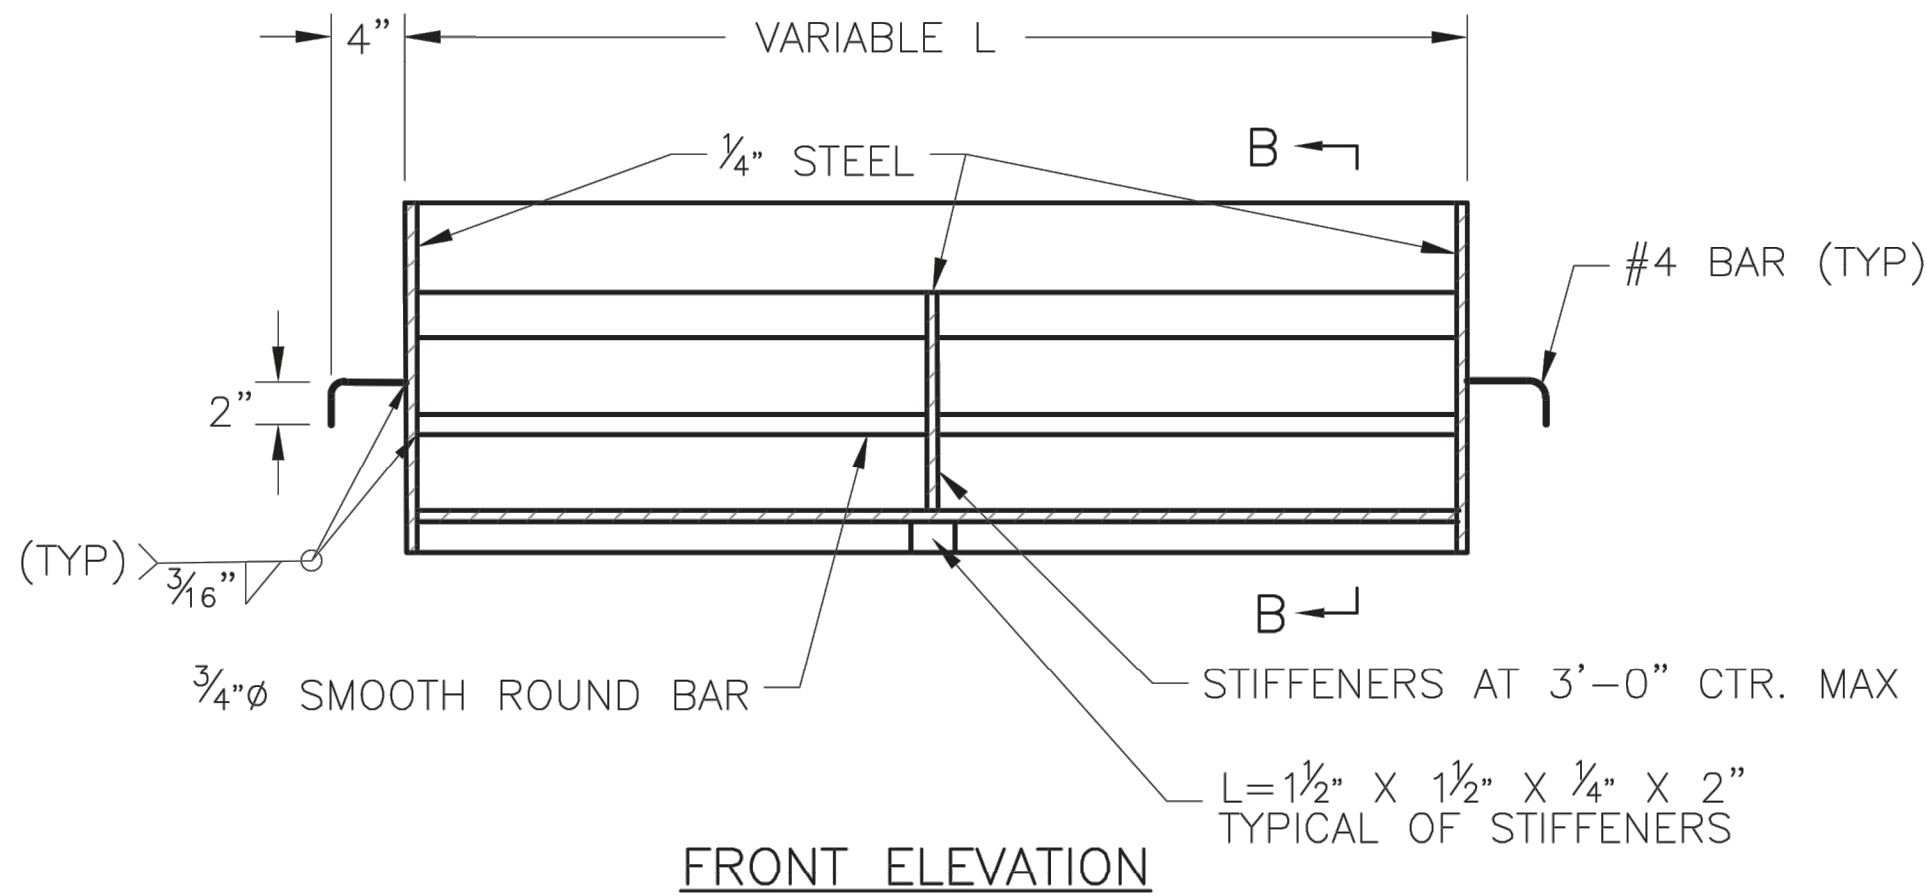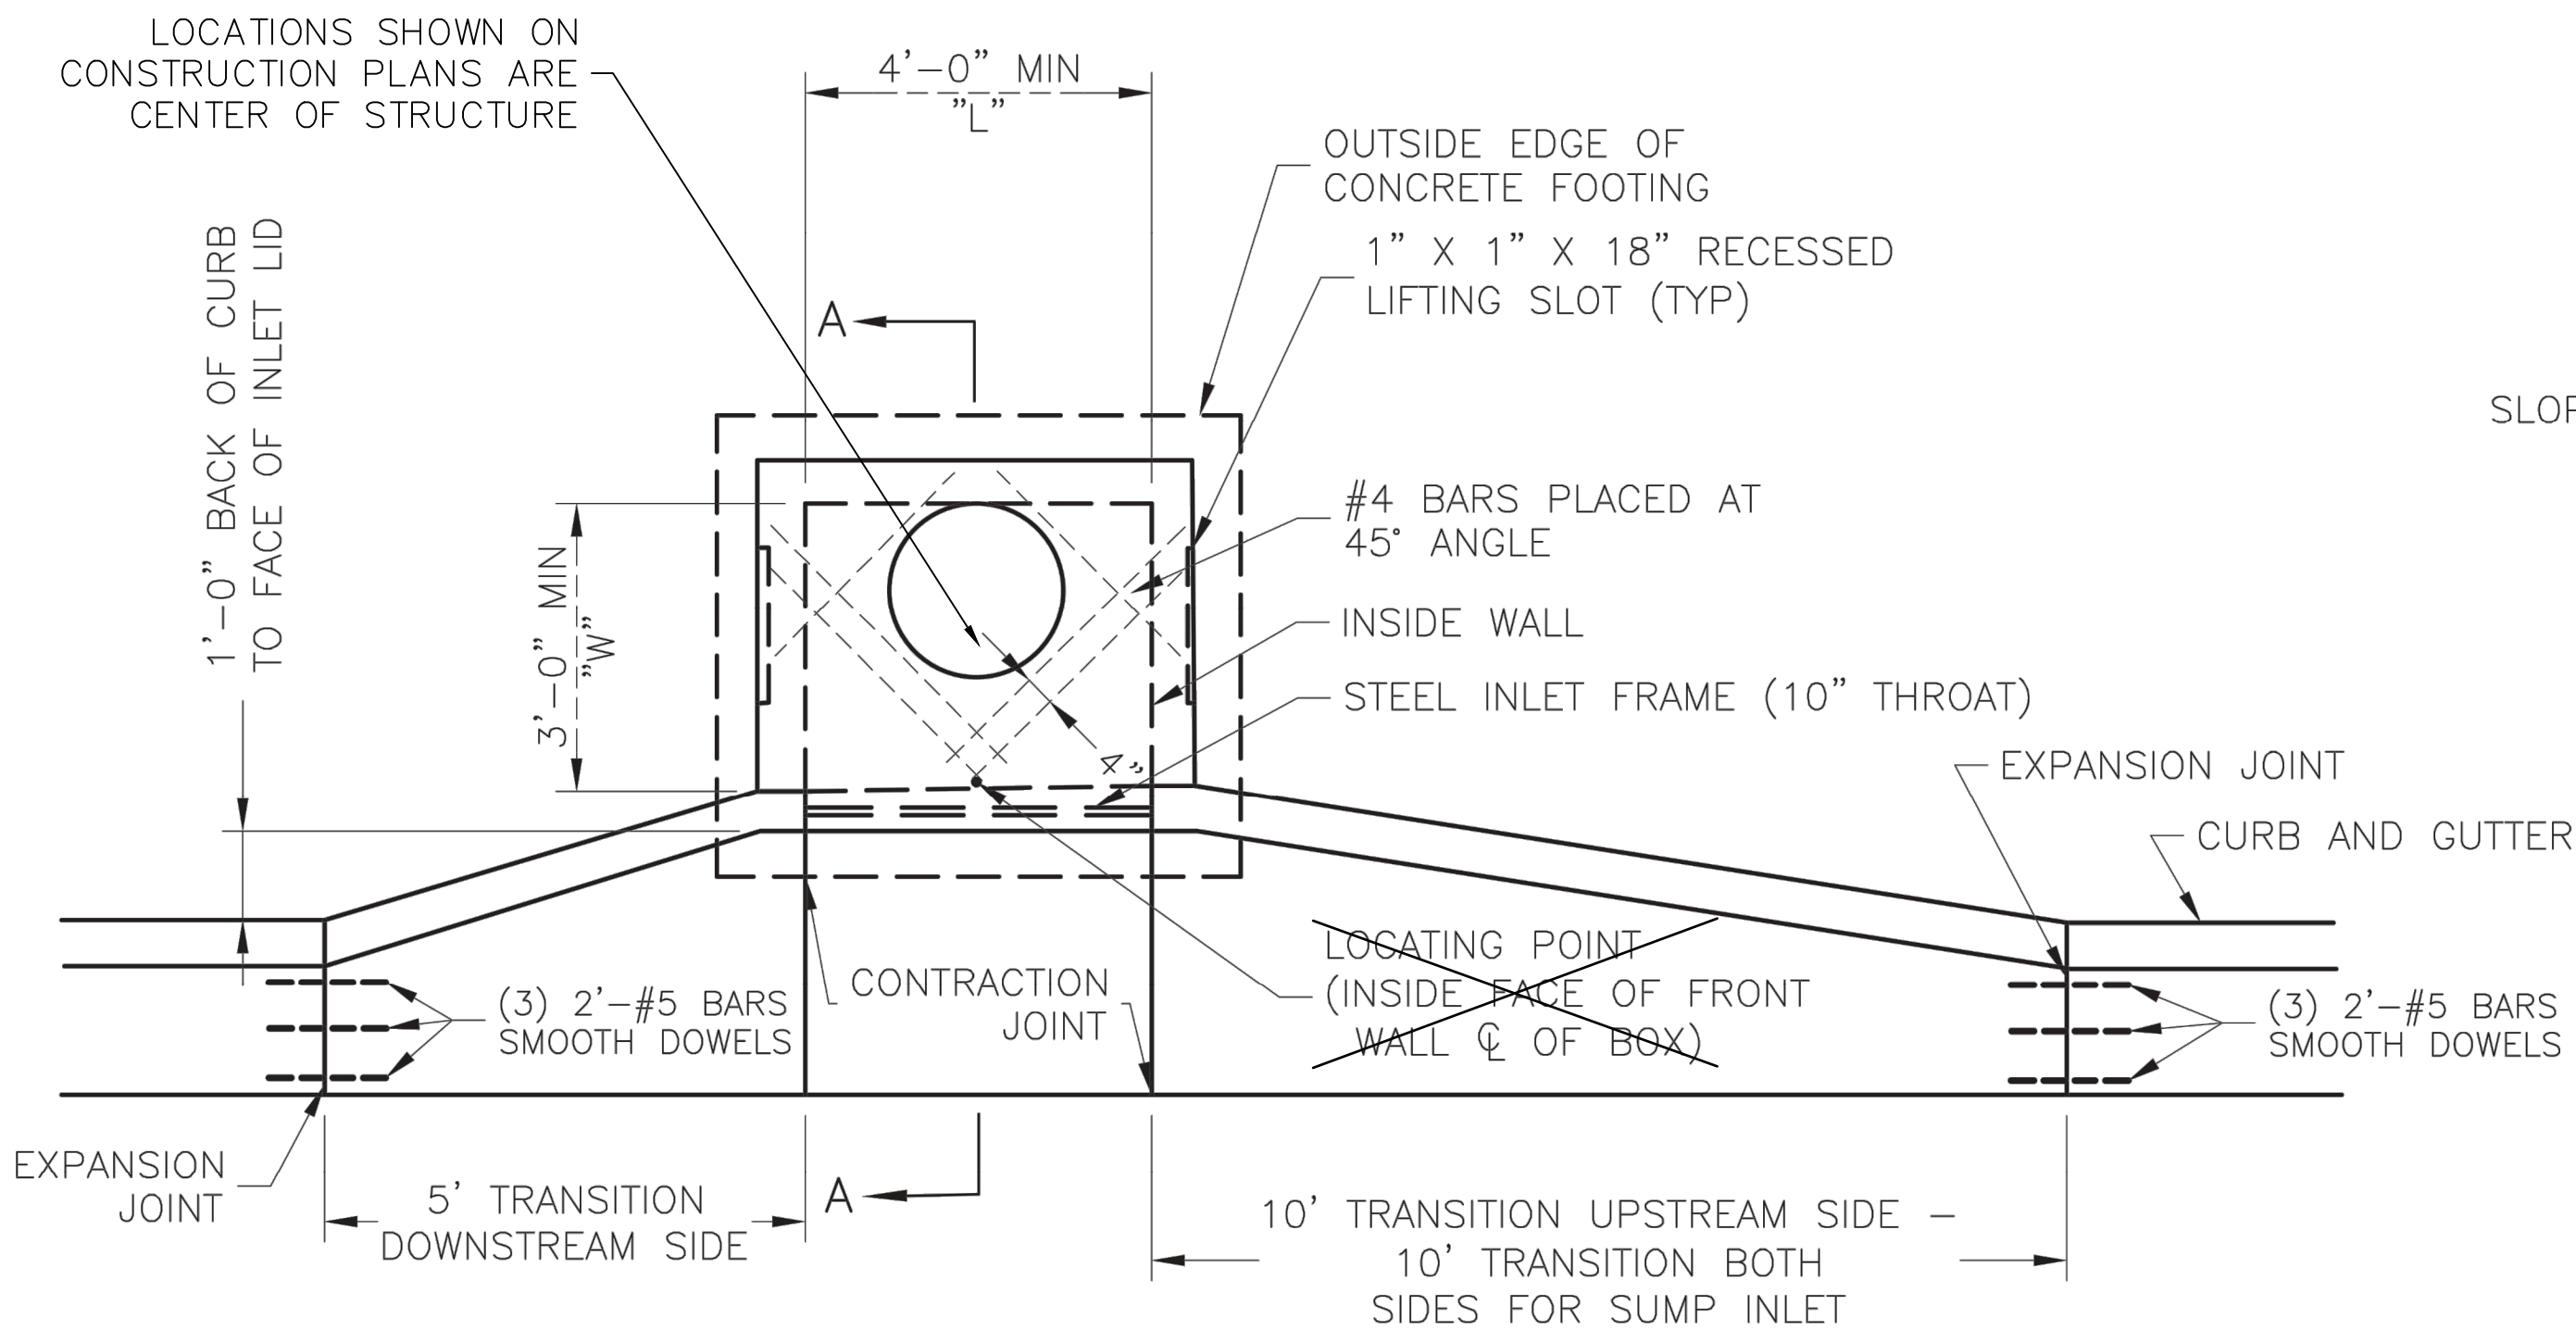

STEEL FRAME NOTES:

- ALL WELDS SHALL BE PERFORMED IN ACCORDANCE WITH APPROPRIATE AWS SPECIFICATIONS AND PROCEDURES.
- ALL WELDS ON EXPOSED SURFACES SHALL BE DRESSED SO AS TO PROVIDE A PLEASING FINISHED APPEARANCE.
- THE ENTIRE FRAME SHALL BE PAINTED A SINGLE COAT OF CHEM-PRIME #37H-78 PRIMER (GRAY) OR EQUAL.

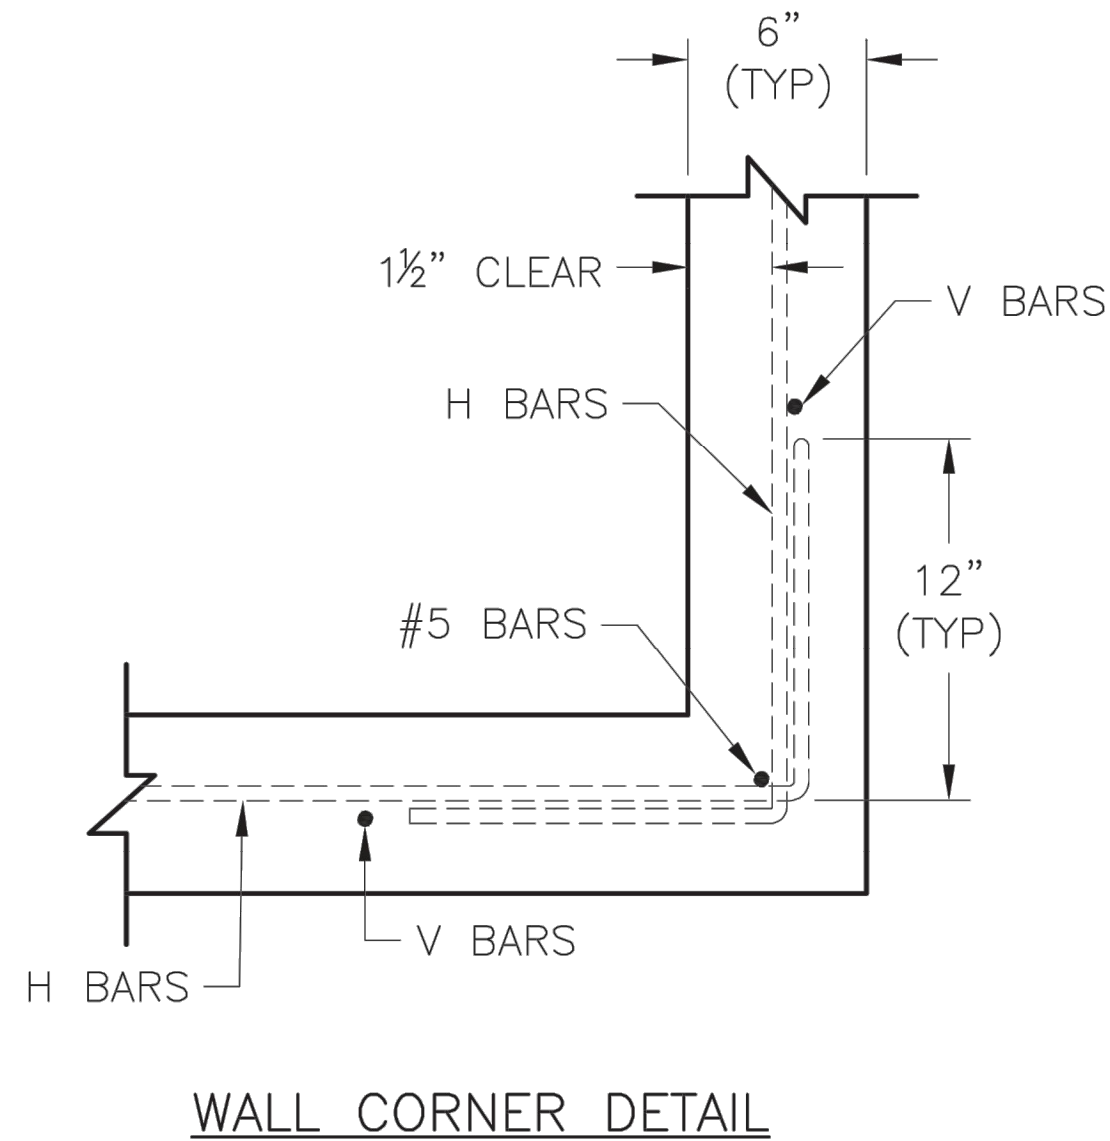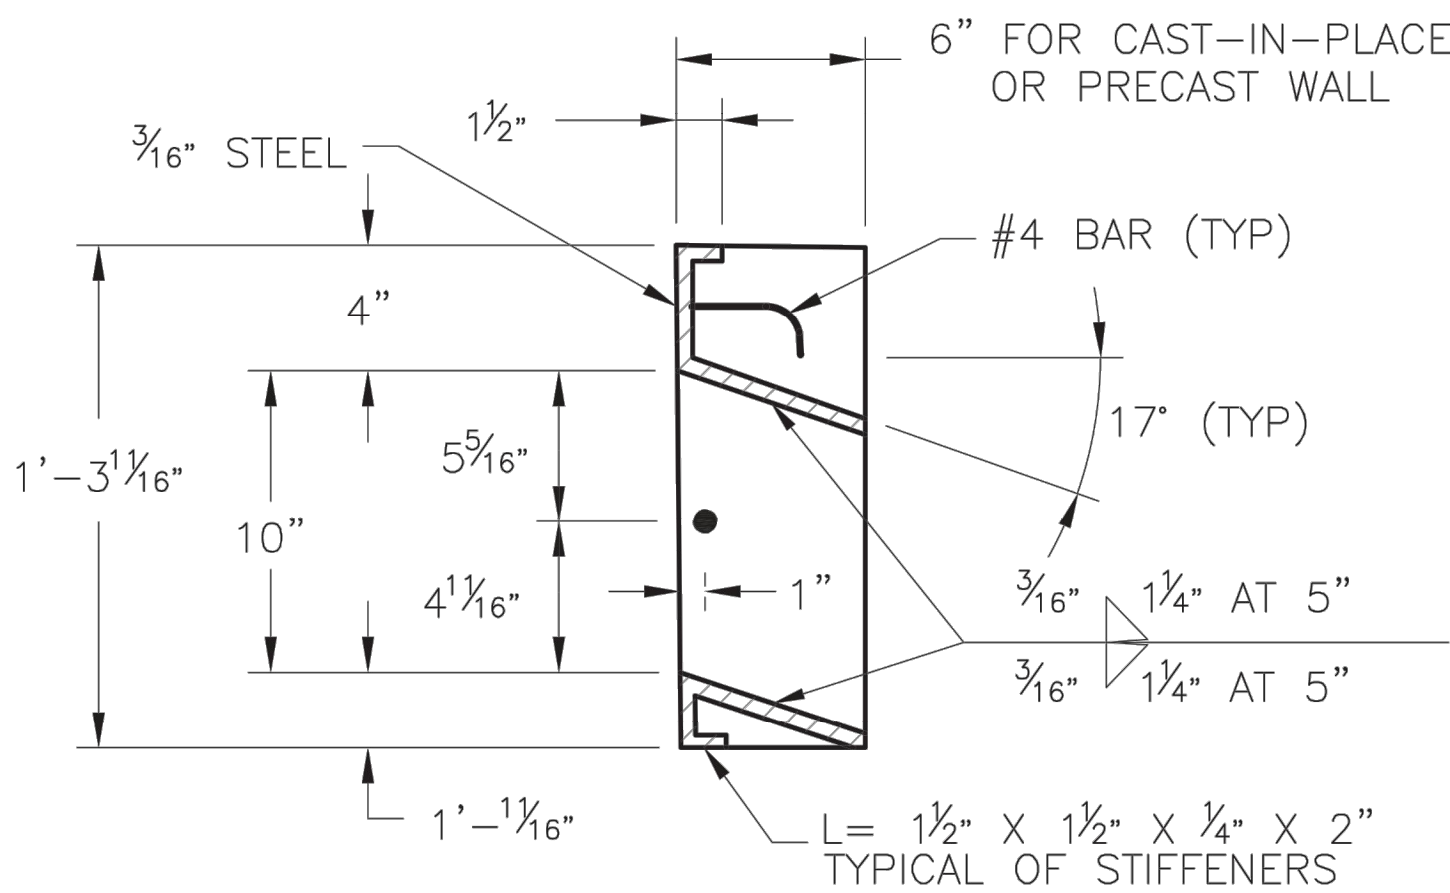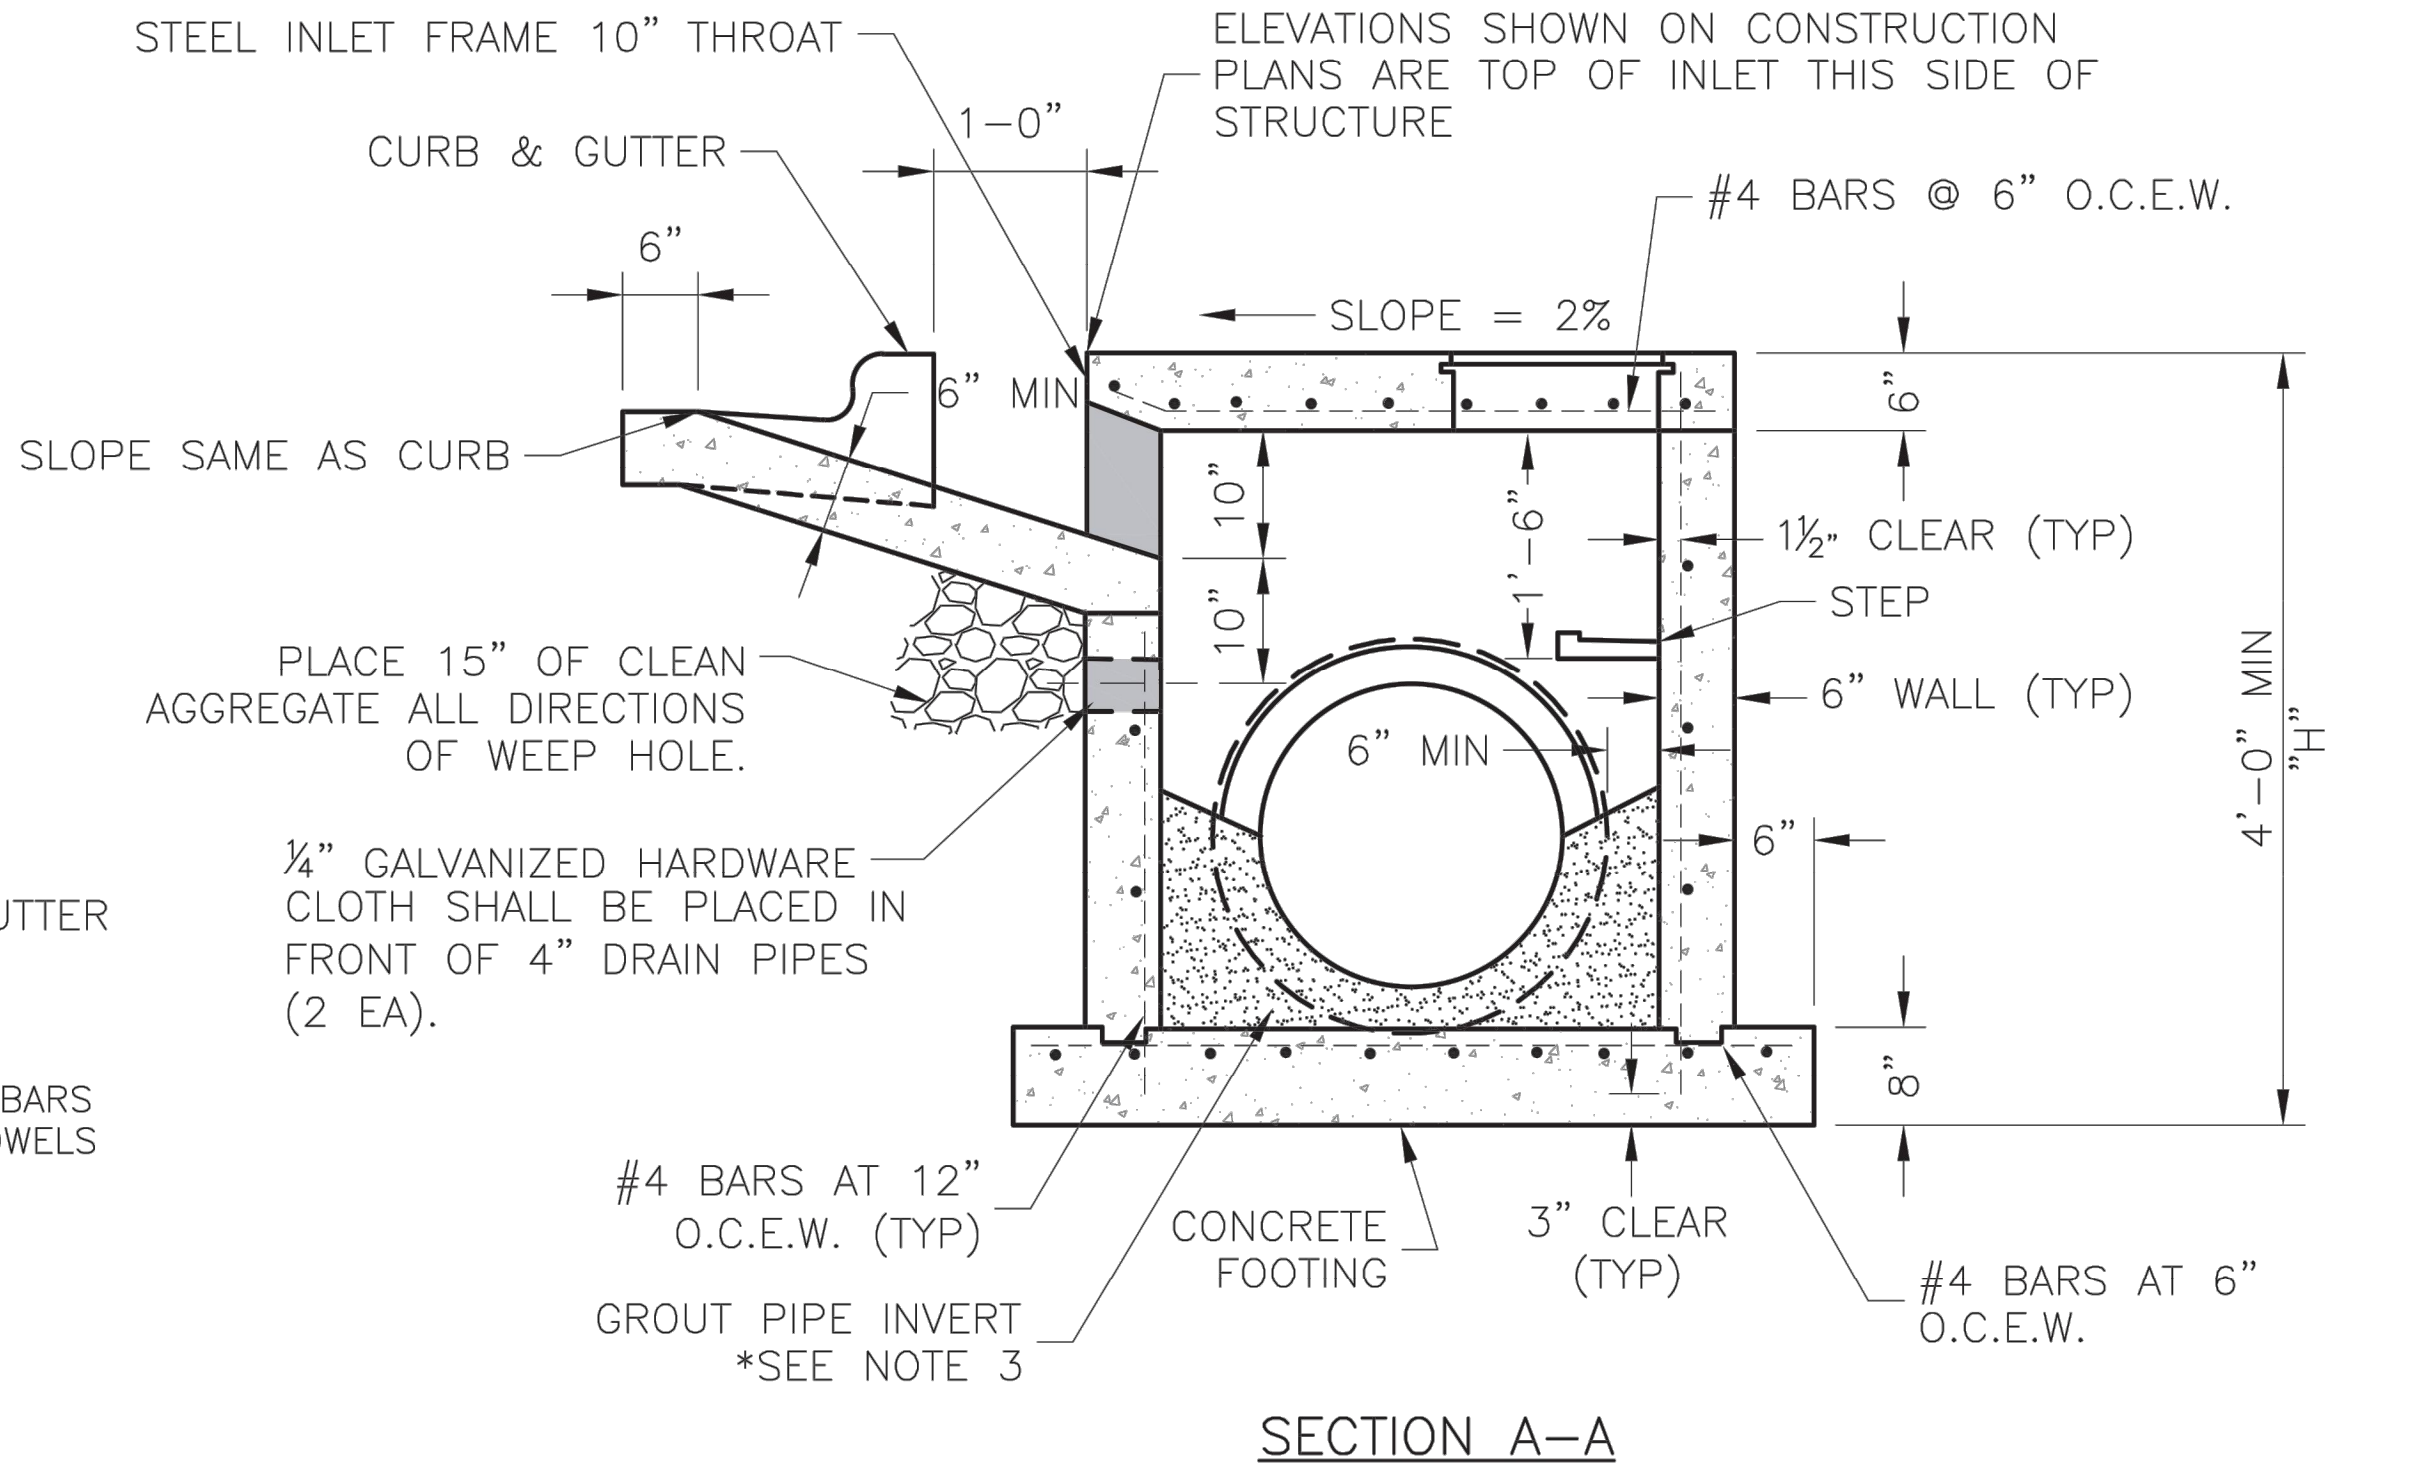

GENERAL NOTES:

- THE FIRST DIMENSION LISTED IN THE CONSTRUCTION NOTES IS THE "L" DIMENSION. THE SECOND DIMENSION IS THE "W" DIMENSION.
- FLOW LINES LISTED ON THE PROJECT PLANS ARE LISTED AT THE INSIDE FACE OF THE WALL.
- FLOOR OF INLET GROUTED AND SHAPED TO MATCH PIPE INVERT TO PROVIDE SMOOTH FLOW.
- LOCATE MH RING AND COVER ON BLANK WALL IF POSSIBLE.
- STEPS SHALL BE SPACED AT 1'-4" O.C. VERTICALLY ON BLANK WALL IF POSSIBLE.
- BEVEL ALL EXPOSED EDGES WITH 3/4" CHAMFER OR 1/2" TOOLED EDGE.
- ON-GRADE INLETS SHALL CONFORM TO THE STREET GRADE AND SUMP INLETS SHALL BE LEVEL.
- PRECAST LIDS SHALL BE PINNED, SEALED WITH NON-SHRINKABLE GROUT AND REMOVABLE FOR FUTURE MAINTENANCE.
- LIFTING RINGS SHALL BE REMOVED AND SEALED WITH NON-SHRINKABLE GROUT
- FOR RING AND COVER SEE THE STORMWATER APPROVED PRODUCT LIST.

LEE'S SUMMIT
MISSOURI

STANDARD DETAILS
CITY OF LEE'S SUMMIT, MO
LEE'S SUMMIT, JACKSON COUNTY, MO

CURB INLET DETAIL

PUBLIC WORKS ENGINEERING DIVISION | 220 SE GREEN STREET | LEE'S SUMMIT, MO 64063

Drawn By: MJF
Checked By: DL
Date: 05/2021
Proj. #:

STM-1

RECORD
DRAWINGS

RYAN B. FLEMING
MO. NO. PE-2002003161

REV	NO.	DATE	REVISIONS DESCRIPTION

REVISIONS




STORM SEWER DETAILS	2021
SCANNELL DEVELOPMENT LEE'S SUMMIT LOGISTICS NORTHWEST CORNER OF TUDOR ROAD AND MAIN STREET	
LEE'S SUMMIT, MISSOURI	

C.O.A. NO.:
DRAWN BY: ARJ/AMW
CHECKED BY: XXX
APPROVED BY: RBE
QA/QC BY: RBE
PROJECT NO.: 021-04157
DWG NO.: T_DTL02_02104157
DATE: 2021-10-12

SHEET
40 OF 105

olsson

Olsson Engineering - MO State Certificate of Authority #001592
7301 West 133rd Street, Suite 200 TEL 913.381.1170
Overland Park, KS 66213-4750 FAX 913.381.1174 www.olson.com

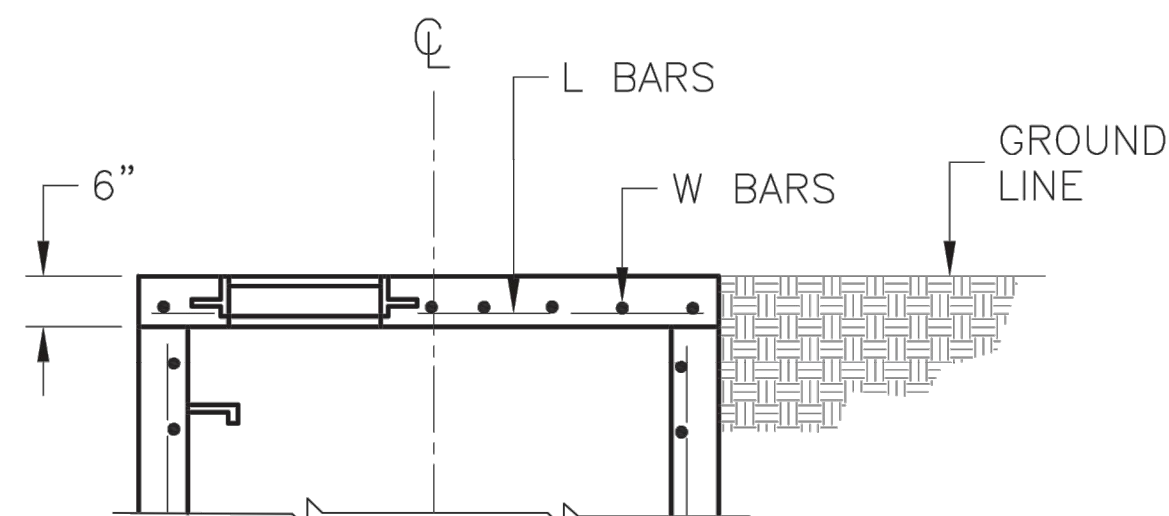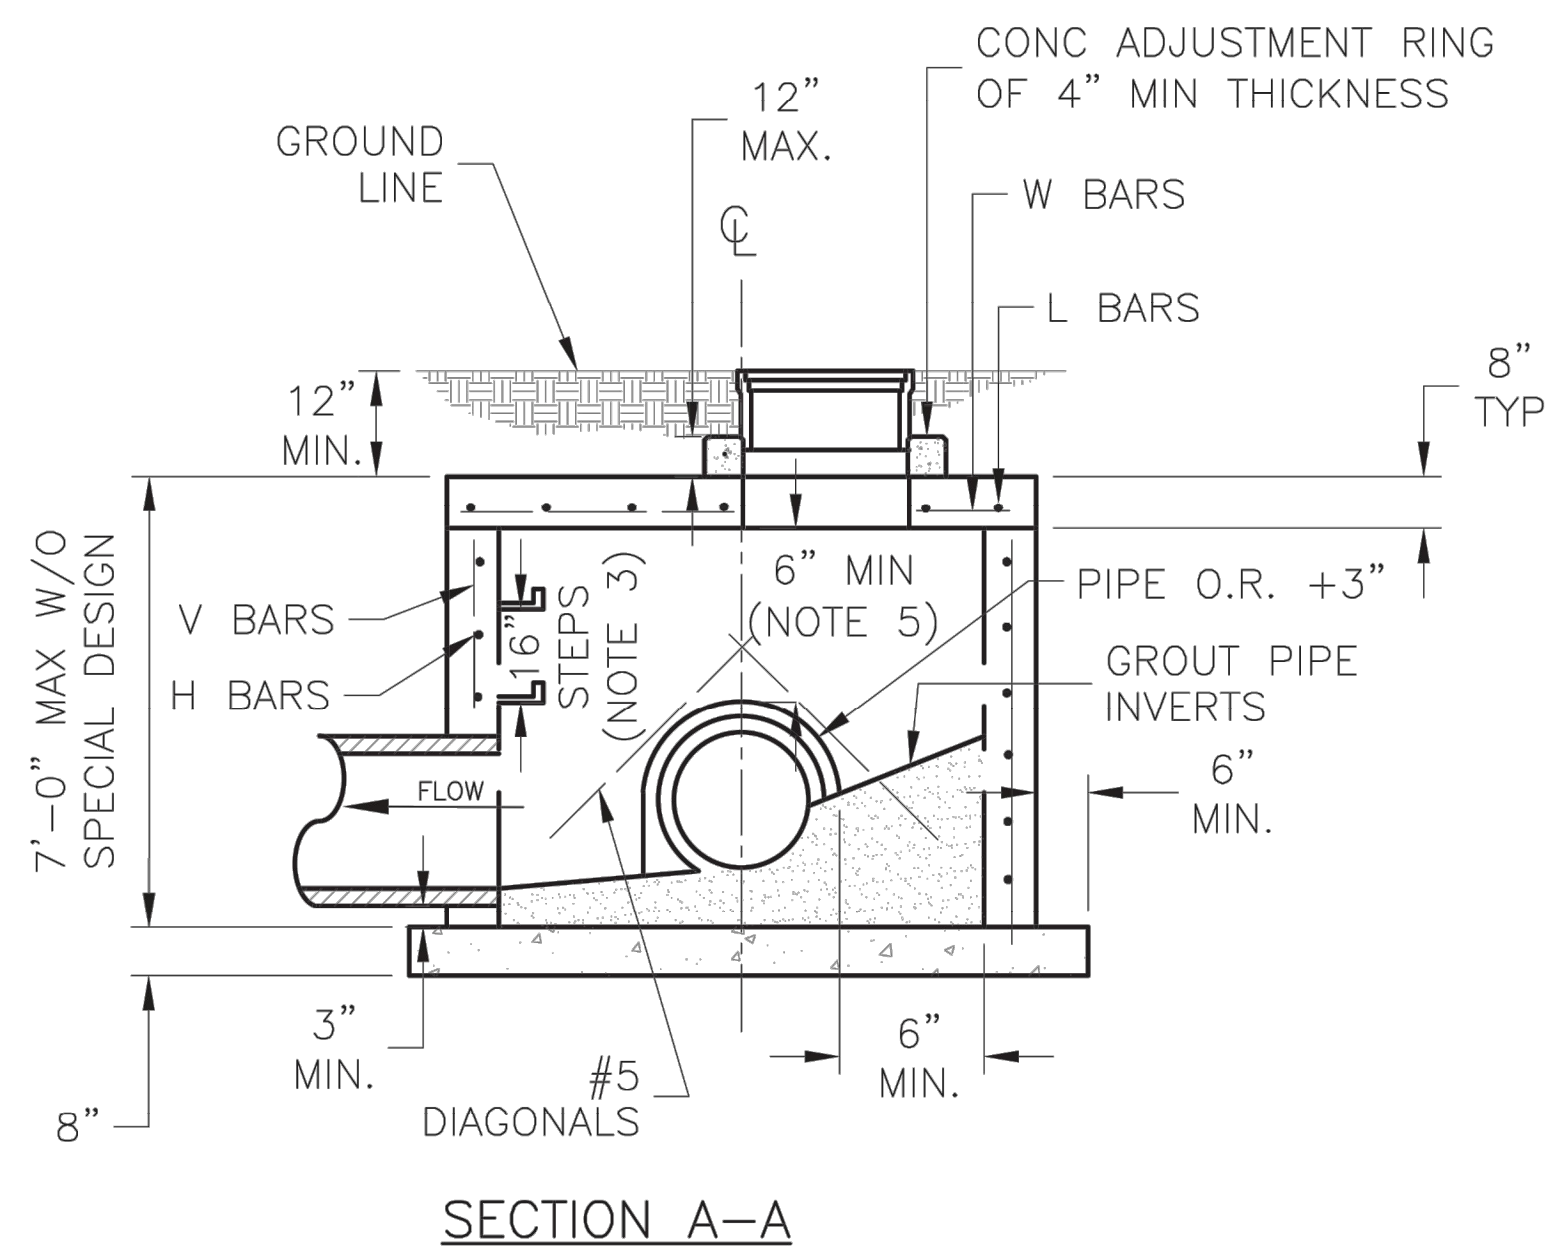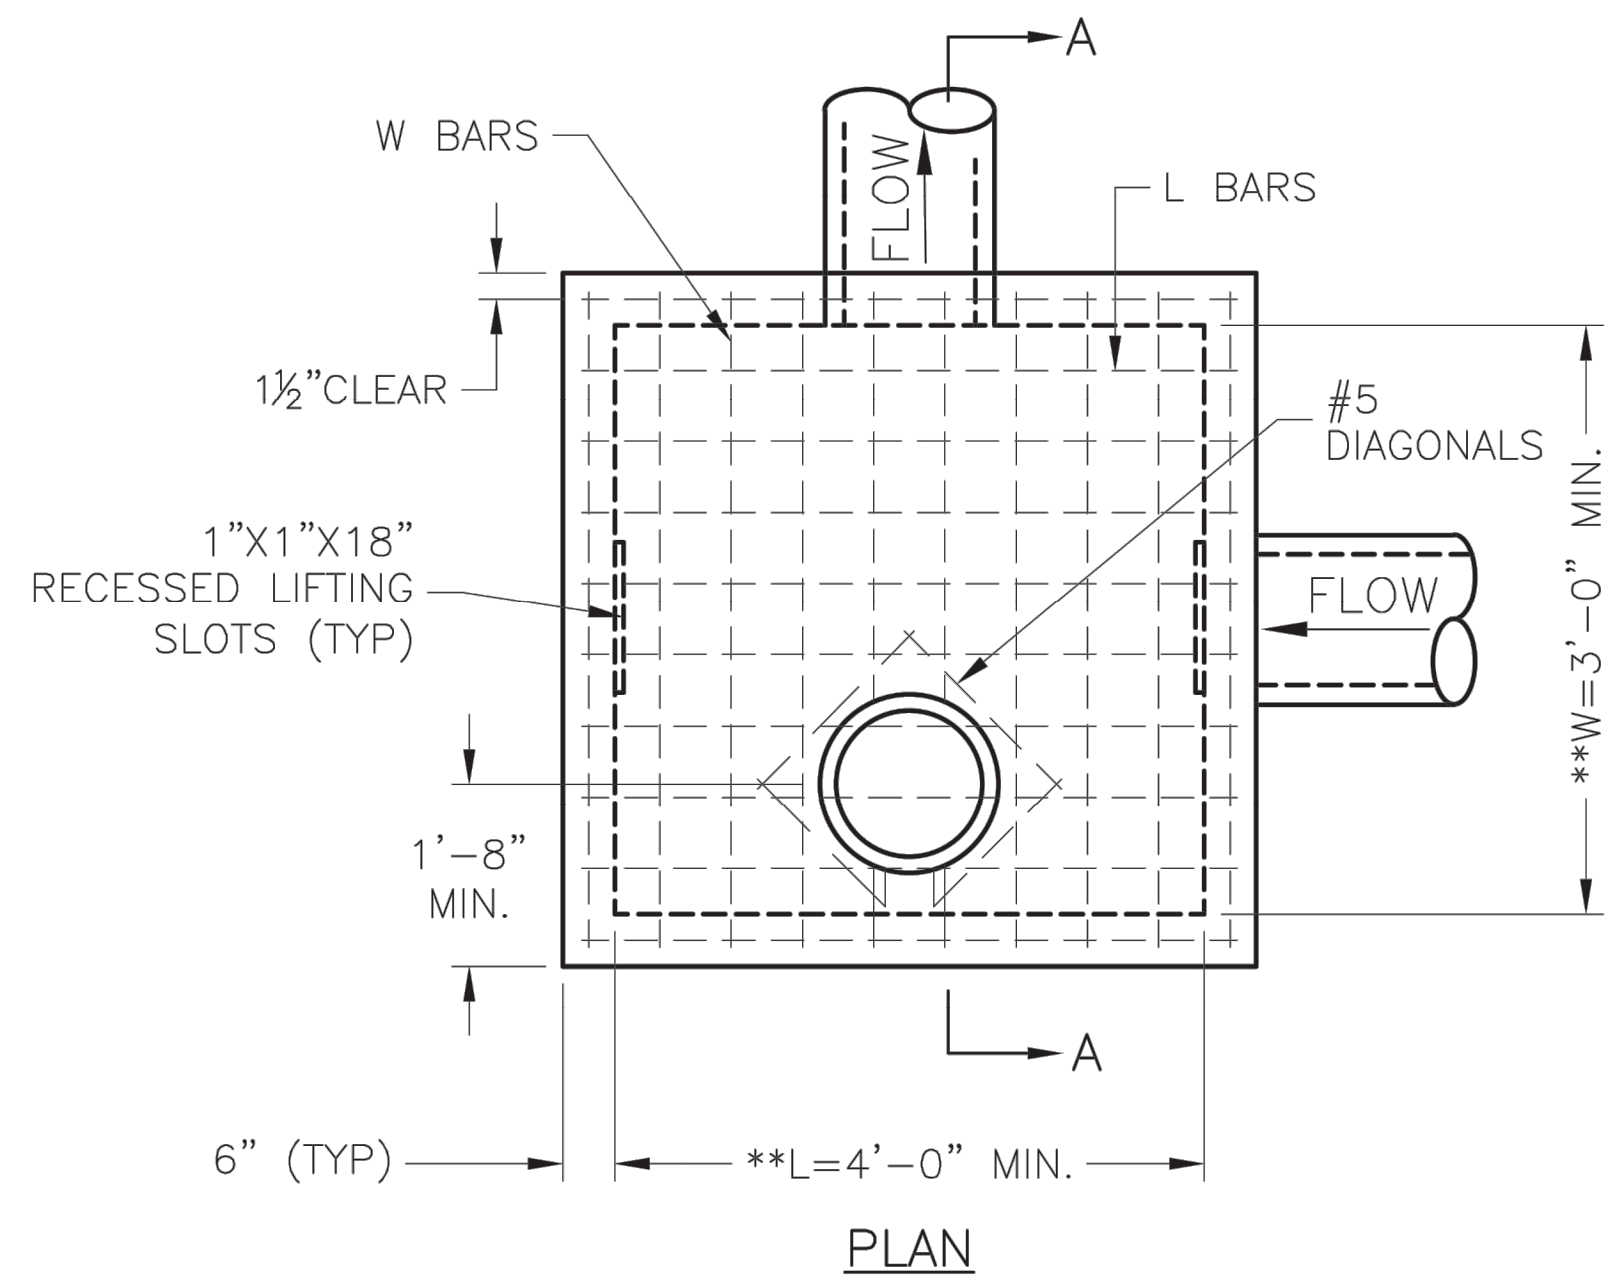


SLAB TOP ALTERNATE FOR
JUNCTION BOX (SHALLOW)

REINFORCING

BARS	BAR SIZE	SPACING (IN.)
H	4	12
V	4	12
L	5	6
W	5	6

** INCREASE IN MULTIPLES OF 6"
(7'-0") MAX WITHOUT SPECIAL DESIGN.
(SEE PROJECT PLANS FOR DETAILS)

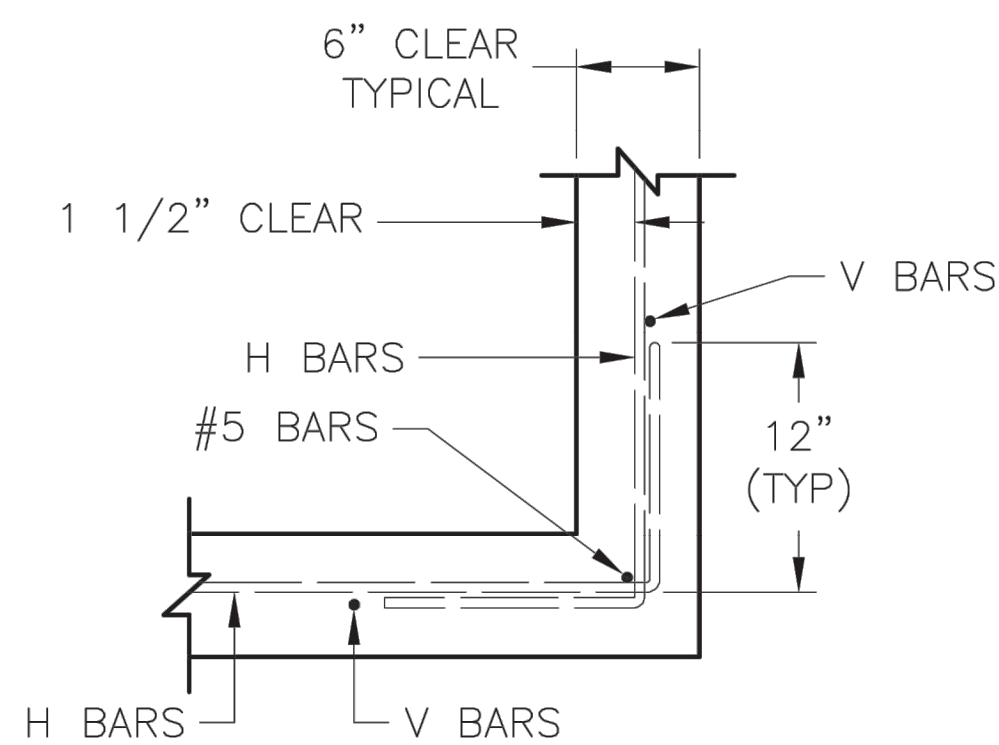

WALL CORNER DETAIL

GENERAL NOTES:

1. LOCATE RING AND COVER ON BLANK WALL.
2. USE $\frac{3}{4}$ " CHAMFER STRIP OR $\frac{1}{2}$ " R EDGER TOOL ON ALL EXPOSED CONCRETE CORNERS.
3. STEPS REQUIRED AT 16" O.C. WHEN DEPTH FROM TOP OF CASTING TO INVERT EXCEEDS 4' ON BLANK WALL IF POSSIBLE.
4. BOXOUTS WILL NOT BE ALLOWED TO PROJECT THROUGH THE CORNERS OF THE STRUCTURE AND THE MINIMUM DISTANCE BETWEEN BOXOUTS IS 6".
5. THE MINIMUM REINFORCING SHALL BE 1 H-BAR OVER A CAST-IN-PLACE PIPE AND 2 H-BARS OVER A PRECAST BOXOUT.
6. PRECAST LIDS SHALL BE PINNED, SEALED WITH NON-SHRINKABLE GROUT AND REMOVABLE FOR FUTURE MAINTENANCE.
7. REINFORCING OF COVERS IN STREETS REQUIRE SPECIAL DESIGN.
8. FOR RING AND COVER SEE THE STORMWATER APPROVED PRODUCT LIST.

Drawn By: MJF
Checked By: DL
Date: 05/2021
Proj. #:

LEE'S SUMMIT
MISSOURI

PUBLIC WORKS ENGINEERING DIVISION | 220 SE GREEN STREET | LEE'S SUMMIT, MO 64063

STANDARD DETAILS
CITY OF LEE'S SUMMIT, MO
LEE'S SUMMIT, JACKSON COUNTY, MO

JUNCTION BOX DETAIL

STORM SEWER DETAILS

SCANNELL DEVELOPMENT LEE'S SUMMIT LOGISTICS
NORTHWEST CORNER OF TUDOR ROAD AND MAIN STREET

LEE'S SUMMIT, MISSOURI

RECORD
DRAWINGS



RYAN B. FLEMING
MO. NO. PE-2002003161

[illegible]

STORM SEWER DETAILS	
SCANNELL DEVELOPMENT LEE'S SUMMIT LOGISTICS NORTHWEST CORNER OF TUDOR ROAD AND MAIN STREET	
LEE'S SUMMIT, MISSOURI	2021


C.O.A. NO.: _____ -
DRAWN BY: _____ ARJ/AMW
CHECKED BY: _____ XXX
APPROVED BY: _____ RBF
QA/QC BY: _____ RBF
PROJECT NO.: _____ 021-04157
DWG NO.: T_DTL02_02104157
DATE: _____ 2021-10-12

SHEET
41 OF 105

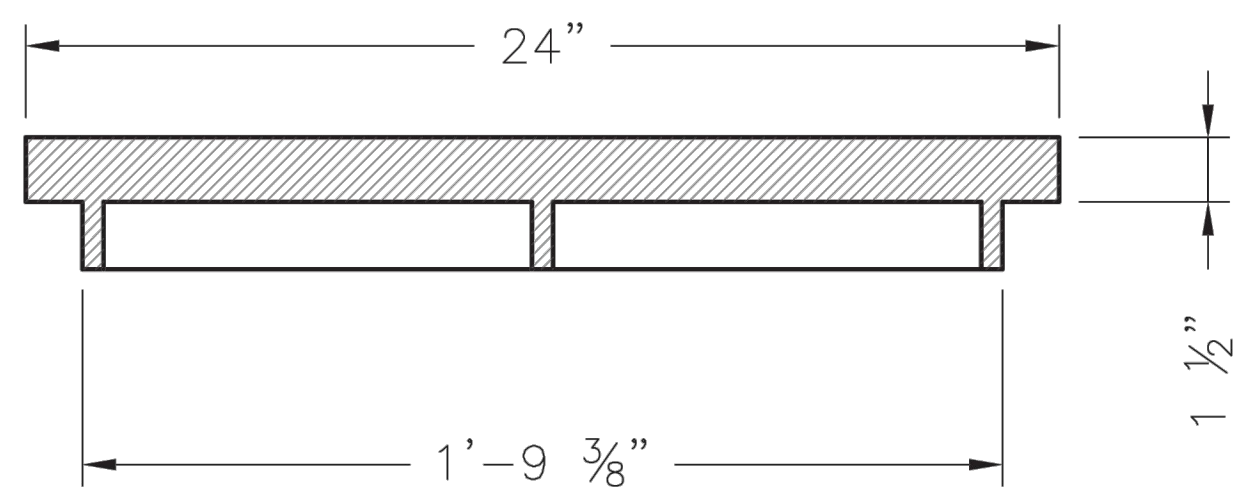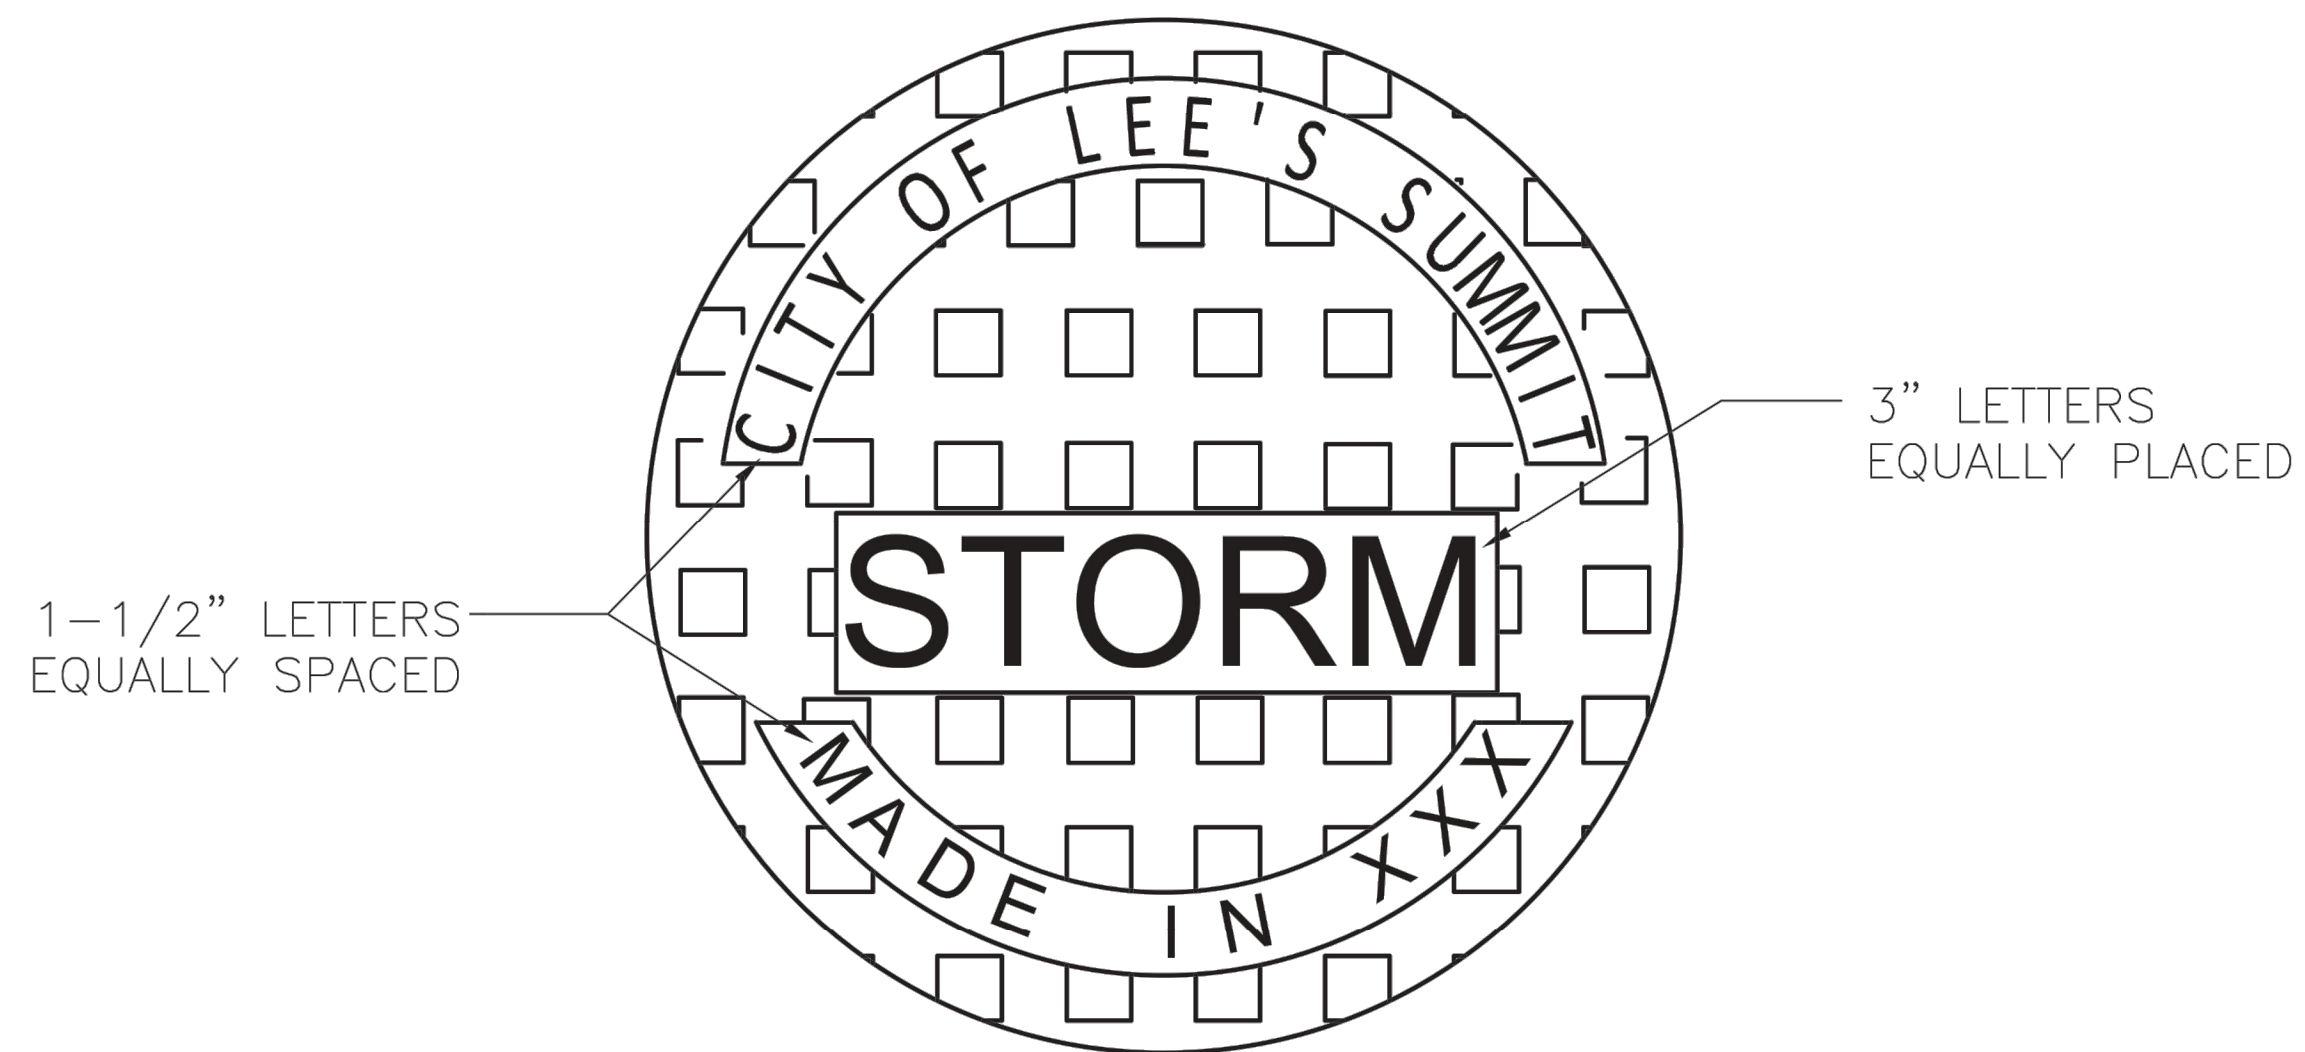

STANDARD 24" MANHOLE COVER
MINIMUM WEIGHT = 160 LB
NOTE: PICK HOLES NOT SHOWN

*COVER AND FRAME MODEL INFORMATION REFER TO THE STORMWATER APPROVED PRODUCT LIST.

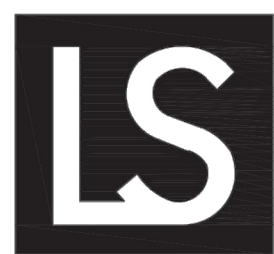

LEE'S SUMMIT

MISSOURI

PUBLIC WORKS ENGINEERING DIVISION | 220 SE GREEN STREET | LEE'S SUMMIT, MO 64063


STORM MANHOLE COVER DETAIL

Date: 05/2021


Drawn By: MJF

Checked By: DL

STM-6

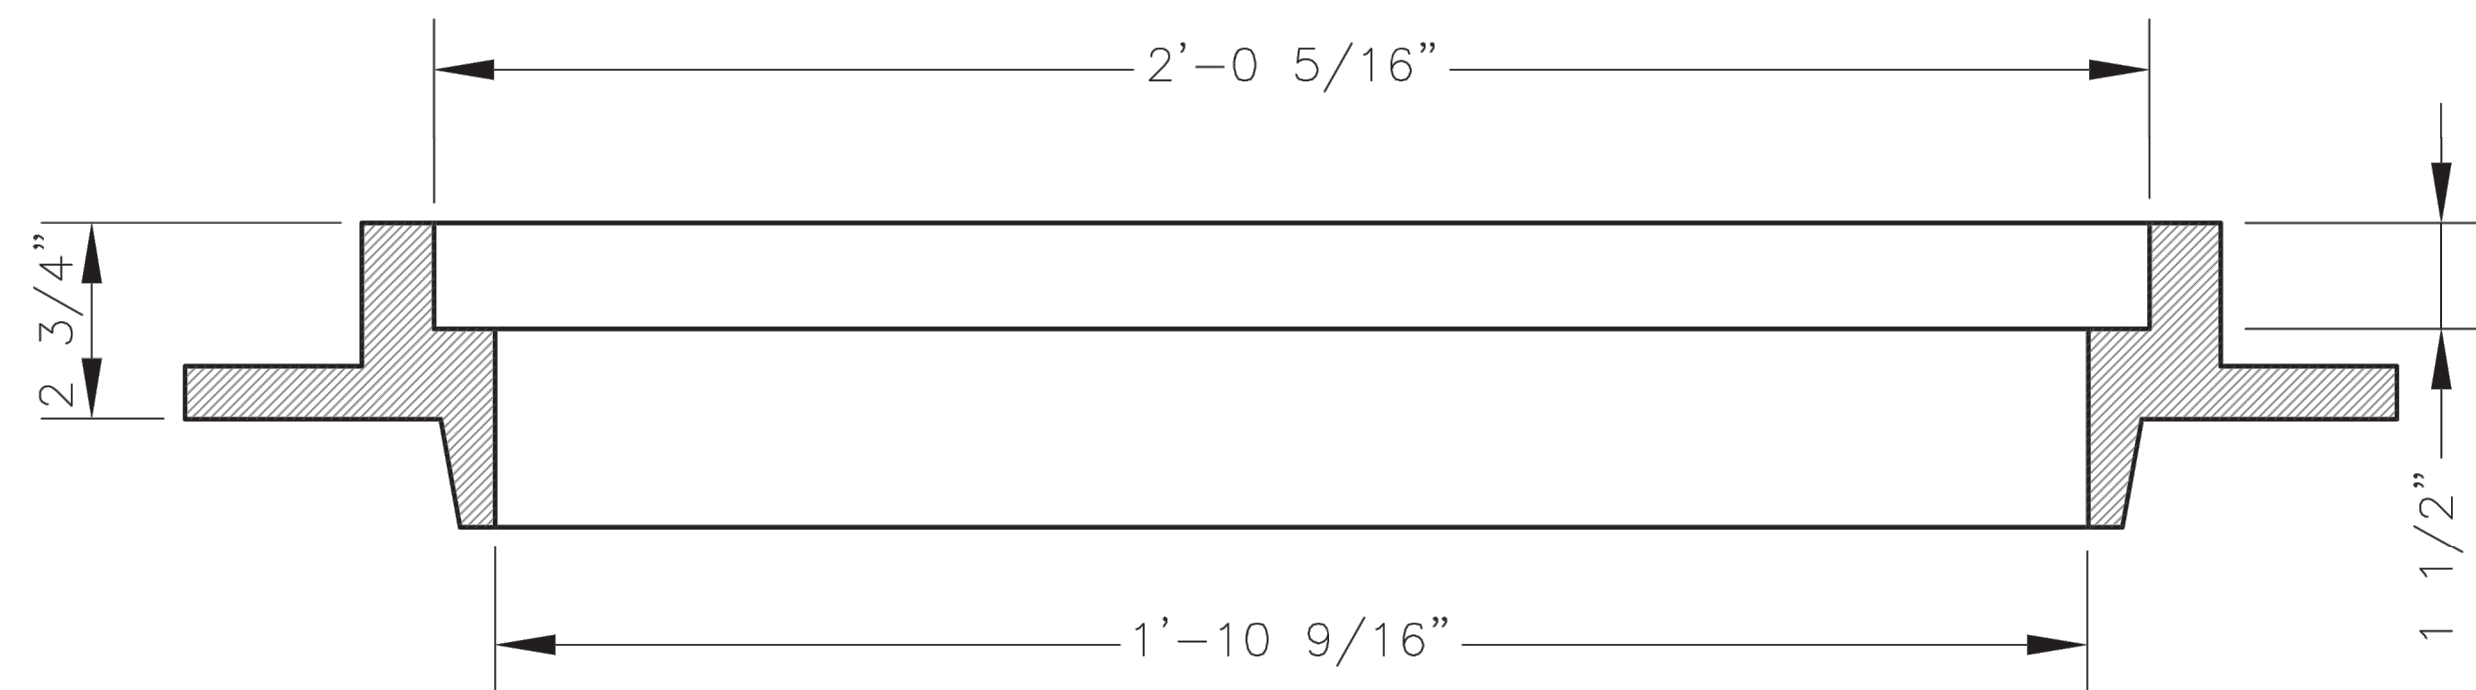

SLAB MANHOLE FRAME
LEE'S SUMMIT PART NO.: LS103A
MINIMUM WEIGHT = 145 LB

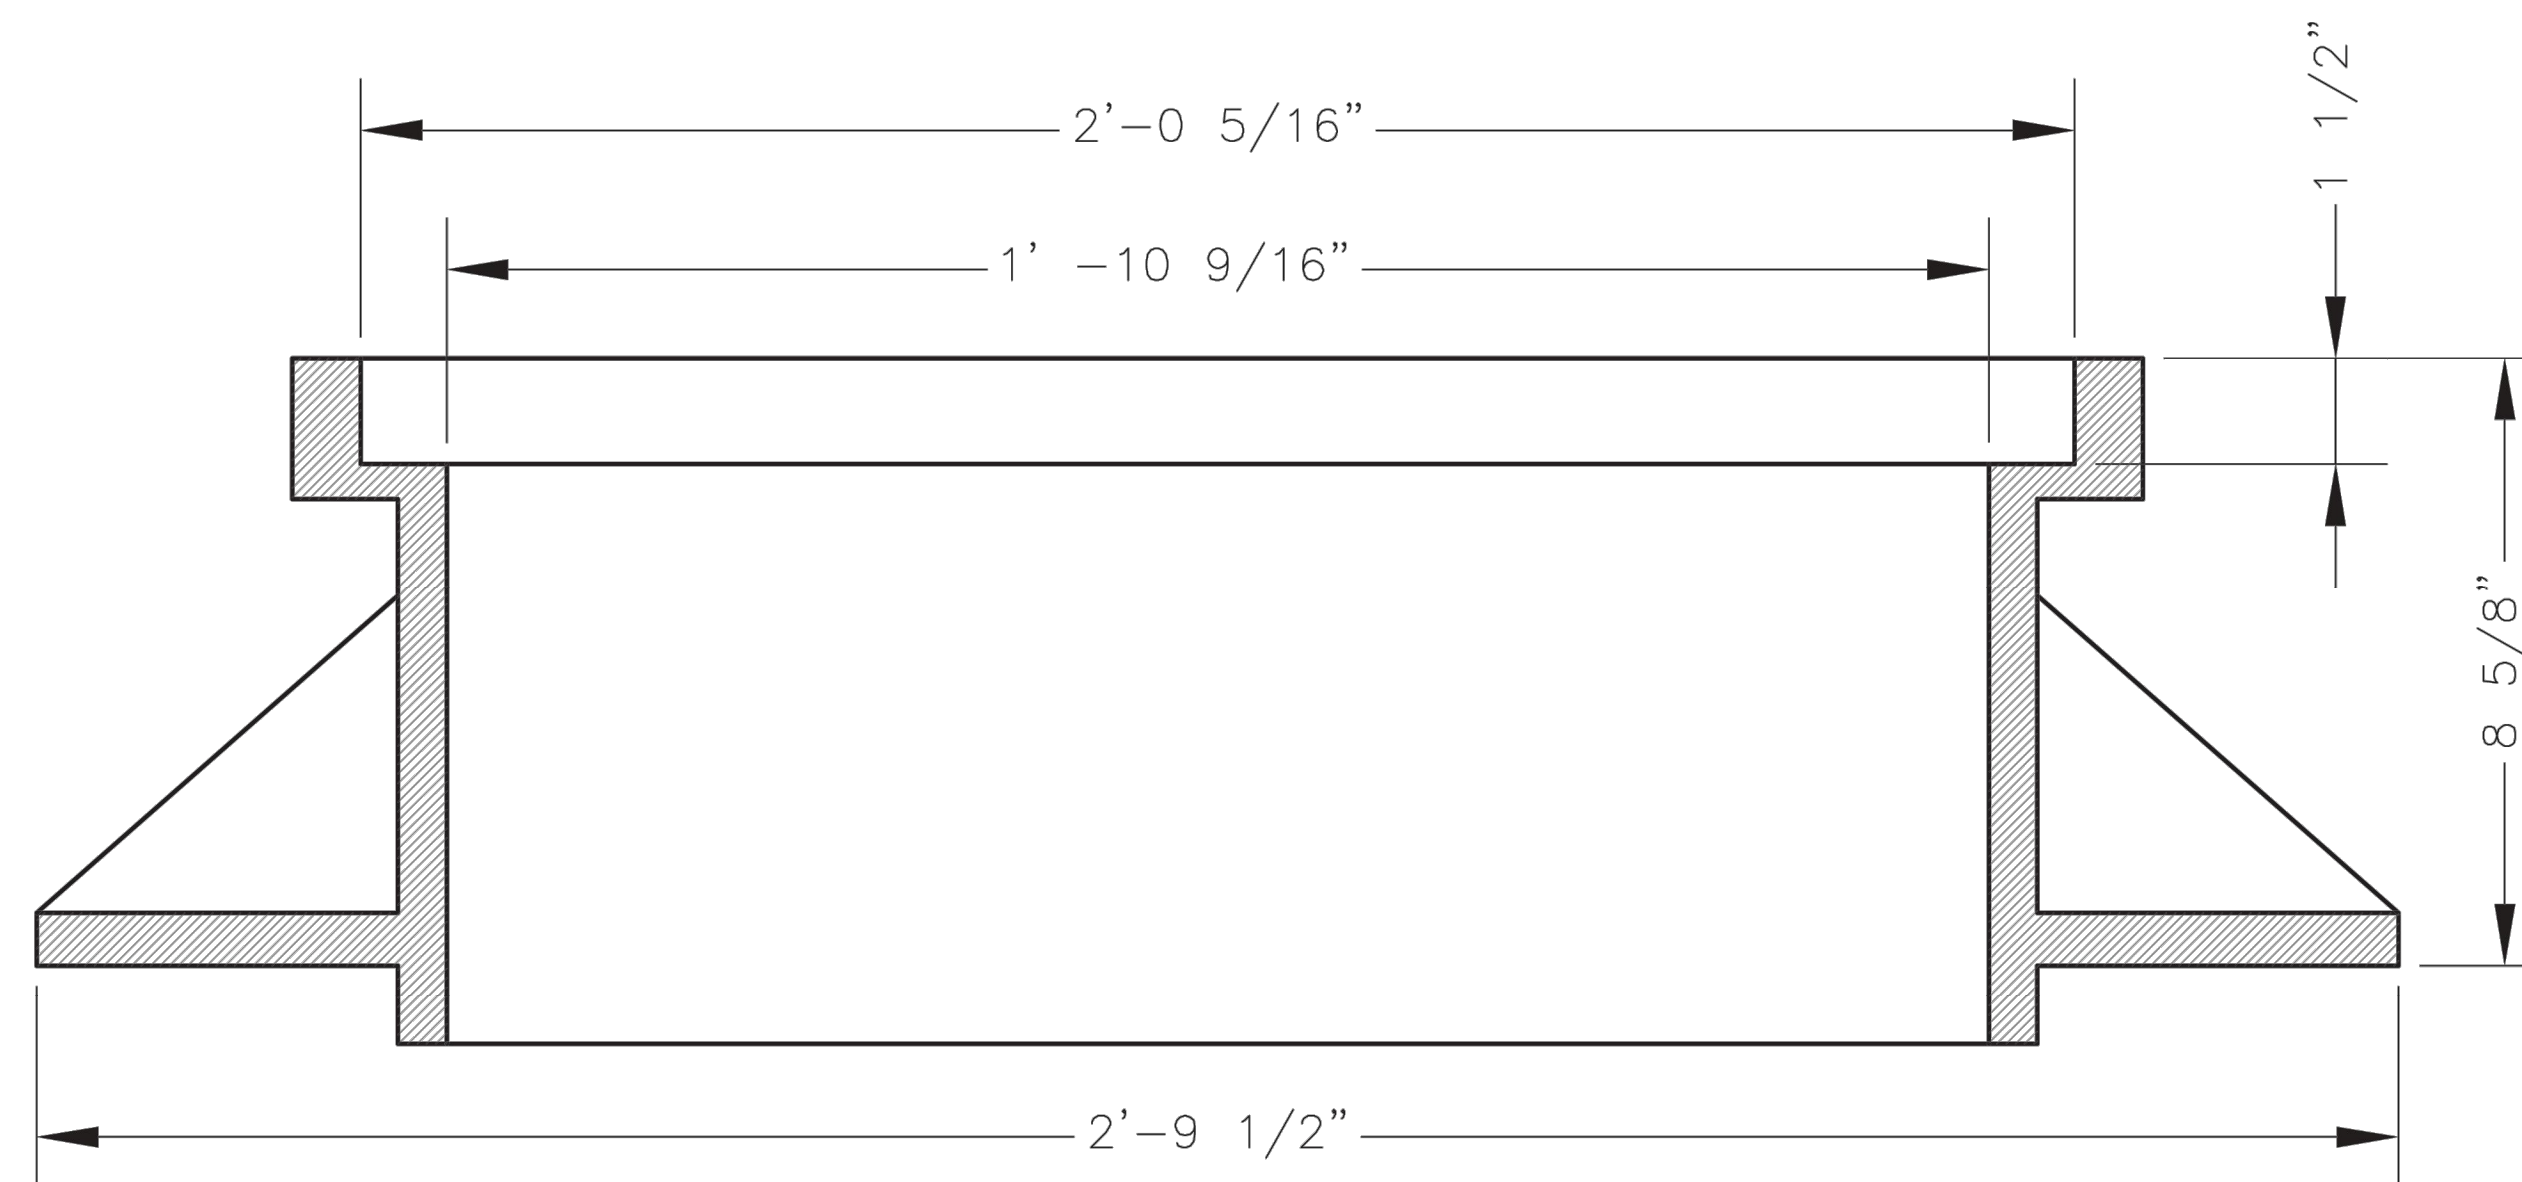

STANDARD 24" MANHOLE FRAME
LEE'S SUMMIT PART NO.: LS101A
MINIMUM WEIGHT = 250 LB

*COVER AND FRAME MODEL INFORMATION REFER TO THE STORMWATER APPROVED PRODUCTS LIST.



LEE'S SUMMIT
MISSOURI

PUBLIC WORKS ENGINEERING DIVISION | 220 SE GREEN STREET | LEE'S SUMMIT, MO 64063

STORM MANHOLE FRAME DETAIL

Date: 05/2021

Drawn By: MJF

Checked By: DL

DWG-7

STORM SEWER DETAILS

SCANNELL DEVELOPMENT LEE'S SUMMIT LOGISTICS
NORTHWEST CORNER OF TUDOR ROAD AND MAIN STREET

LEE'S SUMMIT, MISSOURI


2021

RYAN B. FLEMING
MO. NO. PE-2002003161

RECORD
DRAWINGS

olson

Olsson Engineering - MO State Certificate of Authority #001592
7301 West 133rd Street, Suite 200 TEL 913.381.1170
Overland Park, KS 66213-4750 FAX 913.381.1174 www.olsson.com

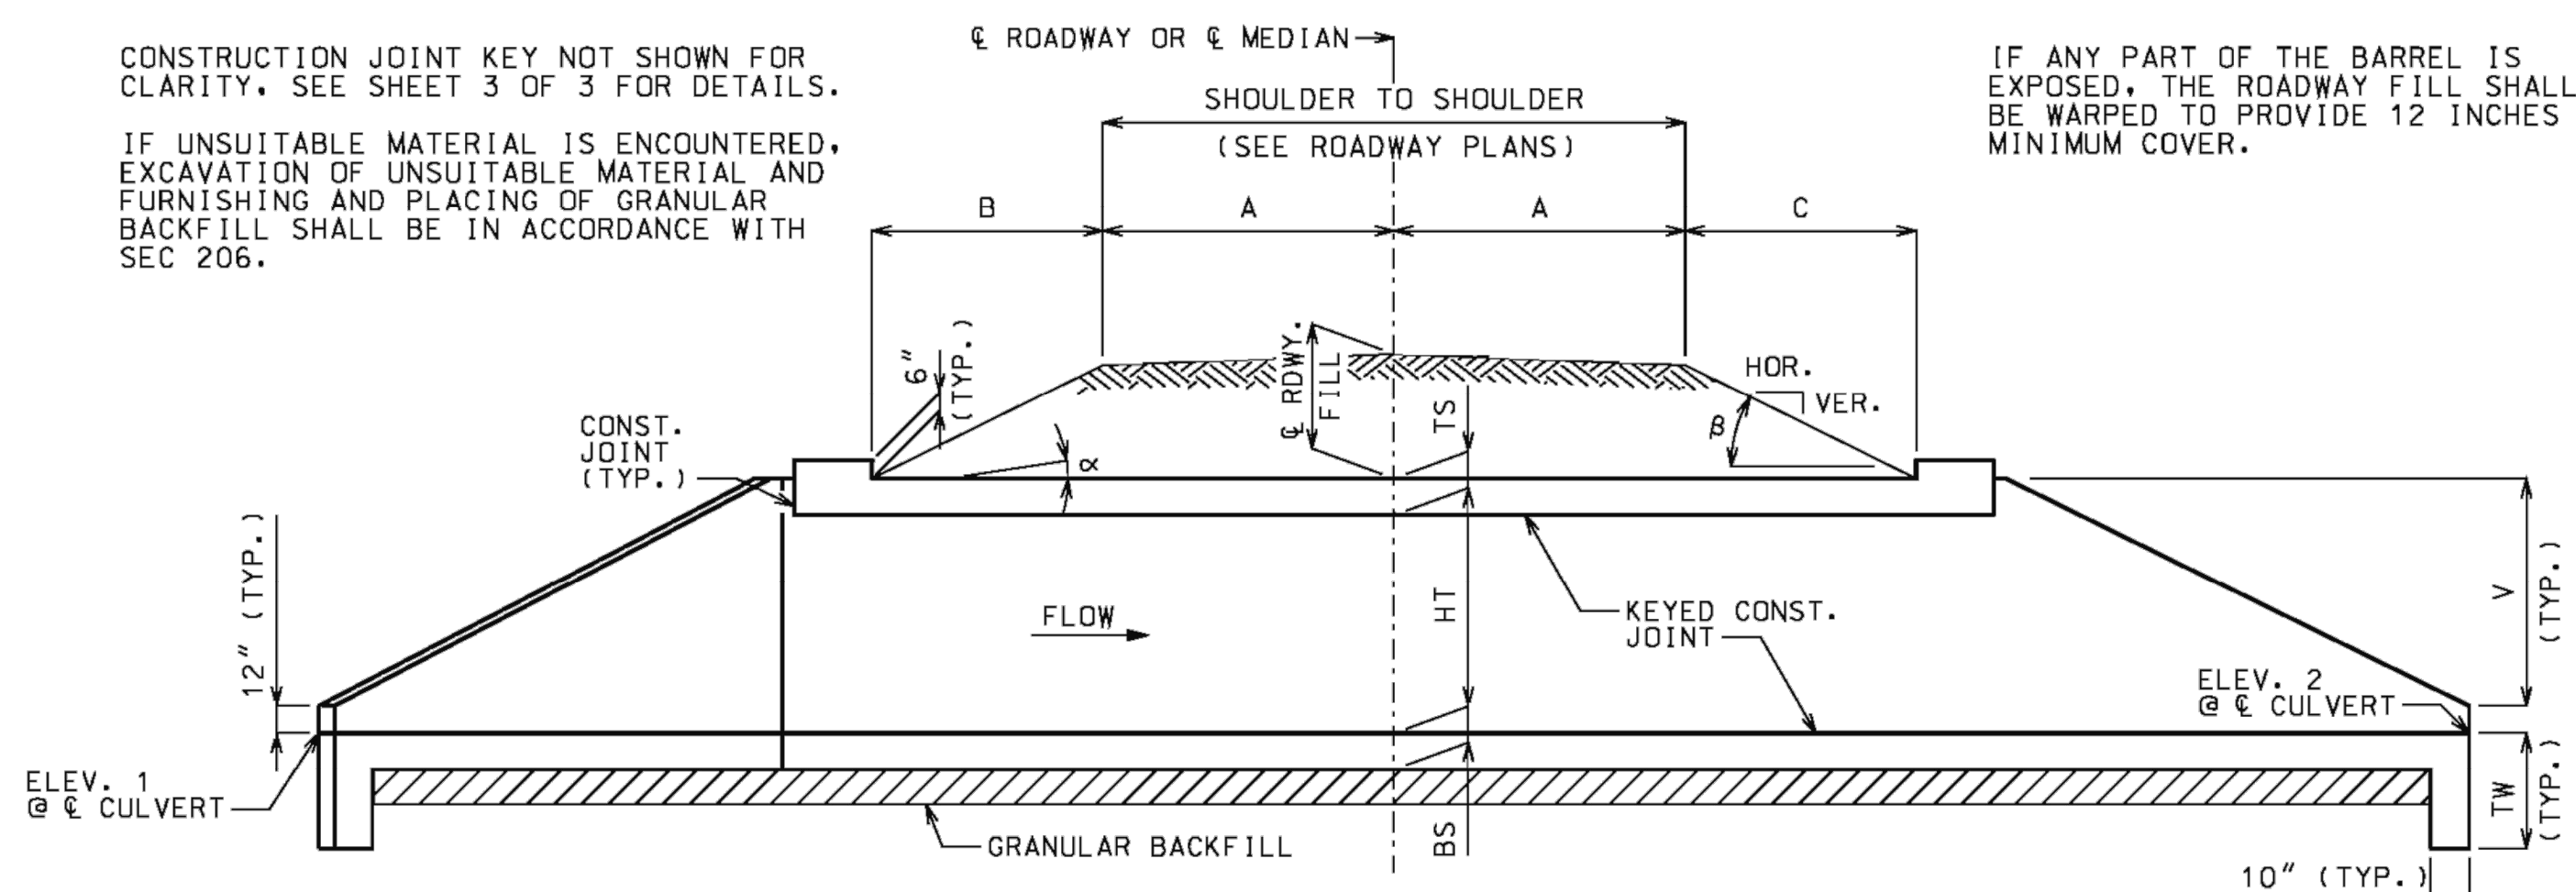

GENERAL ELEVATION A-A

CHANNEL BOTTOM SHALL BE GRADED WITHIN RIGHT OF WAY FOR TRANSITION OF CHANNEL BED TO CULVERT OPENINGS. CHANNEL BANKS SHALL BE TAPERED TO MATCH CULVERT OPENINGS.

CONSTRUCTION JOINT KEY NOT SHOWN FOR CLARITY, SEE SHEET 3 OF 3 FOR DETAILS.

IF UNSUITABLE MATERIAL IS ENCOUNTERED, EXCAVATION OF UNSUITABLE MATERIAL AND FURNISHING AND PLACING OF GRANULAR BACKFILL SHALL BE IN ACCORDANCE WITH SEC 206.

IF ANY PART OF THE BARREL IS
EXPOSED, THE ROADWAY FILL SHALL
BE WARPED TO PROVIDE 12 INCHES
MINIMUM COVER.

EQUATIONS FOR COMPUTING α , β , B AND C

$$\alpha = \text{ANGLE OF BARREL SLOPE WITH HORIZONTAL NORMAL TO } \ell \text{ ROADWAY OR } \ell \text{ MEDIAN} = \text{ARCTAN} \left(\frac{\text{ELEV. 1} - \text{ELEV. 2}}{W} \right)$$

$$\beta = \text{ANGLE OF FILL SLOPE WITH HORIZONTAL NORMAL TO } \text{C ROADWAY OR C MEDIAN} = \text{ARCTAN} \left(\frac{\text{VER.}}{\text{HOR.}} \right)$$

$$B = \text{HORIZONTAL DISTANCE FROM UPSTREAM EDGE OF SHOULDER TO} = \frac{C \text{ RDWY. FILL} + A(CS) - A(\tan\alpha)}{\tan\beta + \tan\alpha}$$
$$C = \frac{\text{HORIZONTAL DISTANCE FROM DOWNSTREAM EDGE OF SHOULDER TO DOWNSTREAM HEADWALL NORMAL TO } \phi \text{ ROADWAY OR } \phi \text{ MEDIAN}}{\frac{\text{RDWY. FILL} + A(\text{CS}) + A(\text{TAN}\alpha)}{\text{TAN}\beta - \text{TAN}\alpha}}$$

CS = CROSS SLOPE OF EACH PART OF ROADWAY INCLUDING CROWN, LANES AND SHOULDERS. CS IS POSITIVE IF RISING AND NEGATIVE IF FALLING AWAY FROM ϕ ROADWAY OR ϕ MEDIAN.

THE TERM "A(CS)" IS THE DIFFERENCE IN ELEVATION BETWEEN C ROADWAY OR C MEDIAN AND THE TOP OF THE FILL SLOPE NORMAL TO C ROADWAY OR C MEDIAN. THIS TERM SHALL BE ADJUSTED FOR UNSYMMETRICAL AND NONSTANDARD ROADWAYS.

TO ACCOUNT FOR A VARYING PROFILE GRADE THE ϵ ROADWAY FILL SHALL BE BASED ON STATIONS THAT CORRESPOND TO THE CORNERS OF THE INSIDE FACE OF THE HEADWALLS THAT PRODUCE MAXIMUM VALUES FOR B AND C.

SEE ROADWAY PLANS FOR SLOPES, @ ROADWAY FILL AND ELEVATIONS 1 AND 2. ELEVATIONS 1 AND 2 CORRESPOND TO UPPER AND LOWER FLOW LINE ELEVATIONS AND MAY BE BELOW THE NATURAL STREAM BOTTOM DUE TO ENVIRONMENTAL REQUIREMENTS.

LAYOUT DIMENSIONS

VARIABLE	DIMENSION	VARIABLE	DIMENSION
α	SEE EQUATIONS	P	$2V(\sec 20^\circ)$
β	SEE EQUATIONS	Q	$TX(\cos 20^\circ)$
B	SEE EQUATIONS	R	$P(\cos 20^\circ)$
C	SEE EQUATIONS	U	$(R + M)(\tan 20^\circ)$
D	$R + M + N + 20''$	V	$HT + TS - 12''$
E	$G + 23''$	W	$2A + B + C + D + E$
F	$S + 2TX$	Y	$TX(\sin 20^\circ)$
G	2V	KK	$S/2 + U$
M	$N(\cos 20^\circ)$	TW	$\max\{3' - 4'' \text{ OR } (BS + 12'')\}$
N	$3'' + TX(\tan 10^\circ)$		

GENERAL NOTES:

DESIGN SPECIFICATIONS:
2010 AASHTO LRFD BRIDGE DESIGN SPECIFICATIONS AND 2010 INTERIM
REVISIONS

DESIGN LOADING:
VEHICULAR = HL-93 MINUS LANE LOAD, EARTH = 120 LB/CF
EQUIVALENT FLUID PRESSURE = 30 LB/CF (MIN.), 60 LB/CF (MAX.)


DESIGN UNIT STRESSES:
CLASS B-1 CONCRETE (BOX CULVERT) $f'_c = 4,000$ PSI
REINFORCING STEEL (GRADE 60) $f_y = 60,000$ PSI

MISCELLANEOUS:
FOR REINFORCEMENT DETAILS, SEE SHEET 2 OF 3. FOR SECTION
DETAILS, SEE SHEET 3 OF 3. FOR MEMBER THICKNESS, SEE 703.17.


DRAWING NOT TO SCALE. FOLLOW DIMENSIONS.

DIMENSIONS ARE IN INCHES UNLESS OTHERWISE NOTED.

WHEN ALTERNATE PRECAST CONCRETE BOX CULVERT SECTIONS ARE USED, THE MINIMUM DISTANCE FROM INSIDE FACE OF HEADWALLS TO PRECAST SECTIONS MEASURED ALONG THE SHORTEST WALL SHALL BE 3 FEET. REINFORCEMENT AND DIMENSIONS FOR WINGS AND HEADWALLS SHALL BE IN ACCORDANCE WITH MISSOURI STANDARD PLANS.

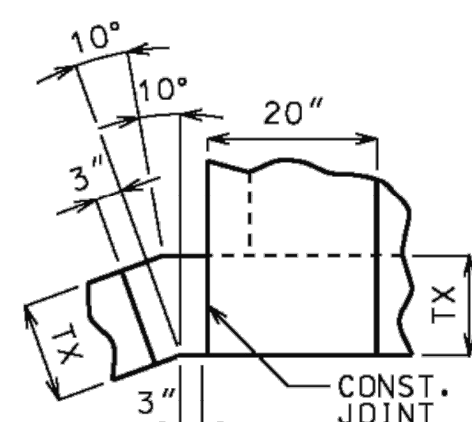

DETAIL A

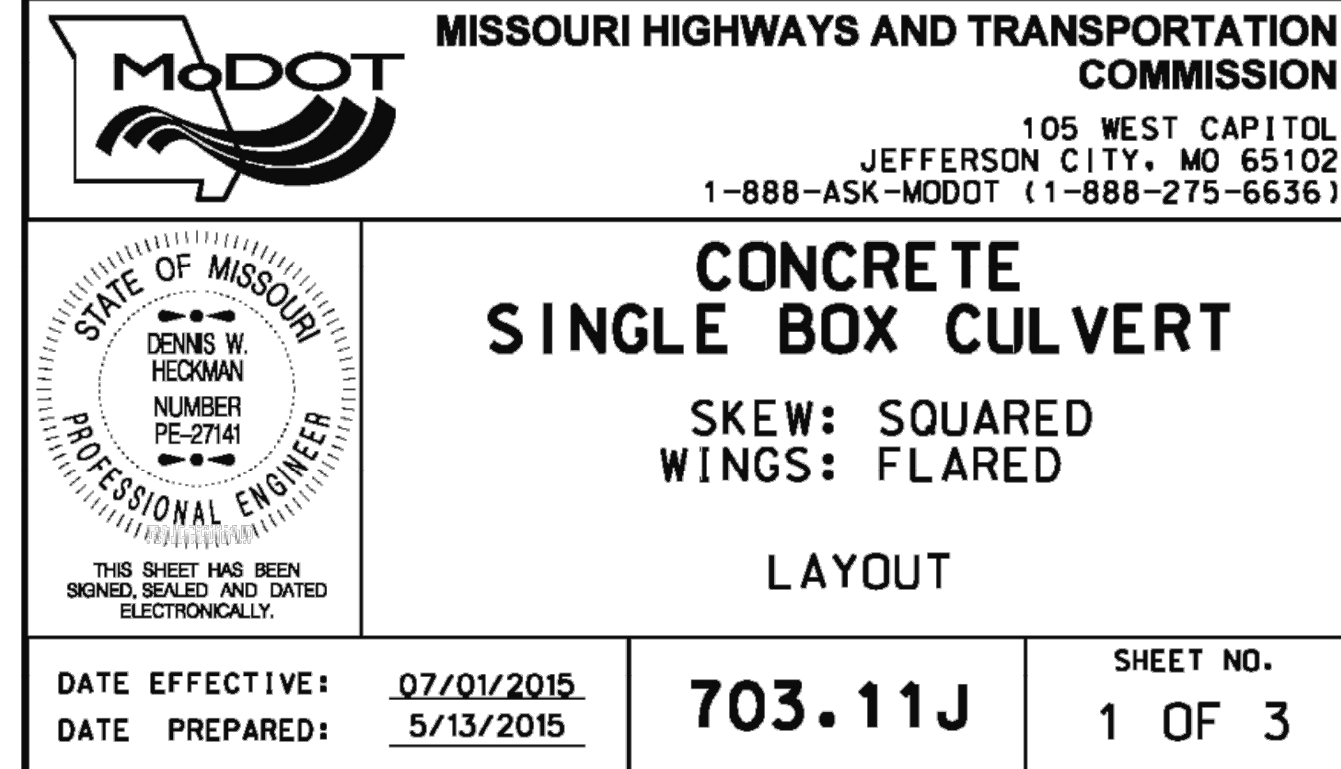

olson

Olsson Engineering - MO State Certificate of Authority #001592
73301 West 133rd Street, Suite 200
TEL 913.381.1170
Overland Park, KS 66213-4750
FAX 913.381.1174 www.olsson.com

RECORD
DRAWINGS



RYAN B. FLEMING
MO. NO. PE-2002003161

[illegible]

REINFORCED CONCRETE BOX DETAILS	SCANNELL DEVELOPMENT LEE'S SUMMIT LOGISTICS NORTHWEST CORNER OF TUDOR ROAD AND MAIN STREET	2004
------------------------------------	---	------

C.O.A. NO.: _____
DRAWN BY: ARJ/AMW
CHECKED BY: XXX
APPROVED BY: RBF
QA/QC BY: RBF
PROJECT NO.: 021-04157
DWG NO.: T_DTL03_02104157
DATE: 2021-10-12

SHEET
43 OF 105

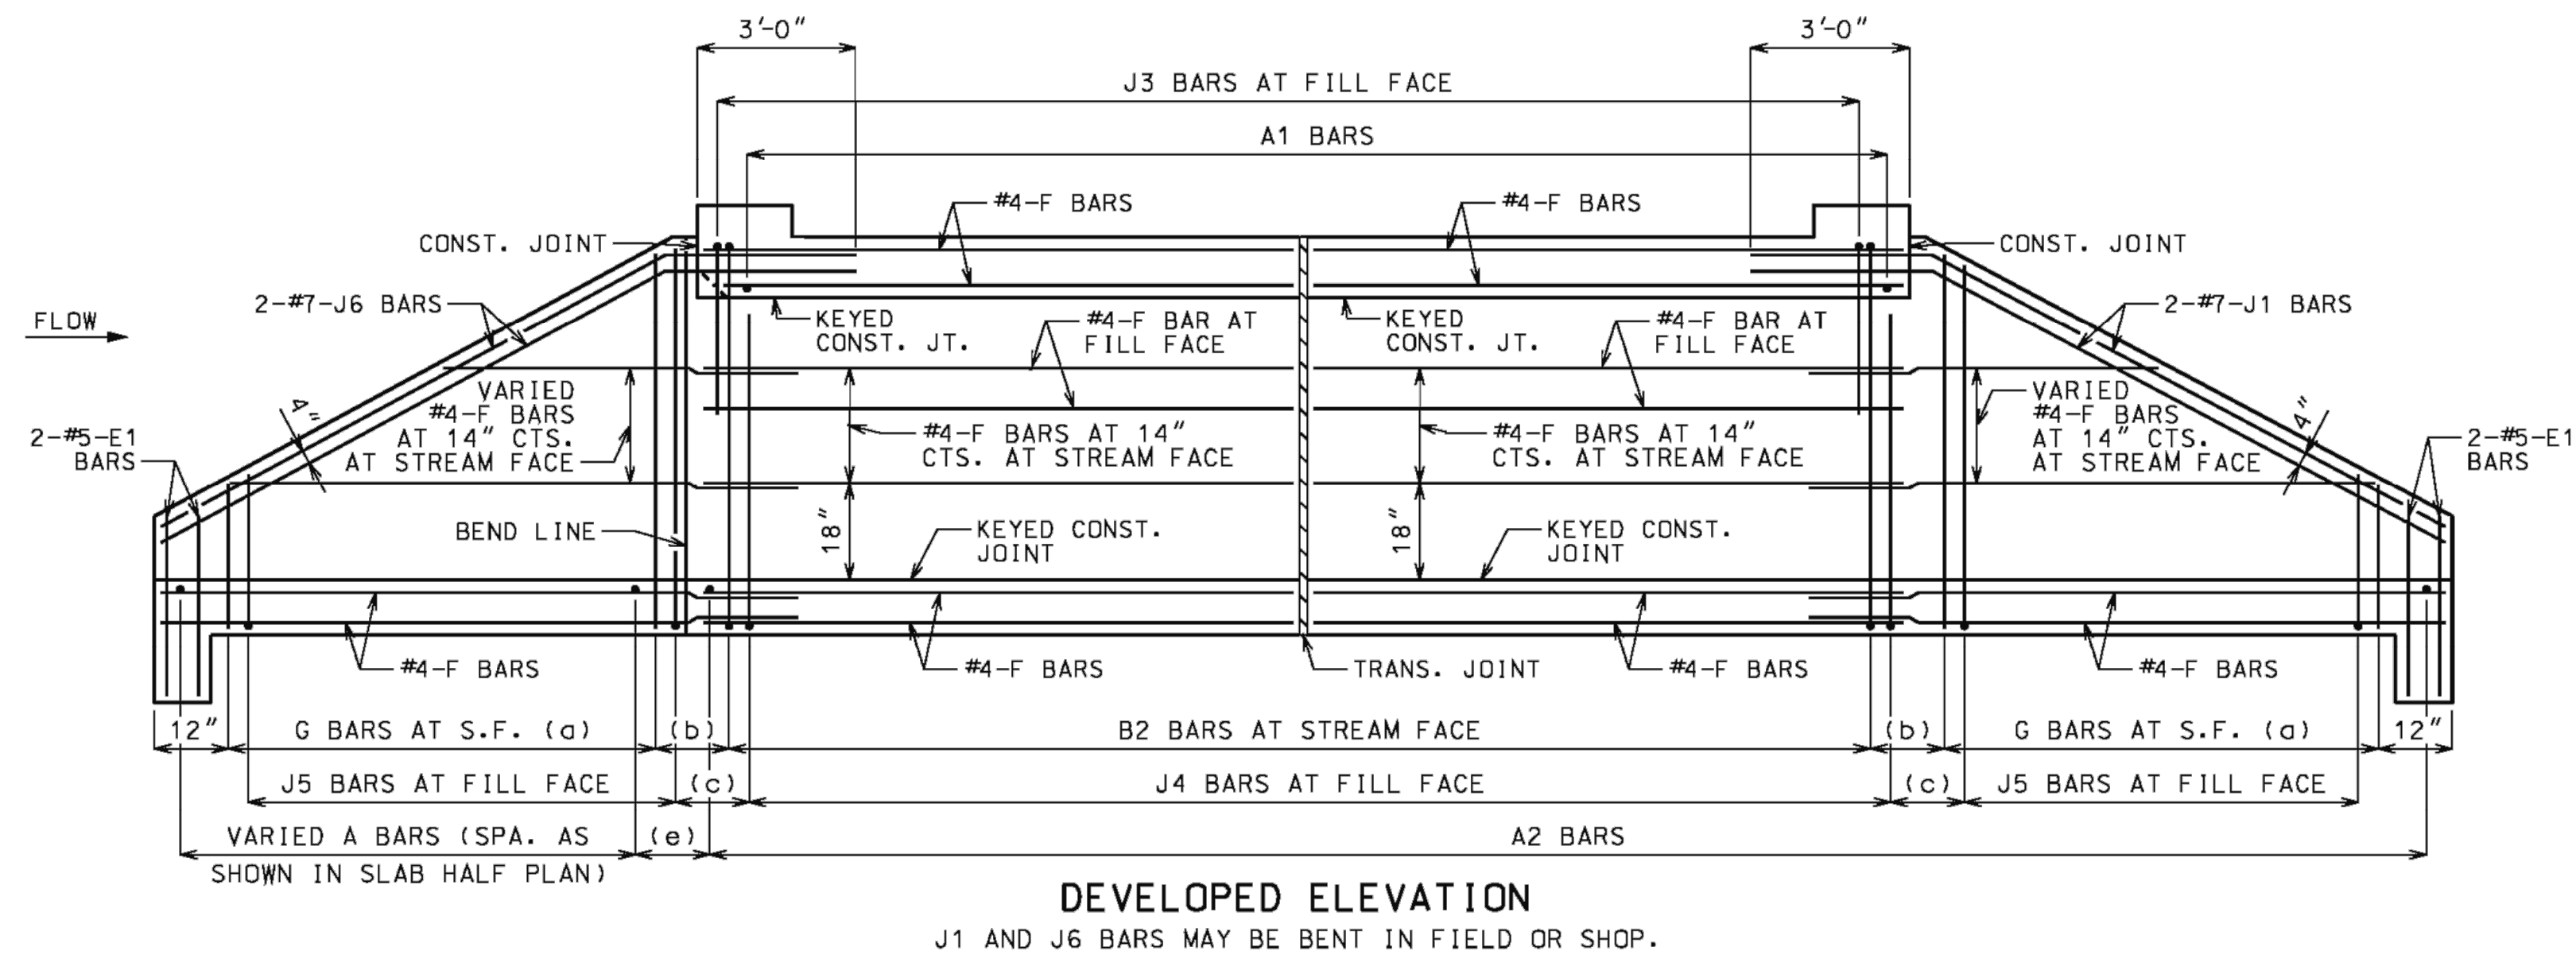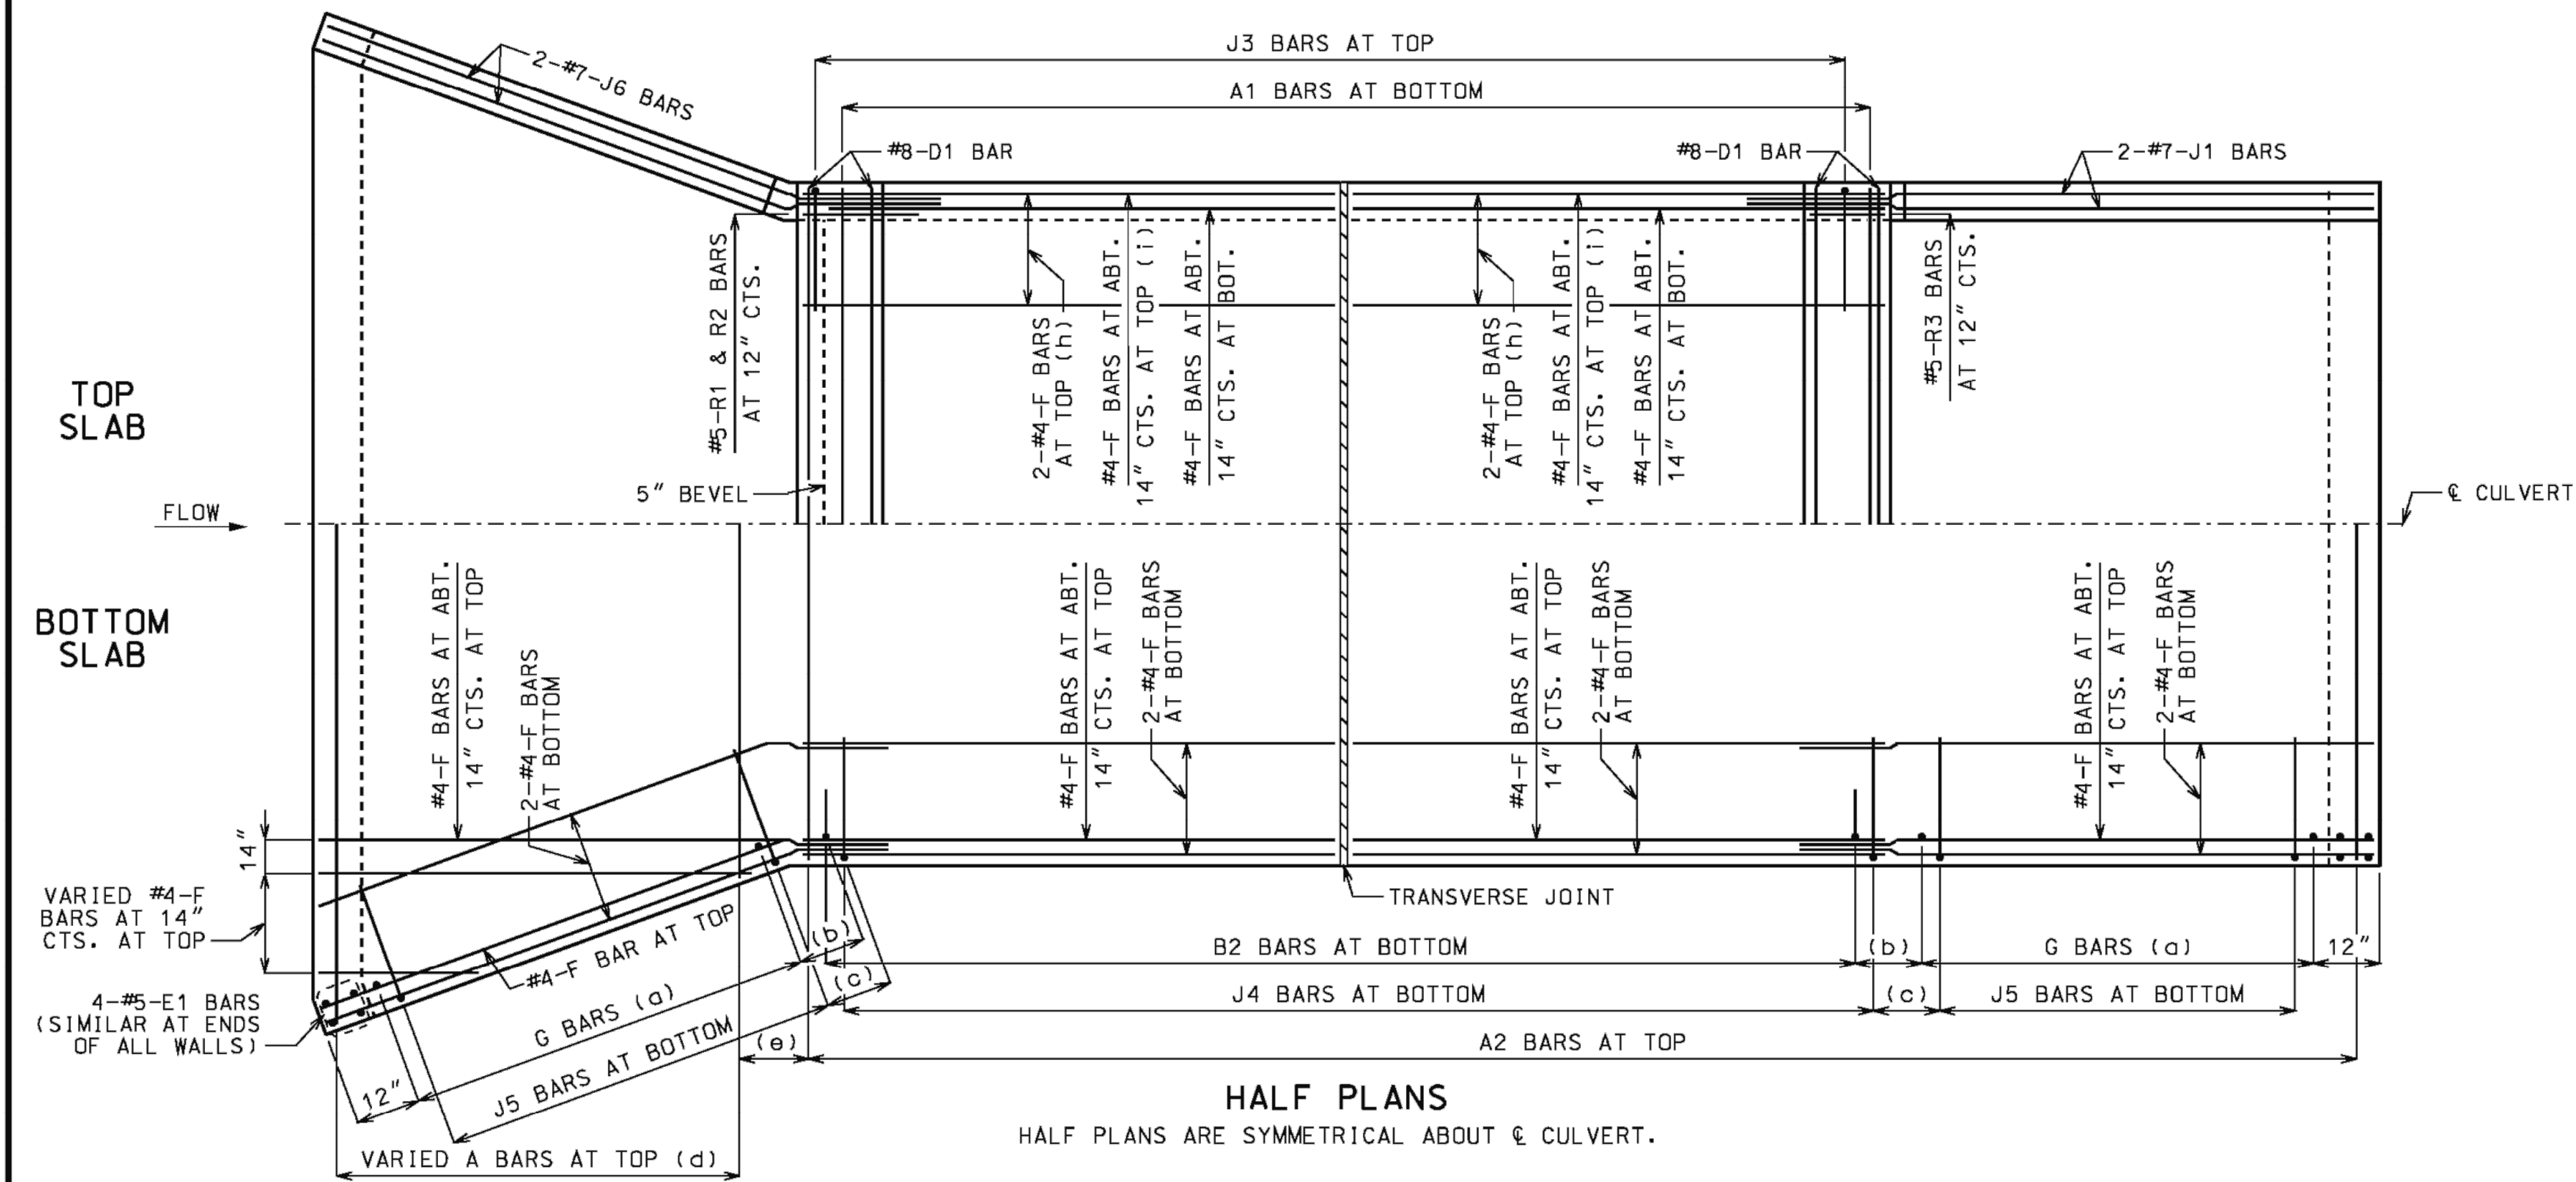

LAYING OUT TRANSVERSE JOINTS

UNLESS SHOWN ON ROADWAY OR BRIDGE PLANS

USE A TRANSVERSE JOINT WHEN BARREL LENGTH IS OVER 80 FEET. USE
ADDITIONAL JOINTS TO LIMIT CUT SECTION LENGTH AND END SECTION
BARREL LENGTH MEASURED ALONG CENTERLINE OF CULVERT TO 50 FEET.

MINIMUM END SECTION LENGTH SHALL BE 3 FEET MEASURED ALONG THE
SHORTEST WALL FROM THE INSIDE FACE OF HEADWALL TO THE TRANSVERSE
JOINT.

TO AVOID LOCATING TRANSVERSE JOINTS UNDER A TRAVELED WAY WITH DESIGN FILLS 2 FEET OR LESS THE FOLLOWING SHALL APPLY:

BARREL LENGTH UP TO 90 FEET WITHOUT A TRANSVERSE JOINT

CUT SECTION LENGTHS UP TO 60 FEET

WHEN BARREL AND CUT SECTION LENGTH RESTRICTIONS REQUIRE TRANSVERSE JOINTS TO BE LOCATED UNDER A TRAVELED WAY WITH DESIGN FILLS 2 FEET OR LESS, THE JOINTS SHALL BE LOCATED TO MINIMIZE THE LENGTH OF JOINT UNDER THE TRAVELED WAY.

TRAVELED WAY IS THE ROADWAY WIDTH MINUS SHOULDER WIDTHS.

FOR CUT SECTION DETAILS, SEE 703.16.

GENERAL NOTES:

FOR SECTIONS THRU BARREL, WINGS AND HEADWALLS, SEE SHEET 3 OF
3. FOR BAR SIZES, SPACING AND DIMENSIONS OF ALL REINFORCEMENT
EXCEPT J5 BARS, SEE 703.17. FOR J5 BARS, SEE 703.37.

CONSTRUCTION JOINT KEY NOT SHOWN FOR CLARITY IN HALF PLANS AND
ELEVATION. SEE SHEET 3 OF 3 FOR DETAILS.

DRAWING NOT TO SCALE. FOLLOW DIMENSIONS.

MINIMUM CLEARANCE TO REINFORCING STEEL SHALL BE $1\frac{1}{2}"$.

LAP LONGITUDINAL BARS A MINIMUM OF 23" AT SPLICES.

BEVELED HEADWALL SHALL BE LOCATED AT UPSTREAM END.

(a) SAME SIZE AND SPACING AS B2 BARS

(b) VARIES, 12" MAXIMUM

(c) J4 BAR SPACING

(d) SAME SIZE AND SPACING AS B2 BARS


(e) A2 BAR SPACING

(f) NOT SPECIFIED ON THIS SHEET

(g) NOT SPECIFIED ON THIS SHEET

(h) FOR DESIGN FILLS OVER 2'-0"

(i) FOR DESIGN FILLS 2'-0" OR LESS

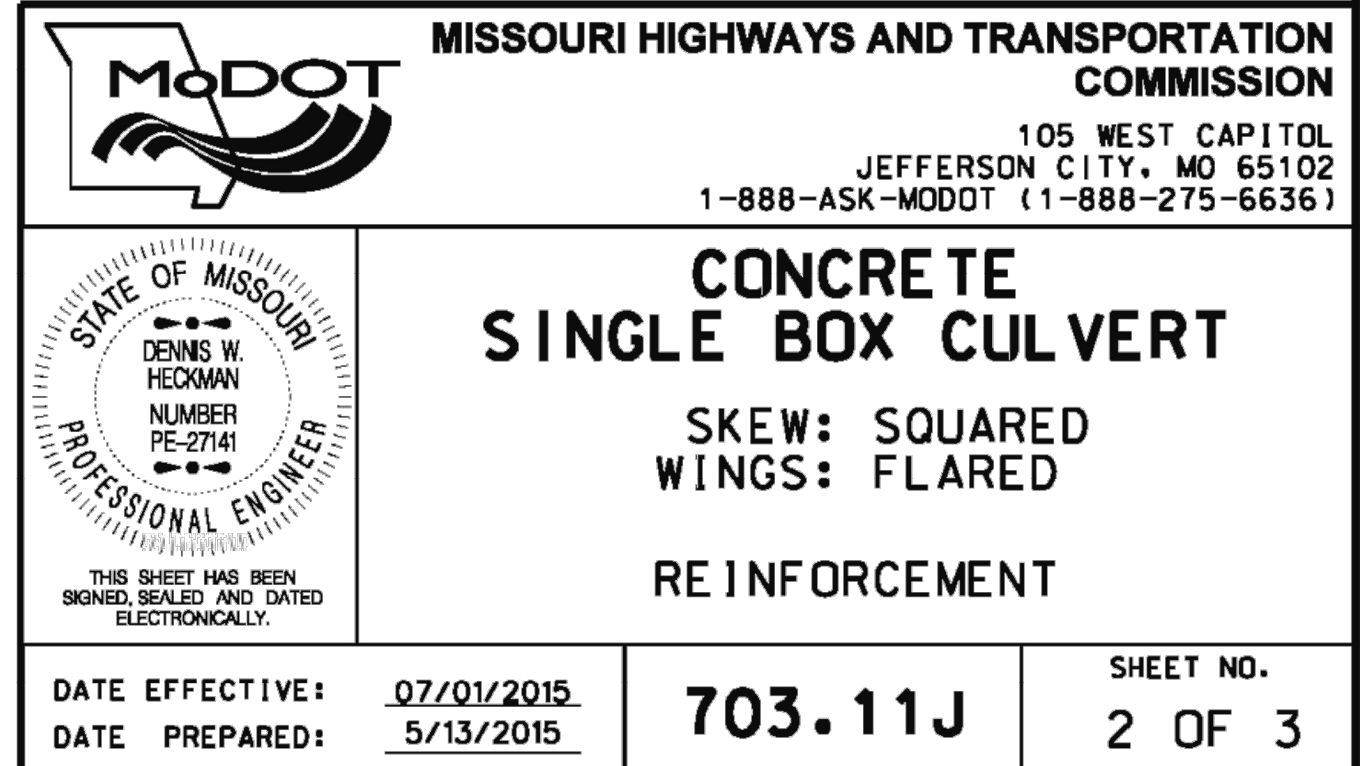

IF A SEAL IS PRESENT ON THIS SHEET IT HAS BEEN ELECTRONICALLY SEALED AND DATED.

REINFORCED CONCRETE BOX DETAILS

SCANNELL DEVELOPMENT LEE'S SUMMIT LOGISTICS
NORTHWEST CORNER OF TUDOR ROAD AND MAIN STREET

LEE'S SUMMIT, MISSOURI

C.O.A. NO.: _____
DRAWN BY: _____ ARJ/AMW
CHECKED BY: _____ XXX
APPROVED BY: _____ RBF
QA/QC BY: _____ RBF
PROJECT NO.: _____ 021-04157
DWG NO.: T_DTL03_02104157
DATE: _____ 2021-10-12

SHEET
44 OF 105

RECORD
DRAWINGS

RYAN B. FLEMING
MO. NO. PE-2002003161

[illegible]


REVISIONS

olson


Olsson Engineering - MO State Certificate of Authority #001592
7301 West 133rd Street, Suite 200 TEL 913.381.1170
Overland Park, KS 66213-4750 FAX 913.381.1174 www.olsson.com

SPAN (S) = 12 FT												HEIGHT (HT) = 6 FT OR 7 FT OR 8 FT												
DESIGN FILL	MEMBER THICKNESS			TOP SLAB BARS									BOTTOM SLAB BARS									WALL BARS B2 BARS		
				A1 BARS			J3 BARS			A2 BARS			J4 BARS											
	TS	BS	TX	SIZE	SPA.	SIZE	SPA.	C1	K2		SIZE	SPA.	SIZE	SPA.	C4	K3			SIZE	SPA.	G1			
										HT=6'	HT=7'	HT=8'						HT=6'	HT=7'	HT=8'				
1 FT	13	10	8	6	7.5	5	8.5	89.6	33.3	37.8	42.1	6	7.5	6	6.5	57.8	78	90	102	5	12	12		
2 FT	14	10	8	6	7	5	8.5	89.6	34.6	39.1	43.8	6	7	6	6	51.6	78	90	102	5	12	12		
4 FT	10	11	8	6	6.5	6	6.5	47.1	30.8	35.0	39.3	6	6.5	5	6.5	42.5	79	91	103	5	12	0		
6 FT	10	11	8	6	6.5	6	6.5	44.1	30.8	35.0	39.3	6	6	5	6	39.5	79	91	103	5	12	0		
8 FT	10	11	8	6	6	6	6.5	41.0	30.8	35.0	39.3	7	7.5	6	6.5	39.5	79	91	103	5	12	0		
10 FT	10	11	8	7	7	7	6	42.5	34.4	39.0	43.6	7	6.5	6	6	38.0	79	91	103	5	12	0		
12 FT	11	12	8	7	7	6	6	38.0	35.1	39.8	44.5	7	6.5	6	6.5	36.5	80	92	104	5	12	0		
14 FT	11	13	8	7	7	6	6	36.5	31.9	36.0	40.3	7	6.5	5	7	30.4	81	93	105	5	12	0		
16 FT	12	14	8	7	6.5	6	6	35.0	32.5	36.8	41.0	7	6.5	5	7	30.4	82	94	106	5	12	0		
18 FT	13	15	8	7	6	6	6.5	33.5	33.3	37.5	41.6	7	6	5	6.5	30.4	83	95	107	5	12	0		
20 FT	15	17	8	7	6	6	7	39.5	35.6	40.0	44.3	7	6.5	5	7	30.4	85	97	109	5	12	0		
22 FT	16	18	8	7	6	6	7	39.5	36.4	40.6	45.0	7	6	5	6.5	30.4	86	98	110	5	12	0		
24 FT	17	19	8	8	7.5	6	7	39.5	37.1	41.4	45.8	7	6	5	6.5	30.4	87	99	111	5	11	0		
26 FT	18	20	8	8	7	6	7	39.5	38.9	43.3	47.8	7	6	5	6	30.4	88	100	112	5	9.5	0		
28 FT	19	21	8	8	7	6	7	39.5	39.6	44.0	48.5	7	6	6	7.5	33.5	89	101	113	5	9.5	0		
30 FT	20	21	8	8	7	6	6.5	39.5	44.3	49.3	54.1	8	7	6	7.5	33.5	89	101	113	5	9.5	0		
32 FT	21	23	9	8	7	6	7.5	39.8	41.1	45.5	50.0	8	7.5	5	6	30.6	91	103	115	5	8.5	0		
34 FT	22	23	9	8	6.5	6	7.5	39.8	42.5	47.1	51.6	8	7	5	6	30.6	91	103	115	5	8.5	0		
36 FT	23	24	9	8	6.5	6	7	39.8	47.9	52.9	58.0	8	7	6	7	33.6	92	104	116	5	8.5	0		
38 FT	24	25	9	8	6.5	6	6.5	39.8	48.8	53.8	58.8	8	7	6	7	33.6	93	105	117	5	8.5	0		
40 FT	24	26	10	8	6	6	7	40.0	44.5	49.0	53.6	8	7	5	6	30.8	94	106	118	5	8	0		
42 FT	25	27	10	8	6	6	7	40.0	45.3	49.8	54.4	8	7	6	7	33.9	95	107	119	5	8	0		
44 FT	26	27	10	8	6	6	7	40.0	50.4	55.5	60.5	8	6.5	6	7	33.9	95	107	119	5	8	0		
46 FT	27	28	10	8	6	6	7	40.0	51.3	56.3	61.4	8	6.5	6	7	33.9	96	108	120	5	7.5	0		
48 FT	28	29	11	8	6	6	7.5	40.3	52.1	57.1	62.1	8	6.5	6	7.5	34.1	97	109	121	5	7.5	0		
50 FT	28	30	11	8	6	6	7.5	40.3	52.5	57.5	62.6	8	6.5	6	7	34.1	98	110	122	5	7.5	0		

SPAN (S) = 12 FT												HEIGHT (HT) = 12 FT OR 13 FT											
DESIGN FILL	MEMBER THICKNESS			TOP SLAB BARS								BOTTOM SLAB BARS								WALL BARS			
				A1 BARS				J3 BARS				A2 BARS				J4 BARS							
	TS	BS	TX	SIZE	SPA.	SIZE	SPA.	C1	K2		SIZE	SPA.	SIZE	SPA.	C4	K3		SIZE	SPA.	G1			
									HT=12'	HT=13'						HT=12'	HT=13'						
1 FT	12	11	9	6	6.5	5	6	90.3	32.4	34.8	6	6.5	6	6	91.8	151	163	5	8.5	12			
2 FT	12	11	9	6	6.5	6	7	91.8	34.0	36.5	6	6.5	6	6	91.8	151	163	5	8.5	12			
4 FT	10	12	9	6	6.5	6	6	91.8	35.4	38.0	6	6.5	6	6	91.8	152	164	5	8.5	0			
6 FT	10	12	9	6	6.5	7	6.5	81.1	35.4	38.0	6	6	6	6	91.8	152	164	5	8	0			
8 FT	10	12	10	6	6.5	6	6	64.6	35.4	38.0	7	7.5	6	6	73.9	152	164	5	8	0			
10 FT	11	13	10	6	6	6	6	61.6	35.9	38.5	7	7.5	6	6	69.3	153	165	5	8	0			
12 FT	12	13	11	6	6	6	7	58.9	36.1	38.8	7	7	6	6	62.0	153	165	5	7.5	0			
14 FT	12	13	11	6	6	6	7	54.3	36.1	38.8	7	7	6	6	55.8	153	165	5	7.5	0			
16 FT	12	14	11	7	7	6	6	52.8	36.3	39.0	7	6.5	6	6.5	55.8	154	166	5	7.5	0			
18 FT	13	16	12	7	7	6	6	53.0	38.6	41.4	7	6.5	6	7	56.1	156	168	5	7	0			
20 FT	14	16	12	7	6.5	6	6	53.0	38.9	41.6	7	6	6	6	54.6	156	168	5	7	0			
22 FT	16	18	13	7	6.5	6	6	59.6	41.5	44.4	7	6.5	6	7	55.0	158	170	5	6.5	0			
24 FT	16	19	13	7	6	7	7	64.4	40.0	42.8	7	6	6	6.5	55.0	159	171	5	6.5	0			
26 FT	18	20	14	7	6.5	6	6	58.5	42.5	45.4	7	6	6	6.5	55.3	160	172	5	6	0			
28 FT	18	21	14	7	6	7	7	63.3	42.8	45.6	7	6	6	6.5	55.3	161	173	5	6	0			
30 FT	19	22	14	8	7.5	7	6.5	63.3	43.3	46.1	7	6	6	6	55.3	162	174	5	6	0			
32 FT	20	23	15	8	7.5	7	7.5	63.6	45.5	48.5	8	7.5	6	6.5	55.6	163	175	6	8	0			
34 FT	21	23	15	8	7	7	7	63.6	45.8	48.8	8	7	6	6	55.6	163	175	6	8	0			
36 FT	22	24	16	8	7	7	7.5	64.0	46.3	49.3	8	7	6	6.5	56.0	164	176	6	8	0			
38 FT	23	25	16	8	7	7	7	64.0	48.6	51.8	8	7	6	6	56.0	165	177	6	8	0			
40 FT	24	26	17	8	7	7	7.5	64.4	49.1	52.3	8	7	6	6.5	56.4	166	178	6	7.5	0			
42 FT	24	27	17	8	6.5	7	6.5	64.4	49.4	52.5	8	7	6	6	56.4	167	179	6	7.5	0			
44 FT	25	28	18	8	6.5	7	7	66.4	49.9	53.0	8	7	6	6.5	56.8	168	180	6	7	0			
46 FT	26	28	18	8	6.5	7	7	66.4	50.1	53.3	8	6.5	6	6	56.8	168	180	6	7	0			
48 FT	27	29	19	8	6.5	7	7.5	66.9	52.6	55.9	8	6.5	6	6.5	57.0	169	181	6	6.5	0			
50 FT	28	30	19	8	6.5	7	7	66.9	53.3	56.4	8	6.5	6	6	57.0	170	182	6	6.5	0			

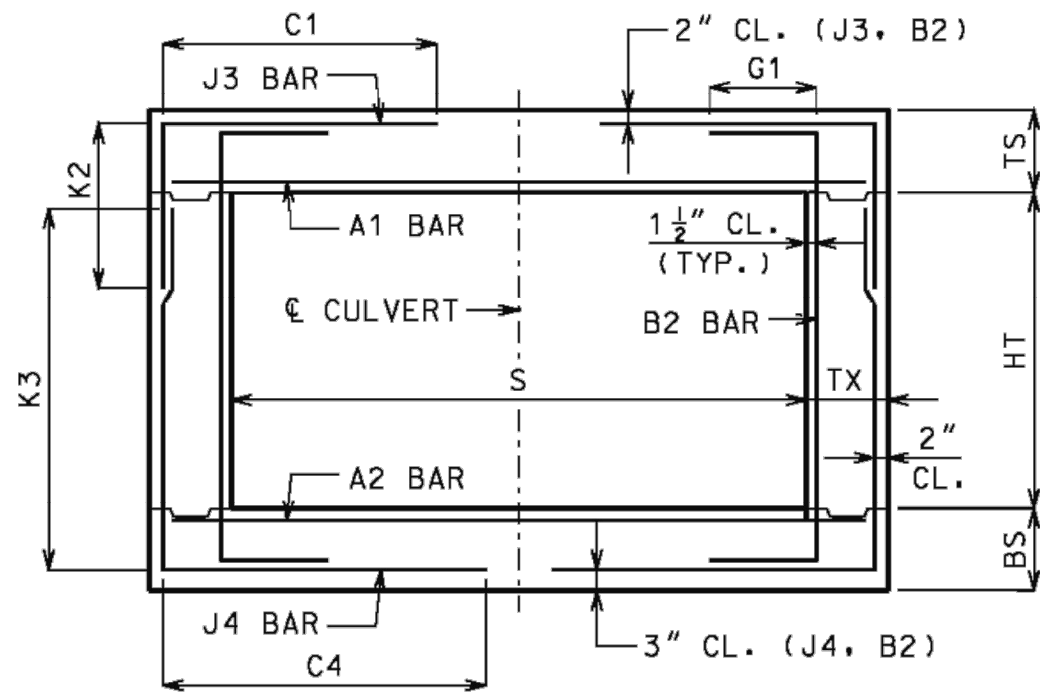

BAR DIMENSIONS DIAGRAM
SYMMETRICAL ABOUT ϵ CULVERT.

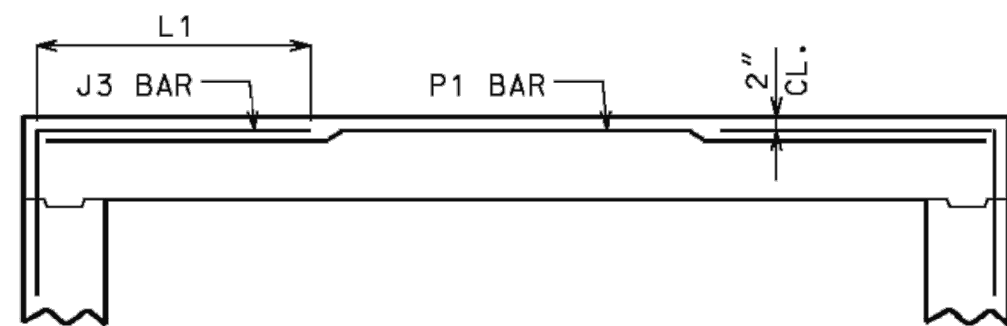


ALTERNATE J3 BAR

AT CONTRACTOR'S OPTION, ALTERNATE J3 BARS MAY BE USED WHEN THE DISTANCE BETWEEN THE ENDS OF J3 BARS IN THE TOP SLAB IS LESS THAN 2'-0". DIMENSION L1 (NOT C1) SHALL BE USED WITH ALTERNATE J3 BARS, WHERE L1 IS EQUAL TO 18", 22" AND 26" FOR #4, #5 AND #6 BARS, RESPECTIVELY. ADDITIONAL P1 BARS ARE REQUIRED WITH ALTERNATE J3 BARS WITH A LENGTH EQUAL TO A1 BARS, AND SIZE AND SPACING EQUAL TO J3 BARS. NO ADDITIONAL PAYMENT WILL BE MADE FOR THIS SUBSTITUTION.

SPAN (S) = 12 FT												HEIGHT (HT) = 9 FT OR 10 FT OR 11 FT											
DESIGN FILL	MEMBER THICKNESS			TOP SLAB BARS								BOTTOM SLAB BARS								WALL BARS			
				A1 BARS		J3 BARS				A2 BARS		J4 BARS											
	TS	BS	TX	SIZE	SPA.	SIZE	SPA.	C1	K2 HT=9' HT=10' HT=11'			SIZE	SPA.	SIZE	SPA.	C4	K3 HT=9' HT=10' HT=11'			SIZE	SPA.	G1	
1 FT	11	12	8	6	6.5	6	7	91.3	31.5	34.5	37.5	6	7.5	6	7	91.3	116	128	140	5	10	12	
2 FT	11	12	8	6	6	6	6.5	91.3	31.5	34.5	37.5	6	7	6	6.5	91.3	116	128	140	5	9.5	12	
4 FT	10	12	8	6	6	6	6	69.9	30.0	32.9	35.8	6	6.5	6	6.5	83.6	116	128	140	5	9.5	0	
6 FT	10	12	8	6	6.5	6	6	57.8	31.3	34.3	37.3	6	6	6	6	62.4	116	128	140	5	9.5	0	
8 FT	10	12	9	6	6	6	6	52.0	31.3	34.3	37.3	7	8	6	6	55.1	116	128	140	5	10	0	
10 FT	10	12	9	7	7.5	7	6	52.0	35.0	38.4	41.8	7	7	6	6	50.5	116	128	140	5	9.5	0	
12 FT	11	13	10	7	7.5	6	6	49.3	33.0	36.1	39.3	7	7	6	6.5	49.3	117	129	141	5	10	0	
14 FT	11	13	10	7	7.5	6	6	46.3	31.8	34.8	37.8	7	7	6	6.5	46.3	117	129	141	5	12	0	
16 FT	12	14	10	7	7	6	6.5	46.3	32.3	35.3	38.3	7	6.5	6	7	44.6	118	130	142	5	11	0	
18 FT	13	15	10	7	6.5	6	6	44.6	38.0	41.5	45.0	7	6	6	7	44.6	119	131	143	5	9.5	0	
20 FT	14	16	10	7	6	7	7.5	47.8	38.6	42.0	45.5	7	6	6	6.5	44.6	120	132	144	5	8.5	0	
22 FT	16	18	11	7	6.5	6	6.5	51.1	37.0	40.3	43.5	7	6.5	6	7.5	45.0	122	134	146	5	8.5	0	
24 FT	17	19	11	7	6	6	6	49.6	37.5	40.8	44.0	7	6	6	7.5	45.0	123	135	147	5	7.5	0	
26 FT	18	20	12	7	6	6	6.5	49.9	38.1	41.3	44.5	7	6	6	7.5	45.3	124	136	148	5	8	0	
28 FT	19	21	12	7	6	6	6	49.9	40.0	43.4	46.8	7	6	6	7.5	45.3	125	137	149	5	7	0	
30 FT	20	22	13	8	7.5	6	6.5	51.8	40.6	44.0	47.4	7	6	6	8	45.5	126	138	150	5	7.5	0	
32 FT	21	23	13	8	7.5	6	6	50.3	41.1	44.5	47.9	8	7.5	6	7.5	45.5	127	139	151	5	7	0	
34 FT	21	23	13	8	7	6	6	50.3	45.6	49.3	53.0	8	7	6	7	45.5	127	139	151	5	6.5	0	
36 FT	22	24	14	8	7	6	6	52.1	43.3	46.8	50.1	8	7	6	7.5	45.9	128	140	152	5	7	0	
38 FT	23	25	14	8	6.5	6	6	50.5	43.8	47.3	50.8	8	7	6	7.5	45.9	129	141	153	5	6	0	
40 FT	24	26	14	8	6.5	6	6	50.5	44.4	47.9	51.4	8	7	6	7	45.9	130	142	154	5	6	0	
42 FT	25	27	15	8	6.5	6	6	52.5	49.6	53.5	57.3	8	7	6	7.5	46.1	131	143	155	5	6	0	
44 FT	26	28	15	8	6.5	6	6	52.5	50.3	54.1	57.9	8	6.5	6	7.5	47.8	132	144	156	6	8	0	
46 FT	27	28	15	8	6.5	6	6	50.9	52.1	56.1	60.0	8	6.5	6	7	47.8	132	144	156	6	8	0	
48 FT	27	29	15	8	6	6	6	52.5	52.5	56.4	60.4	8	6.5	6	7	47.8	133	145	157	6	8	0	
50 FT	28	30	16	8	6	6	6	52.8	53.1	57.1	61.0	8	6.5	6	7.5	48.0	134	146	158	6	8	0	

DWG: F:\2021\04001-04500\021-04157\40-Design\AutoCAD\Final Plans\Sheets\ROBR\T_ERC01_02104157.dwg
DATE: Oct 30, 2023 3:53pm
XREFS: C_PROW_02104157 T_PTLK_02104157 T_PBASE_02104157 V_XBOU_02104157 T_PSTRM_02104157
USER: asaavedra

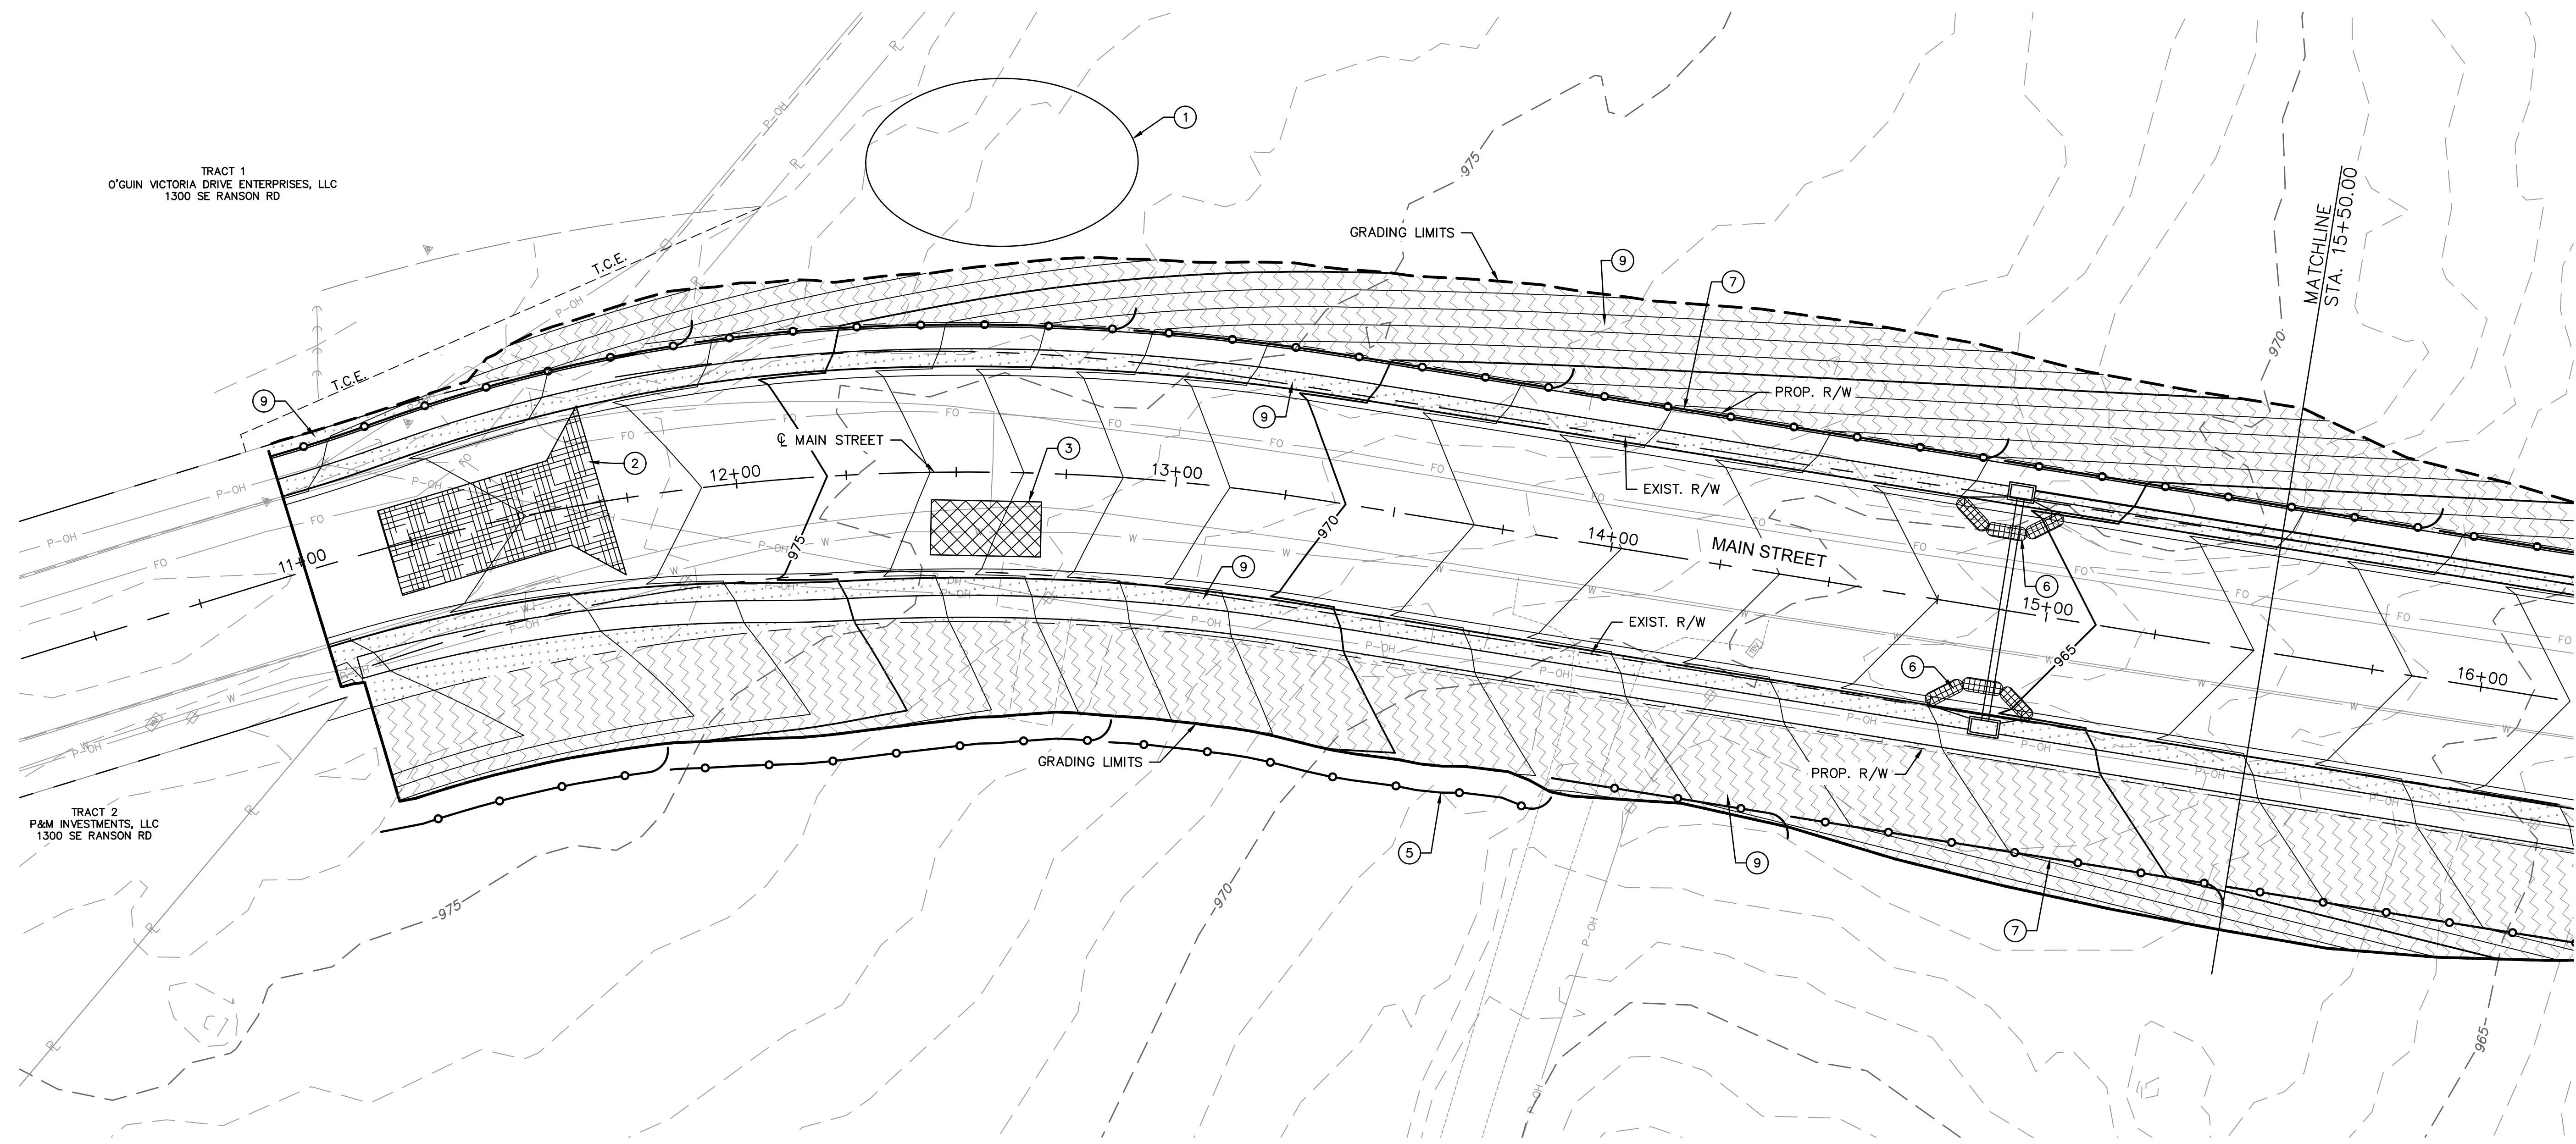

EROSION AND SEDIMENT CONTROL STAGING CHART				
PROJECT STAGE	EROSION CONTROL PLAN BMP REFERENCE NO.	BMP DESCRIPTION	REMOVE AFTER STAGE	NOTES:
I - STORM SEWER AND RCP INSTALLATION PRIOR TO ROADWAY GRADING	1	STAGING AREA	III	
	2	TEMPORARY CONSTRUCTION ENTRANCE	III	
	3	CONCRETE WASHOUT	III	
	4	DIVERSION BERM	IV	INSTALL BEFORE RCB INSTALLATION (SEE SHEET 58)
	5	SILT FENCE/OR BIODEGRADABLE LOGS (9")	IV	
	6	CURB INLET PROTECTION	III	PER CURB INLET DETAIL
II - ROADWAY GRADING & SWALE GRADING	7	SILT FENCE/OR BIODEGRADABLE LOGS (9")	IV	
III - PAVING	8	CURB INLET/AREA INLET PROTECTION	IV	GRAVEL FILTER BAGS
IV - STABILIZE SITE	9	SOD/SEED	N/A	

LEGEND

SILT FENCE

INLET PROTECTION

TEMPORARY ROCK DITCH CHECKS

CONSTRUCTION ENTRANCE

CONCRETE WASHOUT

SOD

SEED

SCALE IN FEET

Olsson Engineering - MO State Certificate of Authority #001592
7301 West 133rd Street, Suite 200
Overland Park, KS 66213-4750
TEL 913.381.1170
FAX 913.381.1174
www.olson.com

RECORD DRAWINGS

RYAN B. FLEMING
MO. NO. PE-2002003161

BY: ARJ

REV. NO. 1

DATE 11/16/2021

REVISIONS DESCRIPTION

CITY COMMENTS

REVISIONS

EROSION CONTROL PLAN

SCANNELL DEVELOPMENT LEE'S SUMMIT LOGISTICS
NORTHWEST CORNER OF TUDOR ROAD AND MAIN STREET


LEE'S SUMMIT, MISSOURI

2021

C.O.A. NO.:
DRAWN BY: ARJ/AMW
CHECKED BY: XXX
APPROVED BY: RBE
QA/QC BY: RBE
PROJECT NO.: 021-04157
DWG NO.: T_ERC01_02104157
DATE: 2021-10-12

SHEET 48 OF 105

DWG: F:\2021\04001-04500\021-04157\40-Design\AutoCAD\Final Plans\Sheets\RDBR\T_ERC01_02104157.dwg
 XREFS: C:\PROJ_02104157 V_XTOPO_02104157 T_PTBLK_02104157
 DATE: Oct 30, 2023 3:53pm
 USER: oasavedra
 T_PBASE_02104157 V_XBOU_02104157 T_PSTRM_02104157

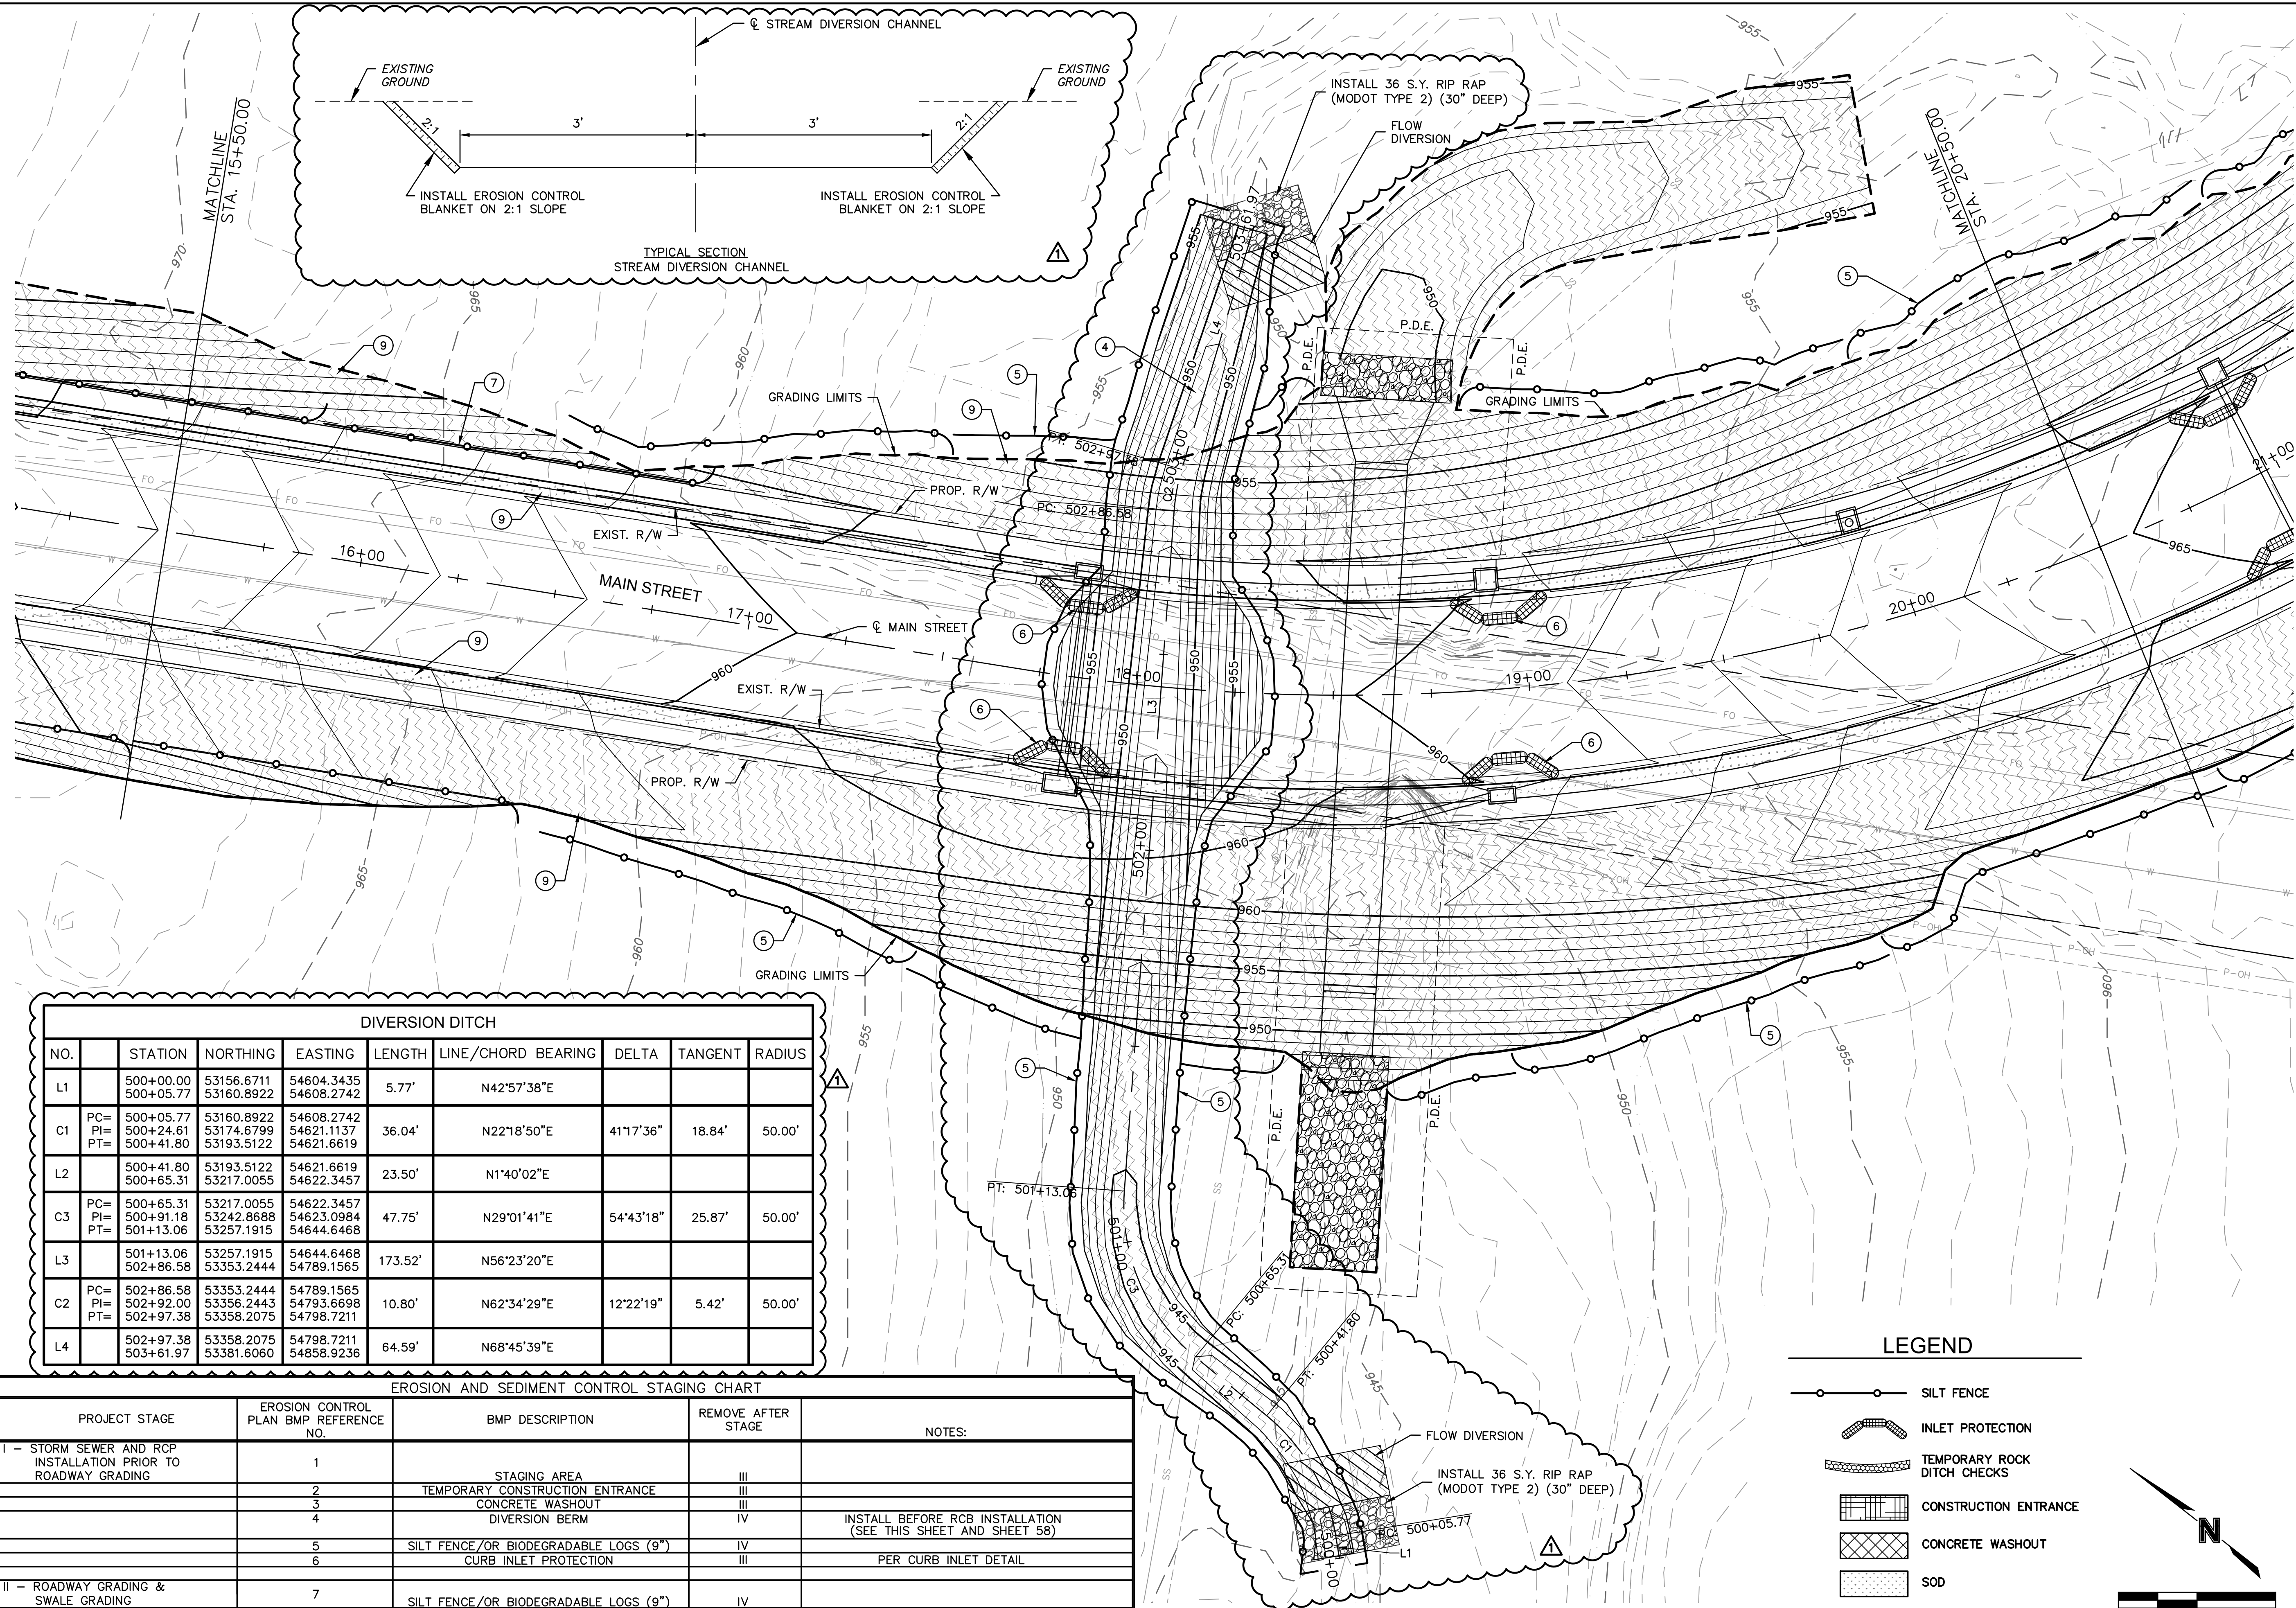

DIVERSION DITCH									
NO.		STATION	NORTHING	EASTING	LENGTH	LINE/CHORD BEARING	DELTA	TANGENT	RADIUS
L1		500+00.00 500+05.77	53156.6711 53160.8922	54604.3435 54608.2742	5.77'	N42°57'38"E			
C1	PC= PI= PT=	500+05.77 500+24.61 500+41.80	53160.8922 53174.6799 53193.5122	54608.2742 54621.1137 54621.6619	36.04'	N22°18'50"E	41°17'36"	18.84'	50.00'
L2		500+41.80 500+65.31	53193.5122 53217.0055	54621.6619 54622.3457	23.50'	N1°40'02"E			
C3	PC= PI= PT=	500+65.31 500+91.18 501+13.06	53217.0055 53242.8688 53257.1915	54622.3457 54623.0984 54644.6468	47.75'	N29°01'41"E	54°43'18"	25.87'	50.00'
L3		501+13.06 502+86.58	53257.1915 53353.2444	54644.6468 54789.1565	173.52'	N56°23'20"E			
C2	PC= PI= PT=	502+86.58 502+92.00 502+97.38	53353.2444 53356.2443 53358.2075	54789.1565 54793.6698 54798.7211	10.80'	N62°34'29"E	12°22'19"	5.42'	50.00'
L4		502+97.38 503+61.97	53358.2075 53381.6060	54798.7211 54858.9236	64.59'	N68°45'39"E			


EROSION AND SEDIMENT CONTROL STAGING CHART				
PROJECT STAGE	EROSION CONTROL PLAN BMP REFERENCE NO.	BMP DESCRIPTION	REMOVE AFTER STAGE	NOTES:
I – STORM SEWER AND RCP INSTALLATION PRIOR TO ROADWAY GRADING	1	STAGING AREA	III	INSTALL BEFORE RCB INSTALLATION (SEE THIS SHEET AND SHEET 58)
	2	TEMPORARY CONSTRUCTION ENTRANCE	III	
	3	CONCRETE WASHOUT	III	
	4	DIVERSION BERM	IV	
	5	SILT FENCE/OR BIODEGRADABLE LOGS (9")	IV	
	6	CURB INLET PROTECTION	III	
II – ROADWAY GRADING & SWALE GRADING	7	SILT FENCE/OR BIODEGRADABLE LOGS (9")	IV	PER CURB INLET DETAIL
III – PAVING	8	CURB INLET/AREA INLET PROTECTION	IV	GRAVEL FILTER BAGS
IV – STABILIZE SITE	9	SOD/SEED	N/A	

erosion control plan					
SCANNELL DEVELOPMENT LEE'S SUMMIT LOGISTICS NORTHWEST CORNER OF TUDOR ROAD AND MAIN STREET					
LEE'S SUMMIT, MISSOURI					
C.O.A. NO.: _____ DRAWN BY: _____ ARJ/AMW CHECKED BY: _____ XXX APPROVED BY: _____ RBF QA/QC BY: _____ RBF PROJECT NO.: _____ 021-04157 DWG NO.: _____ T ERC01_02104157 DATE: _____ 2021-10-12					
SHEET 49 OF 105					

DWG: F:\2021\04001-04500\021-04157\40-Design\AutoCAD\Final Plans\Sheets\ROBR\T_ERC01_02104157.dwg
DATE: Oct 30, 2023 3:53pm
XREFS: C_PROW_02104157 V_XTOPO_02104157 T_PTBK_02104157 T_PTRM_02104157 V_XBOU_02104157 T_PTRM_02104157
USER: asaavedra T_PBASE_02104157

EROSION AND SEDIMENT CONTROL STAGING CHART				
PROJECT STAGE	EROSION CONTROL PLAN BMP REFERENCE NO.	BMP DESCRIPTION	REMOVE AFTER STAGE	NOTES:
I - STORM SEWER AND RCP INSTALLATION PRIOR TO ROADWAY GRADING	1	STAGING AREA	III	
	2	TEMPORARY CONSTRUCTION ENTRANCE	III	
	3	CONCRETE WASHOUT	III	
	4	DIVERSION BERM	IV	INSTALL BEFORE RCB INSTALLATION (SEE SHEET 58)
	5	SILT FENCE/OR BIODEGRADABLE LOGS (9")	IV	
	6	CURB INLET PROTECTION	III	PER CURB INLET DETAIL
II - ROADWAY GRADING & SWALE GRADING	7	SILT FENCE/OR BIODEGRADABLE LOGS (9")	IV	
III - PAVING	8	CURB INLET/AREA INLET PROTECTION	IV	GRAVEL FILTER BAGS
IV - STABILIZE SITE	9	SOD/SEED	N/A	


LEGEND

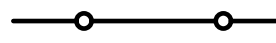

SILT FENCE



INLET PROTECTION

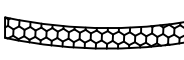

TEMPORARY ROCK DITCH CHECKS




CONSTRUCTION ENTRANCE





CONCRETE WASHOUT



SOD

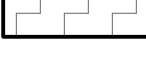

SEED

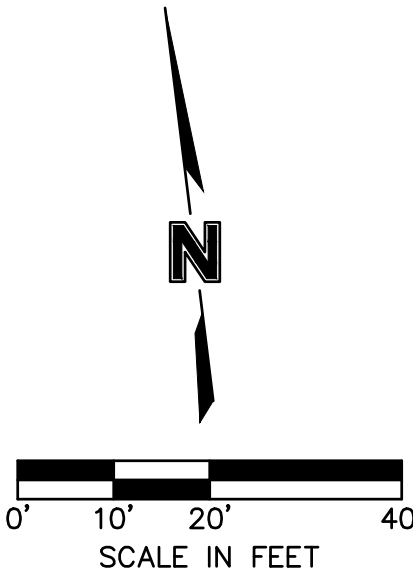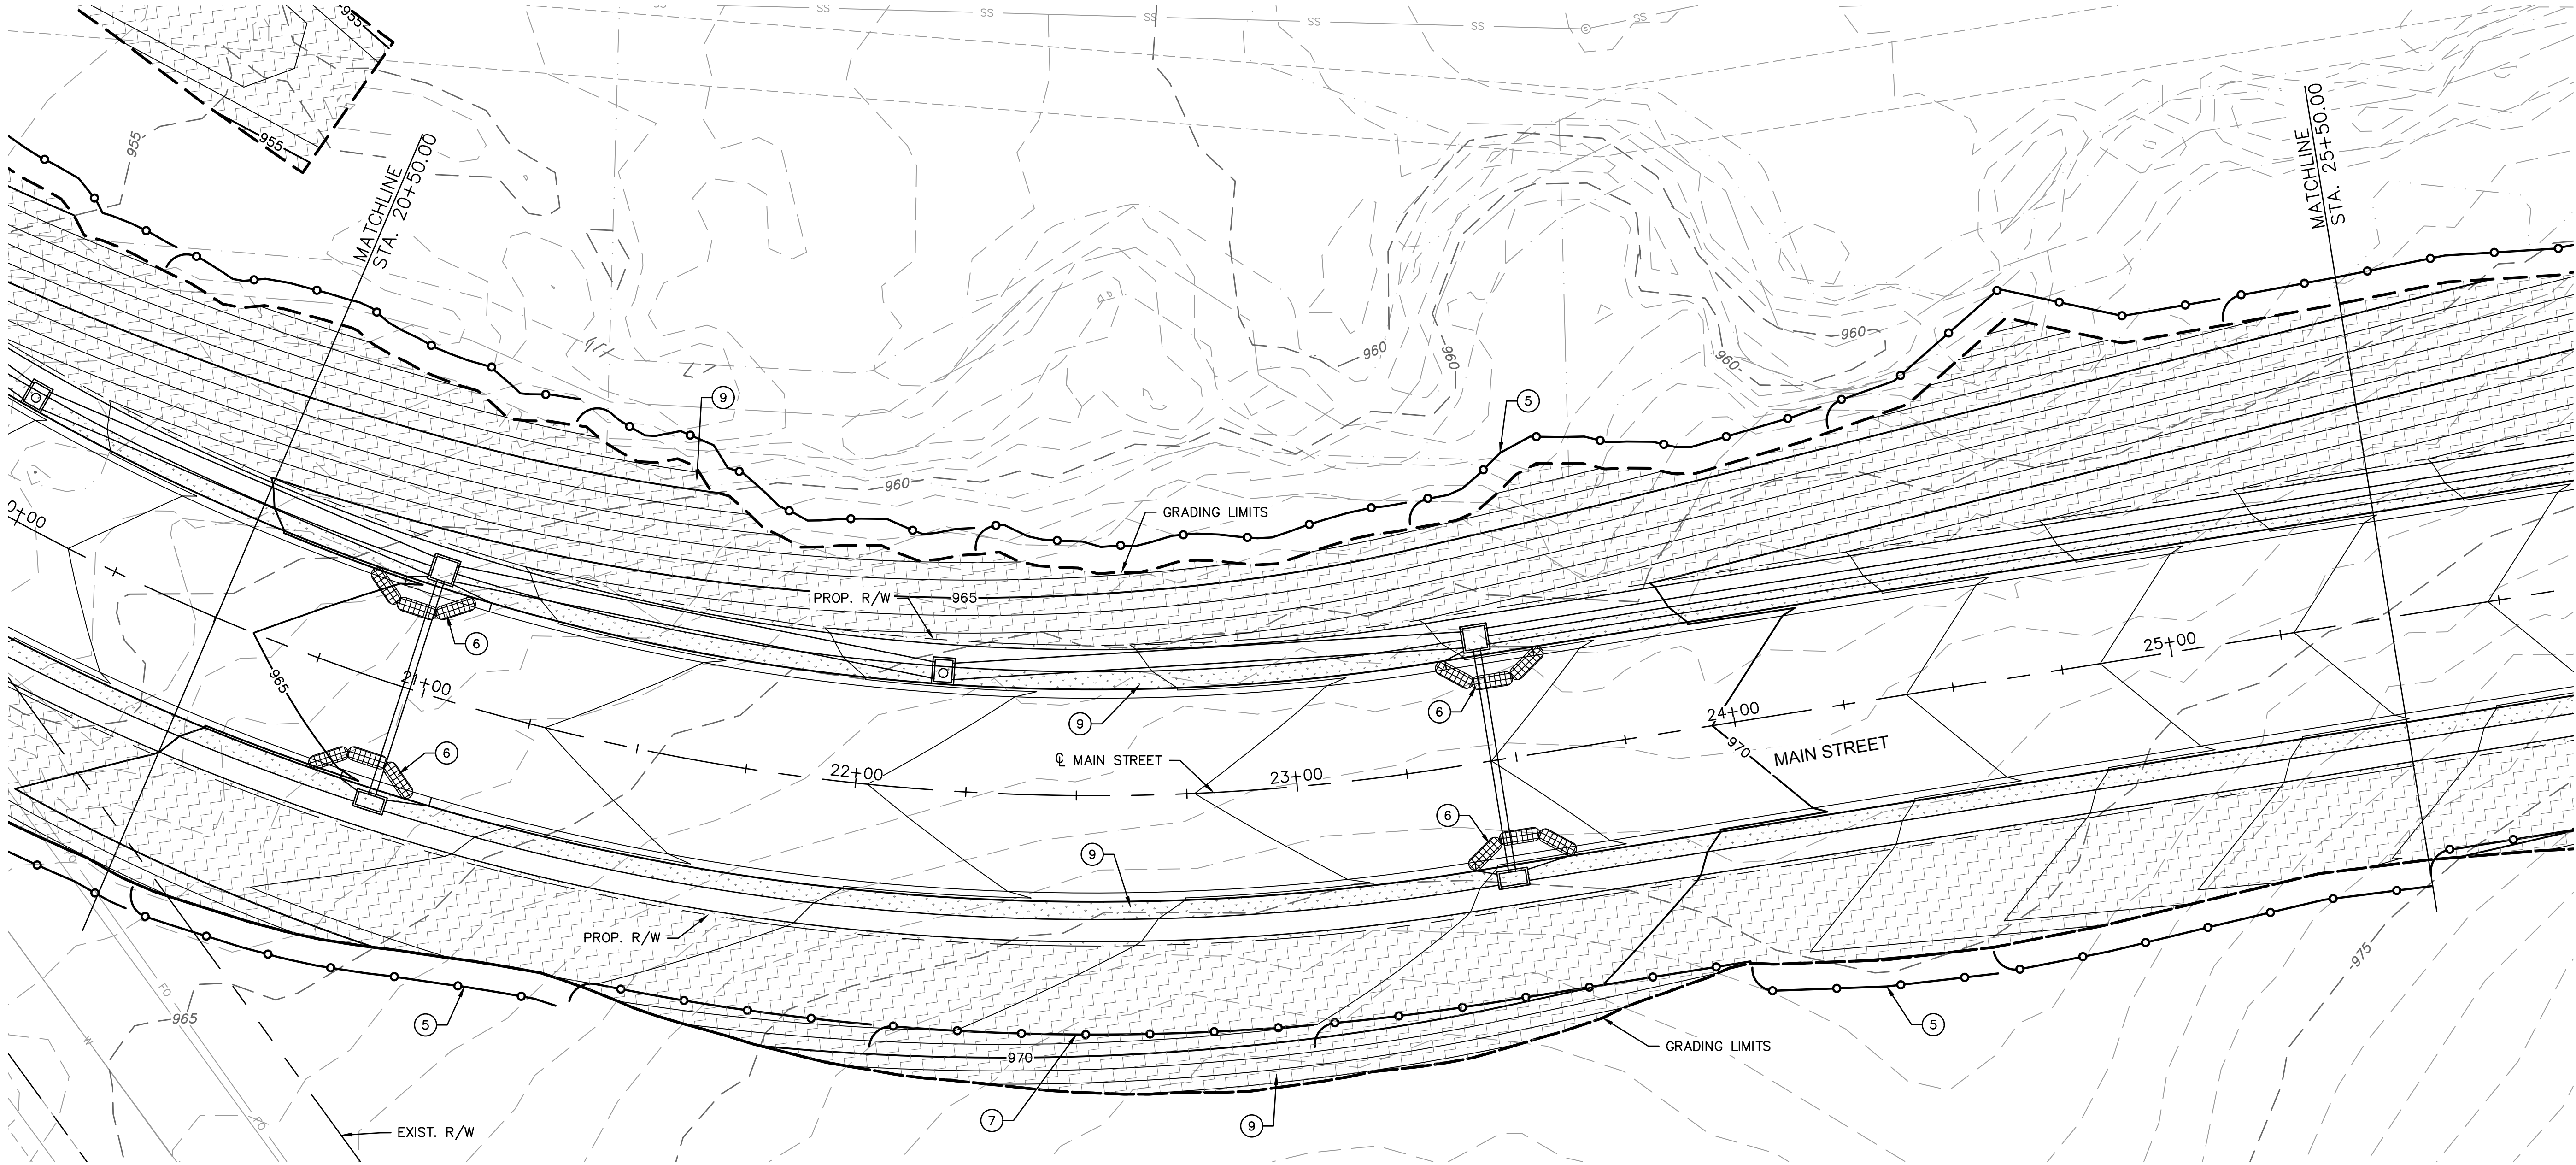

olsson

Olsson Engineering - MO State Certificate of Authority #001592
7301 West 133rd Street, Suite 200 TEL 913.381.1170
Overland Park, KS 66213-4750 FAX 913.381.1174 www.olsson.com

RECORD DRAWINGS

RYAN B. FLEMING
MO. NO. PE-2002003161

REV. NO.	DATE	REVISIONS DESCRIPTION	BY
1	11/16/2021	CITY COMMENTS	ARJ

EROSION CONTROL PLAN


SCANNELL DEVELOPMENT LEE'S SUMMIT LOGISTICS
NORTHWEST CORNER OF TUDOR ROAD AND MAIN STREET
LEE'S SUMMIT, MISSOURI

2021

C.O.A. NO.: _____
DRAWN BY: _____ ARJ/AMW
CHECKED BY: _____ XXX
APPROVED BY: _____ RBE
QA/QC BY: _____ RBE
PROJECT NO.: 021-04157
DWG NO.: T_ERC01_02104157
DATE: 2021-10-12

SHEET
50 OF 105

DWG: F:\2021\04001-04500\021-04157\40-Design\AutoCAD\Final Plans\Sheets\ROBR\T_ERC01_02104157.dwg
DATE: Oct 30, 2023 3:53pm
XREFS: C_PROW_02104157 V_XTOPO_02104157 T_PTBK_02104157 T_PBASE_02104157 V_XBOU_02104157 T_PSTRM_02104157
USER: asaavedra

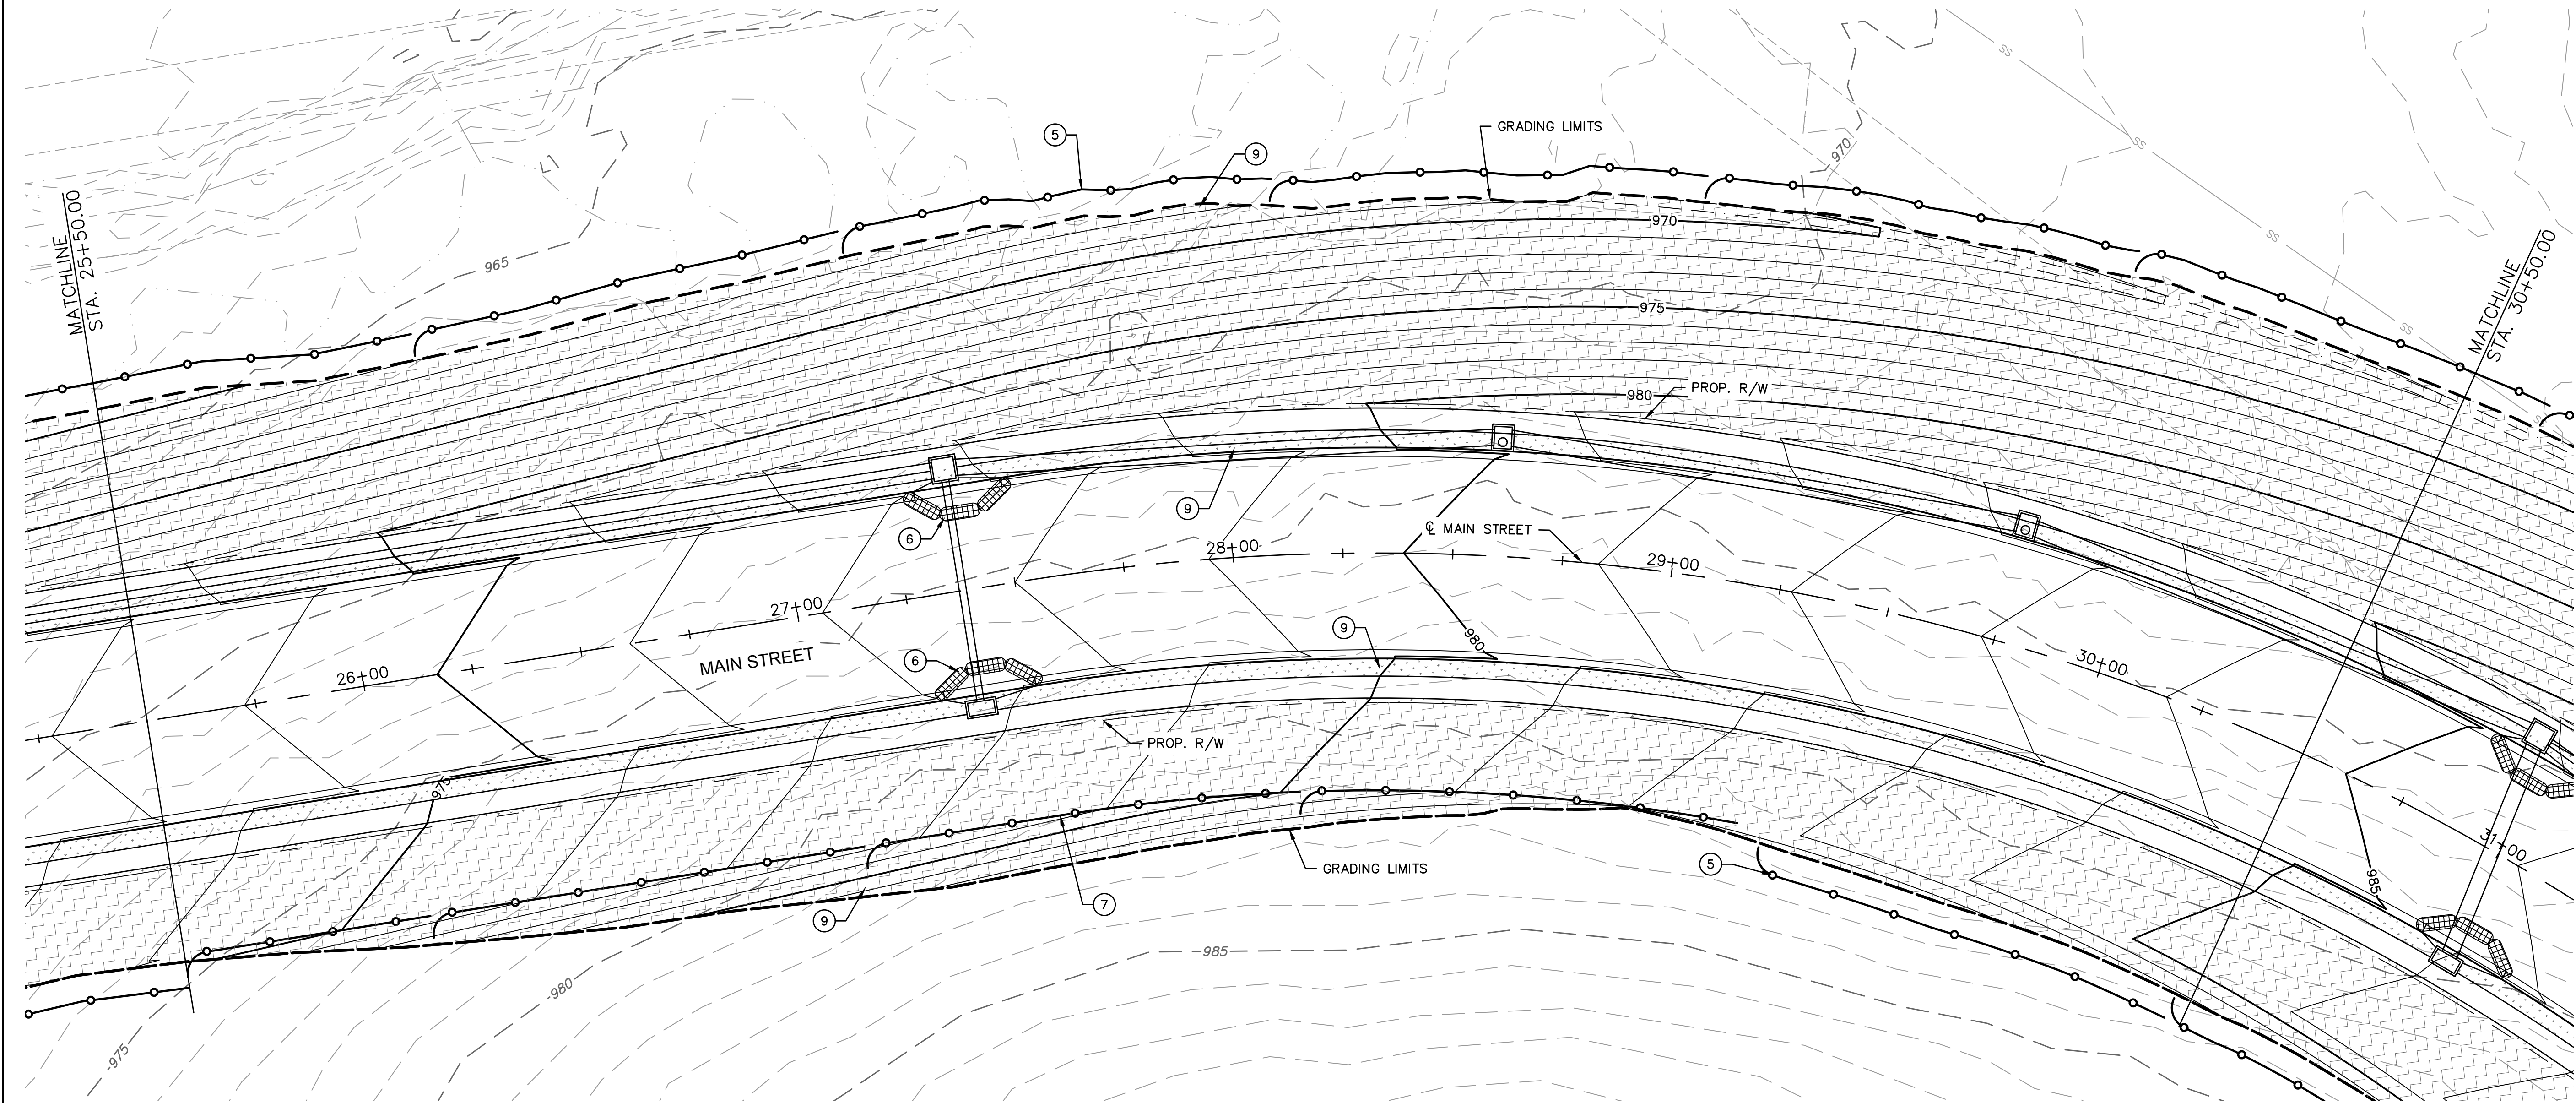

EROSION AND SEDIMENT CONTROL STAGING CHART				
PROJECT STAGE	EROSION CONTROL PLAN BMP REFERENCE NO.	BMP DESCRIPTION	REMOVE AFTER STAGE	NOTES:
I - STORM SEWER AND RCP INSTALLATION PRIOR TO ROADWAY GRADING	1	STAGING AREA	III	
	2	TEMPORARY CONSTRUCTION ENTRANCE	III	
	3	CONCRETE WASHOUT	III	
	4	DIVERSION BERM	IV	INSTALL BEFORE RCB INSTALLATION (SEE SHEET 58)
	5	SILT FENCE/OR BIODEGRADABLE LOGS (9")	IV	
	6	CURB INLET PROTECTION	III	PER CURB INLET DETAIL
II - ROADWAY GRADING & SWALE GRADING	7	SILT FENCE/OR BIODEGRADABLE LOGS (9")	IV	
III - PAVING	8	CURB INLET/AREA INLET PROTECTION	IV	GRAVEL FILTER BAGS
IV - STABILIZE SITE	9	SOD/SEED	N/A	

LEGEND

SILT FENCE

INLET PROTECTION


TEMPORARY ROCK DITCH CHECKS

CONSTRUCTION ENTRANCE

CONCRETE WASHOUT

SOD

SEED

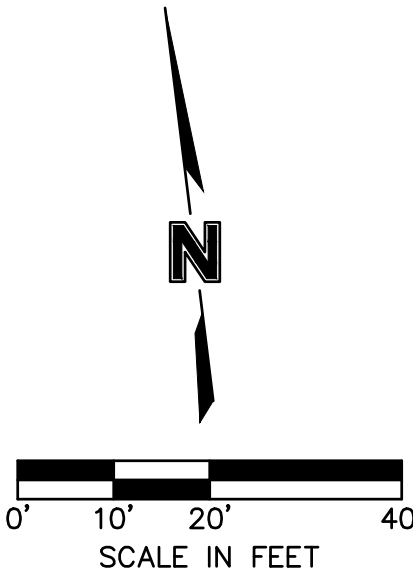

olsson

Olsson Engineering - MO State Certificate of Authority #001592
7301 West 133rd Street, Suite 200
Overland Park, KS 66213-4750
TEL 913.381.1170
FAX 913.381.1174
www.olson.com

RECORD DRAWINGS

RYAN B. FLEMING
MO. NO. PE-2002003161

EROSION CONTROL PLAN



SCANNELL DEVELOPMENT LEE'S SUMMIT LOGISTICS
NORTHWEST CORNER OF TUDOR ROAD AND MAIN STREET
LEE'S SUMMIT, MISSOURI

C.O.A. NO.:
DRAWN BY: ARJ/AMW
CHECKED BY: XXX
APPROVED BY: RBE
QA/QC BY: RBE
PROJECT NO.: 021-04157
DWG NO.: T_ERC01_02104157
DATE: 2021-10-12



SHEET 51 OF 105

2021

DWG: F:\2021\04001-04500\021-04157\40-Design\AutoCAD\Final Plans\Sheets\ROBR\T_ERC01_02104157.dwg
DATE: Oct 30, 2023 3:54pm
XREFS: C_PROW_02104157 V_XTOP_02104157 T_PTBK_02104157 T_PBASE_02104157 V_XBOU_02104157 T_PSTRM_02104157
USER: asaavedra

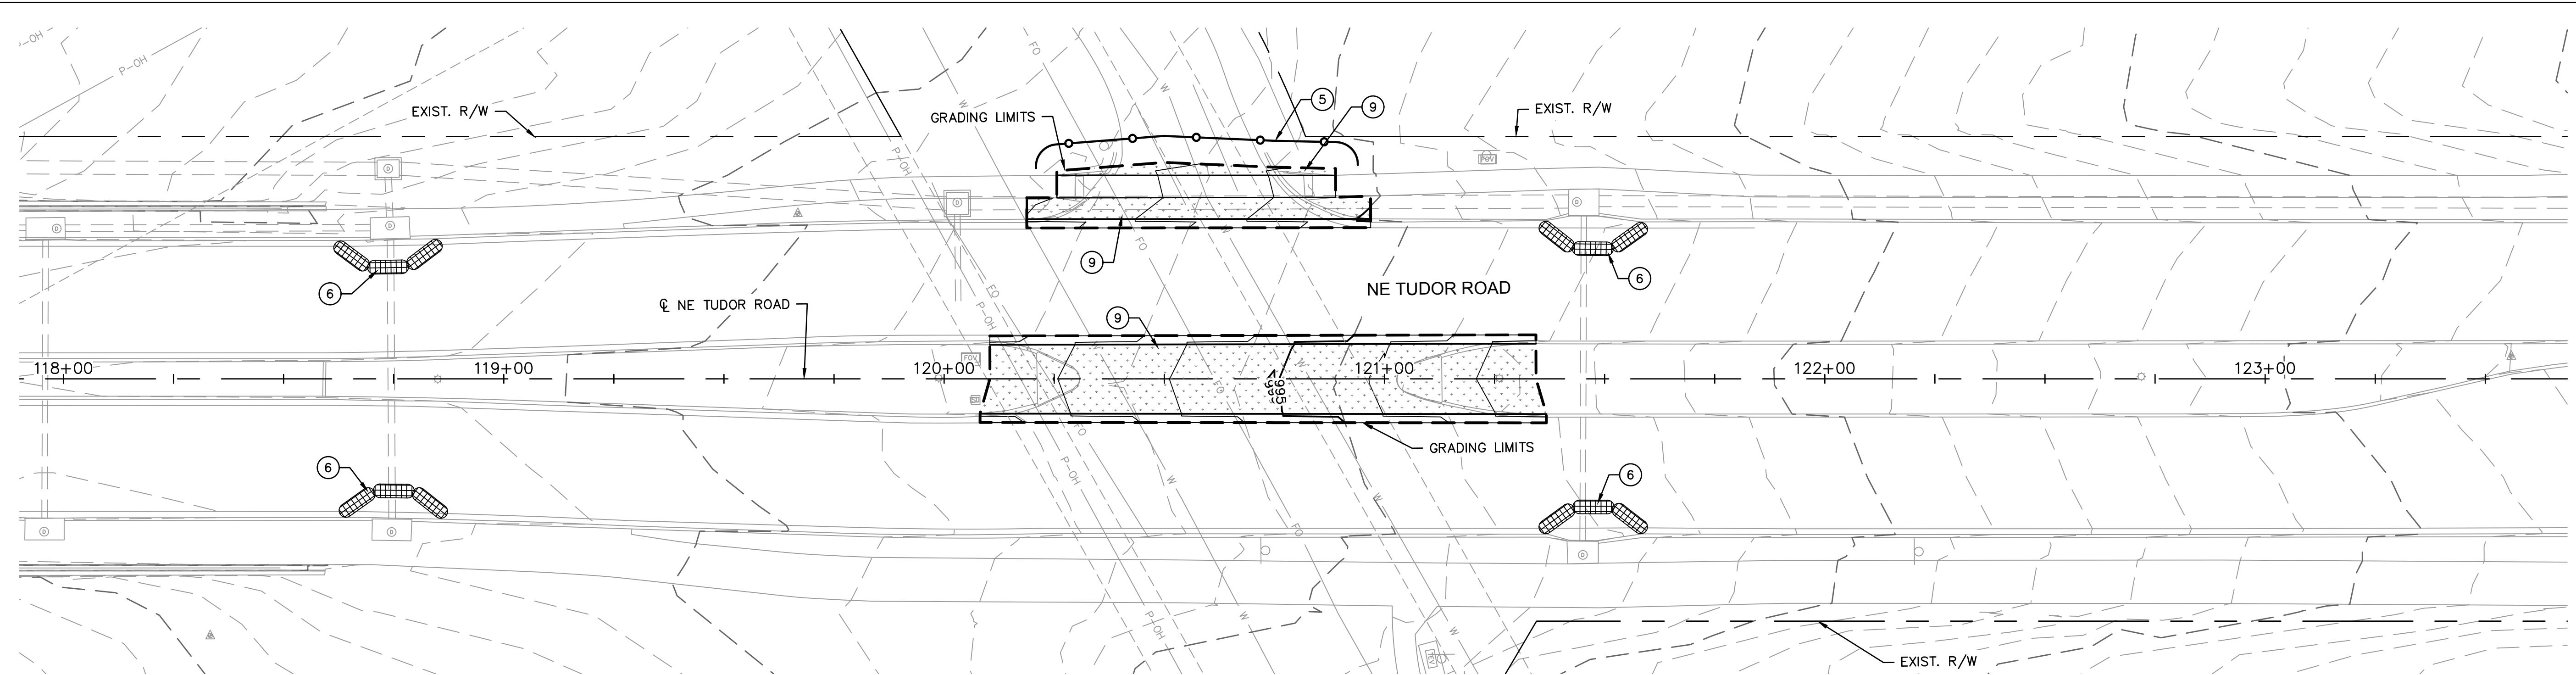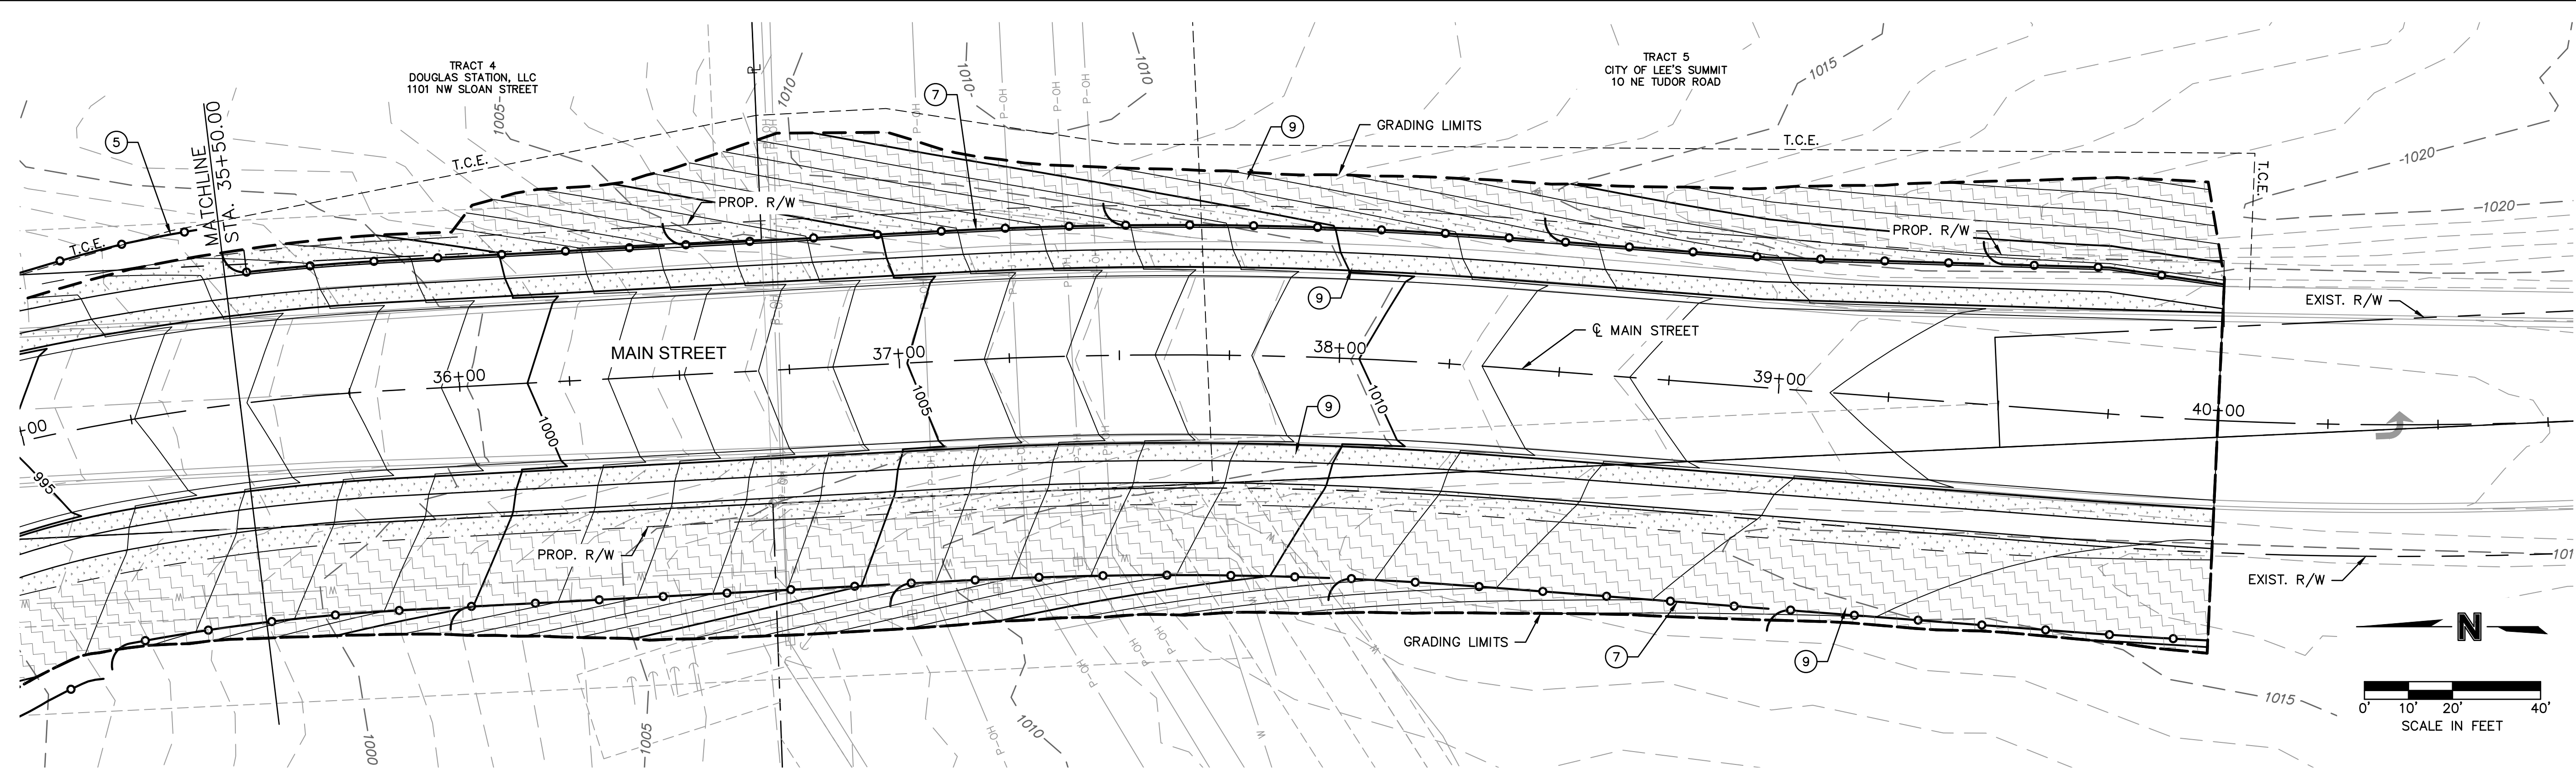

EROSION AND SEDIMENT CONTROL STAGING CHART				
PROJECT STAGE	EROSION CONTROL PLAN BMP REFERENCE NO.	BMP DESCRIPTION	REMOVE AFTER STAGE	NOTES:
I - STORM SEWER AND RCP INSTALLATION PRIOR TO ROADWAY GRADING	1	STAGING AREA	III	INSTALL BEFORE RCB INSTALLATION (SEE SHEET 58)
	2	TEMPORARY CONSTRUCTION ENTRANCE	III	
	3	CONCRETE WASHOUT	III	
	4	DIVERSION BERM	IV	
	5	SILT FENCE/OR BIODEGRADABLE LOGS (9")	IV	
	6	CURB INLET PROTECTION	III	
II - ROADWAY GRADING & SWALE GRADING	7	SILT FENCE/OR BIODEGRADABLE LOGS (9")	IV	PER CURB INLET DETAIL
III - PAVING	8	CURB INLET/AREA INLET PROTECTION	IV	GRAVEL FILTER BAGS
IV - STABILIZE SITE	9	SOD/SEED	N/A	

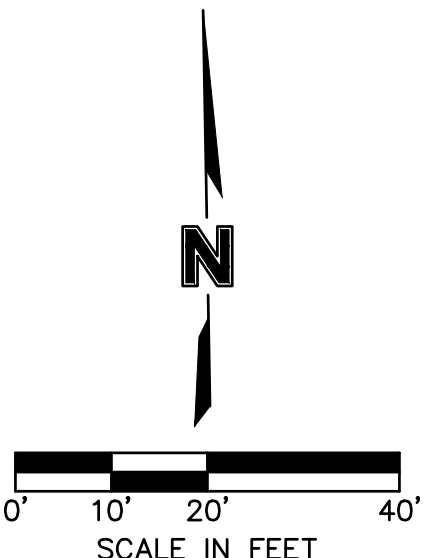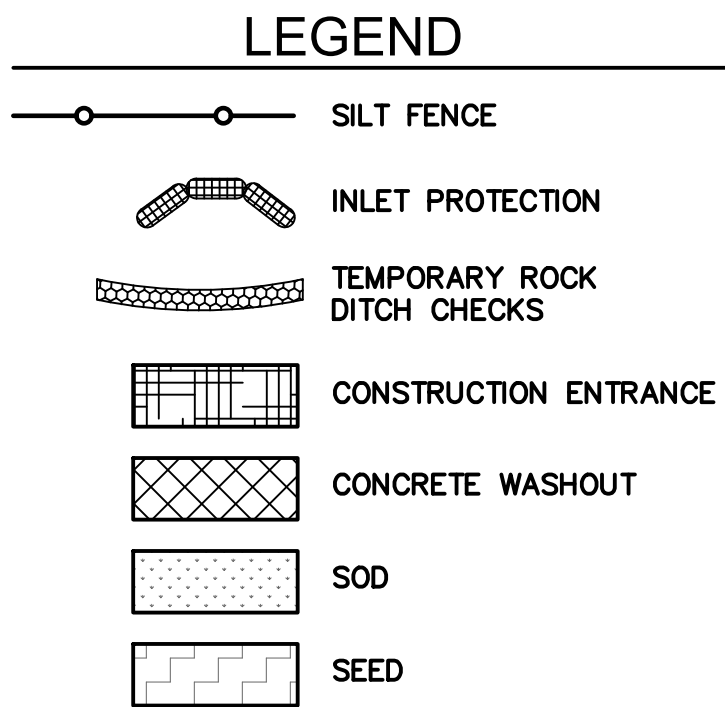

Olsson Engineering - MO State Certificate of Authority #001592
7301 West 133rd Street, Suite 200 TEL 913.381.1170
Overland Park, KS 66213-4750 FAX 913.381.1174 www.olsson.com

RECORD DRAWINGS

RYAN B. FLEMING
MO. NO. PE-2002003161

REV. NO.	DATE	REVISIONS DESCRIPTION	CITY COMMENTS
1	11/16/2021		

EROSION CONTROL PLAN


SCANNELL DEVELOPMENT LEE'S SUMMIT LOGISTICS
NORTHWEST CORNER OF TUDOR ROAD AND MAIN STREET

LEE'S SUMMIT, MISSOURI

2021

C.O.A. NO.:
DRAWN BY: ARJ/AMW
CHECKED BY: XXX
APPROVED BY: RBE
QA/QC BY: RBE
PROJECT NO.: 021-04157
DWG NO.: T_ERC01_02104157
DATE: 2021-10-12

SHEET
53 OF 105

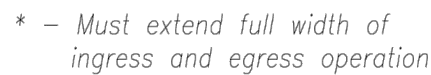

Not to Scale




Not to Scale




Not to Scale

SHEET
54 OF 105

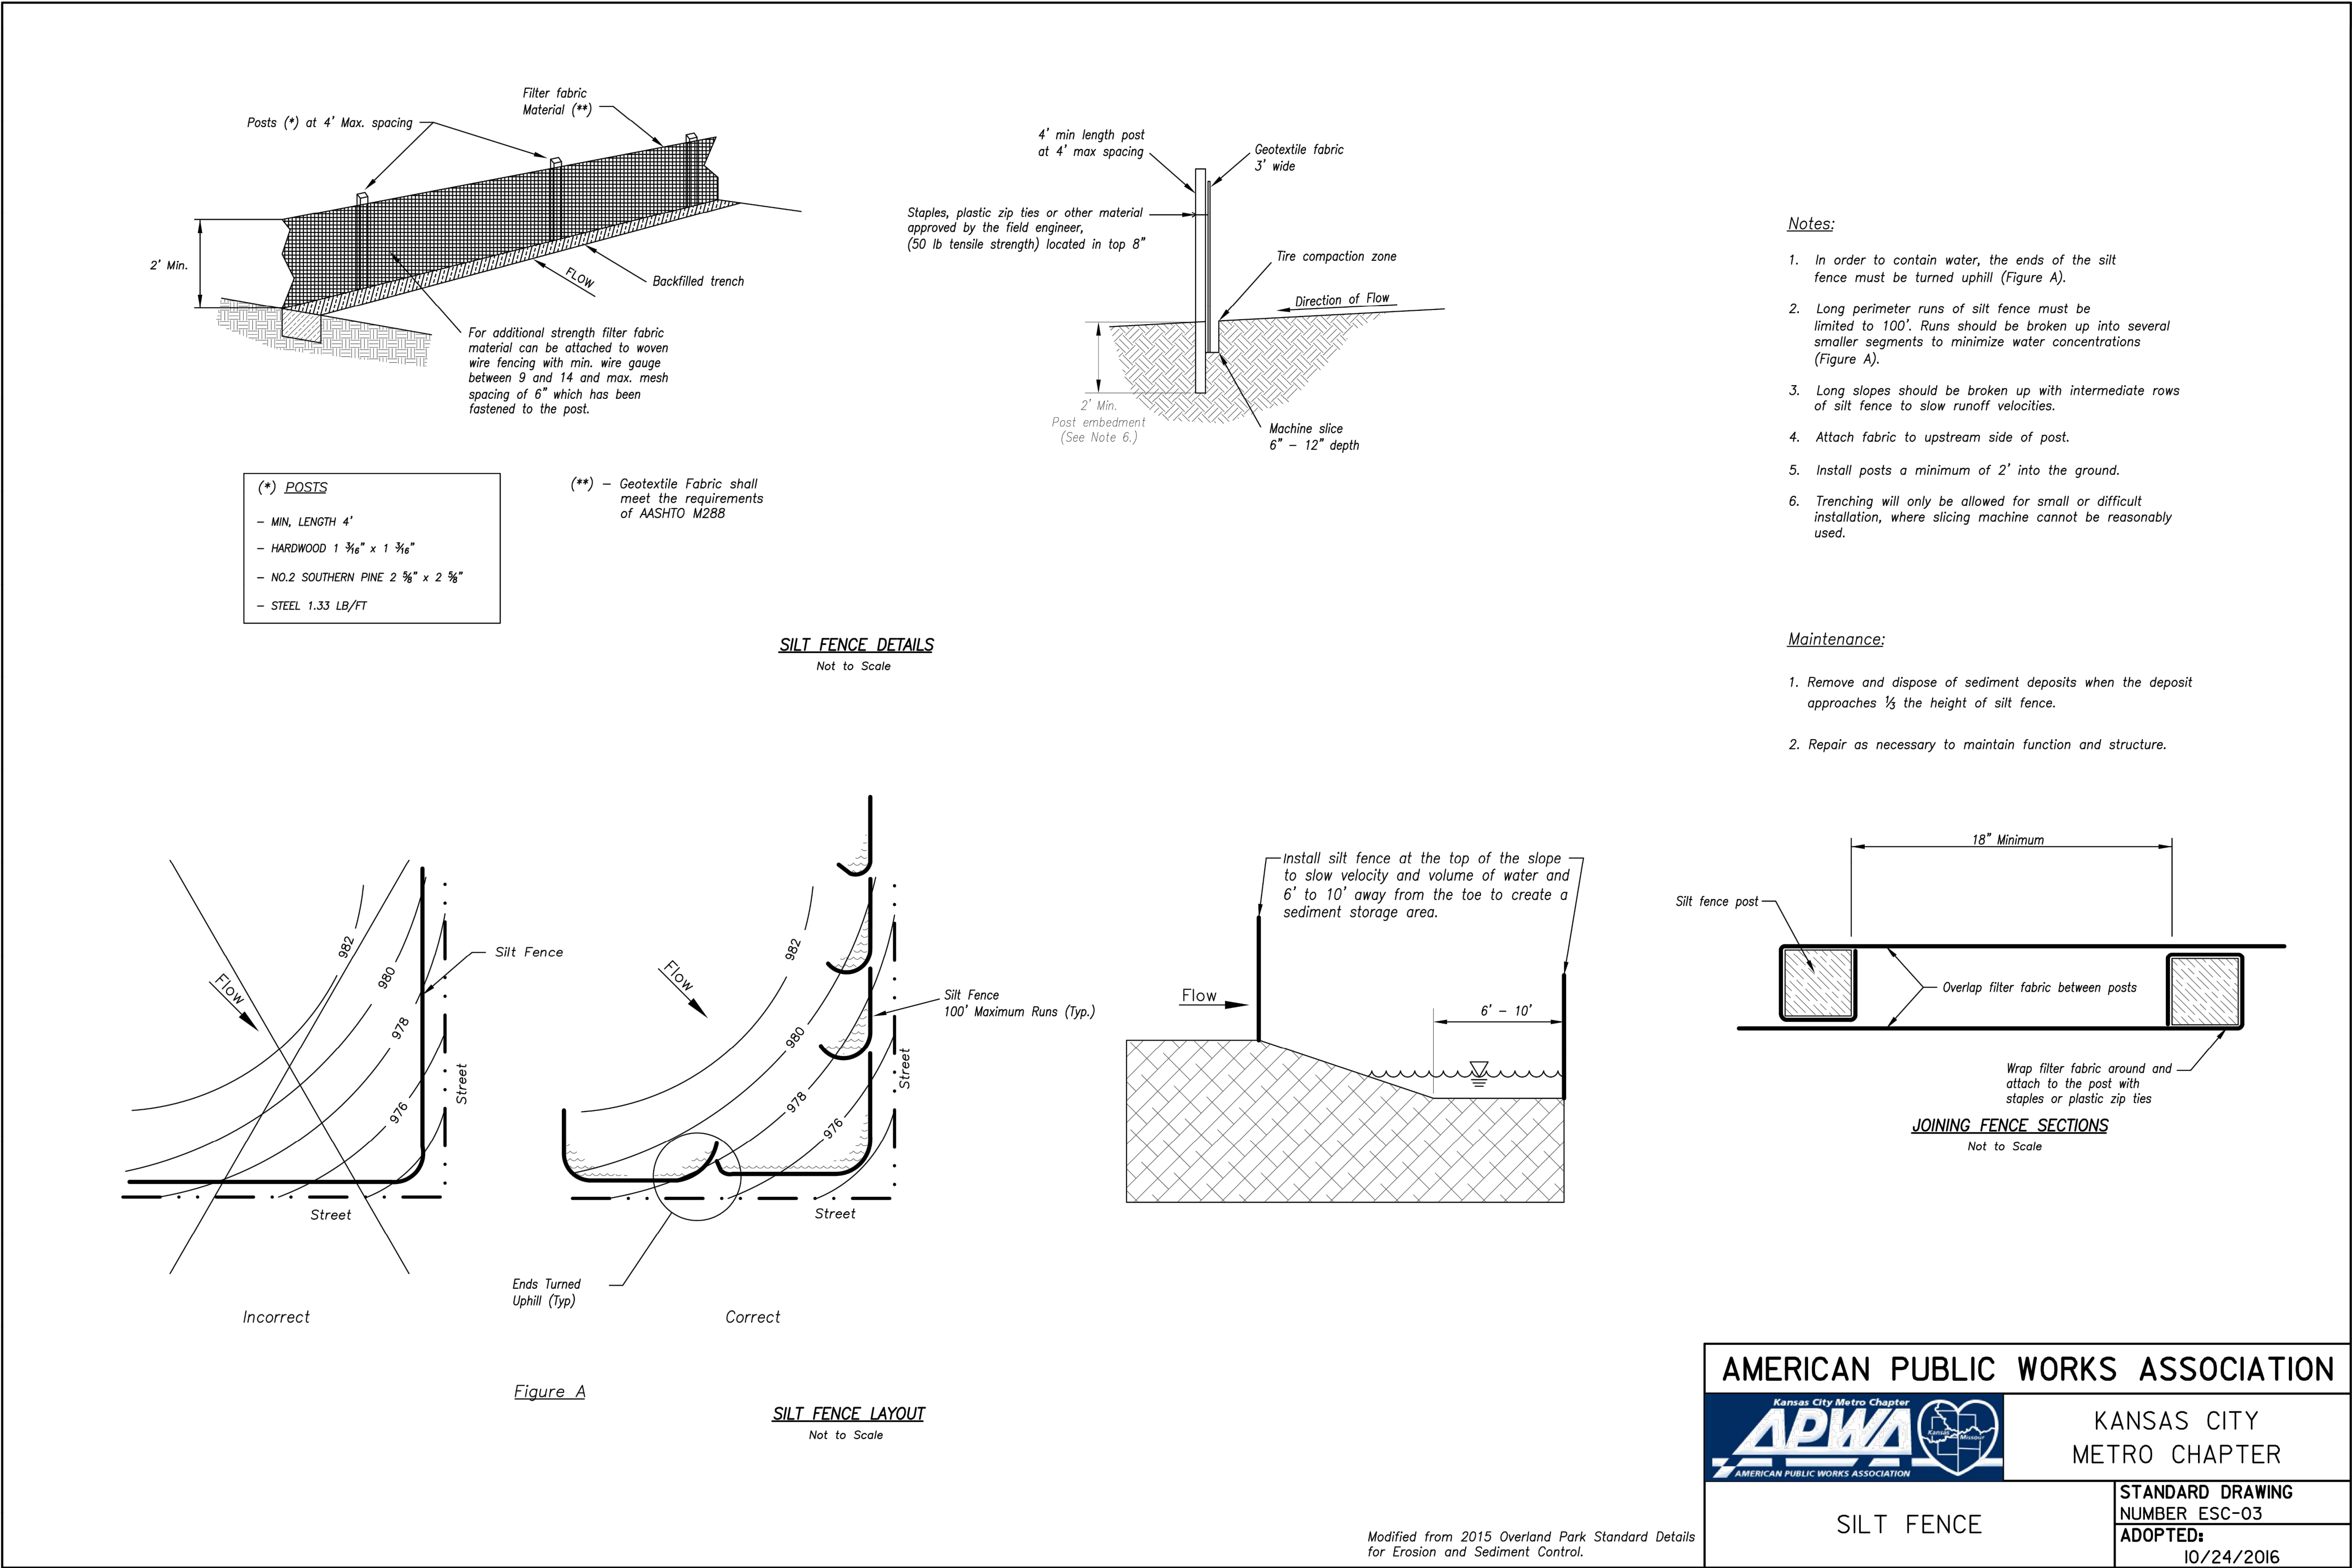

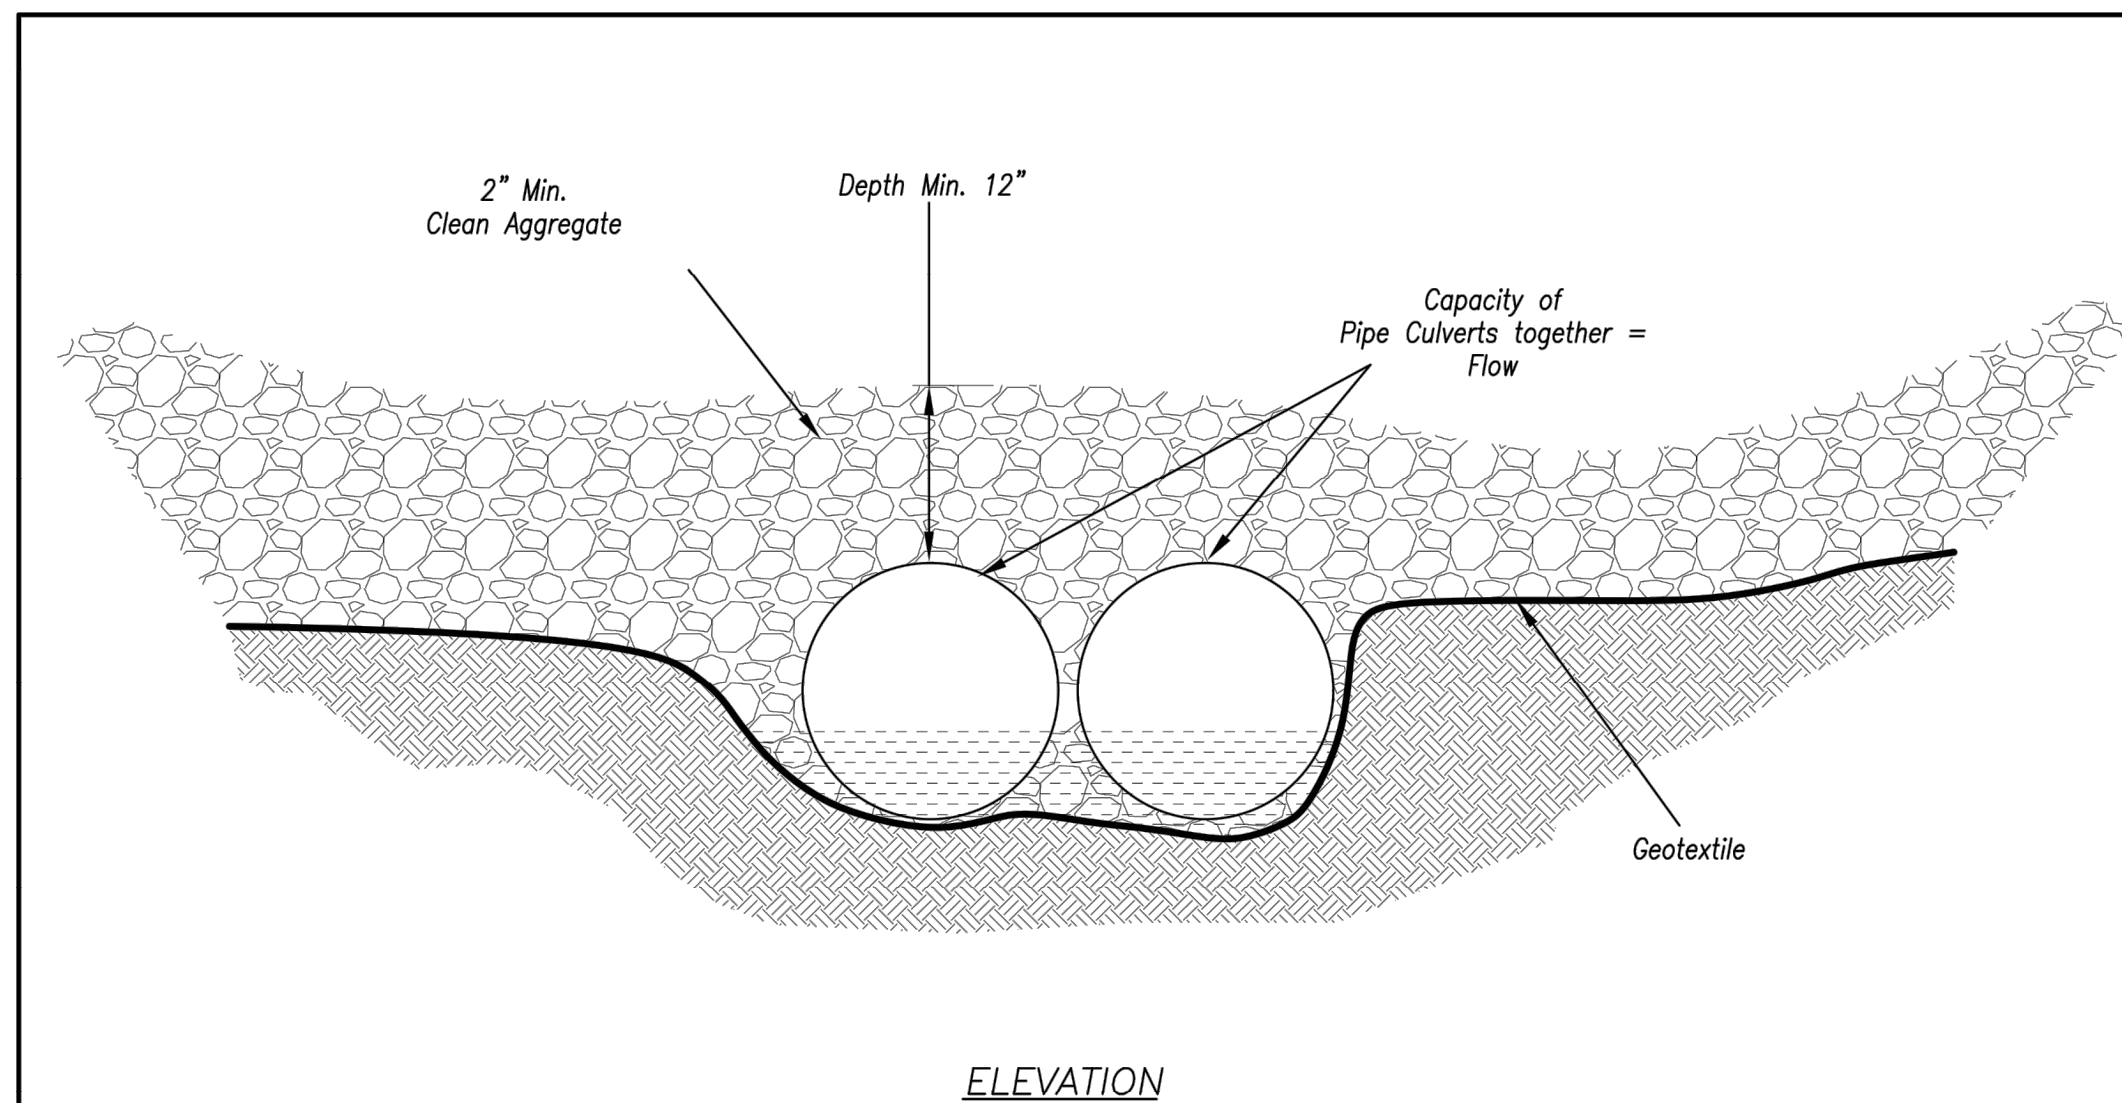


ELEVATION

Maintenance:

1. Repair stream bank erosion by stabilizing with erosion control BMPs such as erosion control blankets.
2. For in-stream degradation, armor the culvert outlet(s) with riprap to dissipate energy.
3. If sediment or debris is accumulating upstream of the crossing, remove as needed to maintain the functionality of the crossing.
4. If a temporary crossing is requiring excessive maintenance, replacement with a larger culvert or alternate design may be necessary.


- Notes for Temporary Stream Crossing:

1. Clearing and excavation of the stream bed and banks shall be kept to a minimum.
2. Place one pipe, buried 6" into the stream bottom, at the lowest point of the channel to allow the passage of aquatic organisms. Additional pipes shall be placed along the remainder of the stream channel bottom such that ordinary high water (OHW) flows designated in the Contract Documents shall flow through the pipes without overtopping the crossing.
(See Specification for more information).
3. Geotextile shall be placed on the streambed and streambanks prior to placement of the pipe culvert and aggregate. The geotextile shall cover the streambed and extend a minimum of 6 inches and a maximum of 1 foot beyond the end of culvert and bedding material. Filter cloth reduces settlement and improves crossing stability.
4. The culvert shall extend a minimum of 1 foot beyond the upstream and downstream toe of the aggregate placed around the culvert. In no case shall the culvert exceed 40 feet in length.
5. The culvert shall be covered with a minimum of 1 foot of aggregate. If multiple culverts are used, they shall be separated by at least 12" of compacted aggregate fill.
6. As soon as crossing no longer needed, all structures including culverts, bedding and geotextile materials shall be removed. Removal of the structure and clean-up of the area shall be accomplished without construction equipment working in the channel.
7. Upon removal of the structure, the stream and banks shall immediately be shaped to its original cross-section and properly stabilized. Take care to minimize the amount of sediment lost into the stream.

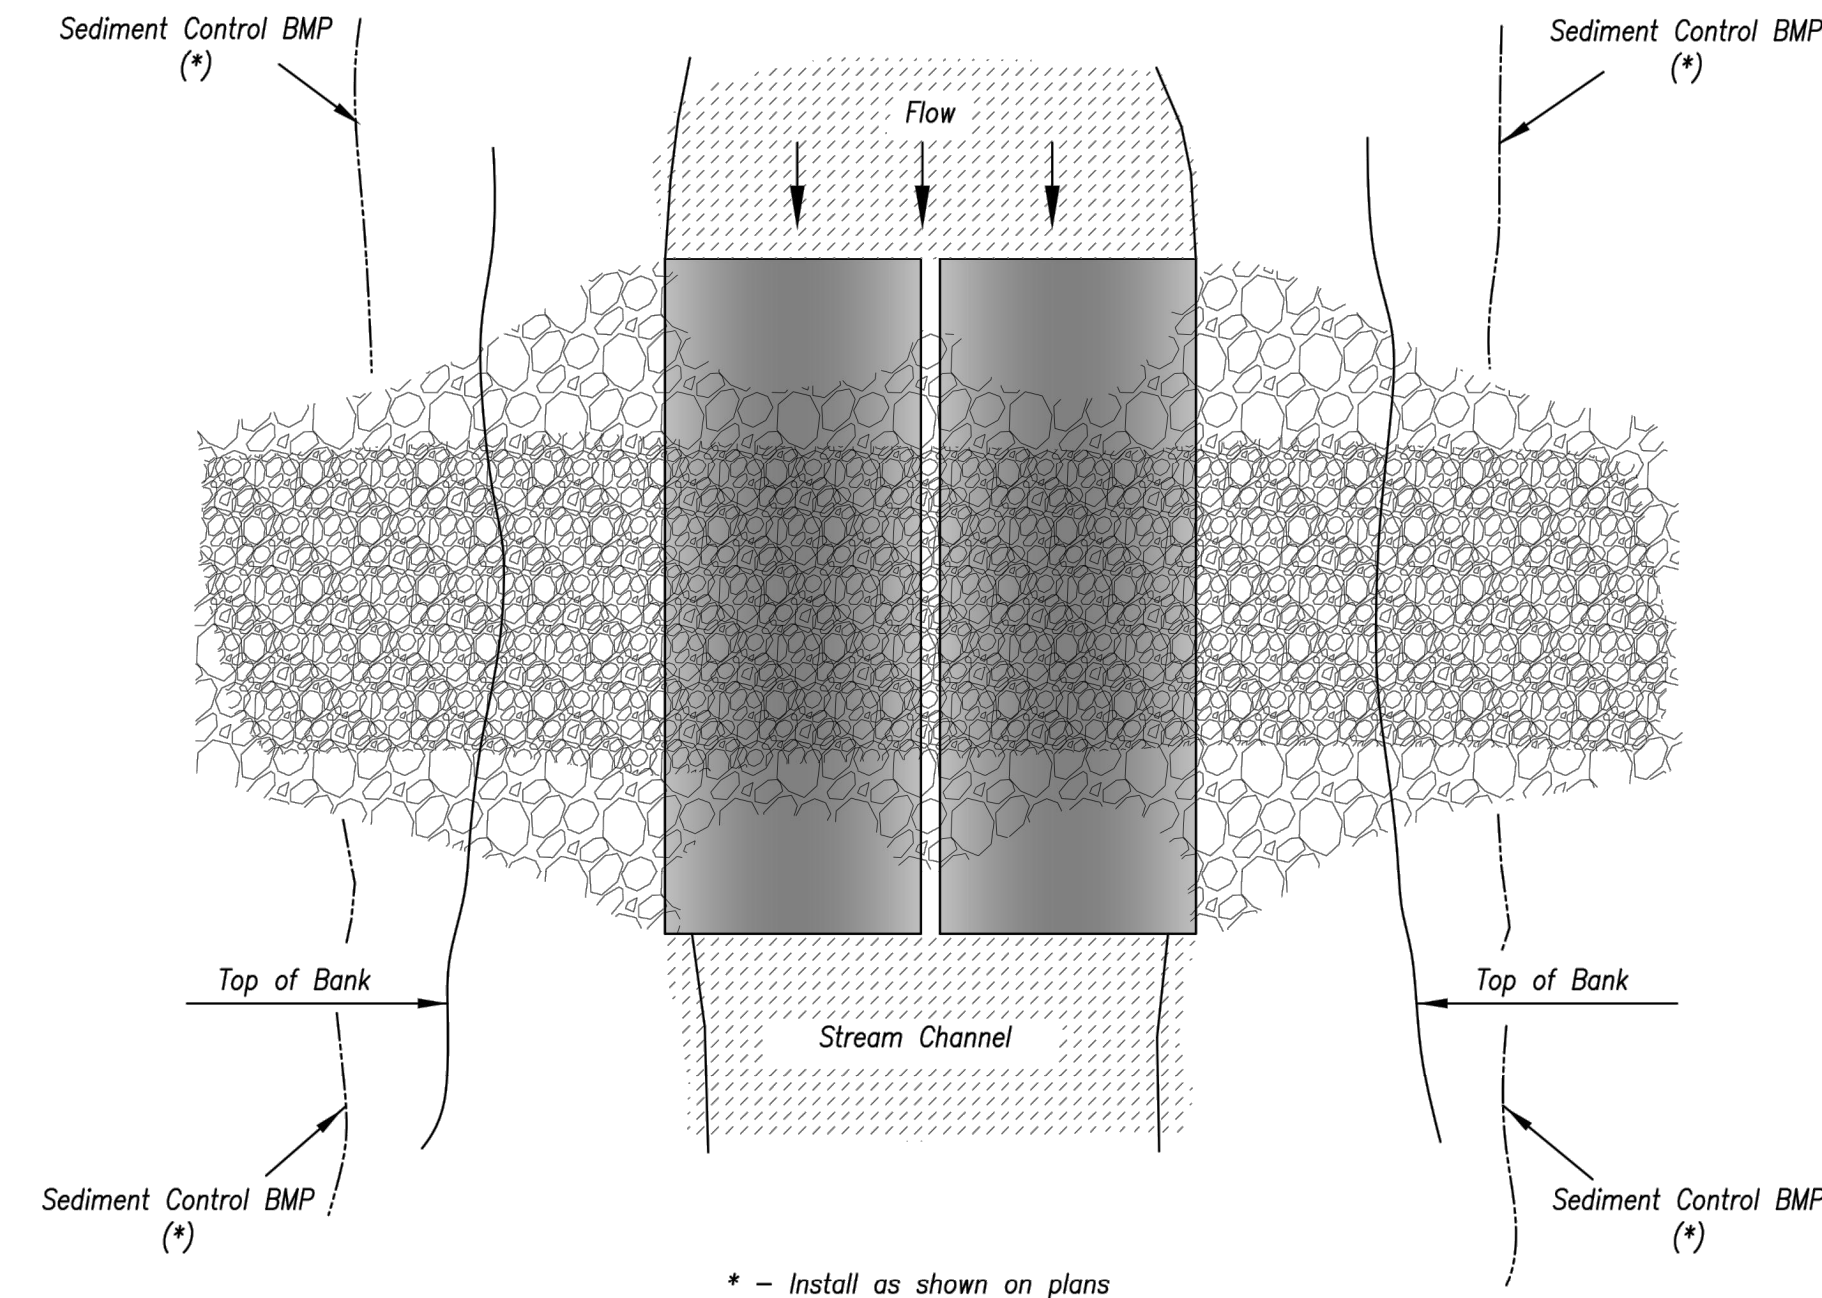

PLAN VIEW

TEMPORARY STREAM CROSSING

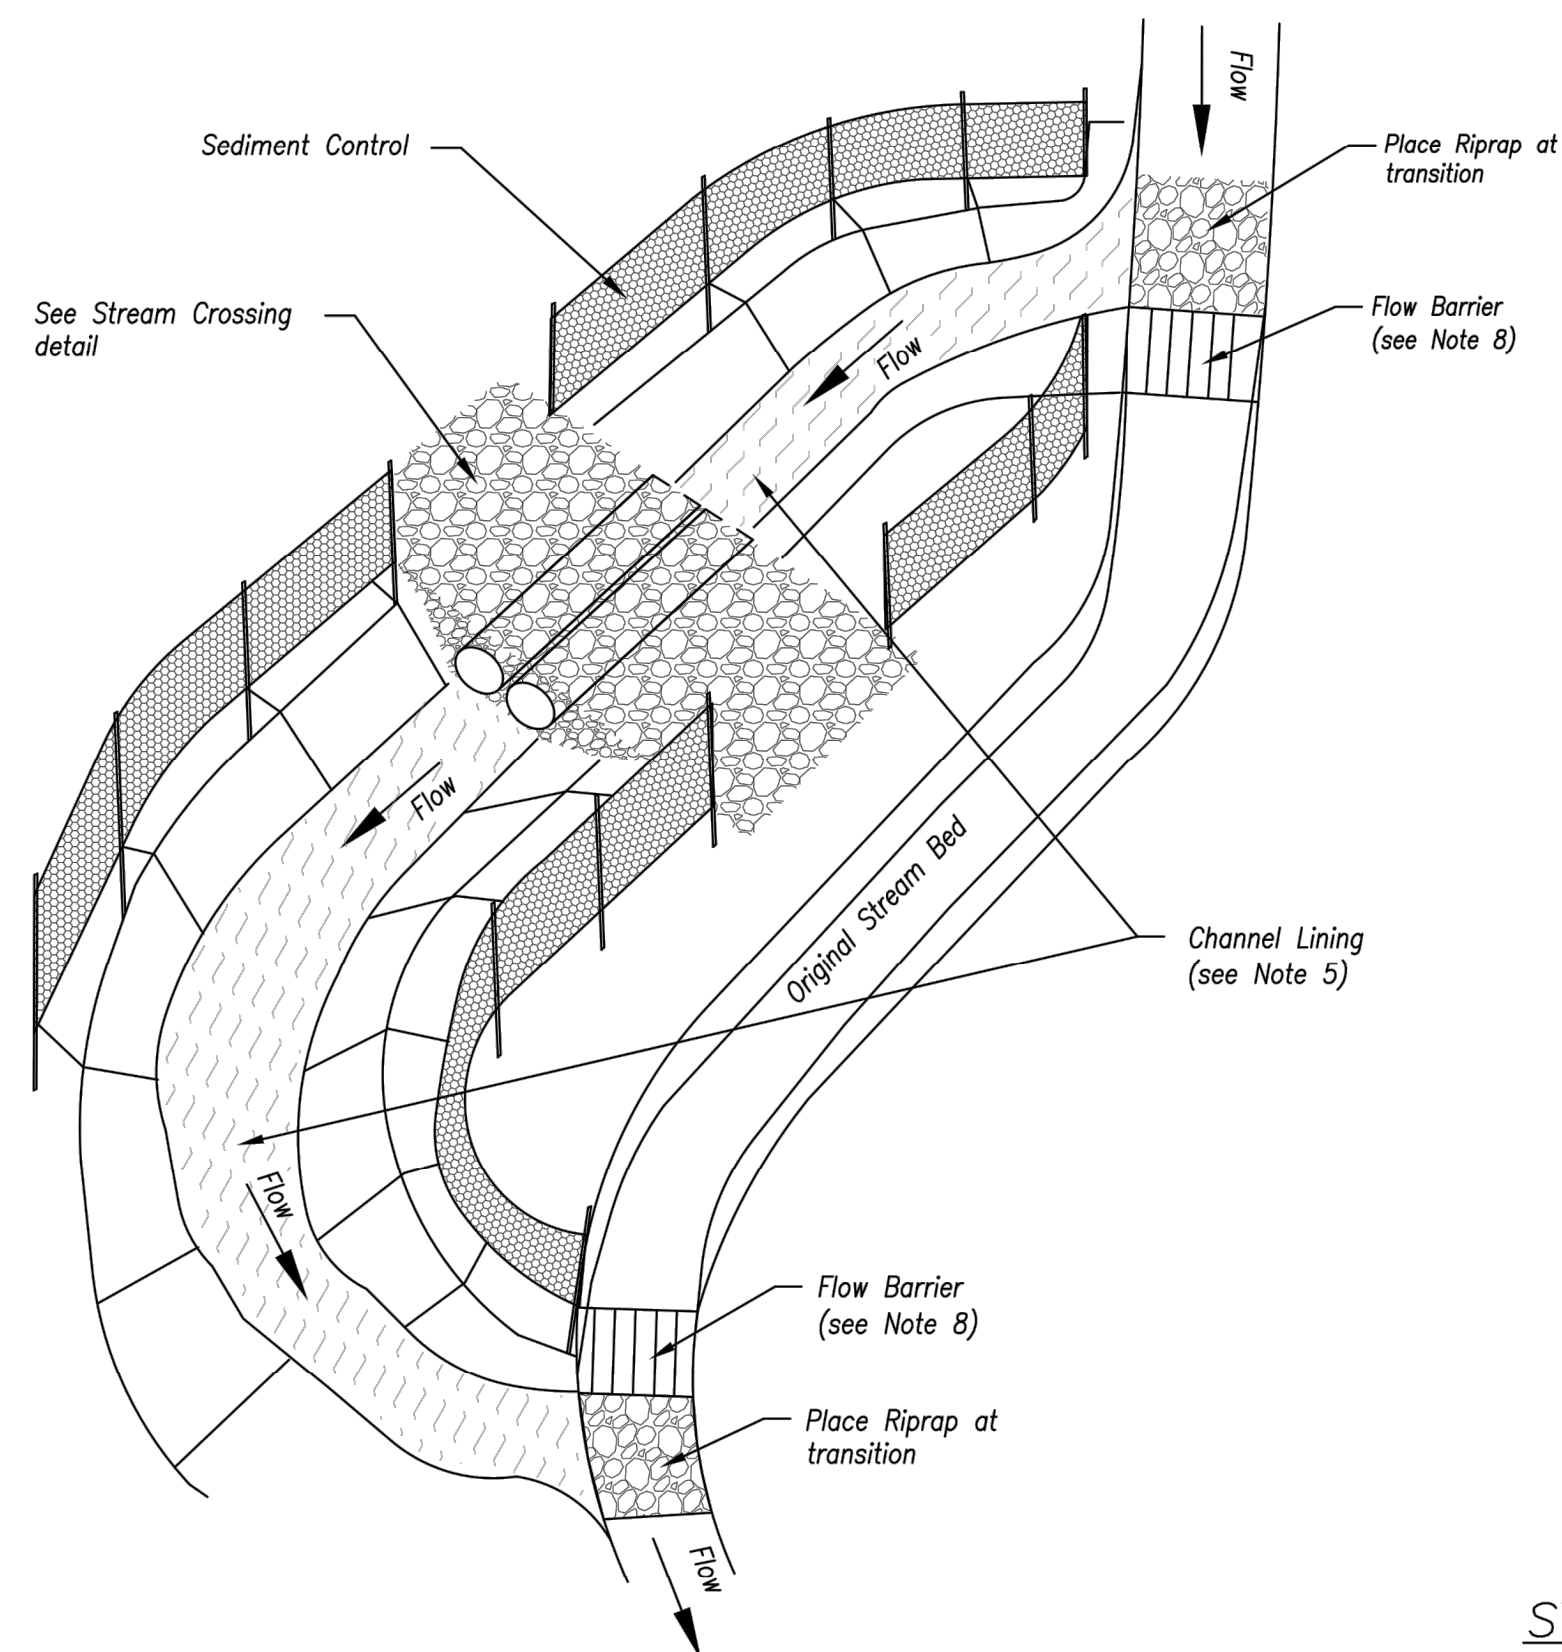


- Notes for Temporary Diversion Channel:

1. The diversion channel crossing must be operational before work is done in the stream. Construction will be performed in the dry.
2. Minimum width of bottom shall be 6 feet or equal to bottom width of existing streambed, whichever is less.
3. Maximum steepness of side slopes shall be 2H:1V. Depth and grade may be variable, dependent on site conditions, but shall be sufficient to ensure continuous flow of water in diversion.
4. Channel must be lined with riprap or turf reinforcement mat depending on the expected velocity and shear stress in the channel.
5. Stream diversion liners shall be secured at the upstream and downstream sides with non-erodible weights such as riprap. These weights shall allow normal flow of the stream. Soil shall not be mixed with stream diversion weights. Weights may also be needed along the diversion's length to secure liner.
6. Stream diversion liners shall be entrenched at the top of slopes along with a sediment control BMP.
7. Non-erodible materials such as riprap, Jersey barriers, sand bags, plywood, or sheet piling shall be used as flow barriers to divert the stream away from it's original channel and prevent or reduce water backup into the construction area.
8. Stream diversion liners shall be re-diverted only after backfilling and re-stabilization of original streambed and banks is completed.

STREAM DIVERSION CHANNEL

Modified from 2015 Overland Park Standard Details
for Erosion and Sediment Control.

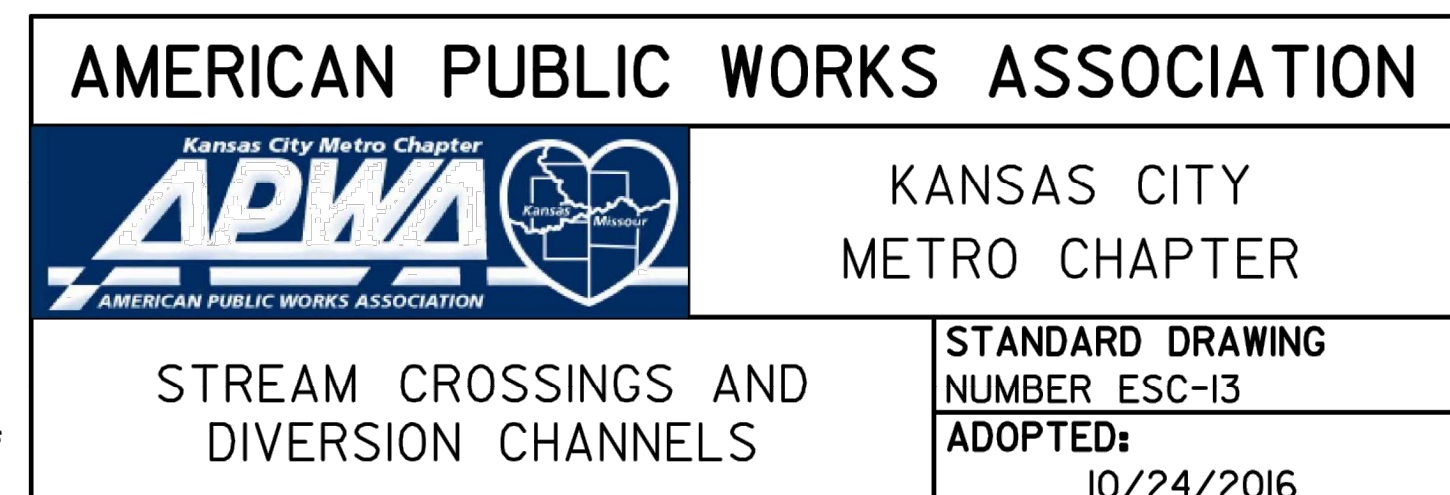

RECORD
DRAWINGS

RYAN B. FLEMING
MO. NO. PE-2002003161

[illegible]

EROSION CONTROL DETAILS

SCANNELL DEVELOPMENT LEE'S SUMMIT LOGISTICS
NORTHWEST CORNER OF TUDOR ROAD AND MAIN STREET

LEE'S SUMMIT, MISSOURI

2021

C.O.A. NO.: _____
DRAWN BY: _____ ARJ/AMW
CHECKED BY: _____ XXX
APPROVED BY: _____ RBF
QA/QC BY: _____ RBF
PROJECT NO.: _____ 02104157
DWG NO.: T_ERCD_02104157
DATE: _____ 2021-10-12

DWG: F:\2021\04001-04500\021-04157\40-Design\AutoCAD\Final Plans\Sheets\JTFC\F_LGT_02104157.dwg
DATE: Oct 30, 2023 3:54pm
USER: asoavedra
T_PSTRM_02104157
F_PTBK_02104157
C_PROW_02104157
F_LGTBASE_02104157

GENERAL NOTES:

- The contractor shall have one (1) signed copy of the plans (approved by the City of Lee's Summit) and one (1) copy of the appropriate Design and Construction Standards and Specification at the job site at all times.
- Construction of the improvements shown or implied by this set of drawings shall not be initiated or any part thereof undertaken until the Director of Public works or his designee is notified of such intent, and all required and properly executed bonds and contract agreements are received and approved by the City. The Contractor shall notify the inspector of the exact construction schedule so that inspections of the street light installation can be made.
- The Construction covered by these plans shall conform to all applicable standards and specifications of the Public Works Department of the City of Lee's Summit, Missouri, in current use. Specifically, but not exclusive to: Street Lighting Specification: Section 2800. Street Lighting Standard Drawings: SL-1 through SL-5.
- All workmanship and materials shall be subject to the inspection and approval of the Public Works Department of the City of Lee's Summit, Missouri.
- All traffic control in conjunction with the street lighting construction shall be in conformance with the Manual on Uniform Traffic Control Devices (MUTCD) and the City's Standard Drawings sheet "Typical Traffic Control for Street Lighting Construction".
- The Contractor shall, by his own investigation, and prior to commencing work, satisfy himself as to the surface and subsurface conditions to be encountered. No additional payments will be made for excavation of rock and backfill materials.
- Existing underground (U/G), overhead (O.H.) utilities, and drainage structures have been plotted from available information and therefore their locations must be considered approximate only. It is the responsibility of the individual Contractor to exactly locate each utility before actual construction, and be fully responsible for any and all damages, which might be occasioned by the Contractor's failure to exactly locate and preserve any and all utilities. In addition, the Contractor shall avoid disruption of services provided by the utilities and shall insure that proper clearances (overhead and underground) are maintained for the duration of construction. See cover sheet for utility company contact information.
- The Contractor shall stake the location of all street lighting poles, power supplies, and junction or pull boxes to be installed. The Engineer or his designee shall inspect the staking prior to any excavation and/or construction. Minor relocation of equipment to avoid conflicts may be allowed with the approval of the Engineer or his designee.
- All street light poles, conduit, junction or pull boxes, and power supplies shall be located within the City's right-of-way or general utility easements.
- Screw-in anchor foundations have been assumed for all areas, unless otherwise noted in the plans. In the event a screw-in anchor may not be installed, then the Contractor may, at his own option, install the screw-in anchor within a pre-drilled hole, or pour a concrete foundation. No change in payment shall be made for foundation substitutions. All pre-drilled holes shall be backfilled with flowable backfill. All conduit trenches shall be backfilled with earth or AB-3 and properly compacted in accordance with the Specifications. The top 4" to 6" of backfill shall be topsoil.
- Factory conduit bends (PVC 90-degree elbows) shall be installed into all pole bases, junction boxes, pull boxes, and power supplies. Couplings shall be used to transition between HDPE and PVC conduits.
- Galvanized Rigid Steel (GRS) conduit is to be used if conduit is to be installed on a structure. All GRS conduits that are to be used shall be cleaned by the Contractor with a mandrel prior to installation of cable.
- Contractor shall install a 2-1/2" PVC (Schedule 40) conduit with pull string to the base of the secondary service point. Contractor shall coordinate secondary service hook-up with the electrical utility company.
- Bracket arms shall be oriented perpendicular to the roadway unless otherwise indicated on the plans.
- All splices to the distribution cable shall be made with junction boxes, pull boxes, or pole bases using required connectors. Splices will only be allowed in junction or pull boxes where a circuit branches. All splices in boxes shall be protected with a waterproof resin splice kit.
- All distribution cables in junction boxes, pull boxes, and power supplies shall be labeled with round aluminum identification tags attached to the cables with copper wire. The power supply and circuit number shall be stamped or engraved on each tag.
- All grounding requirements and National Electric Code requirements shall be met for the street lighting installation to prevent any hazards to the public.
- All existing street lighting equipment to be used in place (U.I.P.) unless otherwise noted. Damage to any existing street lighting equipment due to the construction shall be the responsibility of the Contractor. The equipment shall be replaced or repaired (as directed by the City) with materials equal or better than the existing material.
- The Contractor shall be responsible for coordinating the removal of existing equipment with the respective owner(s). The Contractor shall remove, disassemble, and deliver salvageable equipment per the instructions in the special provisions or as discussed at the pre-construction meeting. The Contractor shall be responsible for any damage or loss of salvageable equipment.
- The Contractor shall take all precautions necessary to minimize the downtime of the existing street lighting systems to be modified.
- All existing curb and gutter, sidewalk, pavement, drainage structures, and irrigation systems damaged during the street lighting construction shall be replaced to meet or exceed the original condition. Unless otherwise directed, grassy areas which were originally sodded shall be re-sodded. All restoration work will be at the Contractor's expense, and shall be acceptable to the Engineer or his designee.
- Any equipment damaged during construction shall be replaced at the contractor's expense.
- The Contractor shall be required to provide and attach street addresses and identification numbers on the power supply cabinets, provide and attach the identification and pole numbers on each street light pole as indicated in the City's Standard Drawings. The address and identification labels/stickers are subsidiary to other items, not separate payment.
- Substantial completion of the street light system shall be defined as all components of the system fully operational. Substantial completion shall allow for testing of the system.
- Final acceptance of the street light system shall be defined as final written approval and acceptance by the City, including completion or correction of all punch list items and the street light system fully operational for a time period of fifteen (15) days, without any problem, as noted in the Specifications. Contractor shall provide marked up as-built plans prior to final acceptance by the City.

PROJECT SPECIFICATION NOTES:

- The center of all pole foundations shall be located 3 feet behind the back of the curb, unless otherwise noted in the plans.
- The center of all pole foundations within the median shall be centered in the median, unless otherwise noted in the plans.
- All power supplies shall be 4-circuit power supplies.

RECAPITULATION OF QUANTITIES

BILL OF MATERIALS (1)		
ITEM	UNIT	QUANTITY
STREET LIGHT POLE (P30S)	EACH	27
STREET LIGHT POLE (P25S)	EACH	-
STREET LIGHT POLE (P30D)	EACH	-
10' BRACKET ARMS	EACH	27
B30 SCREW-IN FOUNDATION	EACH	27
COBRA-HEAD LUMINAIRE w/250 WATT H.P.S. EQUIVALENT LED LAMP	EACH	27
TYPE I JUNCTION BOX	EACH	-
TYPE II JUNCTION BOX	EACH	3
4-CIRCUIT POWER SUPPLY ASSEMBLY	EACH	1
POWER SUPPLY FOUNDATION	EACH	1
3" SCHEDULE 40 P.V.C. CONDUIT (FROM CONTROL CENTER TO POWER POLE)	LN. FT.	30
2" HIGH DENSITY POLYETHYLENE (HDPE) CONDUIT (GRAY) (2)	LN. FT.	3,320
3c No. 2 DISTRIBUTION CABLE	LN. FT.	135
3c No. 4 DISTRIBUTION CABLE	LN. FT.	3,520
1-1c#4 TRACER WIRE AND PULL STRING	LN. FT.	-
1c No. 10 POLE AND BRACKET CABLE	LN. FT.	3,240
BREAK-AWAY NON-FUSED CONNECTOR KITS	EACH	27
BREAK-AWAY FUSED CONNECTOR KITS	EACH	54


NOTES:

(1) THESE APPROXIMATE QUANTITIES WERE PREPARED SOLELY FOR THE CONTRACTOR'S CONVENIENCE. IT IS NOT GUARANTEED THAT THIS LIST OF MATERIALS CONSTITUTES ALL ITEMS REQUIRED FOR THE COMPLETION OF THE WORK.

STREET LIGHT LEGEND

- 250W HPS EQUIVALENT LED COBRA-HEAD LUMINAIRE W/ 30' POLE
- TYPE 2 JUNCTION BOX
- CLASS 1 PULL BOX
- PAD MOUNTED POWER SUPPLY (SHADED AREA INDICATES PHOTOCELL ORIENTATION) (NORTH OR EAST)
- STREET LIGHTING CONDUIT
- CONSTRUCTION NOTE NUMBER
- STEEL POLE
- WOOD POLE
- SIGNAL MAST ARM POLE
- SIGNAL PEDESTAL
- TRAFFIC SIGNAL CONTROLLER CABINET
- SECONDARY SERVICE POINT
- BOX NUMBER
- POLE NUMBER
- POLE
- CIRCUIT
- POWER SUPPLY ID

WIRING DIAGRAM

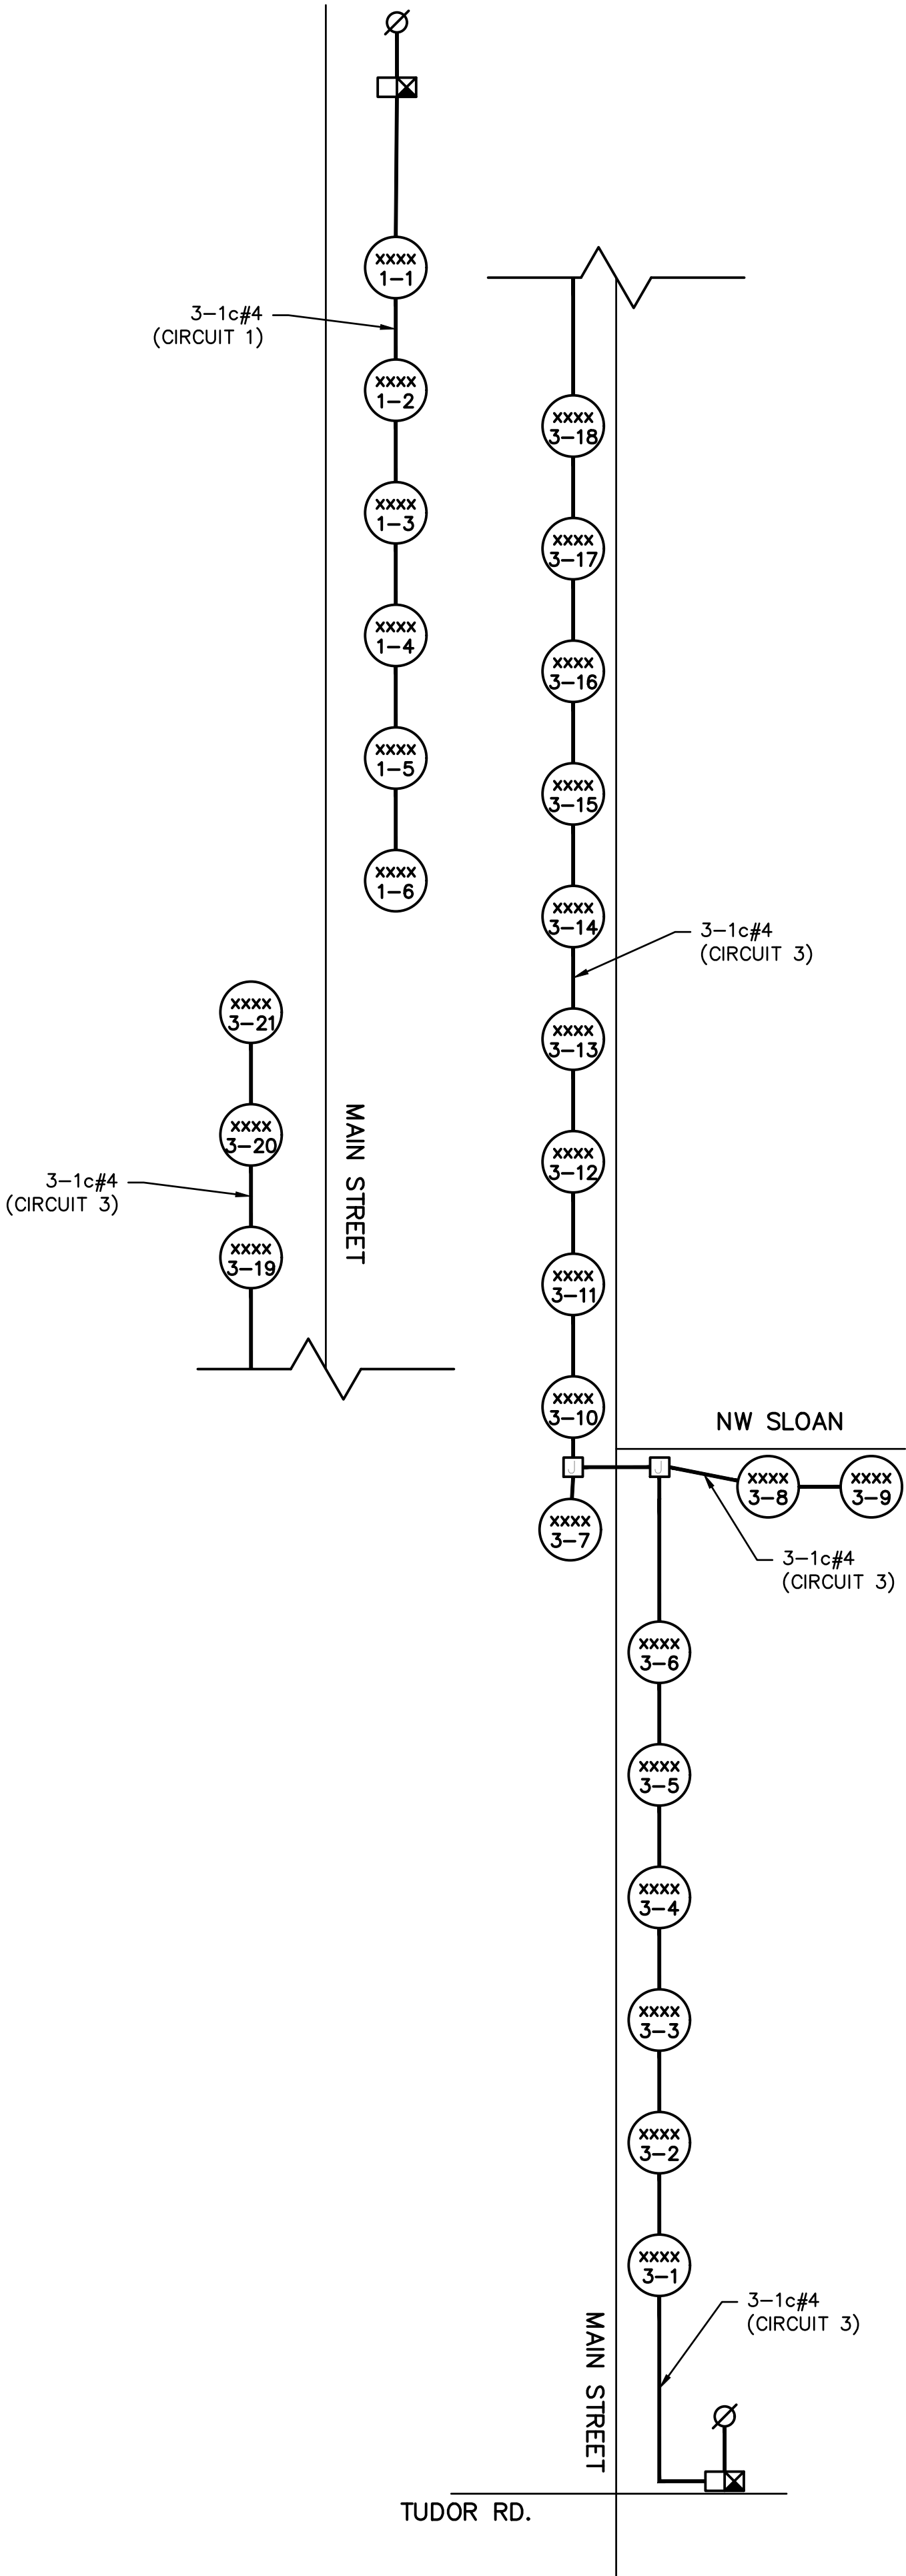

olsson

Olsson Engineering - MO State Certificate of Authority #001592
7301 West 133rd Street, Suite 200
Overland Park, KS 66213-4750
TEL 913.381.1170
FAX 913.381.1174
www.olsson.com

STREET LIGHTING GENERAL NOTES
MAIN STREET

SCANNELL DEVELOPMENT LEE'S SUMMIT LOGISTICS
NORTHWEST CORNER OF TUDOR ROAD AND MAIN STREET

LEE'S SUMMIT, MISSOURI

REV. NO. 2

DATE 2-16-2023

REVISIONS DESCRIPTION LIGHTING UPDATE

BY

2021

REVISIONS

C.O.A. NO.: 001592

DRAWN BY: JRC

CHECKED BY: JAP

APPROVED BY: JSS

QA/QC BY: SLJ



PROJECT NO.: 021-04157

DWG NO.: F_LGT_02104157

DATE: 2023-02-16


SHEET 59 OF 105

USER: asacawedra
T_PSTRM_02104157
F:\2021\04001\021-04157\40-Design\AutoCAD\Final Plans\Sheets\TFTC\F_LGT_02104157.dwg
V_XTOPO_02104157
V_PBASE_02104157
XREFS: V_XBOU_02104157
DATE: Oct 30, 2023 3:54pm

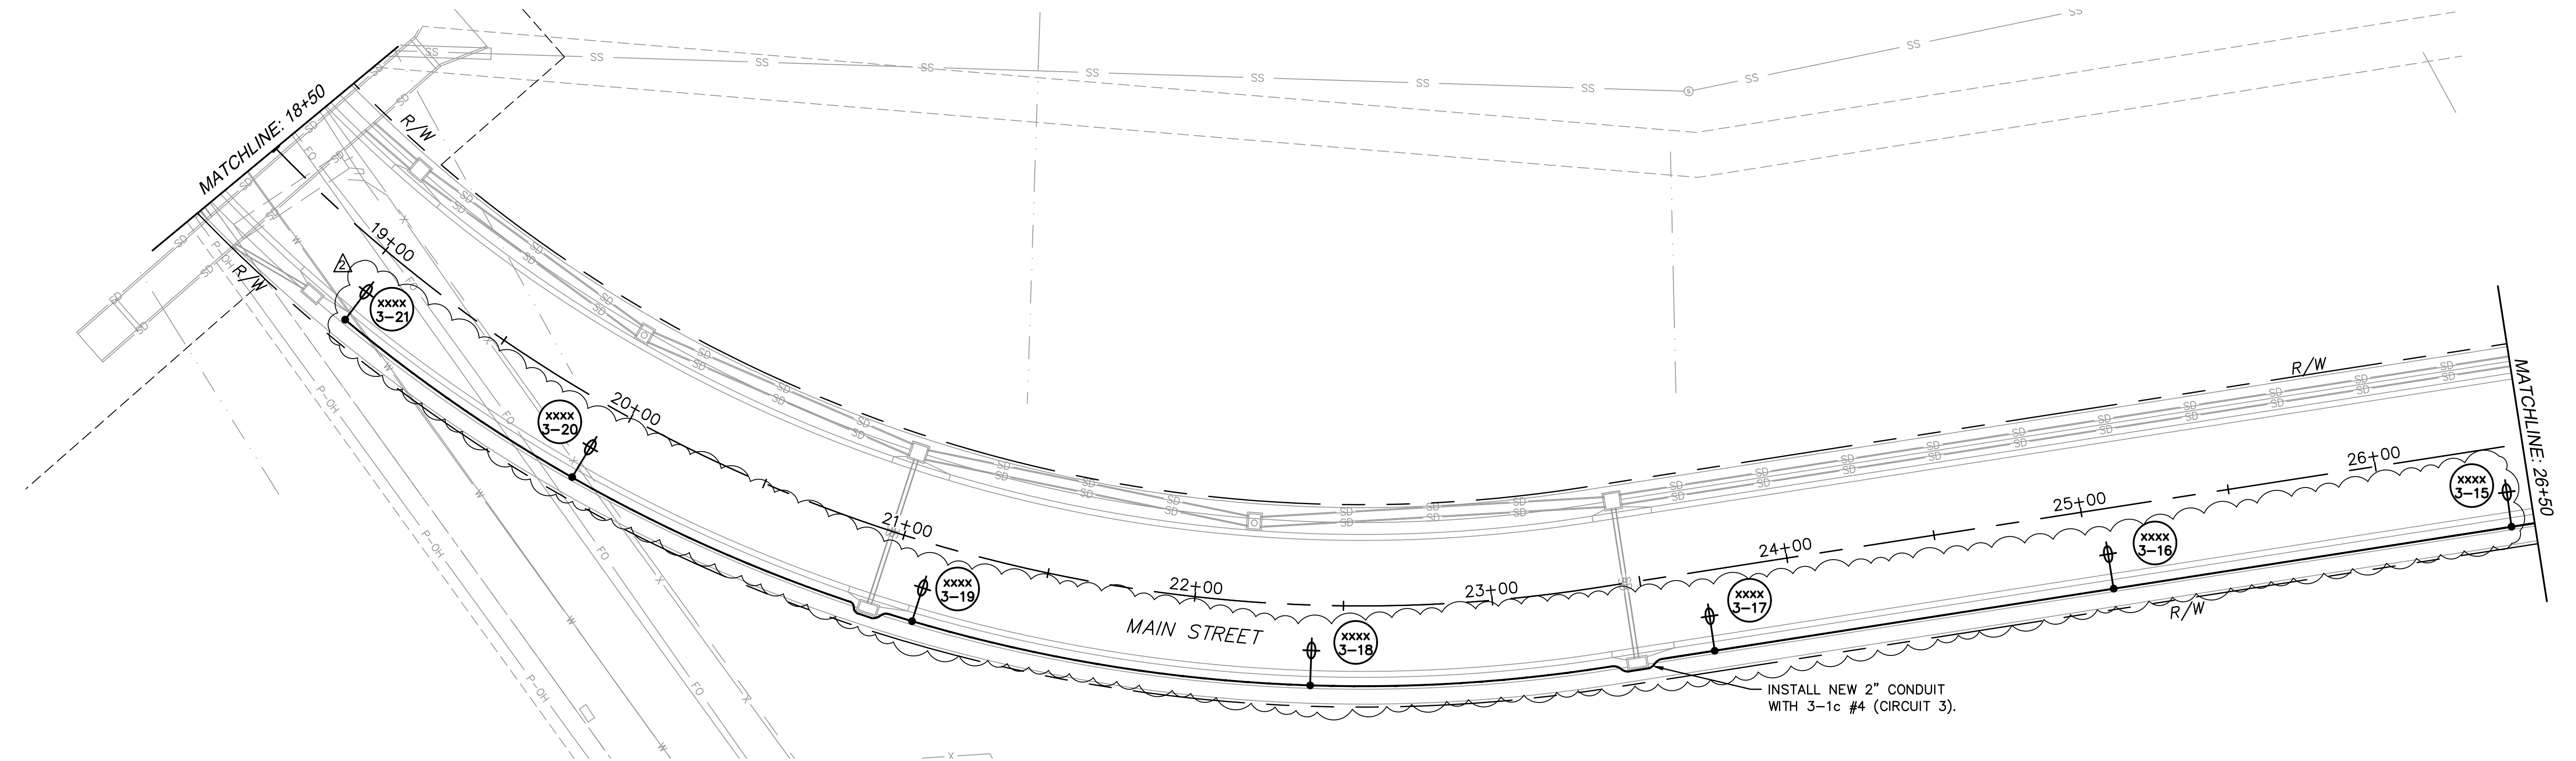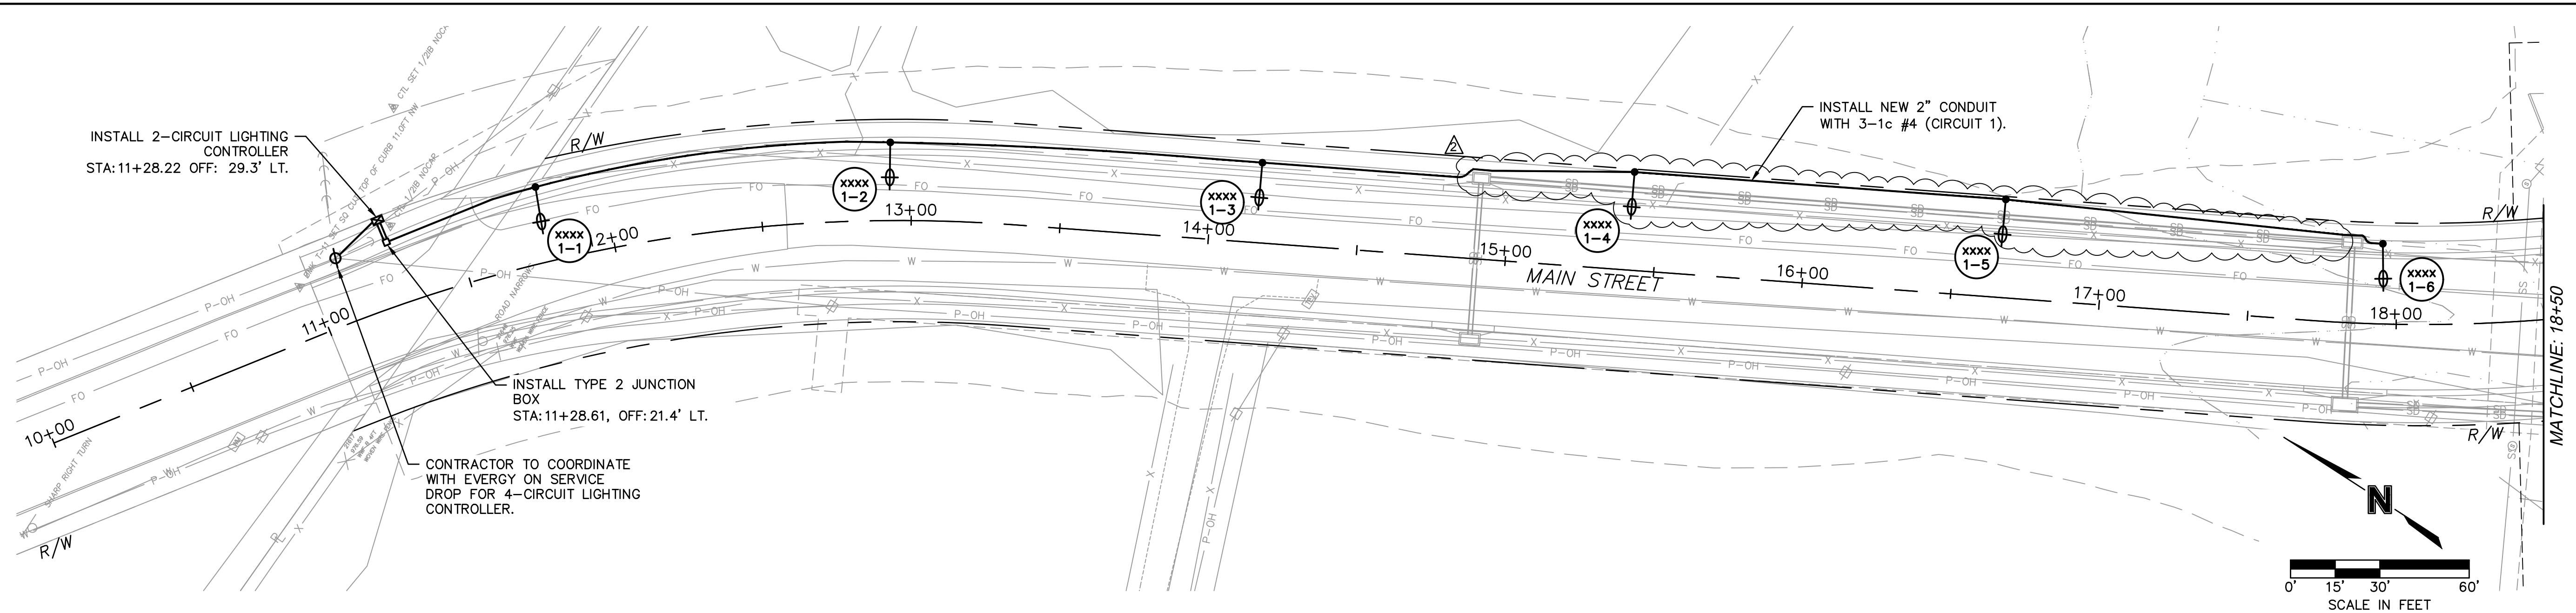

LIGHTING POLE SCHEDULE							
POLE NO	STATION	OFFSET	POLE TYPE	BRACKET ARM	LED LUMINAIRE	DISTRIBUTION	BASE
1-1	11+78.55	25.4' LT.	P30S	10'	250W EQ	TYPE III	B30
1-2	12+96.14	26.2' LT.	P30S	10'	250W EQ	TYPE III	B30
1-3	14+16.25	27.0' LT.	P30S	10'	250W EQ	TYPE III	B30
1-4	15+41.15	33.0' LT.	P30S	10'	250W EQ	TYPE III	B30
1-5	16+66.15	33.0' LT.	P30S	10'	250W EQ	TYPE III	B30
1-6	17+94.80	27.0' LT.	P30S	10'	250W EQ	TYPE III	B30
3-15	26+42.09	27.0' RT.	P30S	10'	250W EQ	TYPE III	B30
3-16	25+06.85	27.0' RT.	P30S	10'	250W EQ	TYPE III	B30
3-17	23+71.25	27.0' RT.	P30S	10'	250W EQ	TYPE III	B30
3-18	22+39.65	27.0' RT.	P30S	10'	250W EQ	TYPE III	B30
3-19	21+10.68	26.9' RT.	P30S	10'	250W EQ	TYPE III	B30
3-20	19+92.64	27.0' RT.	P30S	10'	250W EQ	TYPE III	B30
3-21	19+04.35	26.6' RT.	P30S	10'	250W EQ	TYPE III	B30

NOTE: COORDINATE WITH CITY OF LEE'S SUMMIT FOR POLE ADDRESS INFORMATION.

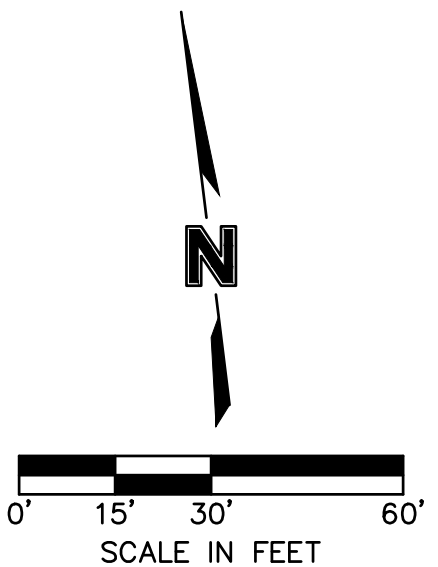

STREET LIGHTING PLAN MAIN STREET

SCANNELL DEVELOPMENT LEE'S SUMMIT LOGISTICS NORTHWEST CORNER OF TUDOR ROAD AND MAIN STREET LEE'S SUMMIT, MISSOURI	2017
---	------

LEE'S SUMMIT, MISSOURI

C.O.A. NO.: 001592
DRAWN BY: JRC
CHECKED BY: JAP
APPROVED BY: JSS
QA/QC BY: SLJ
PROJECT NO.: 021-04157
DWG NO.: F_LGT_02104157
DATE: 2023-02-16

SHEET
60 OF 105

[illegible]





REVISIONS DESCRIPTION	CITY COMMENTS
	LIGHTING UPDATES

REVISIONS

olson

Olsson Engineering - MO State Certificate of Authority #001592
7301 West 133rd Street, Suite 200 TEL 913.381.1170
Overland Park, KS 66213-4750 FAX 913.381.1174 www

DWG: F:\2021\04001-04500\021-04157\40-Design\AutoCAD\Final Plans\Sheets\JTC\F_LGT_02104157.dwg
DATE: Oct 30, 2023 3:54pm
USER: asavedra
T_PSTRM_02104157
F_PTBK_02104157
C_PROW_02104157
F_LGTBASE_02104157

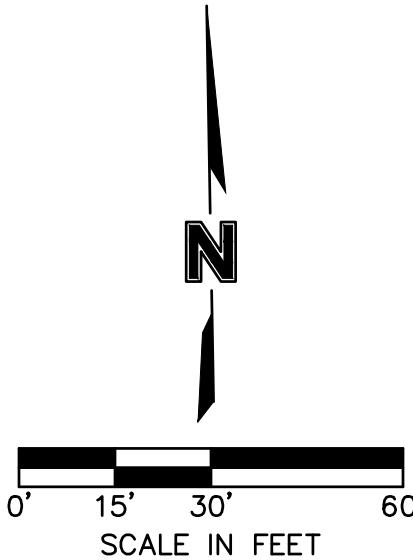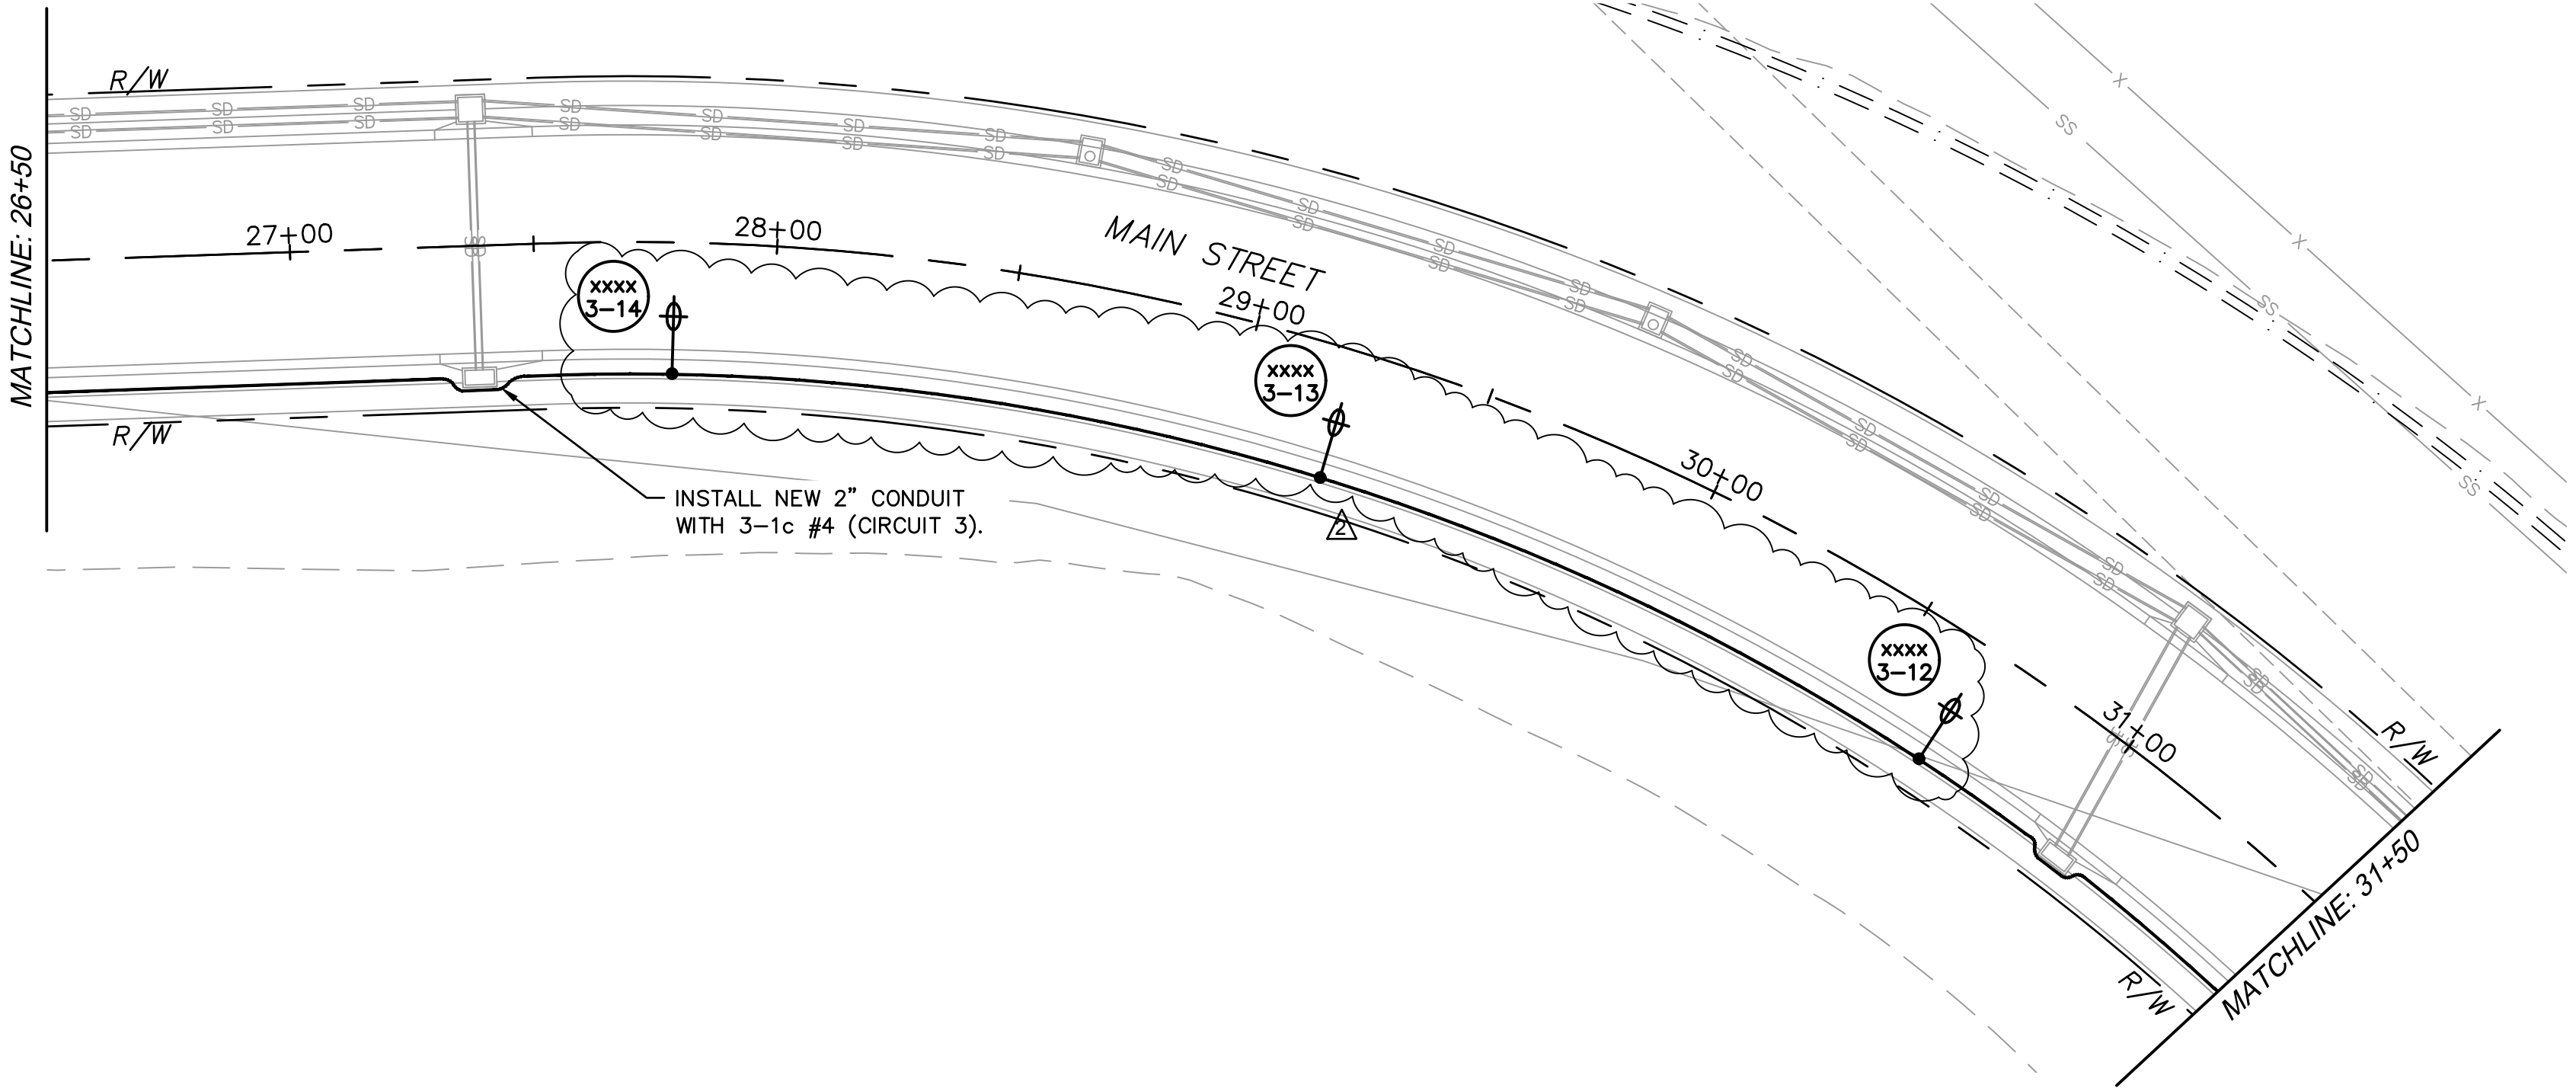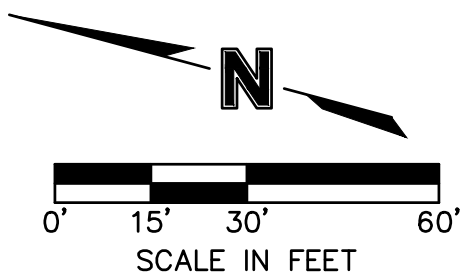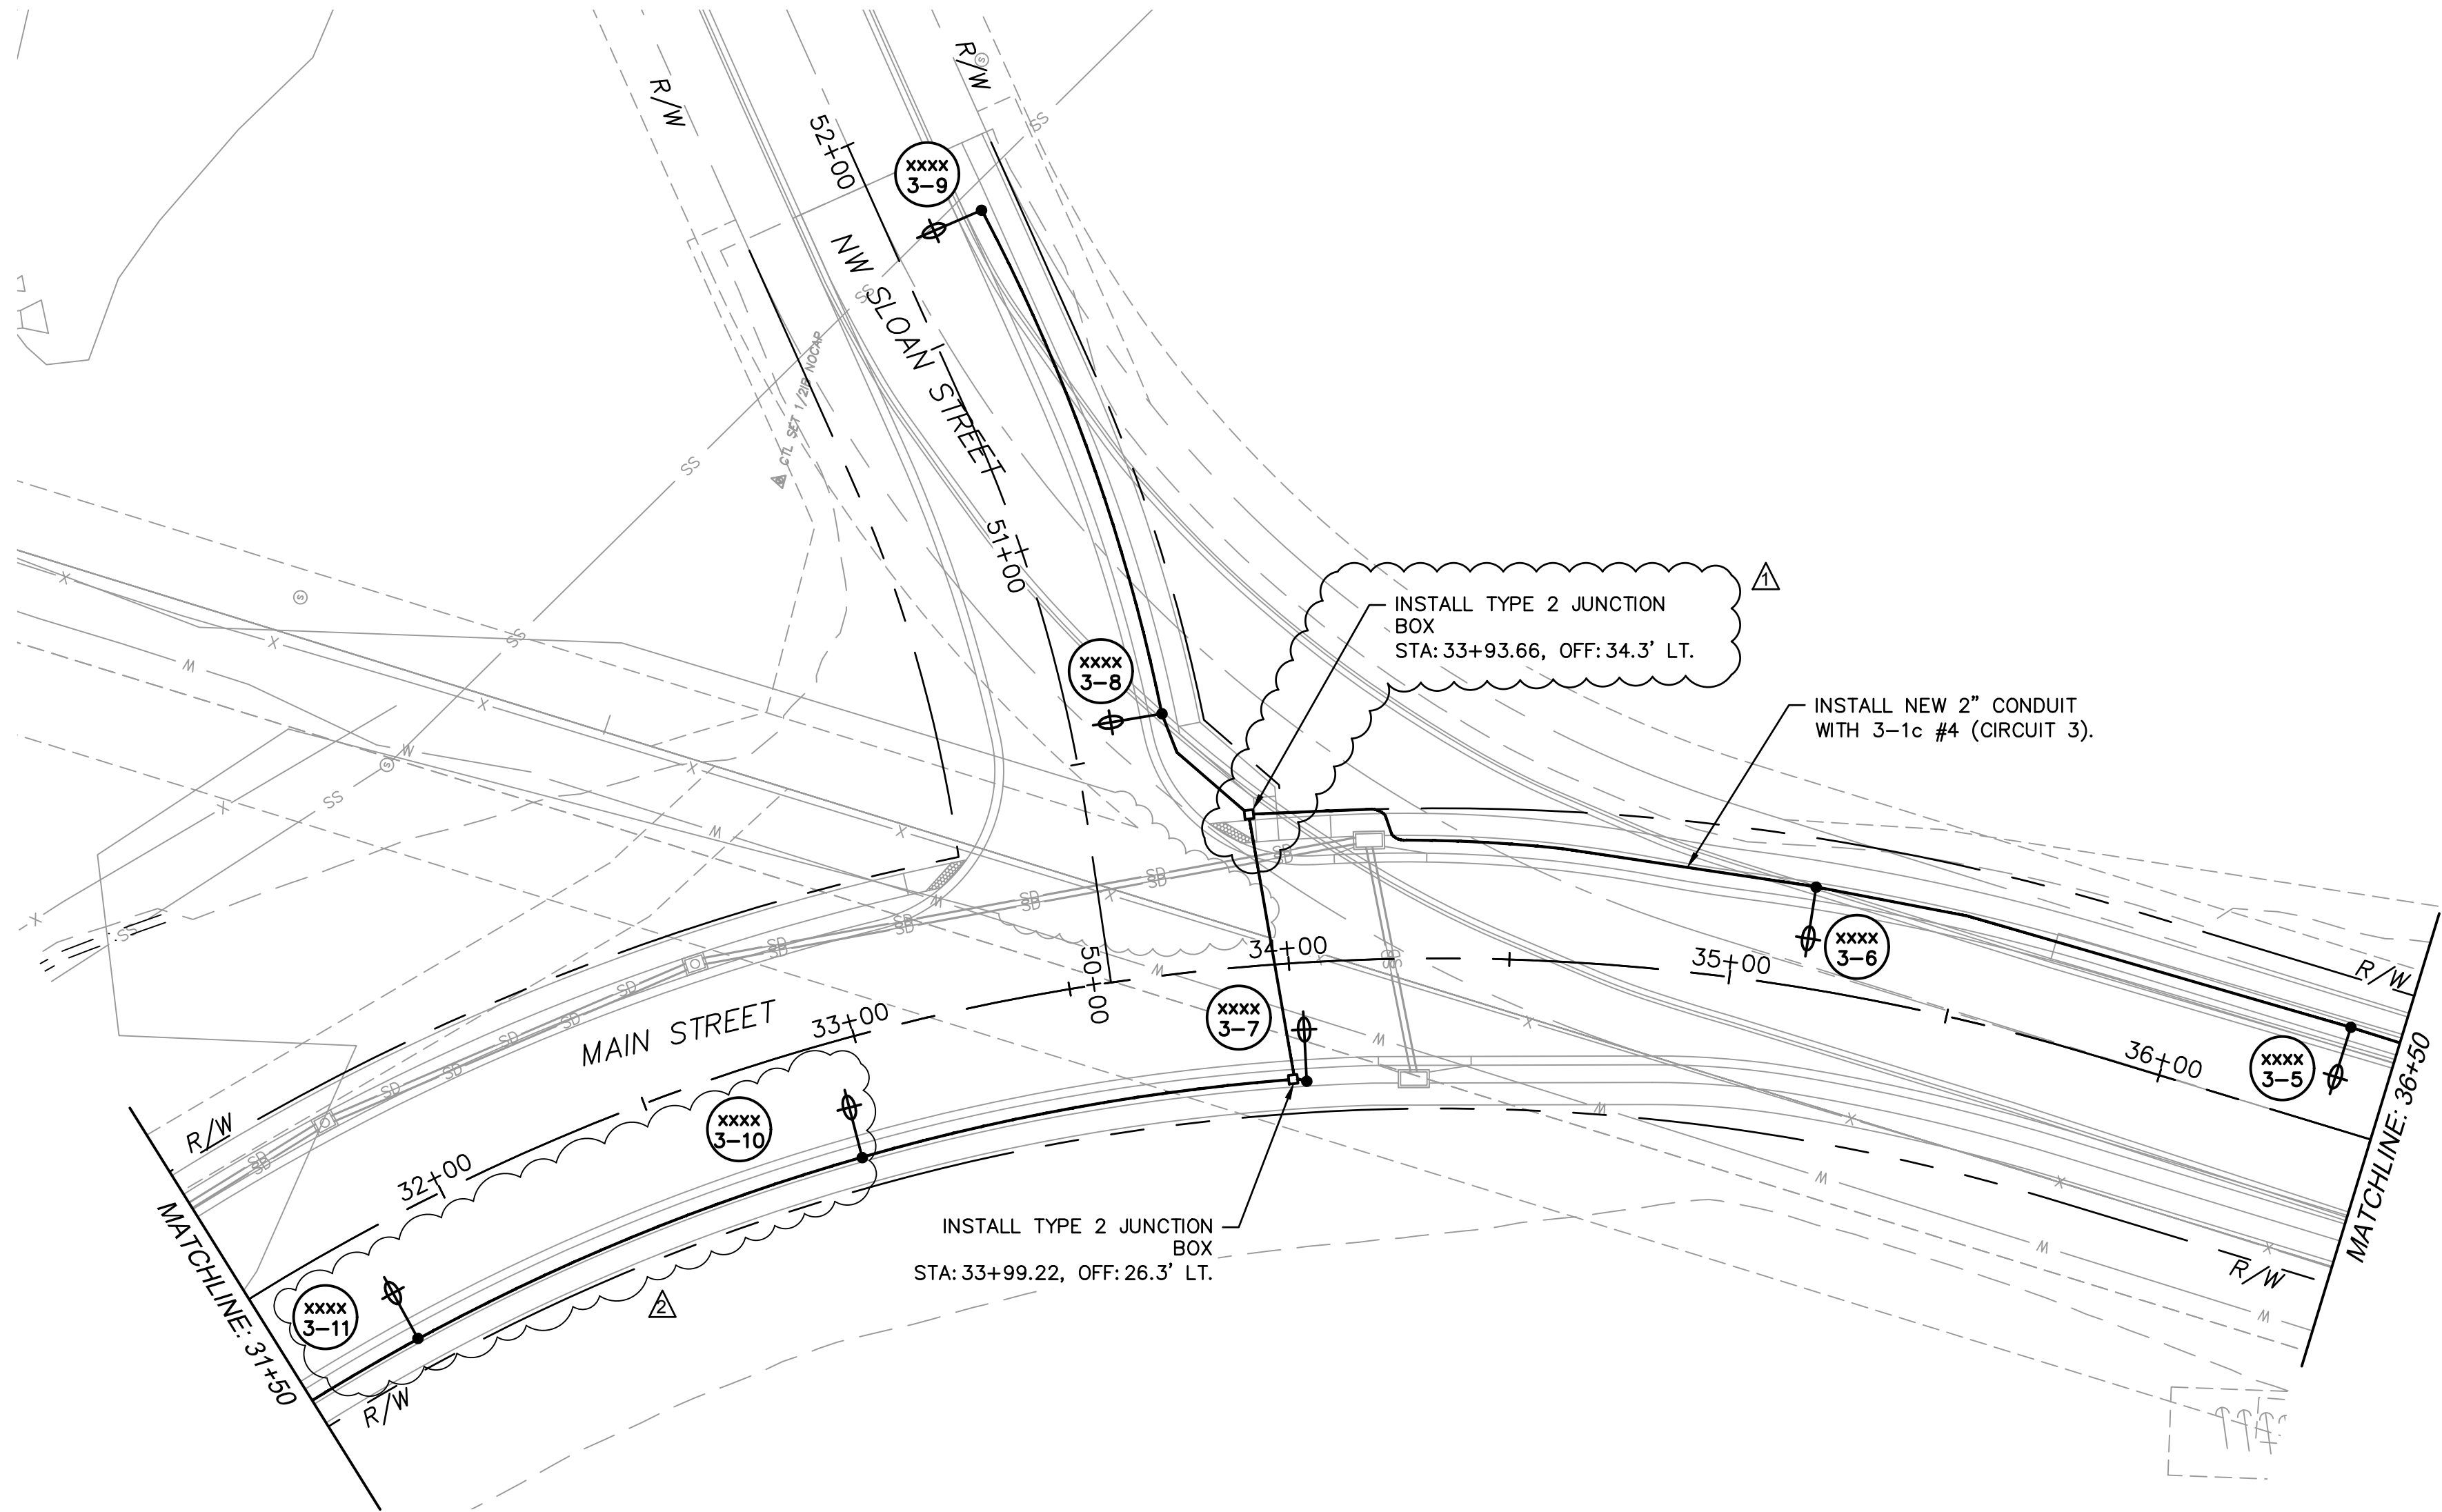

LIGHTING POLE SCHEDULE							
POLE NO	STATION	OFFSET	POLE TYPE	BRACKET ARM	LED LUMINAIRE	DISTRIBUTION	BASE
3-14	27+78.89	27.0' RT.	P30S	10'	250W EQ	TYPE III	B30
3-13	29+21.51	27.0' RT.	P30S	10'	250W EQ	TYPE III	B30
3-12	30+65.30	27.0' RT.	P30S	10'	250W EQ	TYPE III	B30
3-11	31+79.34	27.0' RT.	P30S	10'	250W EQ	TYPE III	B30
3-10	32+94.32	27.0' RT.	P30S	10'	250W EQ	TYPE III	B30
3-9	31+74.22	21.7' RT.	P30S	10'	250W EQ	TYPE III	B30
3-8	50+57.31	20.9' RT.	P30S	10'	250W EQ	TYPE III	B30
3-7	34+00.40	27.0' RT.	P30S	10'	250W EQ	TYPE III	B30
3-6	35+16.15	23.0' LT.	P30S	10'	250W EQ	TYPE III	B30
3-5	33+39.40	23.0' LT.	P30S	10'	250W EQ	TYPE III	B30

NOTE: COORDINATE WITH CITY OF LEE'S SUMMIT FOR POLE ADDRESS INFORMATION.

olsson

Olsson Engineering - MO State Certificate of Authority #001592
7301 West 133rd Street, Suite 200
Overland Park, KS 66213-4750
TEL 913.381.1170
FAX 913.381.1174
www.olson.com

STREET LIGHTING PLAN
MAIN STREET AND SLOAN STREET

SCANNELL DEVELOPMENT LEE'S SUMMIT LOGISTICS
NORTHWEST CORNER OF TUDOR ROAD AND MAIN STREET

LEE'S SUMMIT, MISSOURI

C.O.A. NO.: 001592
DRAWN BY: JRC
CHECKED BY: JAP
APPROVED BY: JSS
QA/QC BY: SLJ
PROJECT NO.: 021-04157
DWG NO.: F_LGT_02104157
DATE: 2023-02-16





2021

REVISIONS

REV. NO.	DATE	REVISIONS DESCRIPTION	BY
1	11-16-2021	CITY COMMENTS LIGHTING UPDATE	
2	2-16-2023		

SHEET
61 OF 105

DWG: F:\2014001\021-04157\40-Design\AutoCAD\Final Plans\Sheets\IFTC\F_SAS_02104157.dwg
DATE: Oct 30, 2023 3:55pm XREFS: V_XBOU_02104157 V_XTOPO_02104157 T_PBASE_02104157 T_PSTRM_02104157 F_PTBK_02104157 F_PAV-MRK-BASE_02104157
USER: ascaavedra

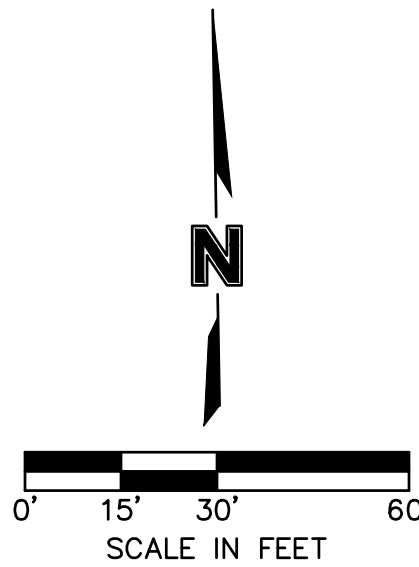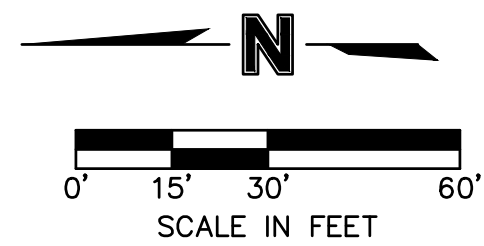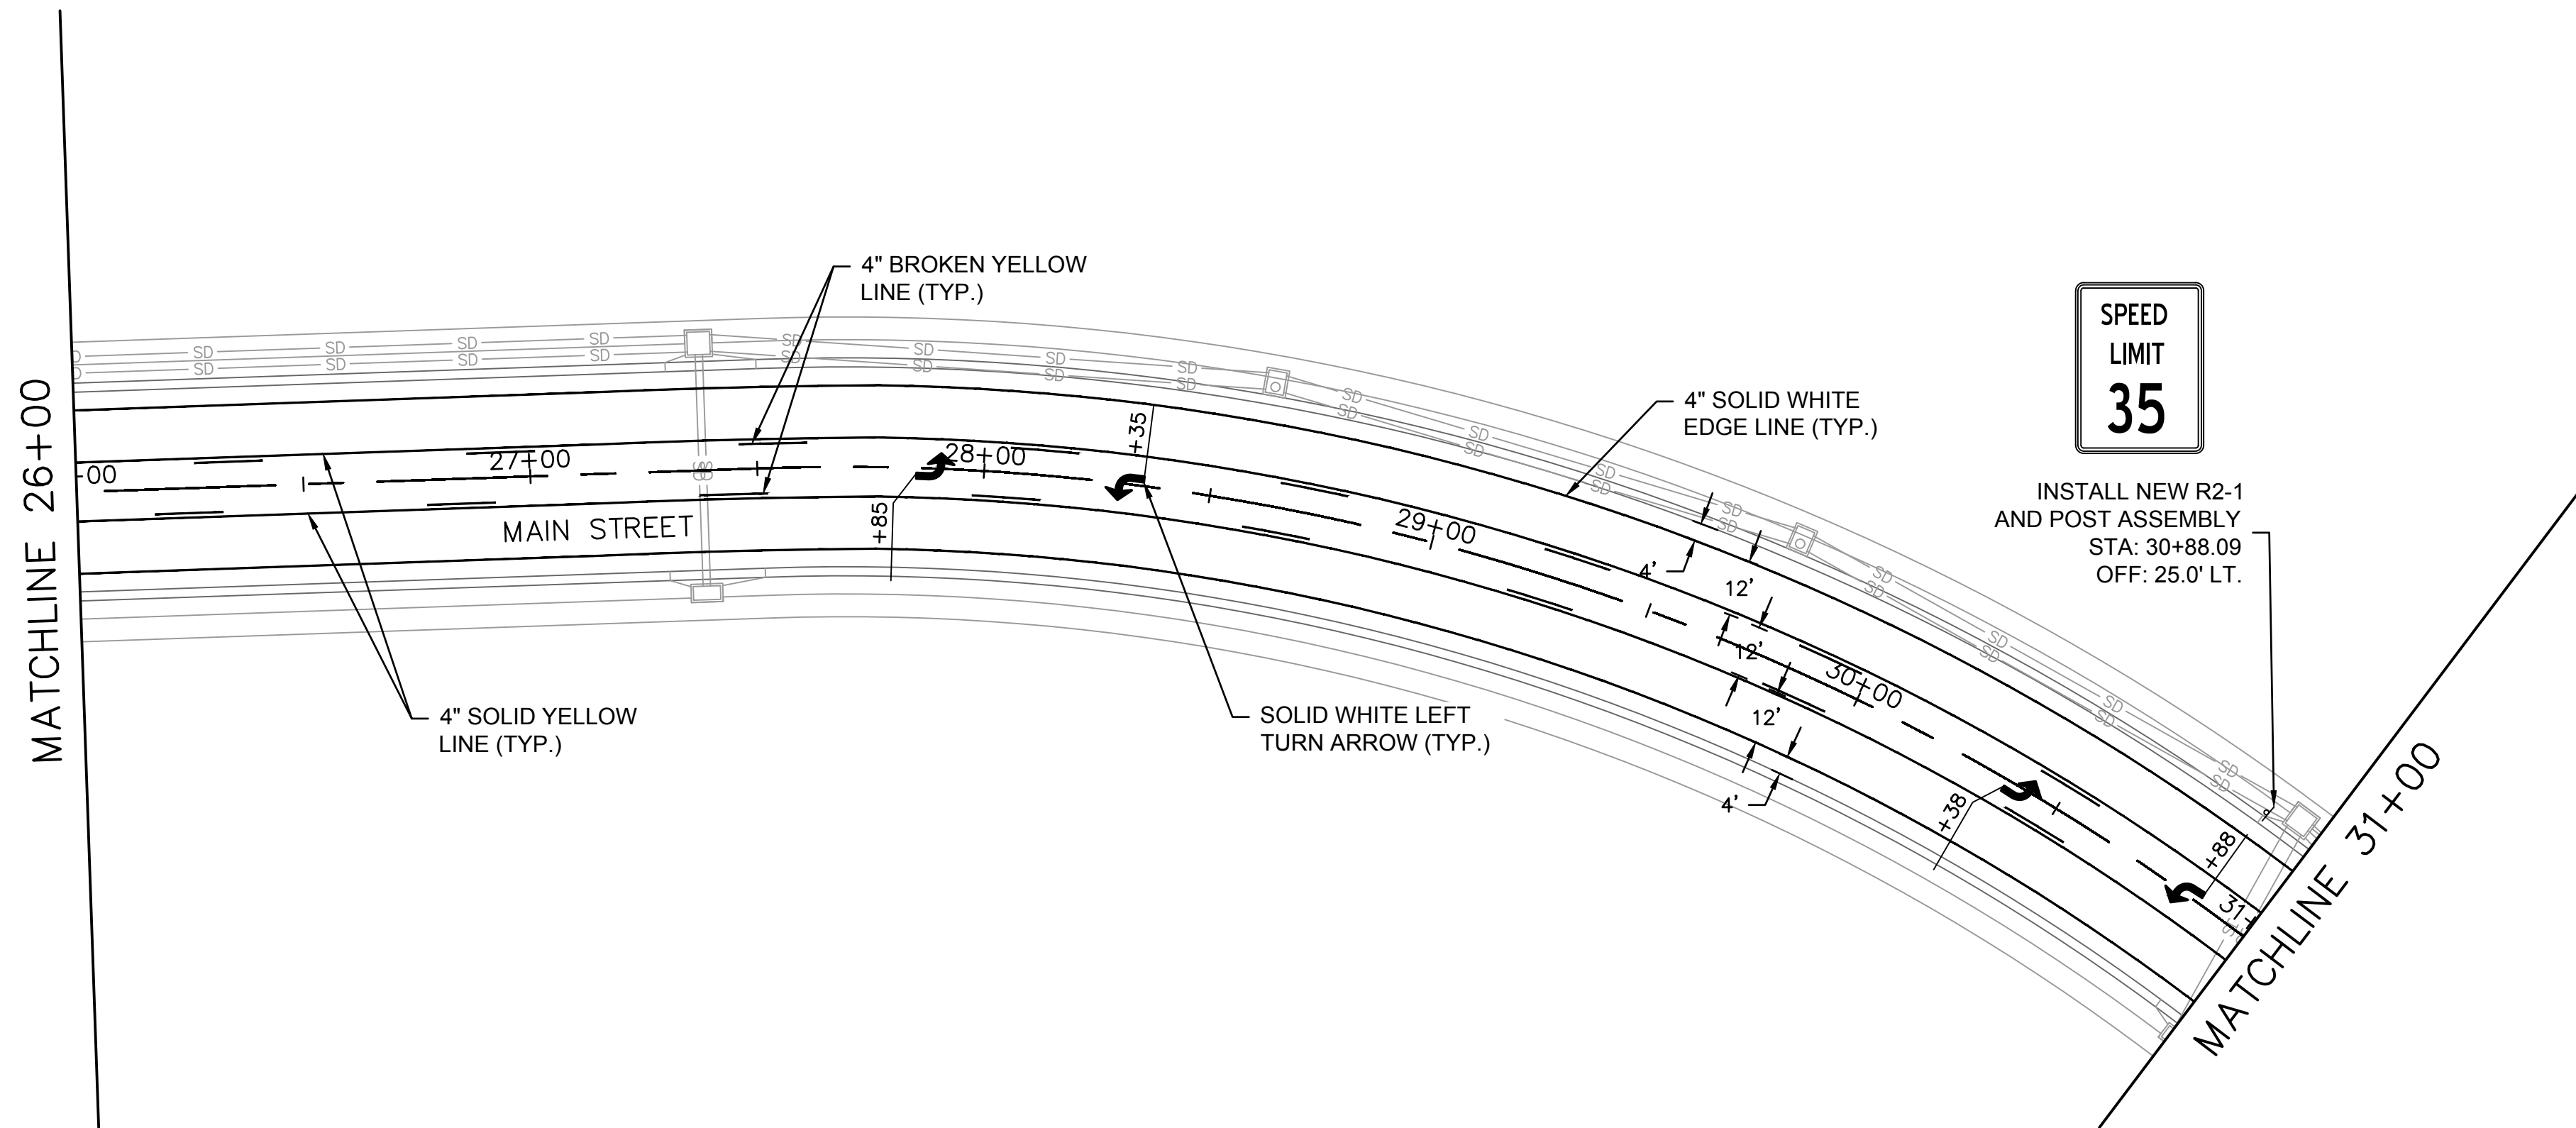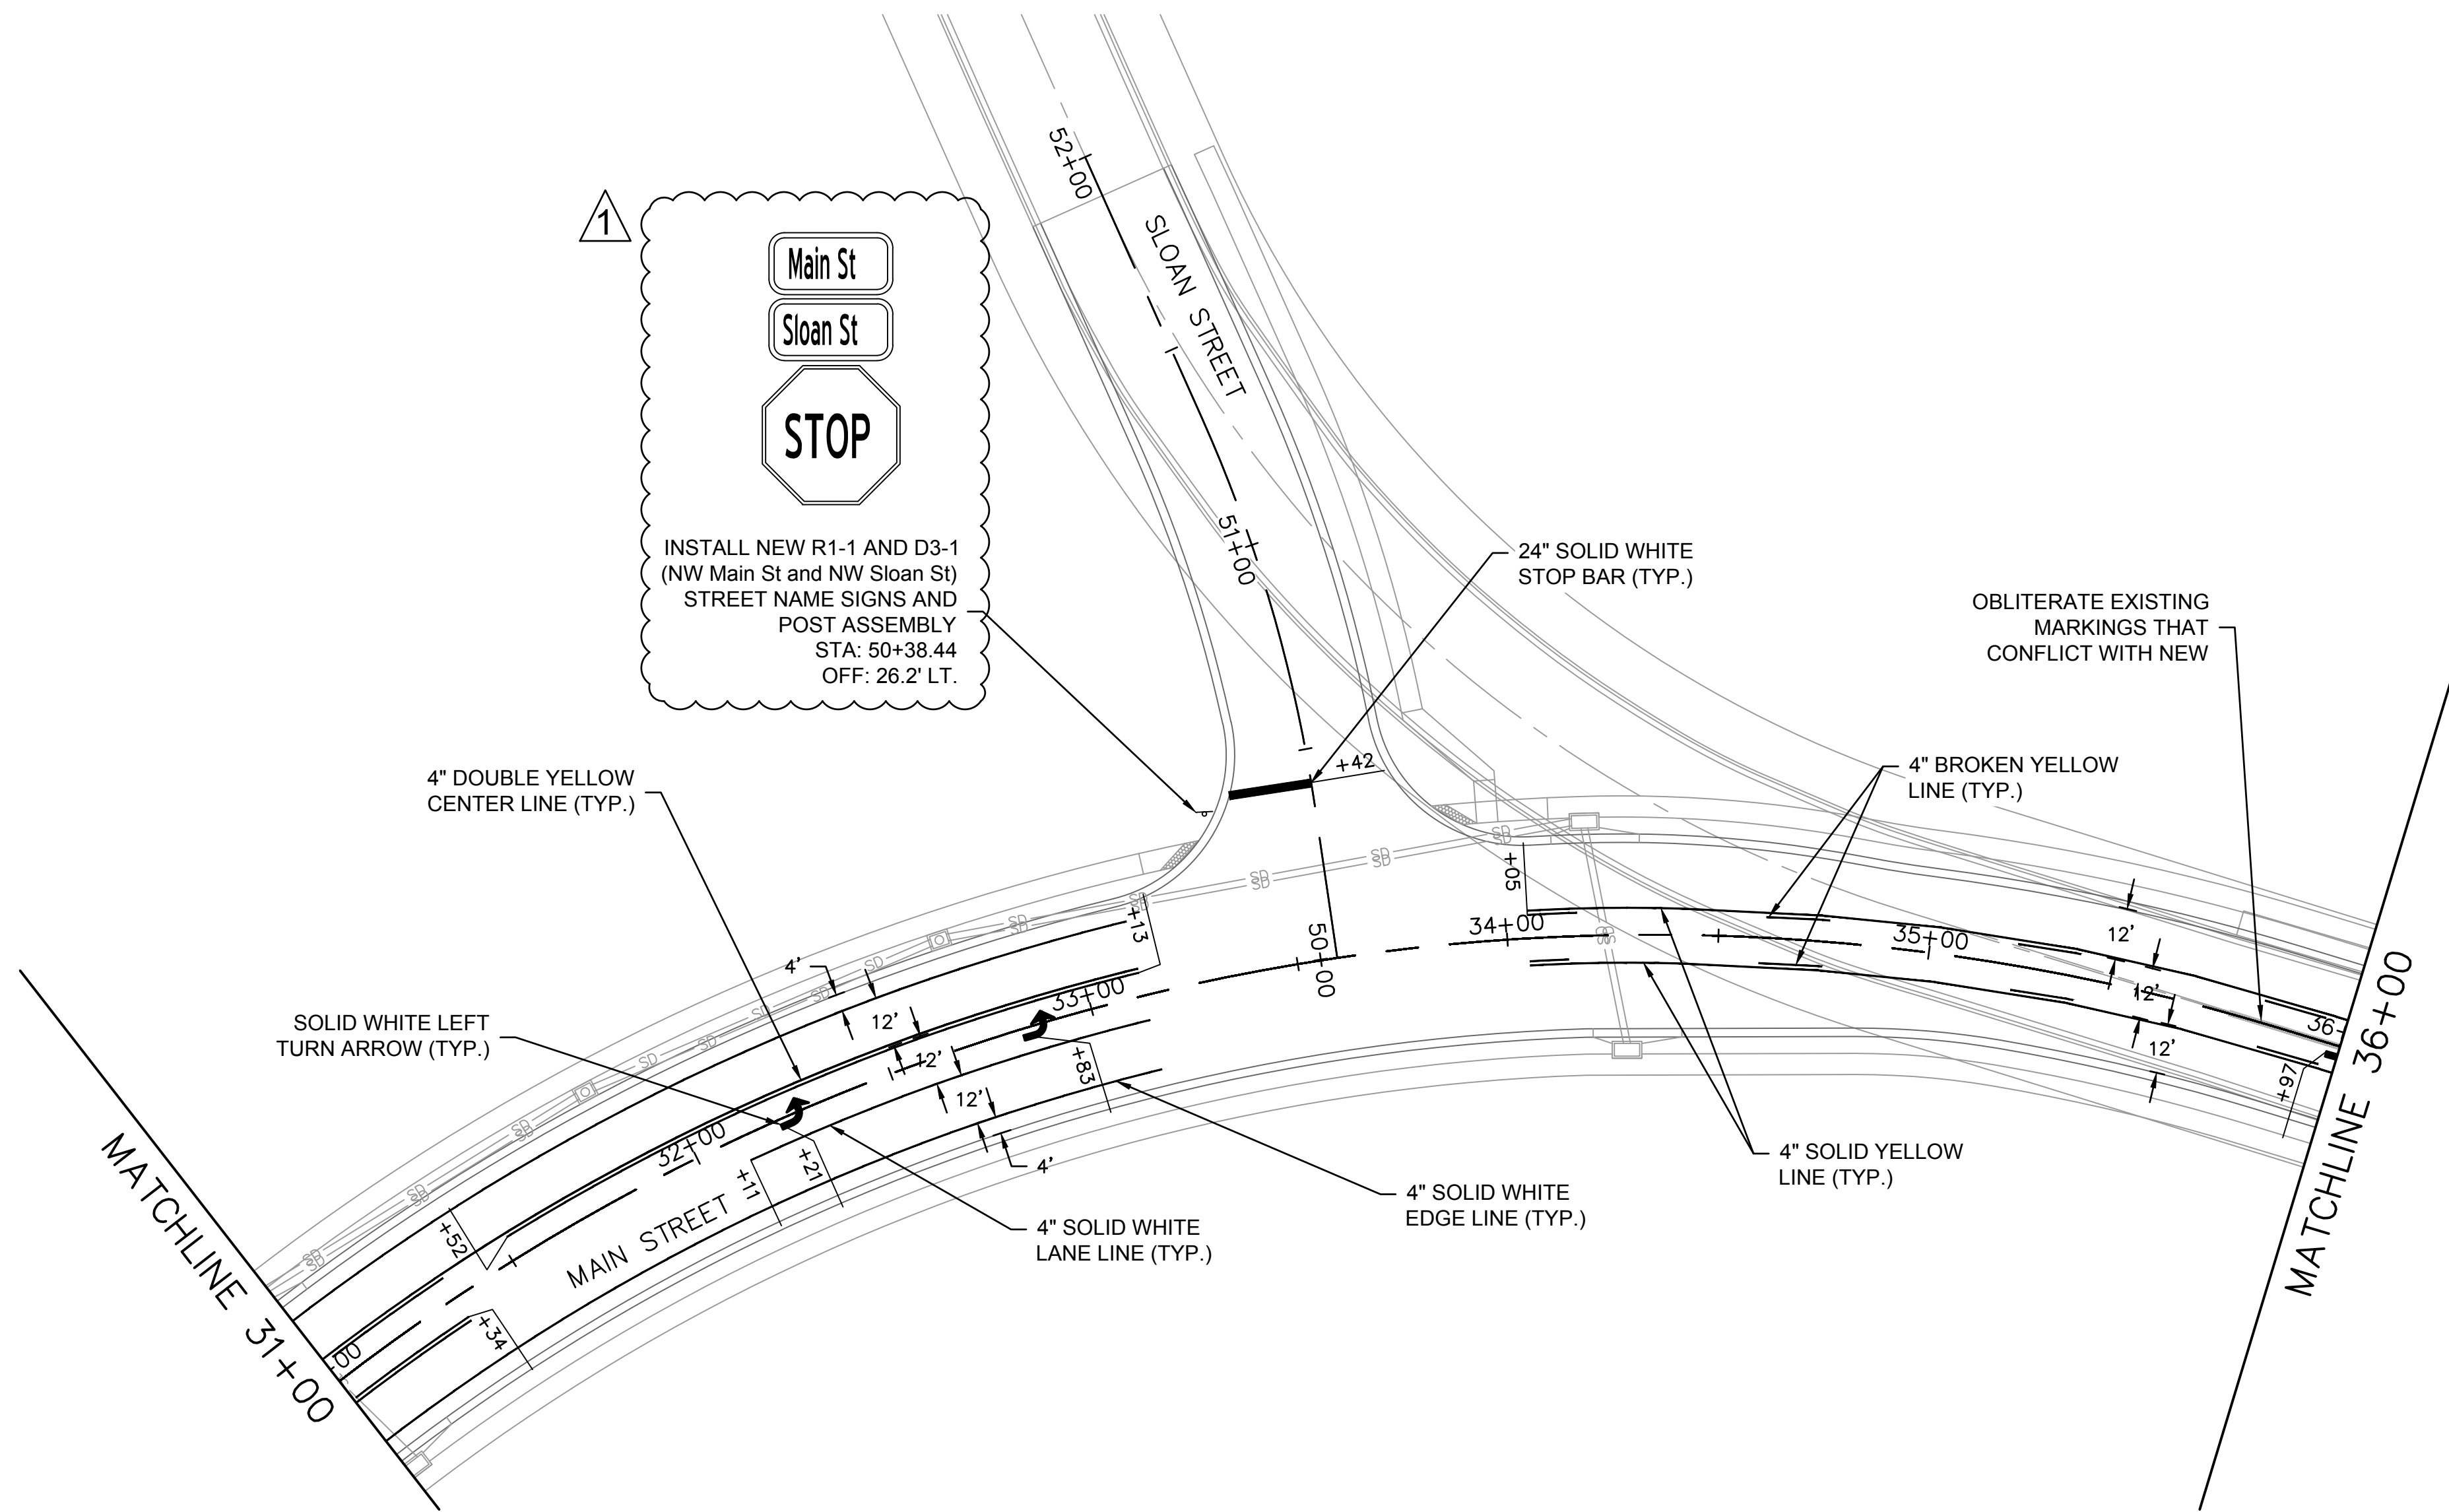


PAVEMENT MARKING AND SIGNING PLAN MAIN STREET AND SLOAN STREET

SCANNELL DEVELOPMENT LEE'S SUMMIT LOGISTICS NORTHWEST CORNER OF TUDOR ROAD AND MAIN STREET	2020
LEE'S SUMMIT, MISSOURI	

[illegible]


olsson

Olsson Engineering - MO State Certificate of Authority #001592
7301 West 133rd Street, Suite 200 TEL 913.381.1170
Overland Park, KS 66213-4750 FAX 913.381.1174 www.olsson.com

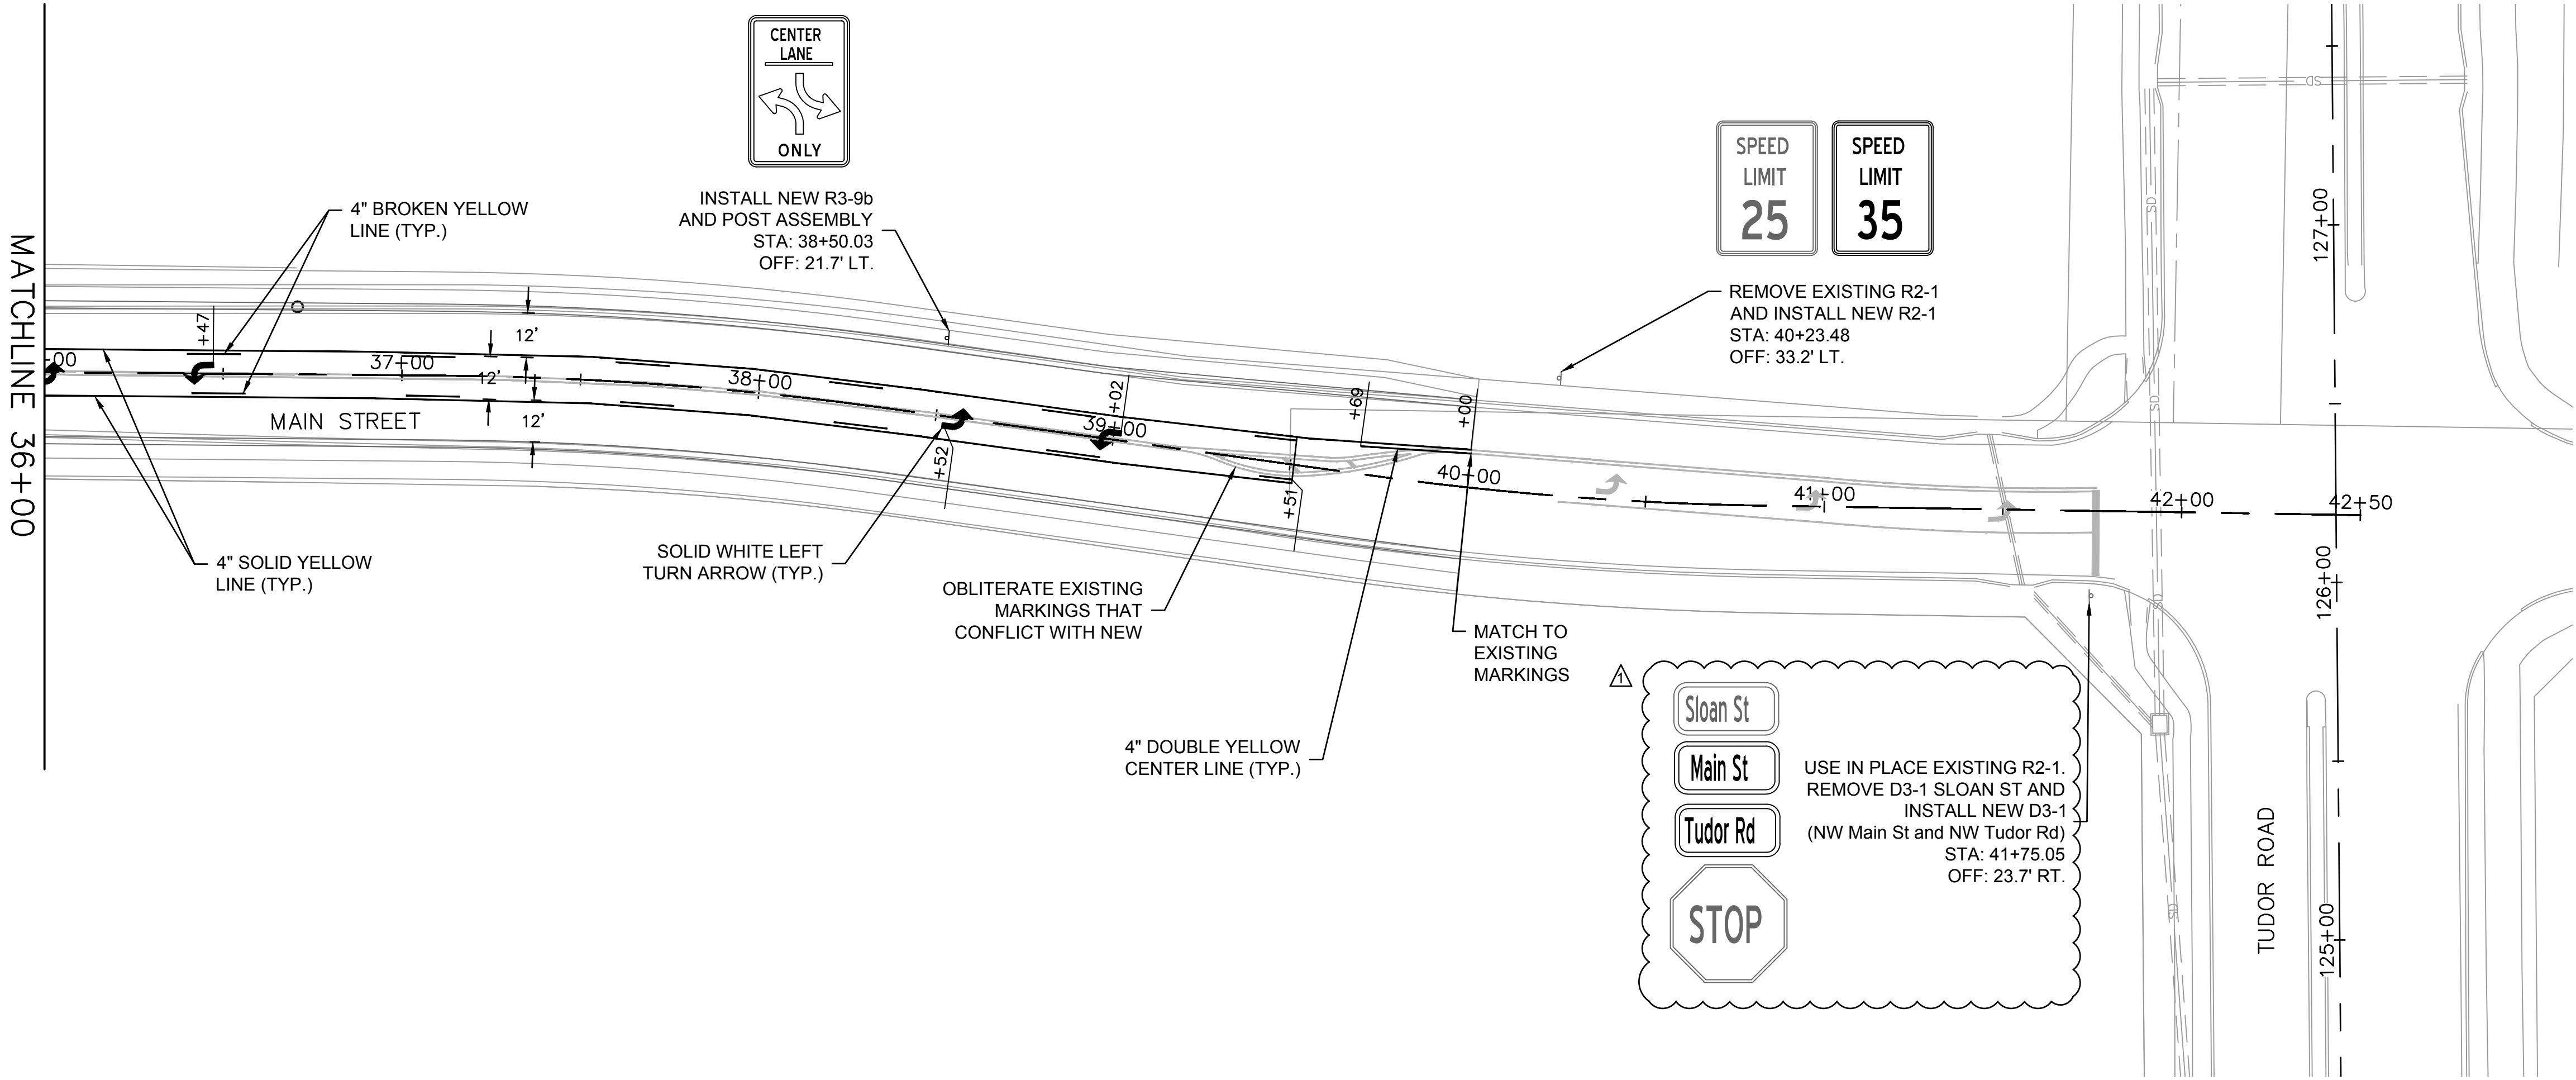

SUMMARY OF PAVEMENT MARKING QUANTITIES			
ITEM	ITEM DESCRIPTION	UNITS	QUANTITY
1.	4" SOLID WHITE LANE LINE (THERMOPLASTIC)	LF	100'
2.	4" SOLID WHITE EDGE LINE (THERMOPLASTIC)	LF	4,185'
3.	4" SOLID WHITE EXTENSION LINE (THERMOPLASTIC)	LF	50'
4.	4" BROKEN YELLOW CENTERLINE (THERMOPLASTIC)	LF	1,210'
5.	4" SOLID YELLOW CENTERLINE (THERMOPLASTIC)	LF	4,875'
6.	4" DOUBLE YELLOW CENTERLINE (THERMOPLASTIC)	LF	920'
7.	12" SOLID YELLOW CROSSHATCH LINE (THERMOPLASTIC)	LF	30'
8.	24" SOLID WHITE STOP BAR (THERMOPLASTIC)	LF	20'
9.	SOLID WHITE LEFT-TURN ARROW (PRE-FORMED THERMOPLASTIC)	EA	22

SUMMARY OF SIGN QUANTITIES						
ITEM	QUANTITY	MUTCD SIGN NUMBER	SIZE (INCHES)	AREA (SQ. FT.)	TOTAL AREA EACH SIGN (SQ. FT.)	SIGN POST (EA.)
1.	2	R3-9b	24x36	6.0	12.0	2
2.	2	R2-1	30x36	7.5	15.0	1
3.	1	R1-1	30x30	6.25	6.25	1
4.	8	D3-1	9x18	1.125	9.0	0
TOTAL					42.25	4

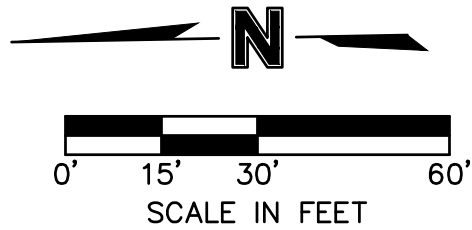

olsson

Olsson Engineering - MO State Certificate of Authority #001592
7301 West 133rd Street, Suite 200
Overland Park, KS 66213-4750
TEL 913.381.1170
FAX 913.381.1174
www.olsson.com

PAVEMENT MARKING AND SIGNING PLAN
MAIN STREET

SCANNELL DEVELOPMENT LEE'S SUMMIT LOGISTICS
NORTHWEST CORNER OF TUDOR ROAD AND MAIN STREET

LEE'S SUMMIT, MISSOURI


REV. NO. 1
DATE 11-16-2021
REVISED DESCRIPTION CITY COMMENTS

BY


REVISIONS

C.O.A. NO.: 001592
DRAWN BY: JRC
CHECKED BY: JAP
APPROVED BY: JSS
QA/QC BY: SLJ
PROJECT NO.: 021-04157
DWG NO.: F_SAS_02104157
DATE: 2023-02-16

SHEET
65 OF 105

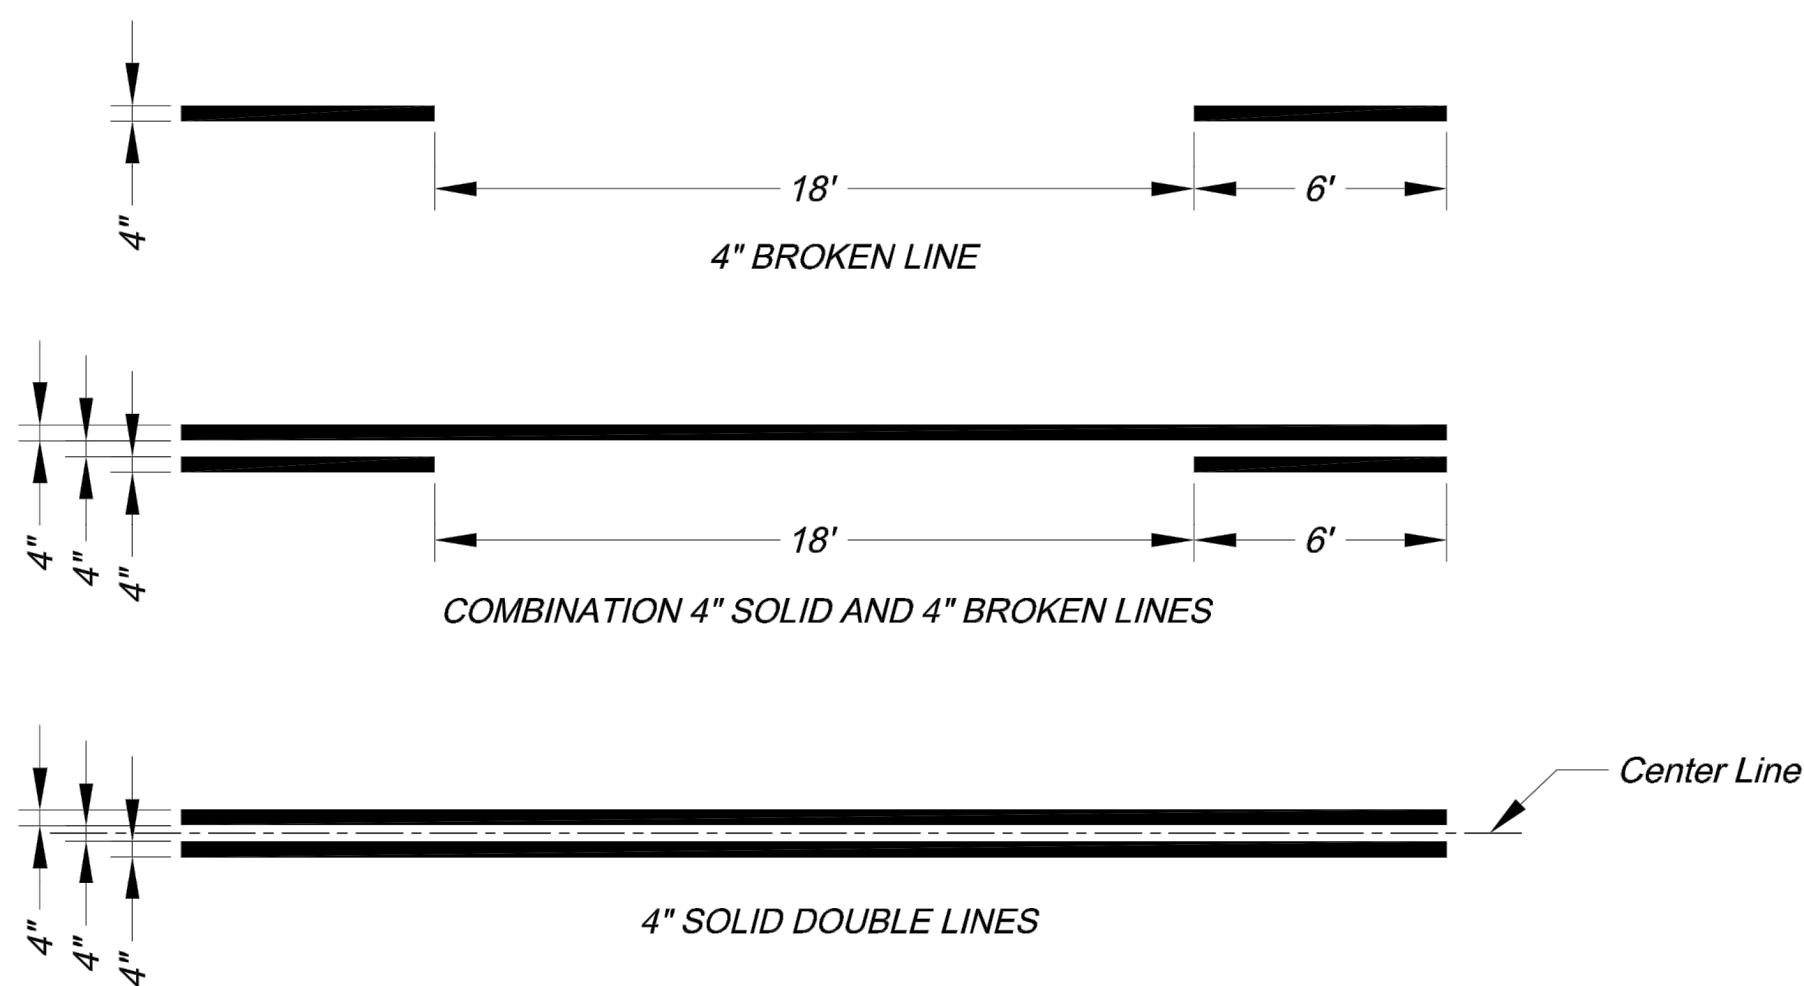


NOTES:
1. All edge line, center line, and lane line pavement markings shall be 4" wide unless otherwise noted.
2. Edge lines shall be continuous solid white or yellow lines. Right side edge lines shall be solid white. Median or left side edge lines on divided roadways are to be solid yellow. Edge lines and center lines shall be continuous across driveways.

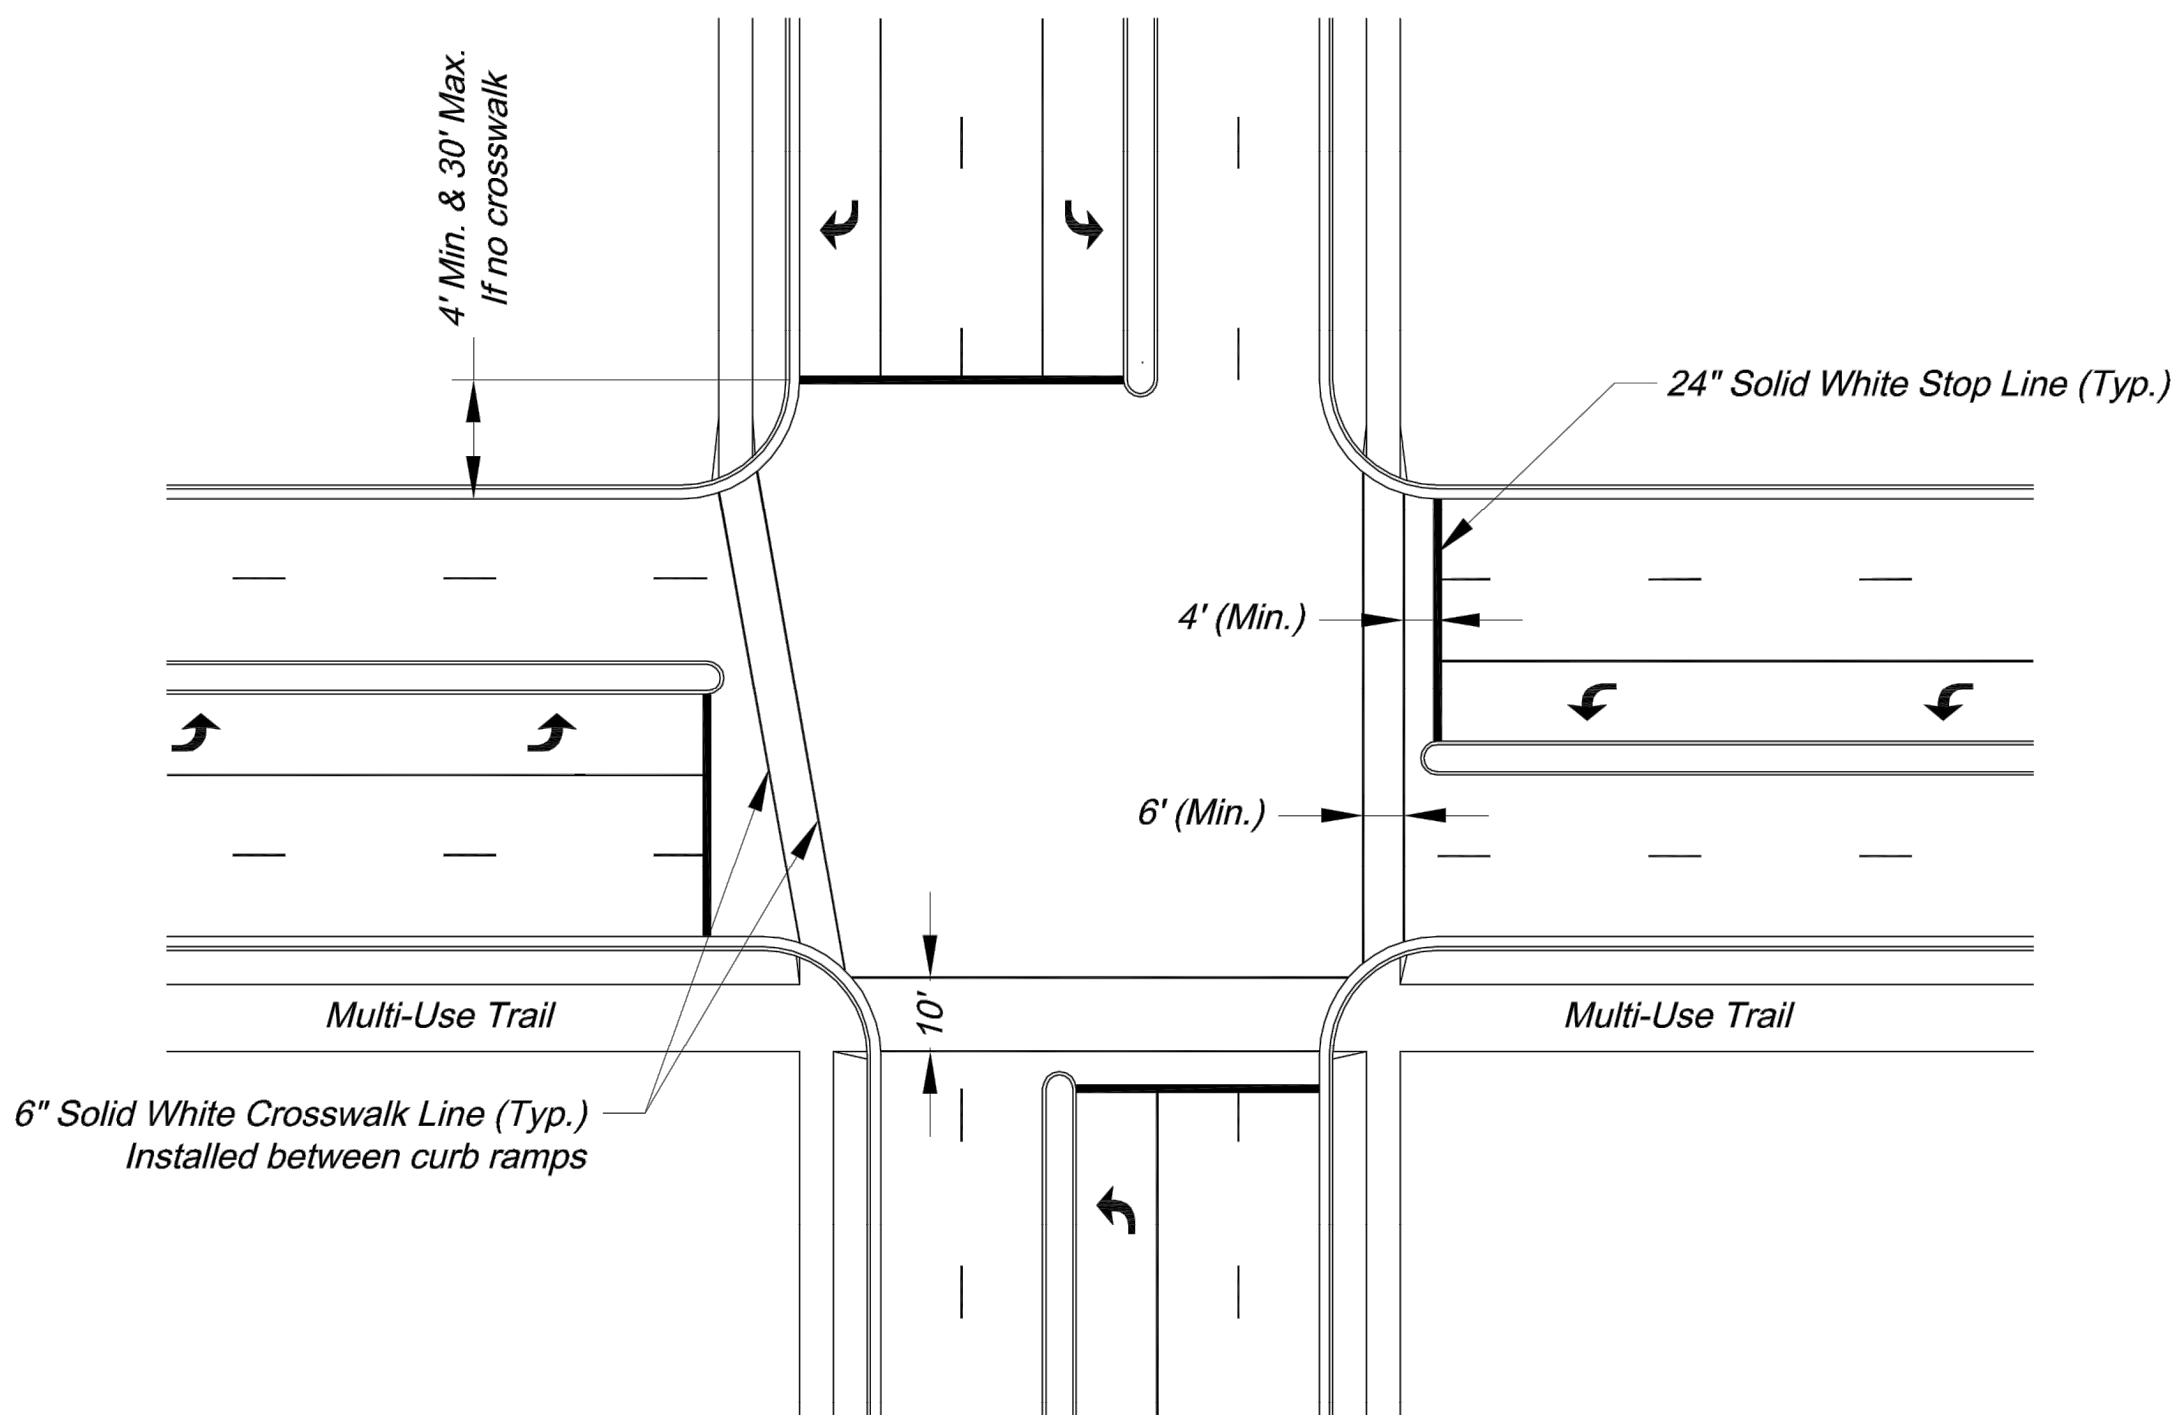


TYPICAL INTERSECTION MARKINGS

NOTES:
1. Transverse crosswalk lines shall be installed such that the distance between lines is at least 6 or 10 feet.
2. Stop lines are required at signalized intersections, on multi-lane stop controlled approaches, or in front of crosswalks at controlled intersections.

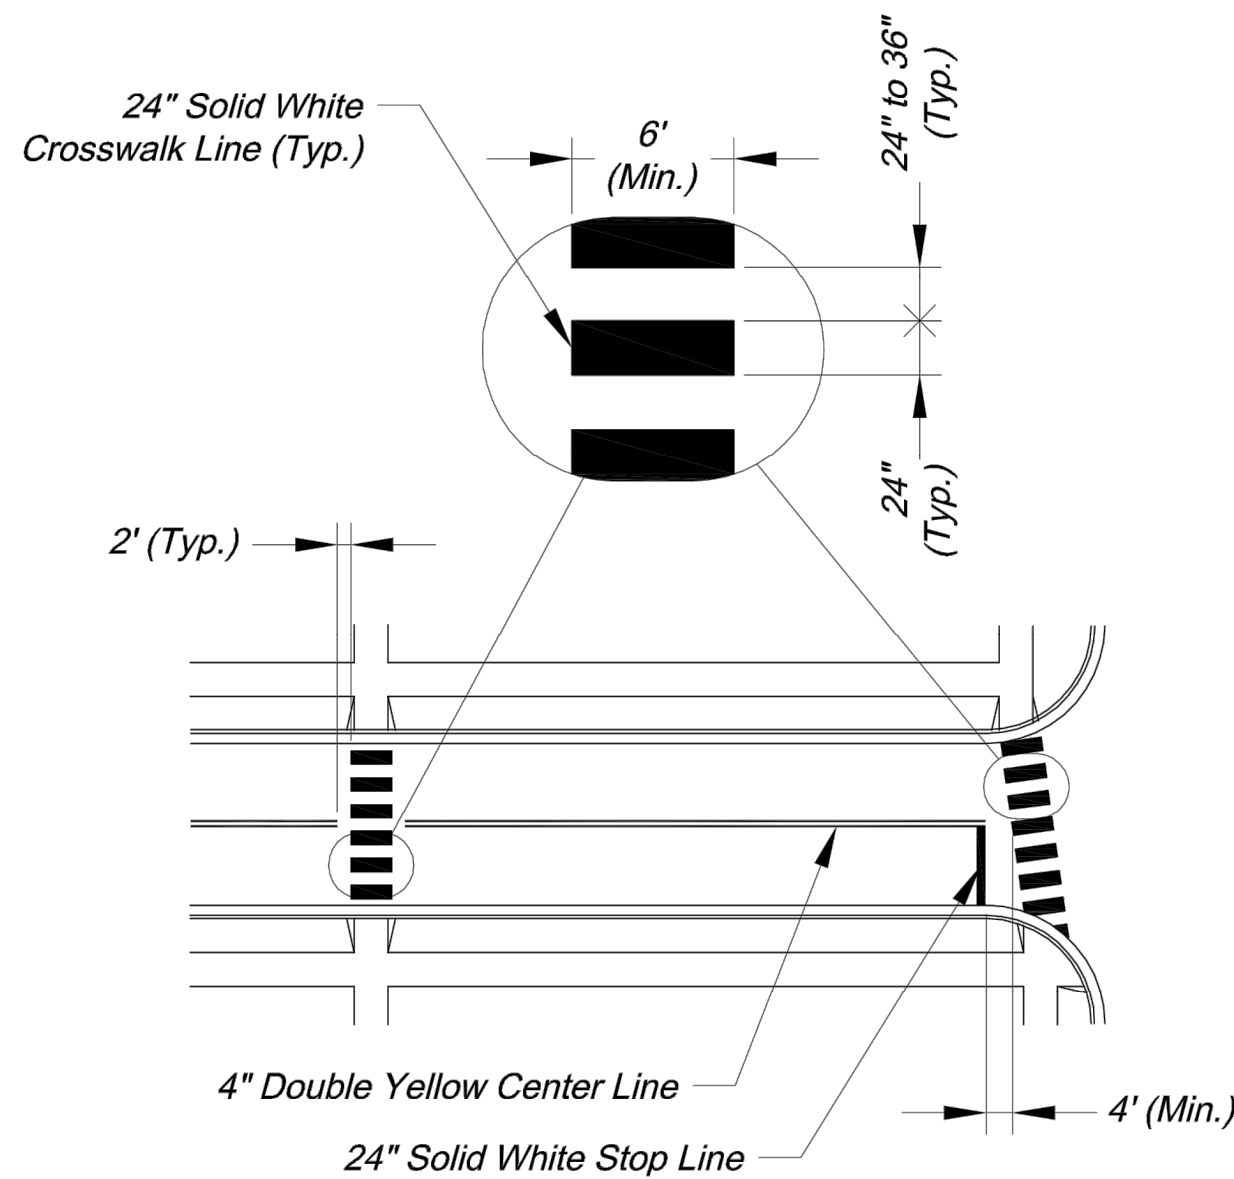


TYPICAL MIDBLOCK OR SCHOOL CROSS WALK

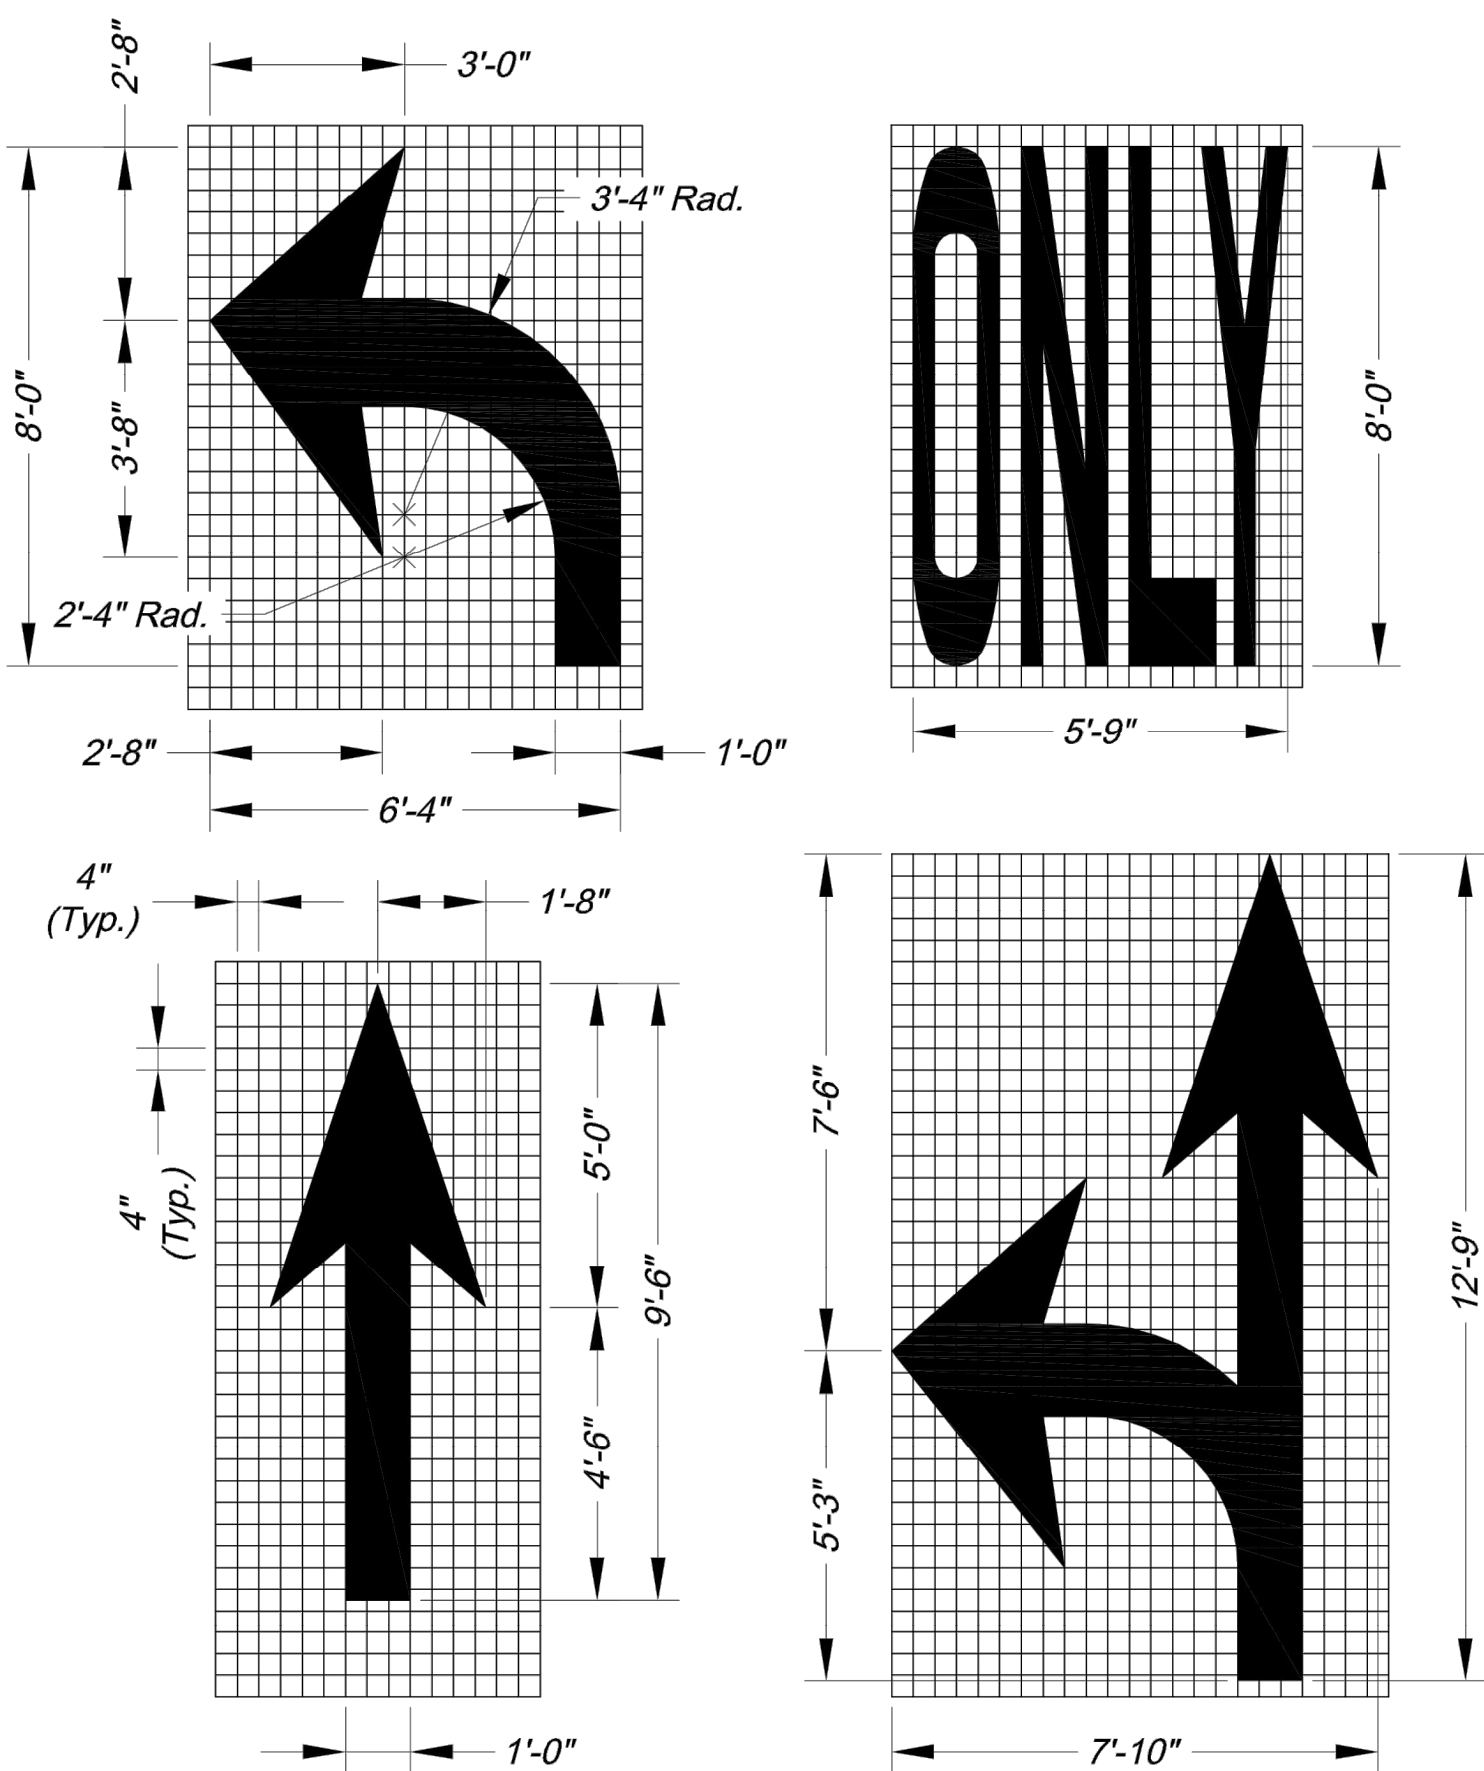


NOTES:
1. All arrow and symbol markings shall be white, and shall be centered in their respective traffic lanes.
2. Right-turn and combination right-turn/straight arrows are reverse of arrows shown.

ARROW AND SYMBOL DETAILS

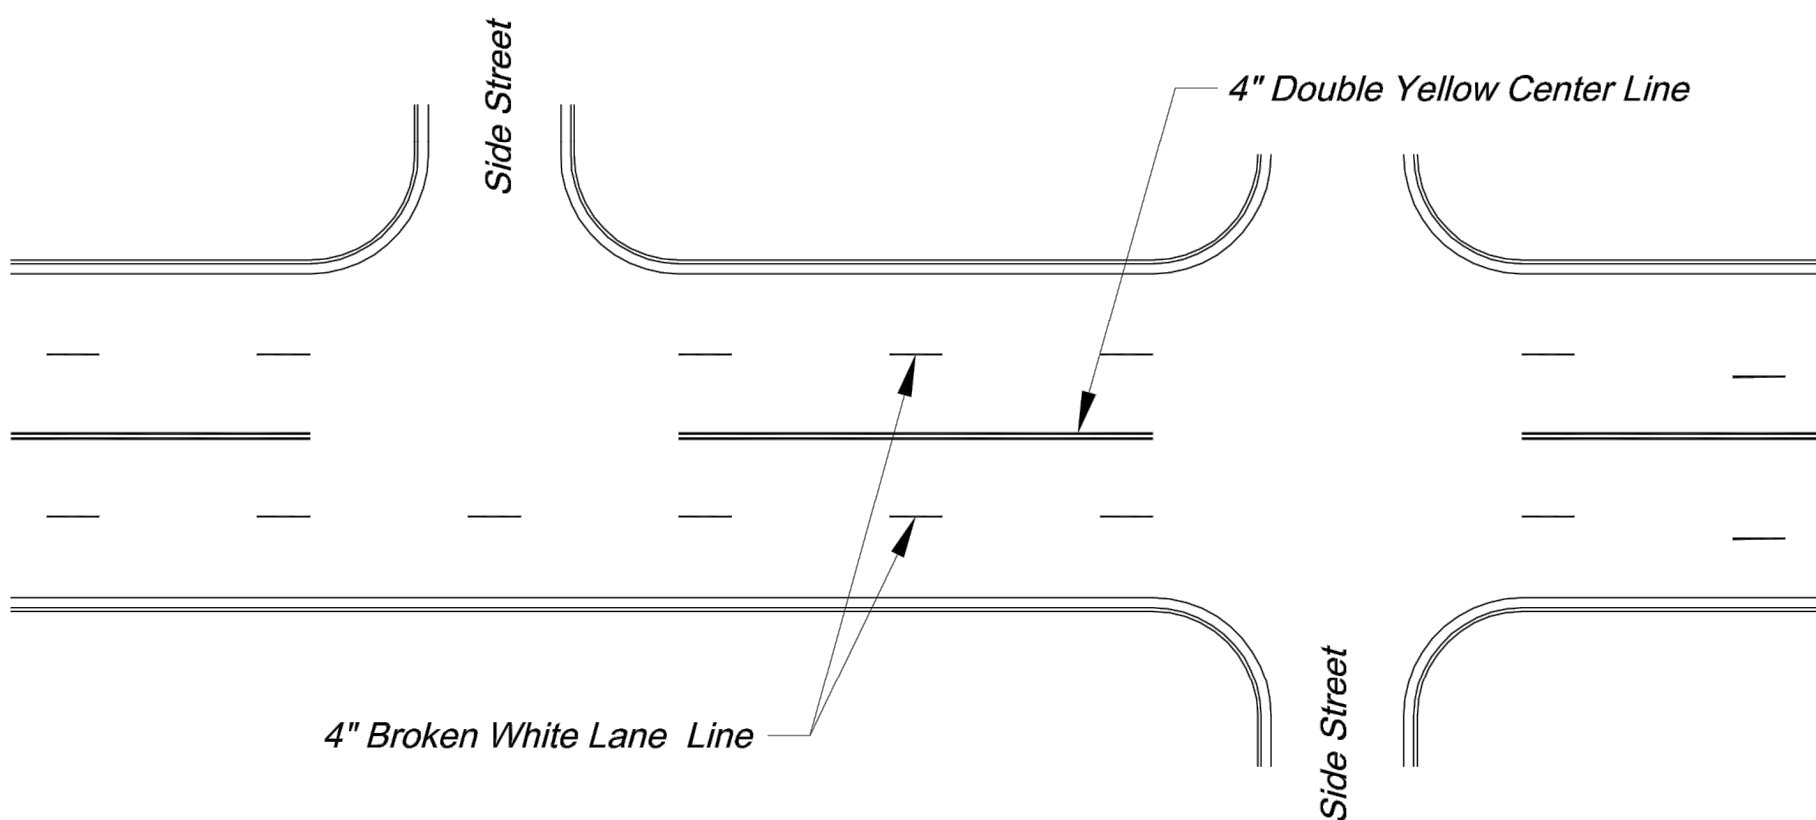


TYPICAL MARKINGS FOR FOUR-LANE UNDIVIDED ROADWAY

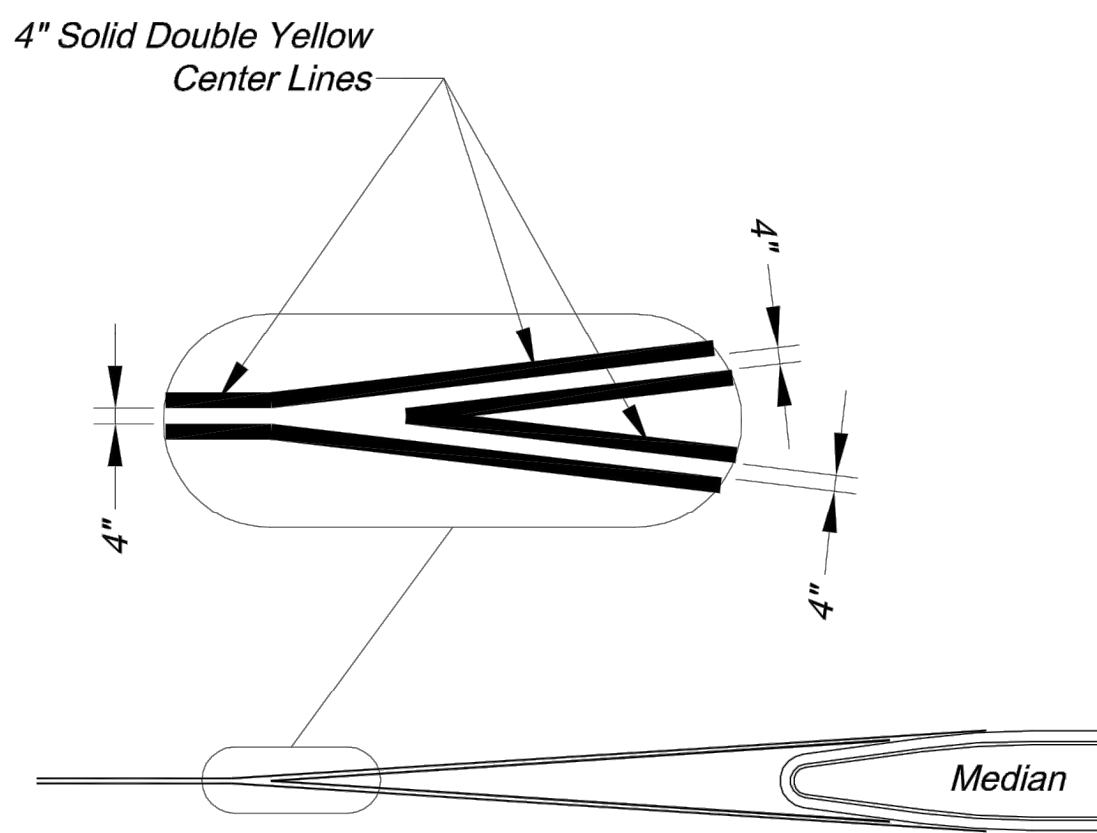

TYPICAL MEDIAN NOSE CENTER LINE DETAIL


PAVEMENT MARKING GENERAL NOTES:
1. All pavement markings shall be in accordance with the latest edition of the *Manual on Uniform Traffic Control Devices (MUTCD)*.
2. All words and symbols shall conform to the latest edition of *Standard Alphabets for Highway Signs and Pavement Markings* printed by the U.S. Department of Transportation, Federal Highway Administration.
3. Pavement markings, either temporary or permanent are required at all times if the roadway is open to traffic.
4. All pavement markings that conflict with the desired markings shall be completely removed. Removals shall not leave the road surface scarred with an image that misleads traffic. Any excess damage or scarring of pavement shall be repaired at the Contractor's expense.
5. The proposed permanent markings shall be laid out by the Contractor in advance of the marking installation. Markings shall not be applied until the layout has been approved by the City Traffic Engineer.
6. Center lines shall be marked on all undivided arterial streets, and any other undivided street with more than two lanes and/or a speed limit of 30 mph or more.
7. Edge lines shall be marked on all non-curbed streets.

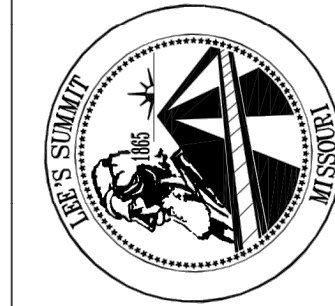


CITY OF LEE'S SUMMIT
PUBLIC WORKS DEPARTMENT
ENGINEERING DIVISION
220 SE GREEN STREET
LEE'S SUMMIT, MISSOURI 64063
PHONE: (816) 969-1800 FAX: (816) 969-1809

Project:
ROADWAY MARKING DETAILS
Sheet Name: STANDARD DRAWING PM-1

Drawn By: AS
Checked By: JW
Date: 09/09/2009
Project#

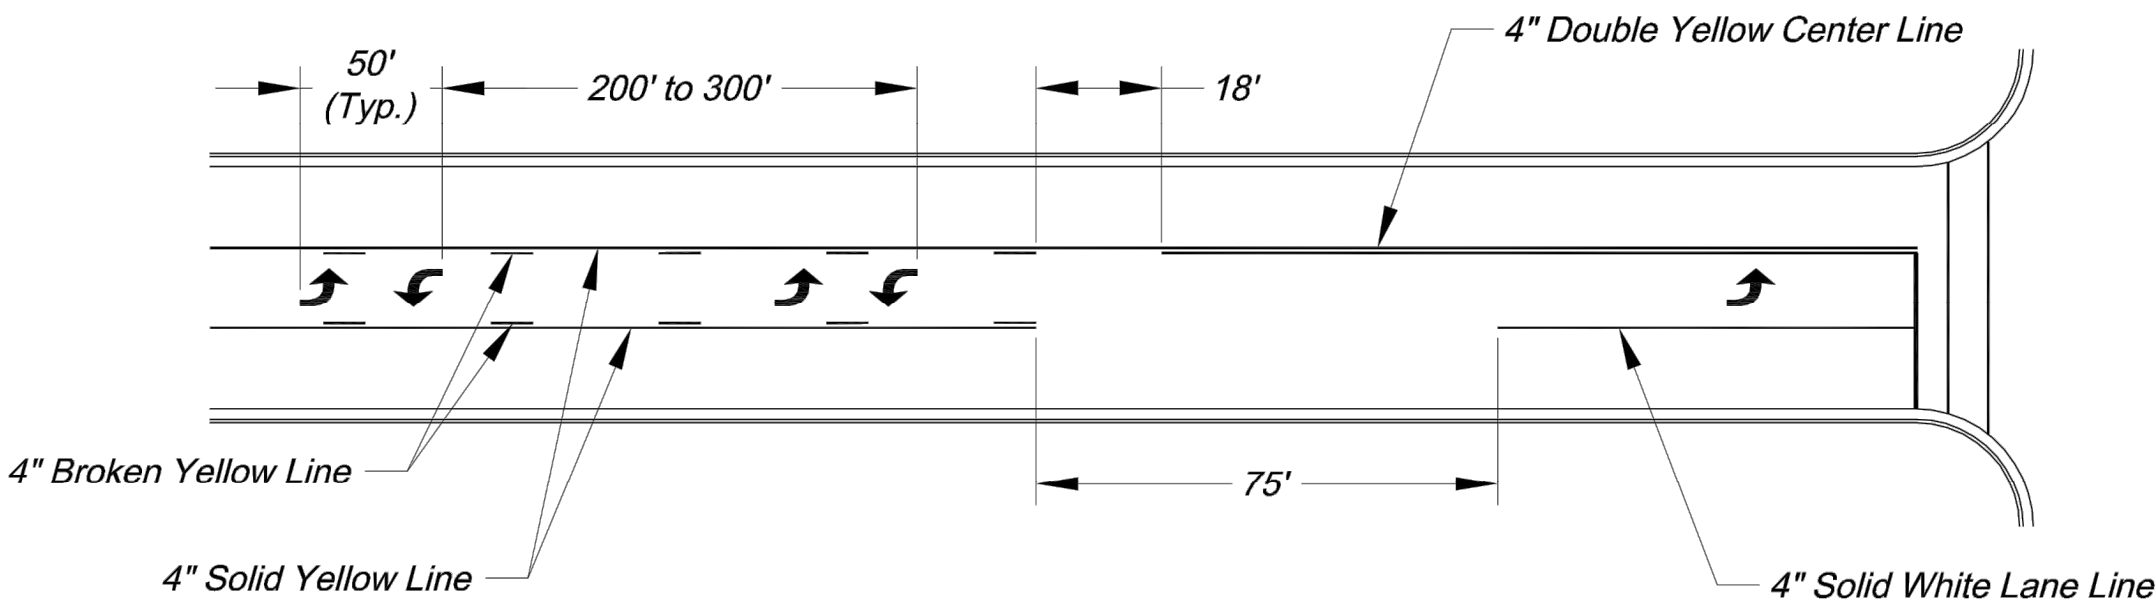


TYPICAL MARKINGS FOR TWO-WAY LEFT-TURN LANE

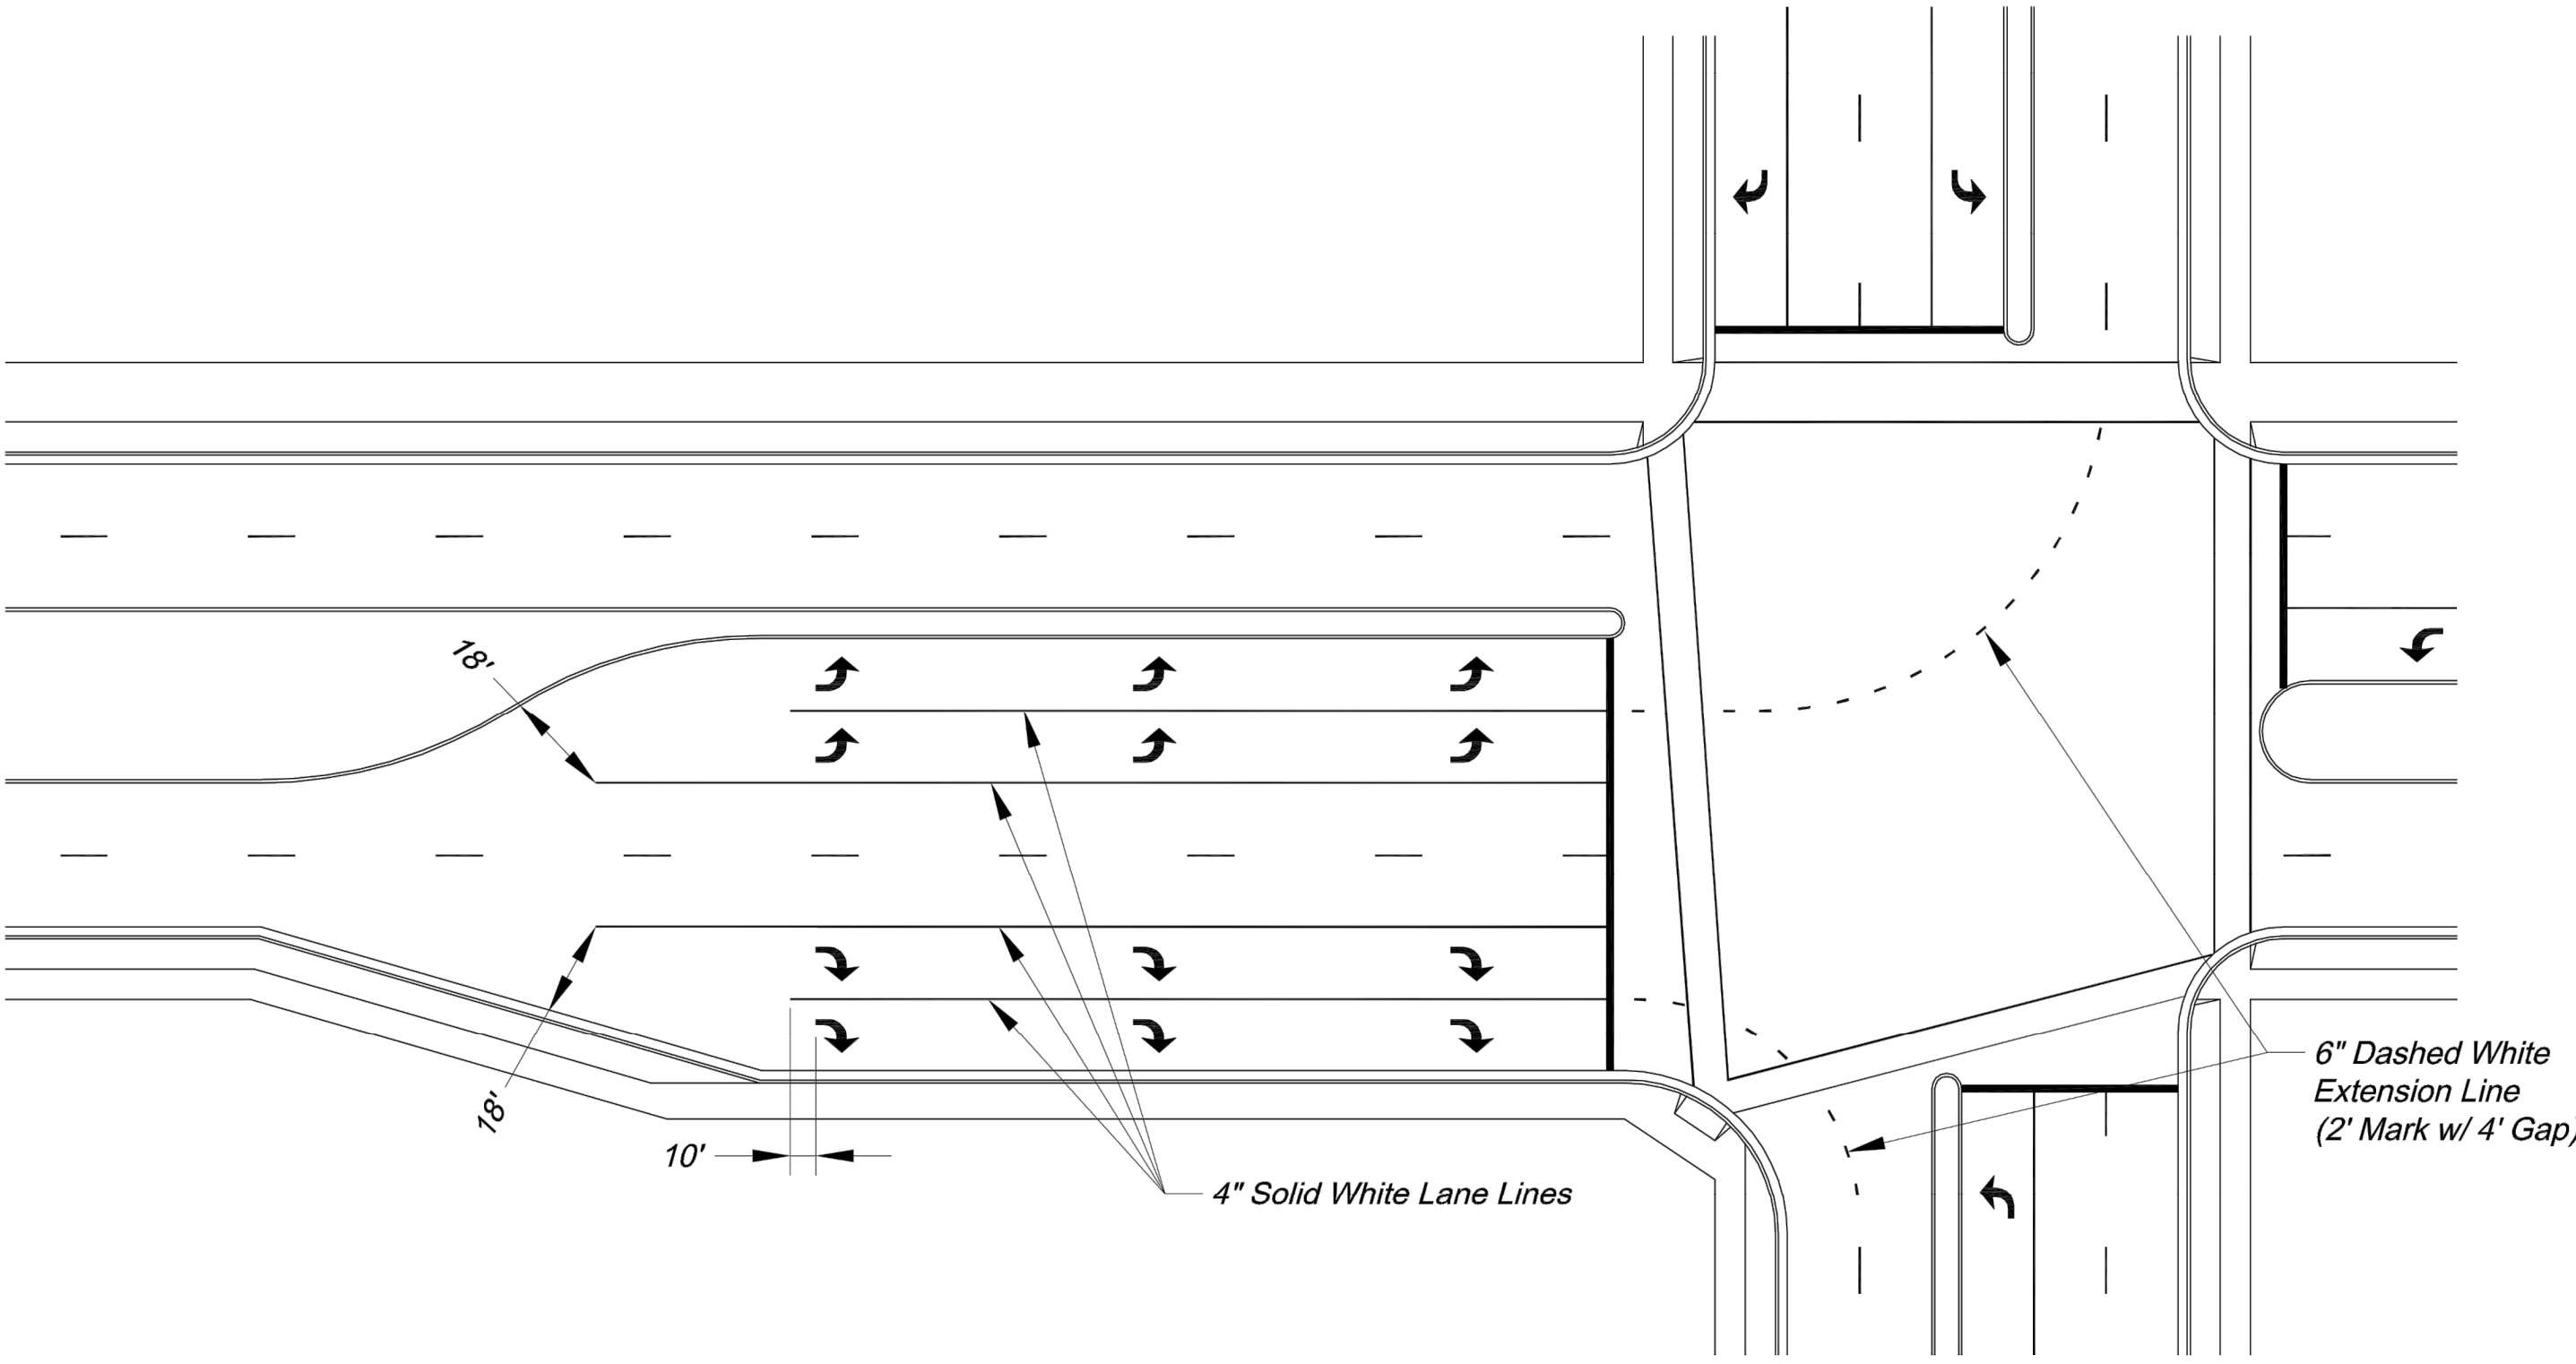

TYPICAL DUAL TURN LANE MARKINGS


NOTE:
1. Dashed extension lines shall not extend through crosswalks.

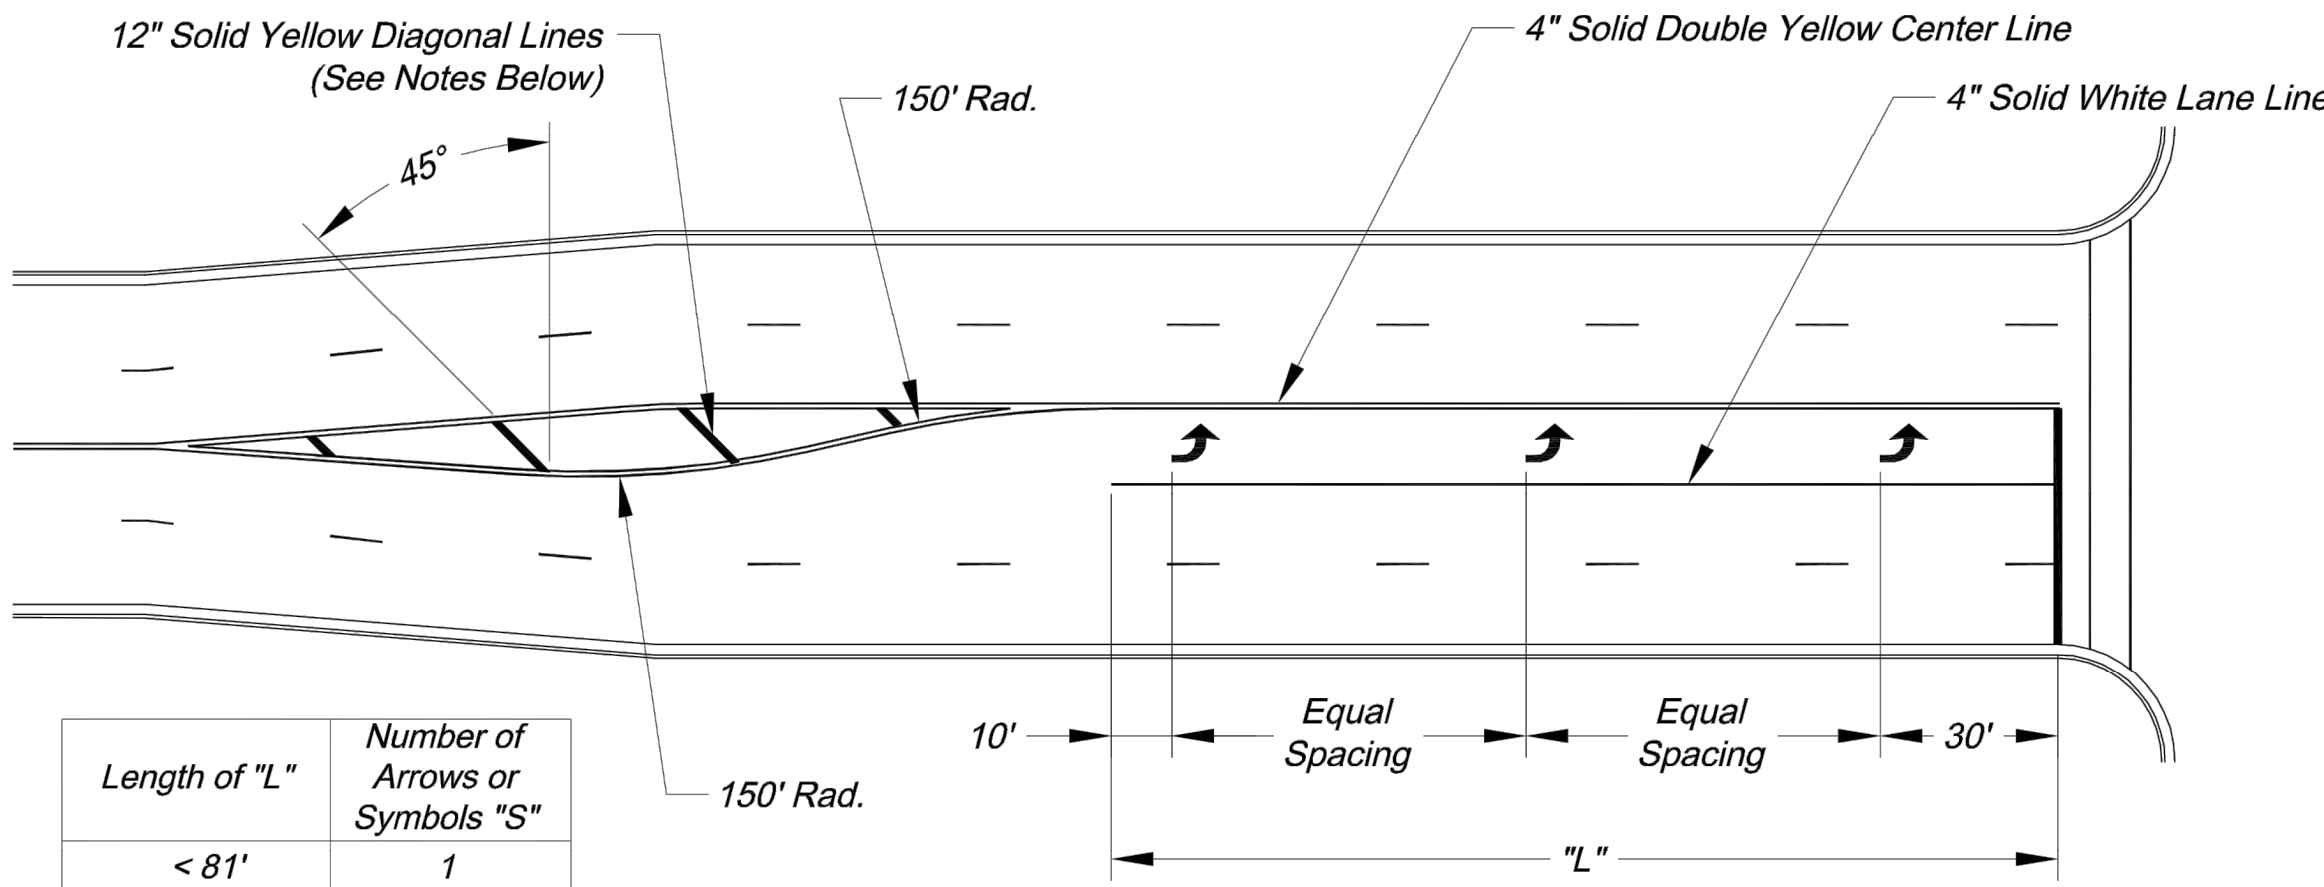

Length of "L"	Number of Arrows or Symbols "S"
< 81'	1
81' - 120'	2
121' - 200'	3
201' - 280'	4
281' - 360'	5
361' - 440'	6

TYPICAL TURN LANE MARKINGS

NOTES:
1. Diagonal lines are required between centerlines if the width of the area between the center lines is greater than 12' and/or the length of the area between center lines is greater than 250'.
2. Diagonal lines should be spaced at 5' increments, equal to the posted speed limit.
3. Equal Spacing is calculated as $(L - 40) / (S - 1)$.
4. When a through lane of traffic terminates as a mandatory turn lane, Arrow and "ONLY" symbols should be marked in the turn lane, in alternating order. The first and last symbols should be Arrows.

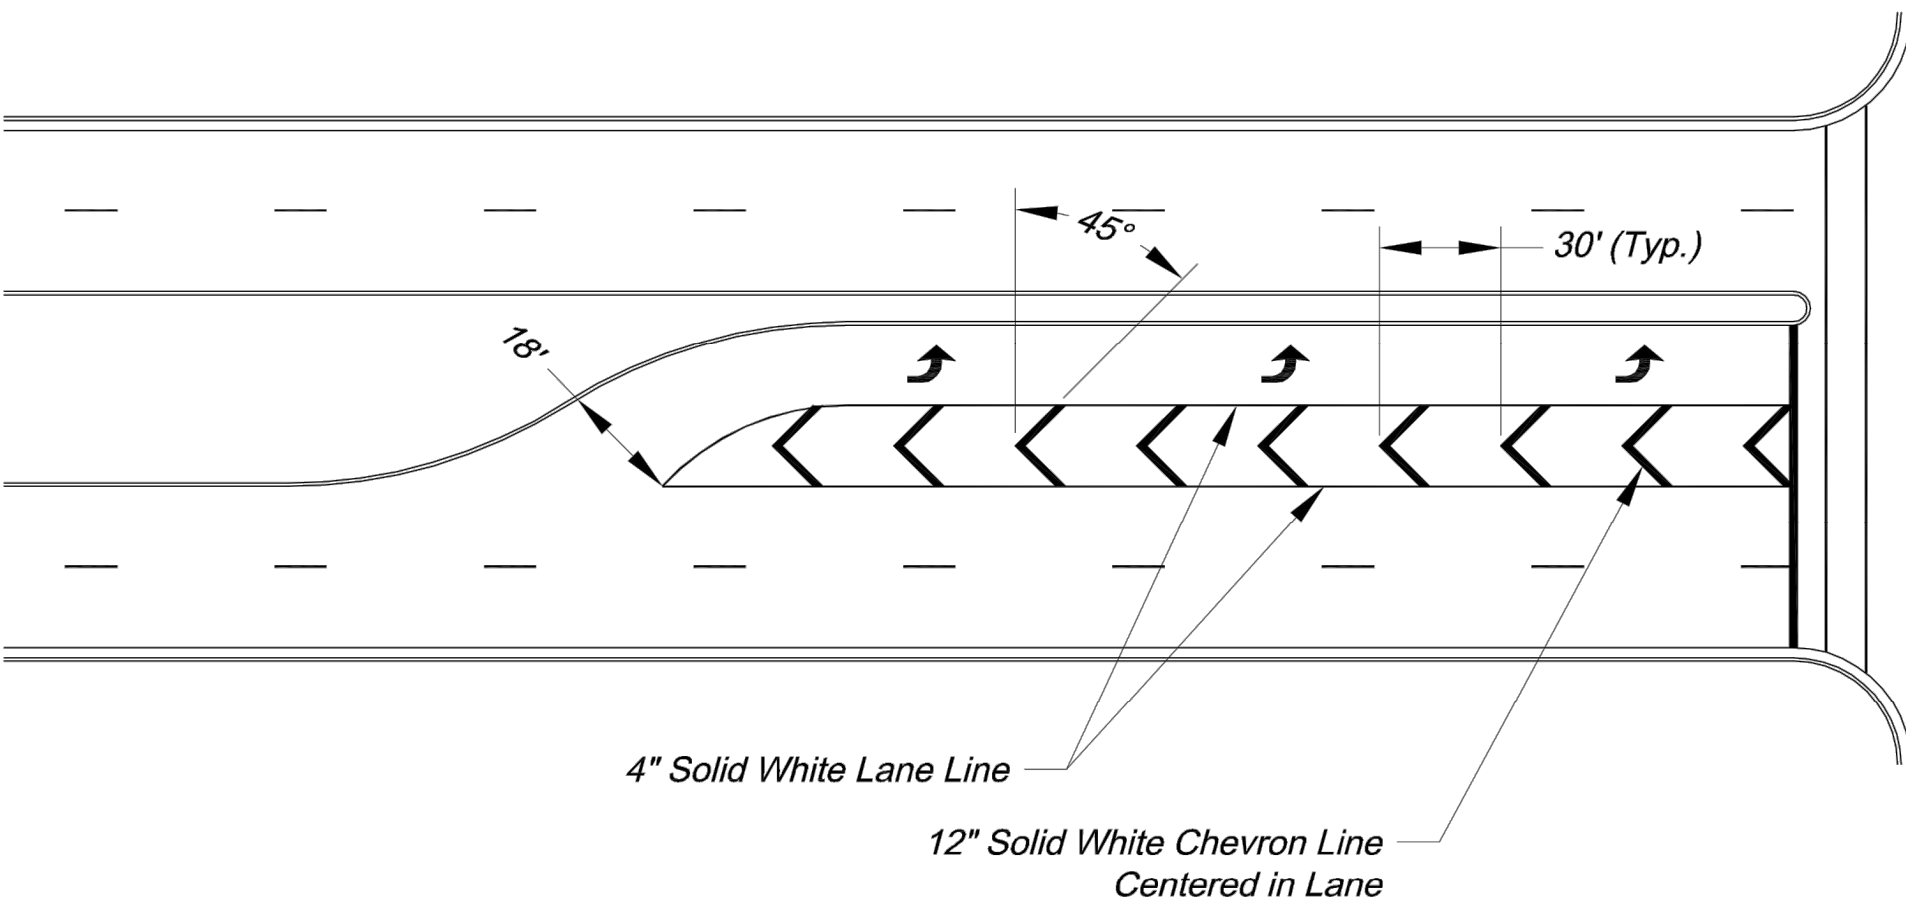

TYPICAL STRIPED OUT TURN LANE MARKINGS

CITY OF LEE'S SUMMIT
PUBLIC WORKS DEPARTMENT
ENGINEERING DIVISION
220 SE GREEN STREET
LEE'S SUMMIT, MISSOURI 64063
PHONE: (816) 969-1800 FAX: (816) 969-1809




INTERSECTION MARKING DETAILS


STANDARD DRAWING PM-2

Project:


Drawn By: AS
Checked By: JW
Date: 09/09/2009
Project#

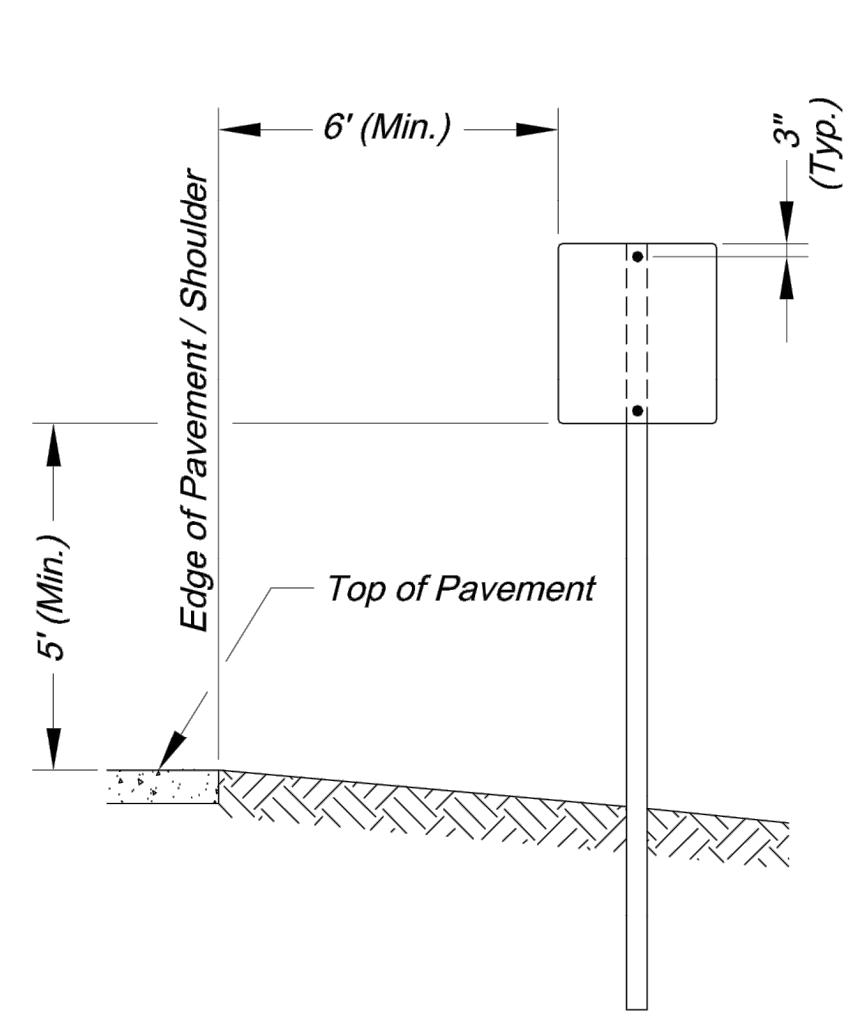


SIGN INSTALLATION FOR
NON-CURBED STREET

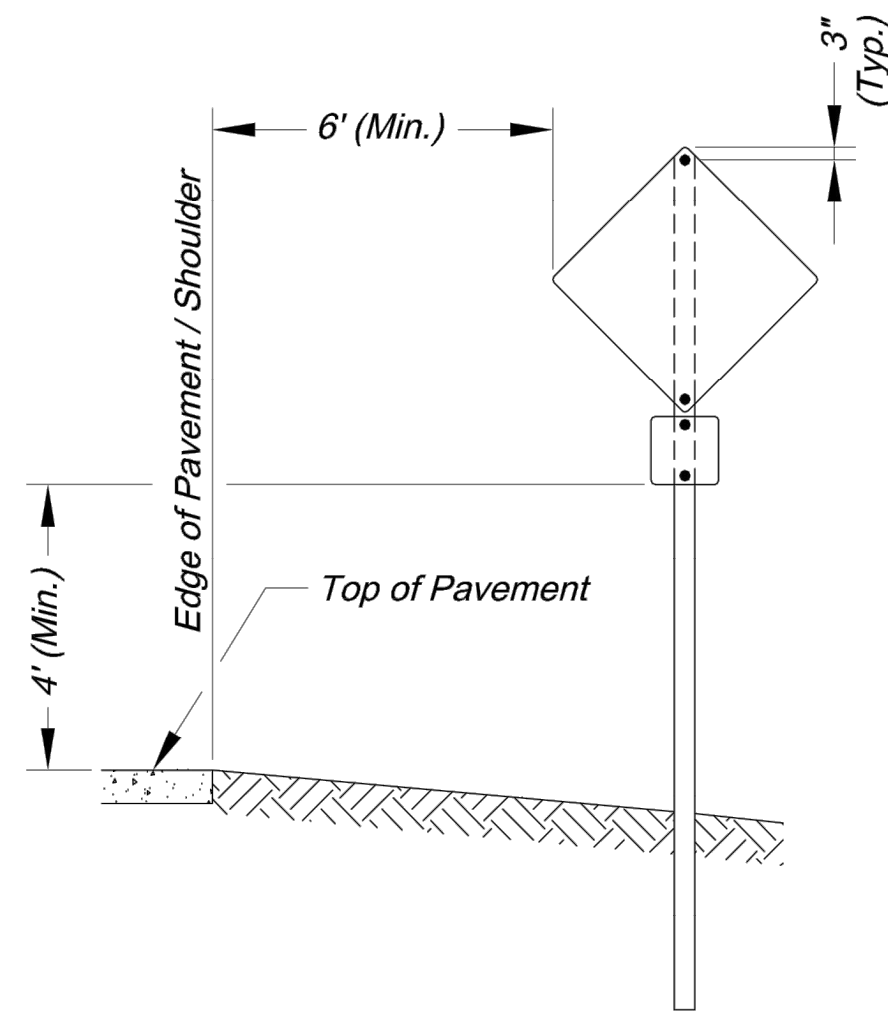


SIGN INSTALLATION WITH
AUXILARY SIGN FOR
NON-CURBED STREET

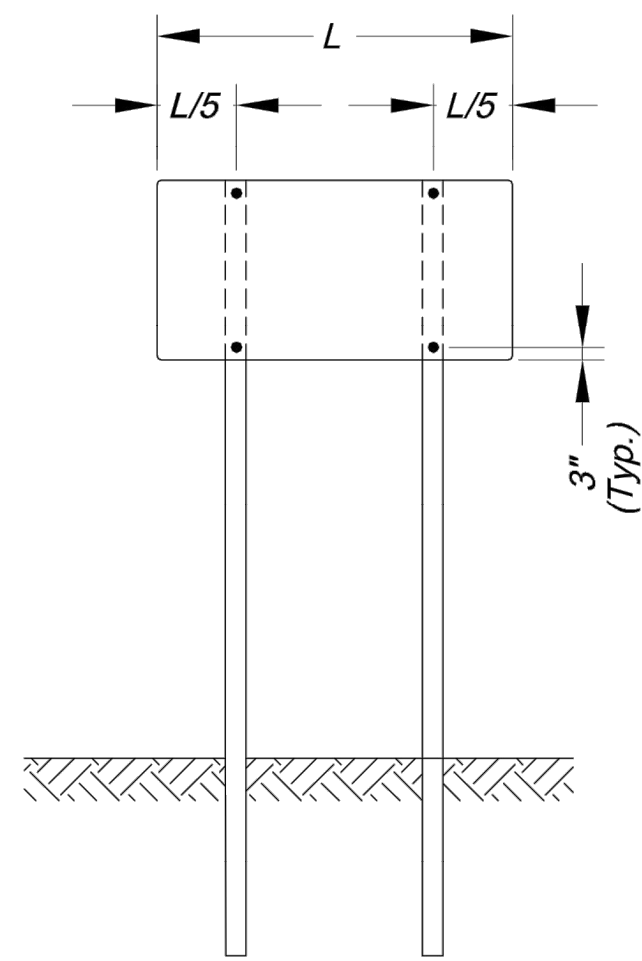


SIGN INSTALLATION WITH
TWO SIGN POSTS

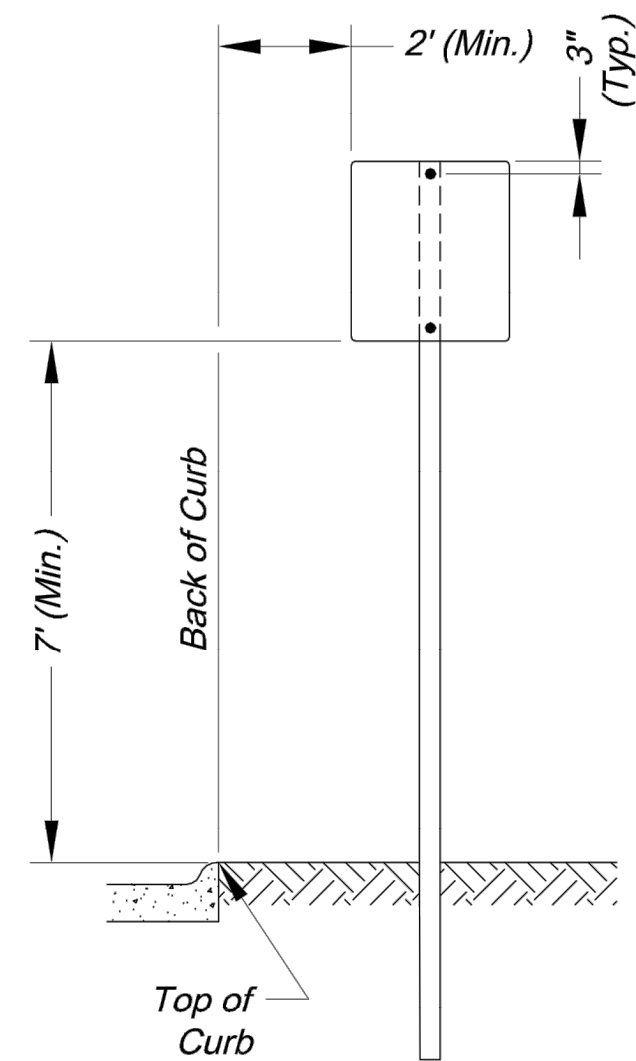

SIGN INSTALLATION FOR
CURBED STREET

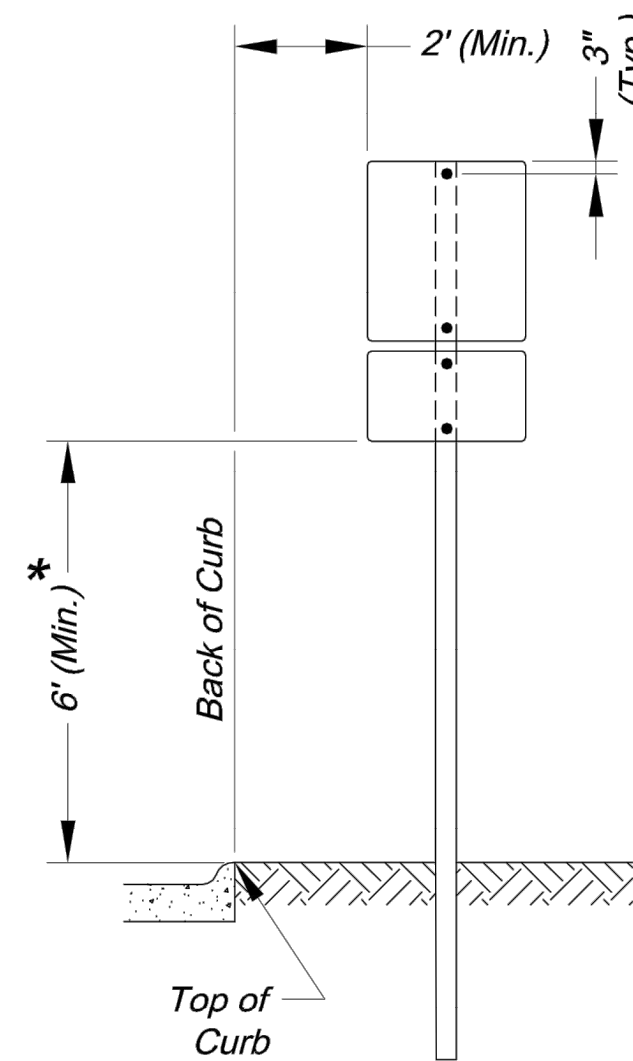

SIGN INSTALLATION WITH
AUXILARY SIGN FOR
CURBED STREET

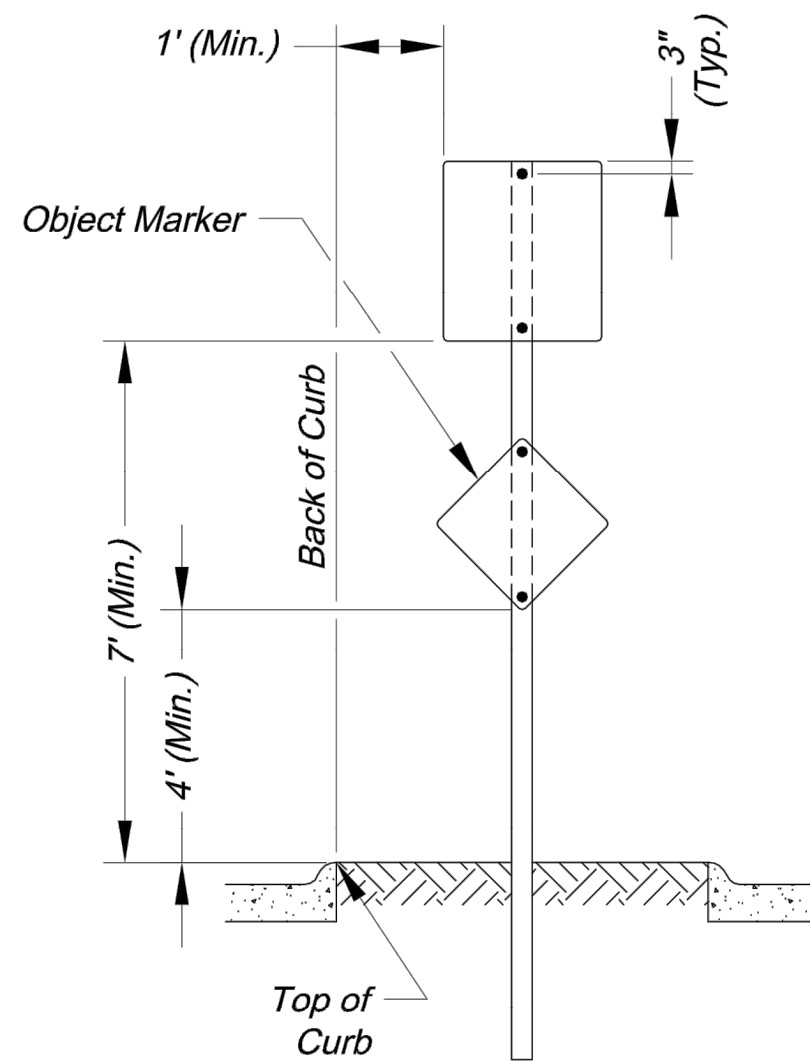


SIGN INSTALLATION FOR
RAISED MEDIANS

SIGN MOUNTING DETAILS


* The height to the bottom of a sign when it is located in a pedestrian walkway or extends into a walkway shall be a minimum of 80 inches above the walkway.

NOTE:

- Generally, the sign mounting height should not be more than 1' greater than the minimum mounting height.

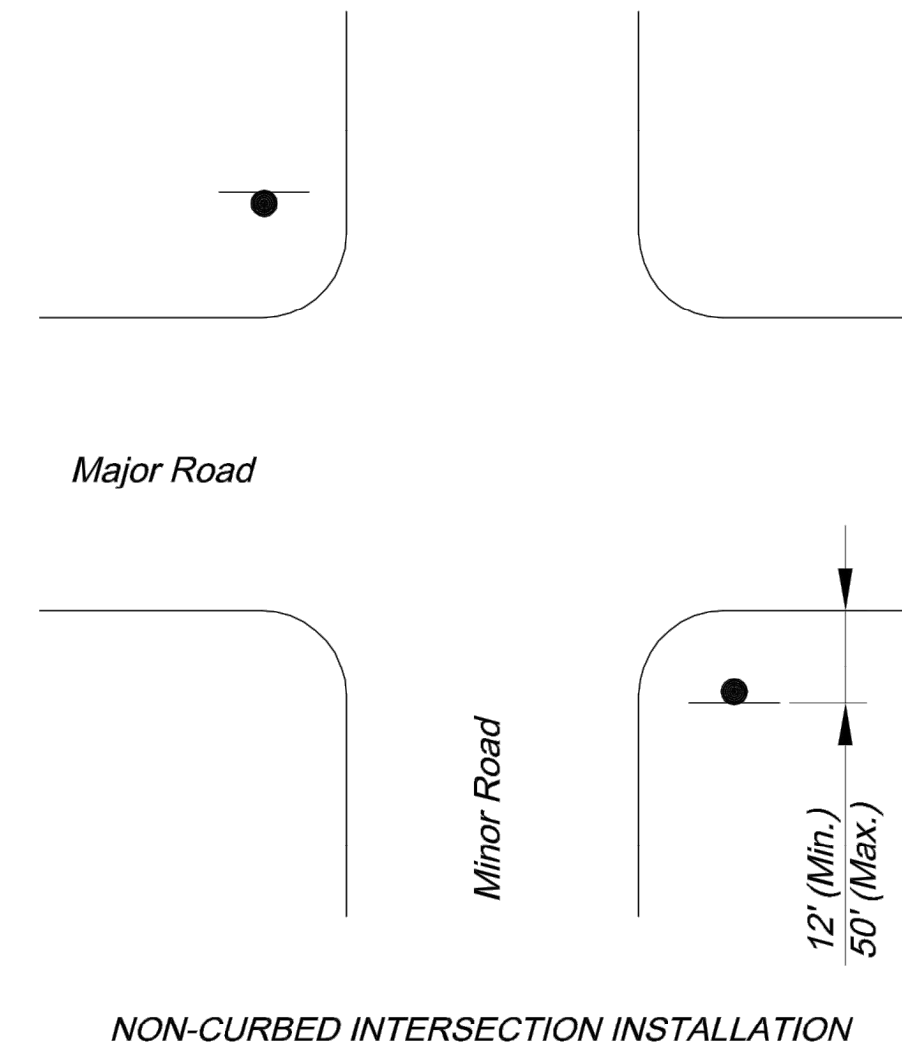


NON-CURBED INTERSECTION INSTALLATION

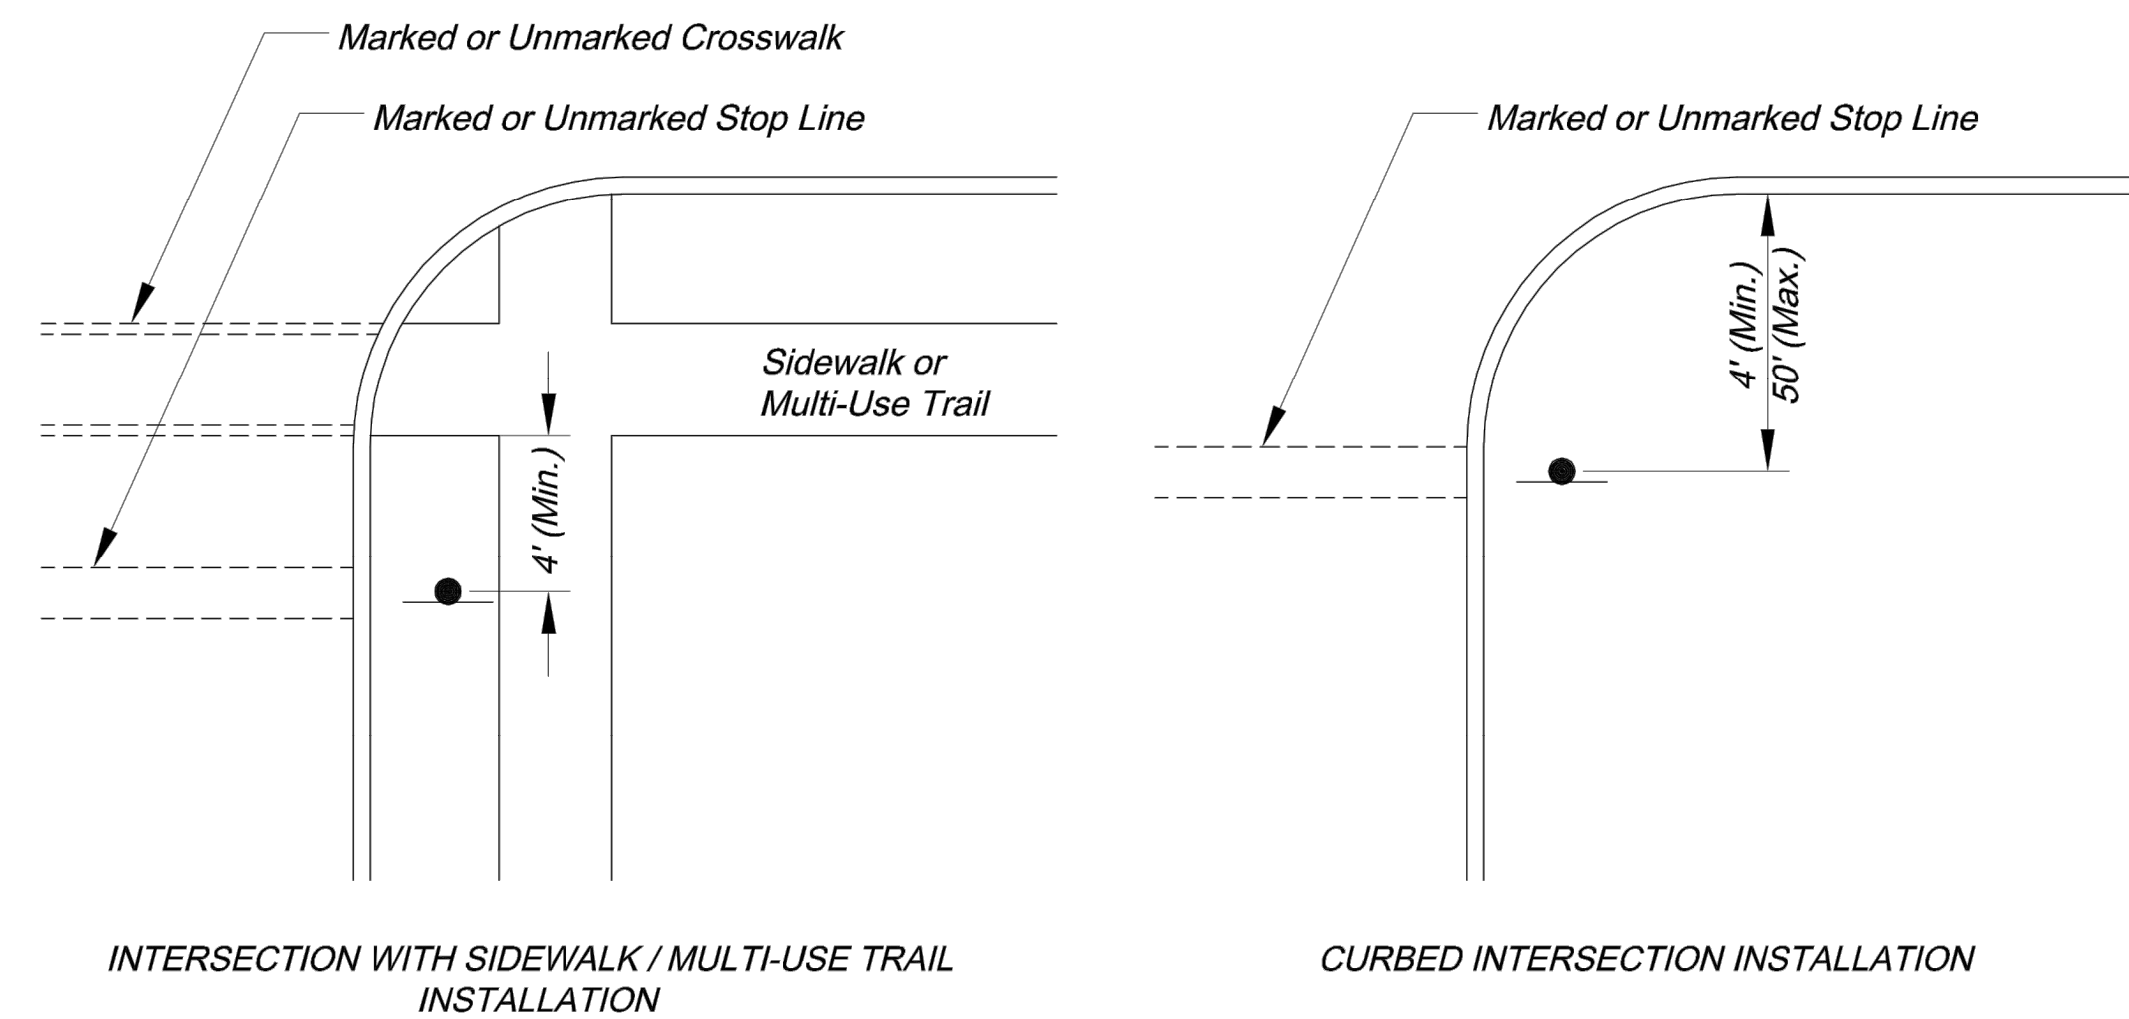

INTERSECTION WITH SIDEWALK / MULTI-USE TRAIL
INSTALLATION

CURBED INTERSECTION INSTALLATION

CONTROL SIGN LOCATION

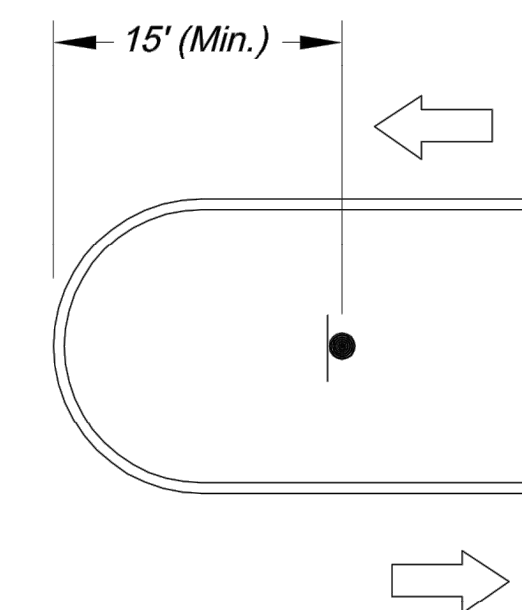


TYPICAL MEDIAN SIGN LOCATION

MEDIAN SIGN LOCATION

NOTES:

- A 4" P.V.C. sleeve shall be installed in new concrete medians at each location where a sign is to be installed.
- For existing concrete medians, a 4" hole shall be cored into the concrete.

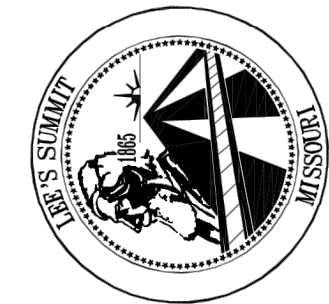

CITY OF LEE'S SUMMIT
PUBLIC WORKS DEPARTMENT
ENGINEERING DIVISION
220 SE GREEN STREET
LEE'S SUMMIT, MISSOURI 64063
PHONE: (816) 969-1800 FAX: (816) 969-1809


SIGN MOUNTING DETAILS

Project:
Street Name: STANDARD DRAWING SN-1

Drawn By: AS
Checked By: JW
Date: 08/26/2009
Project#

1 OF 3


1

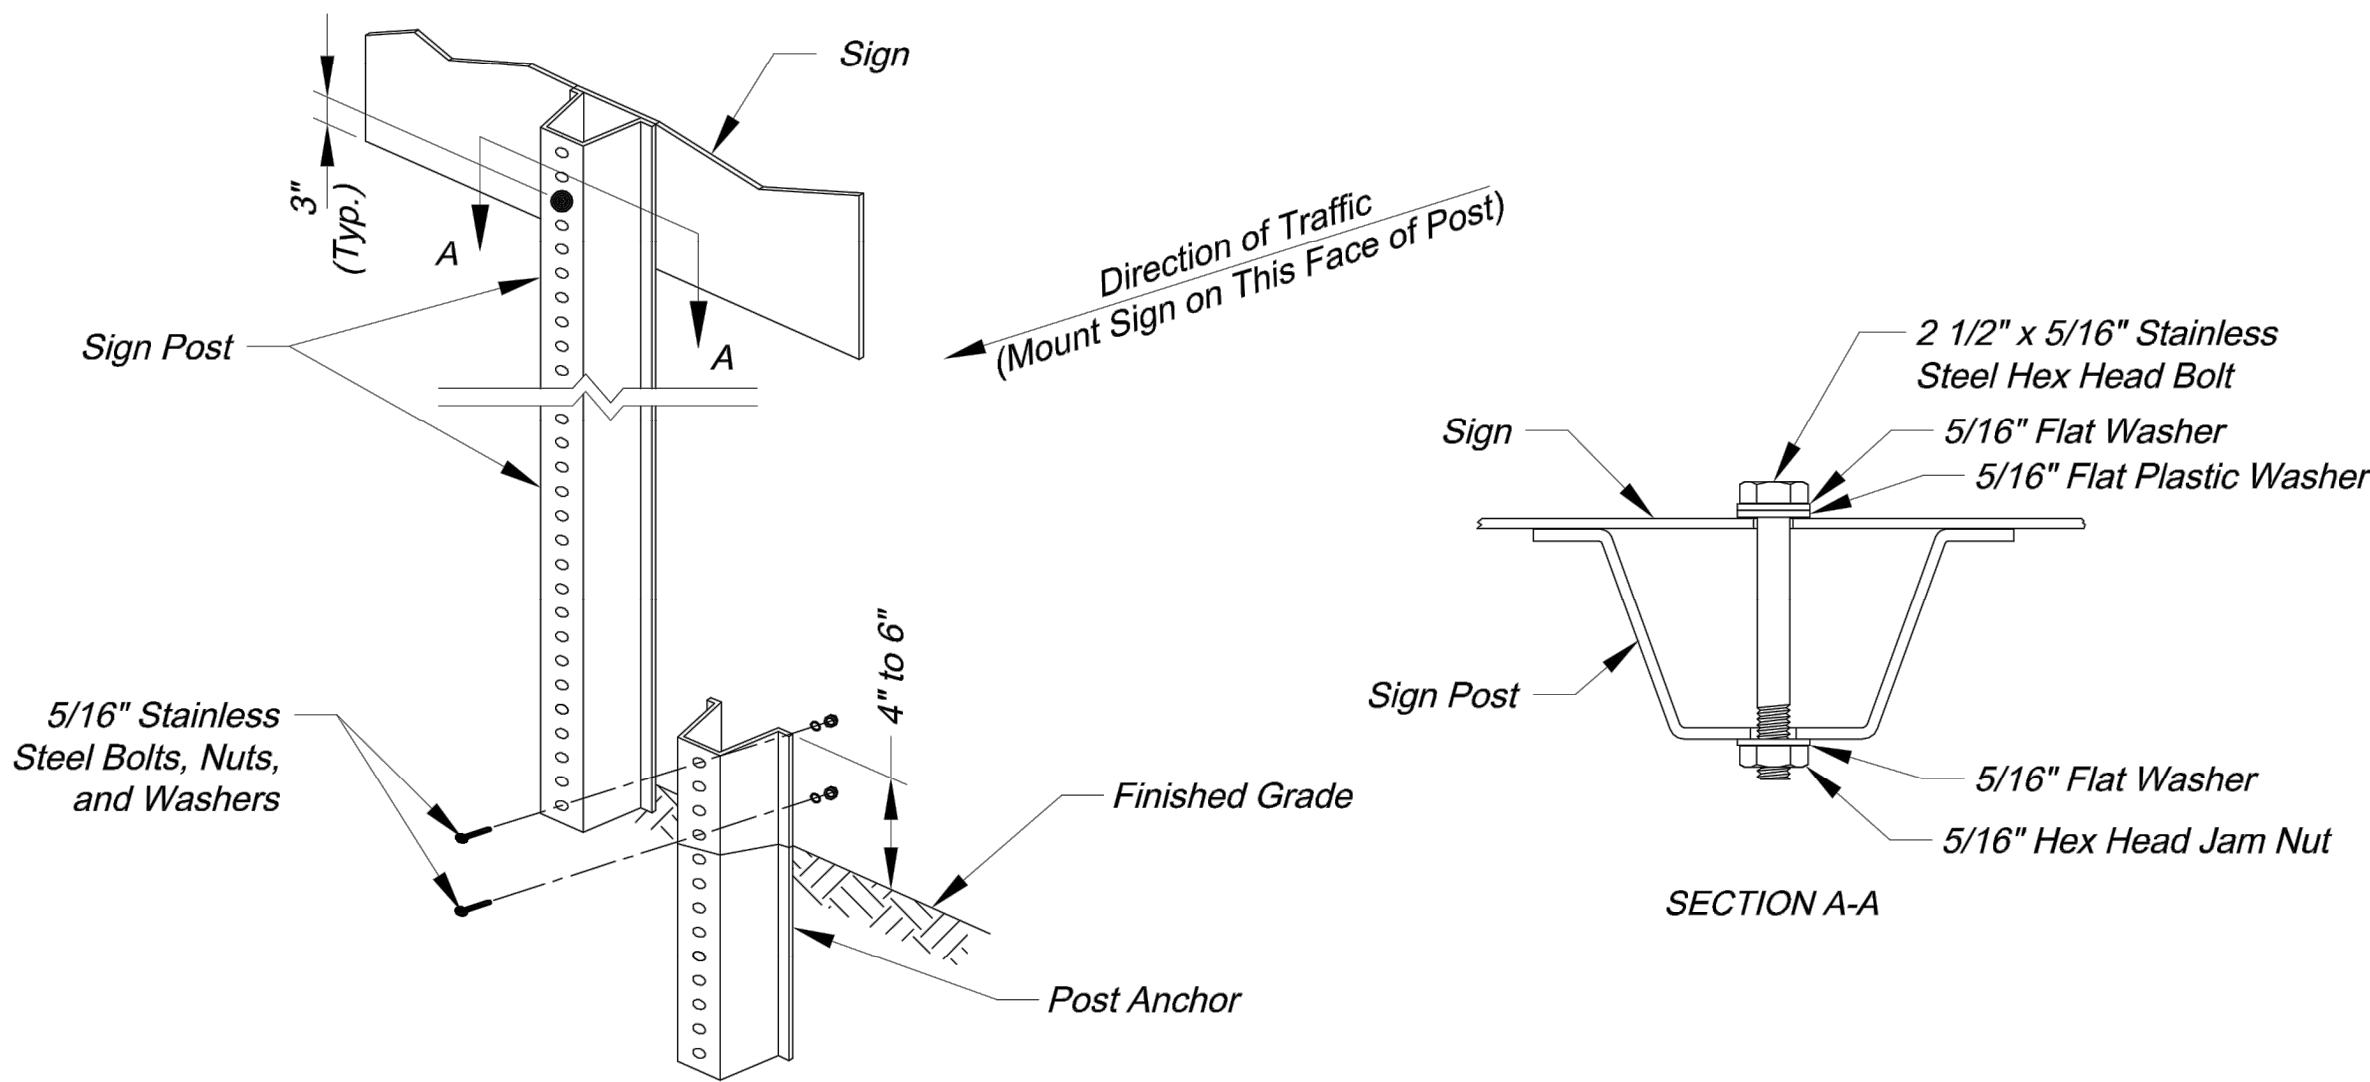

U-STEEL POST DETAILS

U-STEEL POST NOTES:

1. Splice shall be positioned entirely between finished grade line and 18" above finished grade line. Only one splice will be allowed per post.
2. U-Steel post shall be 3 lb./ft., galvanized according to ASTM A123.
3. U-Steel post can be used for installation of signs with an area of less than 2.5 square feet.
4. All posts shall be embedded a minimum of 3 feet.

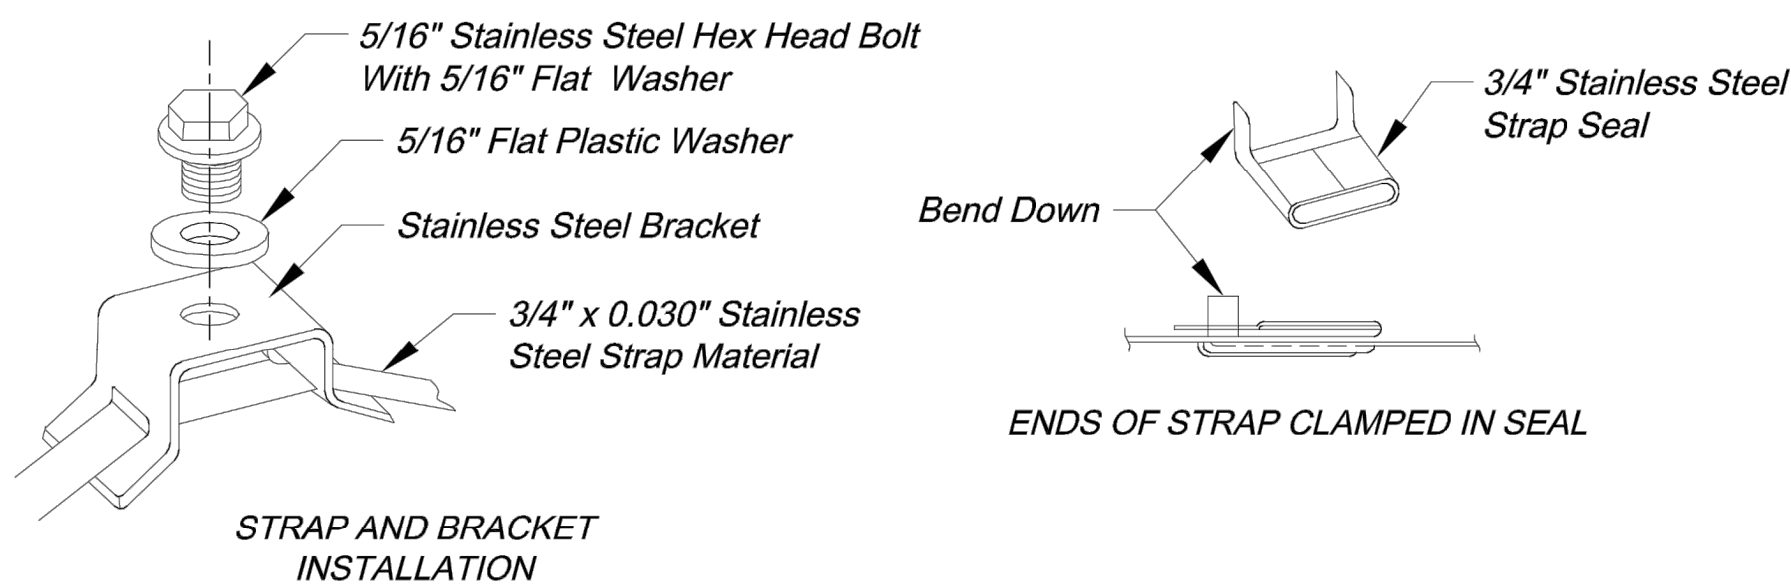

STRAP TYPE SIGN SUPPORT DETAILS

METAL POLE SIGN MOUNTING NOTES:


1. Signs on metal poles shall be attached with two brackets and stainless steel bands.
2. Holes in sign for attachment to the mounting brackets shall be offset a minimum of 2 inches from the edge of the sign.
3. Holes in sign shall be located such that the sign is level.
4. All strap, bracket, and seal materials should be Type 201 stainless steel.

PERMANENT SIGNING GENERAL NOTES:

1. All signing shall be in accordance with the latest edition of the Manual on Uniform Traffic Control Devices (MUTCD).
2. The Contractor is responsible for avoiding any and all utilities when installing sign posts, whether the utility is indicated on the plans or not.
3. All workmanship and materials shall be subject to the inspection and approval of the Public Works Department of the City of Lee's Summit.
4. The Contractor shall stake the location of all sign posts to be installed. The City Inspector shall inspect the staking prior to installation. Minor relocation to avoid conflicts may be allowed with the approval of the City Traffic Engineer or designee.
5. Signs shown to be installed on the side of metal poles shall be mounted with stainless steel straps or wing brackets as detailed. No signs are to be installed on wood poles. See Traffic Signal Standard Drawings for the installation of signs on mast arms.
6. All post mounted signs shall be installed with breakaway anchors according to the Standard Drawings.
7. All existing signs will be used in place during construction and protected from damage unless otherwise indicated in the plans. If the Contractor damages any existing sign or posts during construction, the Contractor will be required to replace the damaged materials with new signs or posts of the same type and size at the Contractor's expense. The Contractor shall be responsible for removing and storing any signs that are to be reinstalled on the project. All equipment shall be reinstalled in good condition.
8. Existing permanent signs and posts removed by the Contractor for construction purposes which are not to be reinstalled shall be delivered to the City's Public Works Maintenance Facility (1971 SE Hamblen Road). The Contractor shall be responsible for removing and storing equipment in good condition and is fully responsible for the equipment until it is delivered.
9. All Stop, Yield, or street name signs shall be maintained in a conspicuous location for the driving public. All Stop and Yield signs removed for construction purposes can be temporarily erected in reflectorized drums (no less than 7 feet above the pavement surface) until they can be reinstalled. Any temporary Stop or Yield sign installation to be left in place overnight will require prior approval from the City Inspector.

SQUARE STEEL POST INSTALLATION SEQUENCE:

1. Sign post anchor driven partially into the ground using a drive cap with a sledge or power equipment.
2. Anchor sleeve slipped over anchor and drive into the ground together with the sign post anchor.
3. Insert sign post into the post anchor and bolt in place.

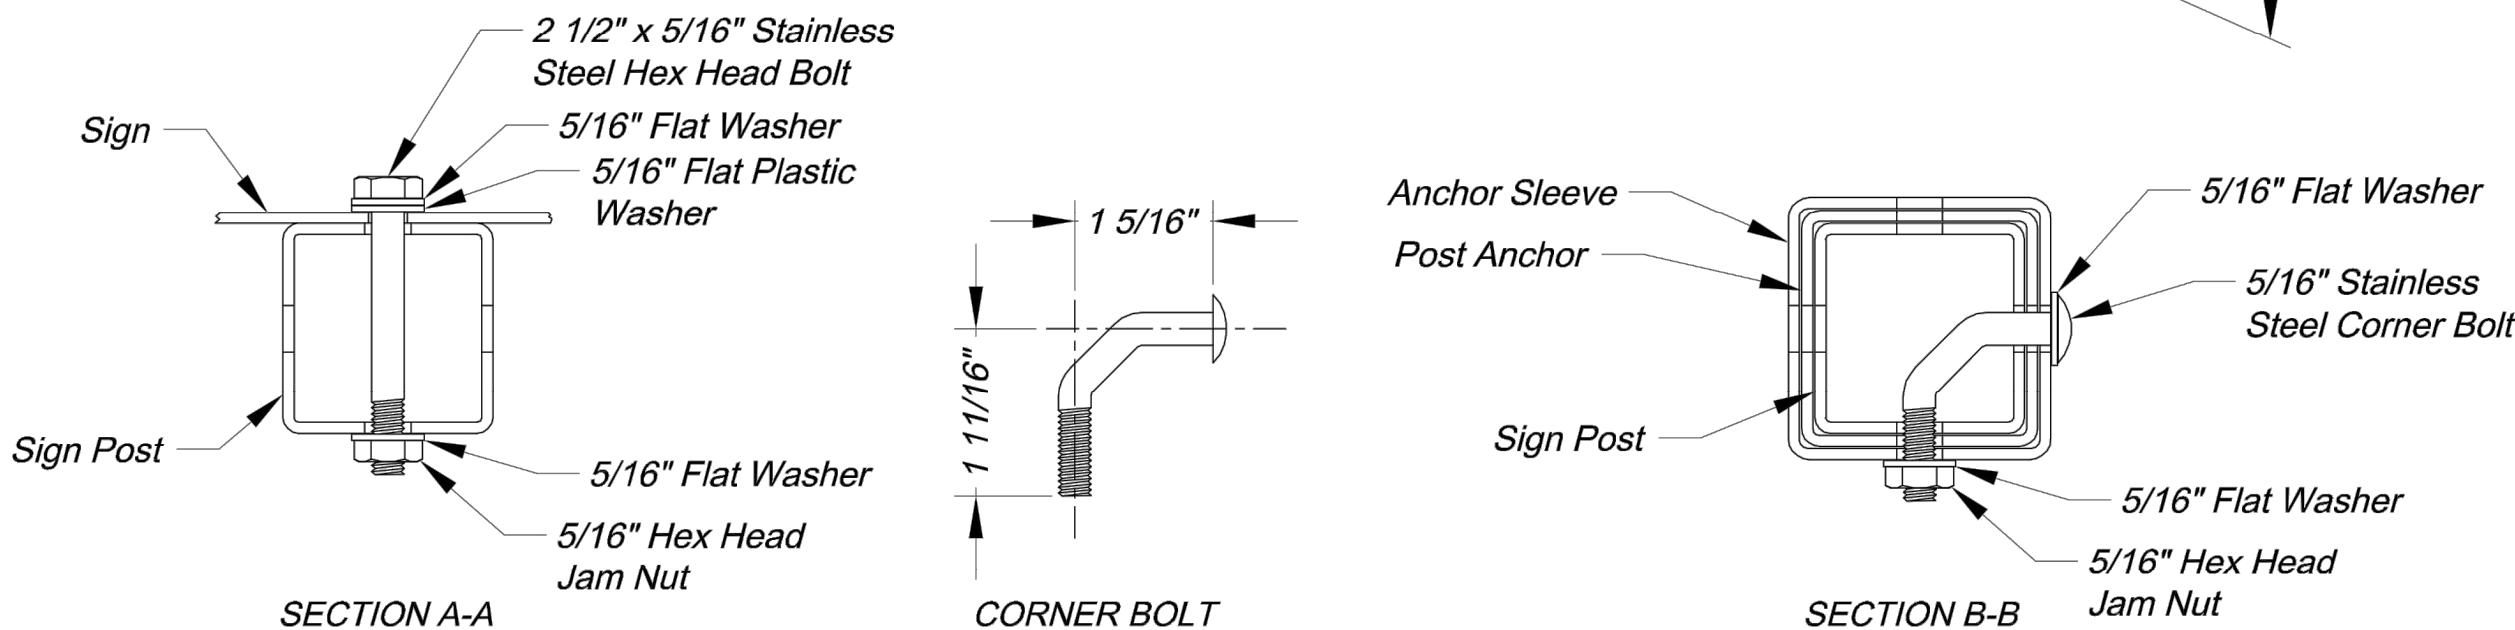

SQUARE STEEL POST DETAILS

SQUARE STEEL POST NOTES:

1. Square steel sign posts and break-away anchor shall consist of the following materials:
 - Sign Post - 14 Ga. 2" x 2" Square Steel Post
 - Post Anchor - 12 Ga. 2 1/4" x 2 1/4" x 36" Square Steel Post
 - Anchor Sleeve - 12 Ga. 2 1/2" x 2 1/2" x 18" Square Steel Post
2. 14 Gauge posts must meet a certified minimum yield strength of 60,000 psi.
3. In all installations the first hole above the finished grade line on the sign post, anchor, and anchor sleeve must be in line for the insertion of the corner bolt.
4. The maximum area for one sign post is 9.0 square feet. A sign or combination of signs with an area greater than 9.0 square feet will require two posts. Also, signs with a width greater than 36" (not including 36" x 36" diamond shaped signs) will require two posts.

CITY OF LEE'S SUMMIT
PUBLIC WORKS DEPARTMENT
ENGINEERING DIVISION
220 SE GREEN STREET
LEE'S SUMMIT, MISSOURI 64063
PHONE: (816) 969-1800 FAX: (816) 969-1809



SIGN POST DETAILS

STANDARD DRAWING SN-2

Project:

Sheet Name:

Drawn By: AS
Checked By: JW
Date: 08/26/2009
Project#


2 OF 3

2


STANDARD ABBREVIATION LISTS

NAMED STREETS	
AVENUE	Ave
BOULEVARD	Blvd
CIRCLE	Cir
CREEK	Cr
COURT	Ct
CROSSING	Xing
DRIVE	Dr
HIGHWAY	Hwy
LANE	Ln
PARKWAY	Pkwy
PLACE	Pl
ROAD	Rd
STREET	St
TERRACE	Ter
TRAIL	Trl
WAY	Way


NUMBERED STREETS	
FIRST	ST
SECOND	ND
THIRD	RD
FOURTH TO TENTH	TH

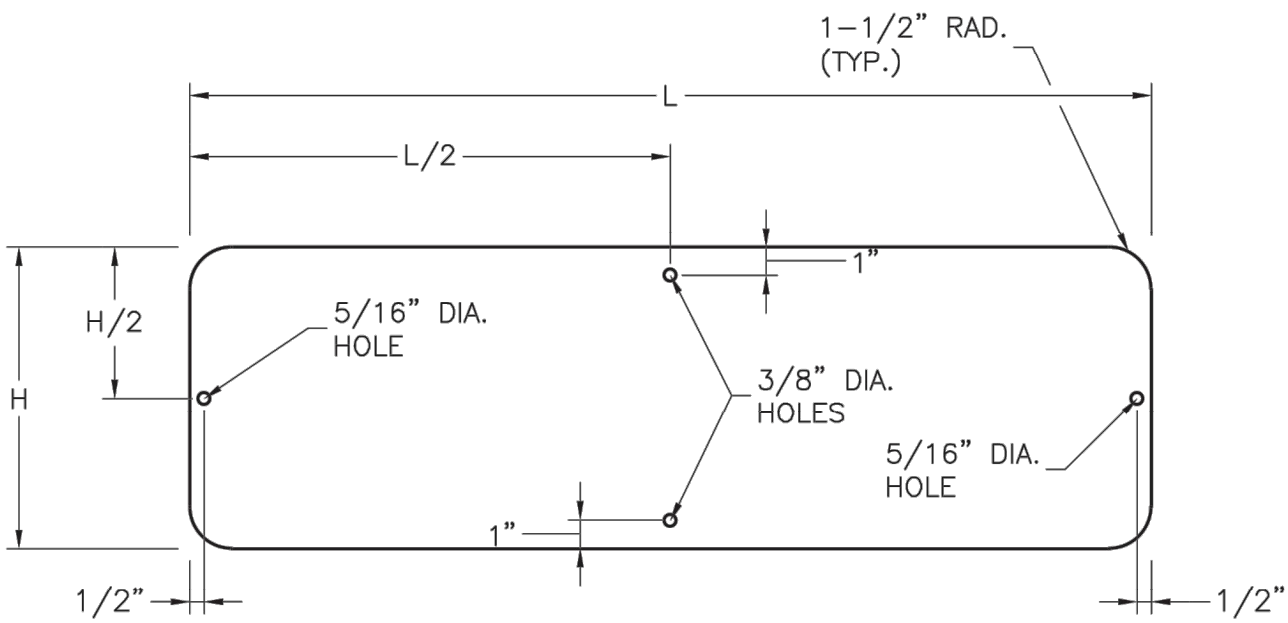


STREET NAME SIGN BLANK DETAILS
FOR MOUNTING ON SQUARE STEEL POSTS

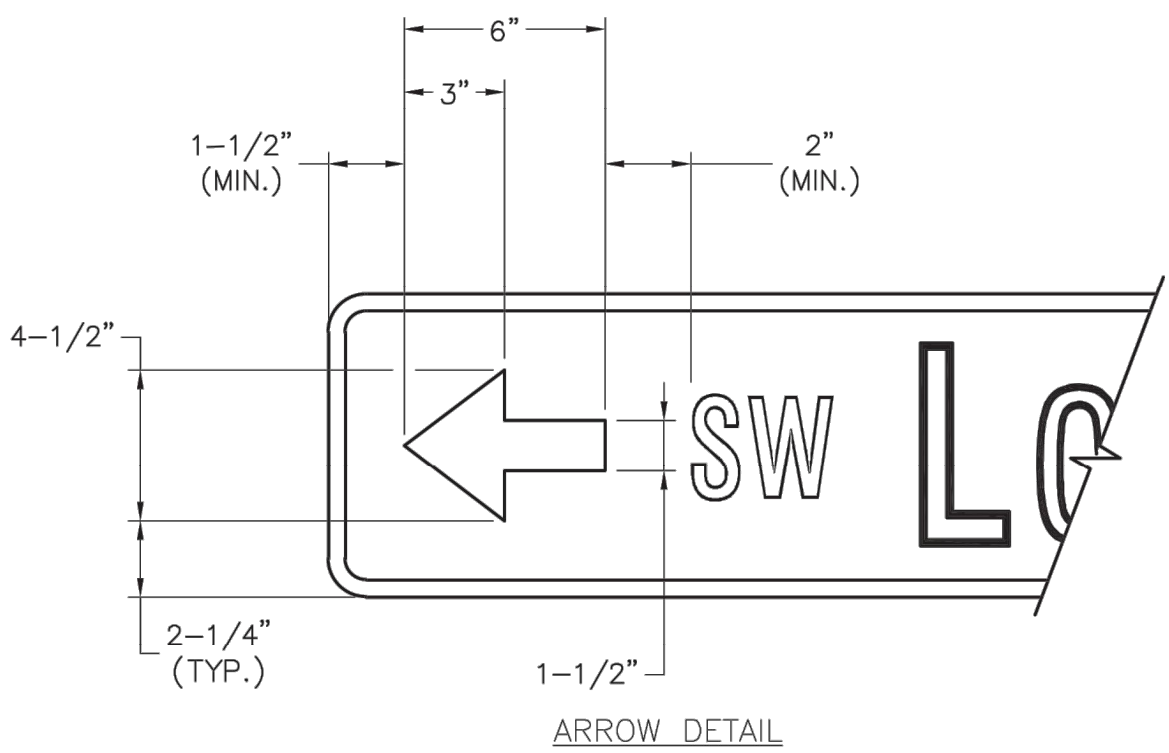

ARROW DETAIL

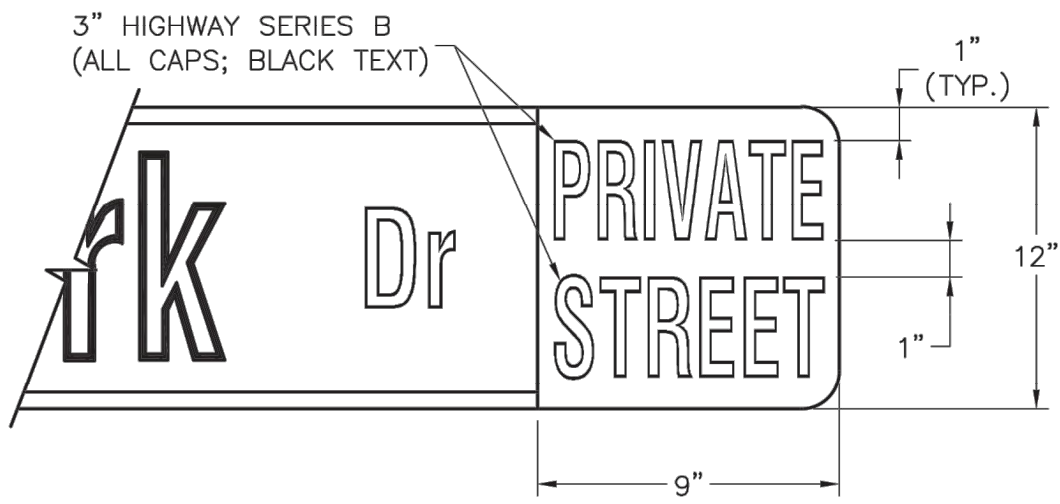


PRIVATE STREET TAG DETAIL

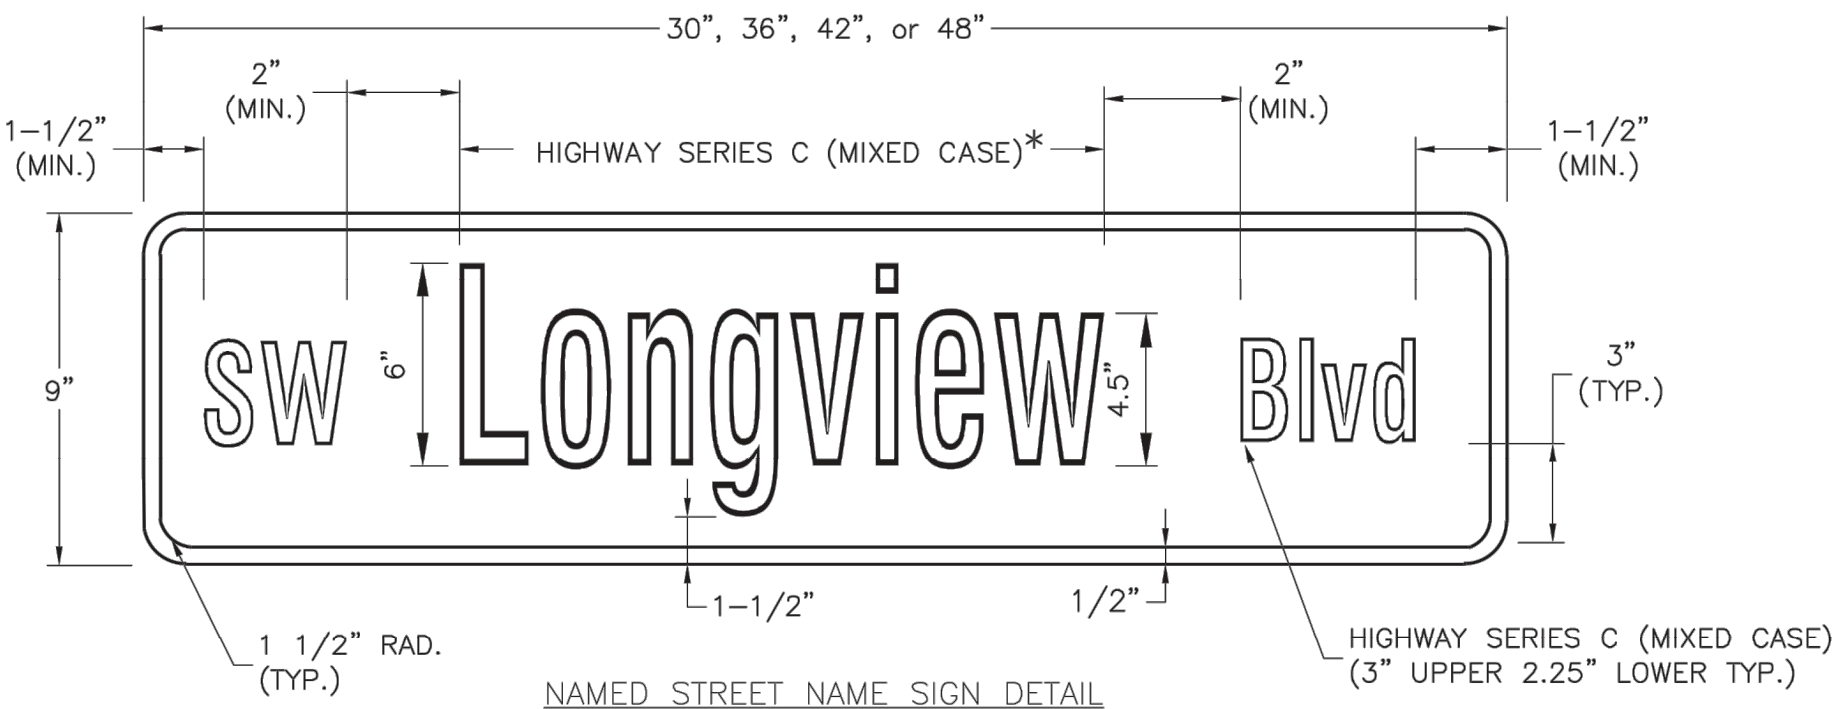

NAMED STREET NAME SIGN DETAIL
* USE HIGHWAY SERIES B (MIXED CASE) IN LIEU OF SERIES C IF NECESSARY TO FIT TEXT ON A 36" SIGN BLANK.

STREET NAME SIGN FACE DETAILS


POST MOUNTED 2-LANE ALL SPEEDS AND MULTI-LANE UNDER 40 MPH

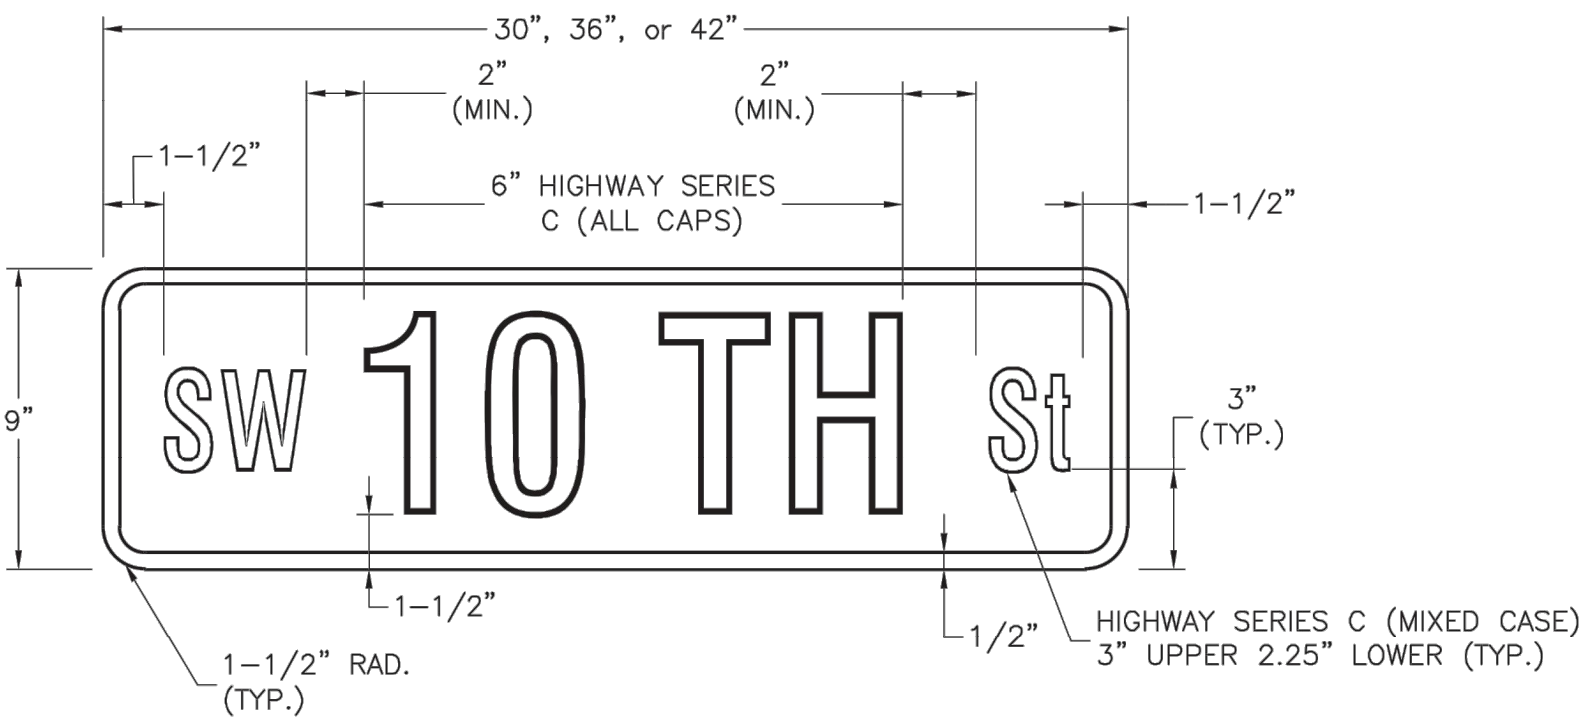

NUMBERED STREET NAME SIGN DETAIL

STREET NAME SIGN FACE DETAILS

POST MOUNTED 2-LANE ALL SPEEDS AND MULTI-LANE UNDER 40 MPH

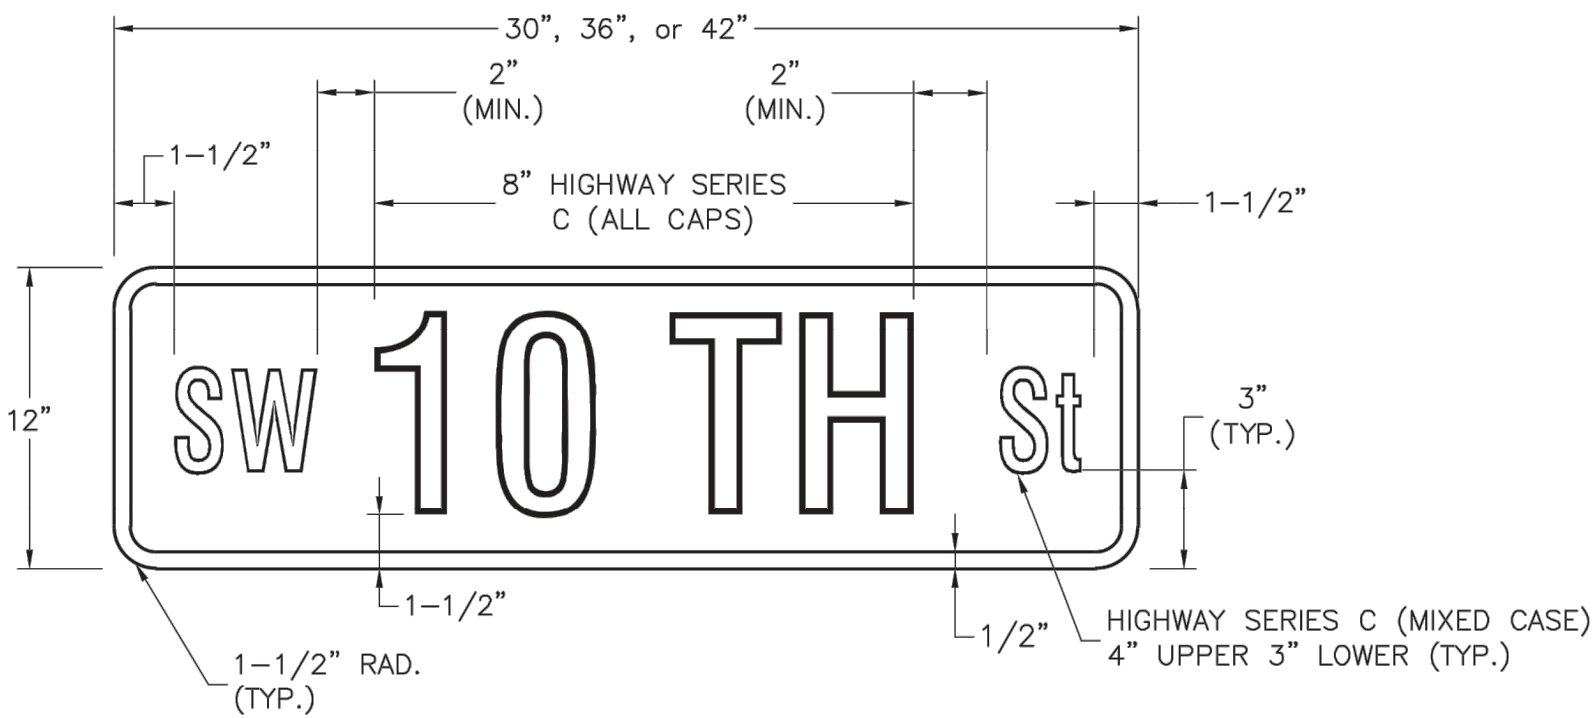


NUMBERED STREET NAME SIGN DETAIL

STREET NAME SIGN FACE DETAILS

POST MOUNTED MULTI-LANE GREATER THAN 40 MPH

NOTES:


1. FOR ALL STREET NAME SIGNS, THE LEGEND SHALL BE WHITE AND THE BACKGROUND SHALL BE GREEN.
2. ARROWS SHALL BE ADDED TO STREET NAME SIGNS WHERE THE NAME OF A STREET CHANGES AT AN INTERSECTION. STREET NAME SIGNS WITH ARROWS ARE TO BE INSTALLED ON EACH SIDE OF THE INTERSECTION TO INDICATE THE CHANGE IN NAMES. ARROWS SHALL BE WHITE.
3. THE "PRIVATE STREET" TAG SHOULD BE ADDED TO THE END OF STREET NAME SIGNS TO INDICATE WHERE A STREET THAT IS OUTSIDE THE RIGHT-OF-WAY INTERSECTS A PUBLIC STREET. THE BACKGROUND FOR THE "PRIVATE STREET" TAG SHALL BE YELLOW.
4. MULTI-LANE IS DEFINED AS HAVING 2 LANES OR MORE IN EACH DIRECTION, EXCLUDING TURN LANES.
5. OVERHEAD SIGN DETAILS MAY BE FOUND ON THE SIGNAL HEAD MOUNTING DETAIL.

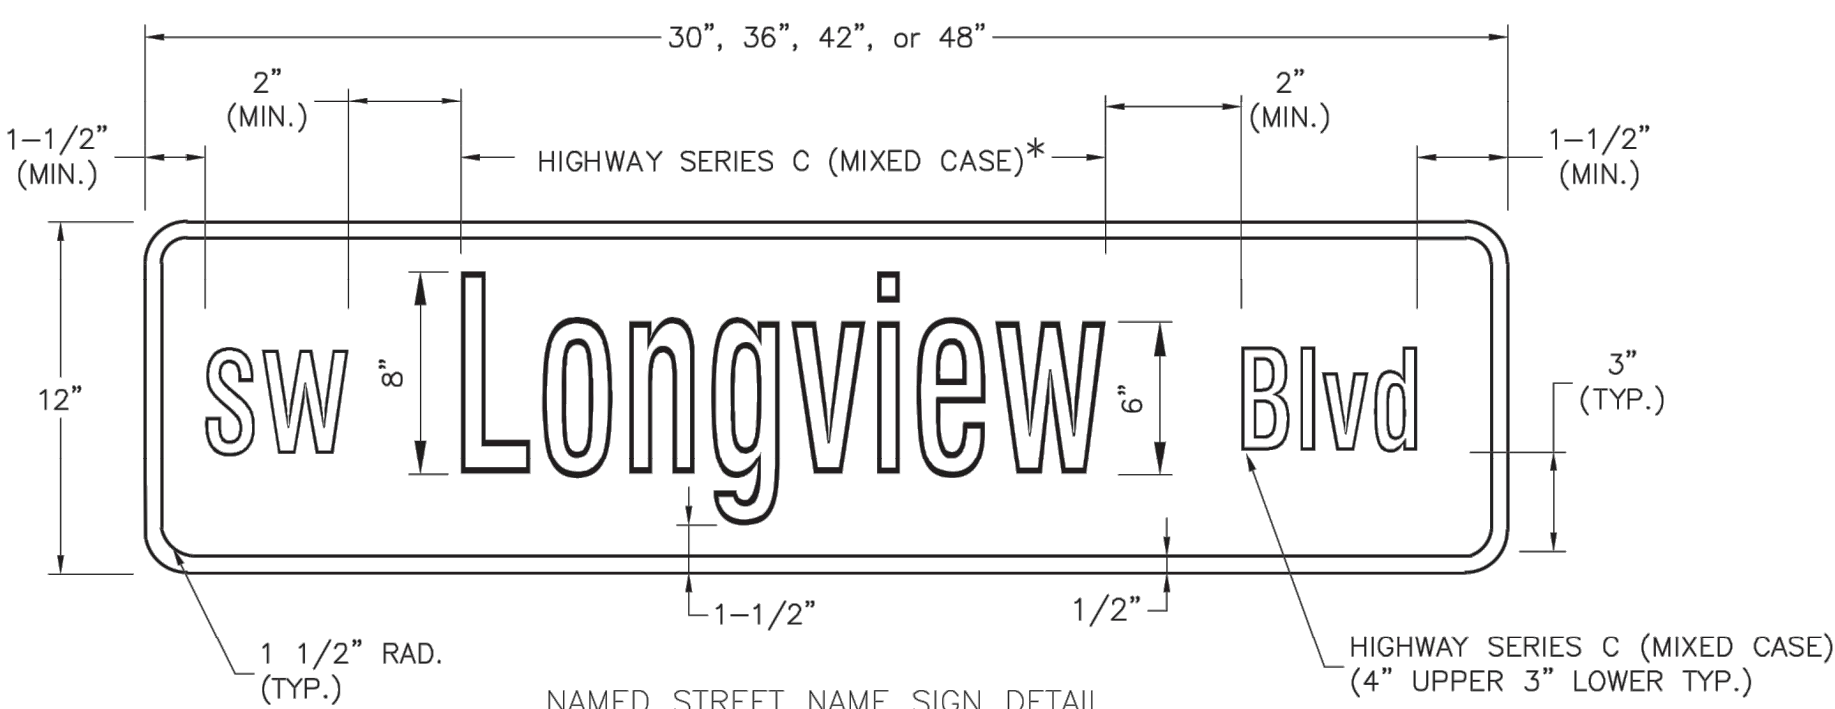


NAMED STREET NAME SIGN DETAIL
* USE HIGHWAY SERIES B (MIXED CASE) IN LIEU OF SERIES C IF NECESSARY TO FIT TEXT ON A 36" SIGN BLANK.

STREET NAME SIGN FACE DETAILS


POST MOUNTED MULTI-LANE GREATER THAN 40 MPH

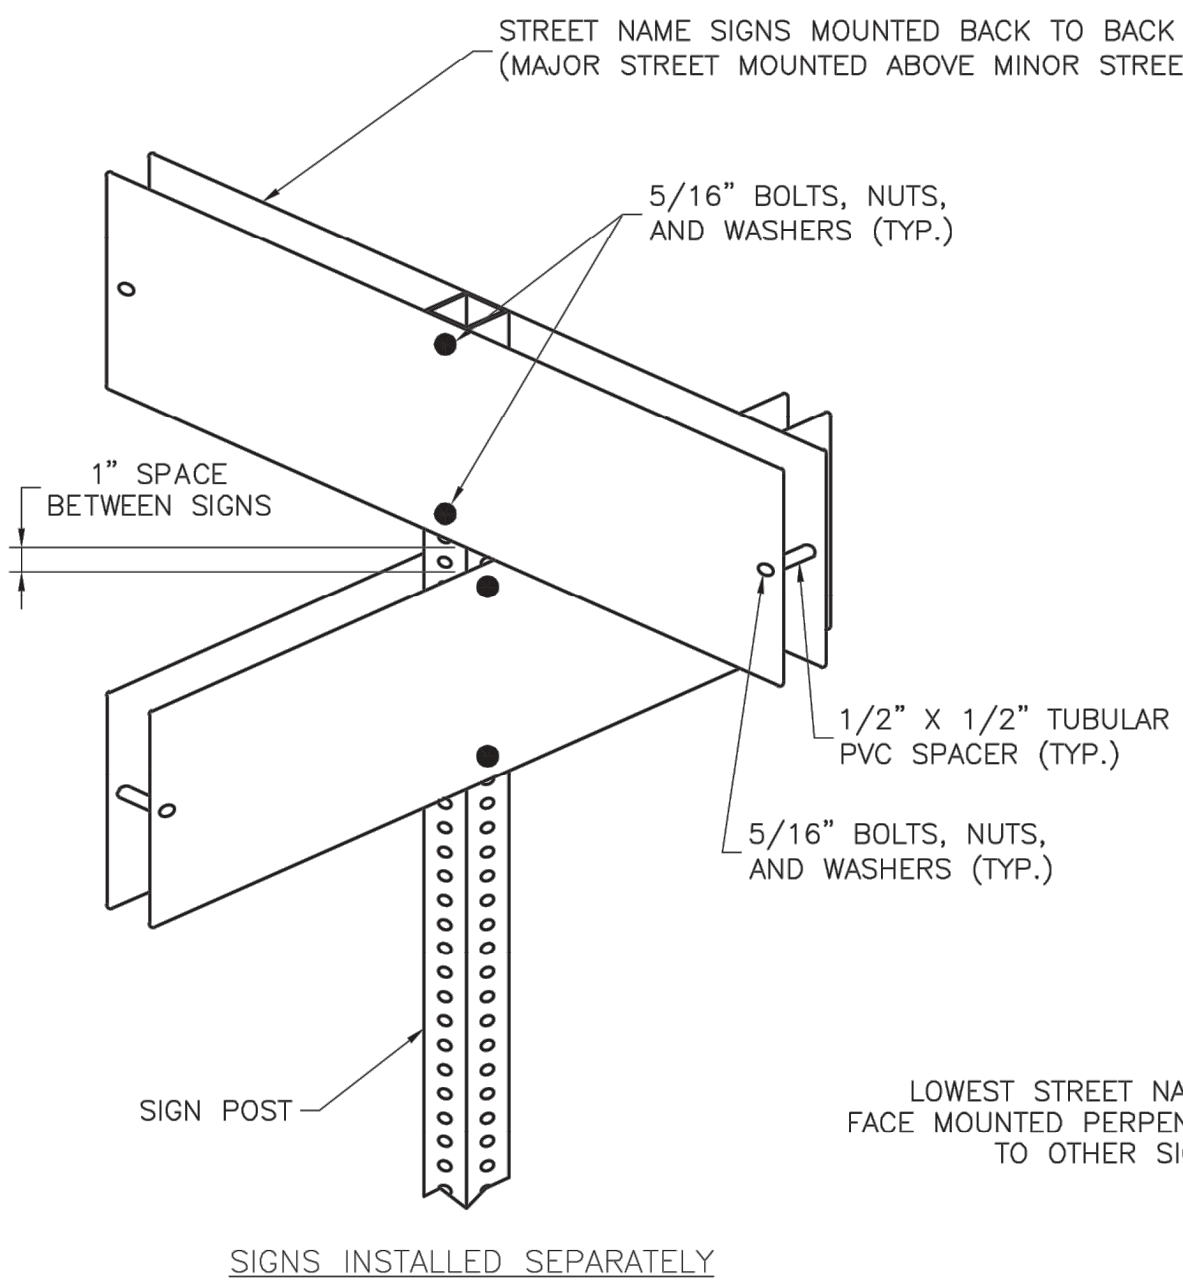

SIGNS INSTALLED SEPARATELY

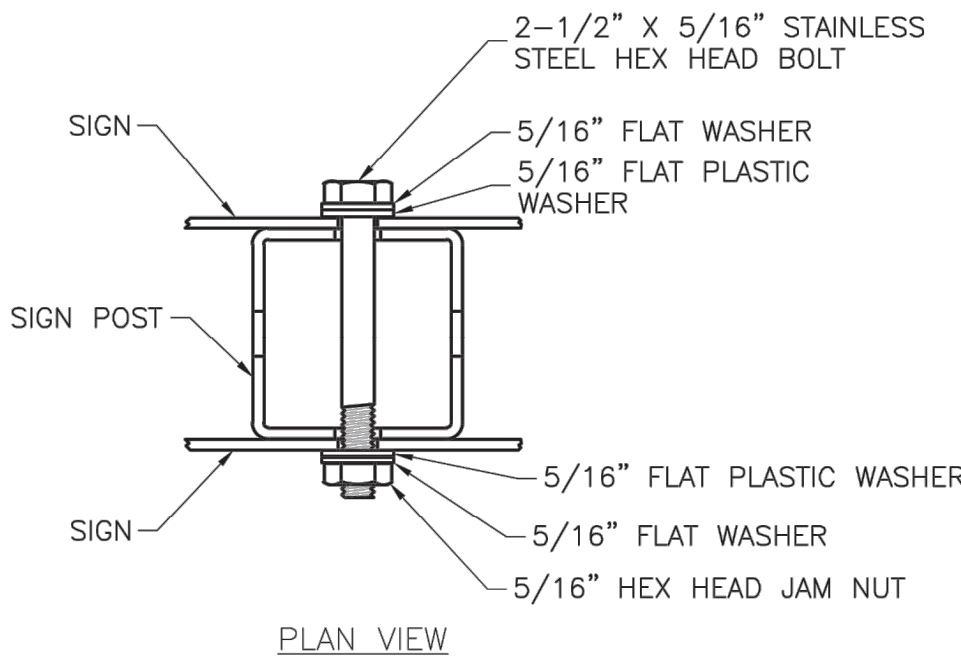


SQUARE STEEL POST MOUNTING DETAILS

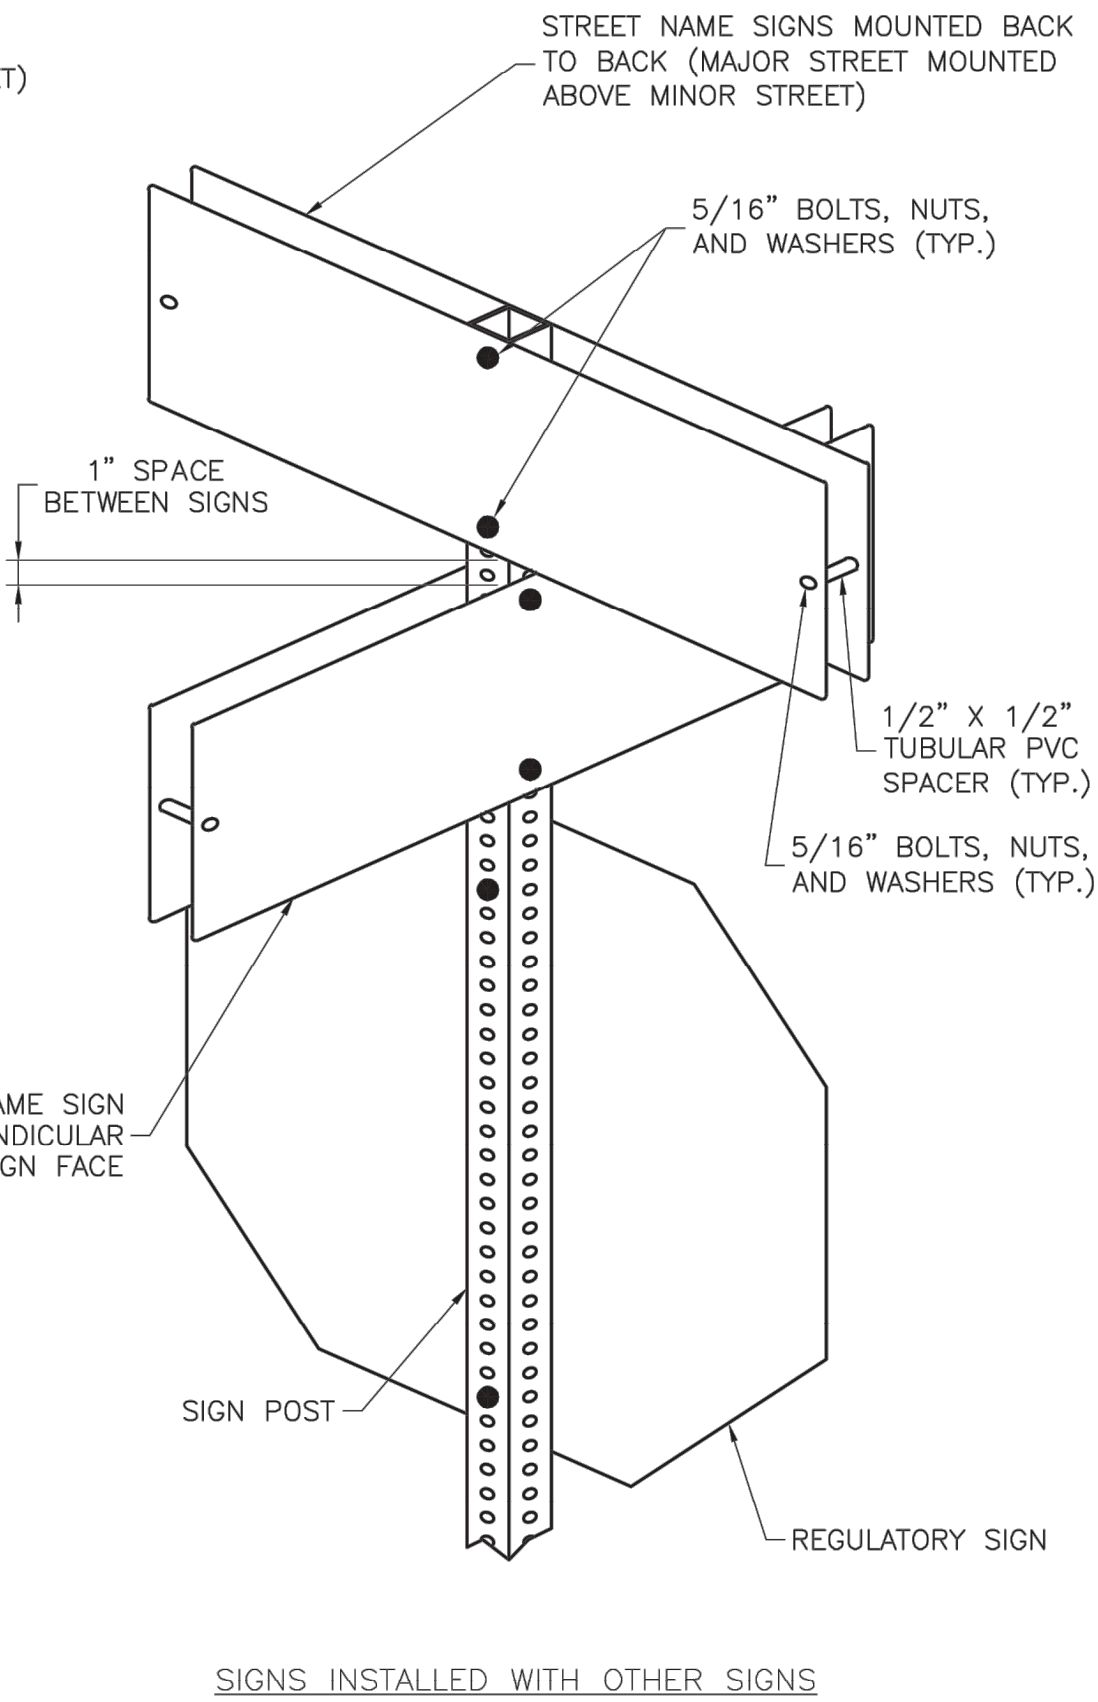

SIGNS INSTALLED WITH OTHER SIGNS

USER: *osaguedra*
C_PBASE_02104157
T_PBASE_02104157
C_PROW_02104157
XREFS: T_PTBK_02104157
XREFS: V_XTOPO_02104157
XREFS: Plans/Sheets/ROBR/T_PTC_02104157.dwg
F: 2021_04001_021_04157_40-Design
DWG: 2021_04001_021_04157_40-Design/AutoCAD/Final
DATE: Oct 30, 2023 3:57pm
T_AERI_02104157
V_XBOU_02104157
T_PSTRM_02104157

CONSTRUCTION PHASING:

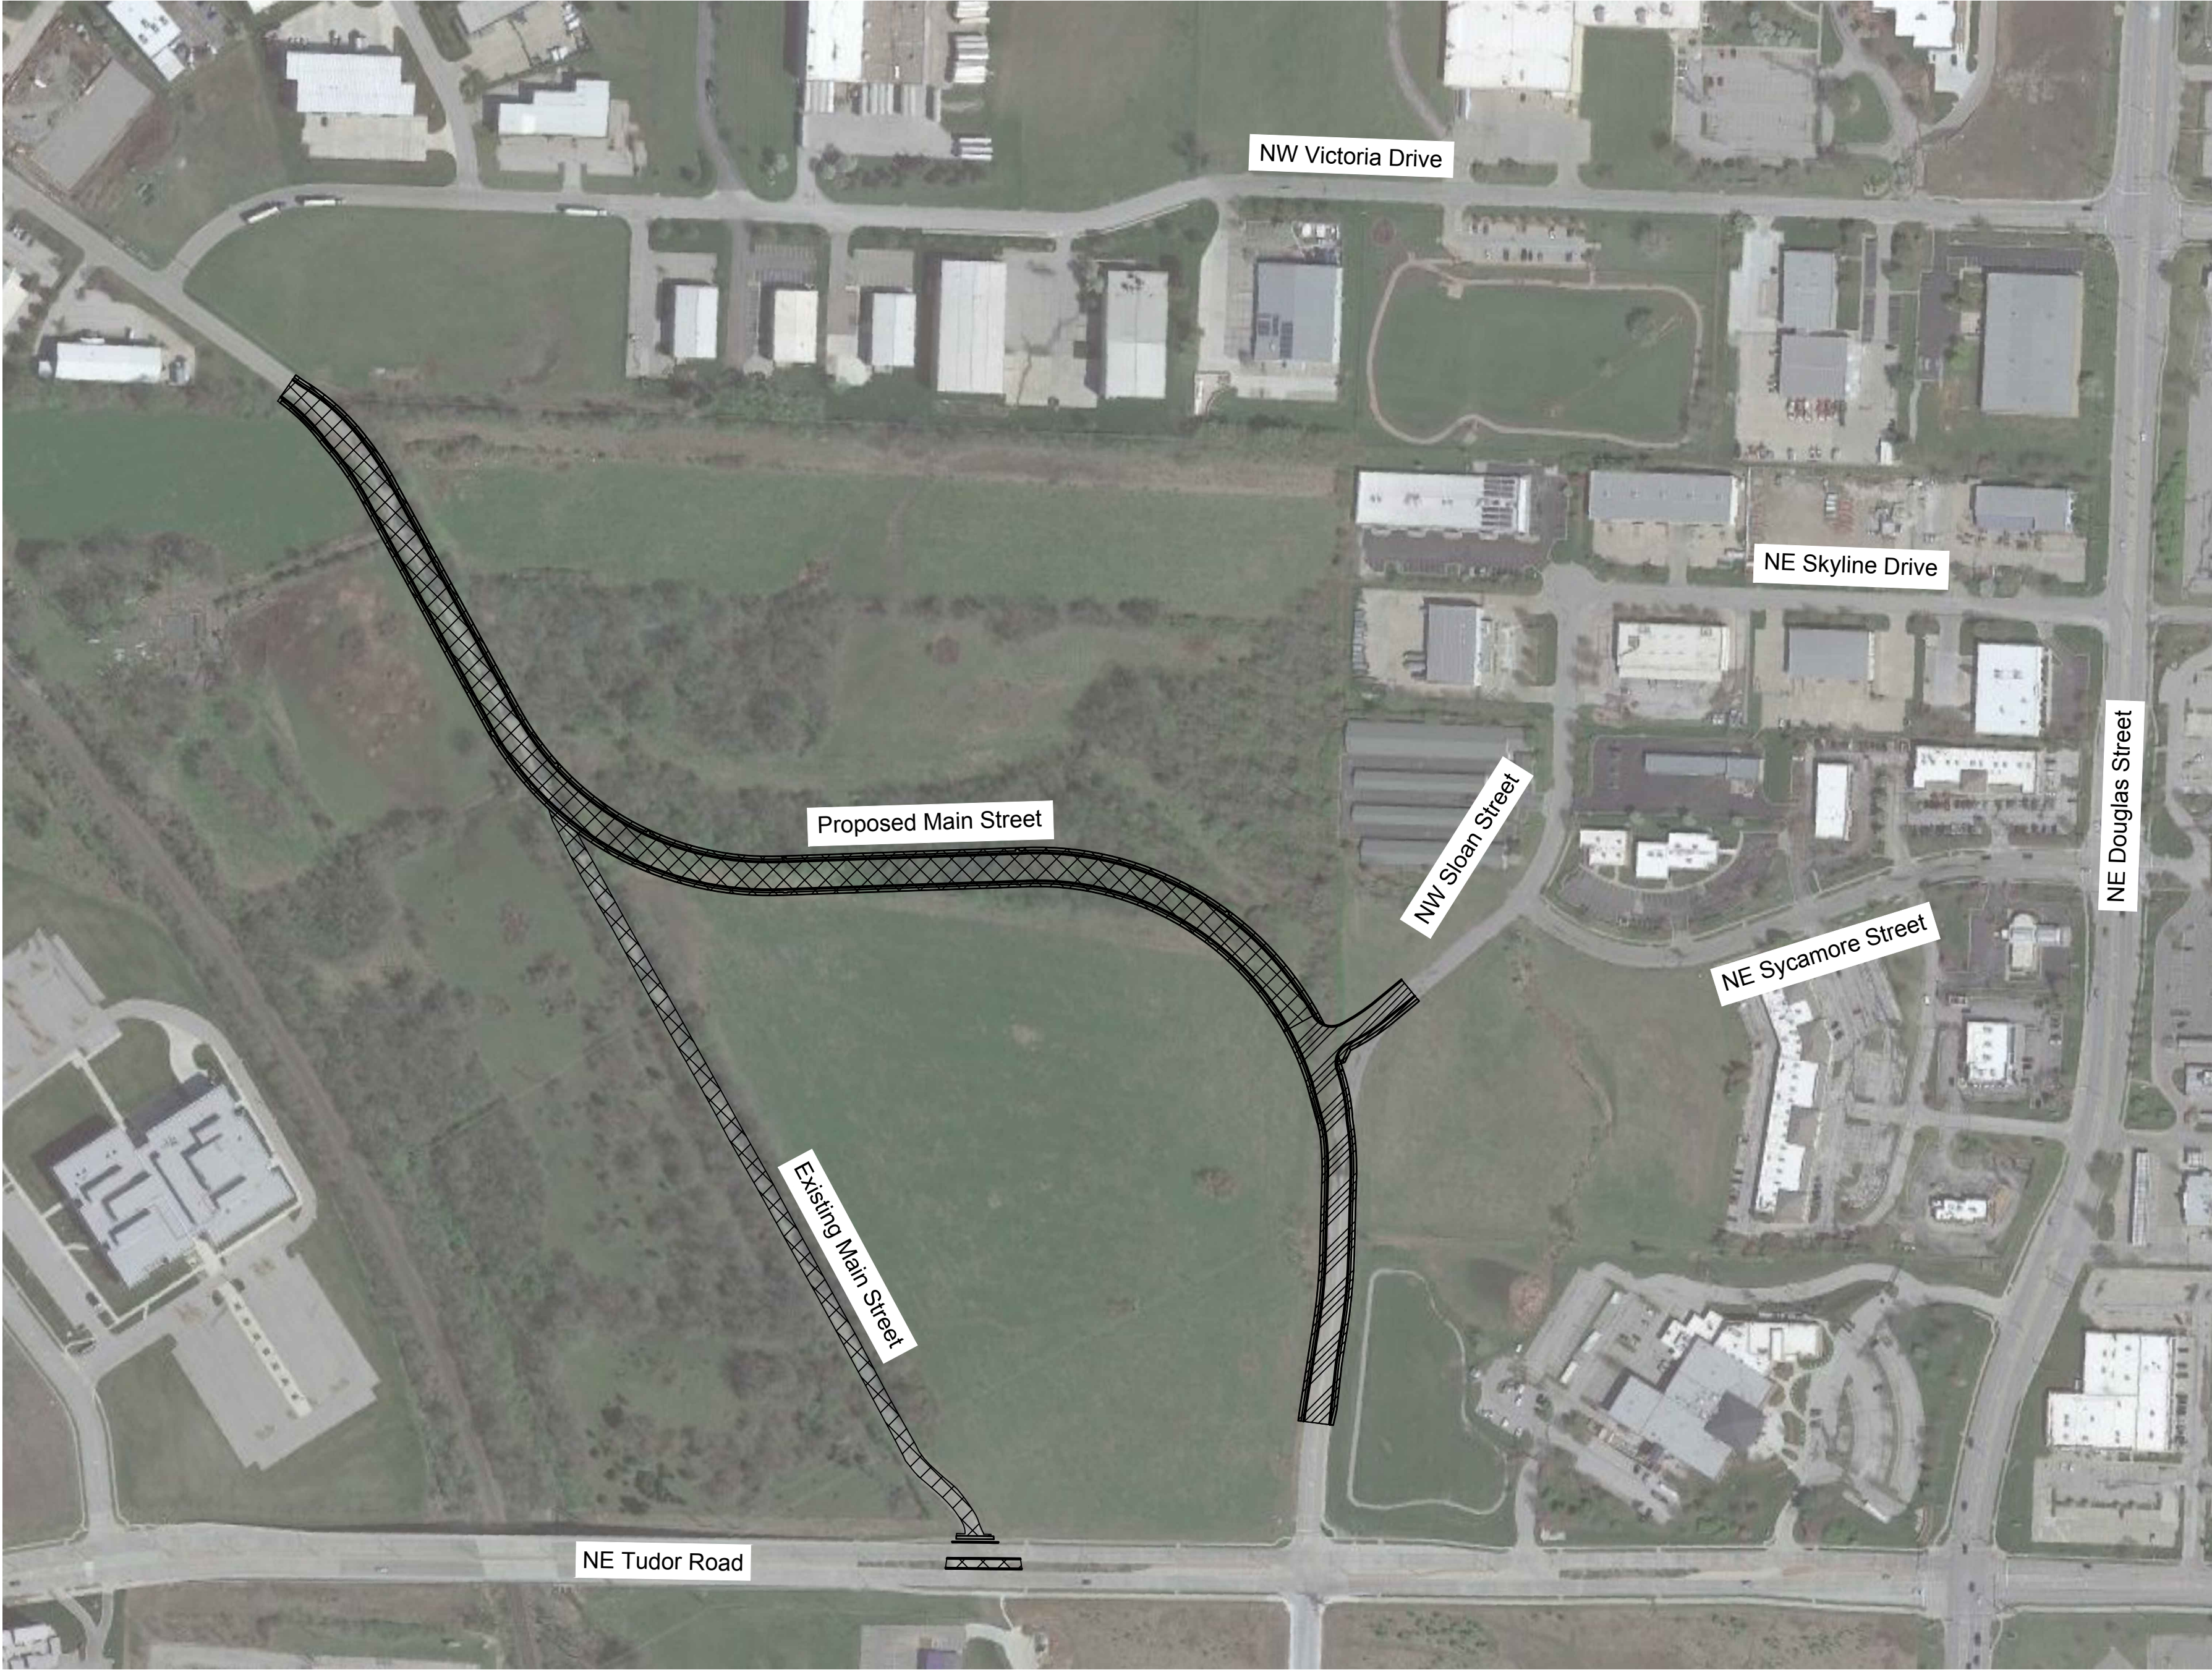

GENERAL NOTES:


- 1) AS WITH ALL CONSTRUCTION ACTIVITIES, TRAFFIC SITUATIONS ARE SUBJECT TO CHANGE. THE CONTRACTOR SHALL BE AWARE THAT ALL TEMPORARY TRAFFIC CONTROL SHALL CONFORM TO THE STANDARDS OUTLINED IN THE MANUAL ON UNIFORM TRAFFIC CONTROL DEVICES (M.U.T.C.D.), SEE SHEET 75 FOR MINIMUM TAPER LENGTHS, TEMPORARY SIGNAGE, AND OTHER TRAFFIC CONTROL REQUIREMENTS.
- 2) ALTERNATE TRAFFIC CONTROL MAY BE USED AS NEEDED AT THE APPROVAL OF THE ENGINEER.

CHASE 1:
CLOSE TRAFFIC ON EXISTING MAIN STREET BETWEEN NW VICTORIA DRIVE AND NE TUDOR ROAD. DETOUR TRAFFIC ON NE DOUGLAS STREET AND NW VICTORIA DRIVE.
CONSTRUCT NEW MAIN STREET FROM SOUTH OF NW VICTORIA DRIVE TO THE NORTH RETURN OF REALIGNED NW SLOAN STREET. REMOVAL OF EXISTING MAIN STREET
BETWEEN TUDOR ROAD AND TIE-IN SOUTH OF VICTORIA DRIVE. CLOSE MEDIAN AT EXISTING MAIN STREET ALONG TUDOR ROAD. SEE SHEET 75 FOR TEMPORARY TRAFFIC
CONTROL REQUIREMENTS.

PHASES 2:
CLOSE TRAFFIC ON NW SLOAN STREET BETWEEN NE SYCAMORE STREET AND TUDOR ROAD. DETOUR TRAFFIC ON NE DOUGLAS STREET. CONSTRUCT REALIGNED MAIN STREET
AND NW SLOAN STREET. SEE SHEET 75 FOR TEMPORARY TRAFFIC CONTROL REQUIREMENTS.

PHASING LEGEND

-  PHASE 1 WORK AREA
-  PHASE 2 WORK AREA

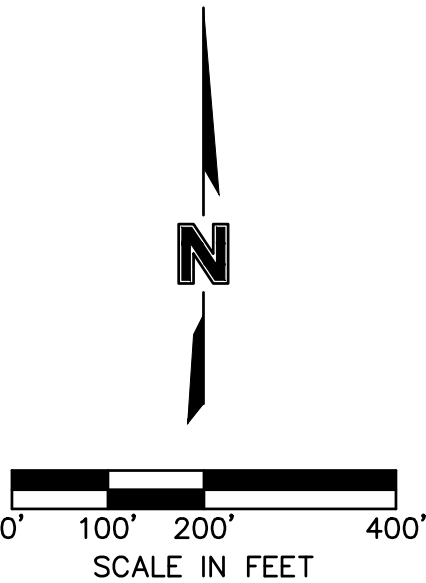

RECORD
DRAWINGS

RYAN B. FLEMING
MO. NO. PE-2002003161

[illegible]

TRAFFIC CONTROL PLAN
TRAFFIC CONTROL PHASING

SCANNELL DEVELOPMENT LEE'S SUMMIT LOGISTICS
NORTHWEST CORNER OF TUDOR ROAD AND MAIN STREET

LEE'S SUMMIT, MISSOURI	2021
------------------------	------


C.O.A. NO.: _____
 DRAWN BY: _____ ARJ/AMW
 CHECKED BY: _____ XXX
 APPROVED BY: _____ RBF
 QA/QC BY: _____ RBF
 PROJECT NO.: _____ 021-04157
 DWG NO.: _____ T_PTC_02104157
 DATE: _____ 2021-10-12

SHEET
71 OF 105

oslo

Olsson Engineering - MO State Certificate of Authority #001592
73301 West 133rd Street, Suite 200 TEL 913.381.1170
Overland Park, KS 66213-4750 FAX 913.381.1174 www.olsson.com

DWG: F:\2021\04001-04500\021-04157\40-Design\AutoCAD\Final Plans\Sheets\ROBR\T_PTC_02104157.dwg
DATE: Oct 30, 2023 3:57pm
XREFS: T_PTBK_02104157 C_PROW_02104157 T_PBASE_02104157 C_PBASE_02104157 T_PPATTI_02104157 V_XBOL_02104157 T_PSTRM_02104157 T_AERL_02104157
USER: asaavedra

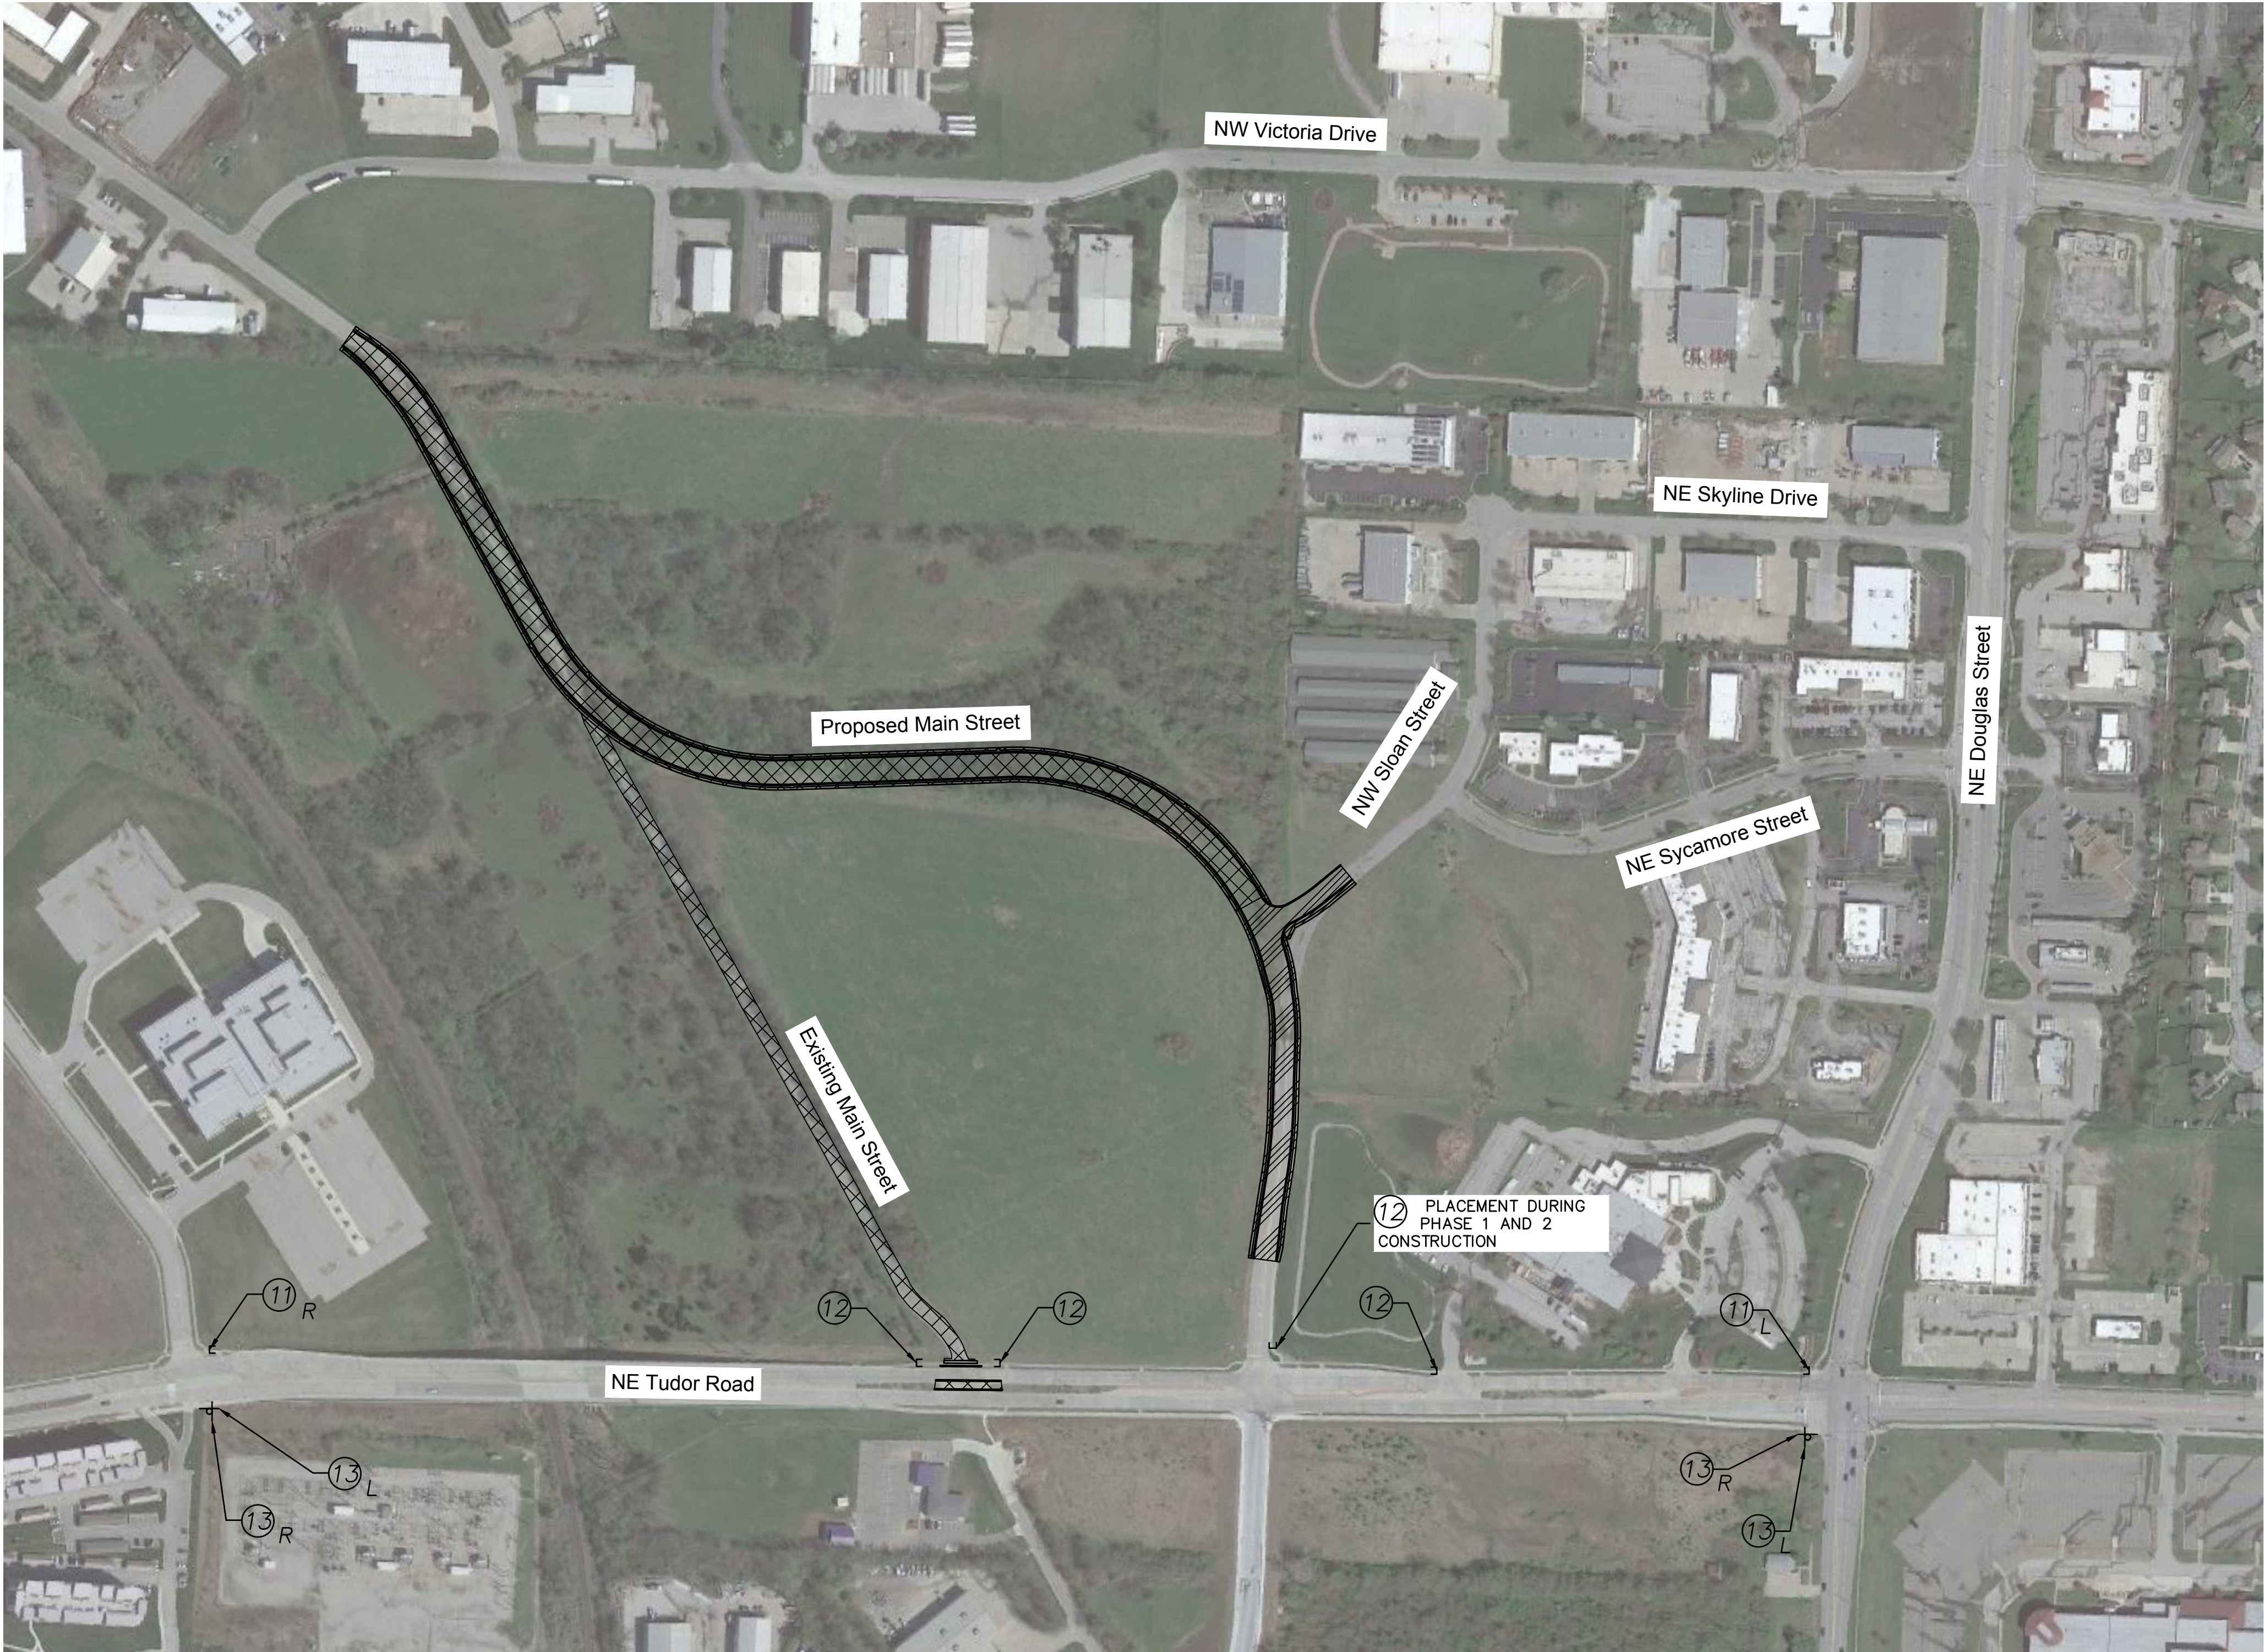

GENERAL NOTES:


- 1) PHASE 1 DETOUR FOR PEDESTRIAN TRAFFIC ALONG THE NORTH SIDE OF TUDOR ROAD AT EXISTING MAIN STREET. DETOUR TO BE IN PLACE UNTIL CONTINUOUS SIDEWALK SECTION IS PROVIDED ALONG THE NORTH SIDE OF TUDOR ROAD AT EXISTING MAIN STREET. WHEN SIDEWALK NETWORK IS COMPLETE AND WORK ZONE DOES NOT INTERFERE WITH PEDESTRIAN ROUTE, PEDESTRIAN DETOUR CAN BE REMOVED.
- 2) SIDEWALK CLOSED SIGNAGE TO BE PROVIDED IN NORTHEAST QUADRANT OF TUDOR ROAD AND SLOAN STREET DURING PHASE 1 AND 2 CONSTRUCTION.

LEGEND

- Sign
- Type II Barricade
- Phase 1 Work Area
- Phase 2 Work Area

SIGN LEGEND

- ROAD WORK AHEAD
- DETOUR AHEAD
- DETOUR
- ROAD CLOSED
- END ROAD WORK
- END DETOUR
- ROAD CLOSED AHEAD
- MAIN STREET
- SIDWALK CLOSED AHEAD
- SIDWALK CLOSED
- DETOUR
- MAIN ST CLOSED NORTH OF TUDOR FOLLOW DETOUR
- 11 L R9-11(L)
- 11 R R9-11(R)
- 12 SP-3
- 13 L M4-9b(L)
- 13 R M4-9b(R)
- 14 SP-3
- 15 L W1-6(L)
- 15 R W1-6(R)
- 16 SP-2
- 17 L R3-1
- 17 R R3-1
- 18 SP-1
- 19 SP-1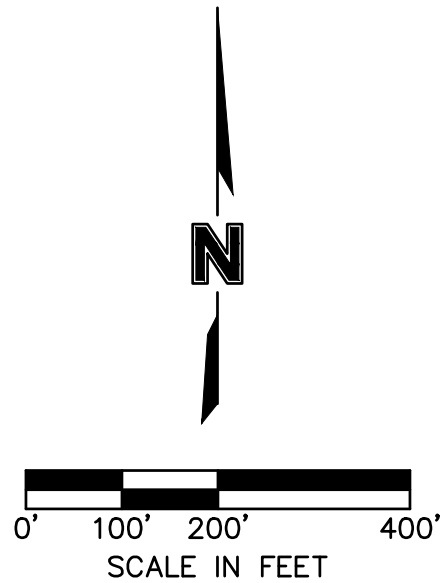
olsson

Olsson Engineering - MO State Certificate of Authority #001592
7301 West 133rd Street, Suite 200
Overland Park, KS 66213-4750
TEL 913.381.1170
FAX 913.381.1174
www.olsson.com

RECORD DRAWINGS

RYAN B. FLEMING
MO. NO. PE-2002003161

BY

REVISIONS DESCRIPTION

DATE

REV. NO.

REVISIONS

TRAFFIC CONTROL PLAN
PEDESTRIAN DETOUR PLAN

SCANNELL DEVELOPMENT LEE'S SUMMIT LOGISTICS
NORTHWEST CORNER OF TUDOR ROAD AND MAIN STREET

LEE'S SUMMIT, MISSOURI


2021

C.O.A. NO.:
DRAWN BY: ARJ/AMW
CHECKED BY: XXX
APPROVED BY: RBE
QA/QC BY: RBE
PROJECT NO.: 021-04157
DWG NO.: T_PTC_02104157
DATE: 2021-10-12


SHEET
74 OF 105

SYMBOL LEGEND

- Work Area
- Channelizer
- Sign
- Arrow Panel
- Barricade
- Flagger
- Direction of Travel

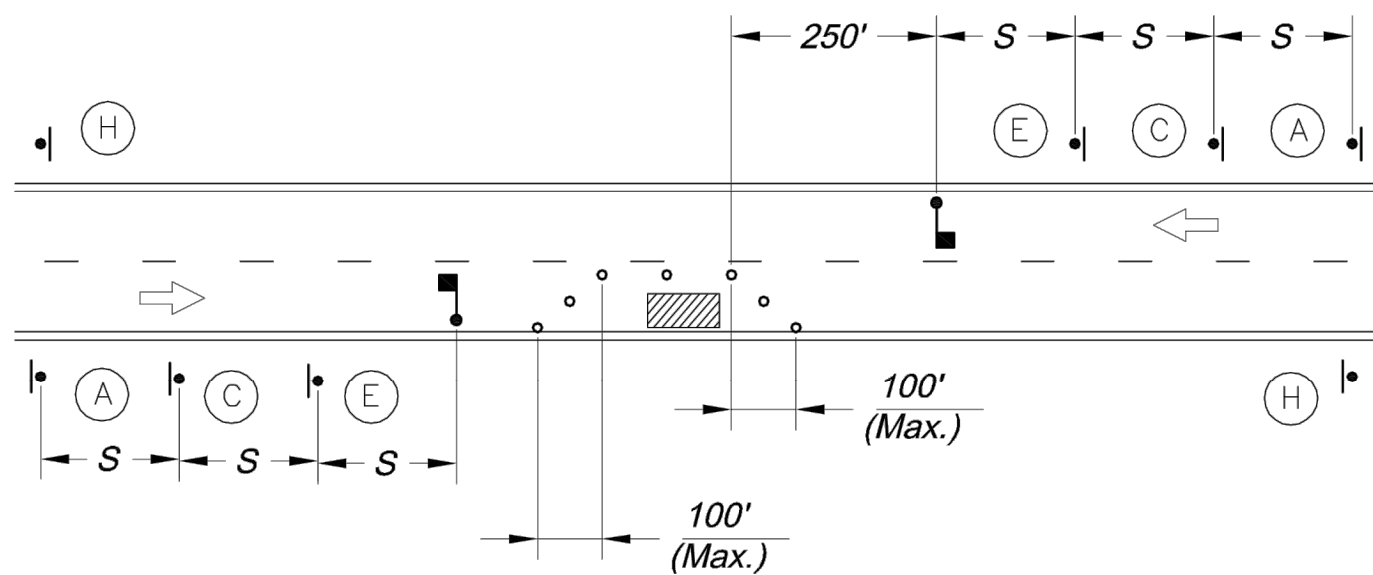


LANE CLOSURE - TWO LANE STREET

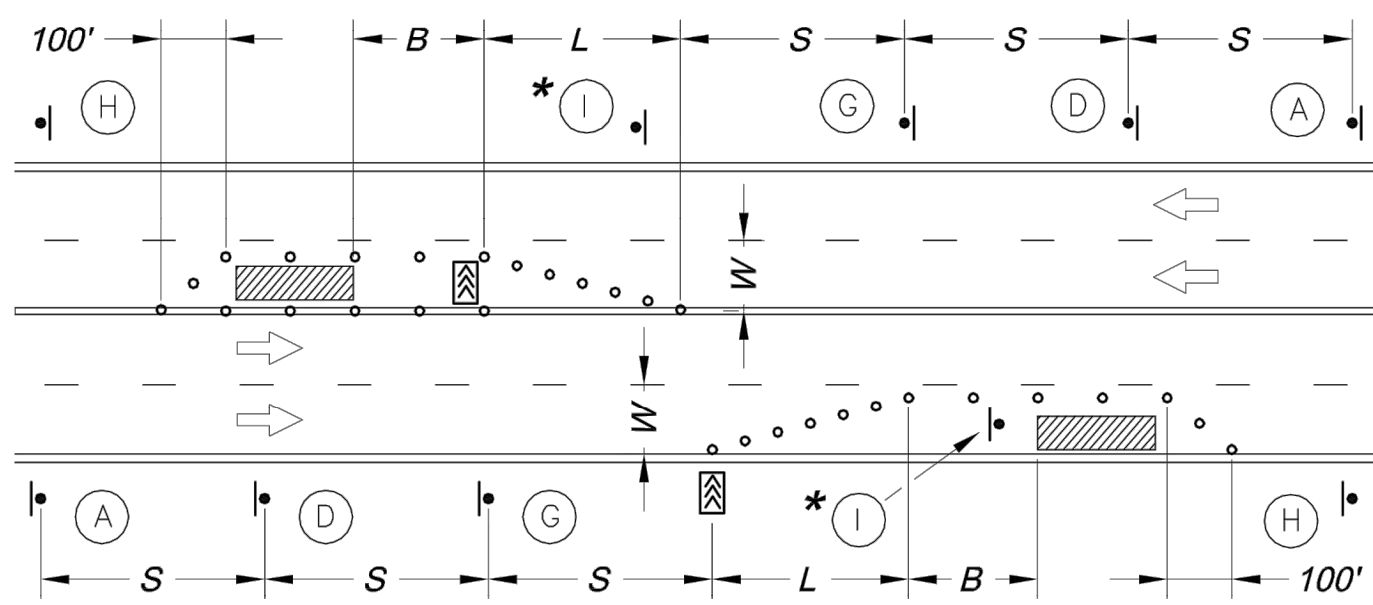

LANE CLOSURE - FOUR LANE STREET

* Install Signs Every 200 Feet Throughout the Closed Lane or As Needed

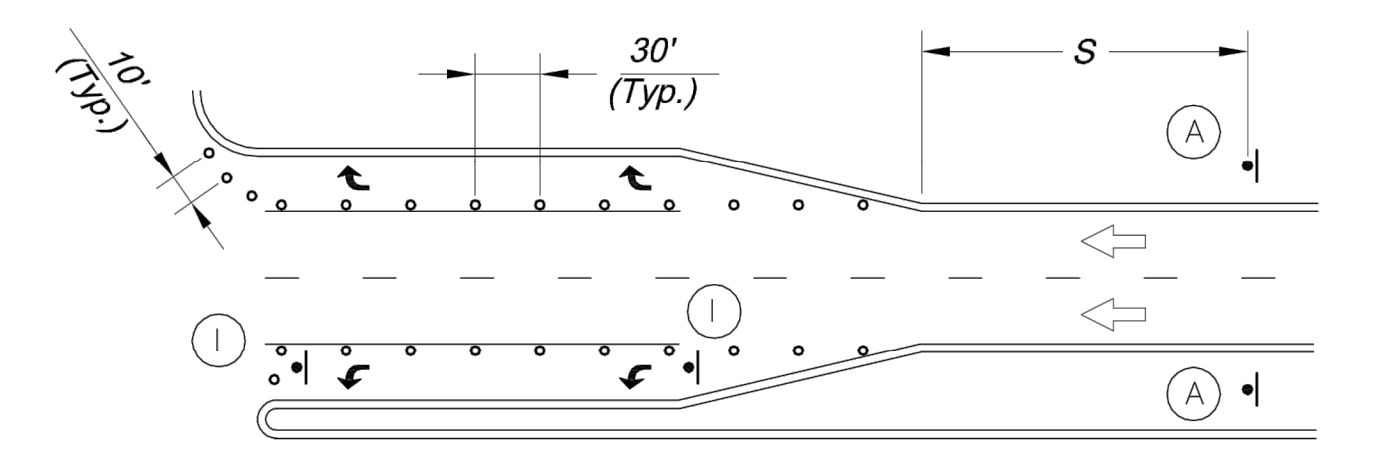

TURN LANE CLOSURE


Sign Spacing "S"	
Speed Limit (mph)	Spacing (Feet)
25	100
30 - 35	250
≥ 40	350

Taper Dimensions (Feet)				
Speed Limit (mph)	Minimum Taper Length "L", per Lane Width "W"			Minimum Number of Channelizers
	10	11	12	
25	105	115	125	6
30	150	165	180	7
35	205	225	245	8
40	270	295	320	9
45	450	495	540	13


Guidelines for Length of Longitudinal Buffer Space "B"	
Speed Limit (mph)	Length (Feet)
25	35
30	55
35	85
40	120
45	170

Maximum Channelizer Spacing		
Speed Limit (mph)	Within Taper (Feet)	Outside Taper (Feet)
25	25	50
30	30	60
35	35	70
40	40	80
45	45	90

SIGN LEGEND

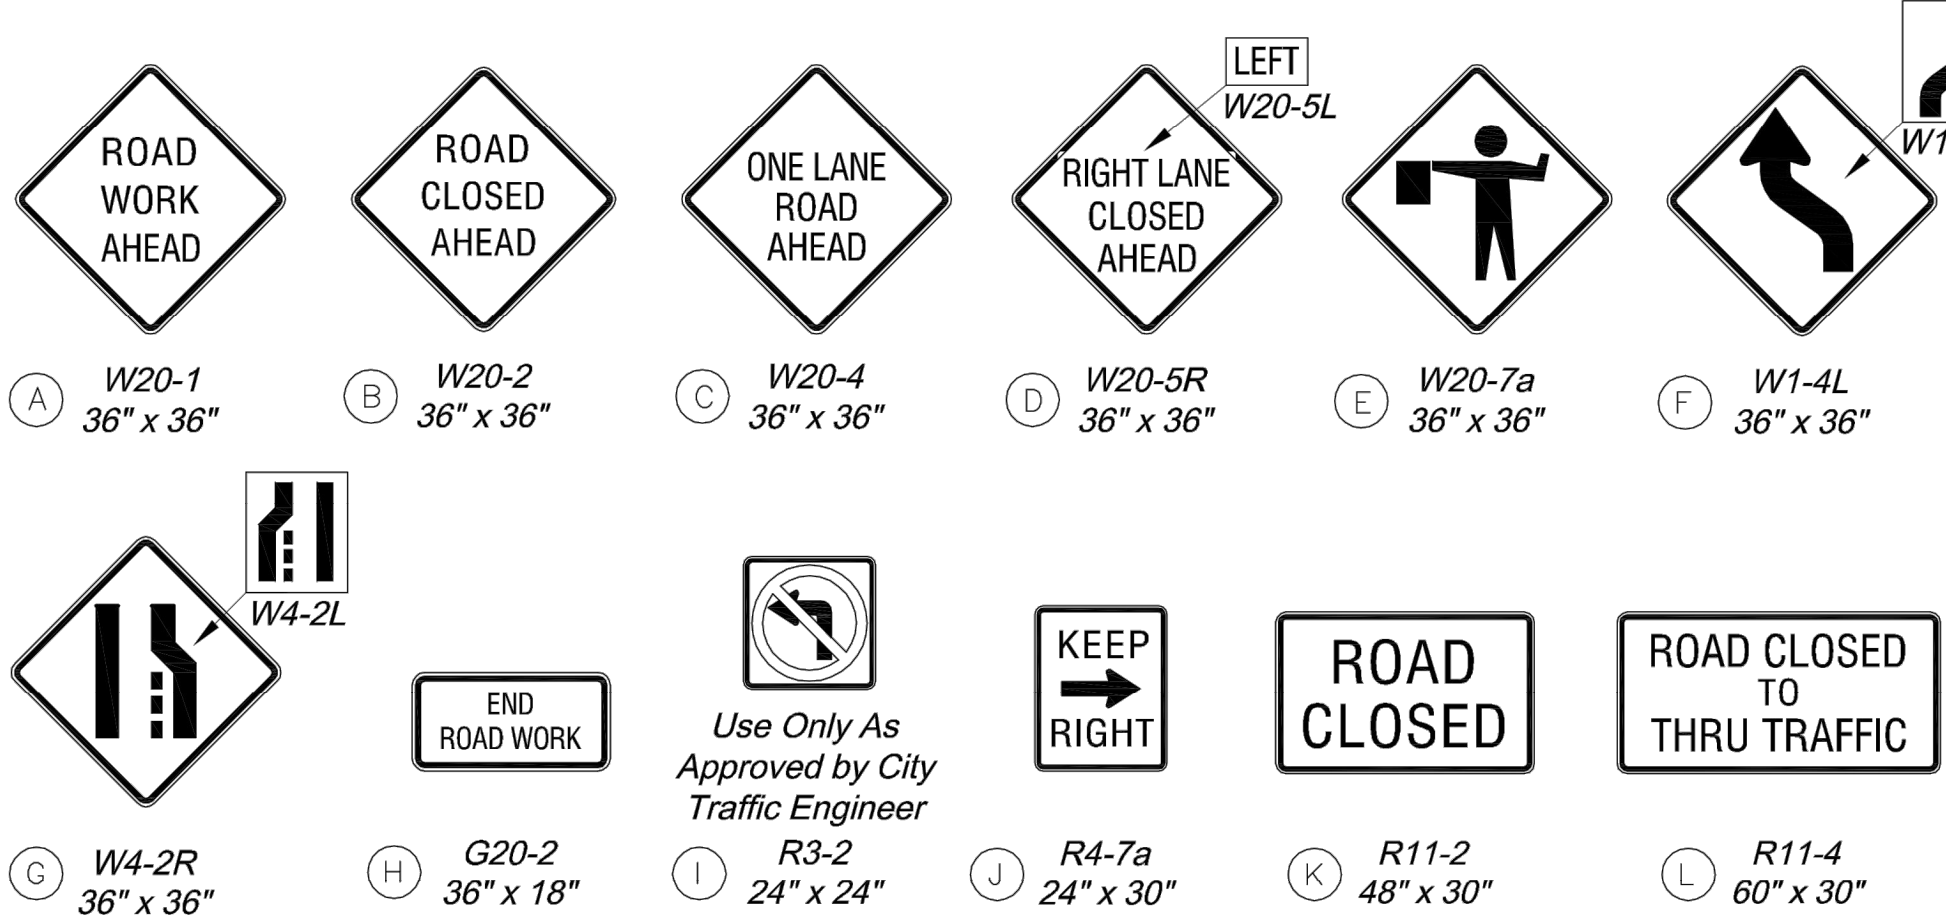


TYPICAL SIGNING FOR WORK ADJACENT TO THE STREET

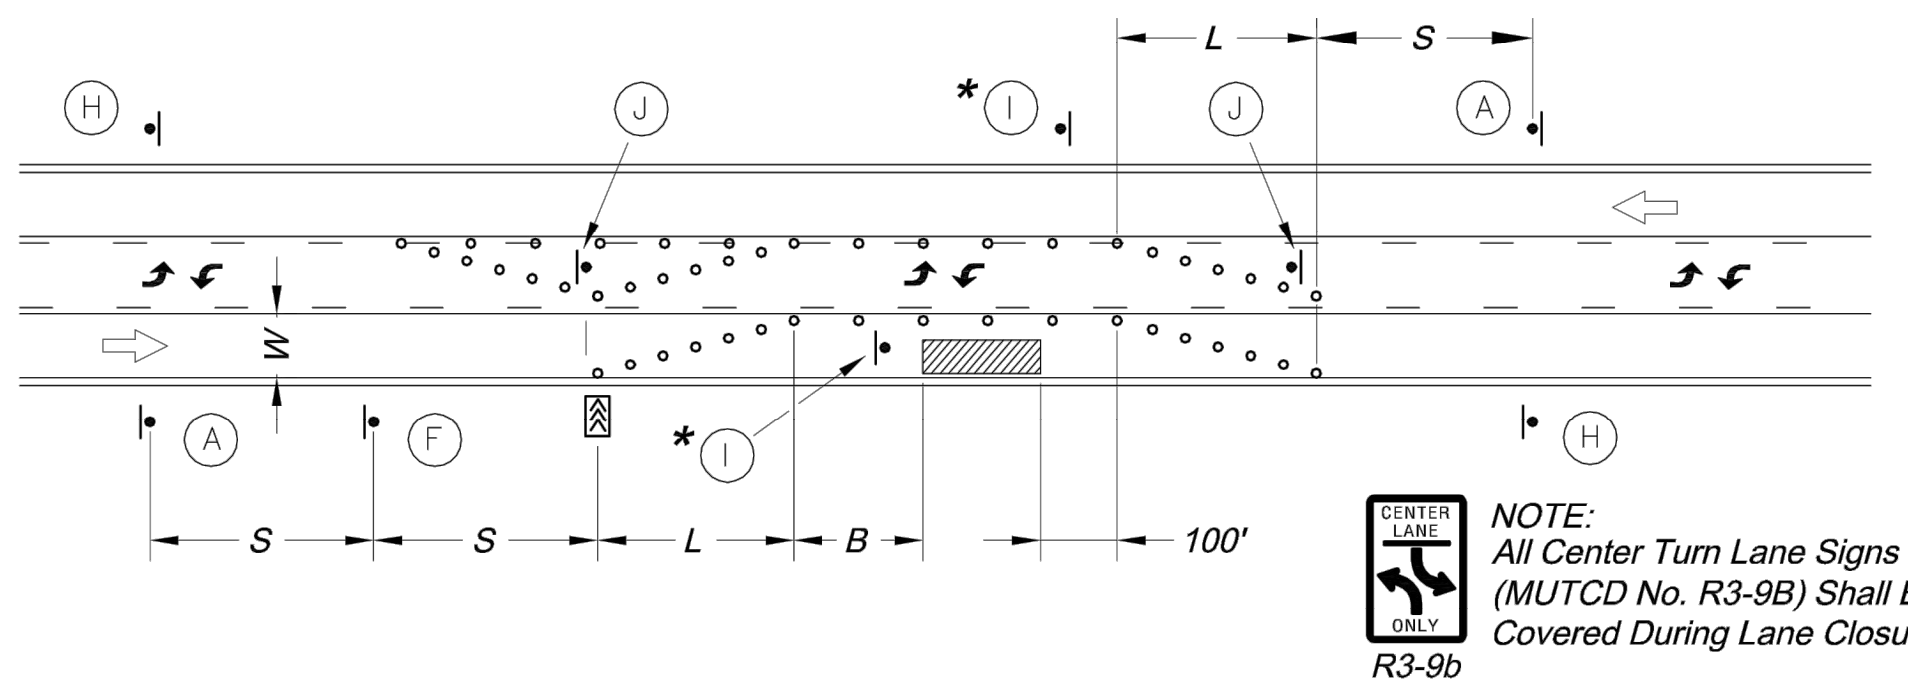

LANE CLOSURE - THREE LANE STREET


* Install Signs Every 200 Feet Throughout the Closed Lane or As Needed

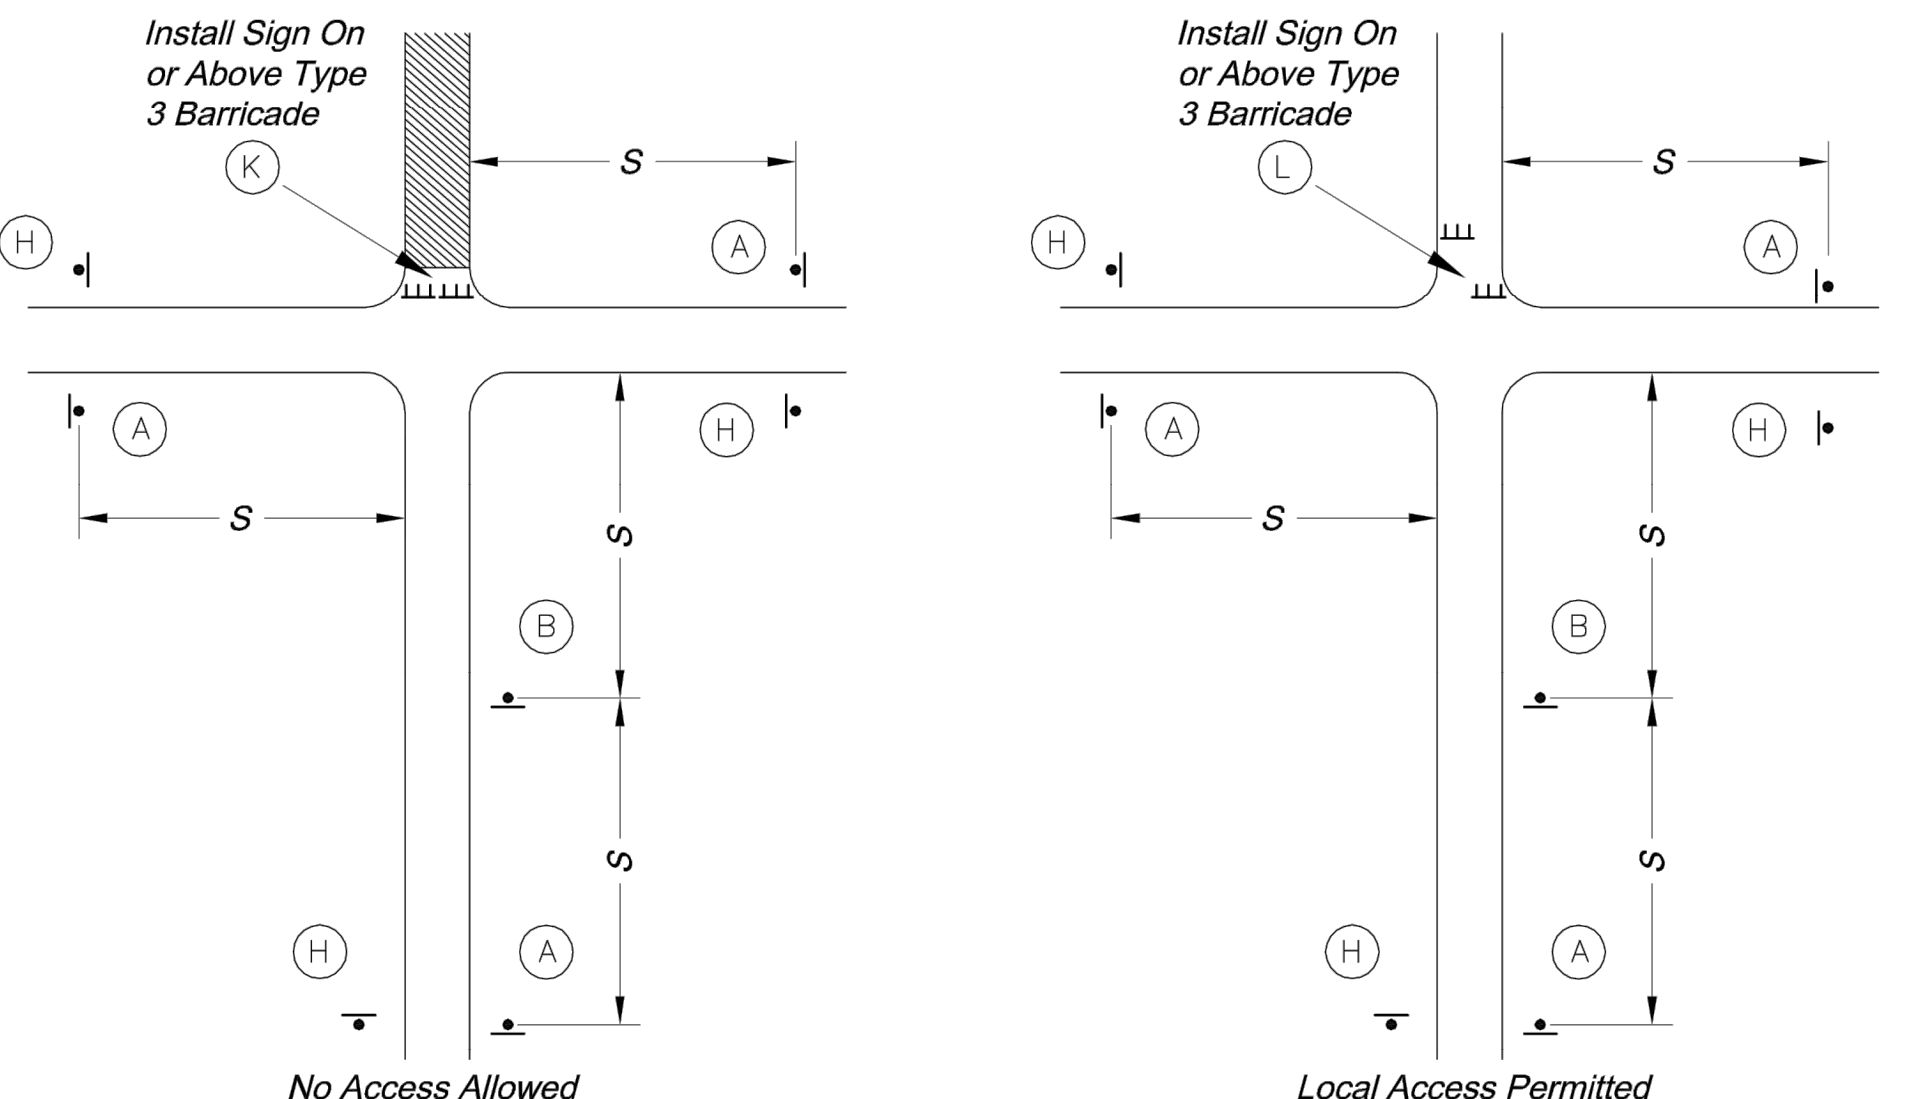

TYPICAL STREET CLOSURE


GENERAL NOTES:

- All signs, barricades, channelizers, markings and other traffic control devices shall conform to the latest edition of the Manual on Uniform Traffic Control Devices (MUTCD).
- All traffic control devices shall be standard in size, shape, color, and message, in good condition, and retro-reflectORIZED. All signs shall be securely mounted with height and lateral location as described in the MUTCD.
- Warning lights shall be used on barricades in place at night and on warning signs which alert drivers about a change in alignment, traffic control, lane closure, or road closure.
- Flaggers shall be used where indicated on the plans, where construction vehicles interact with normal traffic, or where construction activities impose a restriction on traffic, as directed by the City Traffic Engineer. Where flaggers are used, advance signing shall be erected as shown in the details or as specified in the MUTCD. Flaggers shall meet the requirements in the MUTCD in regard to character, training, attire, and behavior.
- Trim-lines are the City's preferred channelizing device. Cones may not be used at nighttime.
- Traffic control devices not in use or not applicable shall be either covered or removed from the work area.
- The Contractor shall use barricades, street plates, or fencing as needed to effectively shield pedestrian and vehicular traffic from exposed objects, excavations, and construction activities.
- Access shall be maintained to all driveways and side streets unless noted otherwise on the plans.
- No street shall be closed without the approval of the City Traffic Engineer. The Contractor shall notify the City Traffic Engineer at least 7 days in advance of any street closure. If a detour route around the closure is to be provided, all detour signing shall be as shown on a plan approved by the City Traffic Engineer.
- Construction vehicles parked along streets shall be located within the work area (traffic control) or where otherwise normally permitted. Construction materials, including traffic control and vehicles shall not restrict sight distance for vehicles exiting at streets or drives.
- Construction materials shall be kept off of sidewalks, consolidated in one location within City right-of-way, and removed daily unless otherwise approved by the Inspector. Dirt, mud, and other construction debris on streets and sidewalks shall be removed immediately.
- The Contractor shall not perform any work that will restrict vehicular traffic in any way between the hours of 7:00 a.m. and 9:00 a.m. or 4:00 p.m. and 6:00 p.m. Monday through Friday unless otherwise indicated in the specifications.
- All travel lanes should be at least 11 feet wide unless otherwise authorized by the City Traffic Engineer. A "Narrow Lanes" sign shall be installed in advance of a lane width reduction to less than 11 feet.
- All edge drop-offs of more than 2 inches and less than 4 inches should be protected by a wedge or barrier and all edge drop-offs greater than 4 inches shall have edge protection (see Traffic Control Specifications for edge treatment requirements).
- The "Workers" symbolic sign (MUTCD No. W21-1a) may be used instead of the "Road Work Ahead" sign for work with a duration of 12 hours or less. The "End Road Work" sign is not required to be installed after the "Workers" sign.
- No traffic signal shall be altered or modified in any way without a plan approved by the City Traffic Engineer.
- The Contractor shall be responsible for maintaining all traffic control devices on an around-the-clock basis, whether or not work is actively being pursued and any deficiencies noted shall be corrected immediately.
- The traffic control requirements shown on these plans are minimum requirements only and do not attempt to address in depth the variety of situations that may occur once construction has started. In no way do the requirements shown on these plans relieve the Contractor of his responsibility for selecting the proper traffic control devices and implementation procedures that will assure the safety of drivers, pedestrians, and workers at all times.
- Should the contractor fail to enforce the traffic control plan or fail to clean, replace or otherwise maintain the traffic control devices when directed to do so by the City Traffic Engineer or representative, the City may take one or more of the following actions:
 - Employ another agency to correct deficiencies in traffic control devices and deduct the cost from the Contractor's pay estimate,
 - Stop the work until deficiencies are corrected,
 - Suspend all pay estimates until deficiencies are corrected, or
 - Place the Contractor in default.

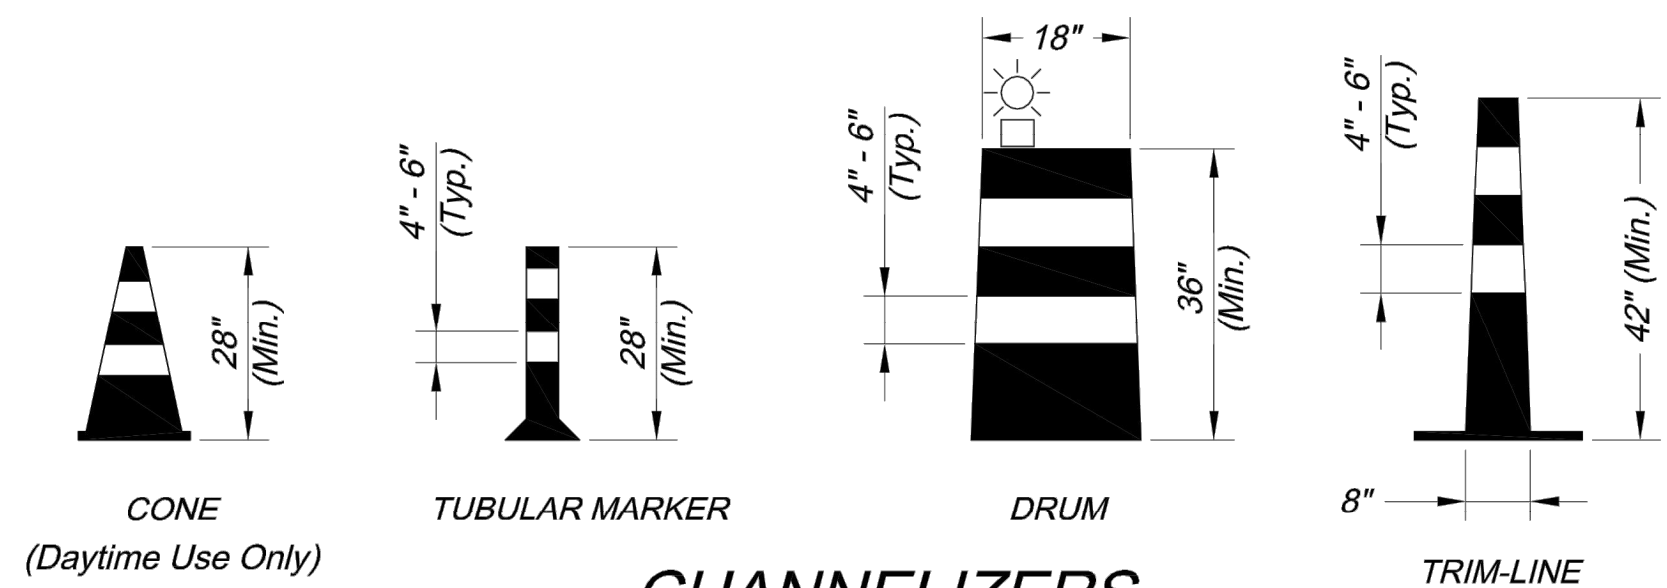

CHANNELIZERS

NOTE: White Bands On Barricades and Channelizers Shall Be Made From High Intensity Sheeting Material.

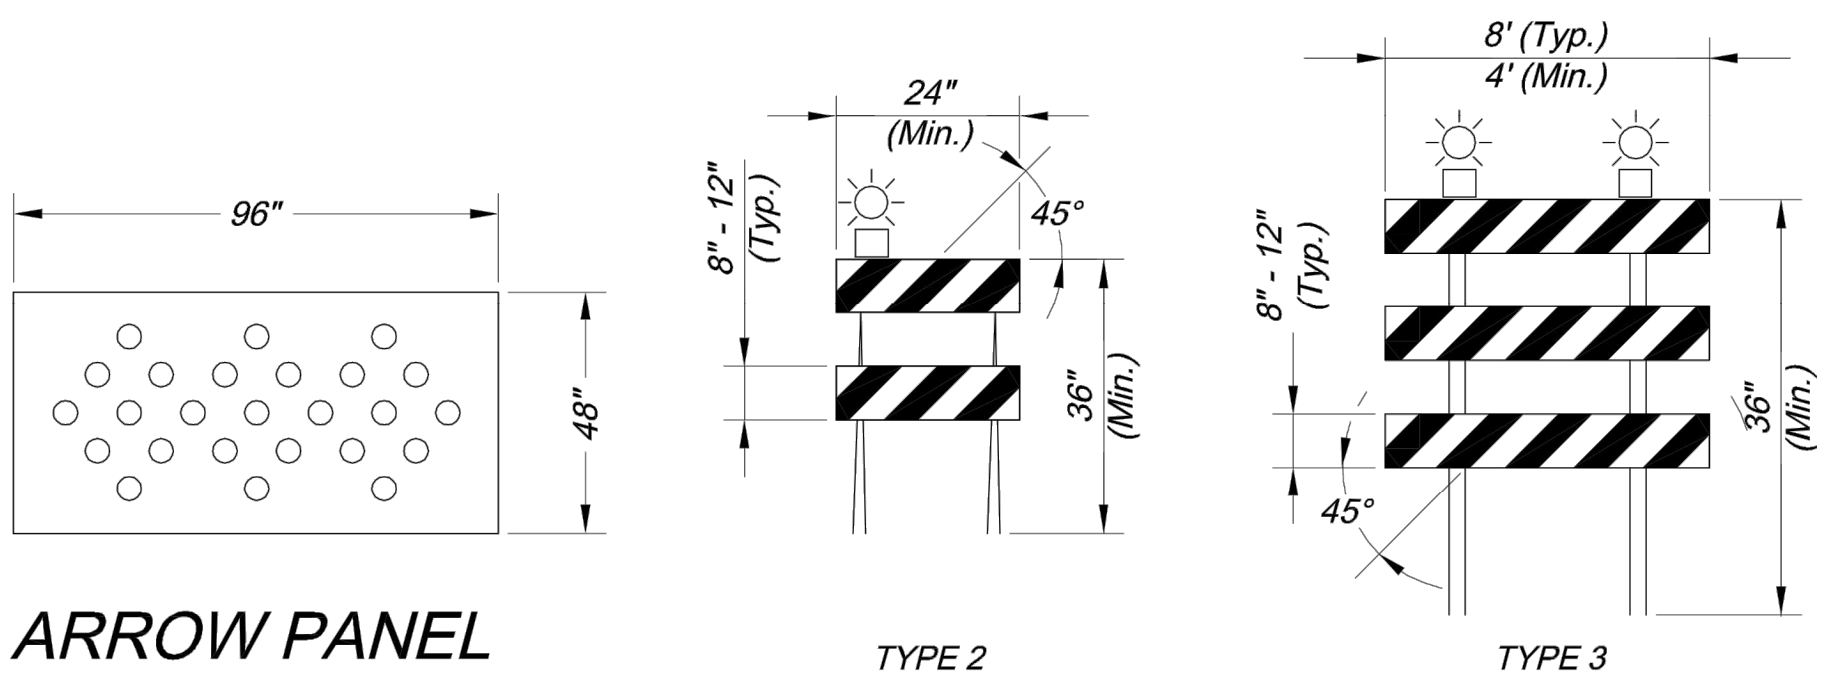

ARROW PANEL

BARRICADES


CITY OF LEE'S SUMMIT
PUBLIC WORKS DEPARTMENT
ENGINEERING DIVISION
220 SE GREEN STREET
LEE'S SUMMIT, MISSOURI 64063
PHONE: (816) 969-1800 FAX: (816) 969-1809




Project: MAIN STREET/NW SLOAN/NE TUDOR ROAD
TRAFFIC CONTROL DETAILS
Sheet Name: STANDARD DRAWING TC-1

Drawn By: JJW
Checked By: MP
Date: 12-10-2008
Project No.: X


DWG: F:\2021\04001-04500\021-04157\40-Desian\AutoCAD\Final Plans\Sheets\ROBR\T_XSC01_02104157.dwg
XREFS: T_PTBLK_02104157
T_PBASE_02104157
DATE: Oct 30, 2023 3:57pm

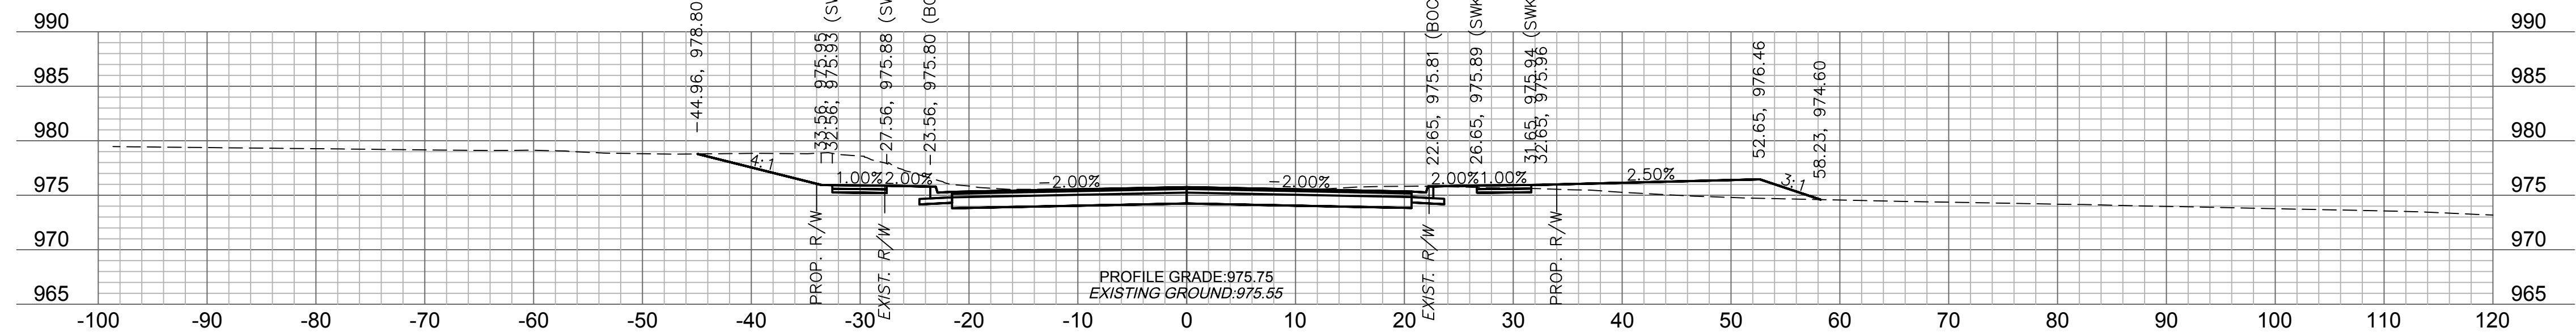


12+00

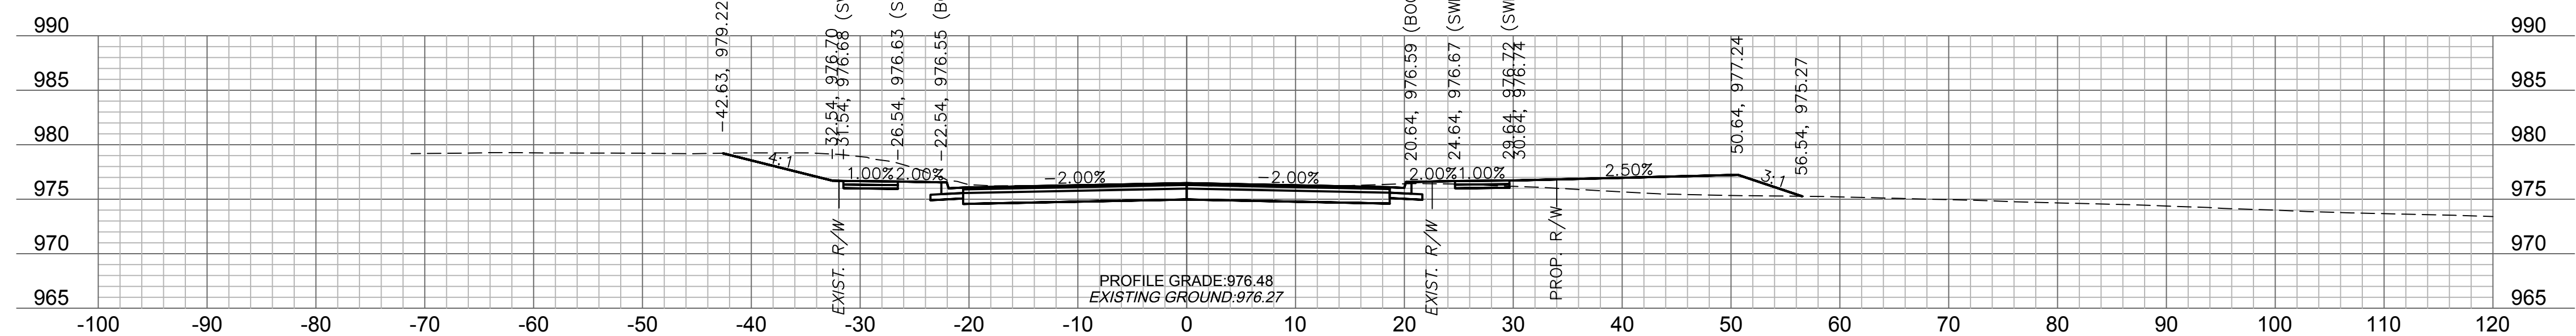


11+75

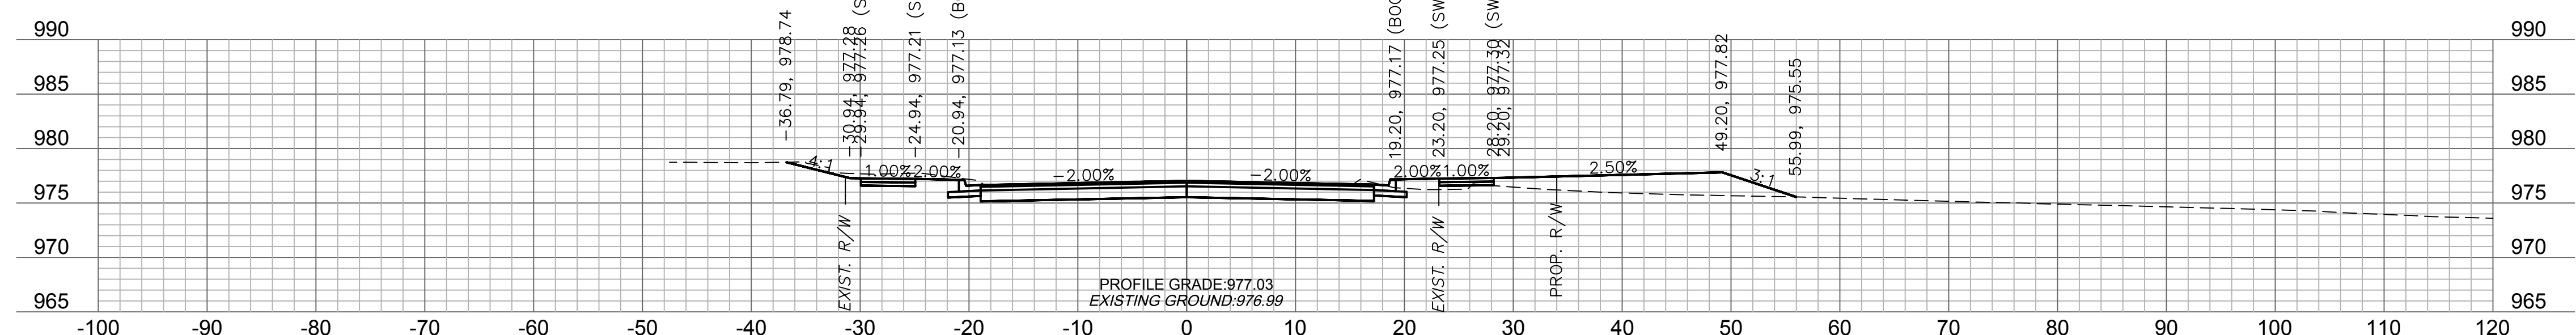


11+50

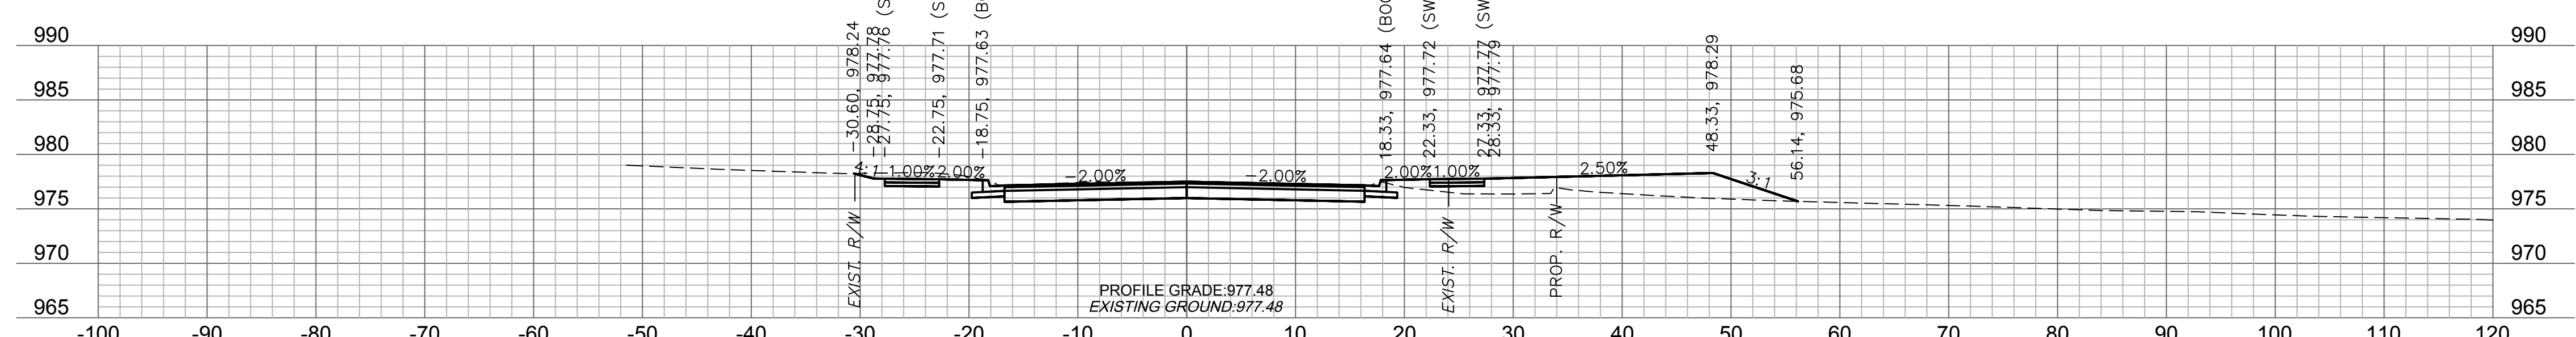

11+25

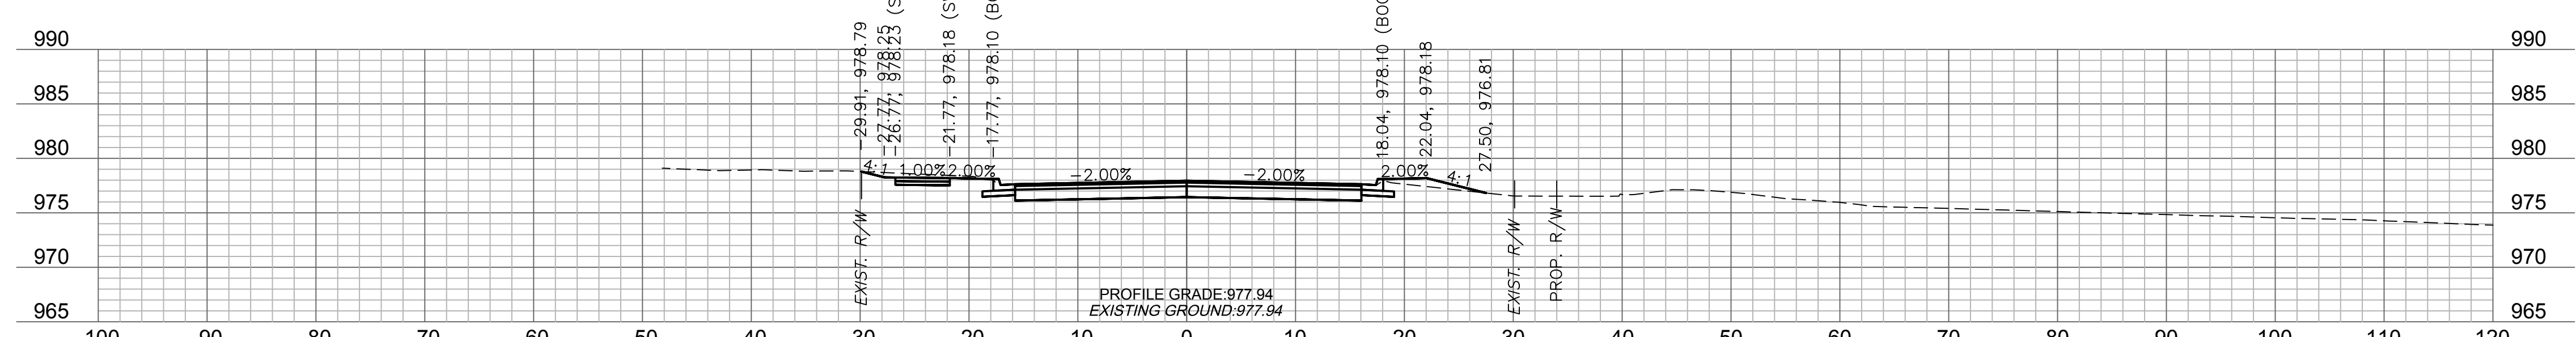

11+00

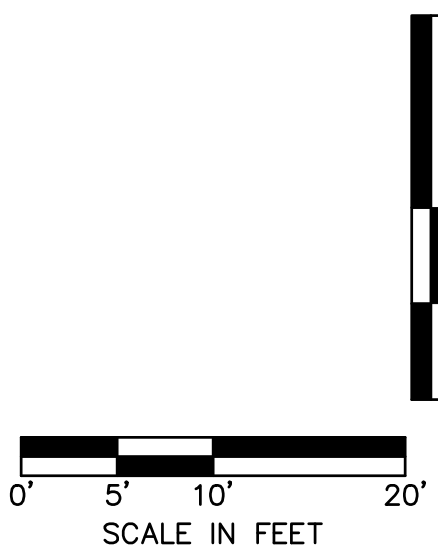

Olsson

Olsson Engineering - MO State Certificate of Authority #001592
7301 West 133rd Street, Suite 200 TEL 913.381.1170
Overland Park, KS 66213-4750 FAX 913.381.1174 www.olsson.com

RECORD
DRAWINGS

RYAN B. FLEMING
MO. NO. PE-200200316



[illegible]

MAIN STREET CROSS SECTIONS	SCANNELL DEVELOPMENT LEE'S SUMMIT LOGISTICS NORTHWEST CORNER OF TUDOR ROAD AND MAIN STREET	202
	LEE'S SUMMIT, MISSOURI	

C.O.A. NO.: _____
 DRAWN BY: _____ ARJ/AMW
 CHECKED BY: _____ XXX
 APPROVED BY: _____ RBF
 QA/QC BY: _____ RBF
 PROJECT NO.: _____ 021-04157
 DWG NO.: _____ T_XSC01_02104157
 DATE: _____ 2021-10-12

SHEET
76 OF 105






4157\40-Design\AutoCAD\Final Plans\Sheets\RDBR
T_PBASE_02104157
T_PBLK_02104157

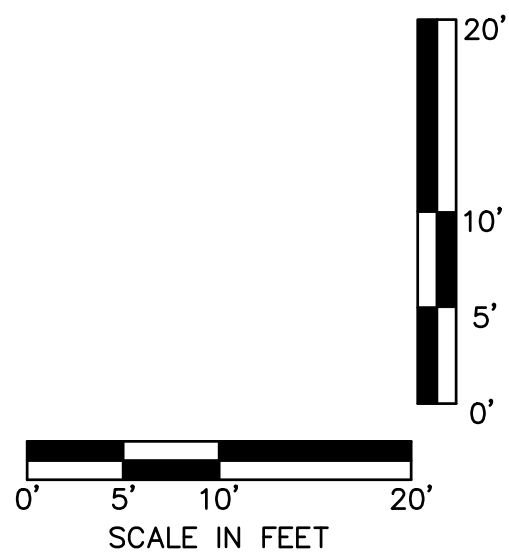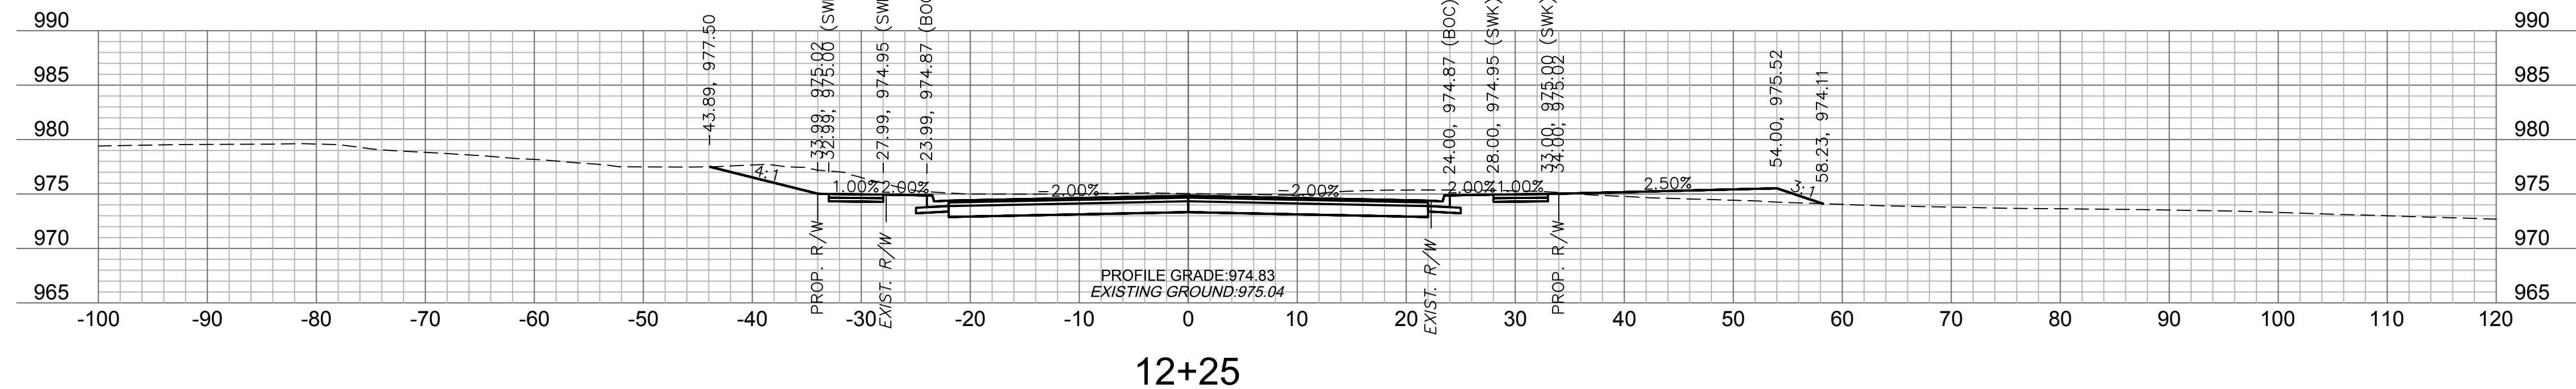

SHEET
77 OF 105

Olsson Engineering - MO State Certificate of Authority #001592
7301 West 133rd Street, Suite 200 TEL 913.381.1170
Overland Park, KS 66213-4750 FAX 913.381.1174

DWG: F:\2021\04001-04500\021-04157\40-Design\AutoCAD\Final Plans\Sheets\RDBR\T_XSC01_02104157.dwg
DATE: Oct 30, 2023 3:57pm XREFS: T_PTBK 02104157 T_PBSE 02104157

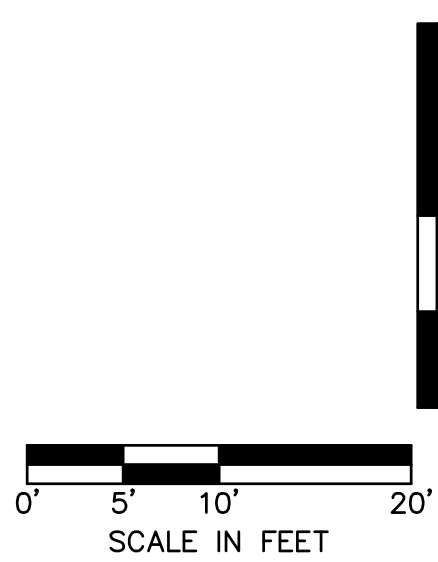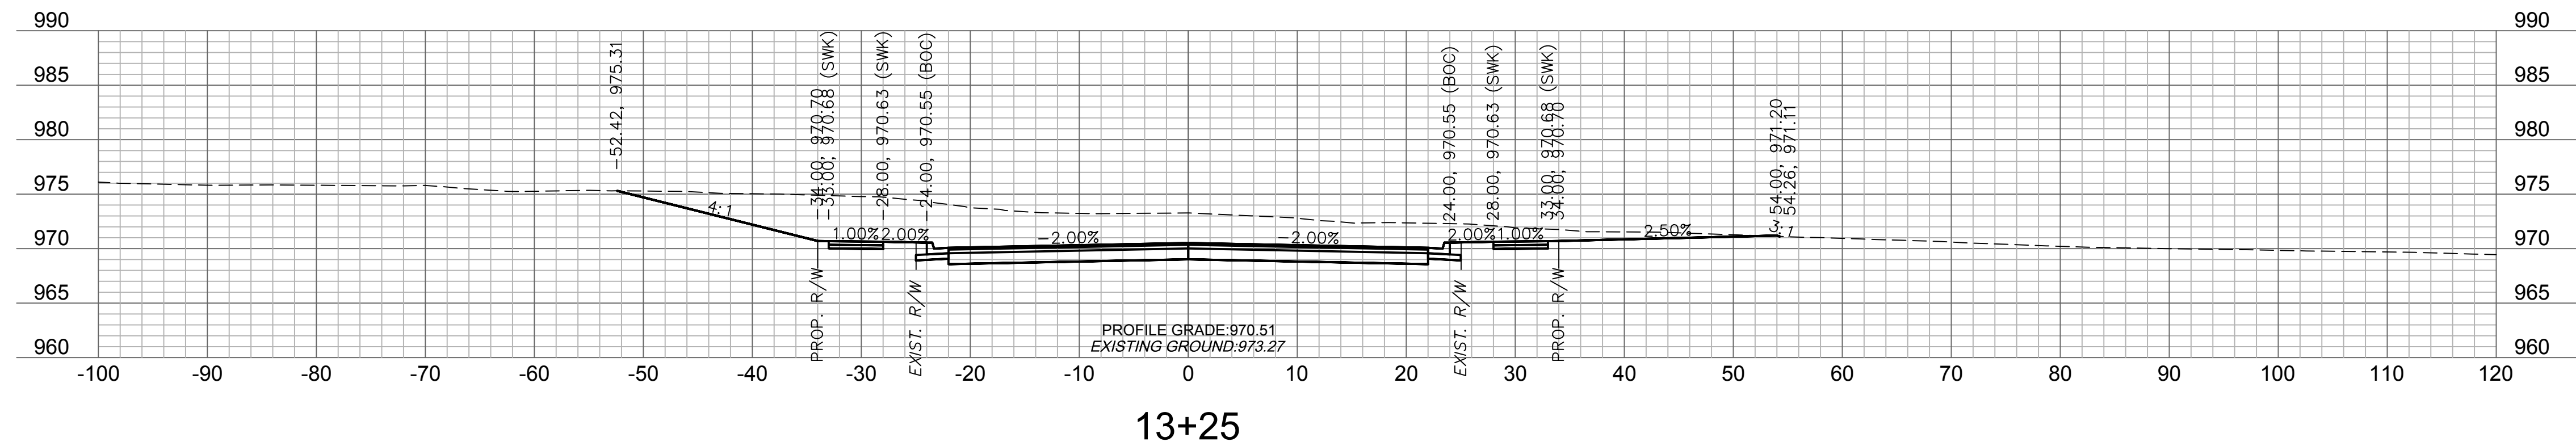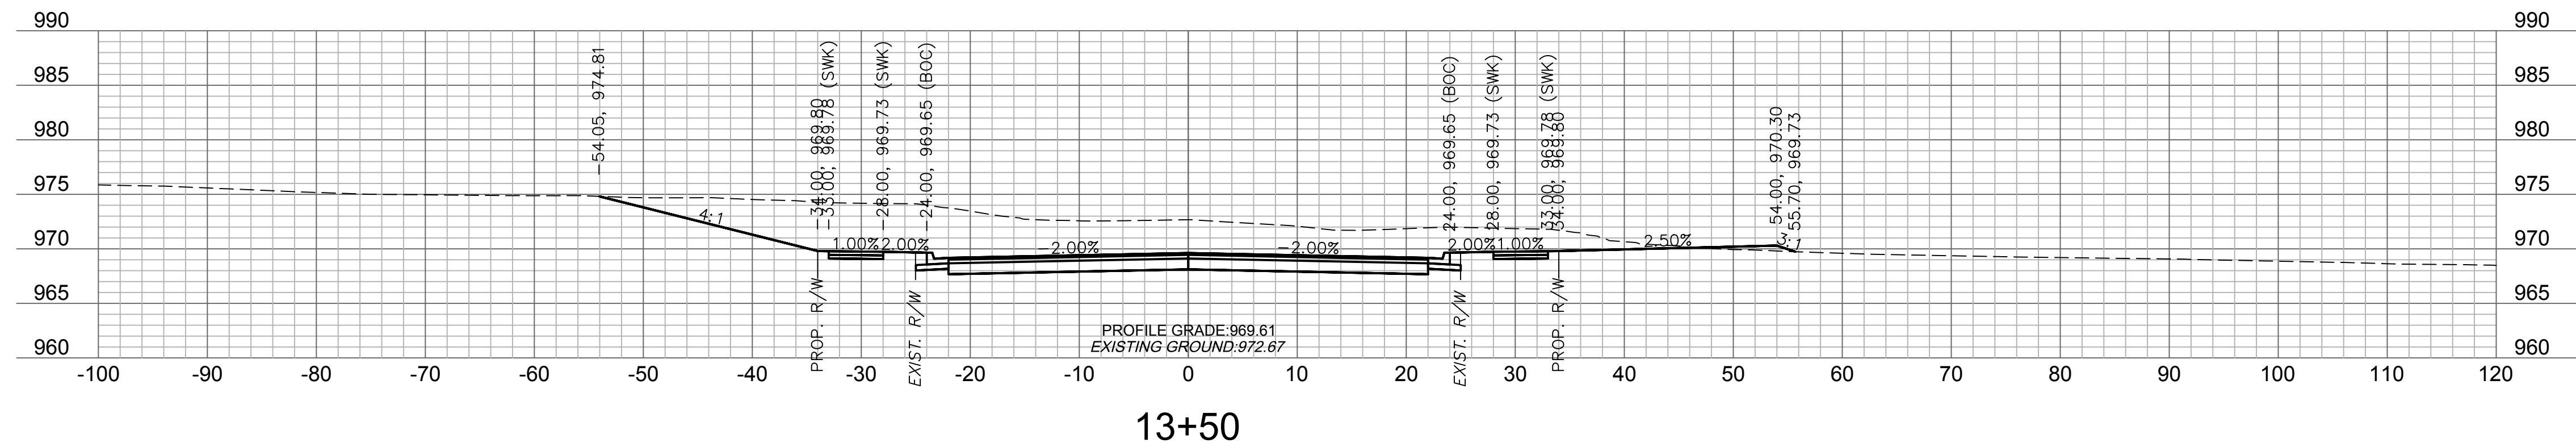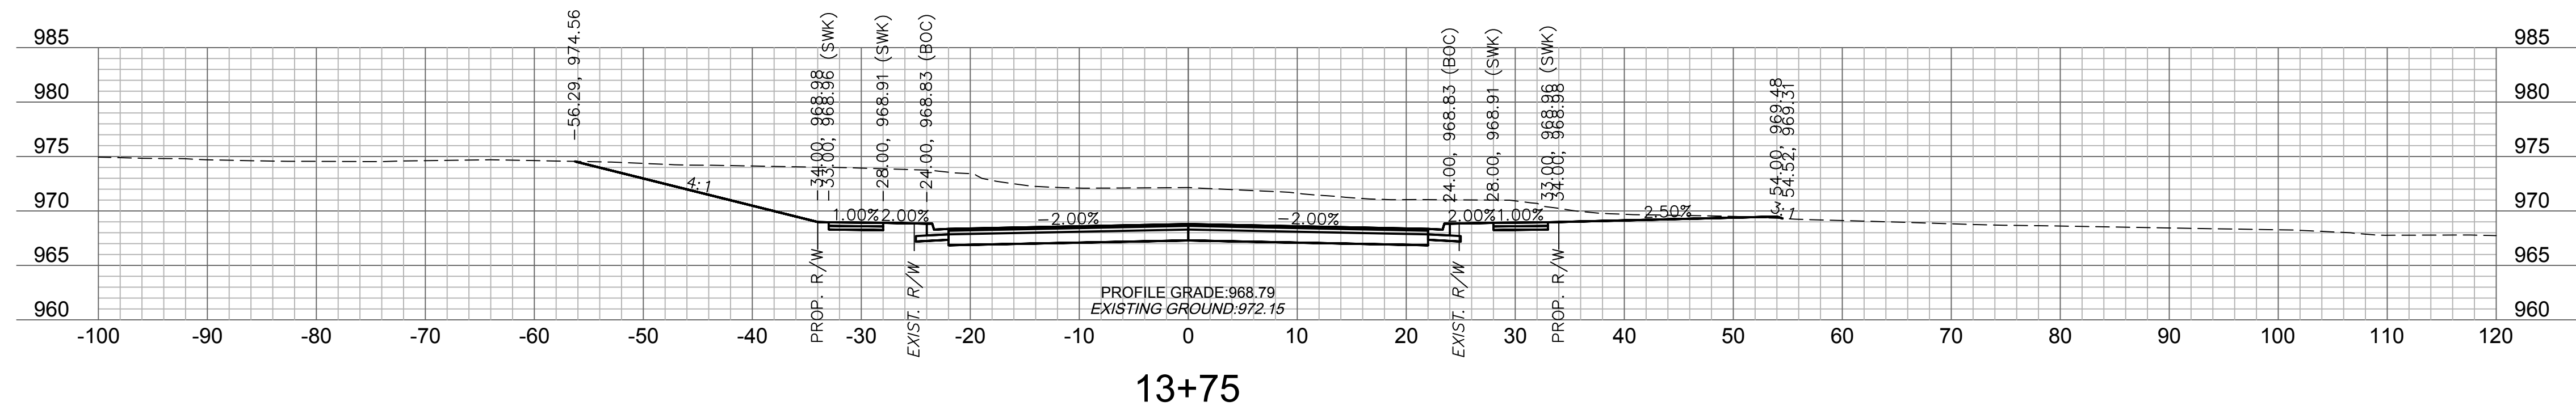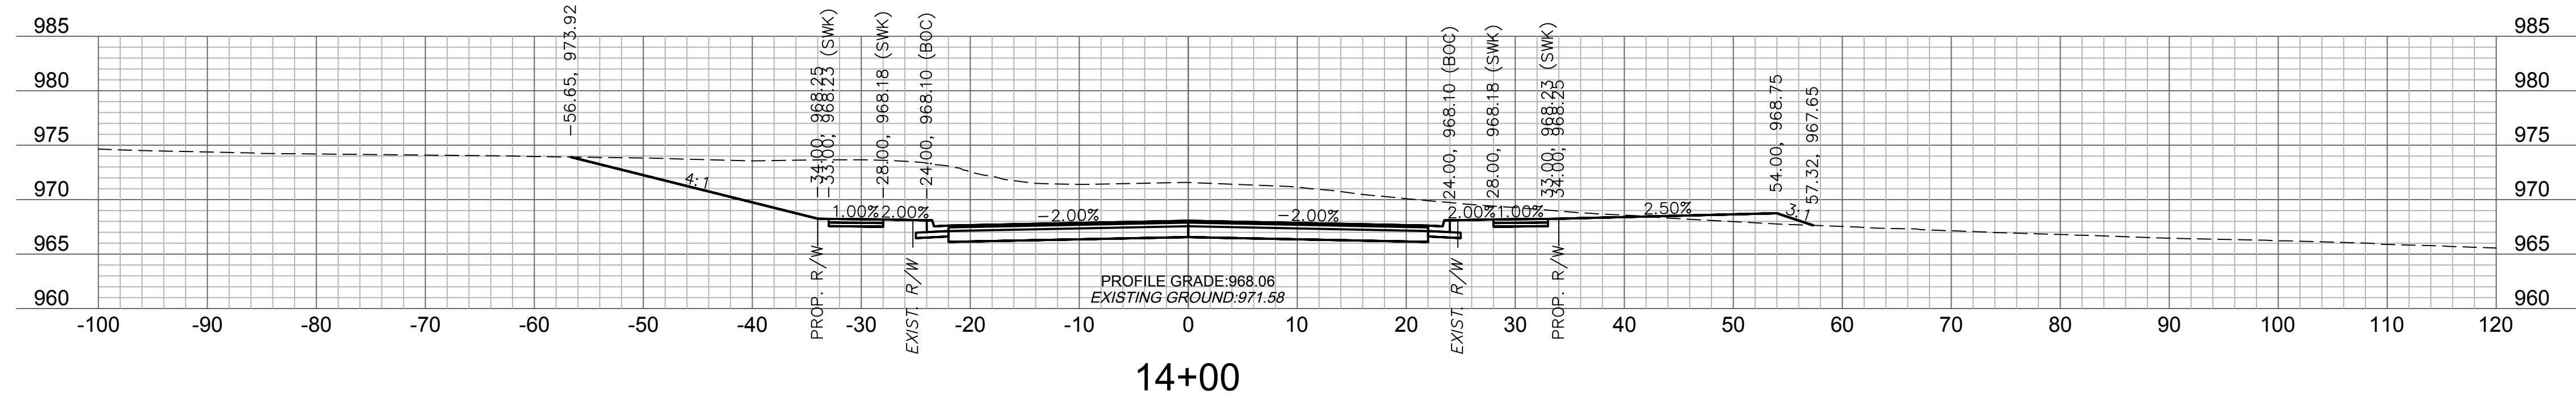

MAIN STREET CROSS SECTIONS

SCANNELL DEVELOPMENT LEE'S SUMMIT LOGISTICS NORTHWEST CORNER OF TUDOR ROAD AND MAIN STREET	2020
LEE'S SUMMIT, MISSOURI!	

C.O.A. NO.: _____ -
DRAWN BY: _____ ARJ/AMW
CHECKED BY: _____ XXX
APPROVED BY: _____ RBF
QA/QC BY: _____ RBF
PROJECT NO.: _____ 021-04157
DWG NO.: T_XSC01_02104157
DATE: _____ 2021-10-12

SHEET
78 OF 105


RECORD
DRAWINGS

RYAN B. FLEMING
MO. NO. PE-2002003161



[illegible]

olson


Olsson Engineering - MO State Certificate of Authority #001592
7301 West 133rd Street, Suite 200 TEL 913.381.1170
Overland Park, KS 66213-4750 FAX 913.381.1174 www.olsson.com

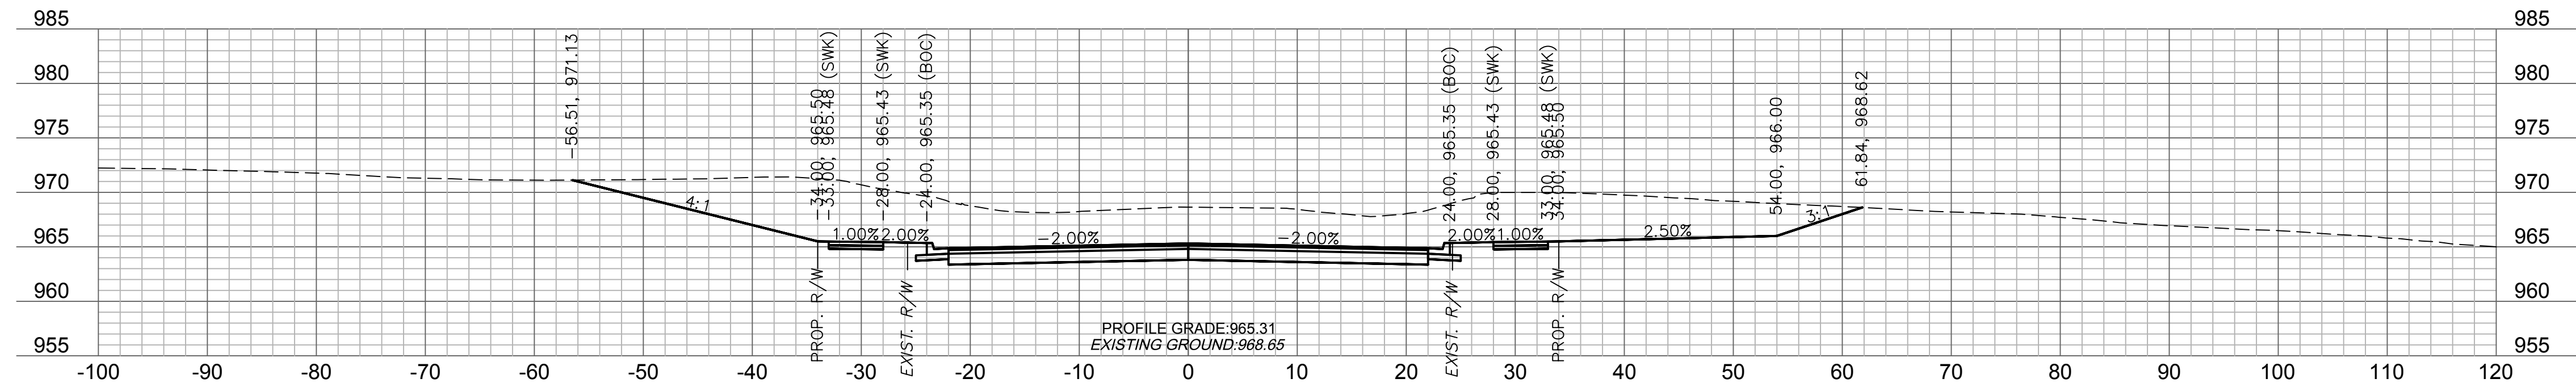

15+00

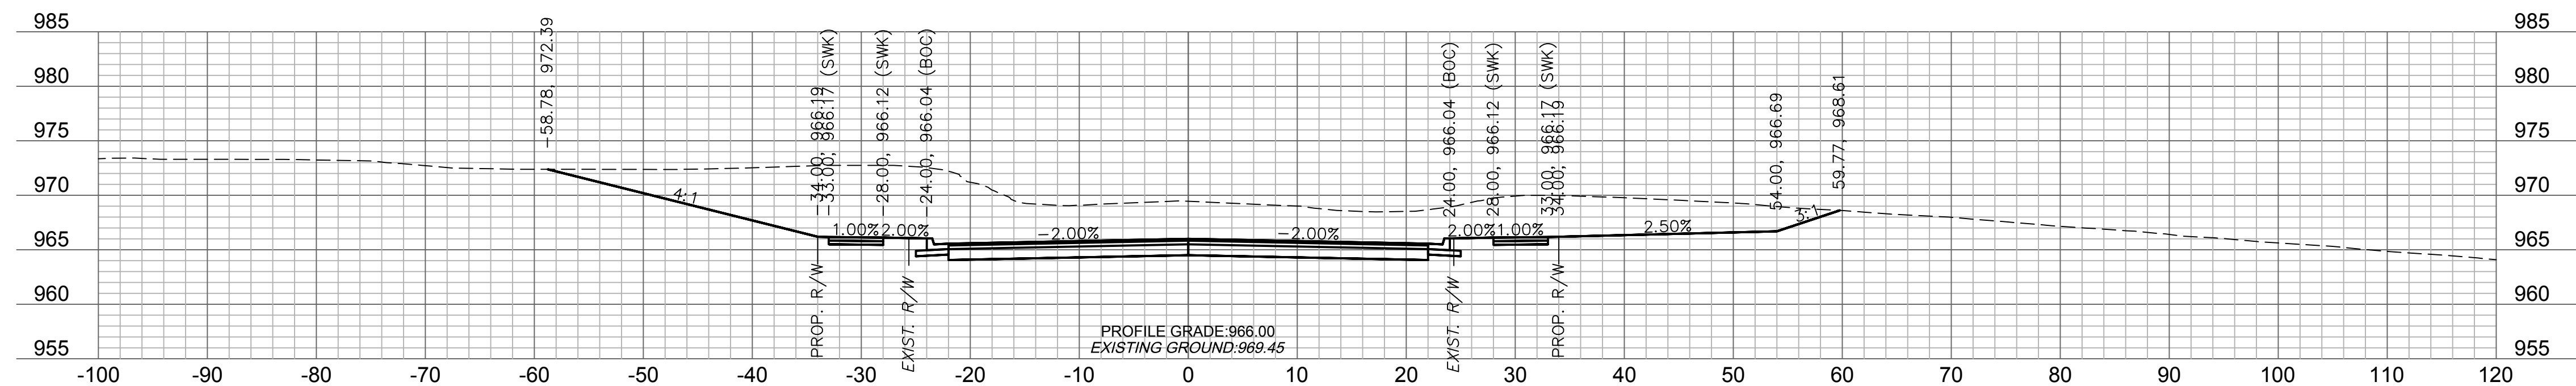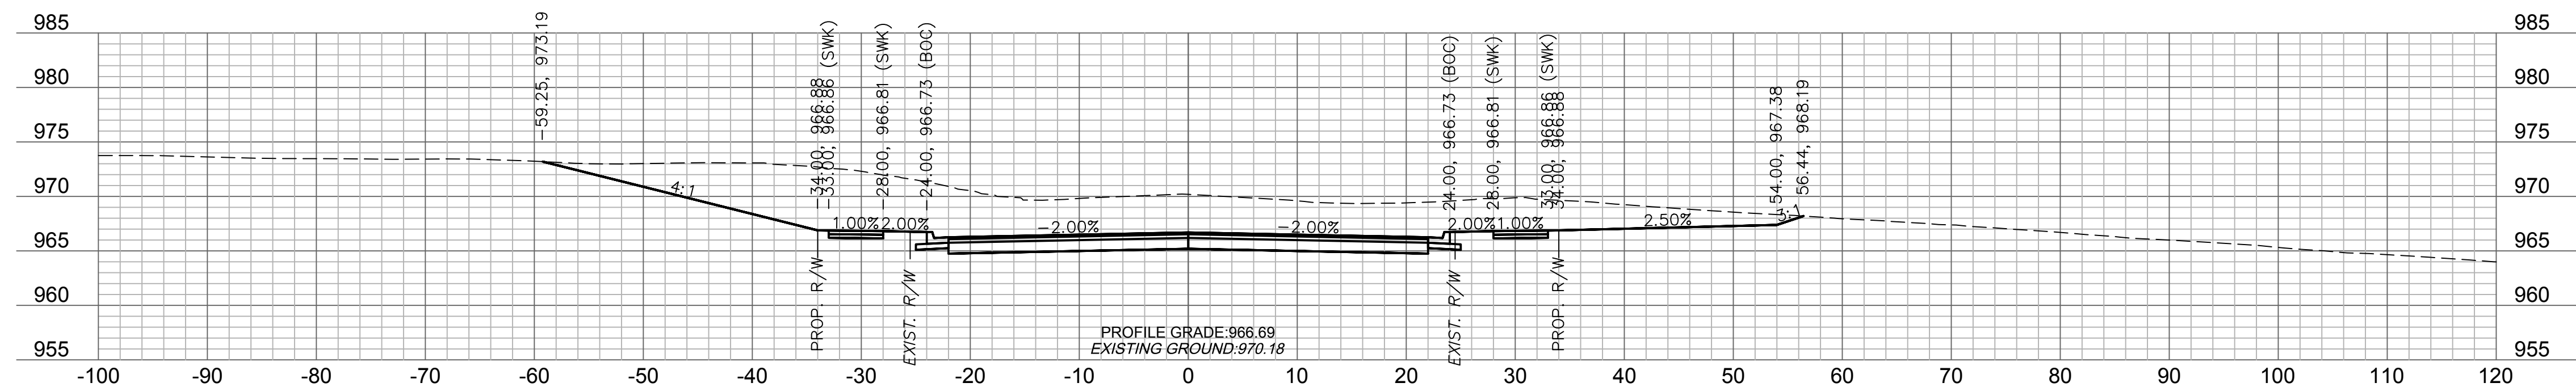 $14+75$ 


14+50

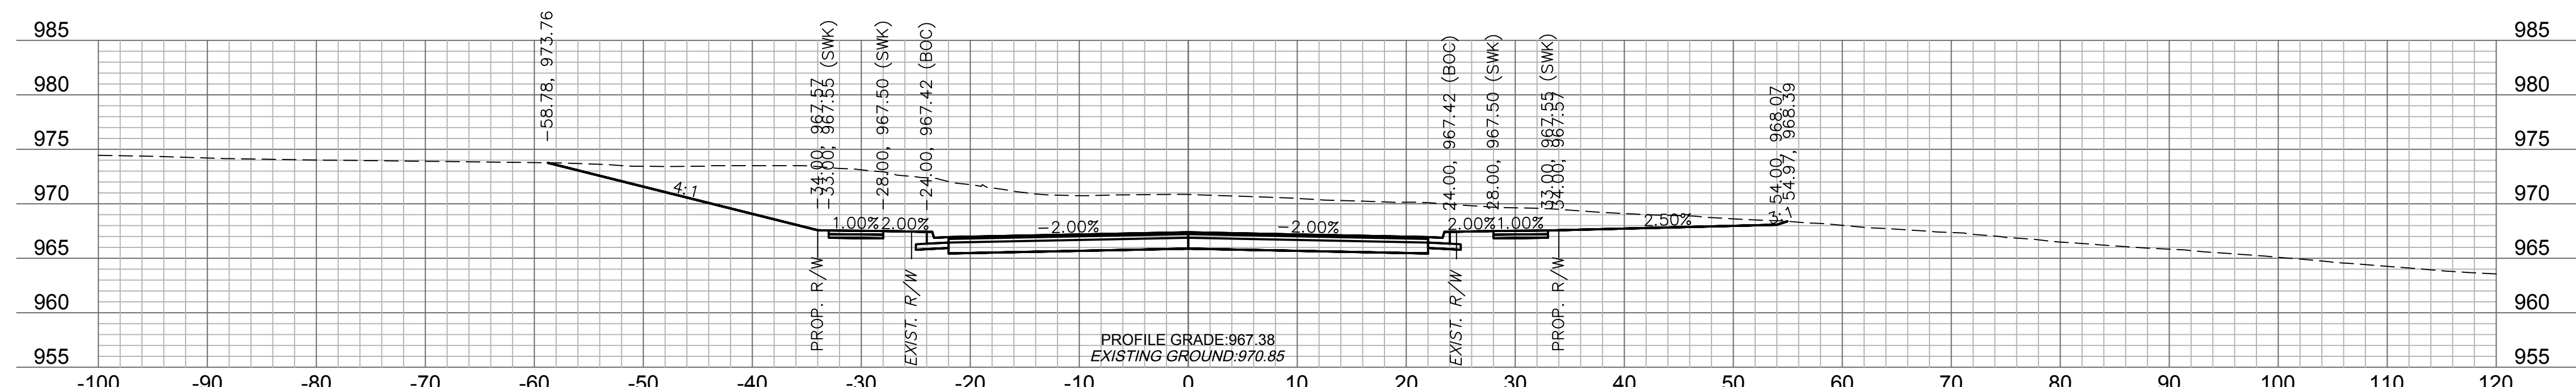


14+25




USER: asaavedra

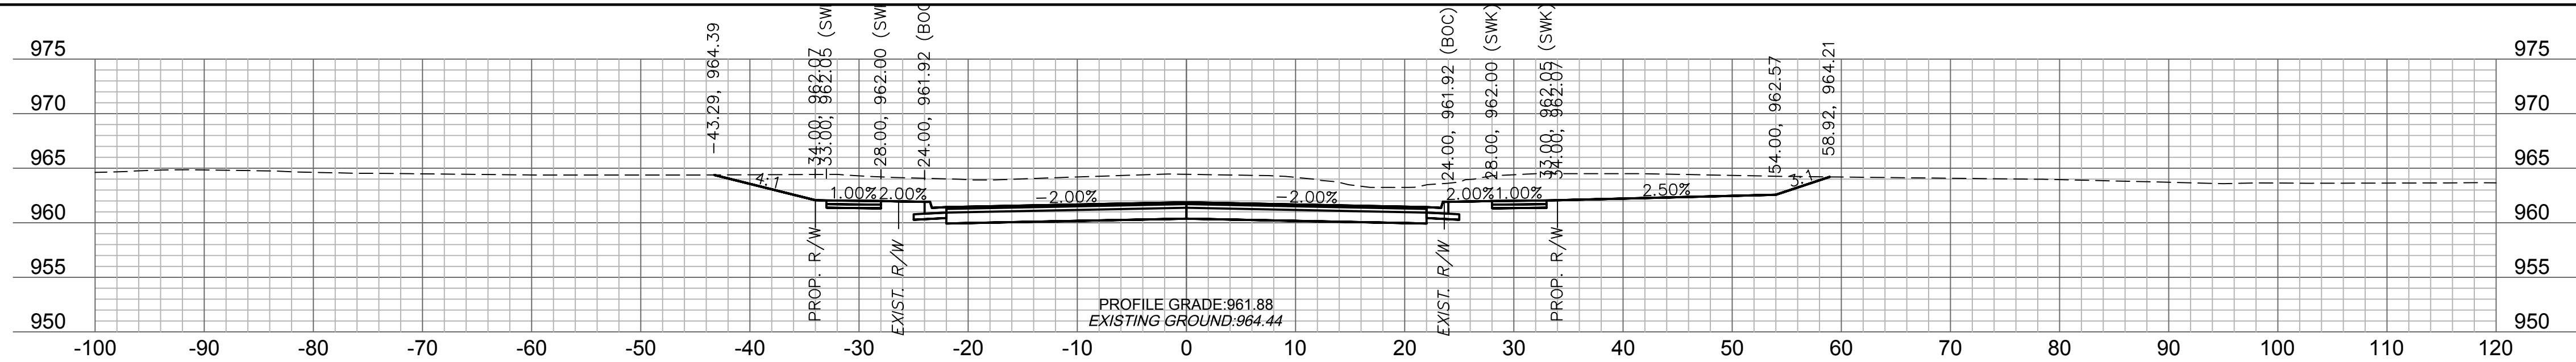


16+25

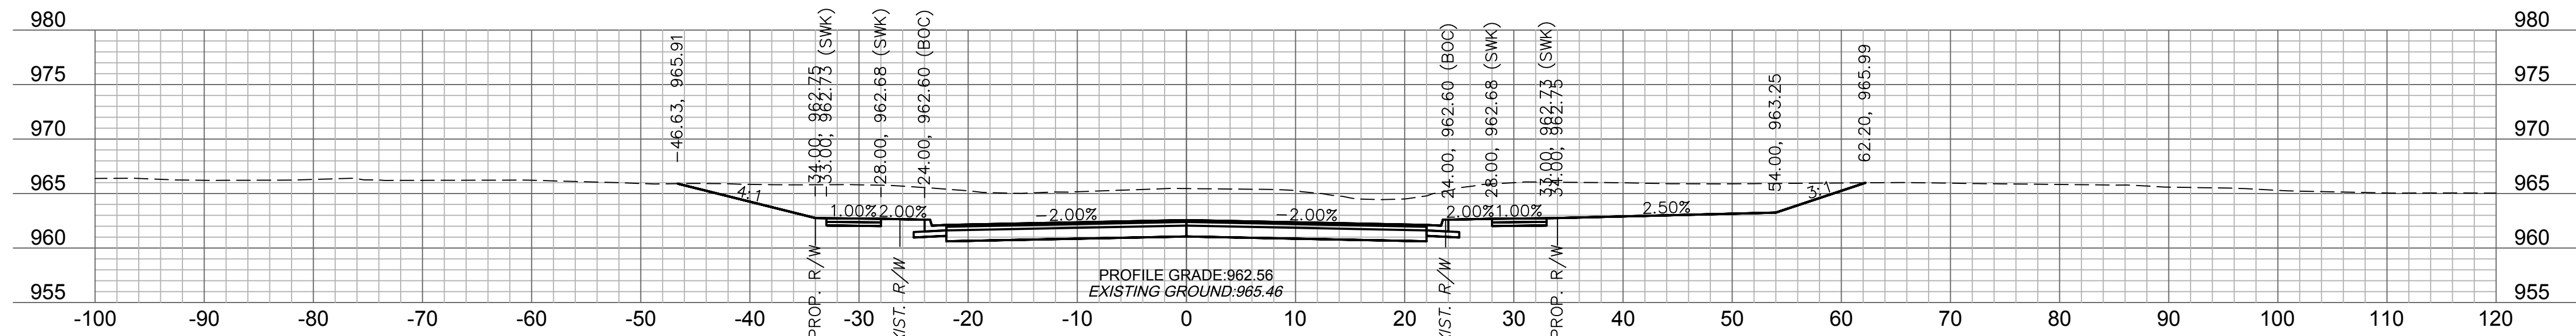


16+00

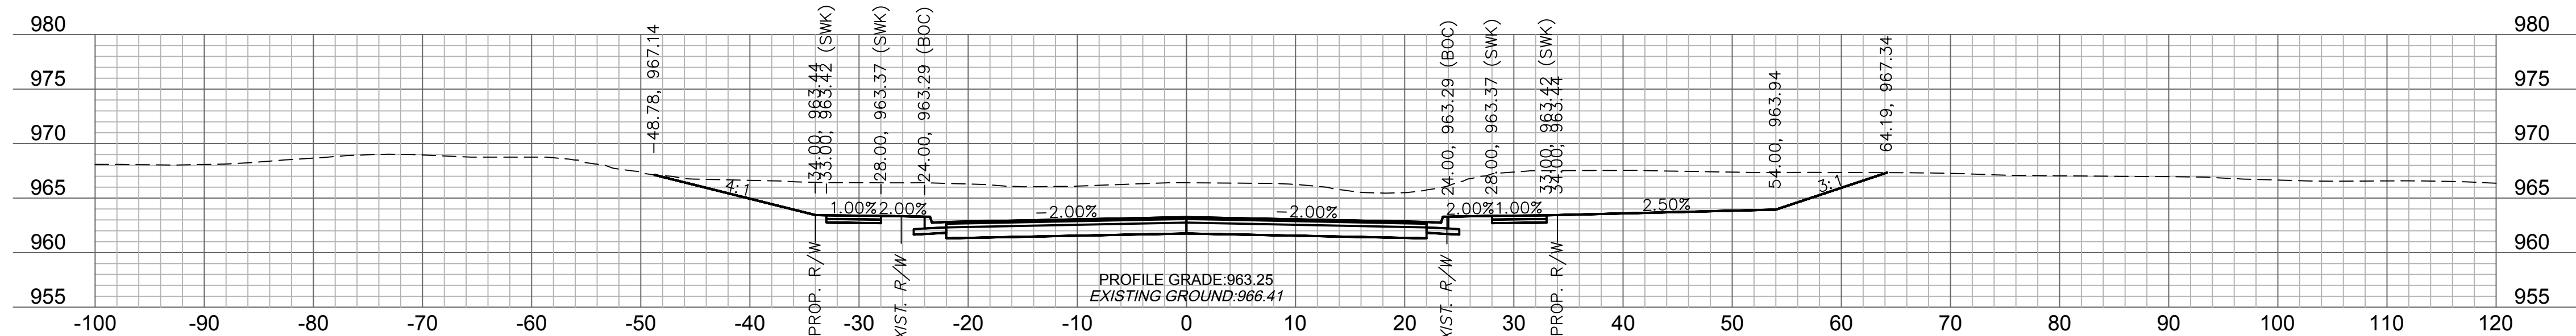

15+75

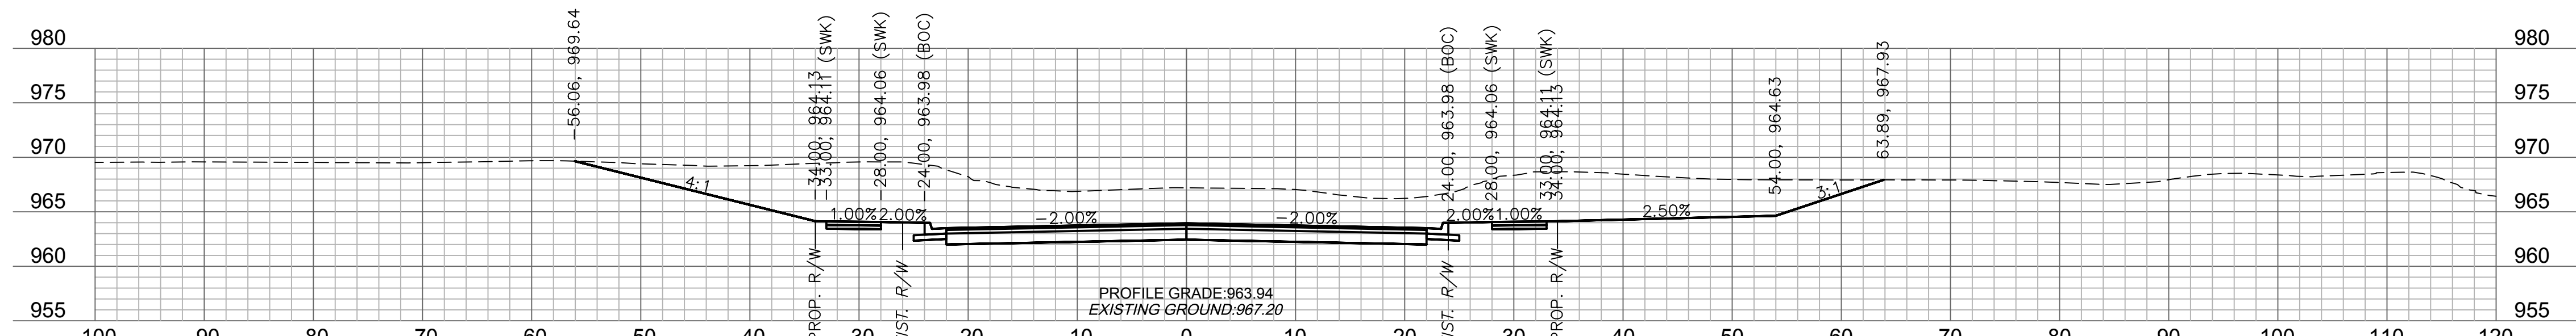

15+50

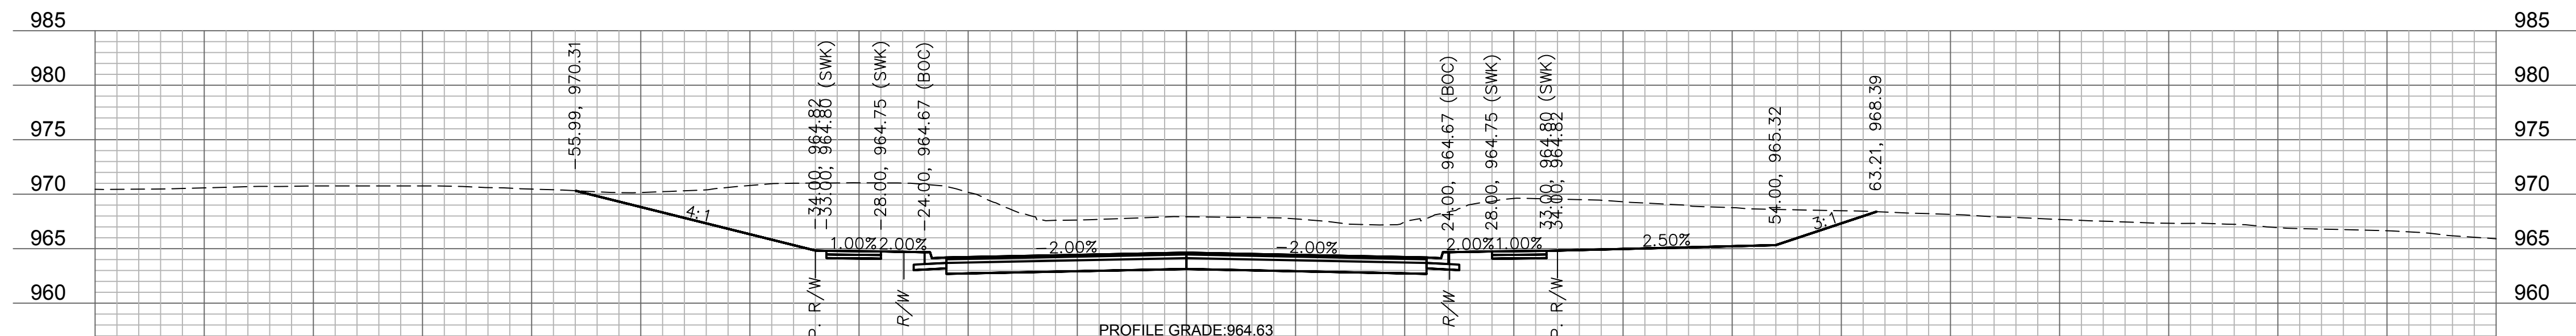

15+25



MAIN STREET
CROSS SECTIONS

SCANNELL DEVELOPMENT LEE'S SUMMIT LOGISTICS NORTHWEST CORNER OF TUDOR ROAD AND MAIN STREET LEE'S SUMMIT, MISSOURI	2020
---	------

LEE'S SUMMIT, MISSOURI

2021

[illegible]



RECORD
DRAWINGS

RYAN B. FLEMING
MO. NO. PE-2002003161


Olsson Engineering - MO State Certificate of Authority #001592
7301 West 133rd Street, Suite 200 TEL 913.381.1170
Overland Park, KS 66213-4750 FAX 913.381.1174 www.olsson.com

olson


DWG: F:\2021\04001\021-04157\40-Design\AutoCAD\Final Plans\Sheets\ROBR\T_XSC01_02104157.dwg
DATE: Oct 30, 2023 3:57pm XREFS: T_PTBLK_02104157 T_PBASE_02104157

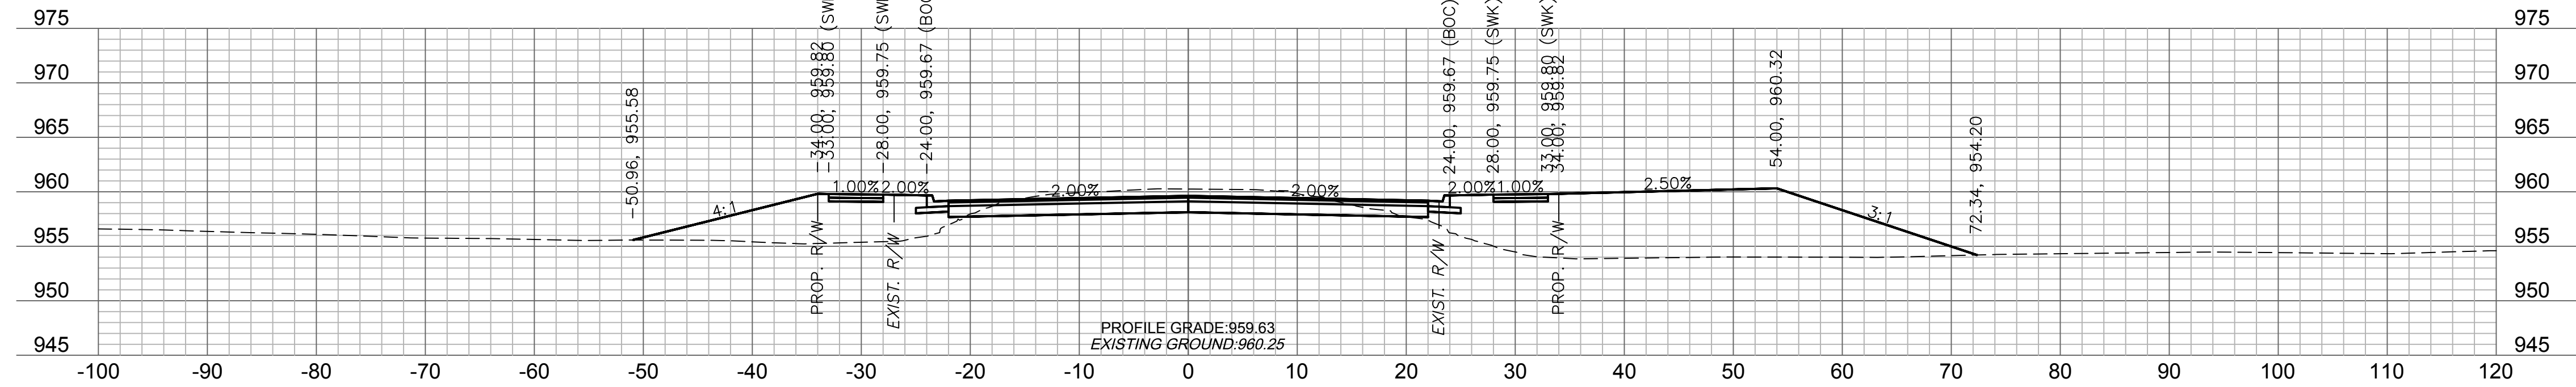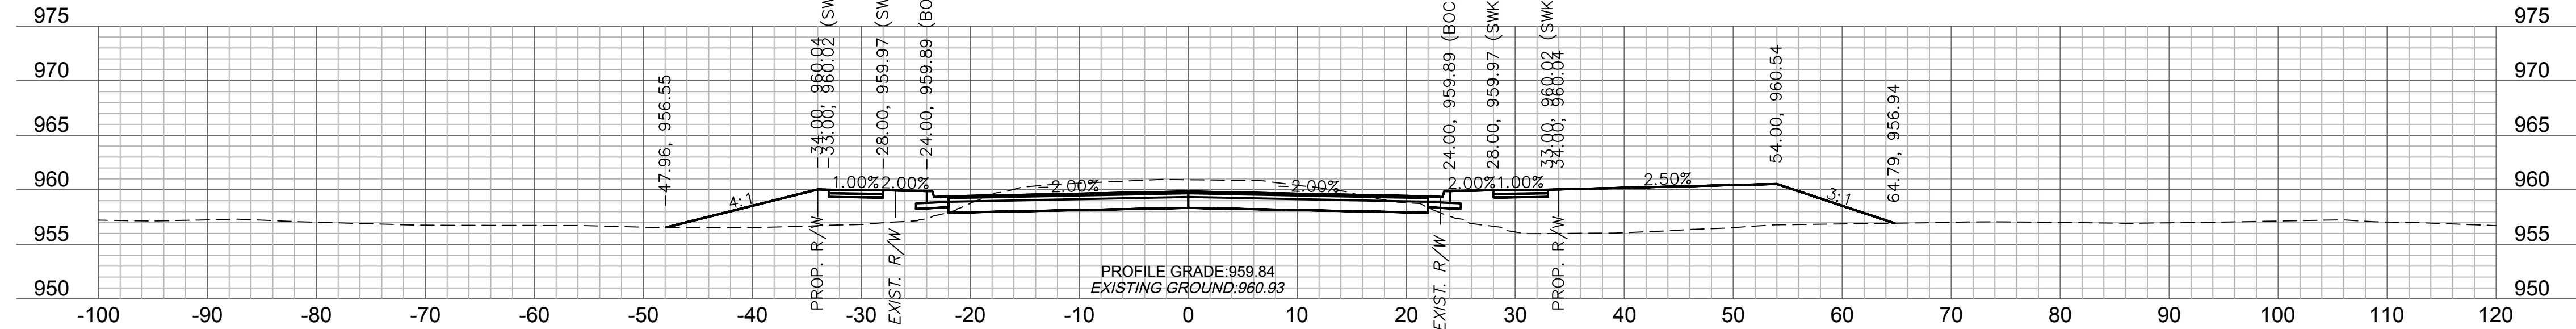 $17+50$ 


17+25

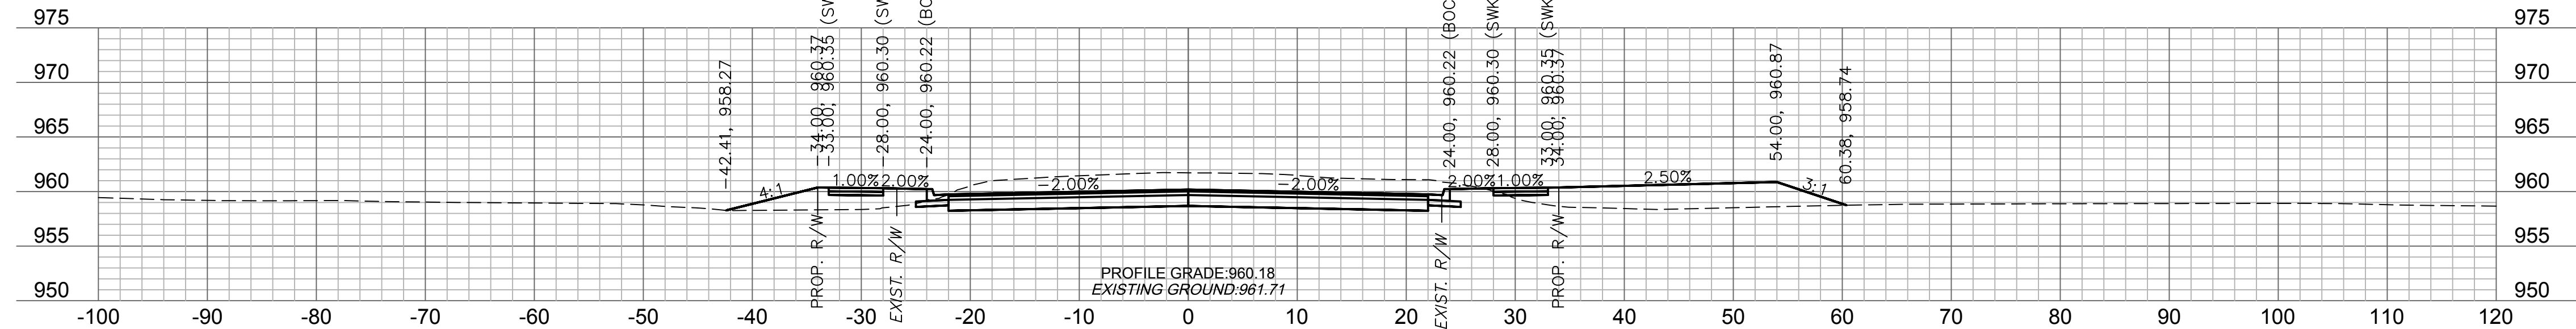

17+00

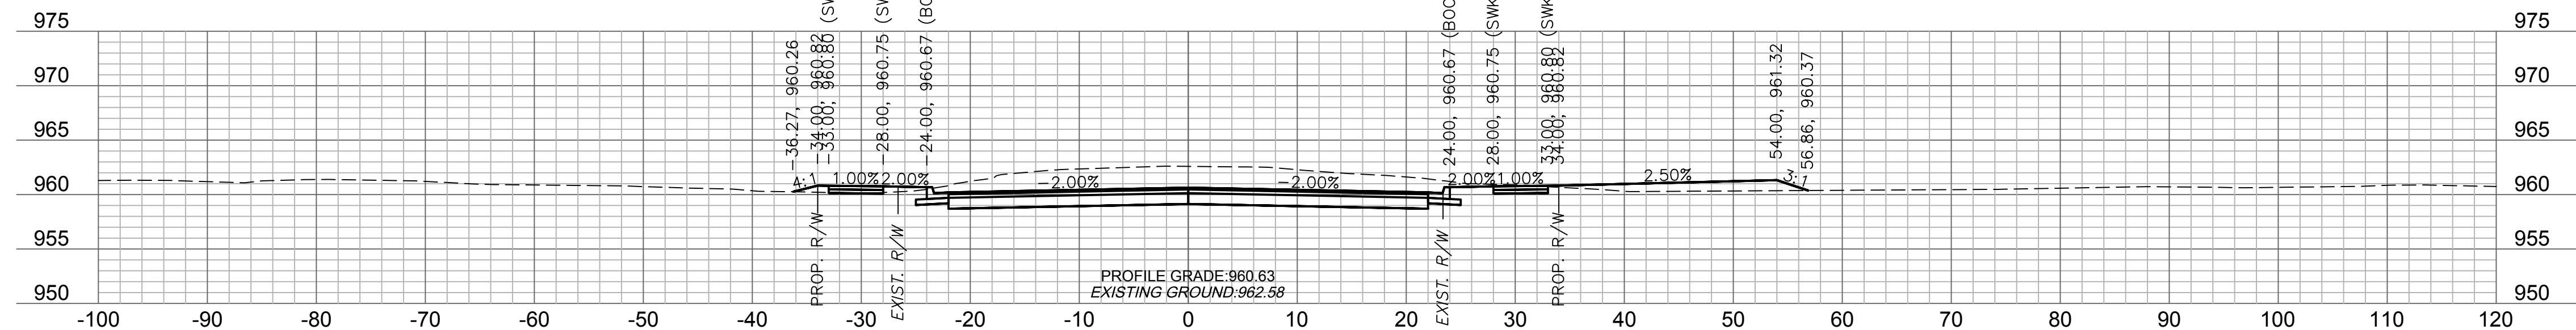

16+75

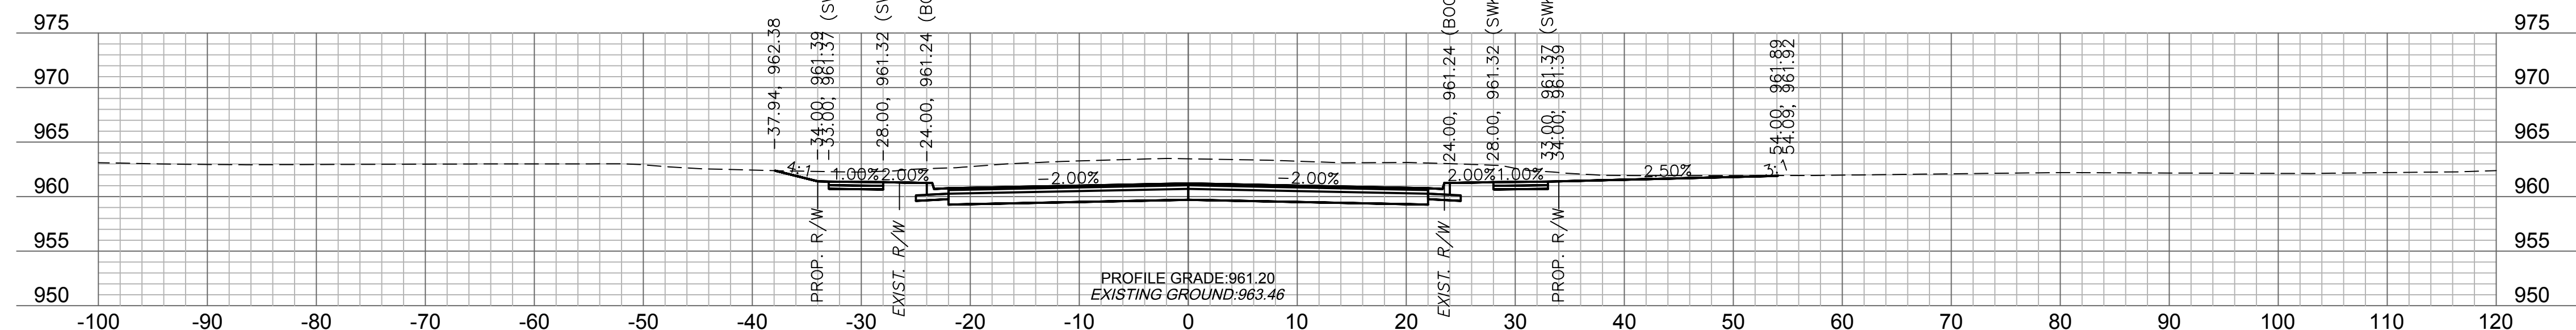

16+50



olson

Olsson Engineering - MO State Certificate of Authority #001592
7301 West 133rd Street, Suite 200 TEL 913.381.1170
Overland Park, KS 66213-4750 FAX 913.381.1174 www.olsson.com

RECORD
DRAWINGS

RYAN B. FLEMING
MO. NO. PE-2002003161

		REV. NO.	DATE	REVISIONS DESCRIPTION	BY
	SHEET				
2021		REVISIONS			

MAIN STREET CROSS SECTIONS



SCANNELL DEVELOPMENT LEE'S SUMMIT LOGISTICS
NORTHWEST CORNER OF TUDOR ROAD AND MAIN STREET

LEE'S SUMMIT, MISSOURI


C.O.A. NO.: _____
DRAWN BY: _____ ARJ/AMW
CHECKED BY: _____ XXX
APPROVED BY: _____ RBF
QA/QC BY: _____ RBF
PROJECT NO.: _____ 021-04157
DWG NO.: T_XSC01_02104157
DATE: _____ 2021-10-12

SHEET
81 OF 105



DWG: F:\2021\04001-04500\021-04157\40-Design\AutoCAD\Final Plans\Sheets\RDBR\T_XSC01_02104157.dwg
DATE: Oct 30, 2023 3:57pm XREFS: T_PTBULK_02104157 T_PBASE_02104157

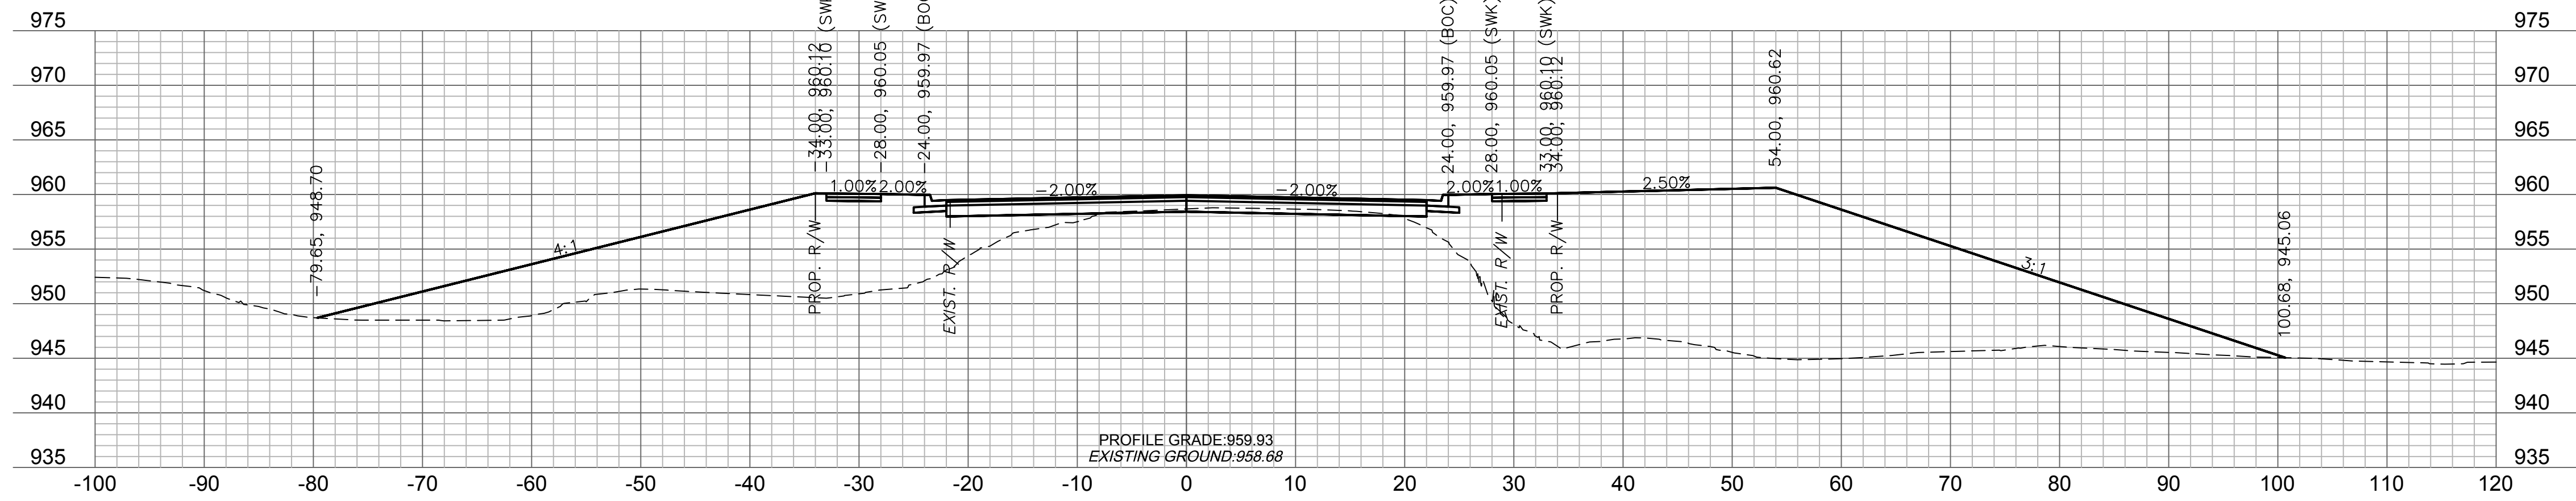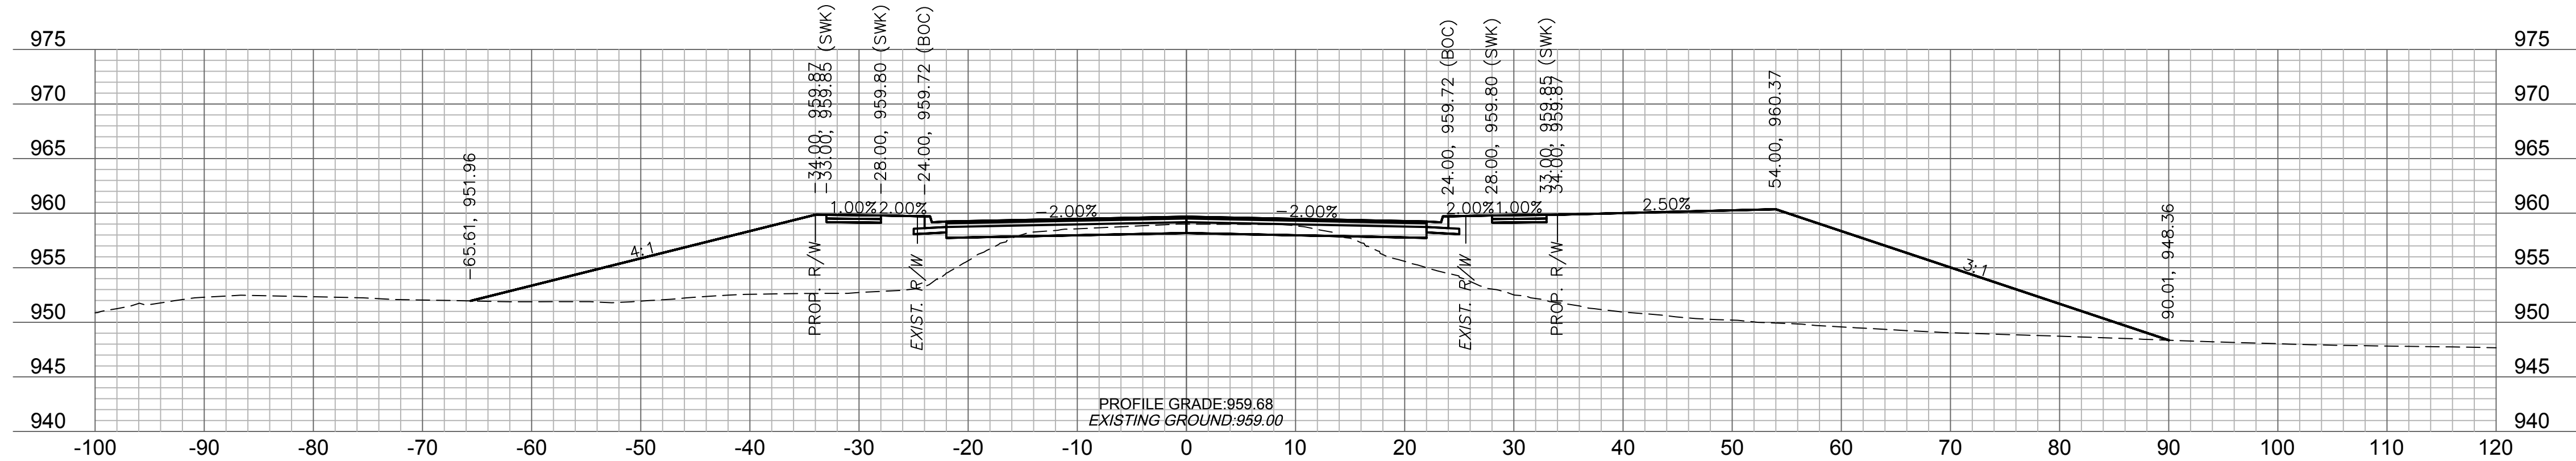 $18+50$ 

18+25

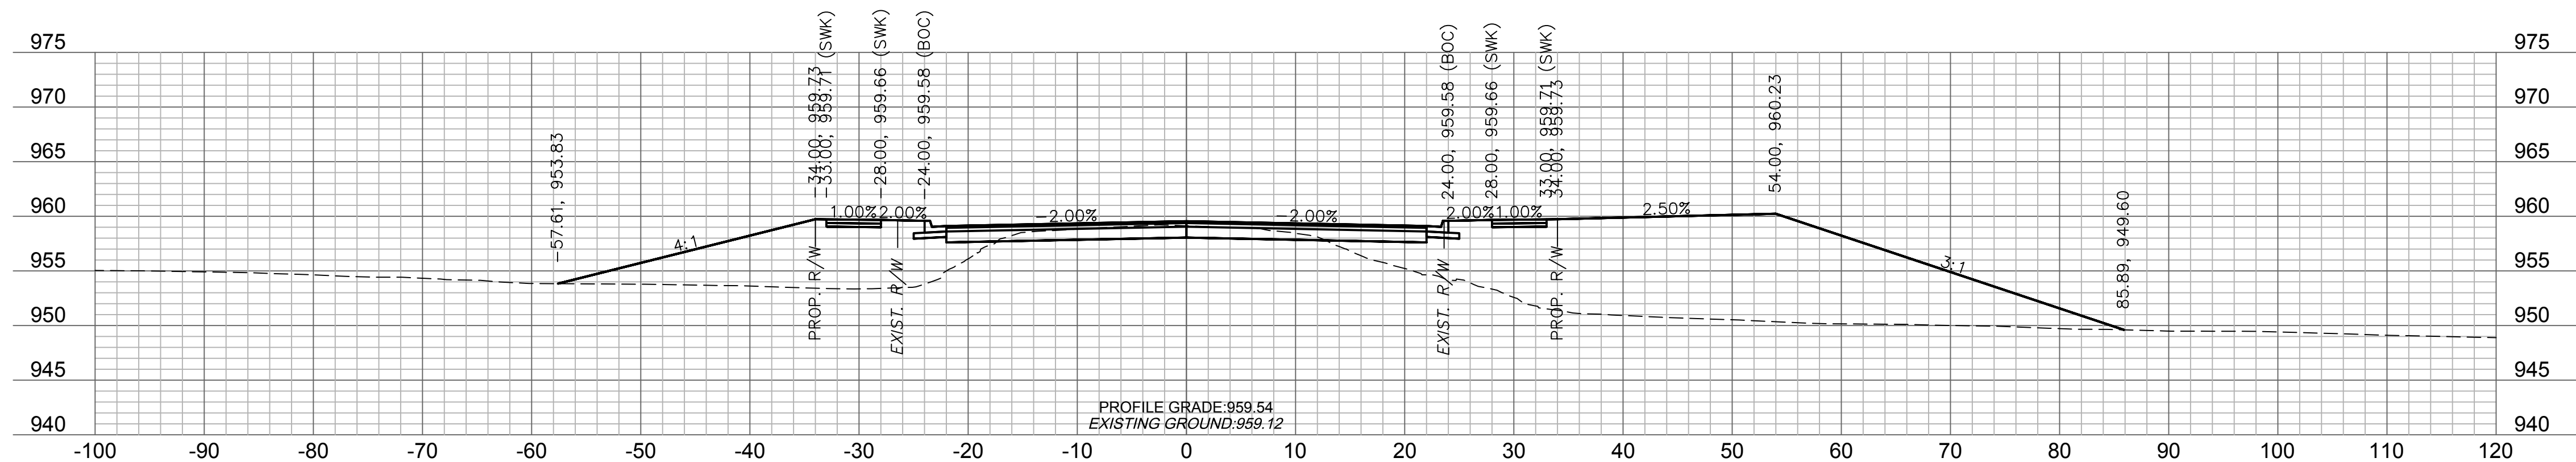

18+00

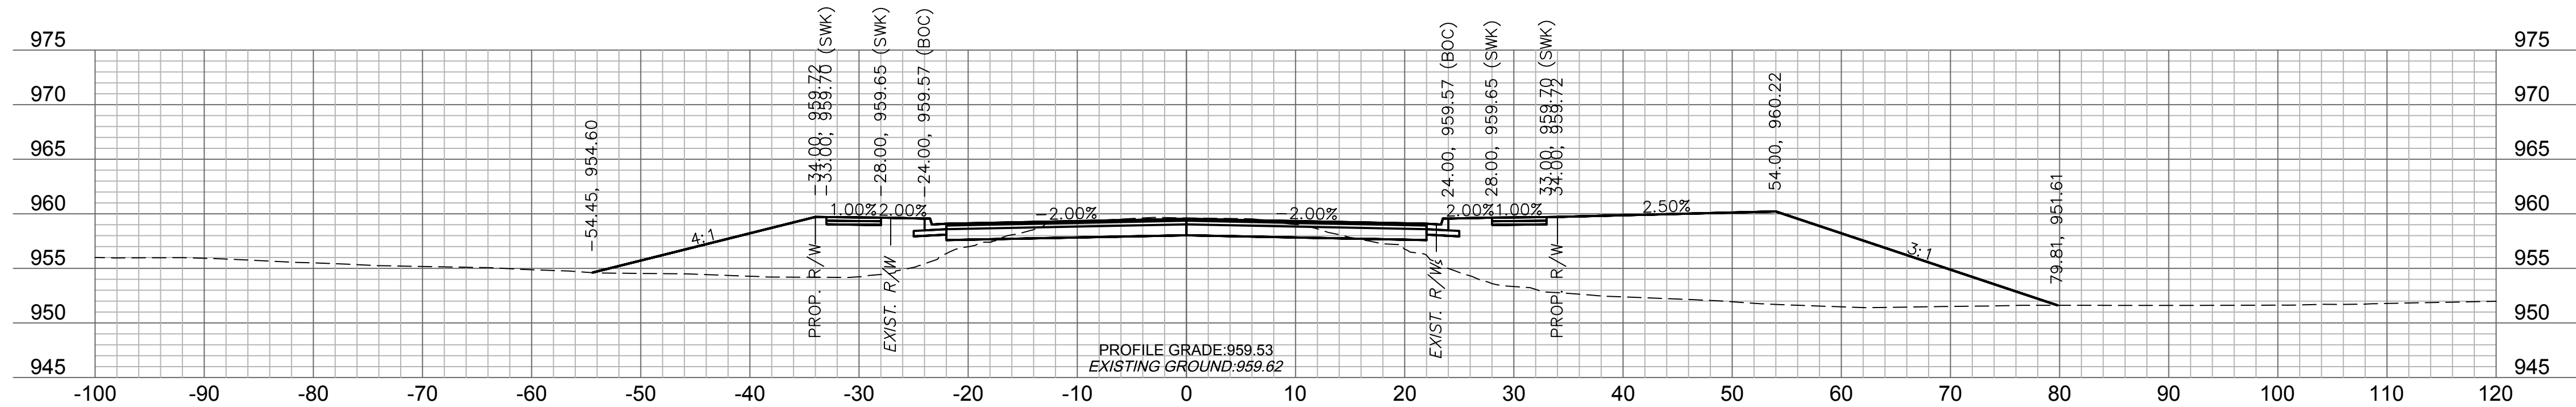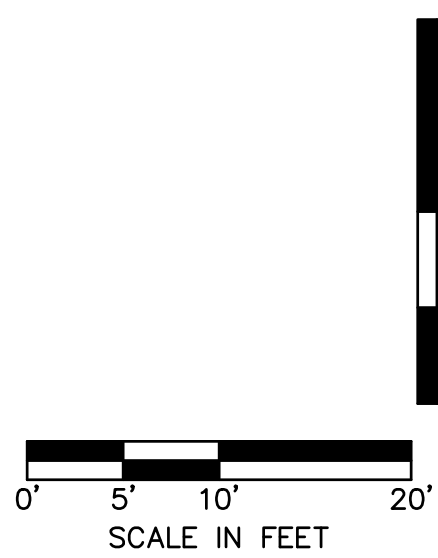 $17+75$ 

olson

Olsson Engineering - MO State Certificate of Authority #001592
7301 West 133rd Street, Suite 200 TEL 913.381.1170
Overland Park, KS 66213-4750 FAX 913.381.1174 www.olsson.com

RECORD
DRAWINGS

RYAN B. FLEMING
MO. NO. PE-2002003161

[illegible]

MAIN STREET CROSS SECTIONS


SCANNELL DEVELOPMENT LEE'S SUMMIT LOGISTICS
NORTHWEST CORNER OF TUDOR ROAD AND MAIN STREET

LEE'S SUMMIT, MISSOURI


C.O.A. NO.: _____
 DRAWN BY: _____ ARJ/AMV
 CHECKED BY: _____ XX
 APPROVED BY: _____ RB
 QA/QC BY: _____ RB
 PROJECT NO.: _____ 021-0415
 DWG NO.: _____ T_XSC01_0210415
 DATE: _____ 2021-10-1

SHEET
82 OF 105


DWG: F:\2021\04001\021-04157\40-Design\AutoCAD\Final Plans\Sheets\ROBR\T_XSC01_02104157.dwg
DATE: Oct 30, 2023 3:57pm XREFS: T_PTBLK_02104157 T_PBASE_02104157

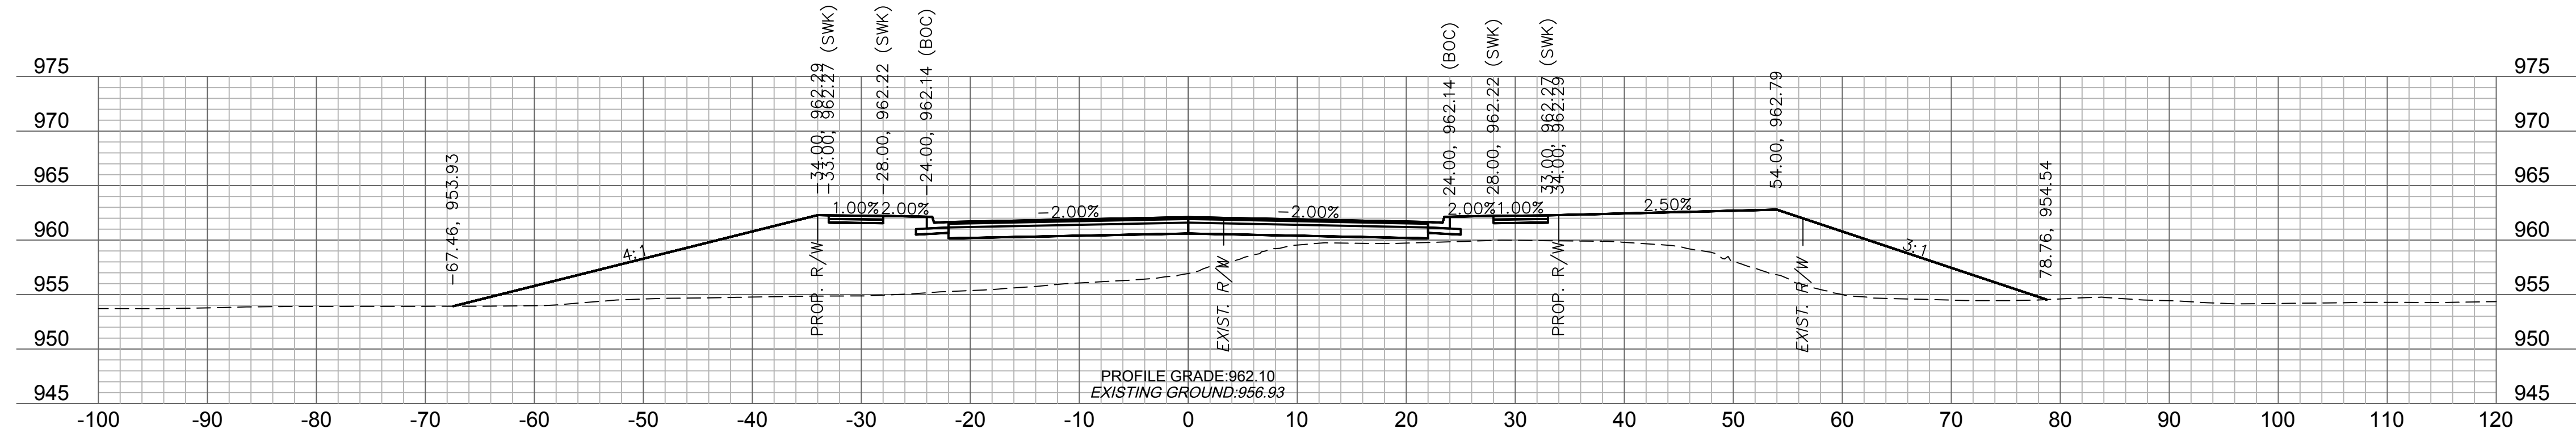



19+50

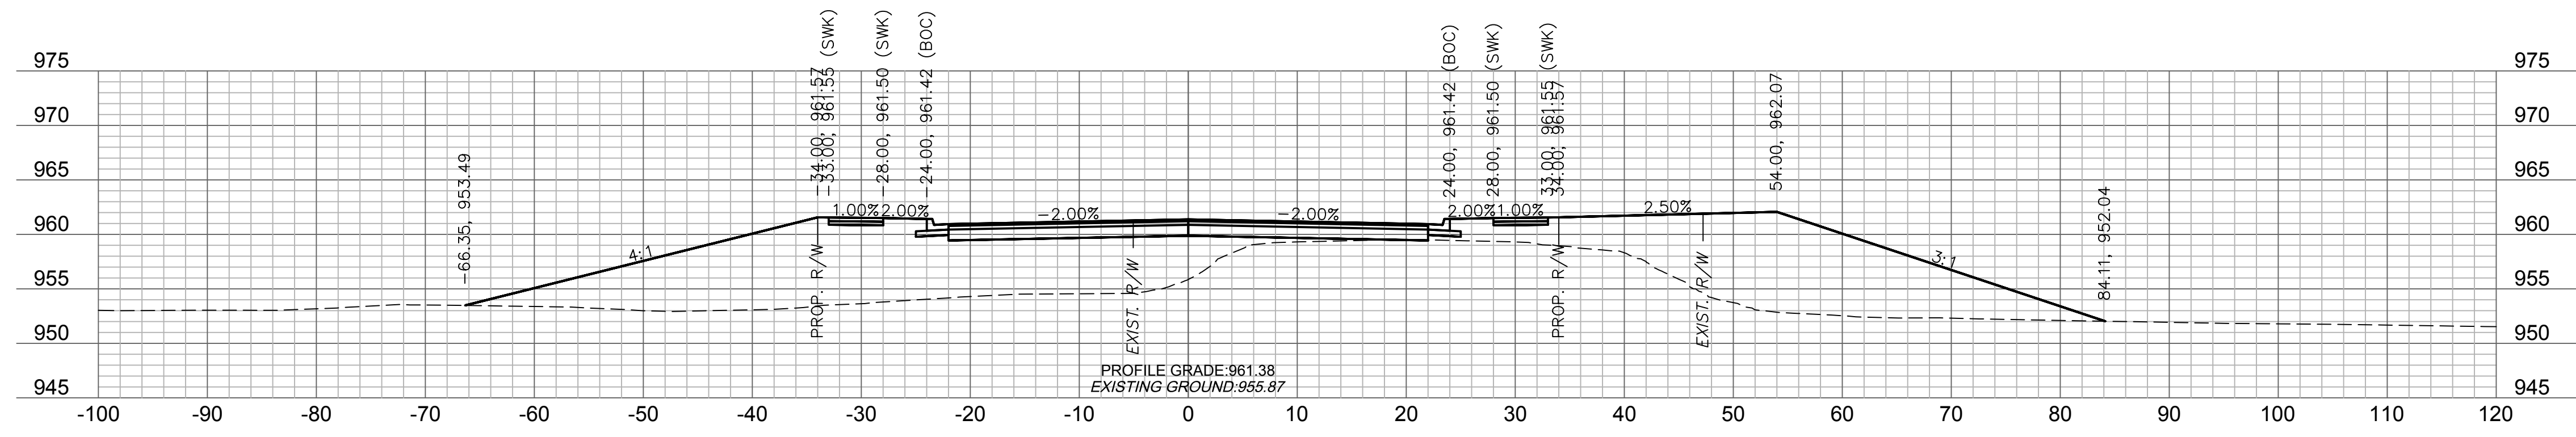

19+25

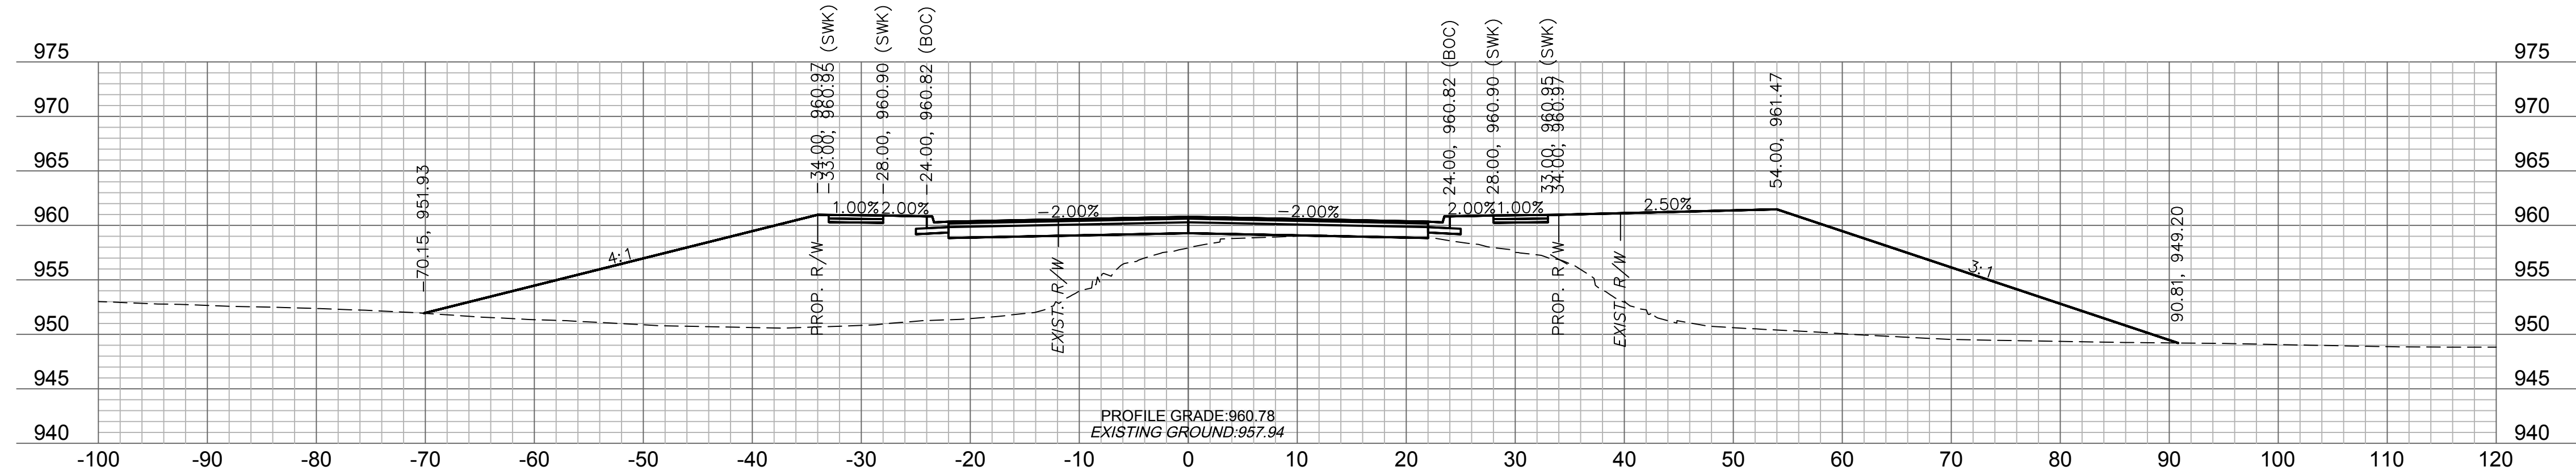

19+00

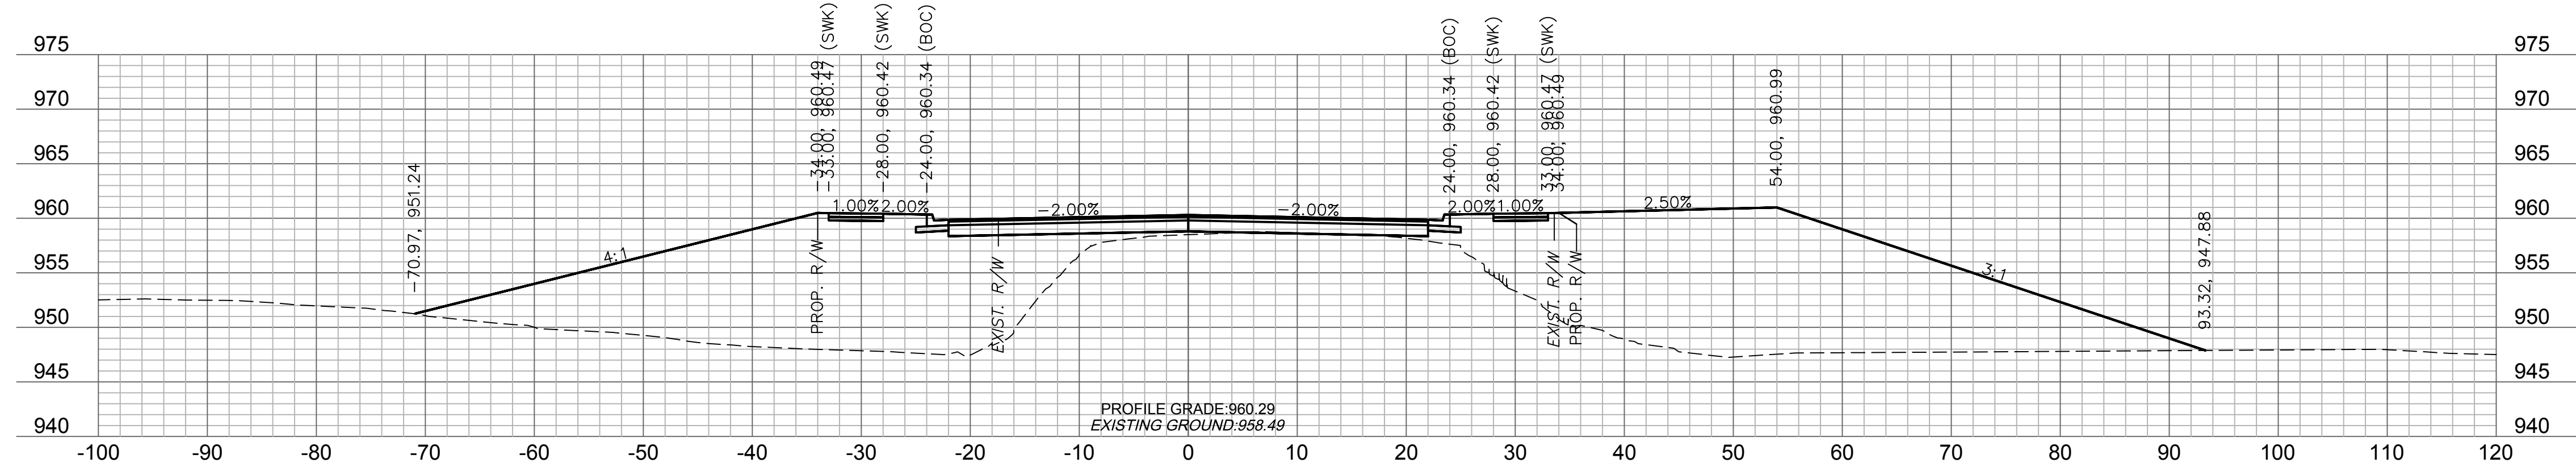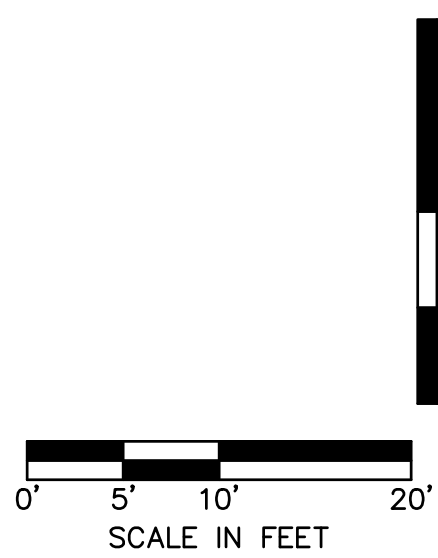 $18+75$ 

Olsson

Olsson Engineering - MO State Certificate of Authority #001592
7301 West 133rd Street, Suite 200 TEL 913.381.1170
Overland Park, KS 66213-4750 FAX 913.381.1174 www.olsson.com

RECORD
DRAWINGS

RYAN B. FLEMING
MO. NO. PE-2002003161

[illegible]

MAIN STREET CROSS SECTIONS


SCANNELL DEVELOPMENT LEE'S SUMMIT LOGISTICS
NORTHWEST CORNER OF TUDOR ROAD AND MAIN STREET

LEE'S SUMMIT, MISSOURI


C.O.A. NO.: _____ -
DRAWN BY: _____ ARJ/AMW
CHECKED BY: _____ XXX
APPROVED BY: _____ RBF
QA/QC BY: _____ RBF
PROJECT NO.: _____ 021-04157
DWG NO.: T_XSC01_02104157
DATE: _____ 2021-10-12

SHEET
83 OF 105


USER: asaavedra

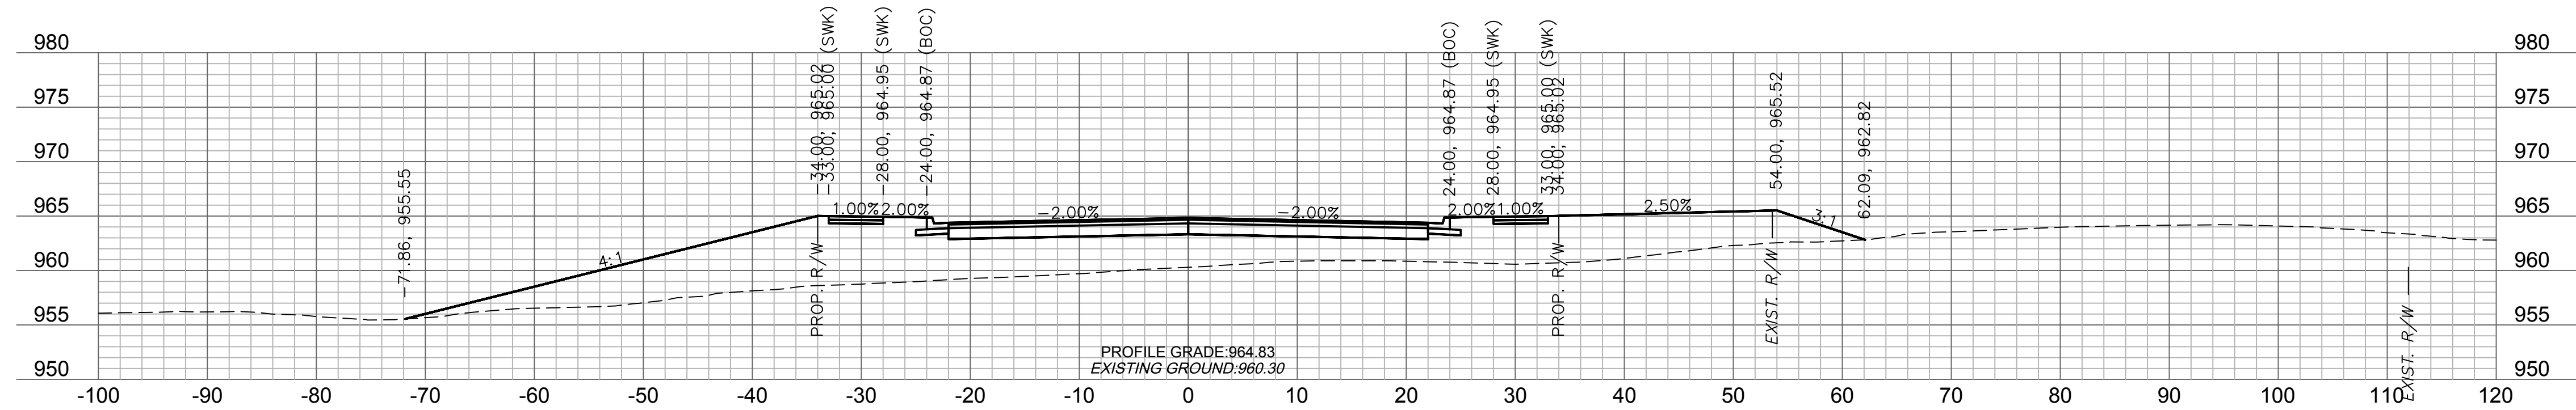


20+50

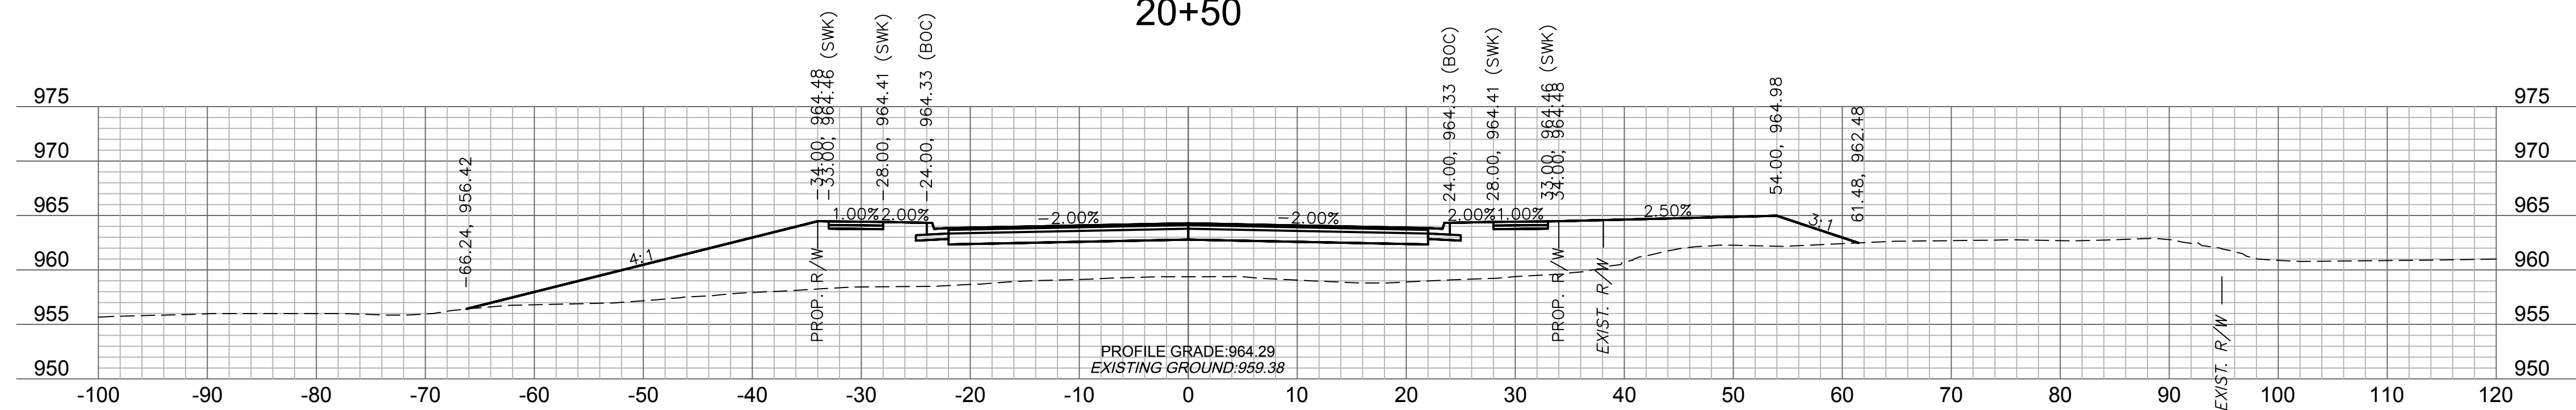


20+25

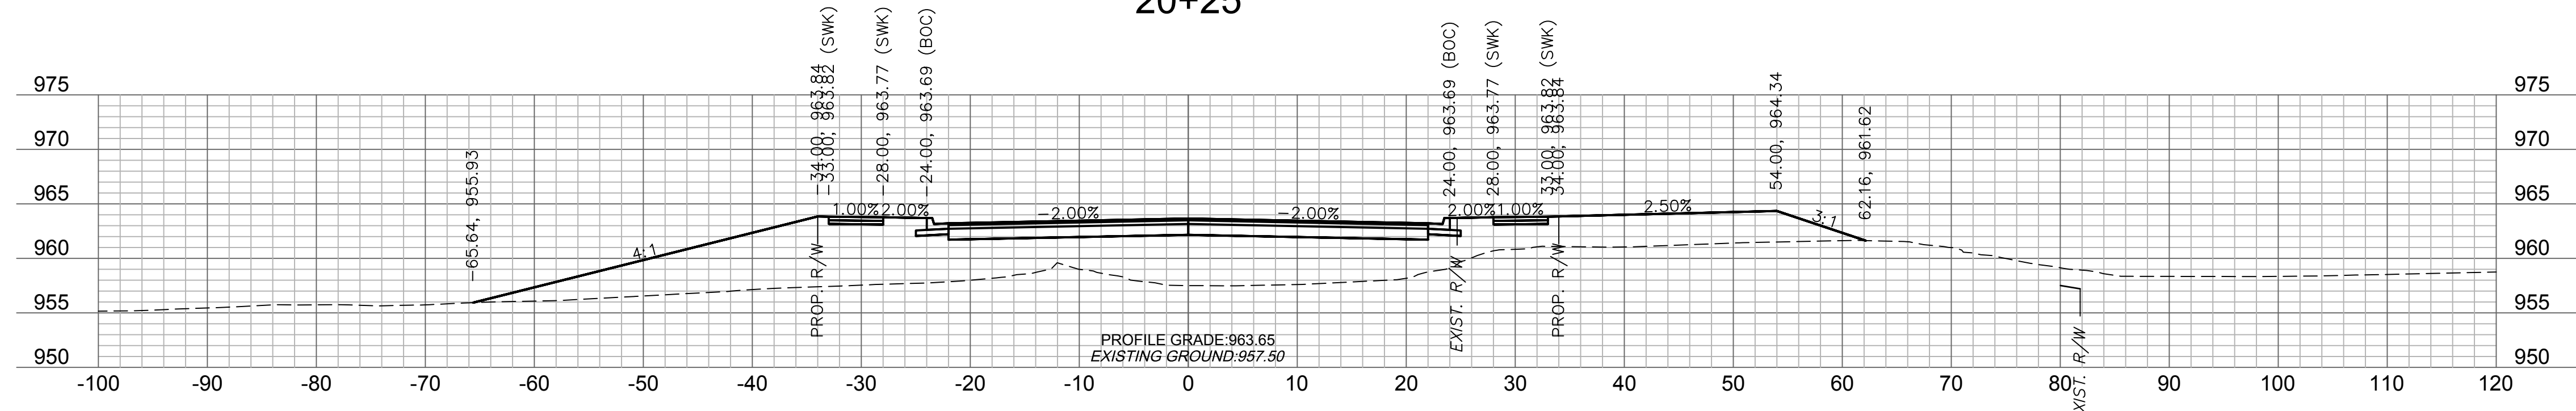

20+00

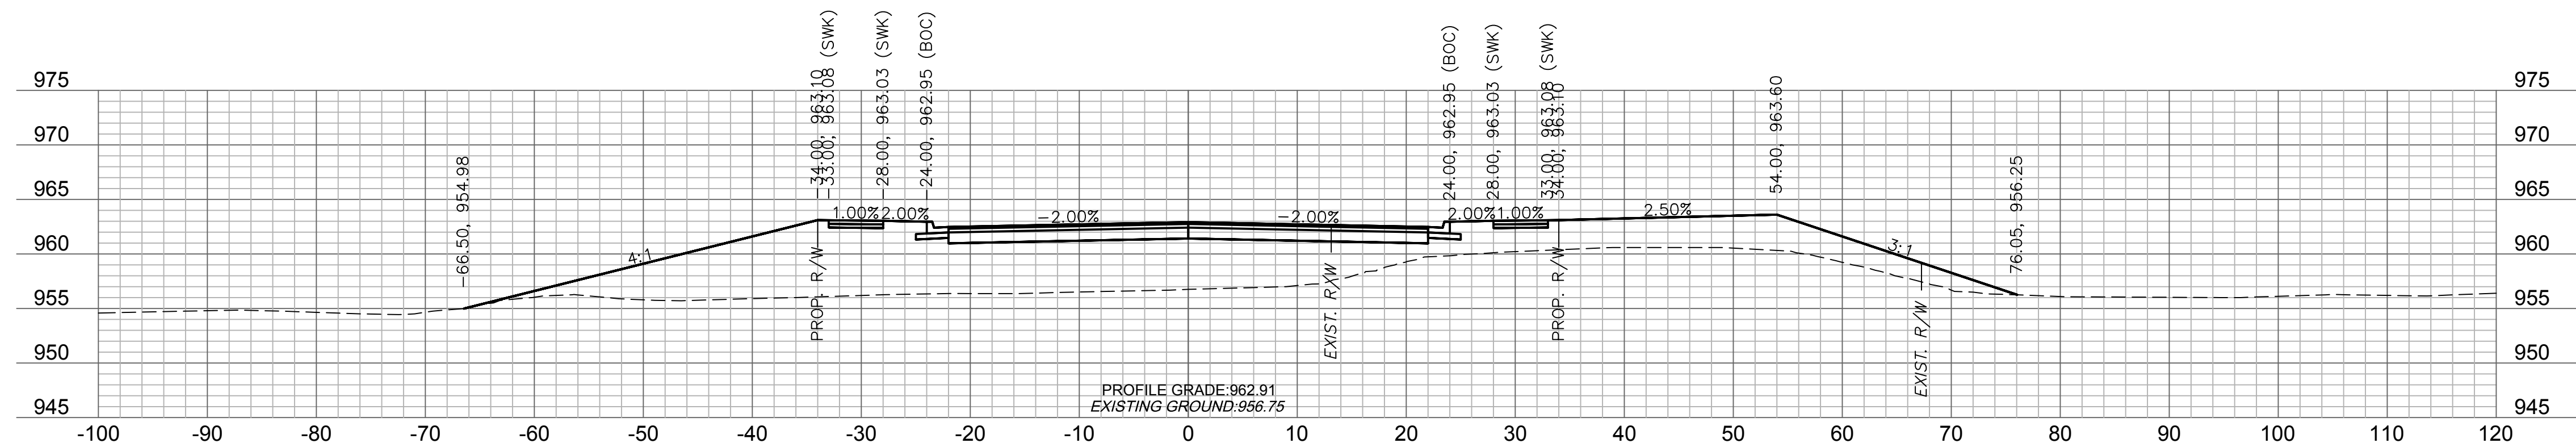

19+75

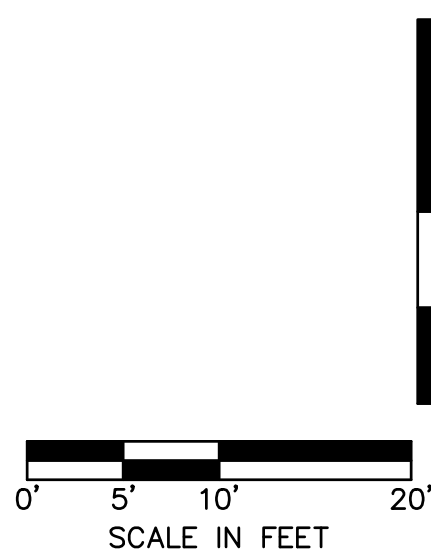

olson

Olsson Engineering - MO State Certificate of Authority #001592
7301 West 133rd Street, Suite 200 TEL 913.381.1170
Overland Park, KS 66213-4750 FAX 913.381.1174 www.olsson.com

RECORD
DRAWINGS

RYAN B. FLEMING
MO. NO. PE-2002003161

[illegible]

MAIN STREET CROSS SECTIONS


SCANNELL DEVELOPMENT LEE'S SUMMIT LOGISTICS
NORTHWEST CORNER OF TUDOR ROAD AND MAIN STREET

LEE'S SUMMIT, MISSOURI


C.O.A. NO.: _____
DRAWN BY: _____ ARJ/AMW
CHECKED BY: _____ XXX
APPROVED BY: _____ RBF
QA/QC BY: _____ RBF
PROJECT NO.: _____ 021-04157
DWG NO.: T_XSC01 02104157
DATE: _____ 2021-10-12

SHEET
84 OF 105


DWG: F:\2021\04001-04500\021-04157\40-Design\AutoCAD\Final Plans\Sheets\ROBR\T_XSC01_02104157.dwg
XREFS: T_PBASE 02104157
T_PTBLK 02104157
DATE: Oct 30, 2023 3:58pm

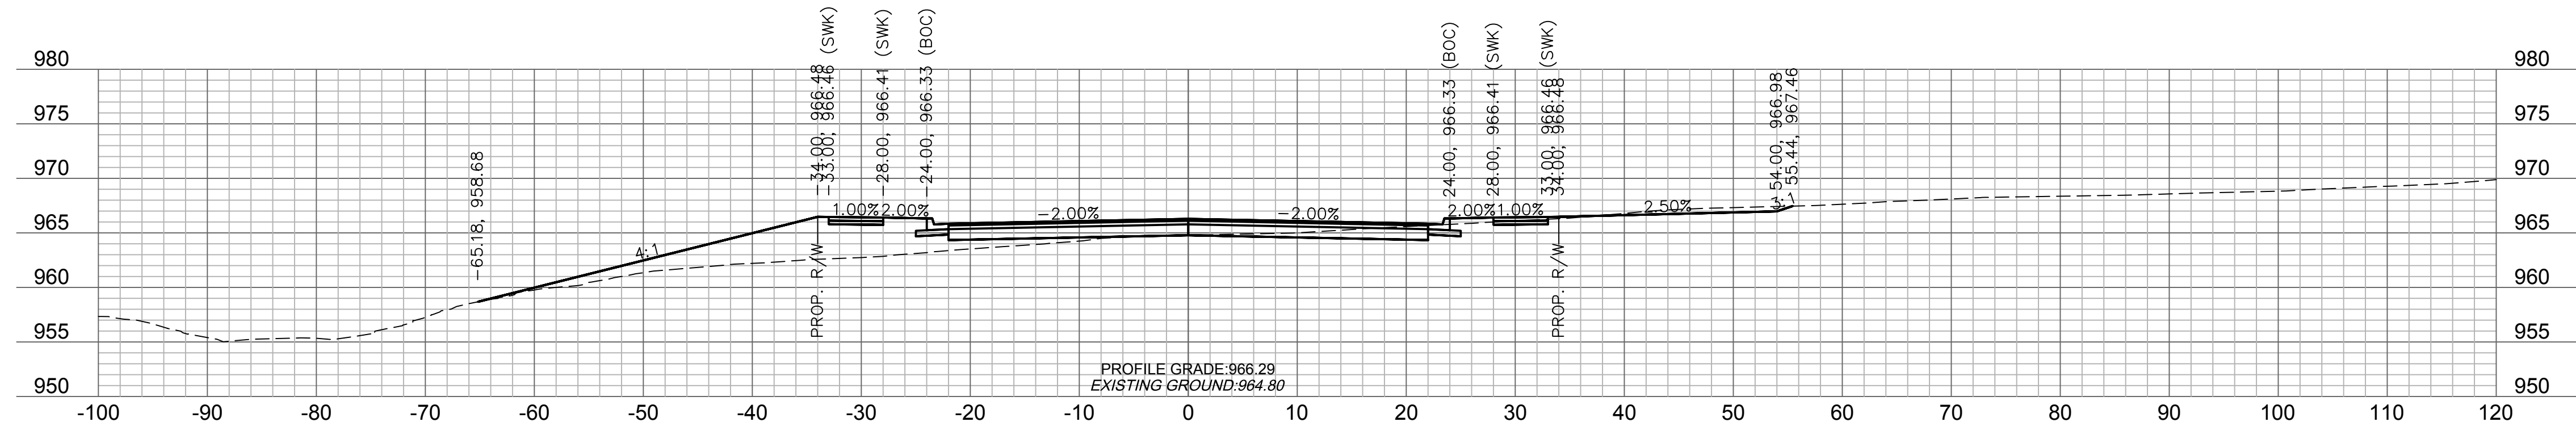


21+50

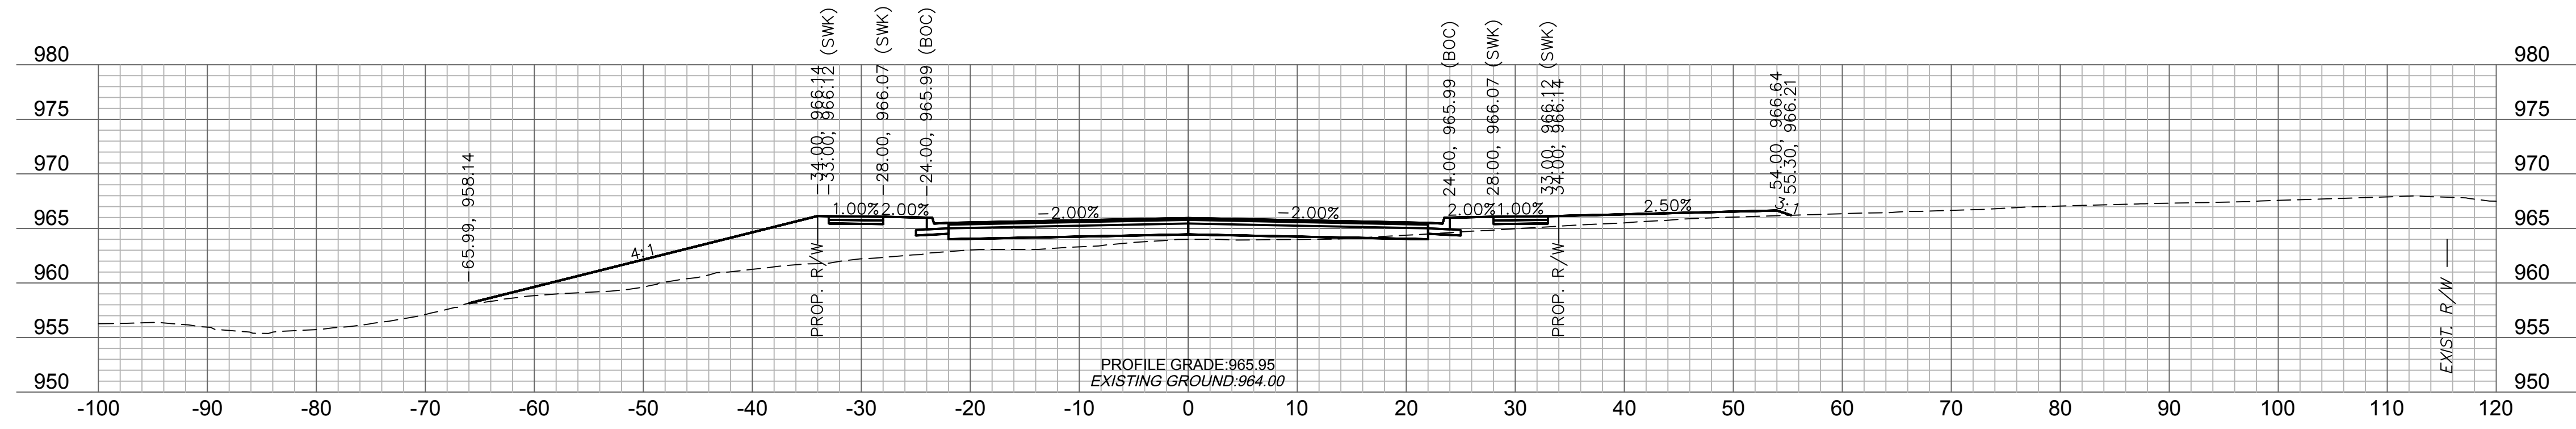


21+25

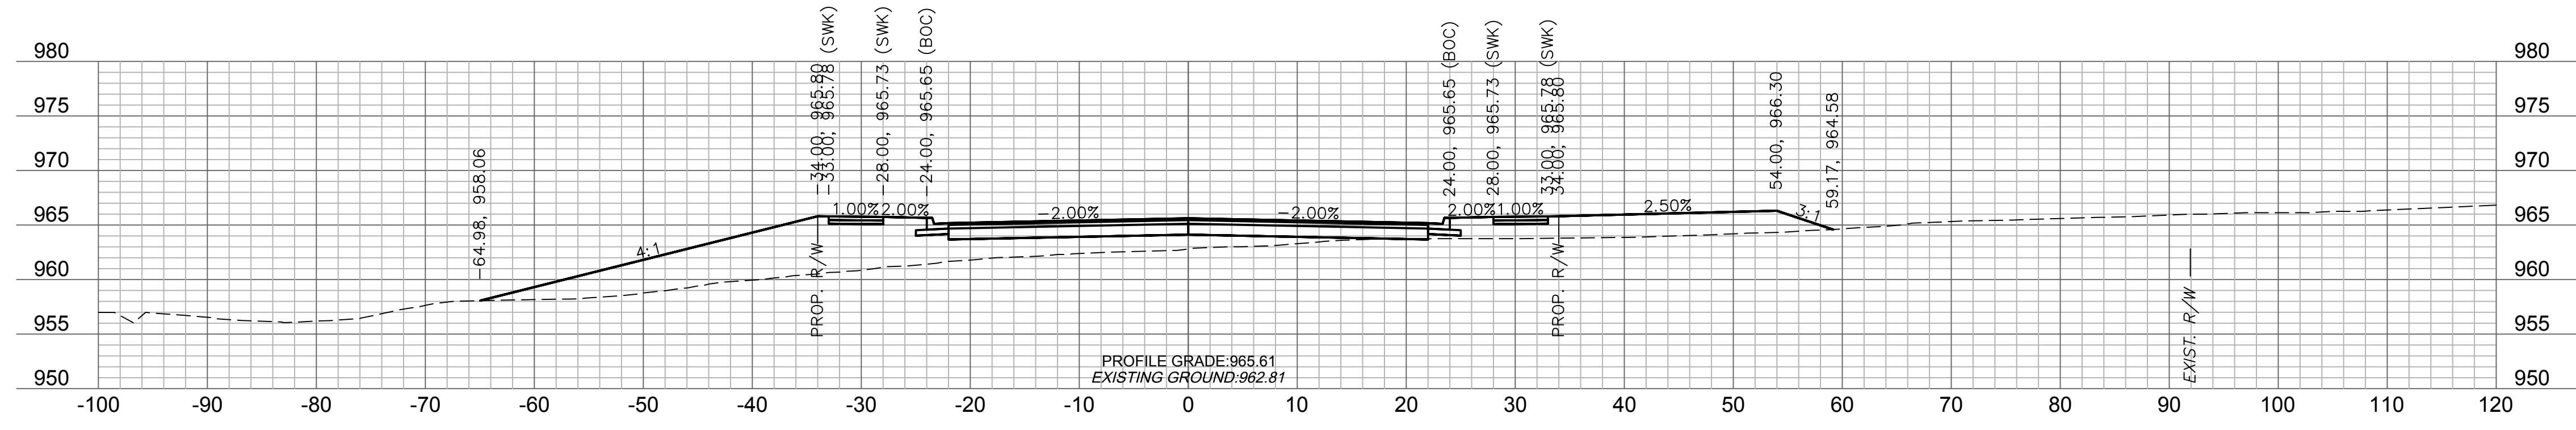

21+00

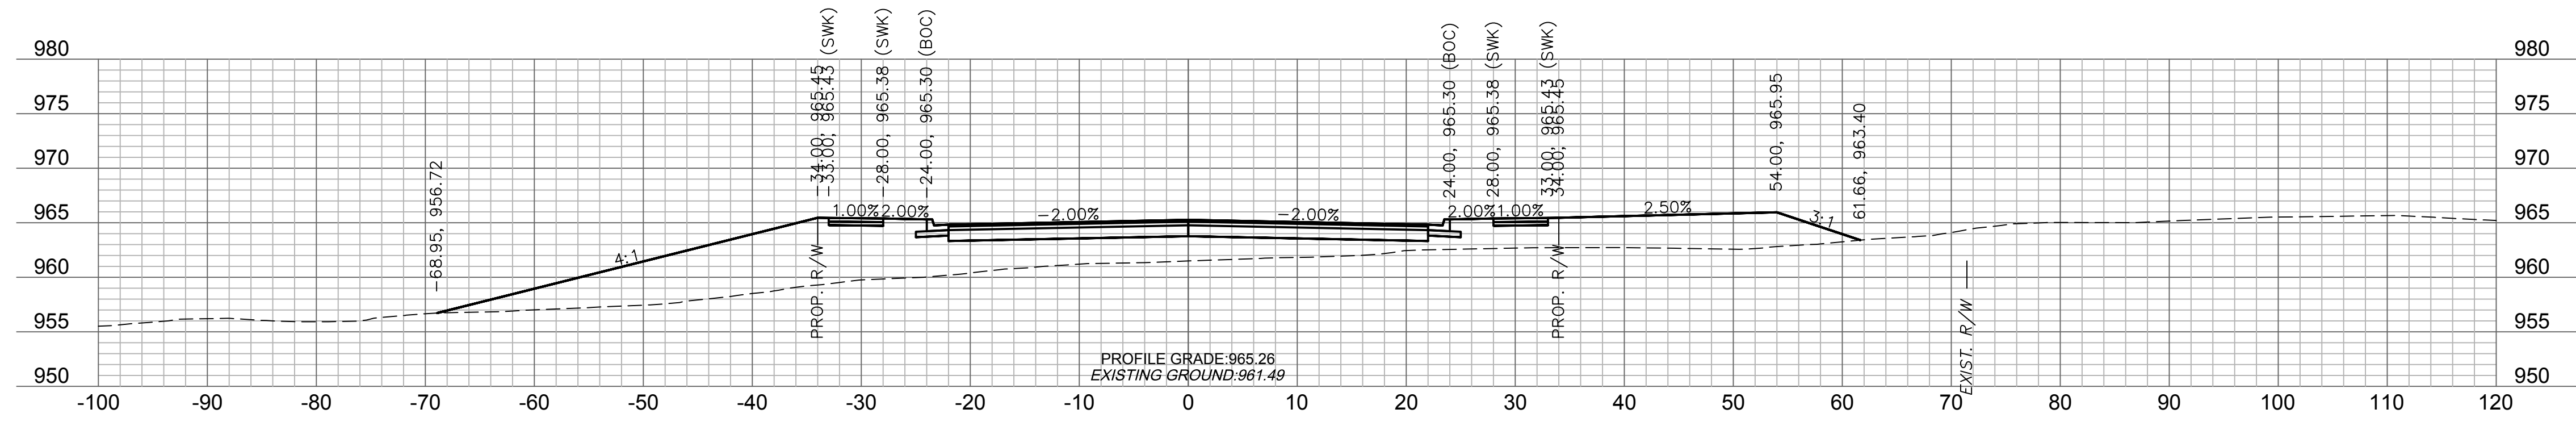

20+75

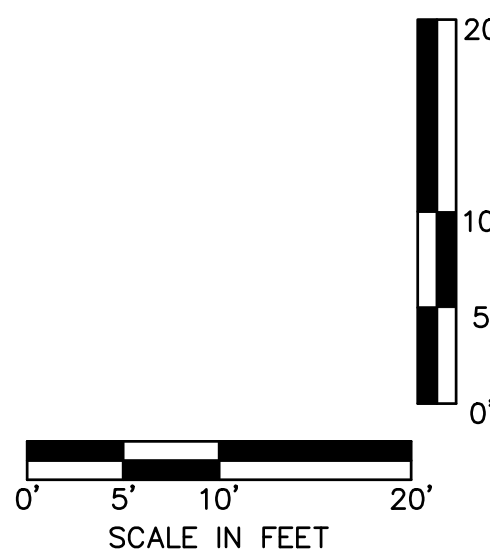

olson

Olsson Engineering - MO State Certificate of Authority #001592
7301 West 133rd Street, Suite 200 TEL 913.381.1170
Overland Park, KS 66213-4750 FAX 913.381.1174 www.olsson.com

RECORD
DRAWINGS

RYAN B. FLEMING
MO. NO. PE-2002003161

[illegible]


MAIN STREET CROSS SECTIONS

SCANNELL DEVELOPMENT LEE'S SUMMIT LOGISTICS
NORTHWEST CORNER OF TUDOR ROAD AND MAIN STREET


LEE'S SUMMIT, MISSOURI

C.O.A. NO.: _____ -
DRAWN BY: _____ ARJ/AMW
CHECKED BY: _____ XXX
APPROVED BY: _____ RBF
QA/QC BY: _____ RBF
PROJECT NO.: _____ 021-04157
DWG NO.: T_XSC01_02104157
DATE: _____ 2021-10-12


SHEET
85 OF 105

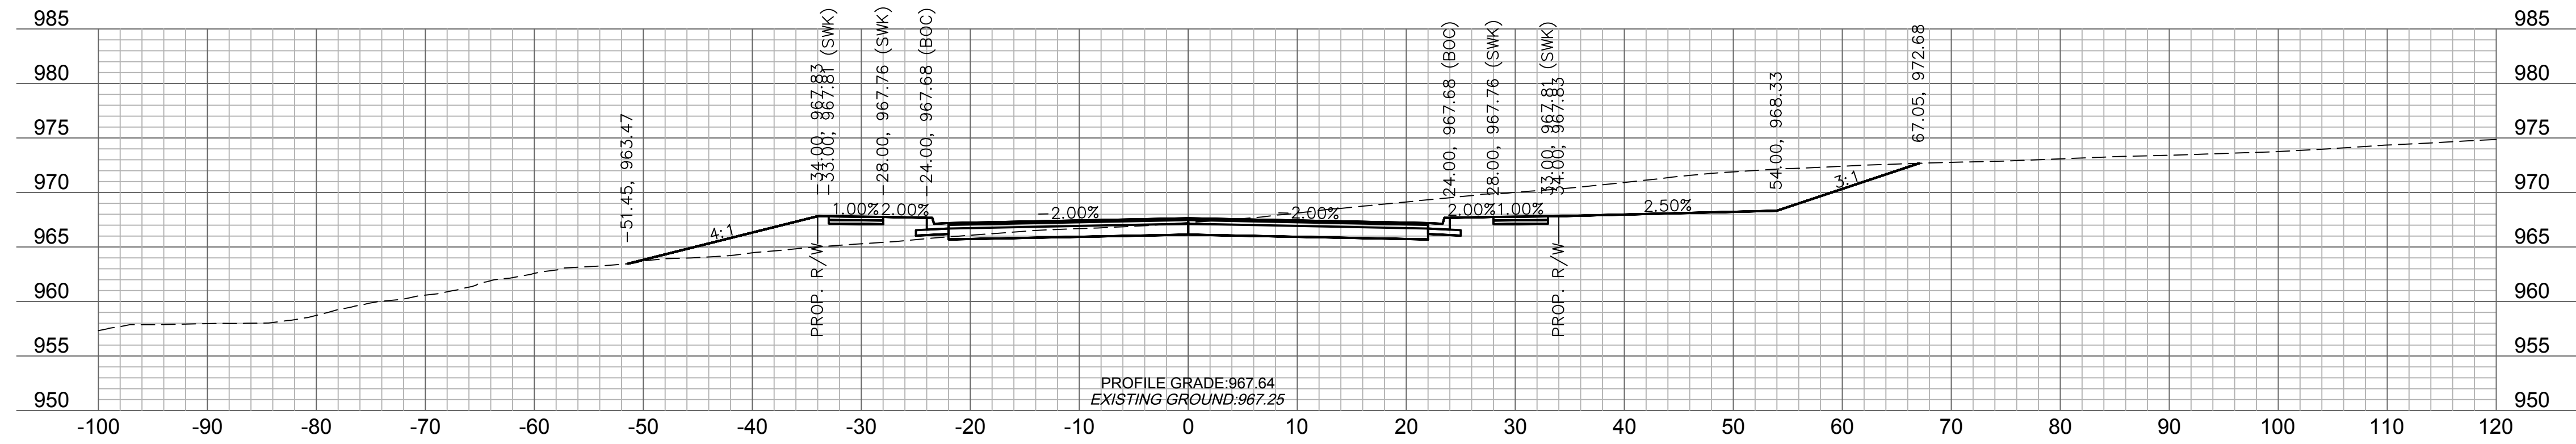


22+50

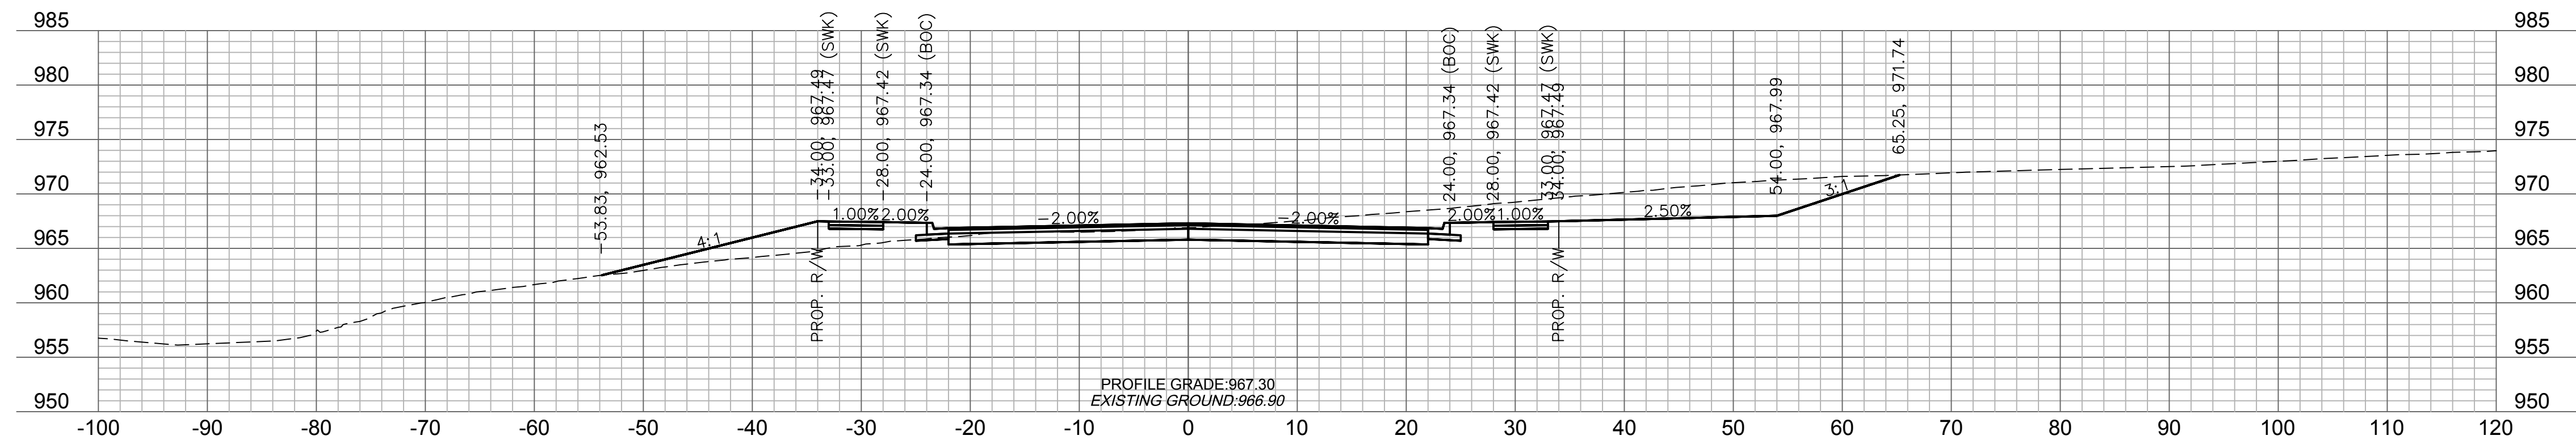

22+25

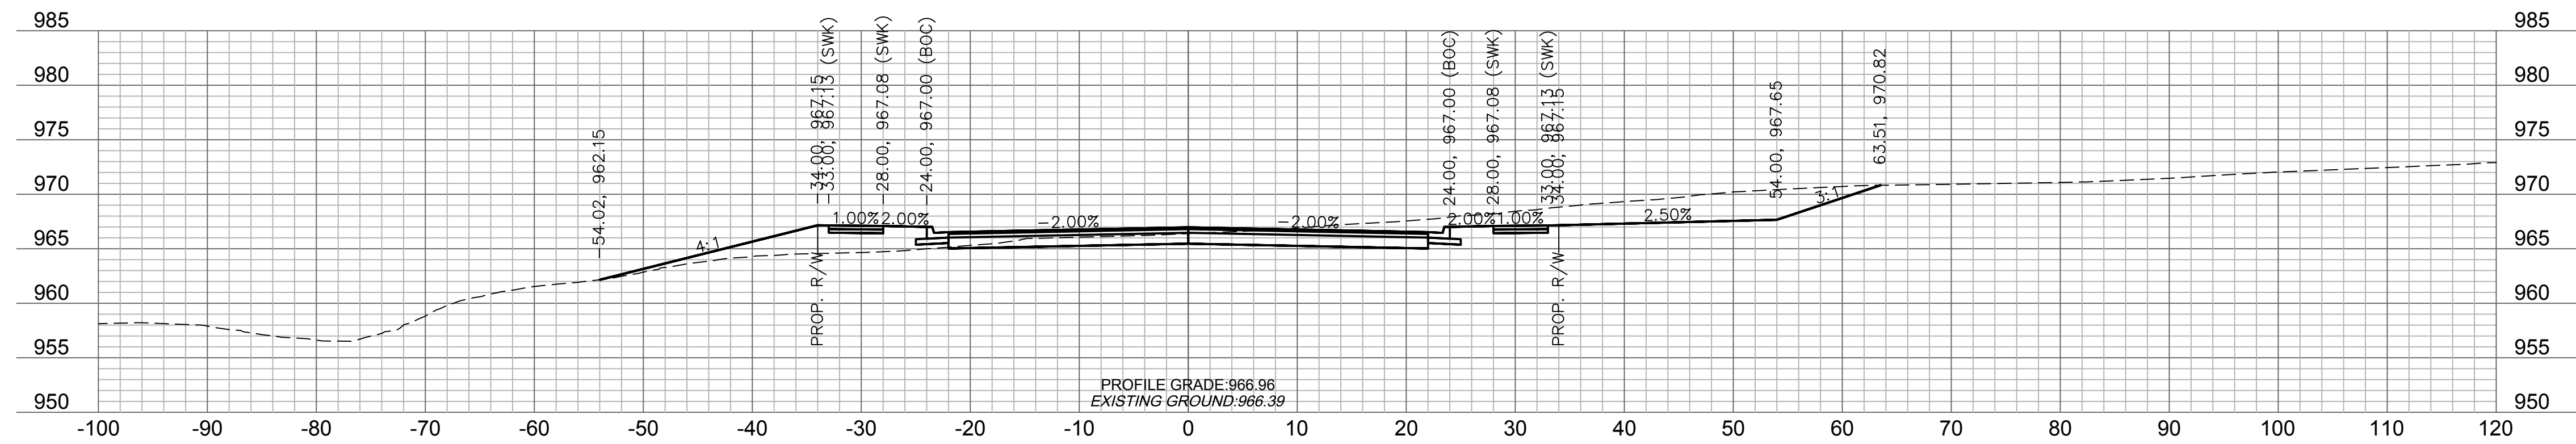

22+00

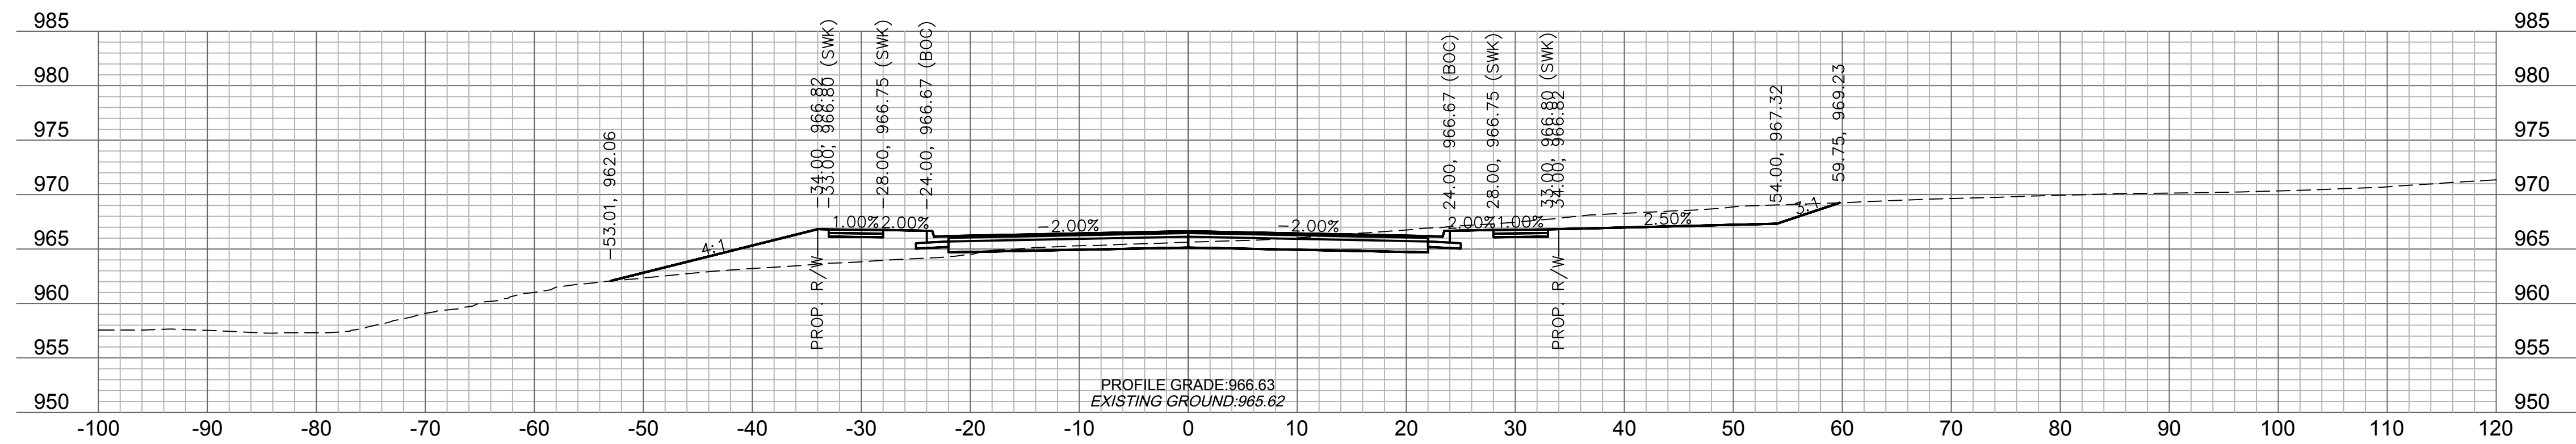

21+75



olson

Olsson Engineering - MO State Certificate of Authority #001592
7301 West 133rd Street, Suite 200 TEL 913.381.1170
Overland Park, KS 66213-4750 FAX 913.381.1174 www.olsson.com

RECORD
DRAWINGS

RYAN B. FLEMING
MO. NO. PE-2002003161

[illegible]

MAIN STREET
CROSS SECTIONS

SCANNELL DEVELOPMENT LEE'S SUMMIT LOGISTICS
NORTHWEST CORNER OF TUDOR ROAD AND MAIN STREET





LEE'S SUMMIT, MISSOURI

2021

C.O.A. NO.: _____ -
DRAWN BY: _____ ARJ/AMW
CHECKED BY: _____ XXX
APPROVED BY: _____ RBF
QA/QC BY: _____ RBF
PROJECT NO.: _____ 021-04157
DWG NO.: T_XSC01_02104157
DATE: _____ 2021-10-12

SHEET
86 OF 105

DWG: F:\2021\04001-04500\021-04157\40-Desian\AutoCAD\Final Plans\Sheets\ROBR\T_XSC01_02104157.dwg
XREFS: T_PTBLK_02104157
T_PBASE_02104157
DATE: Oct 30, 2023 3:58pm

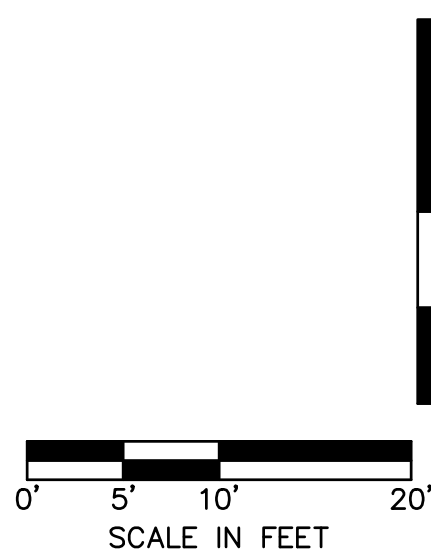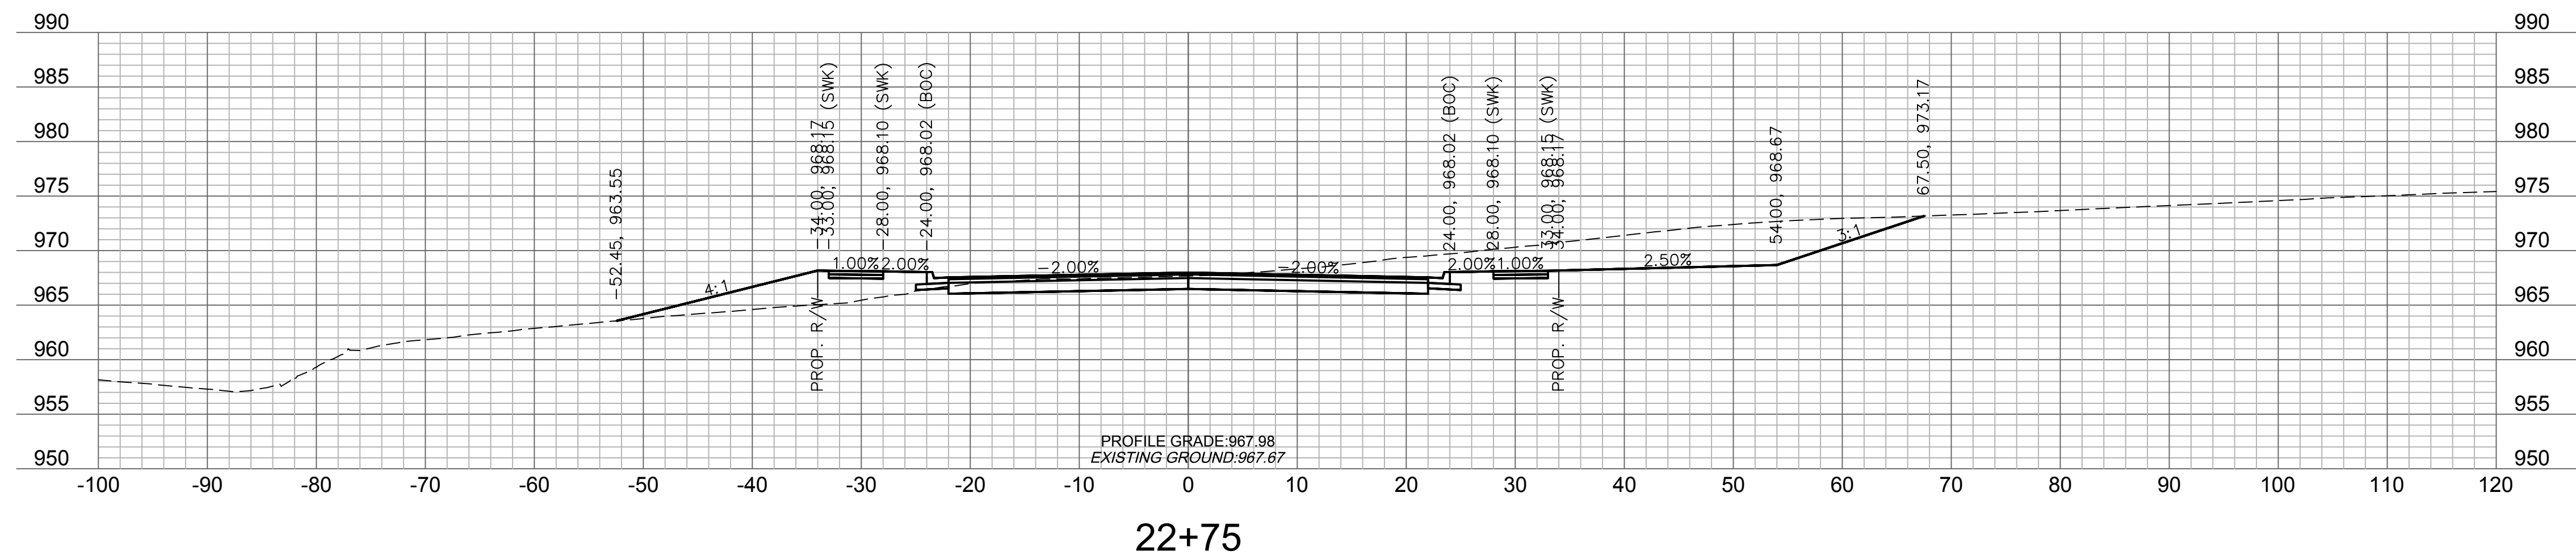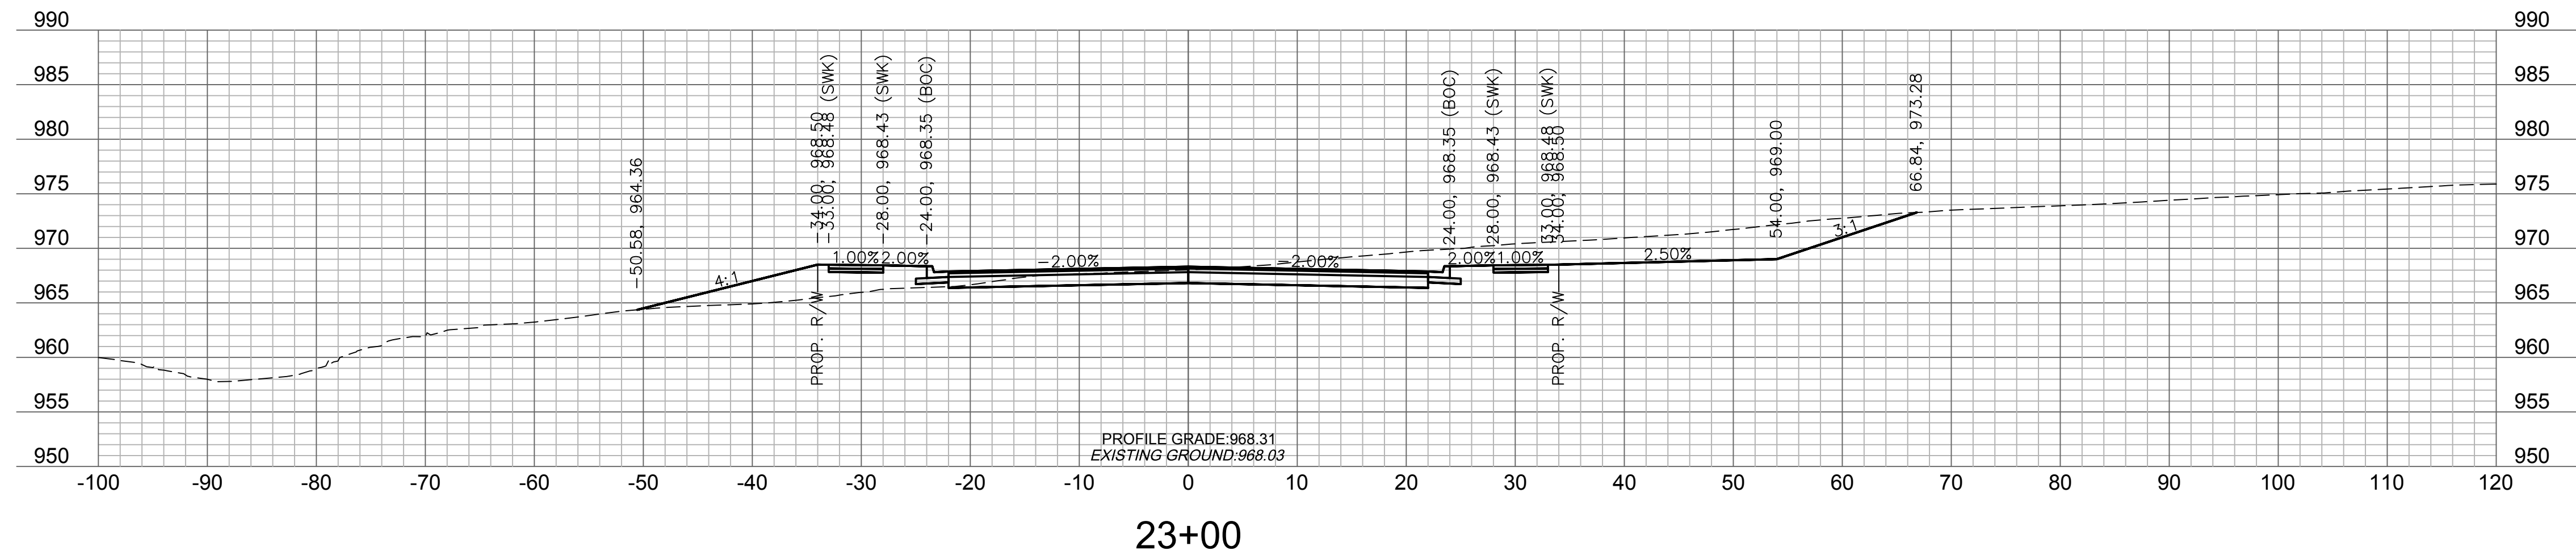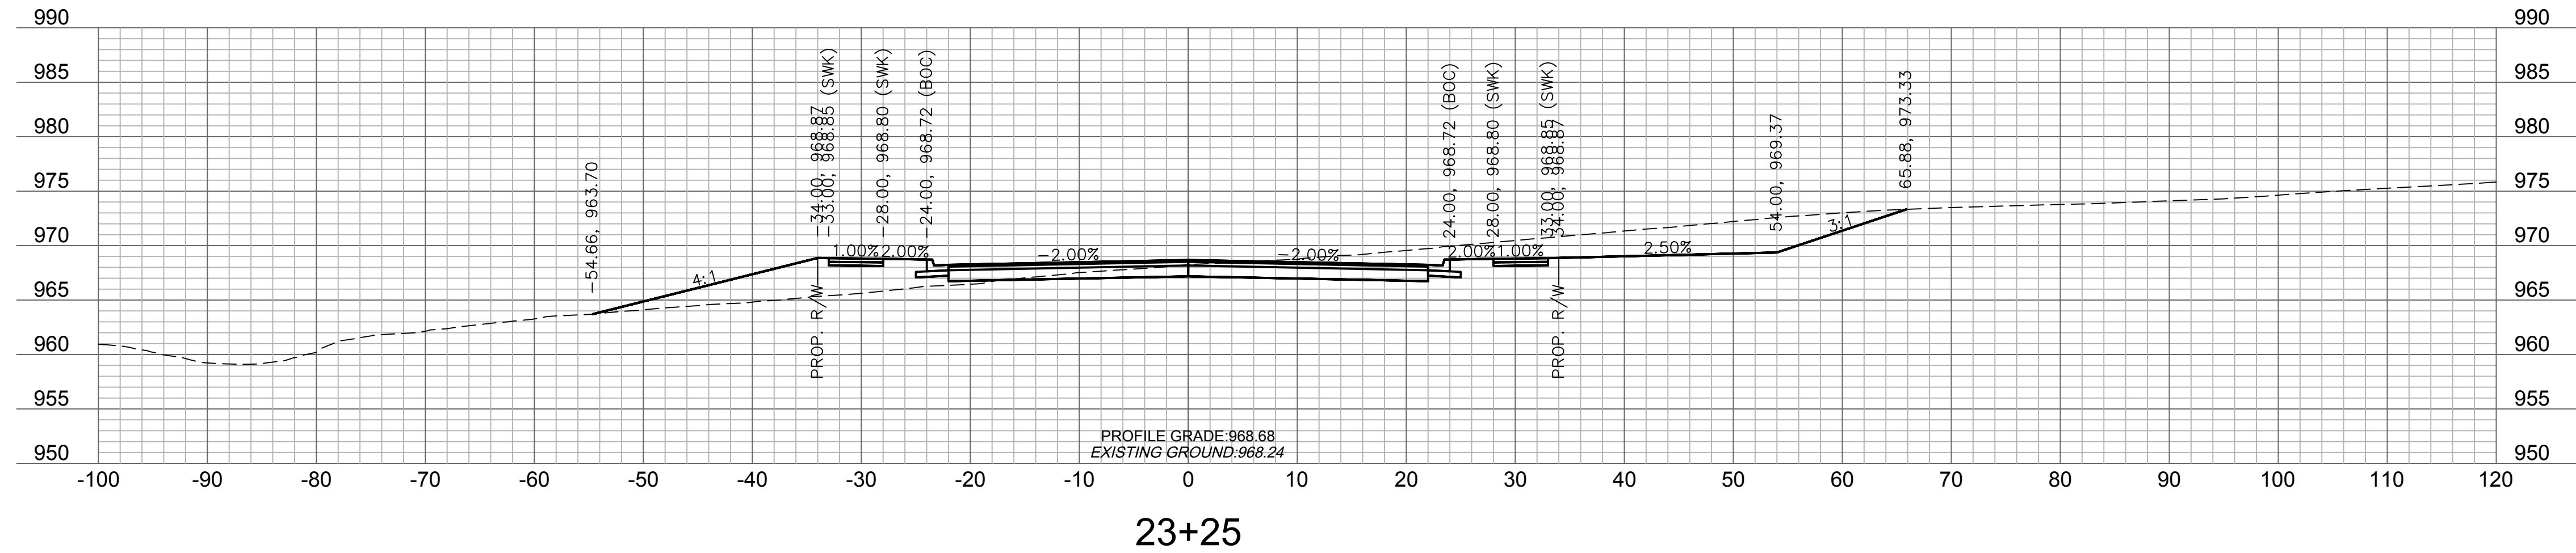

olson

Olsson Engineering - MO State Certificate of Authority #001592
7301 West 133rd Street, Suite 200 TEL 913.381.1170
Overland Park, KS 66213-4750 FAX 913.381.1174 www.olsson.com

RECORD
DRAWINGS

RYAN B. FLEMING
MO. NO. PE-2002003161

[illegible]

MAIN STREET CROSS SECTIONS


SCANNELL DEVELOPMENT LEE'S SUMMIT LOGISTICS
NORTHWEST CORNER OF TUDOR ROAD AND MAIN STREET

LEE'S SUMMIT, MISSOURI


C.O.A. NO.: _____ -
DRAWN BY: _____ ARJ/AMW
CHECKED BY: _____ XXX
APPROVED BY: _____ RBF
QA/QC BY: _____ RBF
PROJECT NO.: _____ 021-04157
DWG NO.: T_XSC01_02104157
DATE: _____ 2021-10-12

SHEET
87 OF 105


4157\40-Design\AutoCAD\Final Plans\Sheets\RDBR\T_XSC01_02104157.dwg
XREFS: T_PTBLK_02104157 T_PBASE_02104157

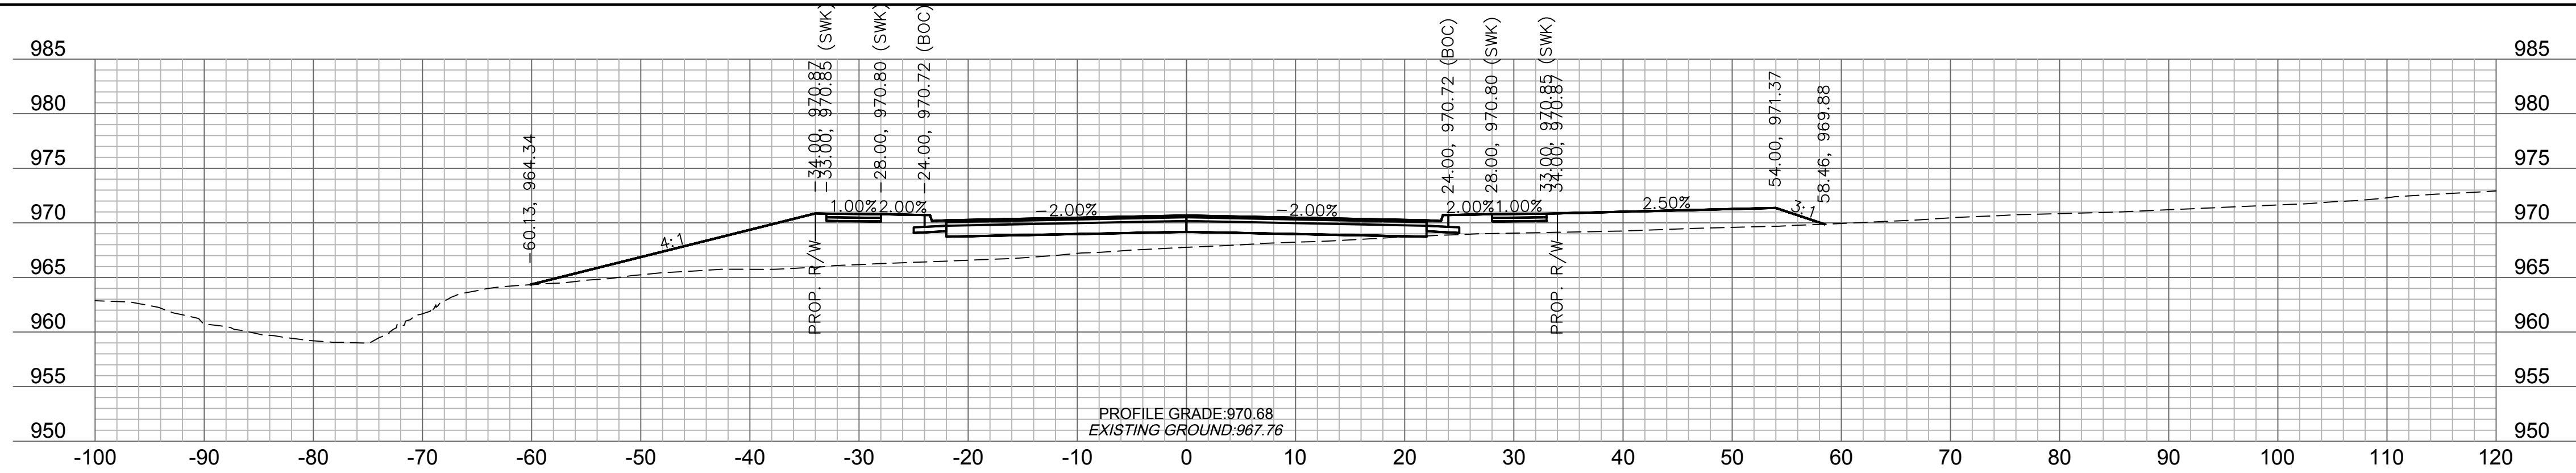


24+25

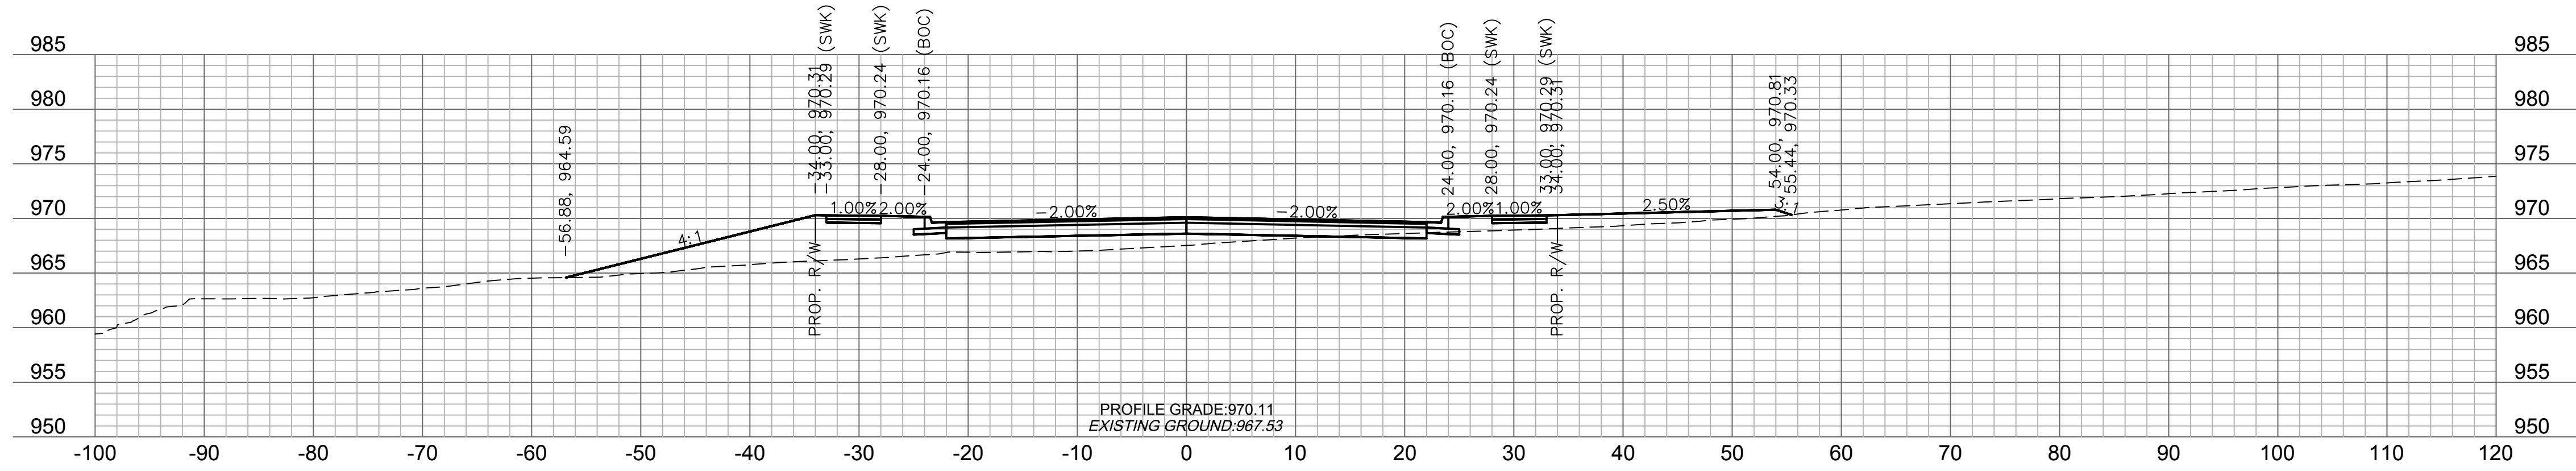

24+00

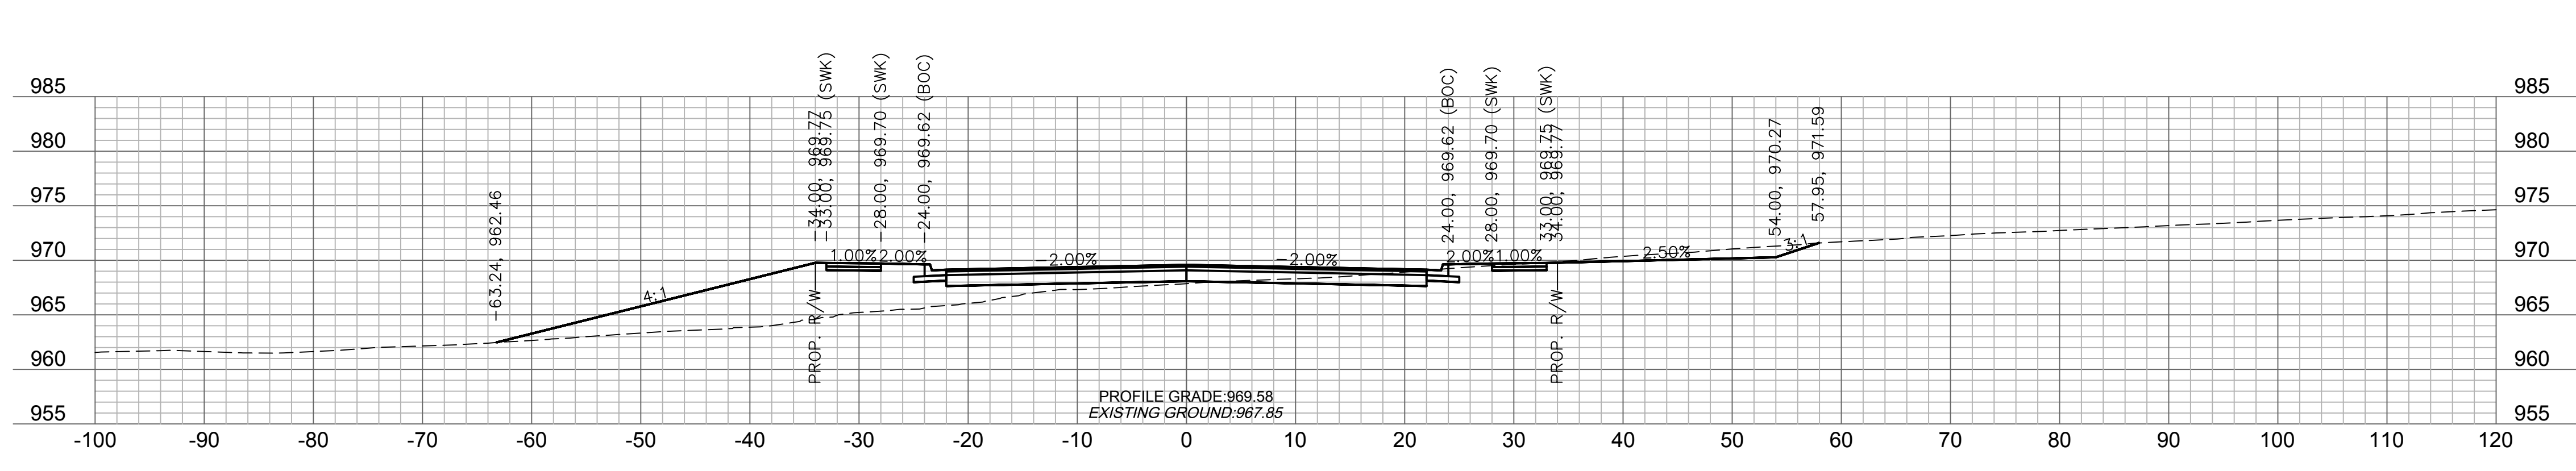

23+75

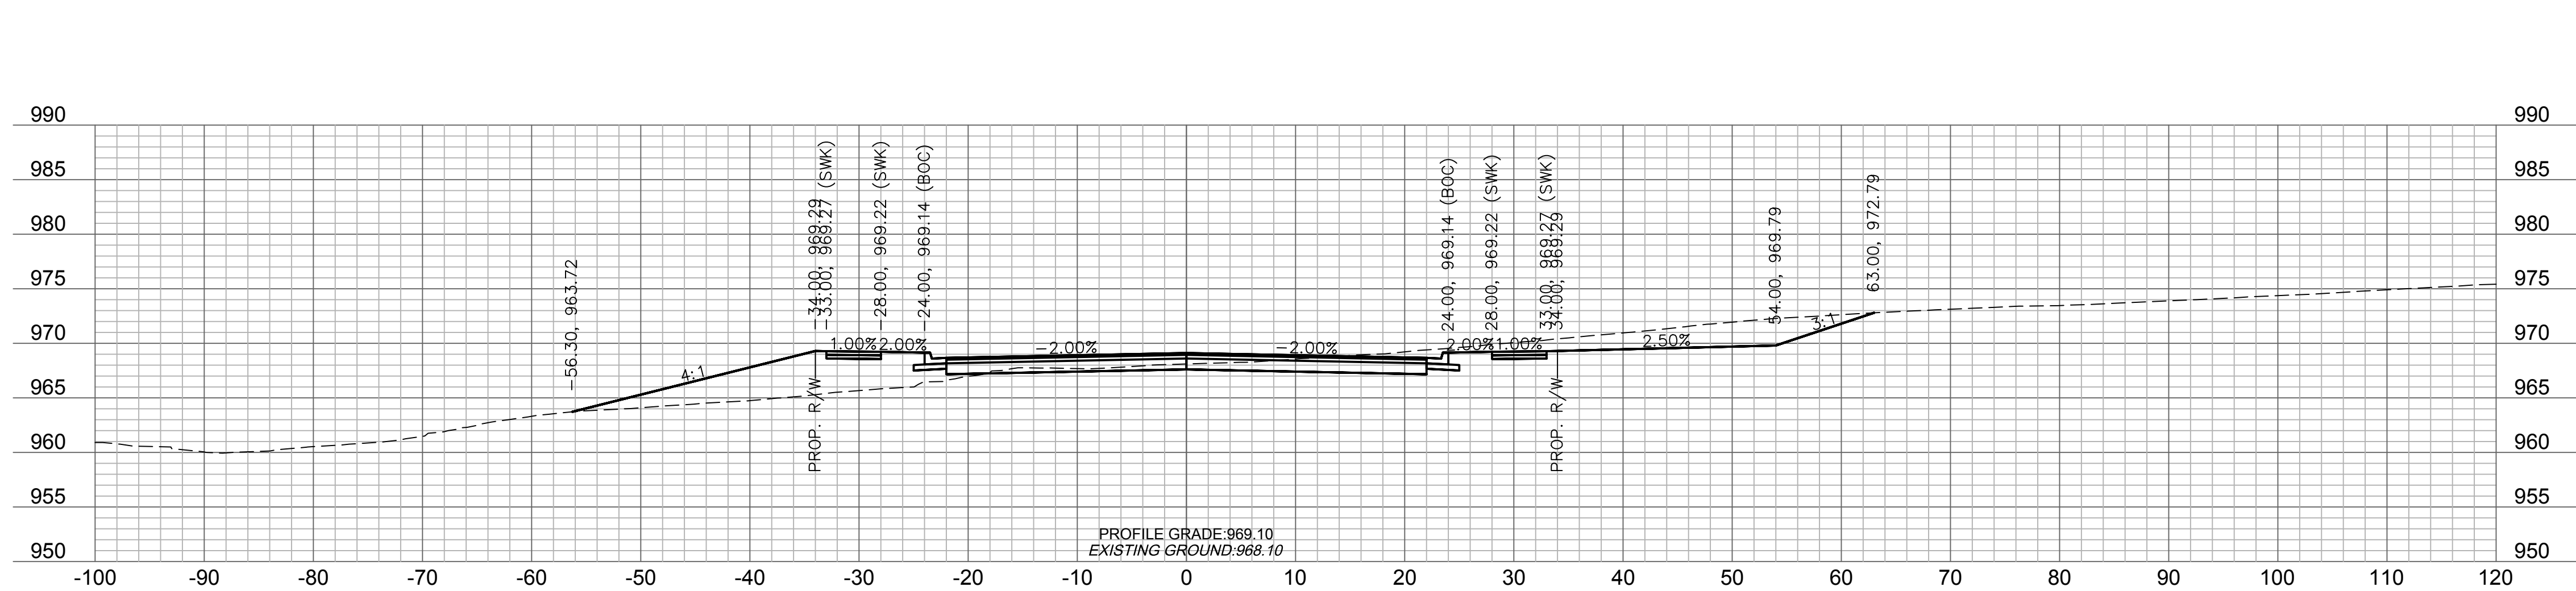 $23+50$ 

olson

Olsson Engineering - MO State Certificate of Authority #001592
7301 West 133rd Street, Suite 200 TEL 913.381.1170
Overland Park, KS 66213-4750 FAX 913.381.1174 www.olsson.com

RECORD
DRAWINGS

RYAN B. FLEMING
MO. NO. PE-2002003161

[illegible]

MAIN STREET CROSS SECTIONS


SCANNELL DEVELOPMENT LEE'S SUMMIT LOGISTICS
NORTHWEST CORNER OF TUDOR ROAD AND MAIN STREET

LEE'S SUMMIT, MISSOURI	202
------------------------	-----


C.O.A. NO.: _____ -
DRAWN BY: _____ ARJ/AMW
CHECKED BY: _____ XXX
APPROVED BY: _____ RBF
QA/QC BY: _____ RBF
PROJECT NO.: _____ 021-04157
DWG NO.: T_XSC01_02104157
DATE: _____ 2021-10-12

SHEET
88 OF 105


DWG: F:\2021\04001-04500\021-04157\40-Design\AutoCAD\Final Plans\Sheets\ROBR\T_XSC01_02104157.dwg
XREFS: T_PBASE 02104157
T_PTBLK 02104157
DATE: Oct 30, 2023 3:58pm

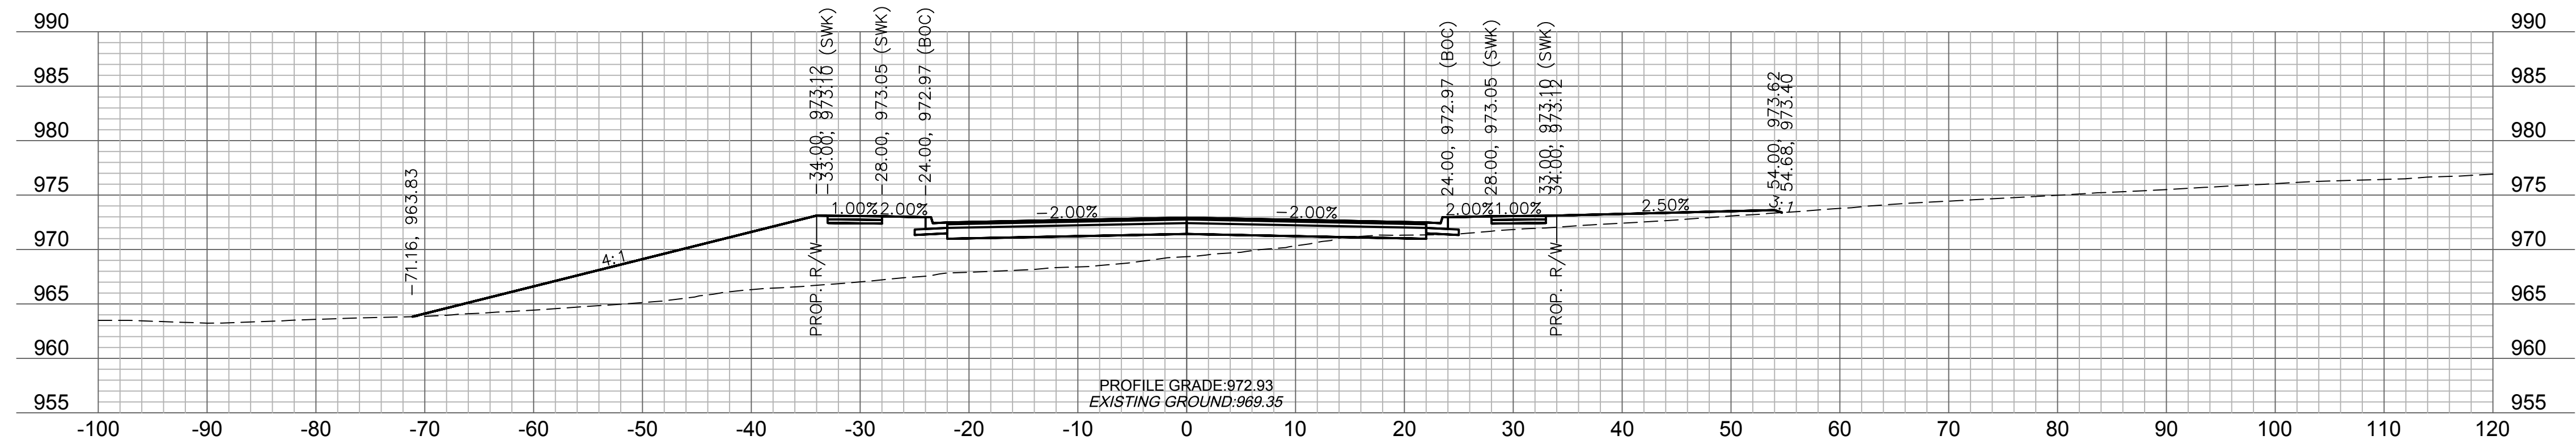


25+25

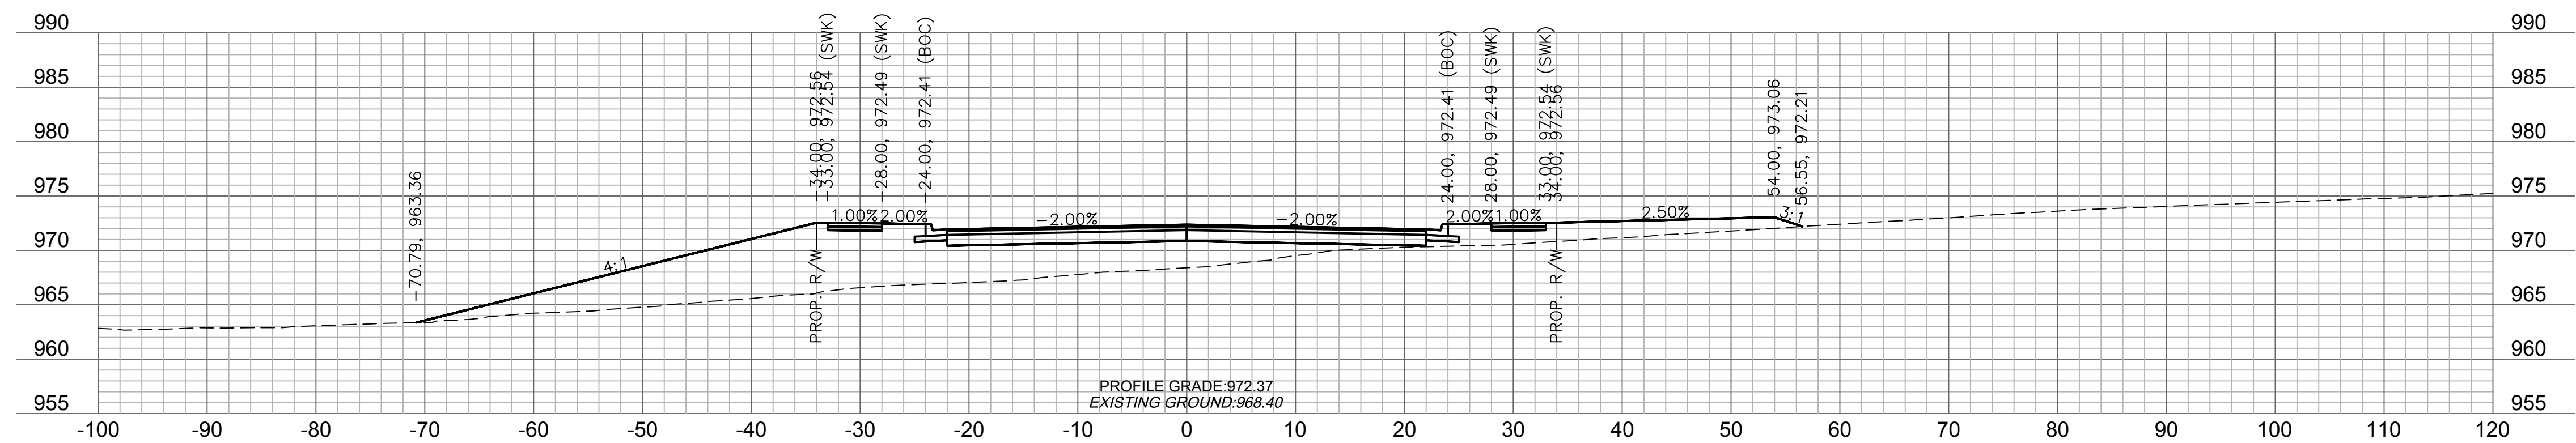

25+00

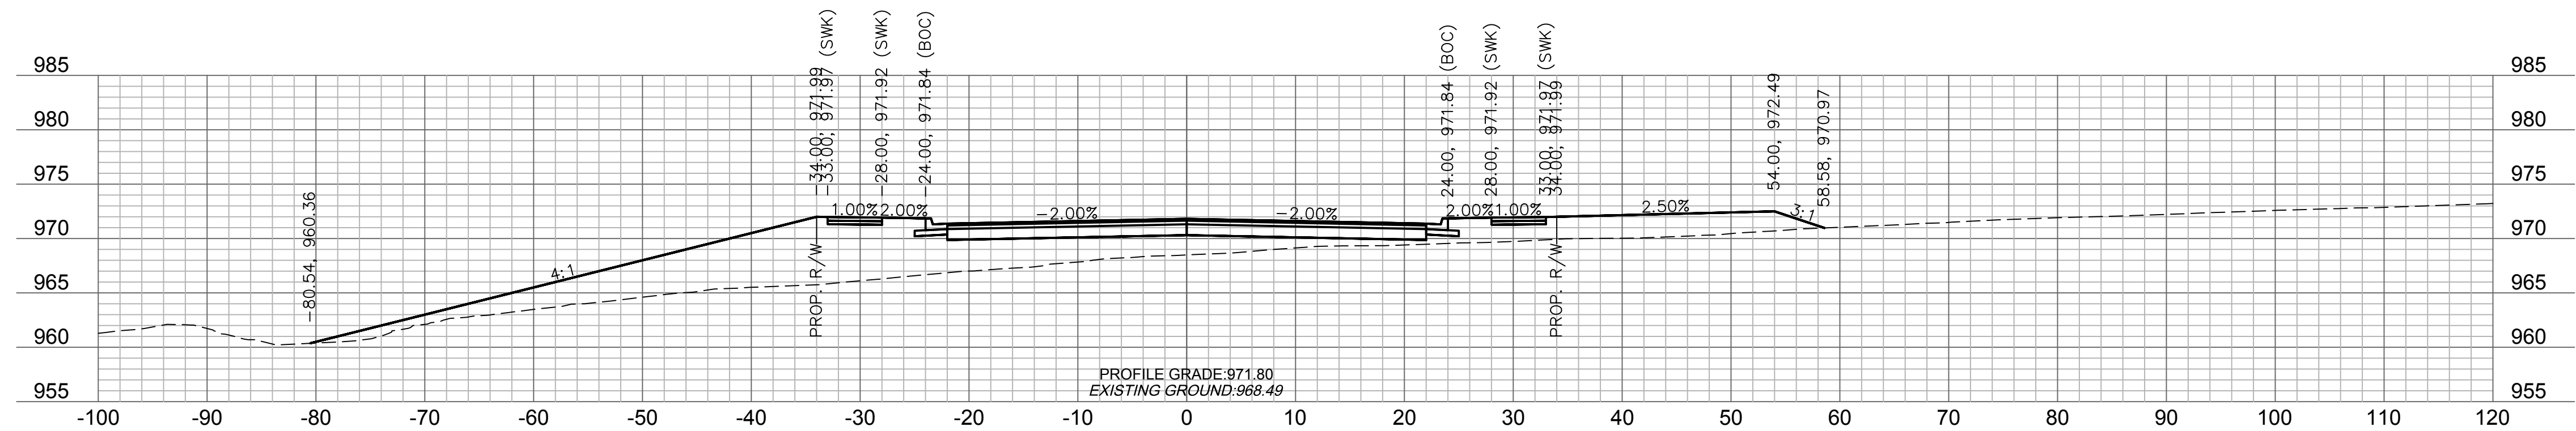

24+75

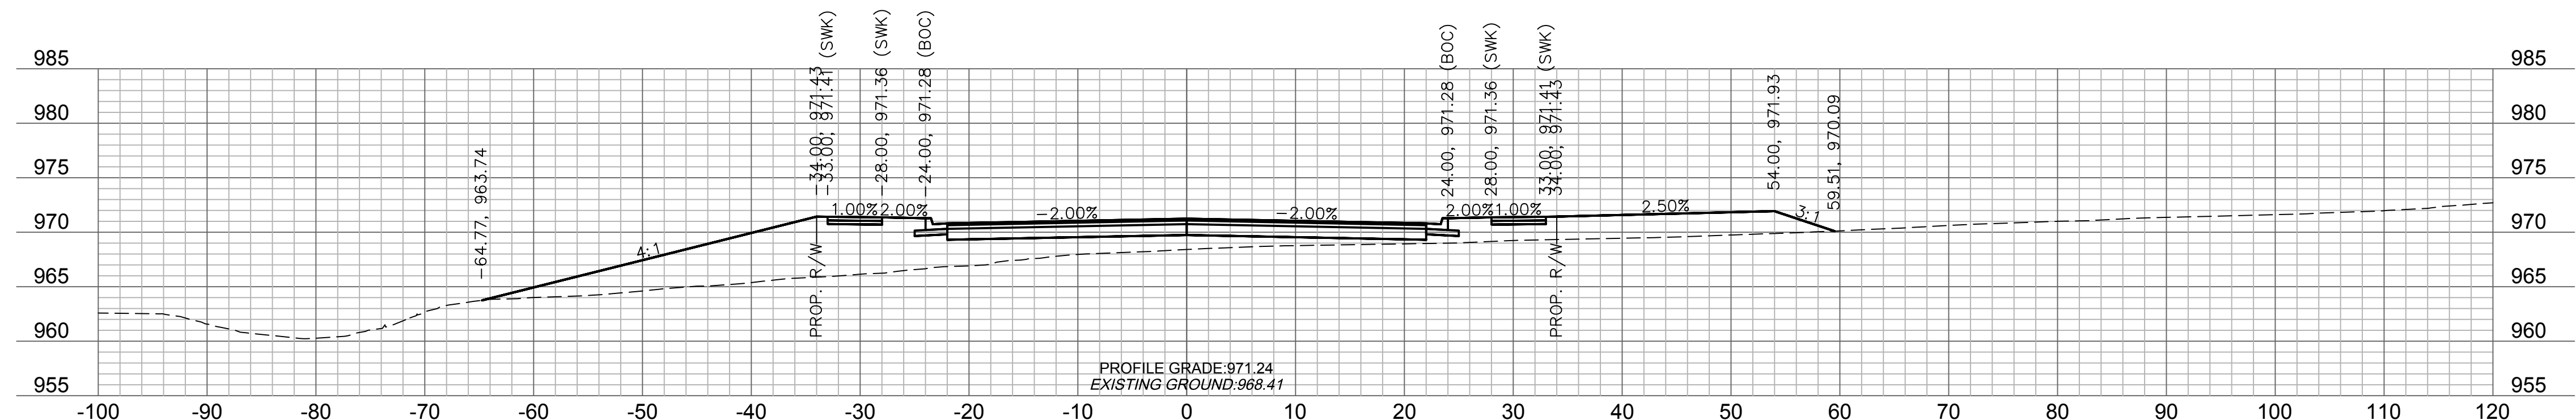

24+50



Olsson

Olsson Engineering - MO State Certificate of Authority #001592
77301 West 133rd Street, Suite 200 TEL 913.381.1170
Overland Park, KS 66213-4750 FAX 913.381.1174 www.olsson.com

RECORD
DRAWINGS

RYAN B. FLEMING
MO. NO. PE-2002003161

[illegible]

MAIN STREET CROSS SECTIONS


SCANNELL DEVELOPMENT LEE'S SUMMIT LOGISTICS
NORTHWEST CORNER OF TUDOR ROAD AND MAIN STREET

LEE'S SUMMIT, MISSOURI	2022
------------------------	------


C.O.A. NO.: _____ -
DRAWN BY: _____ ARJ/AMW
CHECKED BY: _____ XXX
APPROVED BY: _____ RBF
QA/QC BY: _____ RBF
PROJECT NO.: _____ 021-04157
DWG NO.: T_XSC01_02104157
DATE: _____ 2021-10-12

SHEET
89 OF 105


USER: asaavedra

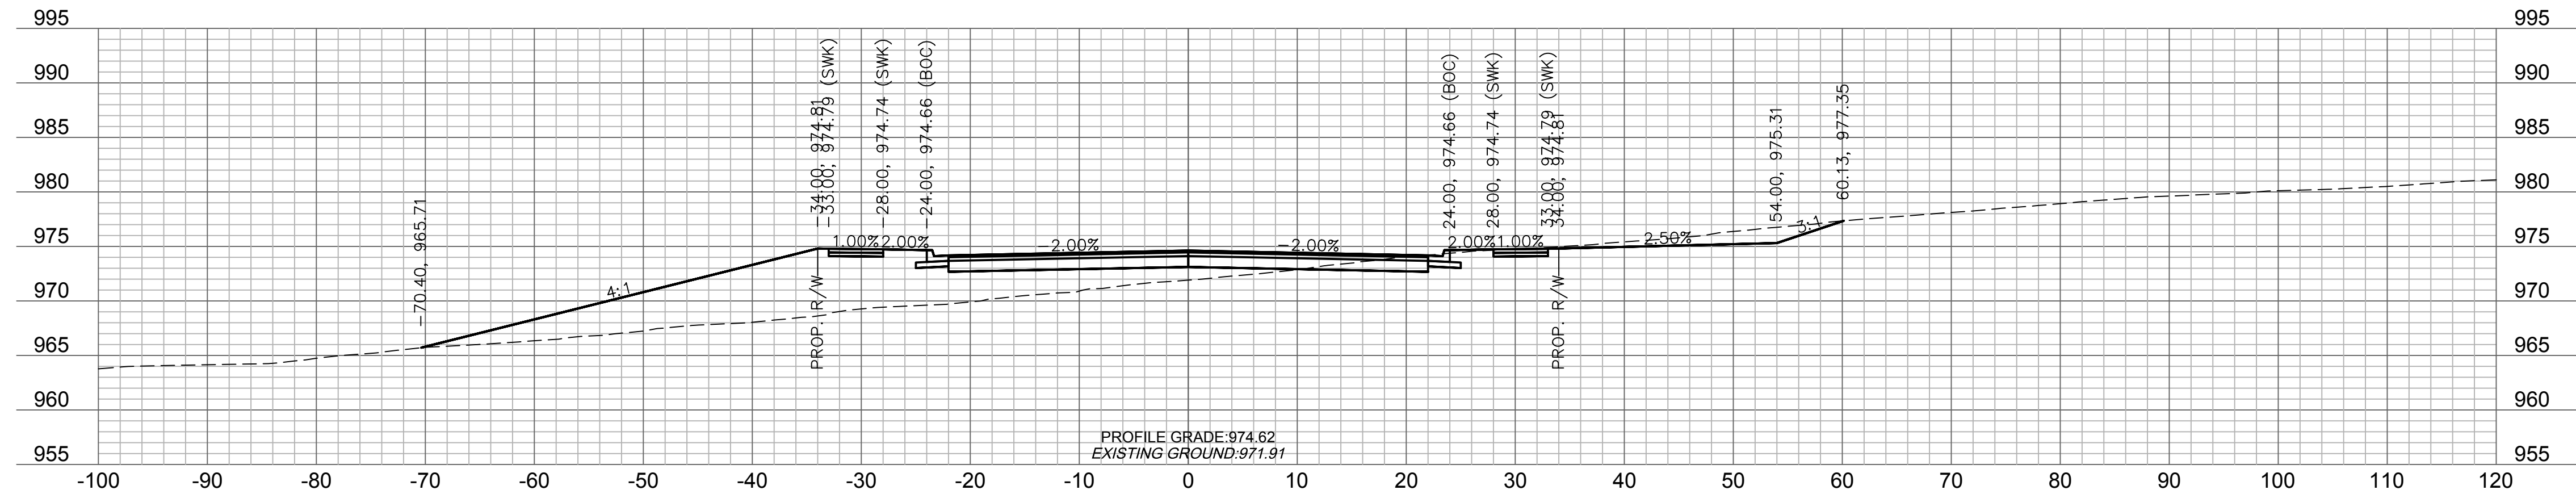


26+00

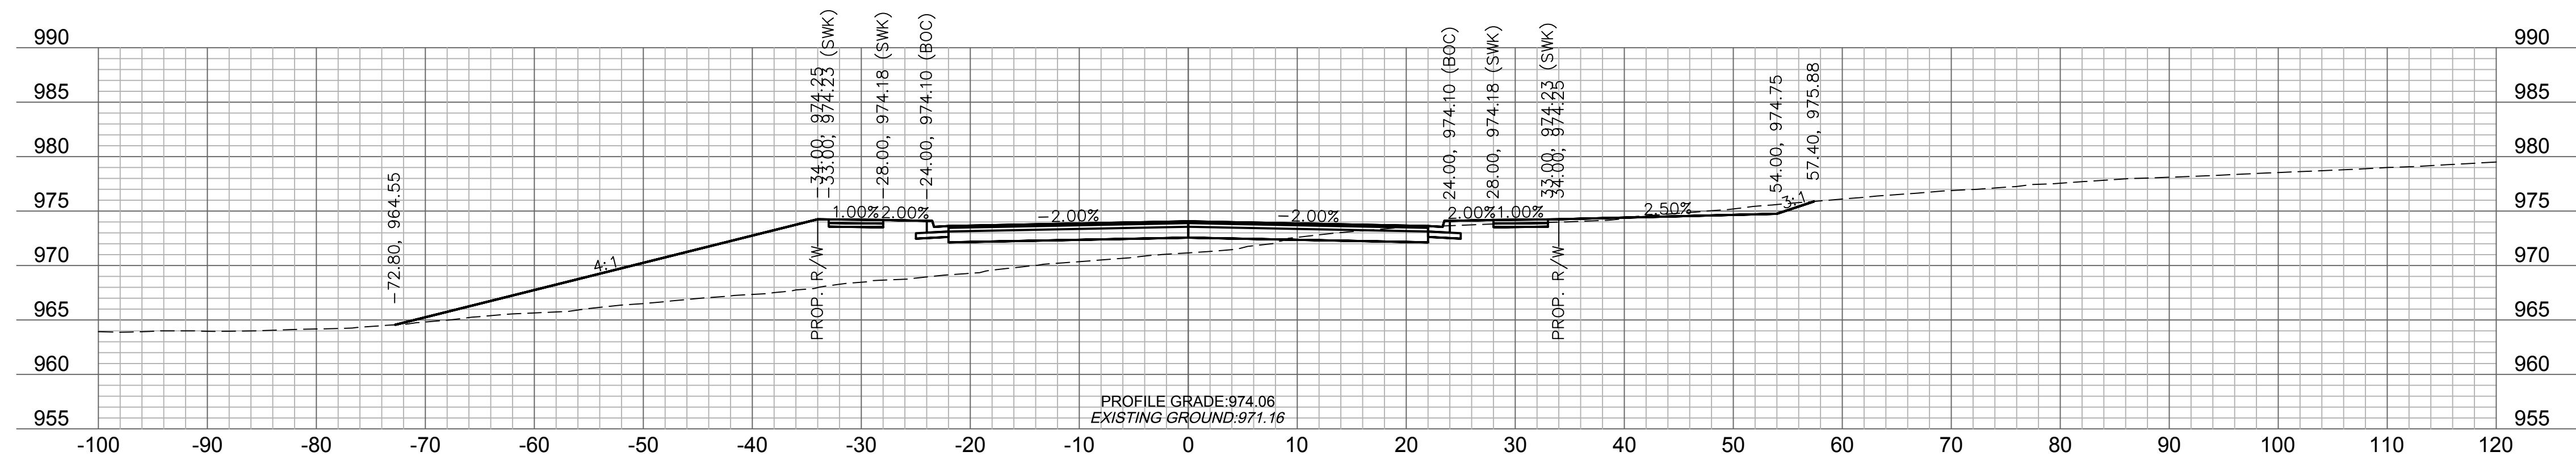

25+75

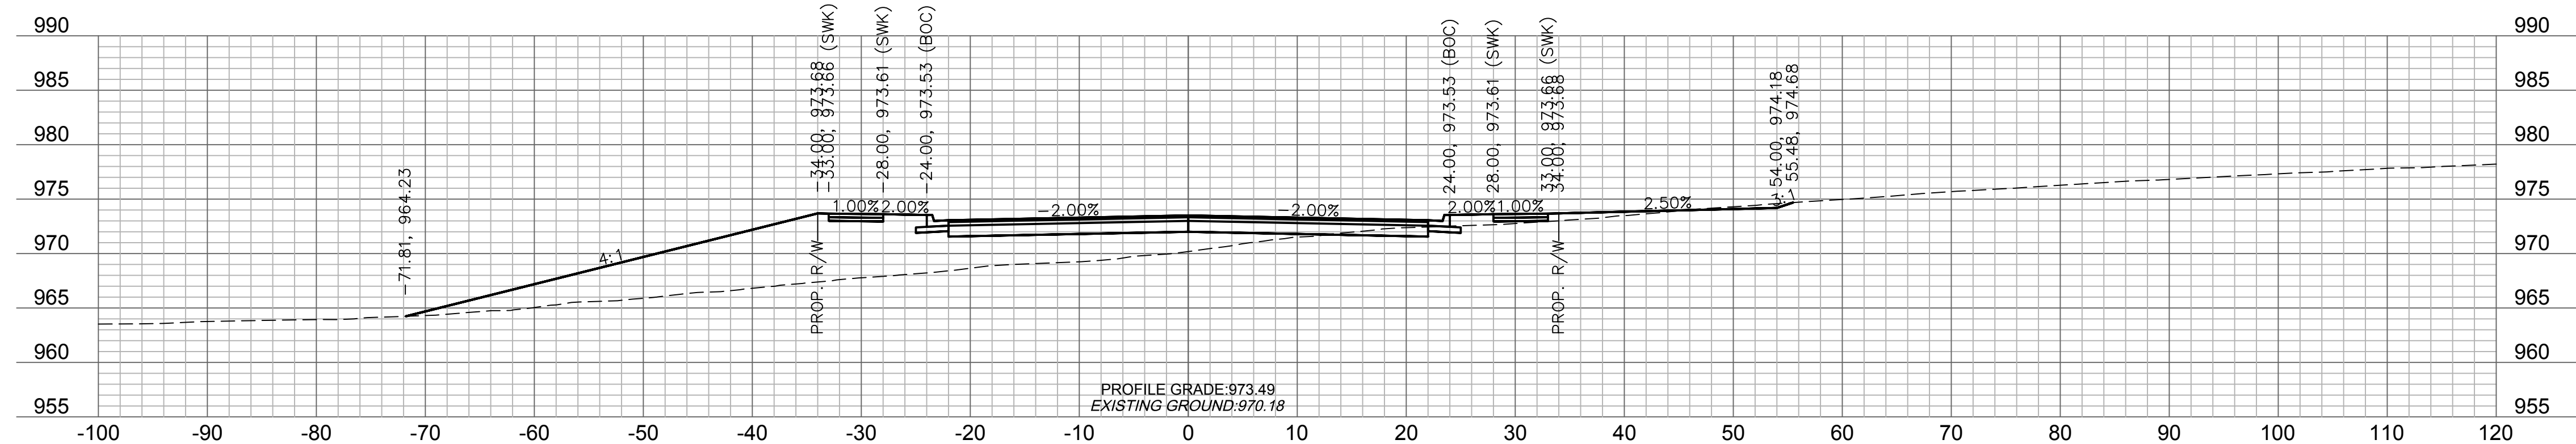

25+50

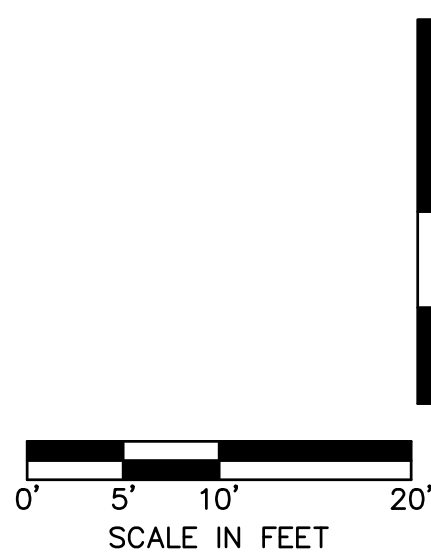

RECORD
DRAWINGS

RYAN B. FLEMING
MO. NO. PE-2002003161

[illegible]

MAIN STREET CROSS SECTIONS	
SCANNELL DEVELOPMENT LEE'S SUMMIT LOGISTICS NORTHWEST CORNER OF TUDOR ROAD AND MAIN STREET	2024





C.O.A. NO.: _____
 DRAWN BY: _____ ARJ/AMV
 CHECKED BY: _____ XX
 APPROVED BY: _____ RB
 QA/QC BY: _____ RB
 PROJECT NO.: _____ 021-0415
 DWG NO.: T_XSC01_0210415
 DATE: _____ 2021-10-1

SHEET
90 OF 105

olson

Olsson Engineering - MO State Certificate of Authority #001592
7301 West 133rd Street, Suite 200 TEL 913.381.1170
Overland Park, KS 66213-4750 FAX 913.381.1174 www.olsson.com

USER: asaavedra

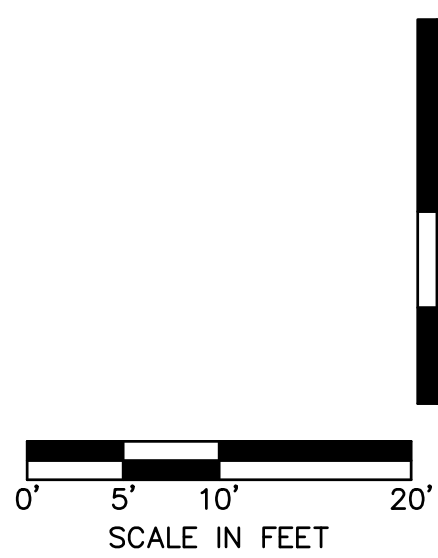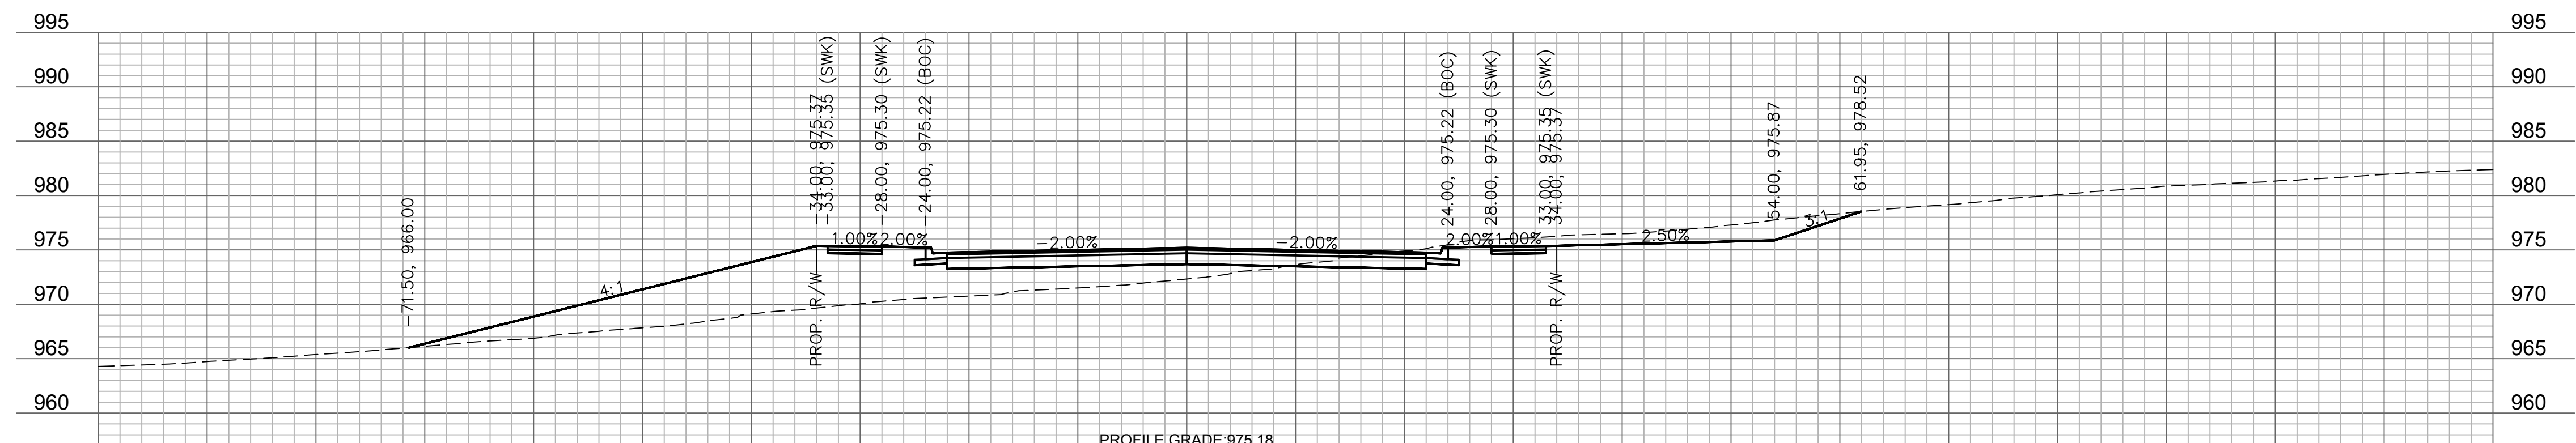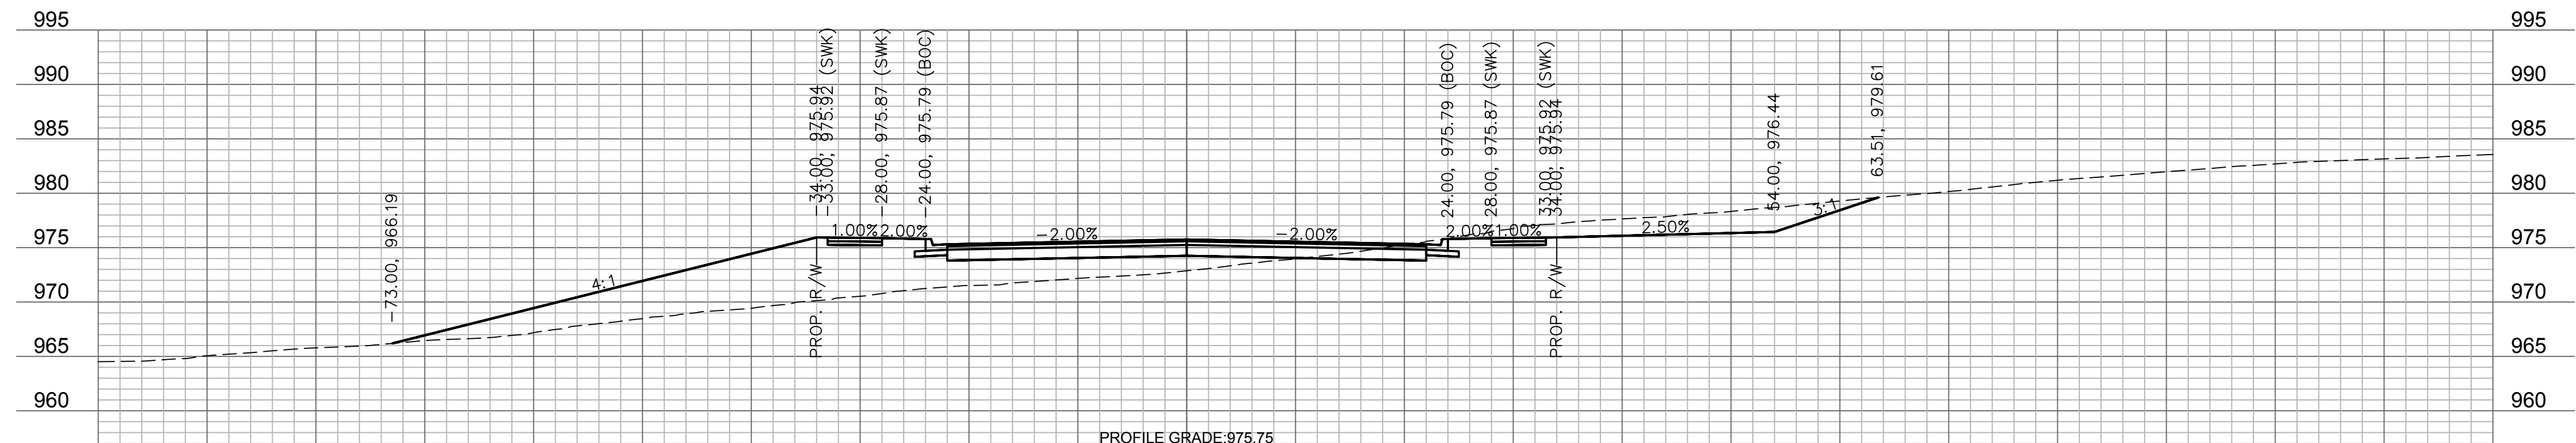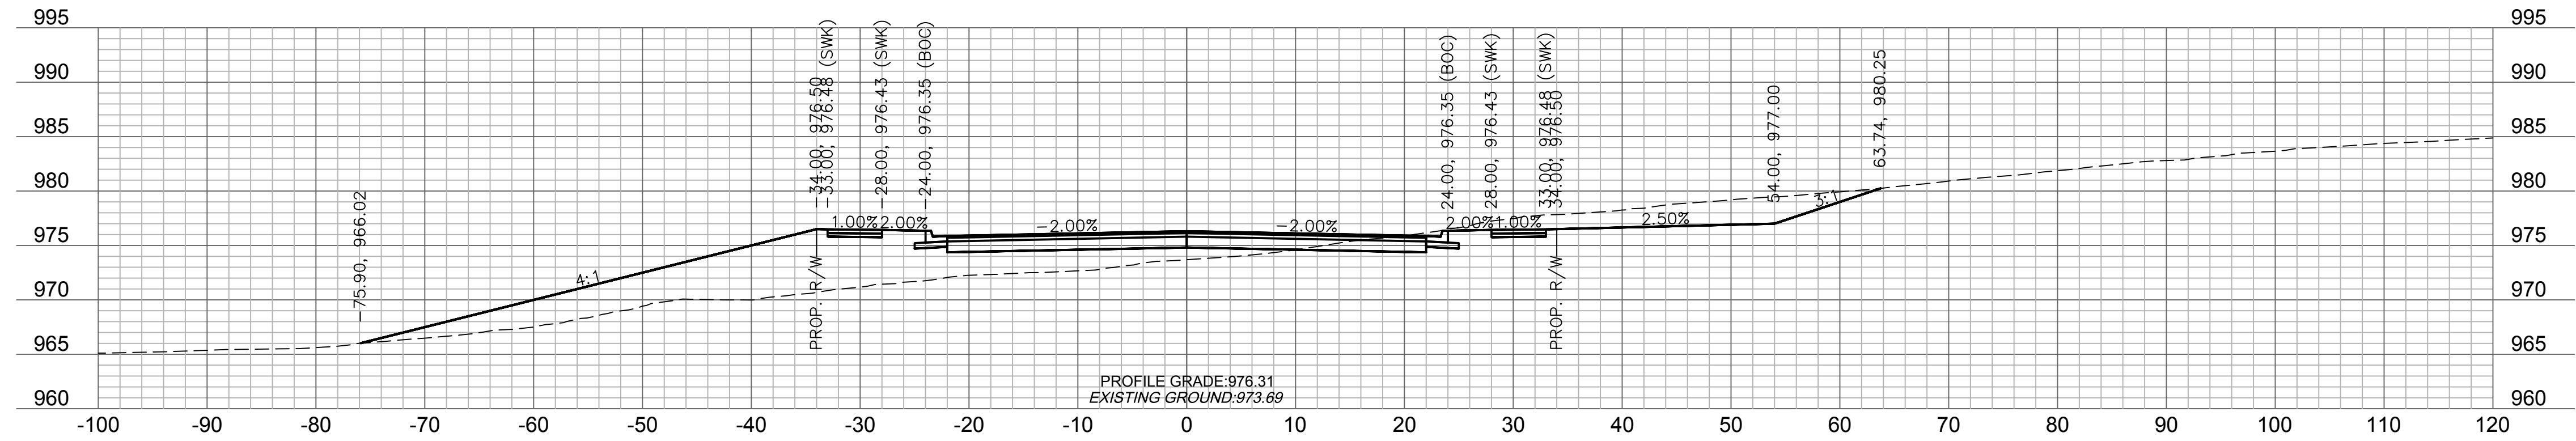

olson

Olsson Engineering - MO State Certificate of Authority #001592
7301 West 133rd Street, Suite 200 TEL 913.381.1170
Overland Park, KS 66213-4750 FAX 913.381.1174 www.olsson.com

RECORD
DRAWINGS

RYAN B. FLEMING
MO. NO. PE-2002003161

[illegible]

MAIN STREET CROSS SECTIONS




SCANNELL DEVELOPMENT LEE'S SUMMIT LOGISTICS
NORTHWEST CORNER OF TUDOR ROAD AND MAIN STREET

LEE'S SUMMIT, MISSOURI

C.O.A. NO.: _____ -
DRAWN BY: _____ ARJ/AMW
CHECKED BY: _____ XXX
APPROVED BY: _____ RBF
QA/QC BY: _____ RBF
PROJECT NO.: _____ 021-04157
DWG NO.: T_XSC01_02104157
DATE: _____ 2021-10-12

SHEET
91 OF 105

USER: asaavedra

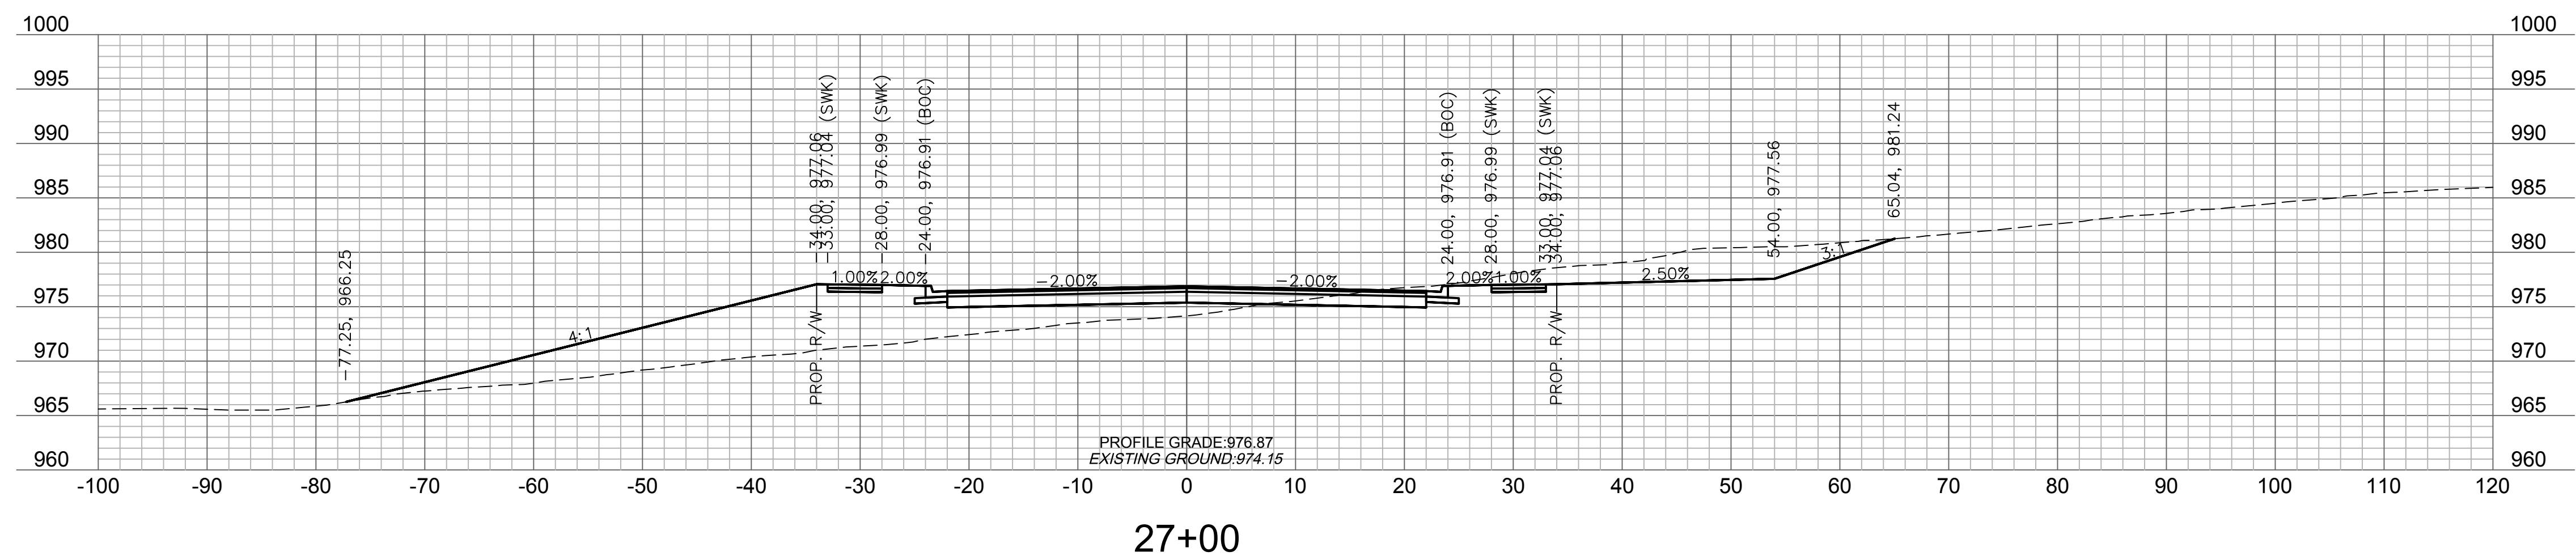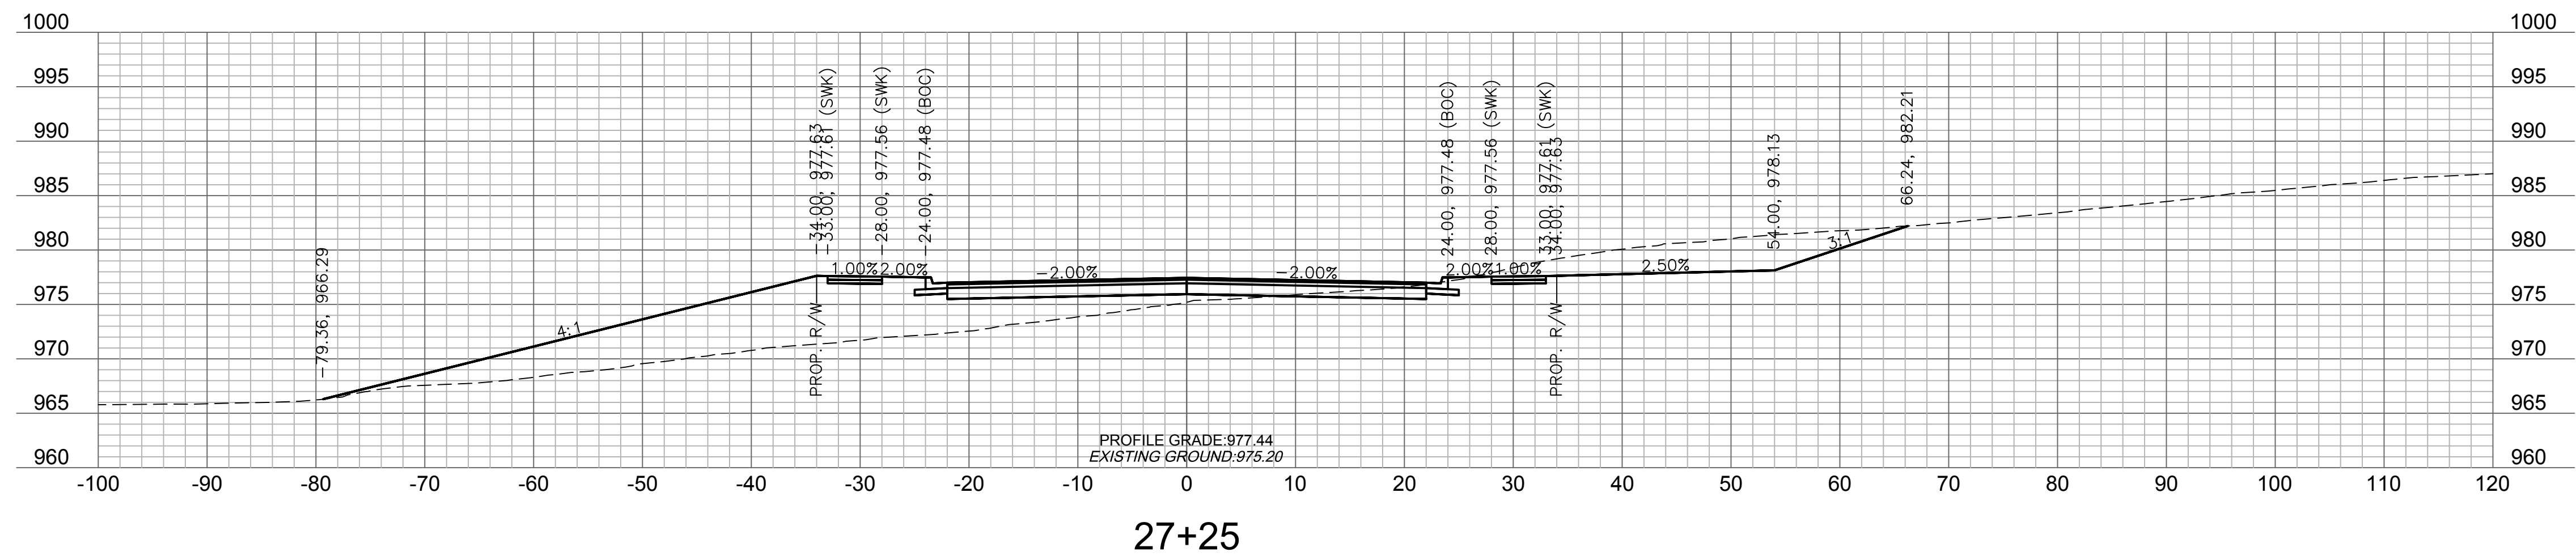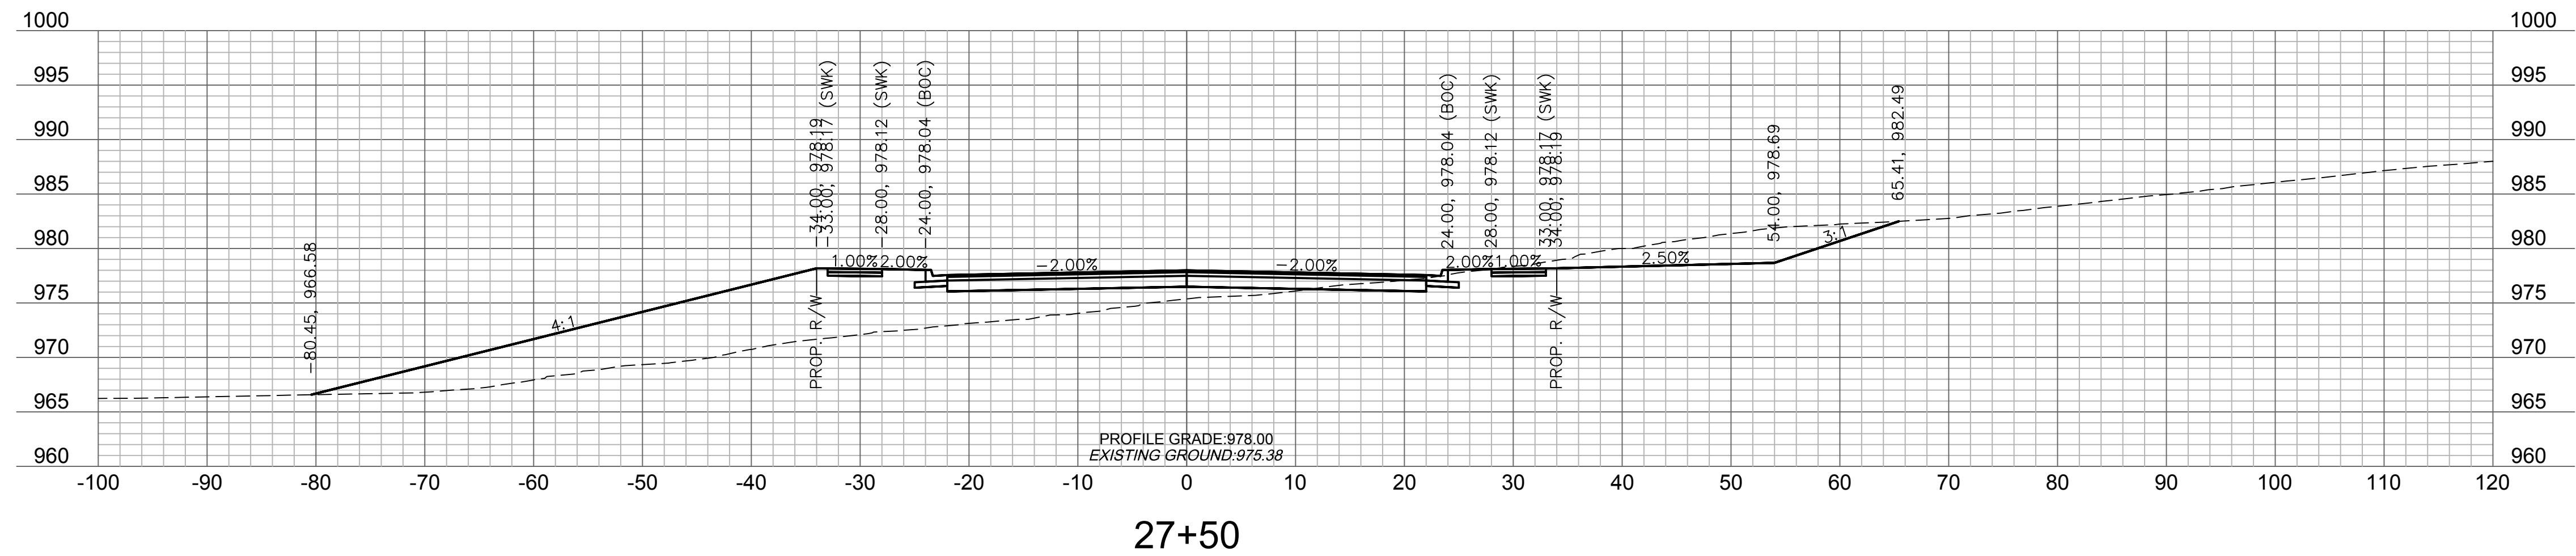

olson

Olsson Engineering - MO State Certificate of Authority #001592
7301 West 133rd Street, Suite 200 TEL 913.381.1170
Overland Park, KS 66213-4750 FAX 913.381.1174 www.olsson.com

RECORD
DRAWINGS

RYAN B. FLEMING
MO. NO. PE-2002003161

[illegible]

MAIN STREET
CROSS SECTIONS




SCANNELL DEVELOPMENT LEE'S SUMMIT LOGISTICS
NORTHWEST CORNER OF TUDOR ROAD AND MAIN STREET

LEE'S SUMMIT, MISSOURI

C.O.A. NO.: _____ -
DRAWN BY: _____ ARJ/AMW
CHECKED BY: _____ XXX
APPROVED BY: _____ RBF
QA/QC BY: _____ RBF
PROJECT NO.: _____ 021-04157
DWG NO.: T_XSC01_02104157
DATE: _____ 2021-10-12

SHEET
92 OF 105

4157\40-Design\AutoCAD\Final Plans\Sheets\RDBR\T_XSC01_02104157.dwg
T_PBASE_02104157
T_PTBLK_02104157

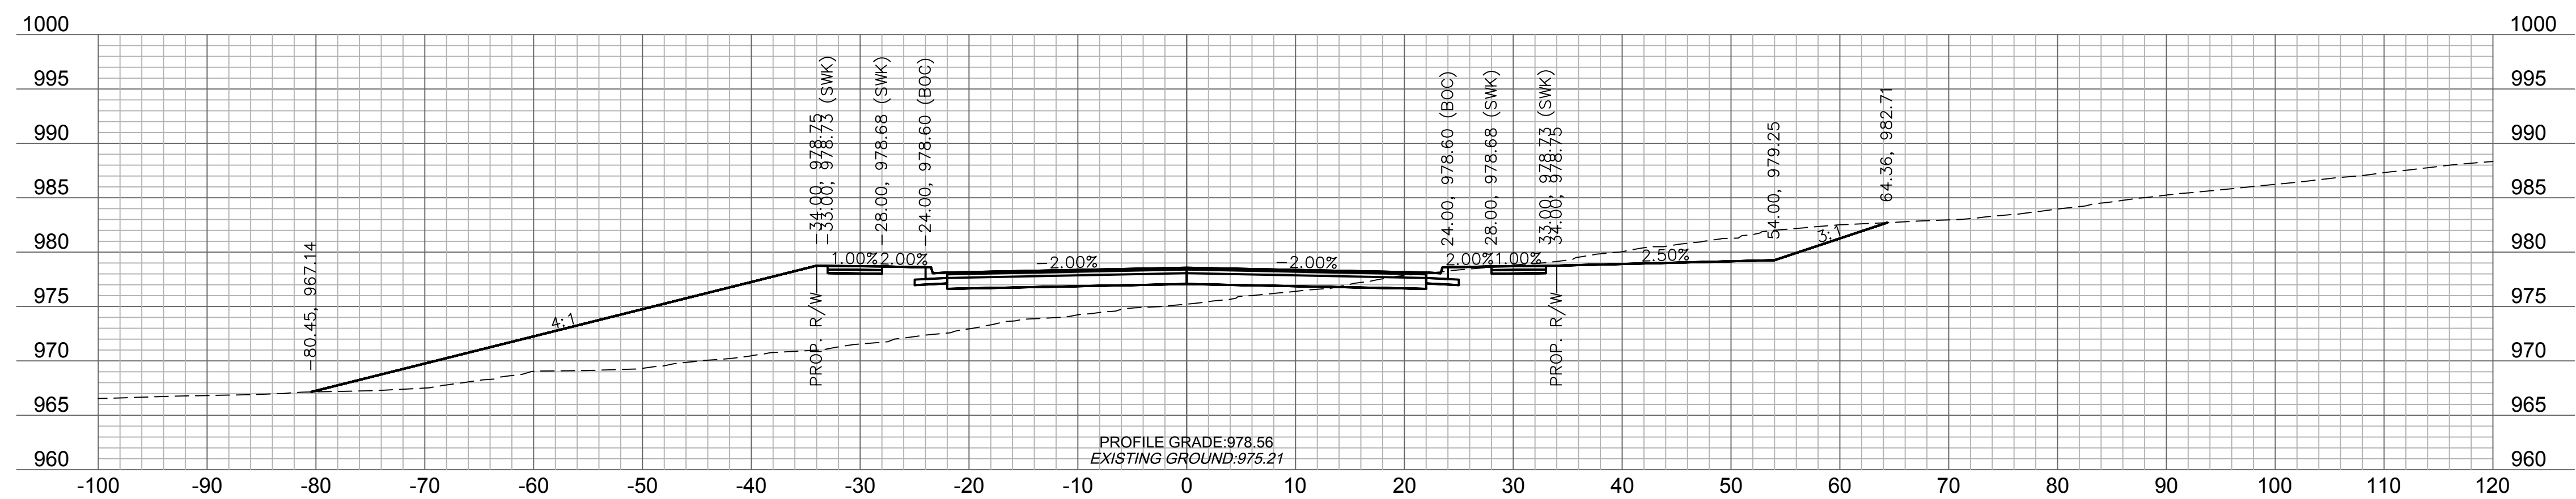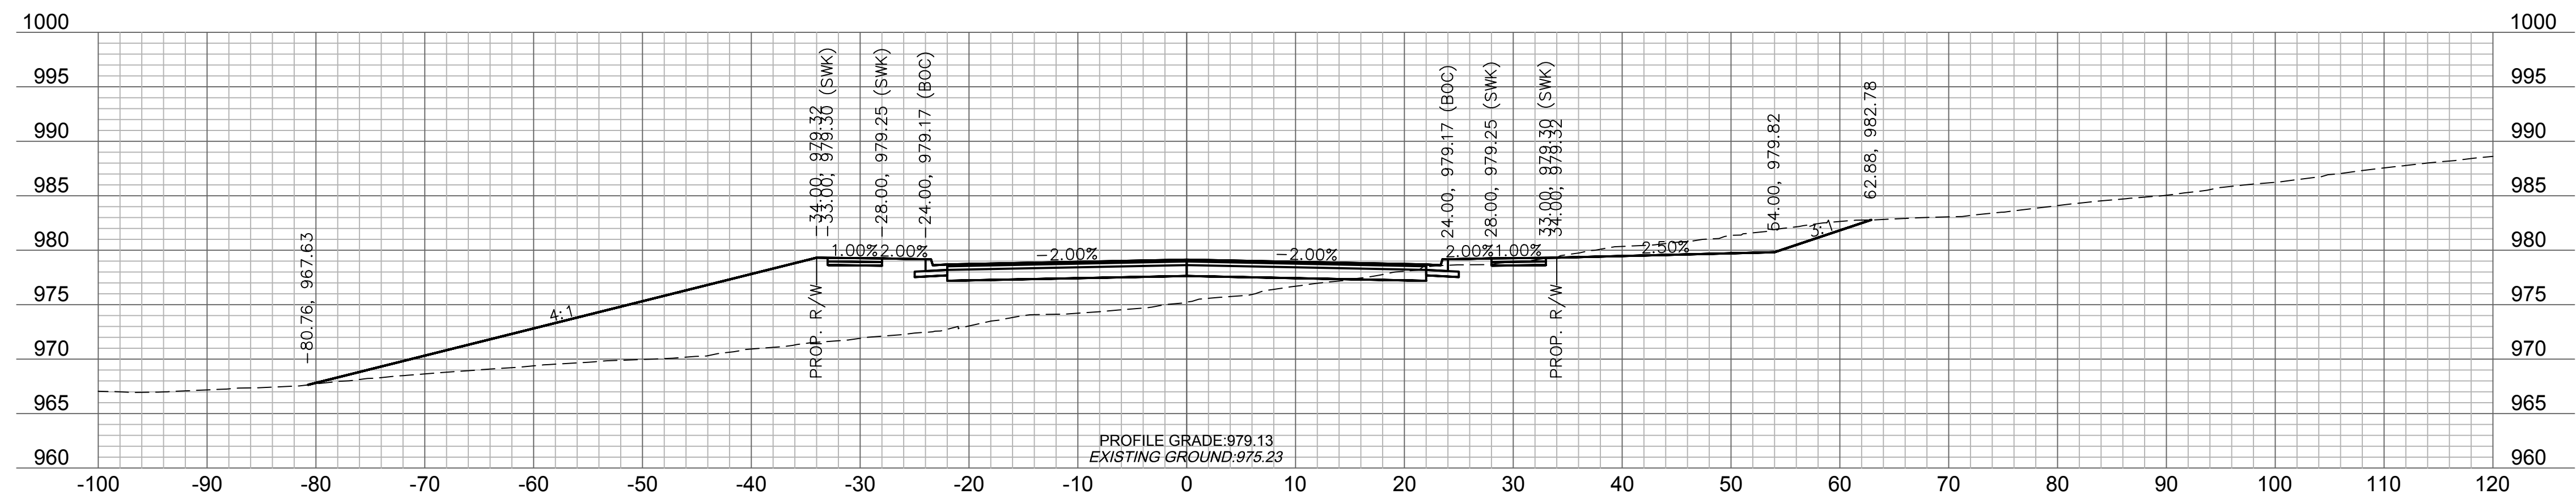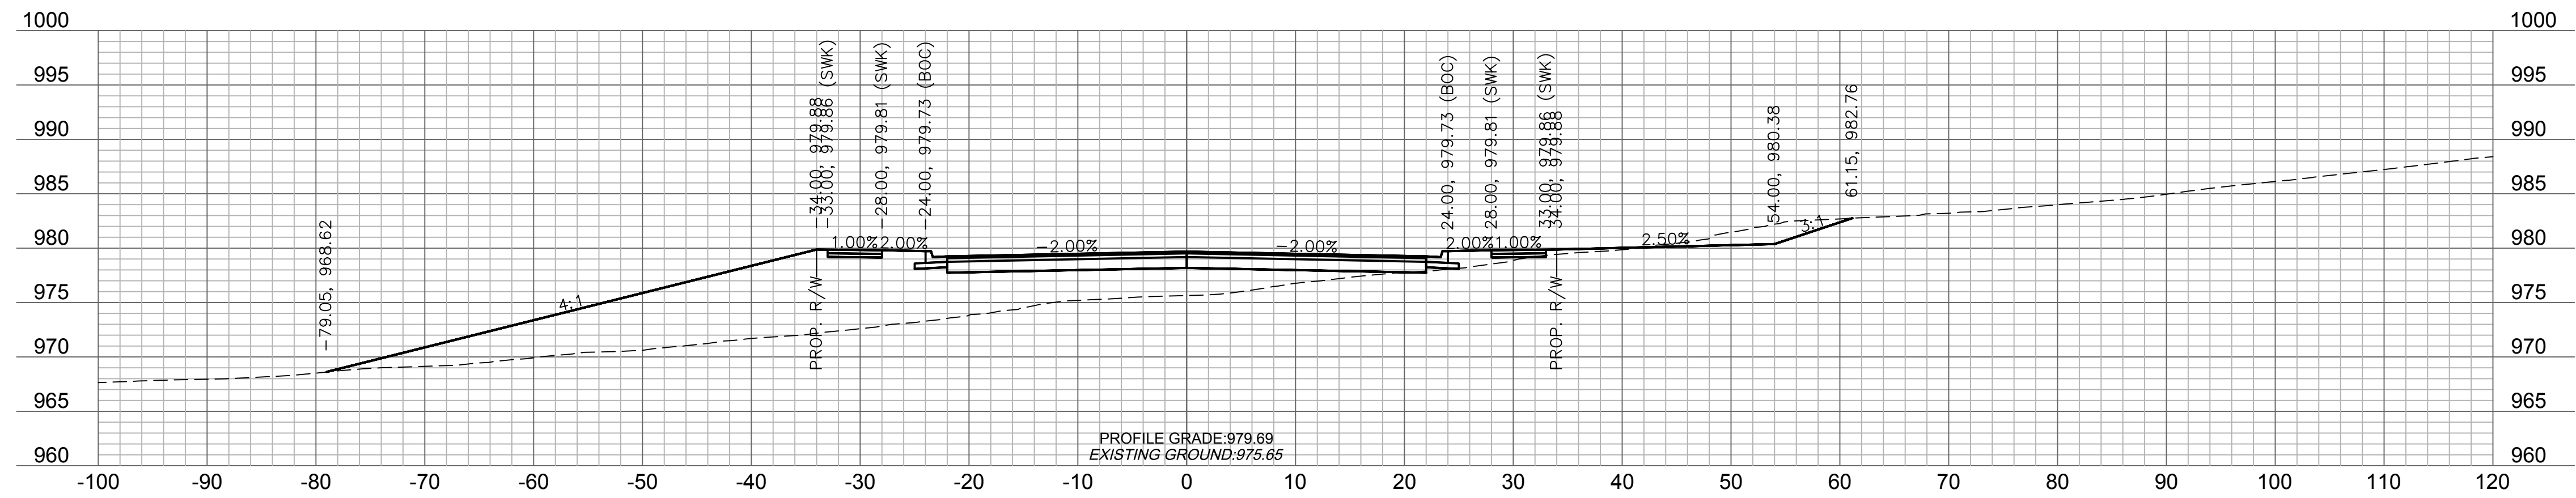

RECORD
DRAWINGS

RYAN B. FLEMING
MO. NO. PE-2002003161

[illegible]

MAIN STREET CROSS SECTIONS	
SCANNELL DEVELOPMENT LEE'S SUMMIT LOGISTICS NORTHWEST CORNER OF TUDOR ROAD AND MAIN STREET	2024




C.O.A. NO.: _____
 DRAWN BY: _____ ARJ/AMV
 CHECKED BY: _____ XX
 APPROVED BY: _____ RB
 QA/QC BY: _____ RB
 PROJECT NO.: _____ 021-0415
 DWG NO.: T_XSC01_0210415
 DATE: _____ 2021-10-1

SHEET
93 OF 105

olson

Olsson Engineering - MO State Certificate of Authority #001592
7301 West 133rd Street, Suite 200 TEL 913.381.1170
Overland Park, KS 66213-4750 FAX 913.381.1174 www.olsson.com

DWG: F:\2021\04001\021-04157\40-Design\AutoCAD\Final Plans\Sheets\ROBR\T_XSC01_02104157.dwg
DATE: Oct 30, 2023 3:58pm XREFS: T_PTBLK_02104157 T_PBASE_02104157

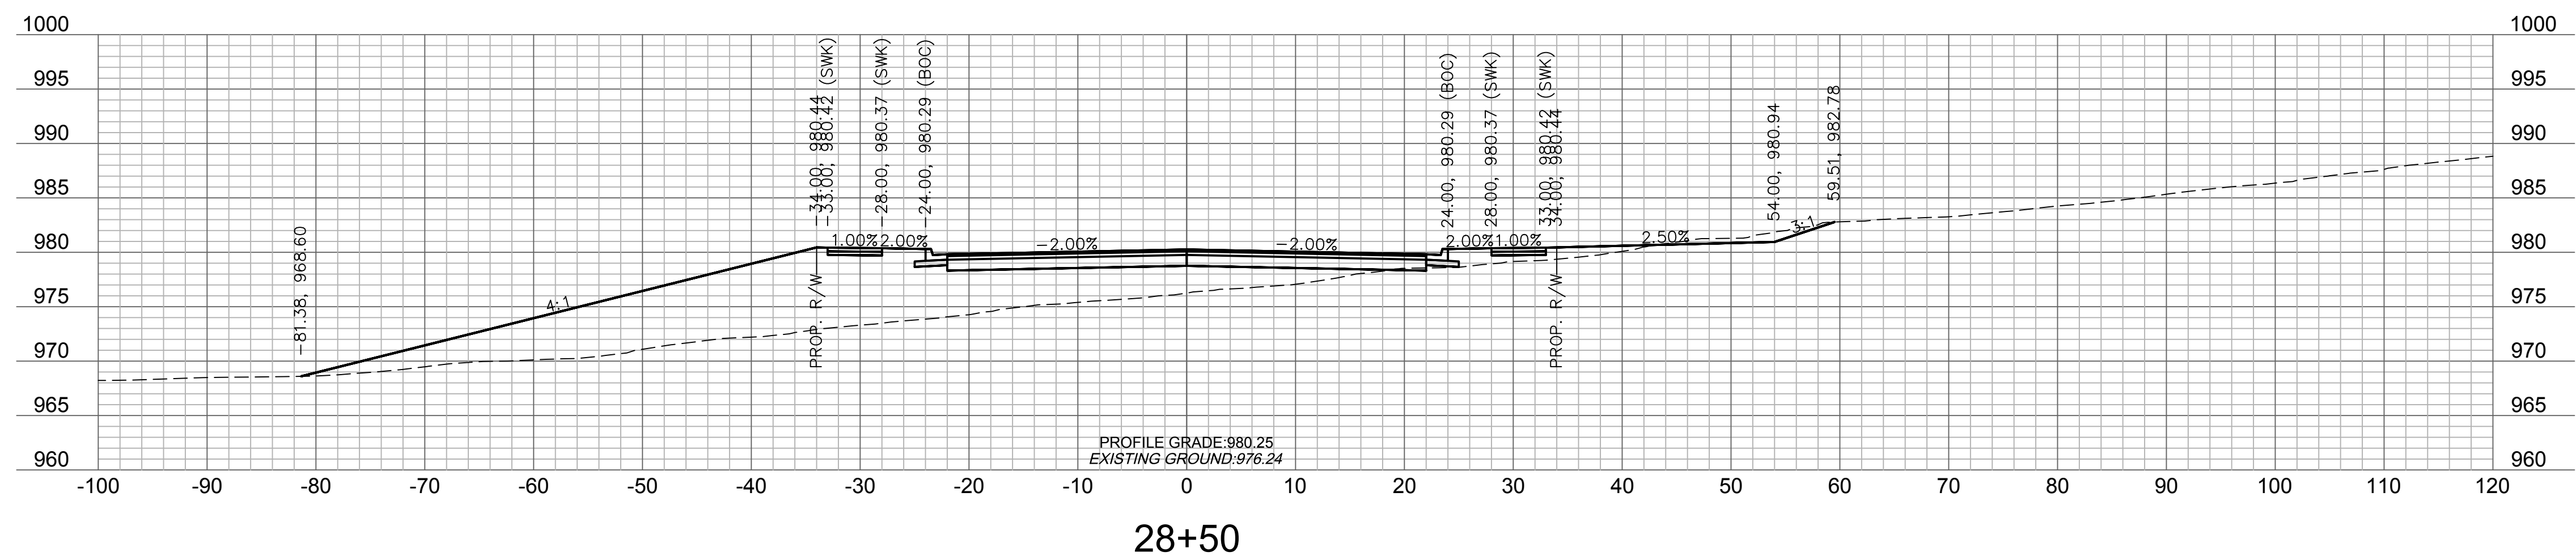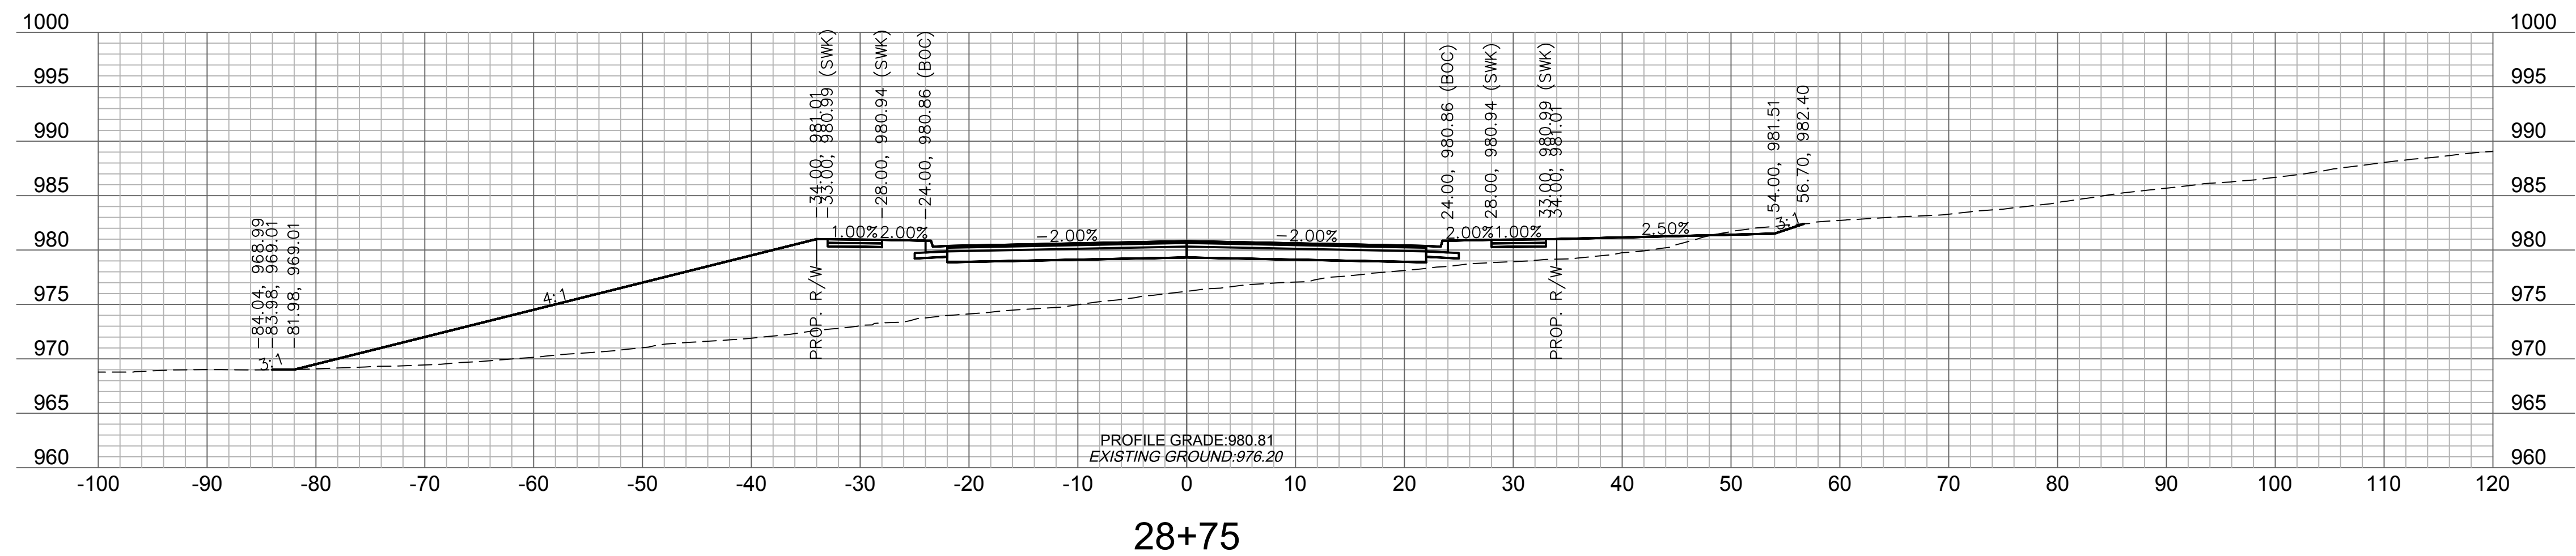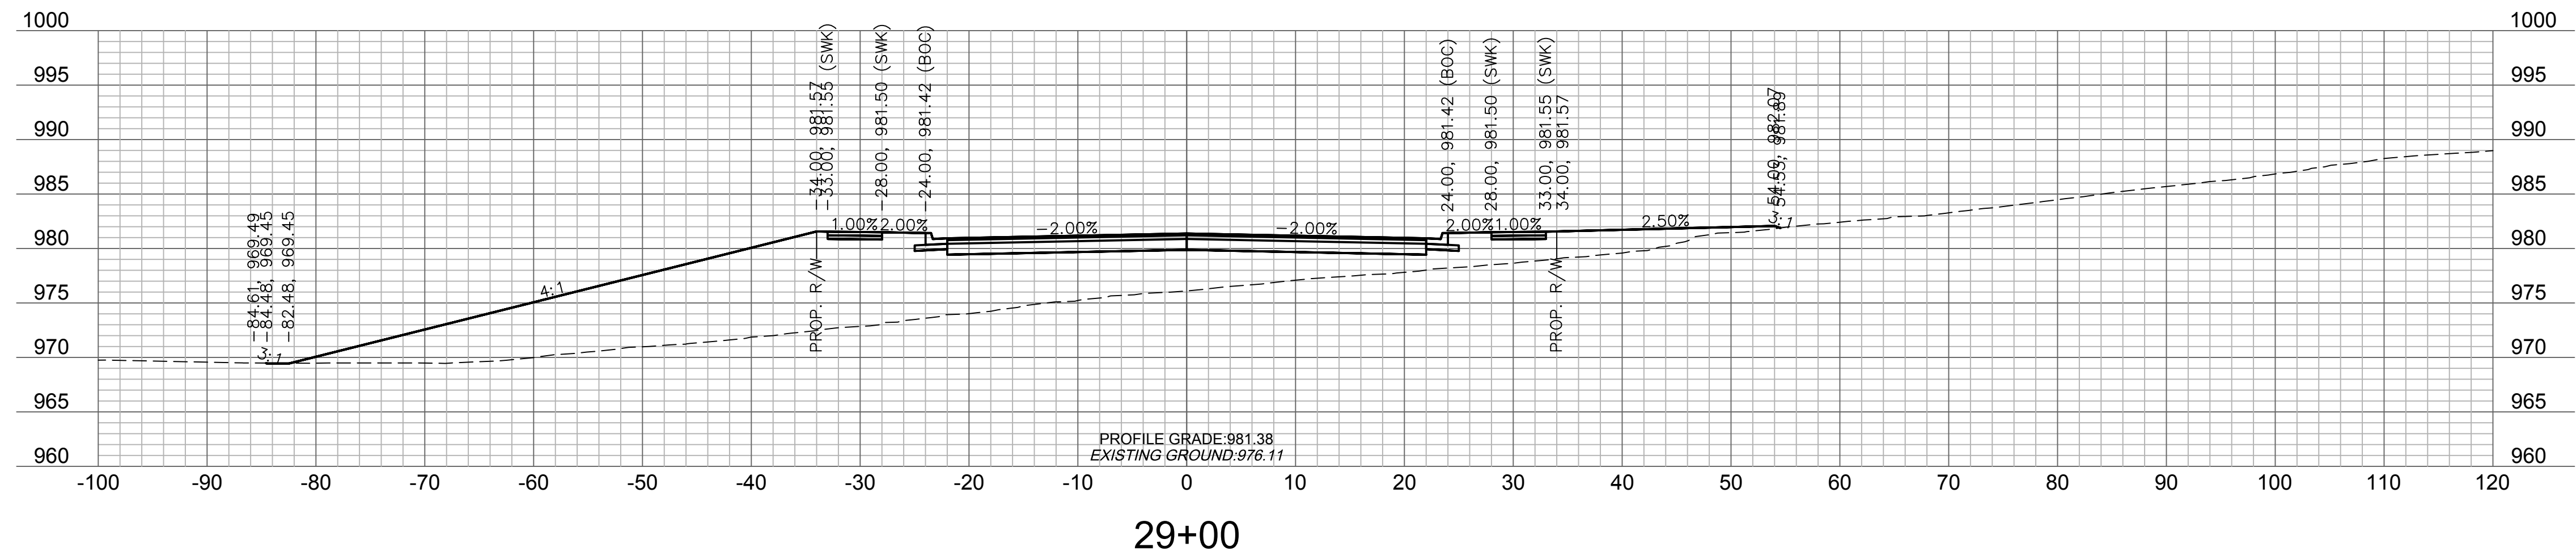

RECORD
DRAWINGS

RYAN B. FLEMING
MO. NO. PE-2002003161

[illegible]

MAIN STREET CROSS SECTIONS	
SCANNELL DEVELOPMENT LEE'S SUMMIT LOGISTICS NORTHWEST CORNER OF TUDOR ROAD AND MAIN STREET	2024


C.O.A. NO.: _____
 DRAWN BY: _____ ARJ/AMV
 CHECKED BY: _____ XX
 APPROVED BY: _____ RB
 QA/QC BY: _____ RB
 PROJECT NO.: _____ 021-0415
 DWG NO.: T_XSC01_0210415
 DATE: _____ 2021-10-1

SHEET
94 OF 105


olson

Olsson Engineering - MO State Certificate of Authority #001592
7301 West 133rd Street, Suite 200 TEL 913.381.1170
Overland Park, KS 66213-4750 FAX 913.381.1174 www.olsson.com


DWG: F:\2021\04001-04500\021-04157\40-Desian\AutoCAD\Final Plans\Sheets\ROBR\T_XSC01_02104157.dwg
XREFS: T_PTBLK_02104157
T_PBASE_02104157
DATE: Oct 30, 2023 3:58pm

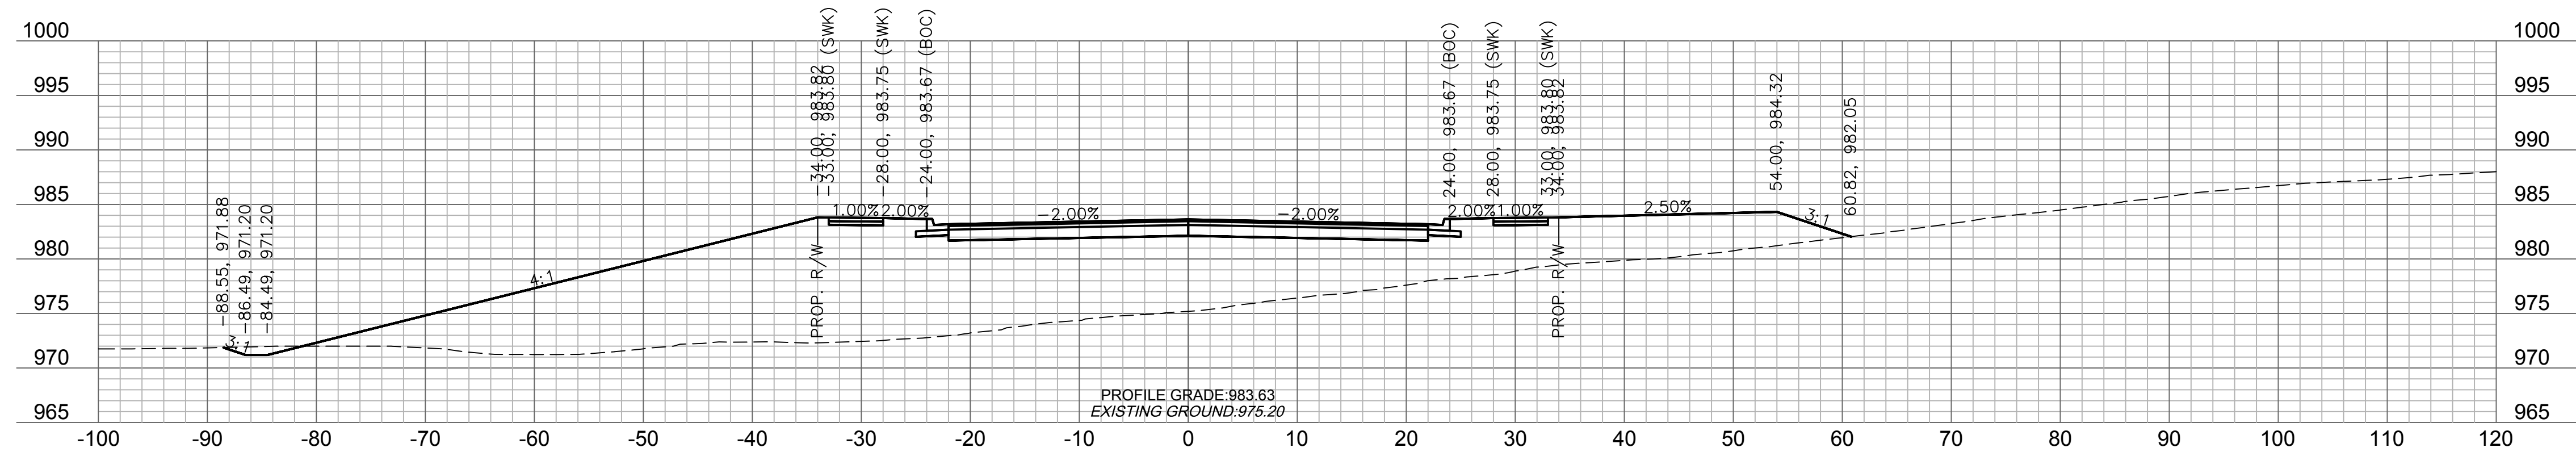


30+00

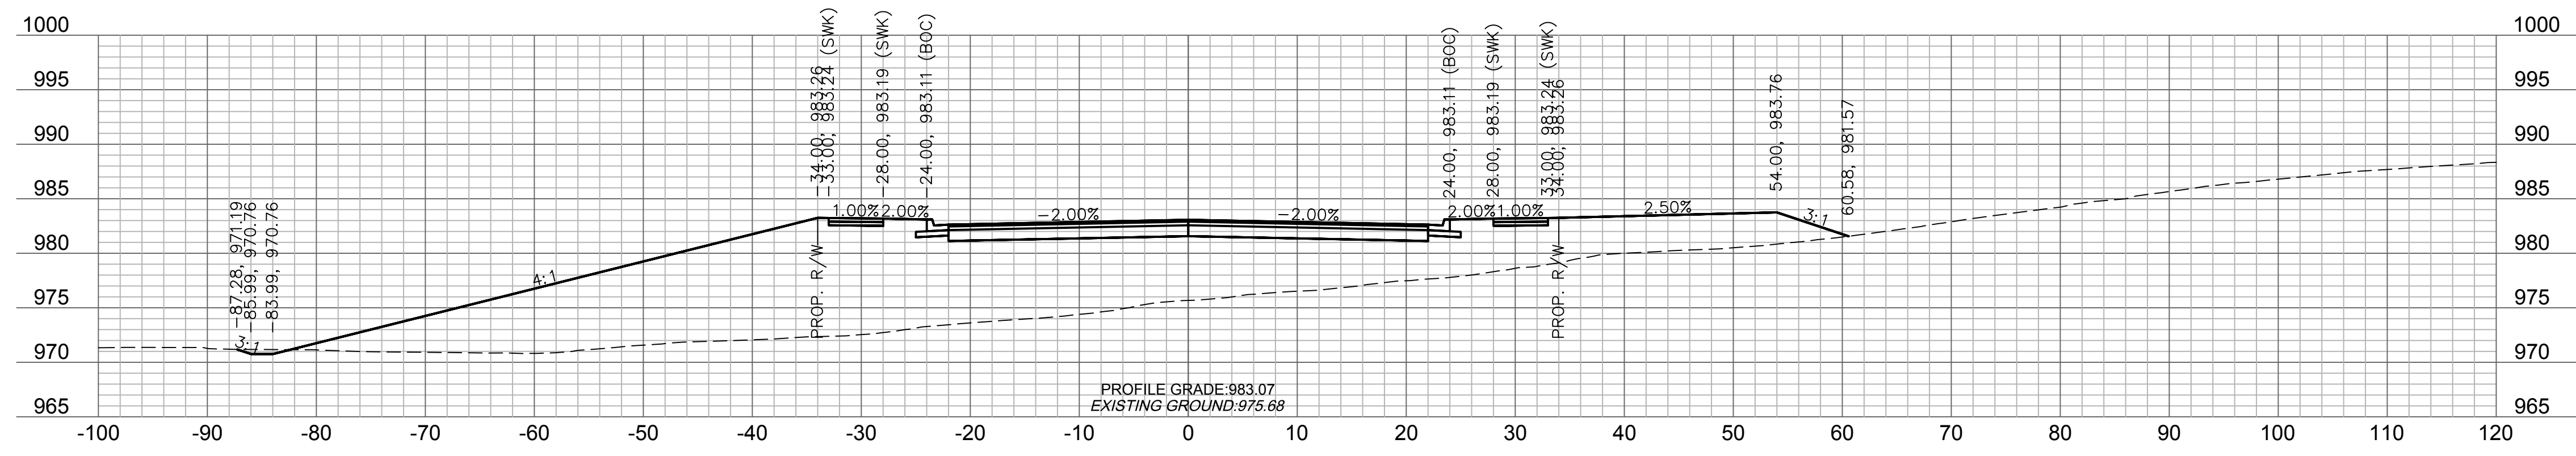

29+75

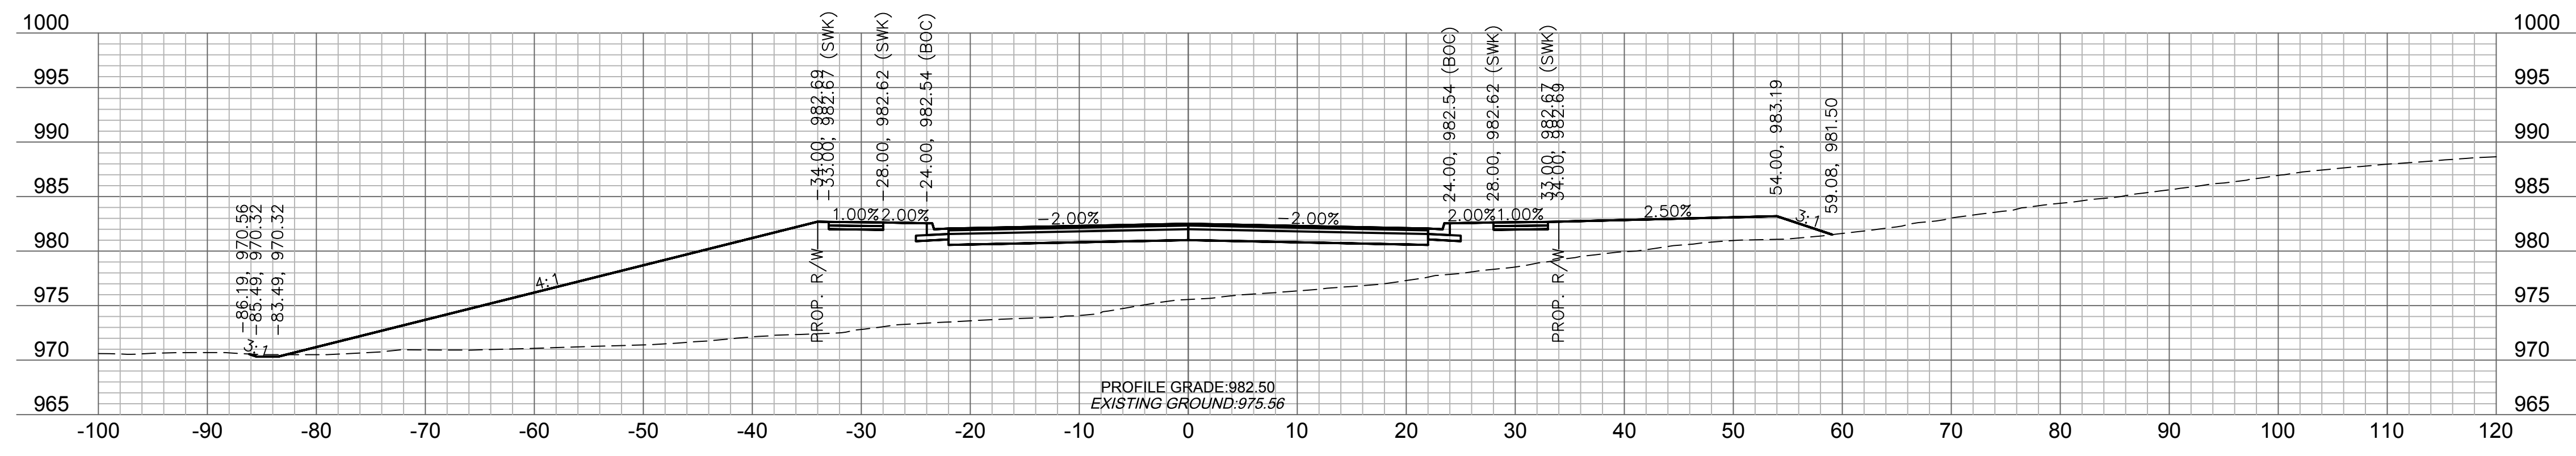

29+50

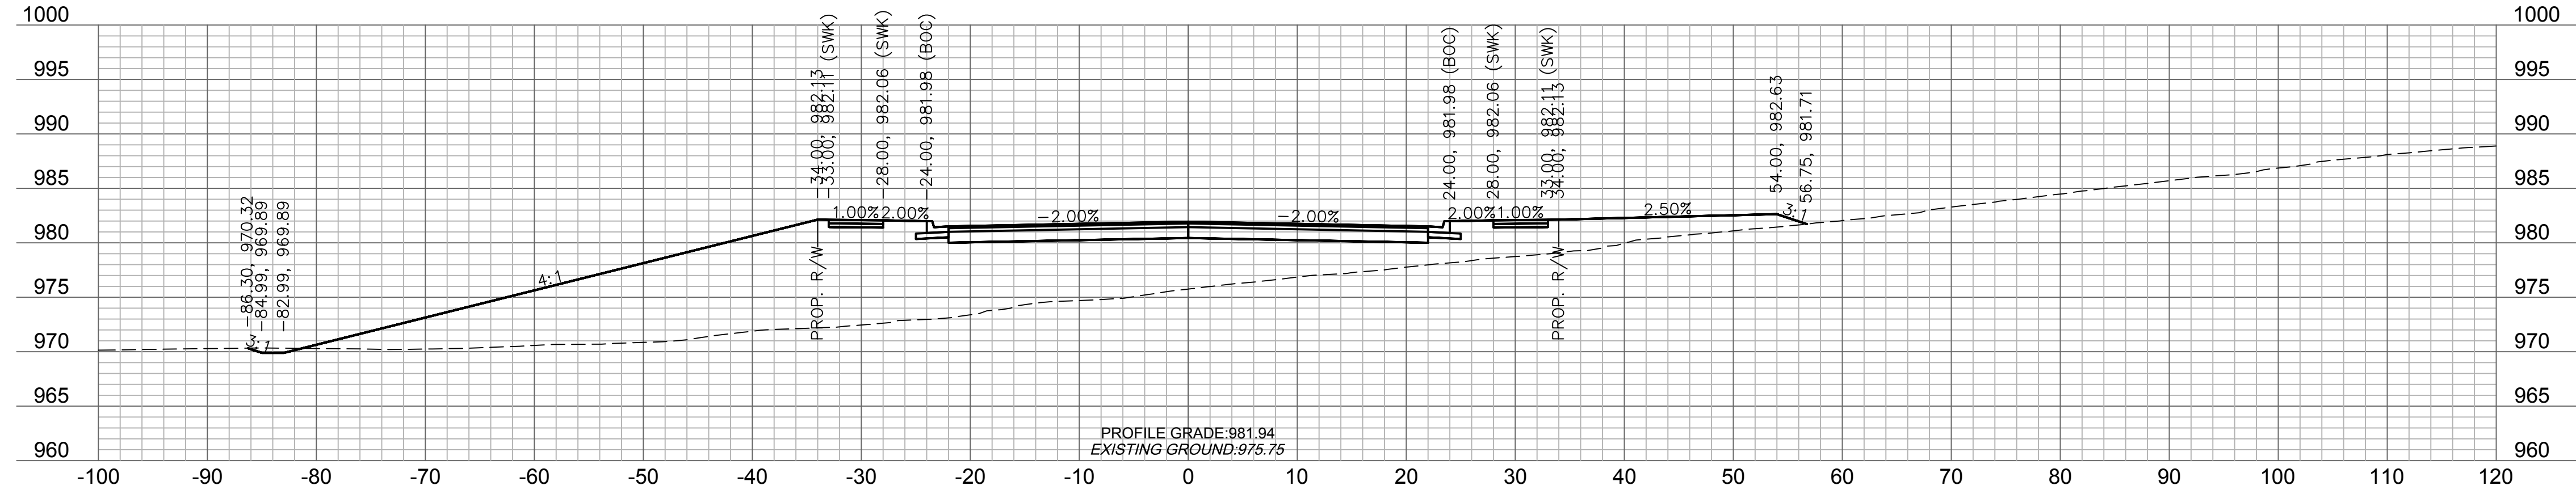

29+25



olson

Olsson Engineering - MO State Certificate of Authority #001592
7301 West 133rd Street, Suite 200 TEL 913.381.1170
Overland Park, KS 66213-4750 FAX 913.381.1174 www.olsson.com

RECORD
DRAWINGS

RYAN B. FLEMING
MO. NO. PE-2002003161

[illegible]






MAIN STREET CROSS SECTIONS

SCANNELL DEVELOPMENT LEE'S SUMMIT LOGISTICS
NORTHWEST CORNER OF TUDOR ROAD AND MAIN STREET

LEE'S SUMMIT, MISSOURI	2022
------------------------	------

C.O.A. NO.: _____ -
DRAWN BY: _____ ARJ/AMW
CHECKED BY: _____ XXX
APPROVED BY: _____ RBF
QA/QC BY: _____ RBF
PROJECT NO.: _____ 021-04157
DWG NO.: T_XSC01_02104157
DATE: _____ 2021-10-12

SHEET
95 OF 105

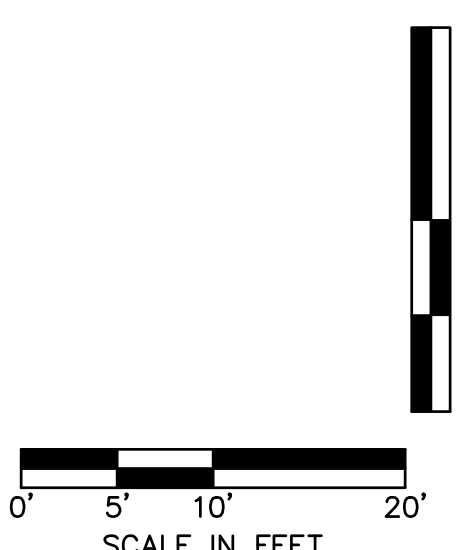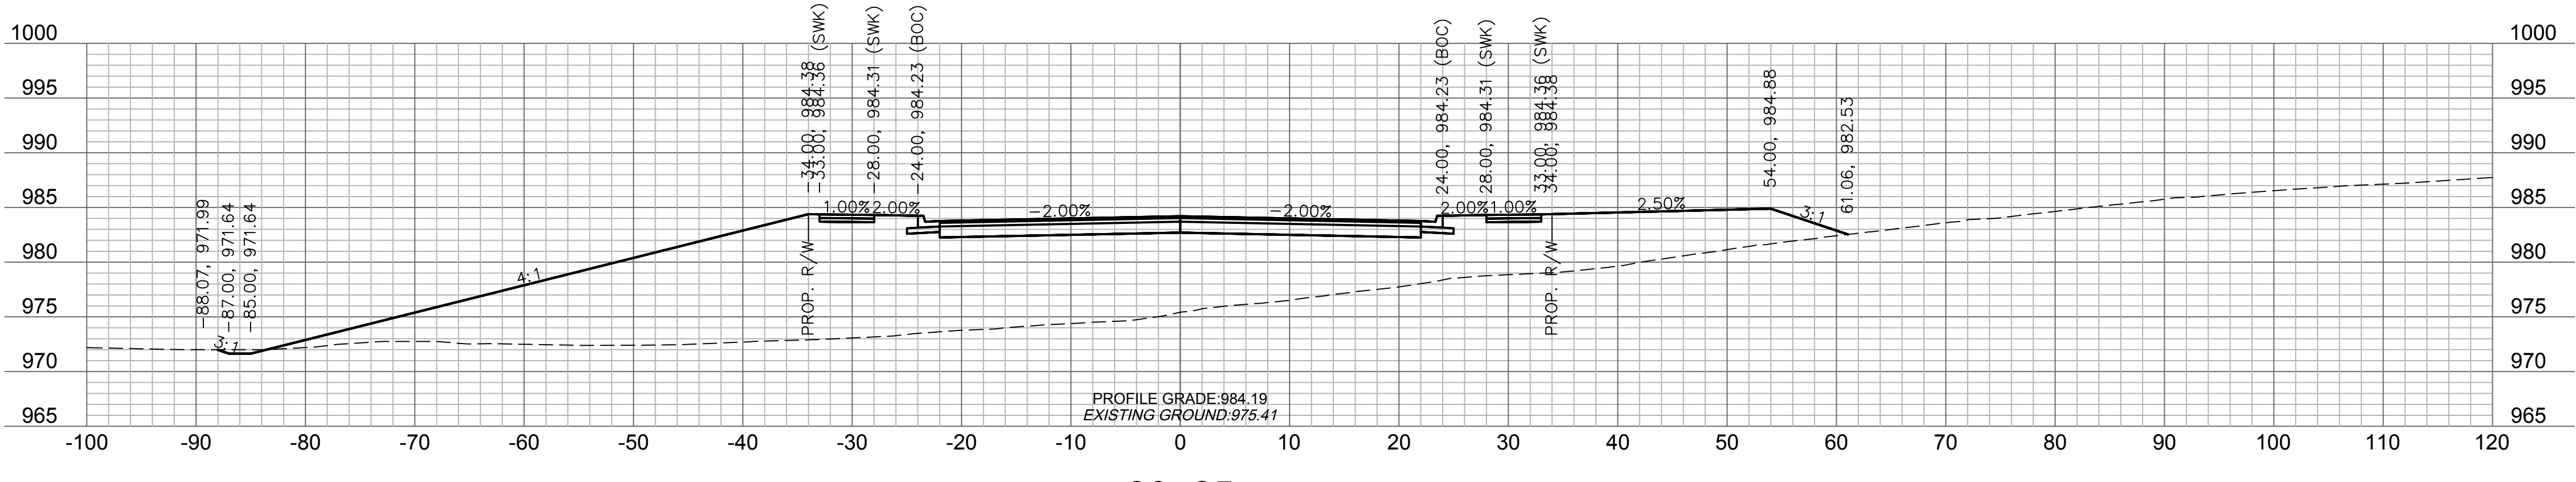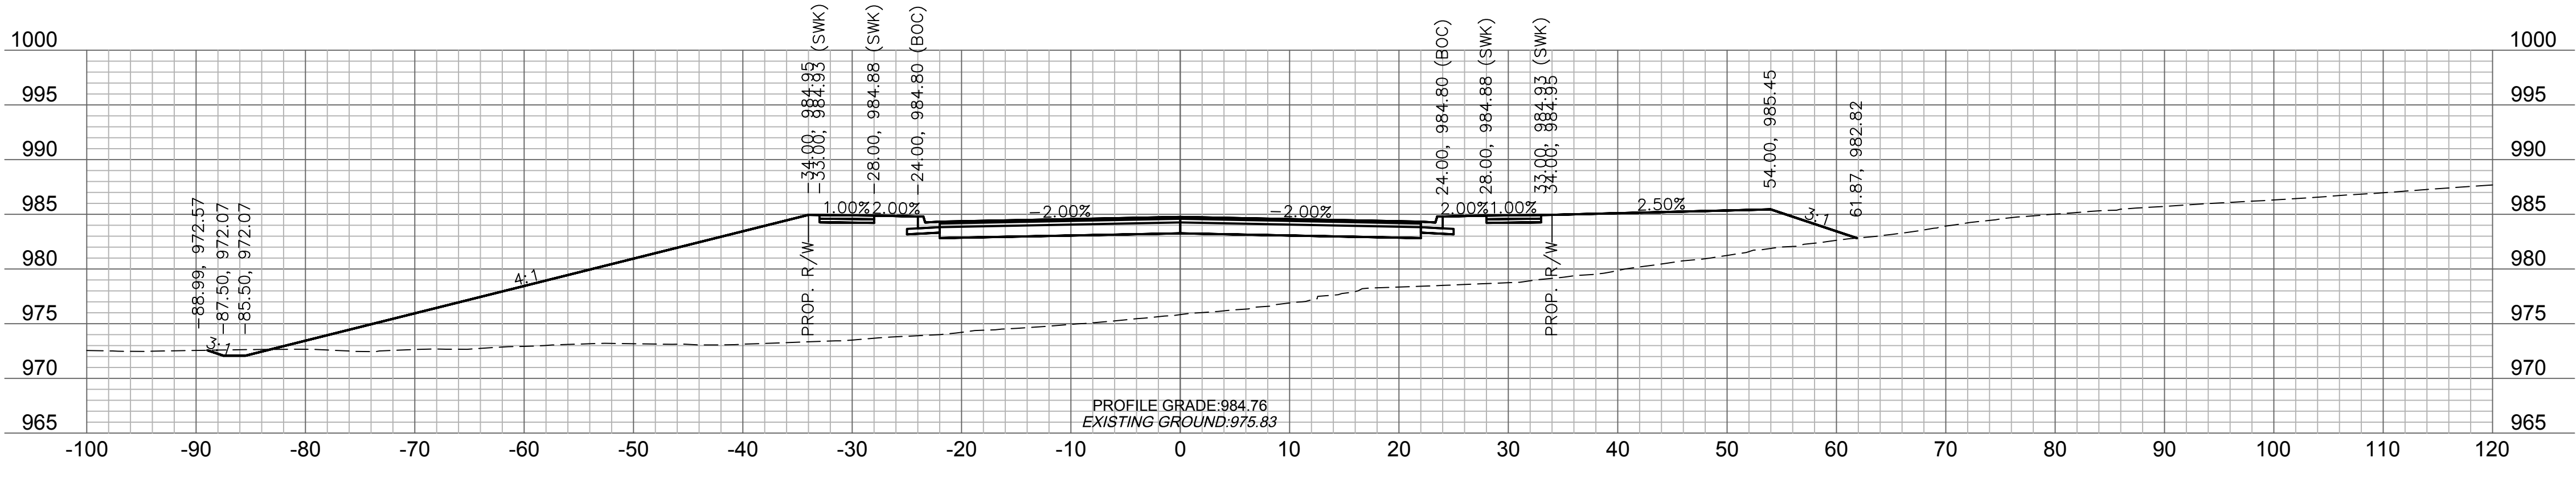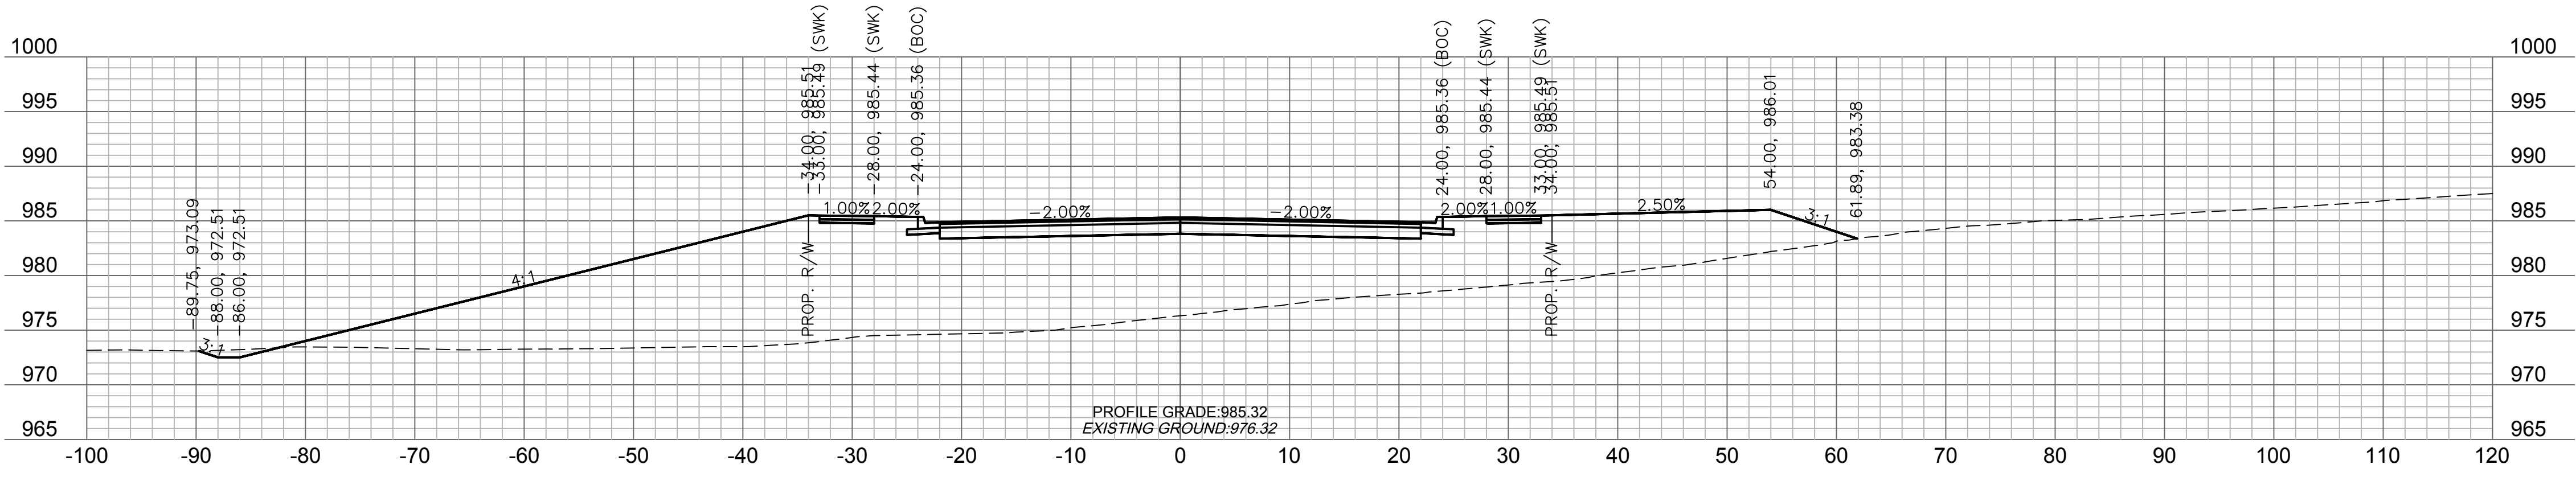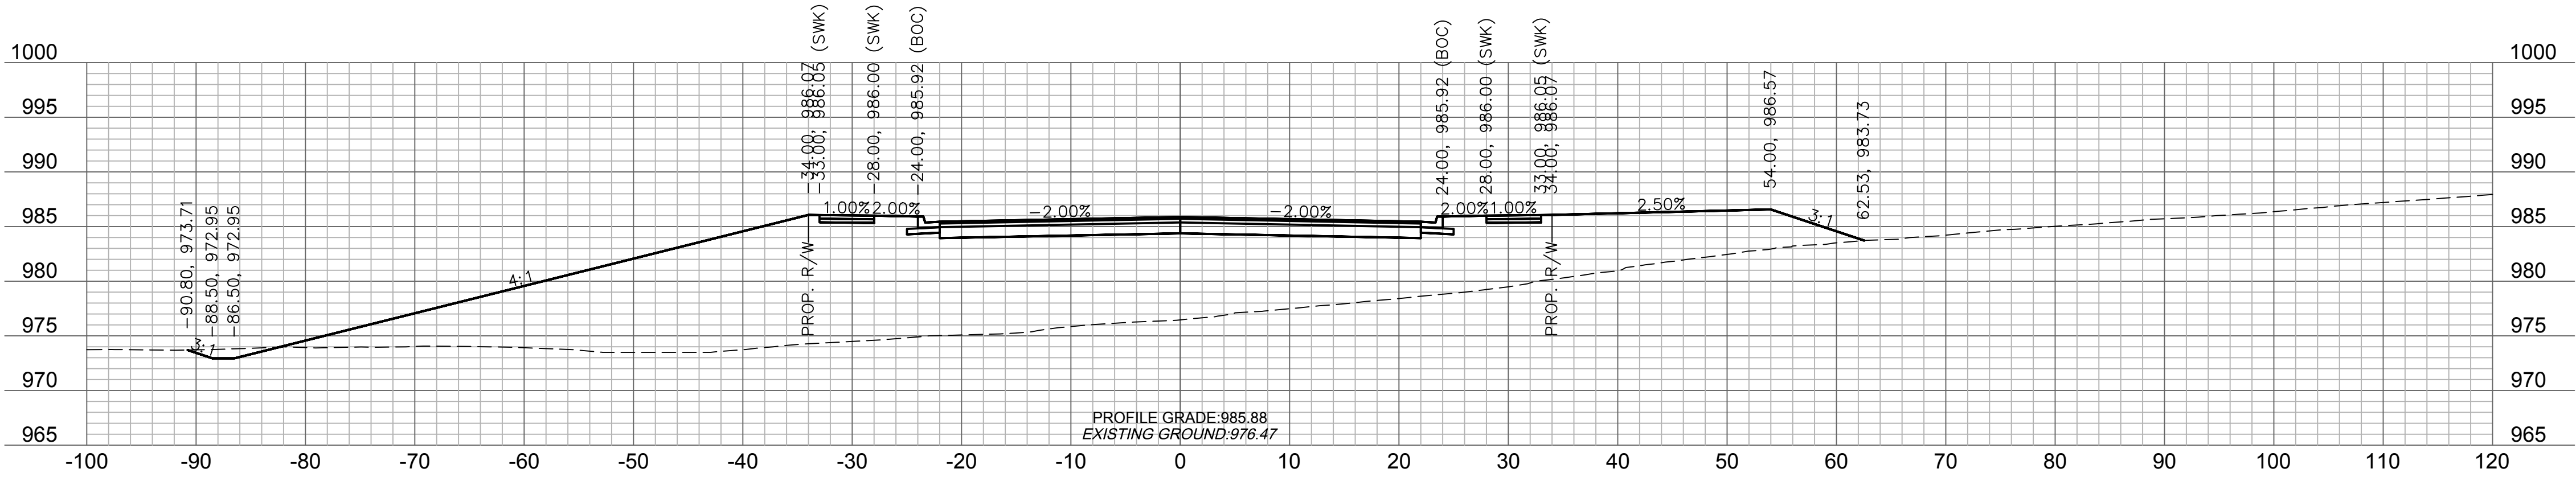

olsson

Olsson Engineering - MO State Certificate of Authority #001592
7301 West 133rd Street, Suite 200 TEL 913.381.1170
Overland Park, KS 66213-4750 FAX 913.381.1174 www.olsson.com

RECORD
DRAWINGS

RYAN B. FLEMING
MO. NO. PE-2002003161

REV. NO.	DATE	REVISIONS DESCRIPTION	BY

REVISIONS

MAIN STREET
CROSS SECTIONS

SCANNELL DEVELOPMENT LEE'S SUMMIT LOGISTICS
NORTHWEST CORNER OF TUDOR ROAD AND MAIN STREET


LEE'S SUMMIT, MISSOURI

2021


C.O.A. NO.:
DRAWN BY: ARJ/AMW
CHECKED BY: XXX
APPROVED BY: RBE
QA/QC BY: RBE
PROJECT NO.: 021-04157
DWG NO.: T_XSC01_02104157
DATE: 2021-10-12

SHEET
96 OF 105


DWG: F:\2021\04001-04500\021-04157\40-Desian\AutoCAD\Final Plans\Sheets\ROBR\T_XSC01_02104157.dwg
XREFS: T_PTBLK_02104157
T_PBASE_02104157
DATE: Oct 30, 2023 3:59pm

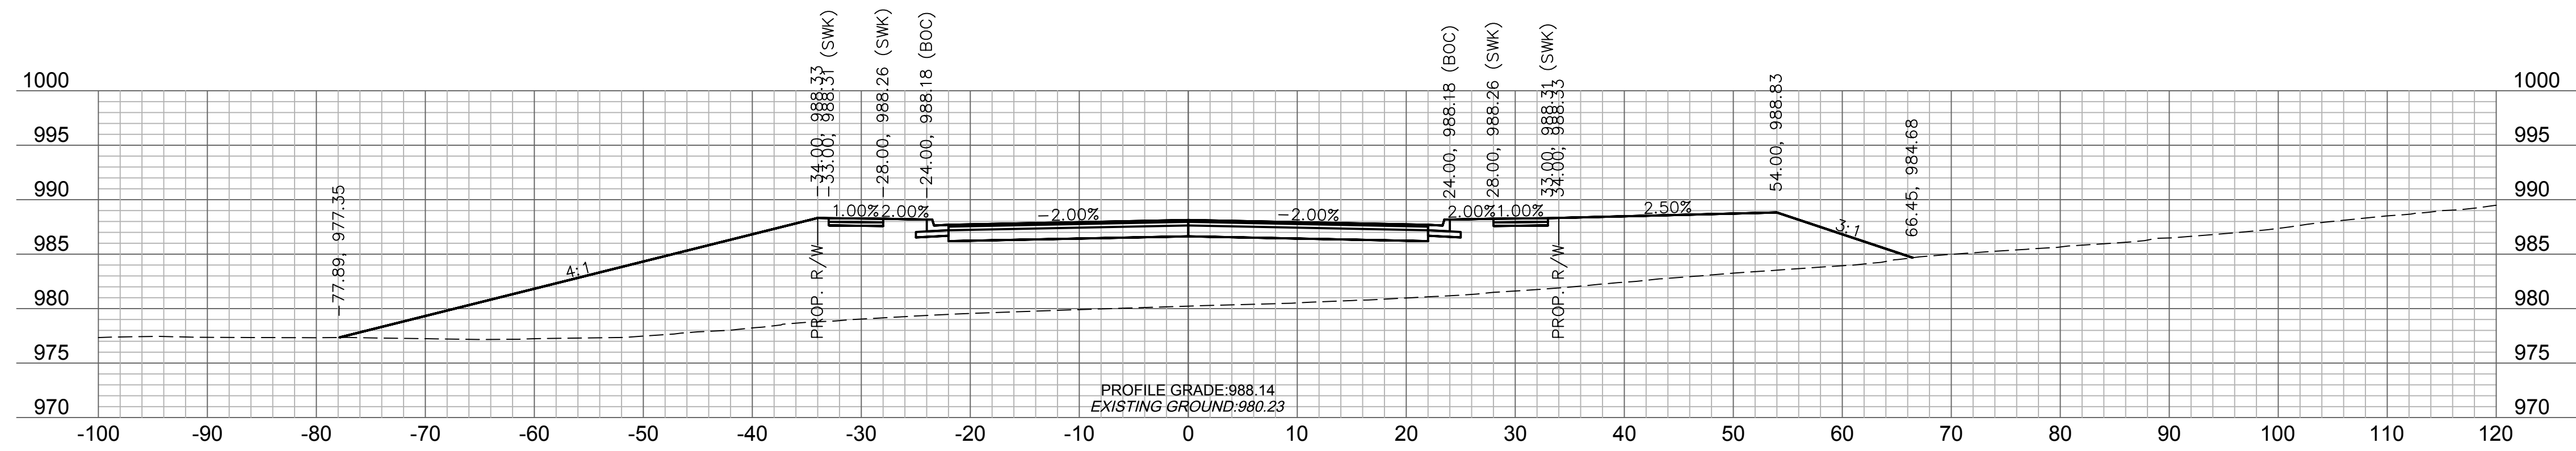


32+00

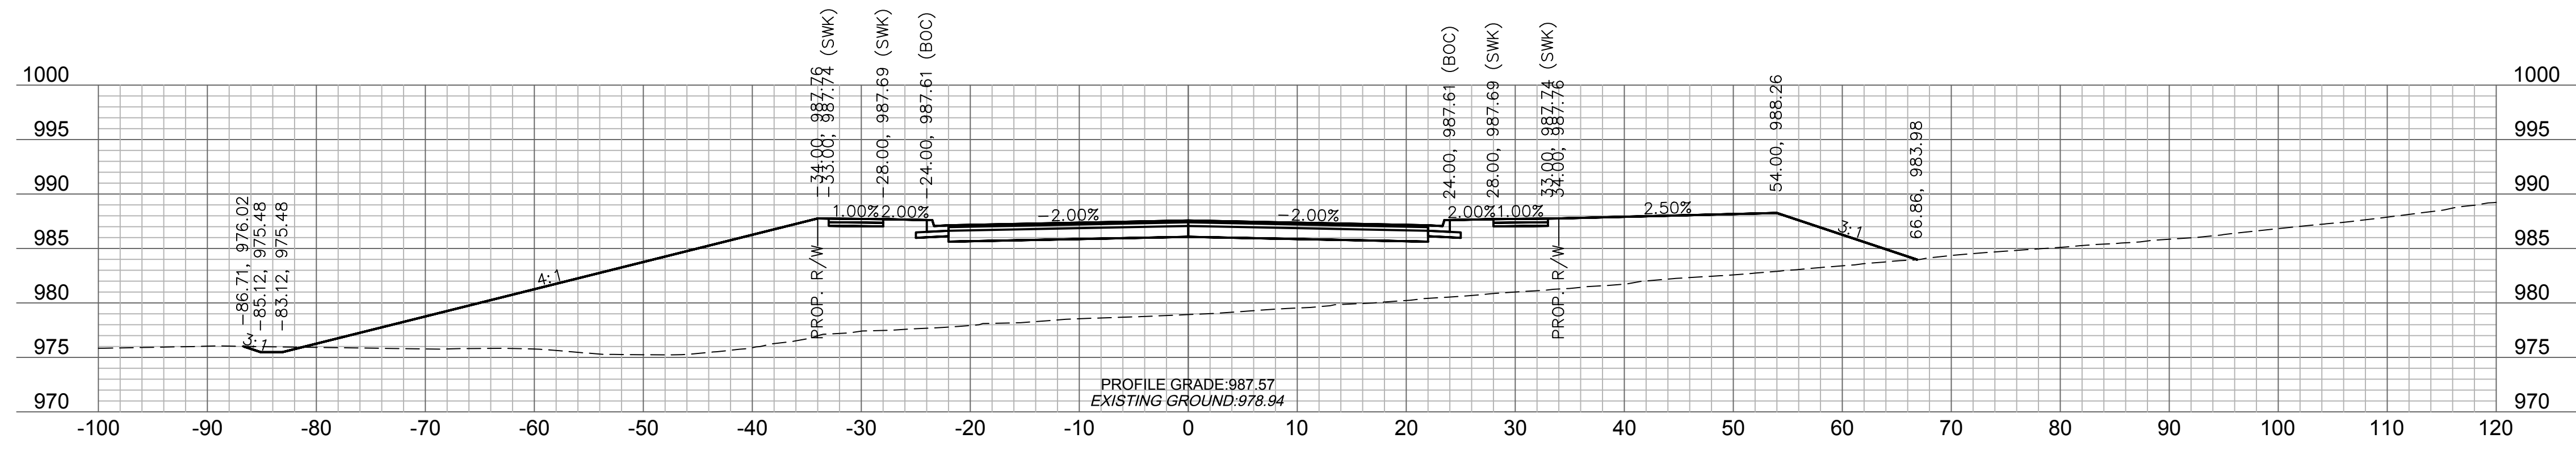

31+75

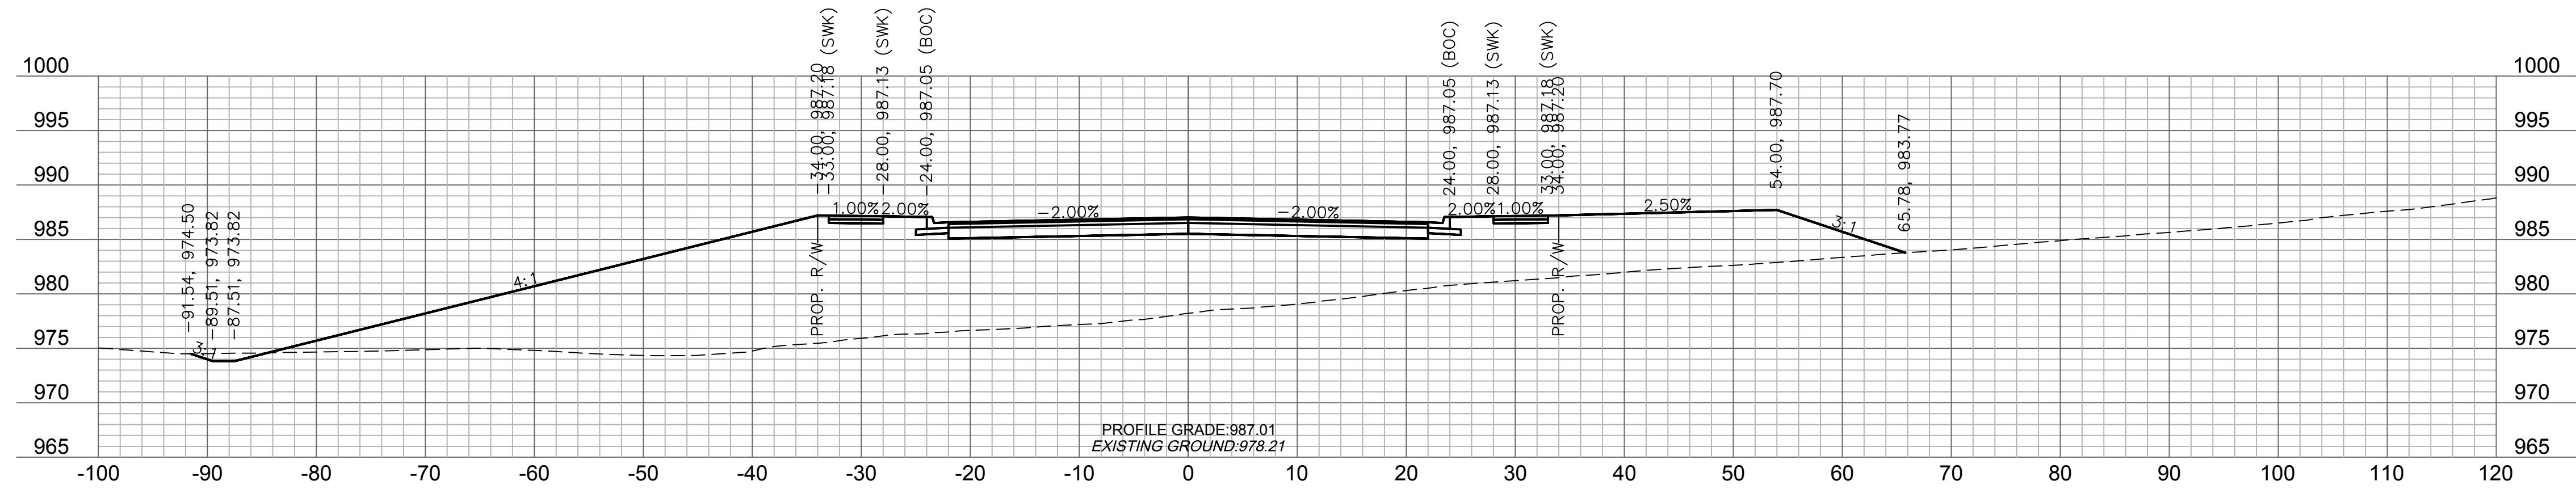

31+50

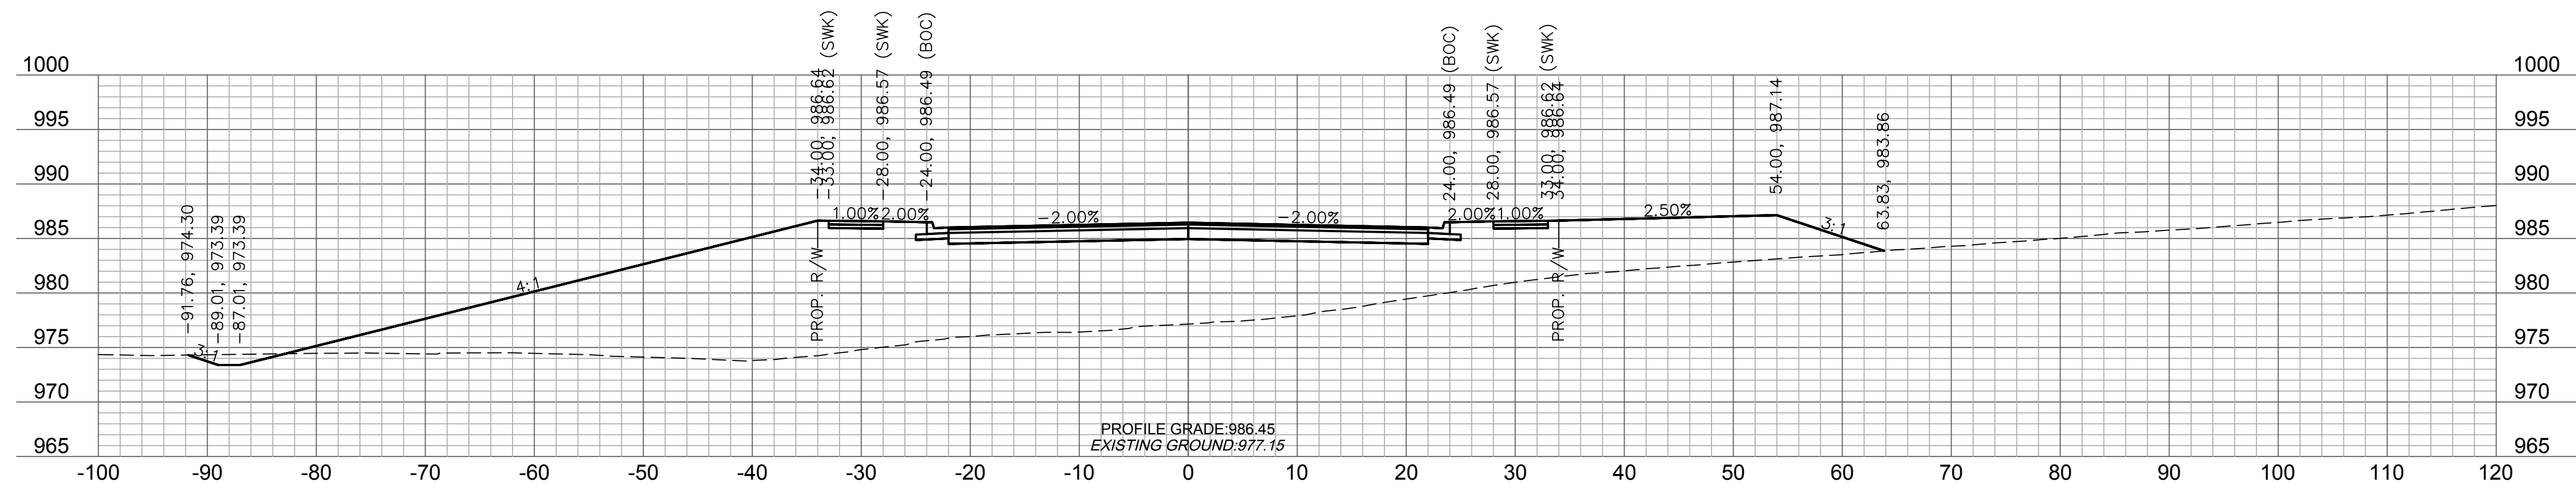

31+25



olson

Olsson Engineering - MO State Certificate of Authority #001592
7301 West 133rd Street, Suite 200 TEL 913.381.1170
Overland Park, KS 66213-4750 FAX 913.381.1174 www.olsson.com

RECORD
DRAWINGS

RYAN B. FLEMING
MO. NO. PE-2002003161

[illegible]

MAIN STREET CROSS SECTIONS


SCANNELL DEVELOPMENT LEE'S SUMMIT LOGISTICS
NORTHWEST CORNER OF TUDOR ROAD AND MAIN STREET

LEE'S SUMMIT, MISSOURI


C.O.A. NO.: _____
DRAWN BY: _____ ARJ/AMW
CHECKED BY: _____ XXX
APPROVED BY: _____ RBF
QA/QC BY: _____ RBF
PROJECT NO.: _____ 021-04157
DWG NO.: T_XSC01_02104157
DATE: _____ 2021-10-12

SHEET
97 OF 105



DWG: F:\2021\04001-04500\021-04157\40-Design\AutoCAD\Final Plans\Sheets\ROBR\T_XS001_02104157.dwg
XREFS: T_PTBLK_02104157
T_PBASE_02104157
DATE: Oct 30, 2023 3:59pm

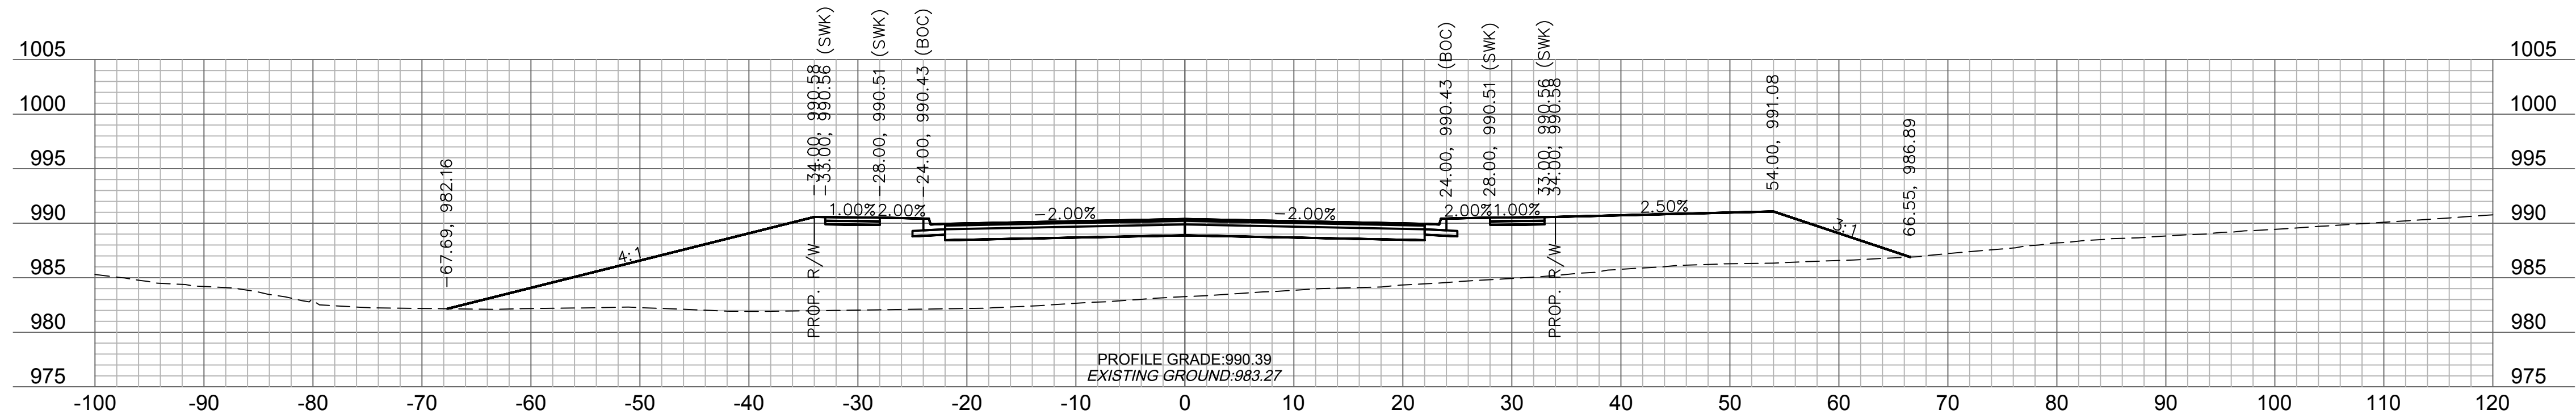

33+00

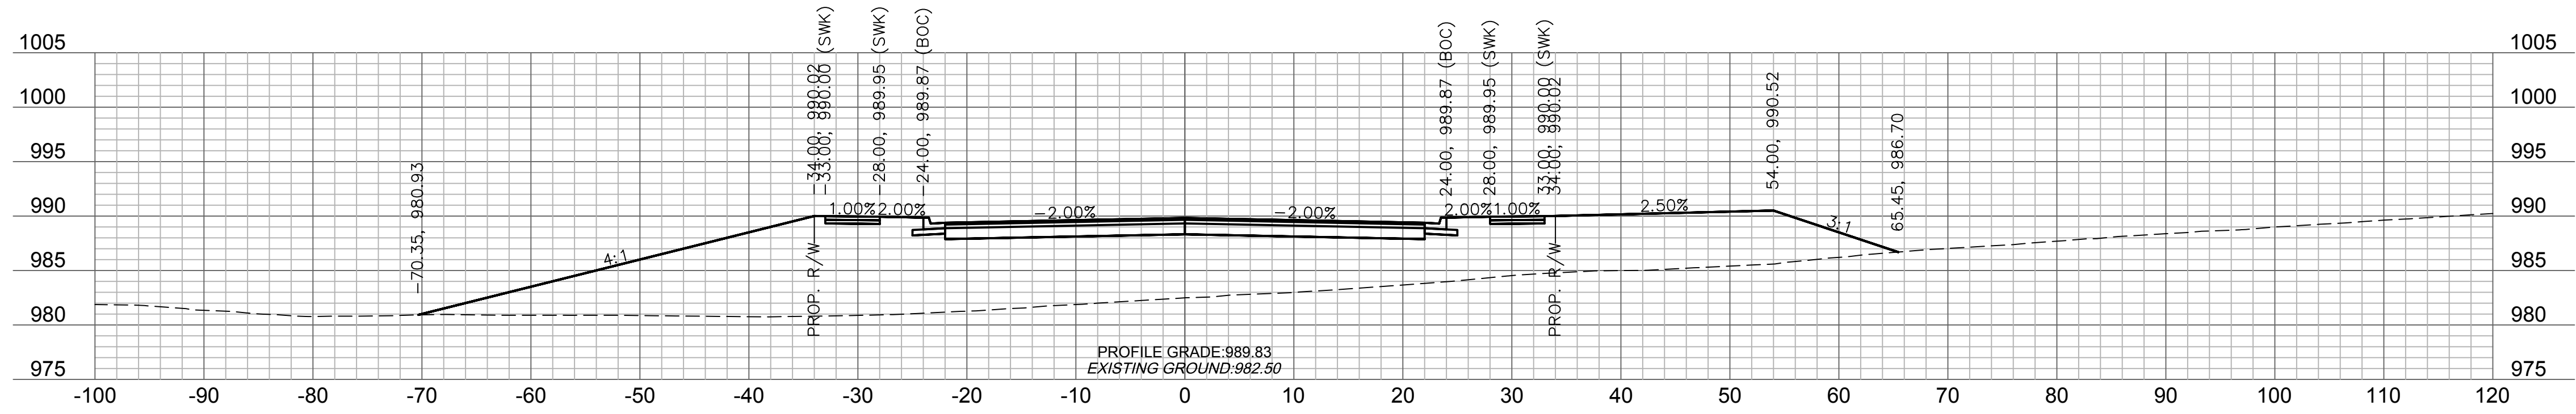

32+75

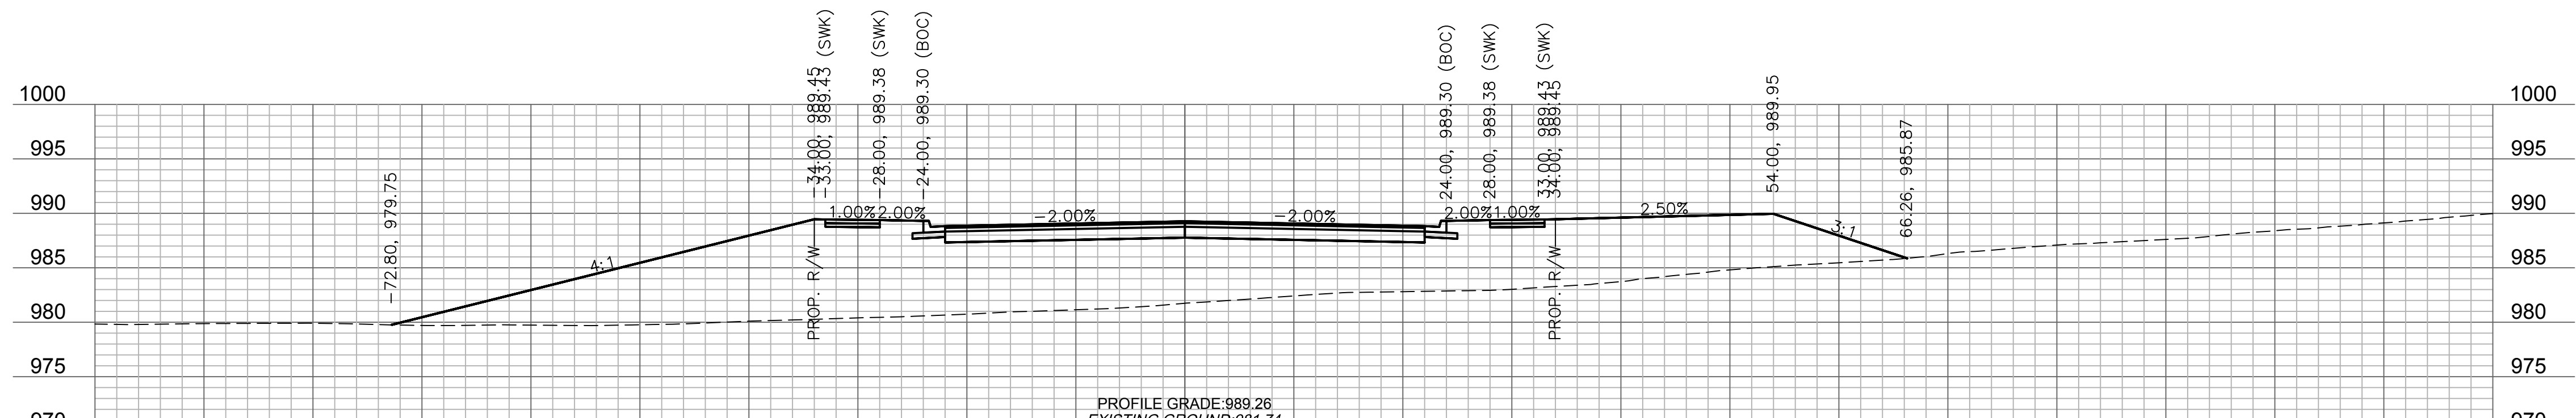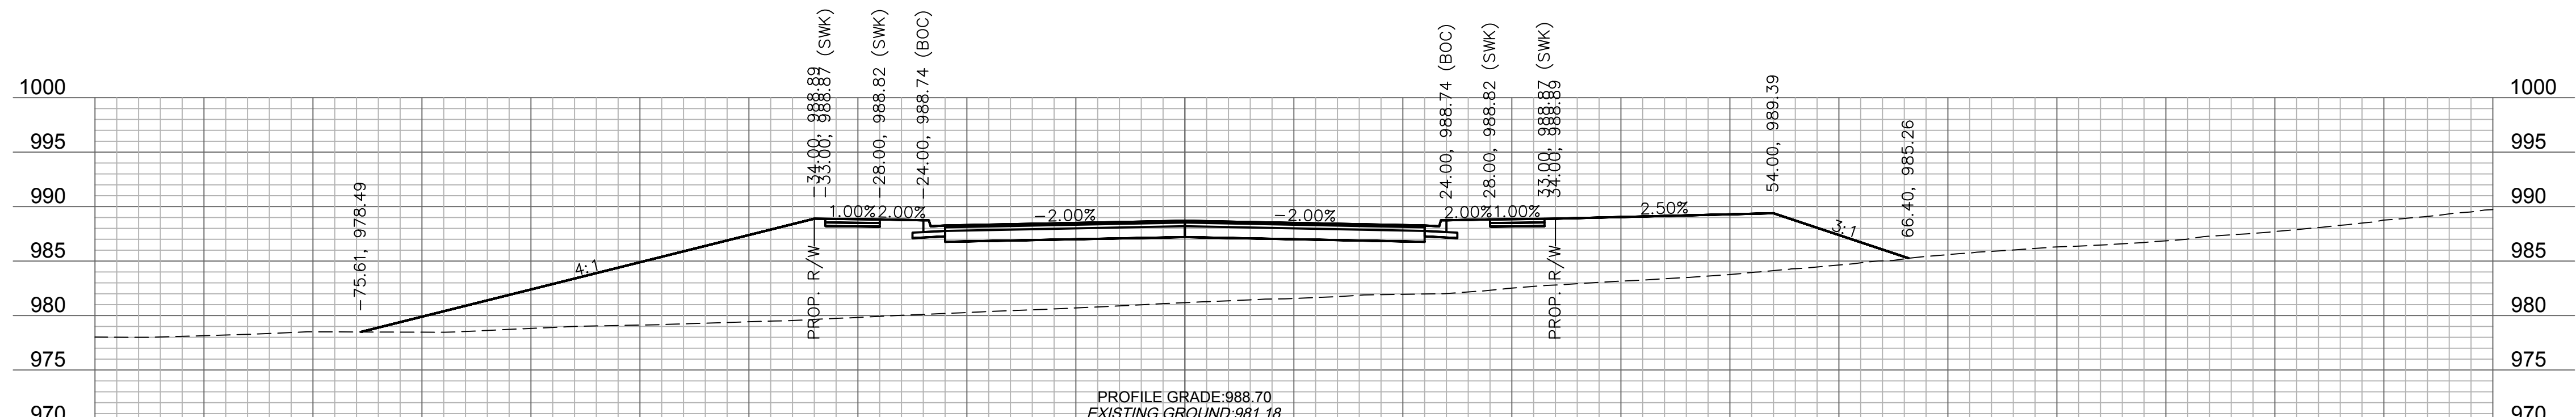 $32+50$ 

32+25



olson

Olsson Engineering - MO State Certificate of Authority #001592
 7301 West 133rd Street, Suite 200 TEL 913.381.1170
 Overland Park, KS 66213-4750 FAX 913.381.1174 www.olsson.com

RECORD
DRAWINGS

RYAN B. FLEMING
MO. NO. PE-2002003161

[illegible]

MAIN STREET CROSS SECTIONS



SCANNELL DEVELOPMENT LEE'S SUMMIT LOGISTICS
NORTHWEST CORNER OF TUDOR ROAD AND MAIN STREET

LEE'S SUMMIT, MISSOURI	2022
------------------------	------


C.O.A. NO.: _____
 DRAWN BY: _____ ARJ/AMW
 CHECKED BY: _____ XXX
 APPROVED BY: _____ RBF
 QA/QC BY: _____ RBF
 PROJECT NO.: _____ 021-04157
 DWG NO.: T_XSC01_02104157
 DATE: _____ 2021-10-12

SHEET
98 OF 105



USER: asaavedra

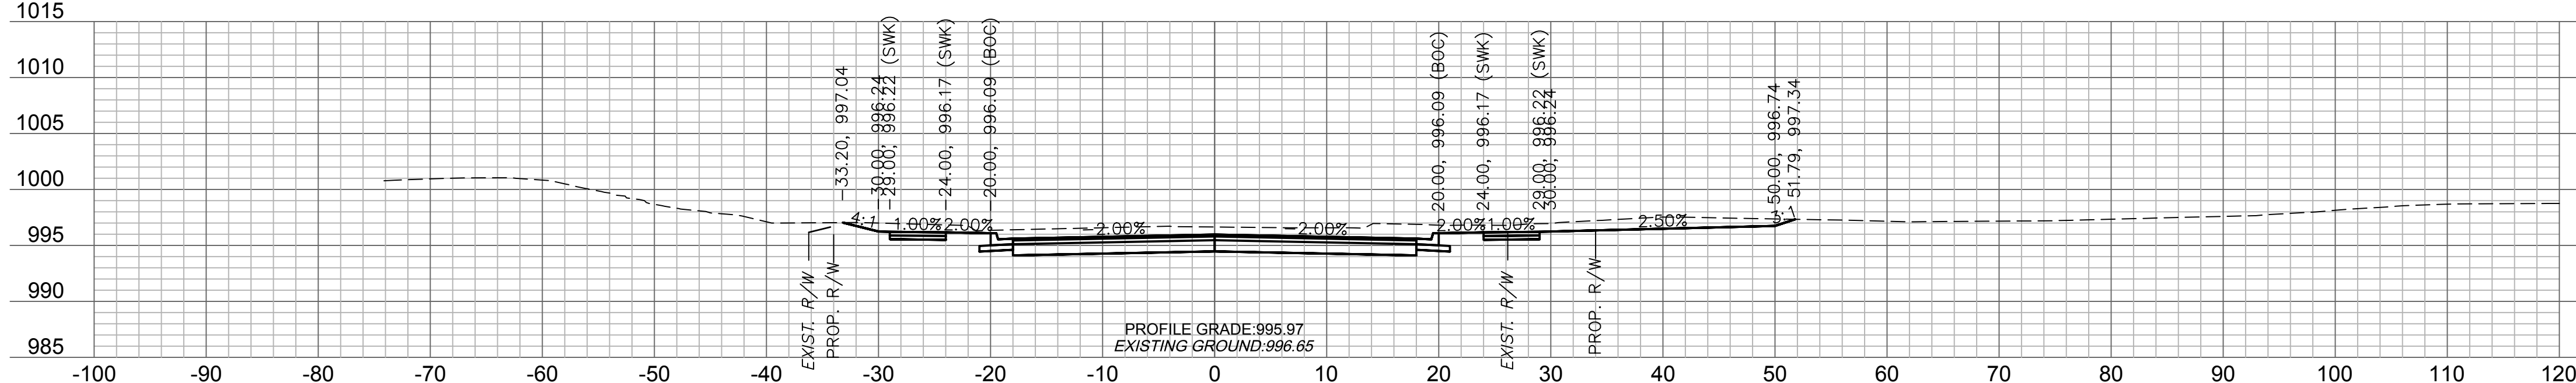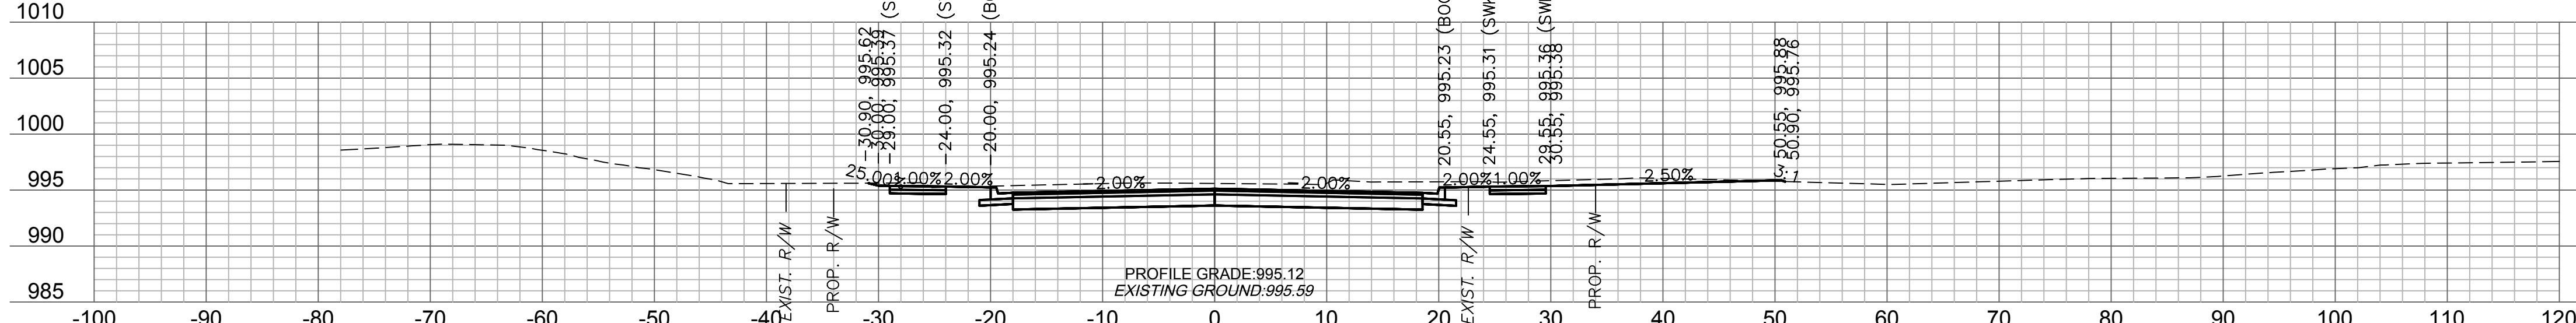 $35+25$ 


35+00

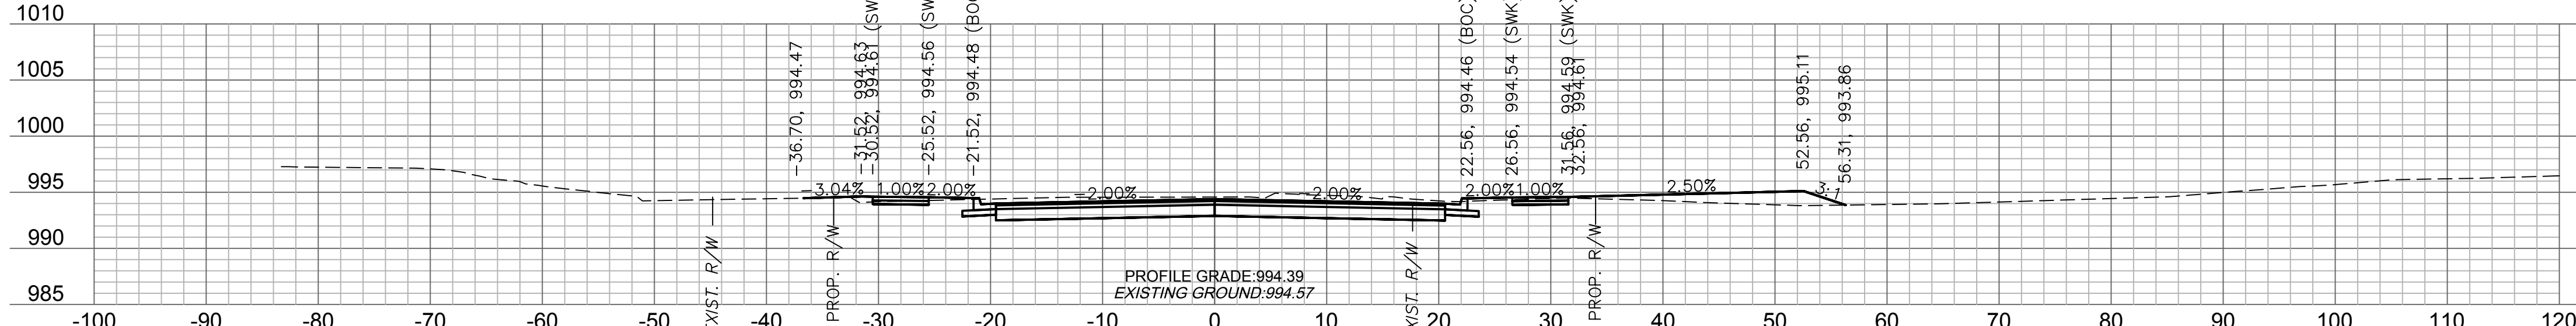

34+75

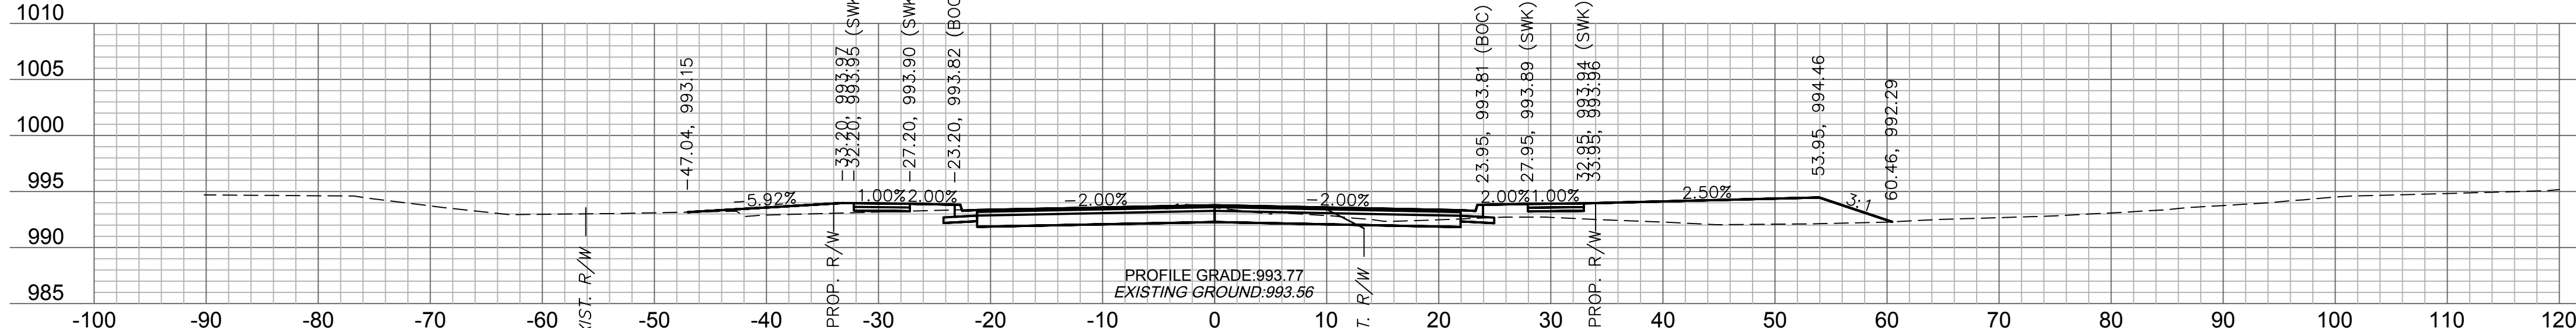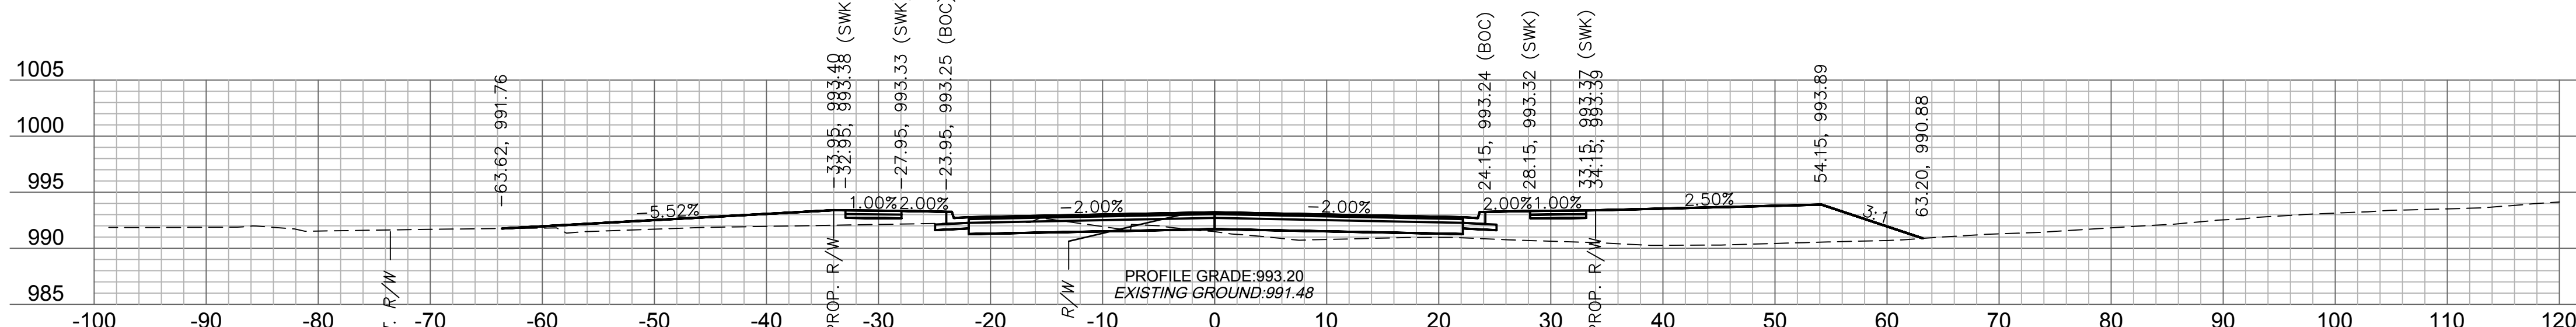 $34+50$ 

34+25

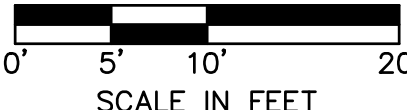

MAIN STREET CROSS SECTIONS

SCANNELL DEVELOPMENT LEE'S SUMMIT LOGISTICS

LEE'S SUMMIT, MISSOURI

2021

[illegible]


RECORD
DRAWINGS

RYAN B. FLEMING
D. NO. PE-200200316


oslo

Olsson Engineering - MO State Certificate of Authority #001592
7301 West 133rd Street, Suite 200 TEL 913.381.1170 www.olsson.com
Overland Park KS 66213-4750 FAX 913.381.1174


DWG: F:\2021\04001-04500\021-04157\40-Design\AutoCAD\Final Plans\Sheets\ROBR\T_XSC01_02104157.dwg
DATE: Oct 30, 2023 3:59pm XREFS: T_PTBk_02104157 USER: asaavedra

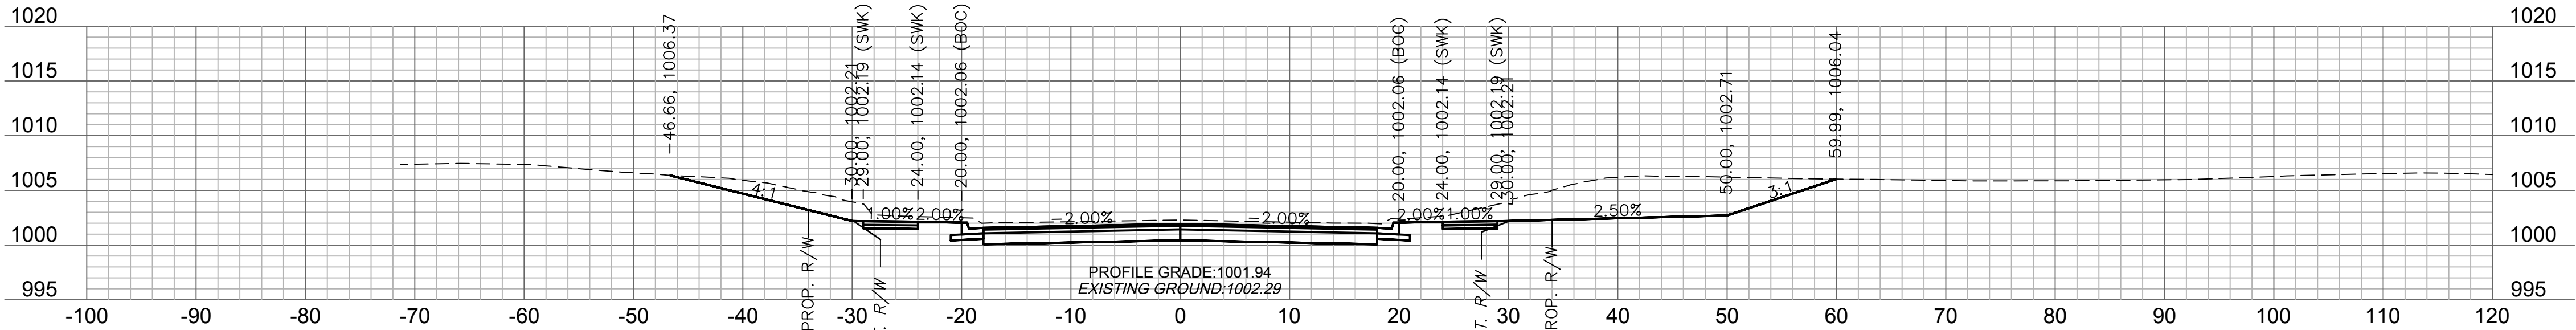


36+50

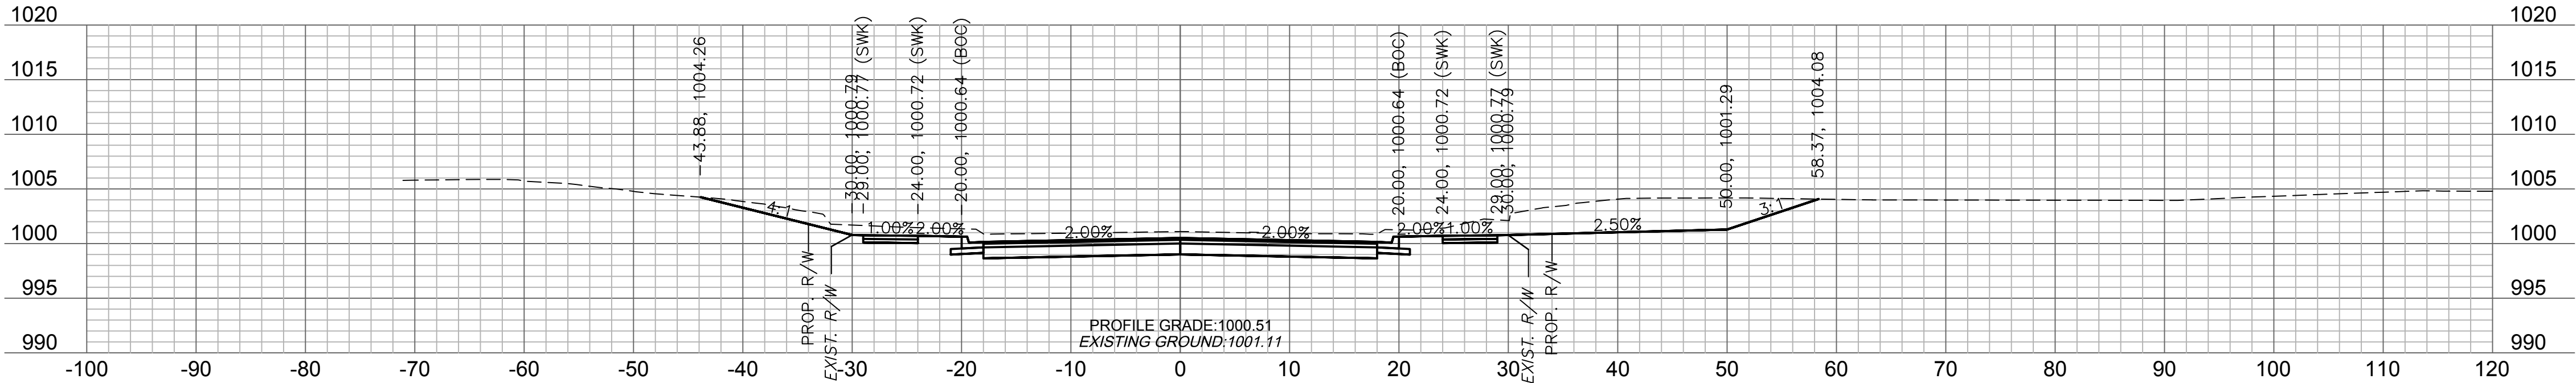


36+25

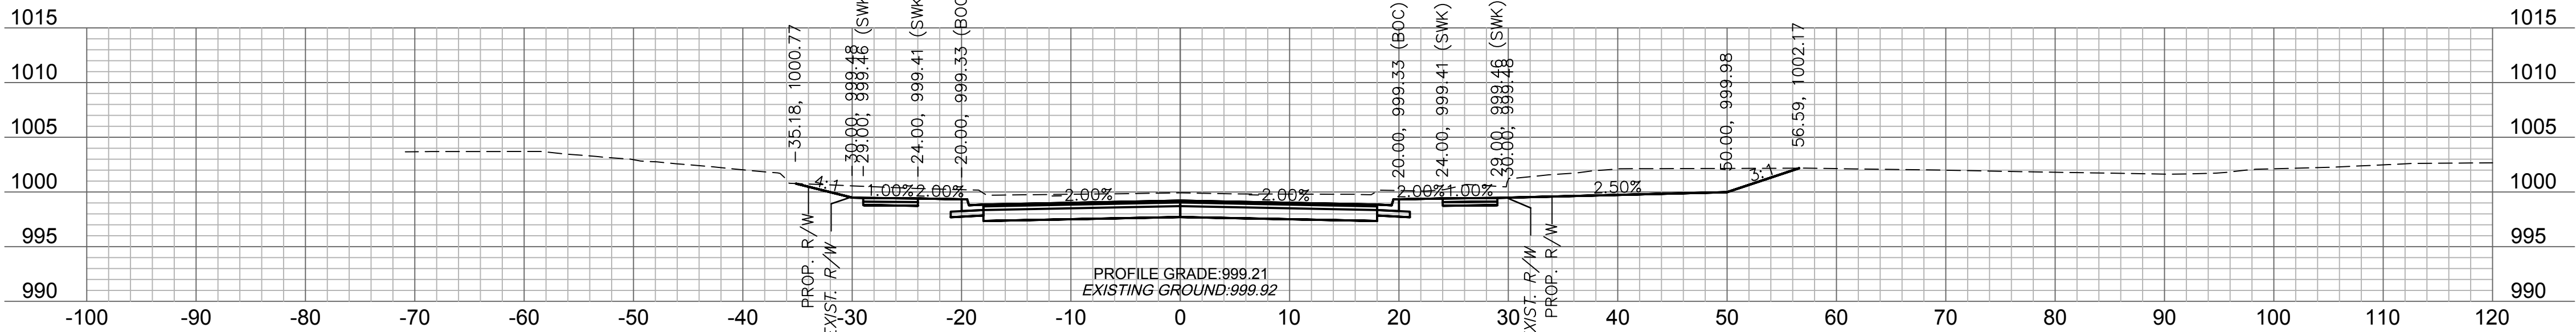

36+00

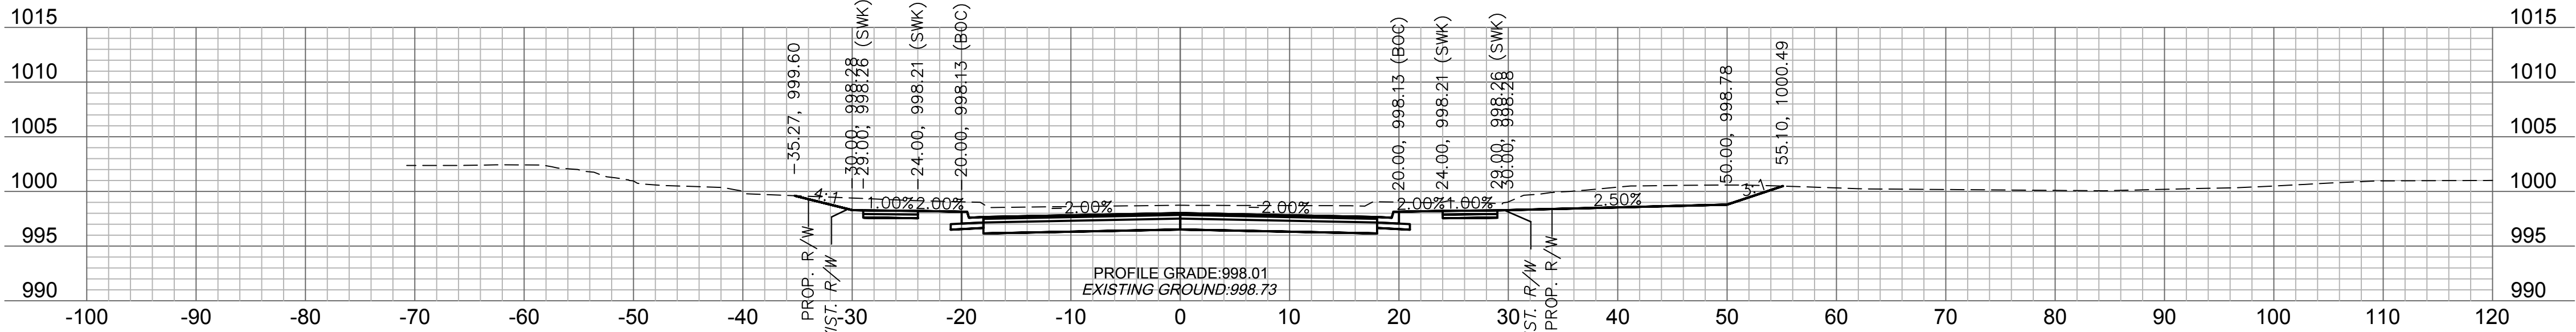

35+75

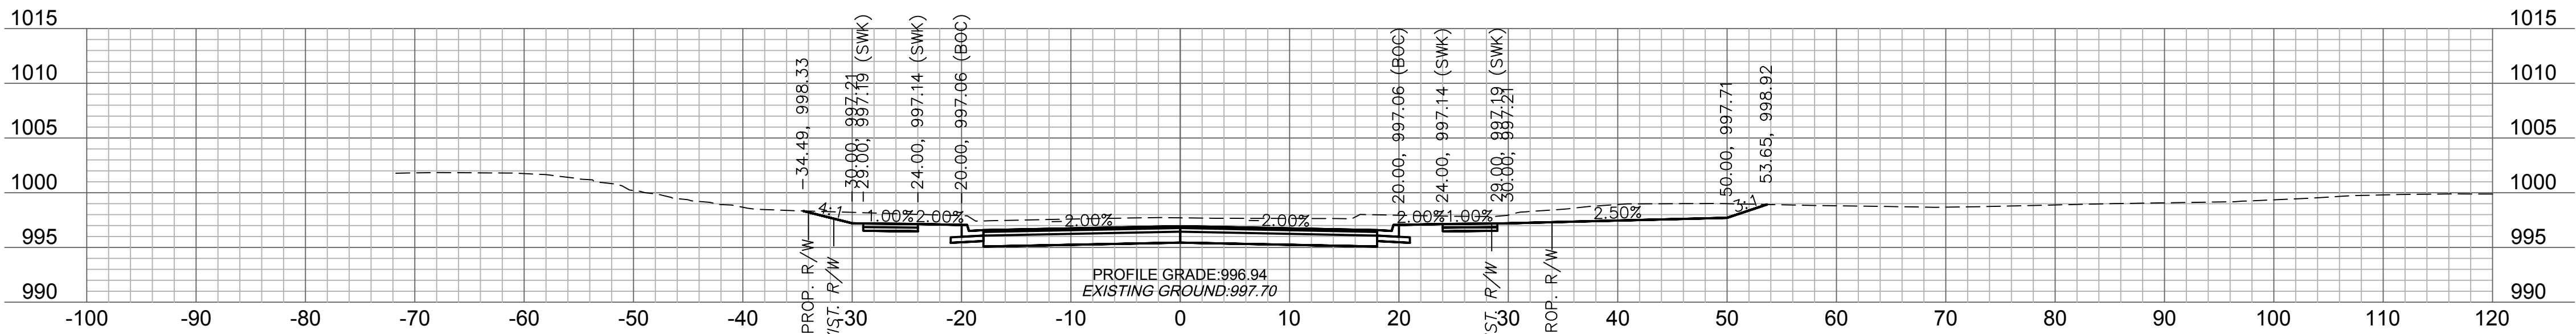

35+50



olsson

Olsson Engineering - MO State Certificate of Authority #001592
7301 West 133rd Street, Suite 200 TEL 913.381.1170
Overland Park, KS 66213-4750 FAX 913.381.1174 www.olsson.com

RECORD
DRAWINGS

RYAN B. FLEMING
MO. NO. PE-2002003161

BY	
REVISIONS DESCRIPTION	
DATE	
REV. NO.	






REVISIONS

MAIN STREET CROSS SECTIONS		2021
SCANNELL DEVELOPMENT LEE'S SUMMIT LOGISTICS NORTHWEST CORNER OF TUDOR ROAD AND MAIN STREET		
LEE'S SUMMIT, MISSOURI		

C.O.A. NO.:
DRAWN BY: ARJ/AMW
CHECKED BY: XXX
APPROVED BY: RBE
QA/QC BY: RBE
PROJECT NO.: 021-04157
DWG NO.: T_XSC01_02104157
DATE: 2021-10-12

SHEET
100 OF 105

DWG: F:\2021\04001-04500\021-04157\40-Design\AutoCAD\Final Plans\Sheets\RDBR\T_XSC01_02104157.dwg
DATE: Oct 30, 2023 3:59pm XREFS: T_PTBK 02104157 T_PBSE 02104157

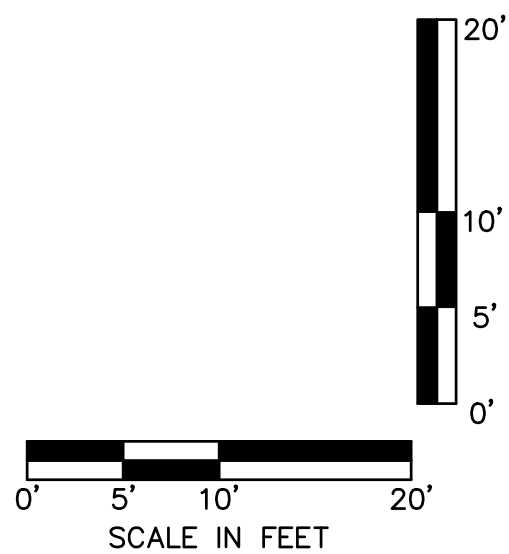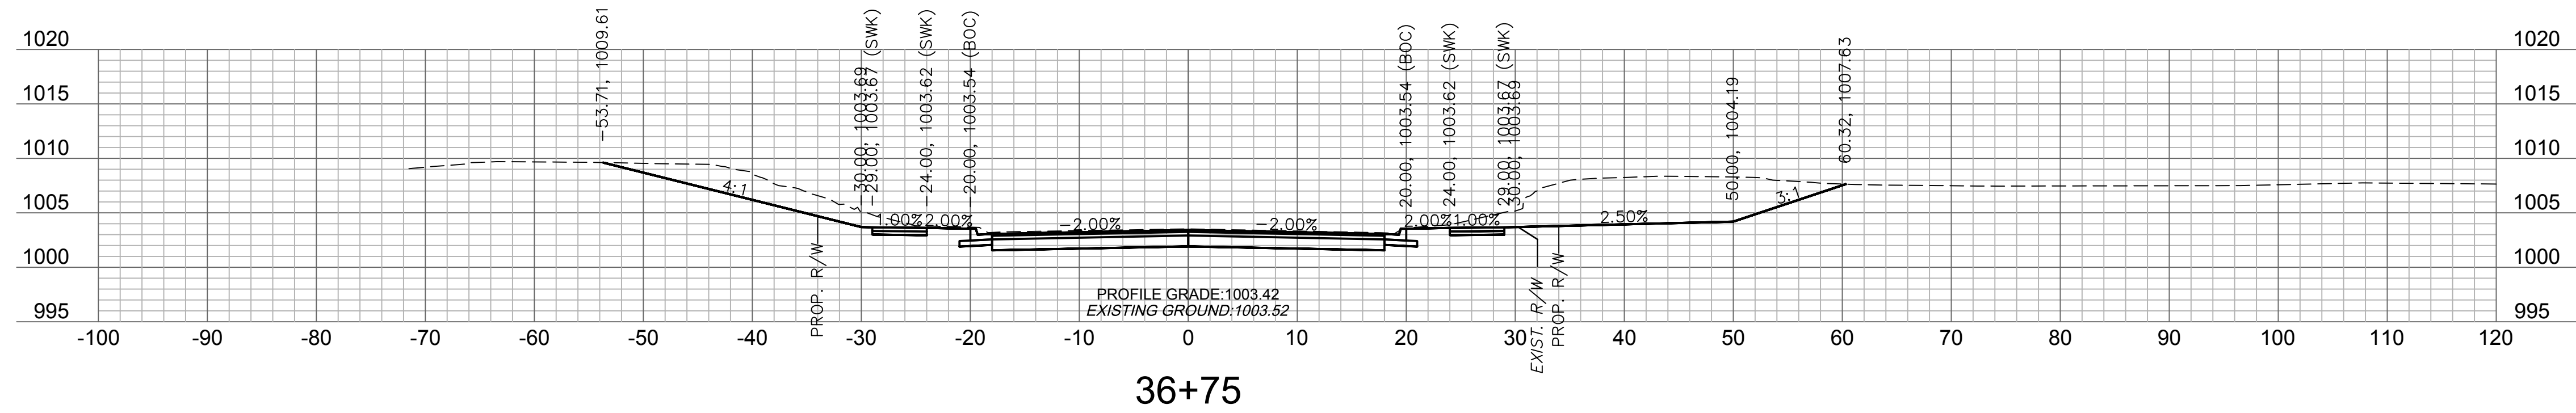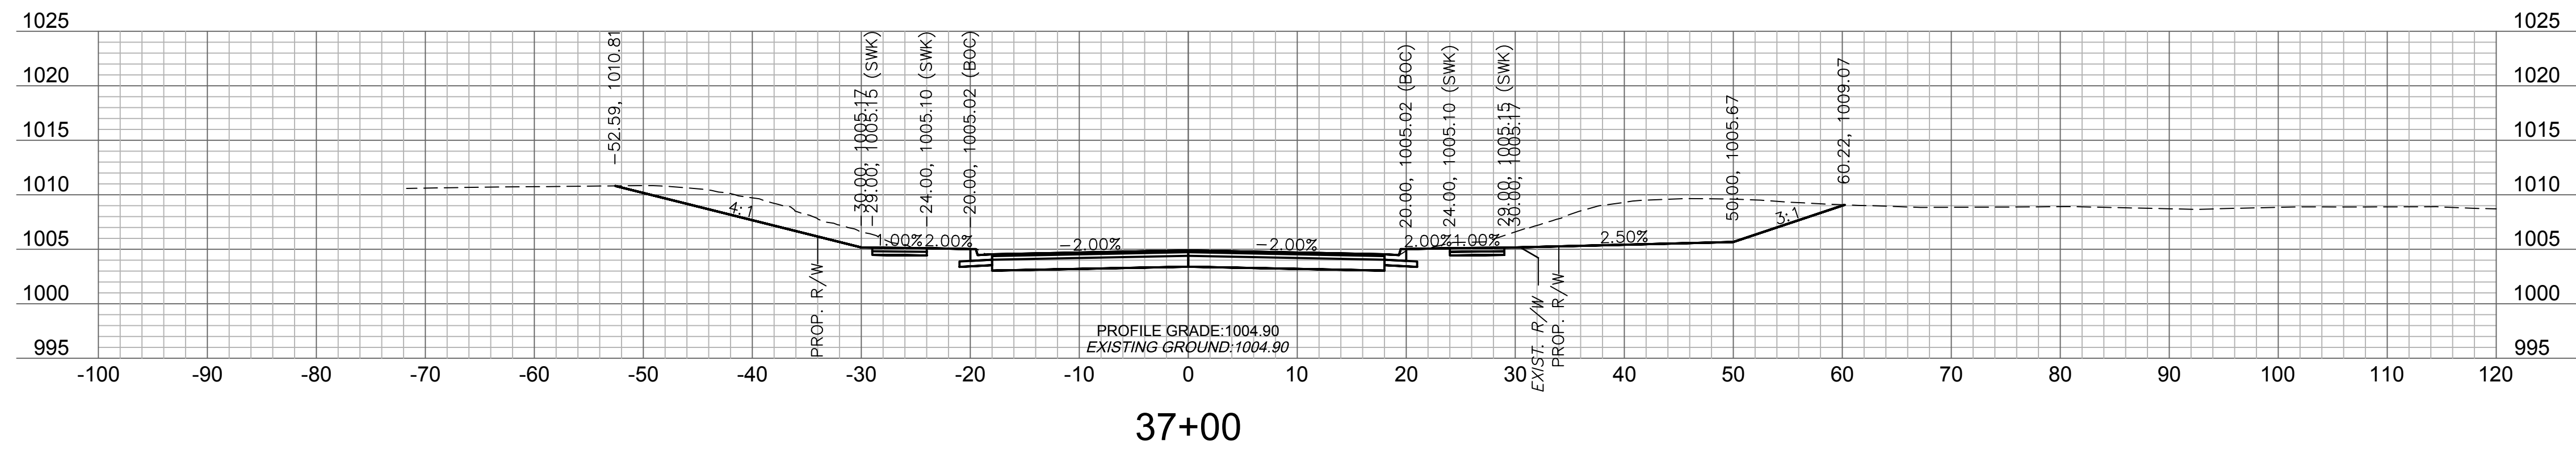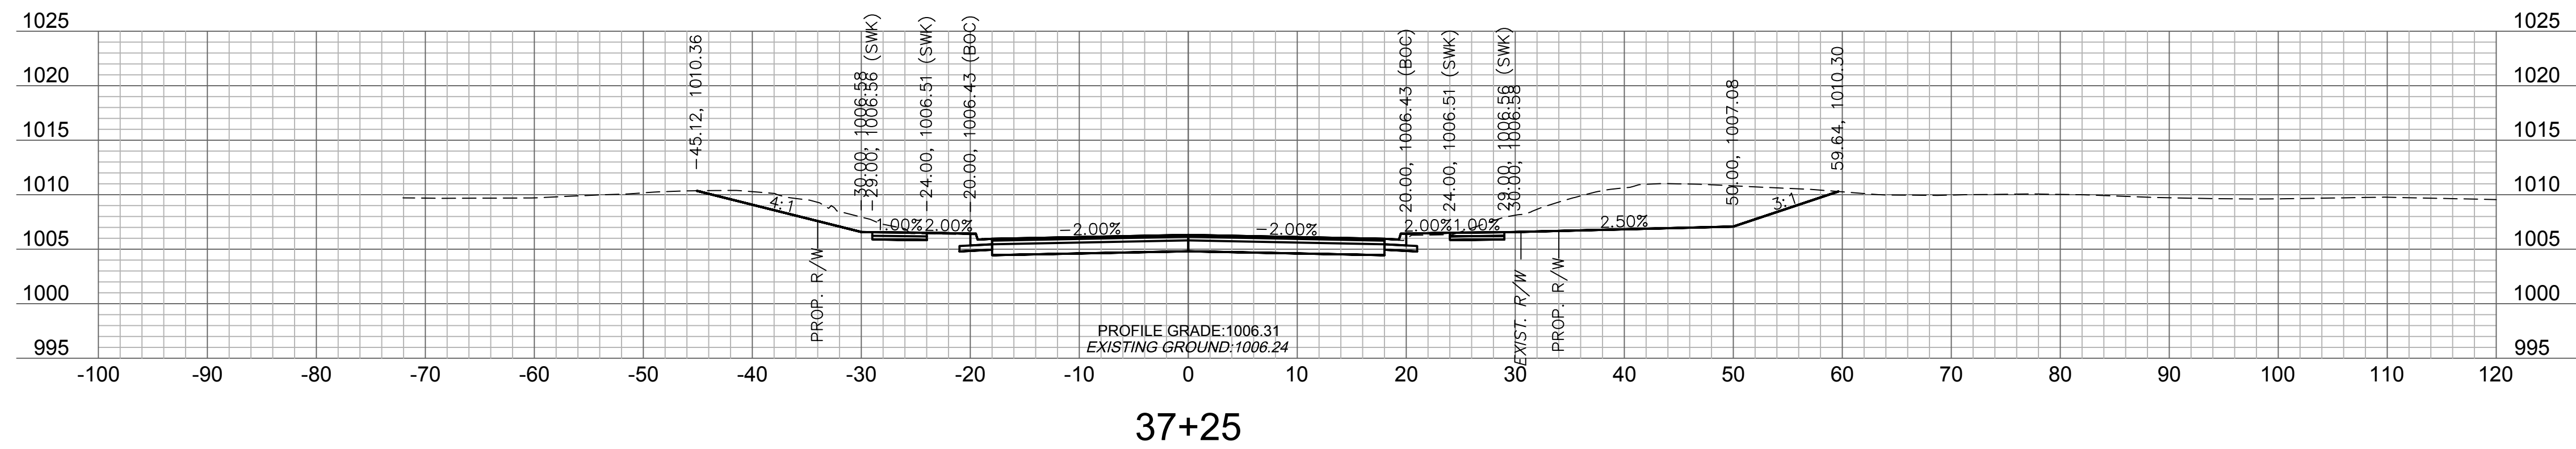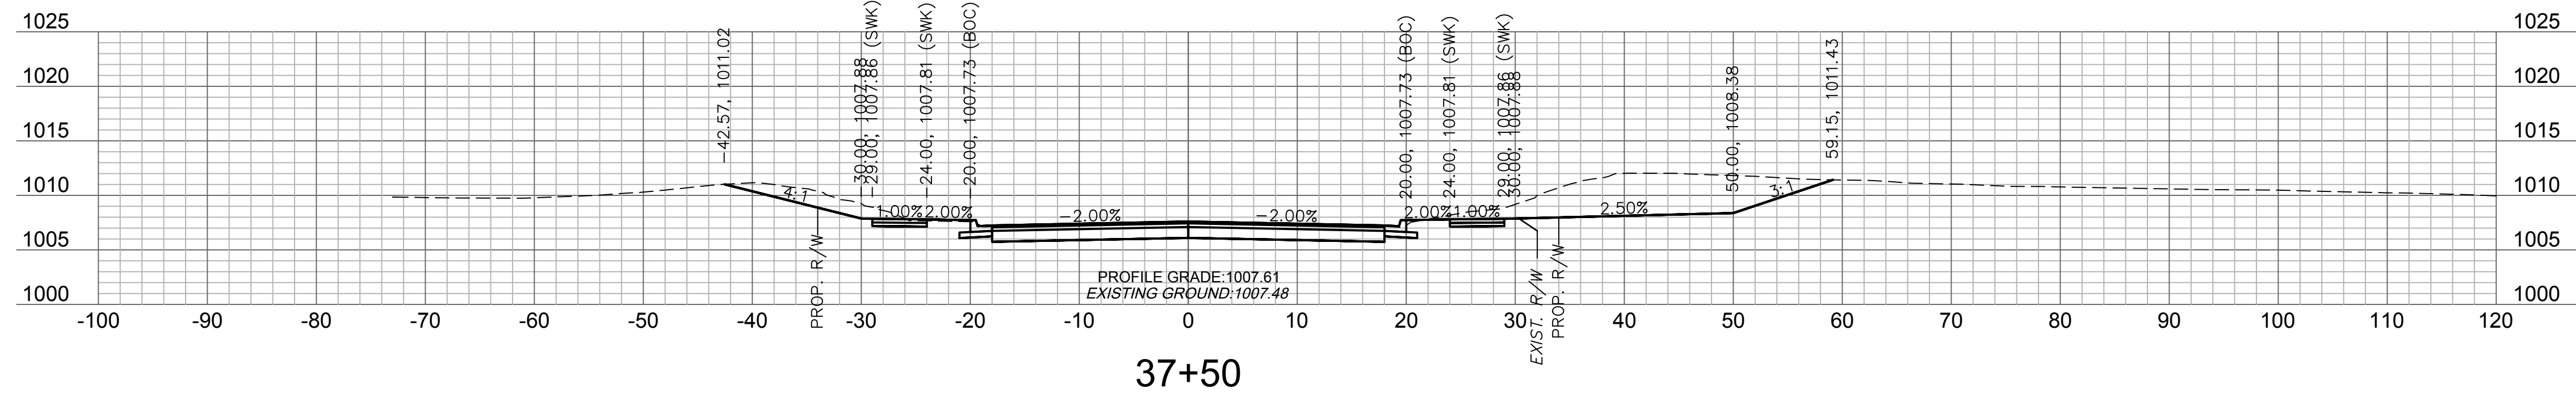

MAIN STREET CROSS SECTIONS

SCANNELL DEVELOPMENT LEE'S SUMMIT LOGISTICS NORTHWEST CORNER OF TUDOR ROAD AND MAIN STREET	202
LEE'S SUMMIT, MISSOURI	

RECORD
DRAWINGS

RYAN B. FLEMING
MO. NO. PE-2002003161

[illegible]


olson

Olsson Engineering - MO State Certificate of Authority #001592
7301 West 133rd Street, Suite 200 TEL 913.381.1170
Overland Park, KS 66213-4750 FAX 913.381.1174 www.olsson.com


C.O.A. NO.: _____
DRAWN BY: _____ ARJ/AMW
CHECKED BY: _____ XXX
APPROVED BY: _____ RBF
QA/QC BY: _____ RBF
PROJECT NO.: _____ 021-04157
DWG NO.: T_XSC01_02104157
DATE: _____ 2021-10-12

SHEET
101 OF 105


DWG: F:\2021\04001-04500\021-04157\40-Design\AutoCAD\Final Plans\Sheets\ROBR\T_XSC01_02104157.dwg
DATE: Oct 30, 2023 3:59pm XREFS: T_PTBK_02104157 USER: asaavedra

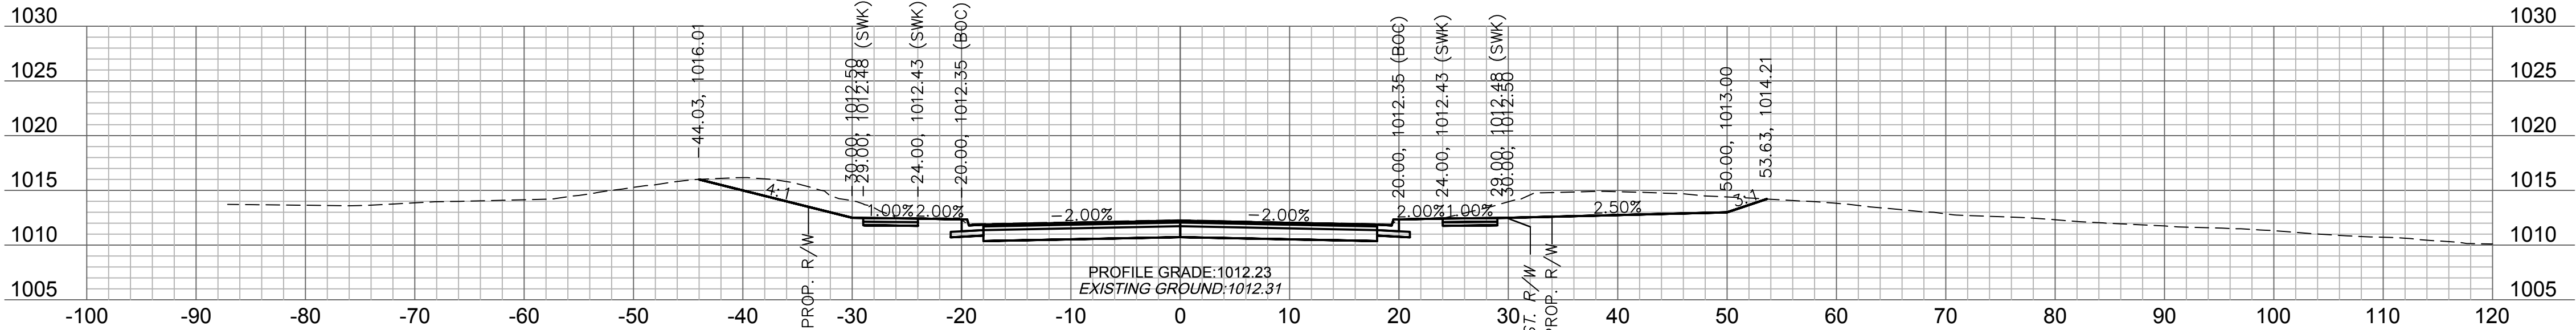


38+75

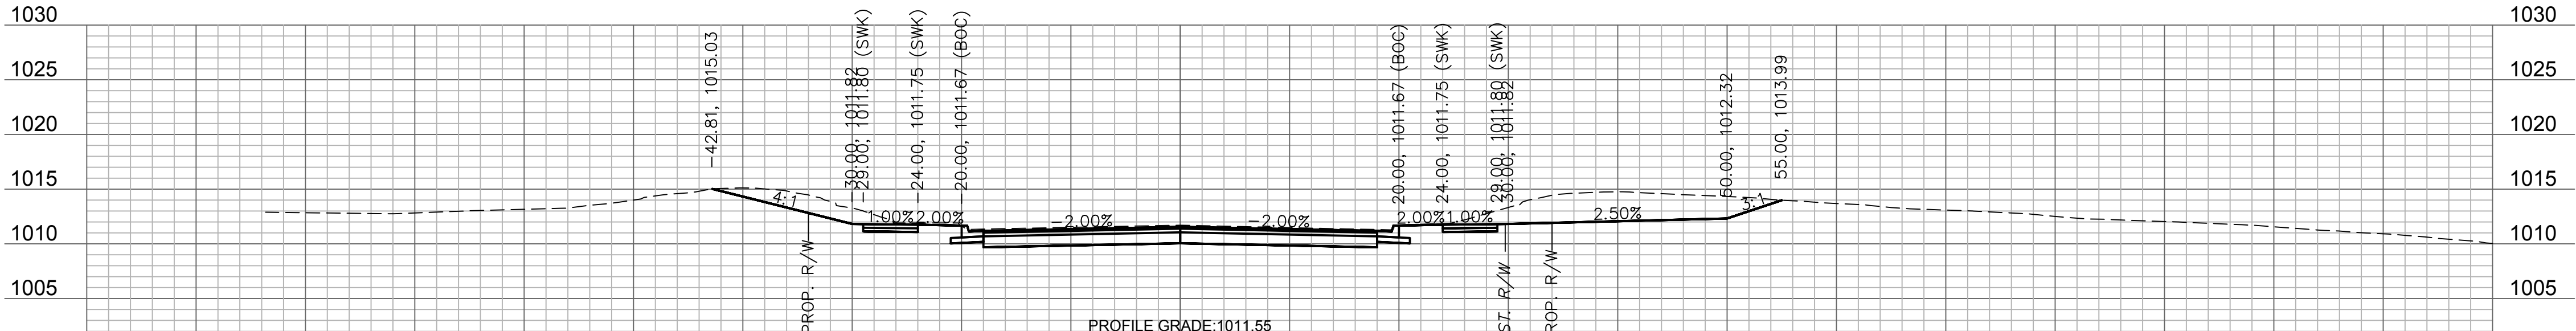


38+50

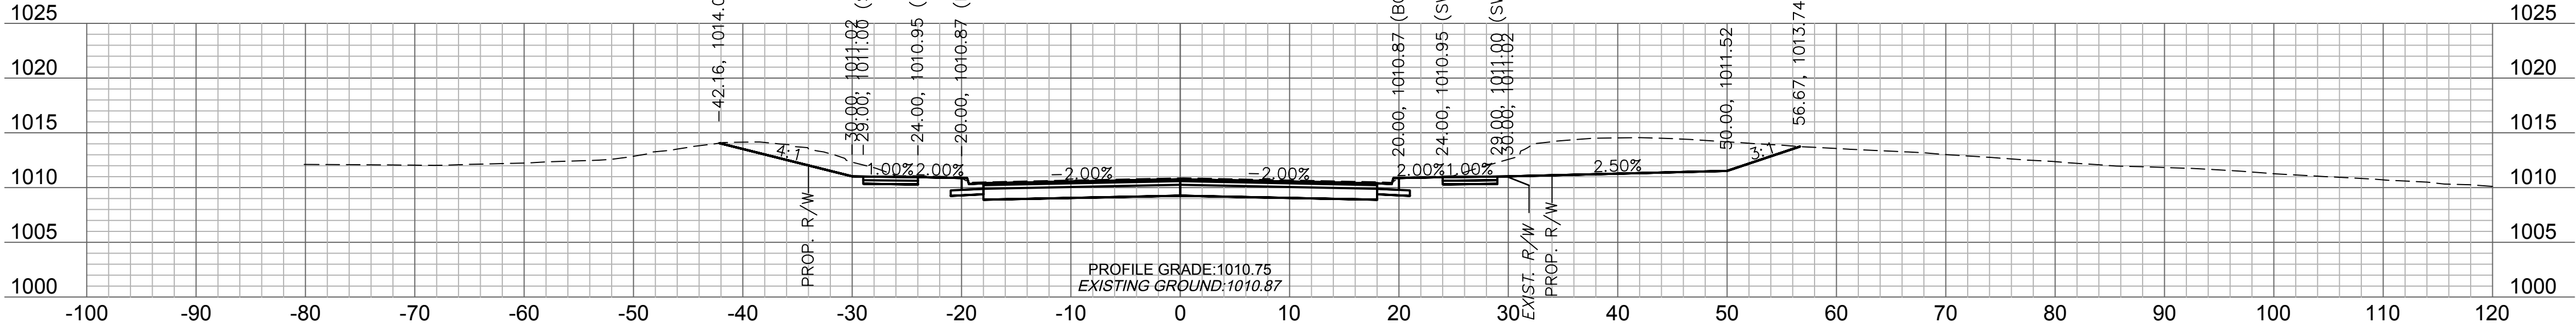


38+25

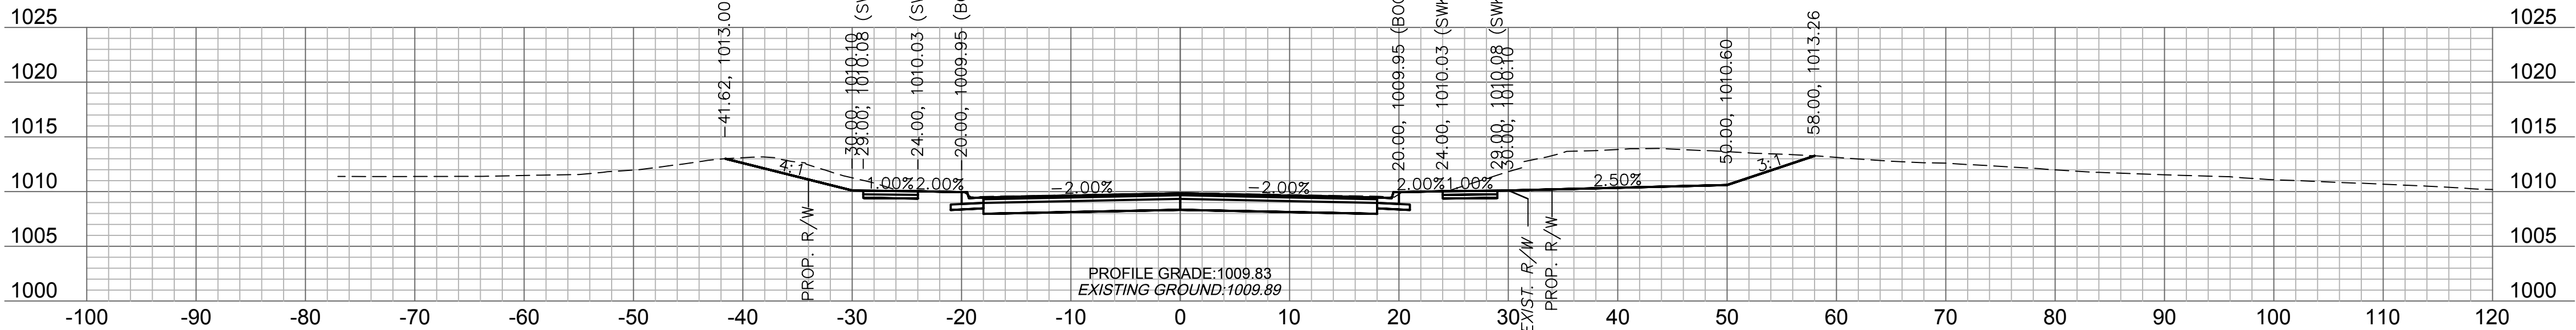

38+00

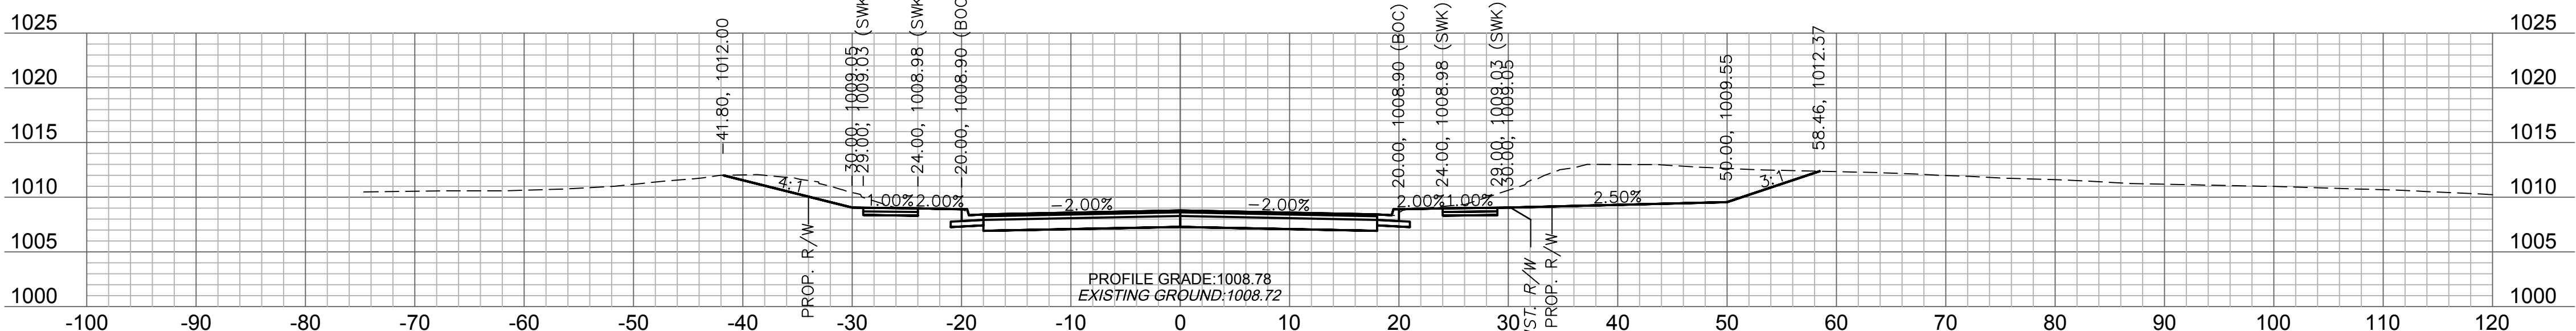

37+75

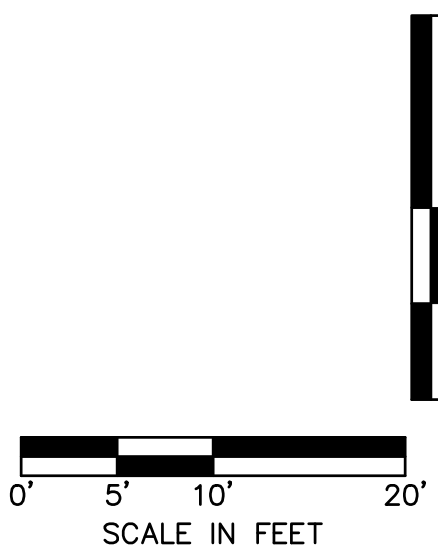

olsson

Olsson Engineering - MO State Certificate of Authority #001592
7301 West 133rd Street, Suite 200
Overland Park, KS 66213-4750
TEL 913.381.1170
FAX 913.381.1174
www.olsson.com

RECORD
DRAWINGS

RYAN B. FLEMING
MO. NO. PE-2002003161

REV. NO.	DATE	REVISIONS DESCRIPTION	BY

REVISIONS

MAIN STREET
CROSS SECTIONS


SCANNELL DEVELOPMENT LEE'S SUMMIT LOGISTICS
NORTHWEST CORNER OF TUDOR ROAD AND MAIN STREET

LEE'S SUMMIT, MISSOURI

C.O.A. NO.:
DRAWN BY: ARJ/AMW
CHECKED BY: XXX
APPROVED BY: RBE
QA/QC BY: RBE
PROJECT NO.: 021-04157
DWG NO.: T_XSC01_02104157
DATE: 2021-10-12

SHEET
102 OF 105

USER: asaaavedra
Plans/Sheets/ROBR/T_XSC01_02104157.dwg
F:\2021\04001-04500\021-04500\AutoCAD\Final
XREFS: T_PBASE_02104157
T_PTBK_02104157
DATE: Oct 30, 2023 3:59pm

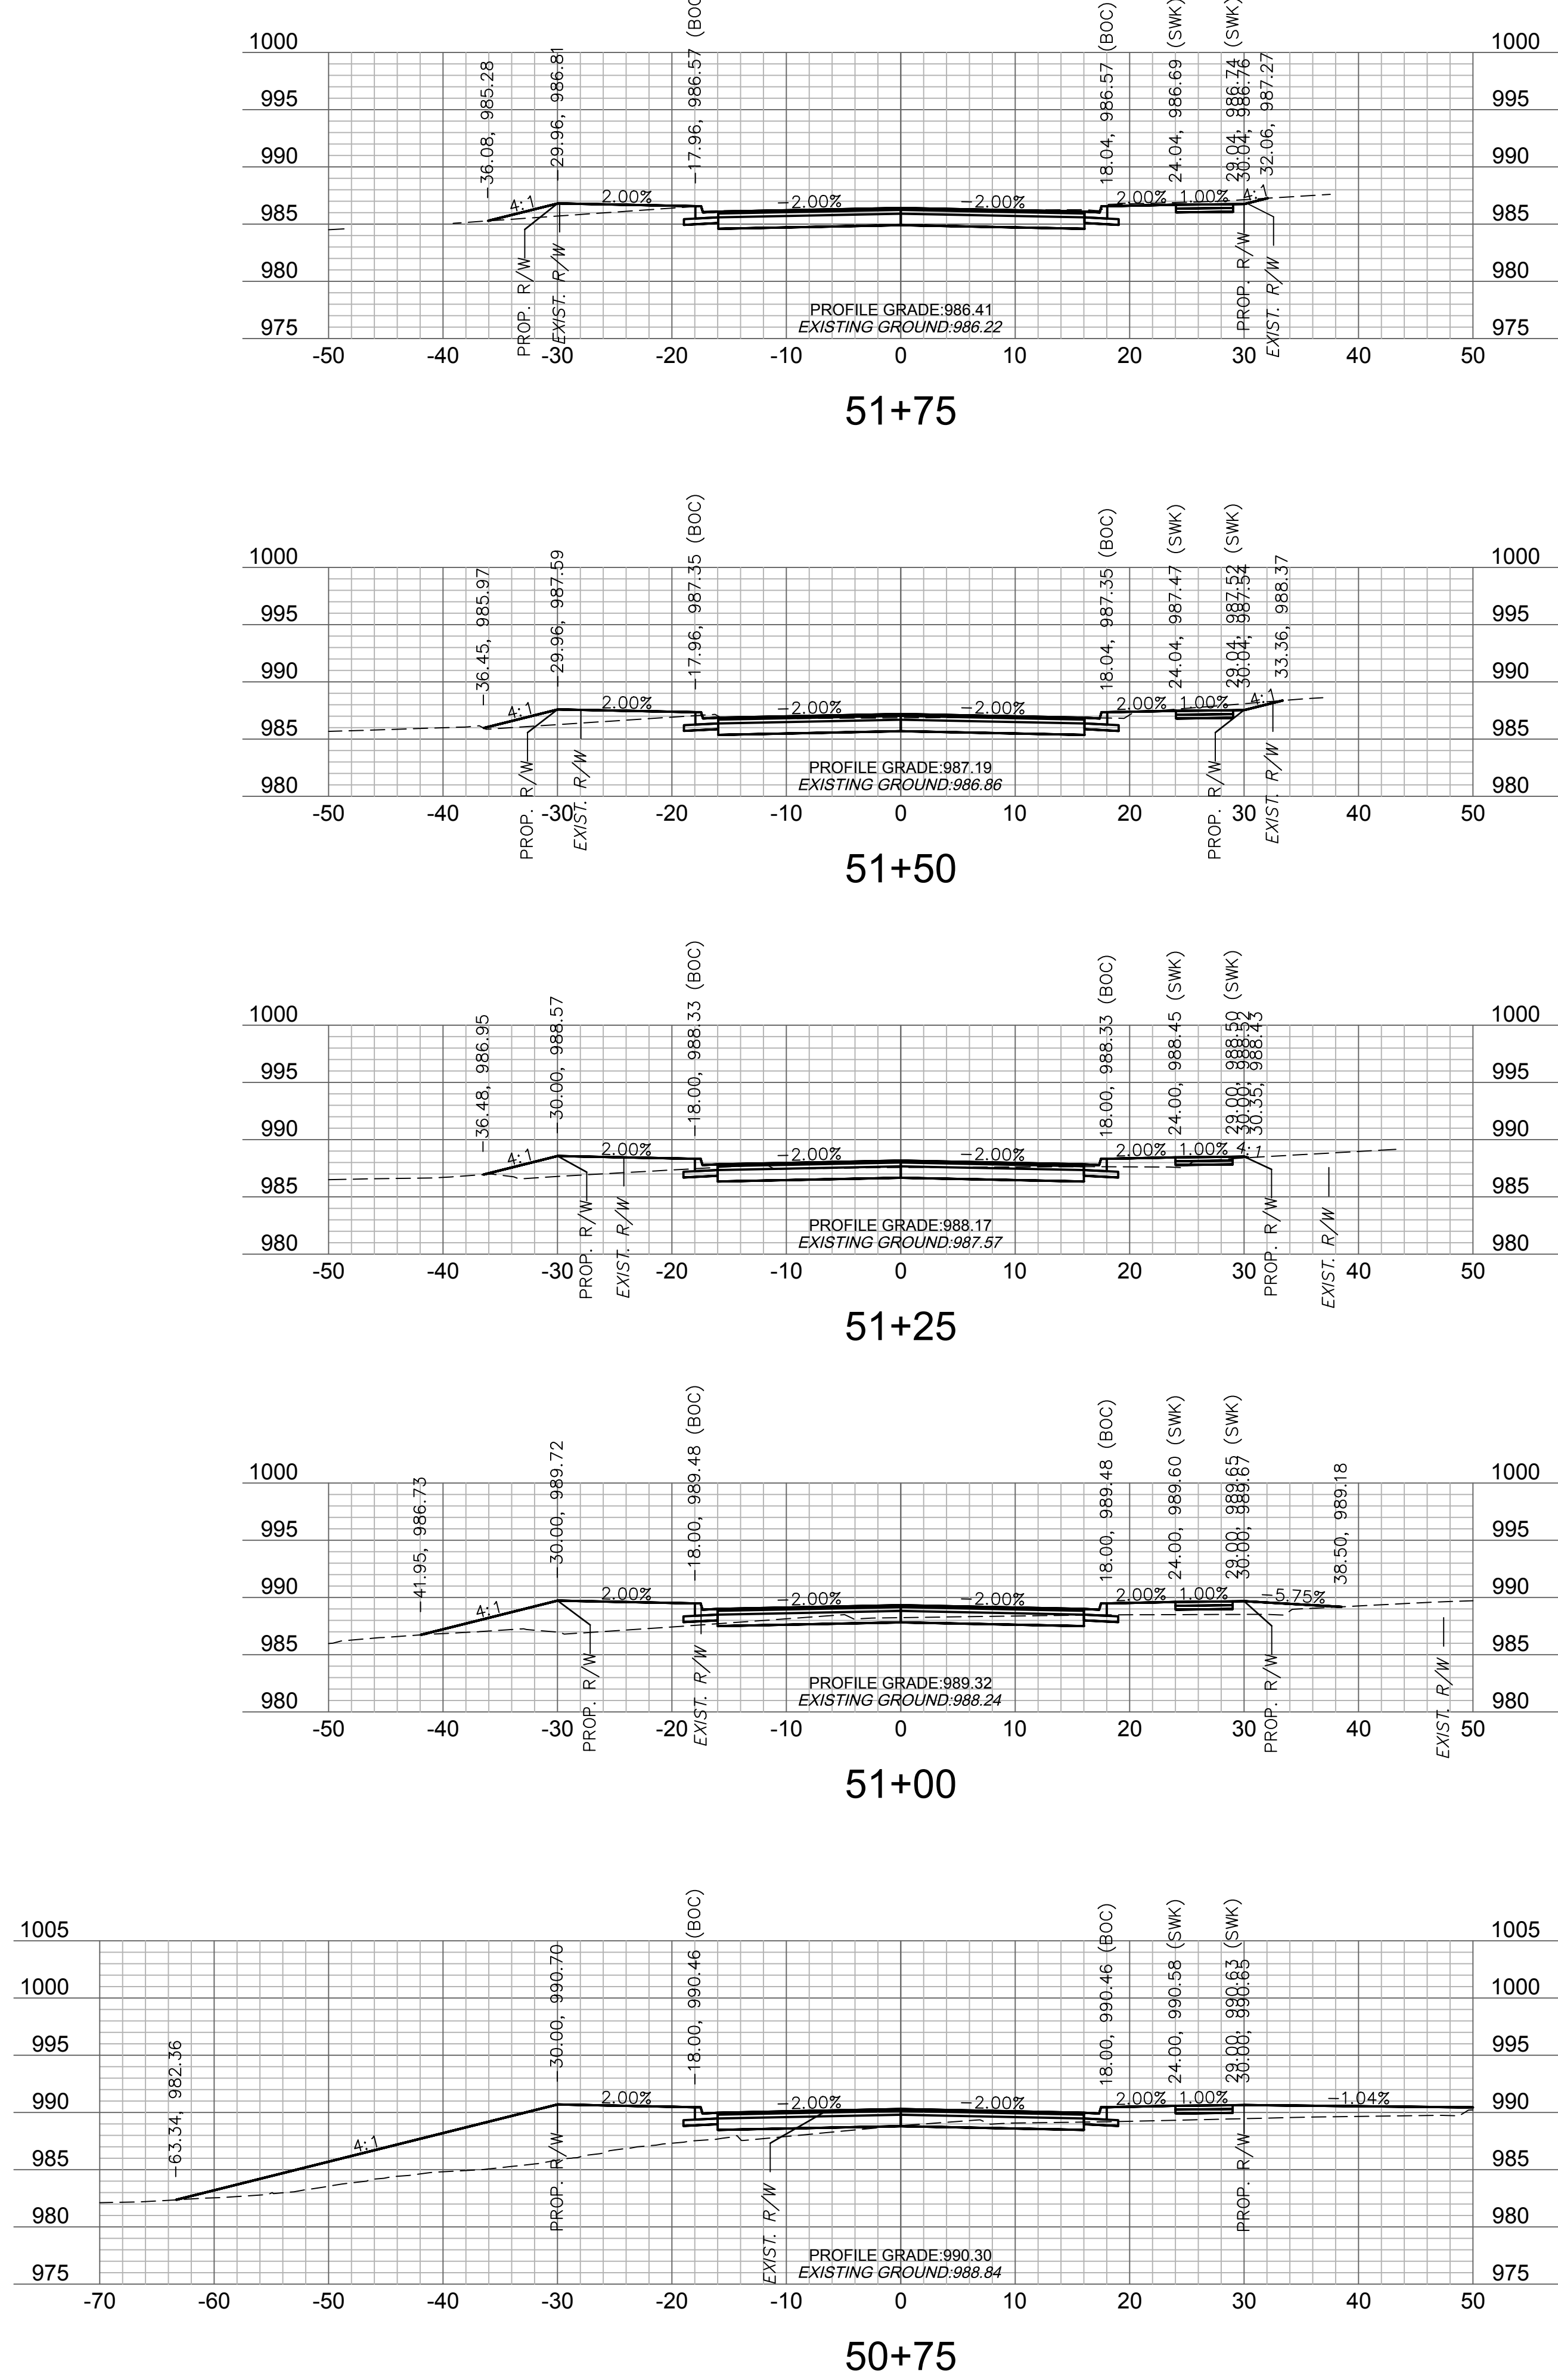

olsson Olsson Engineering - MO State Certificate of Authority #001592 7301 West 133rd Street, Suite 200 Overland Park, KS 66213-4750 TEL 913.381.1170 FAX 913.381.1174 www.olsson.com		RECORD DRAWINGS		RYAN B. FLEMING MO. NO. PE-2002003161	
NW SLOAN STREET CROSS SECTIONS	REV. NO.	DATE	REVISIONS DESCRIPTION	BY	
SCANNELL DEVELOPMENT LEE'S SUMMIT LOGISTICS NORTHWEST CORNER OF TUDOR ROAD AND MAIN STREET					
LEE'S SUMMIT, MISSOURI		2021	REVISIONS		
C.O.A. NO.: _____ DRAWN BY: <u>ARJAMW</u> CHECKED BY: <u>XXX</u> APPROVED BY: <u>RBF</u> QA/QC BY: <u>RBF</u> PROJECT NO.: <u>021-04167</u> DWG NO.: <u>T_XSC01_02104167</u> DATE: <u>2021-10-12</u>					
SHEET 104 OF 105					

