

GENERAL NOTES:

- Ranger Fire's work shall consist of all necessary labor and material to design and install new automatic fire sprinkler systems in the referenced buildings.
- Ranger Fire excludes all electrical work.
- All design and installation shall conform to 2018 IBC with amendments, the 2013 editions of & NFPA 13, 13R & 14 & all COTW amendments.
- All material to be UL/FM approved for fire services.
- Piping material shall consist of the following:
Apartments: 3/4" - 2" = CPVC Pipe w/ CPVC Fittings (u.o.n.)
2 1/2" & larger is Black Sch. 10 Steel Pipe w/ Grooved Fittings
Riser Room: Black Sch. 10 & 40 Steel Pipe w/ Grooved & Threaded Fittings (u.o.n.)
- Owner or tenant is responsible for maintaining adequate thermostatically controlled heat (Min. 40 degrees F.) throughout the area protected by a wet system.
- Sprinkler equipment room and equipment components shall be properly identified.
- All hangers shall be in accordance with NFPA 13 and the hanger listing requirements.
- All systems shall be tested at 200 psi for 2 hours and witnessed by a representative of Lees Summit FD. Any leaks shall be repaired.
- The systems have been hydraulically calculated per NFPA 13 & 13R requirements.

UNIT INSTALLATION / REVIEW NOTES:

- Align all sidewall sprinkler deflectors parallel to ceiling slope (if any).
- Field verify all sprinkler and pipe locations prior to installation.
- All branchline piping is 3/4" CPVC (U.O.N.).
- Route Auxiliary Drains (as needed) for unforeseen trapped areas.
- Fire caulk all fire rated walls that are penetrated.
- All CPVC pipe dimensions are center of the fitting.

BUILDING CONSTRUCTION DATA:

CONSTRUCTION TYPE:

BUILDING 1 V-A

BUILDING 2 V-A

OCCUPANCY TYPE:

BUILDING 1 R-2 U

BUILDING 2 R-2 U

SPRINKLER TYPE:

BUILDING 1 NFPA 13R

SEGMENT A, C, D, E NFPA 13

BUILDING 2 NFPA 13R

SEGMENT F, G, H & J

WATER FLOW TEST INFORMATION

PERFORMED BY : CITY OF LEES SUMMIT

DATE: 11/06/23

STATIC PRESSURE: 90 PSI

RESIDUAL PRESSURE: 89 PSI

FLOW: 2250 GPM

HANGER SPACING CHART

TABLE A.2.2.1 MAXIMUM DISTANCE BETWEEN HANGERS (FT.-IN.)									
NOMINAL PIPE SIZE (IN.)	1/4	1	1-1/4	1-1/2	2	2-1/2	3	4	6
SPACED PIPE	N/A	12'-0"	12'-0"	12'-0"	15'-0"	15'-0"	15'-0"	15'-0"	15'-0"
CPVC	5'-8"	6'-8"	6'-8"	7'-0"	8'-0"	9'-0"	10'-0"	N/A	N/A

NOTE: MAXIMUM DISTANCE BETWEEN HANGERS SHALL BE 10 FEET UNLESS OTHERWISE NOTED. HANGERS SHALL BE INSTALLED AT 10 FEET UNLESS OTHERWISE NOTED. HANGERS SHALL BE INSTALLED AT 10 FEET UNLESS OTHERWISE NOTED. HANGERS SHALL BE INSTALLED AT 10 FEET UNLESS OTHERWISE NOTED.

TABLE A.2.2.1 MAXIMUM DISTANCE BETWEEN HANGERS (FT.-IN.)									
NOMINAL PIPE SIZE (IN.)	1/4	1	1-1/4	1-1/2	2	2-1/2	3	4	6
SPACED PIPE	N/A	12'-0"	12'-0"	12'-0"	15'-0"	15'-0"	15'-0"	15'-0"	15'-0"
CPVC	5'-8"	6'-8"	6'-8"	7'-0"	8'-0"	9'-0"	10'-0"	N/A	N/A

NOTE: MAXIMUM DISTANCE BETWEEN HANGERS SHALL BE 10 FEET UNLESS OTHERWISE NOTED. HANGERS SHALL BE INSTALLED AT 10 FEET UNLESS OTHERWISE NOTED. HANGERS SHALL BE INSTALLED AT 10 FEET UNLESS OTHERWISE NOTED. HANGERS SHALL BE INSTALLED AT 10 FEET UNLESS OTHERWISE NOTED.

DRY SYSTEM INSPECTORS TEST

SCALE: NTS

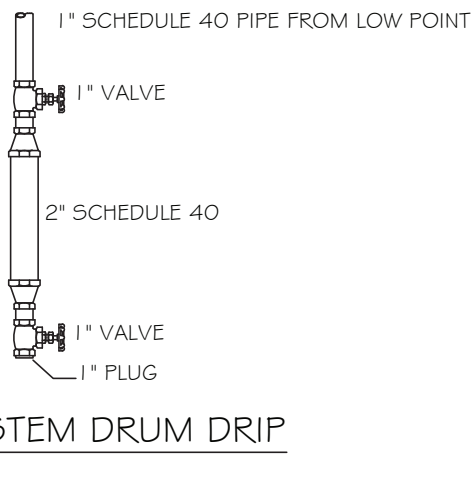

LOW PRESSURE CPVC DRY SYSTEM NOTES:















- Align all sidewall sprinkler deflectors parallel to ceiling slope.
- Space hangers on cpvc pipe per hanger matrix. (Hangers Not Shown For Clarity).
- All branchline piping is 3/4" CPVC (u.o.n.).
- Route 3/4" drains to exterior walls - As Needed.
- Fire caulk all fire rated walls that are penetrated.
- All pipe dimensions are center - center.
- Field verify all sprinkler and pipe locations prior to installation.
- Mains to be sloped 1/4" per 10 feet

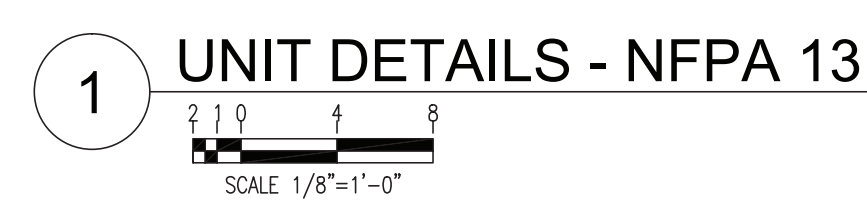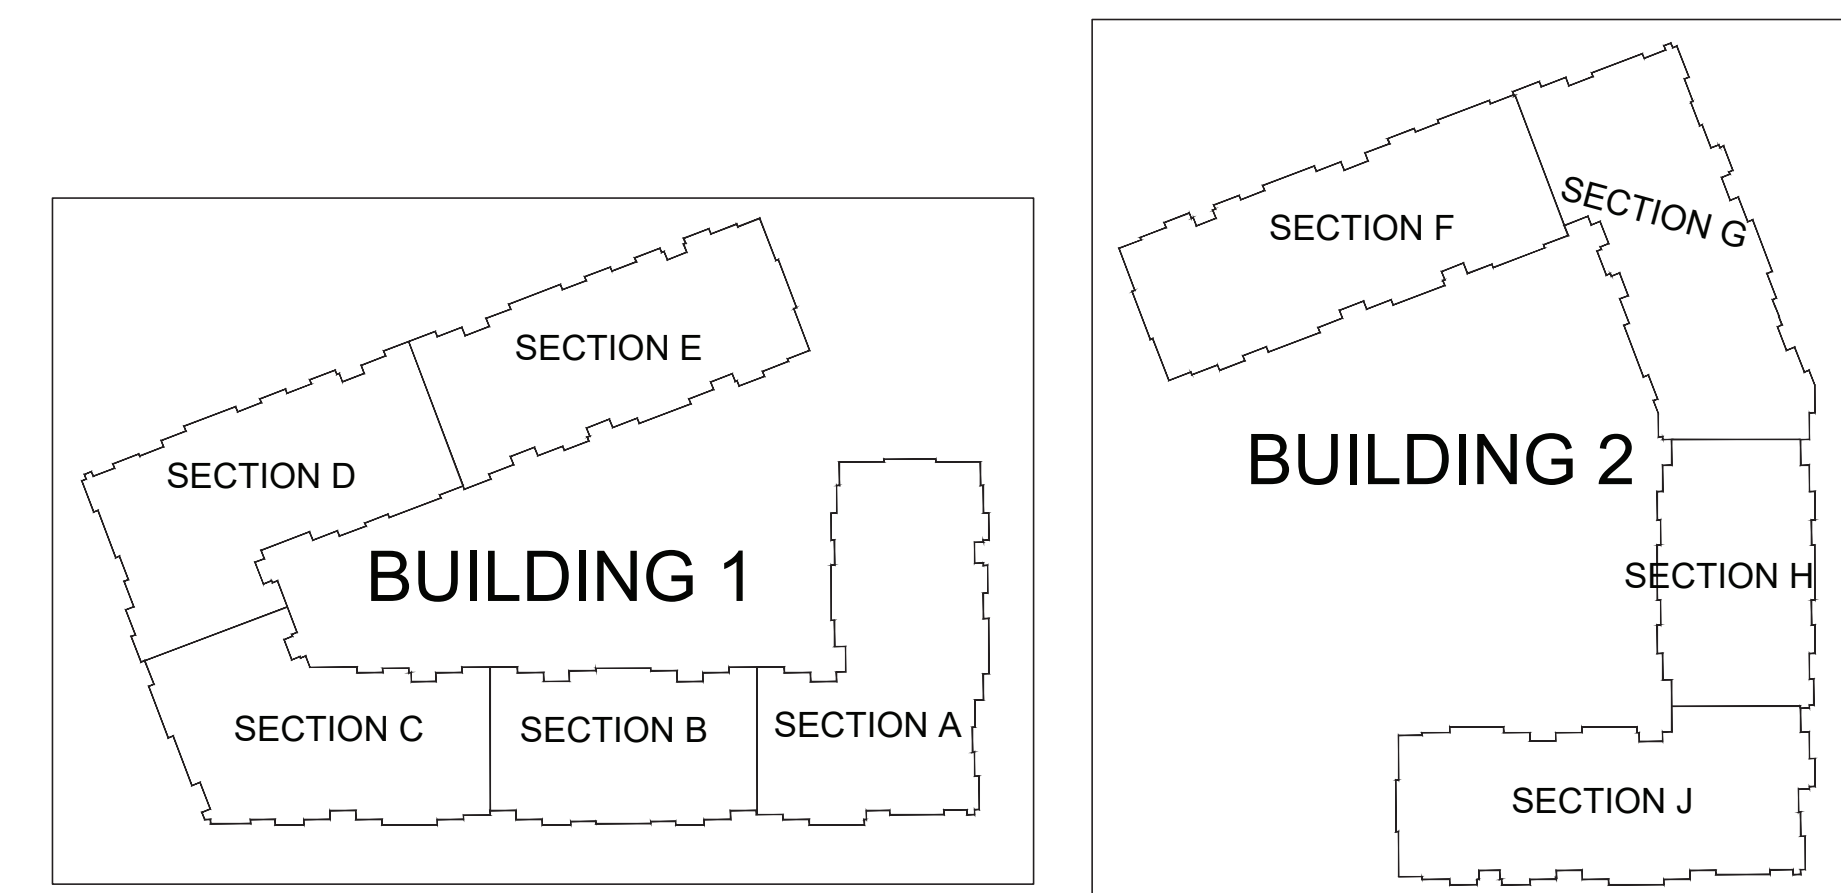


SPRINKLER ARE NOT REQUIRED IN BATHROOMS LESS THAN 55 SQFT NFPA 13 - 8.15.8.1.1

12-26-2023

STATE OF MISSOURI
CHRISTOPHER T. GROSS
NUMBER
12-201510148
PROFESSIONAL ENGINEER

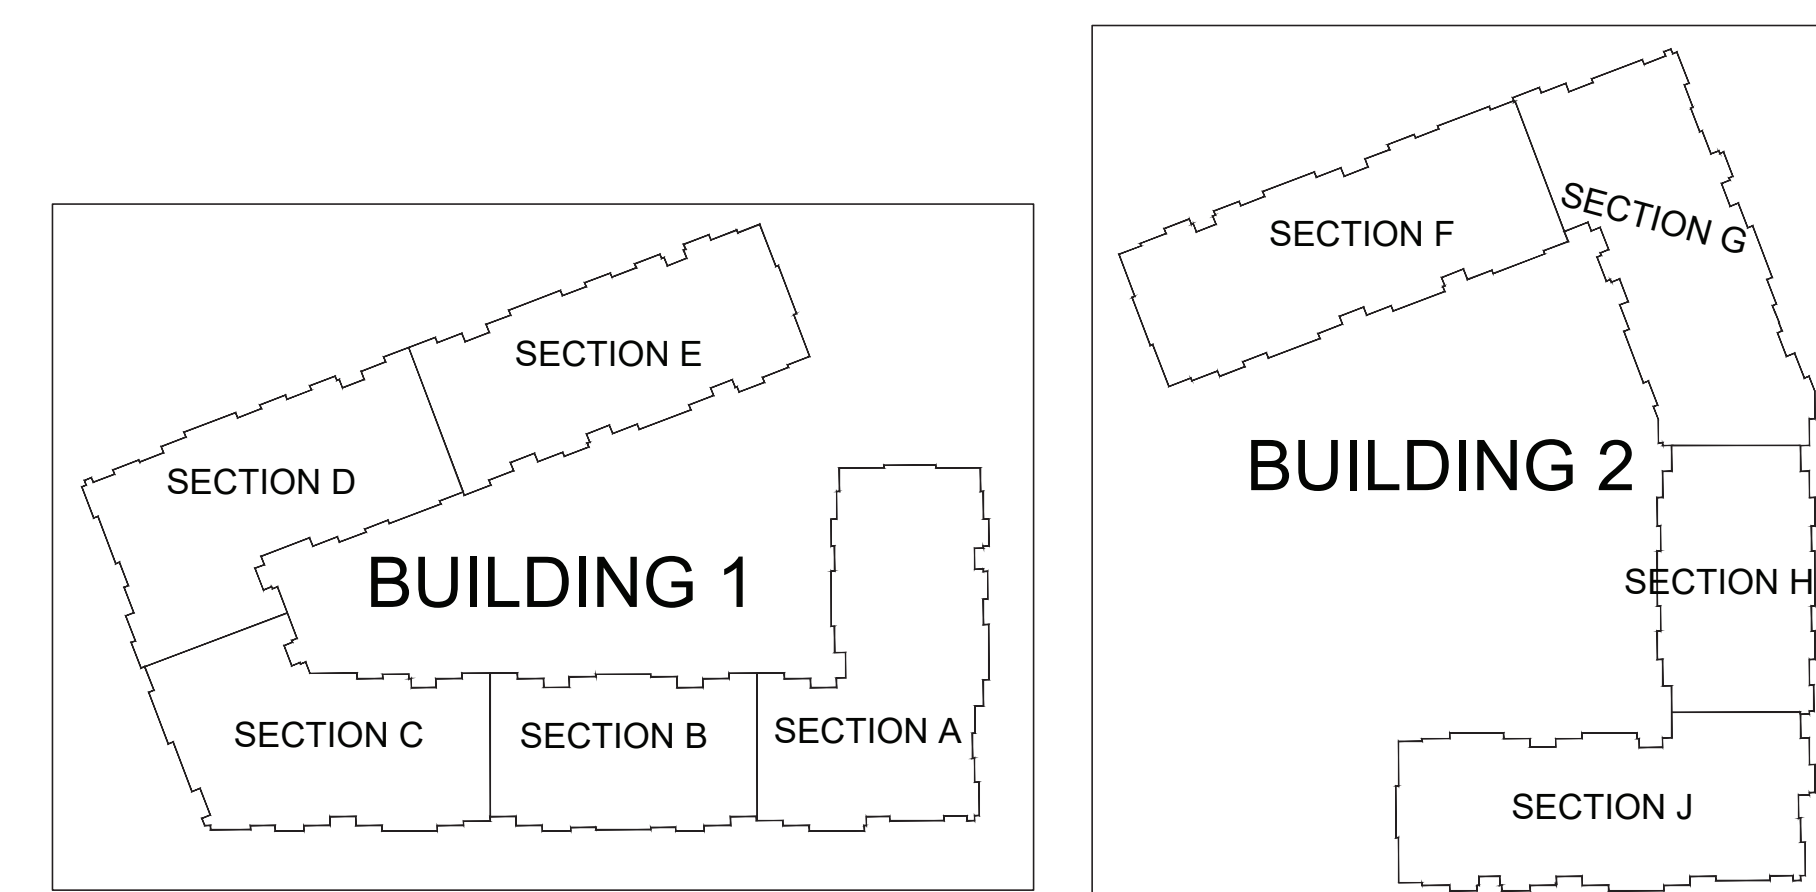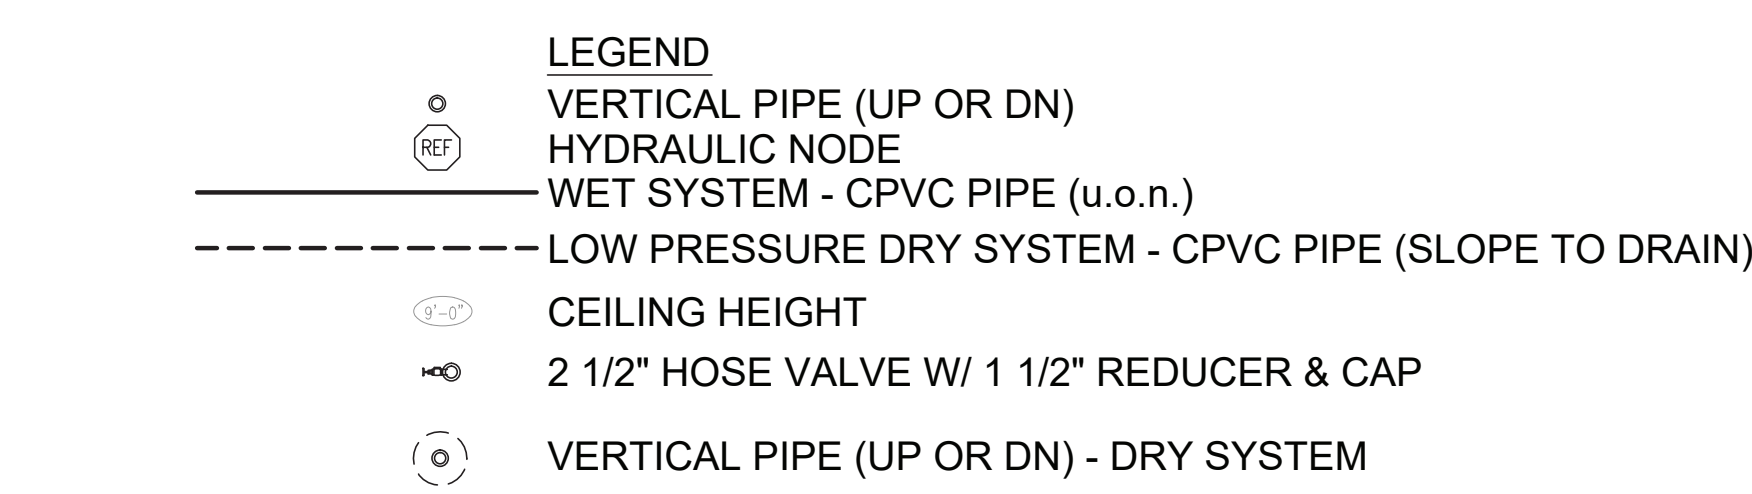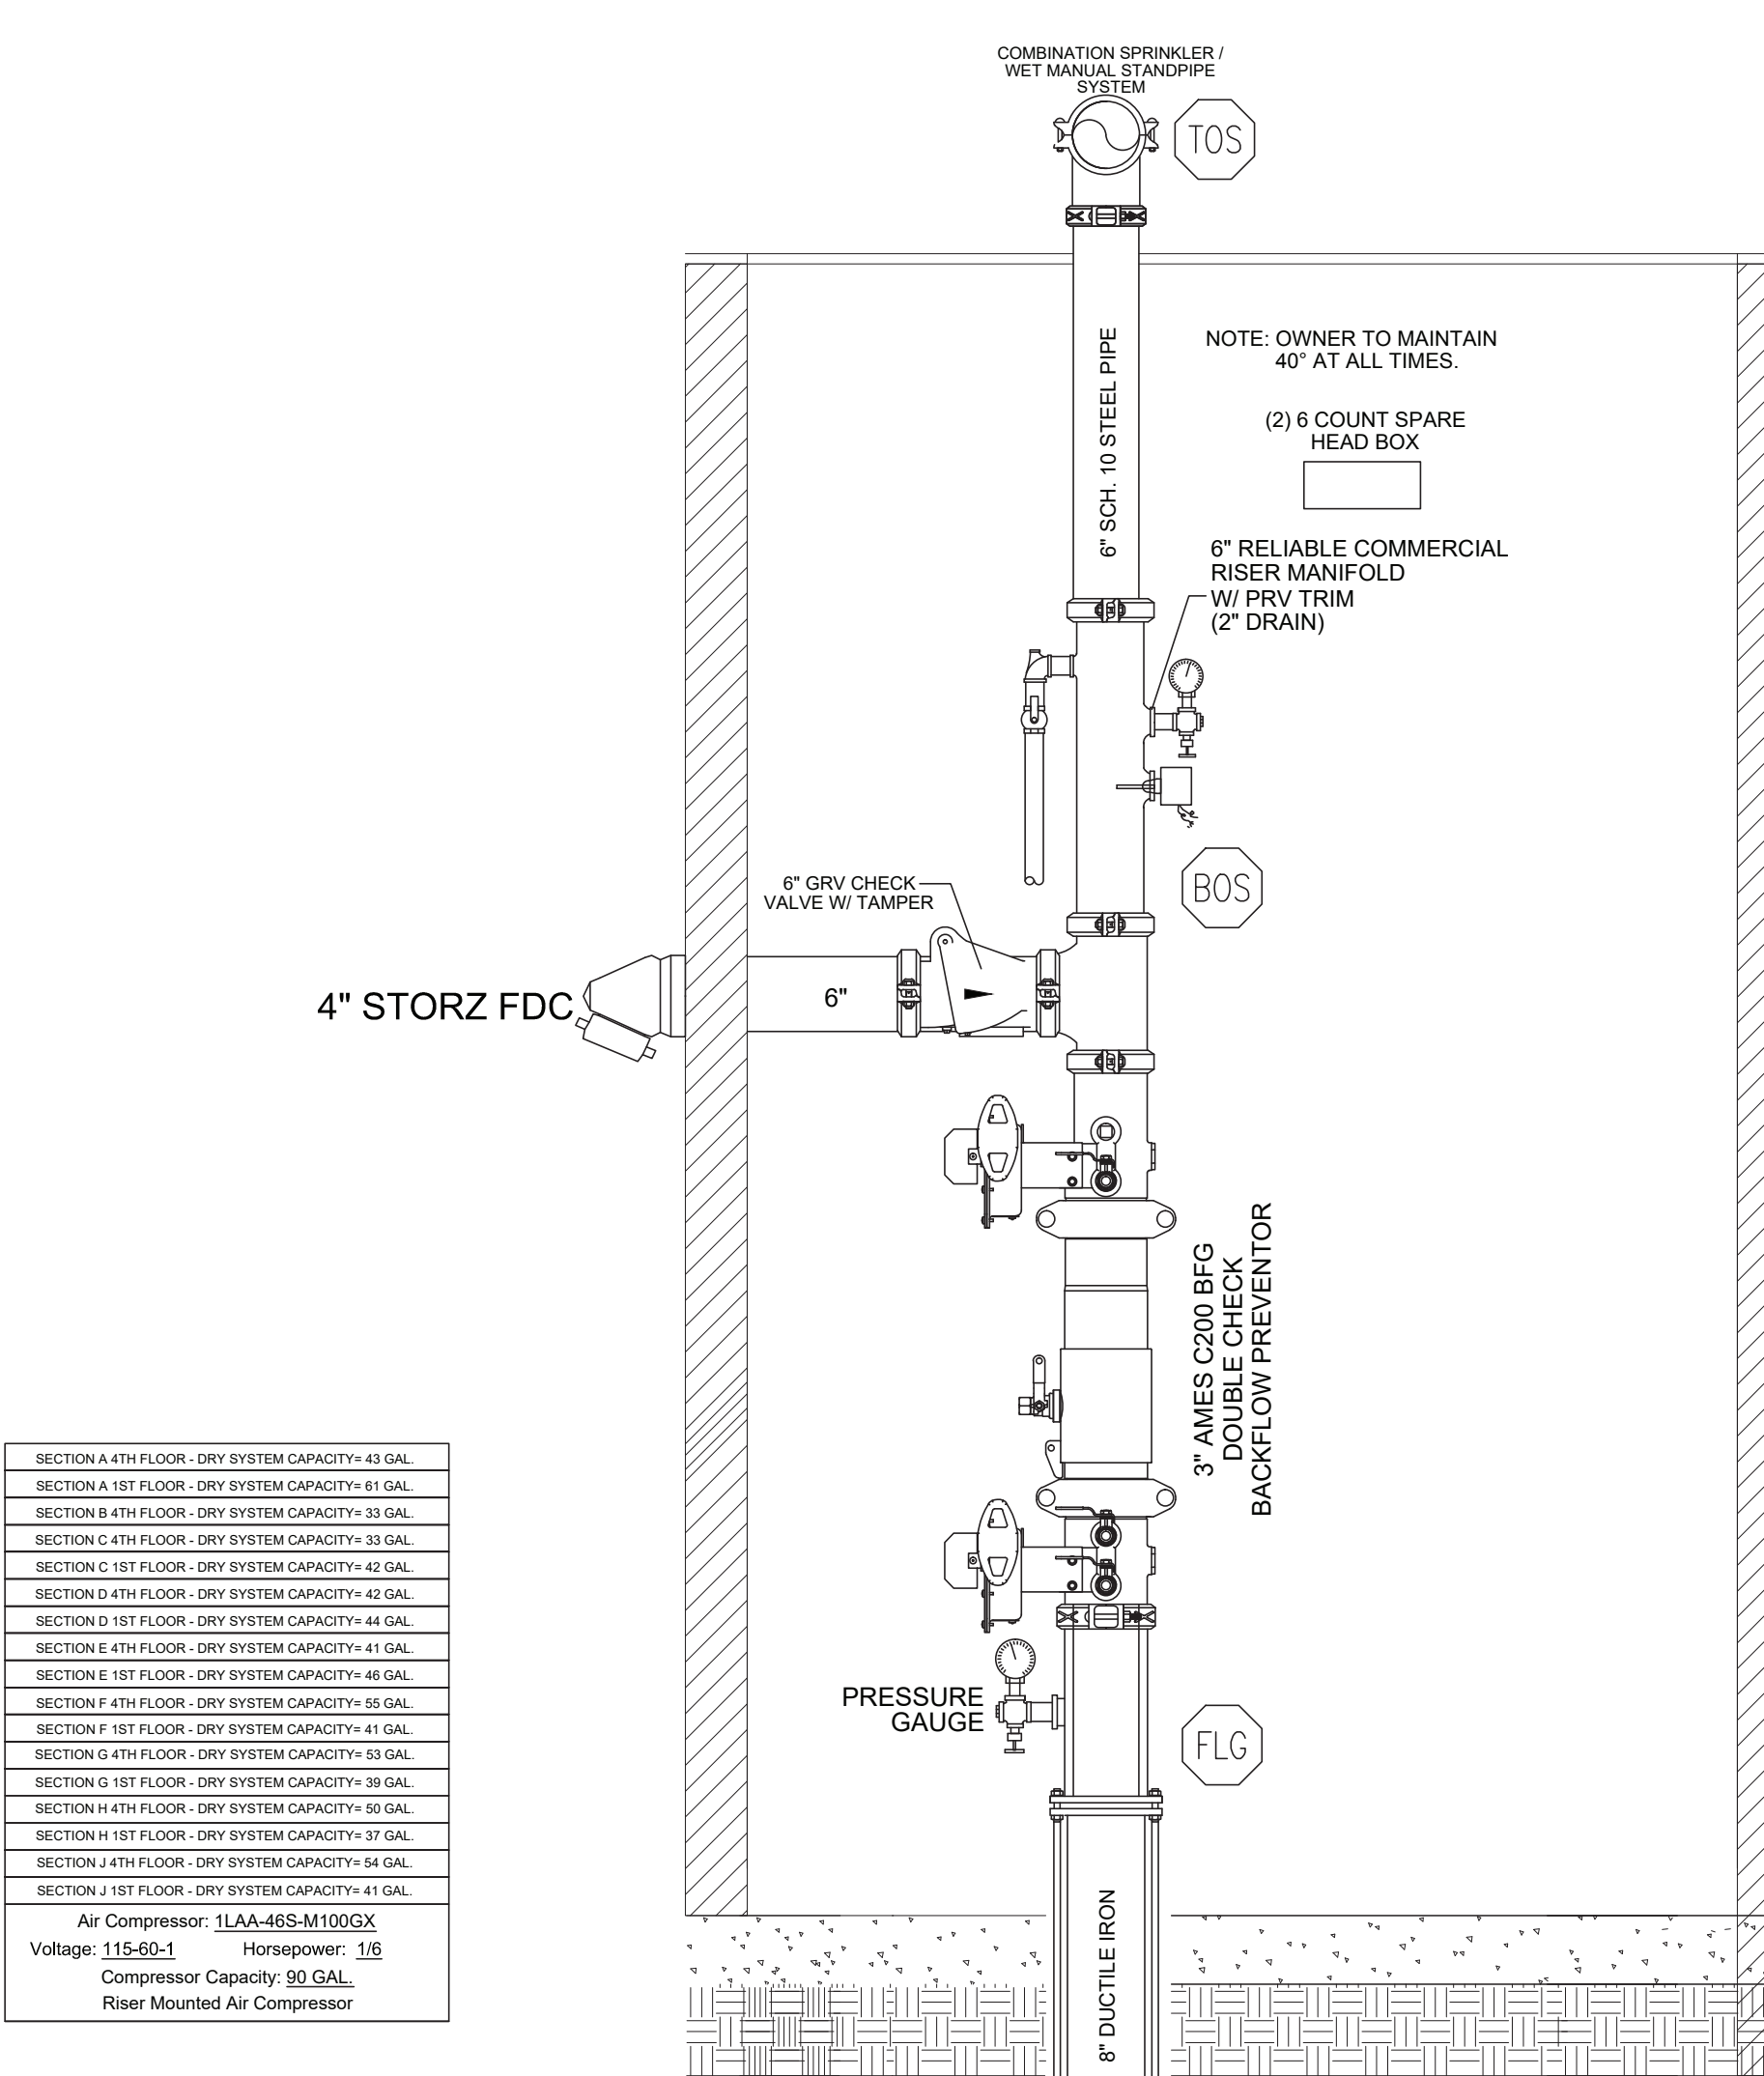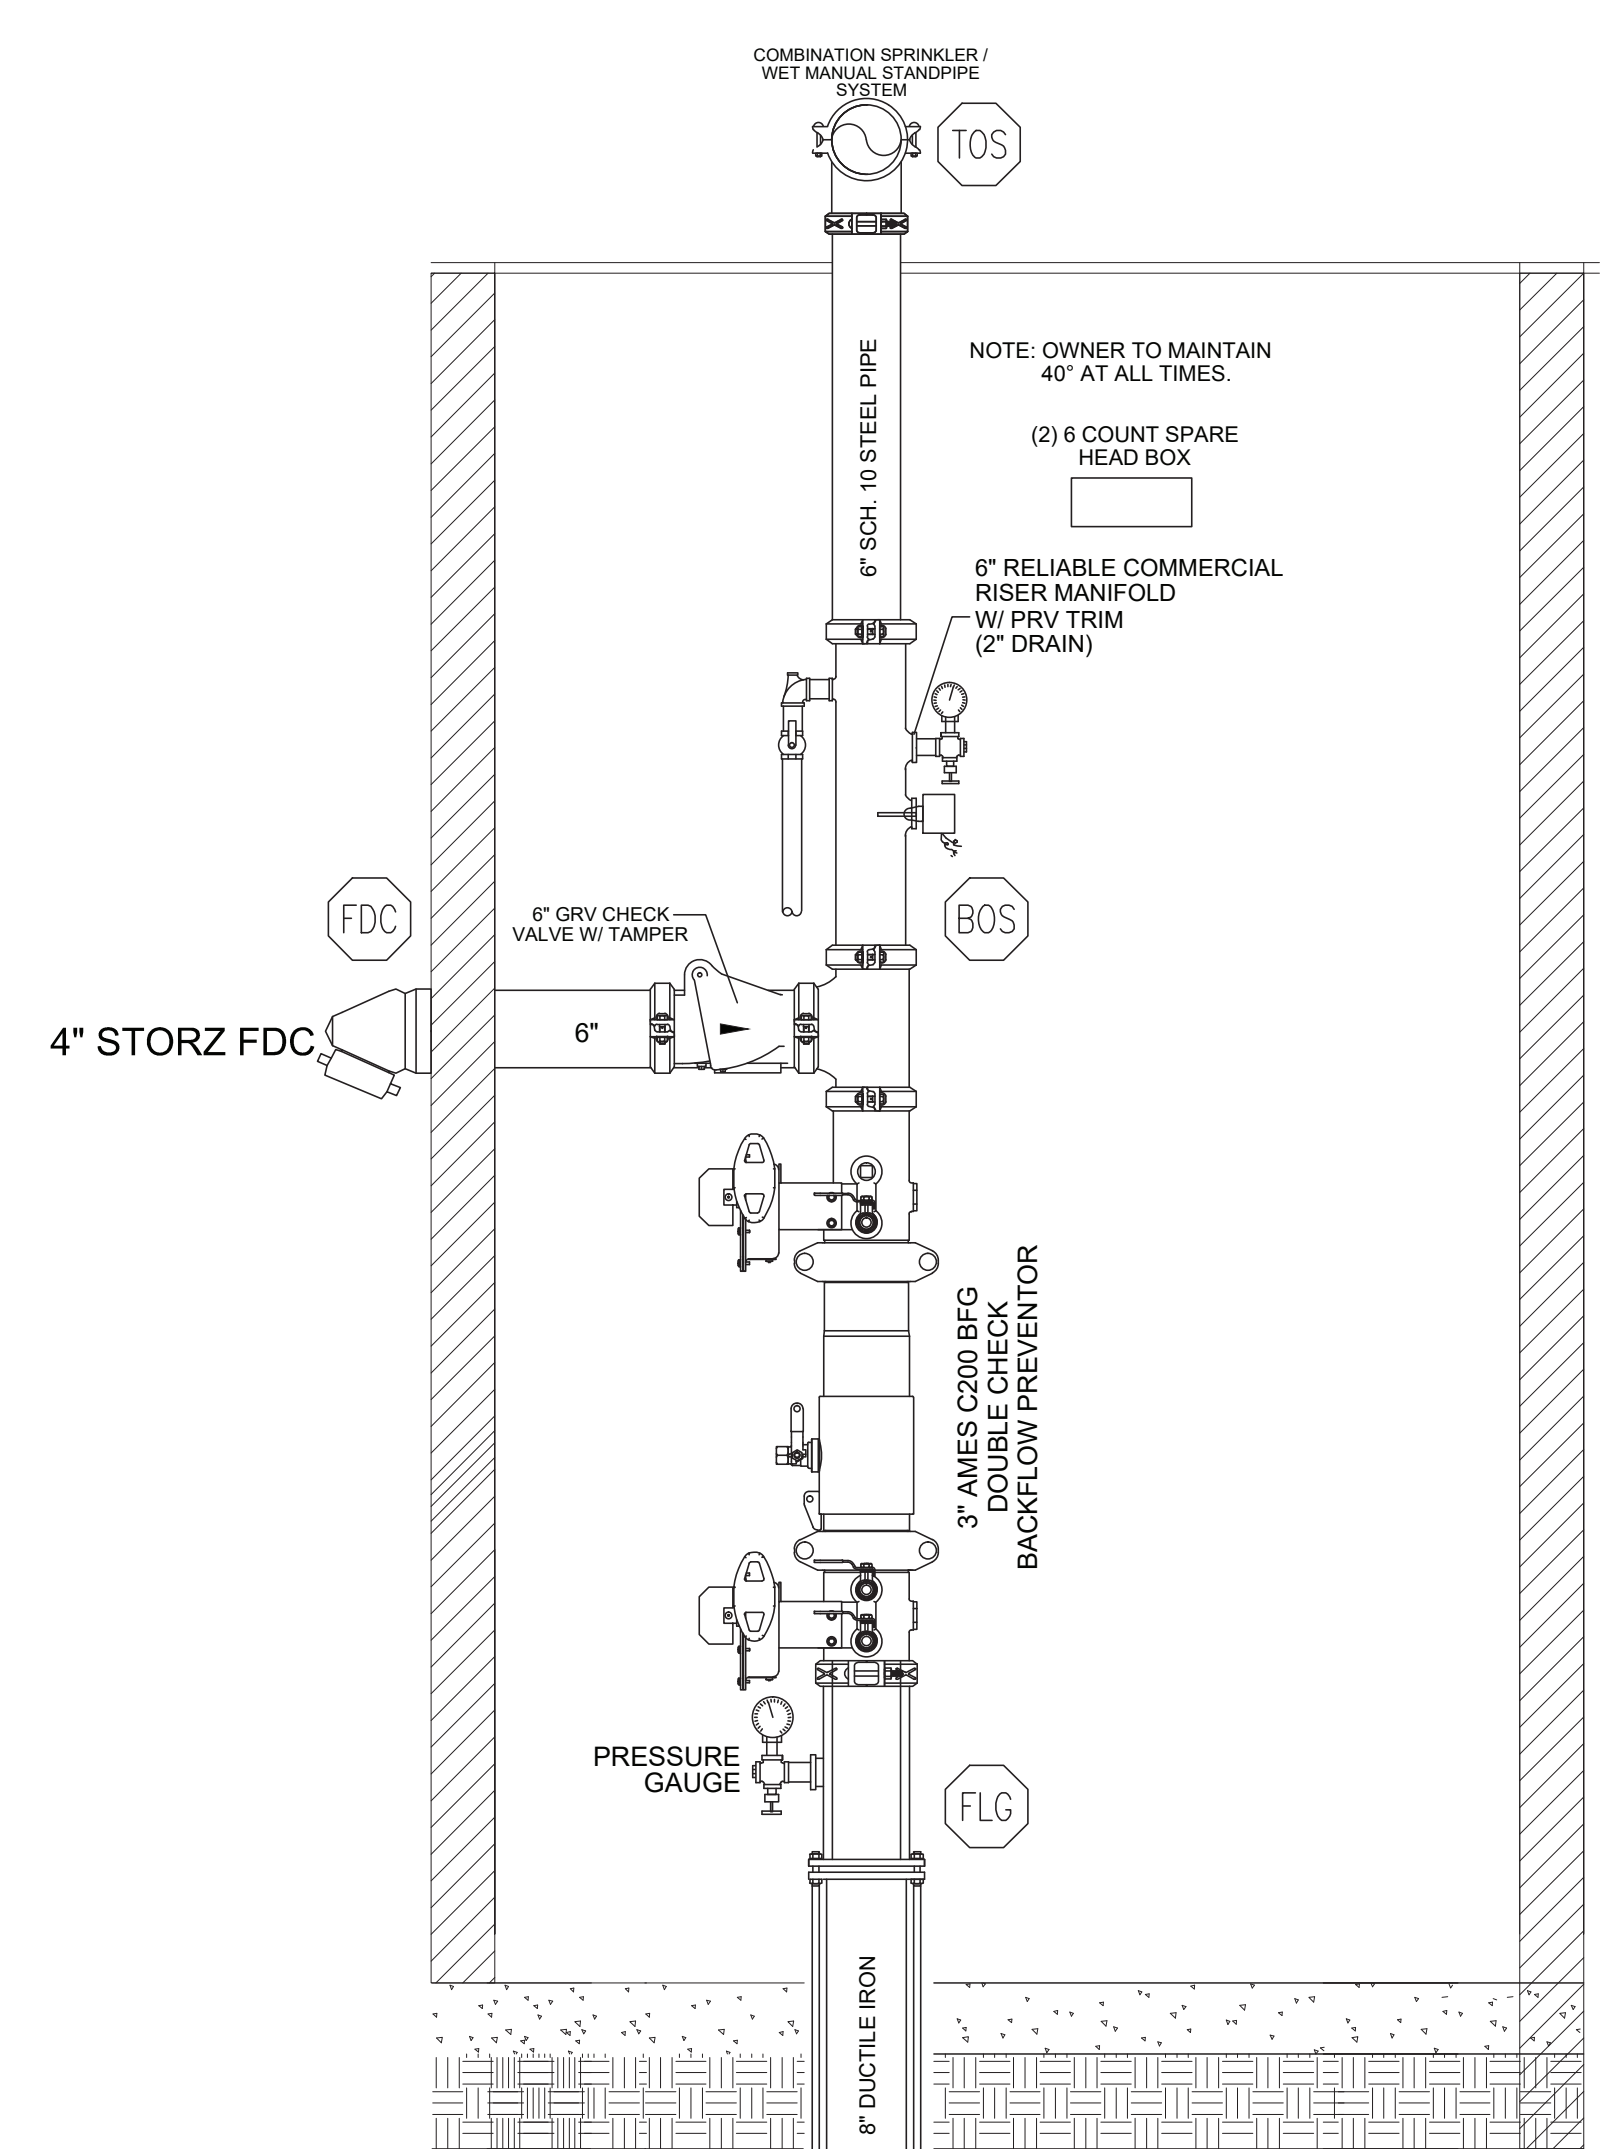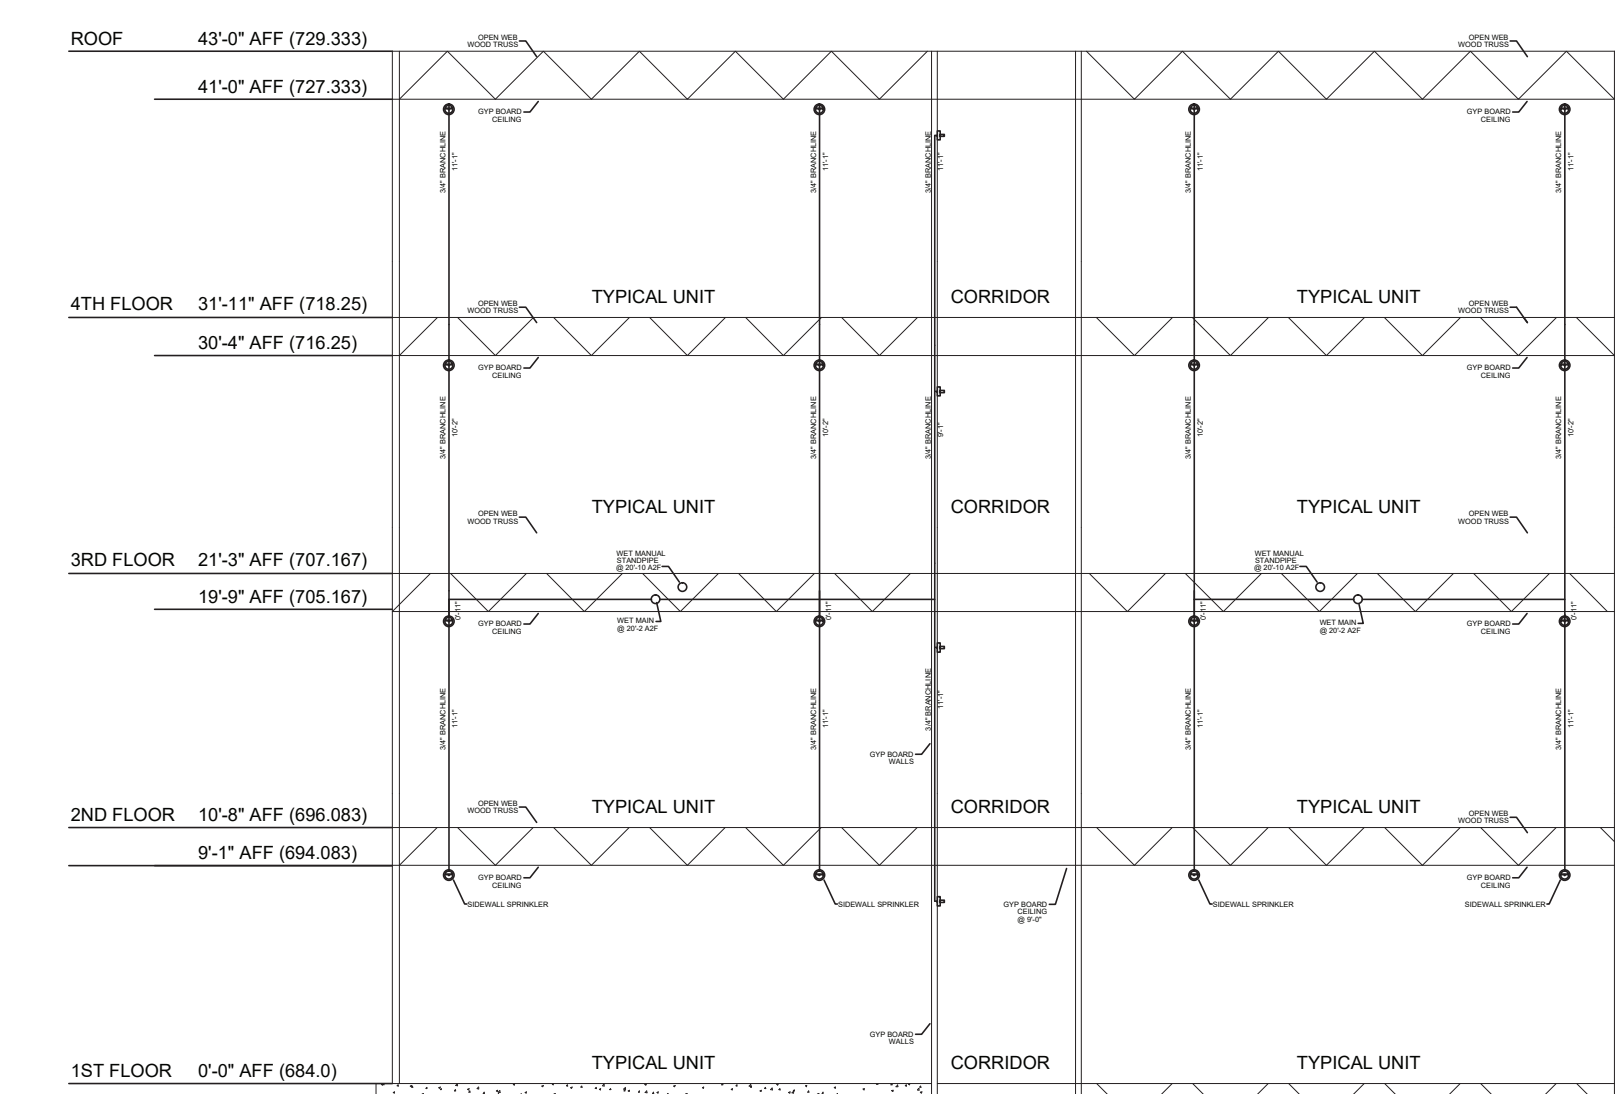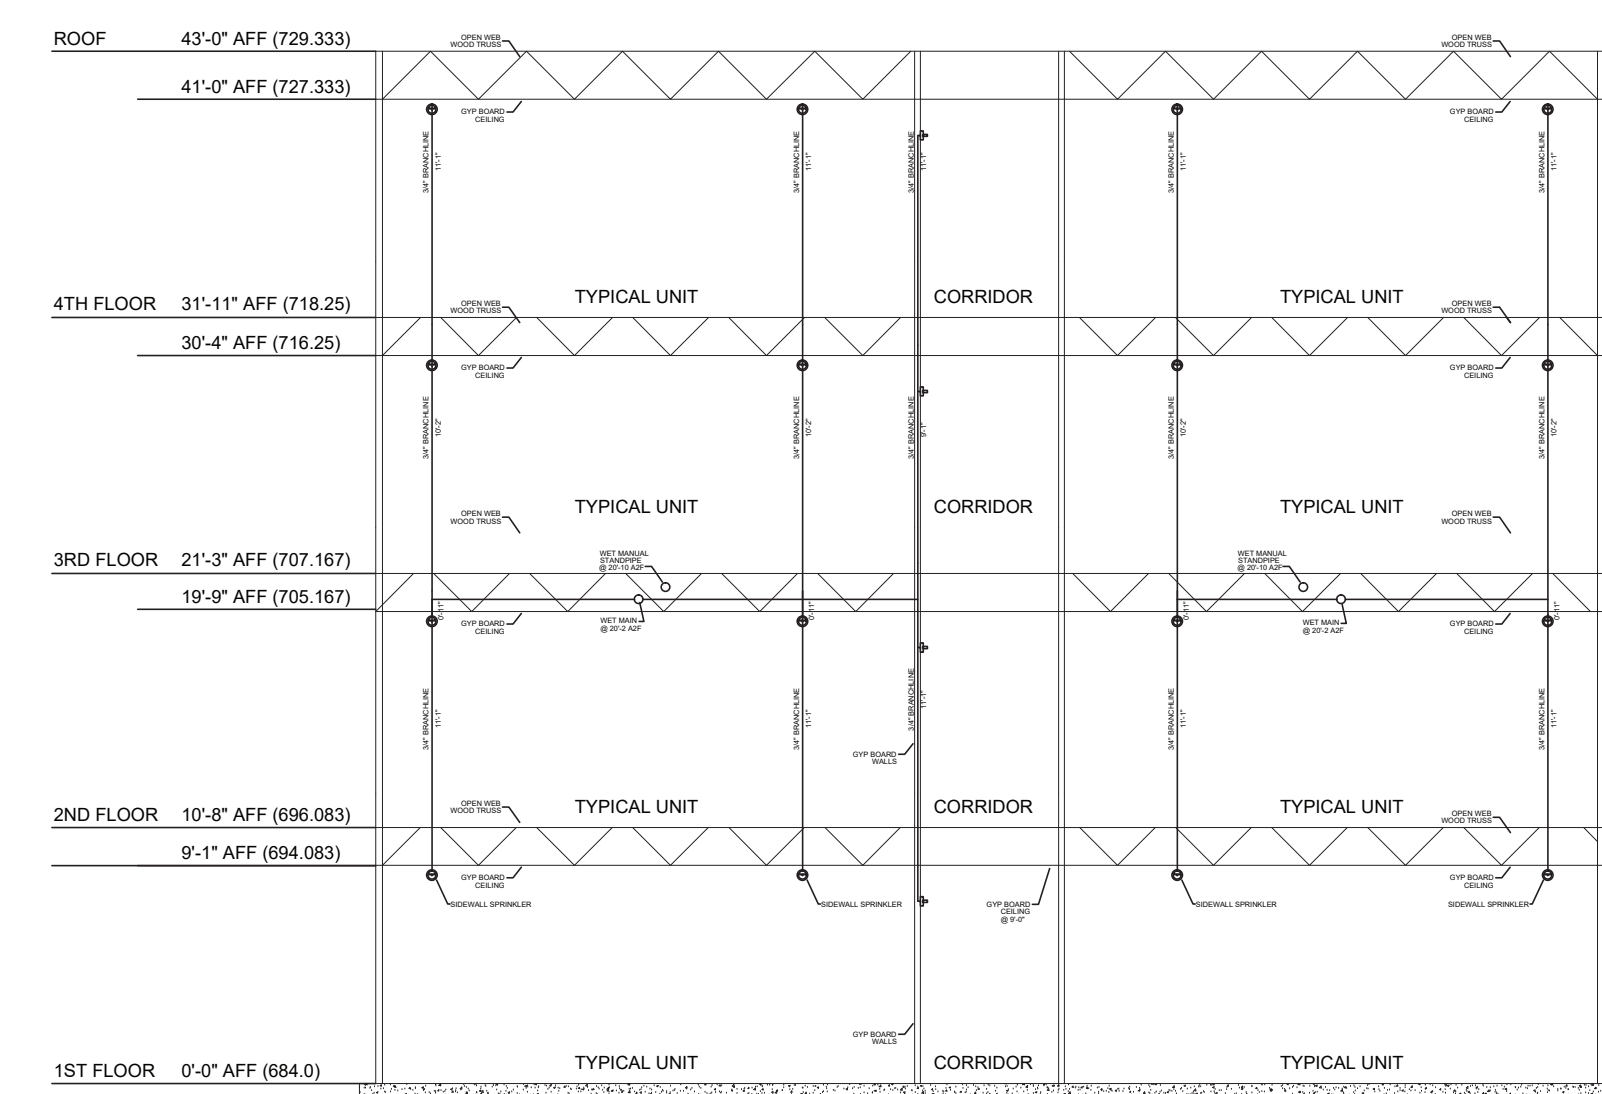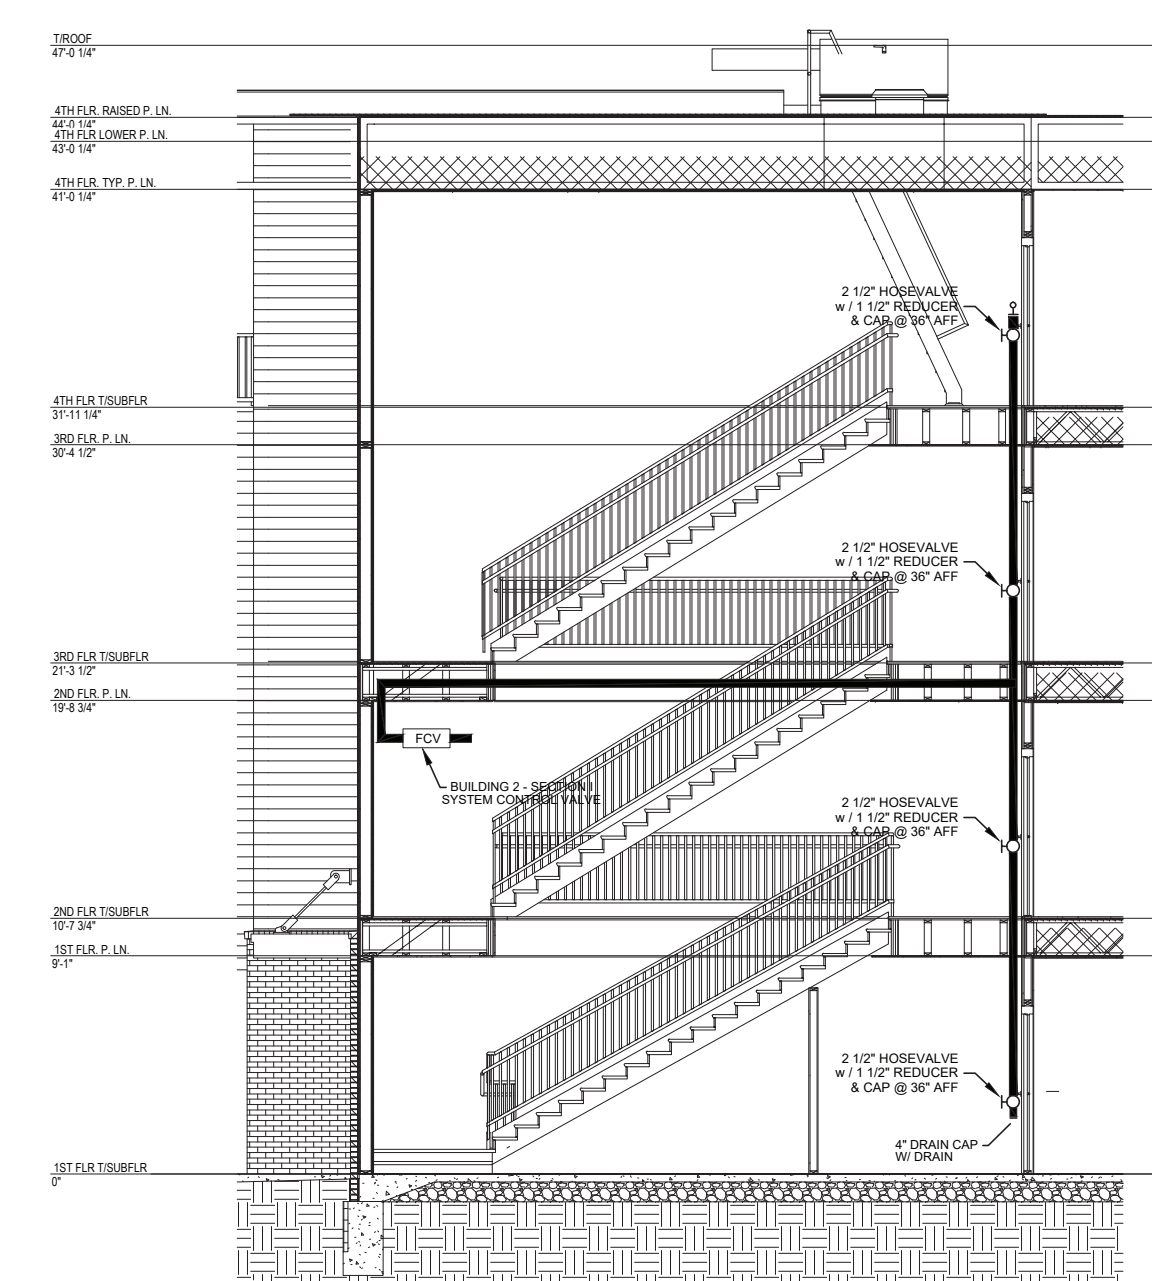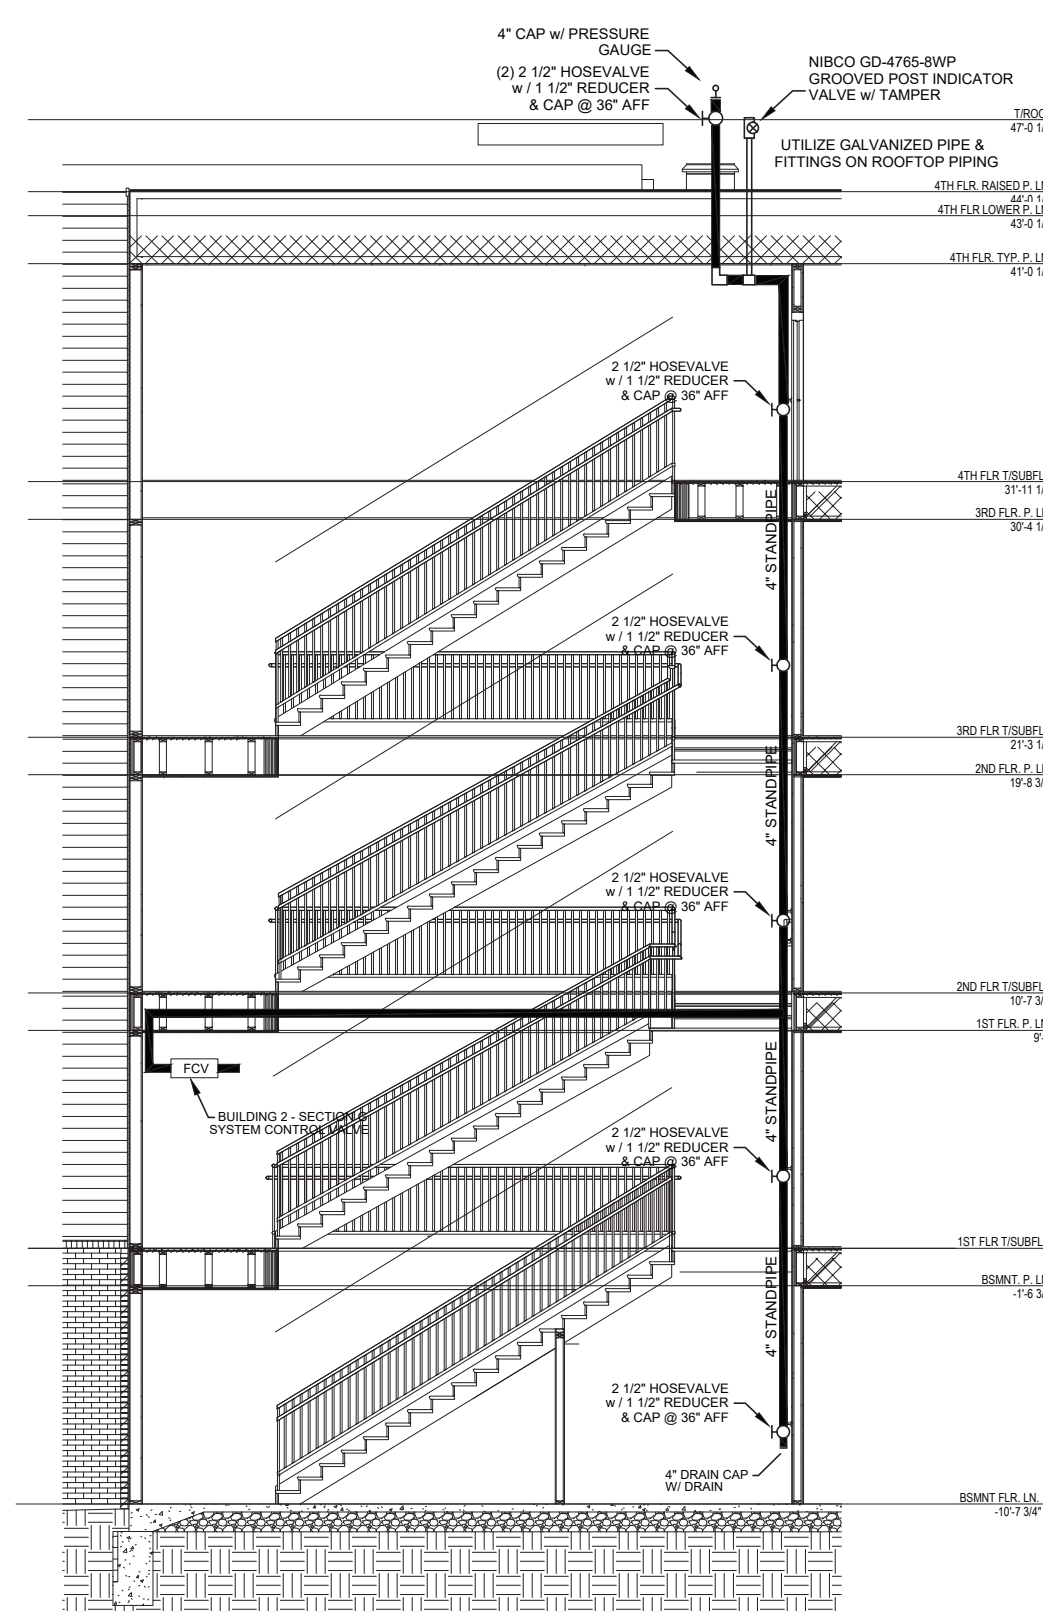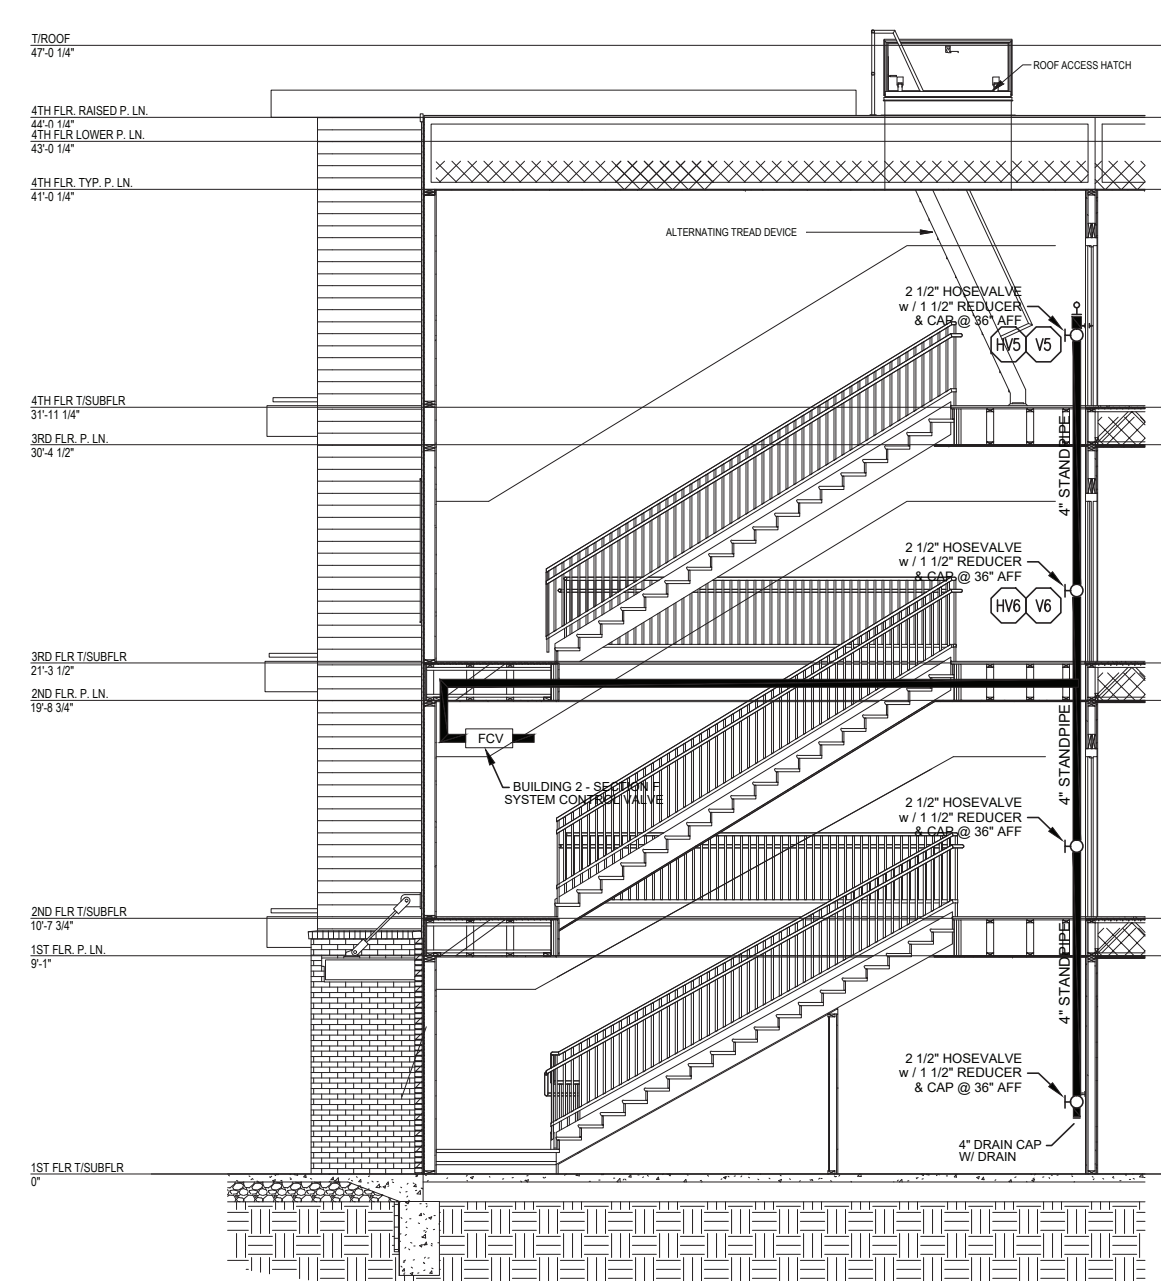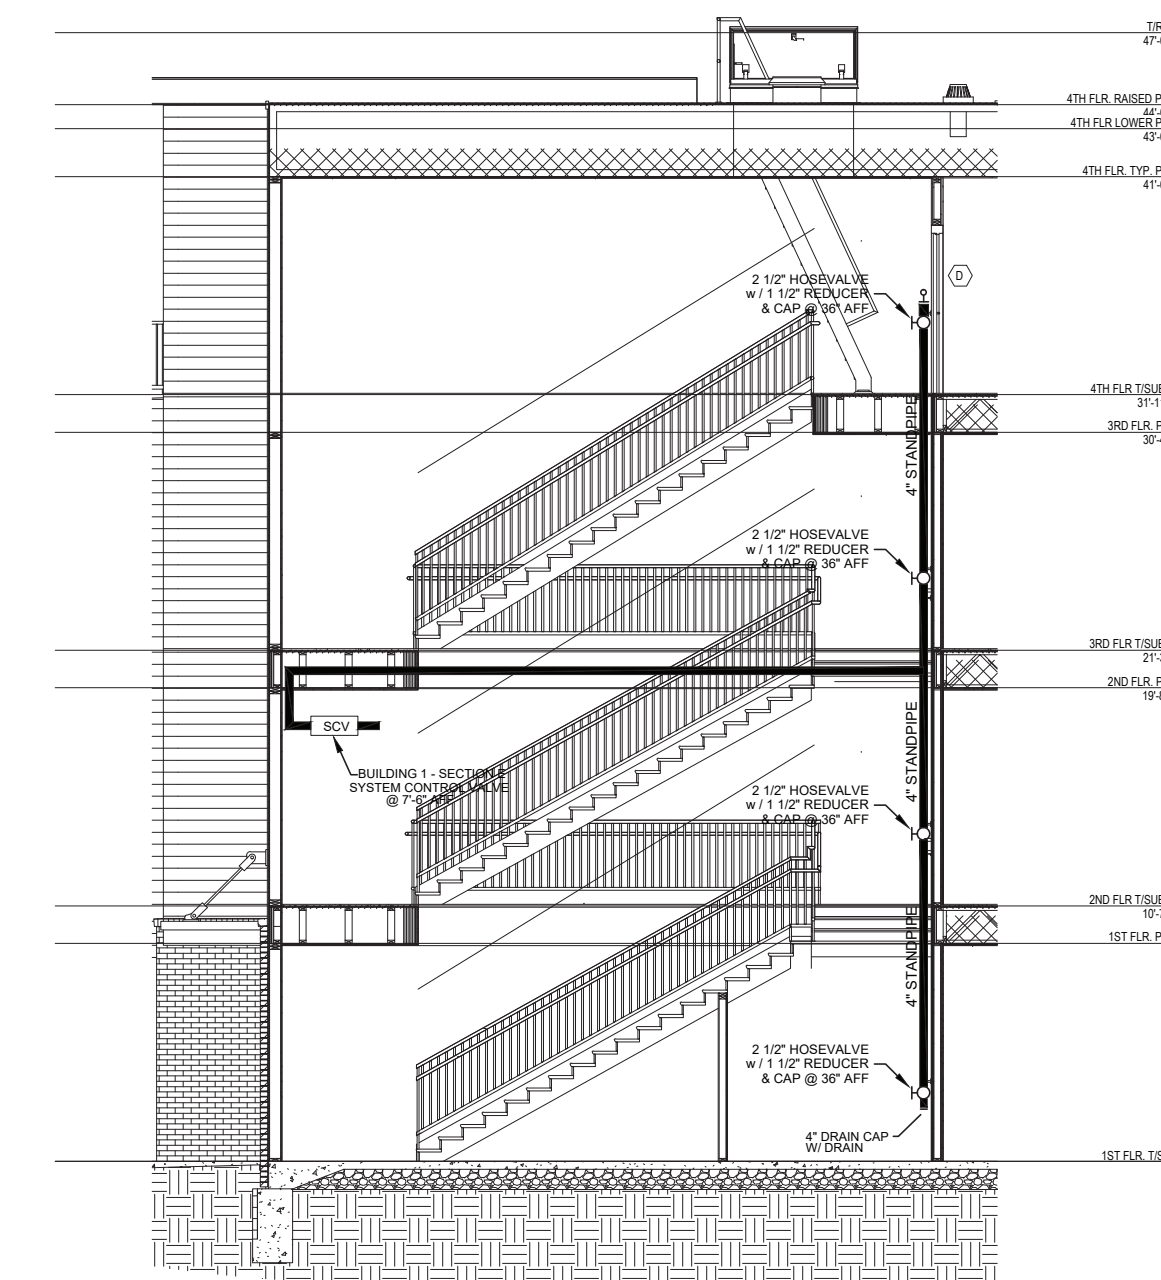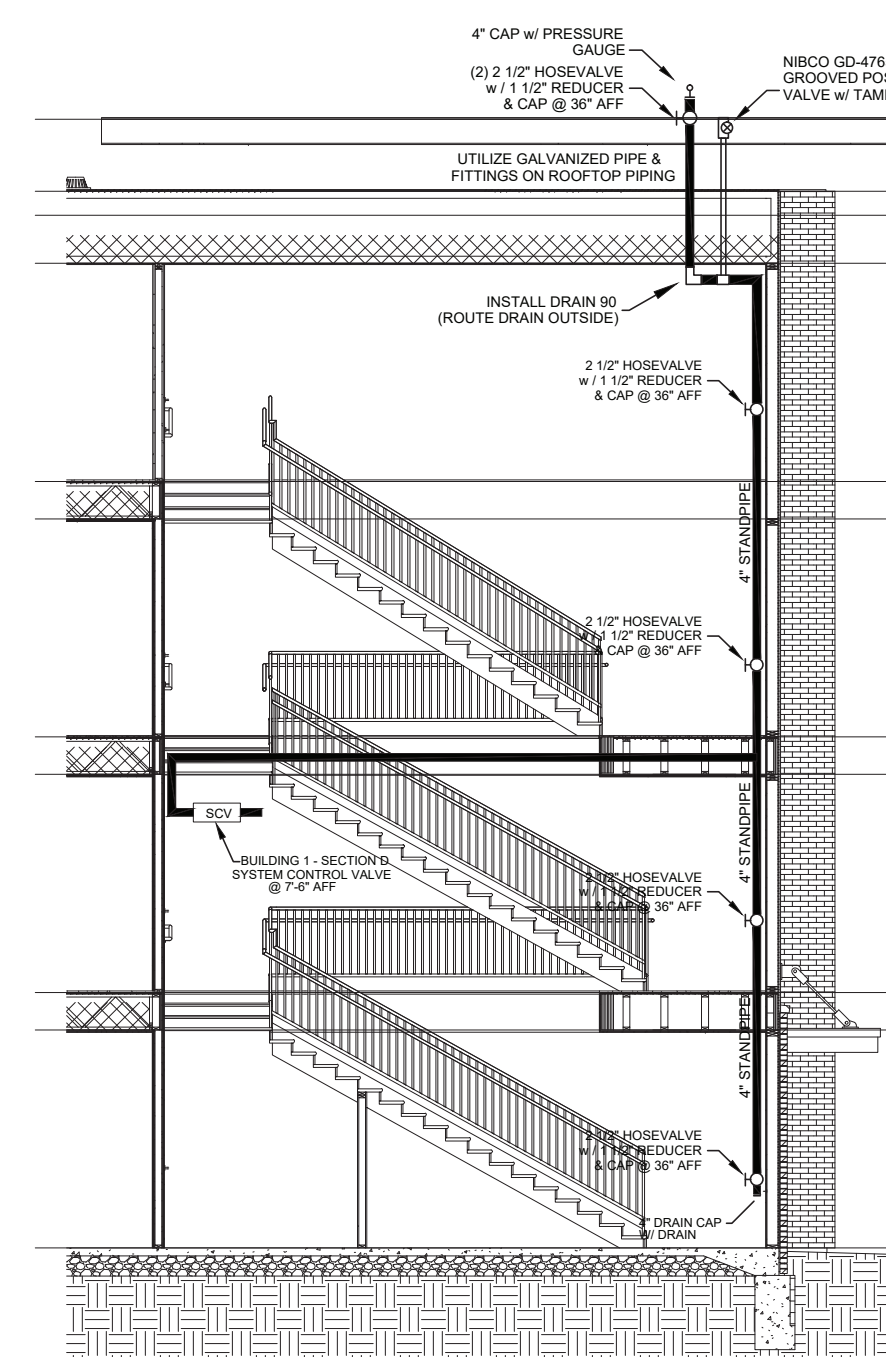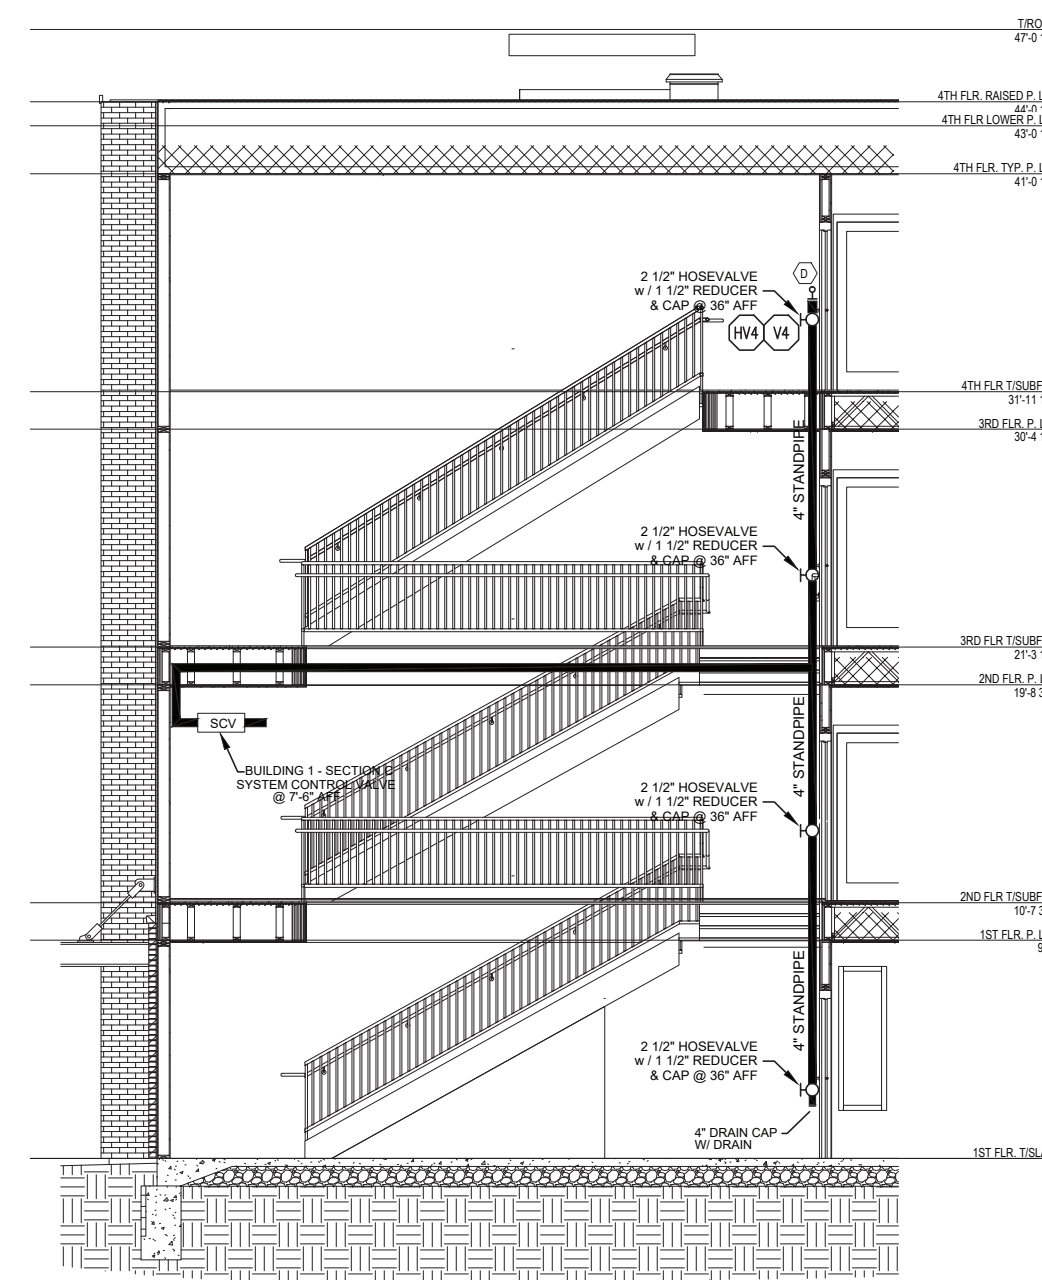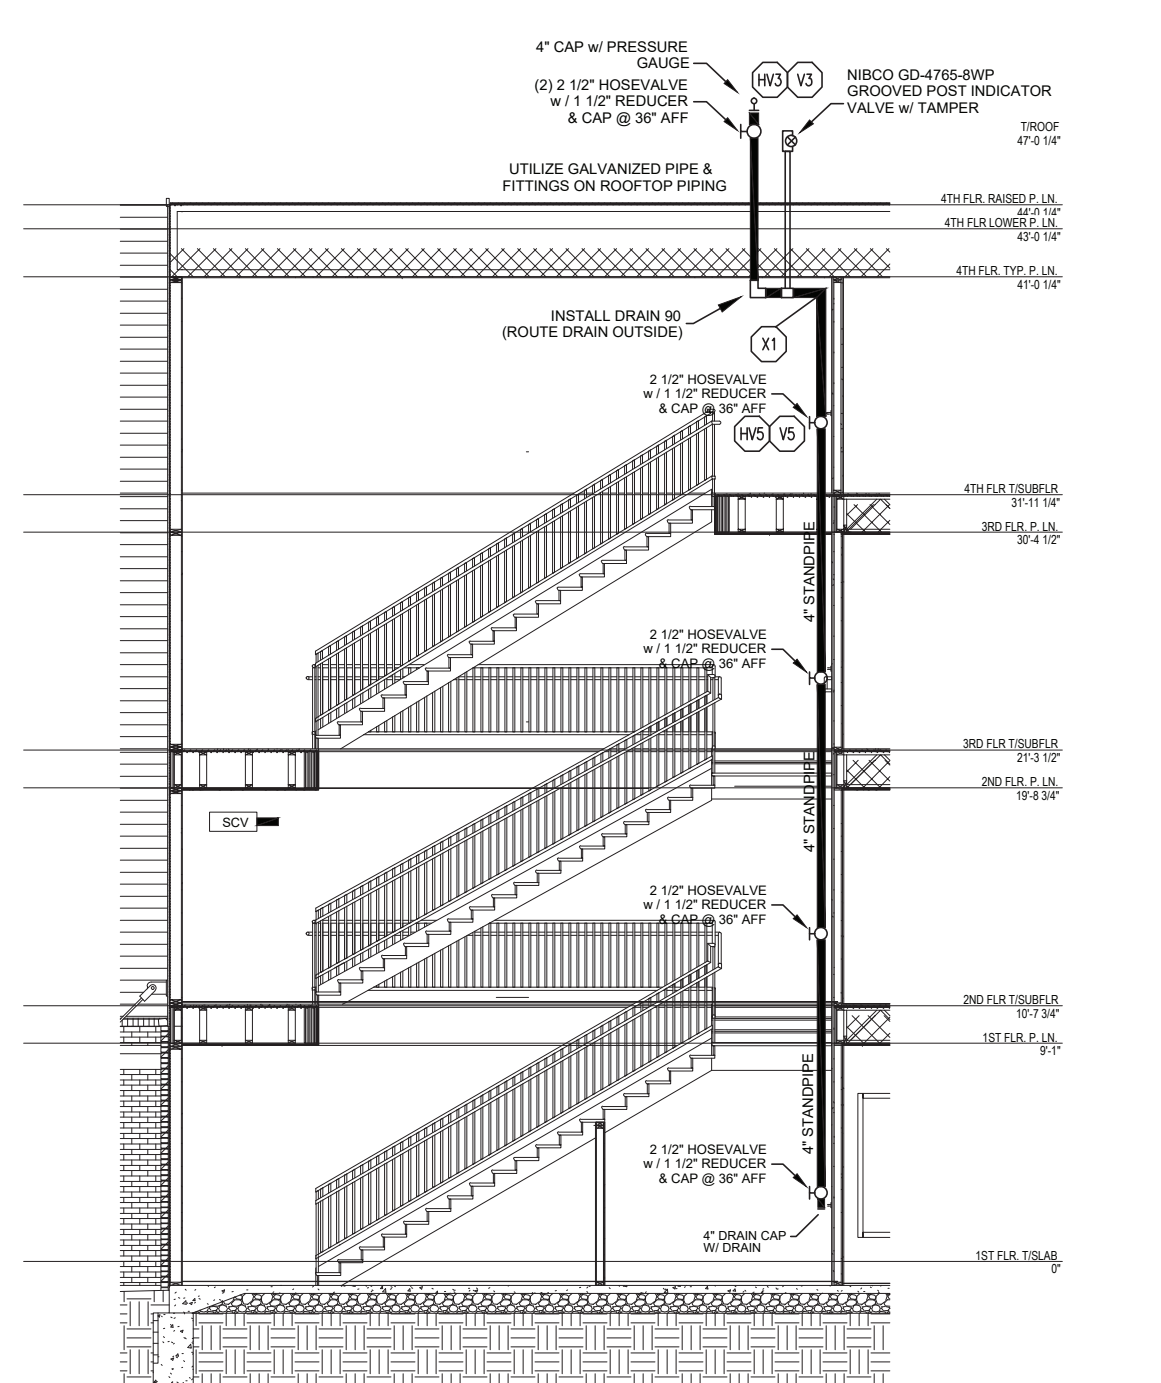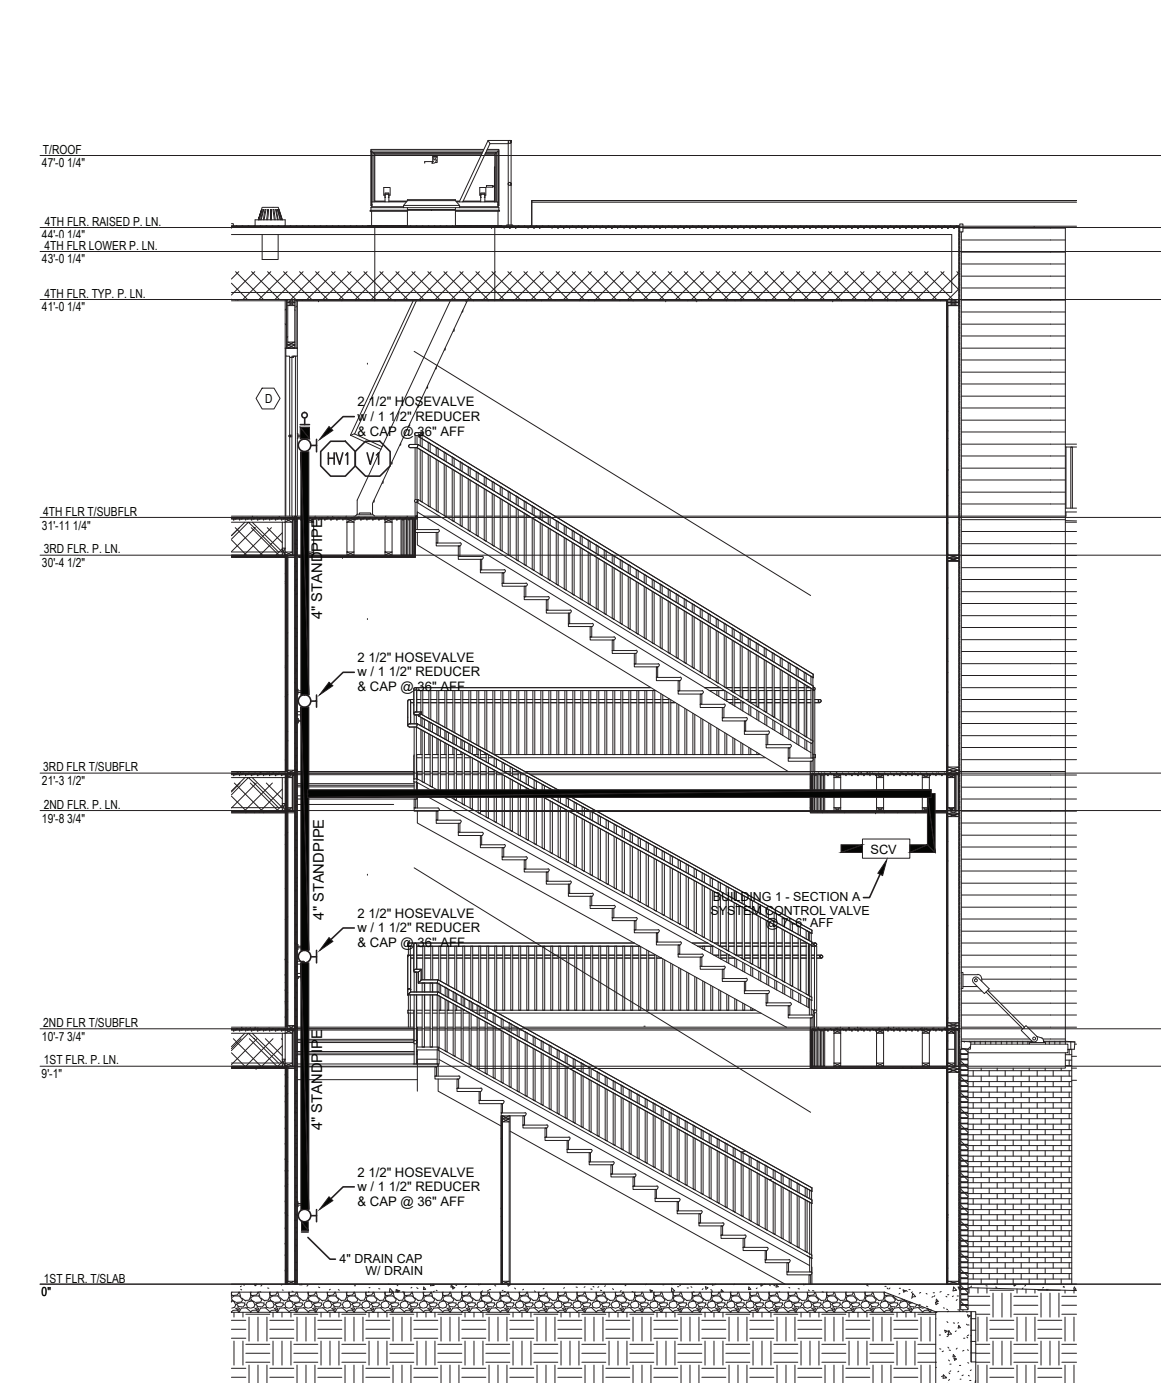[illegible]


SCALE: AS SHOWN DRAWN BY: T.G. CHECKED BY: J.G. DATE: 12/17/13	CONTRACT NAME: SUMMIT SQUARE III 800 & 810 NW SUMMIT ROAD LEE'S SUMMIT, MO	
DWG. NO.: 3 of 14 CONTRACT #. 9006 DESCRIPTION: MPA 13 & 13R	RANGER TIRE	


SECTION A WET & DRY SYSTEM HAS BEEN HYDRAULICALLY CALCULATED
SECTION B WET & DRY SYSTEM HAS BEEN HYDRAULICALLY CALCULATED
SECTION C WET & DRY SYSTEM HAS BEEN HYDRAULICALLY SIZED TYPICAL TO SECTION A WET & DRY SYSTEM
SECTION D WET & DRY SYSTEM HAS BEEN HYDRAULICALLY SIZED TYPICAL TO SECTION A WET & DRY SYSTEM
SECTION E WET & DRY SYSTEM HAS BEEN HYDRAULICALLY SIZED TYPICAL TO SECTION A WET & DRY SYSTEM


SECTION F WET SYSTEM HAS BEEN HYDRAULICALLY SIZED TYPICAL TO SECTION A


SECTION G DRY SYSTEM HAS BEEN HYDRAULICALLY SIZED TYPICAL TO SECTION A DRY SYSTEM
SECTION G WET SYSTEM HAS BEEN HYDRAULICALLY CALCULATED
SECTION H WET & DRY SYSTEM HAS BEEN HYDRAULICALLY SIZED TYPICAL TO SECTION A WET & DRY SYSTEM
SECTION J WET SYSTEM HAS BEEN HYDRAULICALLY SIZED TYPICAL TO SECTION A WET SYSTEM
SECTION J DRY SYSTEM HAS BEEN HYDRAULICALLY SIZED TYPICAL TO SECTION F DRY SYSTEM


LEGEND


 VERTICAL PIPE (UP OR DN)


 HYDRAULIC NODE



 WET SYSTEM - CPVC PIPE (u.o.n.)

 LOW PRESSURE DRY SYSTEM - CPVC PIPE (SLOPE TO DRAIN)

 CEILING HEIGHT


 2 1/2" HOSE VALVE W/ 1 1/2" REDUCER & CAP

 VERTICAL PIPE (UP OR DN) - DRY SYSTEM

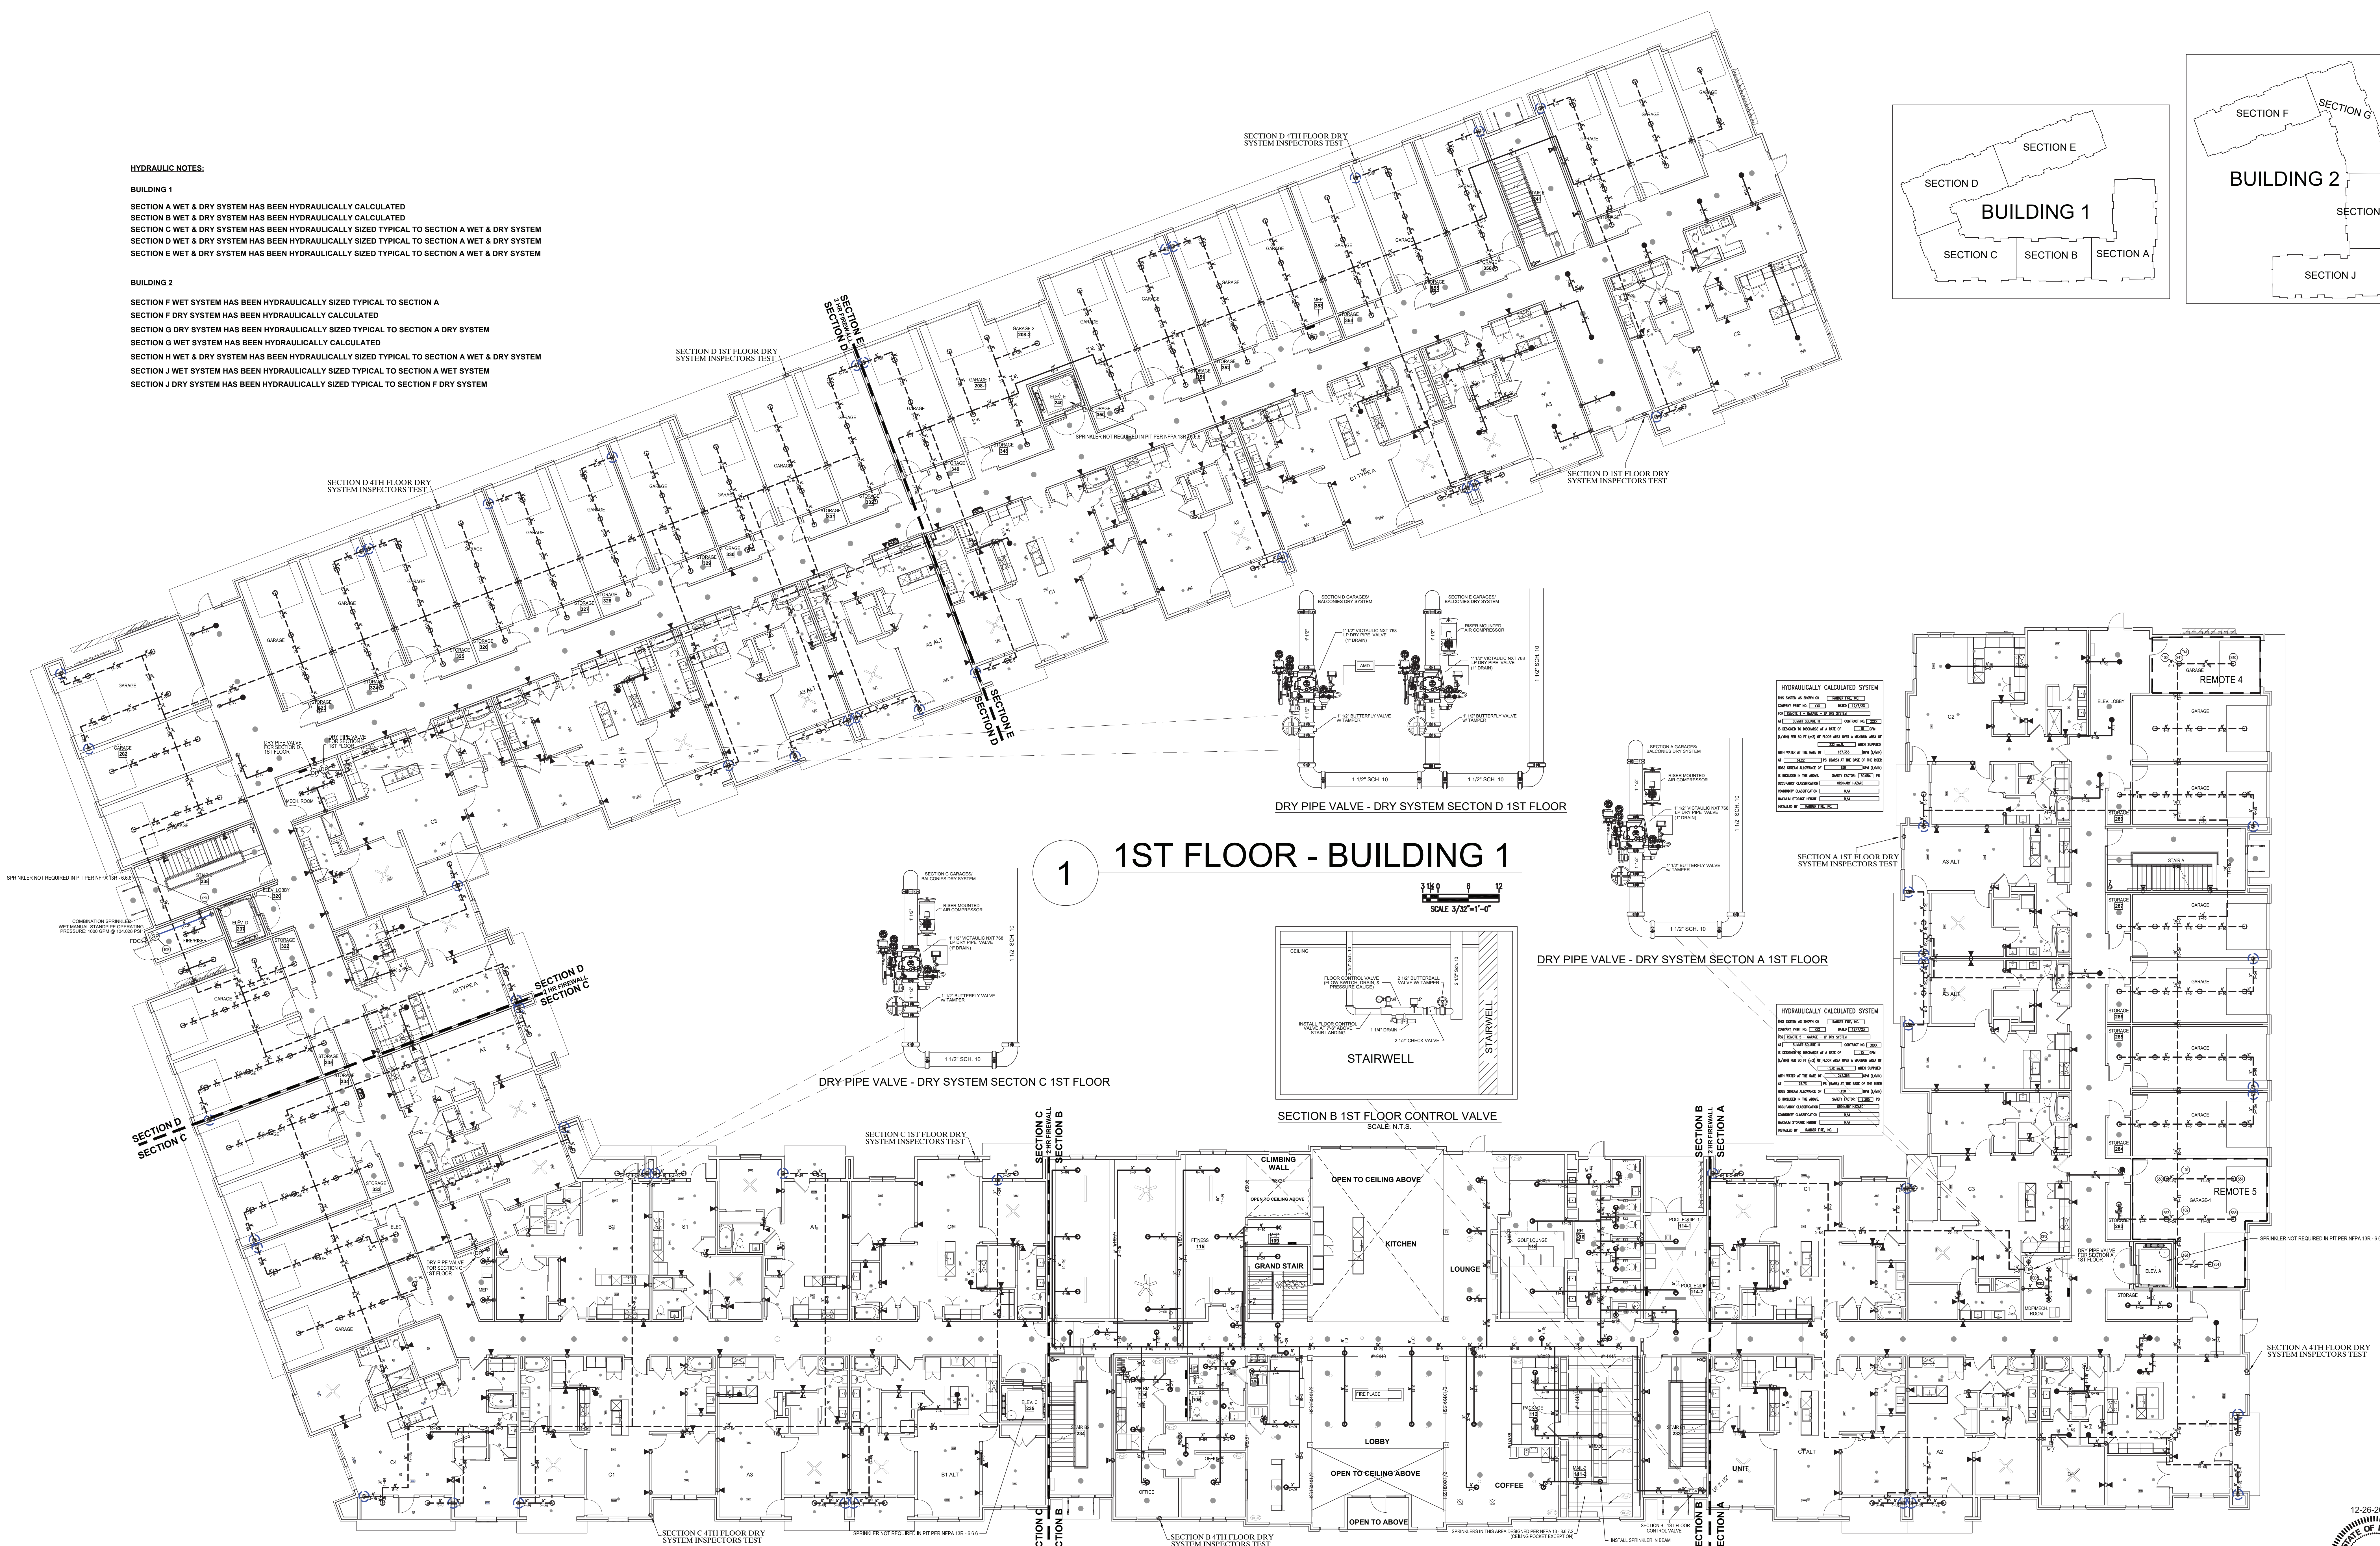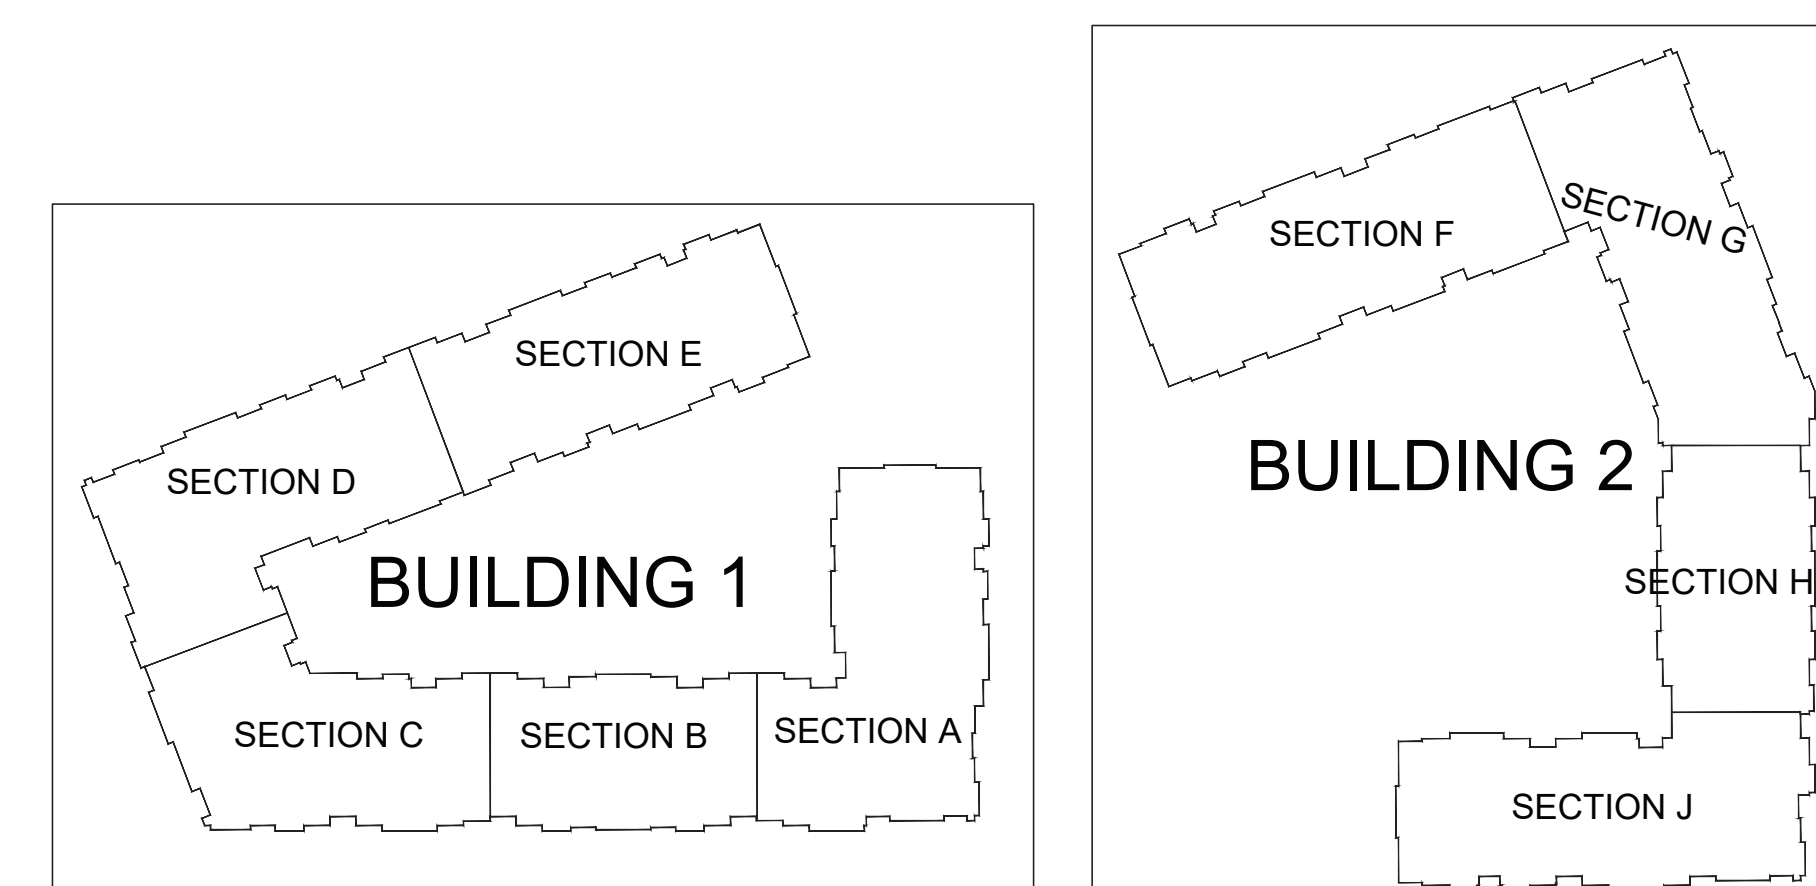


LEVEL 1 - BUILDING 1

12-26-2023

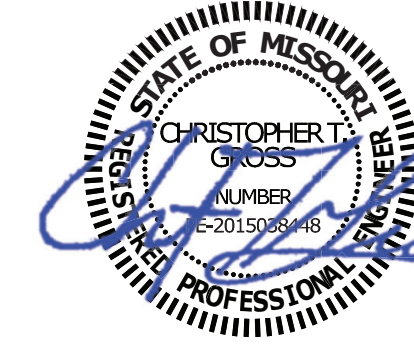

SCALE:	As Shown	CONTRACT NAME:	
DRAWN BY:	T.G.		
CHECKED BY:	J.G.		
DATE:	12/7/23		
DWS. NO.:	4 of 14		
		CONTRACT #:	XXX

SUMMIT SQUARE III
800 & 810 NW WARD ROAD
LEE'S SUMMIT, MO

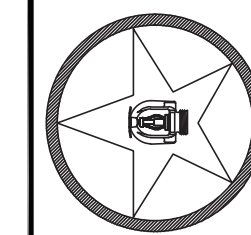

RANGER FIRE



[illegible]

OWNER:	
NORTHPOINT DEVELOPMENT	
3315 N. OAK TRAIL	
KANSAS CITY, MO	
516-888-7700	
CONTRACTOR:	
NEIGHBORS CONSTRUCTION	
1708 E. 123RD	
OLATHE, KS 64602	
913-422-5500	

[illegible]



Ranger Fire, Inc.
1000 South Main Street, Suite 200
Grapevine, Texas 76051

MISSOURI PE COA #2016025677
CG Engineering, LLC
1624 N Glen Elyn
Independence, MO 64056
816-516-9540

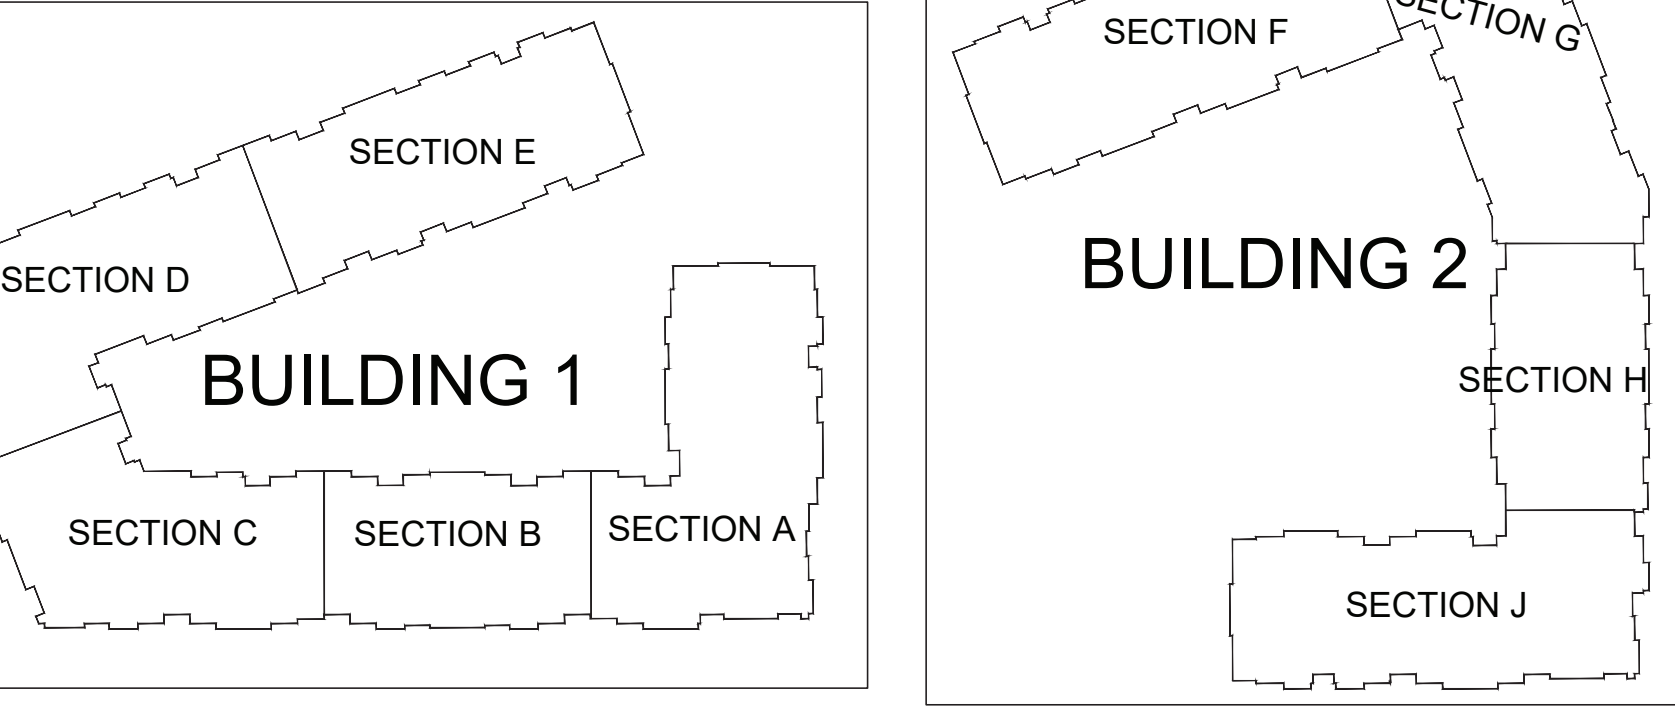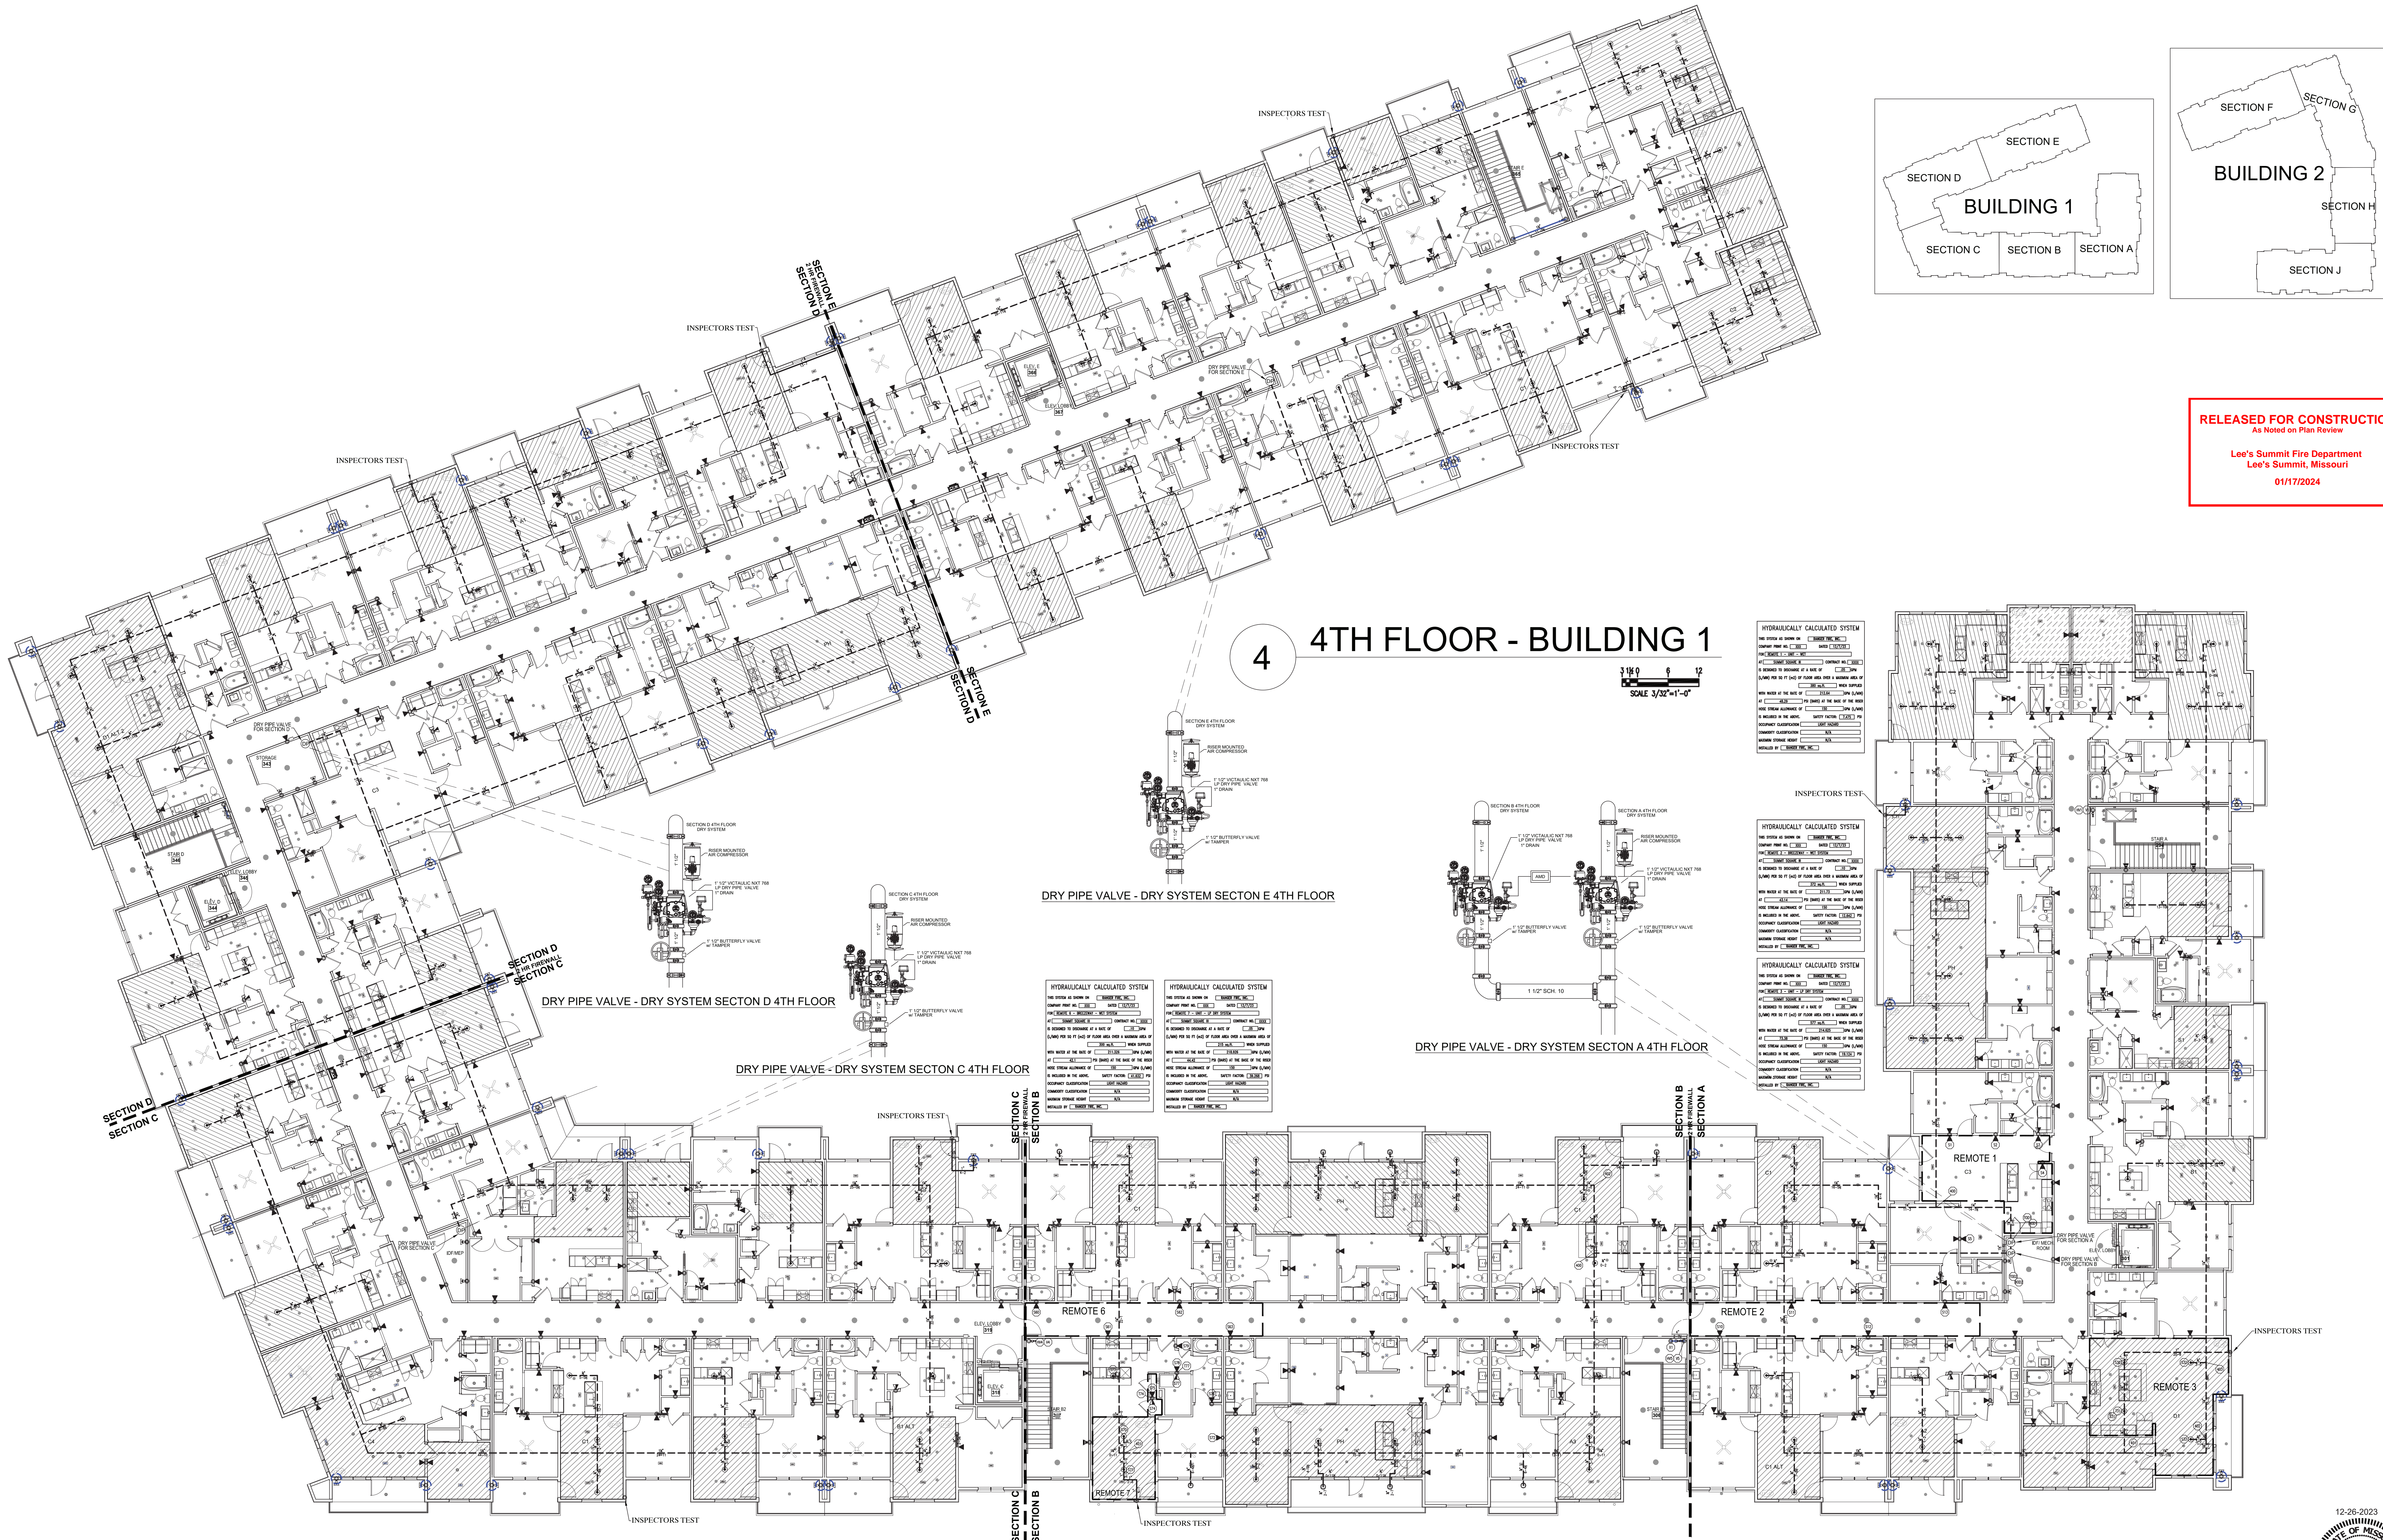


RELEASED FOR CONSTRUCTION
As Noted on Plan Review

Lee's Summit Fire Department
Lee's Summit, Missouri
01/17/2024

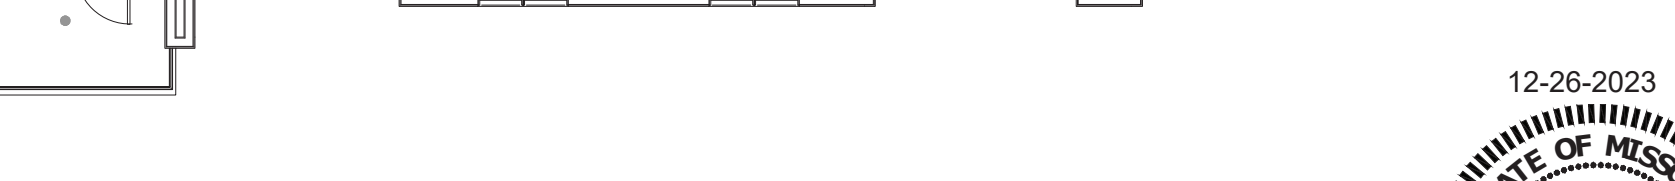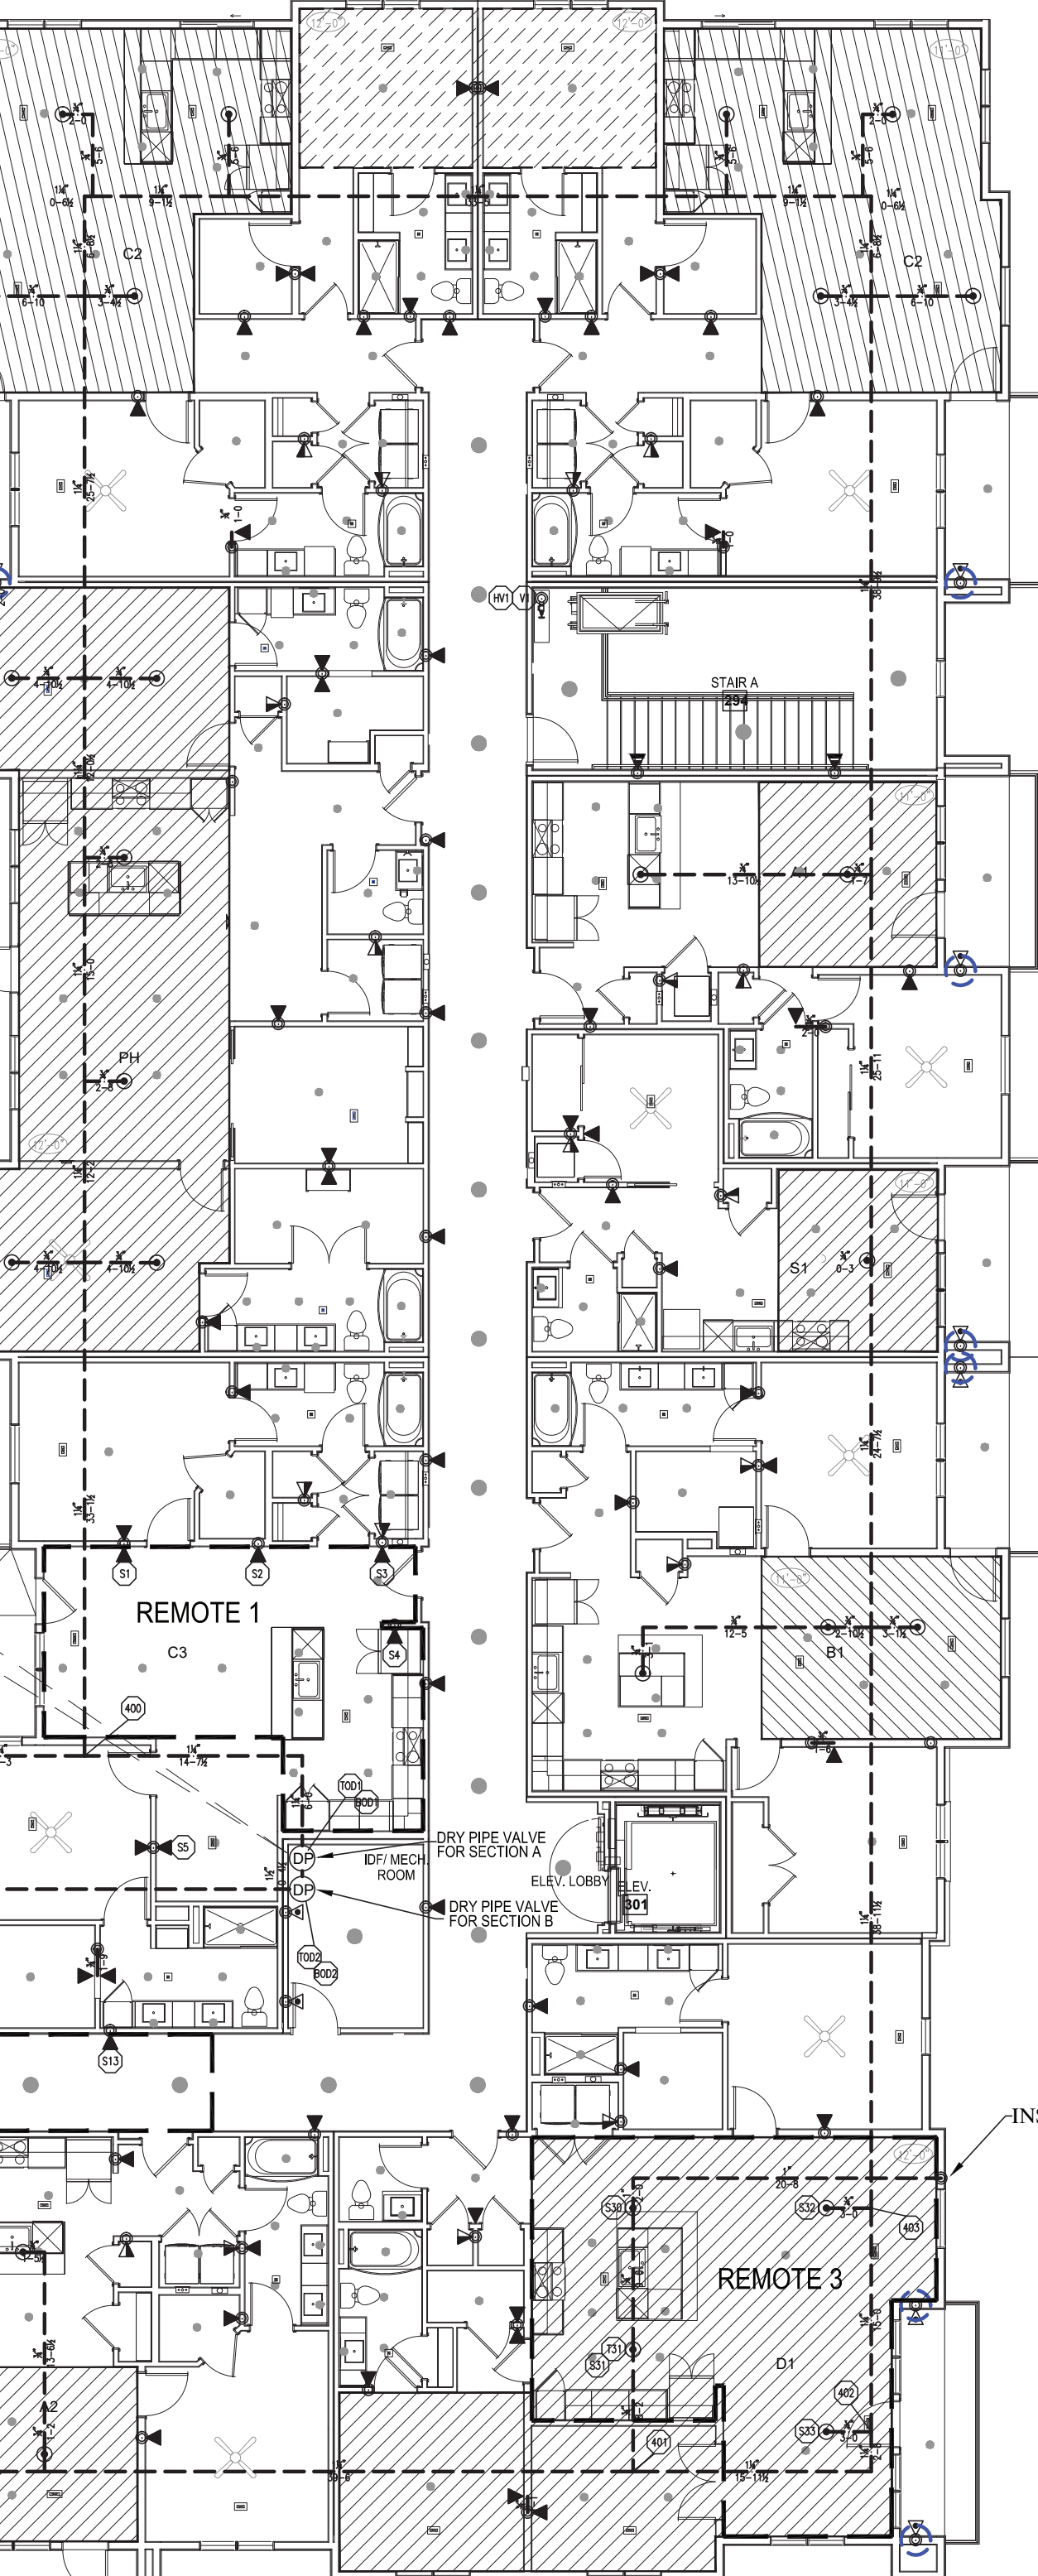

B BASEMENT - BUILDING 2

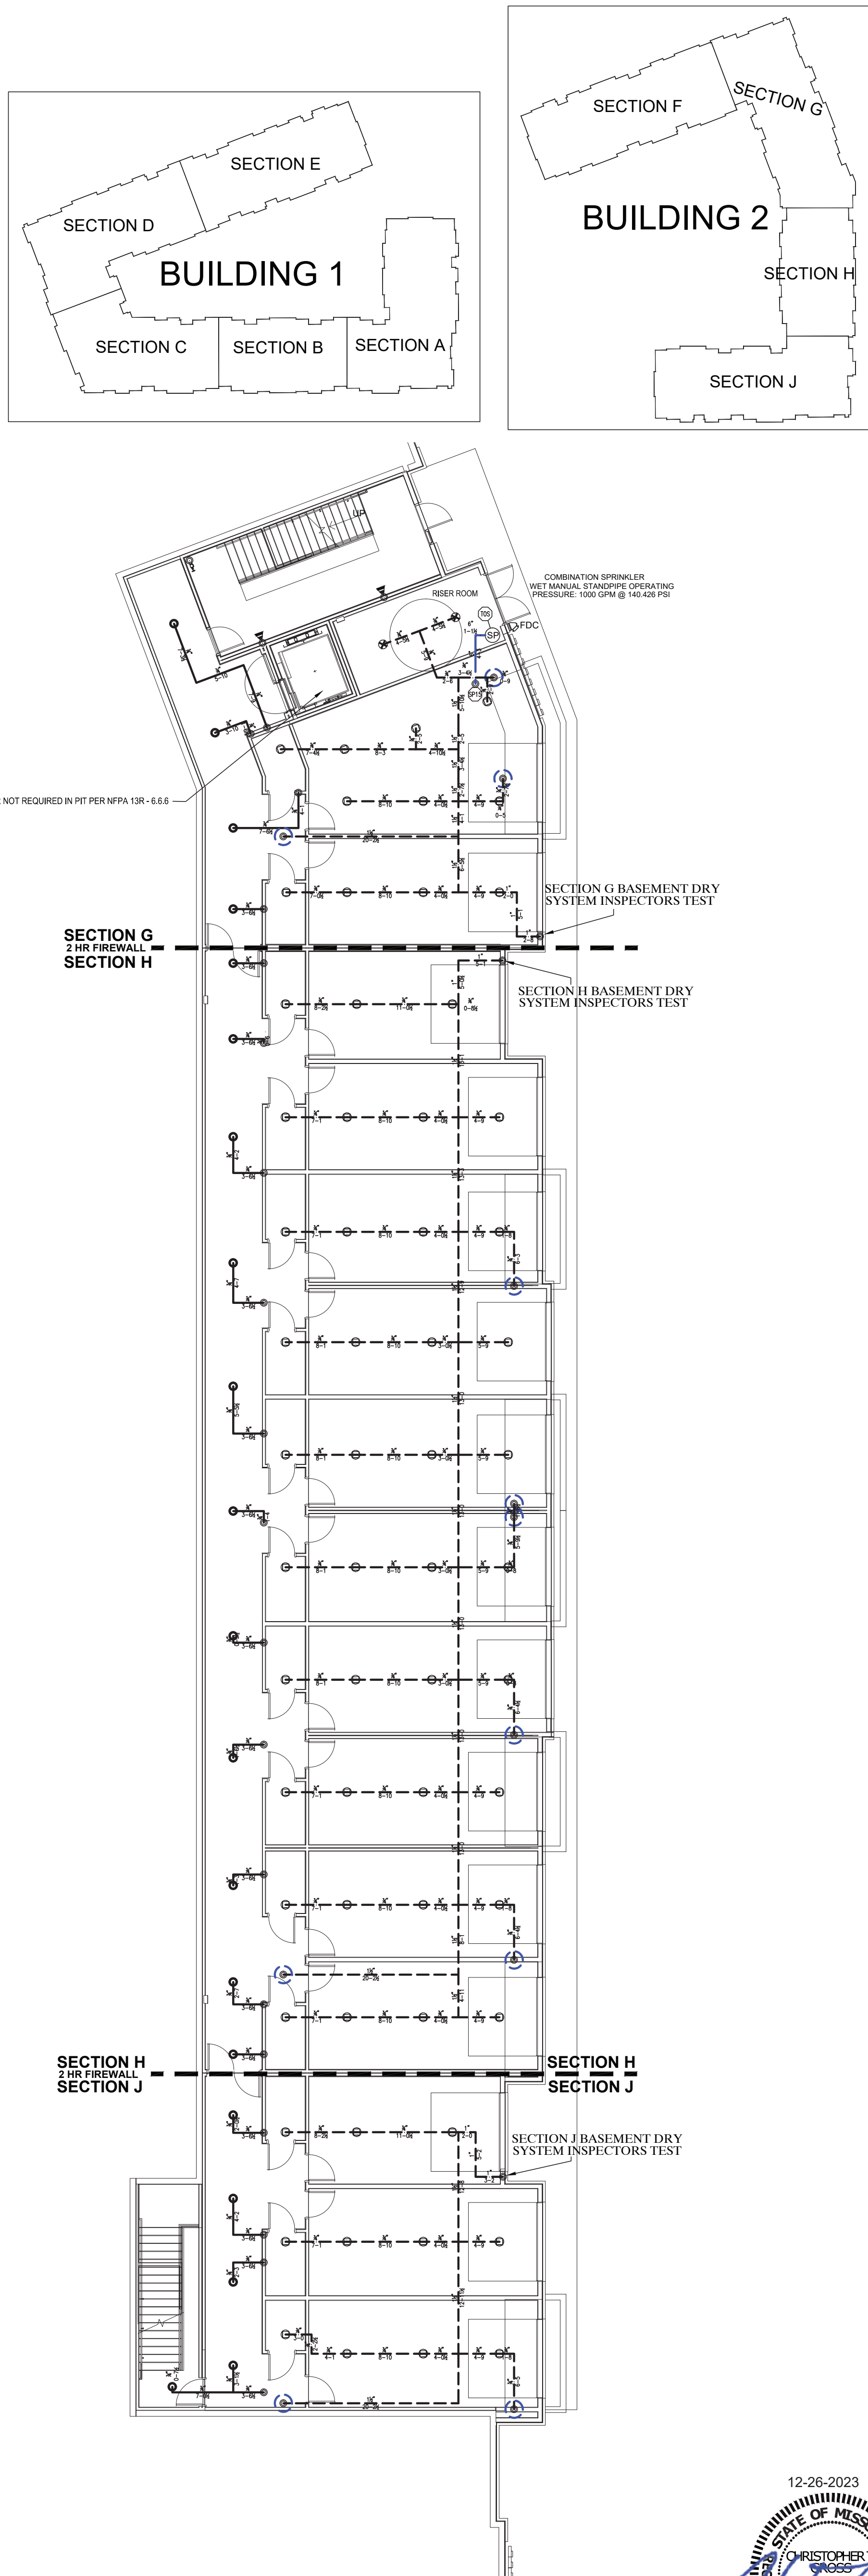

- LEGEND
- VERTICAL PIPE (UP OR DN)
 - HYDRAULIC NODE
 - WET SYSTEM - CPVC PIPE (u.o.n.)
 - - - LOW PRESSURE DRY SYSTEM - CPVC PIPE (SLOPE TO DRAIN)
 - CEILING HEIGHT
 - 2 1/2" HOSE VALVE W/ 1 1/2" REDUCER & CAP
 - VERTICAL PIPE (UP OR DN) - DRY SYSTEM



BASEMENT - BUILDING 2

SCALE: As Shown		CONTRACT NAME: SUMMIT SQUARE III		RANGER FIRE	
DRAWN BY: T.G.		800 & 810 NW WARD ROAD		LEE'S SUMMIT, MO	
CHECKED BY: J.G.		CONTRACT # XXX		DESCRIPTION: NFPA 13 & 13R	
DATE: 12/7/23		9 of 14		RANGER FIRE	
DWS. NO:		MISSOURI PE COA #2016025677		ENGINEERING, LLC	
		1824 N Glen Elyn		Independence, MO 64056	
		816-516-9540			

CONFIDENTIALITY STATEMENT

This document is the property of Ranger Fire, Inc. and is intended for the use of the client only. It is not to be distributed, copied, or otherwise used without the written consent of Ranger Fire, Inc. The client agrees to hold Ranger Fire, Inc. harmless from and against all claims, damages, and expenses, including reasonable attorneys' fees, arising out of the use of this document for any purpose other than that intended by Ranger Fire, Inc.

REVISIONS

NO.	DATE	DESCRIPTION
1	12/7/23	ISSUED FOR PERMIT
2	12/7/23	WHITE SPRINKLER
3	12/7/23	WHITE SPRINKLER
OWNER: SUMMIT SQUARE III
3315 N. Oak Trafficway
Kansas City, MO 64116


CONTRACTOR: NEIGHBORE CONSTRUCTION COMPANY, INC.
1708 E. 132nd Street
Independence, MO 64056

CONFIDENTIALITY STATEMENT

This document is the property of Ranger Fire, Inc. and is intended for the use of the client only. It is not to be distributed, copied, or otherwise used without the written consent of Ranger Fire, Inc. The client agrees to hold Ranger Fire, Inc. harmless from and against all claims, damages, and expenses, including reasonable attorneys' fees, arising out of the use of this document for any purpose other than that intended by Ranger Fire, Inc.

REVISIONS

NO.	DATE	DESCRIPTION
1	12/7/23	ISSUED FOR PERMIT
2	12/7/23	WHITE SPRINKLER
3	12/7/23	WHITE SPRINKLER
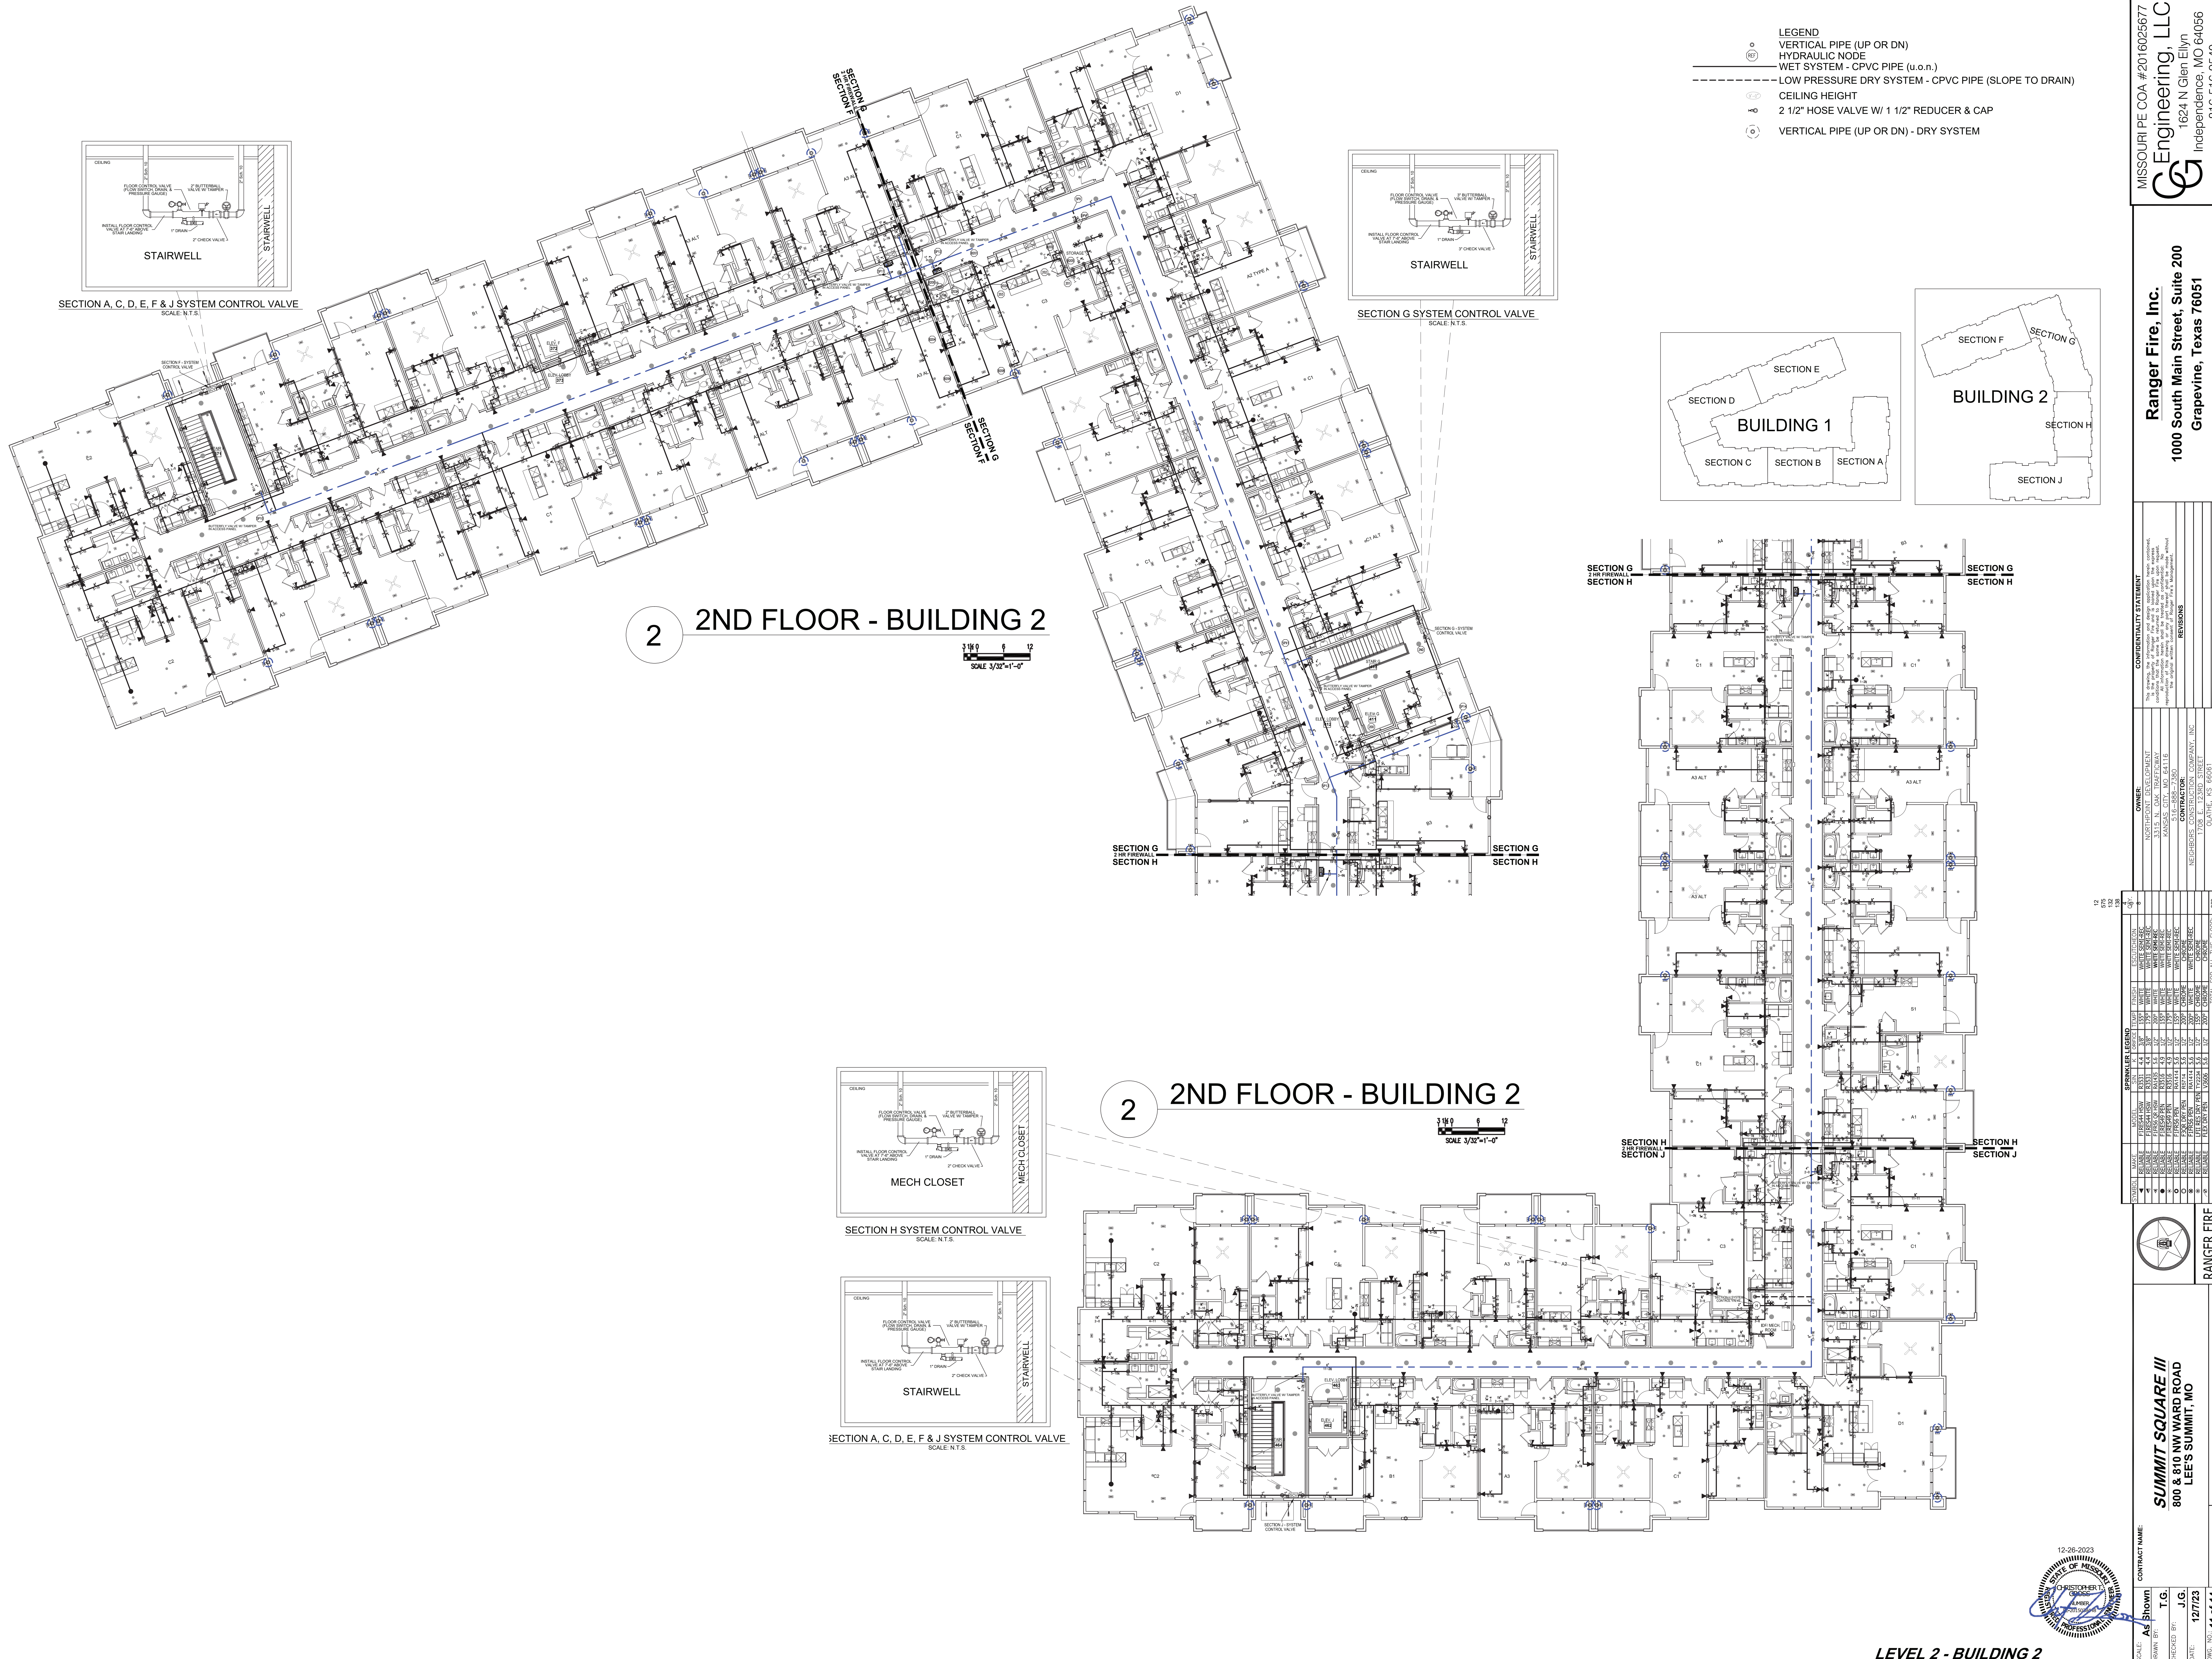

MISSOURI PE COA #2016025677

Engineering, LLC

1824 N Glen Ellyn
Independence, MO 64056
816-516-9540

Ranger Fire, Inc.

1000 South Main Street, Suite 200
Grapevine, Texas 76051

CONFIDENTIALITY STATEMENT

This document contains information that is confidential to the client. It is to be used only for the purpose intended and is not to be distributed to other personnel without the express written consent of the client. The client agrees to hold the information confidential and to protect it from unauthorized disclosure.

REVISIONS

NO.	DATE	DESCRIPTION
1	12/26/2023	ISSUED FOR PERMIT
2	12/26/2023	ISSUED FOR PERMIT
3	12/26/2023	ISSUED FOR PERMIT
OWNER:
ASTORIA N. OAK TRAFFICWAY
3315 N. OAK TRAFFICWAY
KANSAS CITY, MO 64116

CONTRACTOR:
NEIGHBORE CONSTRUCTION COMPANY, INC.
1708 E. 132ND STREET
KANSAS CITY, MO 64124
913-422-5555

CONTRACT NAME:
SUMMIT SQUARE III
800 & 810 NW WARD ROAD
LEE'S SUMMIT, MO

CONTRACT #: XXX

DESCRIPTION: NFPA 13 & 13R

SCALE: As Shown

DRAWN BY: T.G.

CHECKED BY: J.G.

DATE: 12/17/23

DRS. NO.: 11 of 14

12-26-2023

STATE OF MISSOURI

REGISTERED PROFESSIONAL

EXPIRATION DATE: 12/31/2024

NO.: 11111

NAME: Christopher J. G. [Signature]

RANGER FIRE

12-26-2023


STATE OF MISSOURI

REGISTERED PROFESSIONAL


EXPIRATION DATE: 12/31/2024

NO.: 11111


NAME: Christopher J. G. [Signature]

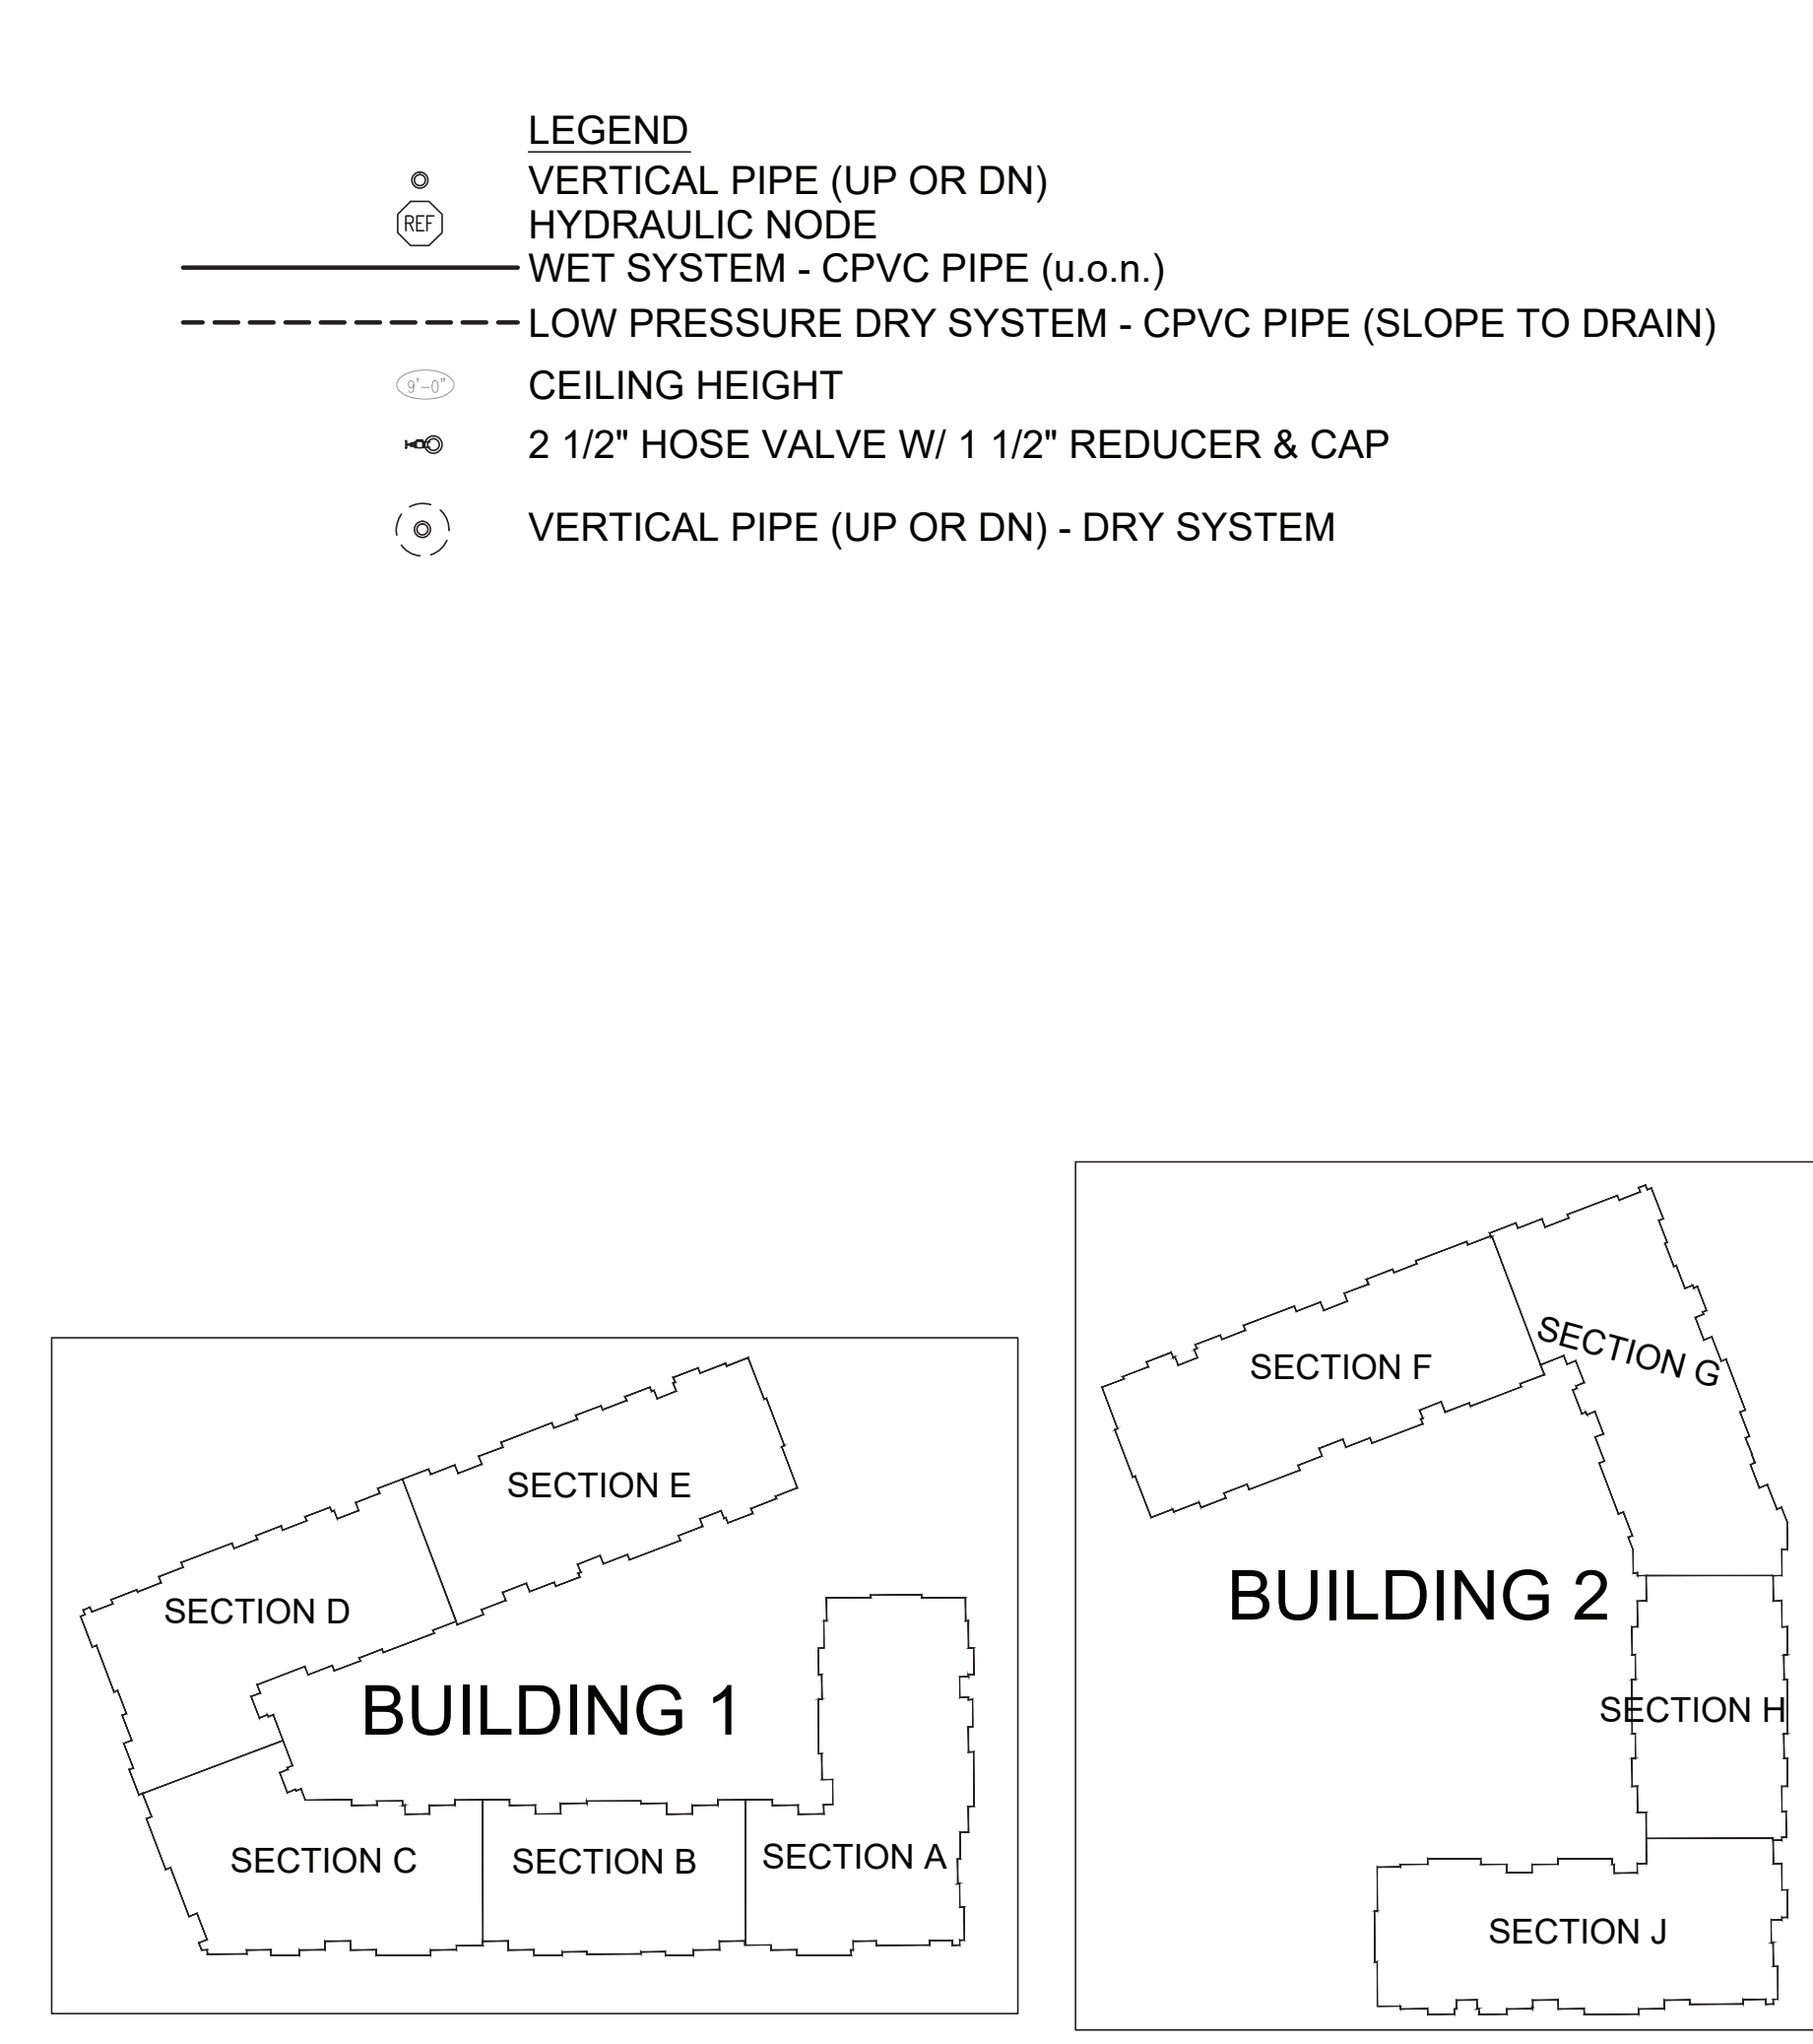

SECTION G
2 HR FIREWALL
SECTION H

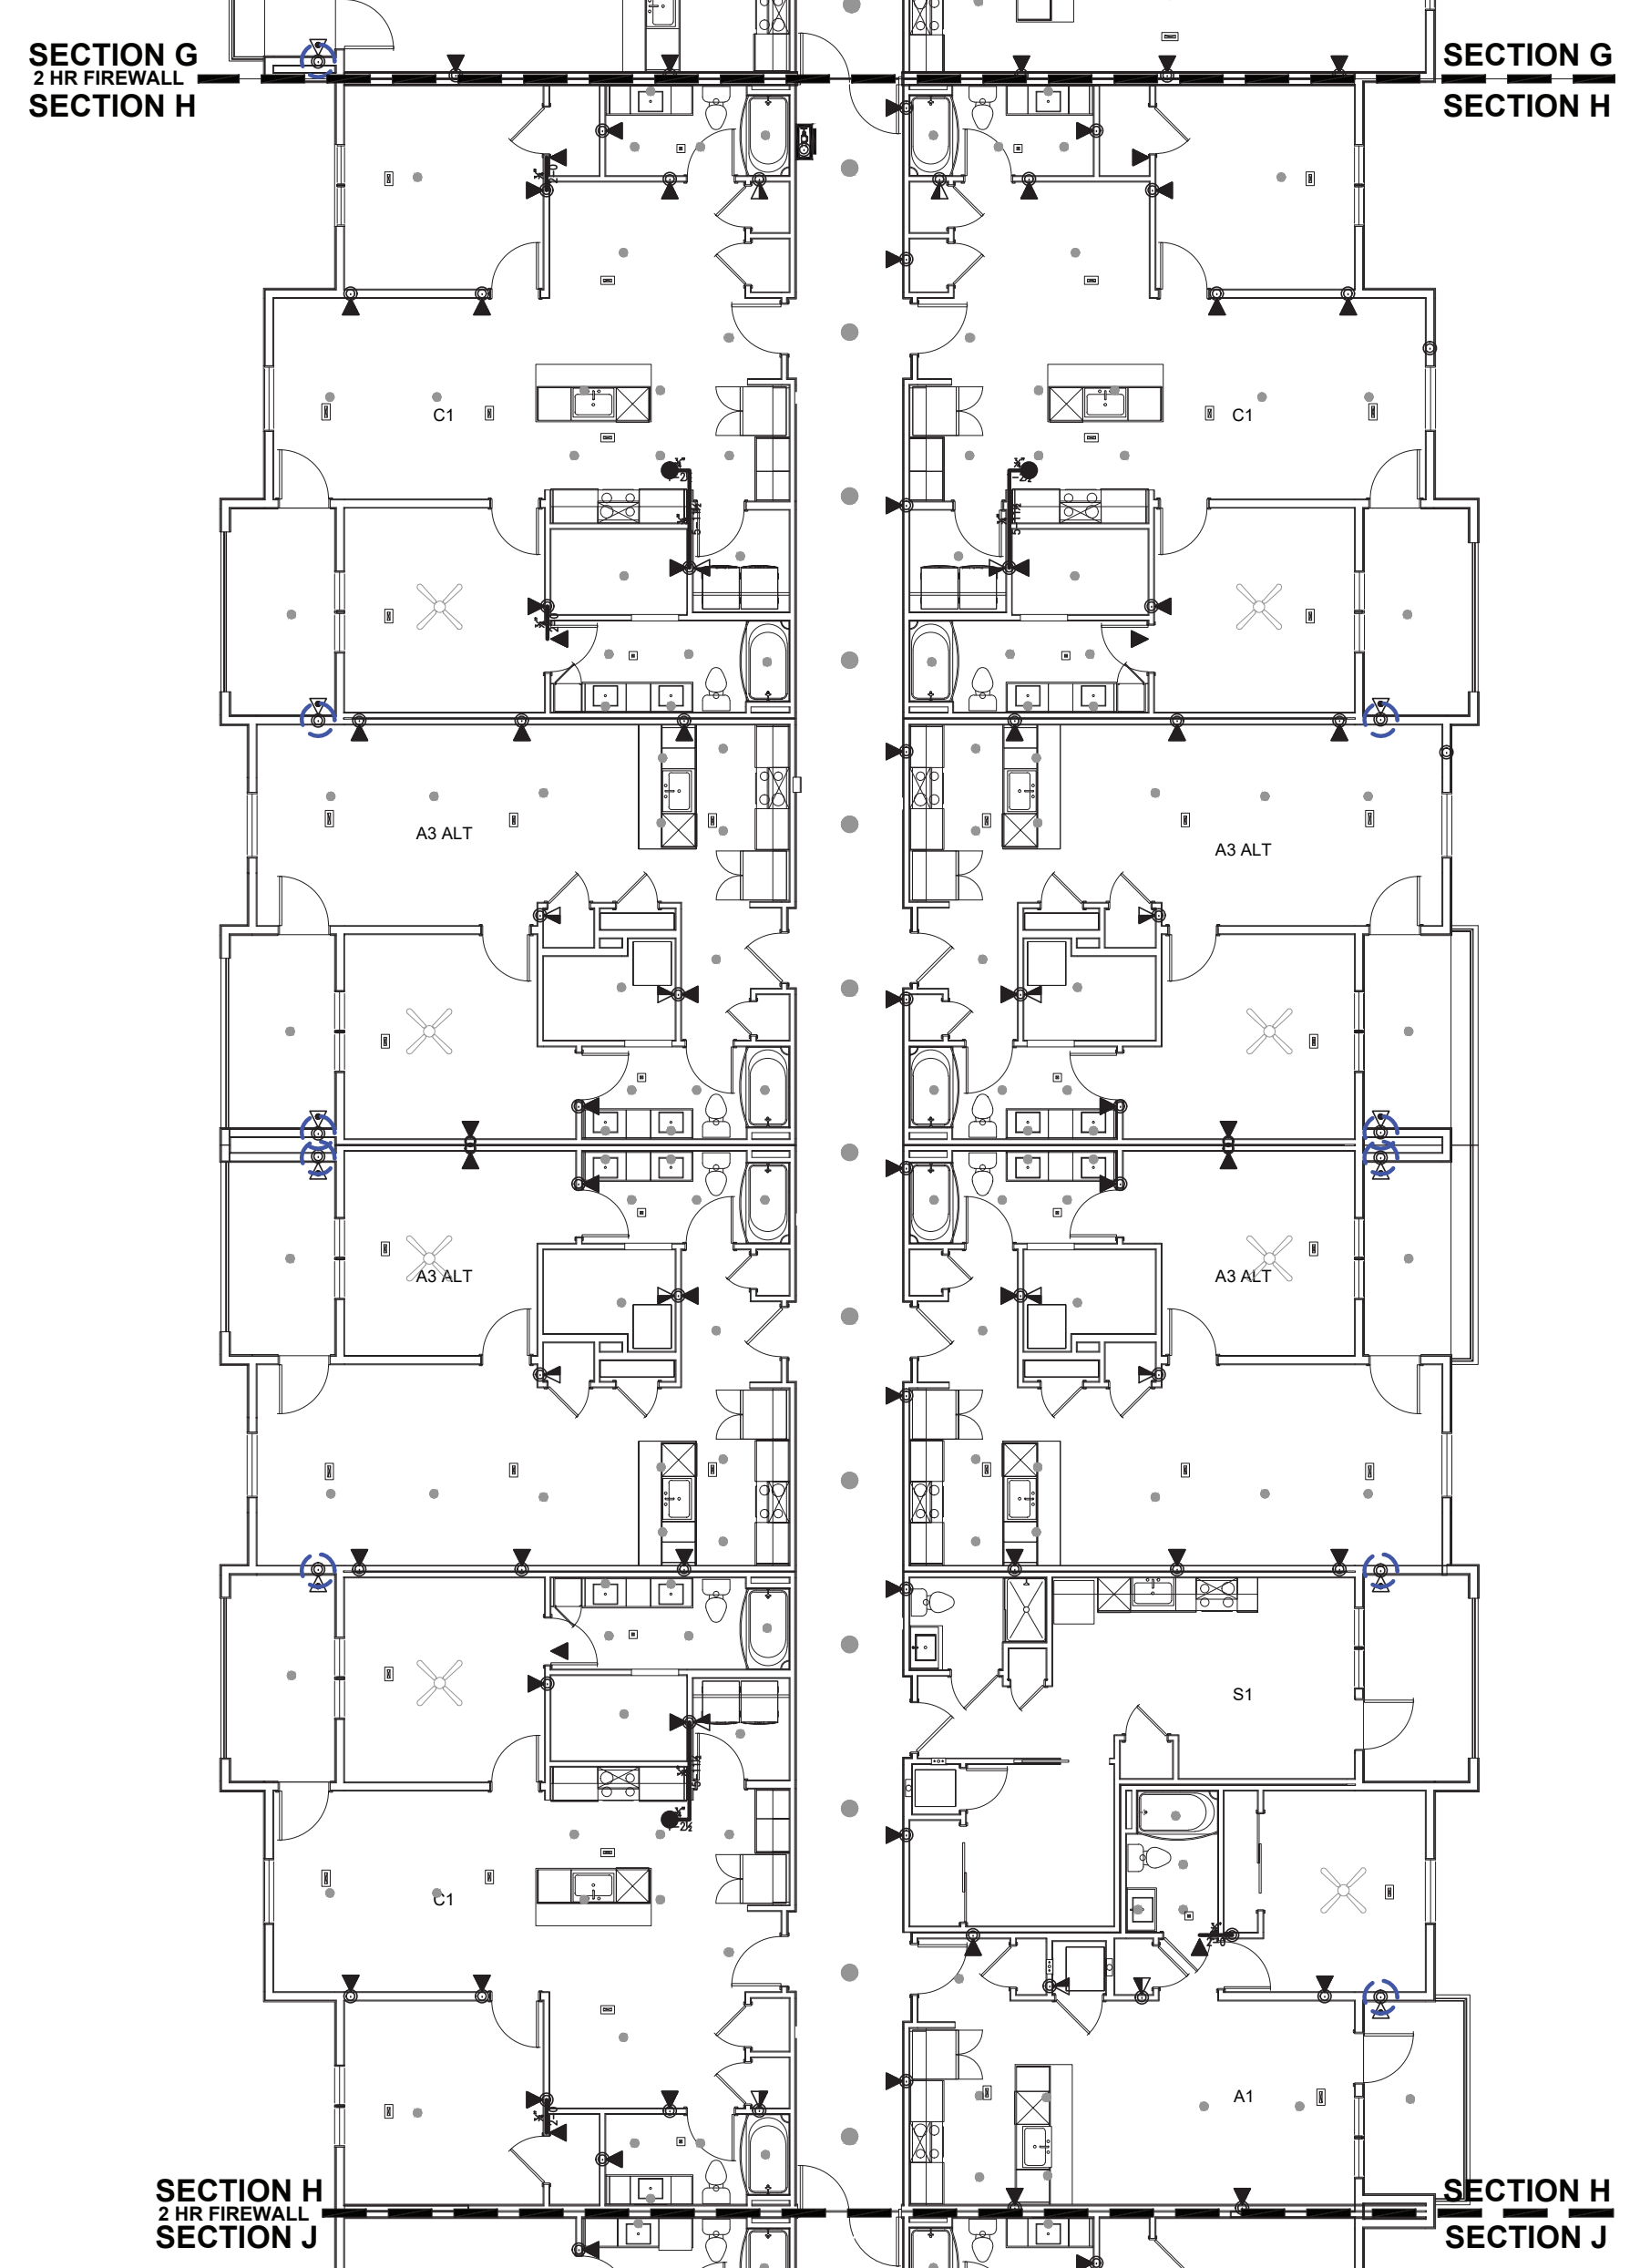


3 1/2 0 6 12
SCALE 3/32"=1'-0"

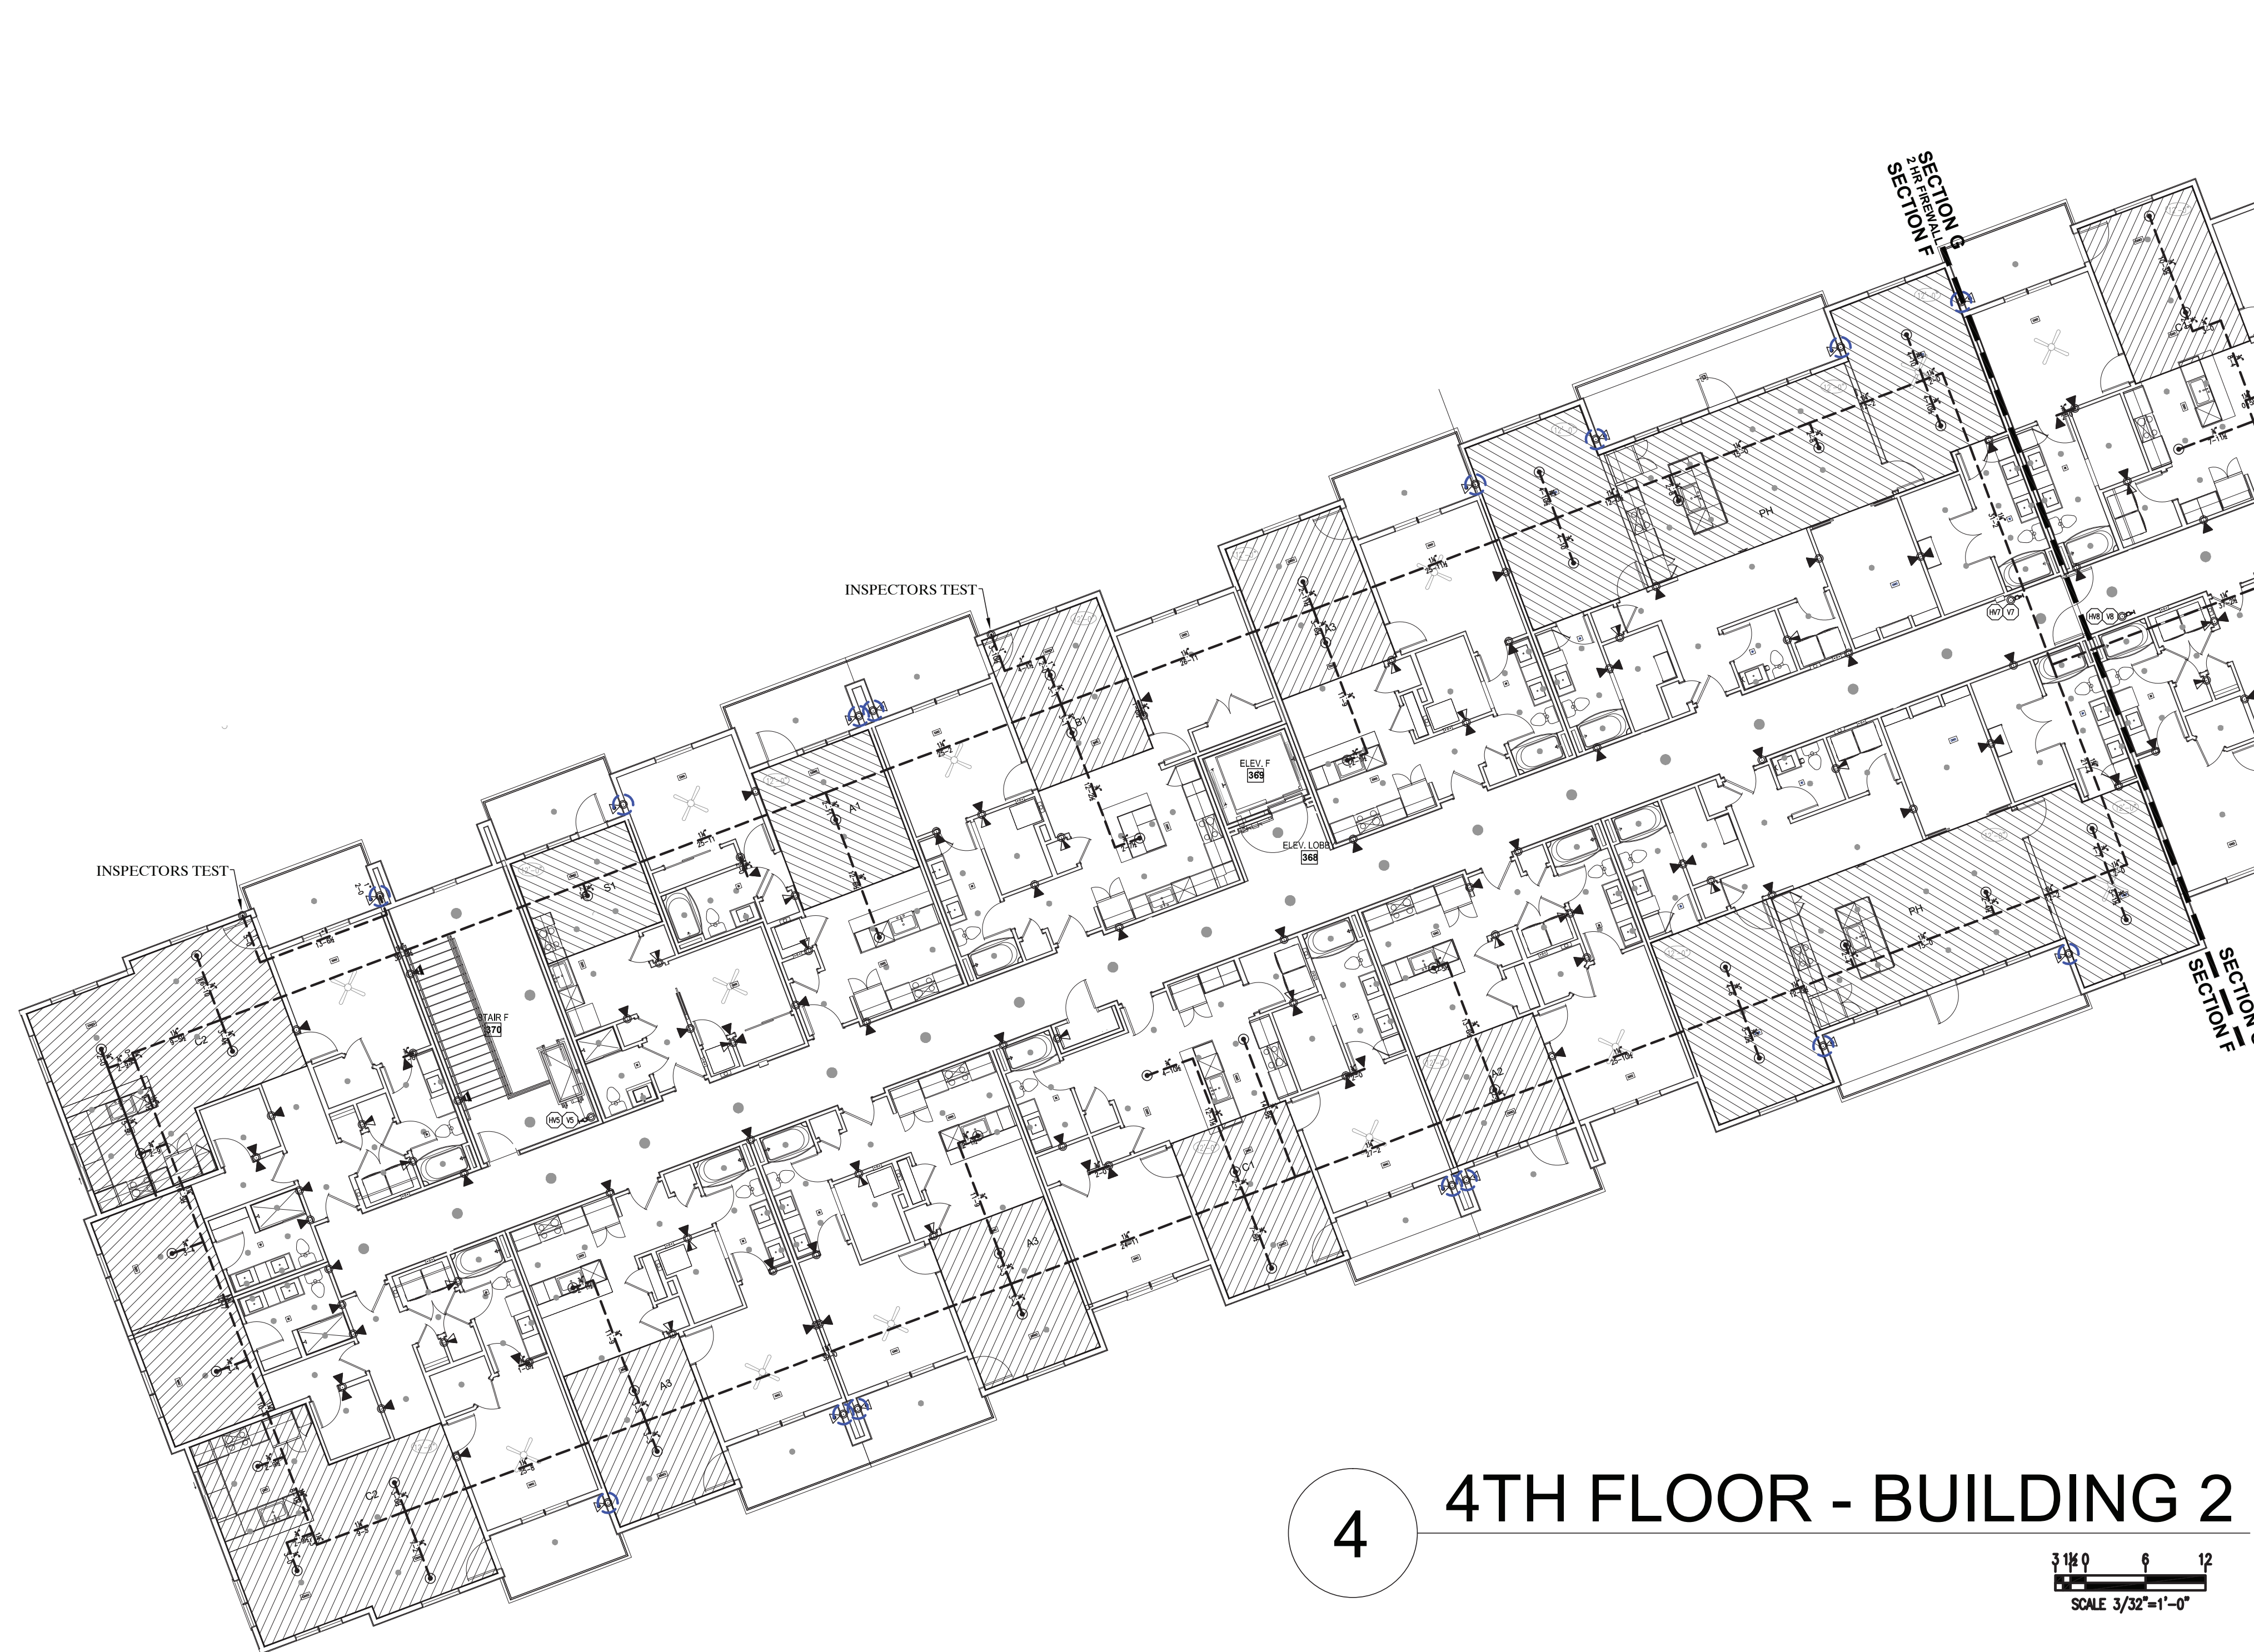


4 4TH FLOOR - BUILDING 2

3/16 0 6 12
SCALE 3/32"=1'-0"

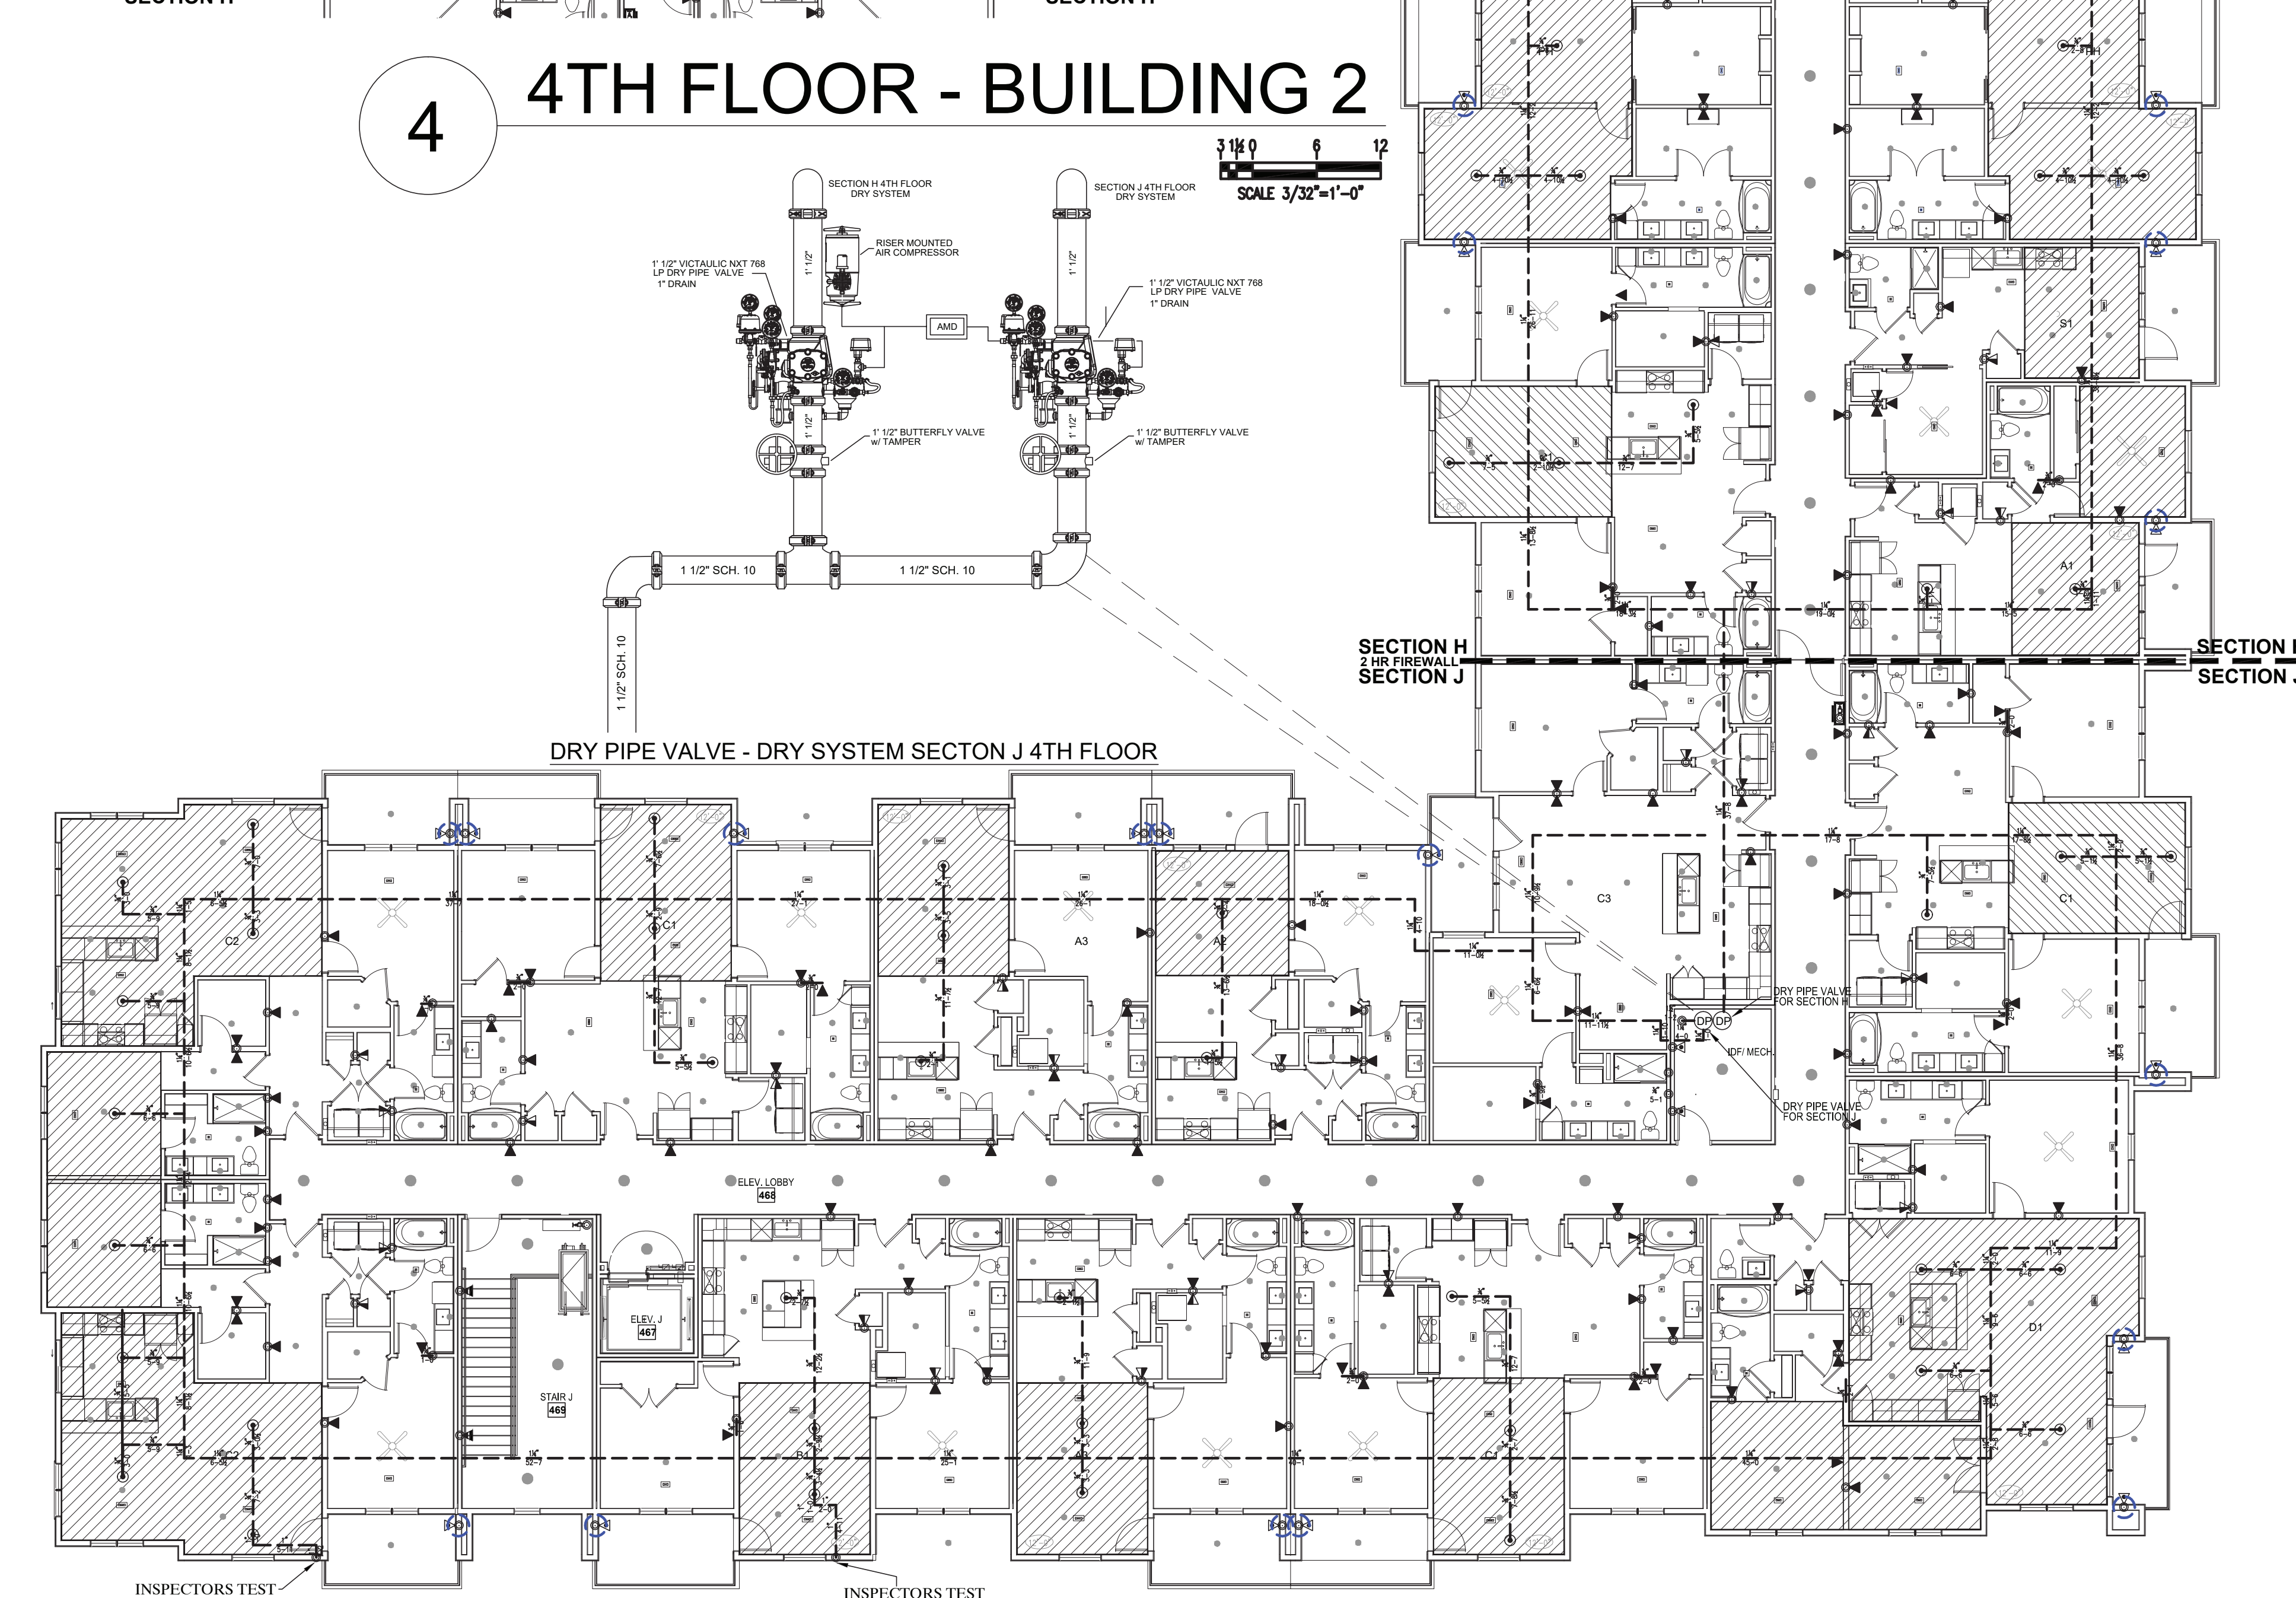

4 4TH FLOOR - BUILDING 2

3/16 0 6 12
SCALE 3/32"=1'-0"

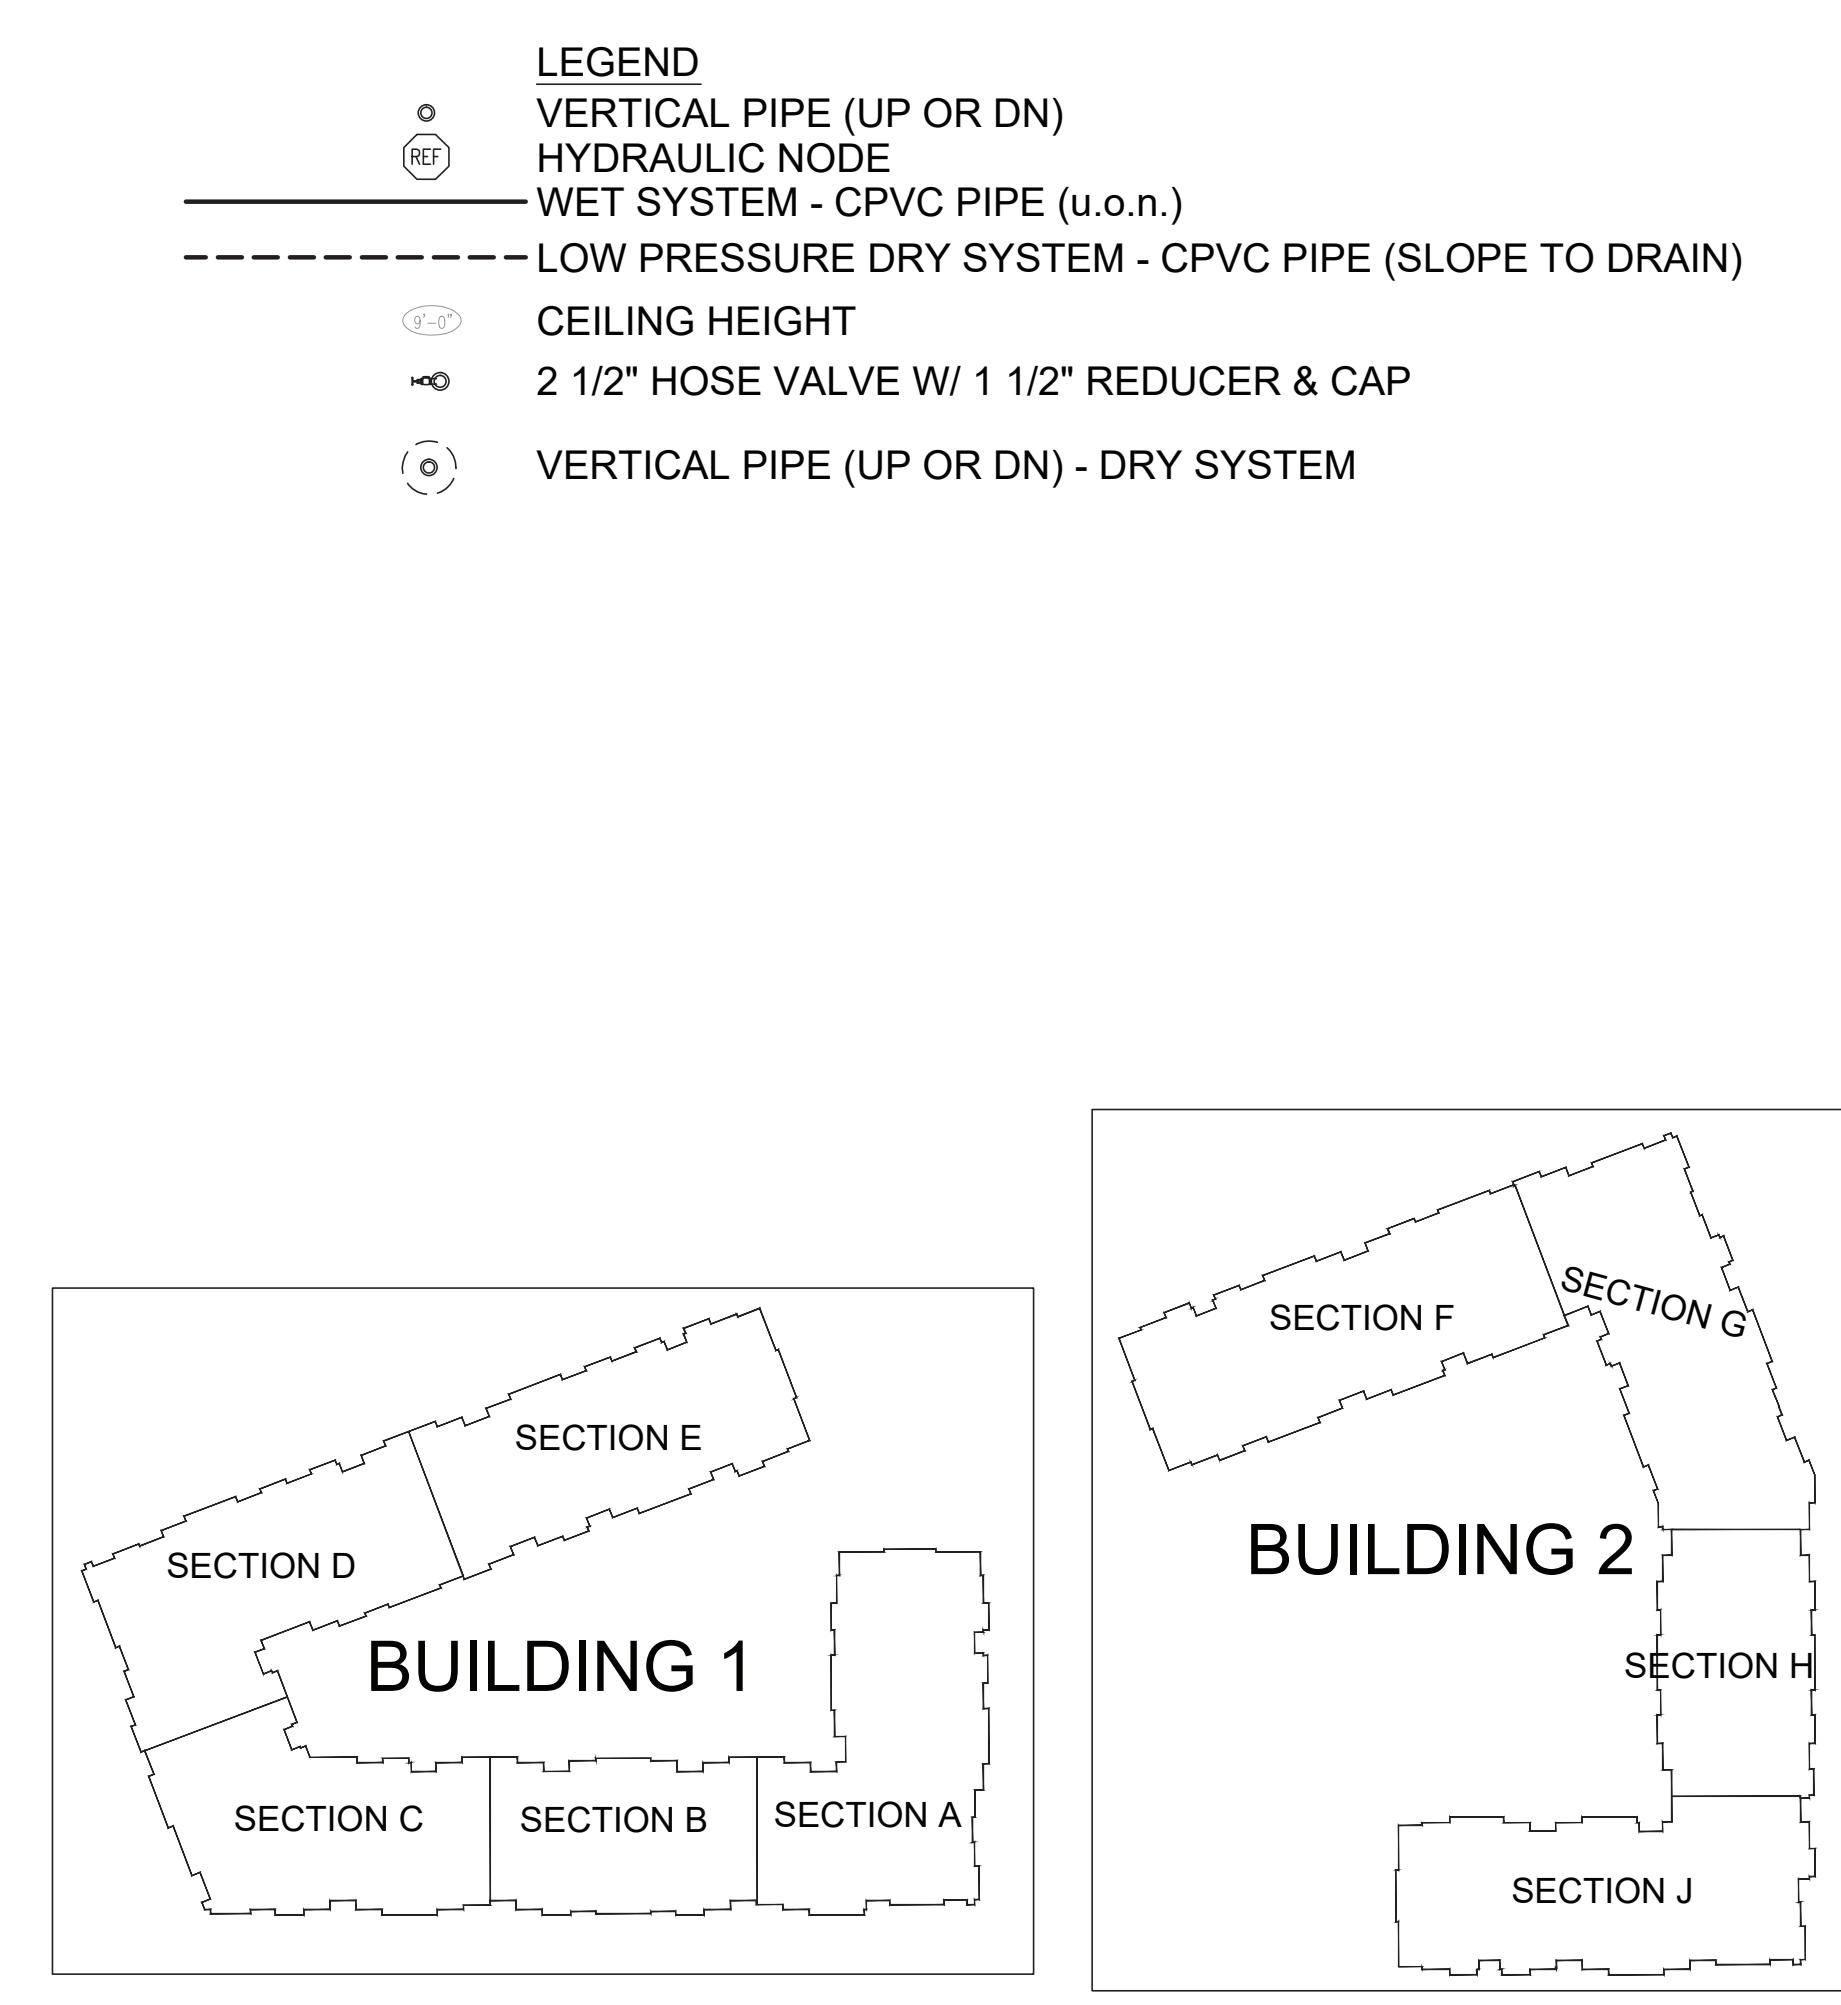

MISSOURI PE COA #2016025677

Engineering, LLC

1624 N Glen Ellyn
Independence, MO 64056
816-516-9540

Ranger Fire, Inc.

1000 South Main Street, Suite 200
Grapevine, Texas 76051

CONFIDENTIALITY STATEMENT	
This document is the property of Ranger Fire, Inc. and is intended for the use of the client only. It is not to be distributed, copied, or otherwise used without the written consent of Ranger Fire, Inc. The client agrees to hold Ranger Fire, Inc. harmless from any and all claims, damages, or expenses, including reasonable attorney's fees, arising from the use of this document for any purpose other than that for which it was intended.	
OWNER:	ASTORIA CITY, MO 64116
CONTRACTOR:	NEIGHBORHOOD CONSTRUCTION COMPANY, INC.
DATE:	12-26-2023
PROJECT:	800 & 810 NW WARD ROAD LEE'S SUMMIT, MO
CONTRACT #:	13 of 14

ITEM	QUANTITY	UNIT	PRICE	TOTAL
1.00	1.00	HR	100.00	100.00
2.00	1.00	HR	100.00	100.00
3.00	1.00	HR	100.00	100.00
12-26-2023

STATE OF MISSOURI

REGISTERED PROFESSIONAL ENGINEER

127/23

13 of 14

Summit Square III

800 & 810 NW WARD ROAD
LEE'S SUMMIT, MO

RANGER FIRE

800 & 810 NW WARD ROAD
LEE'S SUMMIT, MO

12-26-2023

STATE OF MISSOURI

REGISTERED PROFESSIONAL ENGINEER

127/23

13 of 14

Summit Square III

800 & 810 NW WARD ROAD
LEE'S SUMMIT, MO

RANGER FIRE

800 & 810 NW WARD ROAD
LEE'S SUMMIT, MO

LEVEL 4 - BUILDING 2

