
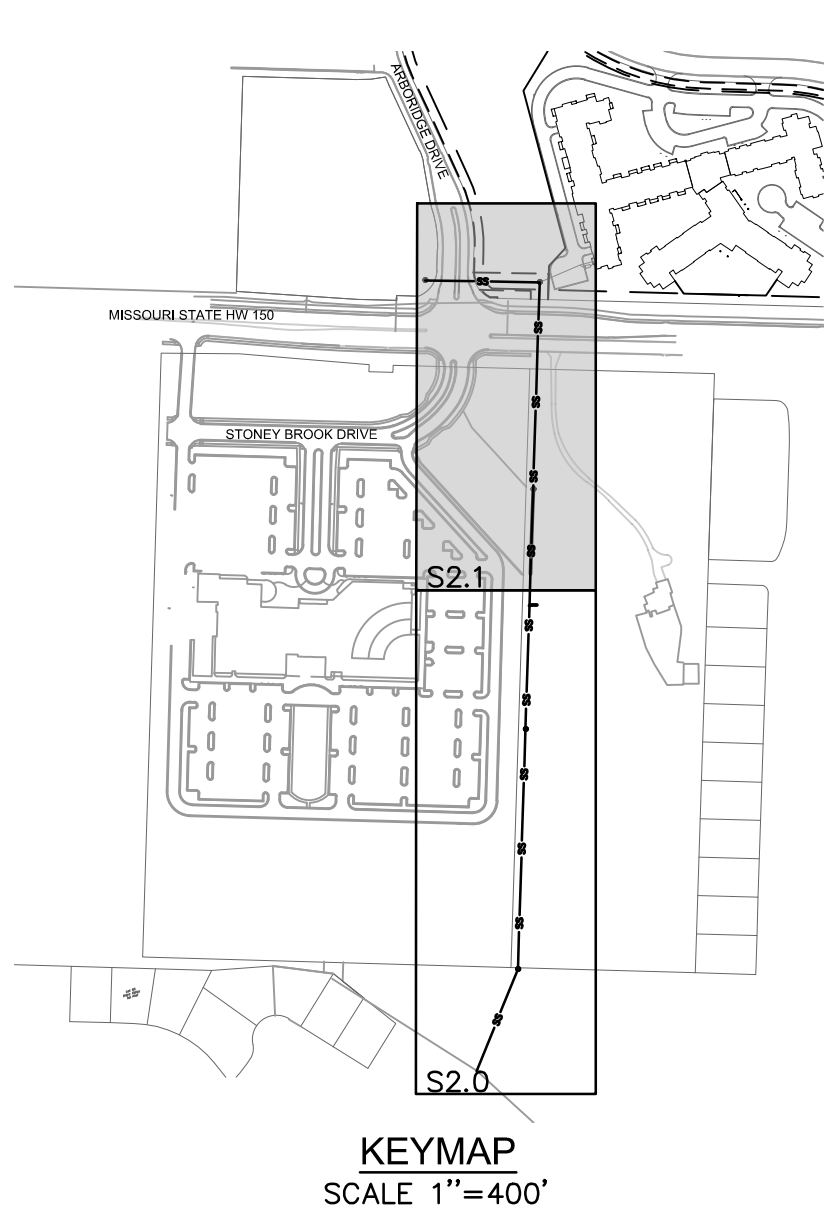




DWG: F:\2021\04001-04500\021-04054-A\40-Design\AutoCAD\Final Plans\Sheets\CHCV\Sanitary Sewer Plans\C_SAN01_A2104054.dwg
DATE: Jan 19, 2024 2:44pm XREFS: C_PBASE_A2104054 C_PBLDG_A2104054 C_PBDY_A2104054 C_PSSWR_A2104054 C_PBLK_A2104054 C_PBDY_A2104054
USER: cm929 C_PBLK_A2104054 - Sanitary C_PSSWR_A2104054

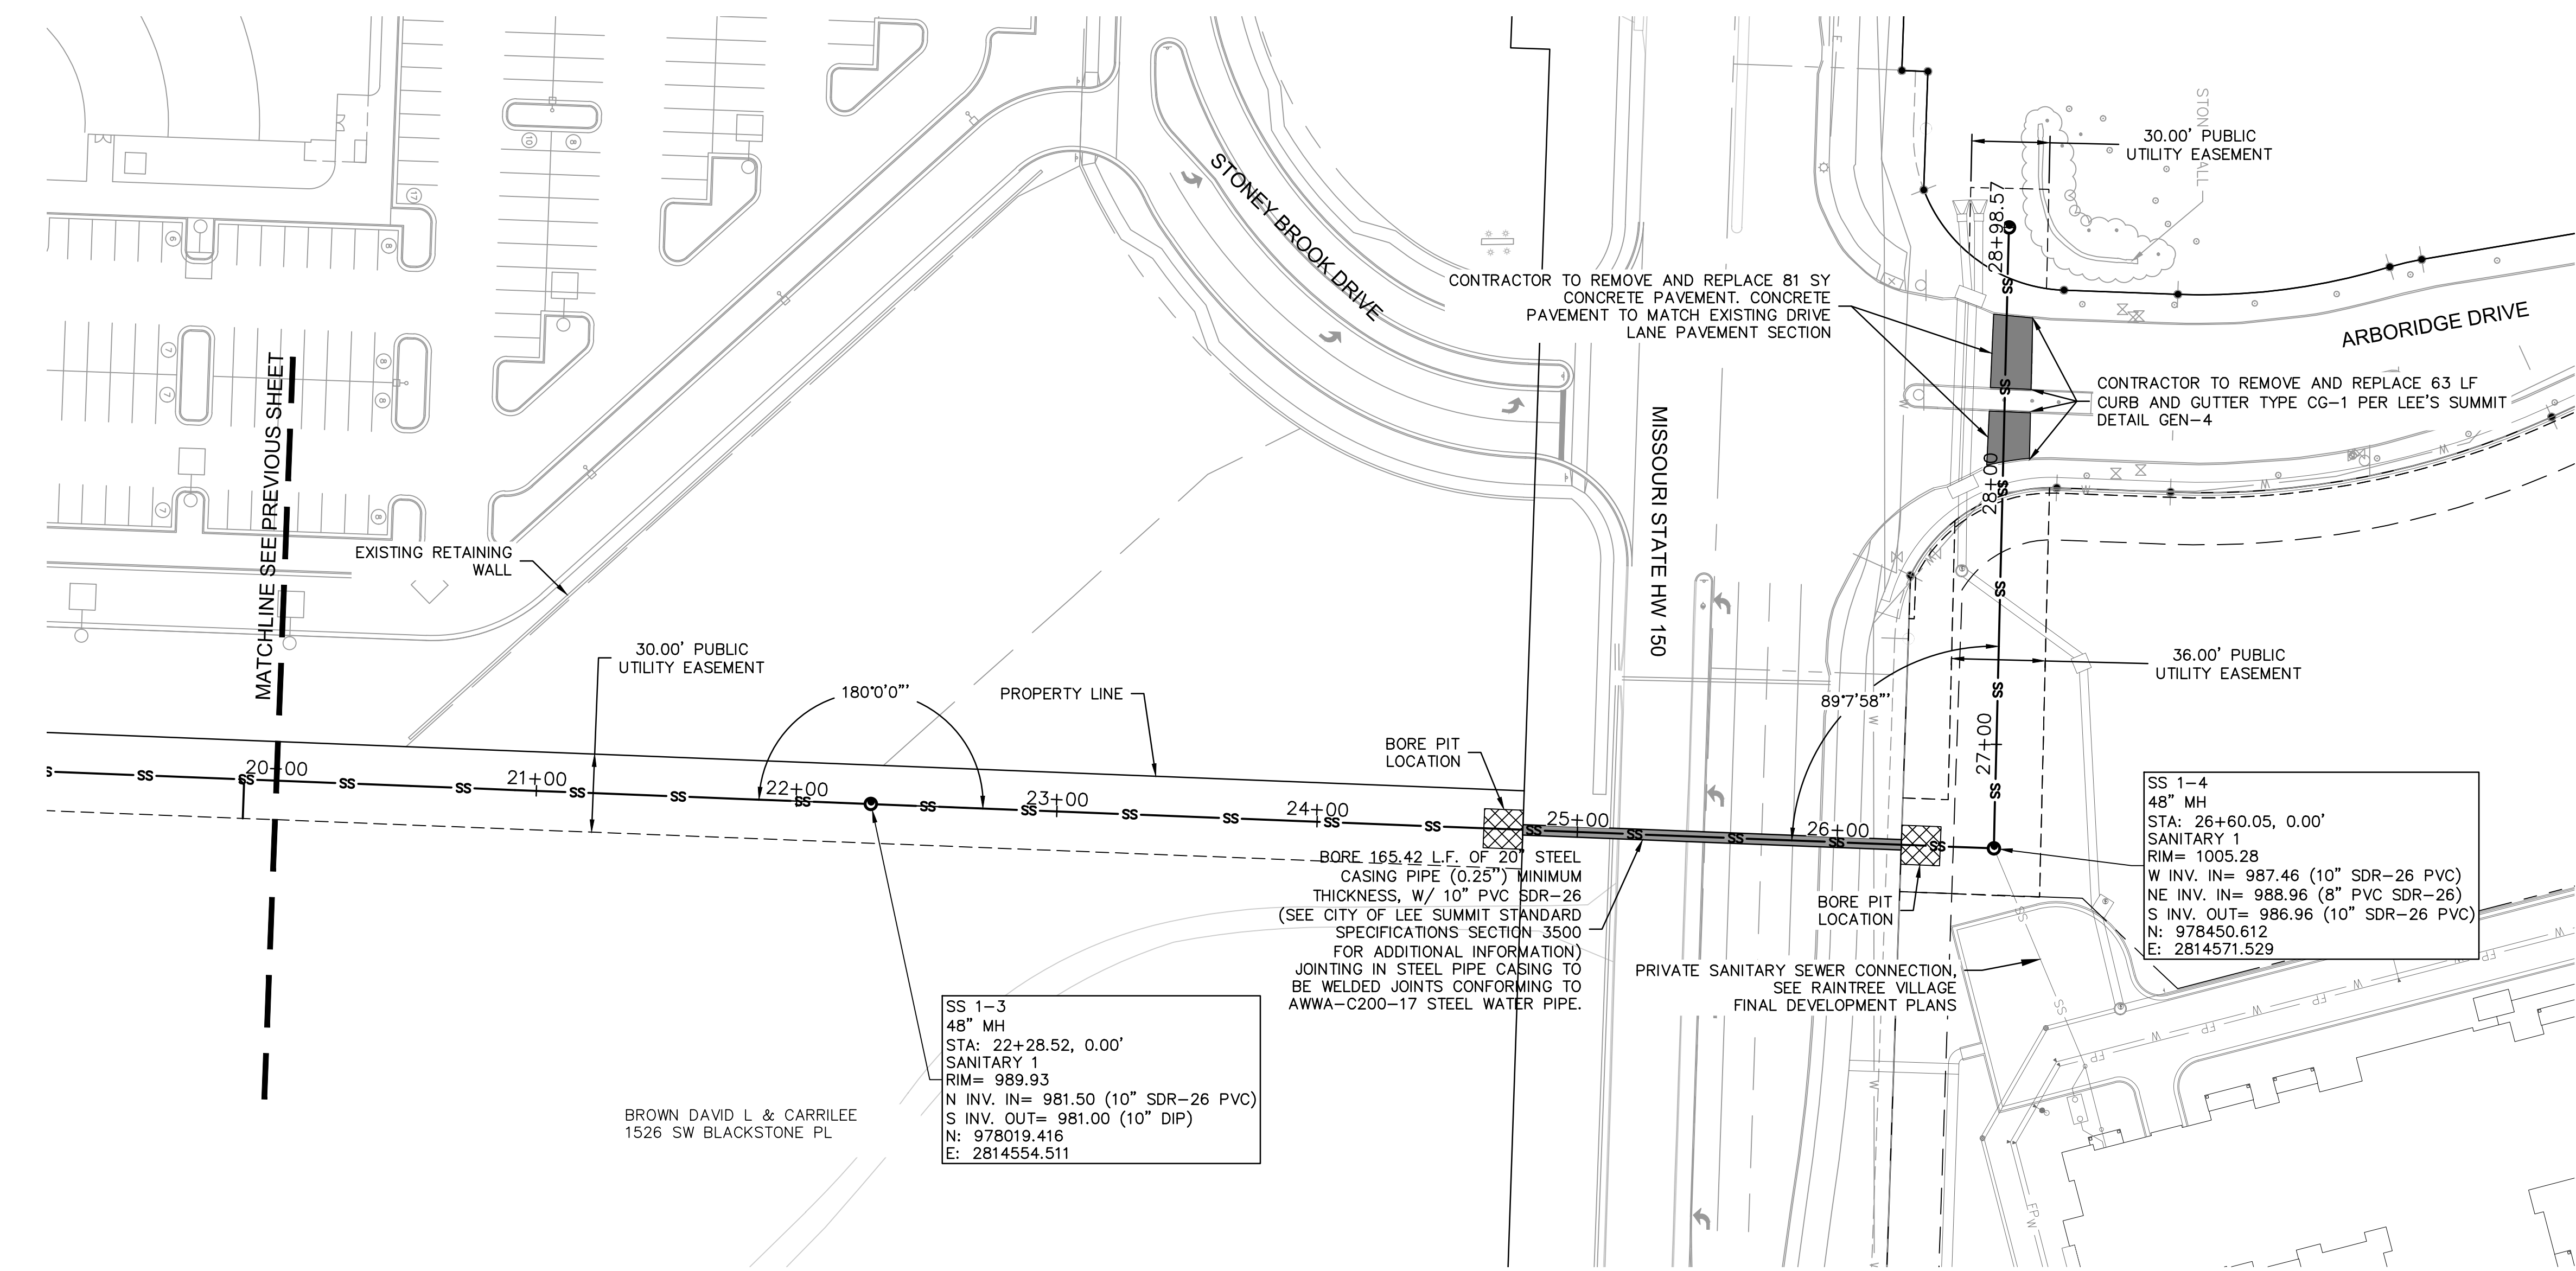

- KEYNOTES**
- SAWCUT AND REMOVE EXISTING CURB AND PAVEMENT PER LEE'S SUMMIT'S TRENCHING/PATCHING ROADWAY'S DETAIL (GEN-5).
 - TRAFFIC CONTROL PER CITY OF LEE'S SUMMIT TRAFFIC CONTROL DETAILS (TC-1 / TC-2)

RELEASED FOR CONSTRUCTION
As Noted on Plan Review

Development Services Department
Lee's Summit, Missouri
01/23/2024

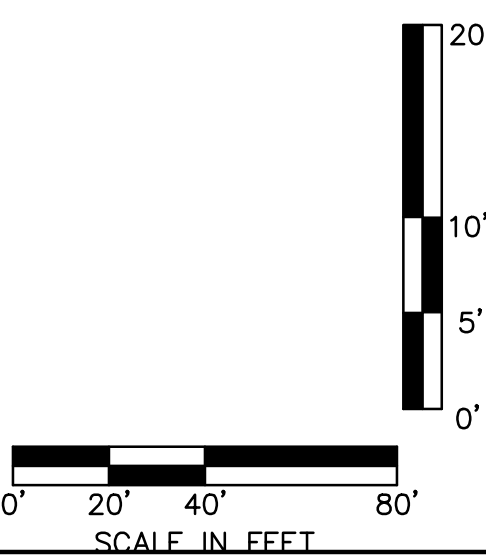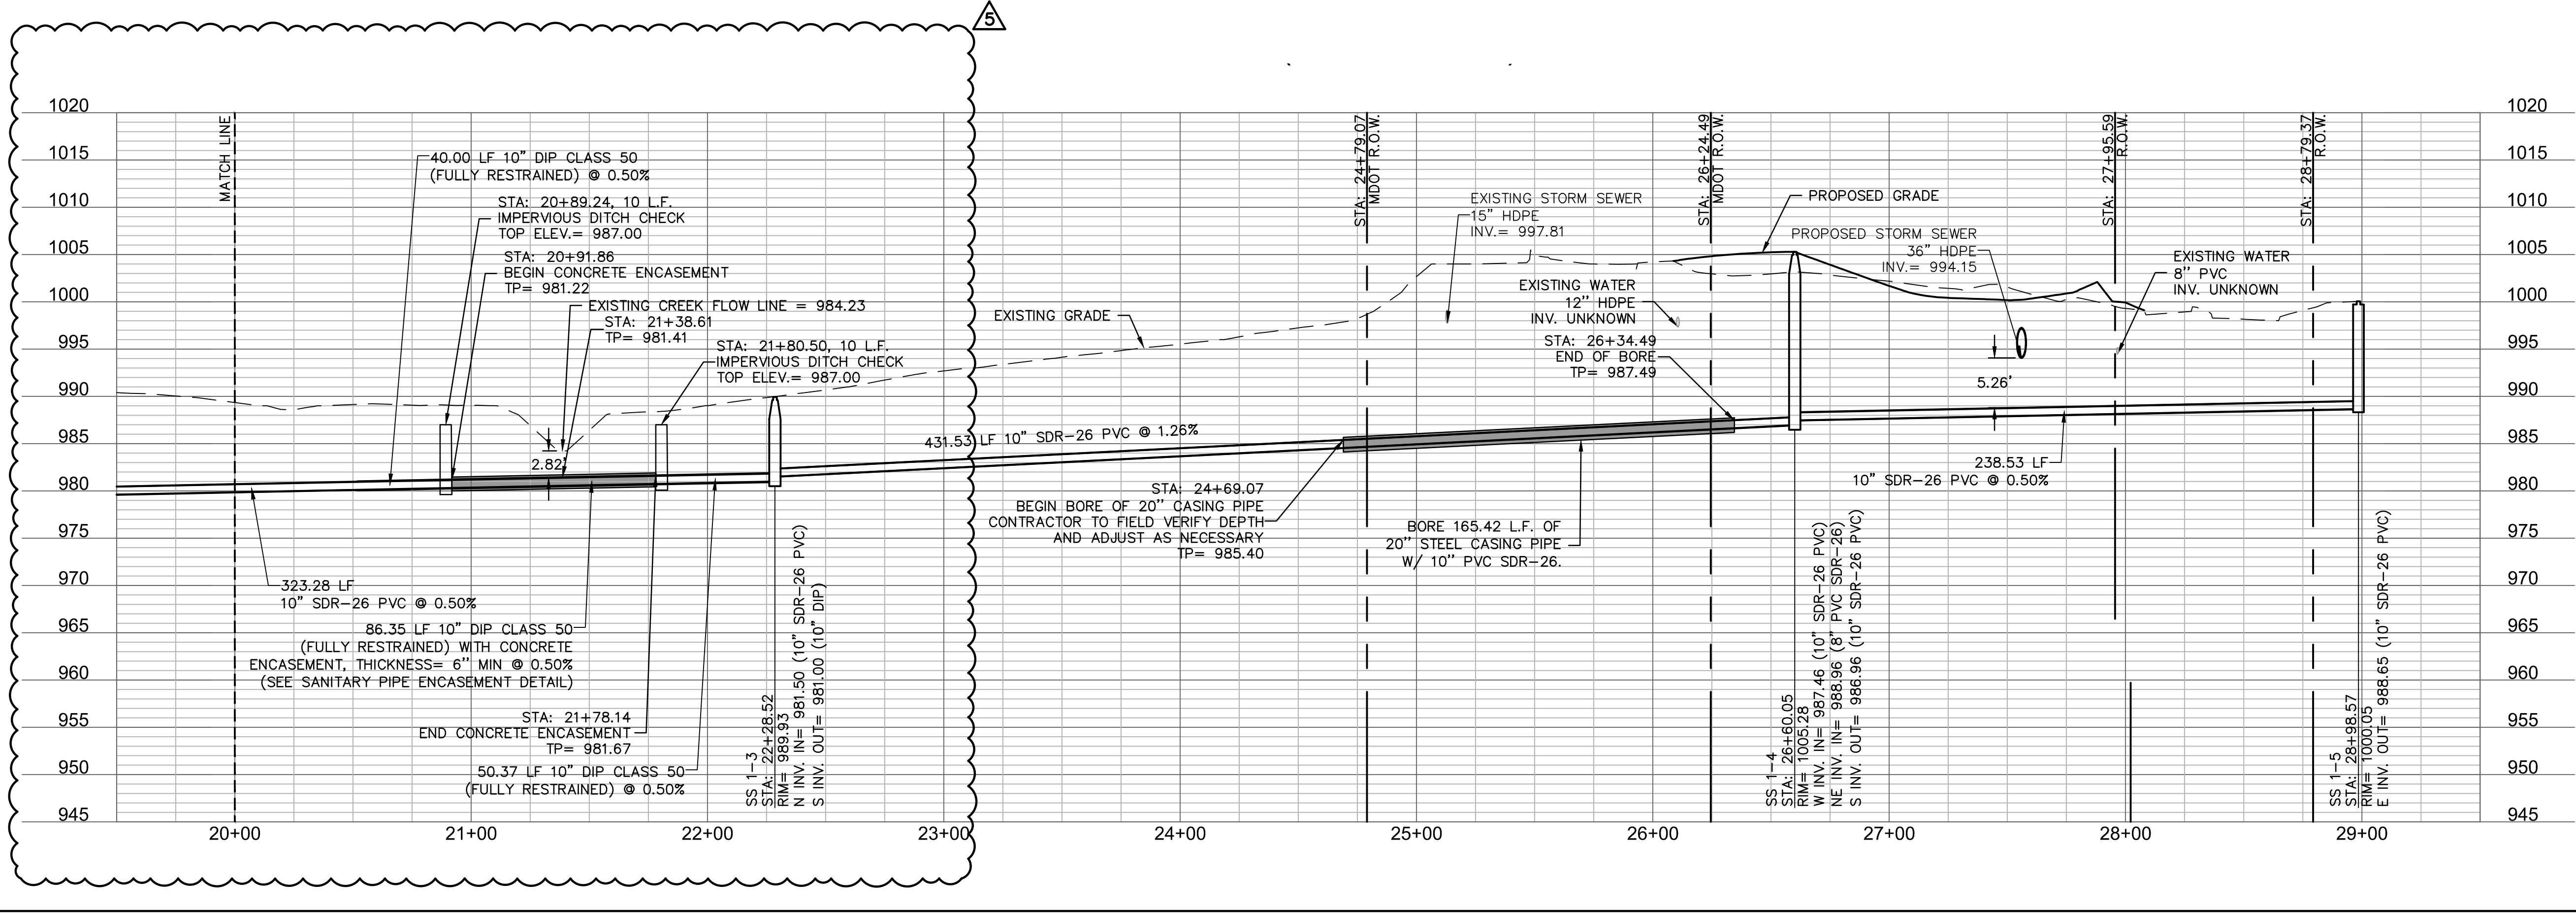

olsson

Olsson - Civil Engineering
Missouri Certificate of Authority # 001592
1301 Burlington Street
North Kansas City, MO 64116
TEL 816.361.1177
www.olsson.com

STATE OF MISSOURI
JULIE ELAINE SELLERS
Professional Engineer
NUMBER
PE-2017000367
1/19/24

REV. NO.	DATE	REVISIONS DESCRIPTION	BY
1	09.29.2022	CITY COMMENTS	CSM
2	01.20.2023	CITY COMMENTS	
3	02.28.2023	CITY COMMENTS	
4	05.11.2023	MISSOURI DNR COMMENTS	
5	01.12.2024		

SANITARY SEWER PLAN & PROFILE PUBLIC SANITARY SEWER PLANS	
RAINTREE VILLAGE PUBLIC SANITARY SEWER PLANS	
LEE'S SUMMIT, MO	
2023	

drawn by: CSM
checked by: CSM
approved by: JS
QA/QC by: JS
project no.: A21-04054
drawing no.: C_SAN01_A2104054
date: 08.10.2022

SHEET
S2.1