


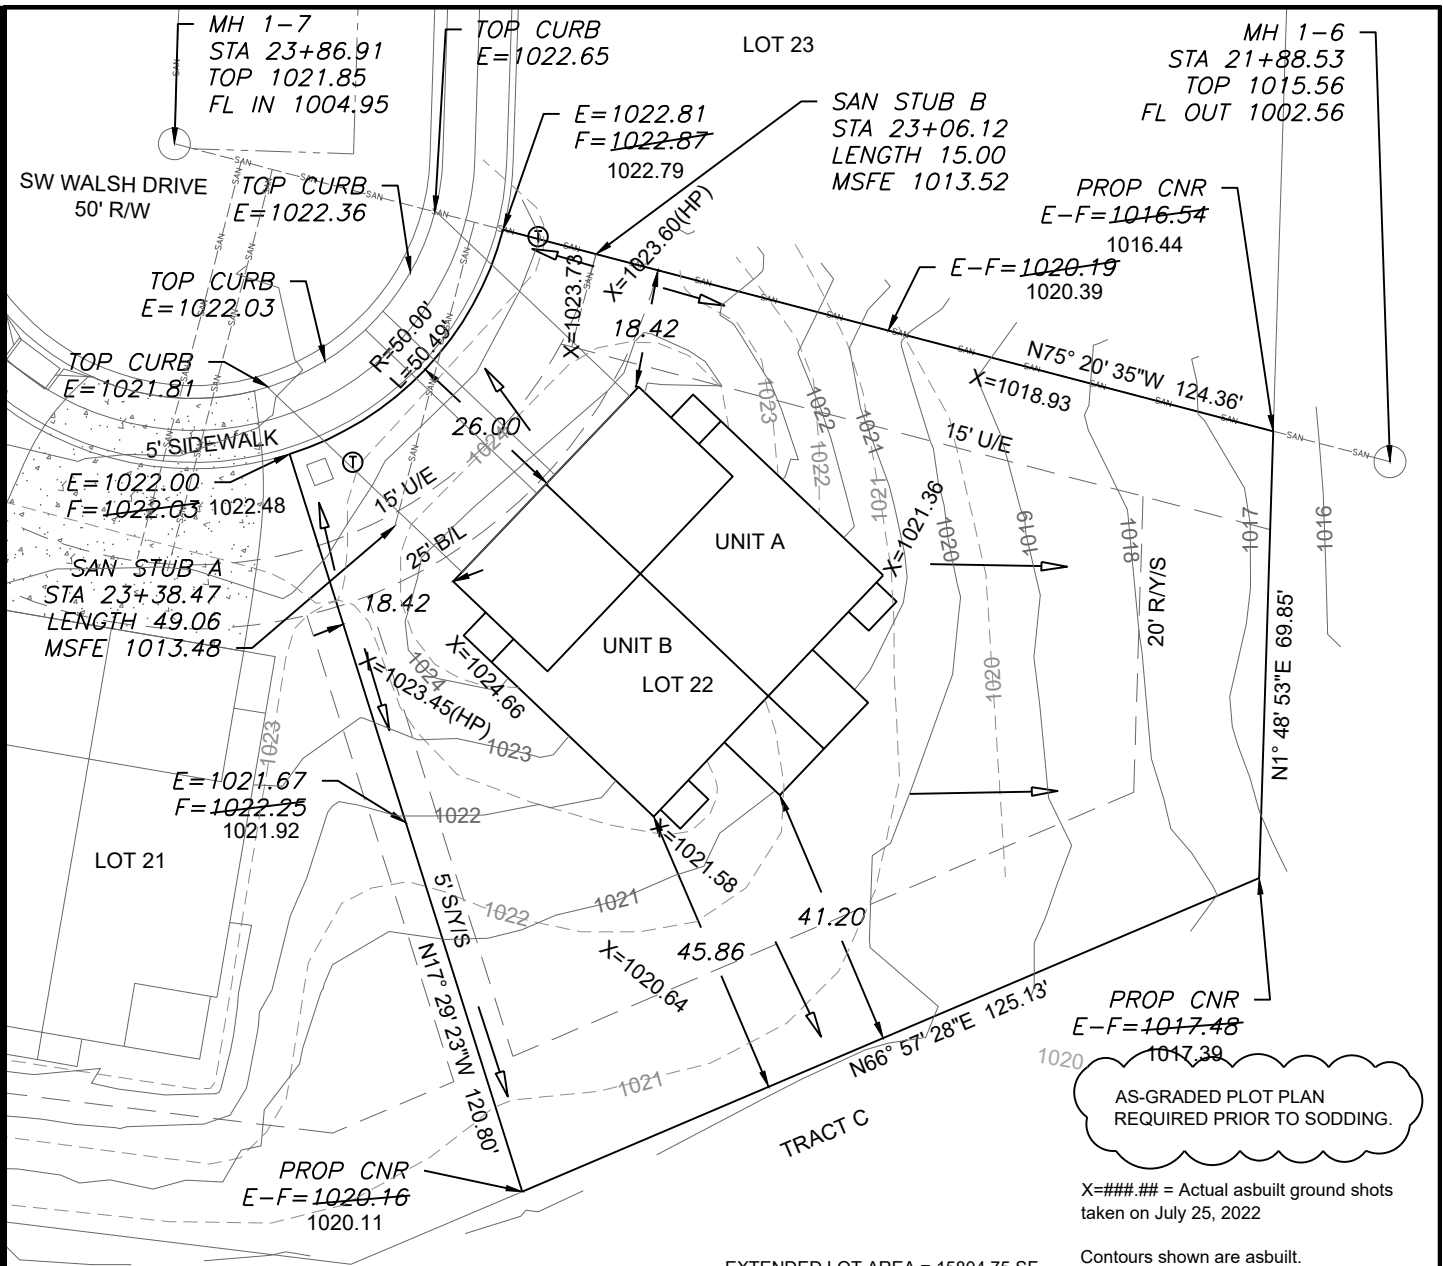

AS-GRADED PLOT PLAN
REQUIRED PRIOR TO SODDING.

X=###.## = Actual asbuilt ground shots
taken on July 25, 2022

Contours shown are asbuilt.

EXTENDED LOT AREA = 15804.75 SF
DRIVE AREA = 930.8 SF
APPROACH AREA = 388.2 SF
SIDEWALK AREA = 59.0 SF

LEGEND

- Gas Meter
- Telephone or Fiber-Optic Pedestal
- Cable TV Pedestal
- Electric Pedestal
- Light Pole
- Mailbox
- Fire Hydrant
- Water Valve

PROPOSED HOUSE

TOP FOUNDATION = 1026.25
GARAGE FLOOR = 1024.25
TOP FOOTING = 1018.25
BASEMENT FLOOR = 1018.58
DRIVE SLOPE (B) = 7.7%
DRIVE SLOPE (A) = 6.4%


E = EXISTING ELEVATION
F = PROPOSED FINAL ELEVATION
G = ADJACENT GRADE AT EGRESS
U/E = UTILITY EASEMENT
B/L = BUILDING LINE
S/Y/S = SIDE YARD SETBACK
R/Y/S = REAR YARD SETBACK

NOTES


1. BUILDER TO VERIFY ALL BUILDING ELEVATIONS AND DIMENSIONS.
2. THIS PLOT PLAN DOES NOT CONSTITUTE A BOUNDARY SURVEY.
3. THE EASEMENTS SHOWN ON THIS PLOT PLAN ARE TAKEN FROM THE FINAL PLAT. OTHER EASEMENTS MAY EXIST.

PROPOSED
CONTOURS
AS-GRADED
CONTOURS

OS BAR
E=1021.28

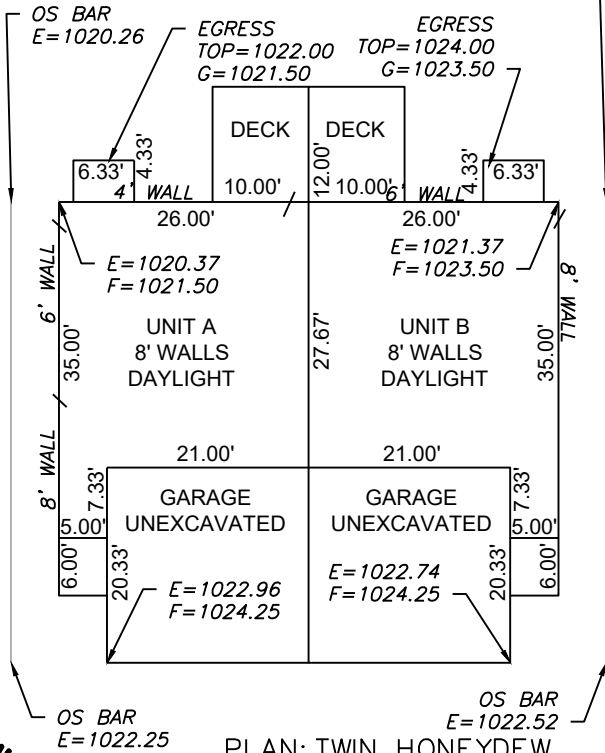

PLAN: TWIN HONEYDEW
Scale 1"=20'

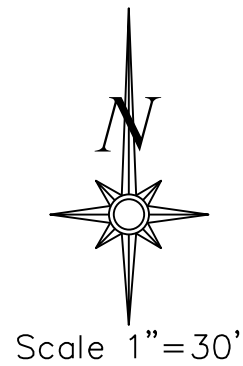


LOT INFORMATION

15,310 SQ. FT.
REAR LEFT MBOE=1018.43
REAR RIGHT MBOE=1021.17
MSFE=1013.48 (UNIT A)
MSFE=1013.52 (UNIT B)
ADDRESS
UNIT A: 3823 SW WALSH DR
UNIT B: 3825 SW WALSH DR

LEGAL DESCRIPTION

LOT 22, OSAGE FIRST PLAT, A
SUBDIVISION AS RECORDED IN
LEE'S SUMMIT, JACKSON
COUNTY, MISSOURI.

ENGINEERING SOLUTIONS
ENGINEERING & SURVEYING
50 SE 30TH STREET
LEE'S SUMMIT, MO 64082
P:(816) 623-9888 F:(816) 623-9849
WWW.ENGINEERINGSOLUTIONSKC.COM

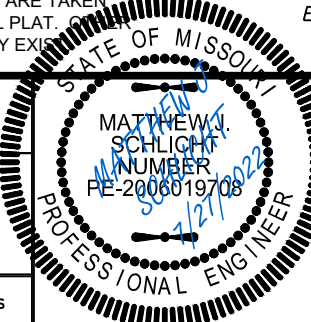

AS-GRADED PLOT PLAN - LOT 22

OSAGE FIRST PLAT
LEE'S SUMMIT, JACKSON COUNTY, MISSOURI

CLOVER & HIVE
120 SE 30TH STREET
LEE'S SUMMIT, MO 64082

PROJECT NO.	FILE NAME	DATE	SHEET	OF
1	LOT 20, 21, 22, OSAGE, LSMO	6/2/21	1	1

THIS DRAWING IS NOT VALID UNLESS THE SIGNATURE, DATE AND SEAL OF THE ENGINEER WHO SUPERVISED THE PREPARATION OF THIS DRAWING HAS BEEN AFFIXED HERETO.