


FILEPATH: F:\1_P\Projects\SDG\235008 SOWP Lot 13\05_Drawings - Working\Revit\235008 SOWP Lot 13_V23.rvt
DATE: 1/22/2024 1:49:24 PM
DRAWN BY: Author

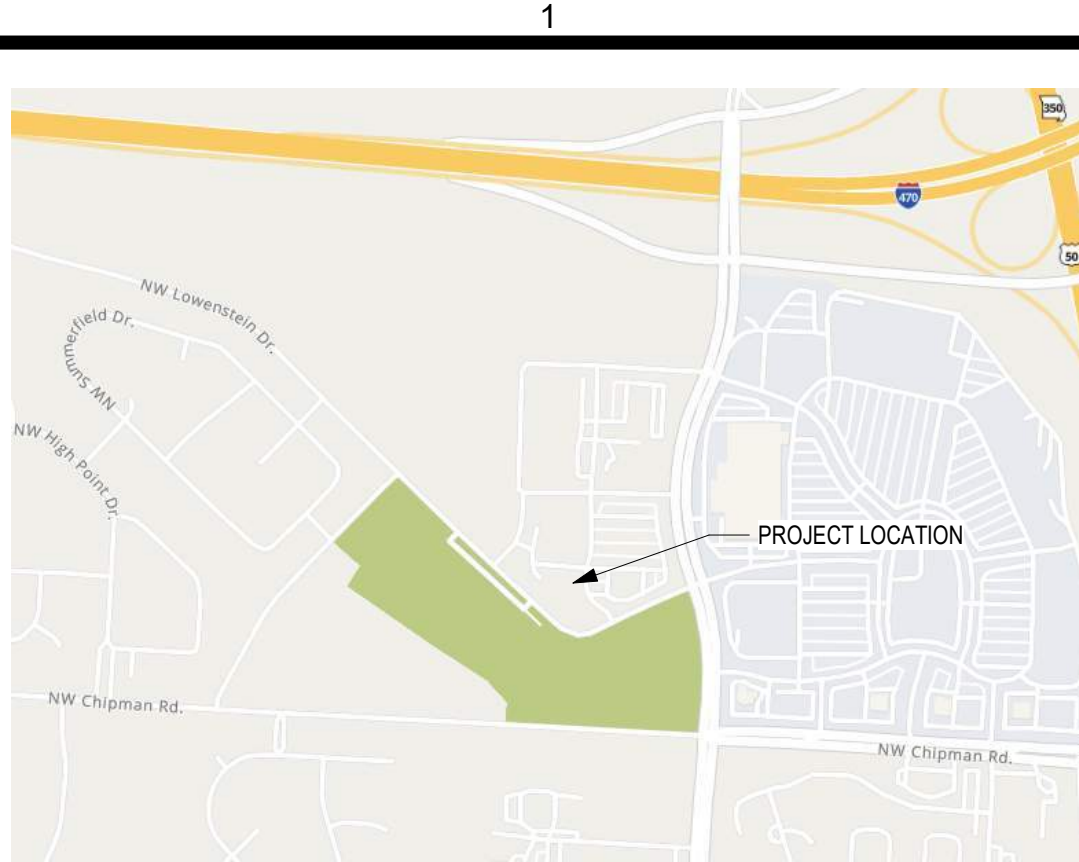

A1 LOCATION MAP

SCALE: NOT TO SCALE



MATERIAL LEGEND

PLAN OR SECTION			RIGID INSULATION
ACOUSTIC TILE (SECTION)			
BATT INSULATION			SAND, GRAVEL, PLASTER, DRYWALL, CUT STONE, GROUT
BRICK			TILE (LARGE SCALE)
CARPET			WOOD BLOCKING
CONCRETE			WOOD MEMBER (CONTINUOUS)
CONCRETE MASONRY UNITS			WOOD STUDS, PARALAM, FINISHED
CONCRETE, PLASTER CUT STONE, STUCCO			
EARTH COMPACTED/DISTURBED			BRICK
METAL			GLASS
METAL STUDS			WOOD
PLYWOOD (LARGE SIZE)			

ABBREVIATIONS

A	ABOVE FINISH FLOOR
ACS PNL	ACCESS PANEL
ACC	ACCESSIBLE
ACT	ACOUSTICAL CEILING TILE
ACOUS PNL	ACOUSTICAL PANEL
ADMIN	ADMINISTRATION
APC	ACOUSTICAL PANEL CEILING
AWT	ACOUSTICAL WALL TREATMENT
ADJ	ADJUSTABLE
AHU	AIR HANDLING UNIT
ALT	ALTERNATE
ALLUM	ALUMINUM
AB	ANCHOR BOLT
L	ANGLE
ANOD	ANODIZE / ANODIZED
APPROX	APPROXIMATE
ARCH	ARCHITECTURAL
ASPH	ASPHALT
B	
BSMT	BASEMENT
BM	BEAM
BRG	BEARING
BRG PL	BEARING PLATE
BR	BEDROOM
BLW	BELOW
BTWN	BETWEEN
BITUM	BITUMINOUS
BD	BOARD
BF	BOTH FACES
BS	BOTH SIDES
BW	BOTH WAYS
BOT	BOTTOM
BRKT	BRACKET
BLDG	BUILDING
BUR	BUILT-UP ROOFING
C	
CAB	CABINET
CUH	CABINET UNIT HEATER
CPT	CARPET
CIP	CAST-IN-PLACE
CS	CAST STONE
CLG	CEILING
CEM	CEMENT
CTR	CENTER
CL	CENTER LINE
C TO C	CERAMIC TILE
CH BD	CHALKBOARD
C	CHANNEL
CLR	CLEAR
CLO	CLOSET
COL	COLUMN
CONC	CONCRETE
CMU	CONCRETE MASONRY UNIT
CJ	CONSTRUCTION JOINT, CONTROL JOINT
D	
DL	DEAD LOAD
DEMO	DEMOLITION
DEPT	DEPARTMENT
D	DEPTH
DET	DETAIL
DIAG	DIAGONAL
DIA	DIAMETER
DIM	DIMENSION

D	
DW	DISHWASHER
DR	DOOR
DBL	DOUBLE
DN	DOWN
DS	DOWNSPOUT
DWG	DRAWING
DF	DRINKING FOUNTAIN
E	
EA	EACH
ESMT	EACH WAY EASEMENT
E	EAST
ELEC	ELECTRIC, ELECTRICAL
EL	ELEVATION
ELEV	ELEVATOR
EQ	EQUAL
EQUIP	EQUIPMENT
EXH FN	EXHAUST FAN
EXIST	EXISTING
EXP	EXPANSION
EXPJ	EXPANSION JOINT
EXT	EXTERIOR
EJ	EXTERIOR INSULATION & FINISH SYSTEM
EIFS	
F	
FC BRK	FACE BRICK
FOF	FACE OF FINISH
FGL	FIBERGLASS
FIN	FINISH
FF EL	FINISH FLOOR ELEVATION
FE	FIRE EXTINGUISHER
FEC	FIRE EXTINGUISHER CABINET
FIXT	FIXTURE
FLASH	FLASHING
FLR	FLOOR
FOO	FLOOR CLEANOUT
FD	FLOOR DRAIN
FLUOR	FLUORESCENT
FLL	FLOW LINE
FT	FOOT
FTG	FOOTING
FDTN	FOUNDATION
FR	FRAME
FA	FRESH AIR
FURN	FURNACE
FURG	FURRING
FS	FULL SIZE
G	
GA	GAUGE
GALV STL	GALVANIZED STEEL
GC	GENERAL CONTRACTOR
GL	GLASS
GB	GRAB BAR
GYP BD	GYPSUM BOARD
H	
HCP	HANDICAPPED
HDW	HARDWARE
HDWD	HARDWOOD
HVAC	HEATING, VENTILATION & AIR CONDITIONING
HT	HEIGHT
H	HIGH
HWY	HIGHWAY
DIAG	DIAGONAL
DIA	DIAMETER
DIM	DIMENSION

H	
HW	HOT WATER
HYD	HYDRANT
I	
INCL	INCLUDED
ID	INSIDE DIAMETER
INSUL	INSULATION
INT	INTERIOR
J	
JAN	JANITOR
K	
KIT	KITCHEN
L	
LAB	LABORATORY
LAM	LAMINATE
LAU	LAUNDRY
LAV	LAVATORY
LWC	LIGHTWEIGHT CONCRETE
LCMU	LIGHTWEIGHT CONCRETE MASONRY
LF	LINEAR FOOT
LL	LIVE LOAD
LR	LIVING ROOM
LLH	LONG LEG HORIZONTAL
LLV	LONG LEG VERTICAL
M	
MAINT	MAINTENANCE
MH	MANHOLE
MFD	MANUFACTURED
MFR	MANUFACTURER
MFG	MANUFACTURING
MO	MASONRY OPENING
MATL	MATERIAL
MAX	MAXIMUM
MECH	MECHANICAL
MTL	METAL
MW	MICROWAVE
MIN	MINIMUM, MINUTE
MISC	MISCELLANEOUS
MR	MOISTURE RESISTANT
MTD	MOUNTED
MULL	MULLION
N	
NRC	NOISE REDUCTION COEFFICIENT
NOM	NOMINAL
N	NORTH
NIC	NOT IN CONTRACT
NTS	NOT TO SCALE
O	
OFF	OFFICE
OC	ON CENTER
OPNG	OPENING
OPP	OPPOSITE
OD	OUTSIDE DIAMETER
O/O	OUT TO OUT
OA	OVERALL
ORD	OVERFLOW ROOF DRAIN
OH	OVERHANG
OF/CI	OWNER FURNISHED/ CONTRACTOR INSTALLED
OF/OI	OWNER FURNISHED/ OWNER INSTALLED
S	
SNU	SANITARY NAPKIN DISPENSER
SNDU	SANITARY NAPKIN DISPOSAL UNIT
SS	SANITARY SEWER
SCHED	SCHEDULE
SECT	SECTION
SHT	SHEET
SV	SHEET VINYL
SHV	SHELVING
SHR	SHOWER
SM	SIMILAR
SCWD	SOLID CORE WOOD
STC	SOUND TRANSMISSION CLASS
S	SOUTH
SPEC	SPECIFICATION
SB	SPLASH BLOCK
SF	SQUARE FOOT
SQ INCH	SQUARE INCH
SQ YD	SQUARE YARD
SST	STAINLESS STEEL
STD	STANDARD
STL JST	STEEL JOIST
STOR	STORAGE
SD	STORM DRAIN
ST	STREET


P	
PT	PAINT
PR	PAIR
PNL	PANEL
PTD	PAPER TOWEL DISPENSER
PTD	PARTICLE BOARD
PTN	PARTITION
PVG	PAVING
PERF	PERFORATED
PERIM	PERIMETER
PLAS	PLASTER
PERP	PERPENDICULAR
PLAM	PLASTIC LAMINATE
PLYWD	PLYWOOD
PVC	POLYVINYL CHLORIDE
LB	POUND
PCF	POUNDS PER CUBIC FOOT
PLF	POUNDS PER LINEAR FOOT
PSF	POUNDS PER SQUARE FOOT
PSI	POUNDS PER SQUARE INCH
PCC	PREFABRICATE
PREFAB	PREFABRICATE
PREFIN	PREFINISH
PROJ	PROJECT
PL	PROPERTY LINE
Q	
QT	QUARRY TILE
R	
REF	REFERENCE, REFRIGERATOR
RCP	REFLECTED CEILING PLAN
REIN	REINFORCE
REQD	REQUIRED
RESIL	RESILIENT
REST	RESTROOM
RA	RETURN AIR
REV	REVISION
R	RISER, RADIUS, RANGE
RD	ROOF DRAIN
RFG	ROOFING
RM	ROOM
RO	ROUGH OPENING
RS	ROUGH SAWN
S	
SNU	SANITARY NAPKIN DISPENSER
SNDU	SANITARY NAPKIN DISPOSAL UNIT
SS	SANITARY SEWER
SCHED	SCHEDULE
SECT	SECTION
SHT	SHEET
SV	SHEET VINYL
SHV	SHELVING
SHR	SHOWER
SM	SIMILAR
SCWD	SOLID CORE WOOD
STC	SOUND TRANSMISSION CLASS
S	SOUTH
SPEC	SPECIFICATION
SB	SPLASH BLOCK
SF	SQUARE FOOT
SQ INCH	SQUARE INCH
SQ YD	SQUARE YARD
SST	STAINLESS STEEL
STD	STANDARD
STL JST	STEEL JOIST
STOR	STORAGE
SD	STORM DRAIN
ST	STREET

S	
STRUCT	STRUCTURAL
SUSP CLG	SUSPENDED CEILING
SW	SWITCH
T	
TK BD	TACKBOARD
TEL	TELEPHONE
TV	TELEVISION
TMPP	TEMPERED
TER	TERRAZZO
THK	THICKNESS
TPD	TOILET PAPER HOLDER
T&G	TONGUE AND GROOVE
T&B	TOP AND BOTTOM
TOC	TOP OF CURB
TOF	TOP OF CONCRETE
TOT	TOP OF FOOTING
TOM	TOP OF MASONRY
TOS	TOP OF STEEL
TOW	TOP OF WALL
TB	TOWEL BAR
TRANS	TRANSPARENT
TF	TRANSPARENT WOOD FINISH
TYP	TYPICAL
U	
UNFIN	UNFINISHED
UH	UNIT HEATER
UNO	UNLESS NOTED OTHERWISE
V	
VR	VAPOR RETARDER
VNR	VENEER
VENT	VENTILATION
VERT	VERTICAL
VEST	VESTIBULE
VB	VINYL BASE
VCT	VINYL COMPOSITION TILE
VWC	VINYL WALL COVERING
VWF	VINYL WALL FABRIC
V	VOLT
W	
WSCOT	WAINSCOT
WC	WALL COVERING, WALL CLOSET
WH	WATER HEATER
WP	WATERPROOFING, WORKING POINT
WT	WEIGHT
WVF	WELDED WIRE FABRIC
W	WEST, WIDE
WDW	WINDOW
WGL	WIRED GLASS
W	WITH
W/O	WITHOUT
WD	WOOD

2-HR SEPARATION

EXIT

NOTE: 2-HR SEPARATION WALL WILL BE CONSTRUCTED AS A FIRE BARRIER, UL #301, EXTENDING FROM FOUNDATION TO UNDERSIDE OF ROOF SHEATHING.

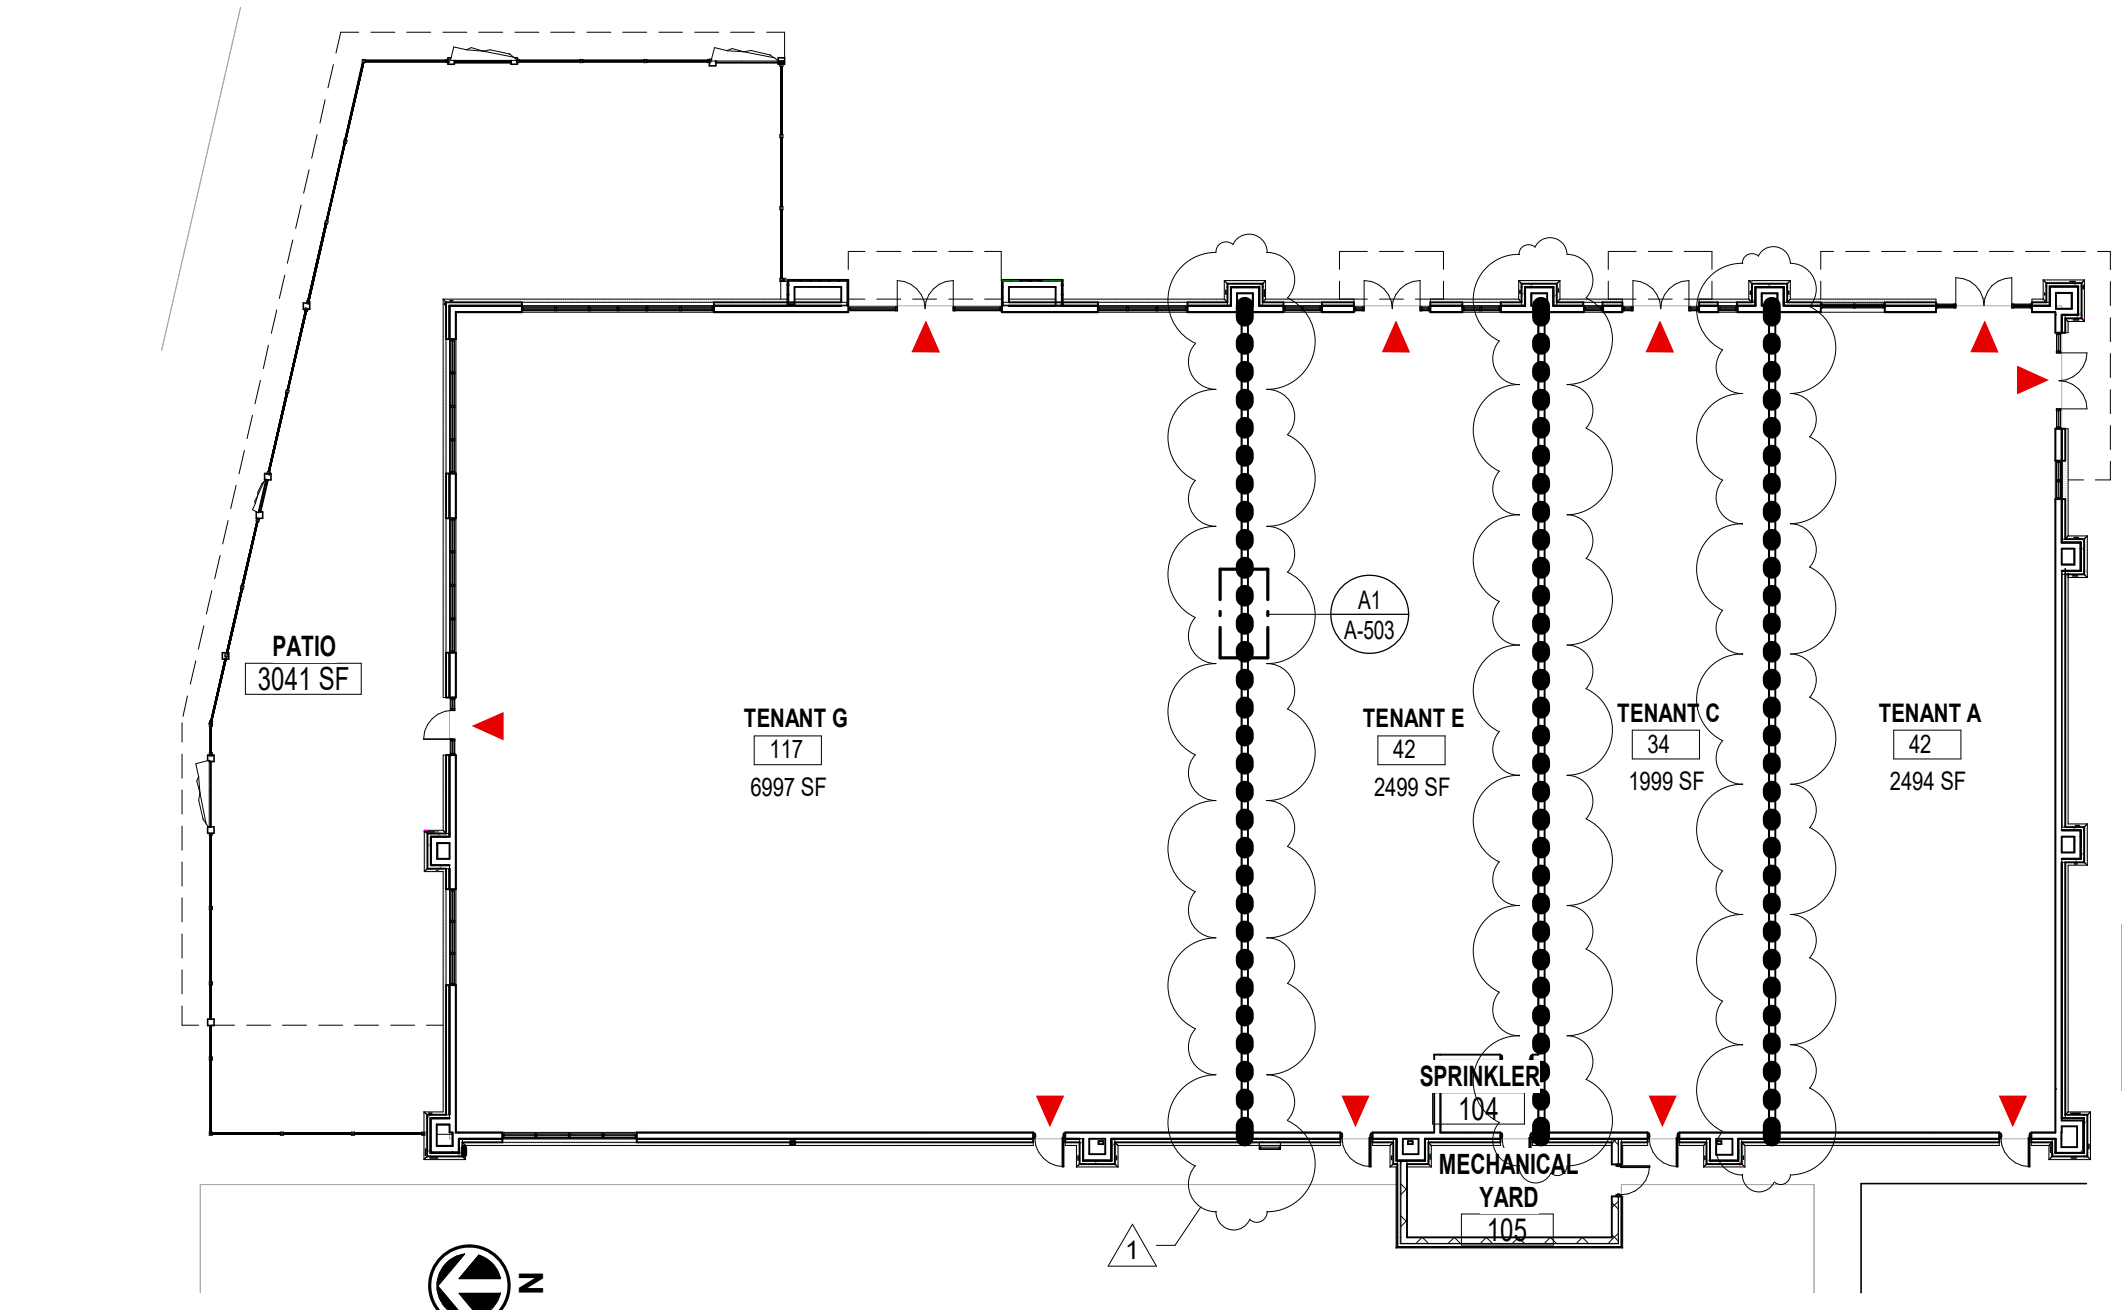

A3 FIRST FLOOR

SCALE: 1" = 20'-0"

CODE SUMMARY

PROJECT SCOPE:

CORE & SHELL DOCUMENTS. DRAWINGS FOR TENANT IMPROVEMENT WILL BE ISSUED A SEPARATE PERMIT AND PROVIDED BY OTHERS.

JURISDICTIONAL BUILDING CODES:

INTERNATIONAL BUILDING CODE	2018
INTERNATIONAL MECHANICAL CODE	2018
NATIONAL ELECTRICAL CODE	2017
INTERNATIONAL PLUMBING CODE	2018
INTERNATIONAL FIRE CODE	2018
INTERNATIONAL FUEL GAS CODE	2018

ICC/ANSI A117.1 ACCESSIBLE AND USABLE BUILDINGS AND FACILITIES 2009

CONSTRUCTION INFORMATION:

BUILDING TYPE:	NEW CONSTRUCTION
OCCUPANCY TYPES:	M (MERCANTILE)
CONSTRUCTION TYPE:	V-B (SPRINKLERED)
ALLOWABLE HEIGHT:	40 FT
ACTUAL HEIGHT:	26 FT
ALLOWABLE STORIES:	1
ACTUAL STORIES:	1
GROSS BUILDING AREA:	13,989 SF

ALLOWABLE FLOOR AREA:

ALLOWABLE FLOOR AREA (M):	9,000 SF
*FRONTAGE INCREASE N/A DUE TO ACTUAL AREA LESS THAN ALLOWABLE FLOOR AREA	

GROSS BUILDING AREA:

TENANT A:	2,494 SF
TENANT C:	1,999 SF
TENANT E:	2,499 SF
TENANT G:	6,997 SF

TOTAL GROSS AREA: 13,989 SF

OCCUPANT LOAD CALCS:

TENANT B (M): IBC TABLE 1006.5	
TOTAL NET SF	13,989 SF
MERCANTILE	60 GROSS
OCCUPANTS	234 OCC

EXITS REQUIRED:

TENANT A (M): IBC TABLE 1006.2.1	
EXITS REQUIRED	1 EXIT
EXITS PROVIDED	3 EXITS

TENANT C (M): IBC TABLE 1006.2.1	
EXITS REQUIRED	1 EXIT
EXITS PROVIDED	2 EXITS

TENANT E (M): IBC TABLE 1006.2.1	
EXITS REQUIRED	1 EXIT
EXITS PROVIDED	2 EXITS

TENANT G (M): IBC TABLE 1006.2.1	
EXITS REQUIRED	2 EXITS
EXITS PROVIDED	3 EXITS


STRUCTURAL FIRE PROTECTION (IBC TABLE 601)

PRIMARY STRUCTURAL FRAME	(0) HOUR
EXTERIOR BEARING WALLS	(0) HOUR
INTERIOR BEARING WALLS	(0) HOUR
EXTERIOR NON-BEARING WALLS & PARTITIONS	N/A
INTERIOR NON-BEARING WALLS & PARTITIONS	(0) HOUR
STRUCTURAL FRAME	(0) HOUR
FLOOR CONSTRUCTION	(0) HOUR
ROOF CONSTRUCTION	(0) HOUR

STRUCTURAL FIRE PROTECTION (IBC TABLE 601)

1. AUTOMATIC SPRINKLER SYSTEM (YES)
2. EXIT LIGHTING PROVIDED

CODE PLAN ROOM TAG

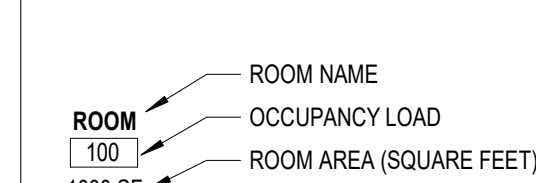

DESIGN TEAM

ARCHITECTURAL DESIGN	
SCHWERDT DESIGN GROUP 2231 SW WANAMAKER RD SUITE 303 TOPEKA, KANSAS 66614	CONTACT: MICHAEL HAMPTON & RYMAN KINNEY PHONE: 785-273-7540 DIRECT: 785-730-0914 E-MAIL: MKH@SDGARCH.COM RAK@SDGARCH.COM
MECHANICAL & ELECTRICAL DESIGN	
PKMR ENGINEERS 13300 WEST 98TH STREET LENEXA, KANSAS, 66215	CONTACT: BRYAN LEINWETTER PE. PHONE: 913-492-2400 E-MAIL: BRYAN.LEINWETTER@PKMRENG.COM
STRUCTURAL DESIGN	
CERTUS STRUCTURAL ENGINEERS 900 S KANSAS AVENUE SUITE 400 TOPEKA, KANSAS, 66612	CONTACT: AARON SCOTT PE. PHONE: 785-291-0400 E-MAIL: AARON.SCOTT@CERTUSSE.COM
CIVIL DESIGN	
SM ENGINEERING 9191 W STEWART ROAD COLUMBIA, MISSOURI 65203	CONTACT: SAM MALINOWSKI, PE PHONE: 785-341-9747 E-MAIL: SMCIVLENGR@GMAIL.COM

SHEET INDEX

ARCHITECTURAL

G-001 COVER SHEET

- CIVIL
- C-1.0 COVER SHEET
- C-2.0 EXISTING CONDITIONS
- C-3.0 SITE PLAN
- C-4.0 UTILITY PLAN
- C-5.0 GRADING PLAN
- C-6.0 EROSION CONTROL PLAN
- C-7.0 EROSION CONTROL DETAILS
- C-8.0 STORM LINE C PLAN AND PROFILE
- C-8.1 STORM LINE F PLAN AND PROFILE
- C-9.0 WATERLINE A PLAN AND PROFILE
- C-10 WATERLINE B & C PLAN AND PROFILE
- C-11 DETAILS
- C-12 DETAILS
- C-13 DETAILS
- L-1 LANDSCAPE PLAN

ARCHITECTURAL

- A-100 SITE PLAN & DETAILS
- A-101 FIRST FLOOR PLAN
- A-102 ROOF PLAN
- A-201 EXTERIOR ELEVATIONS
- A-202 EXTERIOR ENLARGED ELEVATION & FENCE DTLS
- A-301 WALL SECTIONS
- A-302 WALL SECTIONS
- A-501 BUILDING DETAILS
- A-502 BUILDING DETAILS
- A-503 BUILDING DETAILS
- A-601 GLASS & DOOR SCHEDULES

STRUCTURAL

- S-001 GENERAL NOTES
- S-101 FOUNDATION PLAN
- S-102 CANOPY FOUNDATION & FRAMING PLANS
- S-103 WALL FRAMING PLAN
- S-104 ROOF FRAMING PLAN
- S-201 NW FRAMING ISOMETRIC
- S-202 SE FRAMING ISOMETRIC
- S-301 CONCRETE DETAILS & SECTIONS 1
- S-601 FRAMING DETAILS & SECTIONS 1
- S-602 FRAMING DETAILS & SECTIONS 2
- S-603 FRAMING DETAILS & SECTIONS 3

MECHANICAL. ELECTRICAL. PLUMBING

ME-101 MEP NOTES & SPECIFICATIONS

MECHANICAL

- M-101 PLUMBING PLAN
- M-201 HVAC PLAN
- M-301 MECHANICAL DETAILS & SCHEDULES

ELECTRICAL

- E-101 POWER PLAN
- E-102 ELECTRICAL DETAILS & SCHEDULES
- E-201 LIGHTING PLAN
- E-202 SITE LIGHTING PLAN
- E-203 SITE PHOTOMETRIC PLAN

RELEASED FOR CONSTRUCTION
As Noted on Plans Review
Development Services Department
10/1/2024

schwerdt design group
architecture | interiors | planning
2231 sw wanamaker rd, suite 303
topeka, kansas 66614-4275
phone: 785.273.7540
fax: 785.273.7579

MICHAEL K HAMPTON
ARCHITECT (MO# A-2008027042)

SCHWERDT DESIGN GROUP INC
MISSOURI STATE CERTIFICATE
OF AUTHORITY #F00353876

CORE & SHELL BUILDING STREETS OF WEST PRYOR LOT 13

1020 NW PRYOR ROAD, LEES SUMMIT, MISSOURI

SUBMISSION DATES
12-27-2023

ADD-1
JAN 19TH, 2024

SHEET TITLE
COVER SHEET

PROJECT NUMBER
235008

SHEET NUMBER
G-001

FINAL DEVELOPMENT PLANS
FOR
LOT 13A OF WEST PRYOR
LEE'S SUMMIT

UTILITIES
Electric Service
EVERGY
Nathan Michael
913-347-4310
Nathan.michael@kcpl.com

Gas Service
Spire
Katie Darnell
816-969-2247
Katie.darnell@spireenergy.com


Water/Sanitary Sewer
Water Utilities Department
1200 SE Hamblen Road
Lee's Summit, Mo 64081
Jeff Thorn
816-969-1900
jeff.thorn@cityofls.net

Communication Service
AT&T Carrie Cilke
816-703-4386
cc3527@att.com

Time Warner Cable
Steve Baxter
913-643-1928
steve.baxter@charter.com

Comcast
Ryan Alkire
816-795-2218
ryan.alkire@cable.comcast.com

Google Fiber
Becky Davis
913-725-8745
rebeccadavis@google.com

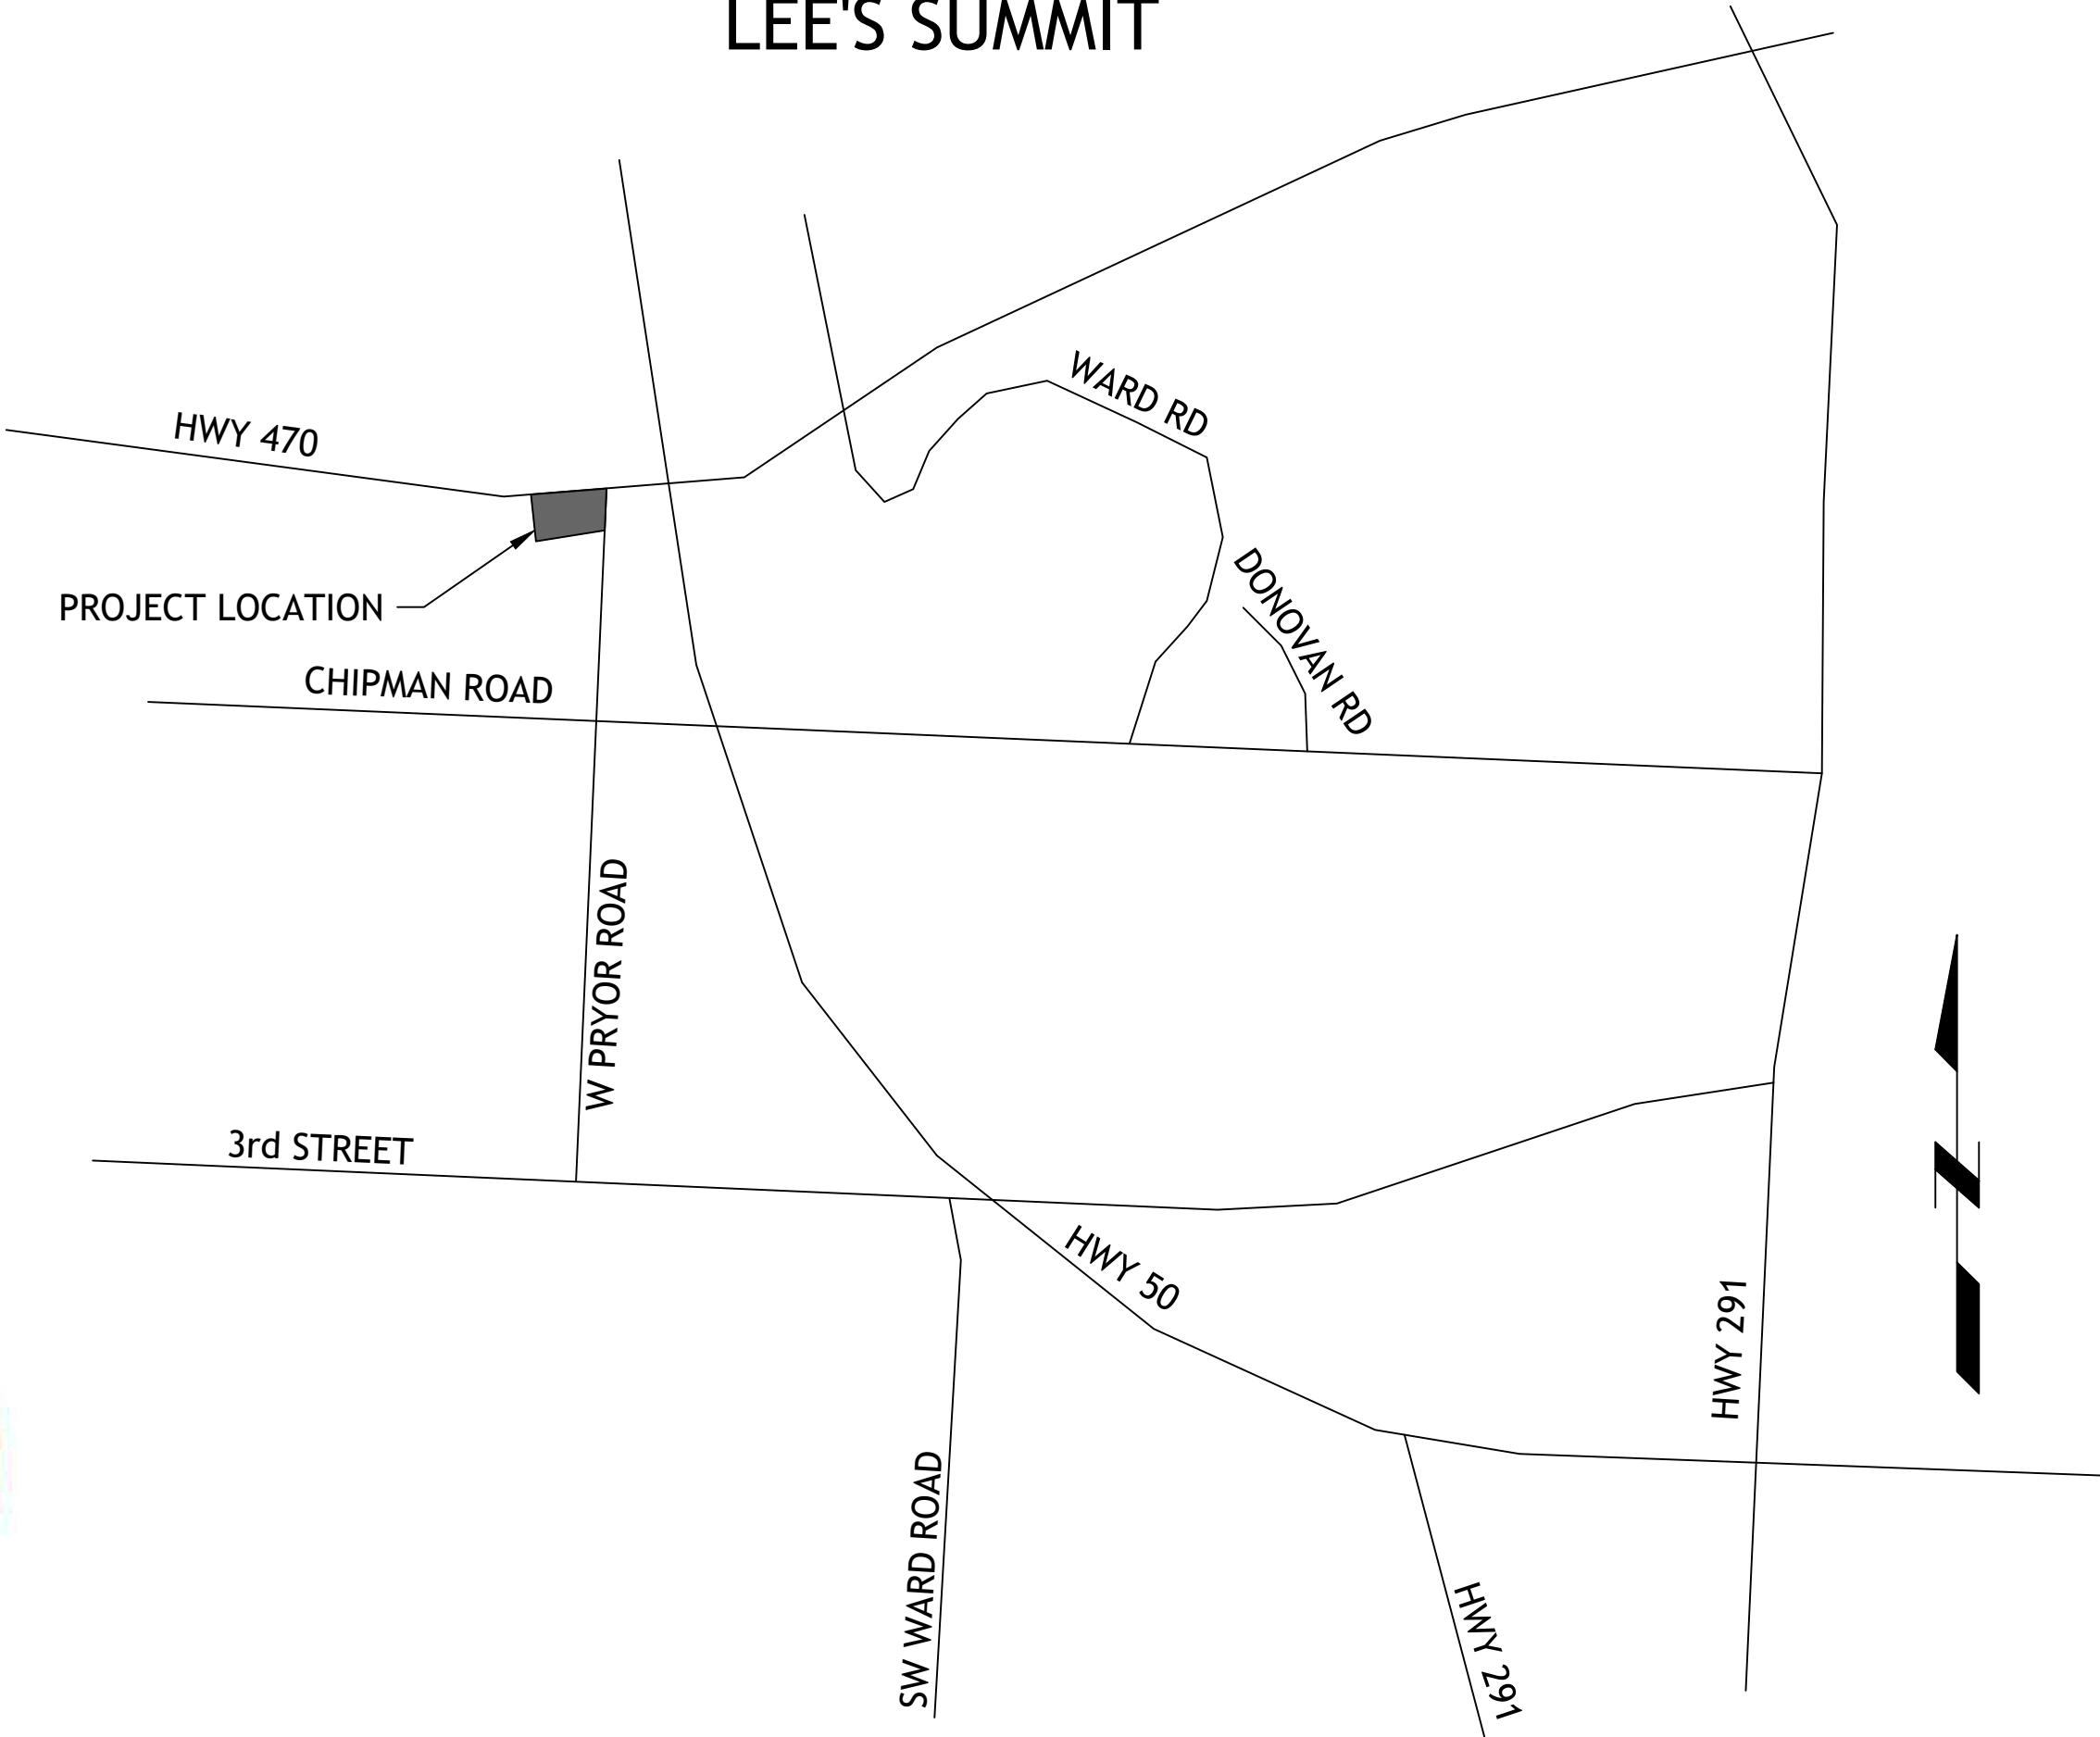

LOCATION MAP

UTILITY STATEMENT:
THE UNDERGROUND UTILITIES SHOWN HEREON ARE FROM FIELD SURVEY INFORMATION OF ONE-CALL LOCATED UTILITIES, FIELD SURVEY INFORMATION OF ABOVE GROUND OBSERVABLE EVIDENCE, AND/OR THE SCALING AND PLOTTING OF EXISTING UTILITY MAPS AND DRAWINGS AVAILABLE TO THE SURVEYOR AT THE TIME OF SURVEY. THE SURVEYOR MAKES NO GUARANTEE THAT THE UNDERGROUND UTILITIES SHOWN COMPRISE ALL SUCH UTILITIES IN THE AREA, EITHER IN SERVICE OR ABANDONED. FURTHERMORE, THE SURVEYOR DOES NOT WARRANT THAT THE UNDERGROUND UTILITIES SHOWN ARE IN THE EXACT LOCATION INDICATED ALTHOUGH HE DOES CERTIFY THAT THEY ARE LOCATED AS ACCURATELY AS POSSIBLE FROM INFORMATION AVAILABLE. THE SURVEYOR HAS NOT PHYSICALLY LOCATED THE UNDERGROUND UTILITIES BY EXCAVATION UNLESS OTHERWISE NOTED ON THIS SURVEY.
SAFETY NOTICE TO CONTRACTOR
IN ACCORDANCE WITH GENERALLY ACCEPTED CONSTRUCTION PRACTICE, THE CONTRACTOR WILL BE SOLELY AND COMPLETELY RESPONSIBLE FOR CONDITIONS OF THE JOB SITE, INCLUDING SAFETY OF ALL PERSONS AND PROPERTY DURING PERFORMANCE OF THE WORK. THIS REQUIREMENT WILL APPLY CONTINUOUSLY AND NOT BE LIMITED TO NORMAL WORKING HOURS.

WARRANTY/DISCLAIMER
THE DESIGNS REPRESENTED IN THESE PLANS ARE IN ACCORDANCE WITH ESTABLISHED PRACTICES OF CIVIL ENGINEERING FOR THE DESIGN FUNCTIONS AND USES INTENEDED BY THE OWNER AT THIS TIME. HOWEVER, NEITHER SM ENGINEERING NOR ITS PERSONNEL CAN OR DO WARRANTY THESE DESIGNS OR PLANS AS CONSTRUCTED, EXCEPT IN THE SPECIFIC CASES WHERE SM ENGINEERING PERSONNEL INSPECT AND CONTROL THE PHYSICAL CONSTRUCTION ON A CONTEMPORARY BASIS AT THE SITE.

CAUTION- NOTICE TO CONTRACTOR
THE CONTRACTOR IS SPECIFICALLY CAUTIONED THAT THE LOCATION AND/OR ELEVATION OF EXISTING UTILITIES AS SHOWN ON THESE PLANS IS BASED ON RECORDS OF THE VARIOUS UTILITY COMPANIES AND, WHERE POSSIBLE, MEASUREMENTS TAKEN IN THE FIELD. THE INFORMATION IS NOT TO BE RELIED ON AS BEING EXACT OR COMPLETE. THE CONTRACTOR MUST CALL THE APPROPRIATE UTILITY COMPANY AT LEAST 72 HOURS BEFORE ANY EXCAVATION TO REQUEST EXACT FIELD LOCATION OF UTILITIES. IT SHALL BE THE RESPONSIBILITY OF THE CONTRACTOR TO RELOCATE ALL EXISTING UTILITIES WHICH CONFLICT WITH PROPOSED IMPROVEMENTS SHOWN ON THE PLANS. THE CONTRACTOR SHALL EXPOSE EXISTING UTILITIES AT LOCATIONS OF POSSIBLE CONFLICTS PRIOR TO ANY CONSTRUCTION.

LEGAL DESCRIPTION:
LOT 13A, STREETS OF WEST PRYOR, LEE'S SUMMIT, JACKSON COUNTY MISSOURI

BENCHMARKS:
#1 CHISELED "SQUARE" ON TOP OF CURB POINT OF INTERSECTION OF WEST PARK PARKING LOT AT EAST DRIVE ENTRANCE
ELEVATION 985.05

#2 CHISELED "SQUARE" ON NORTHWEST CORNER AREA INLET, 25' EAST OF CURB LINE AND ON-LINE WITH SOUTH CURB OF LOWENSTEIN DRIVE AT 90° BEND IN ROAD
ELEVATION 971.06

- NOTE
- ALL CONSTRUCTION SHALL FOLLOW THE CITY OF LEE'S SUMMIT DESIGN AND CONSTRUCTION MANUAL AS ADOPTED BY ORDINANCE 5813. WHERE DISCREPANCIES EXIST BETWEEN THESE PLANS AND THE DESIGN AND CONSTRUCTION MANUAL, THE MORE STRINGENT SHALL PREVAIL.
 - THERE ARE NO GAS/OIL WELLS PER MDNR DATABASE OF OIL & GAS PERMITS
 - SITE IS LOCATED WITHIN FEMA ZONE X, AREAS OF MINIMAL FLOODING PER FEMA 29095C0416G DATED 1-20-17.

INDEX OF SHEETS

- C-1 COVER SHEET
- C-2 EXISTING CONDITIONS
- C-3 SITE PLAN
- C-4 UTILITY PLAN
- C-5 GRADING PLAN
- C-6 EROSION CONTROL PLAN
- C-7 EROSION CONTROL DETAILS
- C-8 STORM LINE C PLAN AND PROFILE
- C-8.1 STORM LINE F PLAN AND PROFILE
- C-9 WATERLINE A PLAN AND PROFILE
- C-10 WATERLINE B & C PLAN AND PROFILE
- C-11 DETAILS
- C-12 DETAILS
- C-13 DETAILS
- L-1 LANDSCAPE PLAN

DEVELOPER

STREETS OF WEST PRYOR, LLC
DAVID N. OLSON
7200 W 133rd ST, SUITE 150
CELL: OVERLAND PARK, KS 66213
314-413-3598

ENGINEER

SM ENGINEERING
5507 High Meadow Circle
Manhattan Kansas, 66503
smcivilengr@gmail.com
785.341.9747



SAMUEL D. MALINOWSKY
PROFESSIONAL ENGINEER

RELEASED FOR CONSTRUCTION
As Noted on Plans Review

SM Engineering
5507 High Meadow Circle
Manhattan Kansas, 66503
smcivilengr@gmail.com
785.341.9747

Drawings and/or Specifications are original proprietary work and property of the Engineer and intended specifically for this project. Use of items contained herein without consent of the Engineer is prohibited. Drawings illustrate best information available to the Engineer. Field verification of actual elements, conditions, and dimensions is required.

Revisions
11-29-23 CITY COMMENTS
1-4-24 PER CLIENT
1-16-24 PER EVERGY


LOT 13A OF WEST PRYOR
LEE'S SUMMIT, MISSOURI

s h e e t
C1.0
Civil
COVER SHEET
permit
19 OCTOBER 2023

Revisions
11-29-23 CITY COMMENTS

LOT 13A OF
WEST PRYOR
LEE'S SUMMIT, MISSOURI


s h e e t
C2.0
Civil
EXISTING CONDITIONS
permit
19 OCTOBER 2023

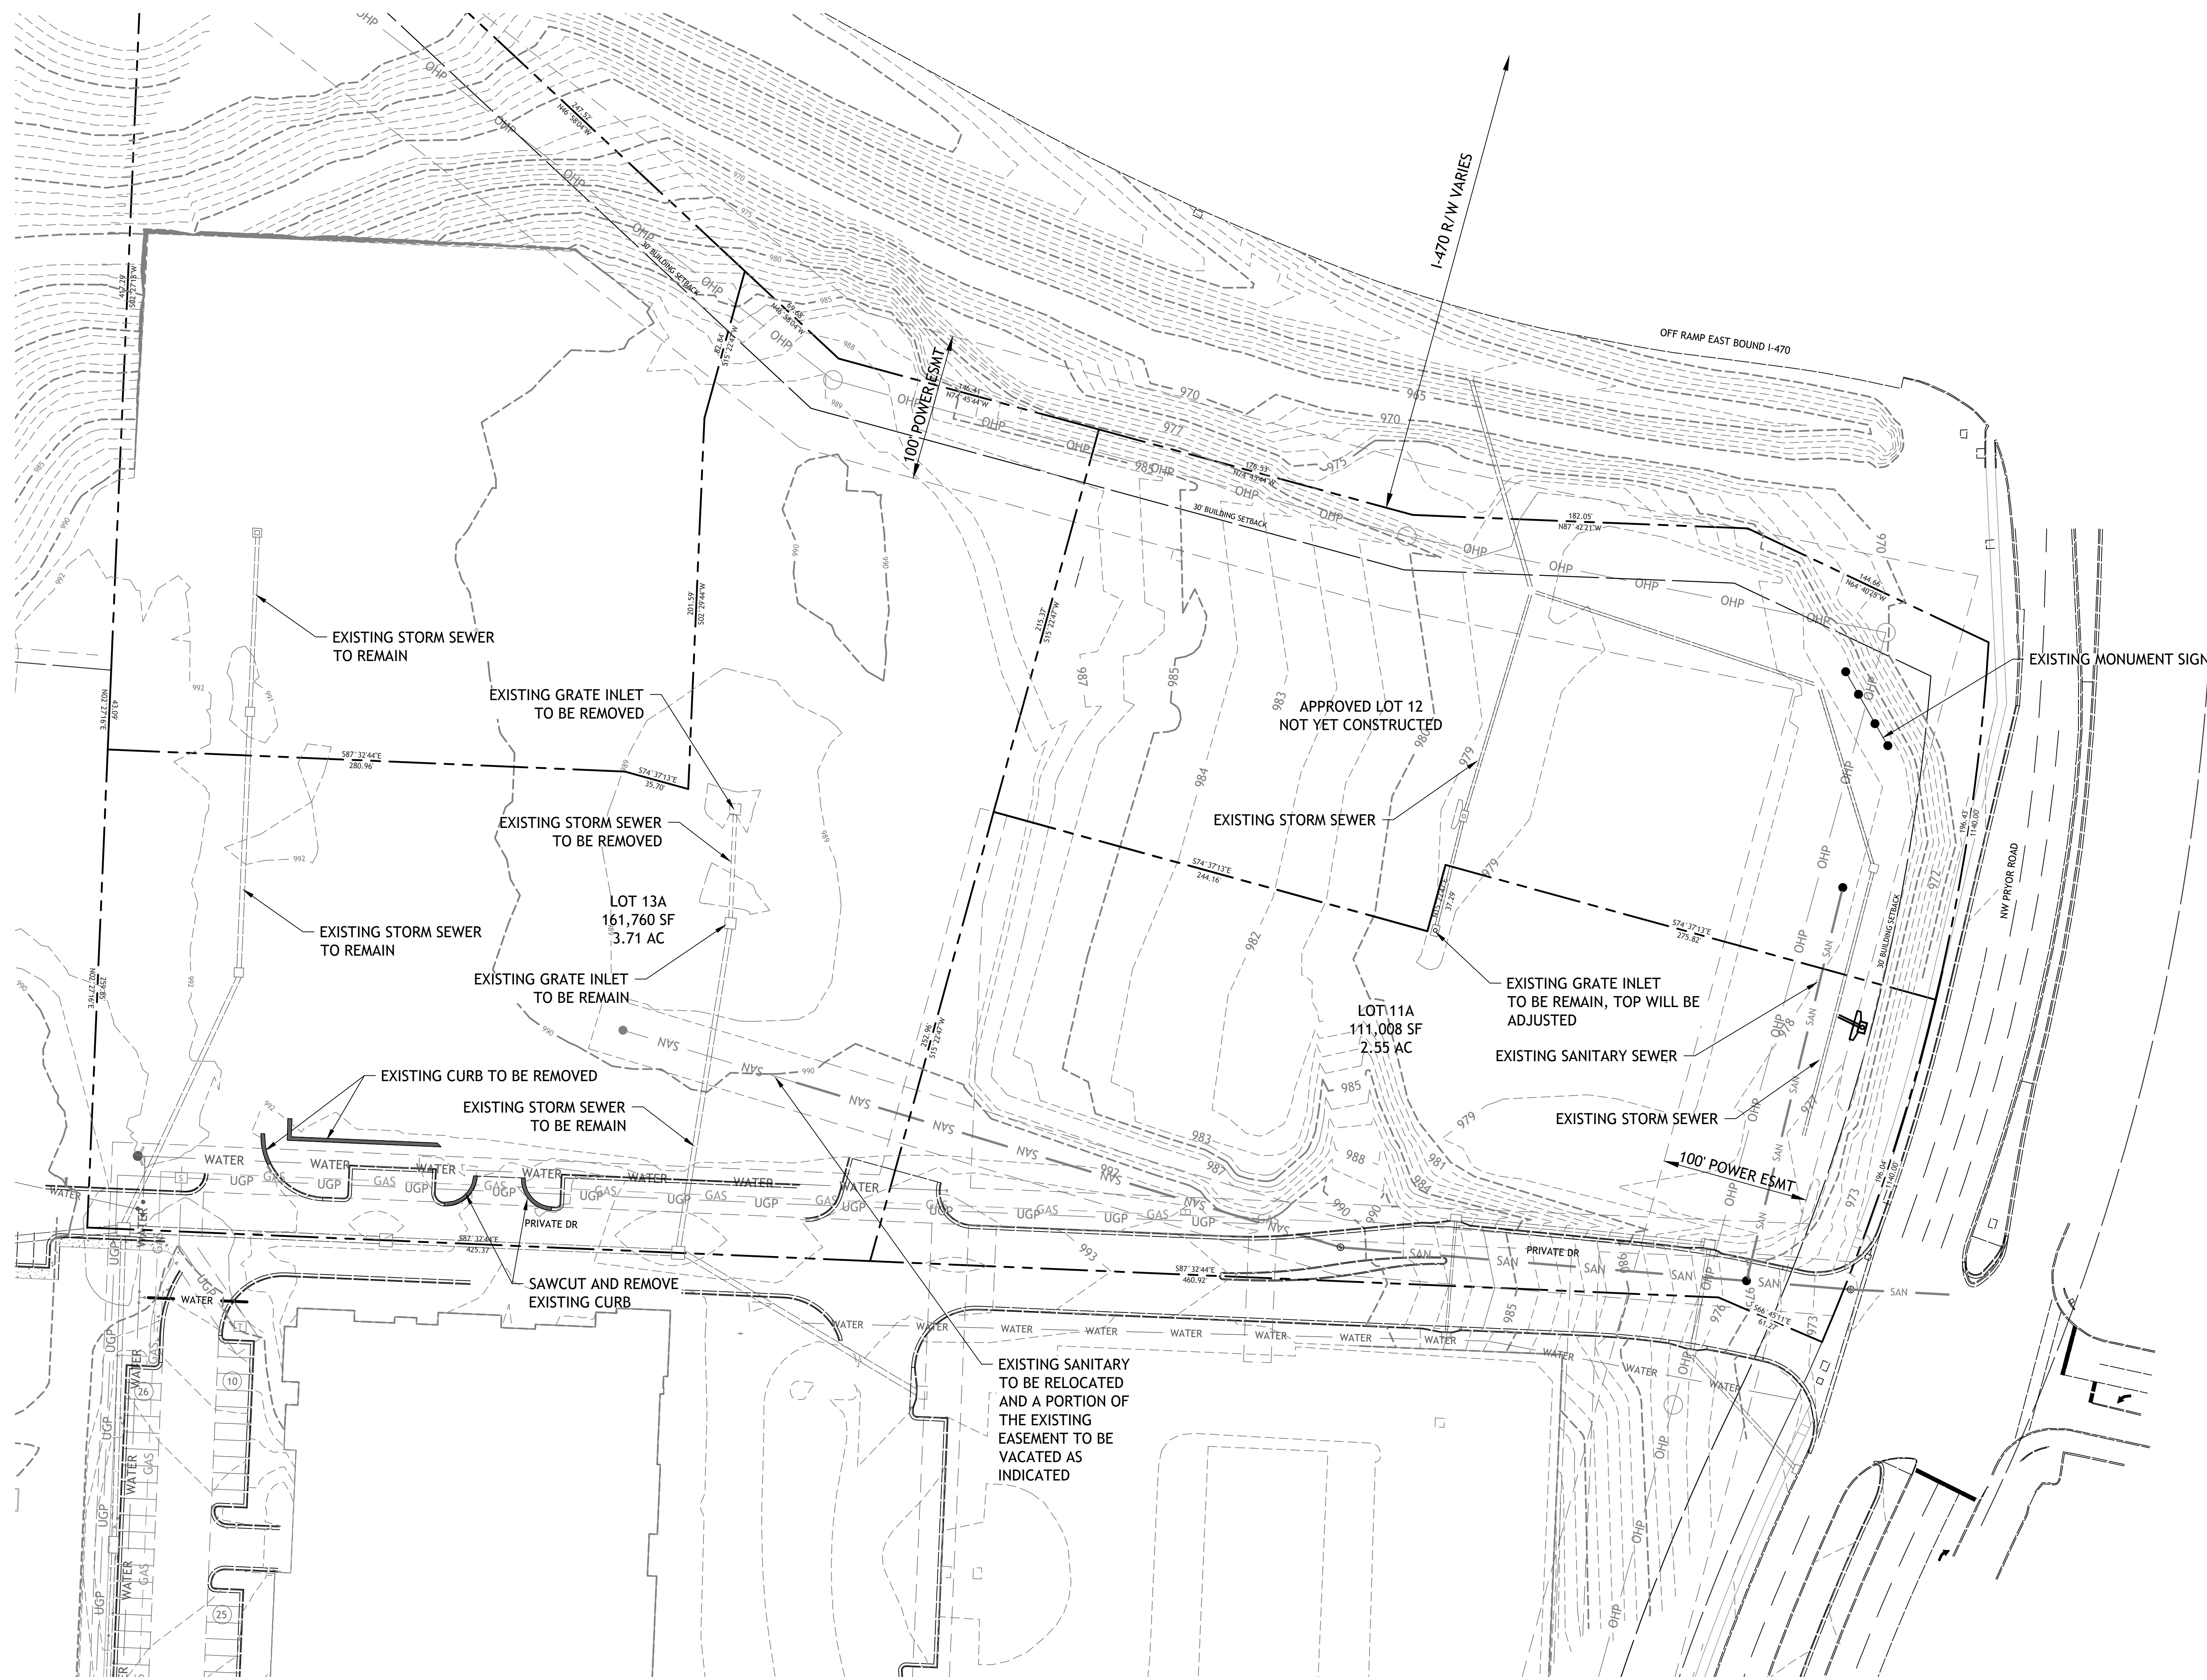


SITE DATA	
LOT 13	
TOTAL SITE	3.71ac (161,760sf)
PAVEMENT AREA	118,941,sf
BUILDING	12,000sf
TOTAL	130,941sf
OPEN SPACE	30,819sf (19.1%)
PARKING REQUIRED	
14/1000sf	168
PROVIDED	247
FAR	0.074

- CONSTRUCTION NOTES:
- COORDINATE START-UP AND ALL CONSTRUCTION ACTIVITIES WITH OWNER.
 - CONSTRUCTION METHODS AND MATERIALS NOT SPECIFIED IN THESE PLANS ARE TO MEET OR EXCEED THE STANDARD SPECIFICATIONS.
 - ALL CONSTRUCTION WORK AND UTILITY WORK OUTSIDE OF PROPERTY BOUNDARIES SHALL BE PERFORMED IN COOPERATION WITH AND IN ACCORDANCE WITH REGULATIONS OF THE AUTHORITIES CONCERNED.
 - PUBLIC CONVENIENCE AND SAFETY: THE CONTRACTOR SHALL CONDUCT THE WORK IN A MANNER THAT WILL INSURE, AS FAR AS PRACTICABLE, THE LEAST OBSTRUCTION TO TRAFFIC, AND SHALL PROVIDE FOR TI-1E CONVENIENCE AND SAFETY OF THE GENERAL PUBLIC AND RESIDENTS ALONG AND ADJACENT TO STREETS IN THE CONSTRUCTION AREA.
 - ALL DIMENSIONS SHOWN ARE TO THE BACK OF CURB UNLESS OTHERWISE NOTED.
 - ACCESSIBLE STALLS SHOWN WITH A "VAN" SHALL BE 16'-0" MIN. AND SHALL HAVE A SIGN DESIGNATING "VAN-ACCESSIBLE". SEE DETAIL102.

- NOTE:
- CONTRACTOR SHALL REFER TO ARCHITECTURAL PLANS FOR EXACT LOCATIONS AND DIMENSIONS OF ENTRANCE. SLOPED PAVING, EXIT PORCHES AND RAMPS, PRECISE BUILDING DIMENSIONS AND EXACT BUILDING UTILITY ENTRANCE LOCATIONS.
 - THESE PLANS HAVE NOT BEEN VERIFIED WITH FINAL ARCHITECTURAL CONTRACT DRAWINGS. CONTRACTOR SHALL VERIFY AND NOTIFY THE ENGINEER OF ANY DISCREPANCIES. CONTRACTOR IS FULLY RESPONSIBLE FOR REVIEW AND COORDINATION OF ALL DRAWINGS AND CONTRACTOR DOCUMENTS.
 - ALL DIMENSIONS ARE PERPENDICULAR TO PROPERTY LINE.
 - ACTUAL SIGN LOCATIONS TO BE COORDINATED WITH CONSTRUCTION MANAGER.

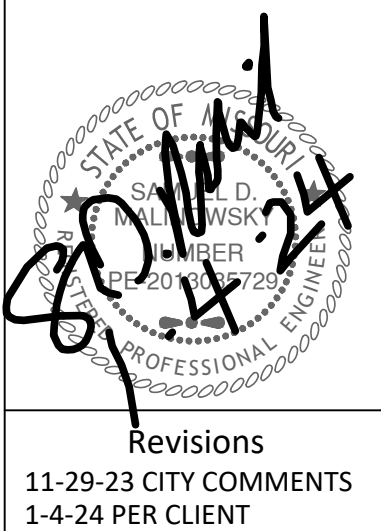


LOT 13A OF
WEST PRYOR
LEE'S SUMMIT, MISSOURI

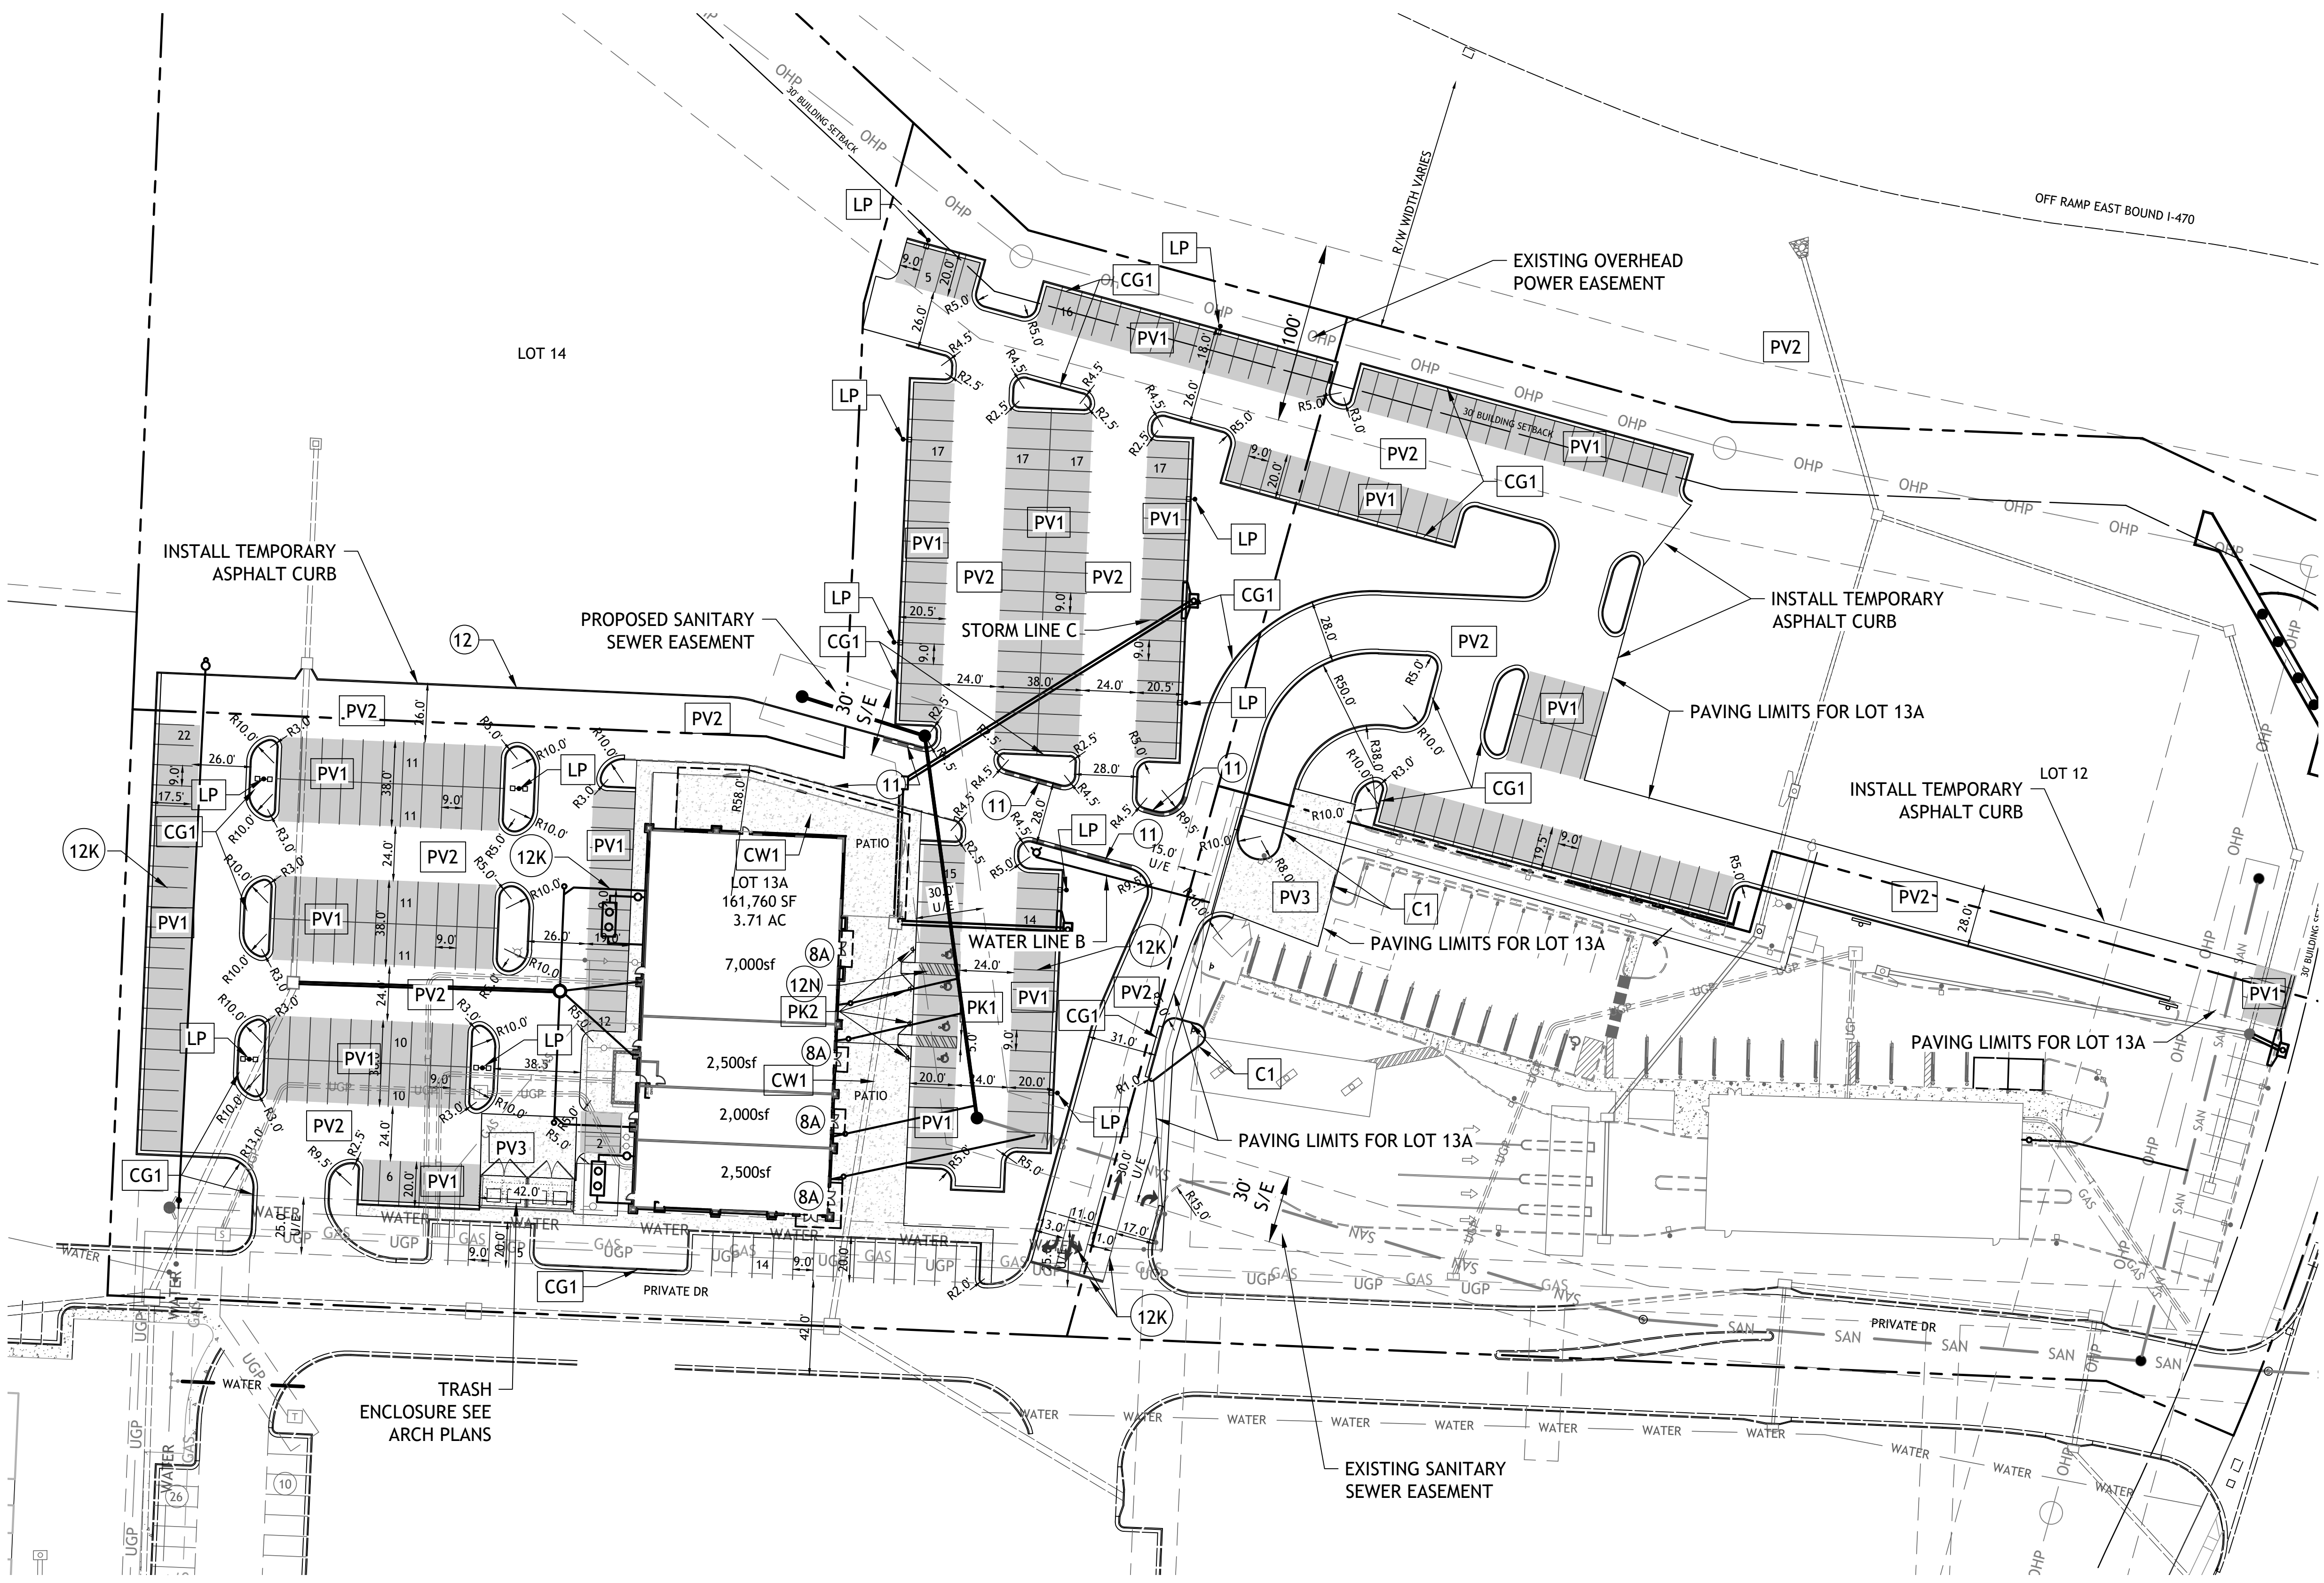


NOTE:
LOT LINES SHOWN ARE PROPOSED
LOTS 11 & 14 TO BE REPLATTED TO SHOW
PROPOSED LOT LINES.

- SEE DETAIL SHEET FOR THE FOLLOWING DETAILS:
PK-1 96" ACCESSIBLE & VAN ACCESSIBLE SPACE STRIPING
PK-2 ACCESSIBLE SIGN
SG-1 BOLLARD DETAIL
C1 STRAIGHT BACK CURB
CG-1 TYPE B CURB AND GUTTER
CW1 CURB WALK AT BUILDING
PV1 REGULAR DUTY PAVEMENT
PV2 HEAVY DUTY ASPHALT PAVEMENT
PV3 HEAVY DUTY CONCRETE PAVEMENT
CW2 SIDEWALK
LP LIGHT POLE (SEE ARCH PLANS)
- NOTES:
8A DOOR (SEE ARCH. PLANS)
12K YELLOW PARKING LOT STRIPING (SHERWIN-WILLIAMS TM 2160 LEAD FREE OR APPROVED EQUAL)
12N 4" YELLOW STRIPES 3'-0" O.C.
11 PAINT CURB RED WITH "FIRE LANE - NO PARKING" 4" WHITE LETTERS NO MORE THAN 15' APART
12 PAINT 6" WIDE RED STRIPE WITH "FIRE LANE - NO PARKING" 4" WHITE LETTERS

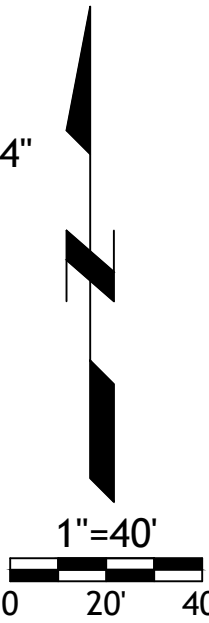

UTILITY NOTES:

1. ALL UTILITY AND STORM SEWER TRENCHES CONSTRUCTED UNDER AREAS THAT RECEIVE PAVING SHALL BE BACKFILLED TO 18 INCHES ABOVE THE TOP OF THE PIPE WITH SELECT GRANULAR MATERIAL PLACED ON EIGHT-INCH LIFTS, AND COMPACTED TO 95% MODIFIED PROCTOR DENSITY.
2. CONTRACTOR SHALL NOT OPEN, TURN OFF, INTERFERE WITH, OR ATTACH ANY PIPE OR HOSE TO OR TAP ANY WATER MAIN BELONGING TO THE CITY UNLESS DULY AUTHORIZED TO DO SO BY THE CITY. ANY ADVERSE CONSEQUENCE OF ANY SCHEDULED OR UNSCHEDULED DISRUPTIONS OF SERVICE TO THE PUBLIC ARE TO BE THE LIABILITY OF THE CONTRACTOR. SM ENGINEERING AND OWNER ARE TO BE HELD HARMLESS.
3. ALL WATER AND SANITARY SEWER SYSTEMS THAT ARE TO BE PUBLIC LINES SHALL BE CONSTRUCTED IN ACCORDANCE WITH SPECIFICATIONS PREVIOUSLY APPROVED BY THE CITY OF LEES SUMMIT AND THE STATE OF MISSOURI AND SHALL BE INSPECTED BY THE CITY. IT IS THE CONTRACTOR'S RESPONSIBILITY TO ASSURE THAT THIS INSPECTION OCCURS.
4. LOCATIONS SHOWN FOR PROPOSED WATER LINES ARE APPROXIMATE. VARIATIONS MAY BE MADE, WITH APPROVAL OF THE ENGINEER, TO AVOID CONFLICTS.
5. CONTRACTOR TO INSTALL TRACING TAPE ALONG ALL NON-METALLIC WATER MAINS AND SERVICE LINES PER SPECIFICATIONS.
6. CONTRACTOR SHALL EXPOSE EXISTING UTILITIES AT LOCATIONS OF POSSIBLE CONFLICT AND POINTS OF CONNECTION PRIOR TO ANY CONSTRUCTION OF NEW UTILITIES.
7. WATER LINES SHALL HAVE A MINIMUM COVER OF 42 INCHES. ALL VALVES ON MAINS AND FIRE HYDRANT LEADS SHALL BE WITH VALVE BOX ASSEMBLIES. THE SIZE OF VALVE BOX ASSEMBLY TO BE INSTALLED IS DETERMINED BY THE TYPE AND SIZE OF VALVE. VALVE BOX CAPS SHALL HAVE THE WORD "WATER".
8. A MINIMUM HORIZONTAL DISTANCE OF 10 FEET SHALL BE MAINTAINED BETWEEN PARALLEL WATER AND SANITARY SEWER LINES. WHEN IT IS NECESSARY FOR ANY WATER LINE TO CROSS A SANITARY SEWER LINE, THE SEWER LINE SHALL BE CONSTRUCTED OF DUCTILE IRON PIPE AT LEAST 10 FEET EITHER SIDE OF THE WATER LINE UNLESS THE WATER LINE IS AT LEAST 2 FEET CLEAR DISTANCE ABOVE THE SANITARY SEWER LINE.
9. INSTALL 2" TYPE "K" COPPER FROM THE MAIN TO 10' BEYOND METER AND EITHER TYPE "K" OR POLYETHYLENE PLASTIC TUBING (PE 3608) TO STOP AND WASTE VALVE INSIDE BUILDING.
10. CONTRACTOR RESPONSIBLE FOR PROVIDING CASEMENT FOR ELECTRICAL SERVICE PER KCP&L
11. SANITARY SEWER SERVICE CONNECTIONS WILL BE MADE WITH A CUT IN WYE

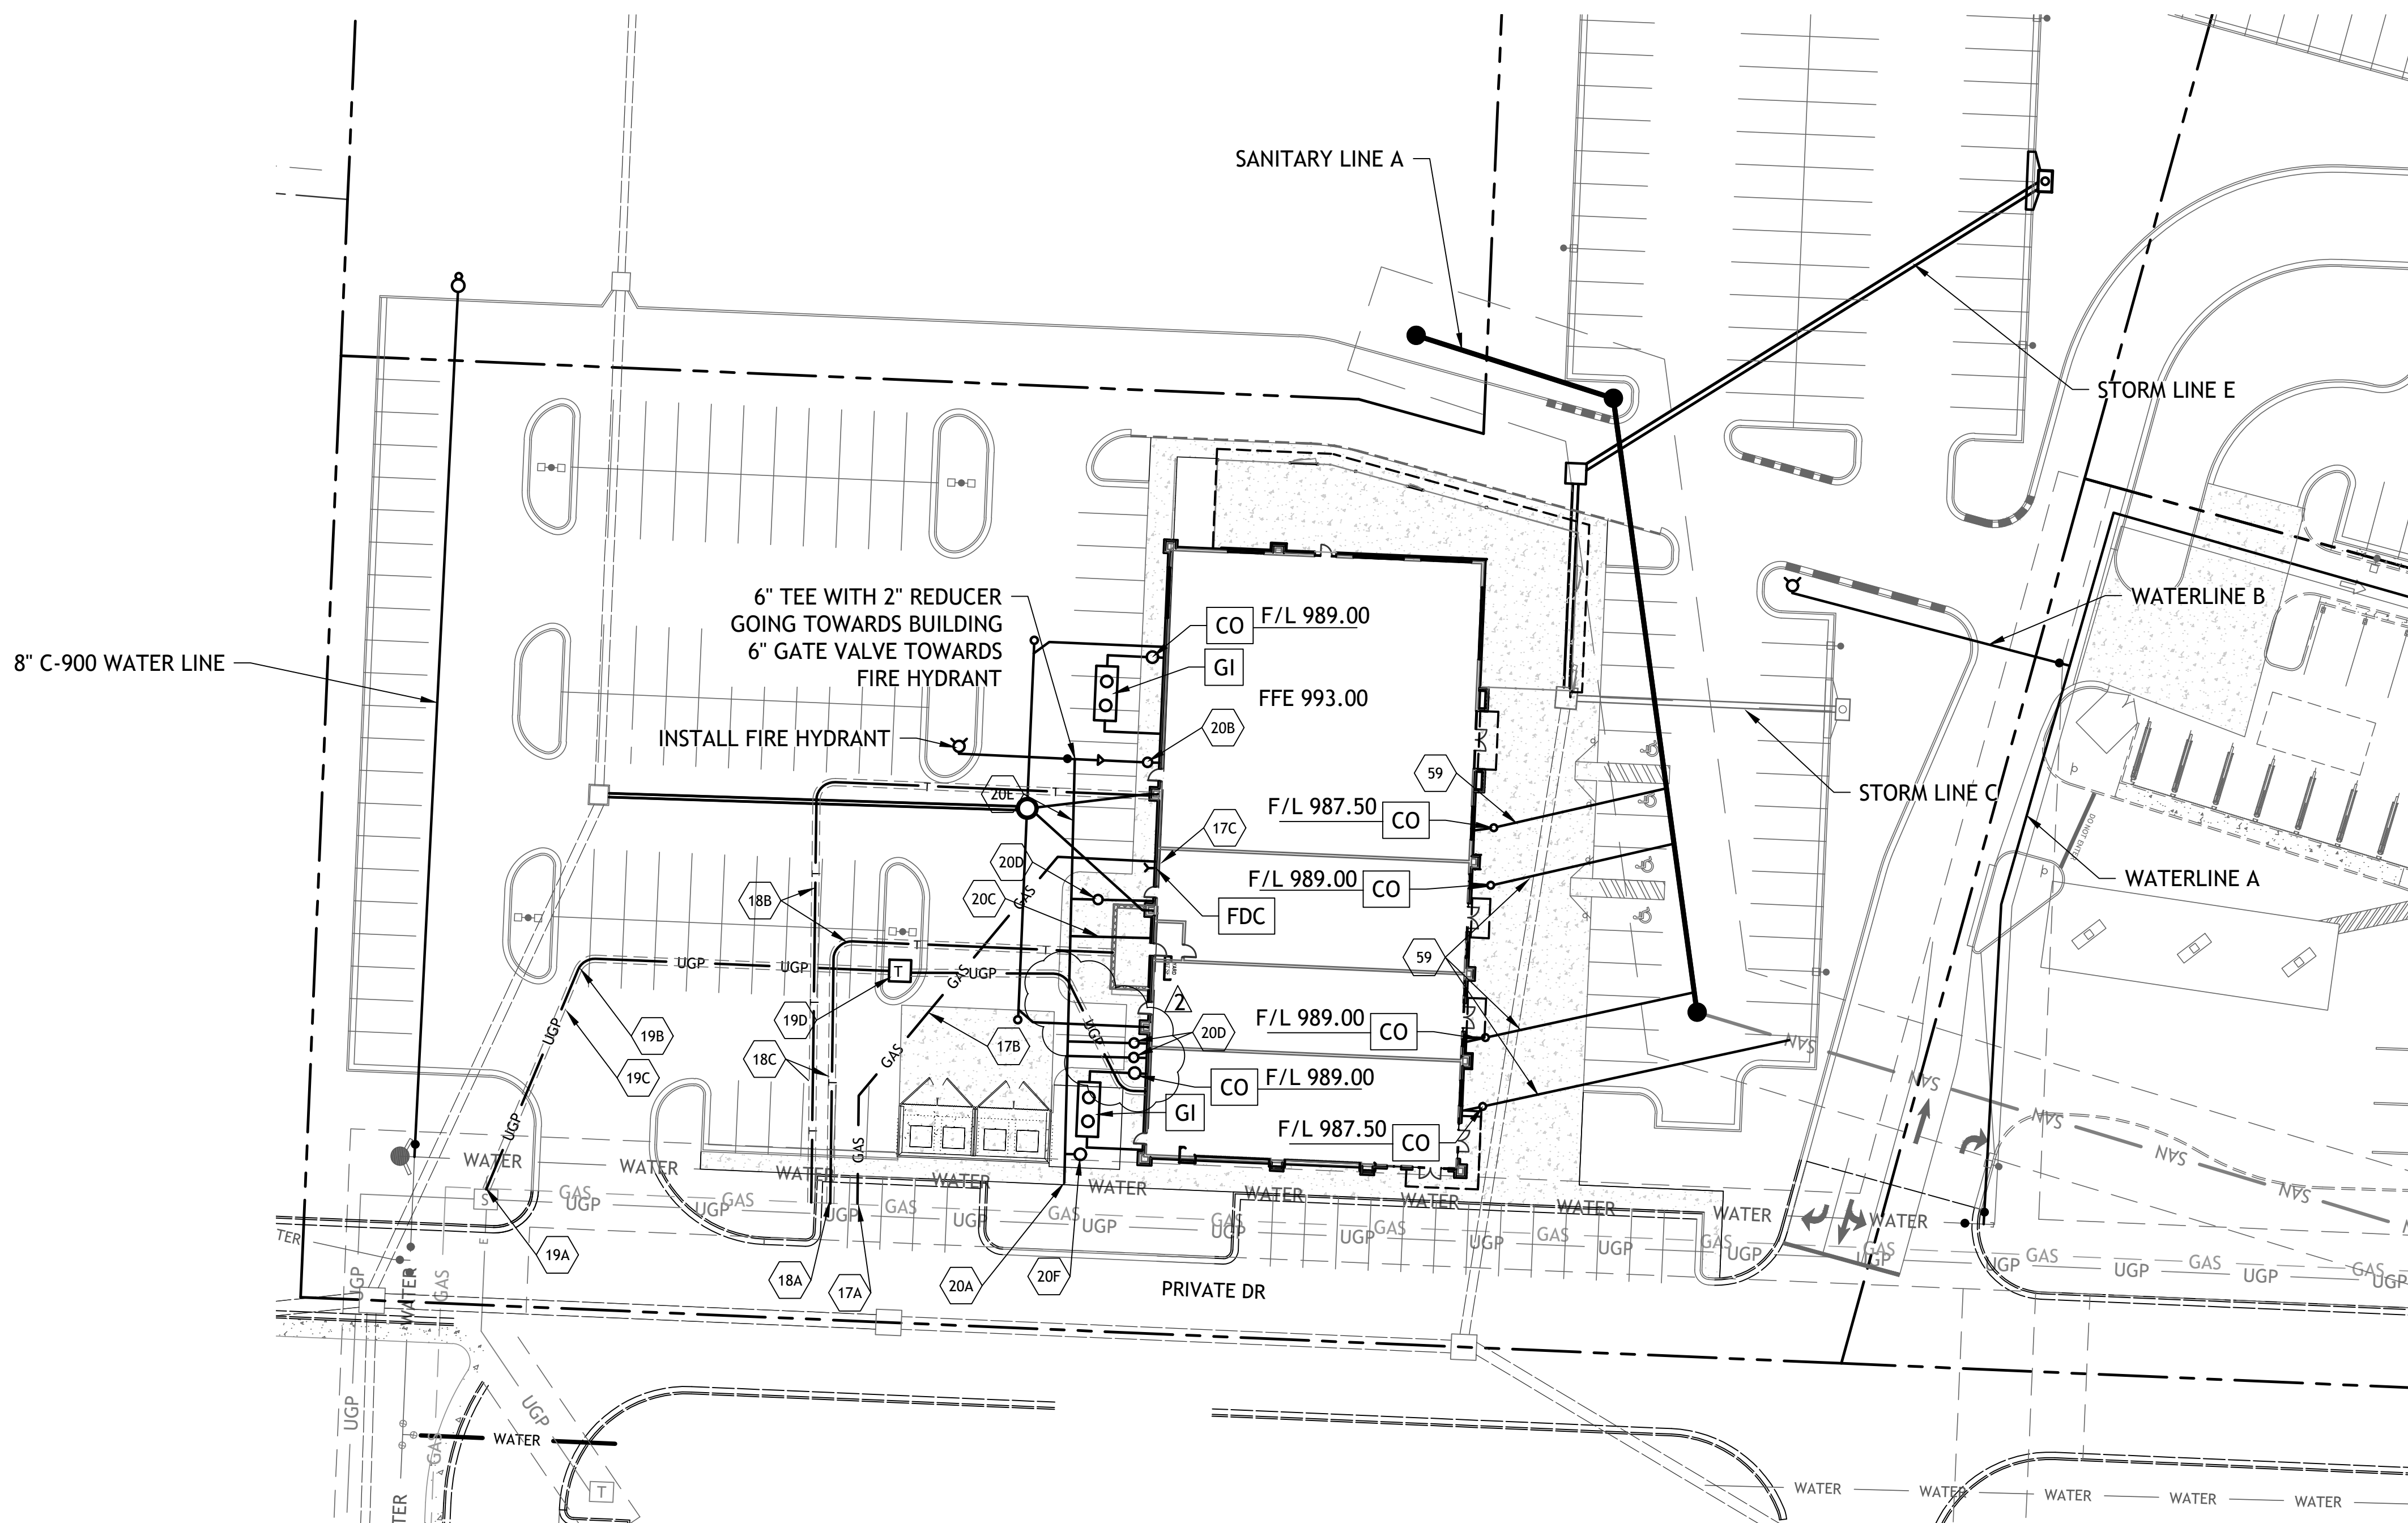

DETAILS


- MS1 TRENCH AND BEDDING DETAILS
- SS2 2-WAY CLEAN-OUT
- FH FIRE HYDRANT
- CO CLEANOUT
- GI GREASE INTERCEPTOR (1,500 GAL)


NOTES

- 17A POINT OF CONNECTION - GAS SERVICE
- 17B GAS SERVICE (BY GAS COMPANY)
- 17C GAS METER
- 18A POINT OF CONNECTION - TELEPHONE SERVICE - COORDINATE WITH TELEPHONE COMPANY
- 18B UNDERGROUND TELEPHONE SERVICE PER LOCAL TELEPHONE COMPANY
- 18C 2-2" CONDUITS INSTALLED BY CONTRACTOR - TELEPHONE SERVICE
- 19A POINT OF CONNECTION - ELECTRICAL SERVICE
- 19C 4" CONDUIT WITH STEEL SWEEPS INSTALLED BY CONTRACTOR - ELECTRIC SERVICE
- 19D TRANSFORMER PAD
- 20A POINT OF CONNECTION - WATER SERVICE
- 20B 2" TAP AND METER WITH 2" SERVICE LINE
- 20C 6" FIRE LINE
- 20D 1" TAP AND METER WITH 1"
- 20E 6" C-900 WATERLINE
- 59 4" SANITARY SEWER SERVICE LINE
- 20F 1" TAP AND METER WITH 1" SERVICE LINE FOR IRRIGATION

UTILITY STATEMENT:

THE UNDERGROUND UTILITIES SHOWN HEREON ARE FROM FIELD SURVEY INFORMATION OF ONE-CALL LOCATED UTILITIES, FIELD SURVEY INFORMATION OF ABOVE GROUND OBSERVABLE EVIDENCE, AND/OR THE SCALING AND PLOTTING OF EXISTING UTILITY MAPS AND DRAWINGS AVAILABLE TO THE SURVEYOR AT THE TIME OF SURVEY. THE SURVEYOR MAKES NO GUARANTEE THAT THE UNDERGROUND UTILITIES SHOWN COMPRISE ALL SUCH UTILITIES IN THE AREA, EITHER IN SERVICE OR ABANDONED. FURTHERMORE, THE SURVEYOR DOES NOT WARRANT THAT THE UNDERGROUND UTILITIES SHOWN ARE IN THE EXACT LOCATION INDICATED ALTHOUGH HE DOES CERTIFY THAT THEY ARE LOCATED AS ACCURATELY AS POSSIBLE FROM INFORMATION AVAILABLE. THE SURVEYOR HAS NOT PHYSICALLY LOCATED THE UNDERGROUND UTILITIES BY EXCAVATION UNLESS OTHERWISE NOTED ON THIS SURVEY.

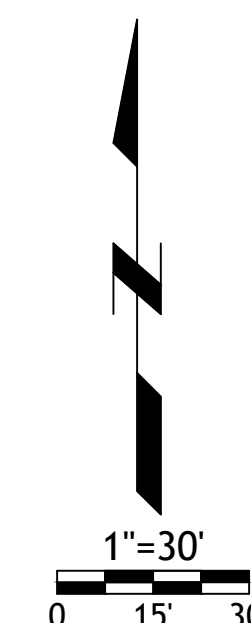

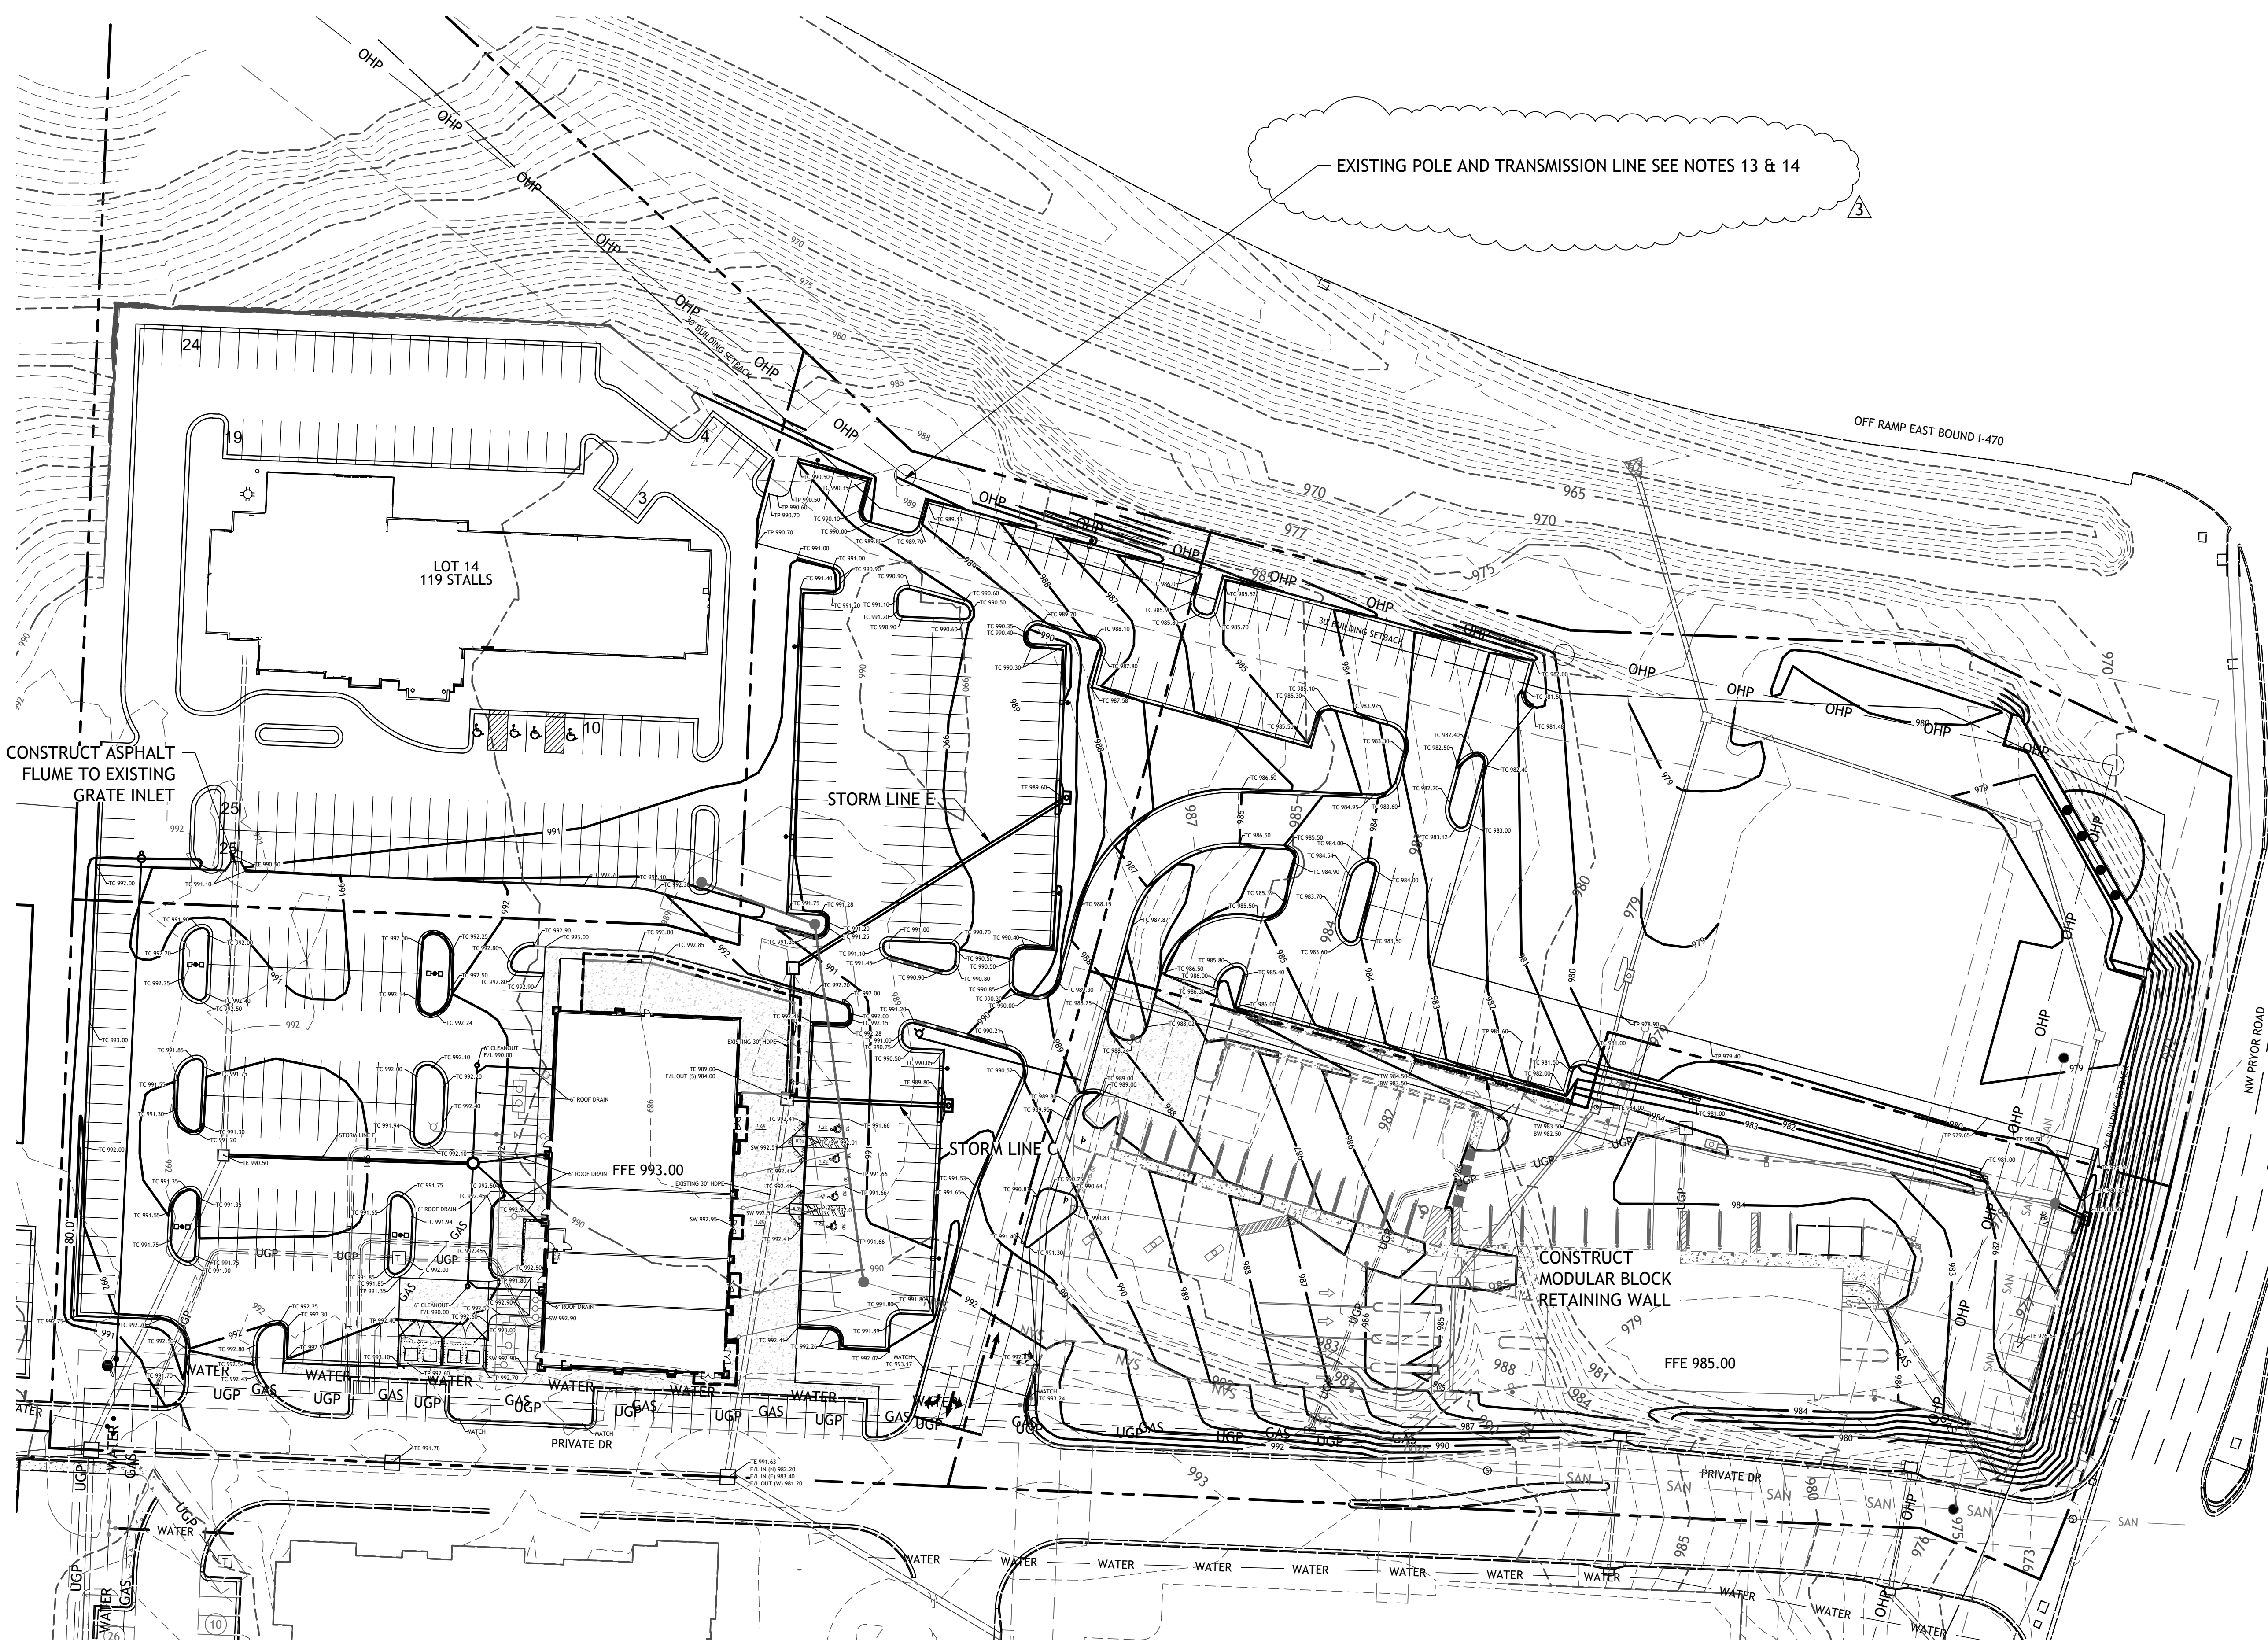

EXISTING POLE AND TRANSMISSION LINE SEE NOTES 13 & 14


GRADING NOTES:

1. EARTHWORK UNDER THE BUILDING SHALL COMPLY WITH THE PROJECT ARCHITECTURAL PLANS. OTHER FILL MATERIAL SHALL BE MADE IN LIFTS NOT TO EXCEED EIGHT INCHES DEPTH COMPACTED TO 95% STANDARD PROCTOR DENSITY. FILL MATERIAL MAY INCLUDE ROCK FROM ON-SITE EXCAVATION IF CAREFULLY PLACED SO THAT LARGE STONES ARE WELL DISTRIBUTED AND VOIDS ARE COMPLETELY FILLED WITH SMALLER STONES, EARTH, SAND OR GRAVEL TO FURNISH A SOLID EMBANKMENT. NO ROCK LARGER THAN THREE INCHES IN ANY DIMENSION NOR ANY SHALE SHALL BE PLACED IN THE TOP 12 INCHES OF EMBANKMENT.
2. AREAS THAT ARE TO BE CUT TO SUBGRADE LEVELS SHALL BE PROOF ROLLED WITH A MODERATELY HEAVY LOADED DUMP TRUCK OR SIMILAR APPROVED CONSTRUCTION EQUIPMENT TO DETECT UNSUITABLE SOIL CONDITIONS.
3. IN ALL AREAS OF EXCAVATION, IF UNSUITABLE SOIL CONDITIONS ARE ENCOUNTERED. A QUALIFIED GEOTECHNICAL ENGINEER SHALL RECOMMEND TO THE OWNER THE METHODS OF UNDERCUTTING AND REPLACEMENT OF PROPERLY COMPACTED, APPROVED FILL MATERIAL. ALL PROOF ROLLING AND UNDERCUTTING SHOULD BE PERFORMED DURING A PERIOD OF DRY WEATHER.
4. CONTRACTOR SHALL USE SILT FENCE OR OTHER MEANS OF CONTROLLING EROSION ALONG THE EDGE OF THE PROPERTY OR OTHER BOTTOM OF SLOPE LOCATIONS.
5. CONTRACTOR IS TO REMOVE AND DISPOSE OF ALL DEBRIS, RUBBISH AND OTHER MATERIALS RESULTING FROM PREVIOUS AND CURRENT DEMOLITION OPERATIONS.
6. THE CONTRACTOR SHALL TAKE ALL PRECAUTIONS NECESSARY TO AVOID PROPERTY DAMAGE TO ADJACENT PROPERTIES DURING THE CONSTRUCTION PHASES OF THIS PROJECT. THE CONTRACTOR WILL BE HELD SOLELY RESPONSIBLE FOR ANY DAMAGES TO THE ADJACENT PROPERTIES OCCURRING DURING THE CONSTRUCTION PHASES OF THIS PROJECT.
7. IT IS NOT THE DUTY OF THE ENGINEER OR THE OWNER TO REVIEW THE ADEQUACY OF THE CONTRACTOR'S SAFETY MEASURES, IN, ON OR NEAR THE CONSTRUCTION SITE AT ANY TIME DURING CONSTRUCTION.
8. PIPE LENGTHS ARE CENTER TO CENTER OF STRUCTURE OR TO END OF END SECTIONS.
9. HANDICAP STALLS SHALL MEET ADA REQUIREMENTS AND SHALL NOT EXCEED 2% SLOPE IN ANY DIRECTION AT THE BUILDING ENTRY AND ACCESSIBLE PARKING STALLS. SLOPES EXCEEDING 2.0% WILL BE REPLACED AT THE CONTRACTOR'S EXPENSE.
10. ALL CONSTRUCTION TRAFFIC, TEMPORARY TRAFFIC CONTROL DEVICES AND PAVEMENT MARKINGS SHALL CONFORM TO REQUIREMENTS OF THE LATEST MANUAL OF UNIFORM TRAFFIC CONTROL DEVICES.
11. CONTRACTOR TO PLACE 8" LOW PERMEABILITY LVC FOR BUILDING PAD
12. CONTRACTOR TO CONSTRUCT THROATS TO CURB INLETS.
13. NO HEAVY EQUIPMENT ALLOWED WITHIN 5' OF EXISTING POLE FOUNDATION TOP OF FOUNDATION SHALL REMAIN 2' ABOVE EXISTING GROUND UPON COMPLETION OF CONSTRUCTION.
14. AT NO TIME SHALL CONSTRUCTION EQUIPMENT BE ALLOWED WITH 20' OF ANY PART OF THE TRANSMISSION LINE.

NOTE
ANY GRADING SHOWN ON LOT 11 OTHER THAN WHAT IS
REQUIRED FOR THE ACCESS DRIVES INDICATED ON THE SITE
PLAN IS SHOWN FOR INFORMATION ONLY AND IS NOT PART
OF THESE PLANS.


NOTES:


1. Prior to Land Disturbance activities, the following shall occur:
 - a) Identify the limits of construction on the ground with easily recognizable indications such as construction staking, construction fencing and placement of physical barriers or other means acceptable to the City Inspector and in conformance with the erosion and pollution control plan;
 - b) Construct a stabilized entrance/parking/staging area;
 - c) Install perimeter controls and protect any existing stormwater inlets;
 - d) Request an initial inspection of the installed Phase I pollution control measures designated on the approved erosion and pollution control plan. Land disturbance work shall not proceed until there is a passed inspection
2. The site shall comply with all requirements of the MoDNR general requirements
 - a) Immediate initiation of temporary stabilization BMPs on disturbed areas where construction activities have temporarily ceased on that portion of the project site if construction activities will not resume for a period exceeding 14 calendar days. Temporary stabilization may include establishment of vegetation, geotextiles, mulches or other techniques to reduce or eliminate erosion until either final stabilization can be achieved or until further construction activities take place to re-disturb the area. This stabilization must be completed within 14 calendar days;
 - b) Inspection of erosion and sediment control measures shall be performed to meet or exceed the minimum inspection frequency in the MoDNR General Permit. At a minimum, inspections shall be performed during all phases of construction at least once every 14 days and within 24 hours of each precipitation event.
 - c) An inspection log shall be maintained and shall be available for review by the regulatory authority;
 - d) The erosion and pollution control plan shall be routinely updated to show all modifications and amendments to the original plan. A copy of the erosion and pollution control plan shall be kept on site and made available for review by the regulatory authority.
3. Temporary seeding shall only be used for periods not to exceed 12 months. For final stabilization, temporary seeding shall only be used to establish vegetation outside the permanent seeding or sodding dates as specified in the Standard Specifications. Final stabilization requires a uniform perennial vegetative cover with a density of 70% over 100% of disturbed area.
4. Erosion and pollution control shall be provided for the duration of a project. All installed erosion and pollution control BMPs shall be maintained in a manner that preserves their effectiveness. If the City determines that the BMPs in place do not provide adequate erosion and pollution control at any time during the project, additional or alternate measures that provide effective control shall be required.
5. Concrete wash or rinse water from concrete mixing equipment. Tools and/or ready-mix trucks, etc., may not be discharged into or be allowed to run to any existing water body or portion of the storm water system. One or more locations for concrete washout will be designated on site, such that discharges during concrete washout will be contained in a small area where waste concrete can solidify in place. Proper signage will be installed to direct users to the concrete washout. Concrete washouts must be handled prior to pouring any concrete.
6. Silt fences and sediment control BMPs which are shown along the back of curb must be installed within two weeks of curb backfill and prior to placement of base asphalt. Exact locations of these erosion control methods may be field adjusted to minimize conflicts with utility construction. However, anticipated disturbance by utility construction shall not delay installation.
7. Required sediment basins and traps shall be installed as early as possible during mass grading. Sediment basins and traps shall be cleaned out when the sediment capacity has been reduced by 20% of its original design volume.
8. All manufactured BMPs such as erosion control blankets, E-TRMs, biodegradable logs, filter socks, synthetic sediment barriers and hydraulic erosion control shall be installed as directed by the manufacturer.
9. The above requirements are the responsibility of the permittee for the site. Responsibility may be transferred to another party by the permittee, but the permittee shall remain liable by the City of Lee's Summit if any of the above conditions are not met.

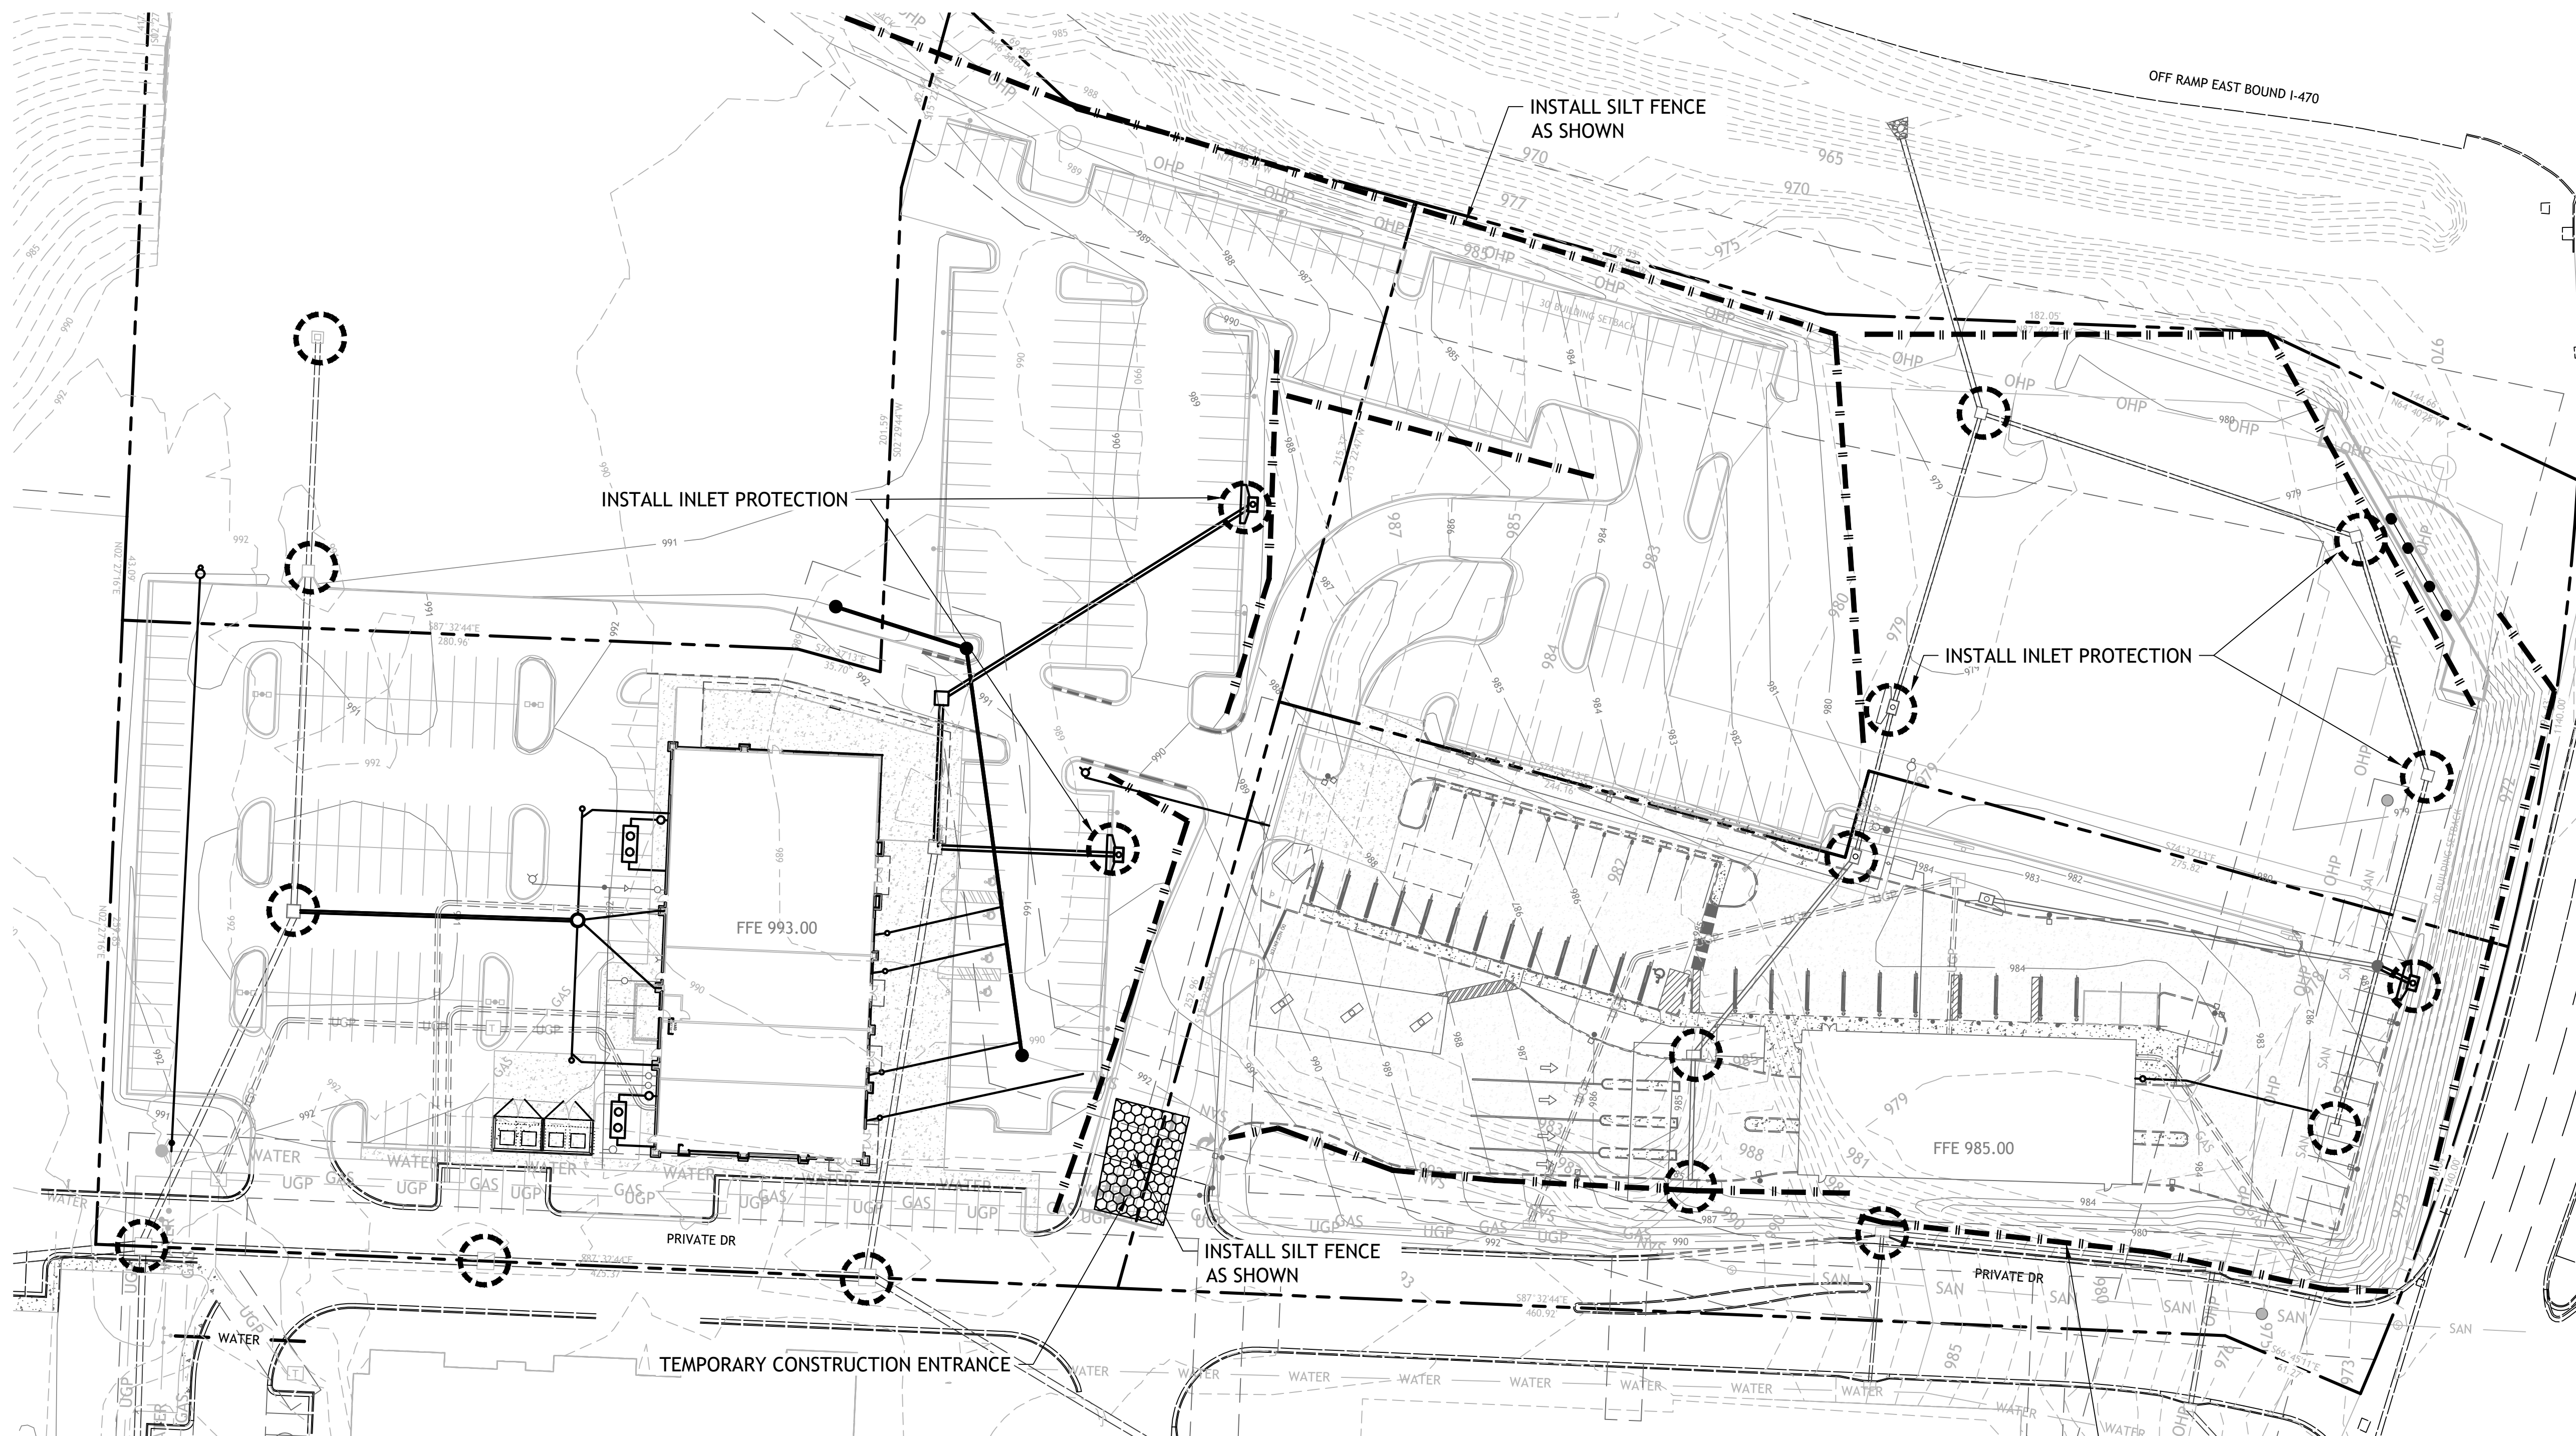

LEGEND

-
- Legend:
- SILT FENCE
 - INLET PROTECTION
 - TEMPORARY CONSTRUCTION ENTRANCE

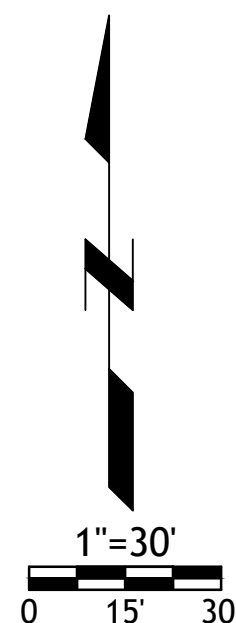


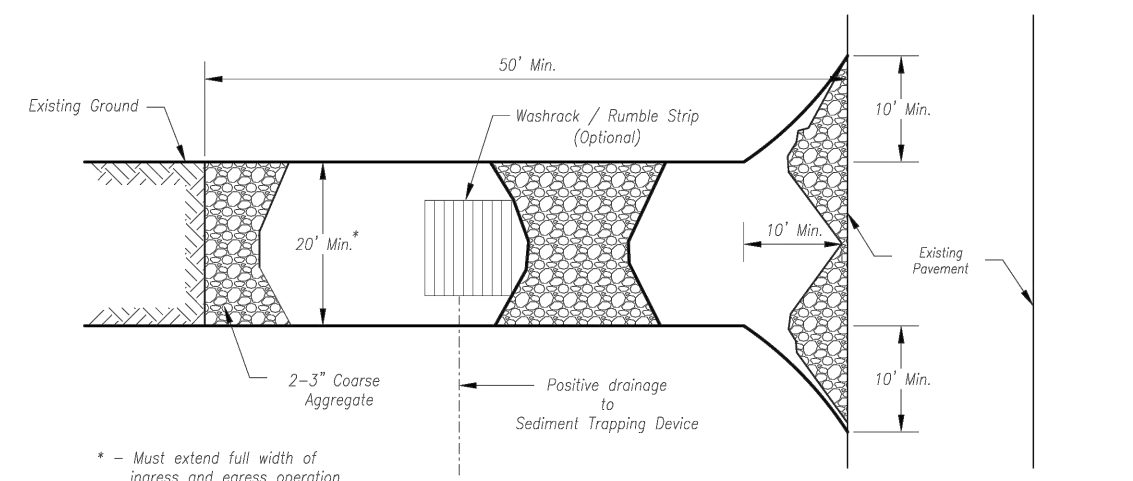


Notes for Concrete Washout:

- Concrete washout areas shall be installed prior to any concrete placement on site.
- Concrete washout areas shall include a flat subsurface pit sized relative to the amount of concrete to be placed on site. The slopes meeting out of the subsurface pit shall be 5:1. The vehicle tracking pad shall be sloped towards the concrete washout area.
- Vehicle tracking control is required at the access point to all concrete washout areas.
- Signs shall be placed at the construction site entrance, washout area and elsewhere as necessary to clearly indicate the location(s) of the concrete washout area(s) to operators of concrete trucks and pump rigs.
- A one-piece impervious liner may be required along the bottom and sides of the subsurface pit in sandy or gravelly soils.

Maintenance for Concrete Washout:

- Concrete washout materials shall be removed once the materials have filled the washout to approximately 75% full.
- Concrete washout areas shall be enlarged as necessary to maintain capacity for wasted concrete.
- Concrete washout water, washed pieces of concrete and all other debris in the subsurface pit shall be transported from the job site in a water-tight container and disposed of properly.
- Concrete washout areas shall remain in place until all concrete for the project is placed.
- When concrete washout areas are removed, excavations shall be filled with suitable compacted backfill and topped, any disturbed areas associated with the installation, maintenance, and/or removal of the concrete washout areas shall be stabilized.

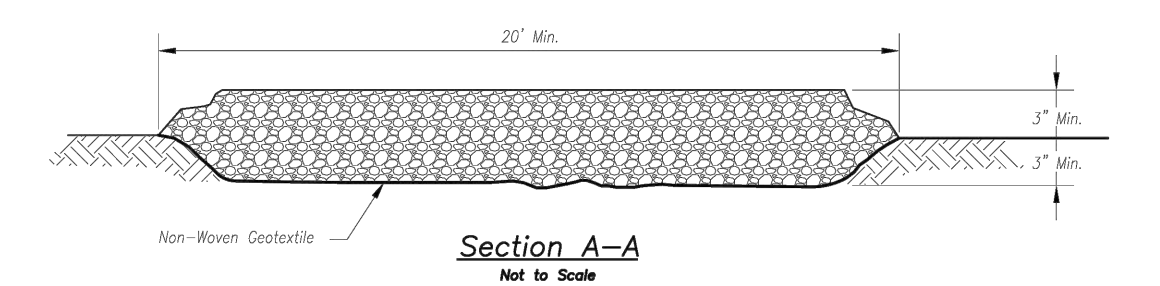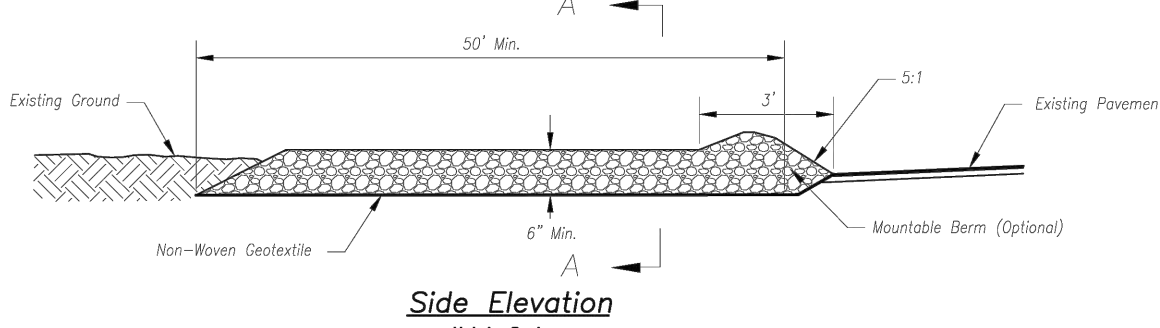

Notes for Construction Entrance:


- Avoid locating on steep slopes, at curves on public roads, or downwind of inhabited areas.
- Remove all vegetation and other unsuitable material from the foundation area, grade, and crown for positive drainage.
- If slope towards the public road exceeds 2%, construct a 6- to 8-inch high ridge with 3:1V side slopes across the foundation approximately 15 feet from the edge of the public road to divert runoff from it.
- Install pipe under the entrance if needed to maintain drainage ditches along public roads.
- Place stone to dimensions and grade as shown on plans. Leave surface sloped for drainage.
- Divert all surface runoff and drainage from the entrance to a sediment control device.
- If conditions warrant, place geotextile fabric on the graded foundation to improve stability.


Maintenance for Construction Entrance:

- Reshape entrance as needed to maintain function and integrity of installation. Top dress with clean aggregate as needed.

CONSTRUCTION ENTRANCE


Construction Entrance modified from 2015 Overland Park Standard Details for Erosion and Sediment Control; Concrete Washout modified from 2009 City of Great Bend Standard Drawings.

AMERICAN PUBLIC WORKS ASSOCIATION	
	KANSAS CITY METRO CHAPTER
CONSTRUCTION ENTRANCE AND CONCRETE WASHOUT	STANDARD DRAWING NUMBER ESC-01 ADOPTED: 10/24/2016

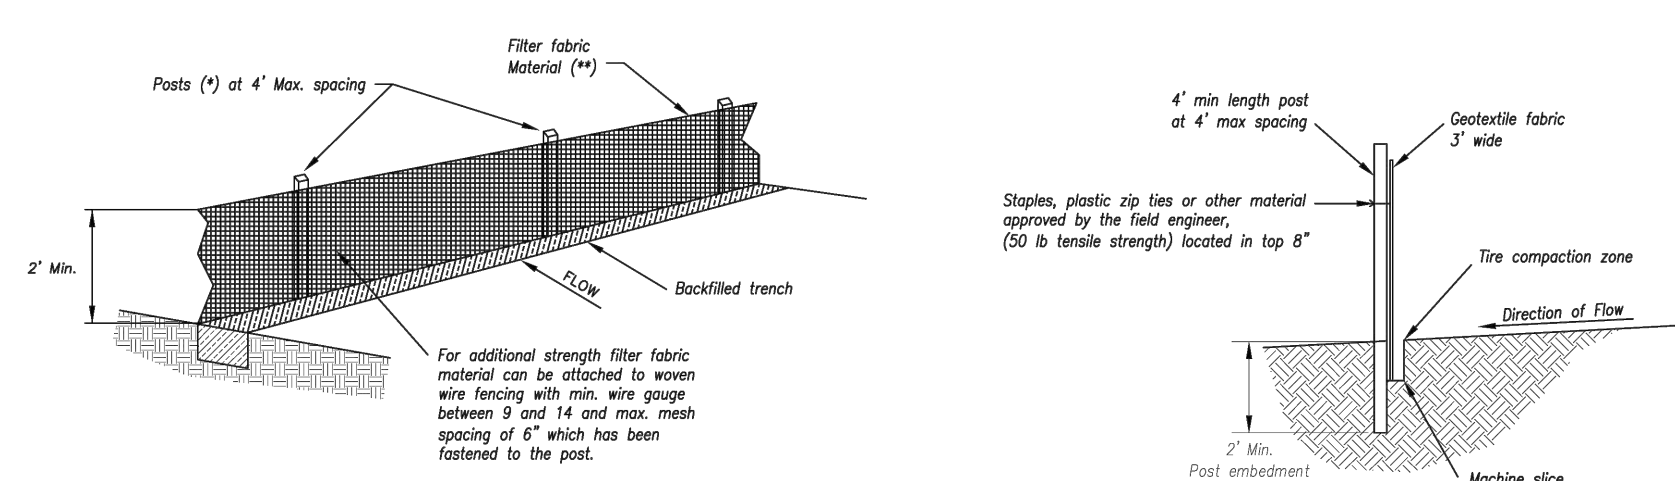

- (*) POSTS
- MIN. LENGTH 4'
 - HARDWOOD 1 3/4" x 1 3/4"
 - NO.2 SOUTHERN PINE 2 3/4" x 2 3/4"
 - STEEL 1.33 LB/YT

(**) - Geotextile Fabric shall meet the requirements of AASHTO M288

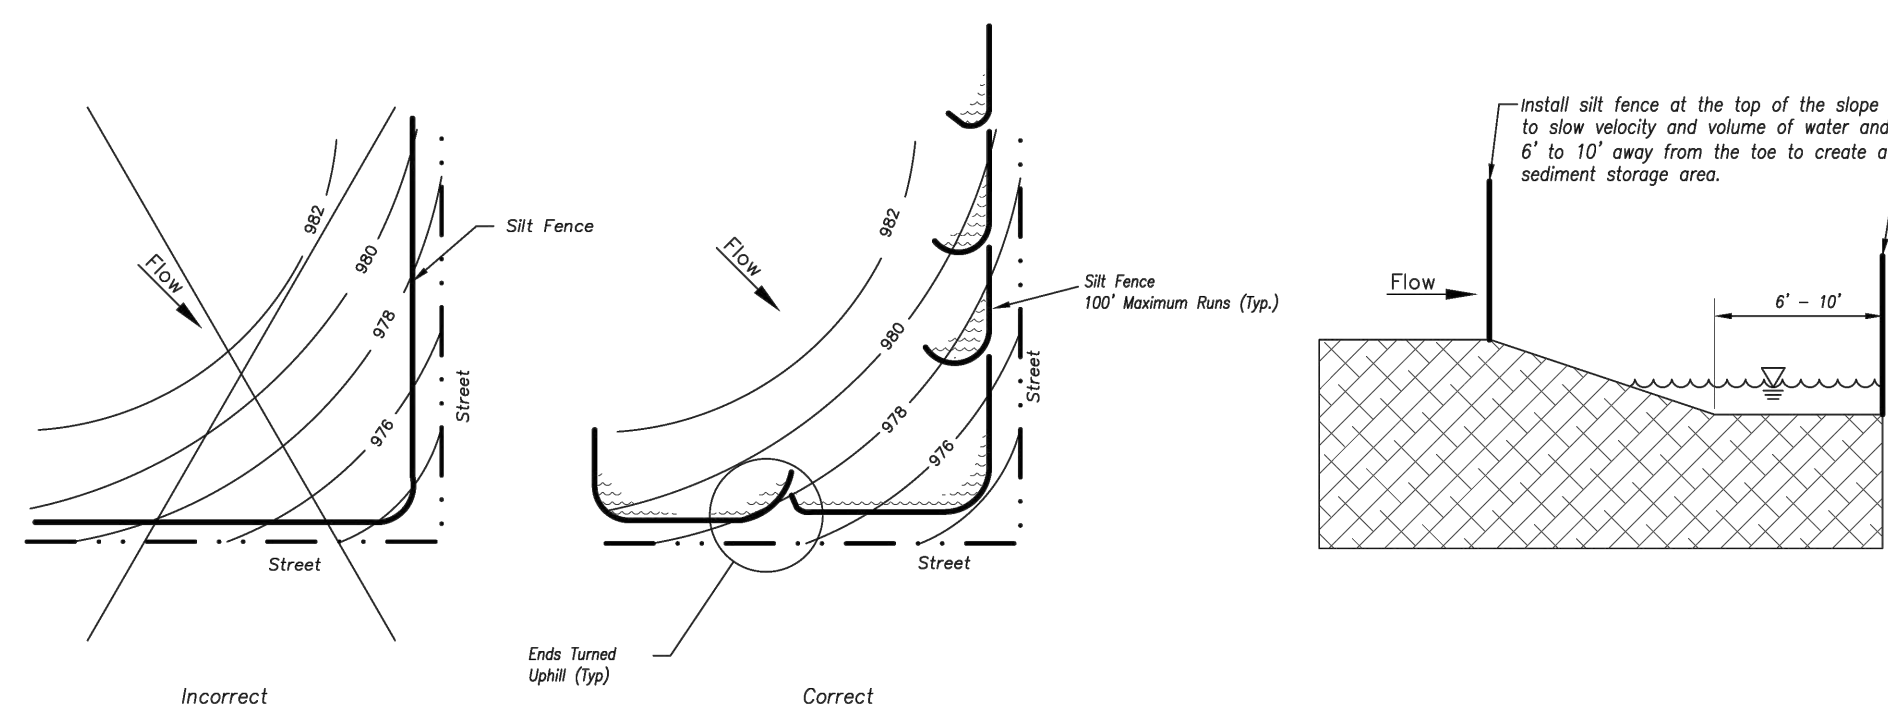



Notes:

- In order to contain water, the ends of the silt fence must be turned uphill (Figure A).
- Long perimeter runs of silt fence must be limited to 100'. Runs should be broken up into several smaller segments to minimize water concentrations (Figure A).
- Long slopes should be broken up with intermediate rows of silt fence to slow runoff velocities.
- Attach fabric to upstream side of post.
- Install posts a minimum of 2' into the ground.
- Trenching will only be allowed for small or difficult installations, where staking machine cannot be reasonably used.


Maintenance:

- Remove and dispose of sediment deposits when the deposit approaches 1/2 the height of silt fence.
- Repair as necessary to maintain function and structure.

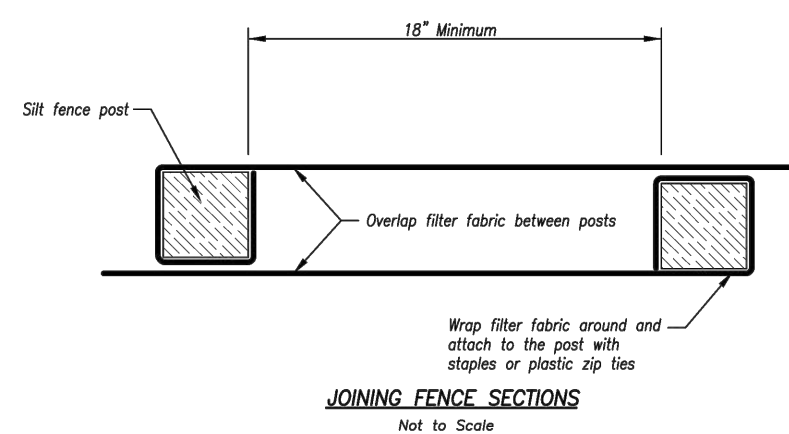


AMERICAN PUBLIC WORKS ASSOCIATION	
	KANSAS CITY METRO CHAPTER
SILT FENCE	STANDARD DRAWING NUMBER ESC-03 ADOPTED: 10/24/2016

Modified from 2015 Overland Park Standard Details for Erosion and Sediment Control.



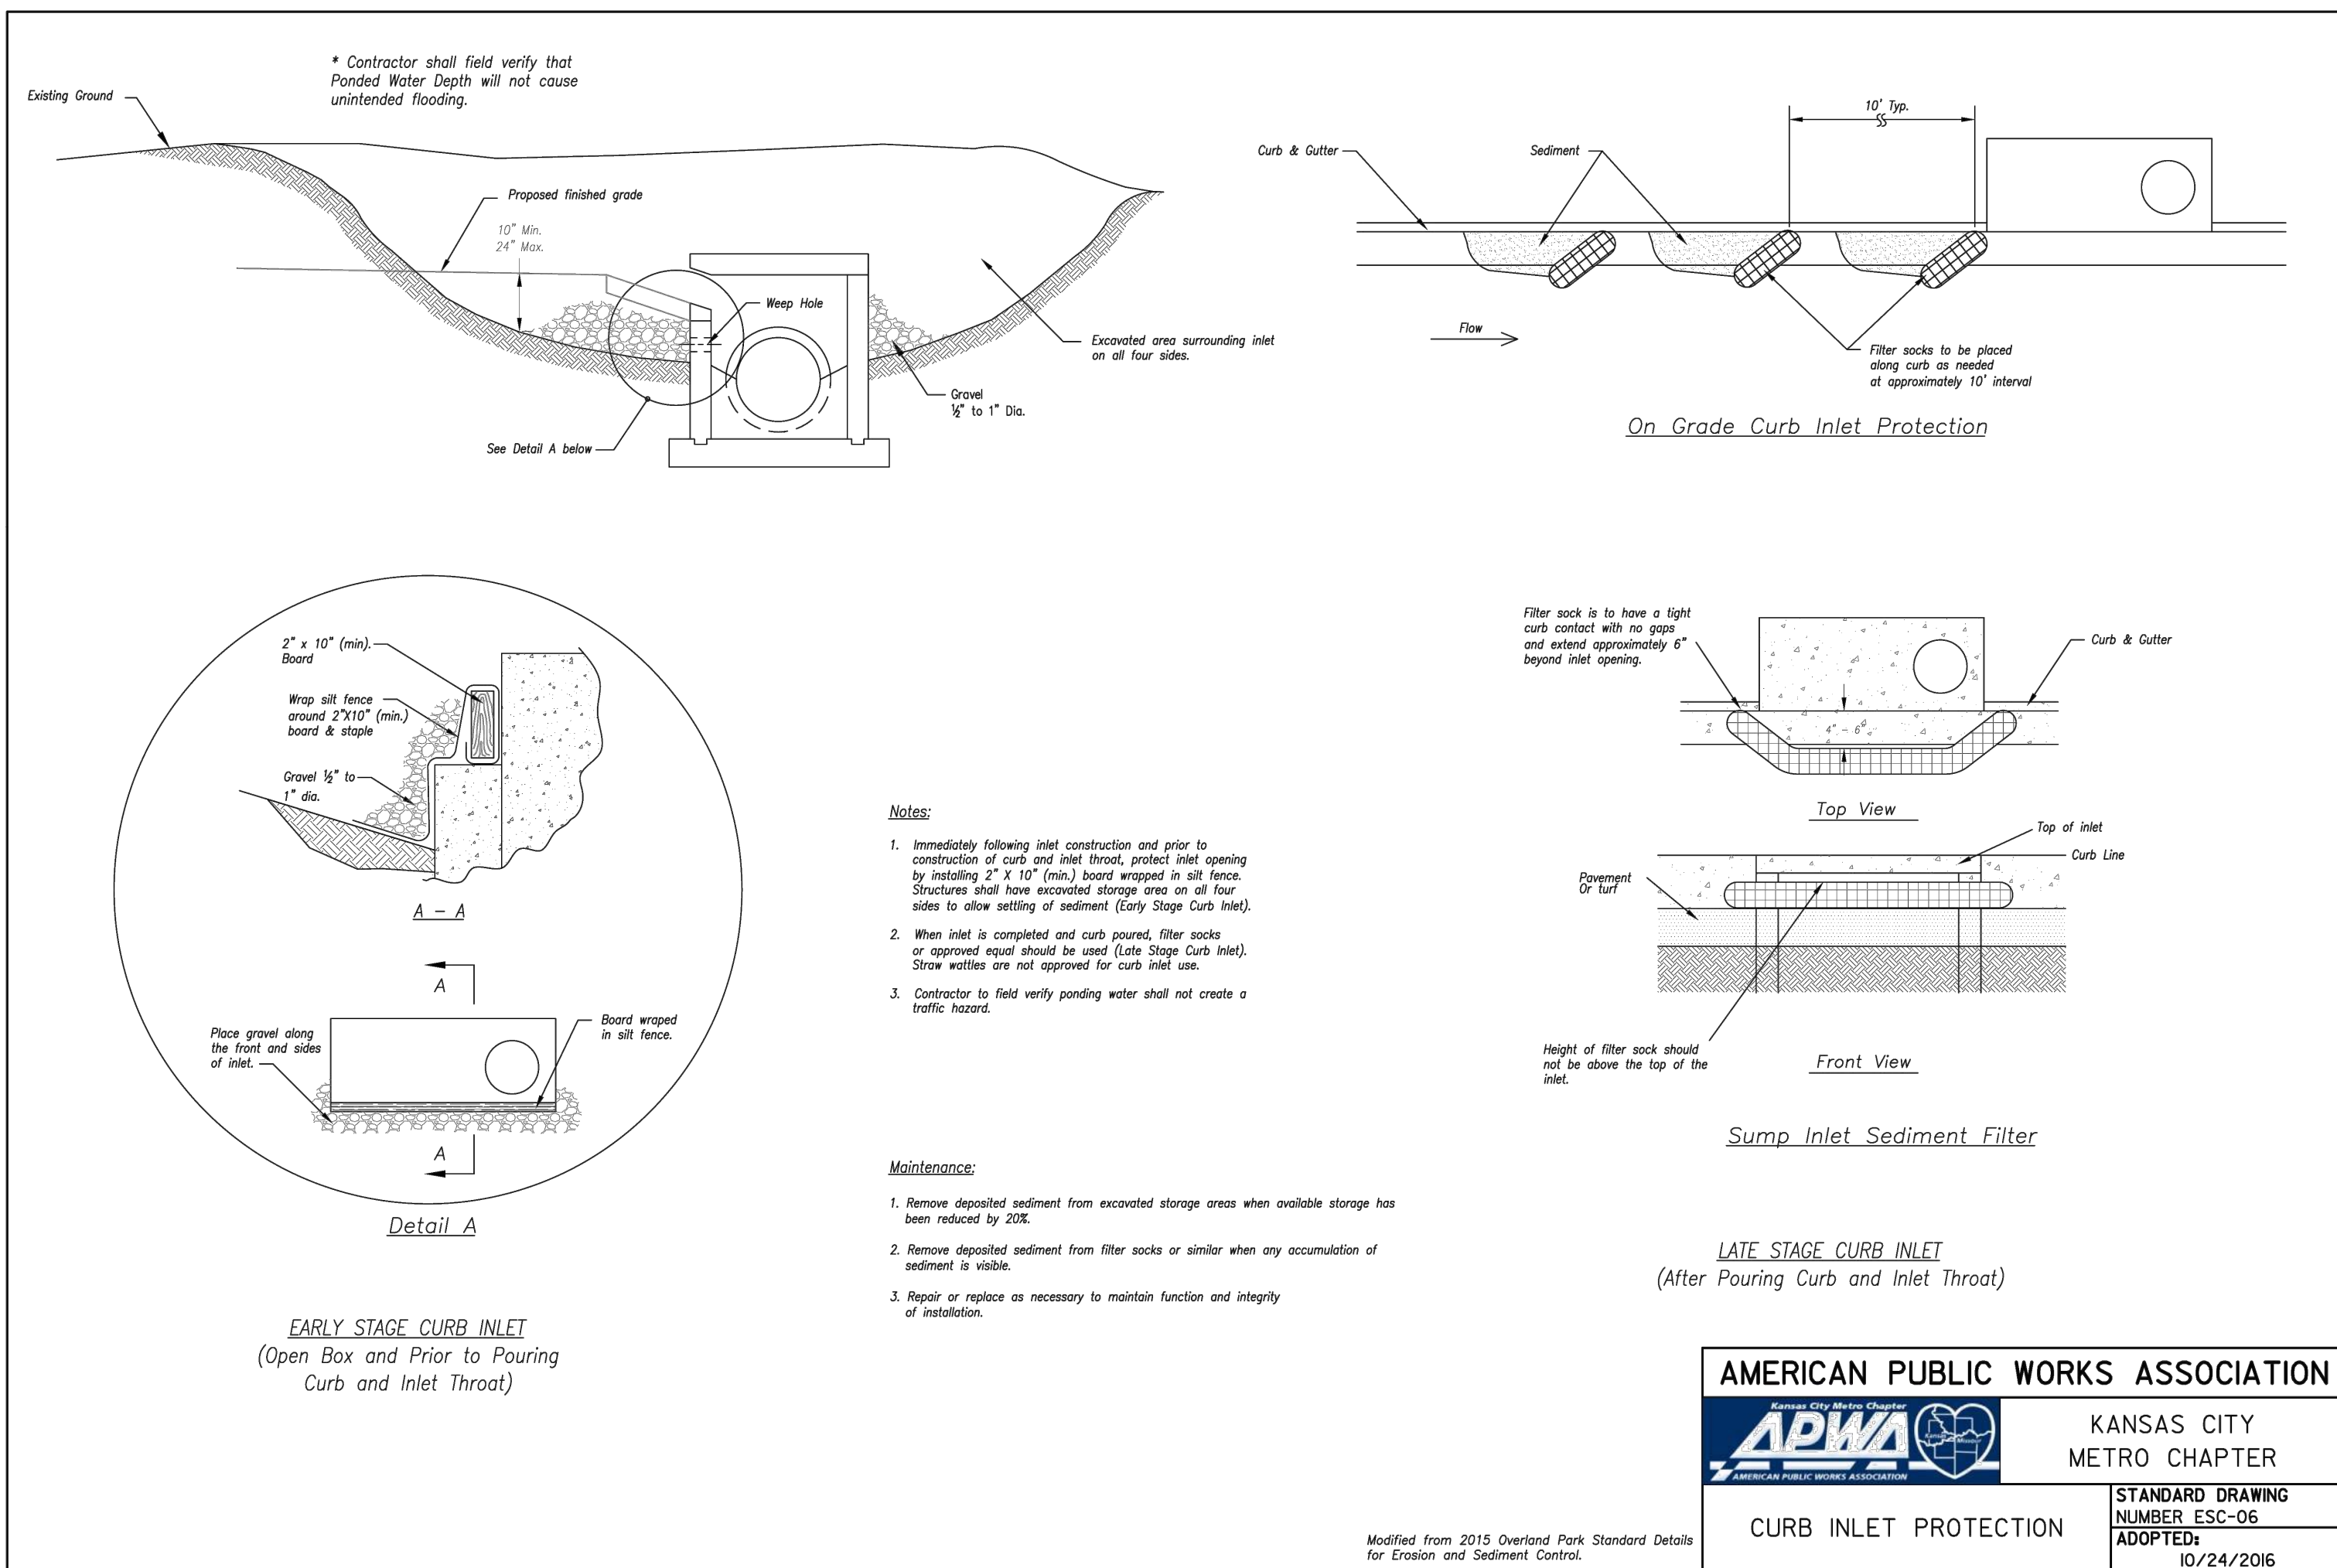




100 Year Storm Calculations

Line No.	Line ID	Area	Drain Area	Runoff Coeff	Inlet Time	Incr Q	Known Q	Flow Rate	Line Length	Line Size	Vel Ave	Capac. Full	Invert Dn	Invert Up	Line Slope	Grnd/Rim Elev Up	HGL Dn	HGL Up	HGL Junct
		(ac)	(C)	(min)	(cfs)	(cfs)	(cfs)	(cfs)	(ft)	(in)	(ft/s)	(cfs)	(ft)	(ft)	(%)	(ft)	(ft)	(ft)	(ft)
1	B2-F1	F1	0.800	0.75	5.0	7.74	0.00	32.45	150.00	30	6.61	31.77	980.20	981.10	0.60	990.50	982.70	983.59	983.72
2	F1-K2	K2	0.750	0.75	5.0	7.25	0.00	21.51	140.00	30	4.38	31.00	981.30	982.10	0.57	990.50	984.30	984.69	984.75
3	K2-K3	K3	1.600	0.70	5.0	14.44	0.00	14.44	98.00	24	4.69	20.44	982.60	983.40	0.82	990.00	984.89	985.24	985.31
4	F1-F2	F2	0.320	0.90	5.0	3.71	0.00	3.71	118.00	12	5.57	4.02	987.00	988.50	1.27	991.80	987.77	989.32	989.32
5	B4-C1		0.000	0.00	0.0	0.00	0.00	10.06	178.00	30	3.56	41.24	982.20	984.00	1.01	992.50	984.70	985.06	985.06
6	C1-E1		0.000	0.00	0.0	0.00	0.00	6.49	62.00	18	4.66	7.28	984.20	984.50	0.48	991.50	985.30	985.60	985.73
7	E1-E2	E2	0.640	0.80	5.0	6.60	0.00	6.60	152.00	18	5.45	8.91	985.00	986.09	0.72	989.00	985.96	987.08	987.08
8	C1-C2	C2	0.360	0.80	5.0	3.71	0.00	3.71	76.00	18	5.38	15.24	984.50	986.10	2.11	989.80	985.04	986.84	986.84

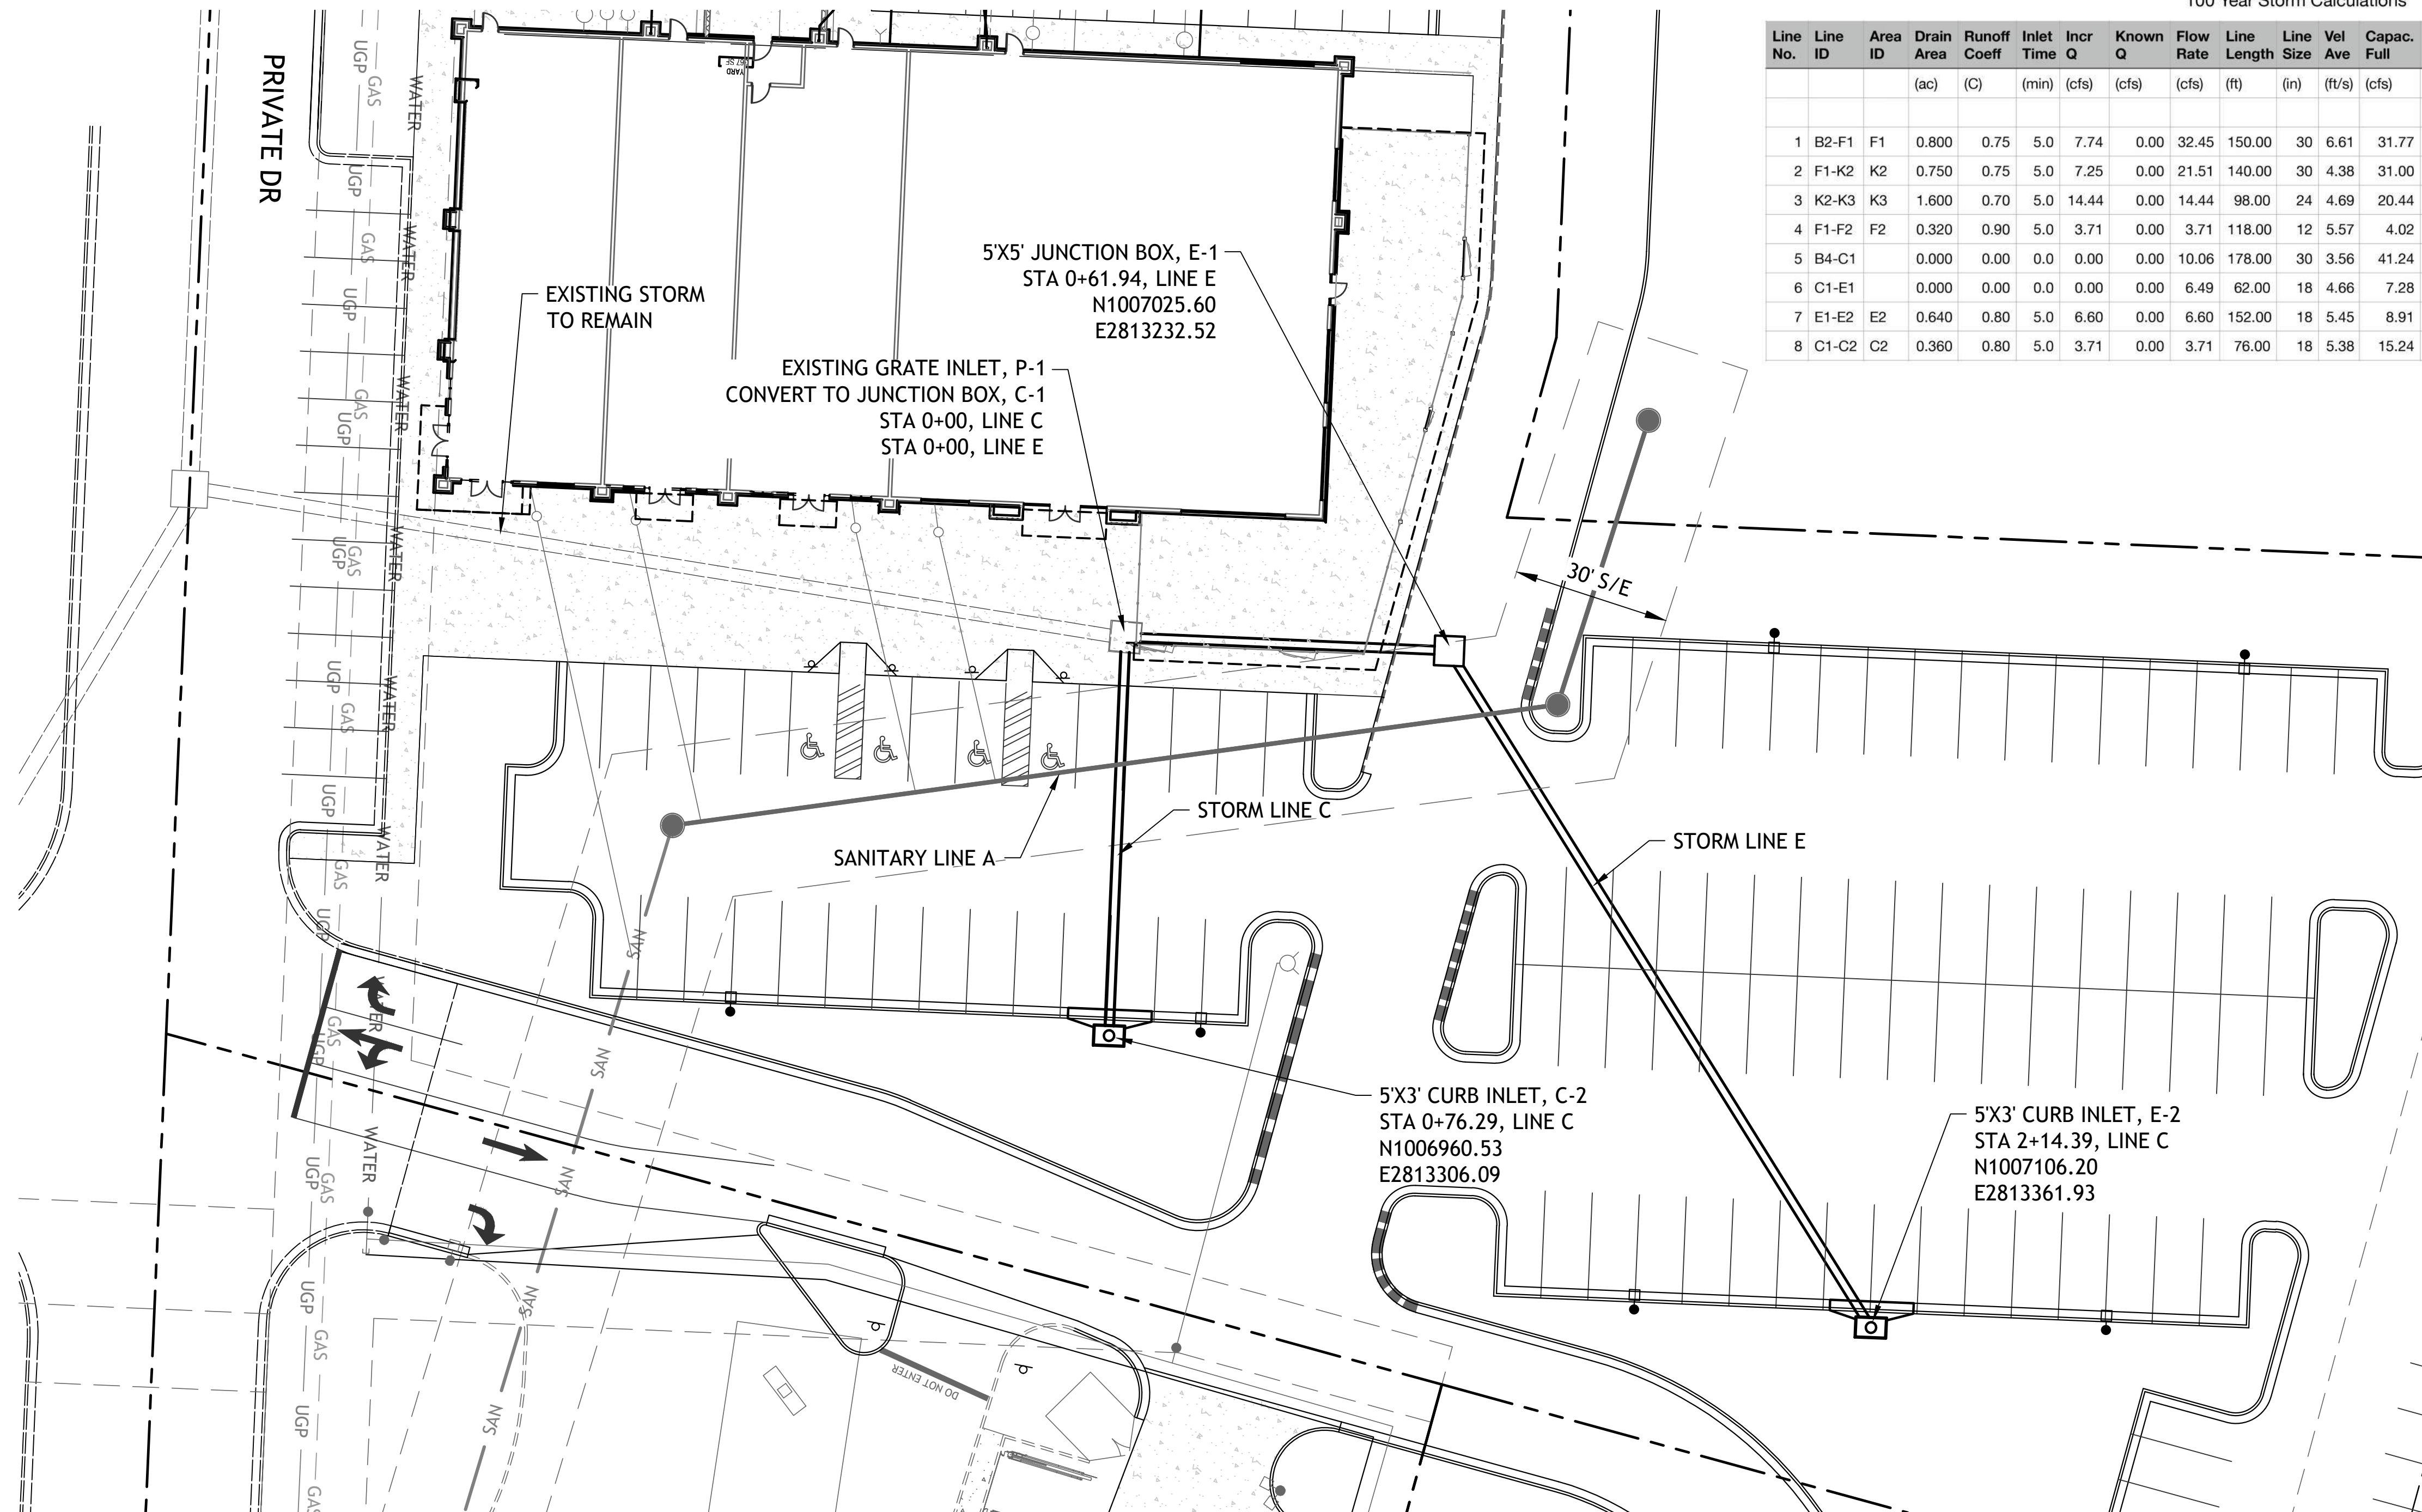


NOTE
COMPACTED FILL SHALL BE PLACED TO A MINIMUM OF 18"
ABOVE THE TOP OF THE PIPE PRIOR TO INSTALLATION.

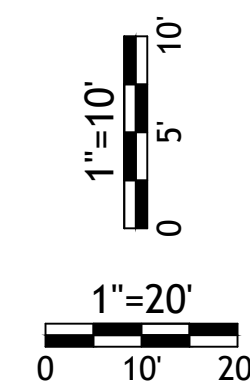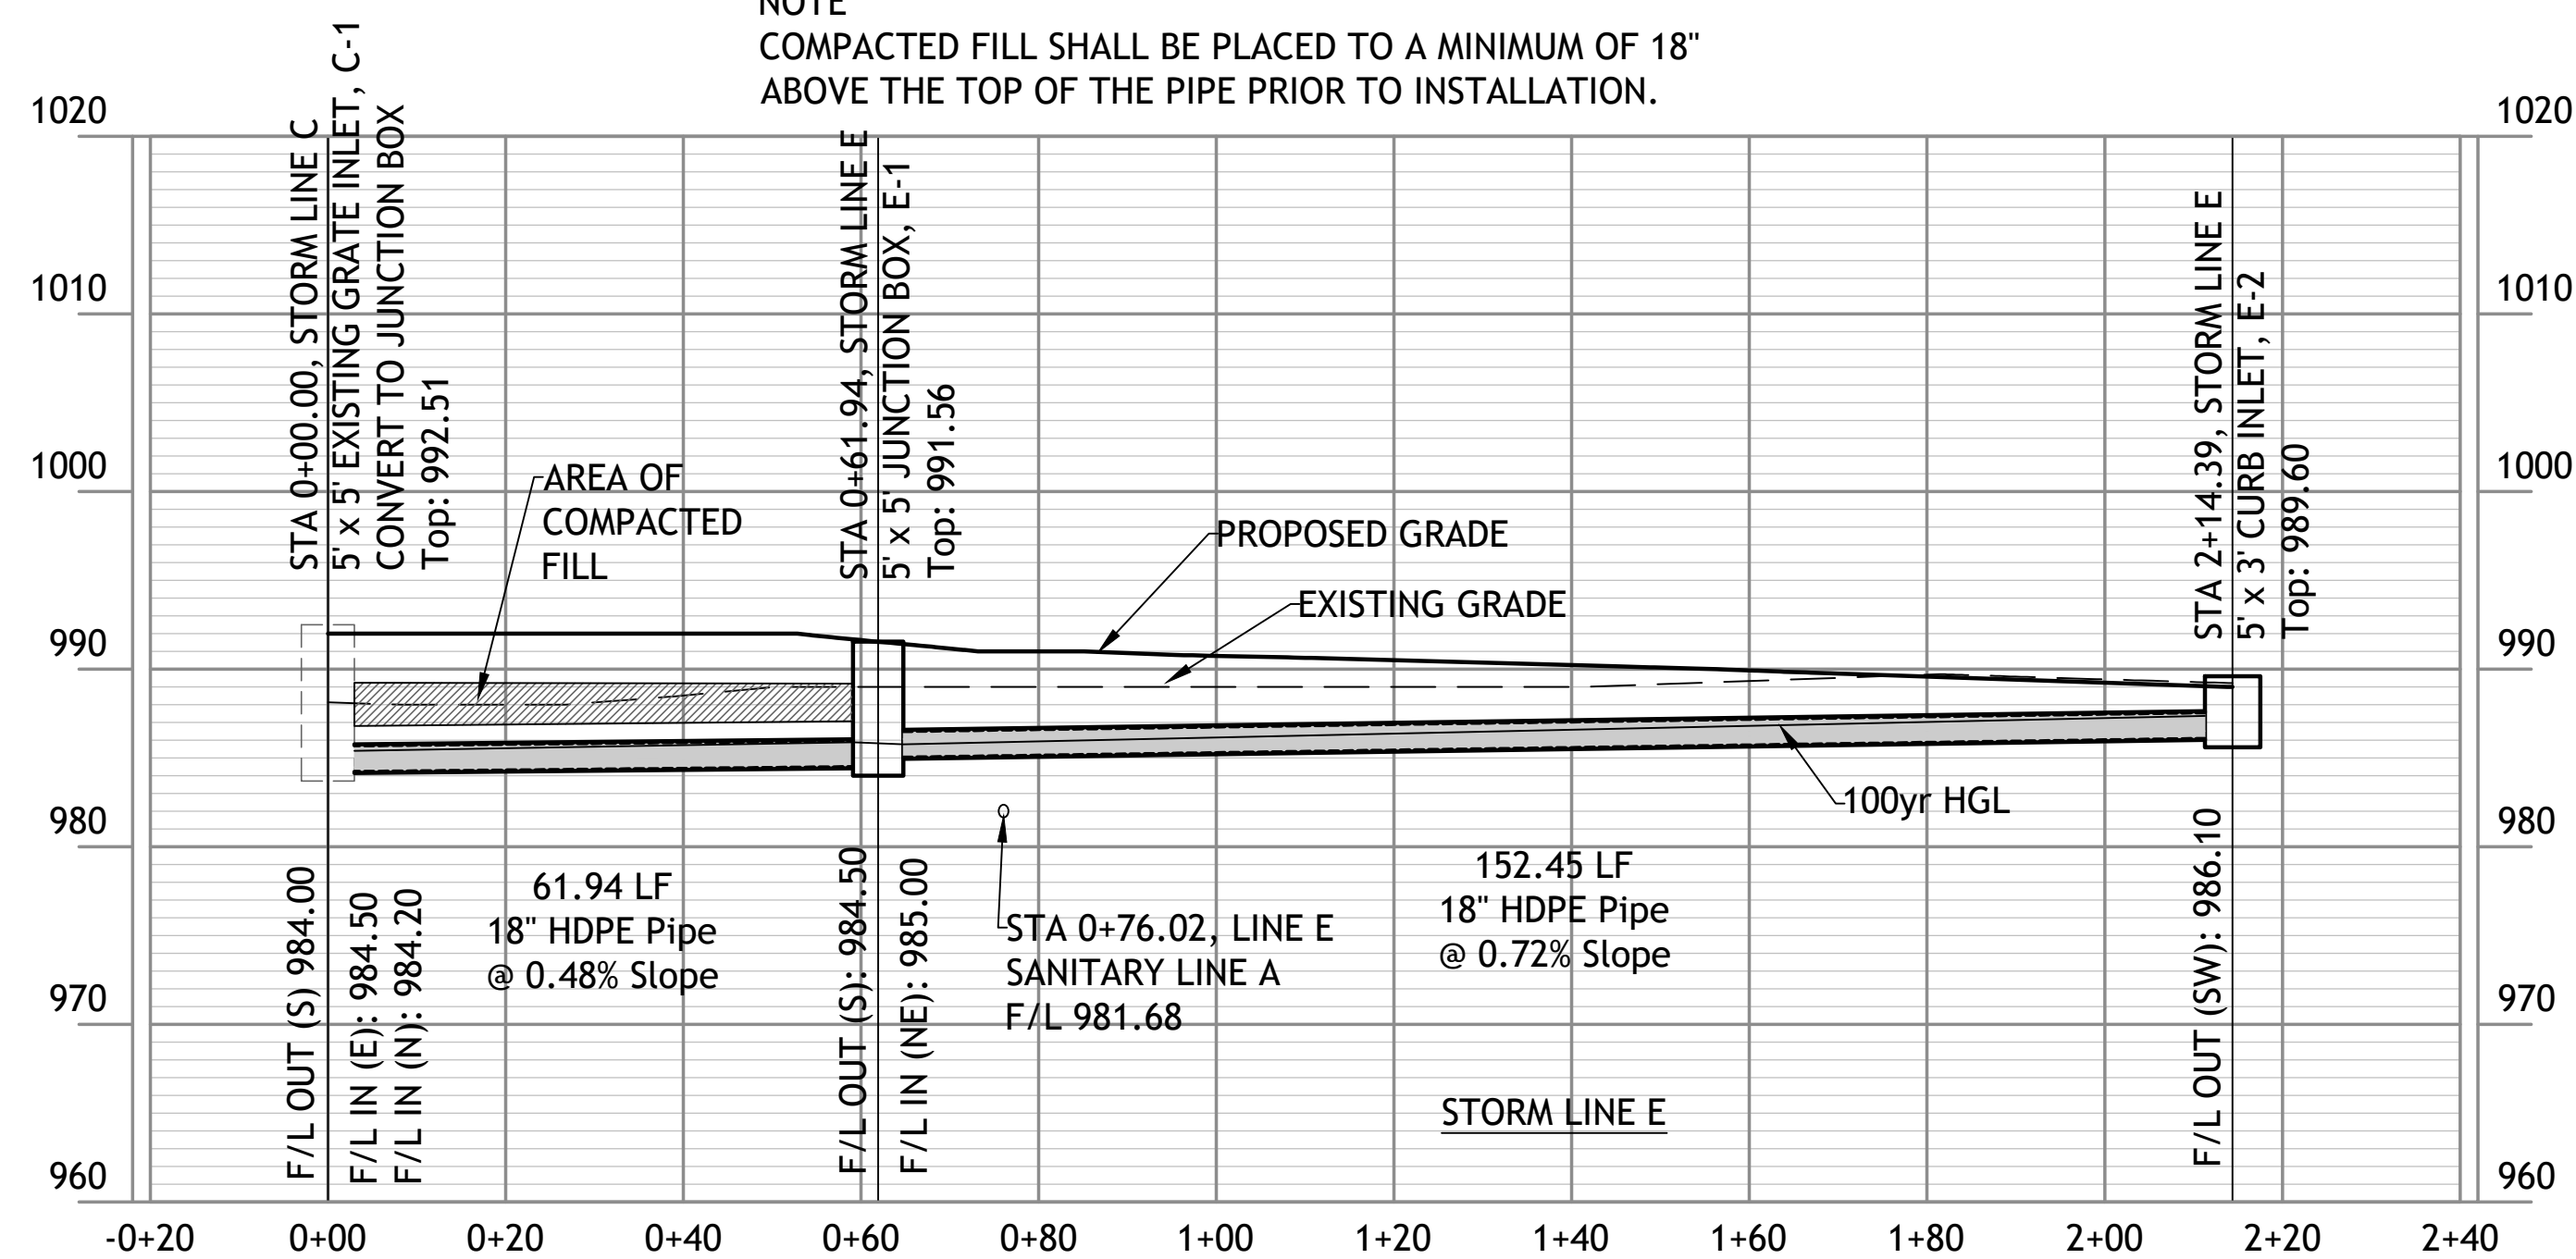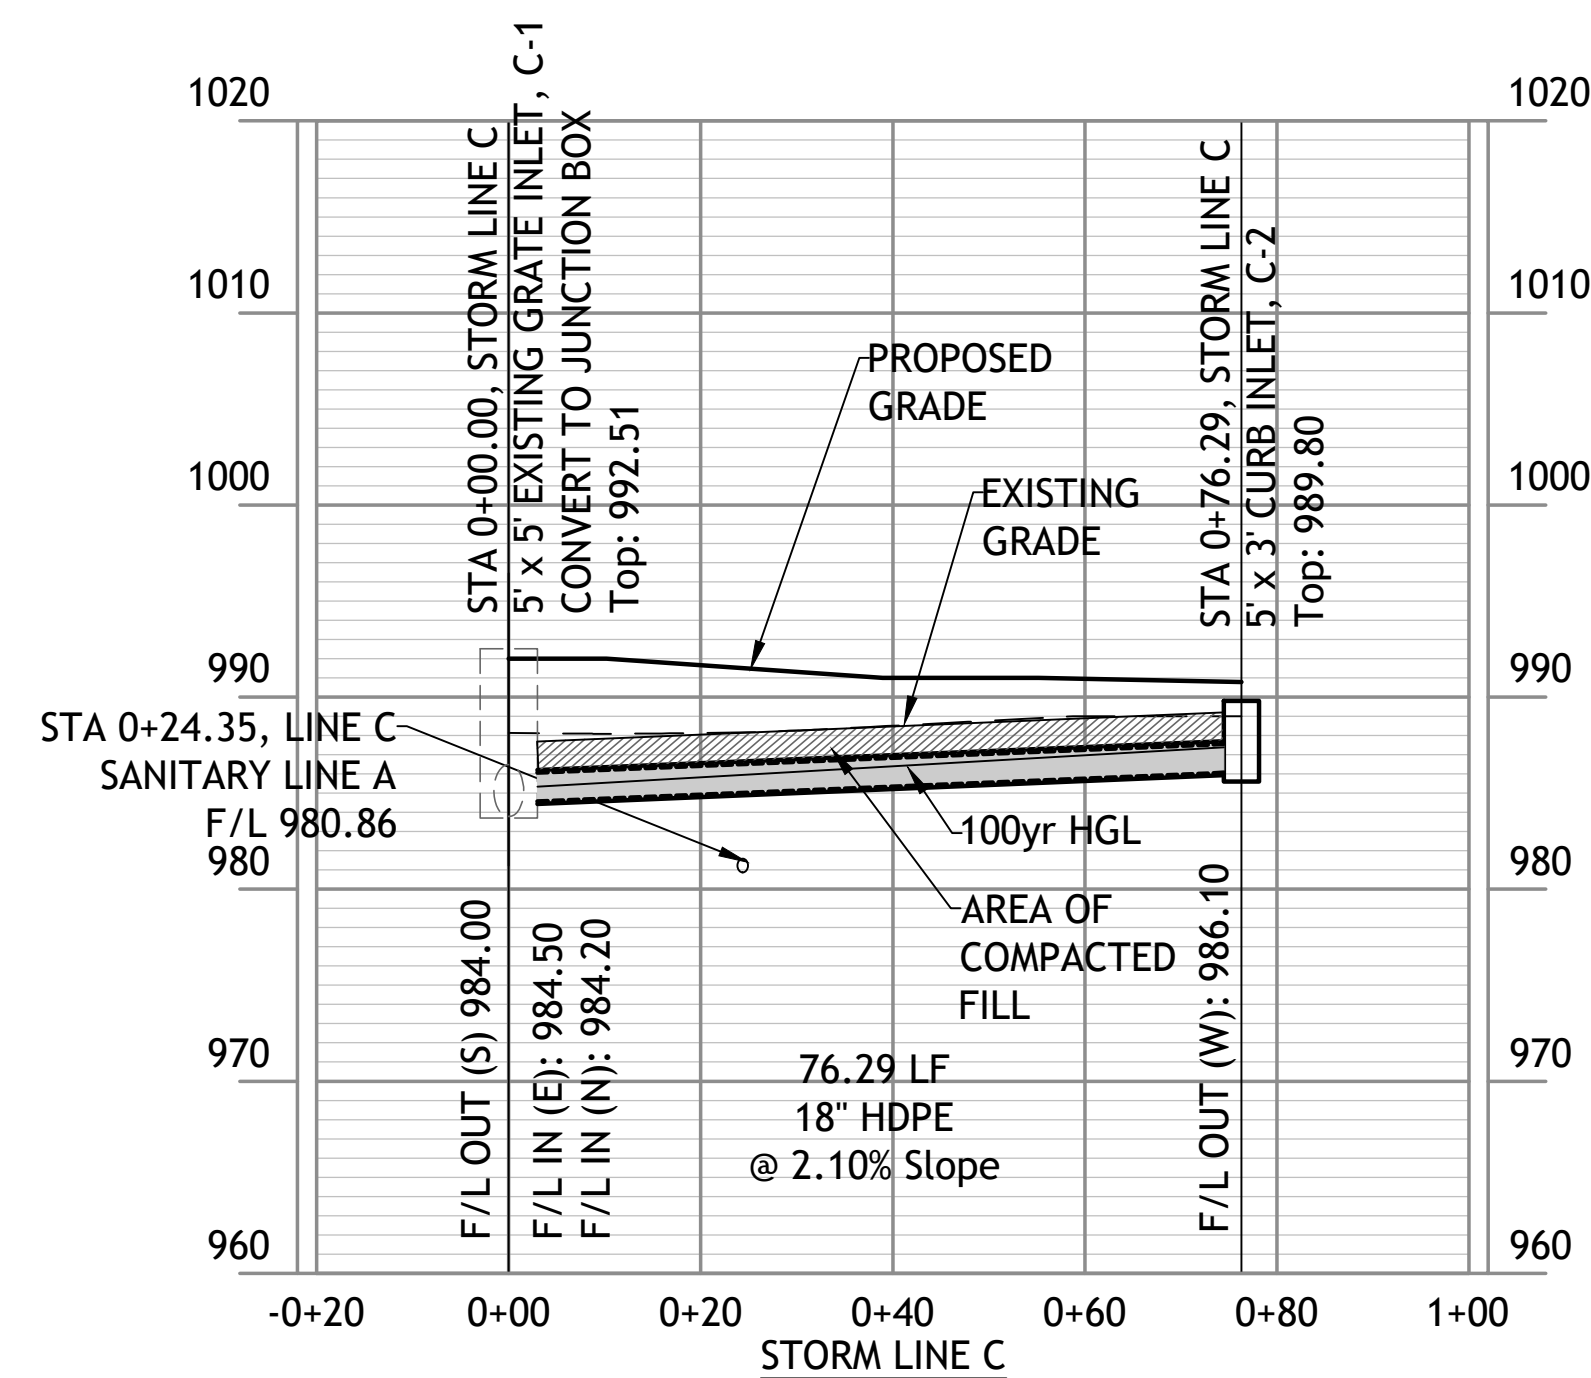

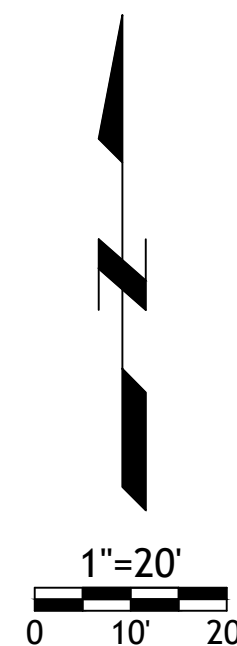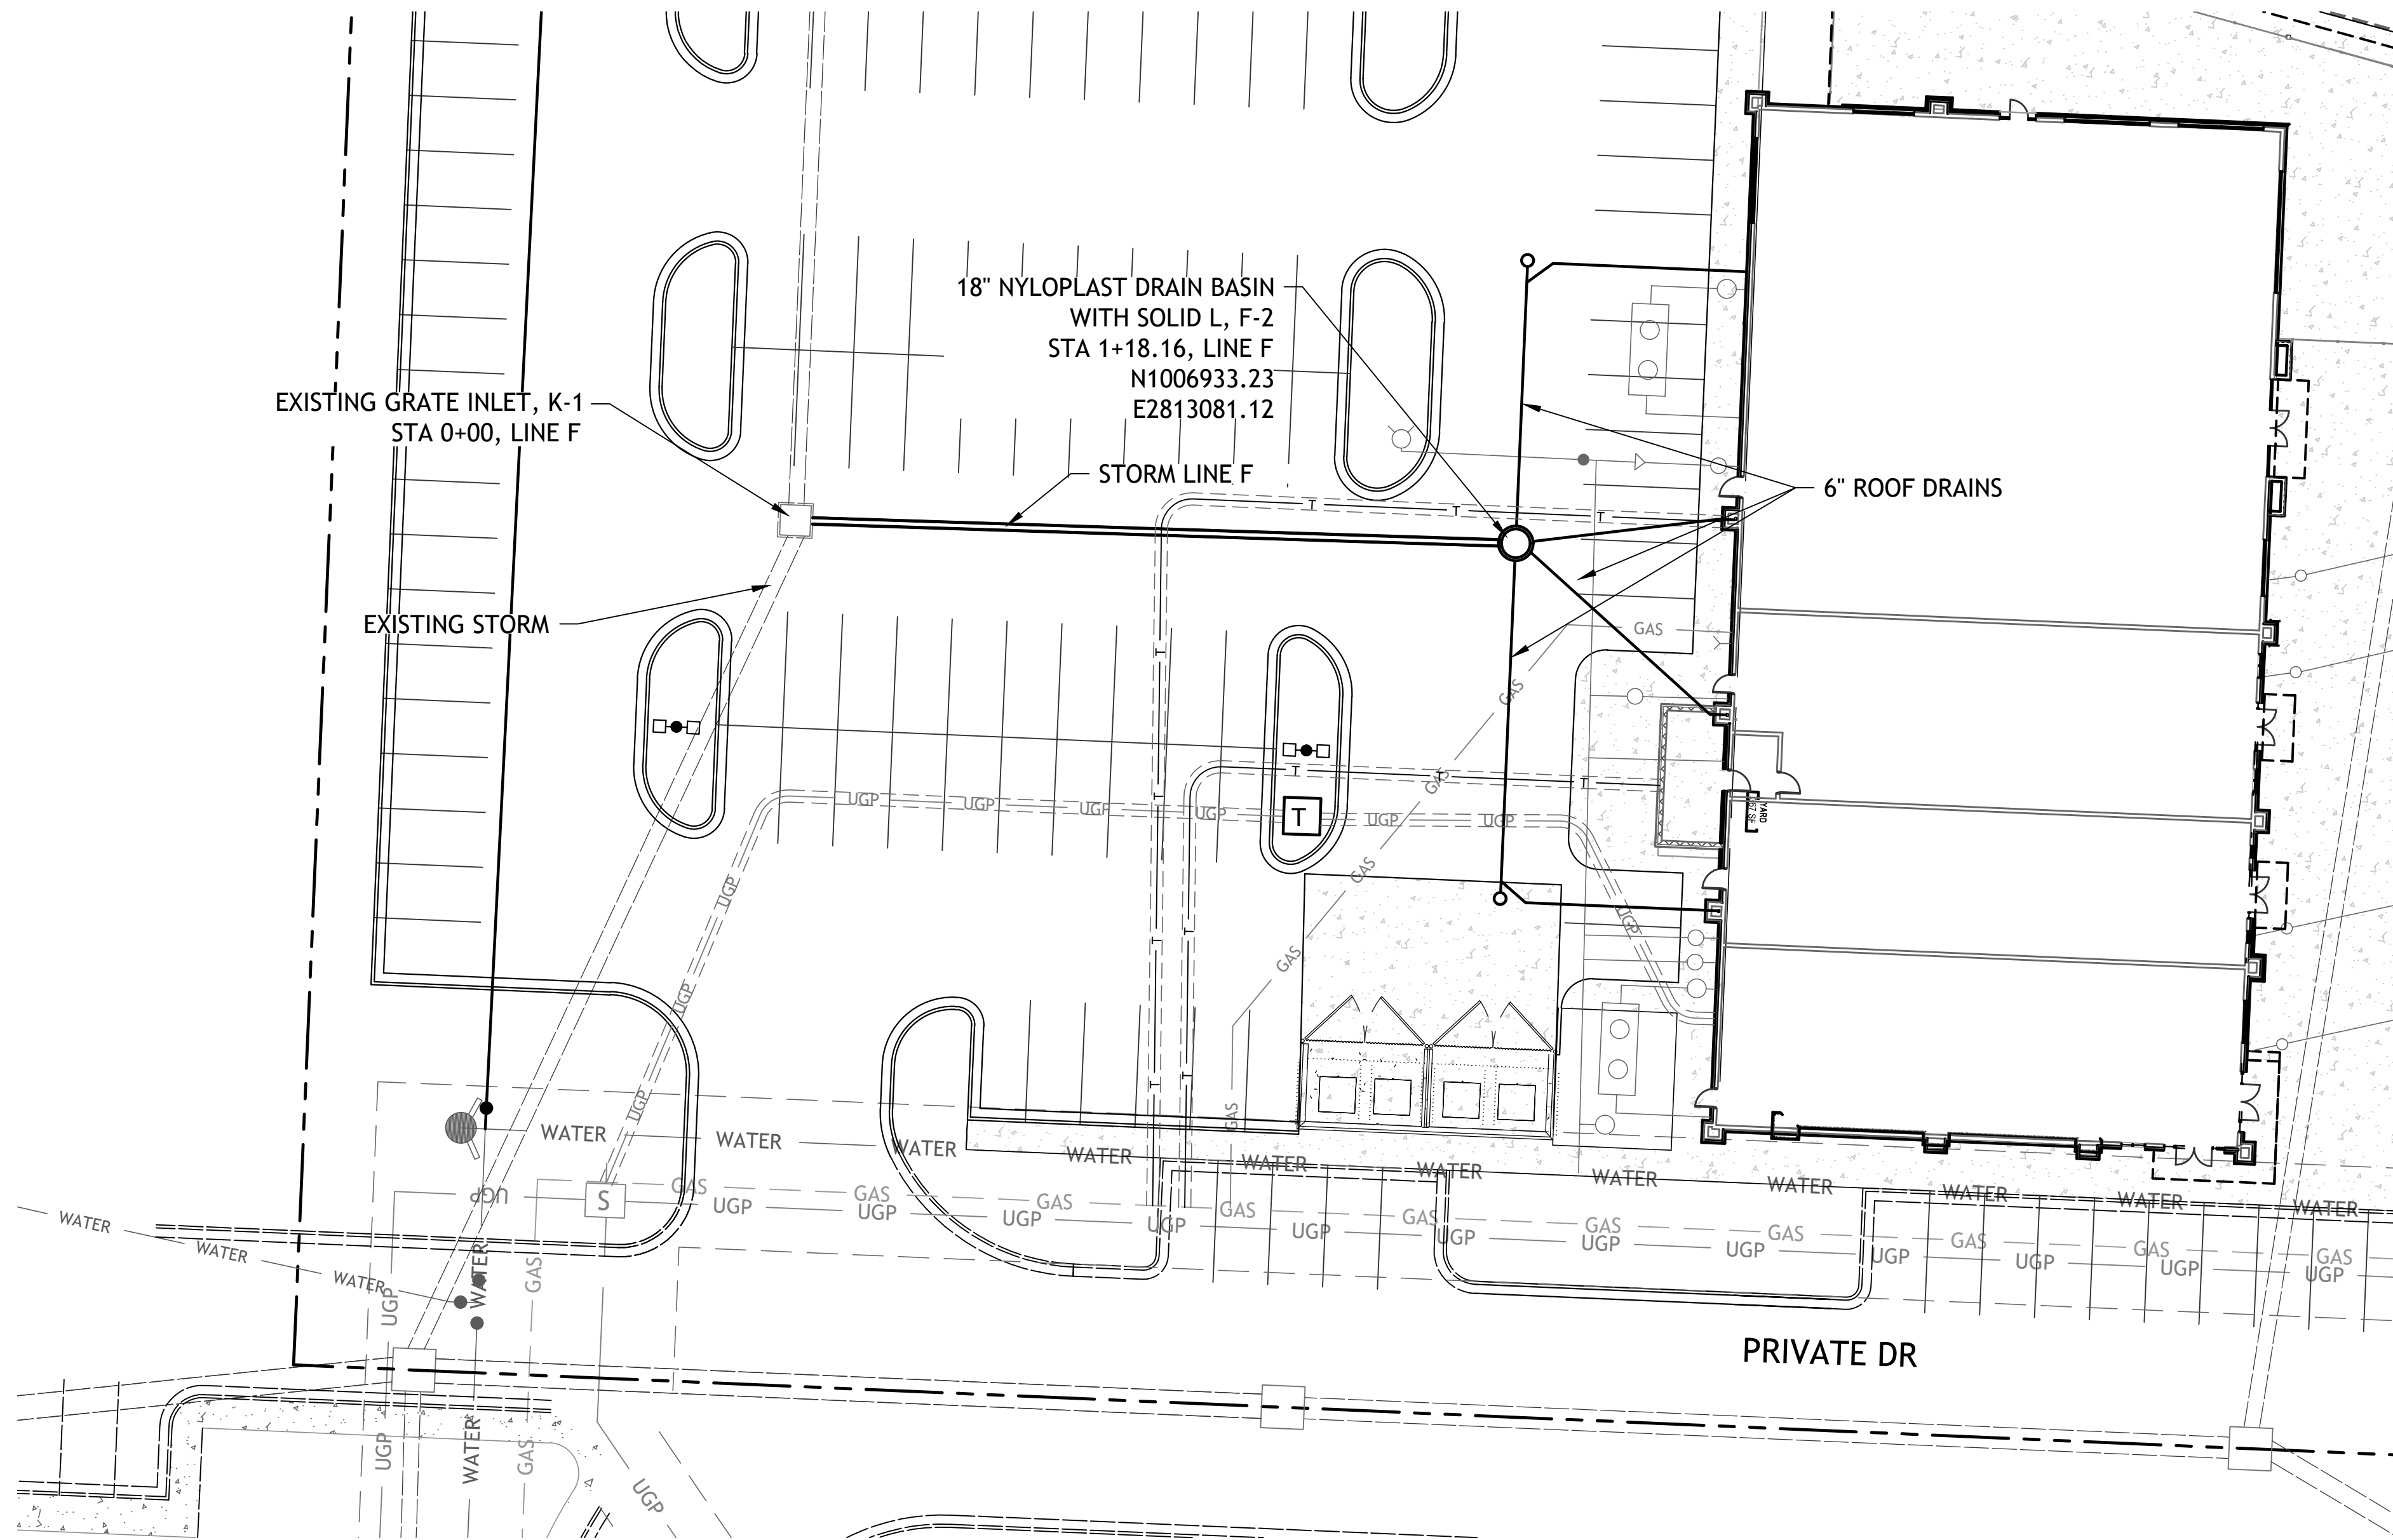


NOTE
COMPACTED FILL SHALL BE PLACED TO A MINIMUM OF 18"
ABOVE THE TOP OF THE PIPE PRIOR TO INSTALLATION.

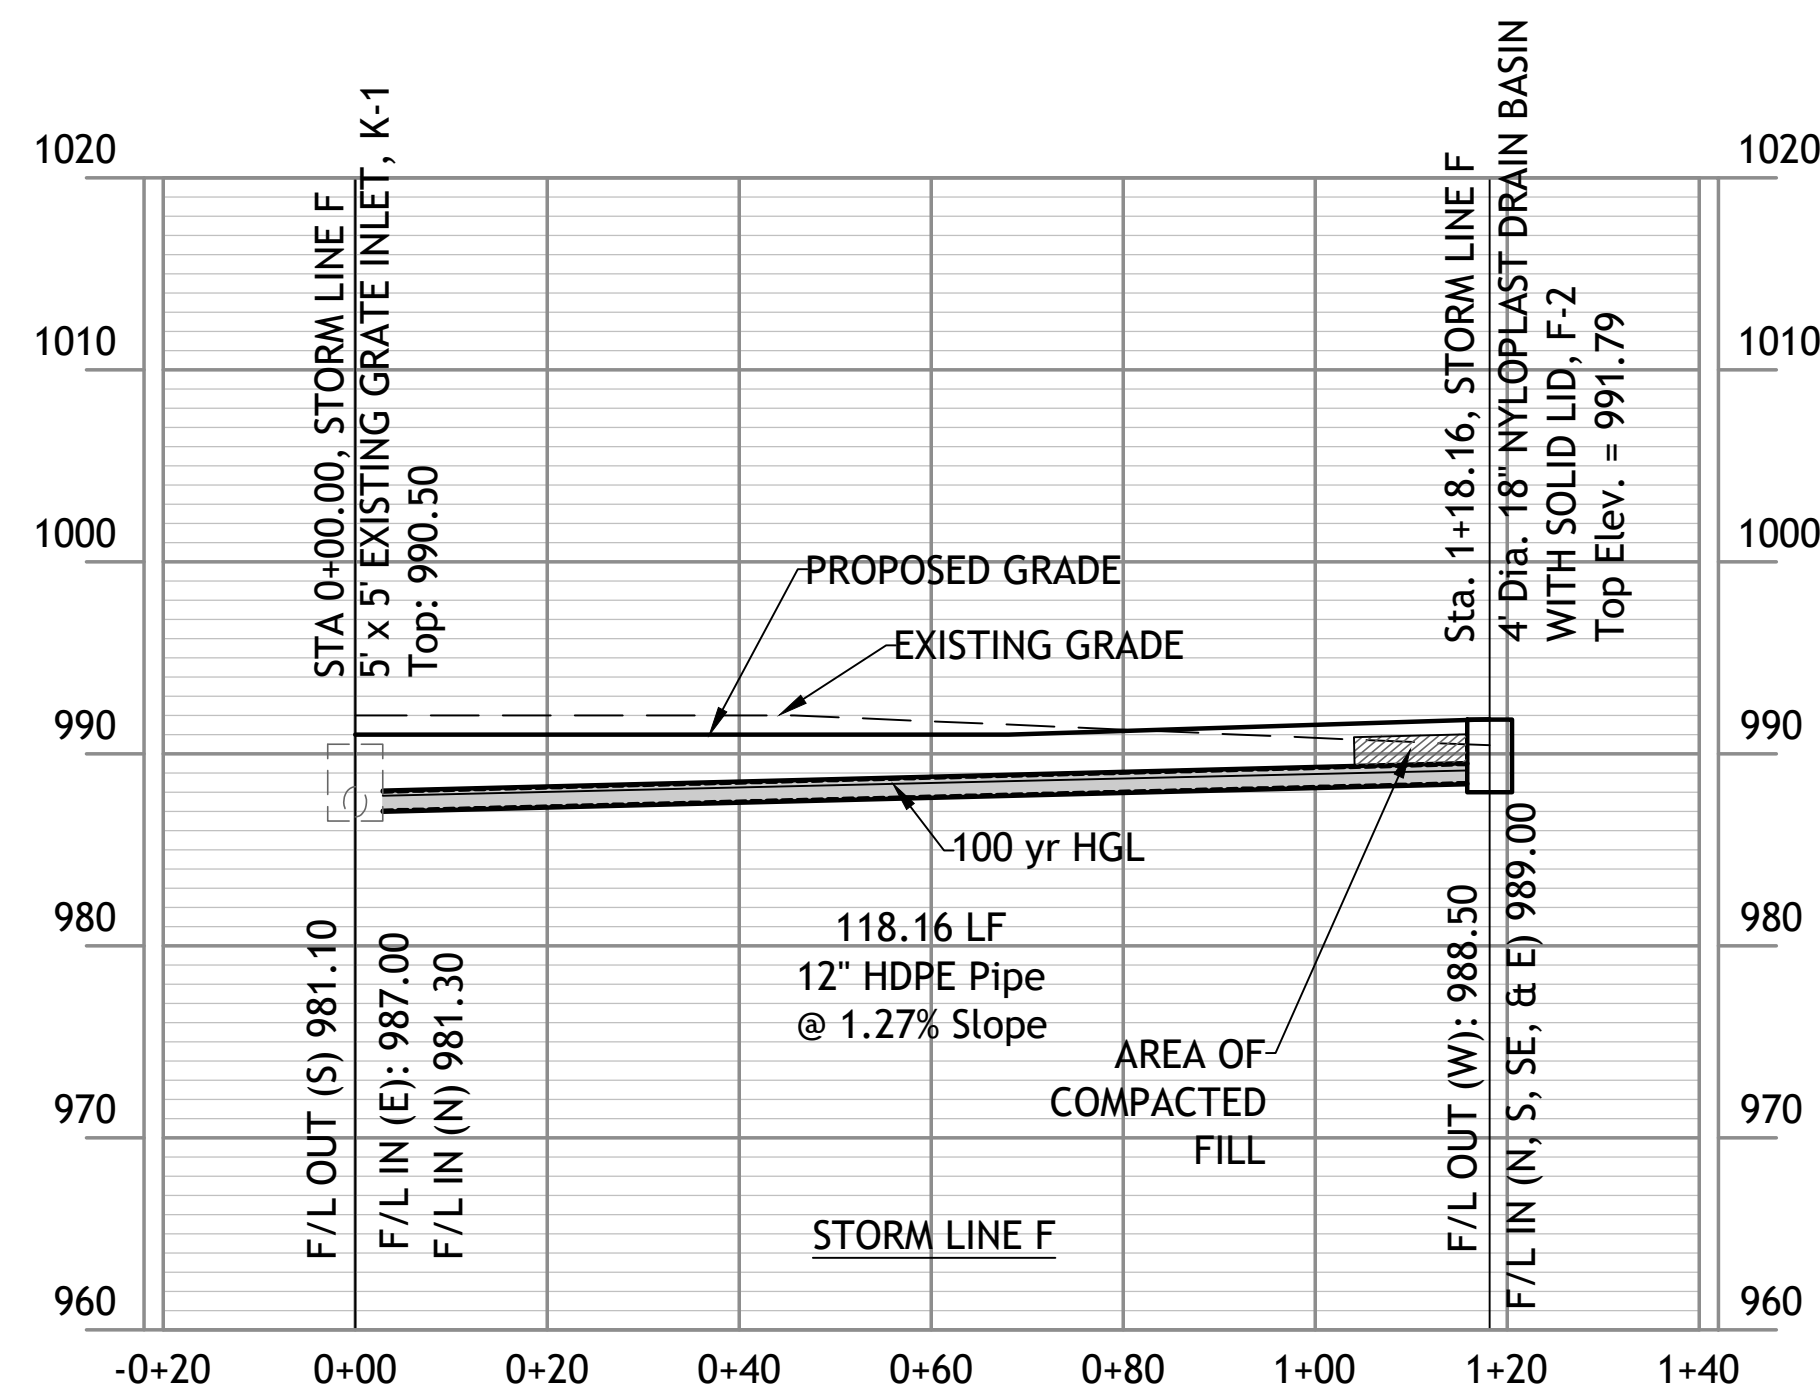






100 Year Storm Calculations



Line No.	Line ID	Area ID	Drain Area	Runoff Coeff	Inlet Time	Incr Q	Known Q	Flow Rate	Line Length	Line Size	Vel Ave	Capac. Full	Invert Dn	Invert Up	Line Slope	Grnd/Rim Elev Up	HGL Dn	HGL Up	HGL Junct
			(ac)	(C)	(min)	(cfs)	(cfs)	(cfs)	(ft)	(in)	(ft/s)	(cfs)	(ft)	(ft)	(%)	(ft)	(ft)	(ft)	(ft)
1	B2-F1	F1	0.800	0.75	5.0	7.74	0.00	32.45	150.00	30	6.61	31.77	980.20	981.10	0.60	990.50	982.70	983.59	983.72
2	F1-K2	K2	0.750	0.75	5.0	7.25	0.00	21.51	140.00	30	4.38	31.00	981.30	982.10	0.57	990.50	984.30	984.69	984.75
3	K2-K3	K3	1.600	0.70	5.0	14.44	0.00	14.44	98.00	24	4.69	20.44	982.60	983.40	0.82	990.00	984.89	985.24	985.31
4	F1-F2	F2	0.320	0.90	5.0	3.71	0.00	3.71	118.00	12	5.57	4.02	987.00	988.50	1.27	991.80	987.77	989.32	989.32
5	B4-C1		0.000	0.00	0.0	0.00	0.00	10.06	178.00	30	3.56	41.24	982.20	984.00	1.01	992.50	984.70	985.06	985.06
6	C1-E1		0.000	0.00	0.0	0.00	0.00	6.49	62.00	18	4.66	7.28	984.20	984.50	0.48	991.50	985.30	985.60	985.73
7	E1-E2	E2	0.640	0.80	5.0	6.60	0.00	6.60	152.00	18	5.45	8.91	985.00	986.09	0.72	989.00	985.96	987.08	987.08
8	C1-C2	C2	0.360	0.80	5.0	3.71	0.00	3.71	76.00	18	5.38	15.24	984.50	986.10	2.11	989.80	985.04	986.84	986.84

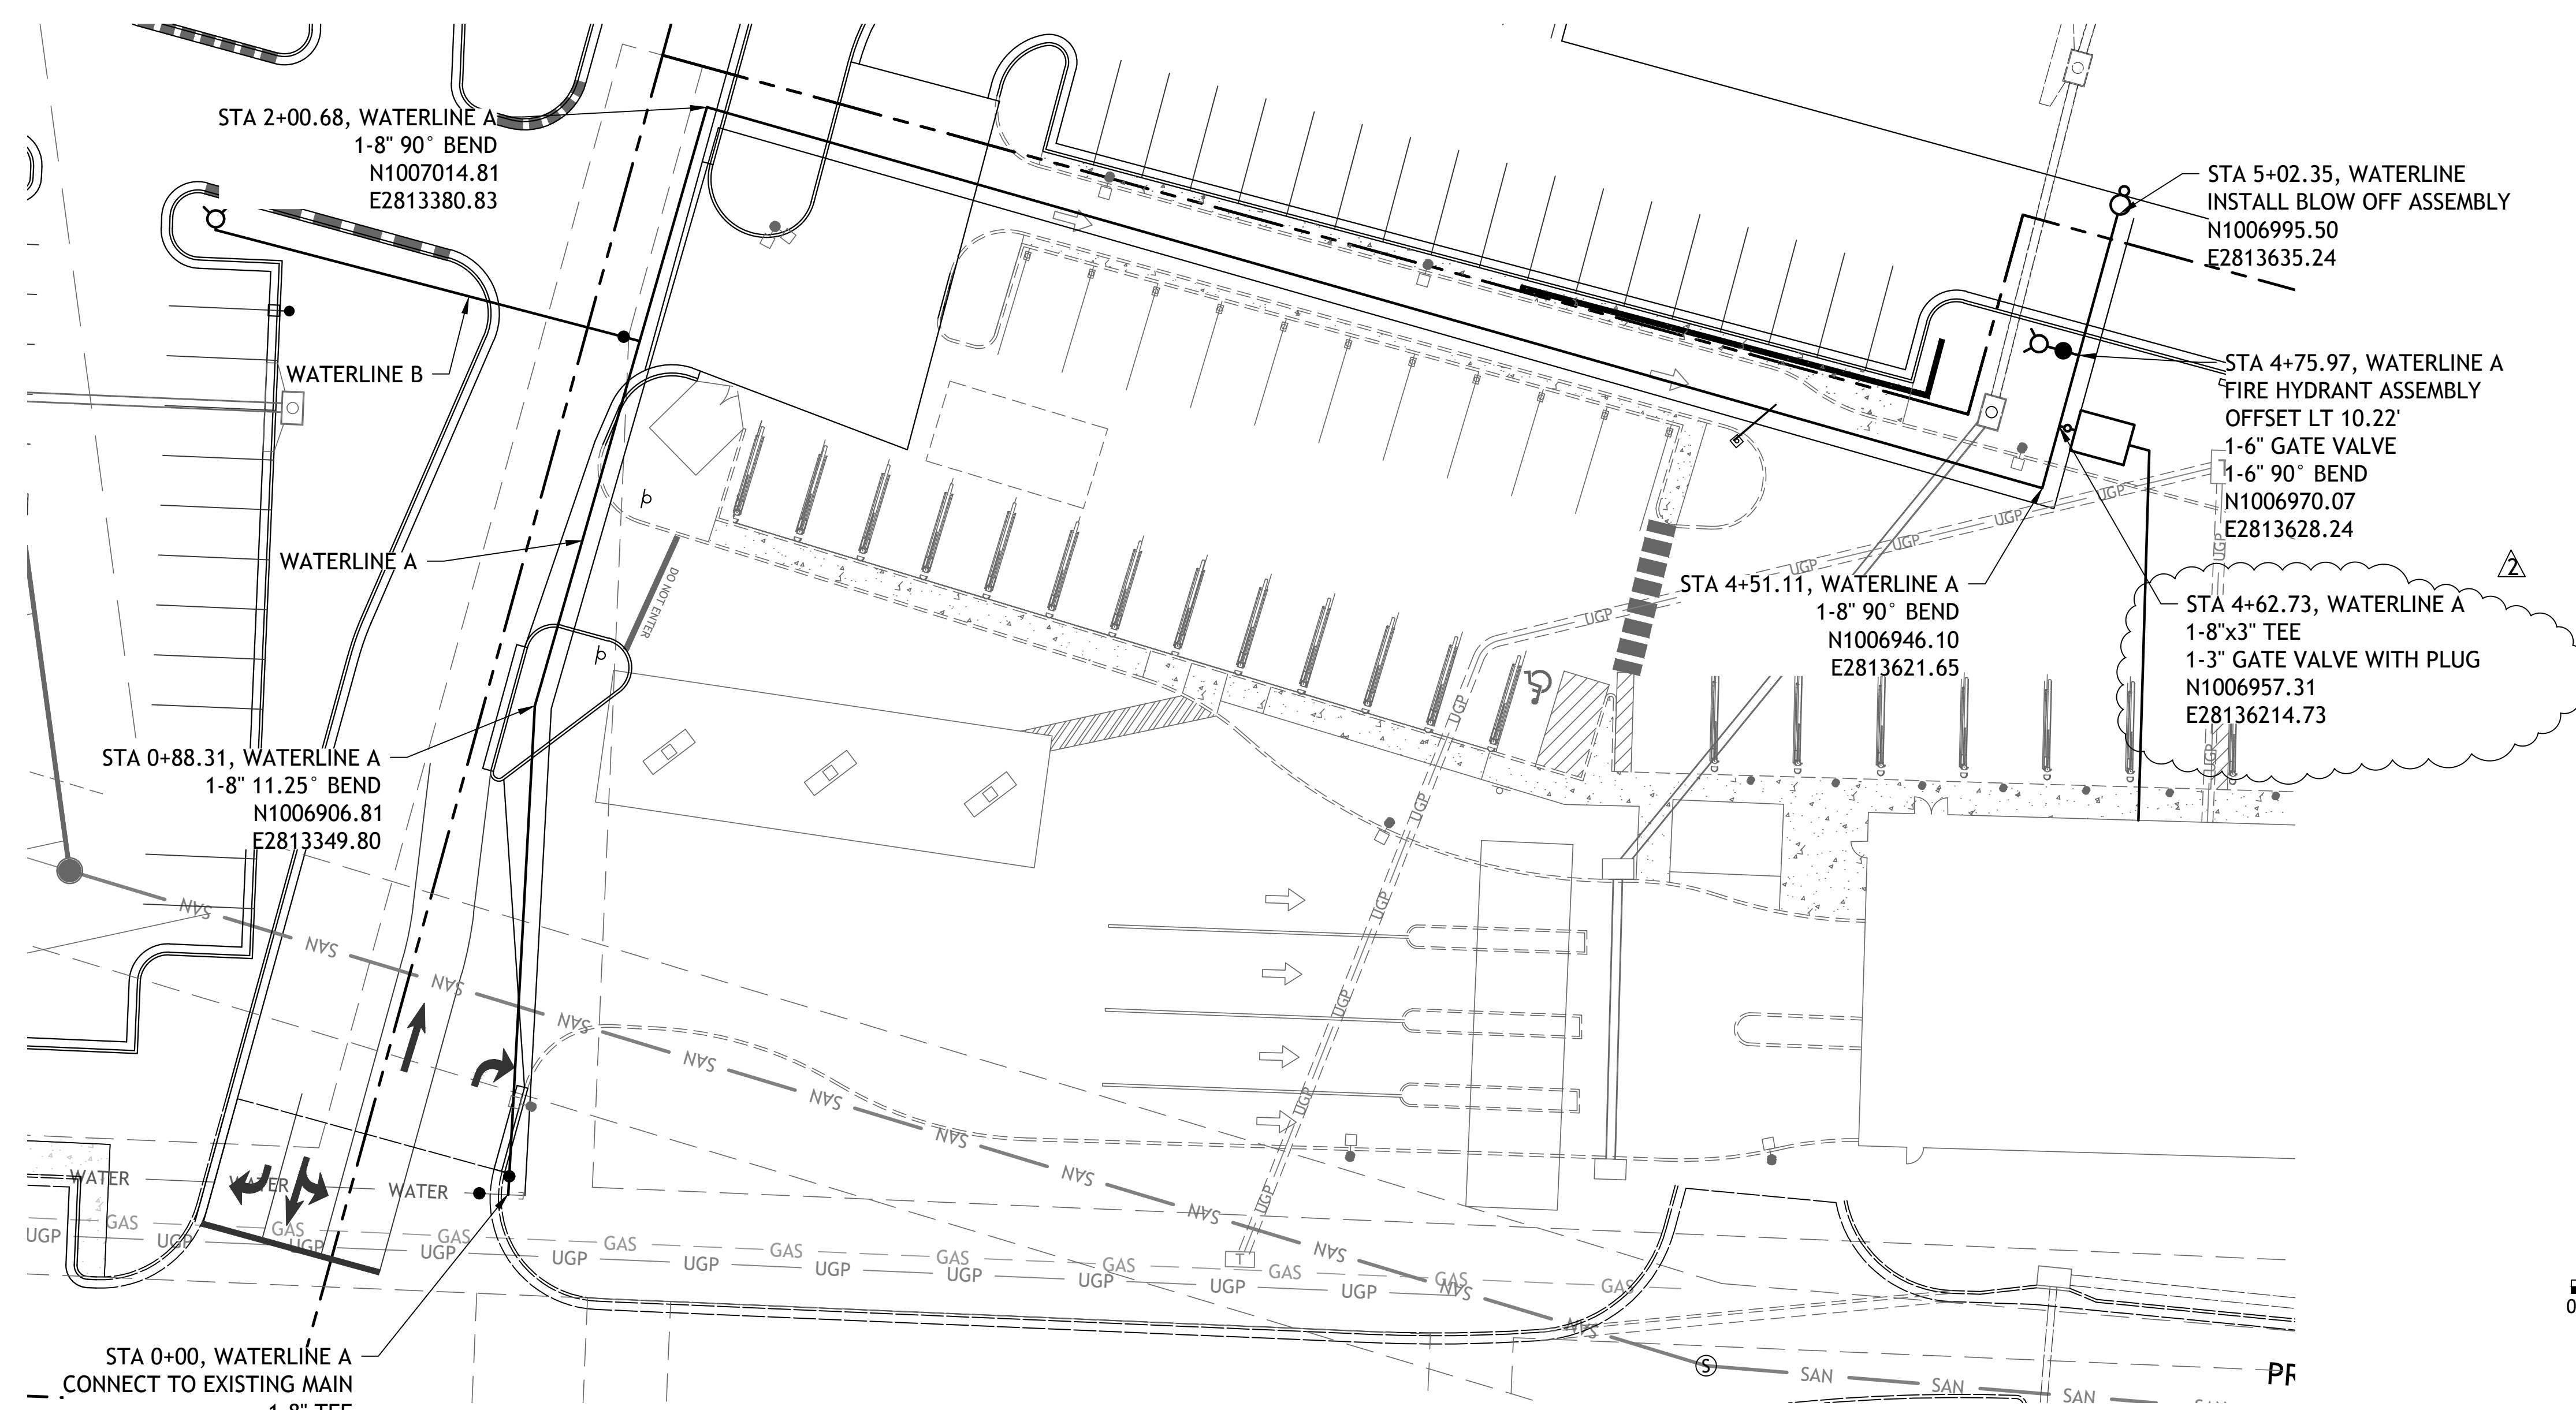

NOTE
COMPACTED FILL SHALL BE PLACED TO A MINIMUM OF 18"
ABOVE THE TOP OF THE PIPE PRIOR TO INSTALLATION.

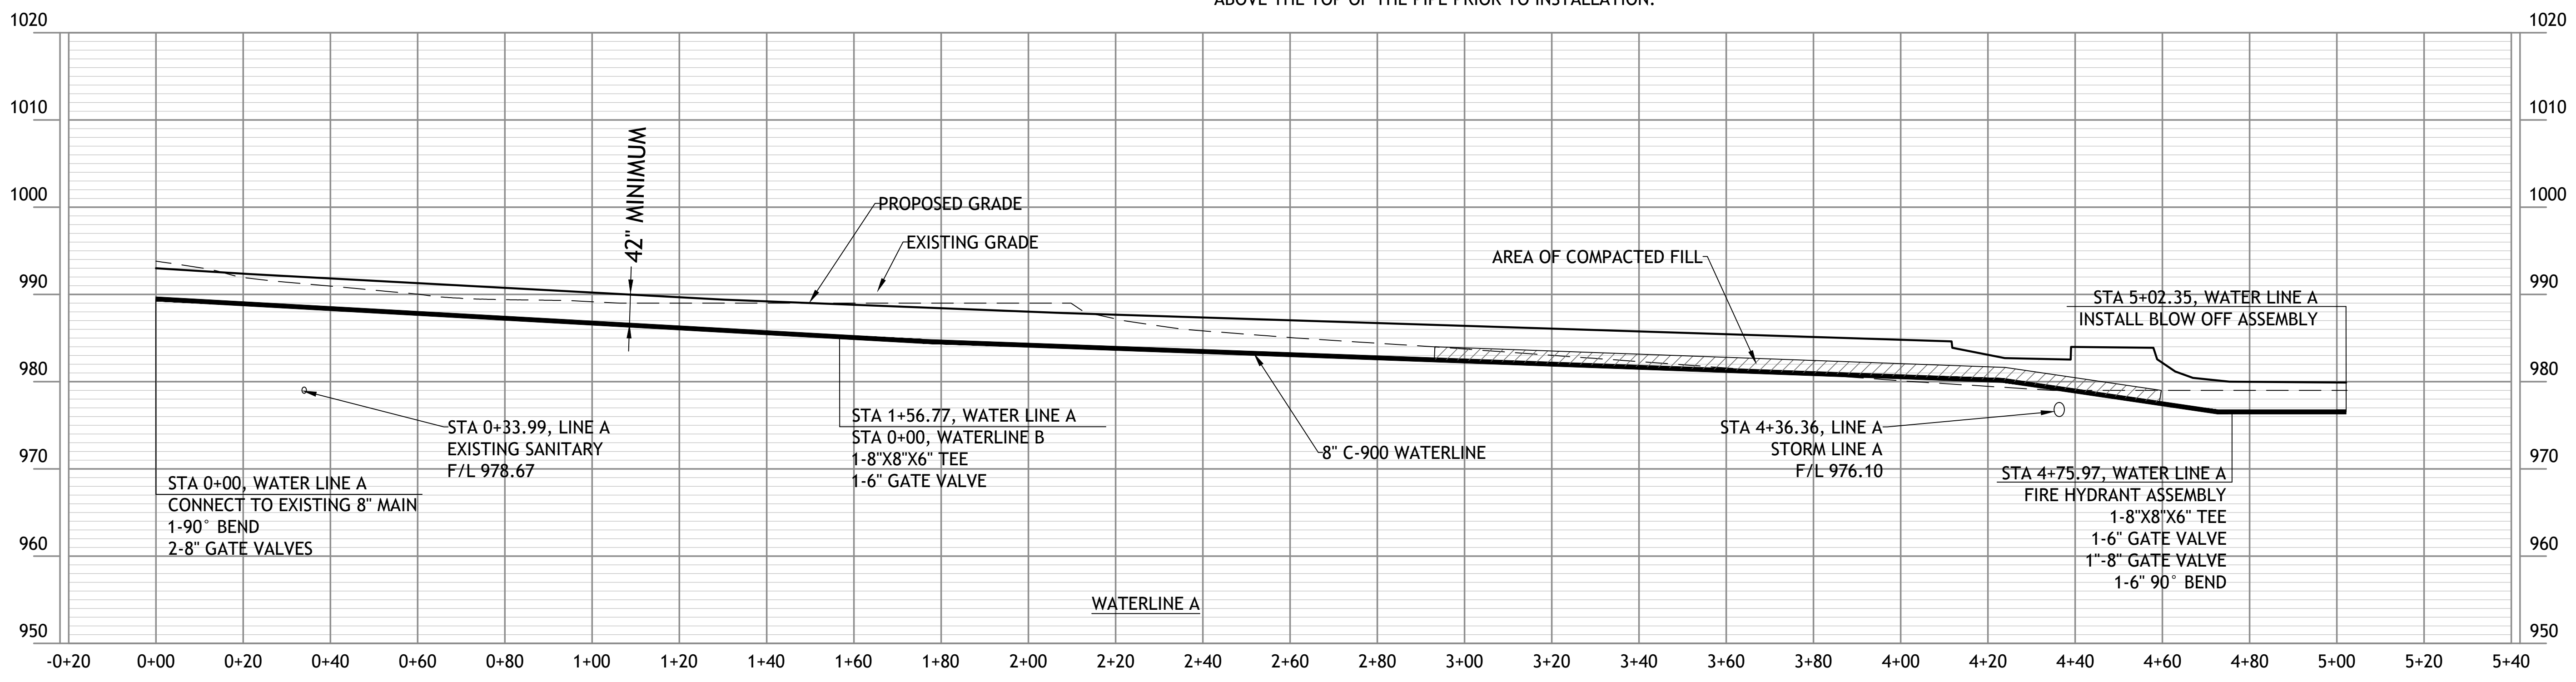


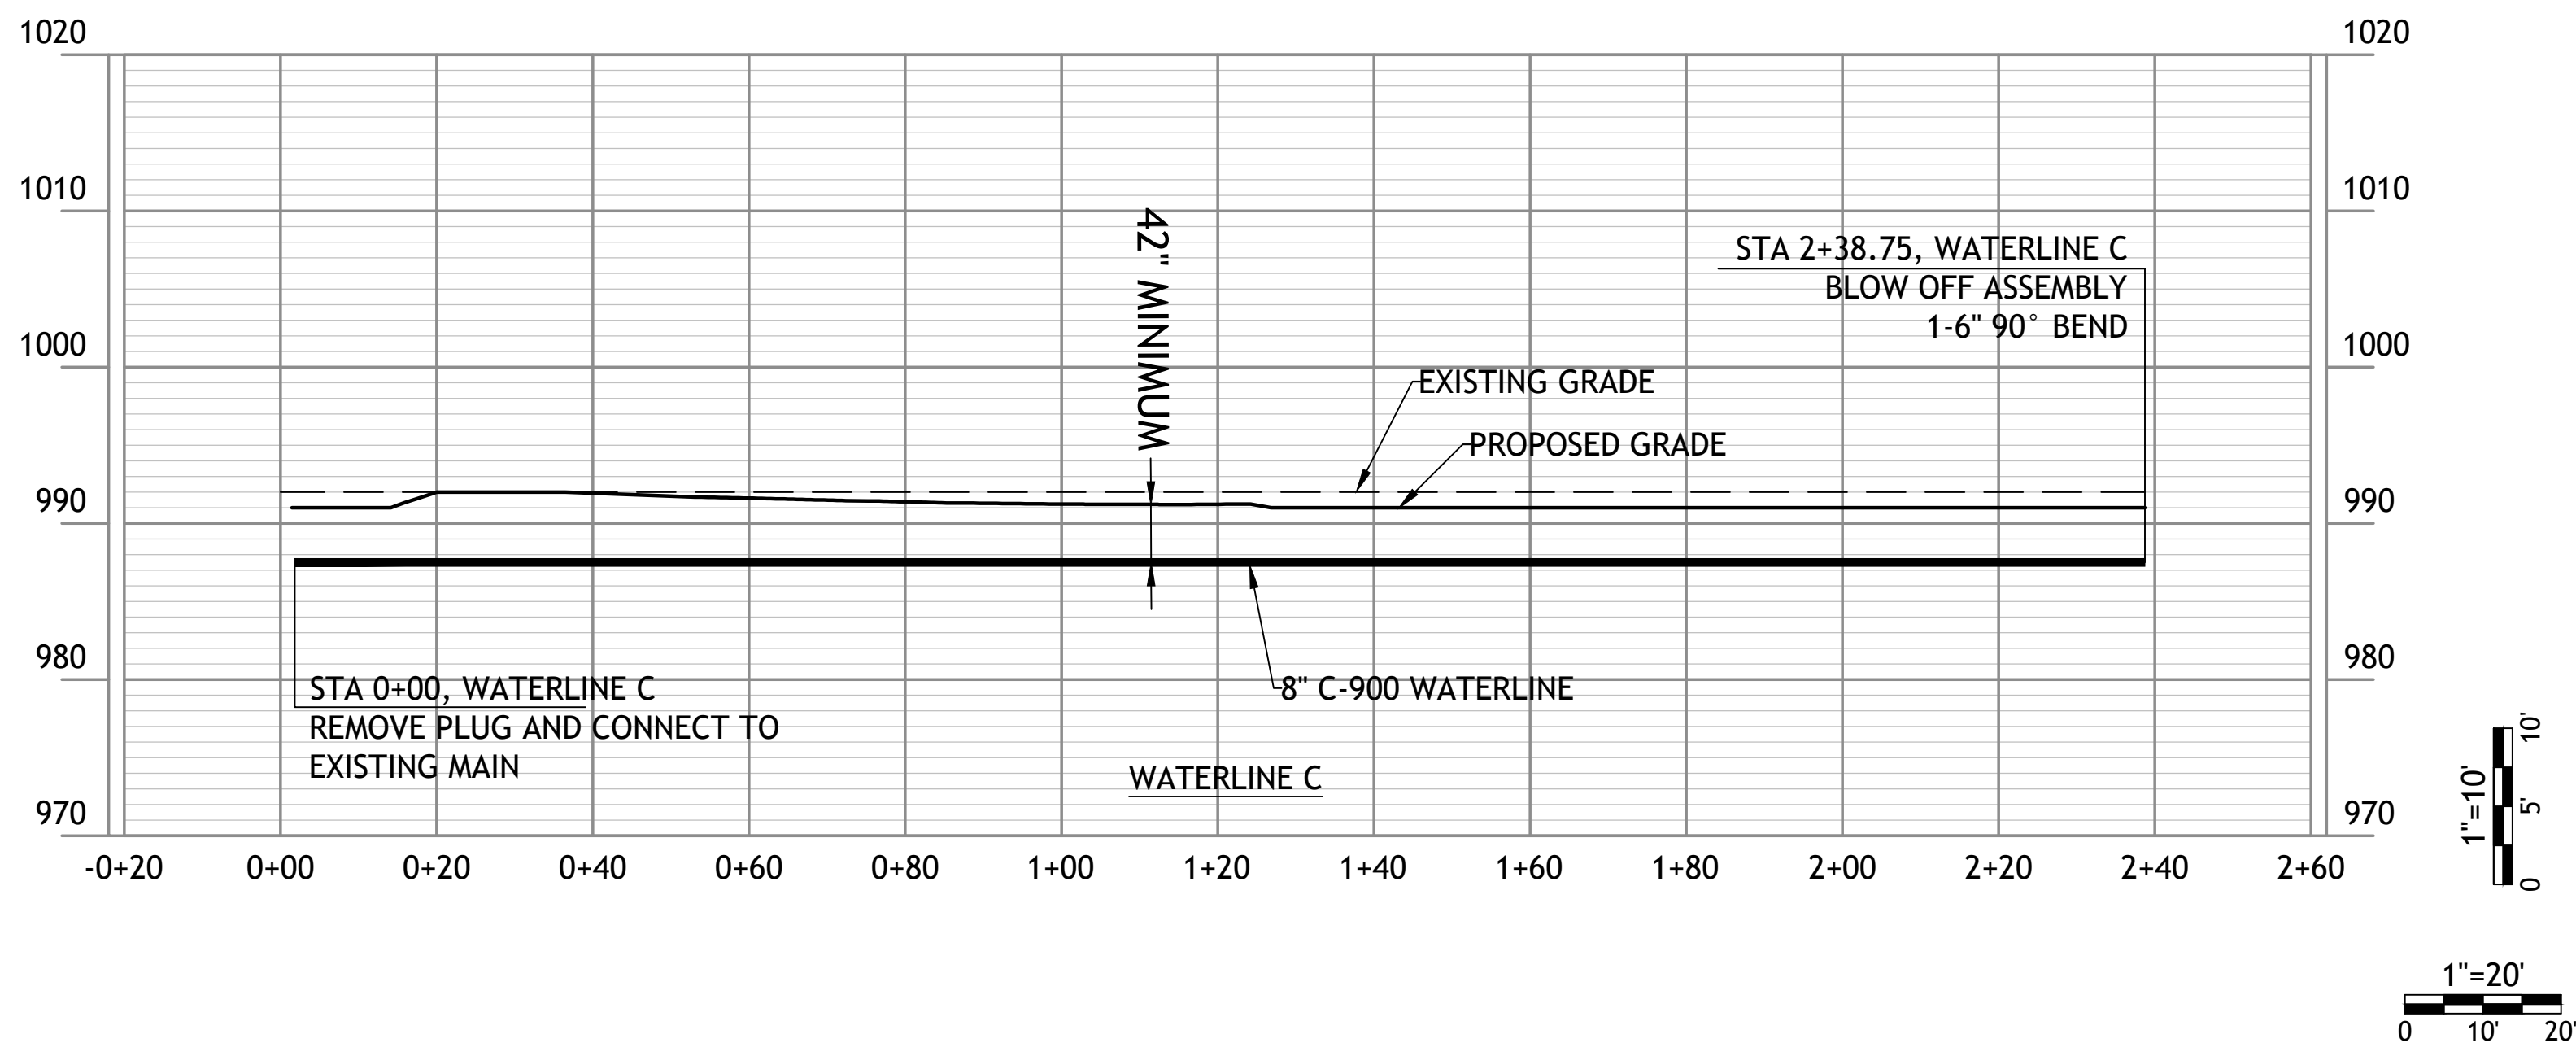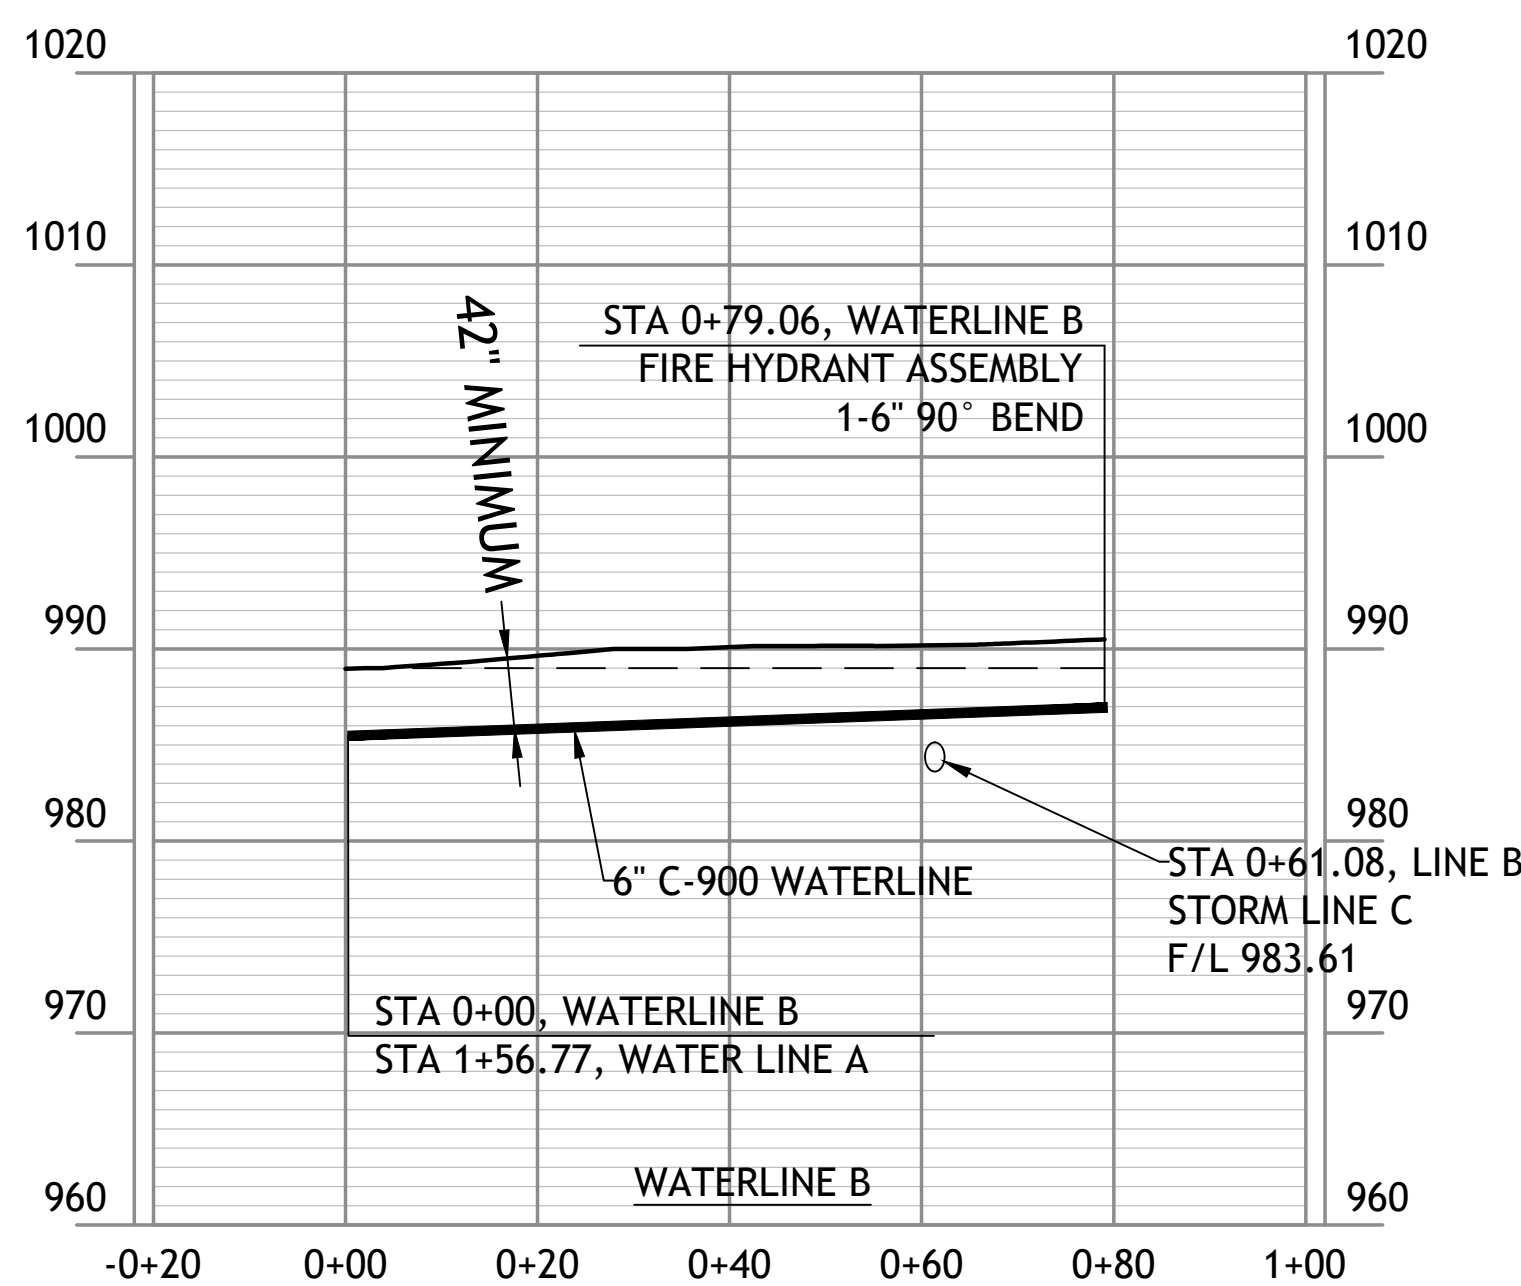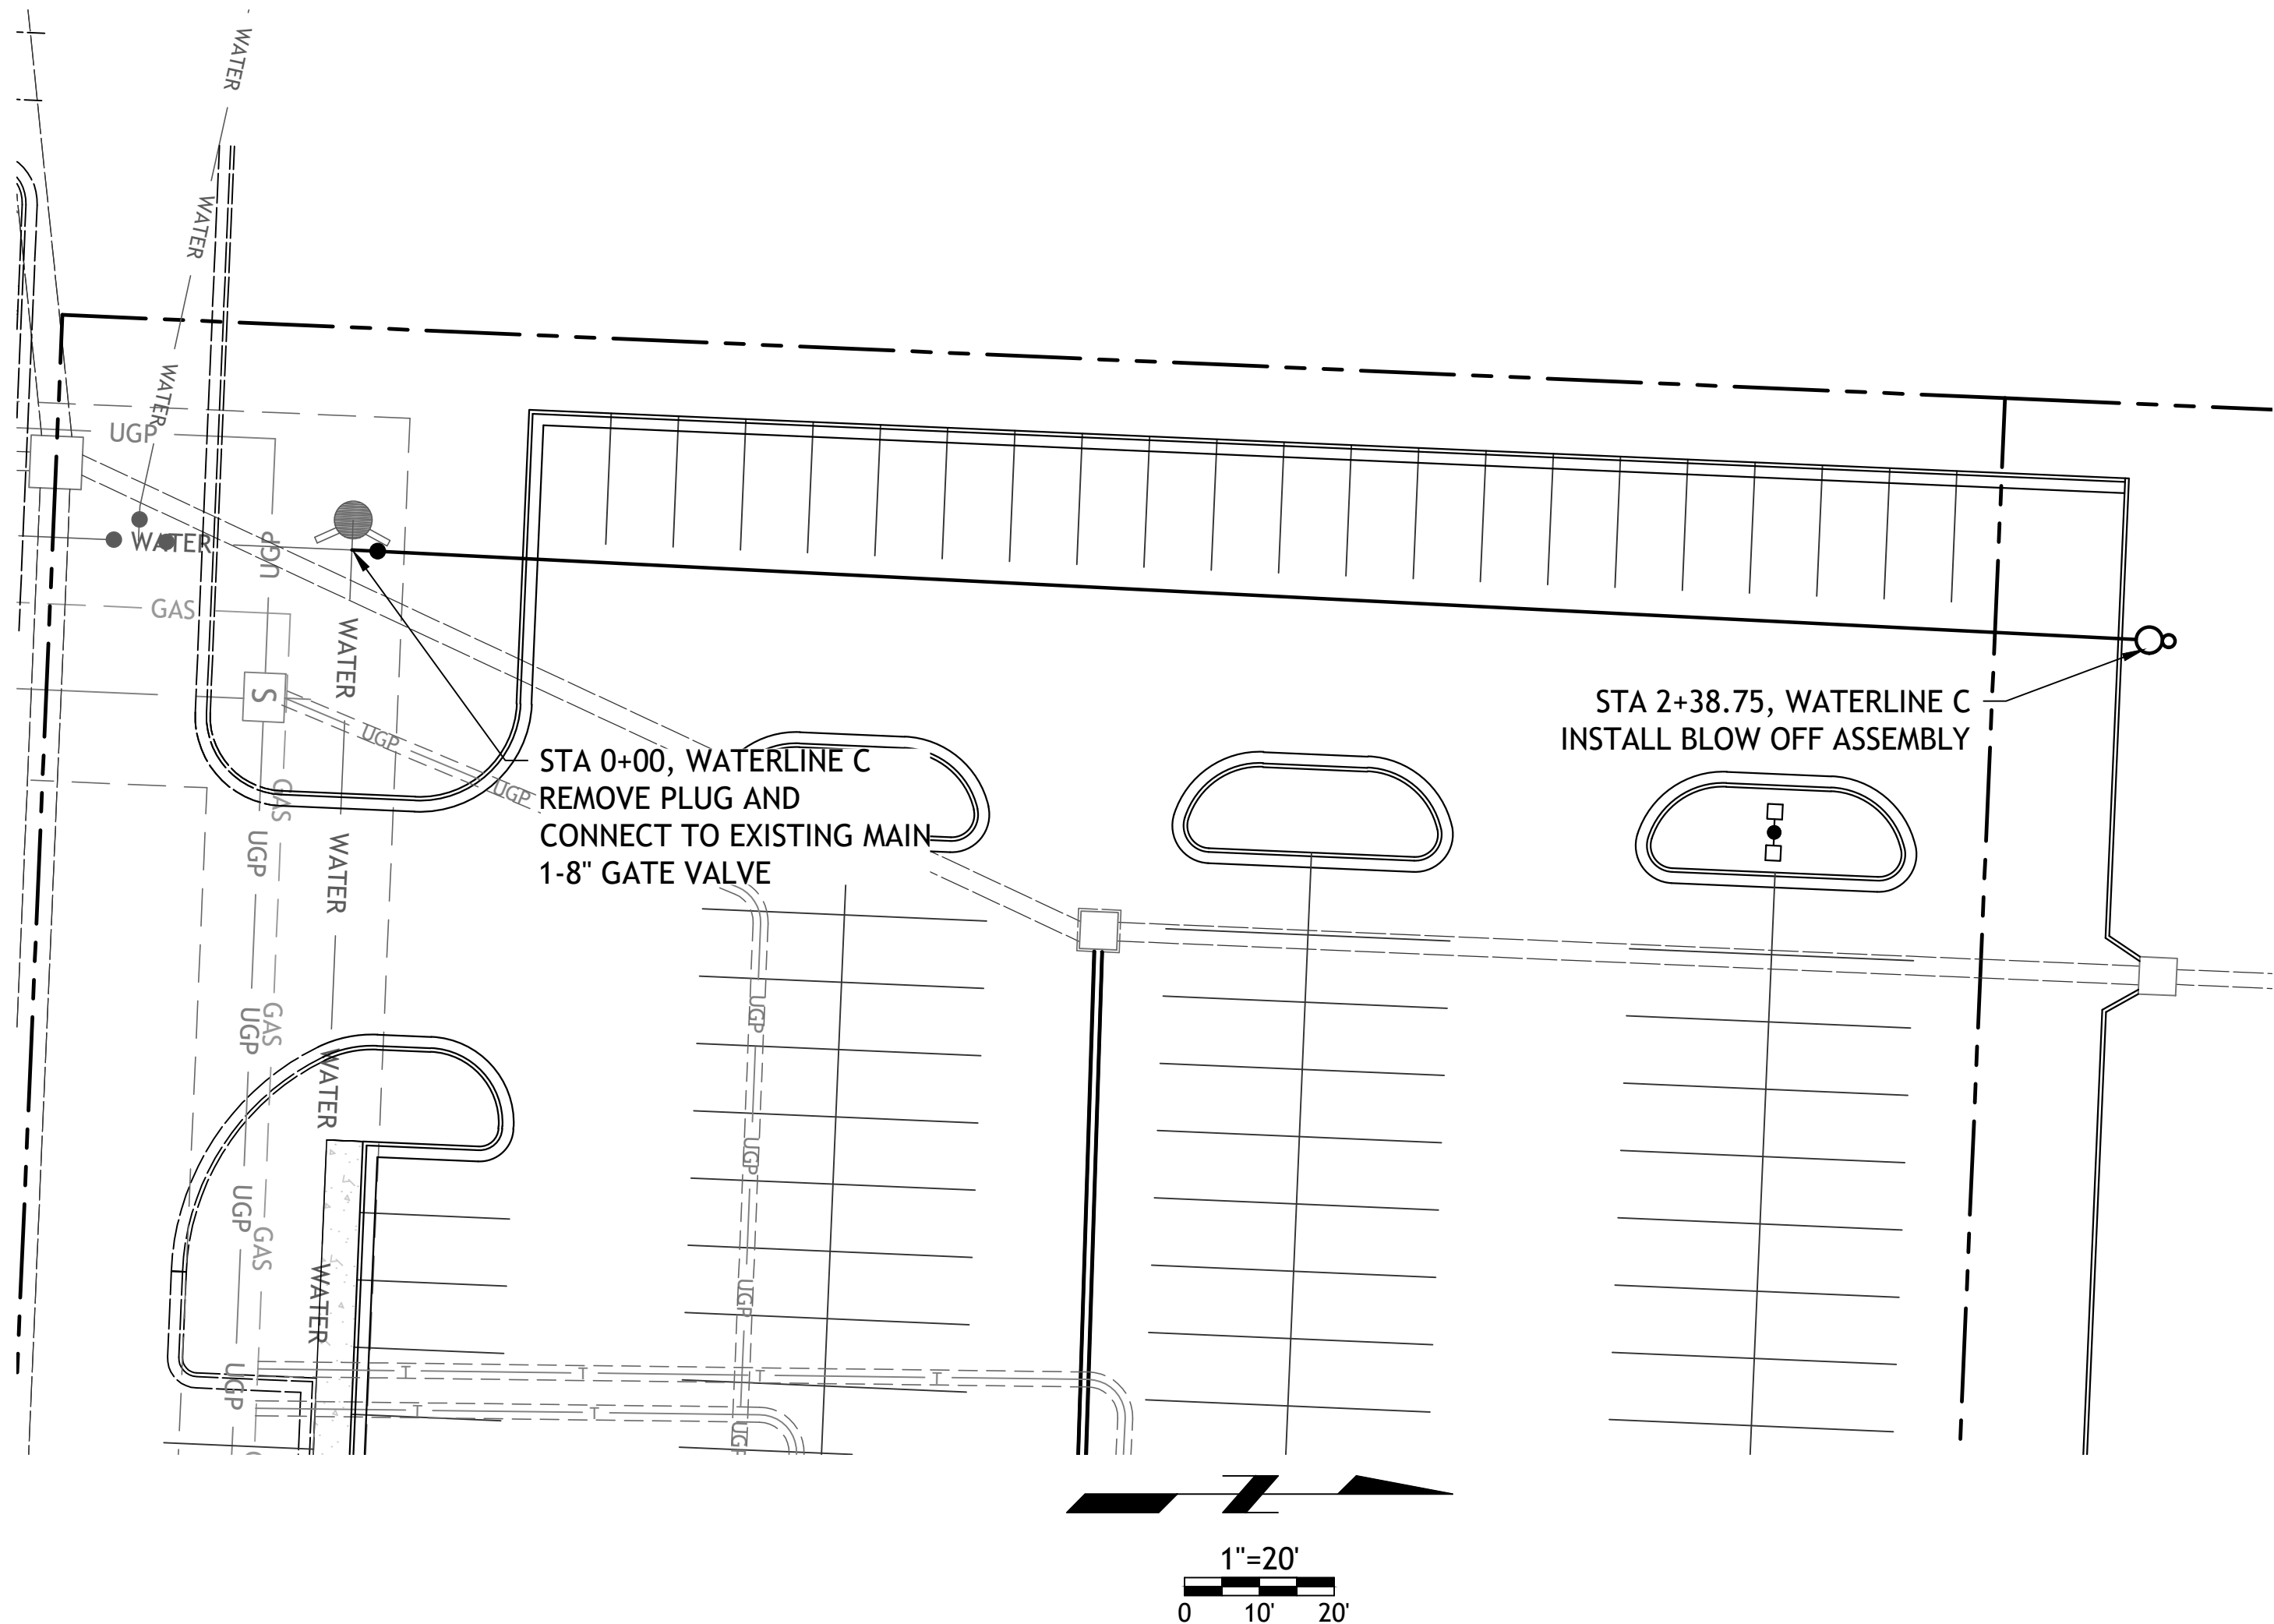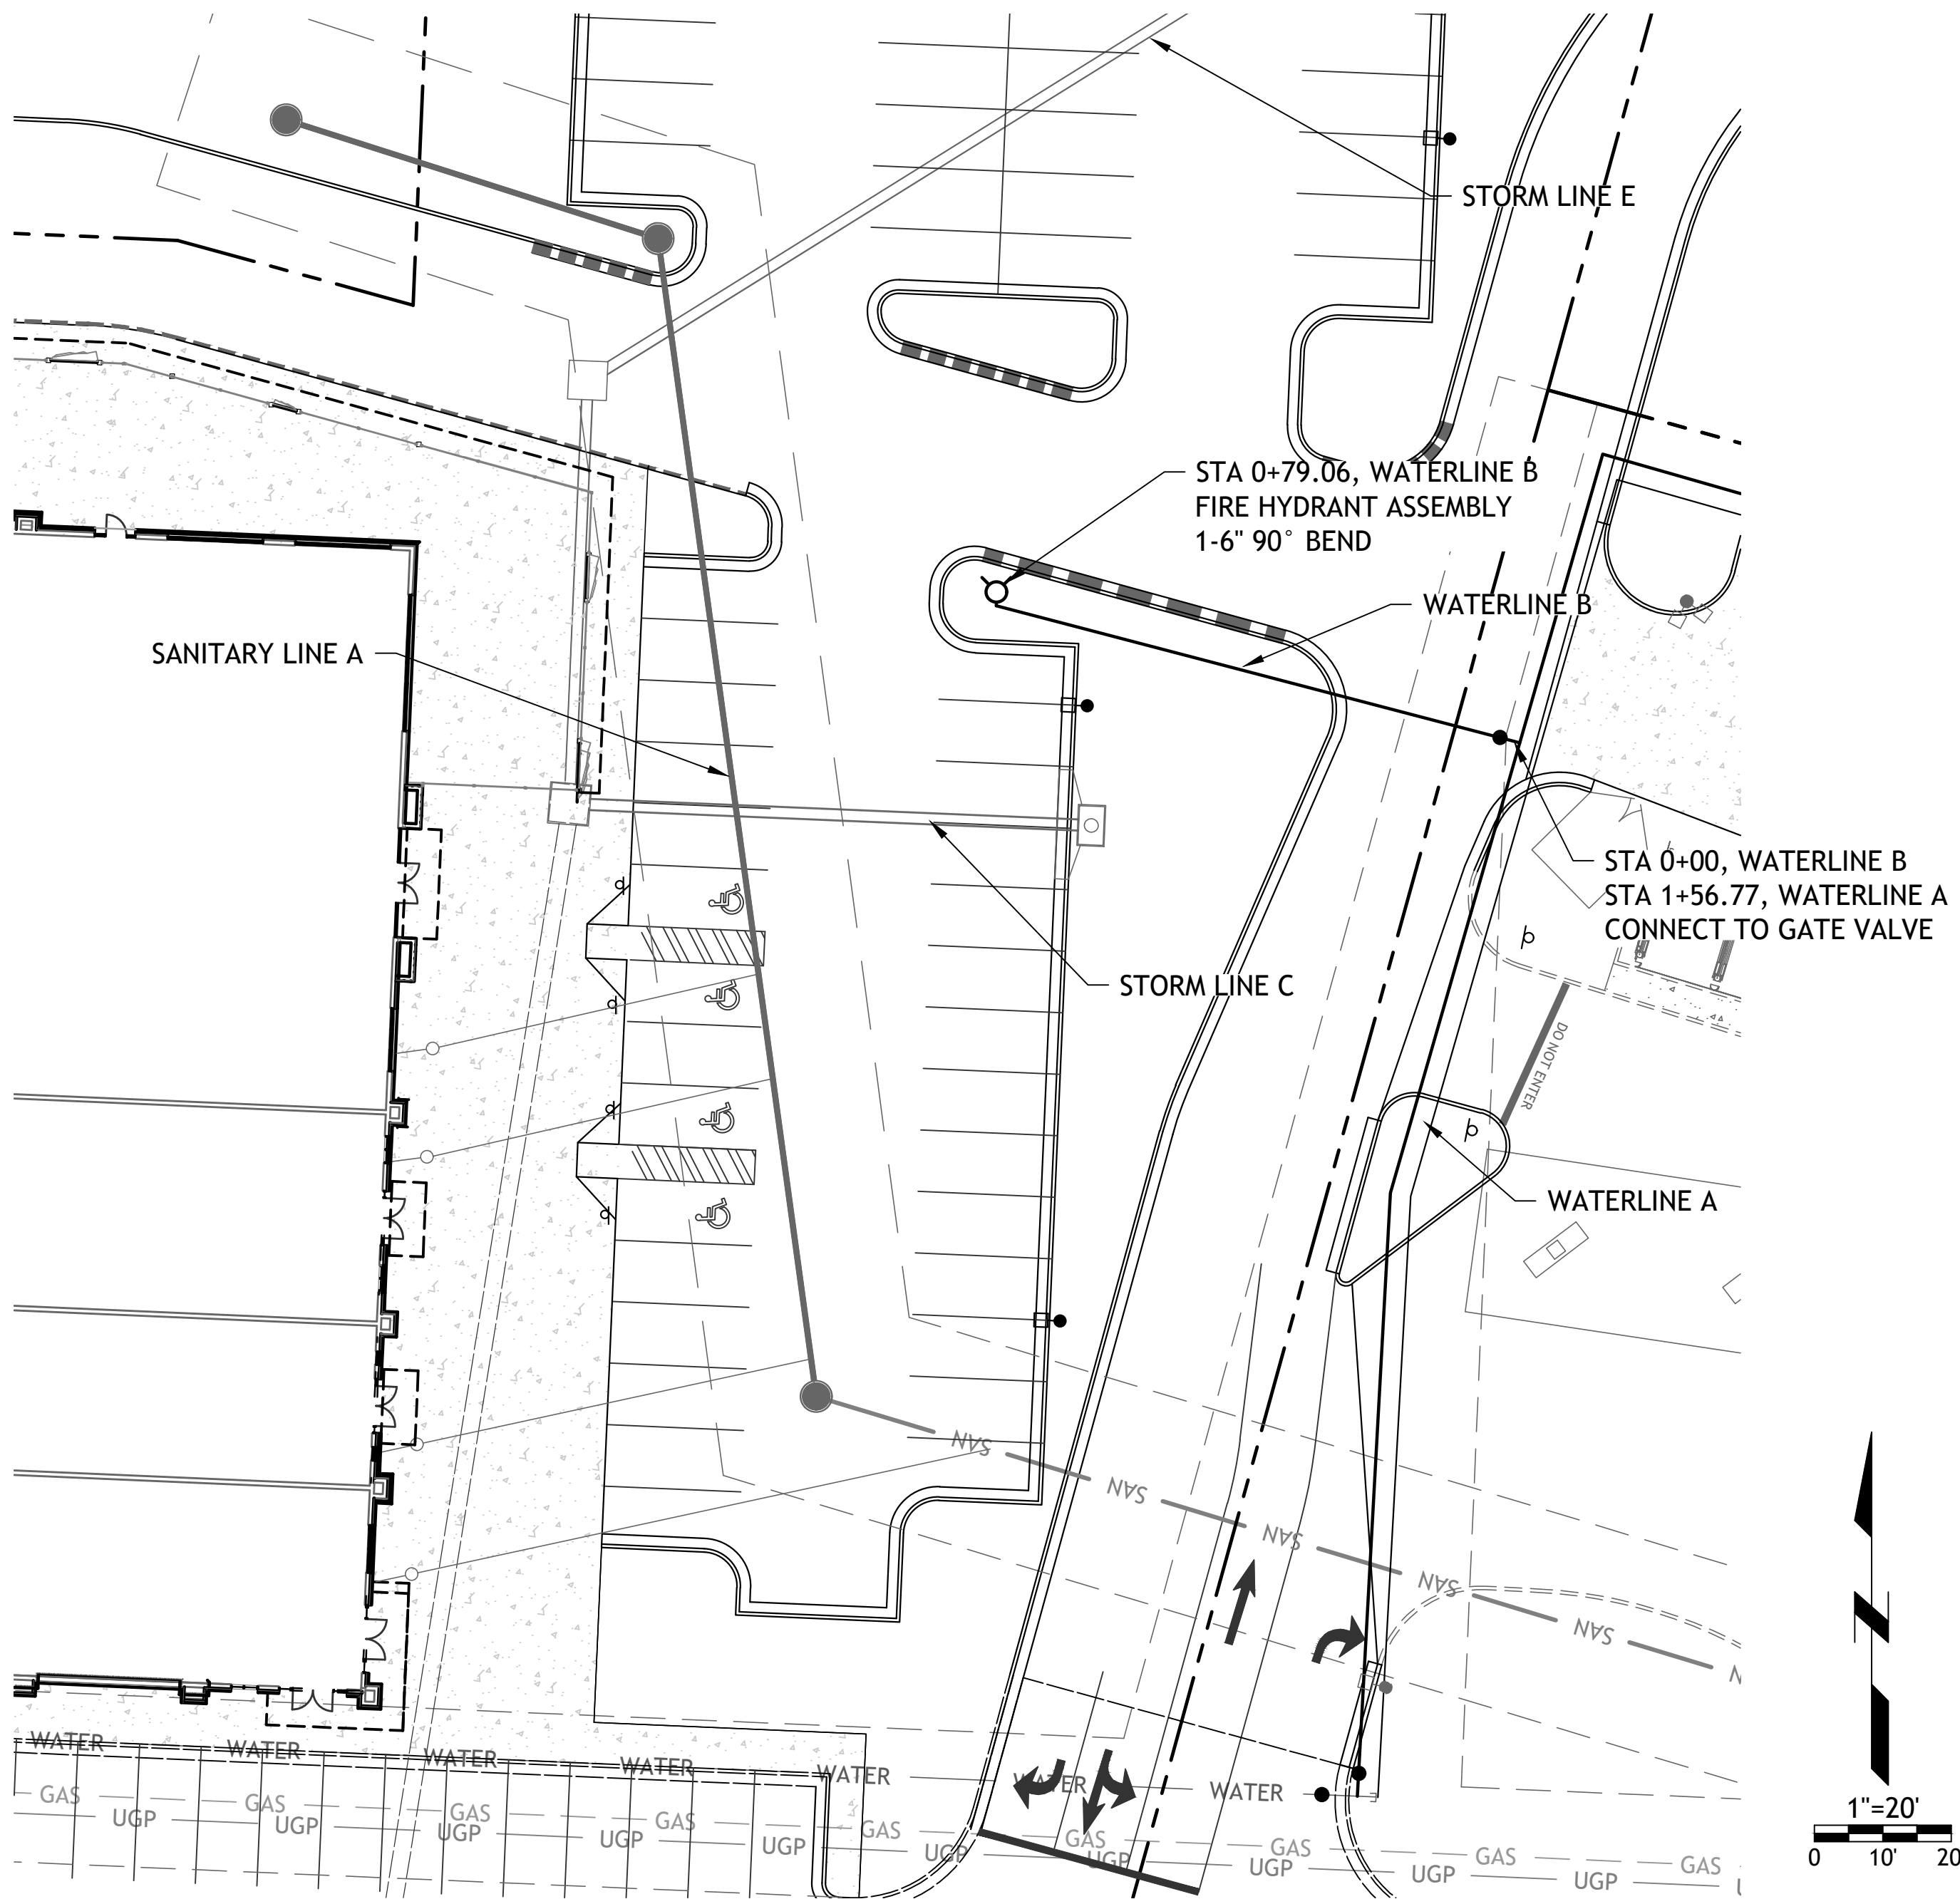

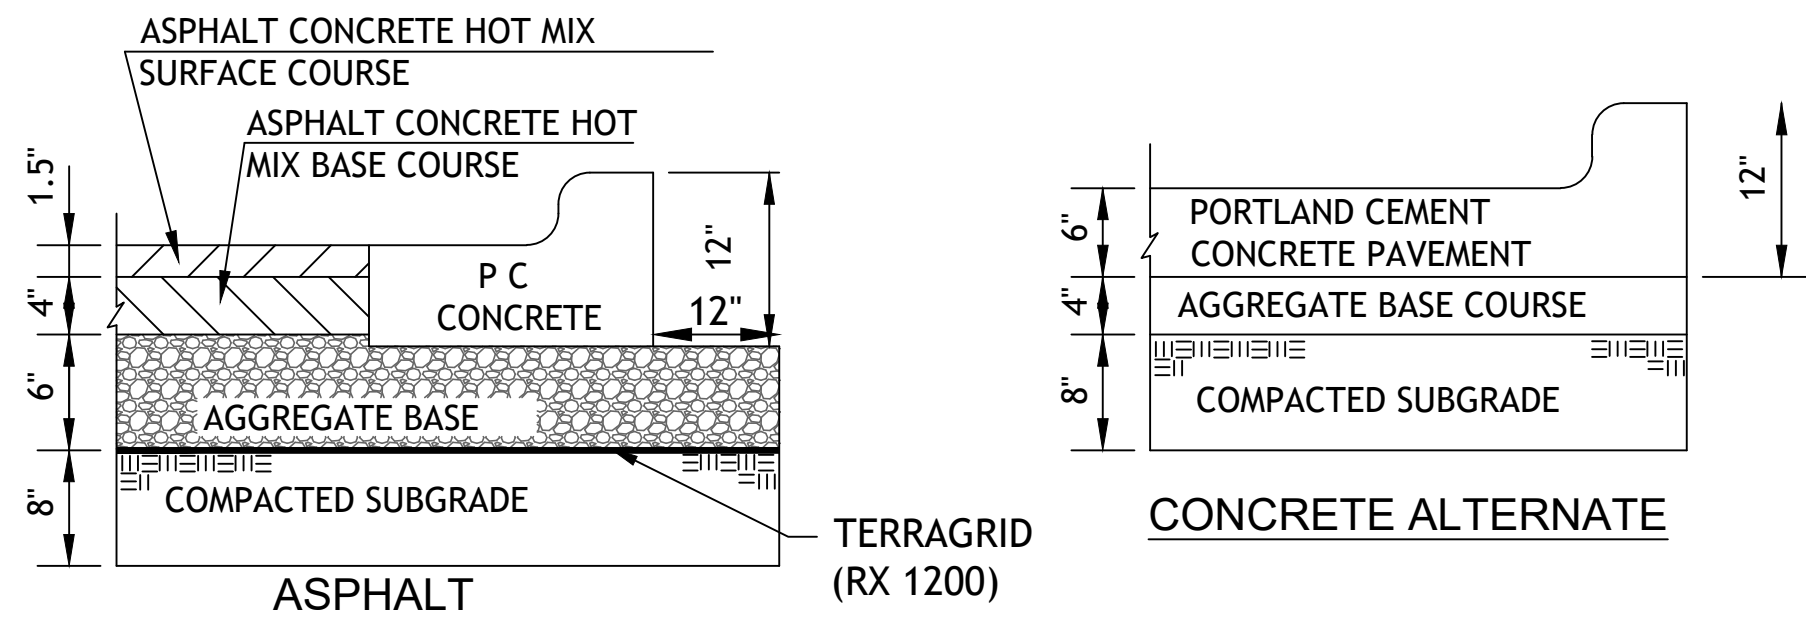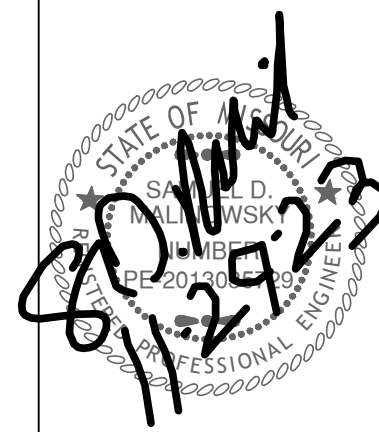

REGULAR DUTY PAVING

PV1

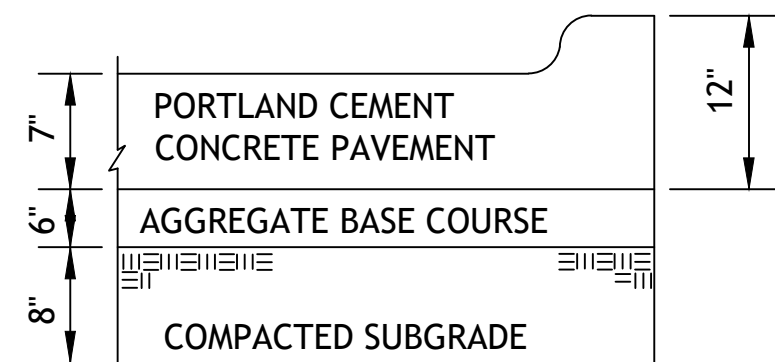


HEAVY DUTY CONCRETE

PV3


1. FLEXIBLE PAVEMENT SHALL BE IN ACCORDANCE WITH THE LATEST EDITION OF THE MISSOURI DEPARTMENT OF TRANSPORTATION STANDARD SPECIFICATIONS.

ASPHALT SURFACE COURSE - APWA TYPE 3-01
ASPHALT BASE COURSE - APWA TYPE 2-01
AGGREGATE BASE MODOT TYPE 5 OR EQUIVALENT

2. PORTLAND CEMENT CONCRETE SHALL HAVE A MINIMUM COMPRESSIVE STRENGTH OF 4000 PSI AT 28 DAYS WITH 6% ENTRAINED AIR $\pm 2\%$ AND SHALL MEET OR EXCEED THE SPECIFICATIONS SET FORTH IN THE LATEST EDITION OF THE MISSOURI DEPARTMENT OF TRANSPORTATION STANDARD SPECIFICATIONS.

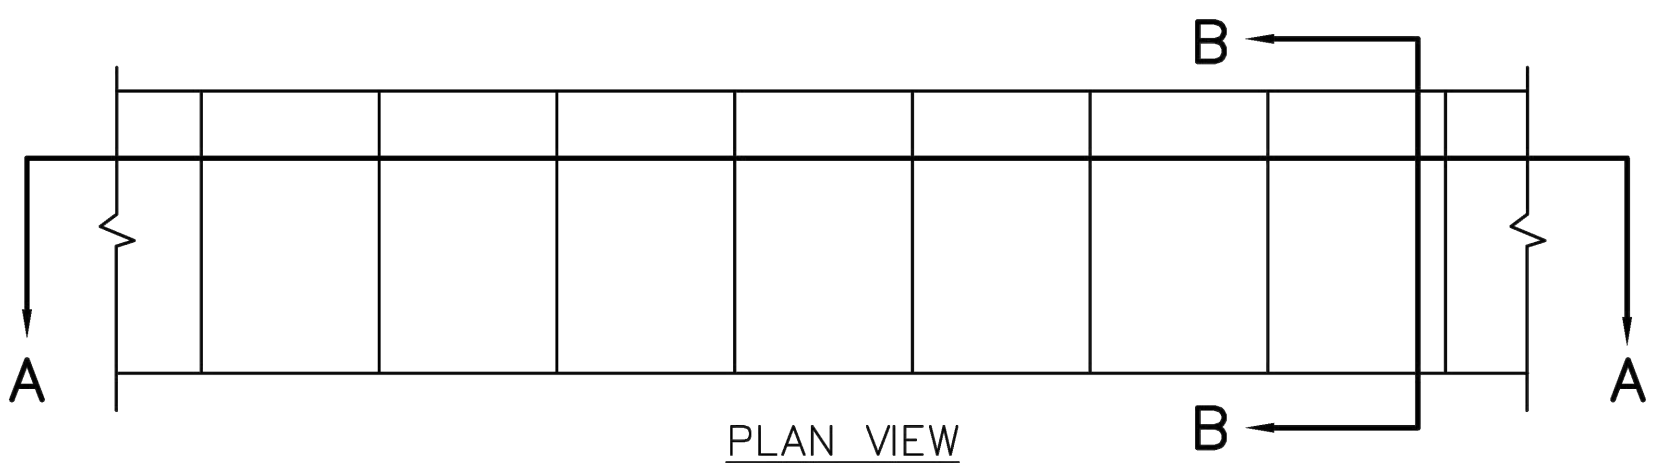


PLAN VIEW

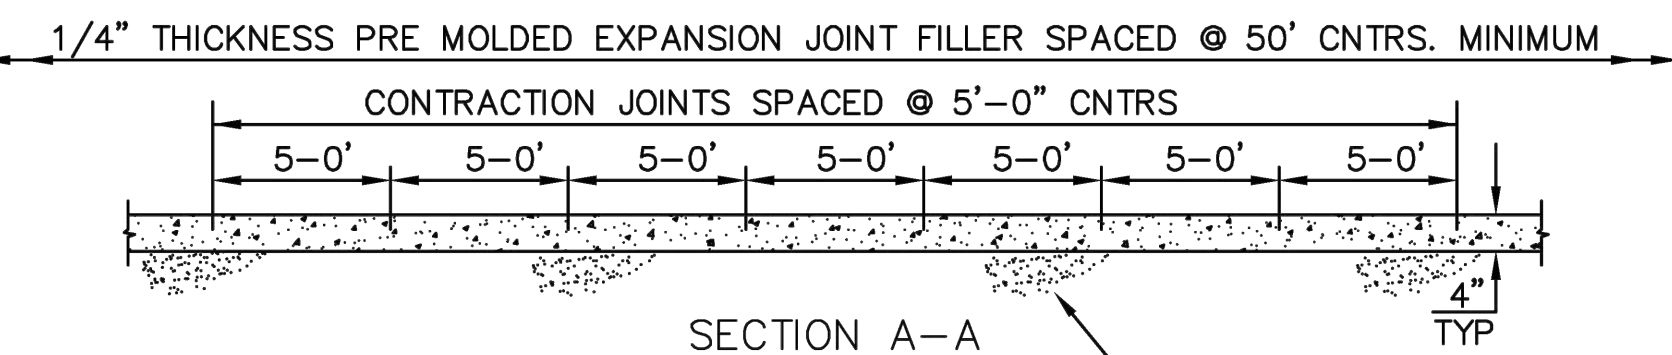

SECTION A-A

NOTE: WHERE SIDEWALKS ARE INTEGRAL WITH DRIVE ENTRANCES INCREASE DEPTH TO 6" AND PROVIDE REINFORCING USING 6x6 #10 WIRE MINIMUM.

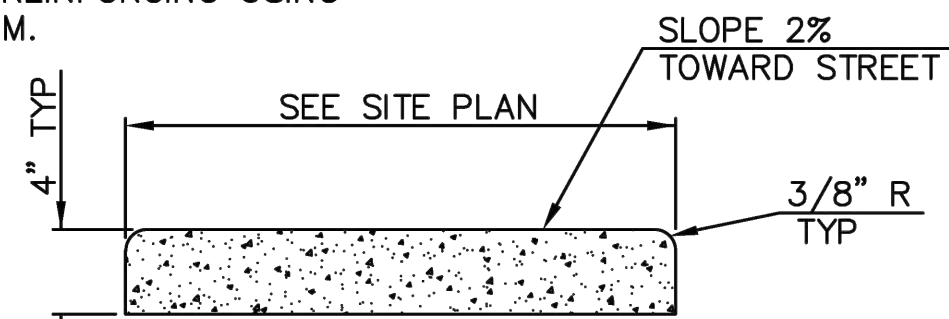

SECTION B-B


CONCRETE SIDEWALK

NOTE: CONCRETE SHALL BE CLASS A WITH $f_c = 3000$ PSI.


CW2

BEDDING
1/2" - 3/4" CLEAN AGGREGATE, HAND TAMPED OR MECHANICALLY COMPACTED IN MAX. 4" LIFTS
INITIAL BACKFILL
- UNDER PAVED AREAS OR WITHIN 4' HORIZONTAL OF PAVED AREAS
1/2" - 3/4" CLEAN AGGREGATE, HAND TAMPED OR MECHANICALLY COMPACTED IN MAX. 4" LIFTS
- UNDER OPEN AREAS
1/2" - 3/4" CLEAN AGGREGATE, HAND TAMPED OR MECHANICALLY COMPACTED IN MAX. 4" LIFTS
FINAL BACKFILL
- UNDER PAVED AREAS OR WITHIN 4' HORIZONTAL OF PAVED AREAS
ON-SITE OR IMPORTED MATERIAL FREE OF MUCK, FROZEN MATERIAL, EXCESS MOISTURE, ORGANICS, TOPSOIL, RUBBISH, CONSTRUCTION DEBRIS, ROCK OR BRICK LARGER THAN 8", COMPACTED TO 95% OF STANDARD DENSITY PER ASTM D-698
- UNDER OPEN AREAS
ON-SITE OR IMPORTED MATERIAL FREE OF MUCK, FROZEN MATERIAL, EXCESS MOISTURE, ORGANICS, TOPSOIL, RUBBISH, CONSTRUCTION DEBRIS, ROCK OR BRICK LARGER THAN 8", COMPACTED TO 90% OF STANDARD DENSITY PER ASTM D-698

BEDDING DEPTH BELOW PIPE		
PIPE DIAMETER	IN SOIL	IN ROCK
24" AND LESS	6"	6"
27" THRU 60"	6"	9"

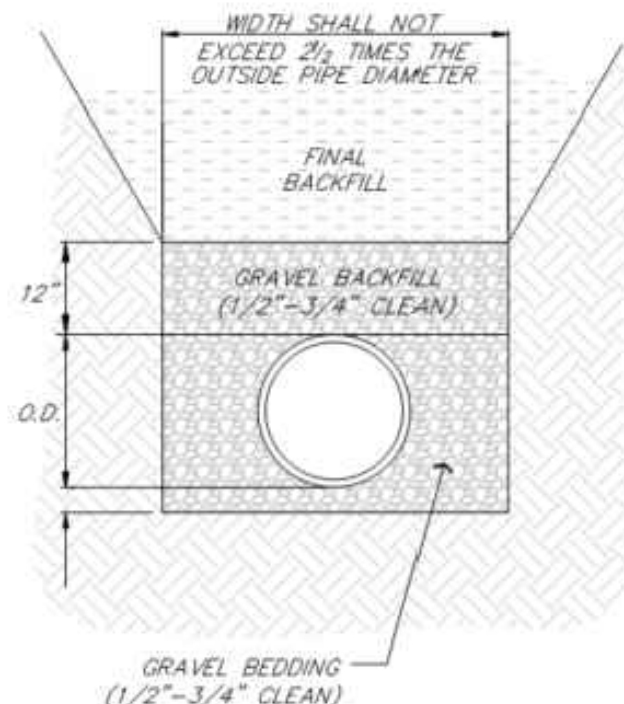


PIPE BEDDING DETAIL
NOT TO SCALE

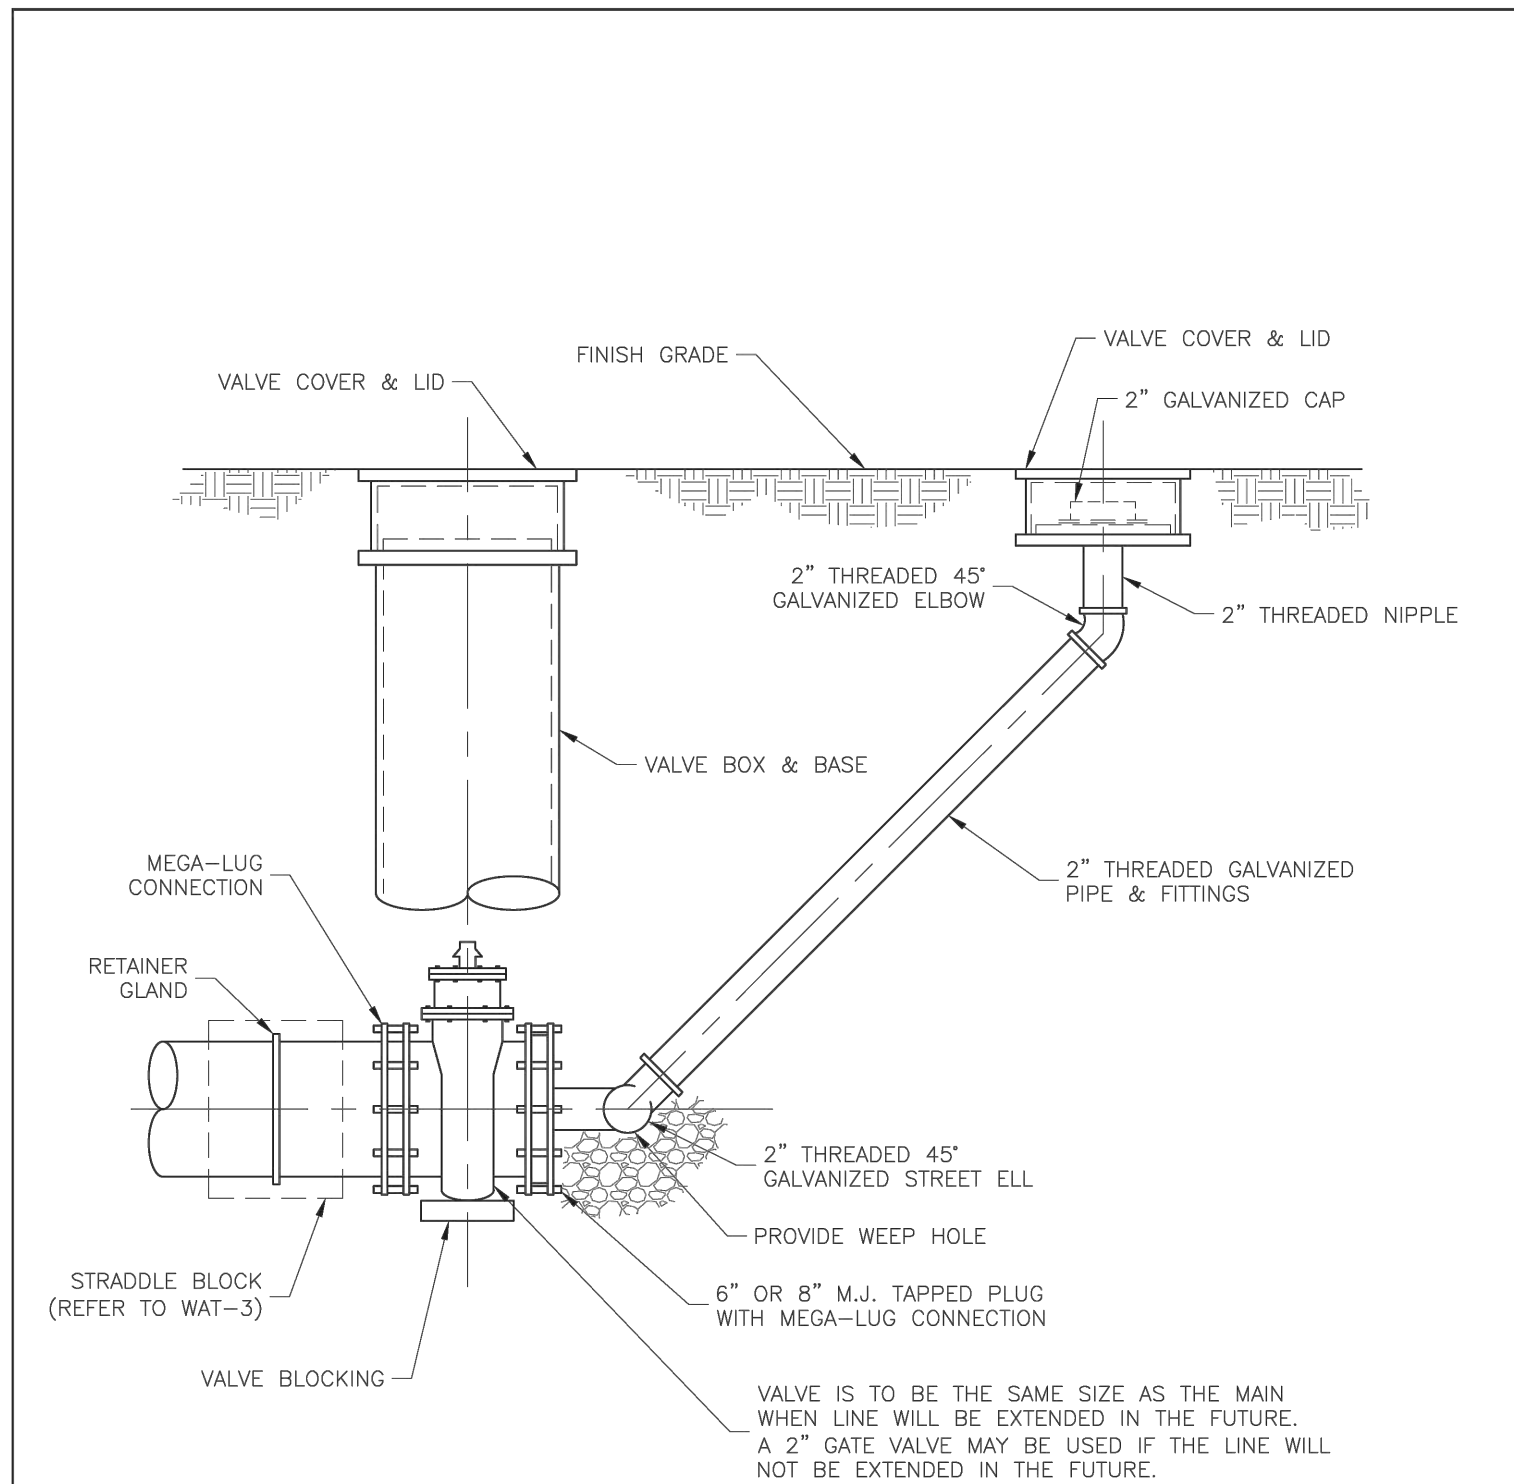

LEE'S SUMMIT
MISSOURI
PUBLIC WORKS ENGINEERING DIVISION | 220 SE GREEN STREET | LEE'S SUMMIT, MO 64063
BLOWOFF ASSEMBLY

Date: 02/2016
Drawn By: JN
Checked By: DL
WAT-13

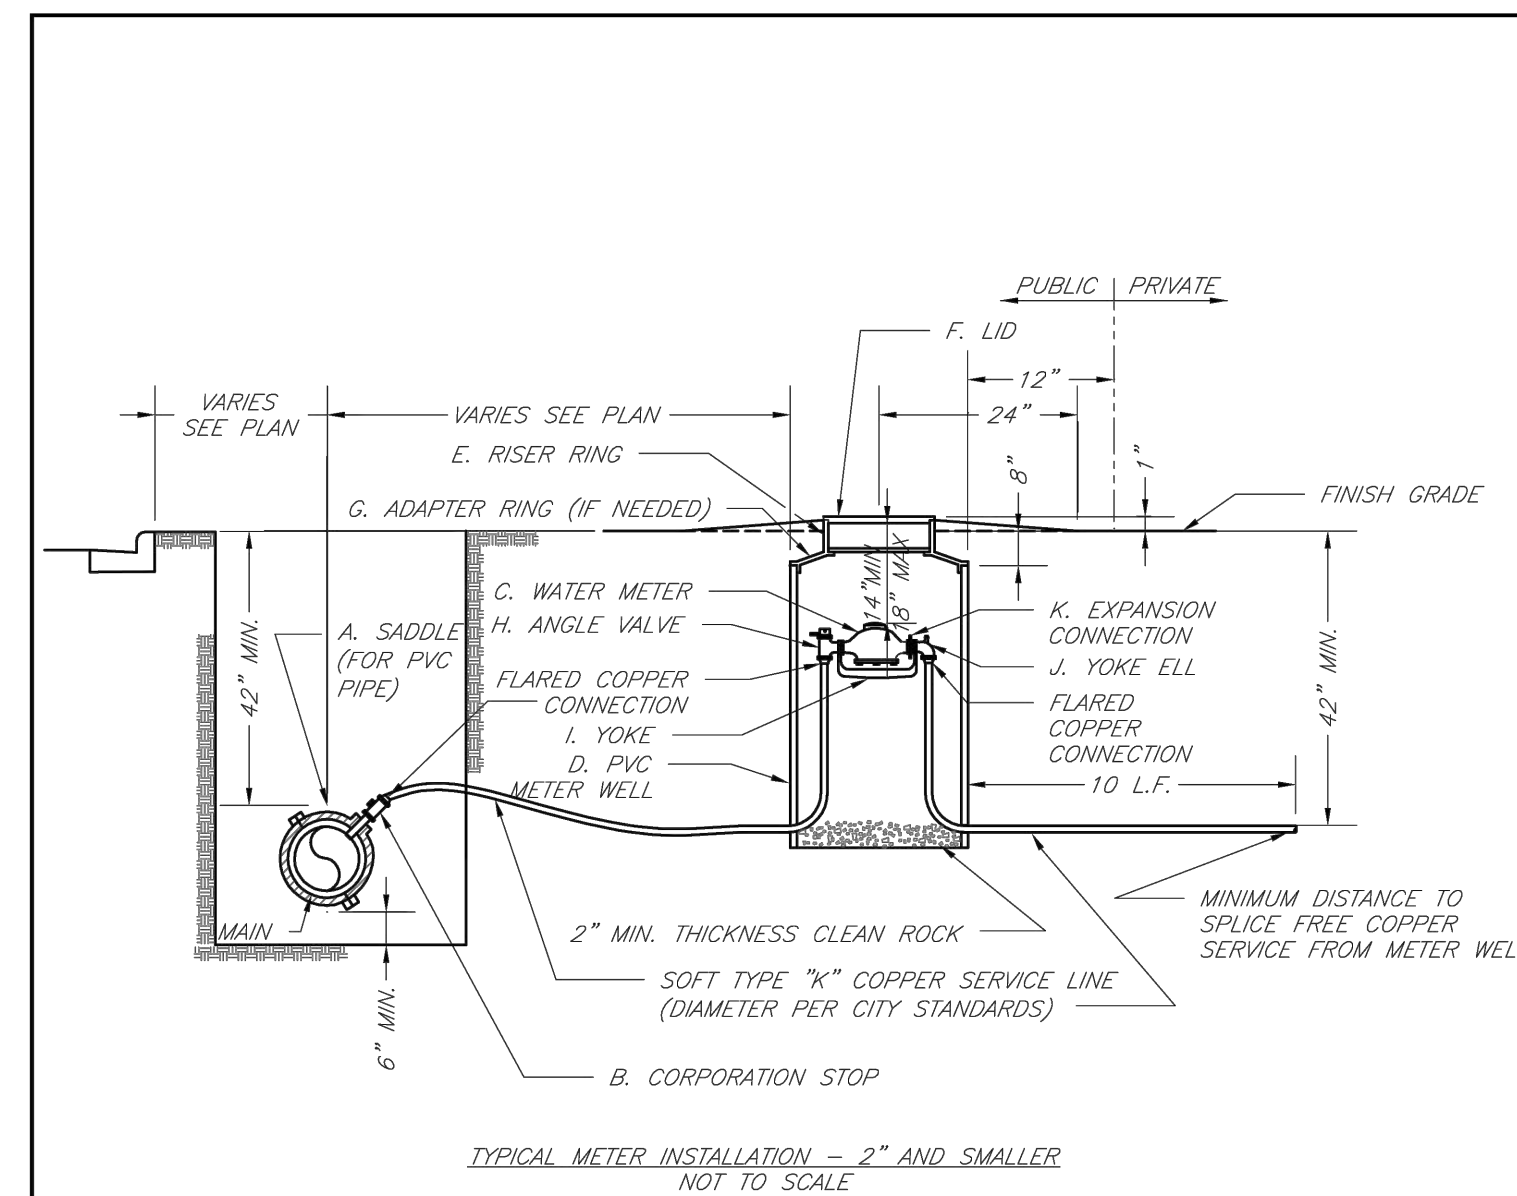


TYPICAL METER INSTALLATION - 2" AND SMALLER
NOT TO SCALE

NOTES:

- METER INSTALLATION SHALL NOT BE LOCATED IN AREAS SUBJECT TO VEHICULAR TRAFFIC OR IN CONCRETE PAVEMENT WITHOUT CITY APPROVAL.
- IF METER IS TO BE LOCATED OTHER THAN IN FRONT OF PROPERTY LINE, CITY APPROVAL SHALL BE OBTAINED.
- CITY TO FURNISH ITEMS A-K.
- NO OTHER EQUIPMENT SHALL BE INSTALLED IN THIS PIT.
- 42" MINIMUM BURY DEPTH FOR ALL SERVICE LINES.
- EXCAVATION FOR TAP TO EXPOSE 4 LINEAR FEET OF MAIN.
- NO SPLICES ALLOWED BETWEEN METER AND MAIN.
- SERVICE CONNECTION TAP AT APPROXIMATELY 45 DEGREES.
- LID AND RISER RING SHALL BE SET SO THAT GROUND WATER WILL DRAIN AWAY FROM THE WELL.
- CONTACT WATER UTILITIES, 816-969-1900, FOR REQUIREMENTS OF A METER LARGER THAN 2"

LEE'S SUMMIT
MISSOURI
PUBLIC WORKS ENGINEERING DIVISION | 220 SE GREEN STREET | LEE'S SUMMIT, MO 64063
SERVICE CONNECTION/METER WELL

Date: 02/13
Drawn By: JN
Checked By: DL
FILE: WAT-11
Rev: 1/14
Rev:

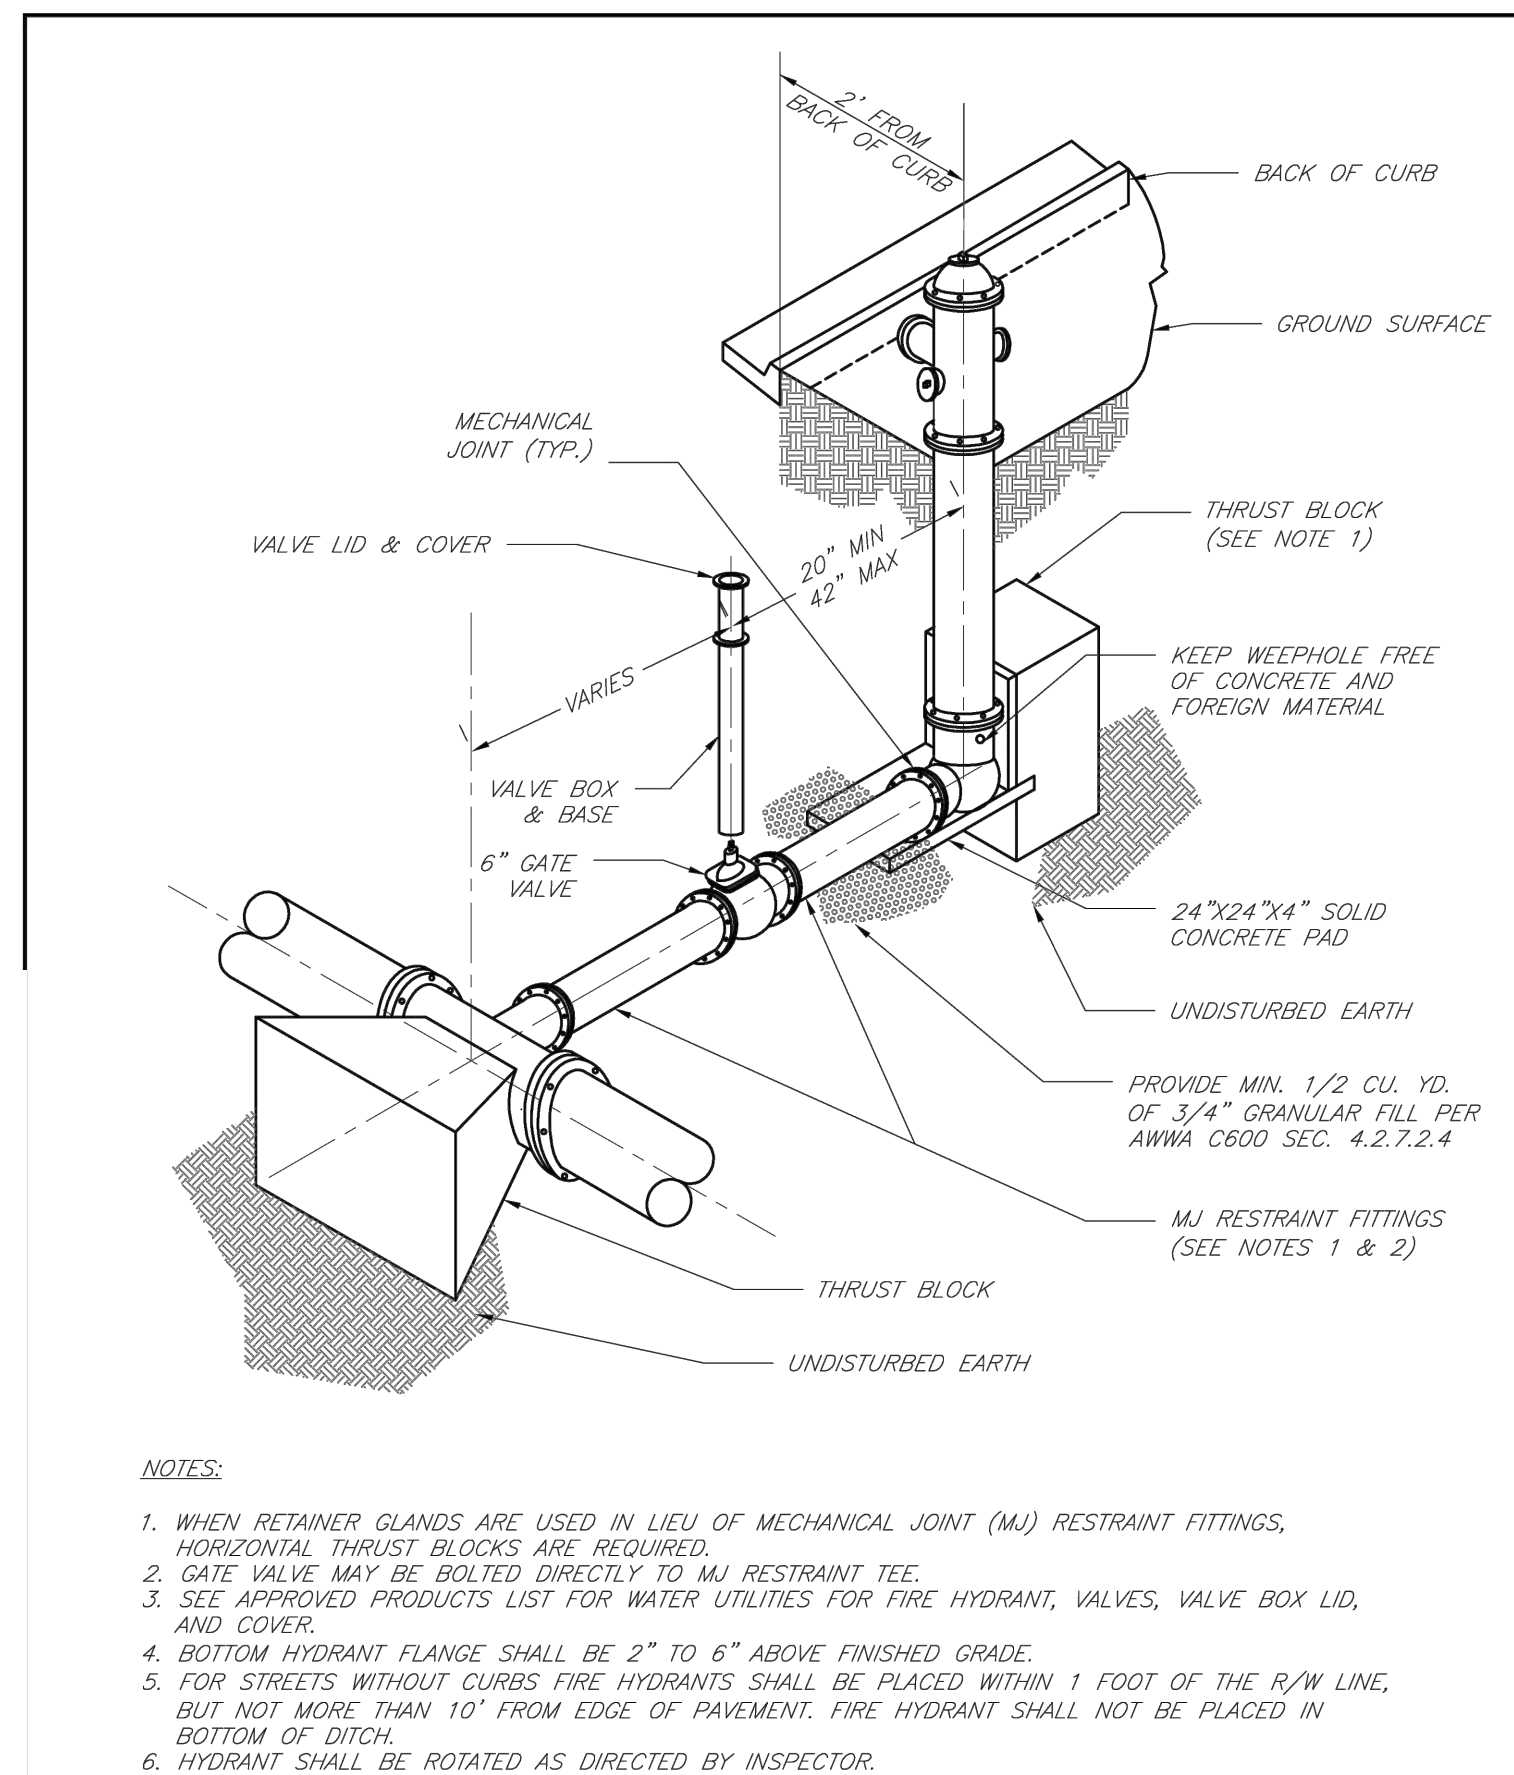


NOTES:

- WHEN RETAINER GLANDS ARE USED IN LIEU OF MECHANICAL JOINT (MJ) RESTRAINT FITTINGS, HORIZONTAL THRUST BLOCKS ARE REQUIRED.
- GATE VALVE MAY BE BOLTED DIRECTLY TO MJ RESTRAINT TEE.
- SEE APPROVED PRODUCTS LIST FOR WATER UTILITIES FOR FIRE HYDRANT, VALVES, VALVE BOX LID, AND COVER.
- BOTTOM HYDRANT FLANGE SHALL BE 2" TO 6" ABOVE FINISHED GRADE.
- FOR STREETS WITHOUT CURBS FIRE HYDRANTS SHALL BE PLACED WITHIN 1 FOOT OF THE R/W LINE, BUT NOT MORE THAN 10' FROM EDGE OF PAVEMENT. FIRE HYDRANT SHALL NOT BE PLACED IN BOTTOM OF DITCH.
- HYDRANT SHALL BE ROTATED AS DIRECTED BY INSPECTOR.

LEE'S SUMMIT
MISSOURI
PUBLIC WORKS ENGINEERING DIVISION | 220 SE GREEN STREET | LEE'S SUMMIT, MO 64063
HYDRANT INSTALLATION - STRAIGHT SET


Date: 02/13
Drawn By: JN
Checked By: DL
FILE: WAT-7
Rev: 1/14
Rev:

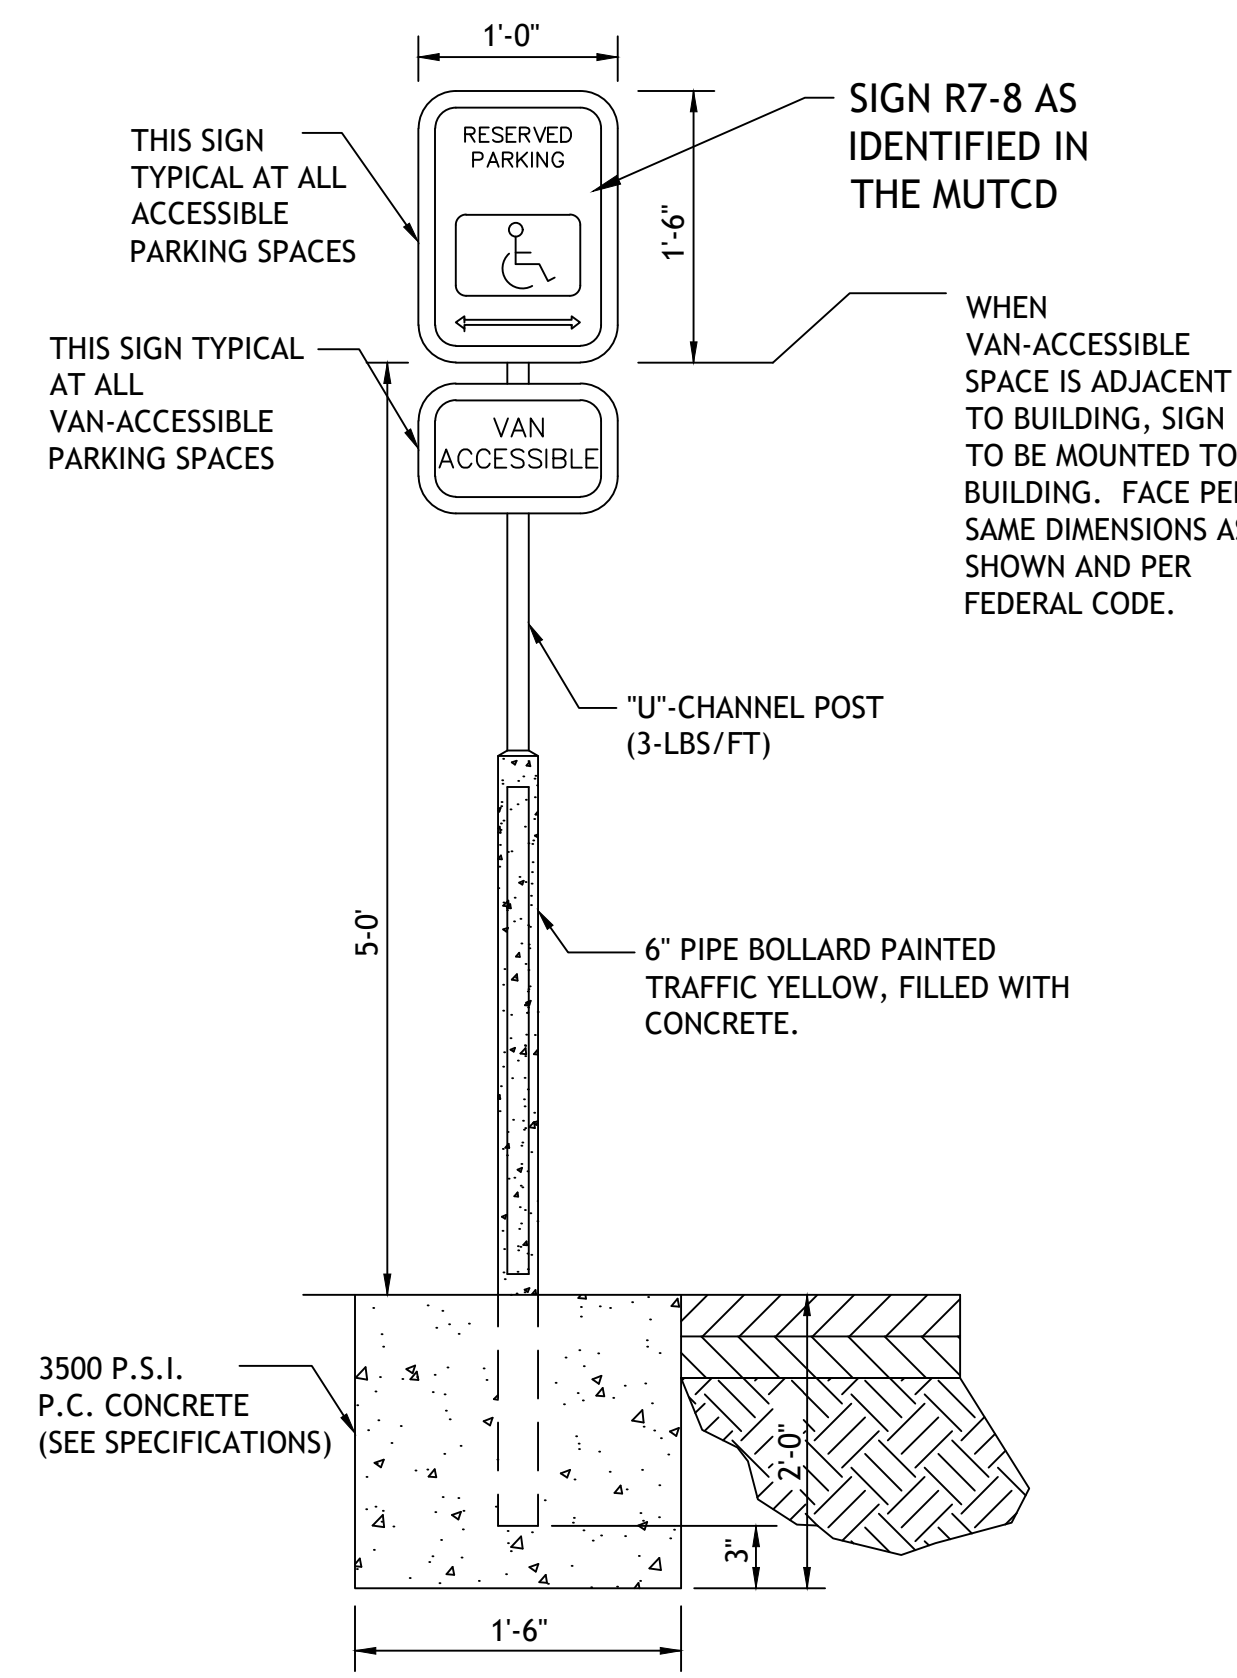

ACCESSIBLE PARKING SIGN

PK2

LOT 13A OF
WEST PRYOR

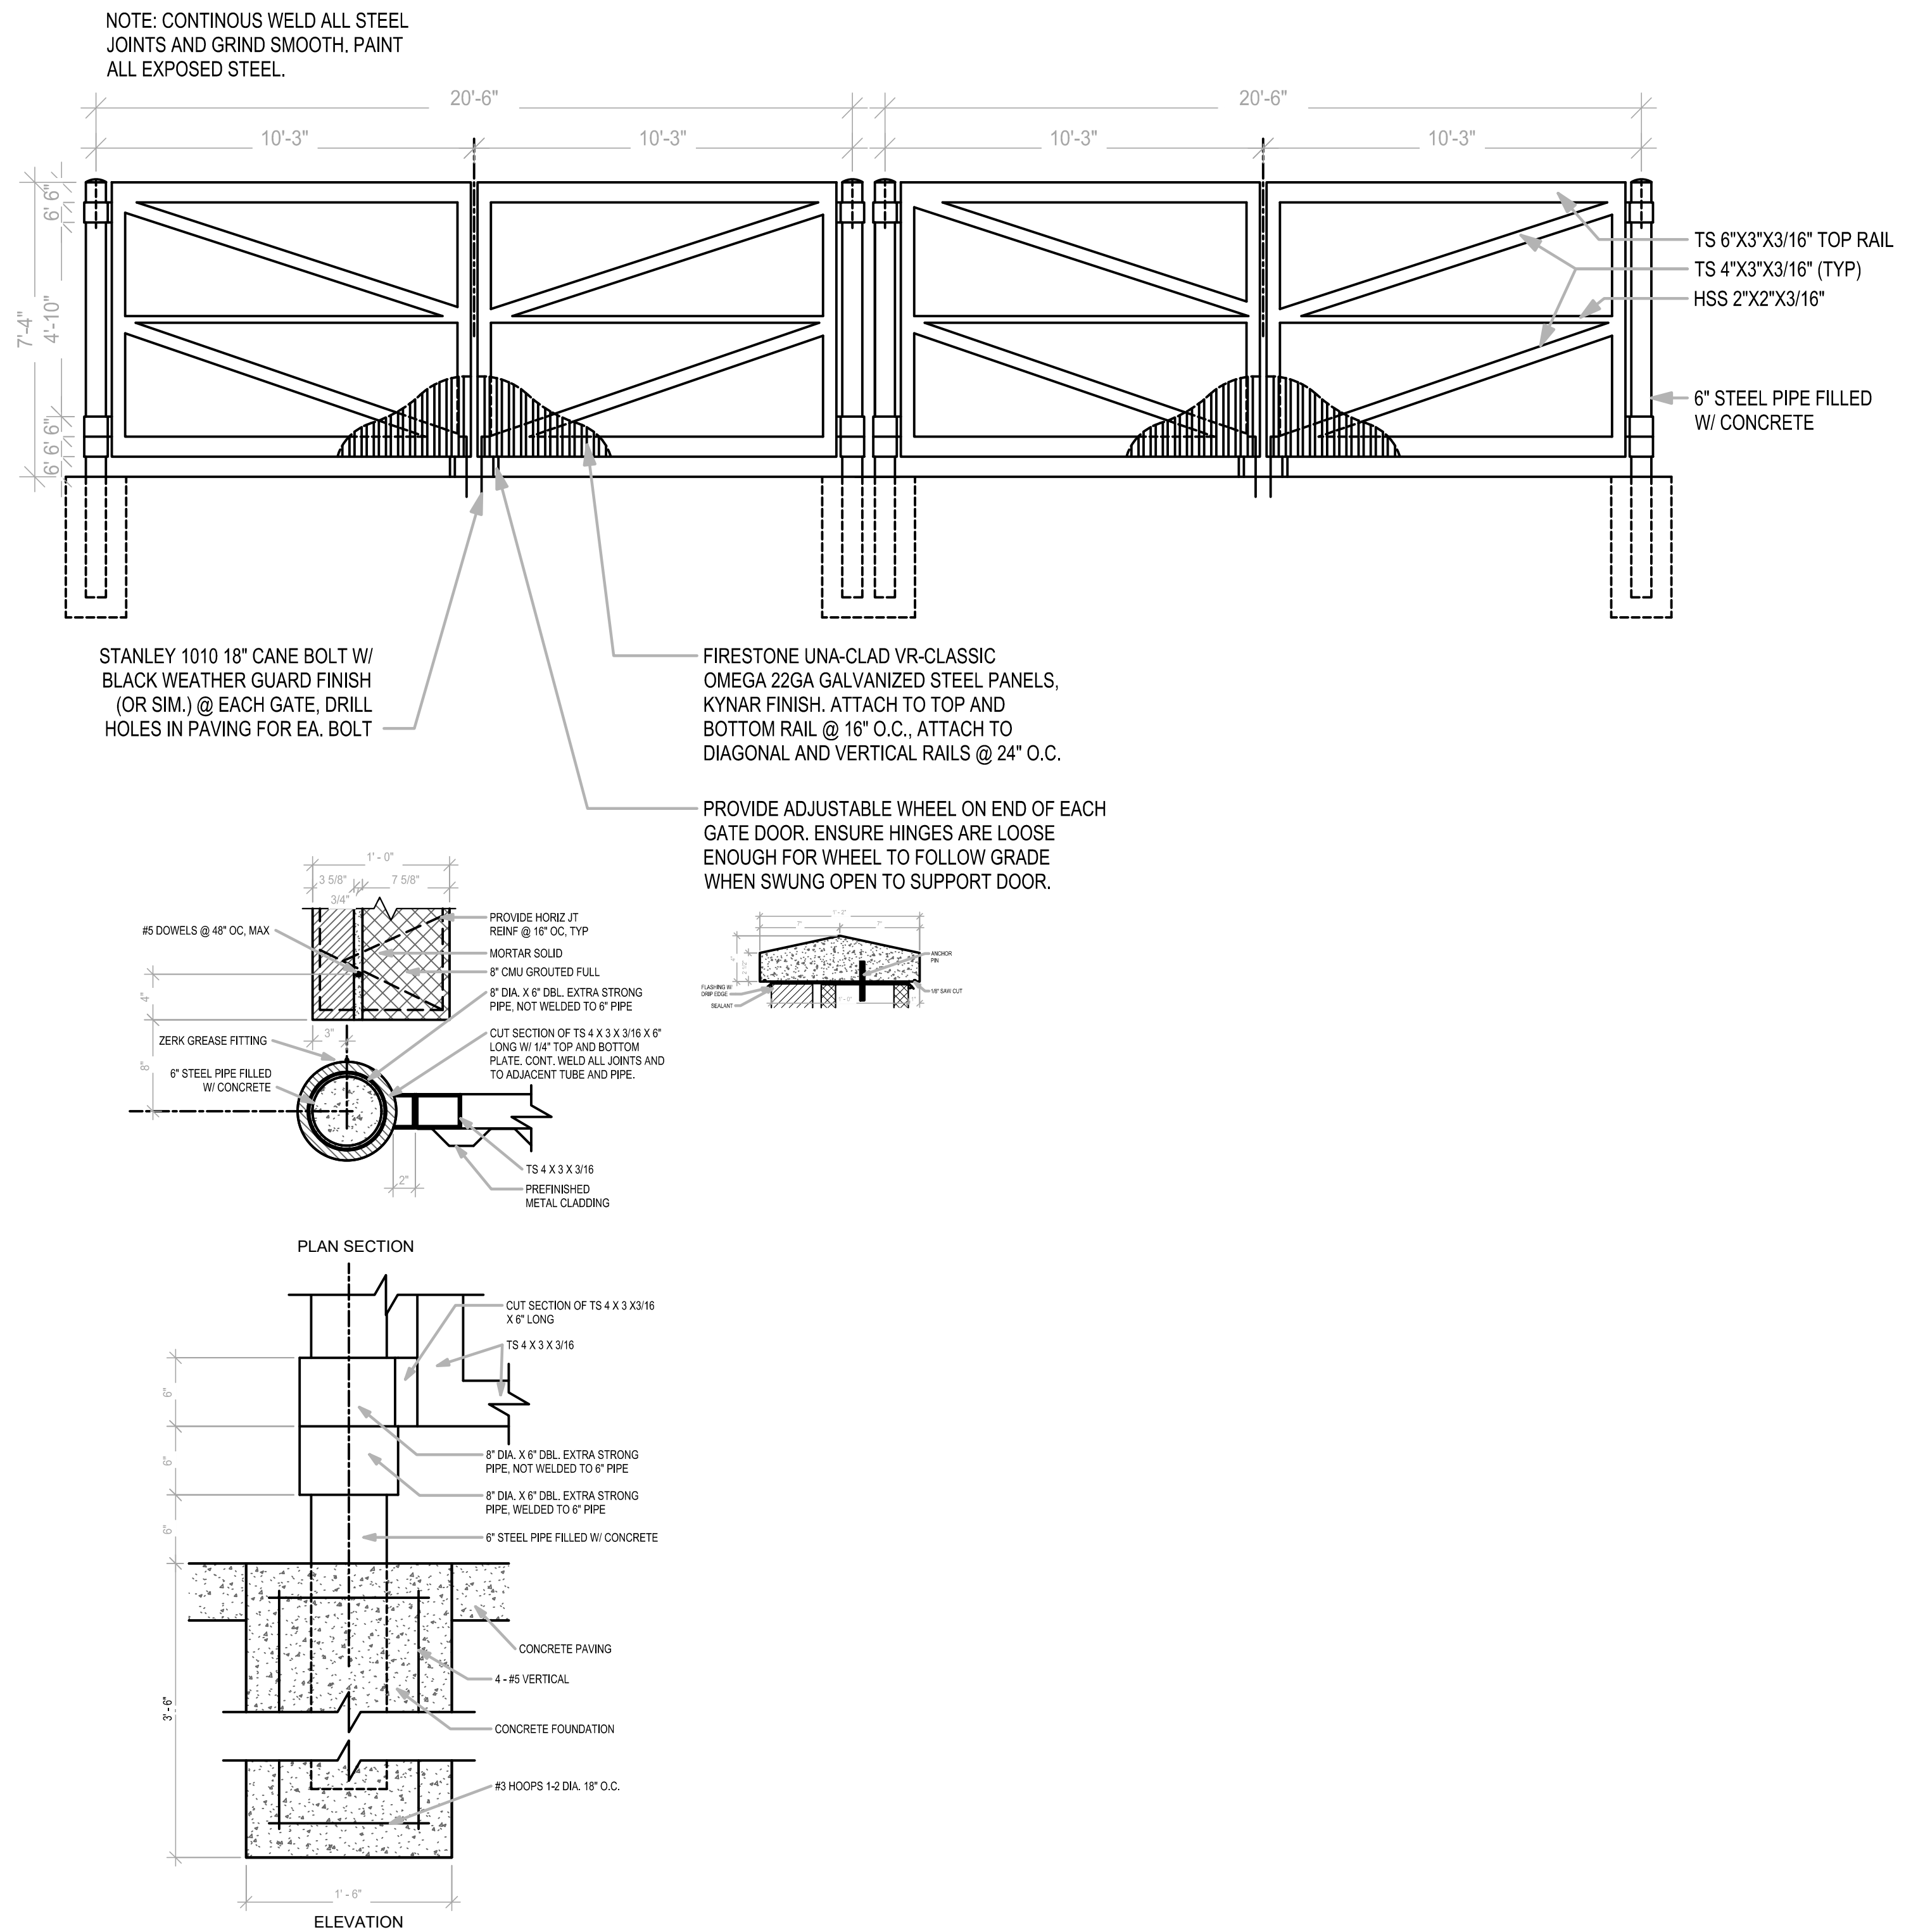

SM Engineering
SM
5507 High Meadow Circle
Manhattan Kansas, 66503
smcivilengr@gmail.com
785.341.9747


Drawings and/or Specifications are original
proprietary work and property of the
Engineer and intended specifically for this
project. Use of items contained herein
without consent of the Engineer is
prohibited. Drawings illustrate best
information available to the Engineer. Field
verification of actual elements, conditions,
and dimensions is required.

8/25/23
Professional Engineer
STATE OF MISSOURI
LEE'S SUMMIT, MISSOURI


Revisions
11-29-23 CITY COMMENTS

LOT 13A OF
WEST PRYOR
LEE'S SUMMIT, MISSOURI

sheet
C13.0
Civil
DETAILS
permit
19 OCTOBER 2023

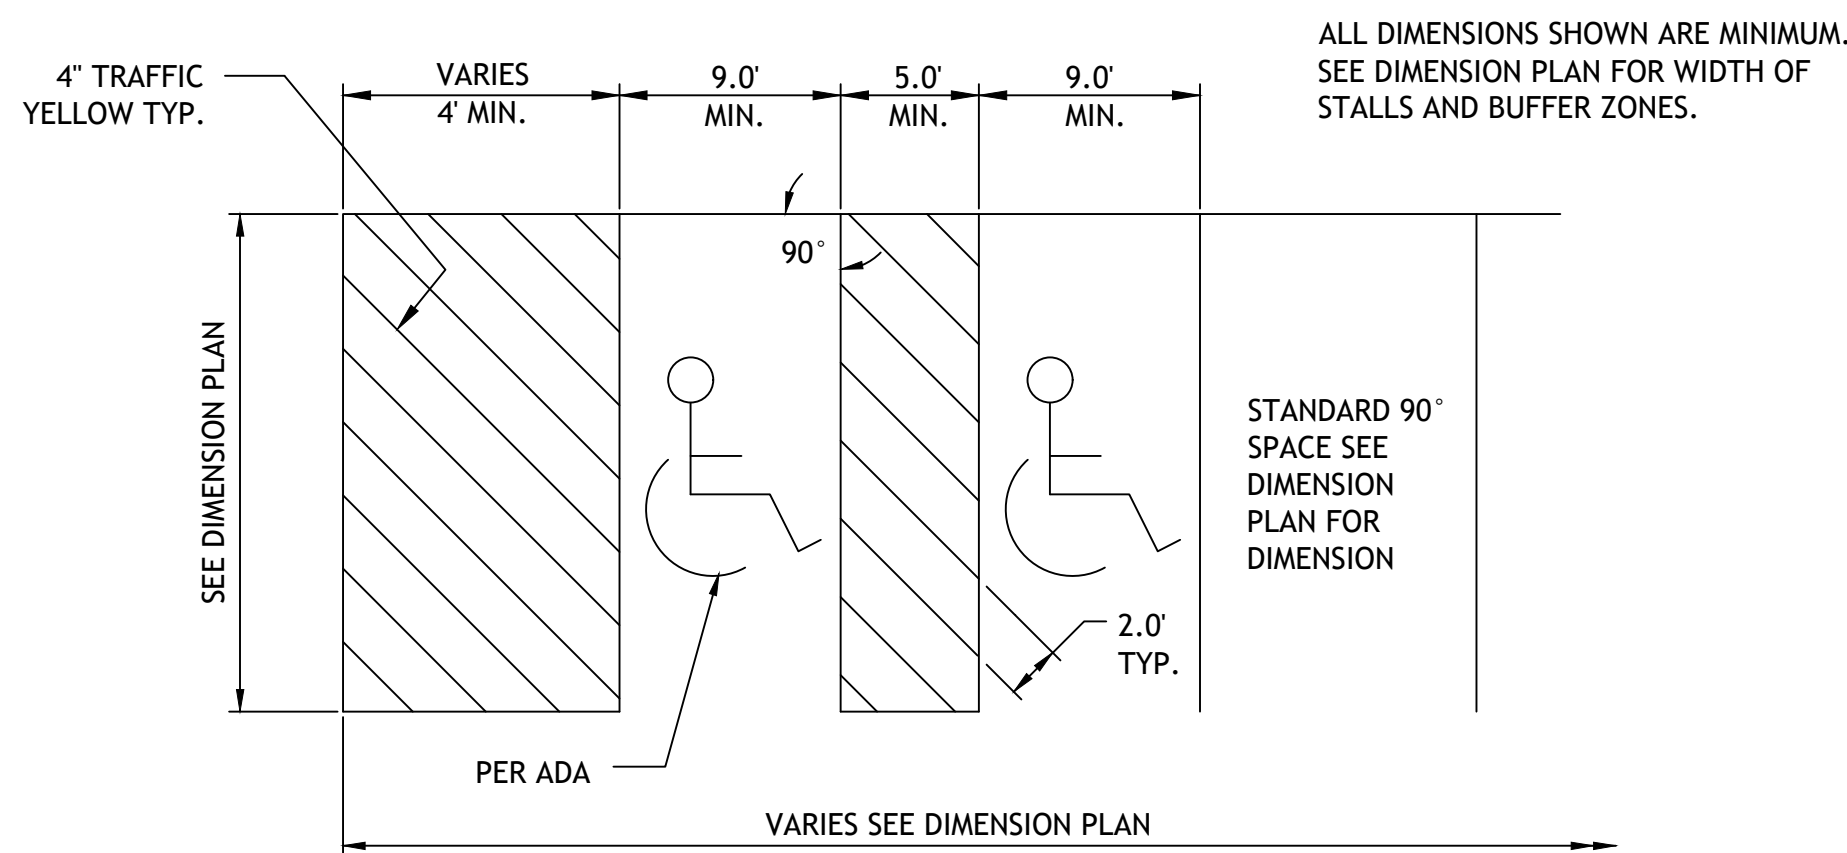


NOTE: PARKING SPACES AND ACCESS ISLES SHALL BE LEVEL
WITH SURFACE SLOPES NOT EXCEEDING 1:50 IN ALL
DIRECTIONS

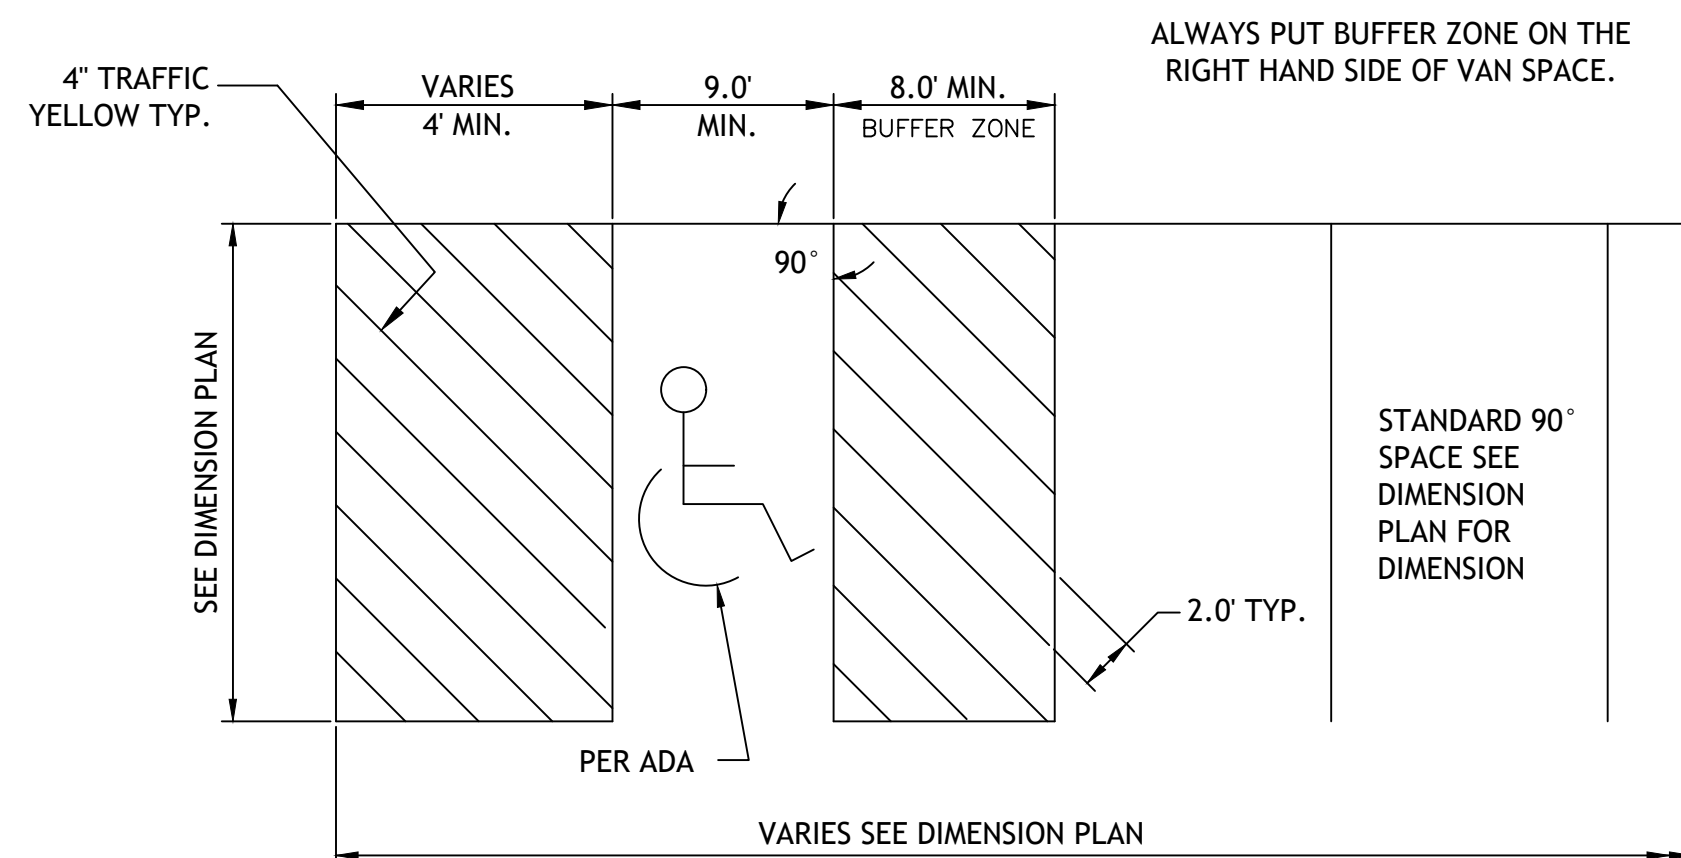



90° ACCESSIBLE & VAN ACCESSIBLE SPACE STRIPING

PK1

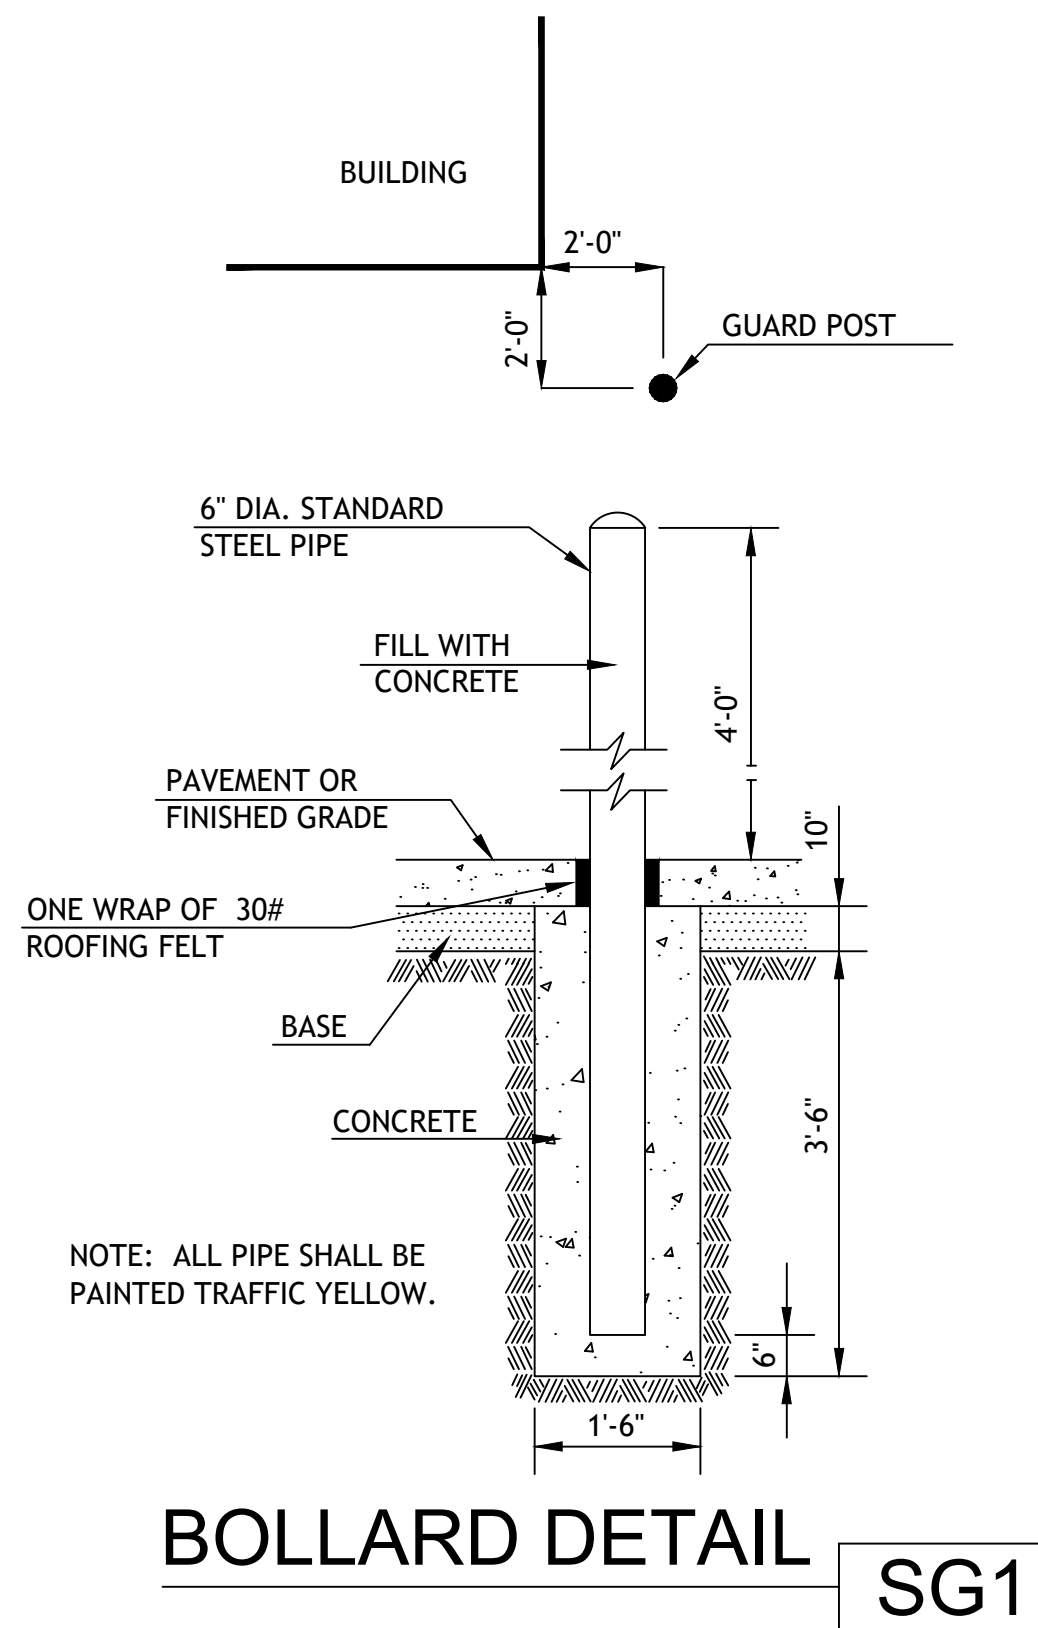


BOLLARD DETAIL

SG1

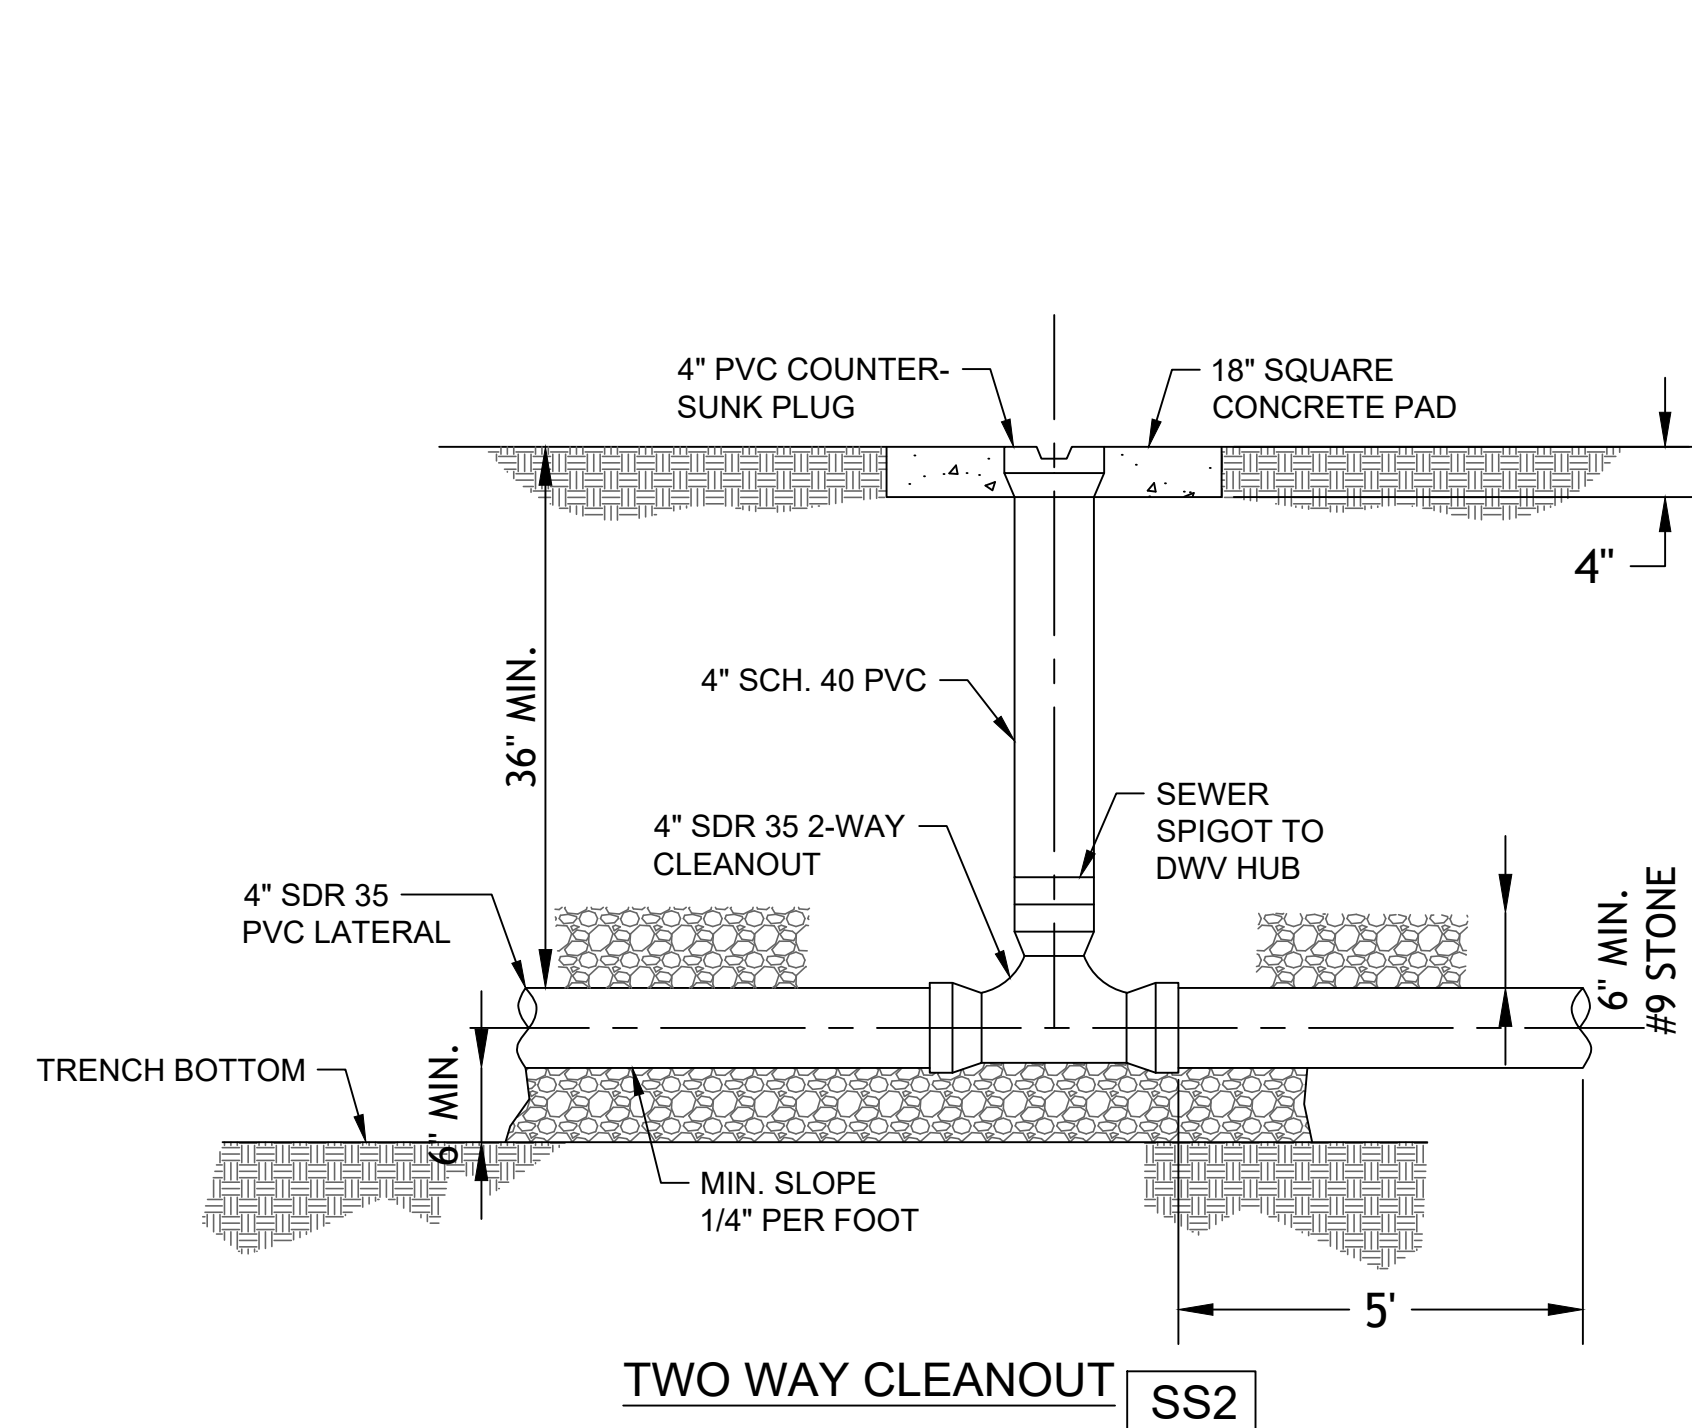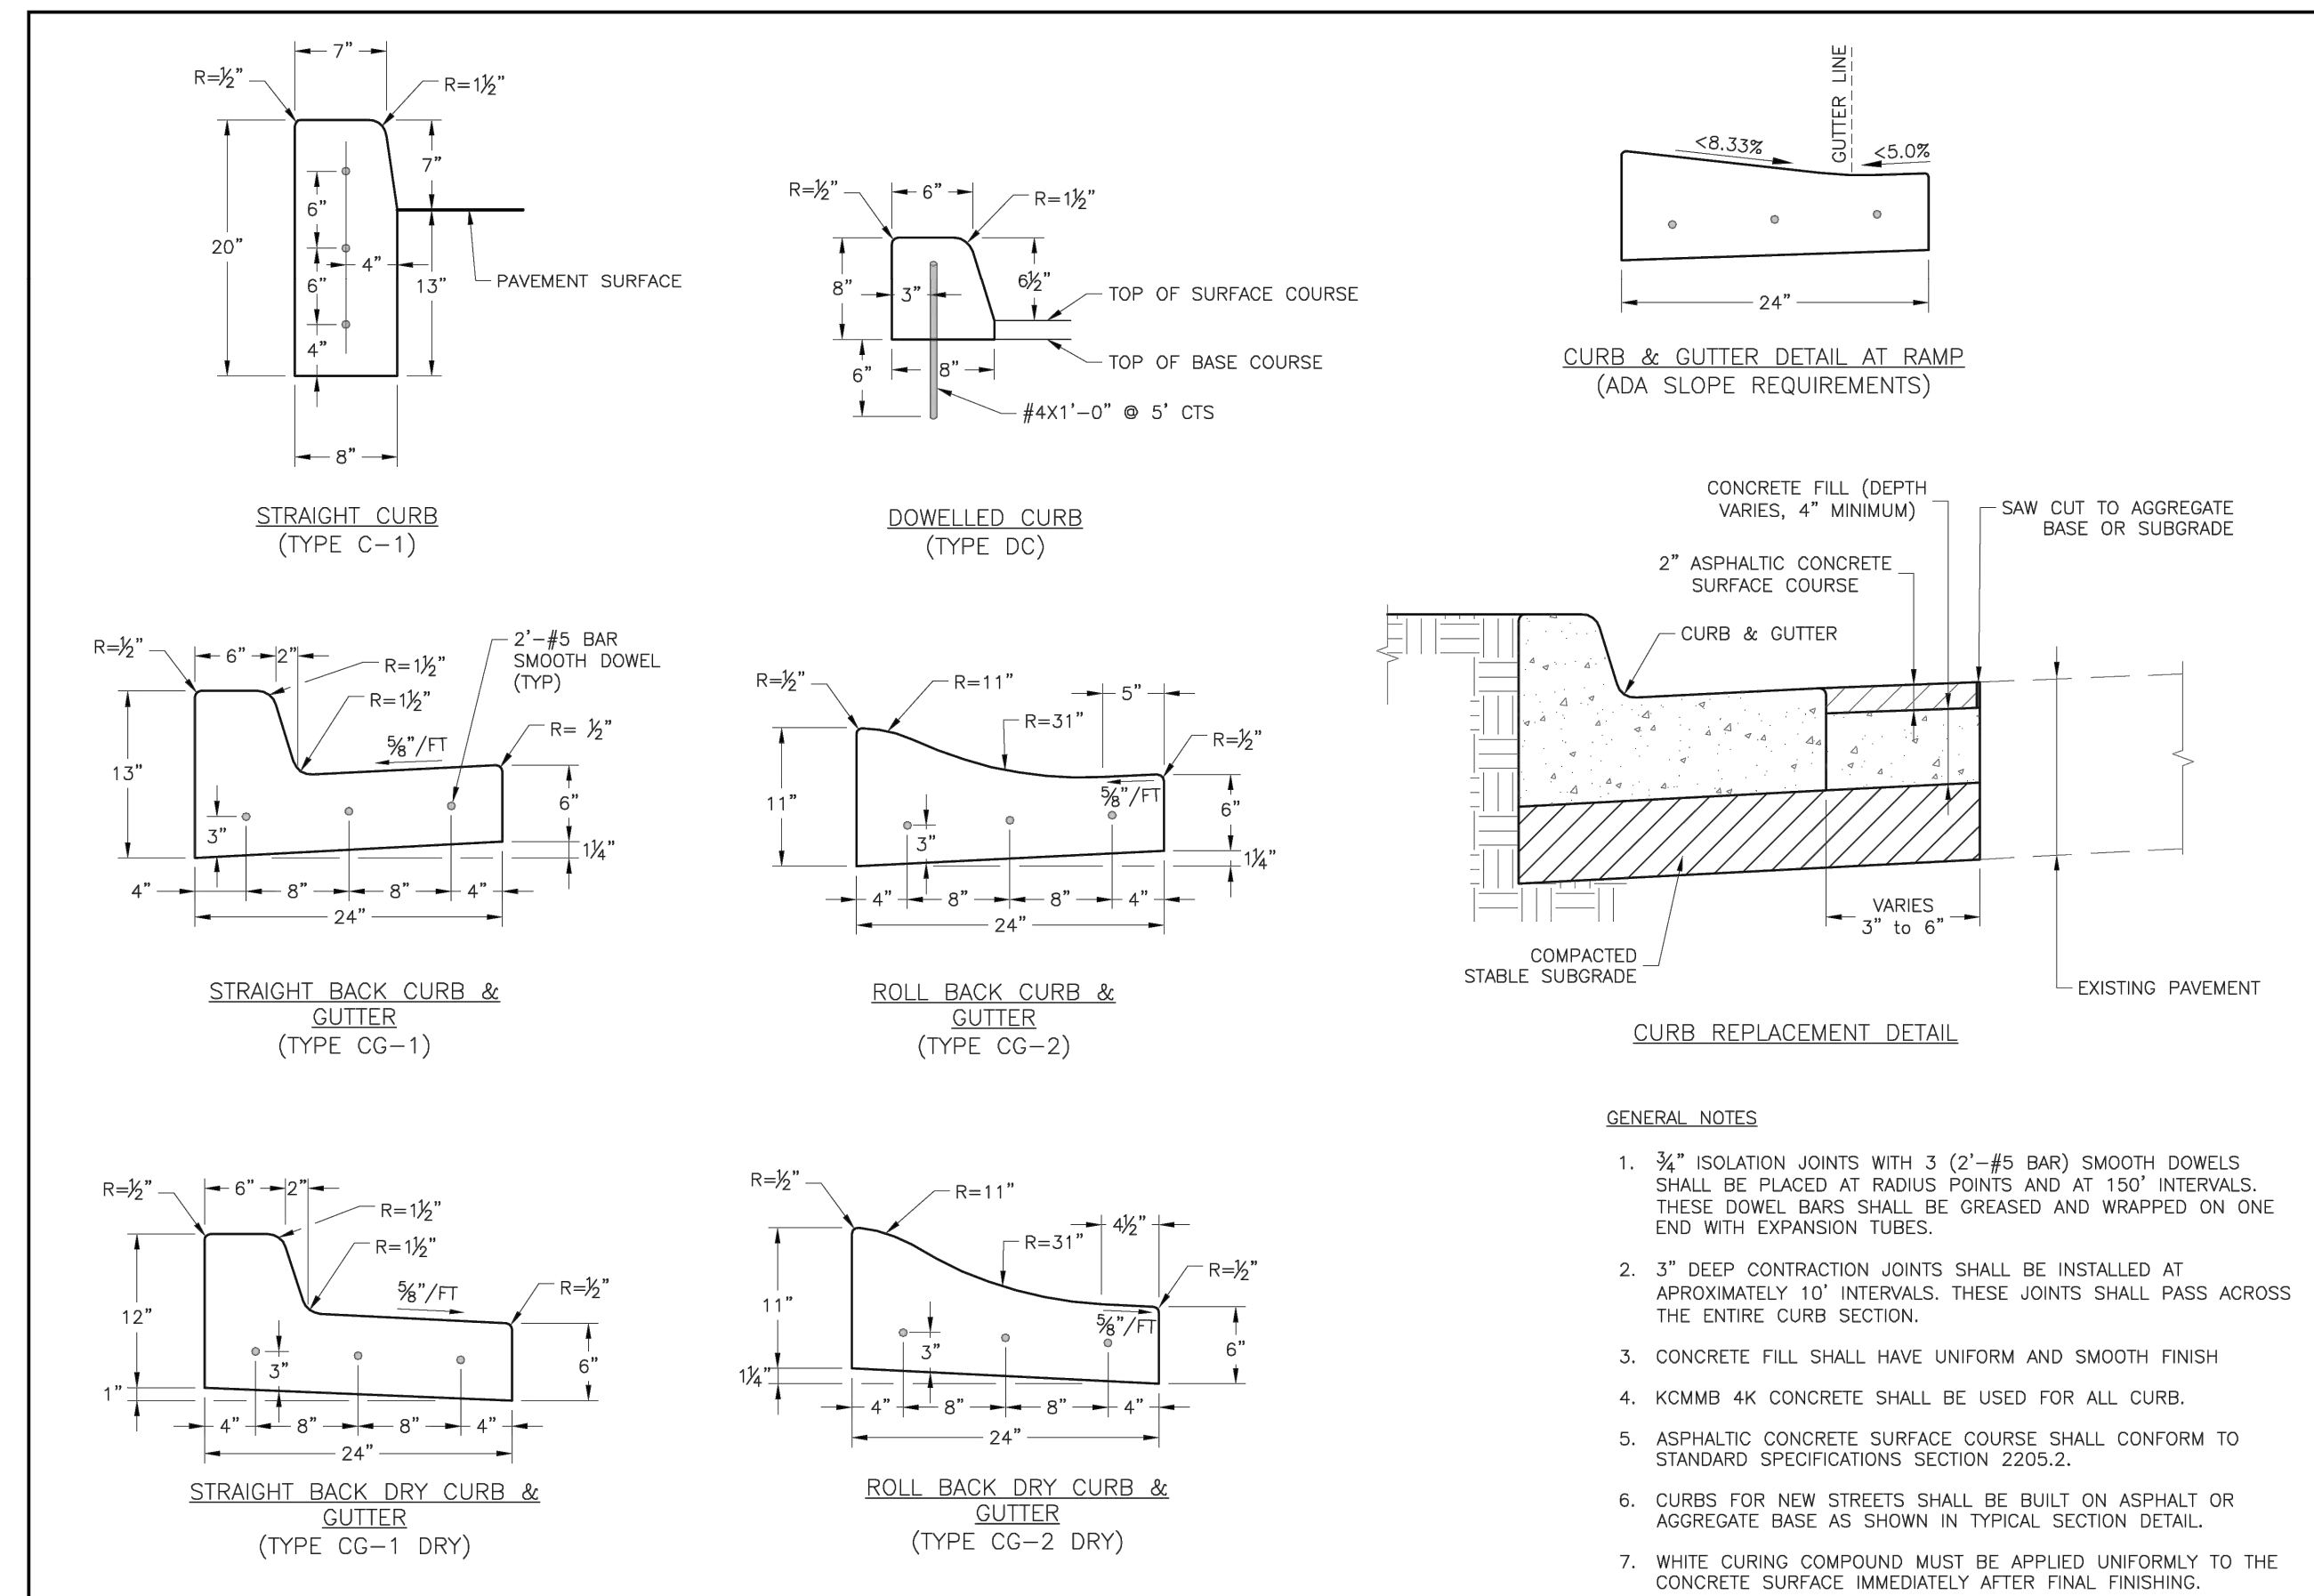


TWO WAY CLEANOUT

SS2

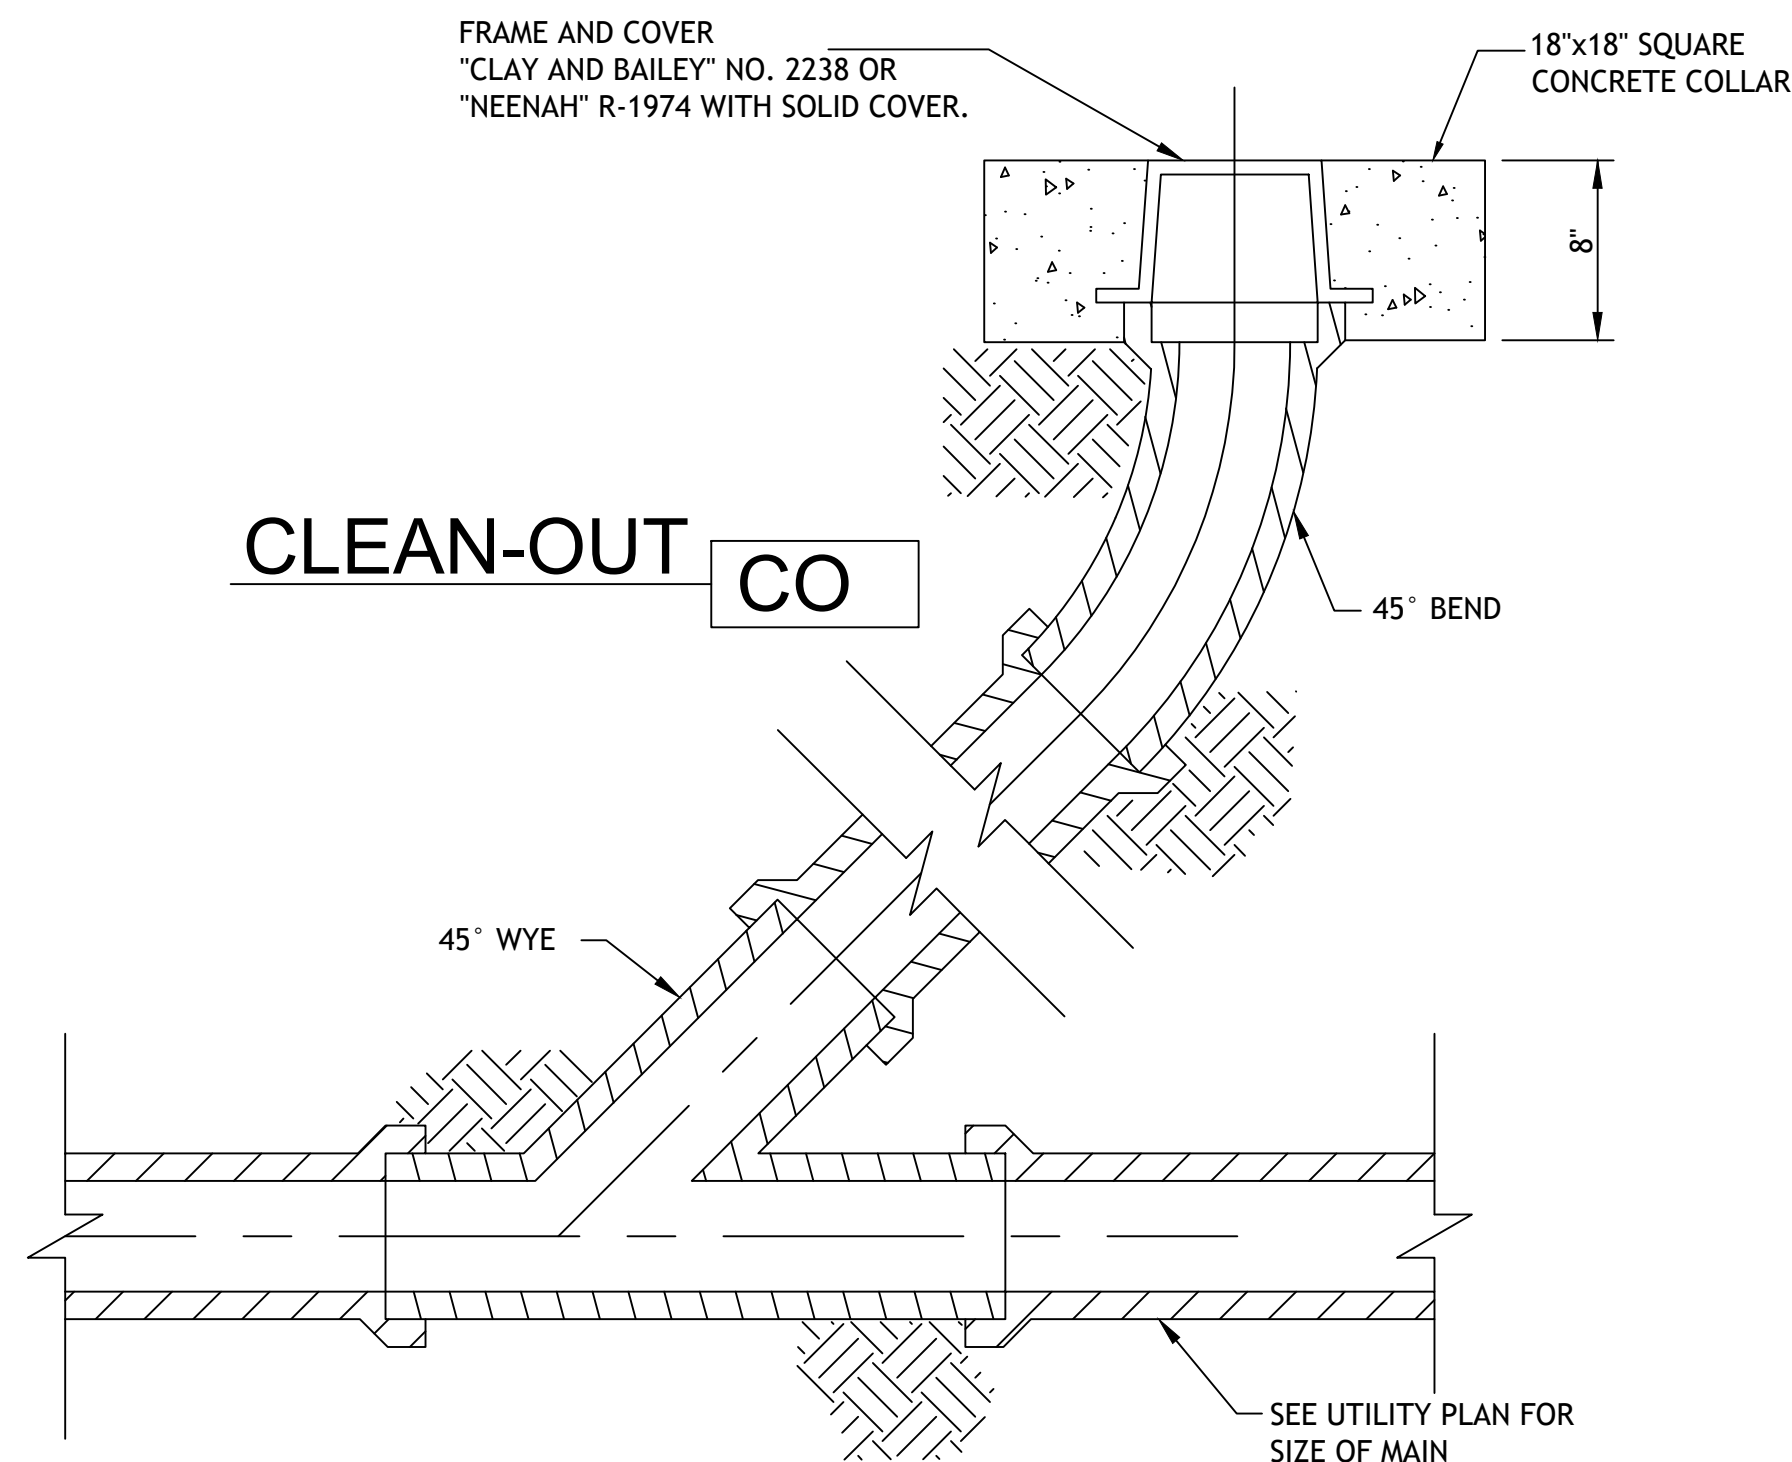


CLEAN-OUT

CO

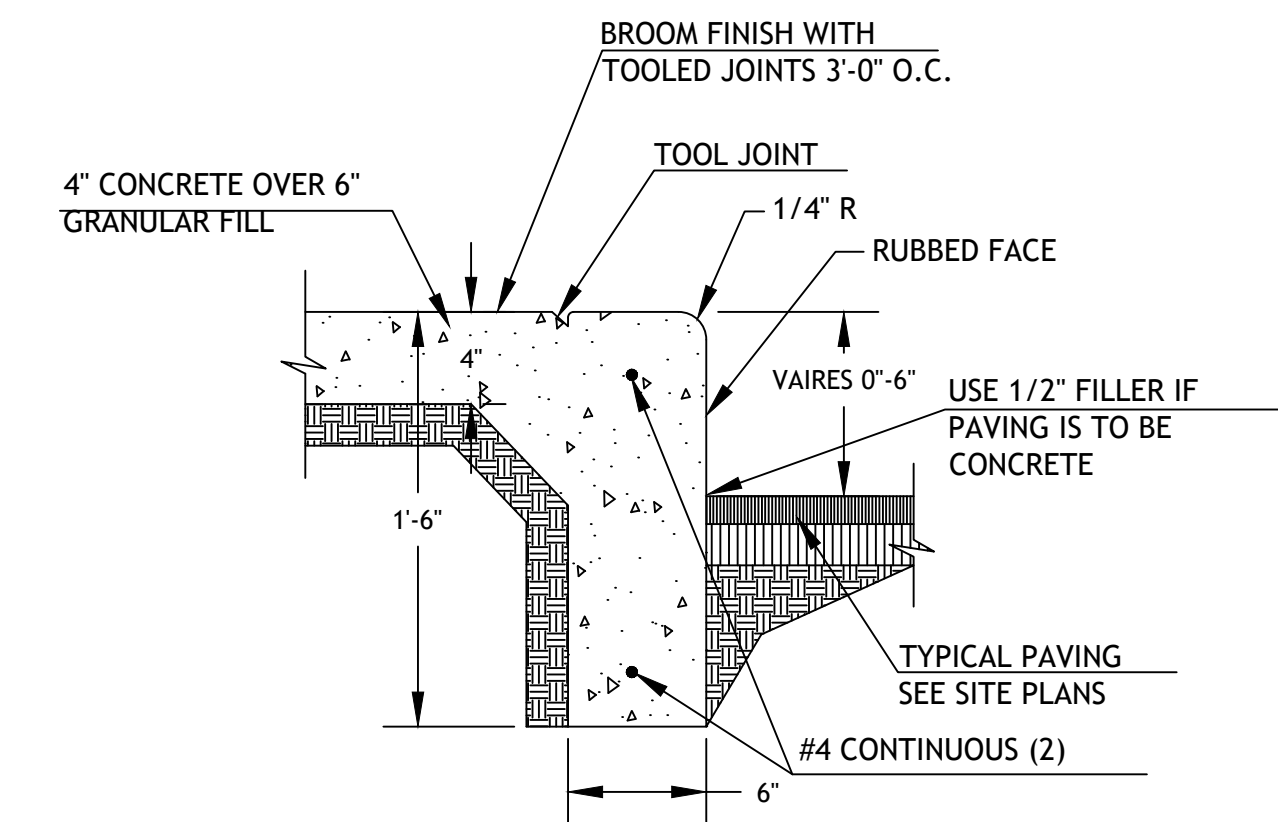

CURB WALK/CURB (AT BUILDING)

CW1

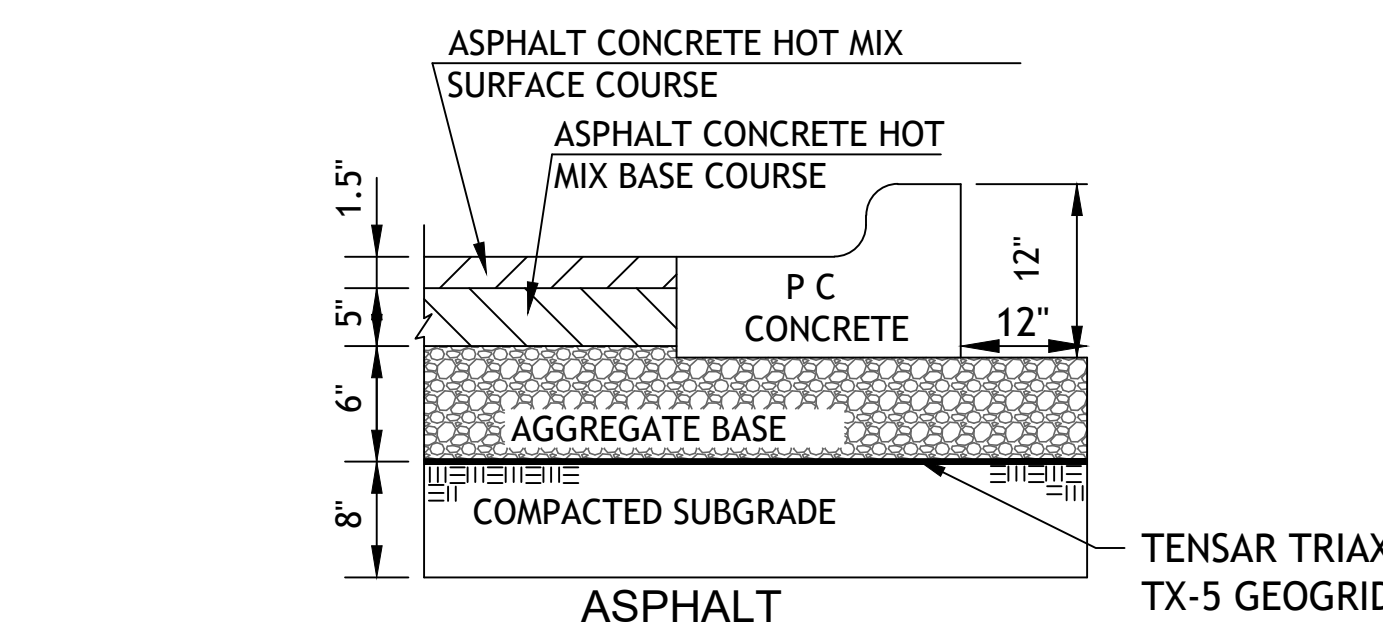

HEAVY DUTY ASPHALT PAVING

PV2

LANDSCAPE NOTES
CONTRACTOR REQUIRED TO LOCATE ALL UTILITIES BEFORE INSTALLATION TO BEGIN.

Contractor shall verify all landscape material quantities and shall report any discrepancies to the Landscape Architect prior to installation.

No plant material substitutions are allowed without Landscape Architect or Owners approval.

Contractor shall guarantee all landscape work and plant material for a period of one year from date of acceptance of the work by the Owner. Any plant material which dies during the one year guarantee period shall be replaced by the contractor during normal planting seasons.

Contractor shall be responsible for maintenance of the plants until completion of the job and acceptance by the Owner.

Successful landscape contractor shall be responsible for design that complies with minimum irrigation requirements, and installation of an irrigation system. Irrigation system to be approved by the owner before starting any installation.

All plant material shall be specimen quality stock as determined in the "American Standards For Nursery Stock" published by The American Association of Nurseryman, free of plant diseases and pest, of typical growth of the species and having a healthy, normal root system.

Sizes indicated on the plant list are the minimum, acceptable size. In no case will sizes less than specified be accepted.

All shrub beds within lawn areas to receive a manicured edge.

All shrub beds shall be mulched with 3" of shredded chocolate mulch.

All sod areas to be fertilized & sodded with a Turf-Type-Tall Fescue seed blend.

All areas to be sodded unless noted otherwise.

All seed areas shall be hydro-seeded with a Turf-Type-Tall Fescue seed blend.

IRRIGATION NOTE

1. SUCCESSFUL LANDSCAPE CONTRACTOR SHALL BE RESPONSIBLE FOR DESIGN THAT COMPLIES WITH MINIMUM IRRIGATION REQUIREMENTS, AND INSTALLATION OF AN IRRIGATION SYSTEM. IRRIGATION SYSTEM TO BE APPROVED BY THE OWNER BEFORE STARTING ANY INSTALLATION.
2. IRRIGATION SYSTEM SHALL PROVIDE A CONSTANT ON ON ZONE FOR FOUNTAIN
3. IRRIGATION CONTROLLER TO BE MOUNTED ON OUTSIDE WALL OF BUILDING. PROVIDE TEMPORARY SUPPORT PRIOR TO BUILDING CONSTRUCTION.
4. ALL AREAS WITHIN LOT 11 & 13 BOUNDARY TO BE IRRIGATED

MOWING NOTE

CONTRACTOR SHALL BE RESPONSIBLE FOR FIRST 2 MOWINGS OF ALL AREAS OF GRASS

LOT 13
470 HWY
REQUIRED:
STREET TREES 1/30' = 7
SHRUBS 1/20' = 11

PROVIDED:
ORNAMENTALS = 11
SHRUBS = 60




PRIVATE DR (SOUTH)
REQUIRED:
STREET TREES 1/30' = 14
SHRUBS 1/20' = 21

PROVIDED:
SHADE = 7
ORNAMENTALS = 7
SHRUBS = 30


INTERIOR PARKING
TOTAL PARKING SURFACE = 80,928 SF
REQUIRED
5% LANDSCAPE AREA = 4,046 SF
PROVIDED = 5,530 SF

OPEN SPACE TREES
OPEN SPACE
REQUIRED
TREES 1 / 5,000SF = 6
SHRUBS 2 / 5,000SF = 12

PROVIDED
SHADE TREES = 17
SHRUBS = 20

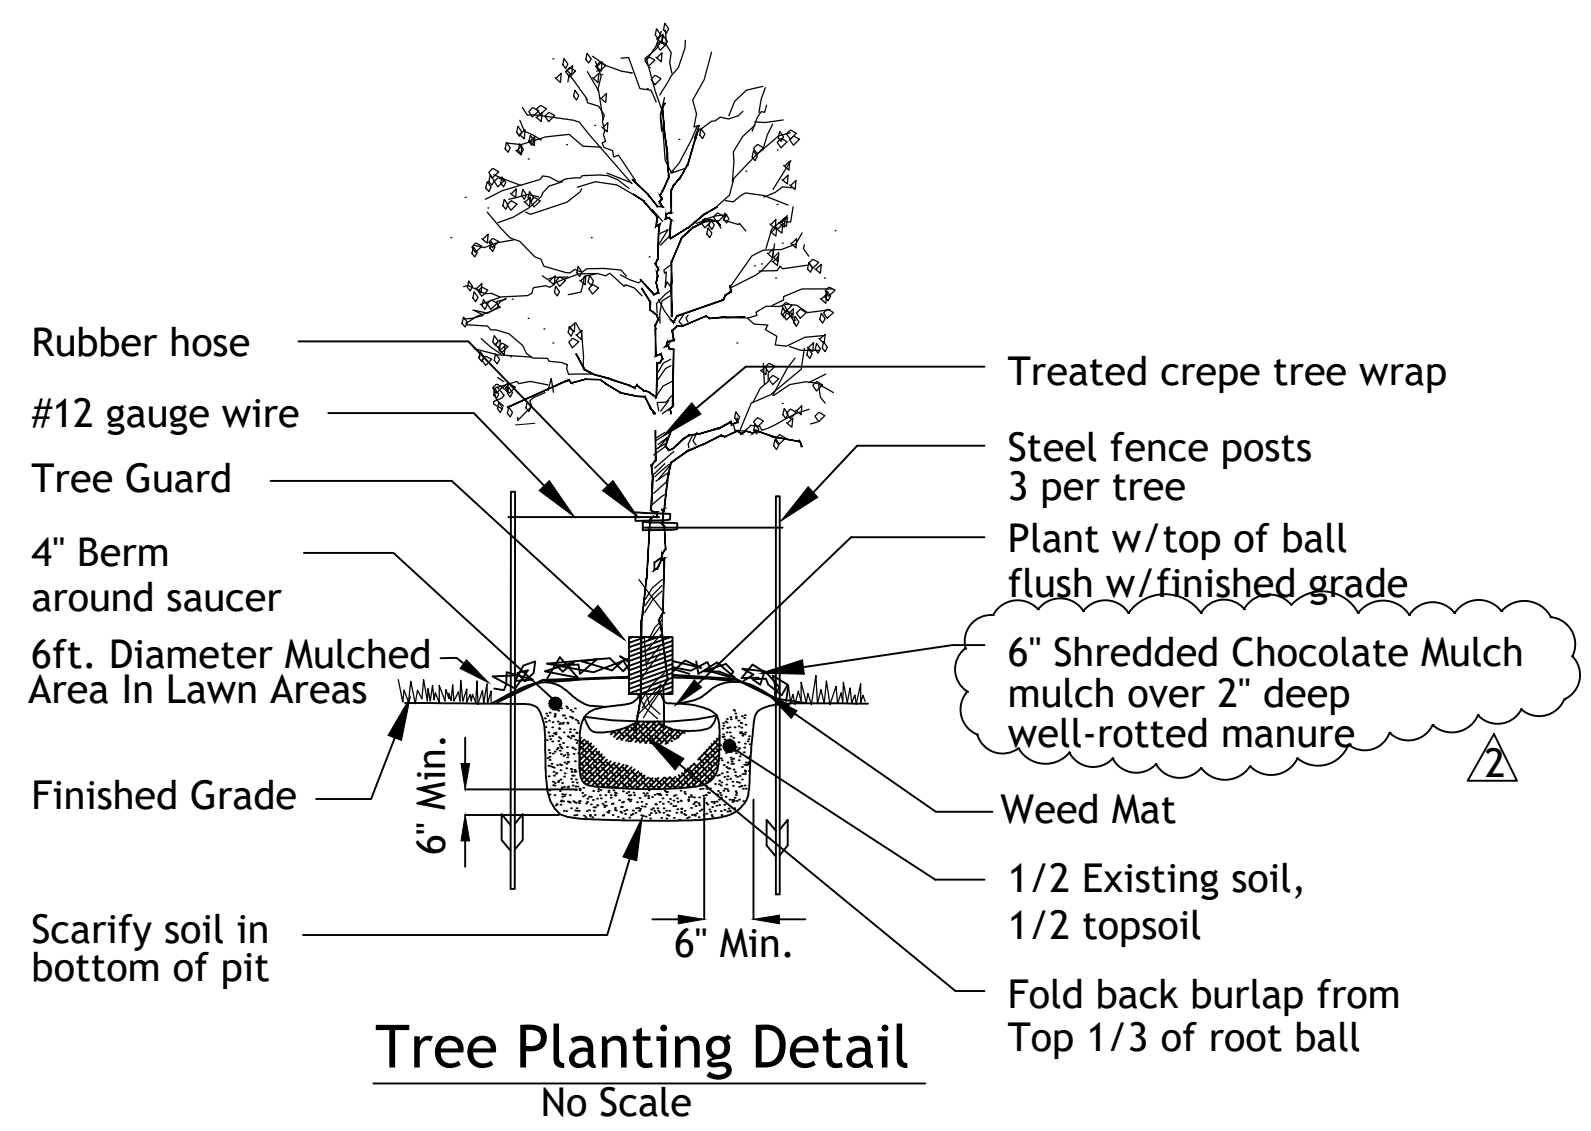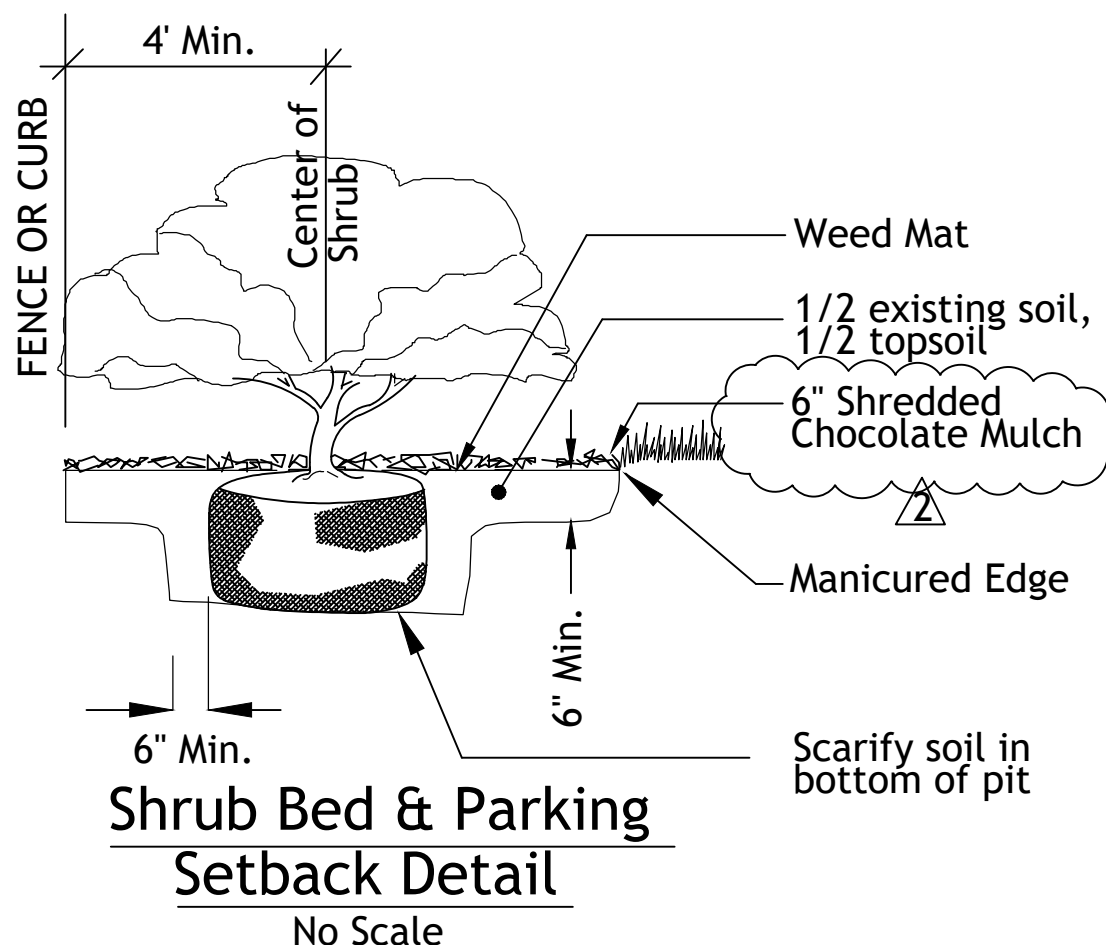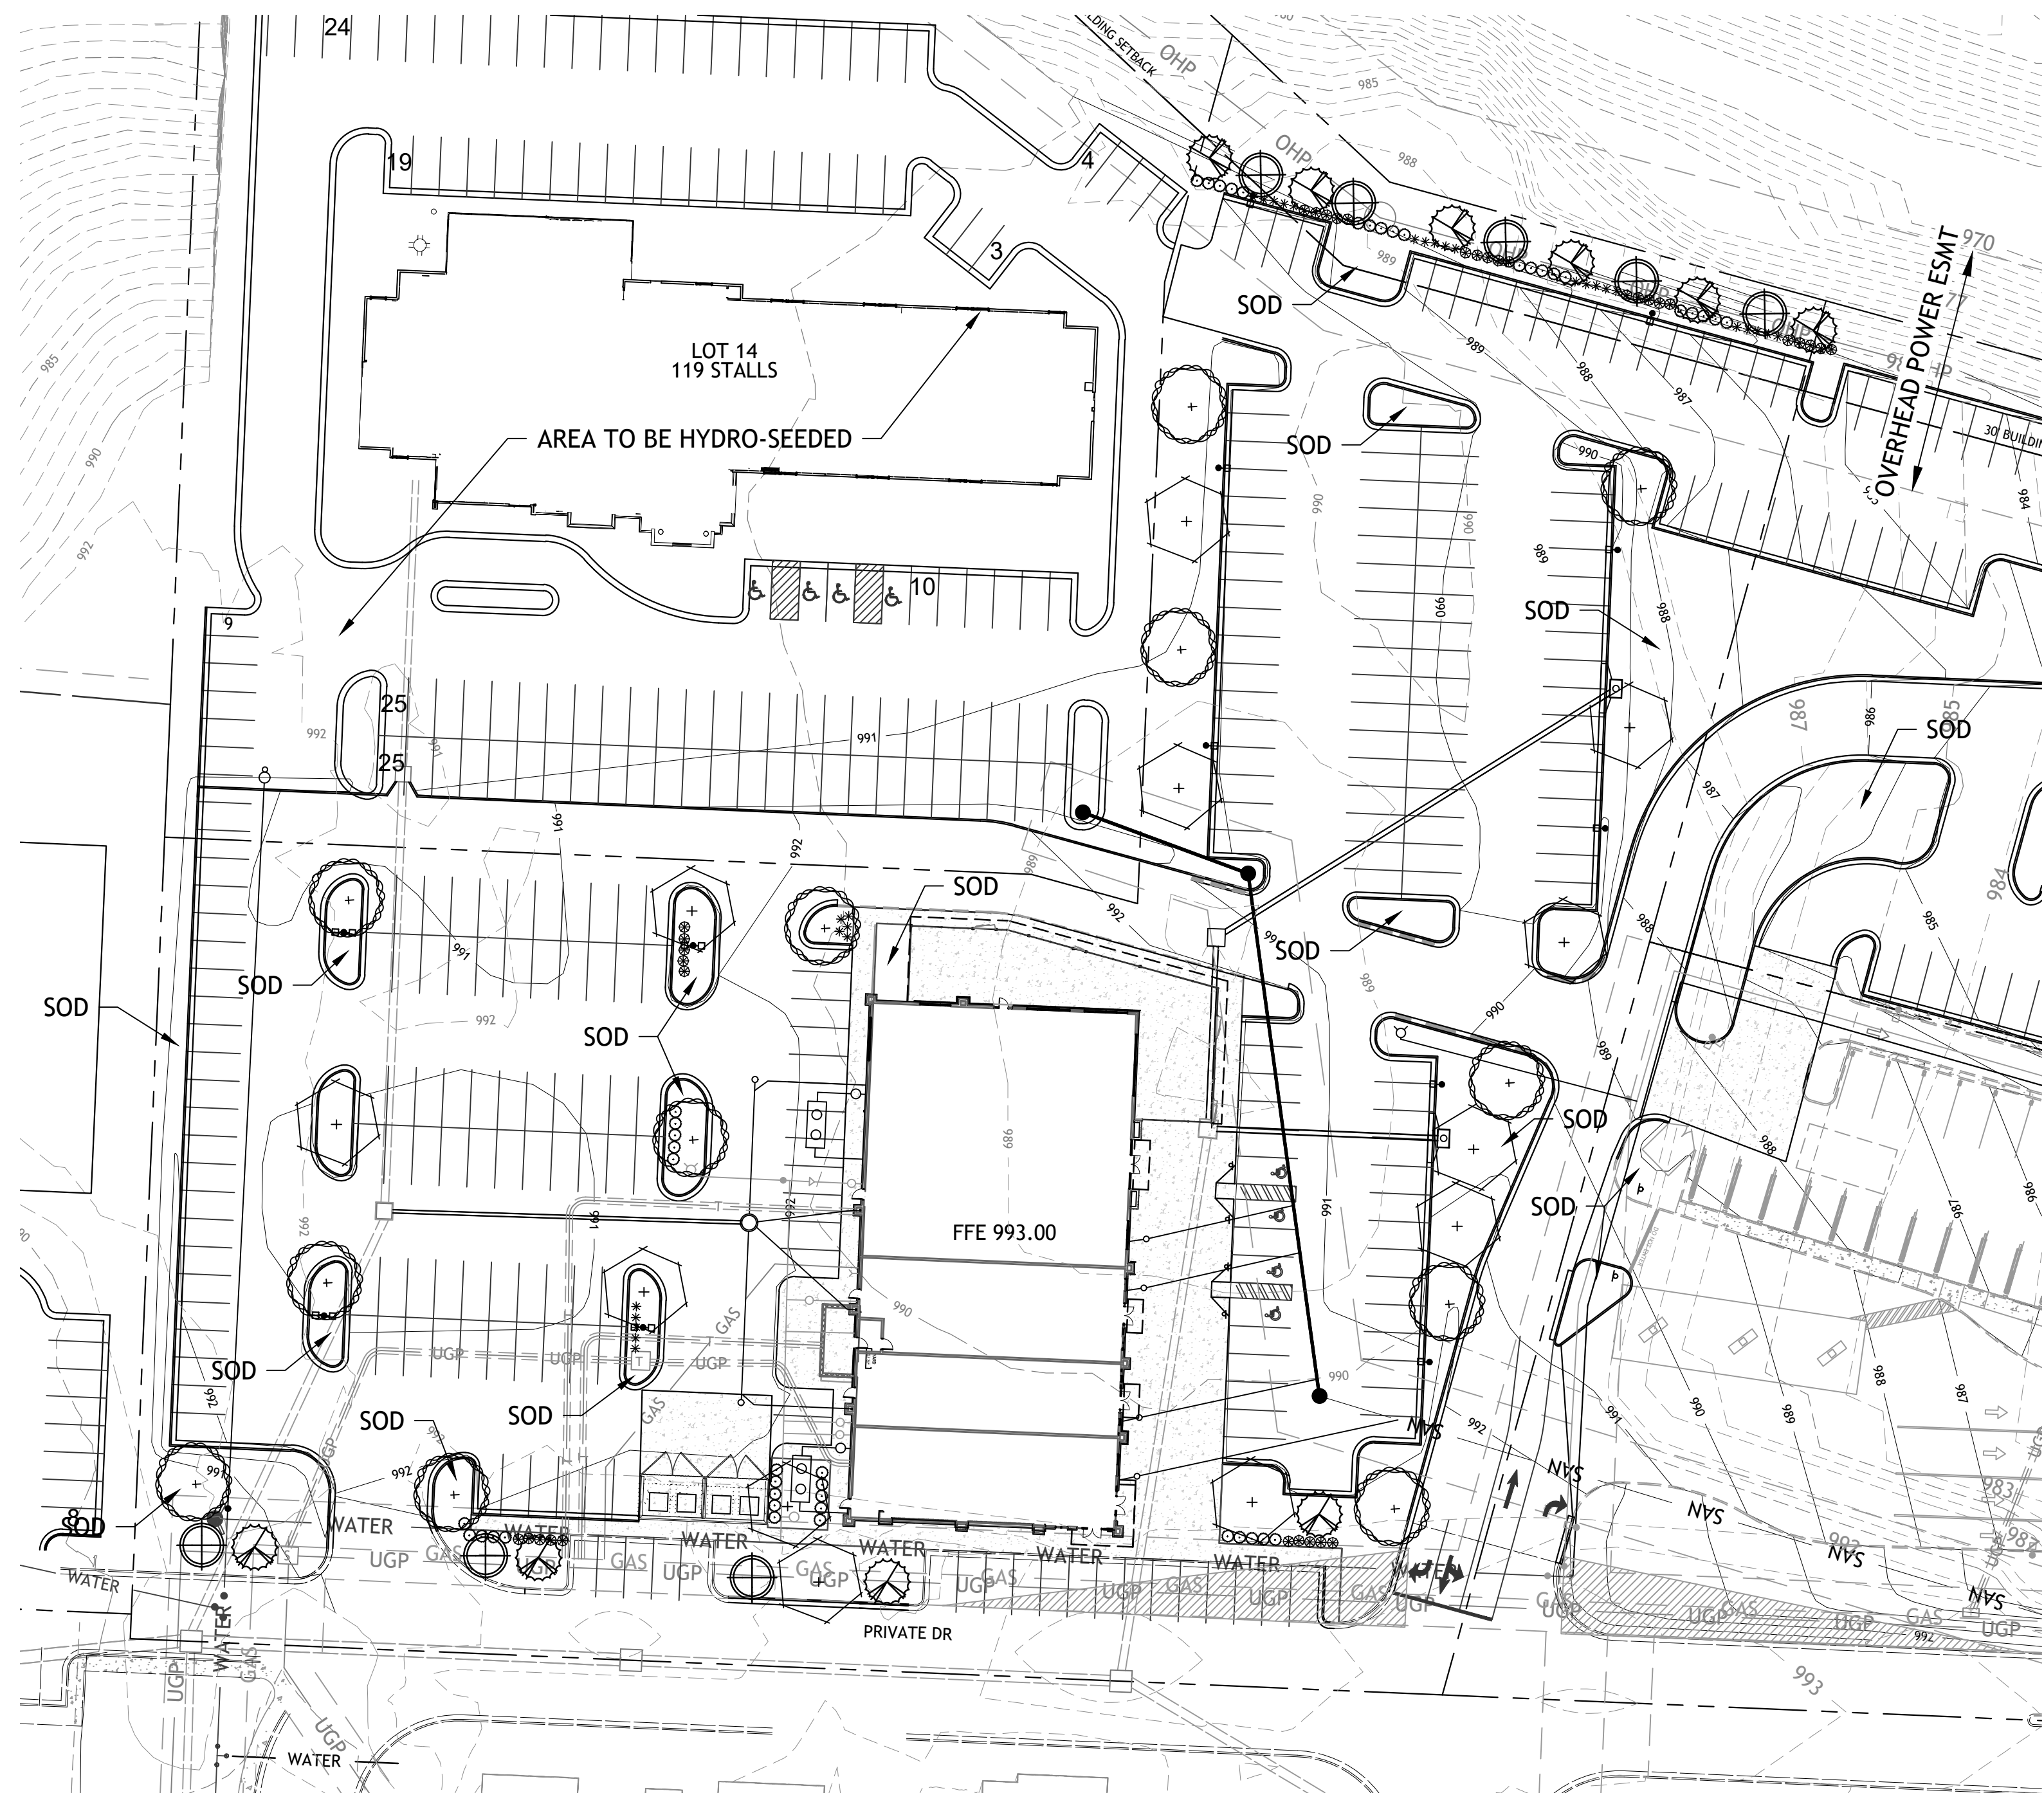

Typical Utility Box Screening Details


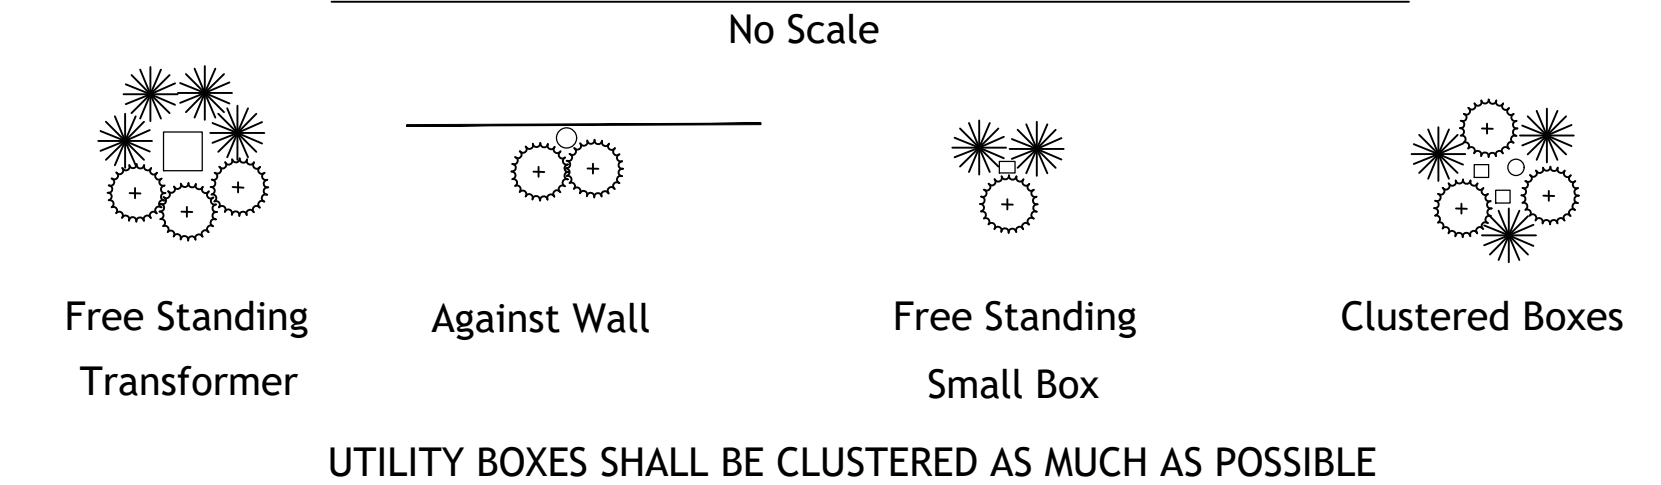


UTILITY BOXES SHALL BE CLUSTERED AS MUCH AS POSSIBLE


Tree List

Symbol	Quantity	Common Name	Botanical Name	Size	Condition	Spacing
	12	October Glory Maple	Acer Rubrum 'October Glory'	3" cal	BB	As Shown
	12	Skyline Honeylocust	Gleditsia Triacanthos 'Skyline'	3" cal	BB	As Shown
	10	Jane Magnolia Tree	Magnolia x 'Jane'	3"cal	BB	As Shown
	8	Black Diamond Purely Purple Crape Myrtle	Lagerstroemia x 'Purely Purple'	3"cal	BB	As Shown



Shrub List	Symbol	Quantity	Common Name	Botanical Name	Size	Condition	Spacing
	—	45	Seagreen Juniper	Juniperus Chinensis 'Seagreen'	18"-24"sp.	Cont.	4'o.c.
	—	35	Dwarf Winged Euonymus	Euonymus Alatus 'Compactus'	18"-24"sp.	Cont.	4'o.c.
	—	30	Morning Light Maiden Grass	Miscanthos Sinensis 'Morning Light'	18"-24"sp.	Cont.	4'o.c.

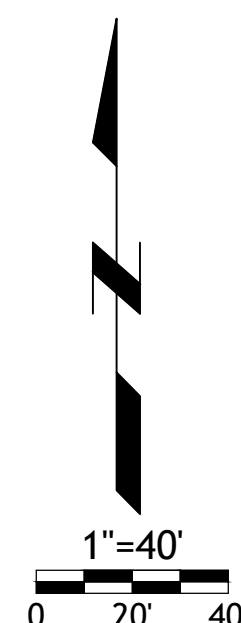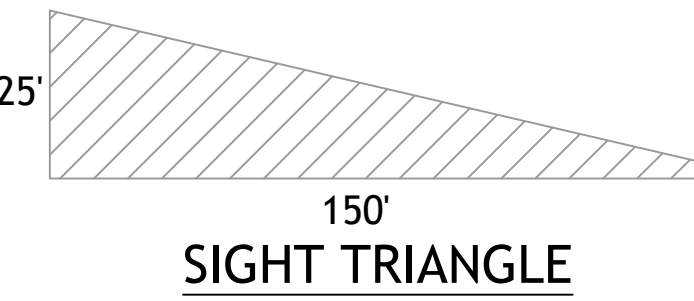


FILEPATH: F:\1_P\Projects\SDG\235008 SOWP Lot 13\05_Drawings - Working\Revit\235008 SOWP Lot 13_V23.rvt
DATE: 1/22/2024 11:07:42 AM
DRAWN BY: Author

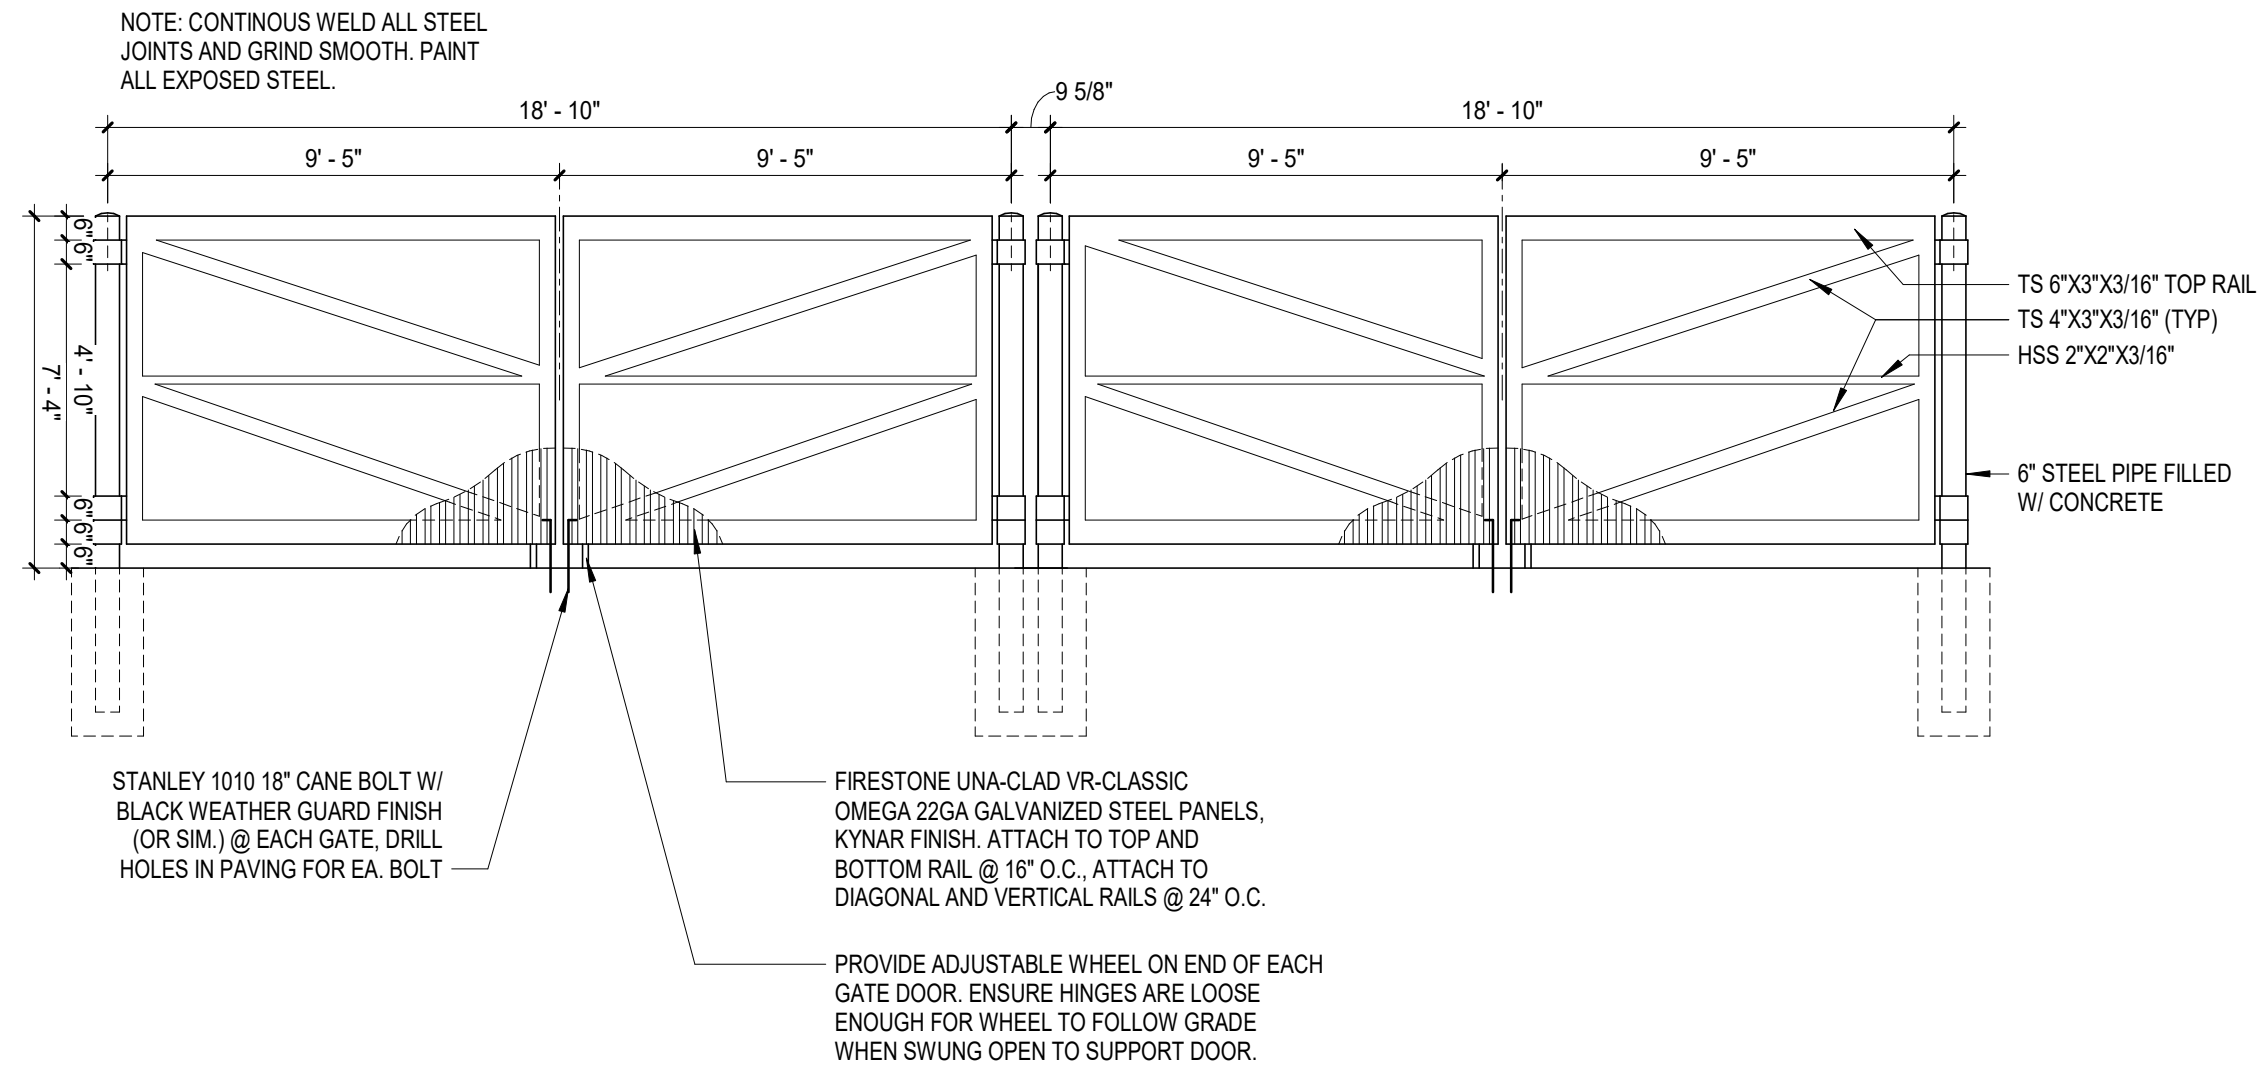


D1 TRASH ENCLOSURE GATE ELEVATION
SCALE: 1/4" = 1'-0"

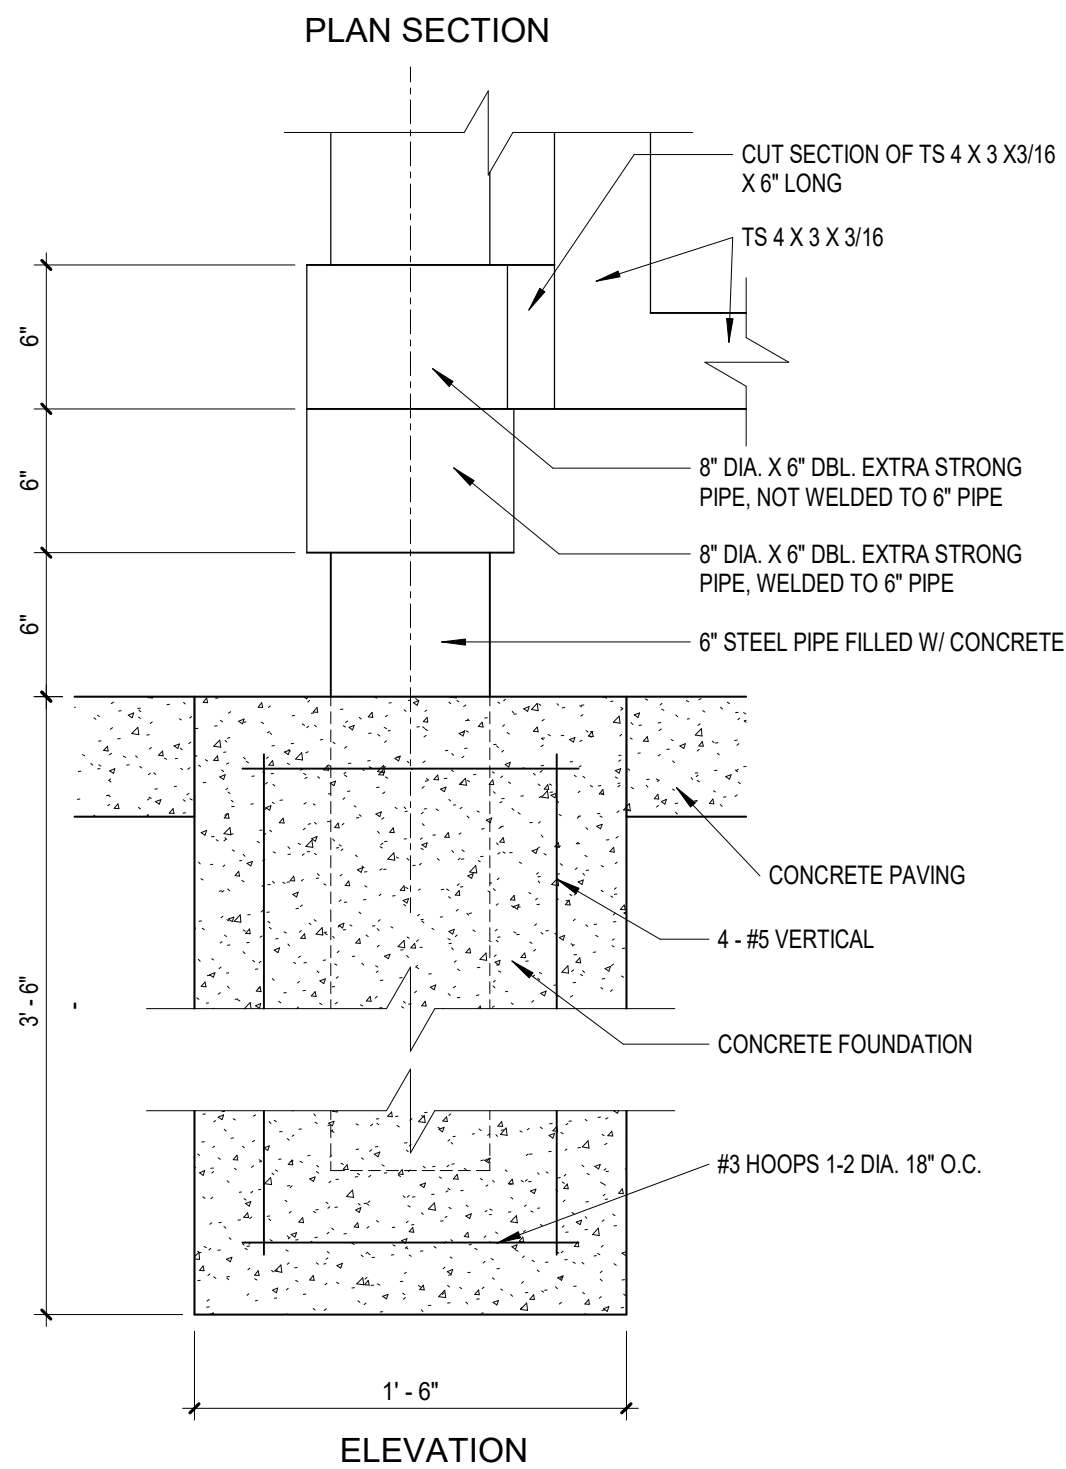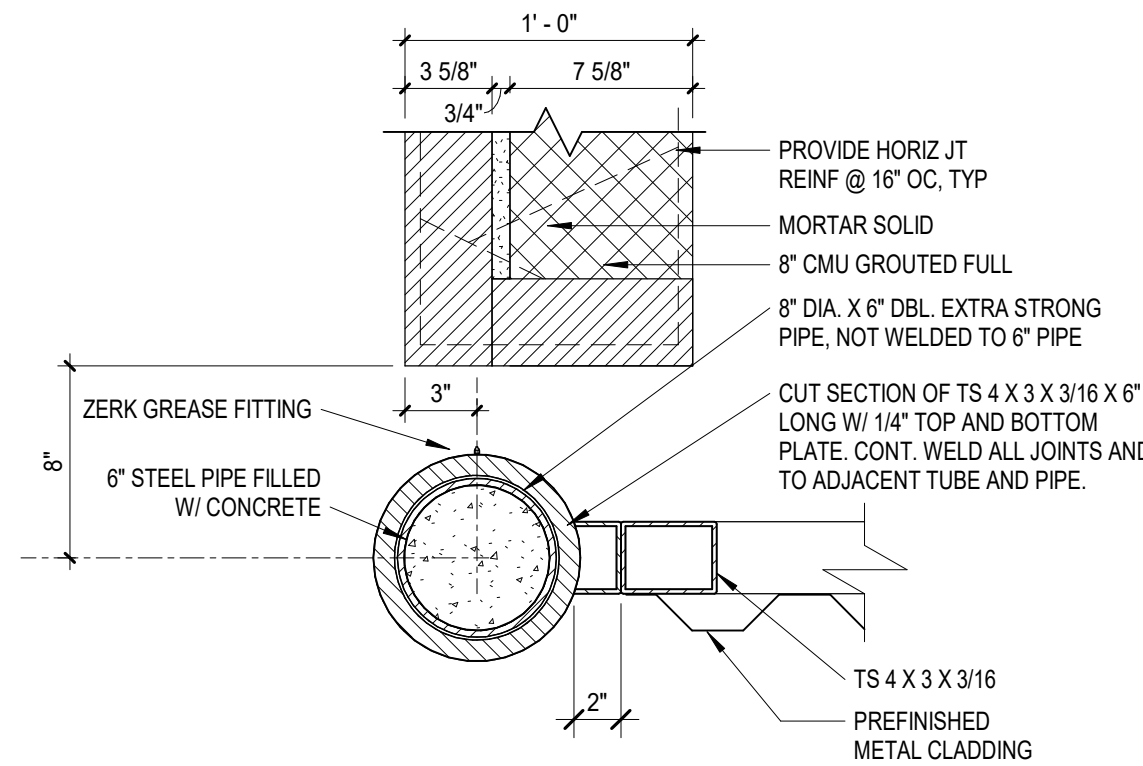


A1 ENCLOSURE GATE HINDGE DETAIL
SCALE: 1 1/2" = 1'-0"

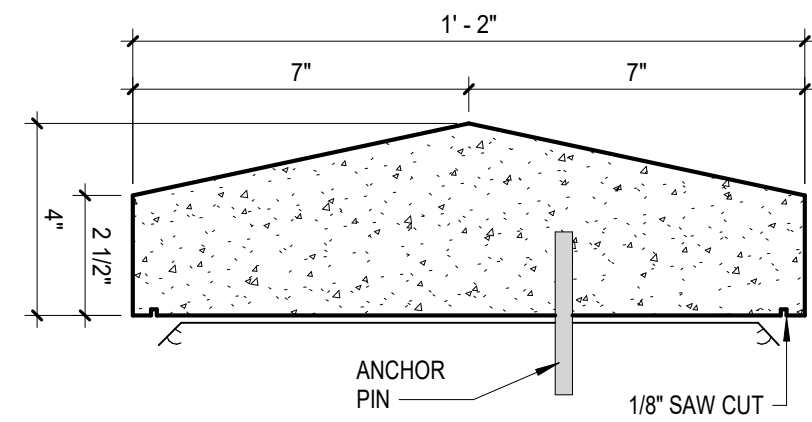


C2 TRASH ENCLOSURE CAP DETAIL1
SCALE: 3" = 1'-0"

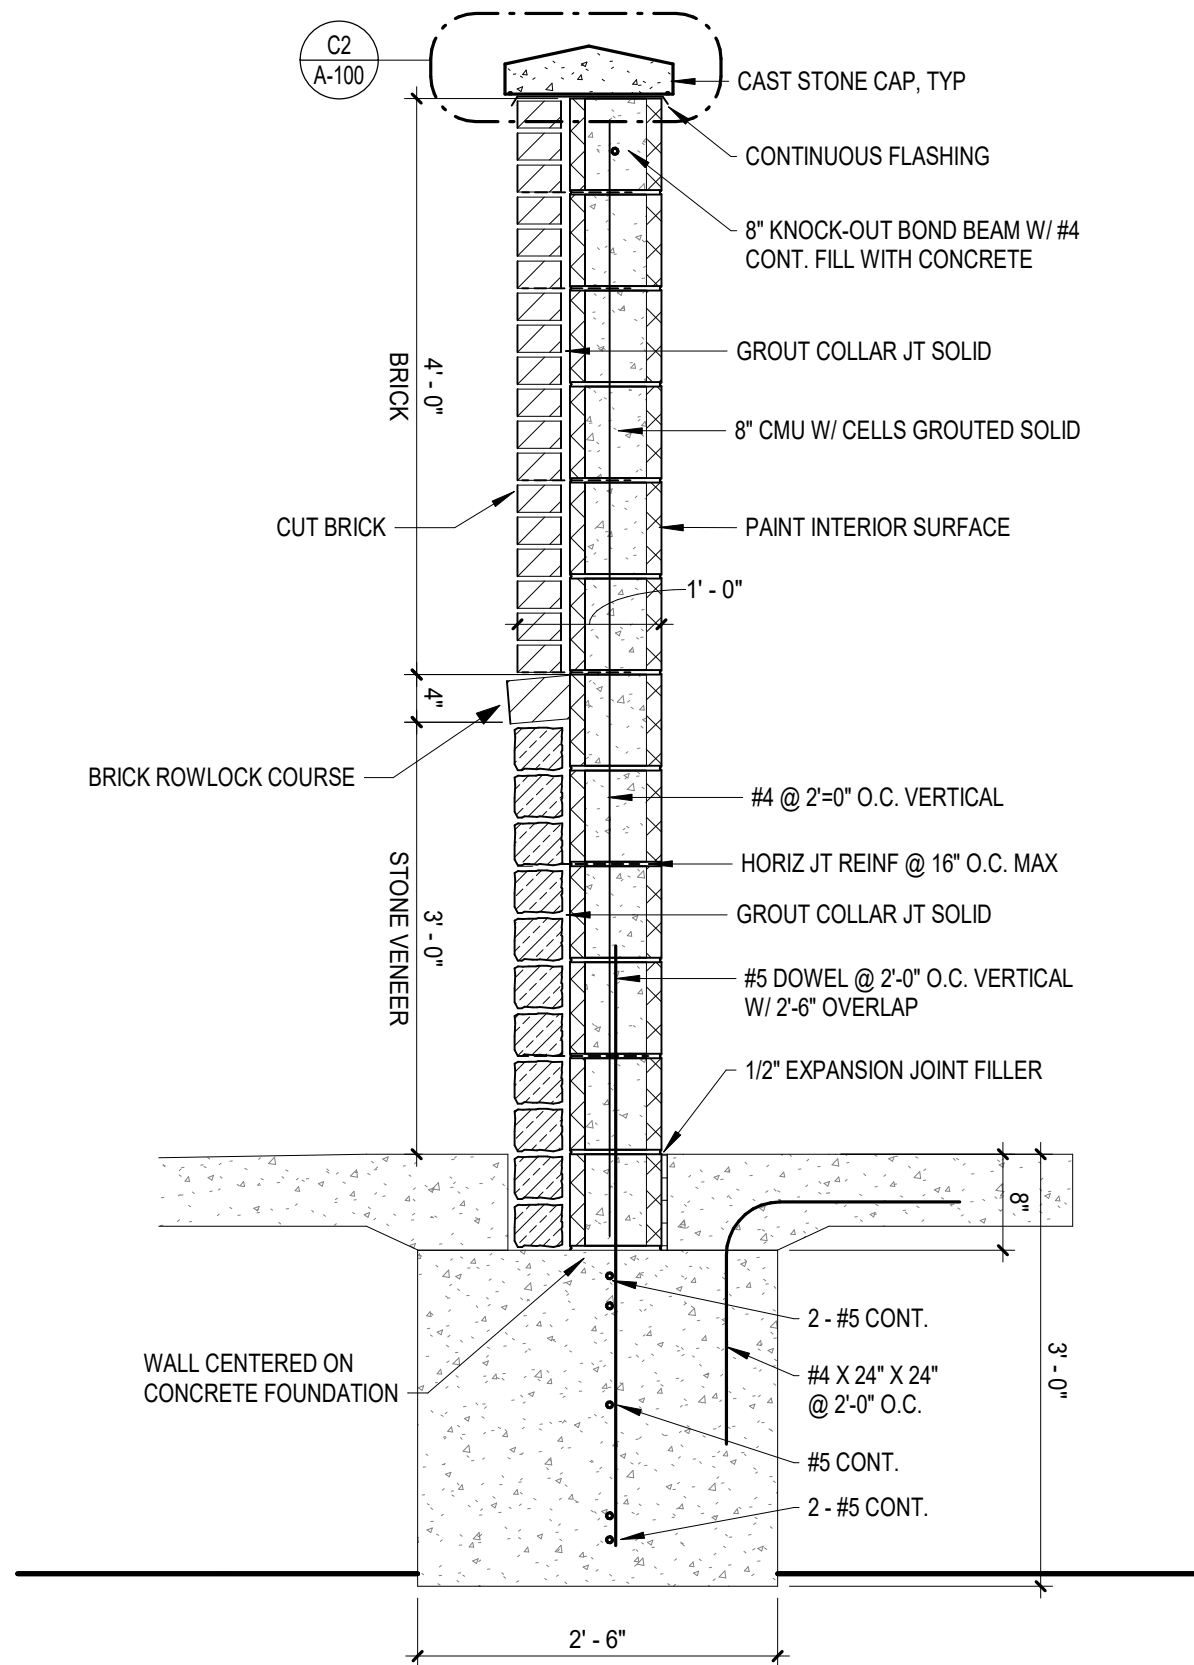

A2 TRASH ENCLOSURE WALL SECTION
SCALE: 3/4" = 1'-0"

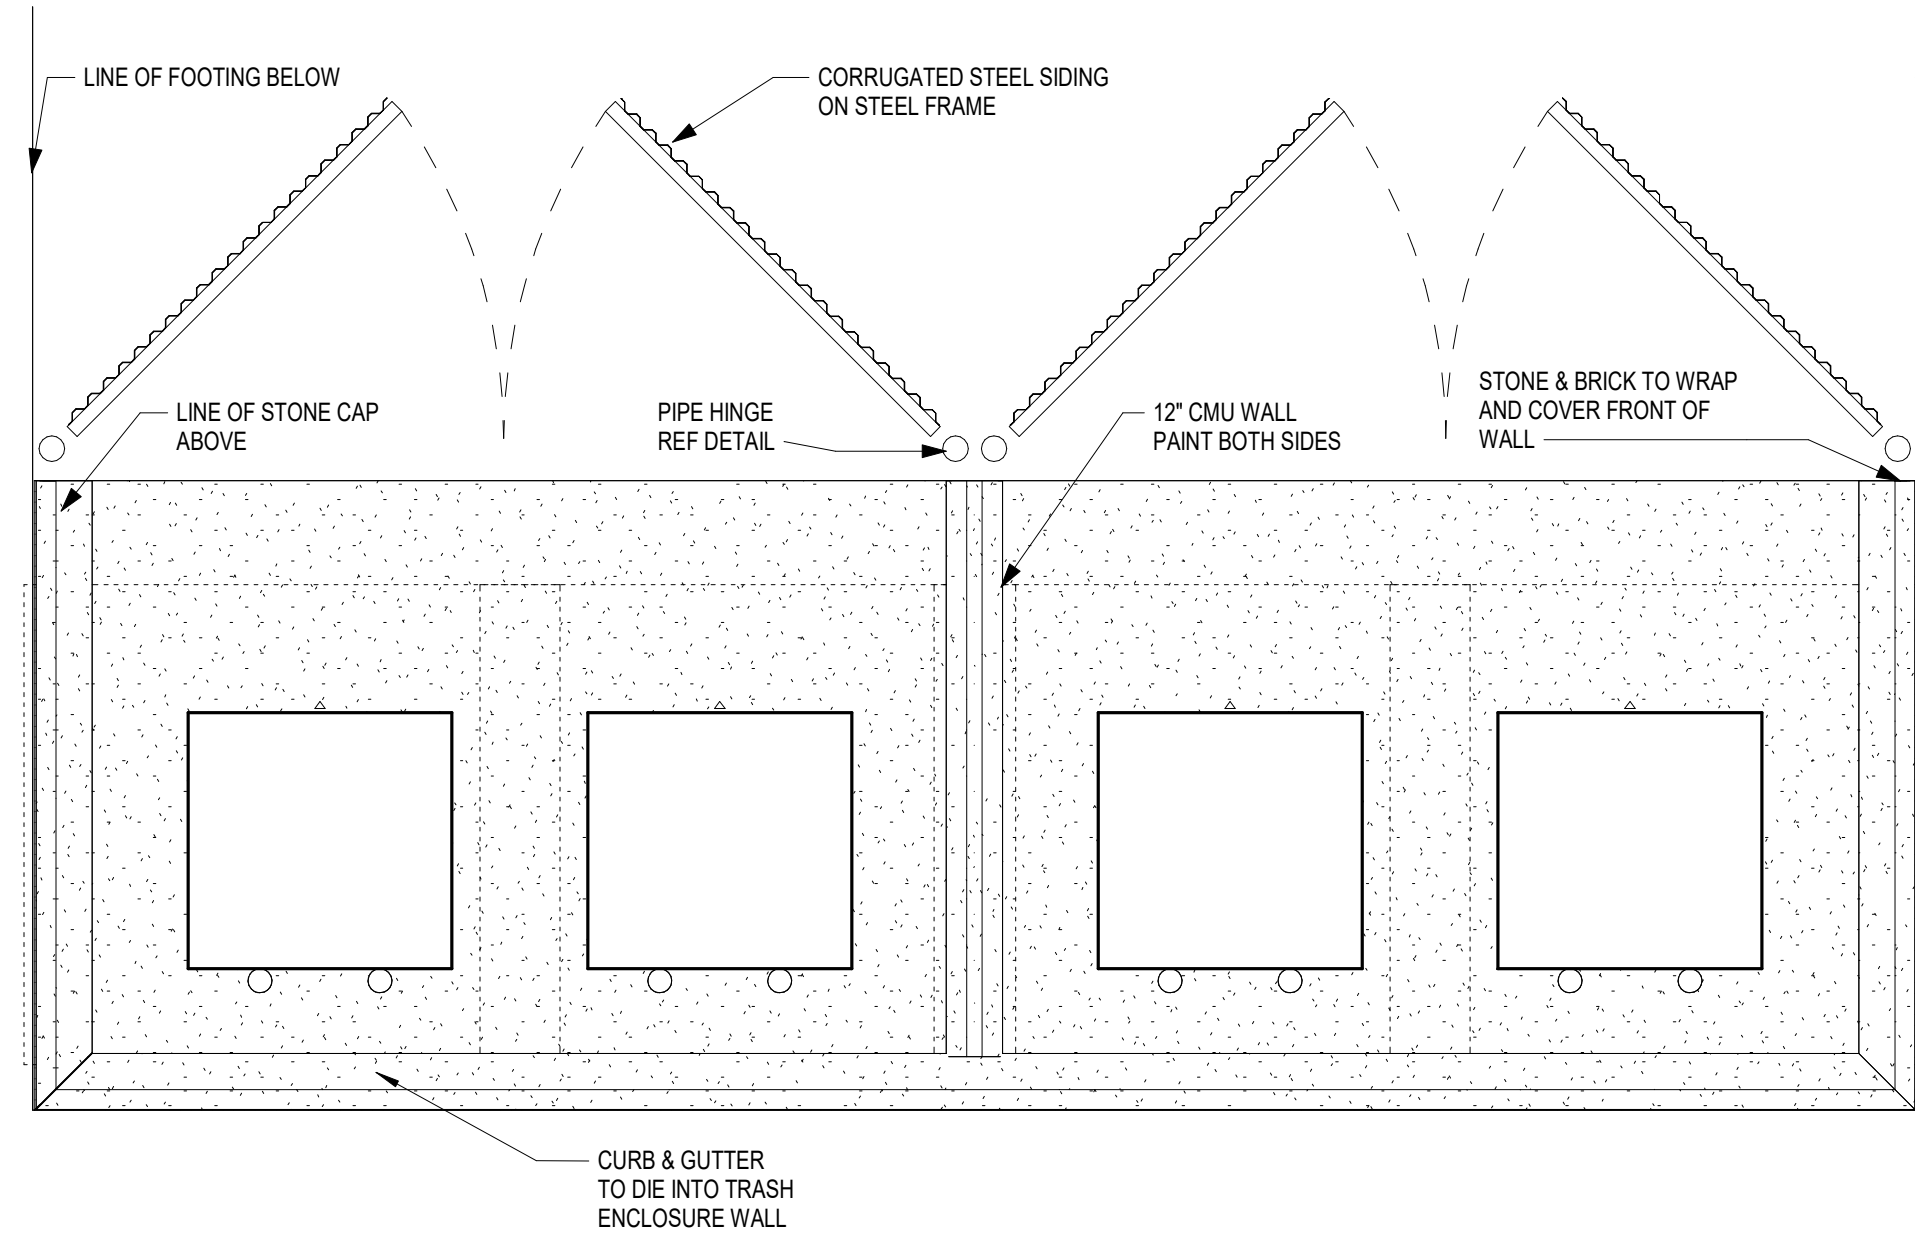

C4 TRASH ENCLOSURE PLAN1
SCALE: 1/4" = 1'-0"

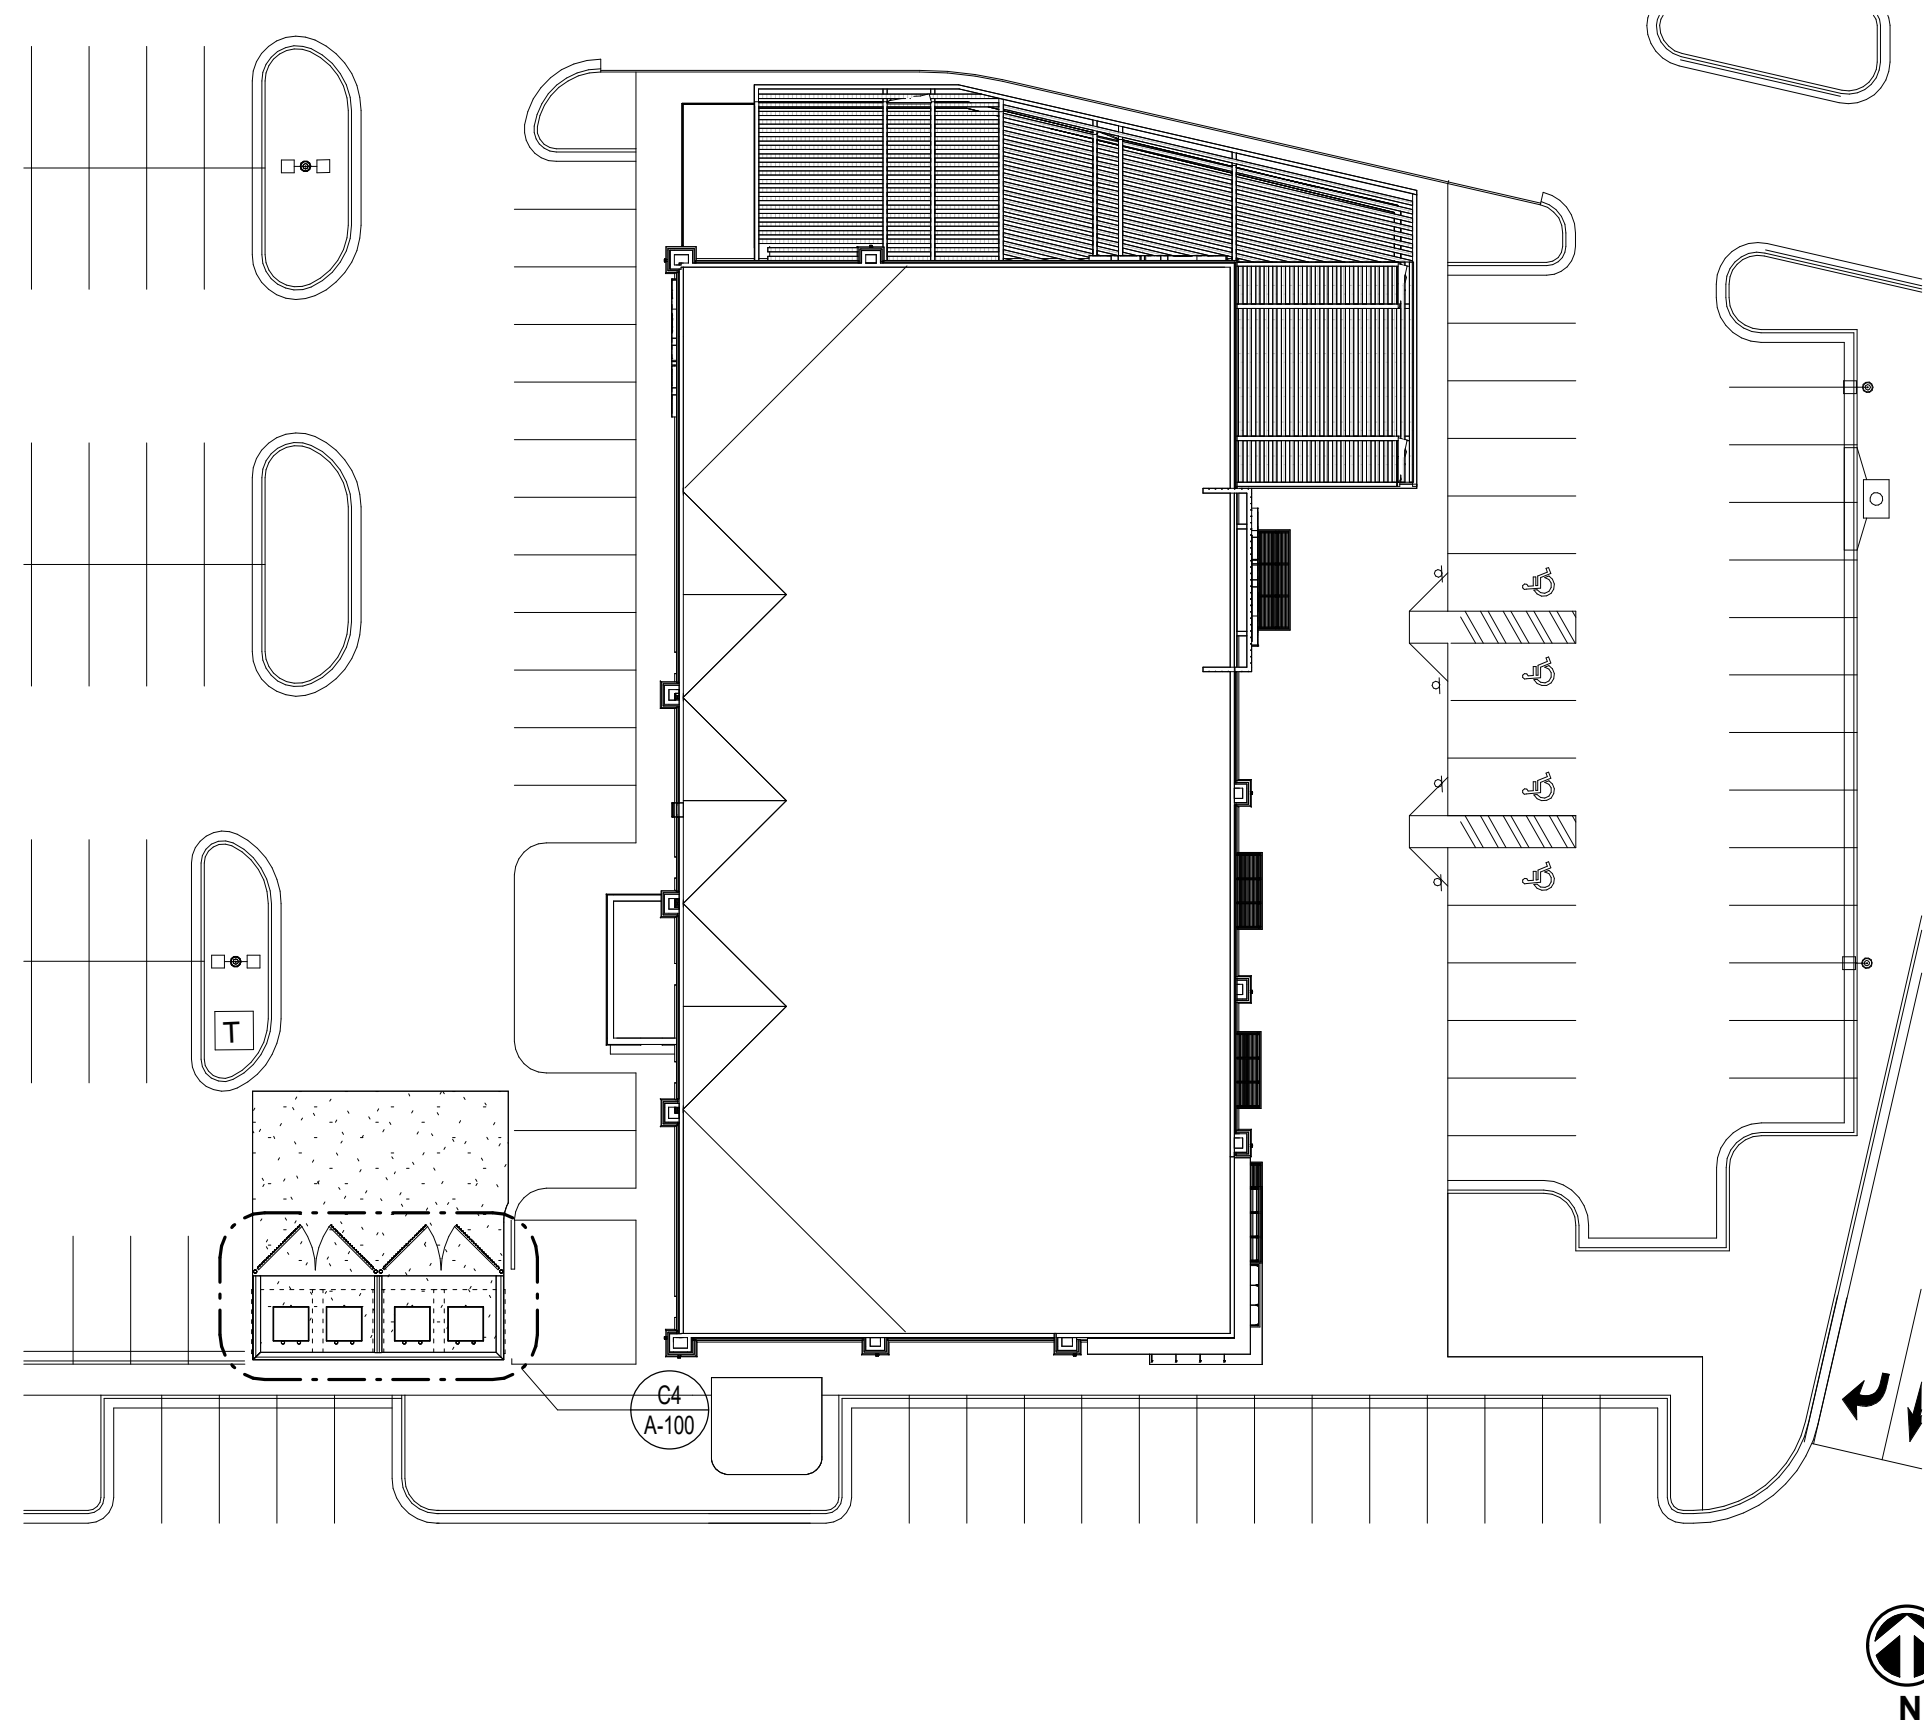

A3 SITE PLAN
SCALE: 1" = 30'-0"

GENERAL NOTES:
1. REFERENCE CIVIL FOR TRASH ENCLOSURE LOCATION.

RELEASED FOR CONSTRUCTION
As Noted on Plans Review
Development Services Department
01/21/2024

schwerdt design group
architecture | interiors | planning
2231 sw wanamaker rd. suite 303
topeka, kansas 66614-4275
phone: 785.273.7540
fax: 785.273.7579

500 north broadway suite 200
oklahoma city, ok 73102
phone: 405.231.3105
fax: 405.231.3115



MICHAEL K. HAMPTON
ARCHITECT (MO# A-2008027042)

SCHWERDT DESIGN GROUP INC
MISSOURI STATE CERTIFICATE
OF AUTHORITY #00363876

CORE & SHELL BUILDING
STREETS OF WEST PRYOR LOT 13
1020 NW PRYOR ROAD, LEES SUMMIT, MISSOURI

SUBMISSION DATES 12-27-2023
SHEET TITLE SITE PLAN & DETAILS
PROJECT NUMBER 235008
SHEET NUMBER A-100

FILEPATH: F:\1_P\Projects\SD\G235008 SOWP Lot 13\05_Drawings - Working\Revit\235008 SOWP Lot 13_V23.rvt
DATE: 1/22/2024 11:07:44 AM
DRAWN BY: Author

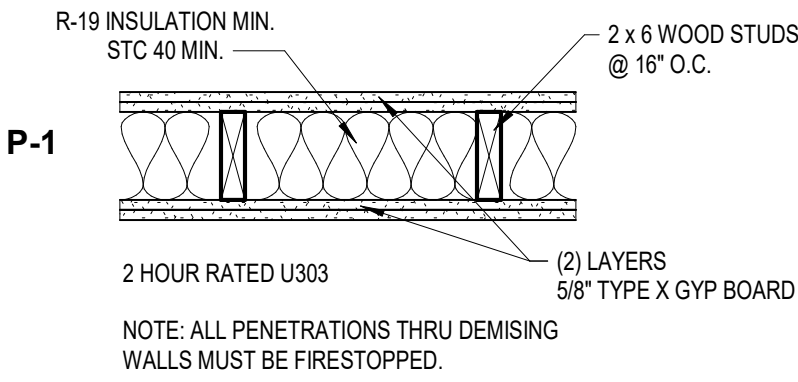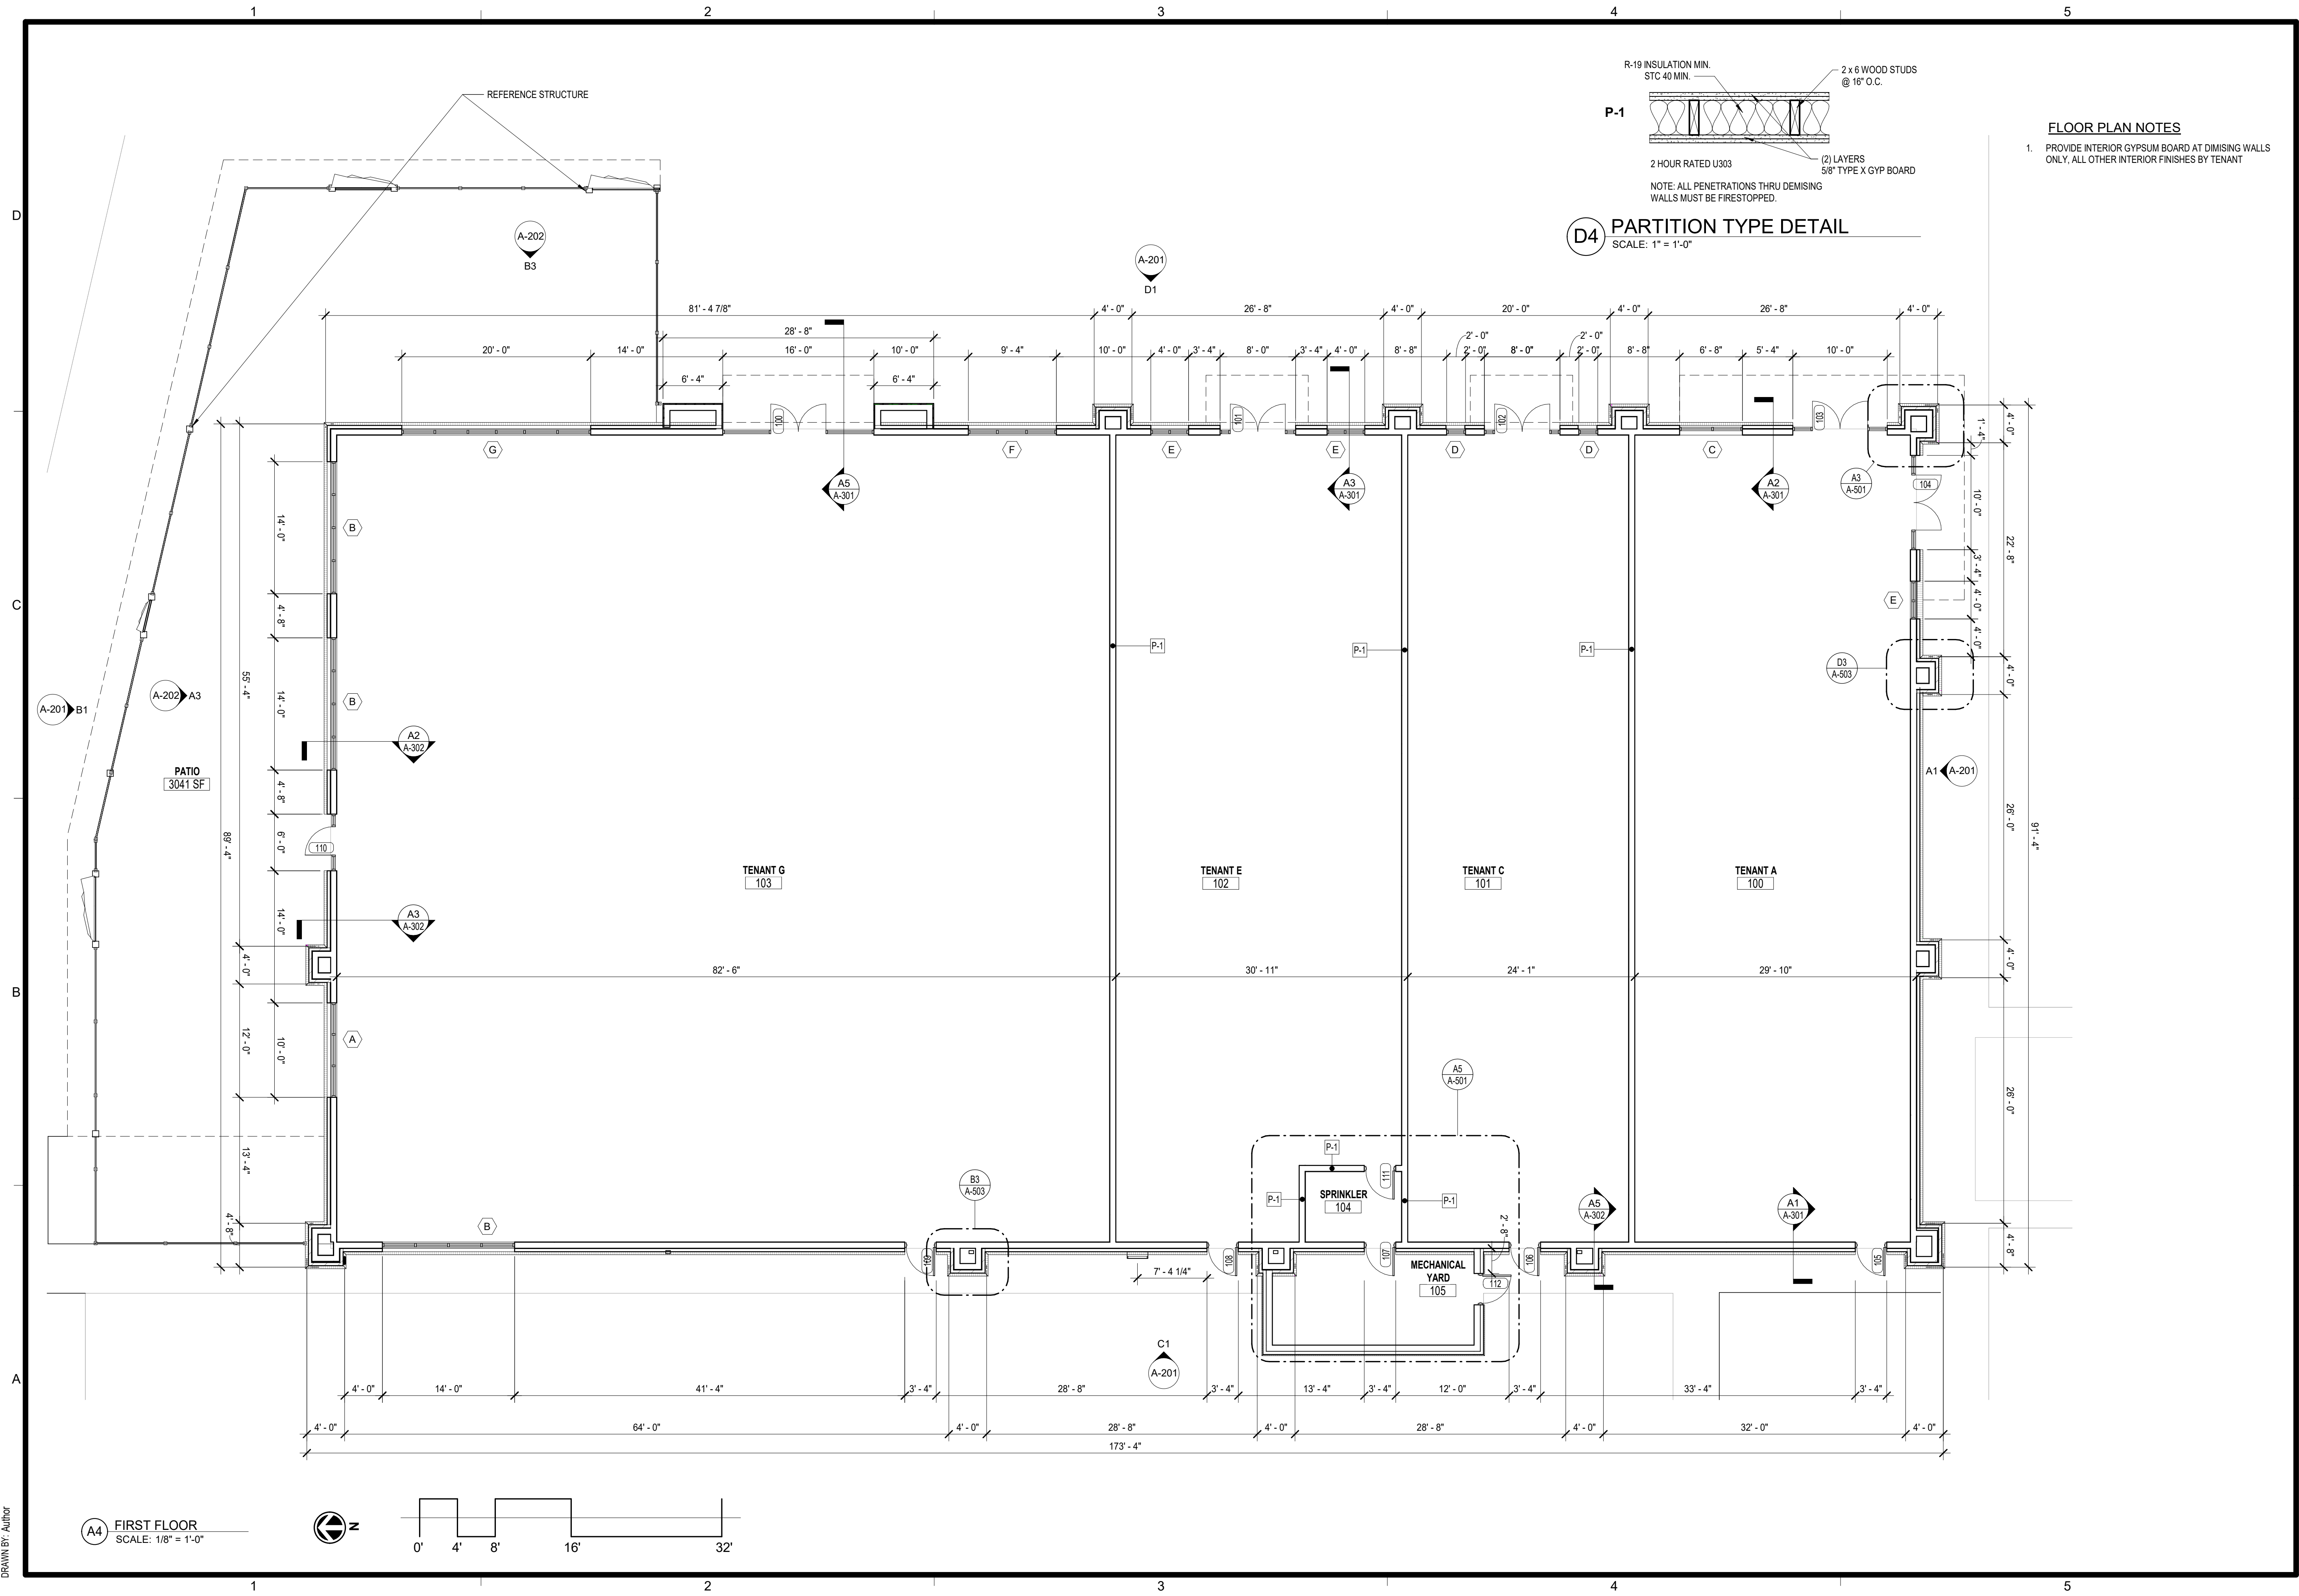

D4 PARTITION TYPE DETAIL
SCALE: 1" = 1'-0"

FLOOR PLAN NOTES

1. PROVIDE INTERIOR GYPSUM BOARD AT DIMISING WALLS
ONLY, ALL OTHER INTERIOR FINISHES BY TENANT

RELEASED FOR
CONSTRUCTION
As Noted on Plans Review
Development Services Department
Lee's Summit, Missouri
01/21/2024

schwerdt design group
architecture | interiors | planning
2231 sw wanamaker rd. suite 303
topeka, kansas 66614-4275
phone: 785.273.7540
fax: 785.273.7579

500 north broadway suite 200
oklahoma city, ok 73102
phone: 405.231.3105
fax: 405.231.3115

STATE OF MISSOURI
MICHAEL K. HAMPTON
ARCHITECT
JANUARY 2024

MICHAEL K HAMPTON
ARCHITECT (MO# A-208027042)
SCHWERDT DESIGN GROUP INC
MISSOURI STATE CERTIFICATE
OF AUTHORITY #F00353876

CORE & SHELL BUILDING
STREETS OF WEST PRYOR LOT 13
1020 NW PRYOR ROAD, LEES SUMMIT, MISSOURI


SUBMISSION DATES
12-27-2023

SHEET TITLE
FIRST FLOOR PLAN

PROJECT NUMBER
235008


SHEET NUMBER
A-101

FILEPATH: F:\1_P\Projects\SDG\235008 SOWP Lot 13\05_Drawings - Working\Revit\235008 SOWP Lot 13_V23.rvt
DATE: 1/22/2024 11:07:44 AM
DRAWN BY: Author

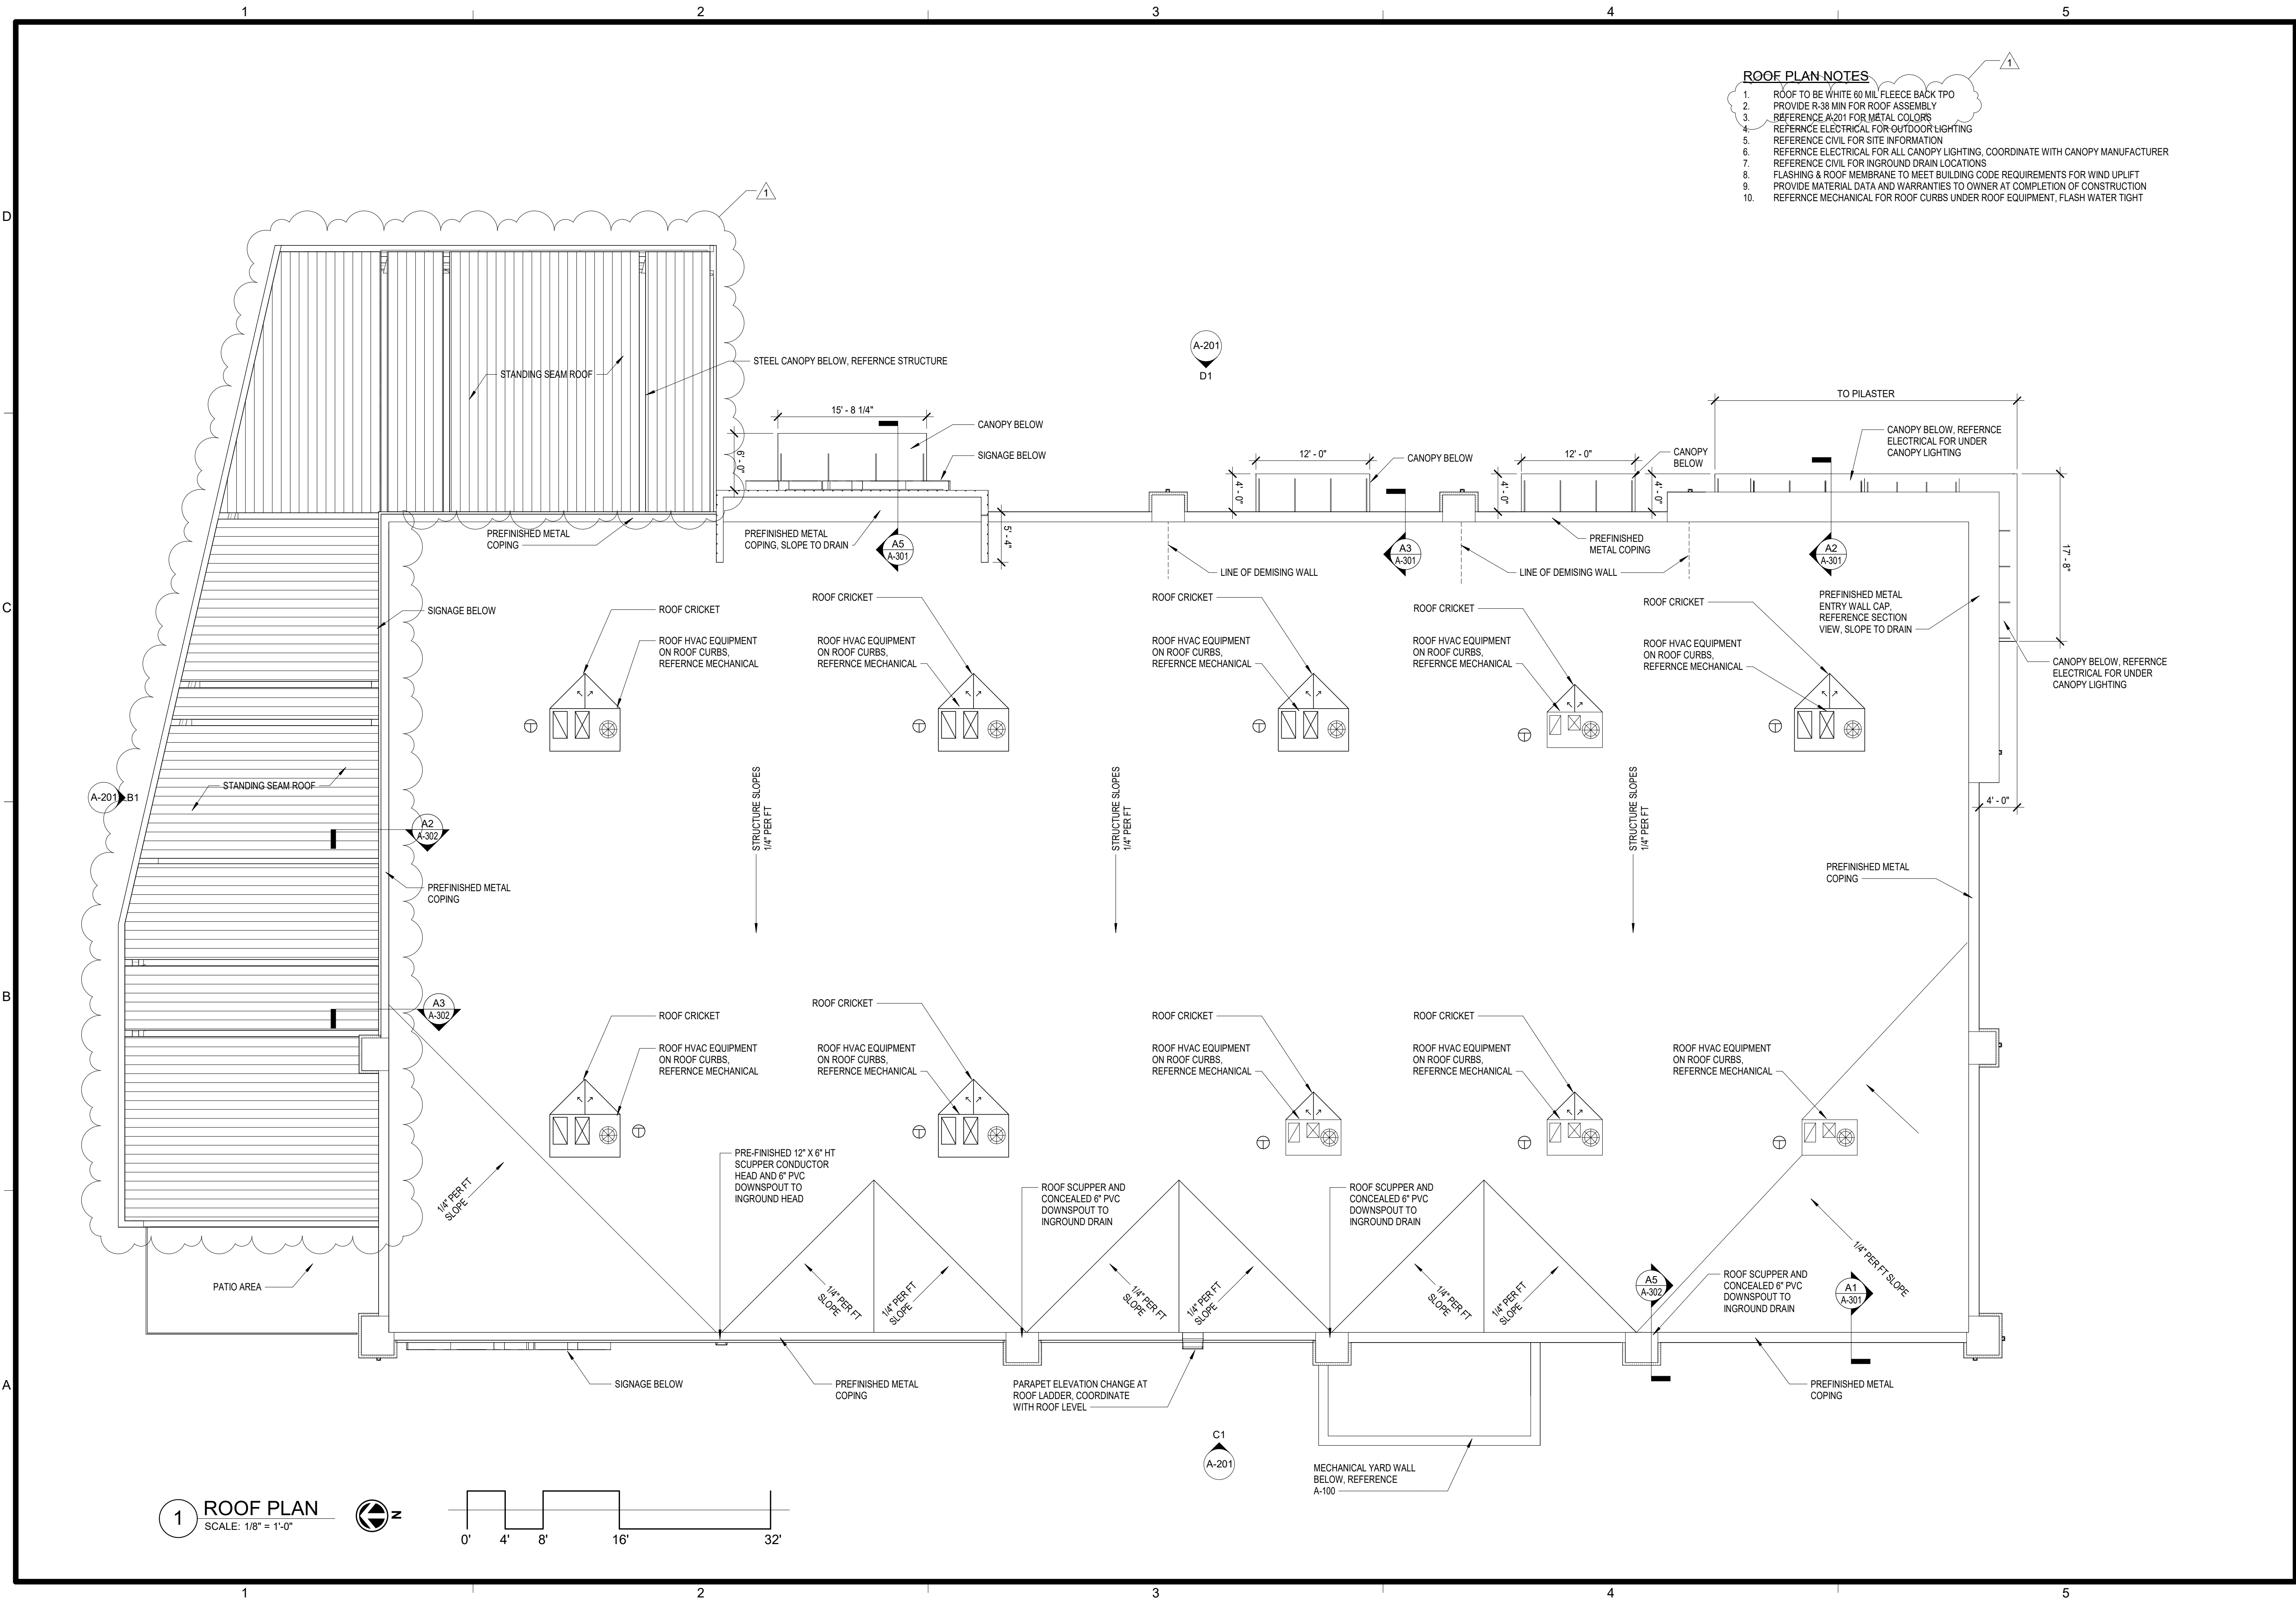

ROOF PLAN NOTES

1. ROOF TO BE WHITE 60 MIL FLEECE BACK TPO
2. PROVIDE R-38 MIN FOR ROOF ASSEMBLY
3. REFERENCE A-201 FOR METAL COLORS
4. REFERENCE ELECTRICAL FOR OUTDOOR LIGHTING
5. REFERENCE CIVIL FOR SITE INFORMATION
6. REFERENCE ELECTRICAL FOR ALL CANOPY LIGHTING, COORDINATE WITH CANOPY MANUFACTURER
7. REFERENCE CIVIL FOR INGROUND DRAIN LOCATIONS
8. FLASHING & ROOF MEMBRANE TO MEET BUILDING CODE REQUIREMENTS FOR WIND UPLIFT
9. PROVIDE MATERIAL DATA AND WARRANTIES TO OWNER AT COMPLETION OF CONSTRUCTION
10. REFERENCE MECHANICAL FOR ROOF CURBS UNDER ROOF EQUIPMENT, FLASH WATER TIGHT

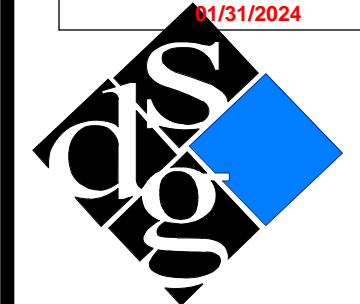

schwerdt design group
architecture | interiors | planning

2231 sw wanamaker rd. suite 303
topeka, kansas 66614-4275
phone: 785.273.7540
fax: 785.273.7579
500 north broadway. suite 200
oklahoma city, ok 73102
phone: 405.231.3105
fax: 405.231.3115



MICHAEL K. HAMPTON
ARCHITECT (MO# A-208027042)

SCHWERDT DESIGN GROUP INC
MISSOURI STATE CERTIFICATE
OF AUTHORITY #00353876

CORE & SHELL BUILDING
STREETS OF WEST PRYOR LOT 13
1020 NW PRYOR ROAD, LEES SUMMIT, MISSOURI

SUBMISSION DATES

12-27-2023

ADD-1 JAN 19TH, 2024

SHEET TITLE
ROOF PLAN

PROJECT NUMBER
235008

SHEET NUMBER
A-102


schwerdt design group
architecture | interiors | planning
2231 sw wanamaker rd. suite 303
topeka, kansas 66614-4275
phone: 785.273.7540
fax: 785.273.7579
500 north broadway suite 200
oklahoma city, ok 73102
phone: 405.231.3105
fax: 405.231.3115

STATE OF MISSOURI
MICHAEL K. HAMPTON
ARCHITECT
A-201-002
ARCHITECT

MICHAEL K. HAMPTON
ARCHITECT (MO# A-208027042)
SCHWERDT DESIGN GROUP INC
MISSOURI STATE CERTIFICATE
OF AUTHORITY #00353876


CORE & SHELL BUILDING
STREETS OF WEST PRYOR LOT 13
1020 NW PRYOR ROAD, LEES SUMMIT, MISSOURI

SUBMISSION DATES
12-27-2023
SHEET TITLE
EXTERIOR ELEVATIONS
PROJECT NUMBER
235008
SHEET NUMBER
A-201

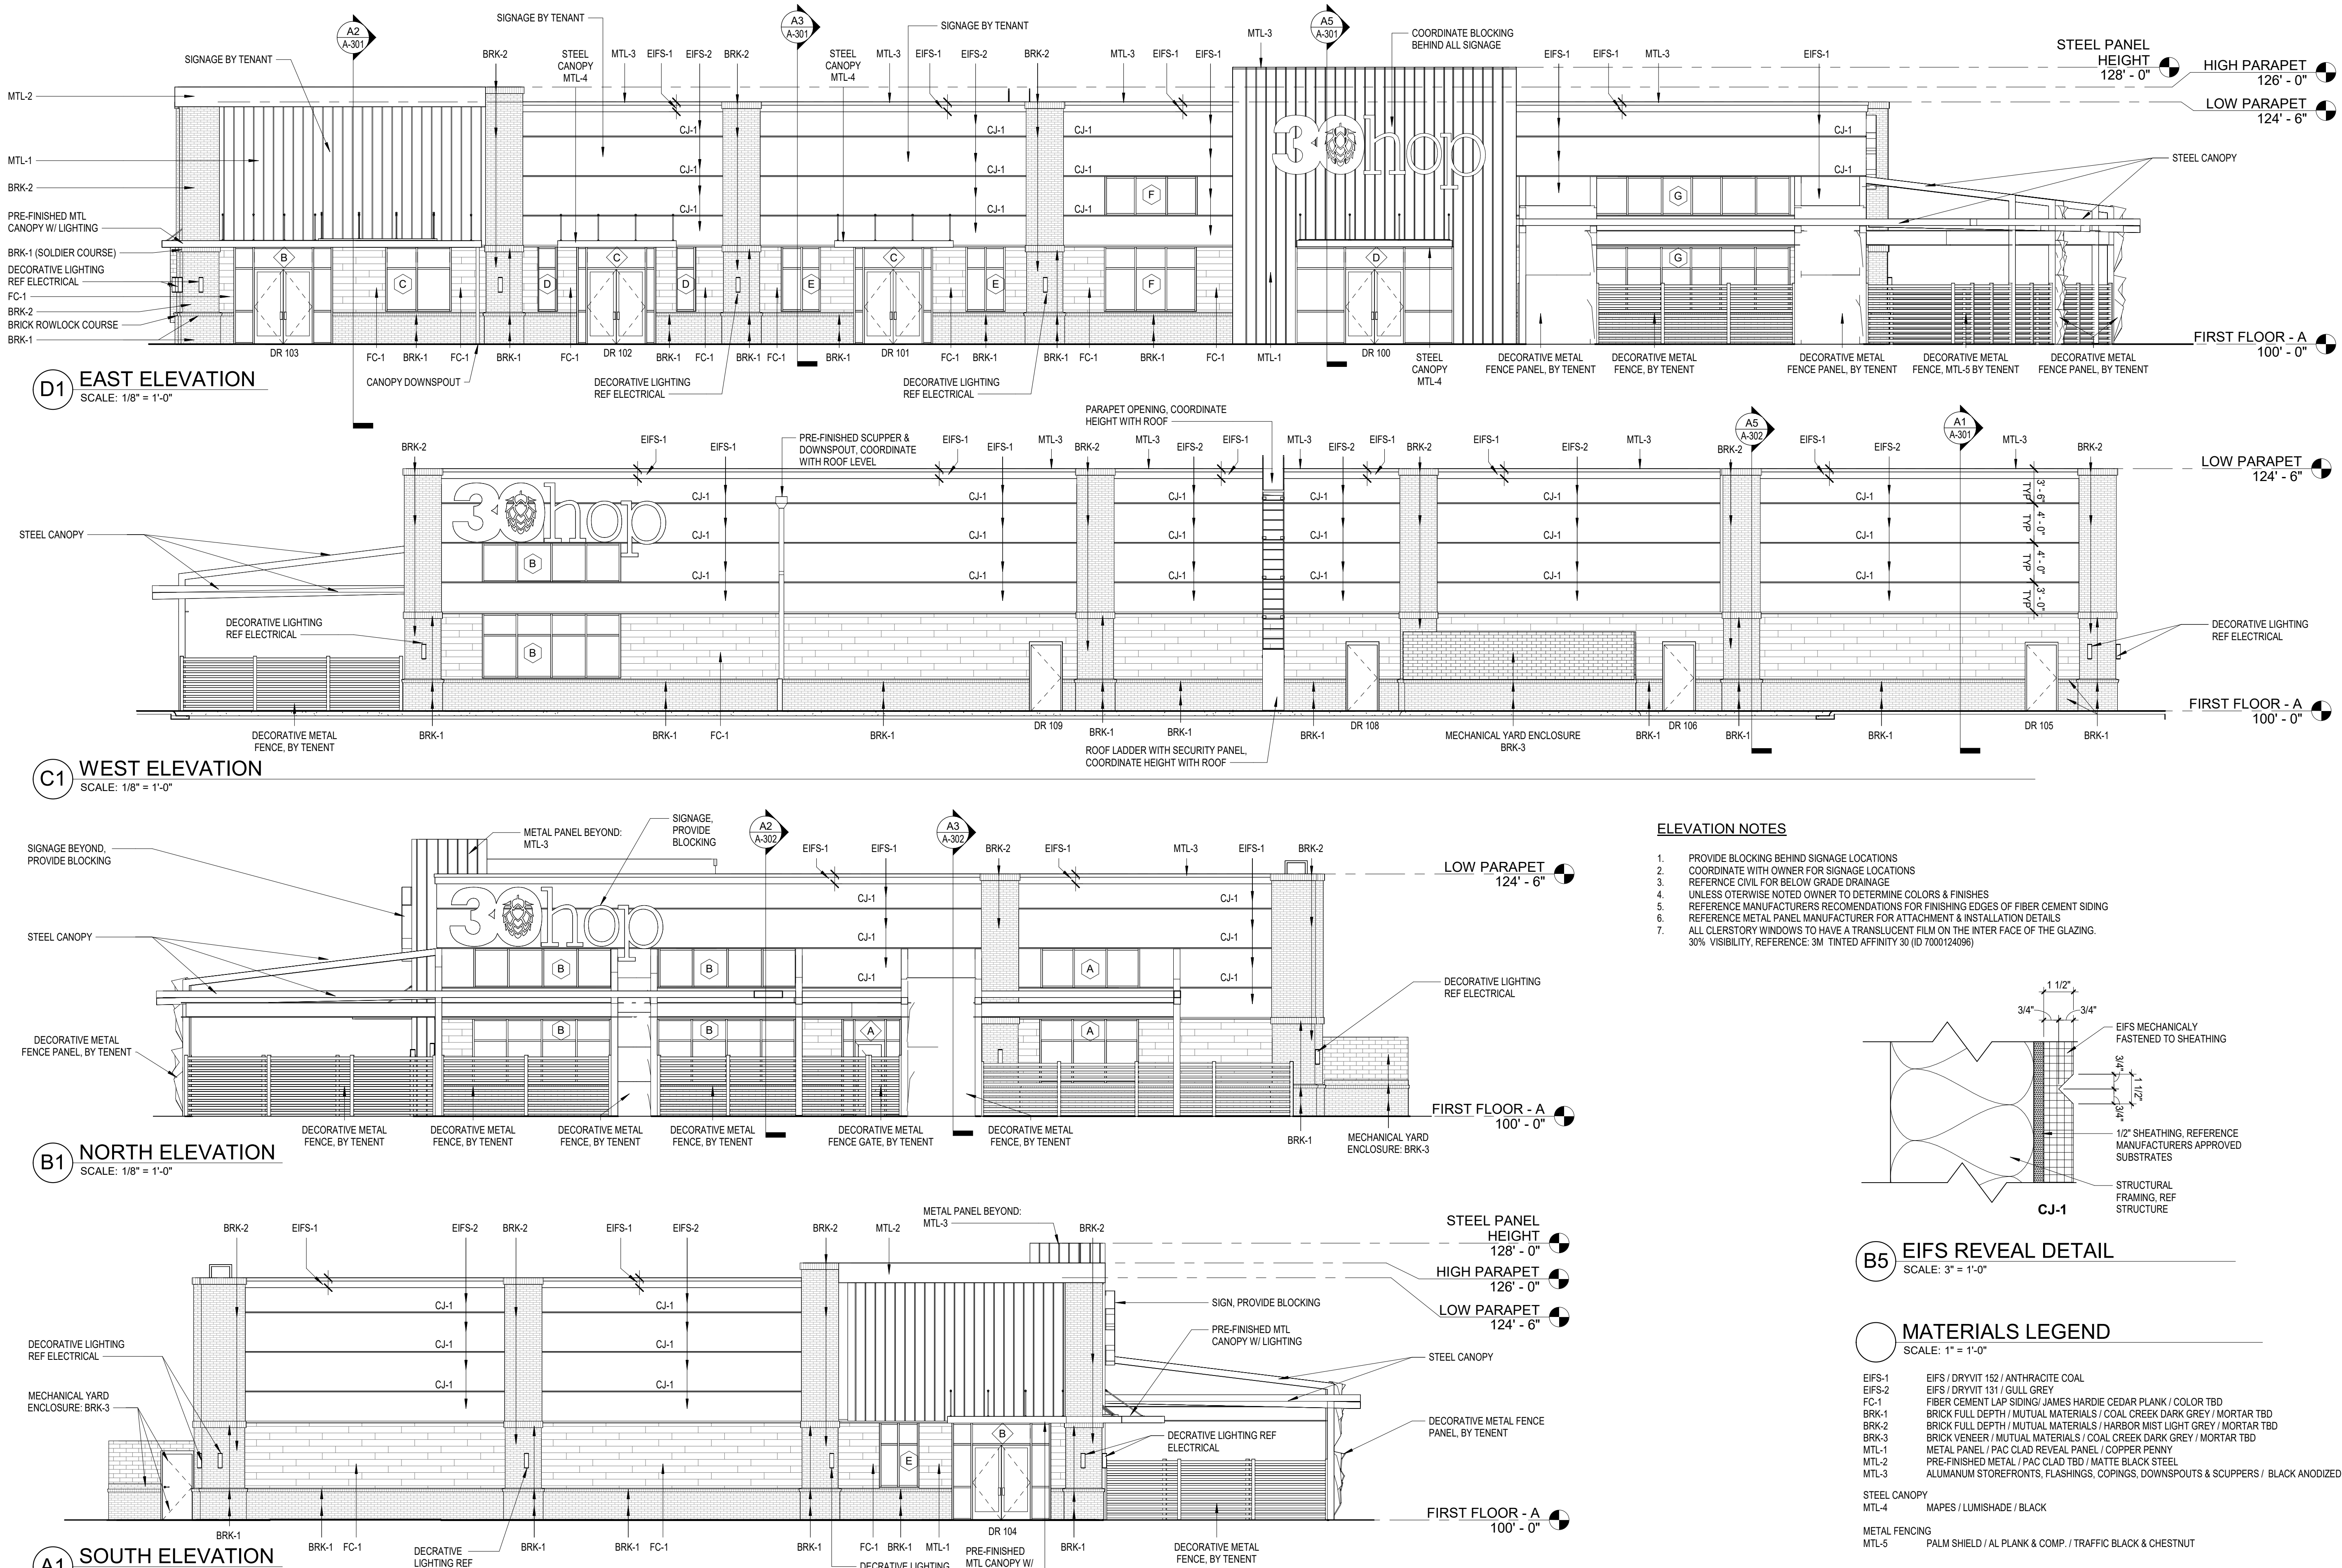

ELEVATION NOTES

1. PROVIDE BLOCKING BEHIND SIGNAGE LOCATIONS
2. COORDINATE WITH OWNER FOR SIGNAGE LOCATIONS
3. REFERENCE CIVIL FOR BELOW GRADE DRAINAGE
4. UNLESS OTHERWISE NOTED OWNER TO DETERMINE COLORS & FINISHES
5. REFERENCE MANUFACTURERS RECOMMENDATIONS FOR FINISHING EDGES OF FIBER CEMENT SIDING
6. REFERENCE METAL PANEL MANUFACTURER FOR ATTACHMENT & INSTALLATION DETAILS
7. ALL CLERSTORY WINDOWS TO HAVE A TRANSLUCENT FILM ON THE INTER FACE OF THE GLAZING. 30% VISIBILITY, REFERENCE: 3M TINTED AFFINITY 30 (ID 7000124096)

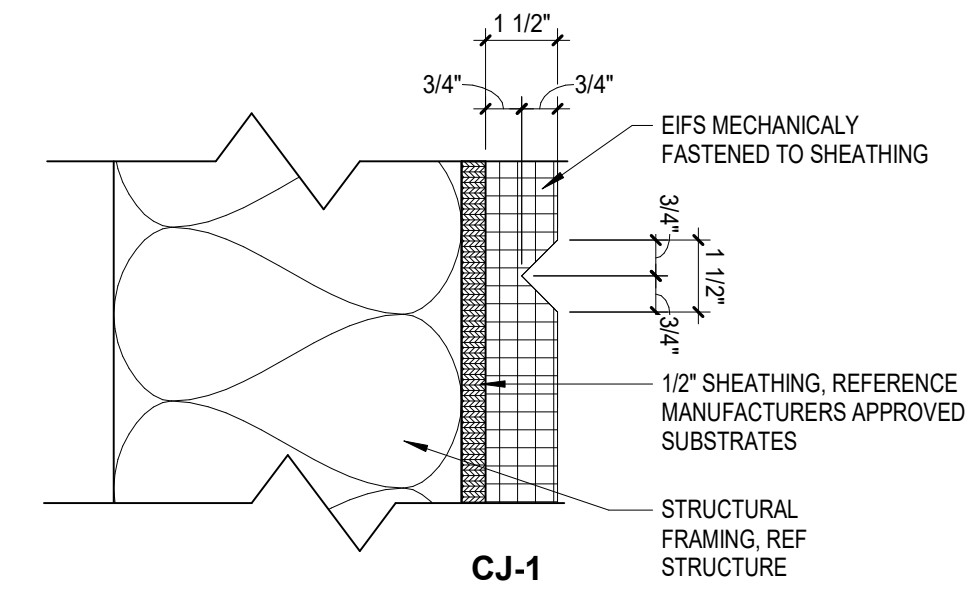


B5 EIFS REVEAL DETAIL
SCALE: 3\"/>

MATERIALS LEGEND
SCALE: 1\"/>


EIFS-1	EIFS / DRYVIT 152 / ANTHRACITE COAL
EIFS-2	EIFS / DRYVIT 131 / GULL GREY
FC-1	FIBER CEMENT LAP SIDING / JAMES HARDIE CEDAR PLANK / COLOR TBD
BRK-1	BRICK FULL DEPTH / MUTUAL MATERIALS / COAL CREEK DARK GREY / MORTAR TBD
BRK-2	BRICK FULL DEPTH / MUTUAL MATERIALS / HARBOR MIST LIGHT GREY / MORTAR TBD
BRK-3	BRICK VENEER / MUTUAL MATERIALS / COAL CREEK DARK GREY / MORTAR TBD
MTL-1	METAL PANEL / PAC CLAD REVEAL PANEL / COPPER PENNY
MTL-2	PRE-FINISHED METAL / PAC CLAD TBD / MATTIE BLACK STEEL
MTL-3	ALUMINUM STOREFRONTS, FLASHINGS, COPINGS, DOWNSPOUTS & SCUPPERS / BLACK ANODIZED
STEEL CANOPY	MAPES / LUMISHADE / BLACK
MTL-4	
METAL FENCING	
MTL-5	PALM SHIELD / AL PLANK & COMP. / TRAFFIC BLACK & CHESTNUT

FILEPATH: F:\1 Projects\SDG\235008 SOWP Lot 13\05 Drawings - Working\Revit\235008 SOWP Lot 13_V23.rvt
DATE: 1/22/2024 11:07:50 AM
DRAWN BY: Author


FILEPATH: F:\1_P\Projects SD\G235008 SOWP Lot 13\05_Drawings - Working\Revit\235008 SOWP Lot 13_V23.rvt
DATE: 1/22/2024 11:07:51 AM
DRAWN BY: Author

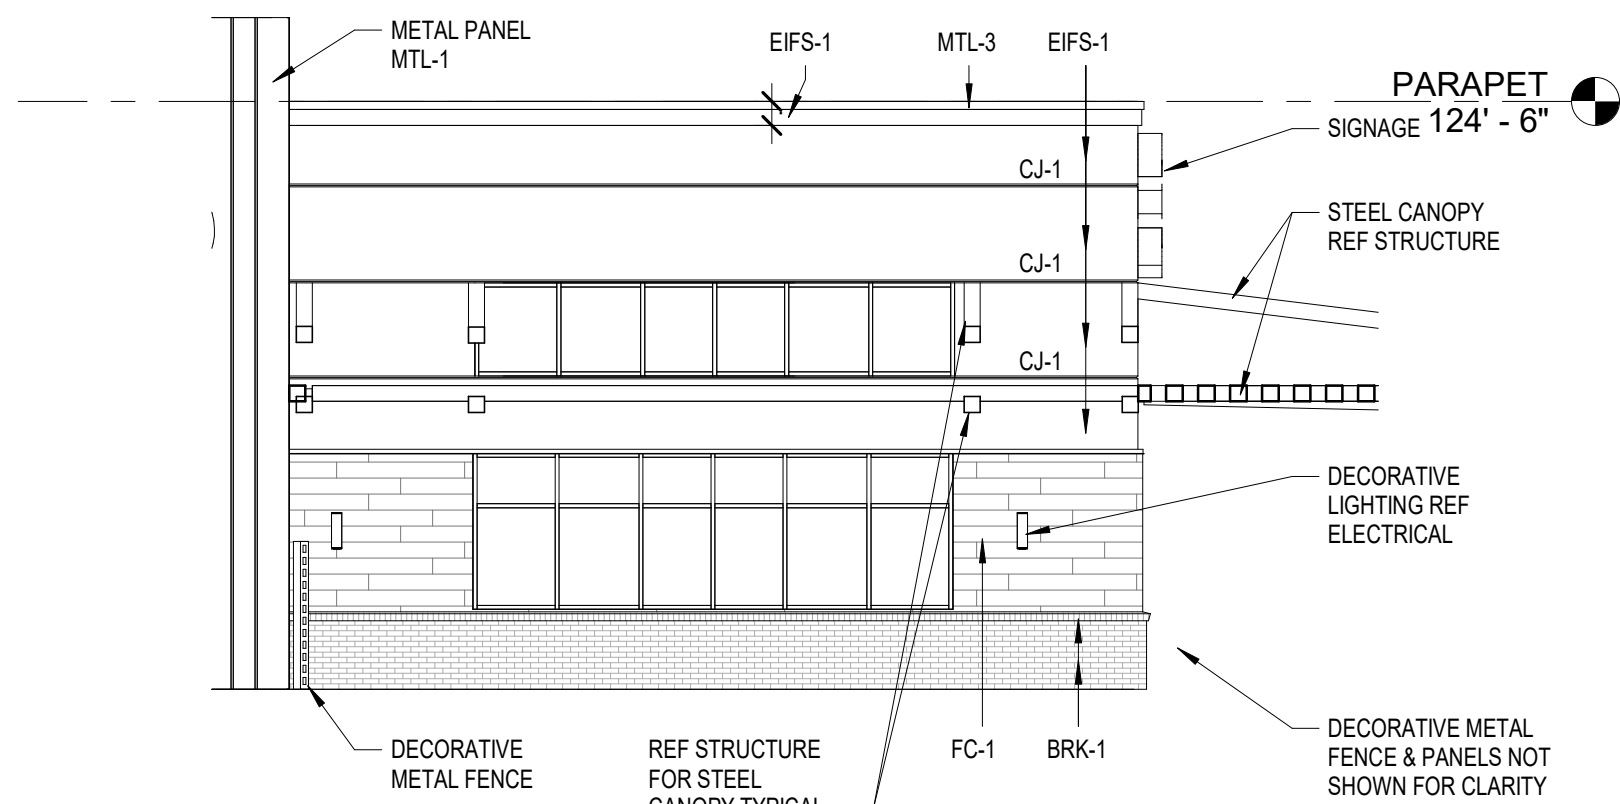

B3 PARTIAL EAST ELEVATION AT BUILDING
SCALE: 1/8" = 1'-0"
(CANOPY OMITTED FOR CLARITY)

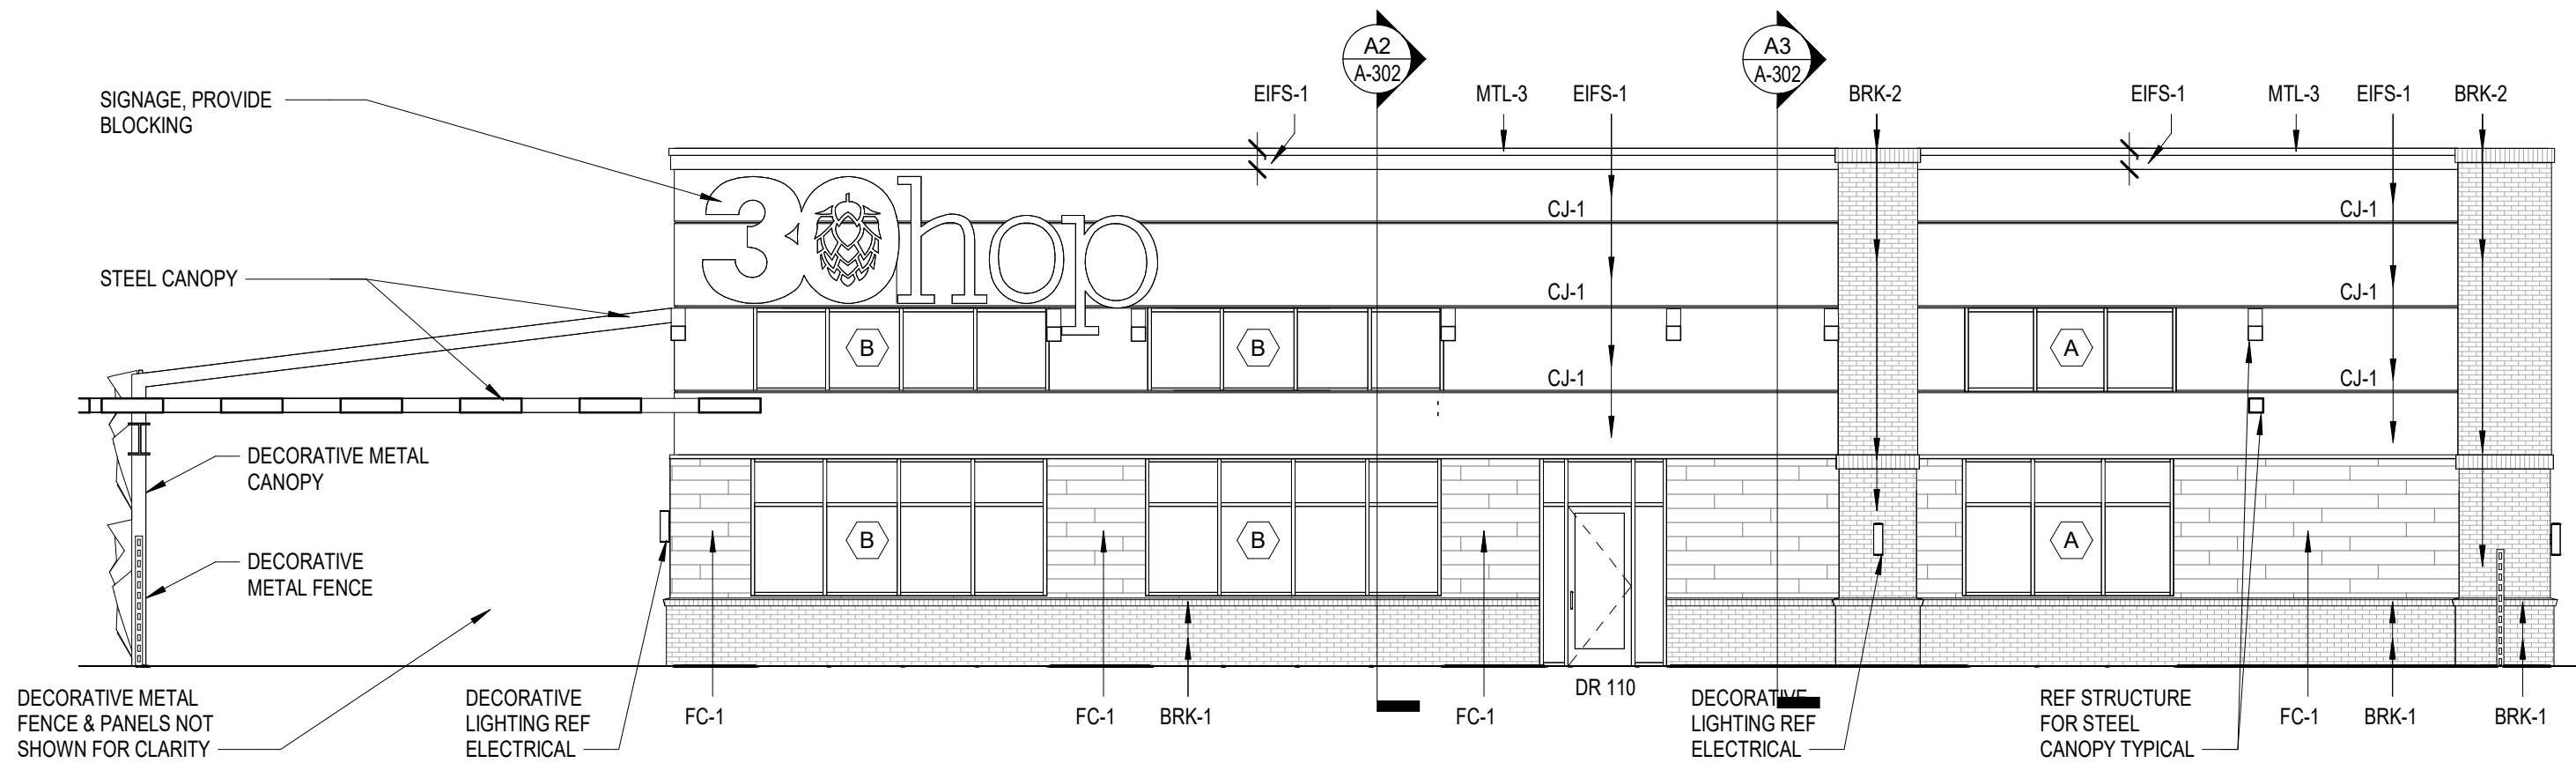

A3 NORTH ELEVATION AT BUILDING (CANOPY OMITTED FOR CLARITY)
SCALE: 1/8" = 1'-0"

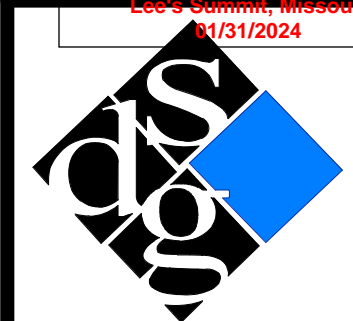

schwerdt design group
architecture | interiors | planning
2231 sw wanamaker rd. suite 303
topeka, kansas 66614-4275
phone: 785.273.7540
fax: 785.273.7579
500 north broadway
oklahoma city, ok 73102
phone: 405.231.3105
fax: 405.231.3115



MICHAEL K HAMPTON
ARCHITECT (MO# A-2008027042)
SCHWERDT DESIGN GROUP INC
MISSOURI STATE CERTIFICATE
OF AUTHORITY #00353876

CORE & SHELL BUILDING
STREETS OF WEST PRYOR LOT 13
1020 NW PRYOR ROAD, LEES SUMMIT, MISSOURI


SUBMISSION DATES
12-27-2023

SHEET TITLE
EXTERIOR ENLARGED
ELEVATION & FENCE DTLS

PROJECT NUMBER
235008

SHEET NUMBER
A-202

FILEPATH: F:\1 Projects SD\235008 SOWP Lot 13\05 Drawings - Working\Revit\235008 SOWP Lot 13_V23.rvt
DATE: 1/22/2024 11:07:54 AM
DRAWN BY: Author

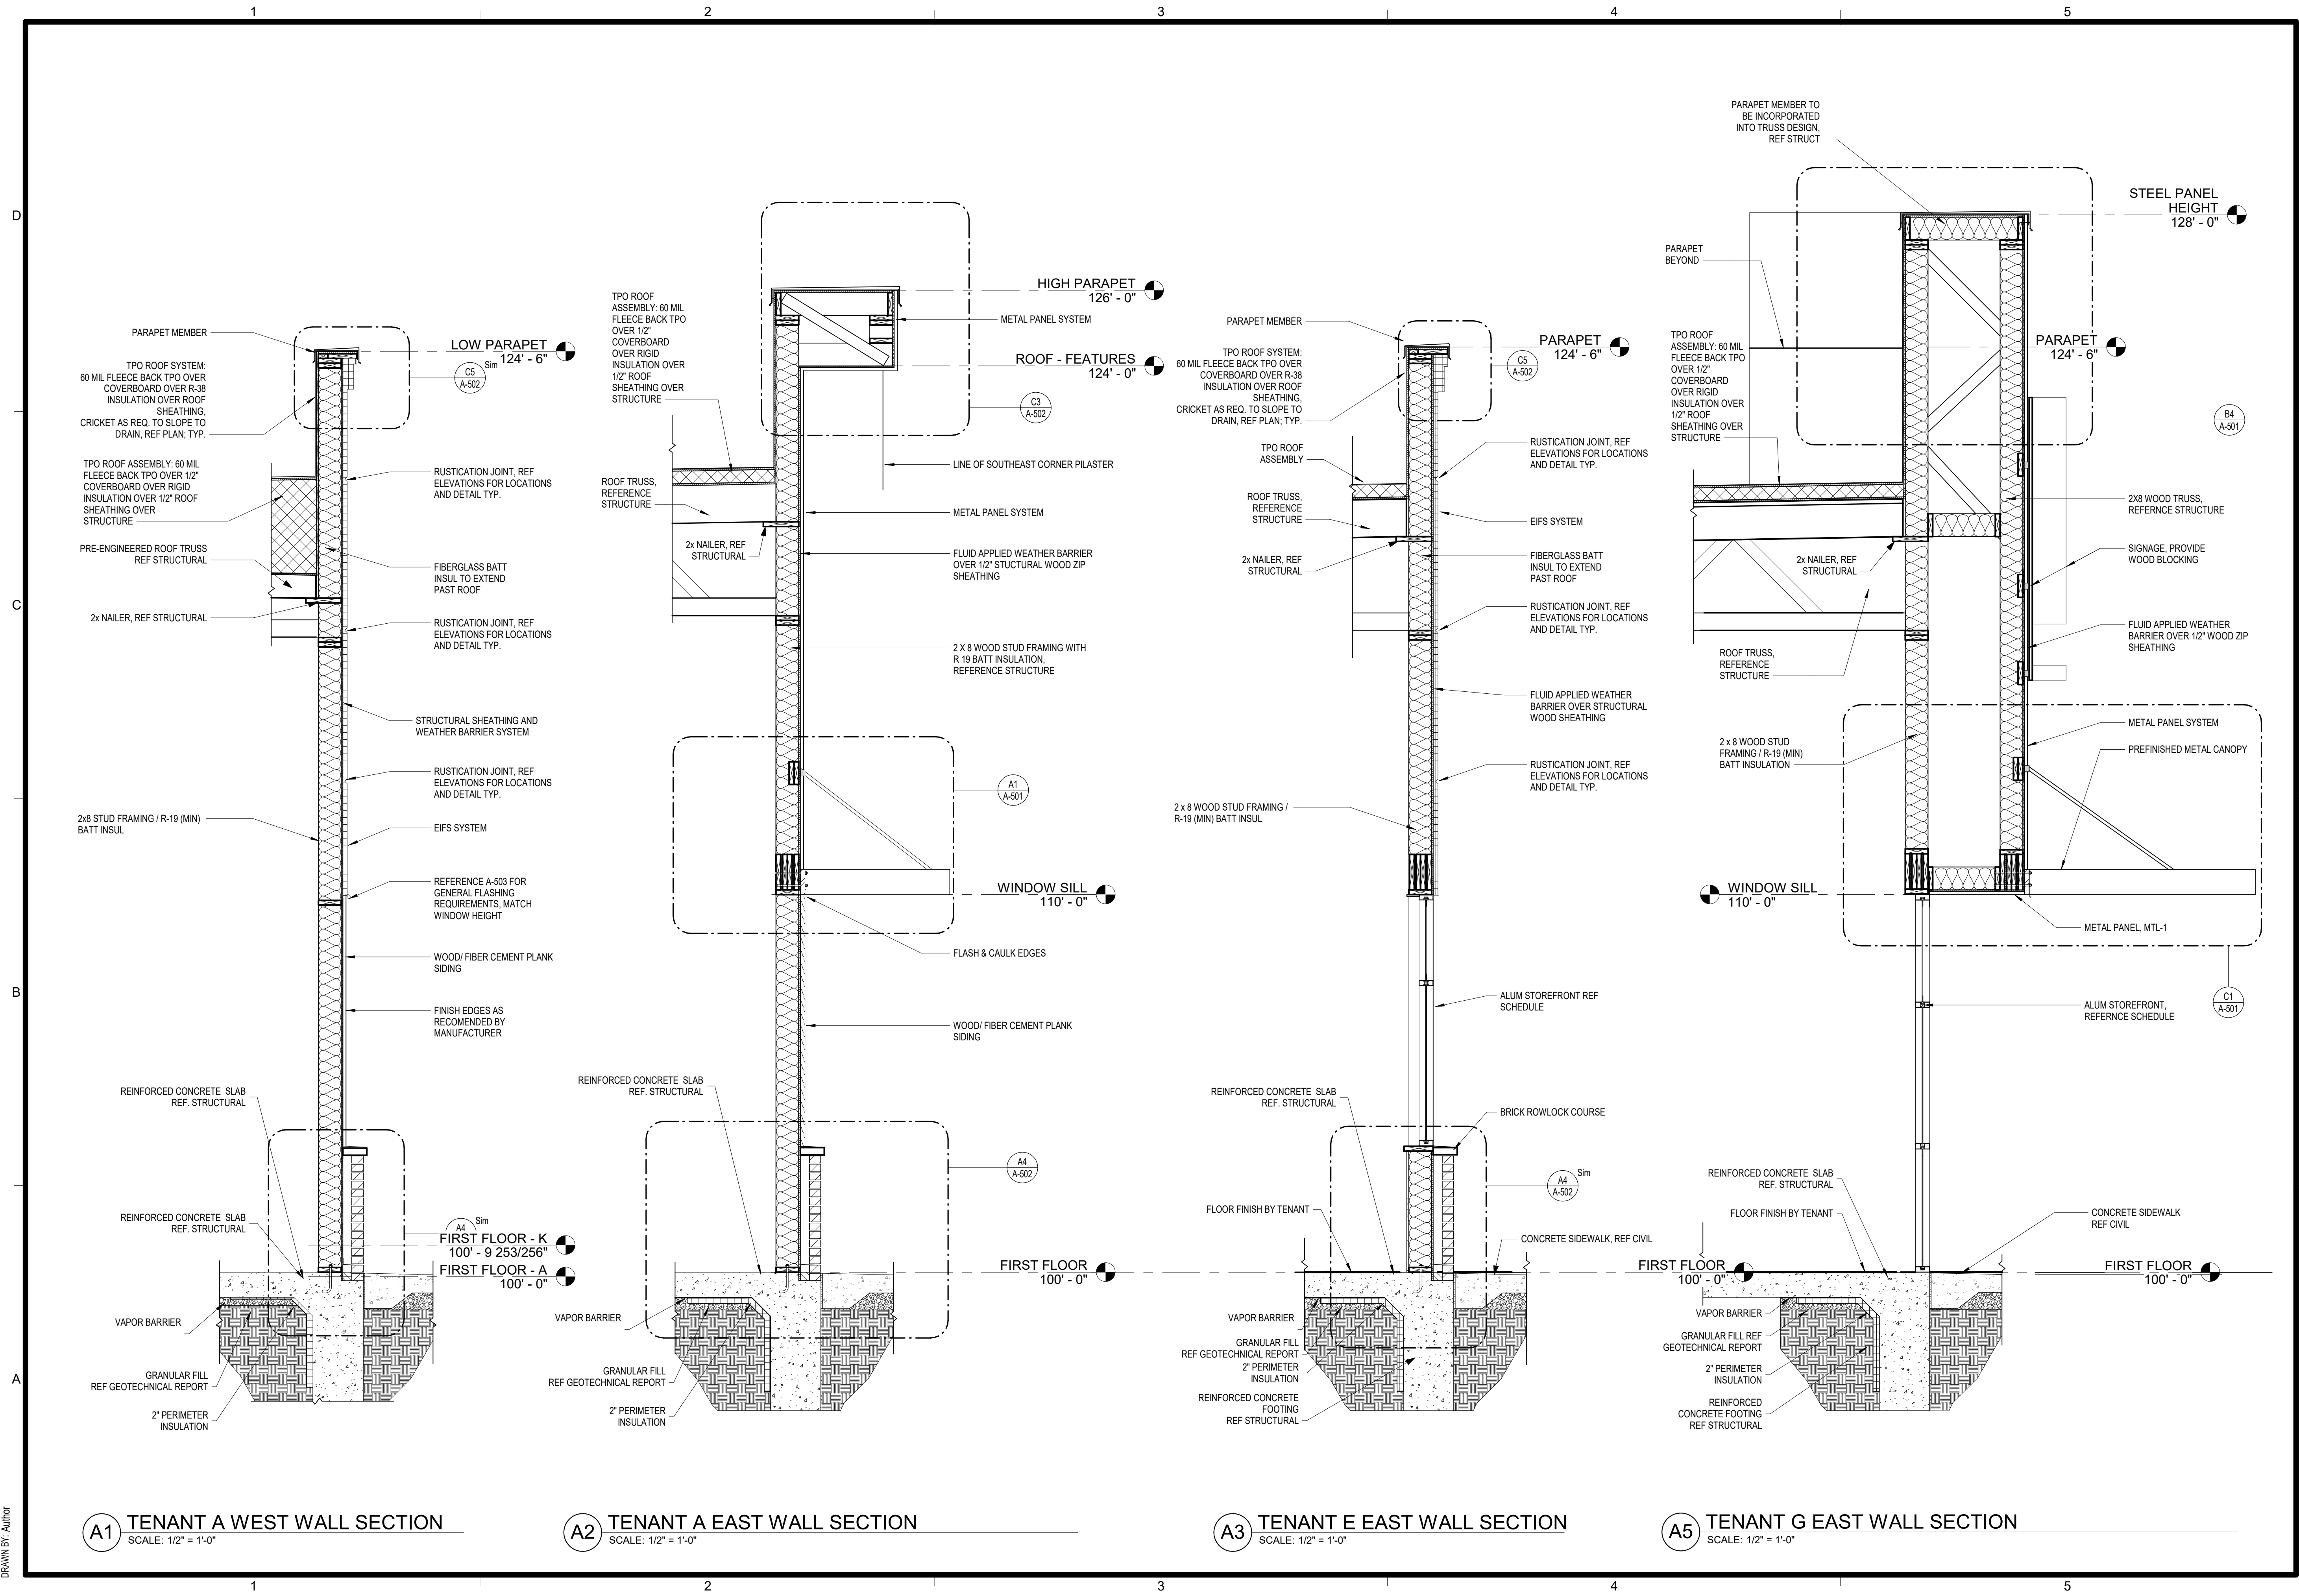

A1 TENANT A WEST WALL SECTION
SCALE: 1/2" = 1'-0"

A2 TENANT A EAST WALL SECTION
SCALE: 1/2" = 1'-0"

A3 TENANT E EAST WALL SECTION
SCALE: 1/2" = 1'-0"

A5 TENANT G EAST WALL SECTION
SCALE: 1/2" = 1'-0"

RELEASED FOR
CONSTRUCTION
As Noted on Plans Review
Development Services Department
01/21/2024

schwerdt design group
architecture | interiors | planning
2231 sw wanamaker rd. suite 303
topeka, kansas 66614-4275
phone: 785.273.7540
fax: 785.273.7579
500 north broadway. suite 200
oklahoma city, ok 73102
phone: 405.231.3105
fax: 405.231.3115

MICHAEL K. HAMPTON
ARCHITECT (MO# A-2008027042)
SCHWERDT DESIGN GROUP INC
MISSOURI STATE CERTIFICATE
OF AUTHORITY #F00353876

CORE & SHELL BUILDING
STREETS OF WEST PRYOR LOT 13
1020 NW PRYOR ROAD, LEES SUMMIT, MISSOURI

SUBMISSION DATES
12-27-2023

SHEET TITLE
WALL SECTIONS

PROJECT NUMBER
235008





SHEET NUMBER
A-301

FILEPATH: F:\1_P\Projects SD\235008 SOWP Lot 13\05_Drawings - Working\Revit\235008 SOWP Lot 13_V23.rvt
DATE: 1/22/2024 11:07:54 AM
DRAWN BY: Author

A2 TENANT A NORTH WALL SECTION @ WINDOWS
SCALE: 1/2" = 1'-0"

A3 TEANAT A NORTH WALL SECTION
SCALE: 1/2" = 1'-0"

A5 TENANT C WEST WALL SECTION
SCALE: 1/2" = 1'-0"

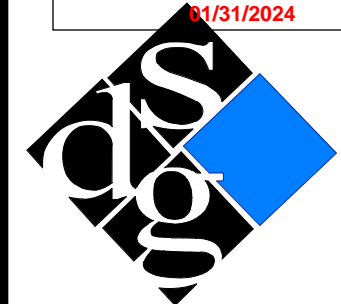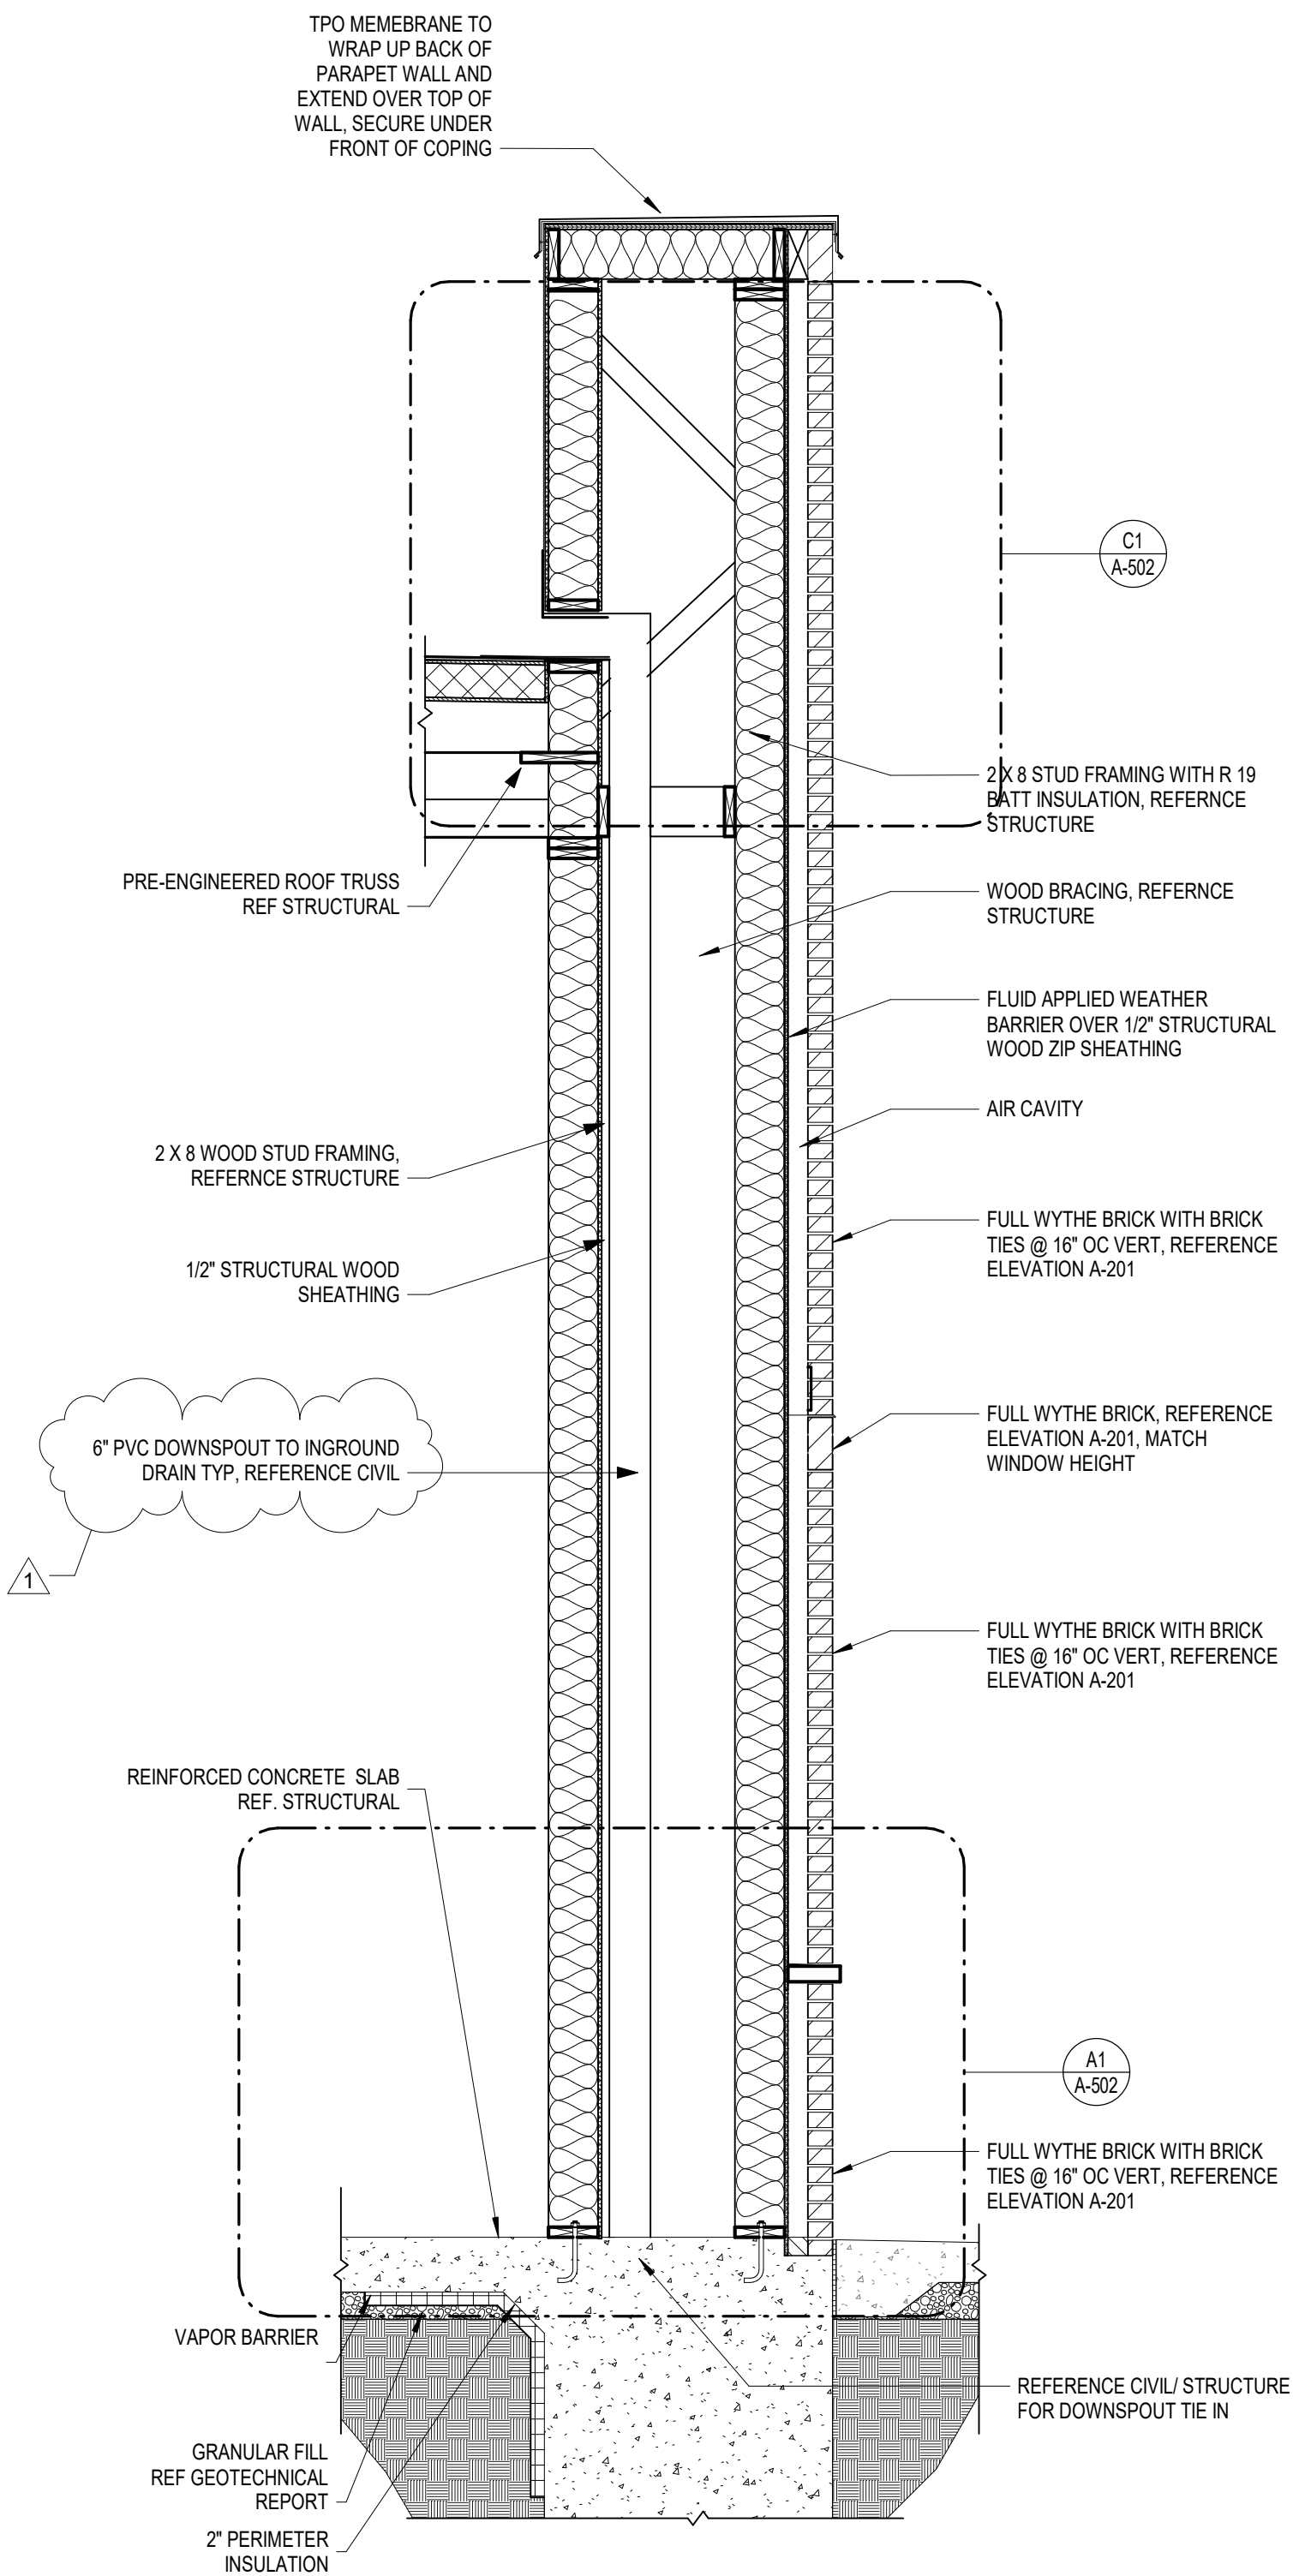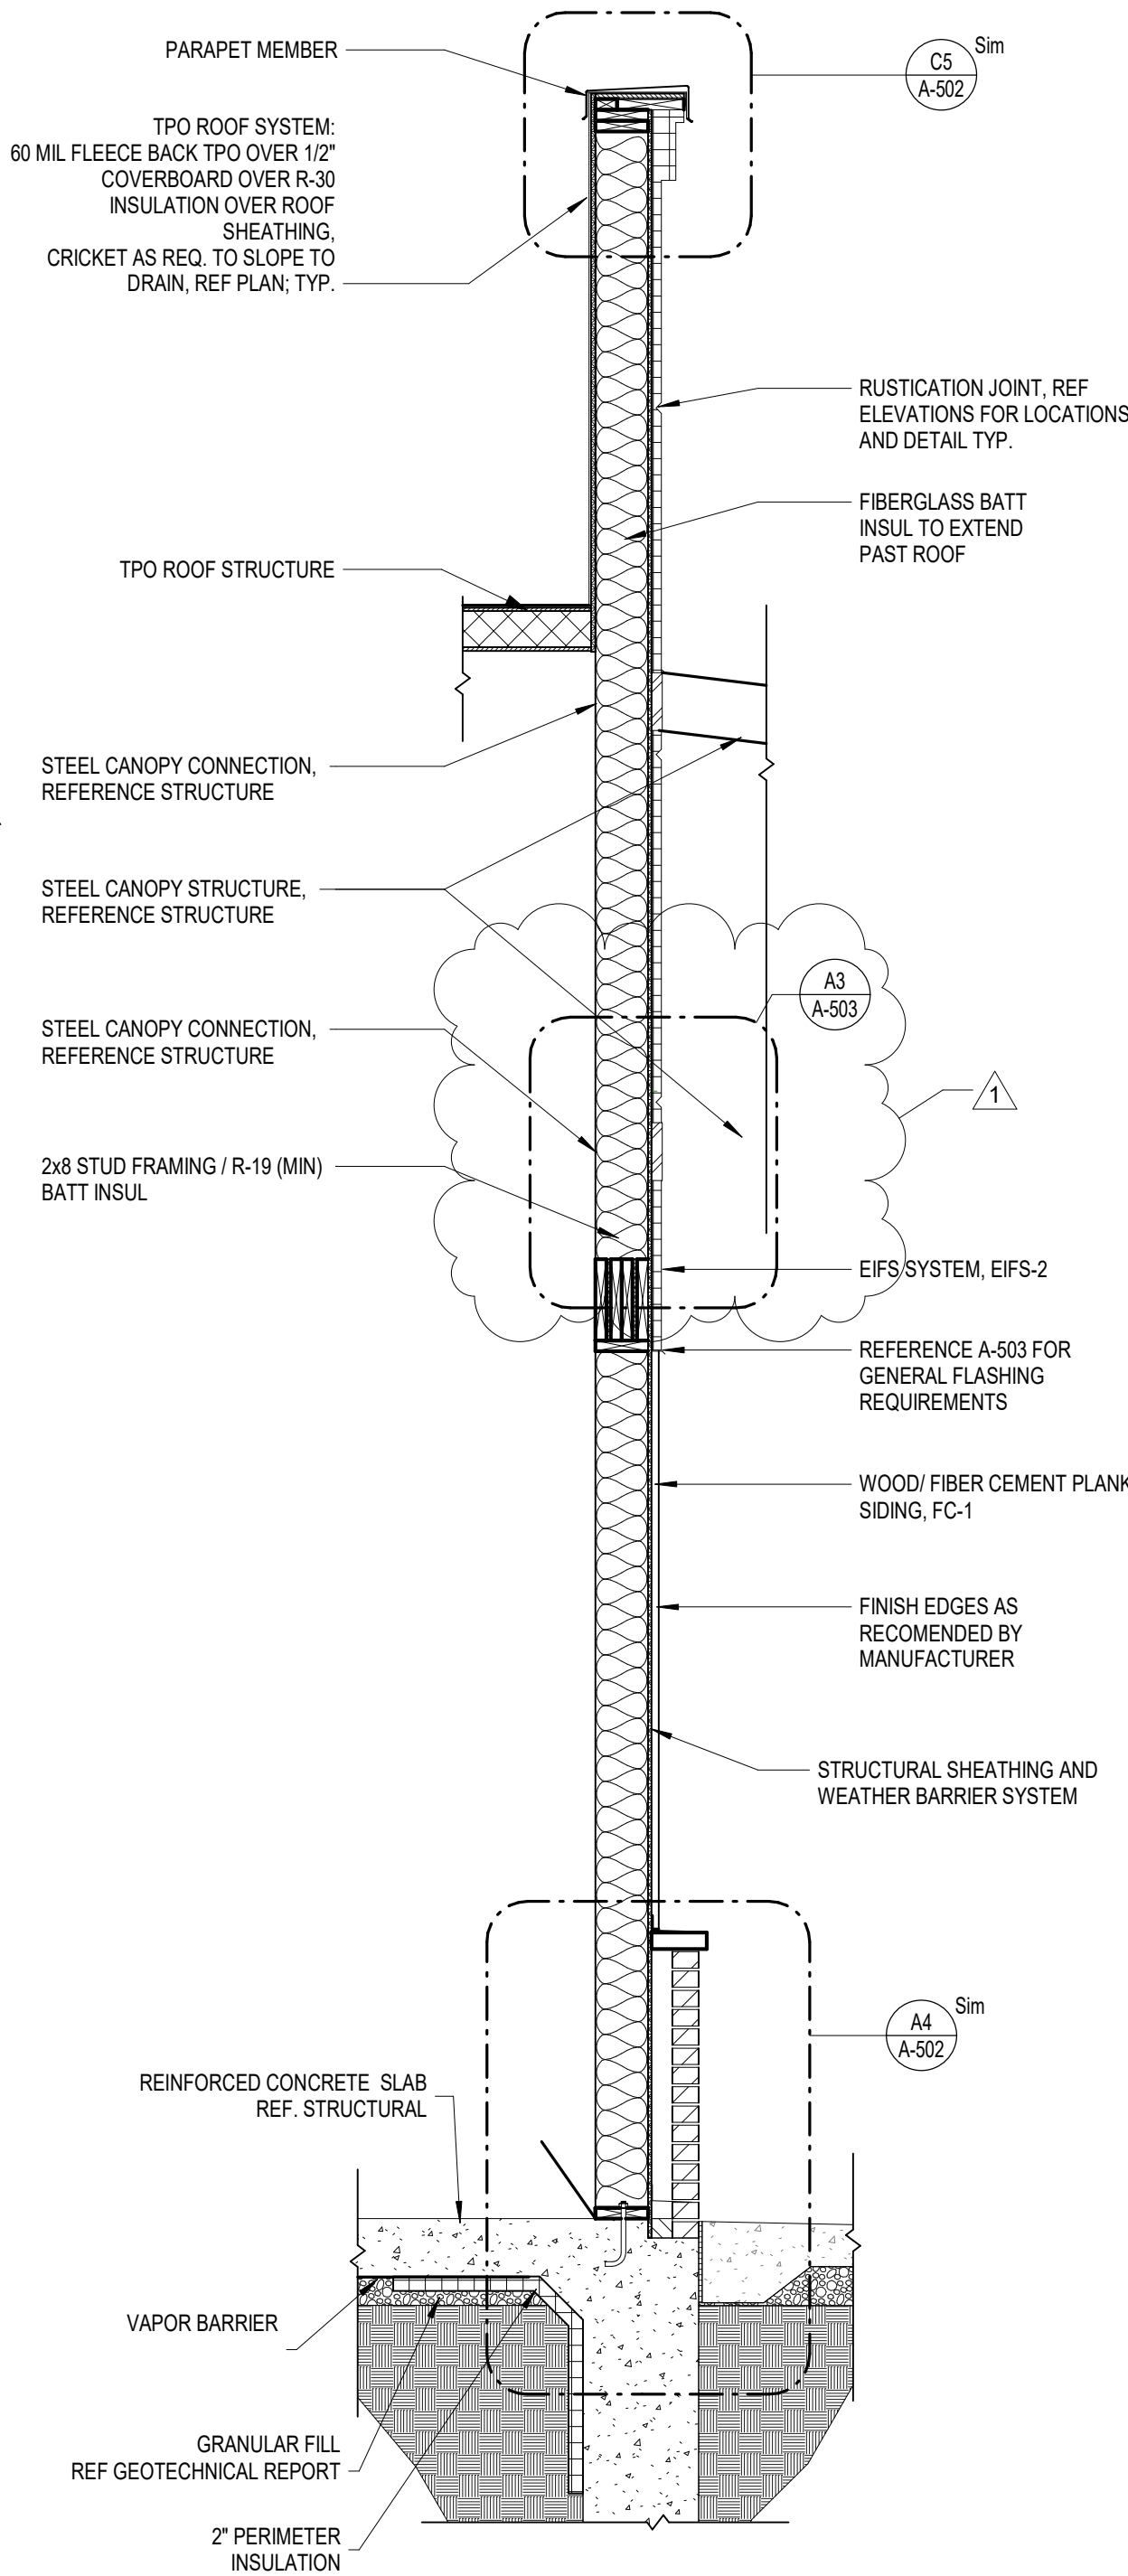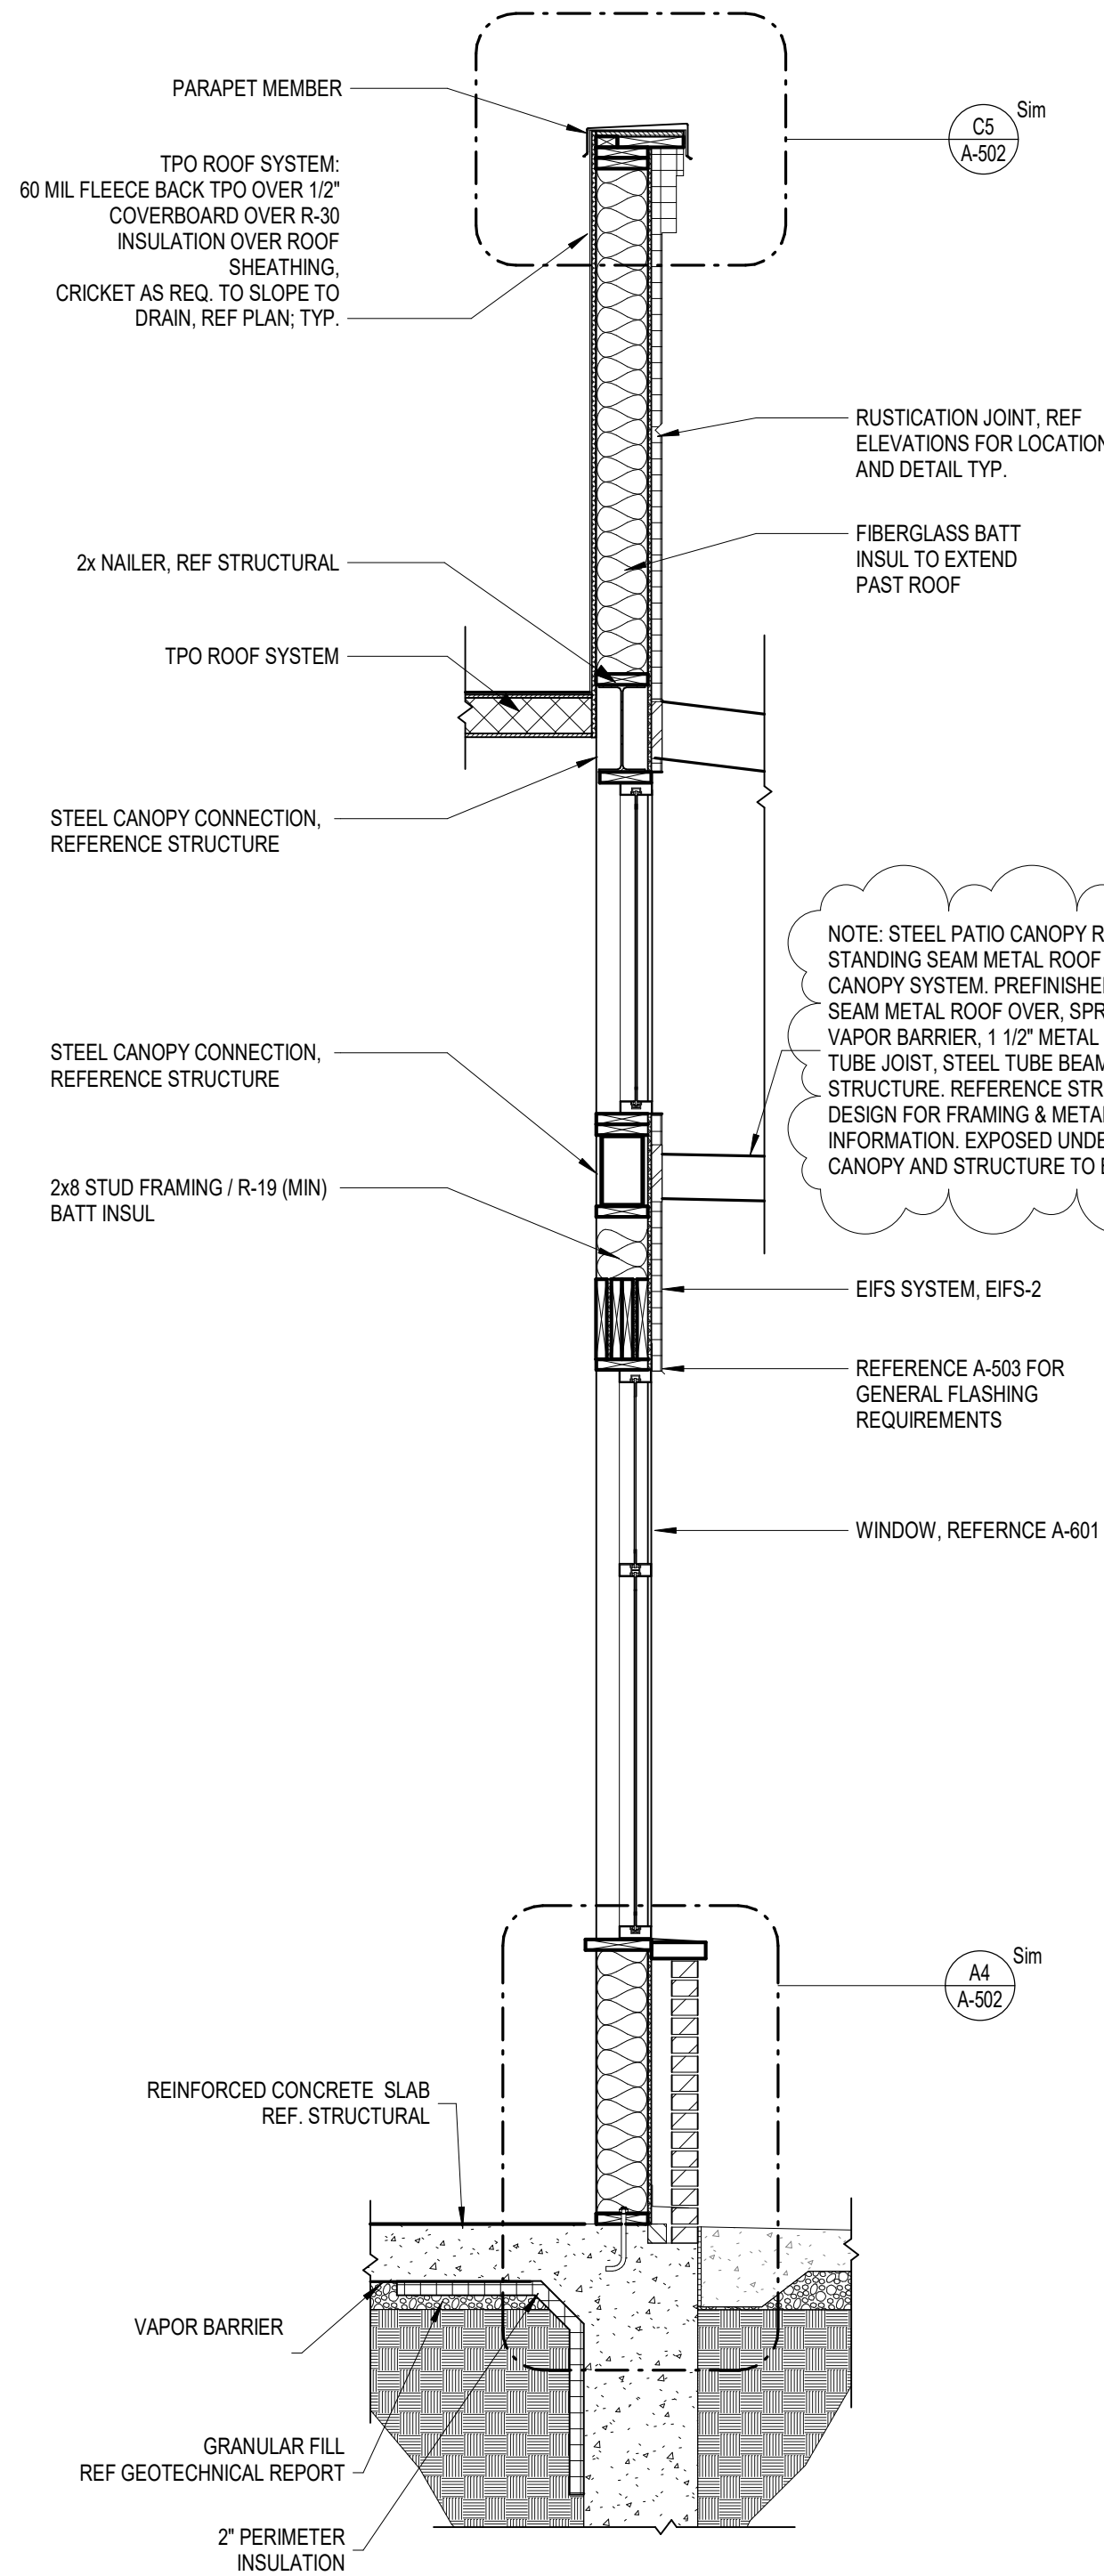

schwerdt design group
architecture | interiors | planning
2231 sw wanamaker rd. suite 303
topeka, kansas 66614-4275
phone: 785.273.7540
fax: 785.273.7579
500 north broadway suite 200
oklahoma city, ok 73102
phone: 405.231.3105
fax: 405.231.3115



MICHAEL K. HAMPTON
ARCHITECT (MO# A-2008027042)
SCHWERDT DESIGN GROUP INC
MISSOURI STATE CERTIFICATE
OF AUTHORITY #00353876

CORE & SHELL BUILDING
STREETS OF WEST PRYOR LOT 13
1020 NW PRYOR ROAD, LEES SUMMIT, MISSOURI


SUBMISSION DATES	
ADD-1	12-27-2023
1	JAN 19TH, 2024

SHEET TITLE
WALL SECTIONS


PROJECT NUMBER
235008

SHEET NUMBER
A-302


FILEPATH: F:\1_P\Projects SDG\235008 SOWP Lot 13\05_Drawings - Working\Revit\235008 SOWP Lot 13_V23.rvt
DATE: 1/22/2024 11:08:01 AM
DRAWN BY: Author

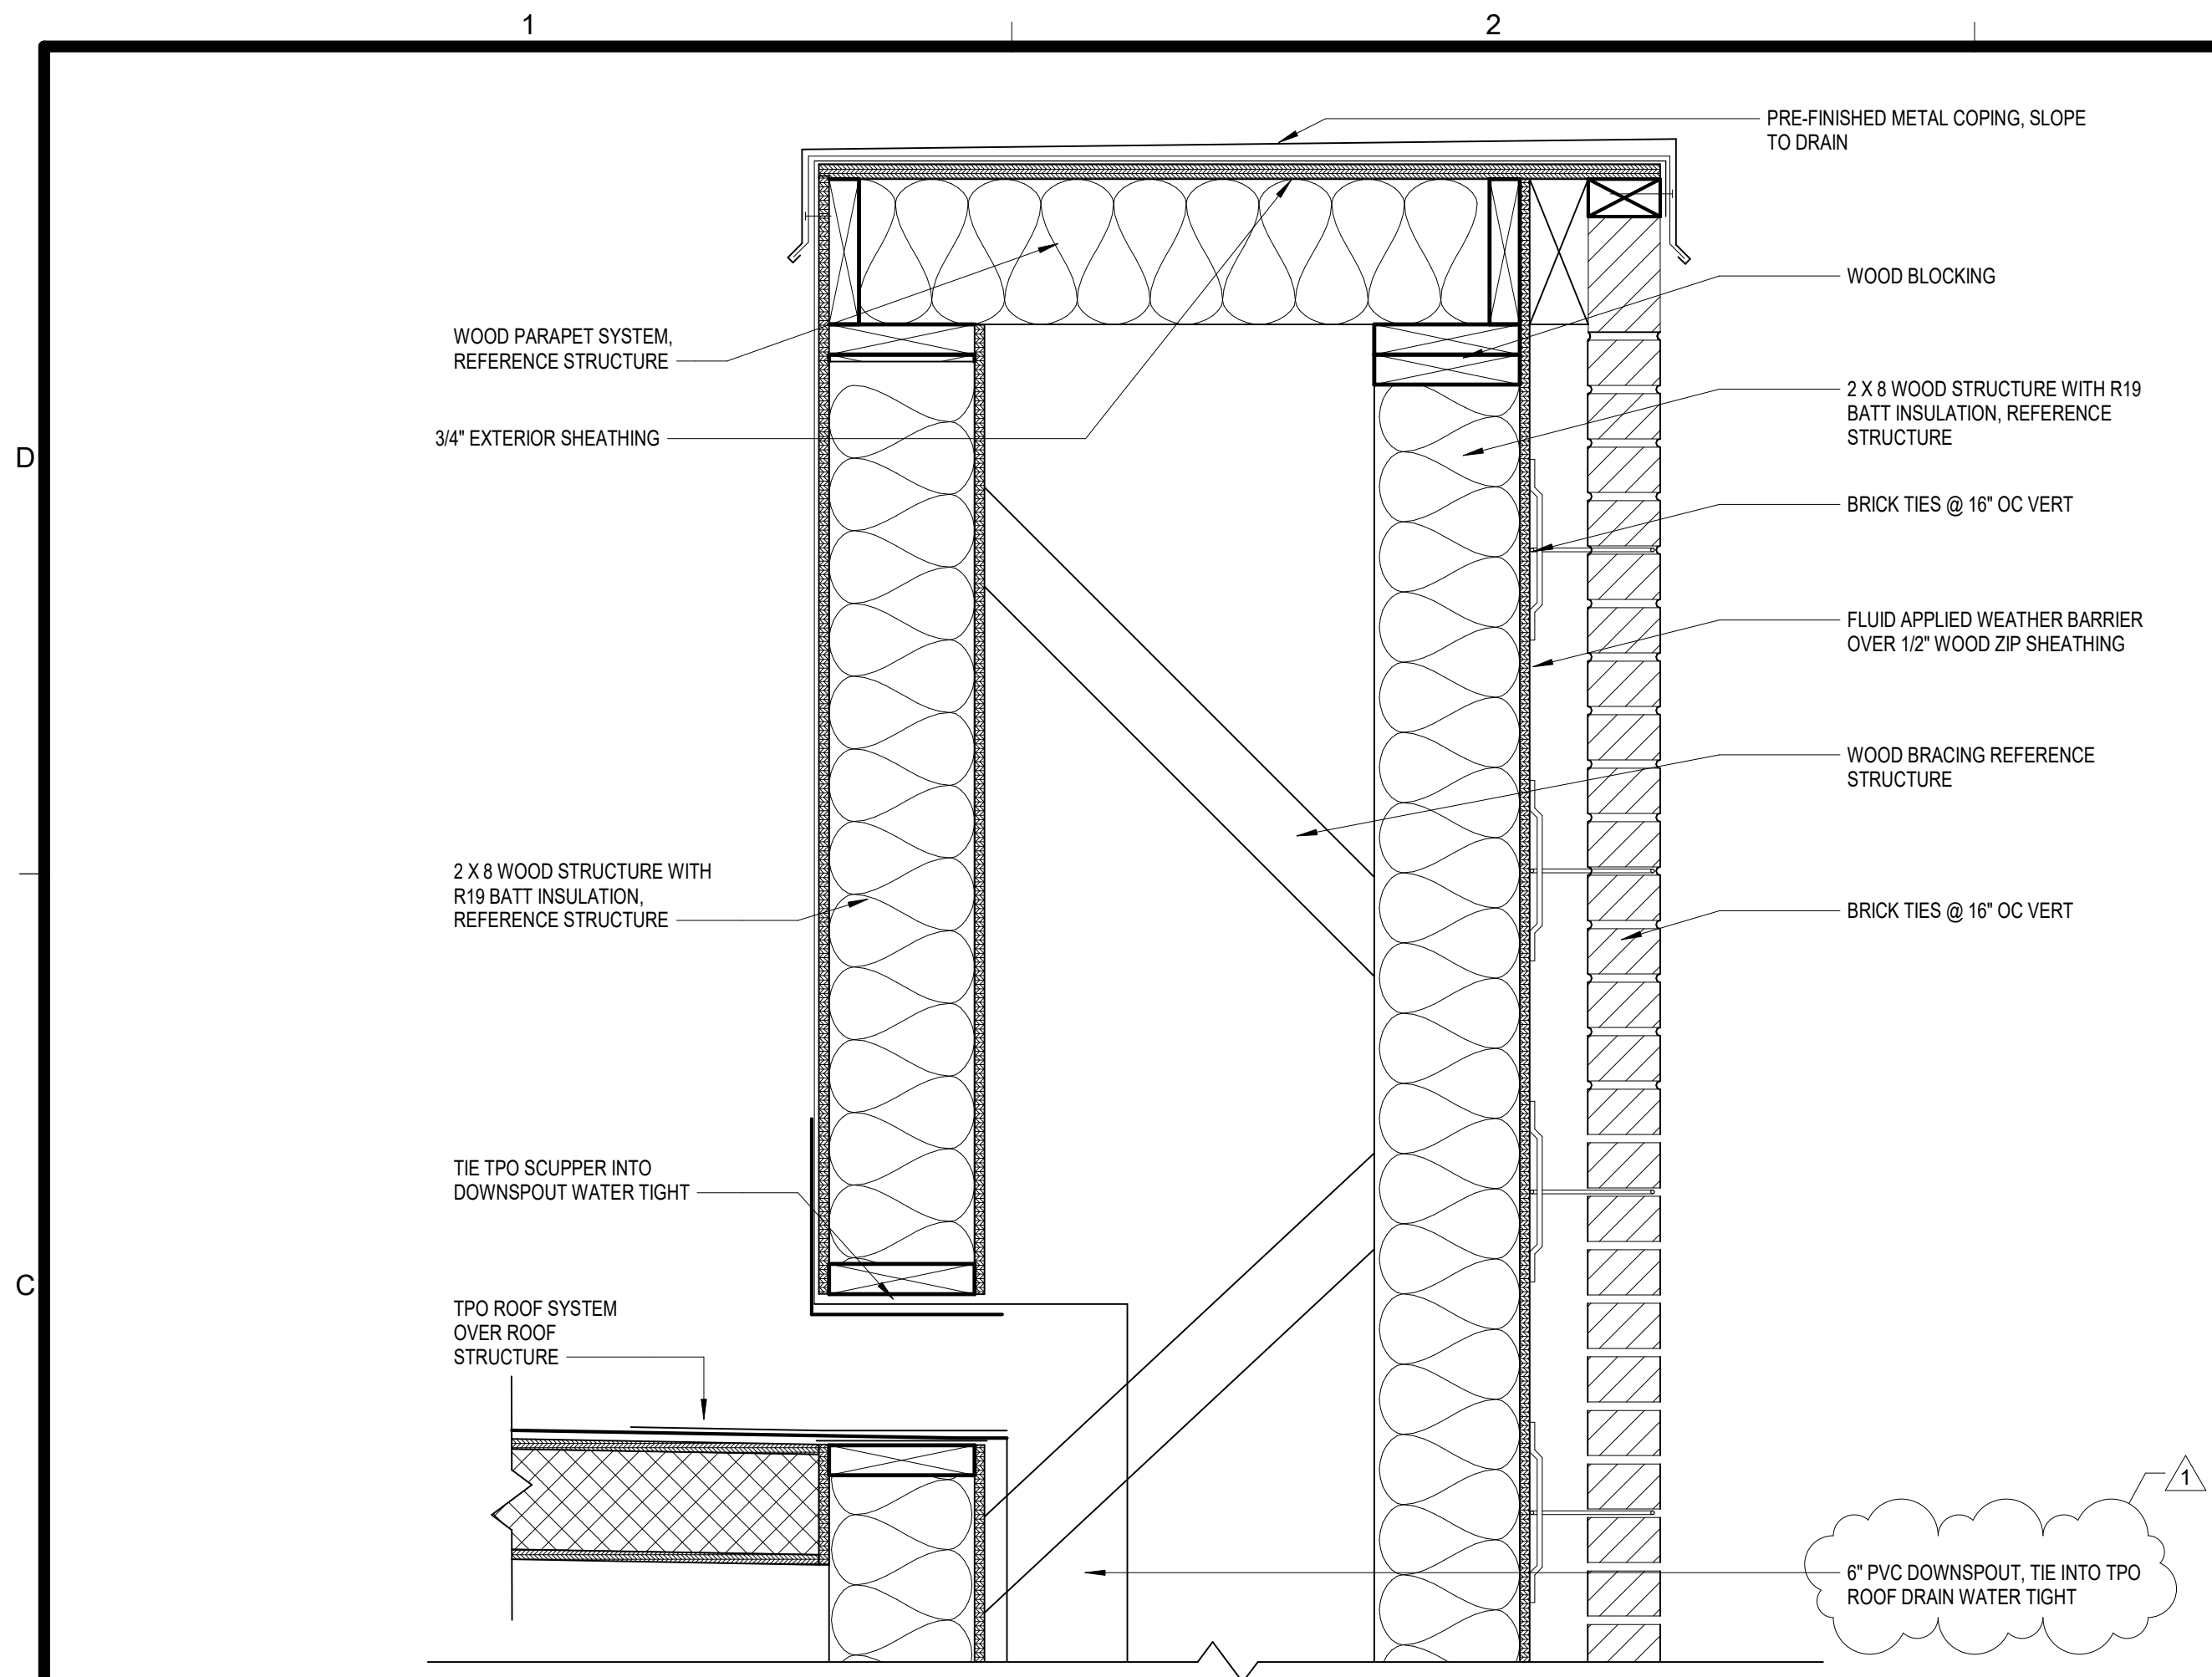


C1 PILASTER PARAPET @ WEST WALL
SCALE: 1 1/2" = 1'-0"

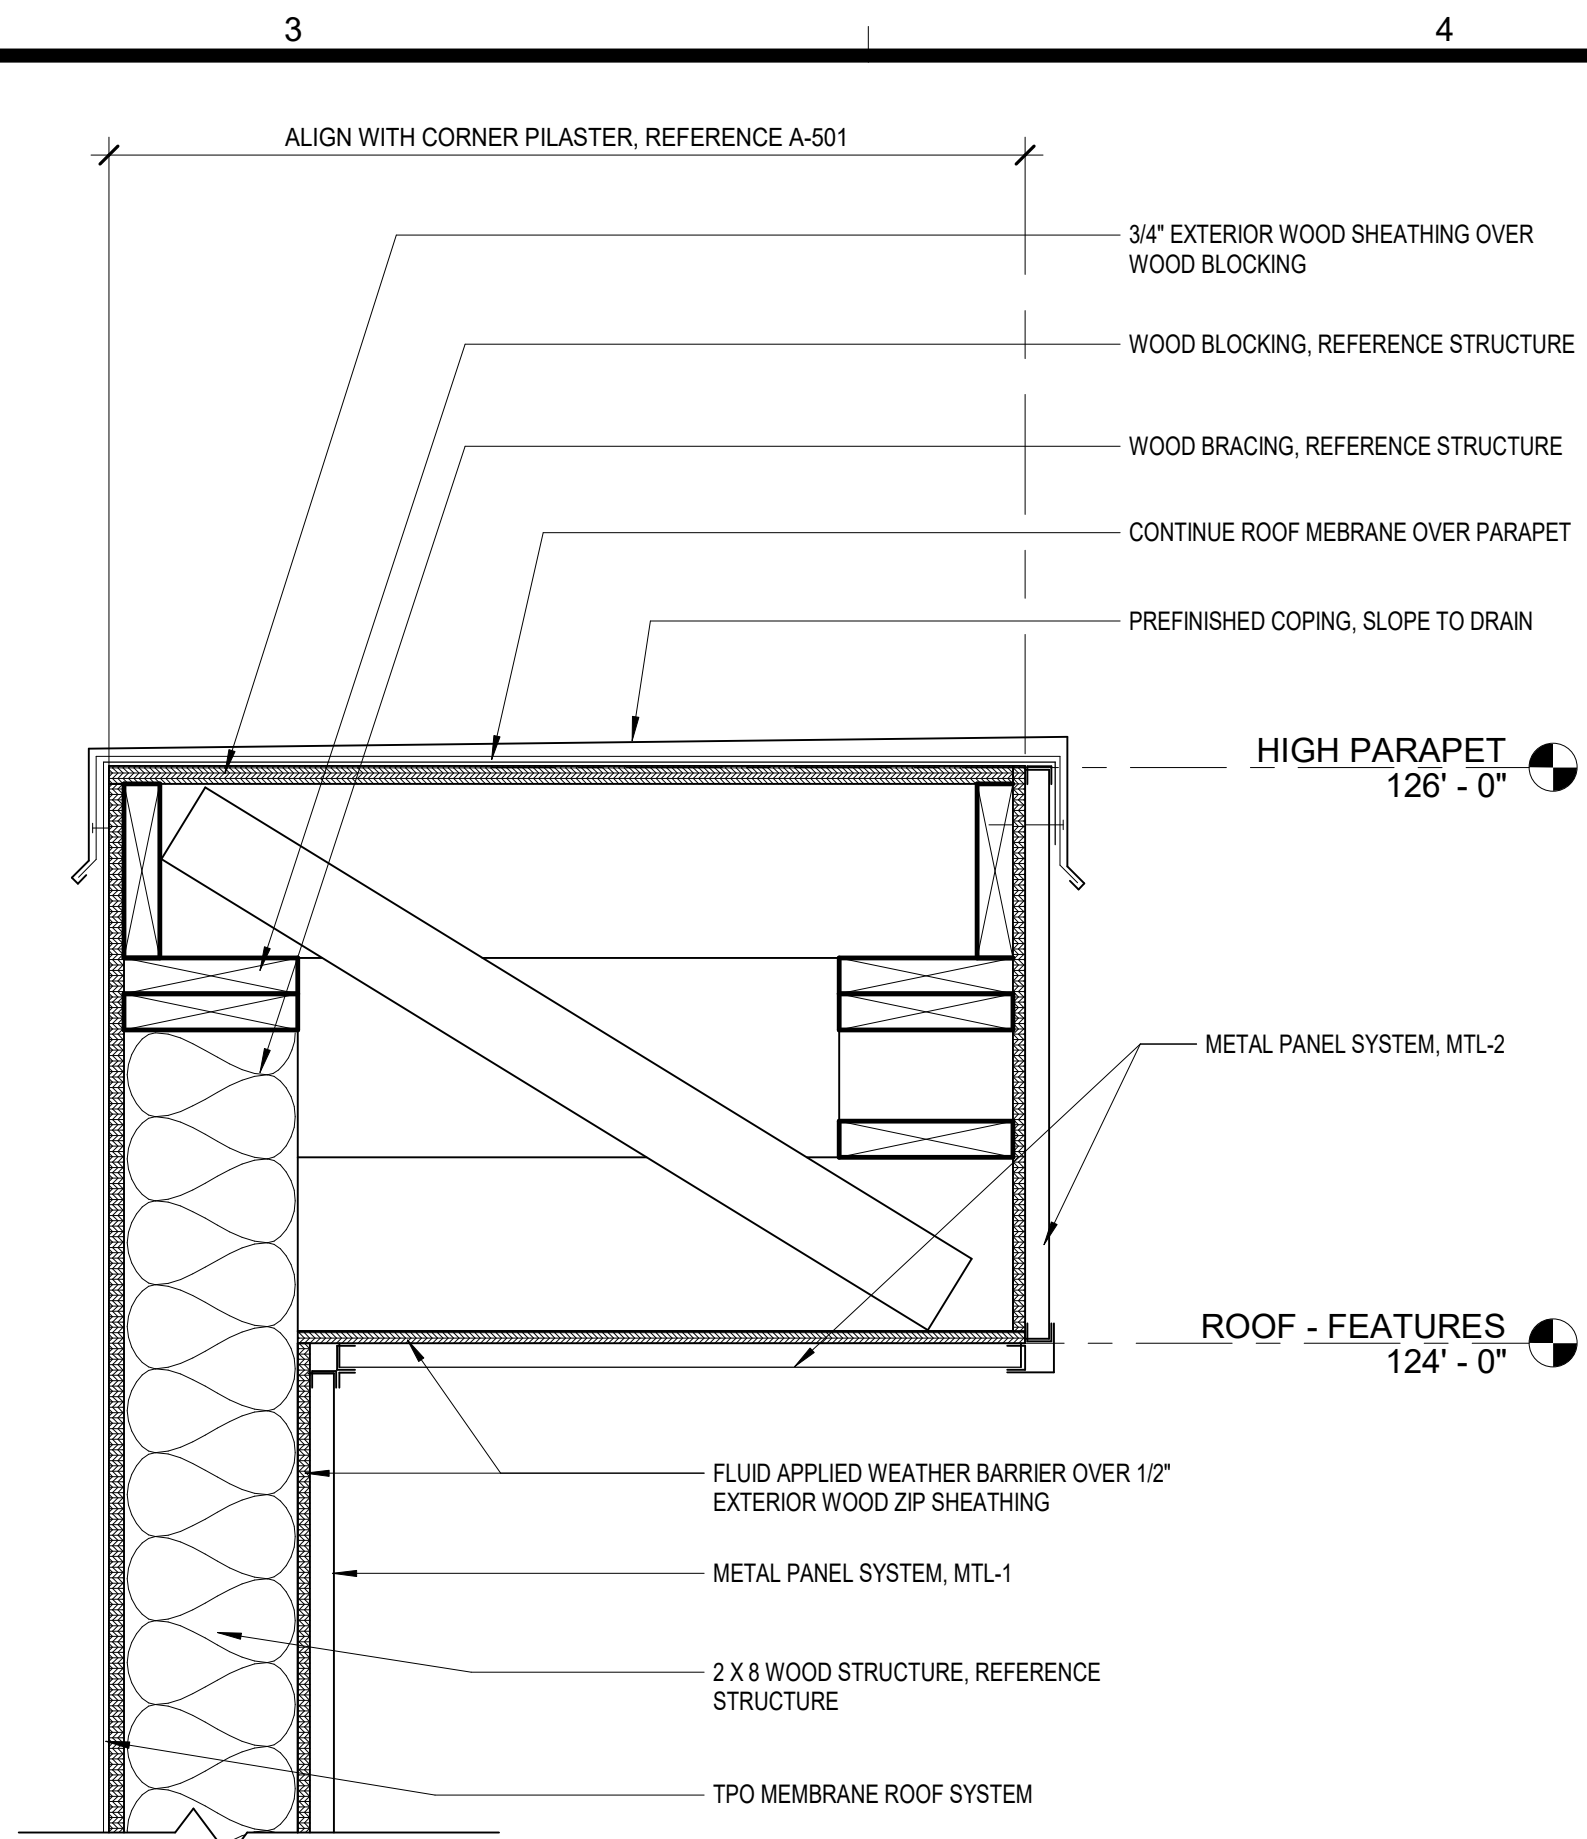


C3 TENANT A PARAPET @ EAST WALL
SCALE: 1 1/2" = 1'-0"

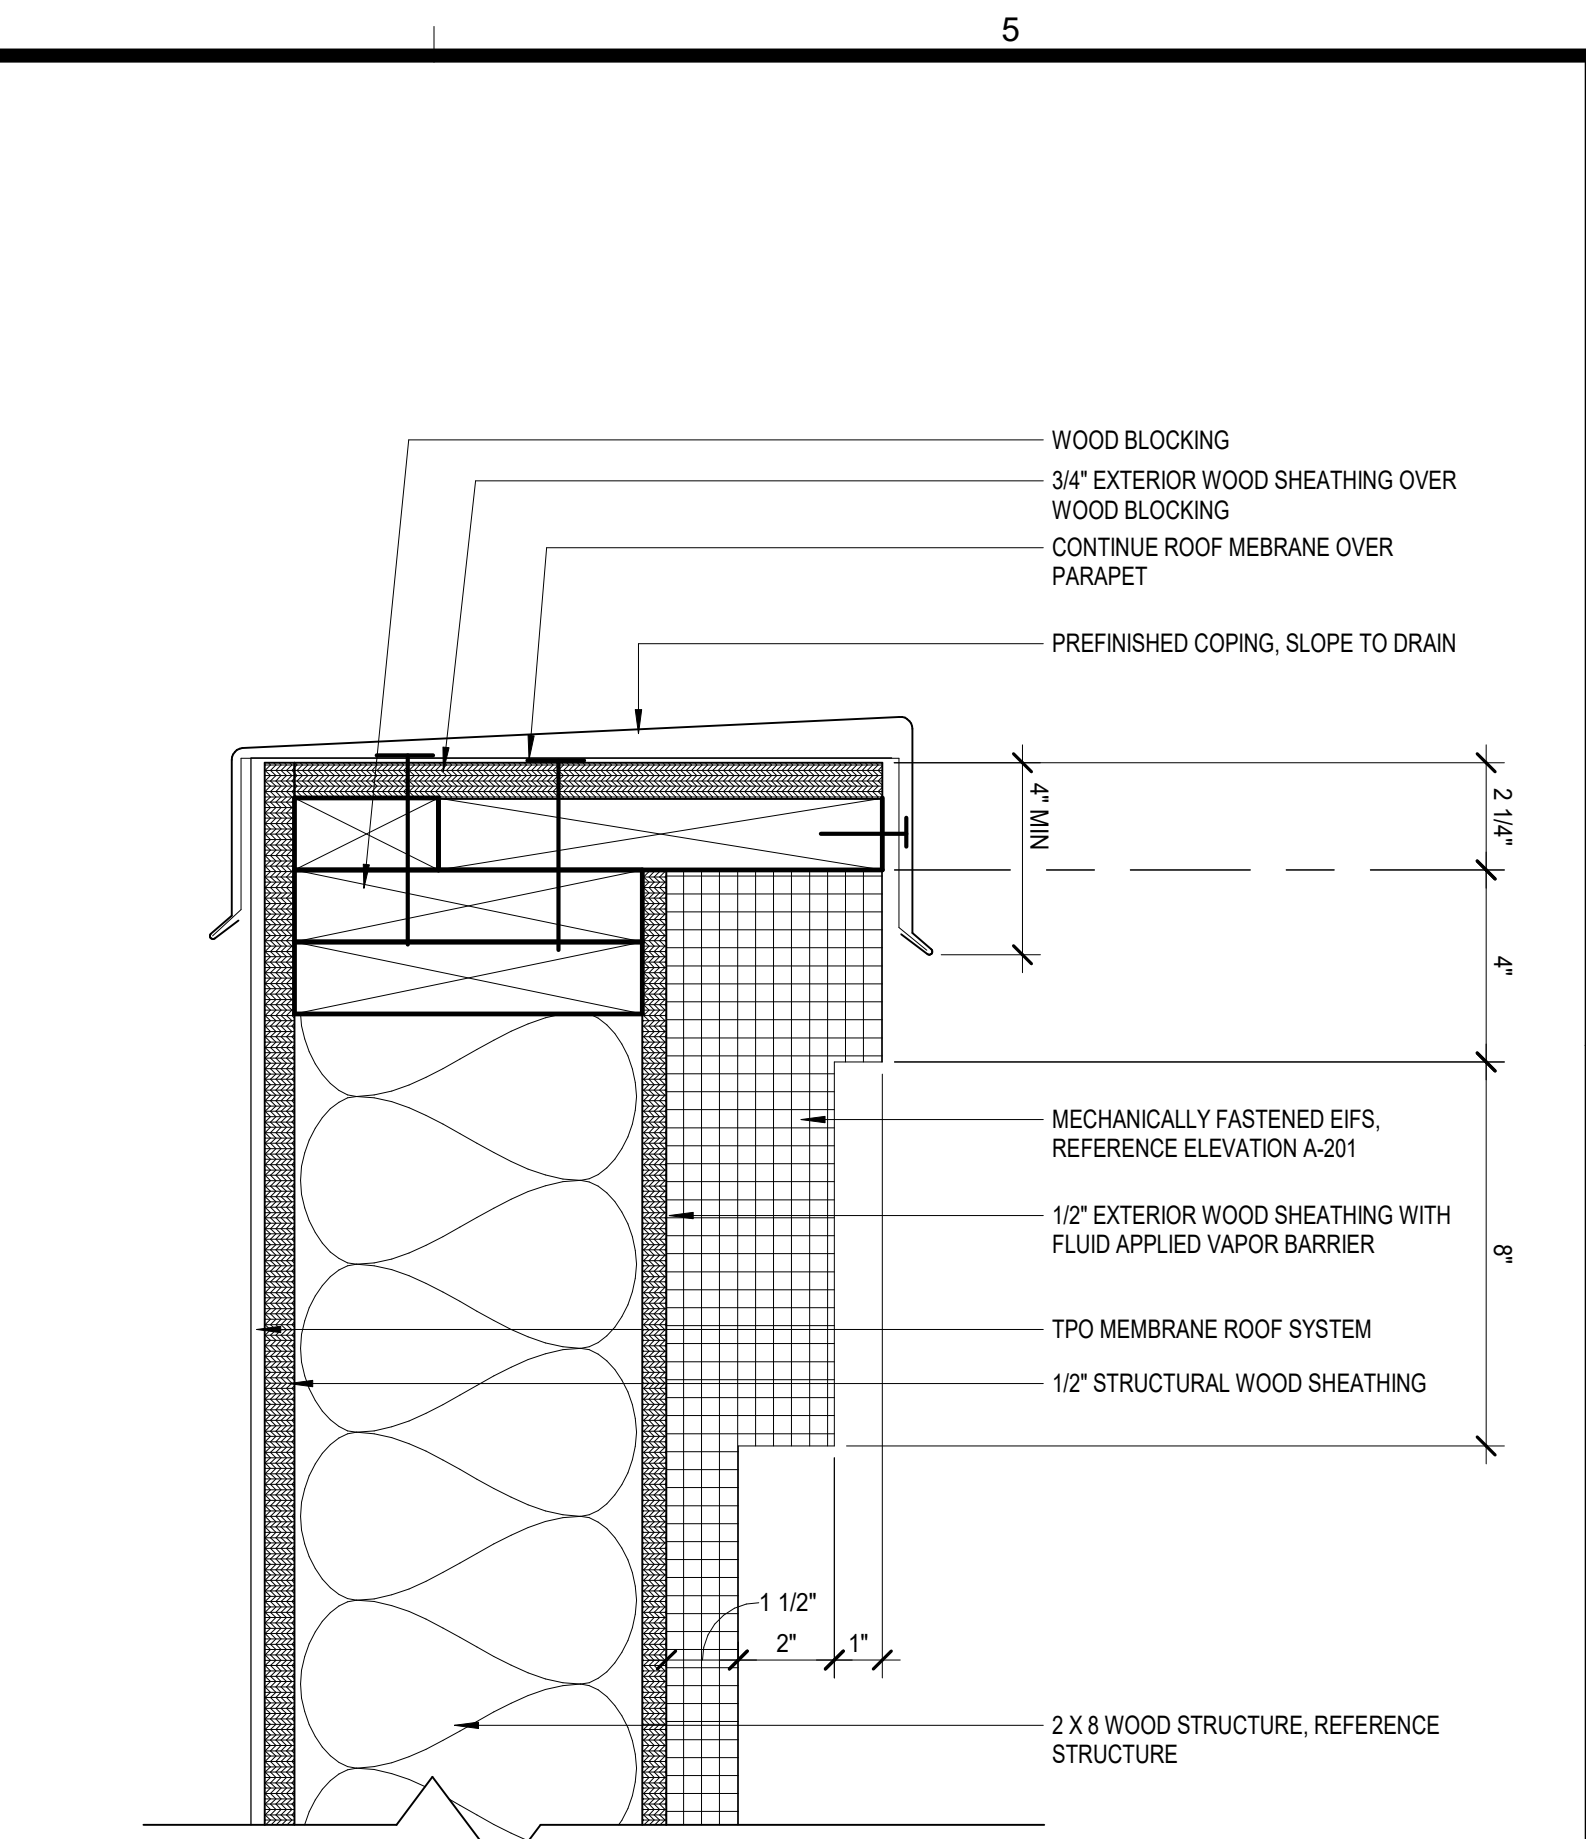

C5 TYPICAL EIFS PARAPET
SCALE: 3" = 1'-0"

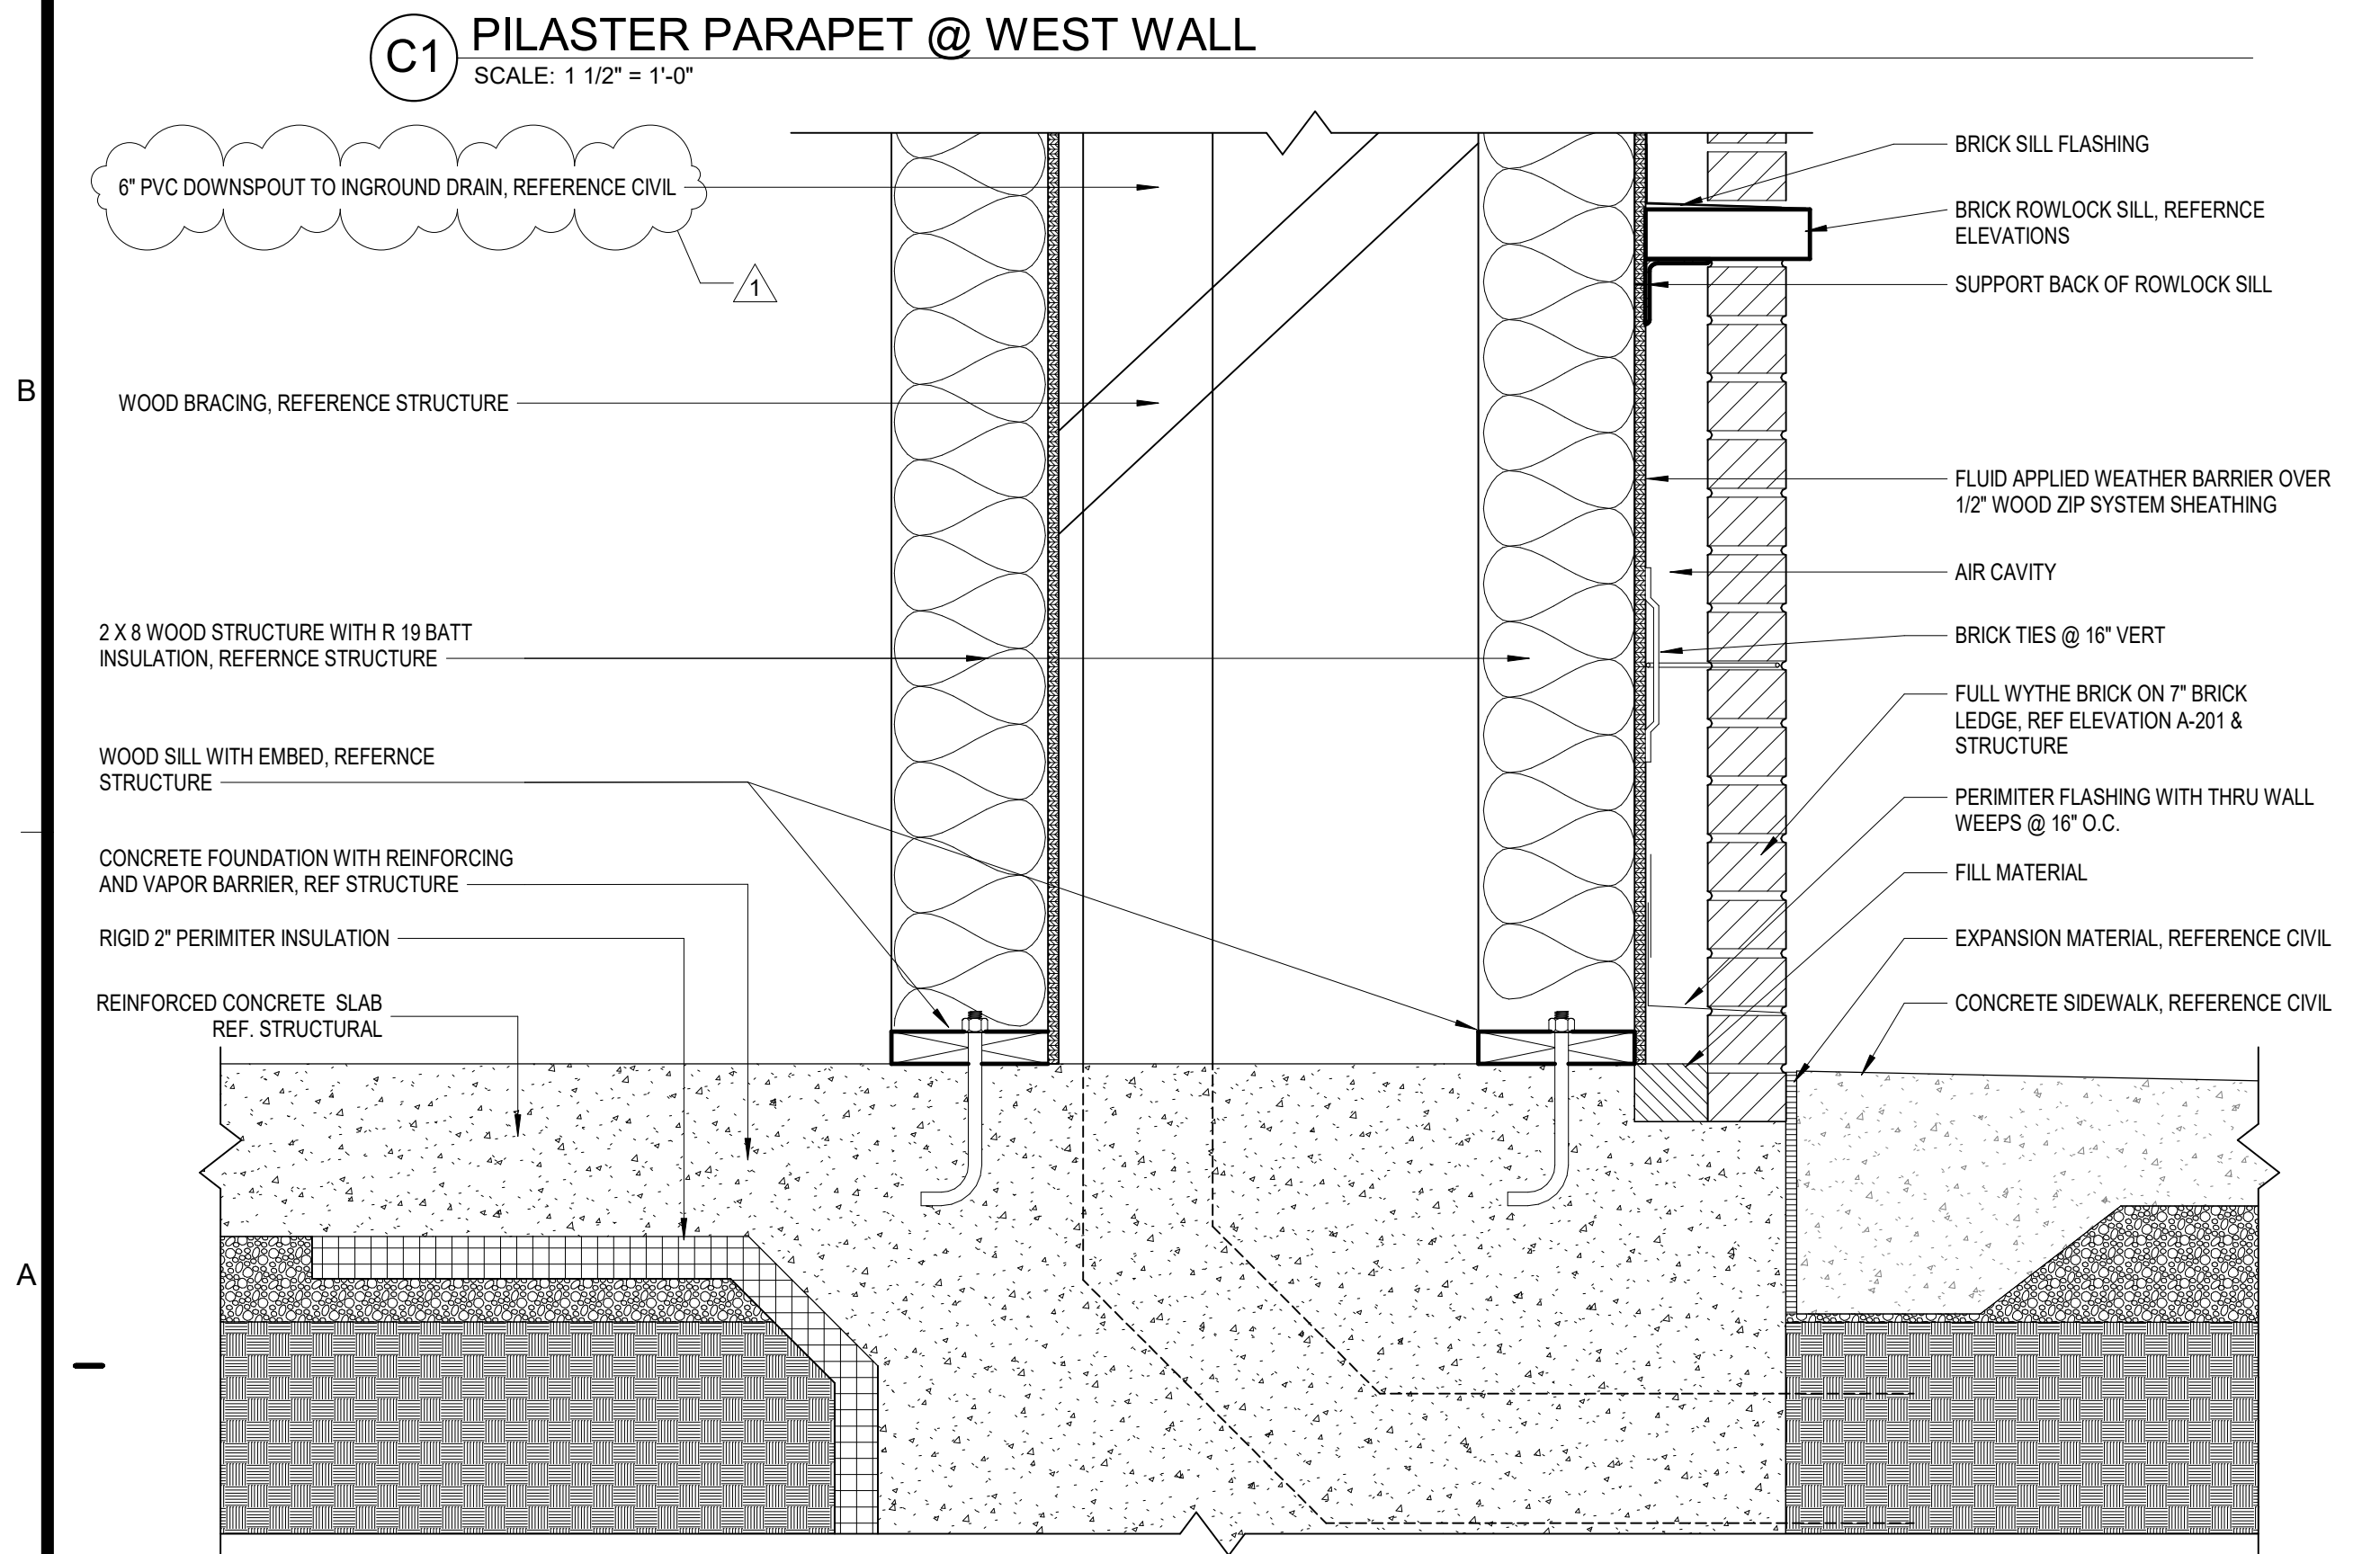

A1 PILASTER BASE @ WEST WALL
SCALE: 1 1/2" = 1'-0"

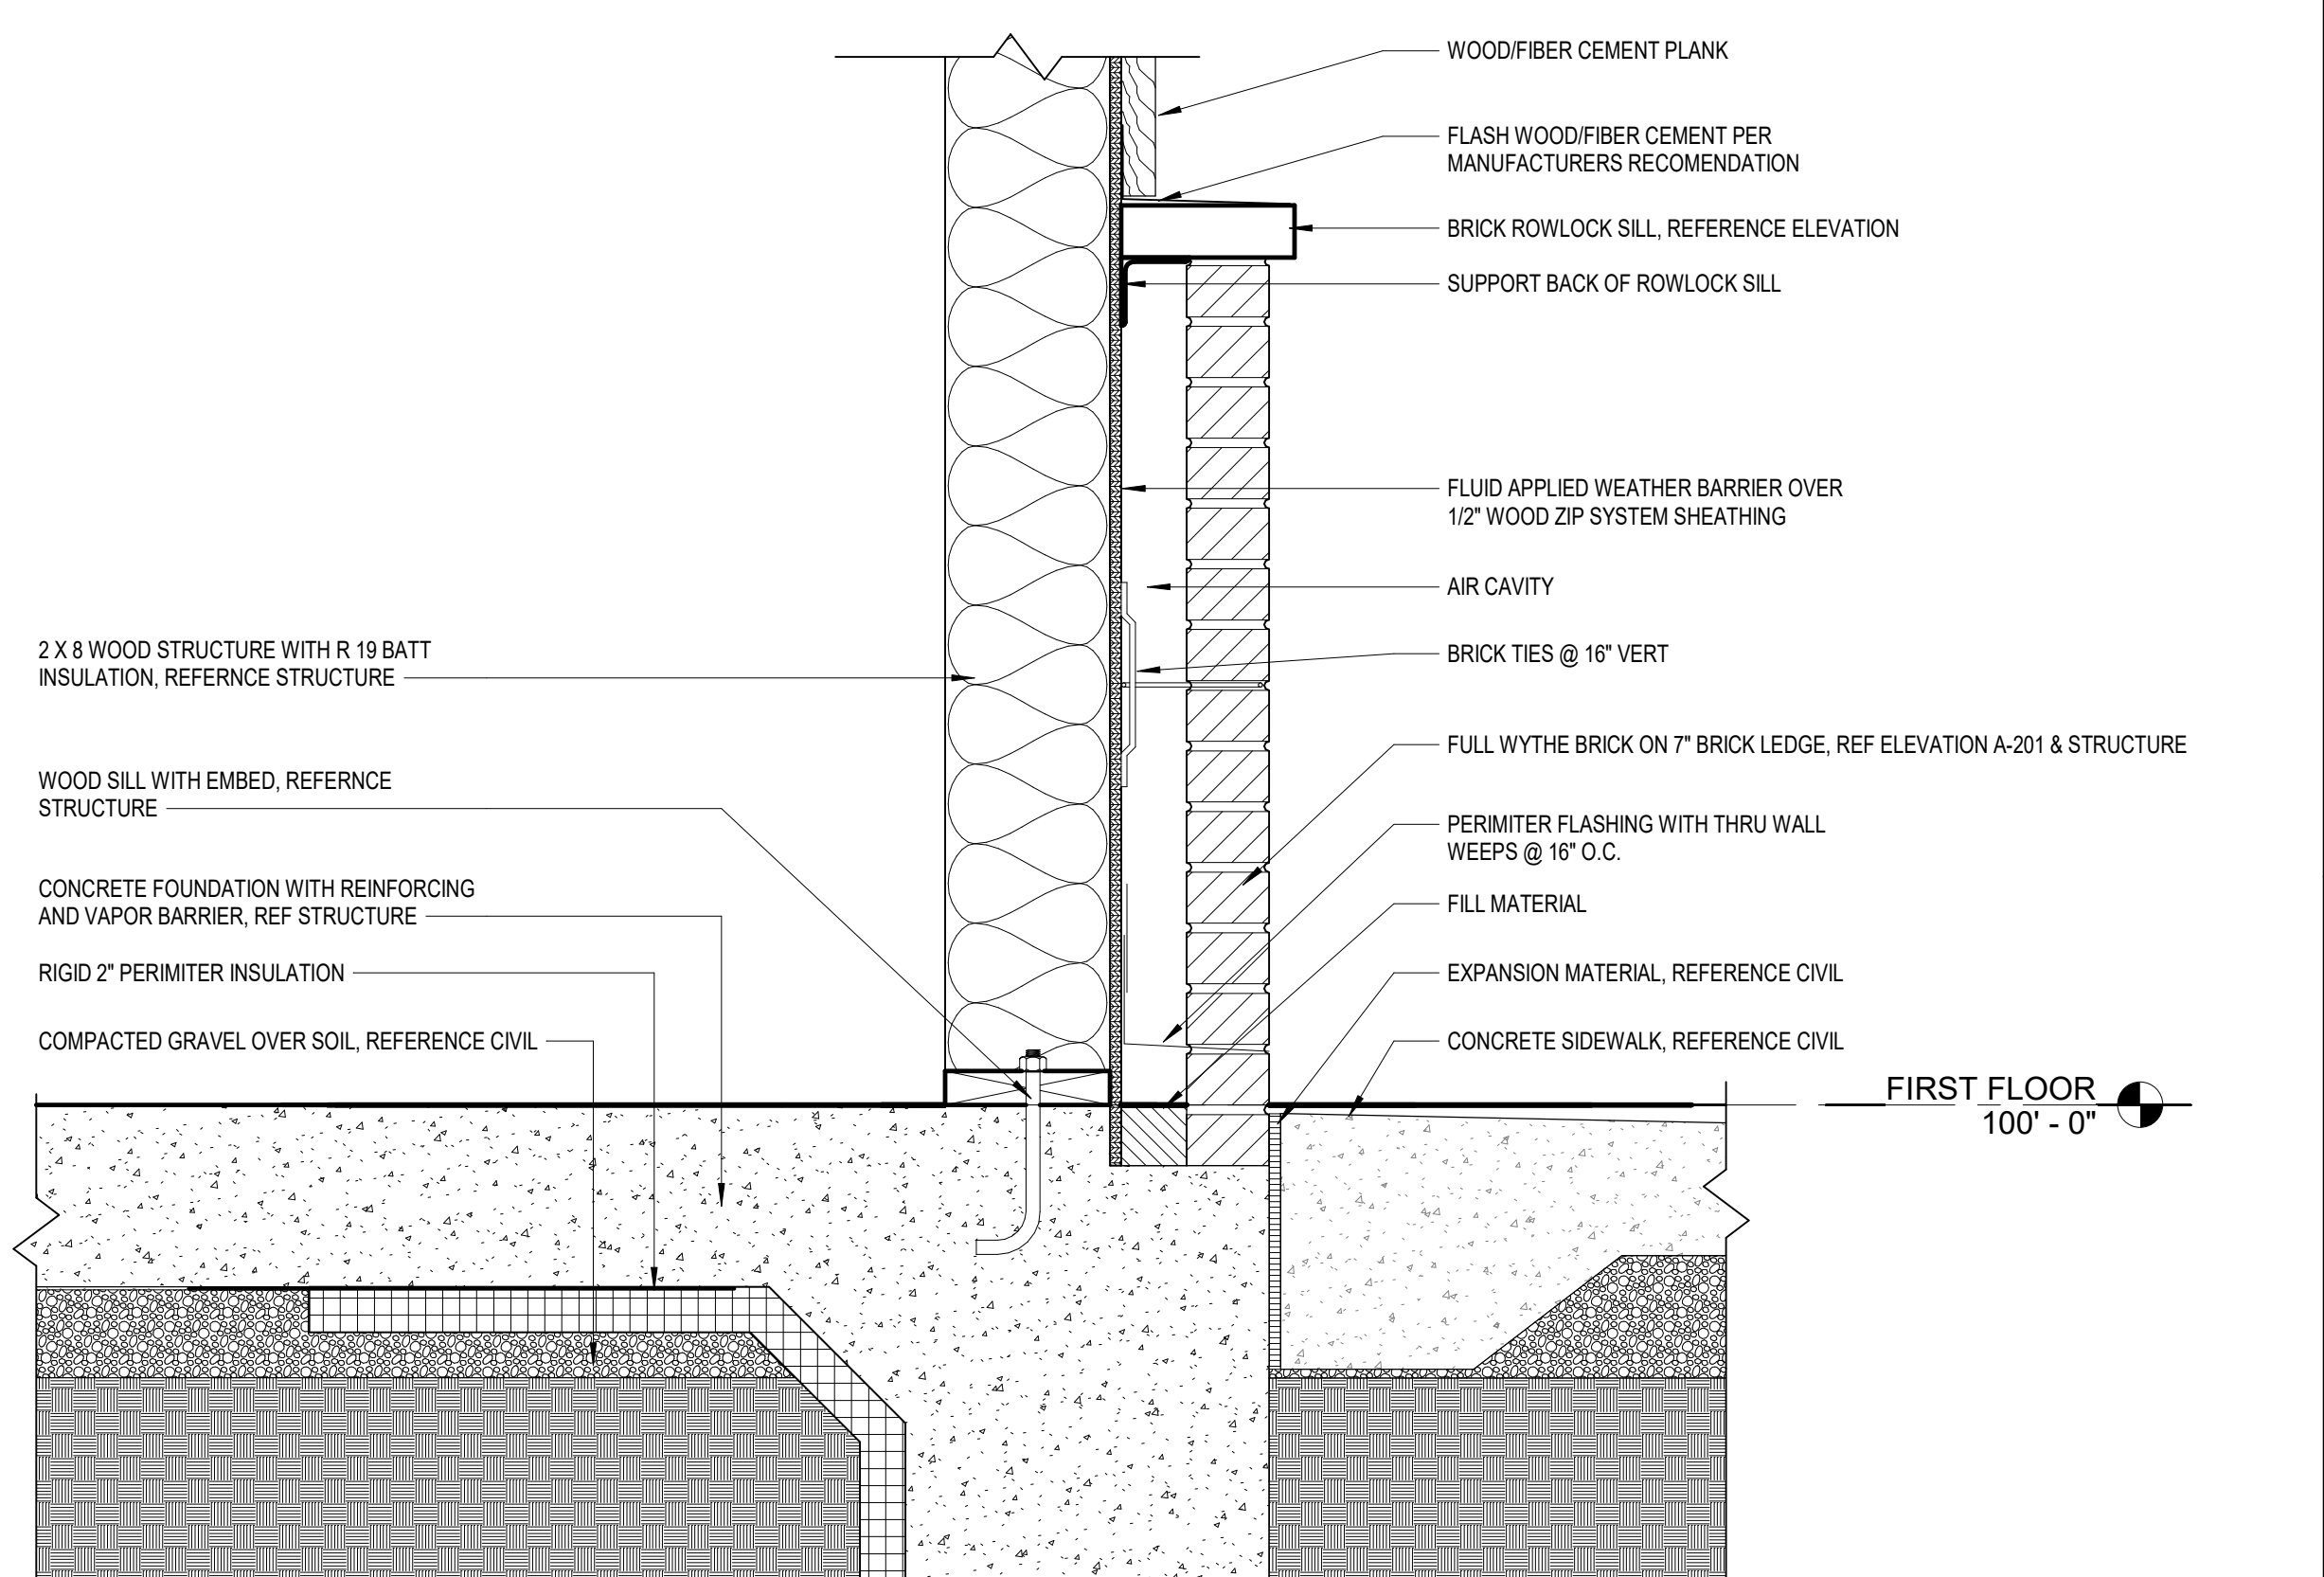

A4 WALL BASE SECTION
SCALE: 1 1/2" = 1'-0"

RELEASED FOR
CONSTRUCTION
As Noted on Plans Review
Development Services Department
01/21/2024

schwerdt design group
architecture | interiors | planning
2231 sw wanamaker rd. suite 303
topeka, kansas 66614-4275
phone: 785.273.7540
fax: 785.273.7579
500 north broadway
oklahoma city, ok 73102
phone: 405.231.3105
fax: 405.231.3115

MICHAEL K HAMPTON
ARCHITECT (MO# A-2008027042)
SCHWERDT DESIGN GROUP INC
MISSOURI STATE CERTIFICATE
OF AUTHORITY #00353876

**CORE & SHELL BUILDING
STREETS OF WEST PRYOR LOT 13**
1020 NW PRYOR ROAD, LEES SUMMIT, MISSOURI

SUBMISSION DATES	
ADD-1	12-27-2023 JAN 19TH, 2024


SHEET TITLE	
BUILDING DETAILS	

PROJECT NUMBER	
235008	


SHEET NUMBER	
A-502	

FILEPATH: F:\1_P\Projects SD\G235008 SOWP Lot 13\05_Drawings - Working\Revit\235008 SOWP Lot 13_V23.rvt
DATE: 1/22/2024 11:08:01 AM
DRAWN BY: Author


A1 FIRE BARRIER DETAILS
SCALE: 1" = 1'-0"

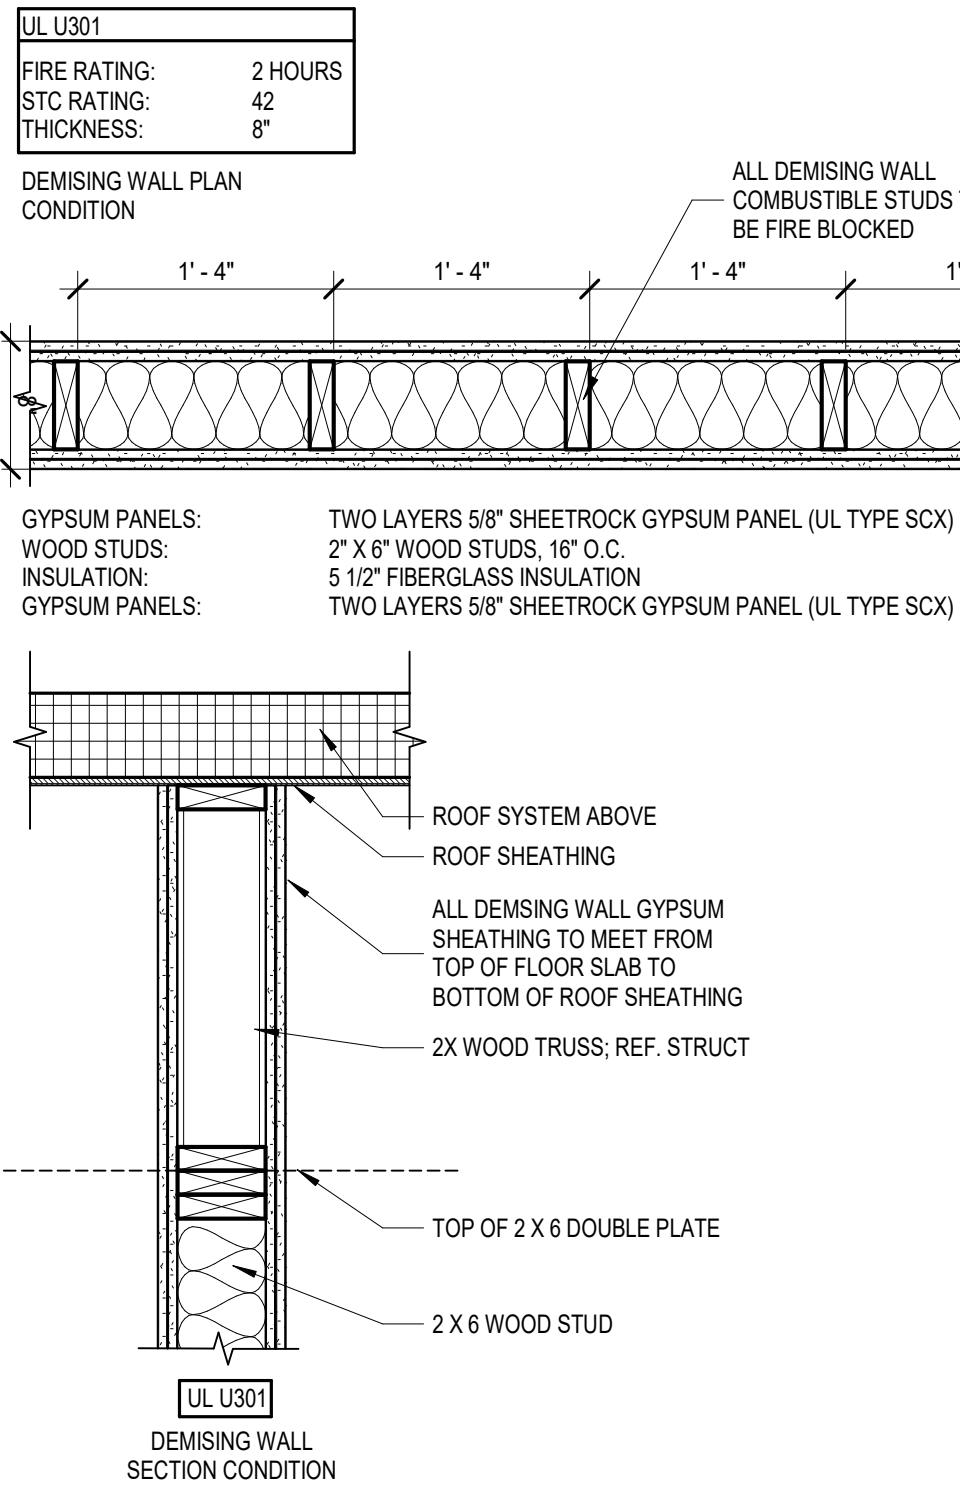


A3 STANDING SEAM WALL CONNECTION
SCALE: 1 1/2" = 1'-0"

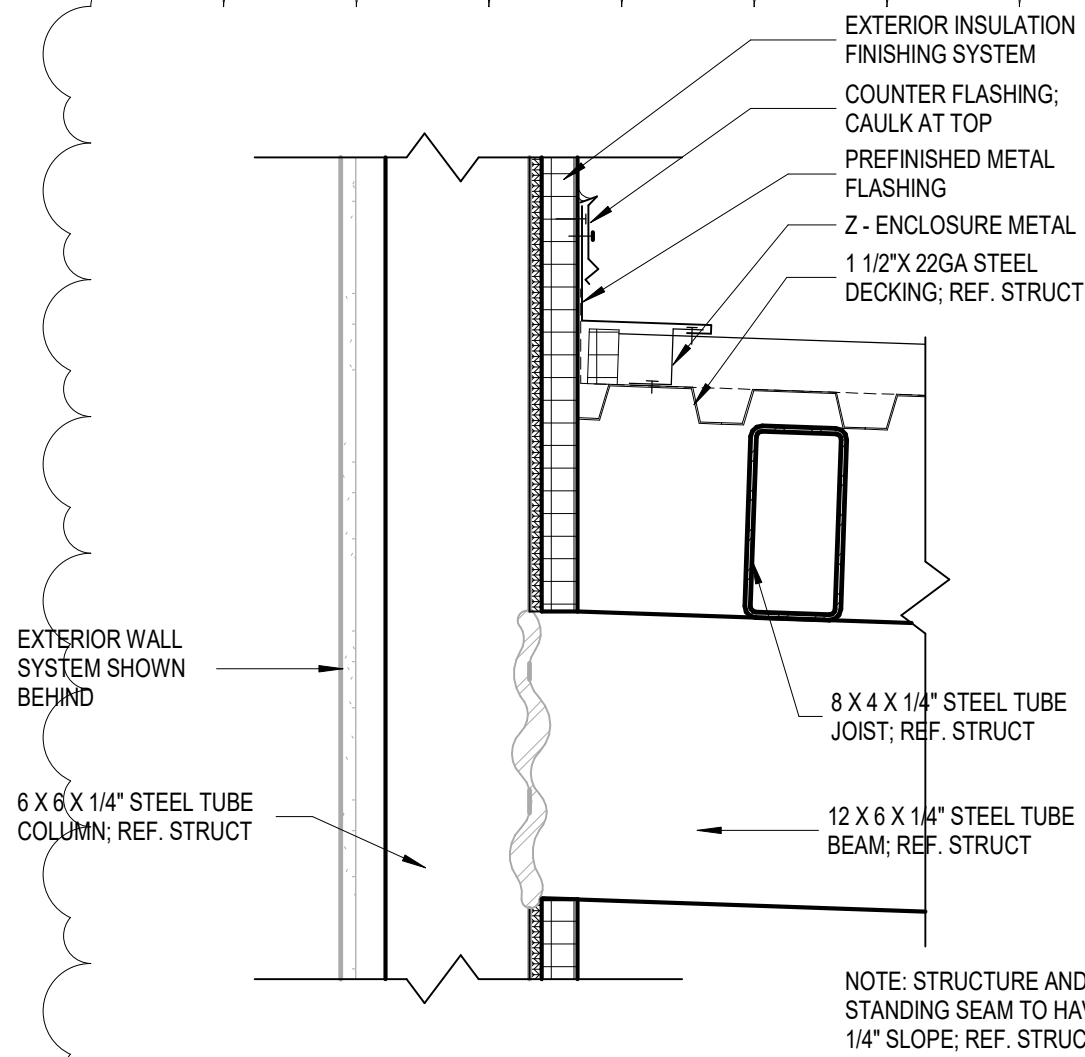

B3 ENLARGED WEST PILASTER PLAN
SCALE: 3/4" = 1'-0"

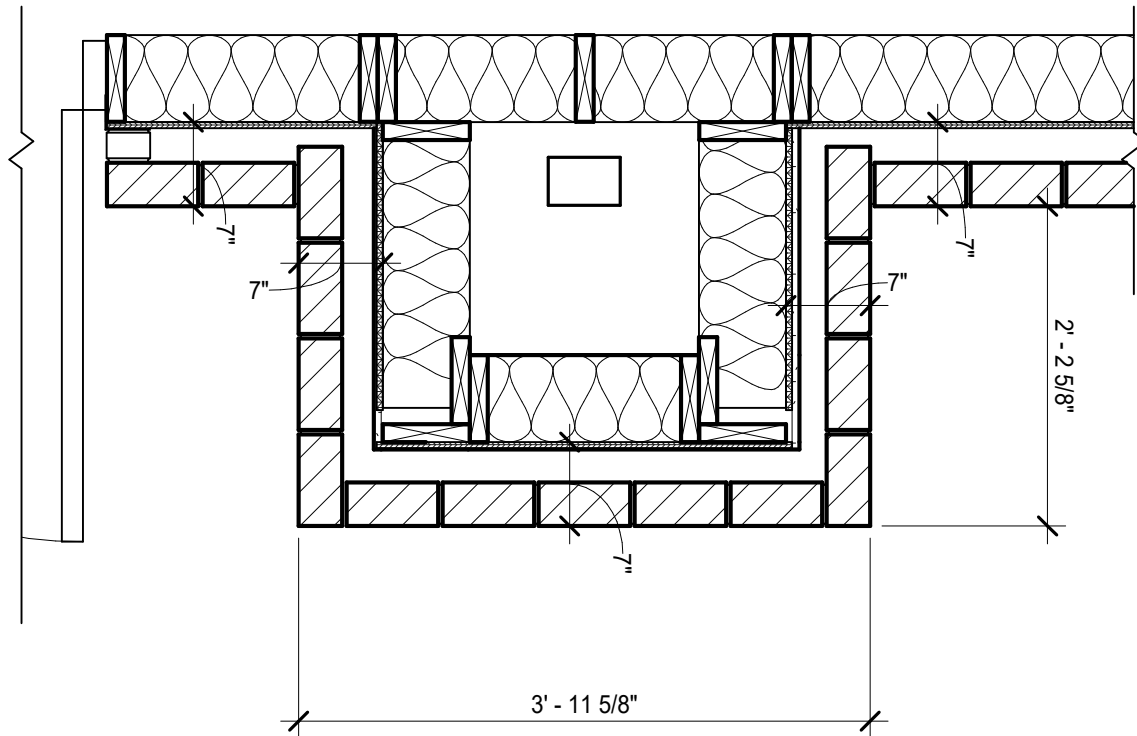


D3 ENLARGED NORTH/ EAST/ SOUTH PILASTER PLAN
SCALE: 3/4" = 1'-0"

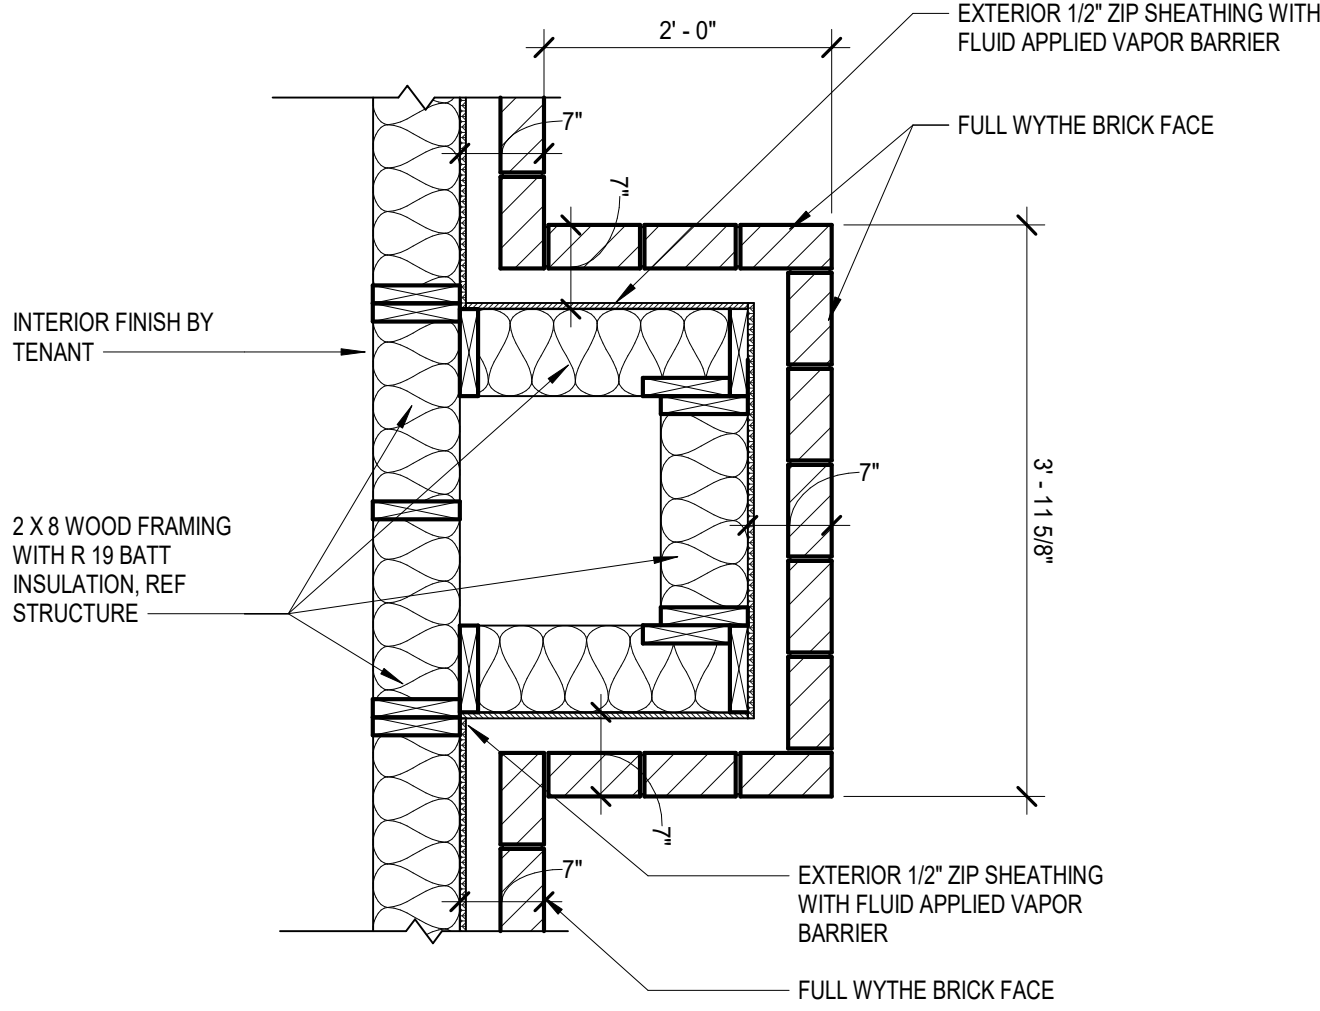


GENERAL FLASHING REQUIREMENTS

- A. PROPERLY WEEP FLASHING POINTS AND NORMAL DRAINAGE POINTS WITH WEEPS @ 1'-4" O.C. MAX. SPACING. WEEP POINTS ARE TO BE LOCATED DIRECTLY ON TOP OF FLASHING.
- B. WHERE FLASHING IS LOCATED TERMINATE AND/OR SEPARATES MATERIALS, DO NO SEAL (U.N.O.) - REFER TO DIAGRAM "C" WHERE IT IS DETERMINED BY THE MATERIAL MANUFACTURER OR OTHERWISE THAT SEALING IS REQUIRED (TO PREVENT WATER PENETRATION BEYOND FLASHING DUE TO WIND DRIVEN RAIN), THEN SEALANT MUST BE WEEPED IN ACCORDANCE WITH NOTE "A" ABOVE.
- C. UNLESS NOTED OTHERWISE, TURN FLASHING UP A MIN. OF 4" BEHIND APPROPRIATE MATERIALS.
- D. FLASHING CONDITIONS, WHETHER DETAILED OR NOT, ARE TO BE IN ACCORDANCE WITH S.M.A.C.N.A. SPECIFICATIONS. WHERE ATYPICAL CONDITIONS OCCUR THAT ARE NOT DETAILED, FLASHING IS TO BE INSTALLED AS CLOSELY AS POSSIBLE TO THE S.M.A.C.M.A. DETAIL THAT IS MOST CLOSELY APPROXIMATES THE ACTUAL CONDITION.
- E. UNLESS NOTED OTHERWISE, AT FLASHING HIGH POINTS SEAL WATER TIGHT TO BACK-UP SUBSTRATE.

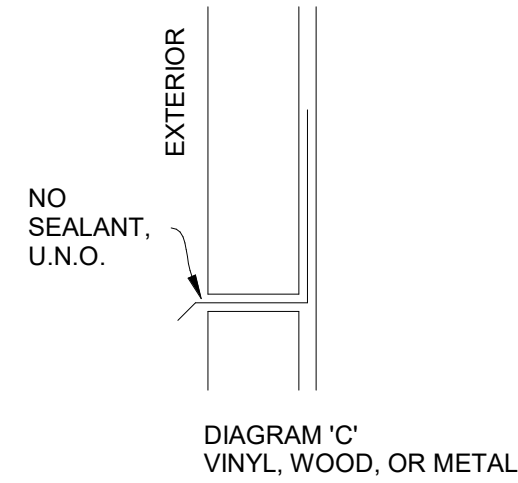

D4 GENERAL FLASHING DETAIL
SCALE: 12" = 1'-0"

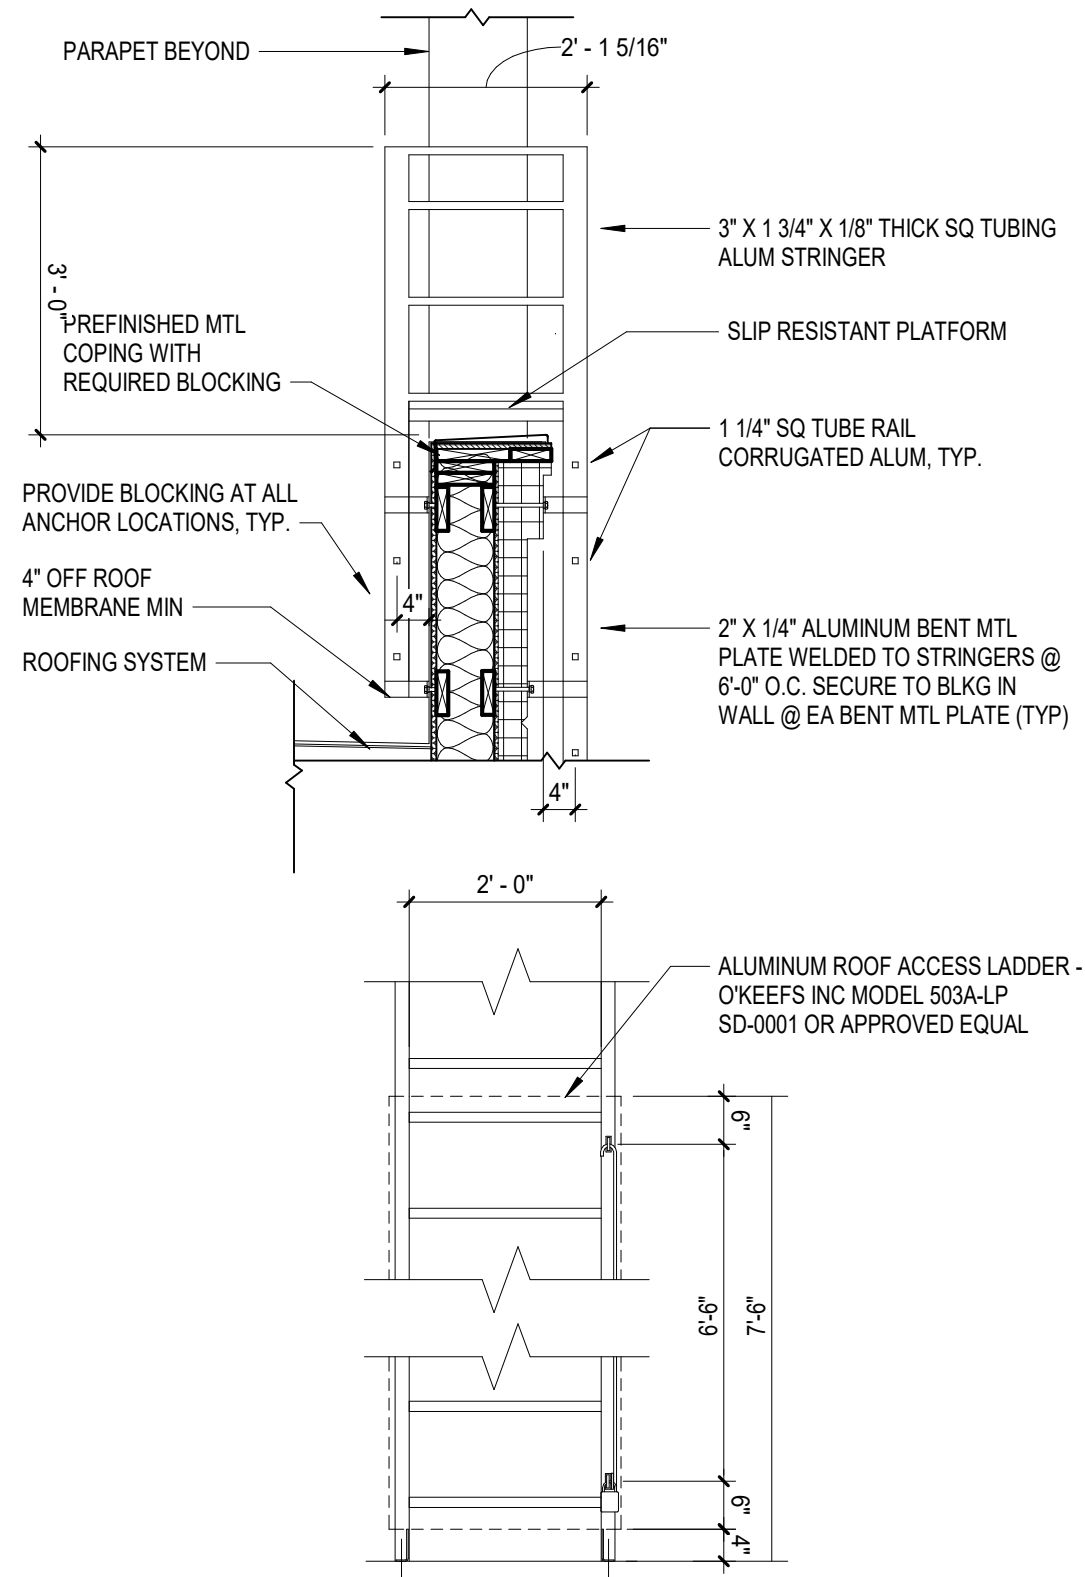

B5 ROOF ACCESS LADDER
SCALE: 1/2" = 1'-0"



schwerdt design group
architecture | interiors | planning
2231 sw wanamaker rd. suite 303
topeka, kansas 66614-4275
phone: 785.273.7540
fax: 785.273.7579
500 north broadway. suite 200
oklahoma city, ok 73102
phone: 405.231.3105
fax: 405.231.3115



MICHAEL K HAMPTON
ARCHITECT (MO# A-2008027042)
SCHWERDT DESIGN GROUP INC
MISSOURI STATE CERTIFICATE
OF AUTHORITY #F00353876

CORE & SHELL BUILDING
STREETS OF WEST PRYOR LOT 13
1020 NW PRYOR ROAD, LEES SUMMIT, MISSOURI


SUBMISSION DATES
12-27-2023
ADD-1 JAN 19TH, 2024

SHEET TITLE
BUILDING DETAILS

PROJECT NUMBER
235008


SHEET NUMBER
A-503

FILEPATH: F:\1_P\Projects\SD\G235008 SOWP Lot 13\05_Drawings - Working\Revit\235008 SOWP Lot 13_V23.rvt
DATE: 1/22/2024 11:08:02 AM
DRAWN BY: Author

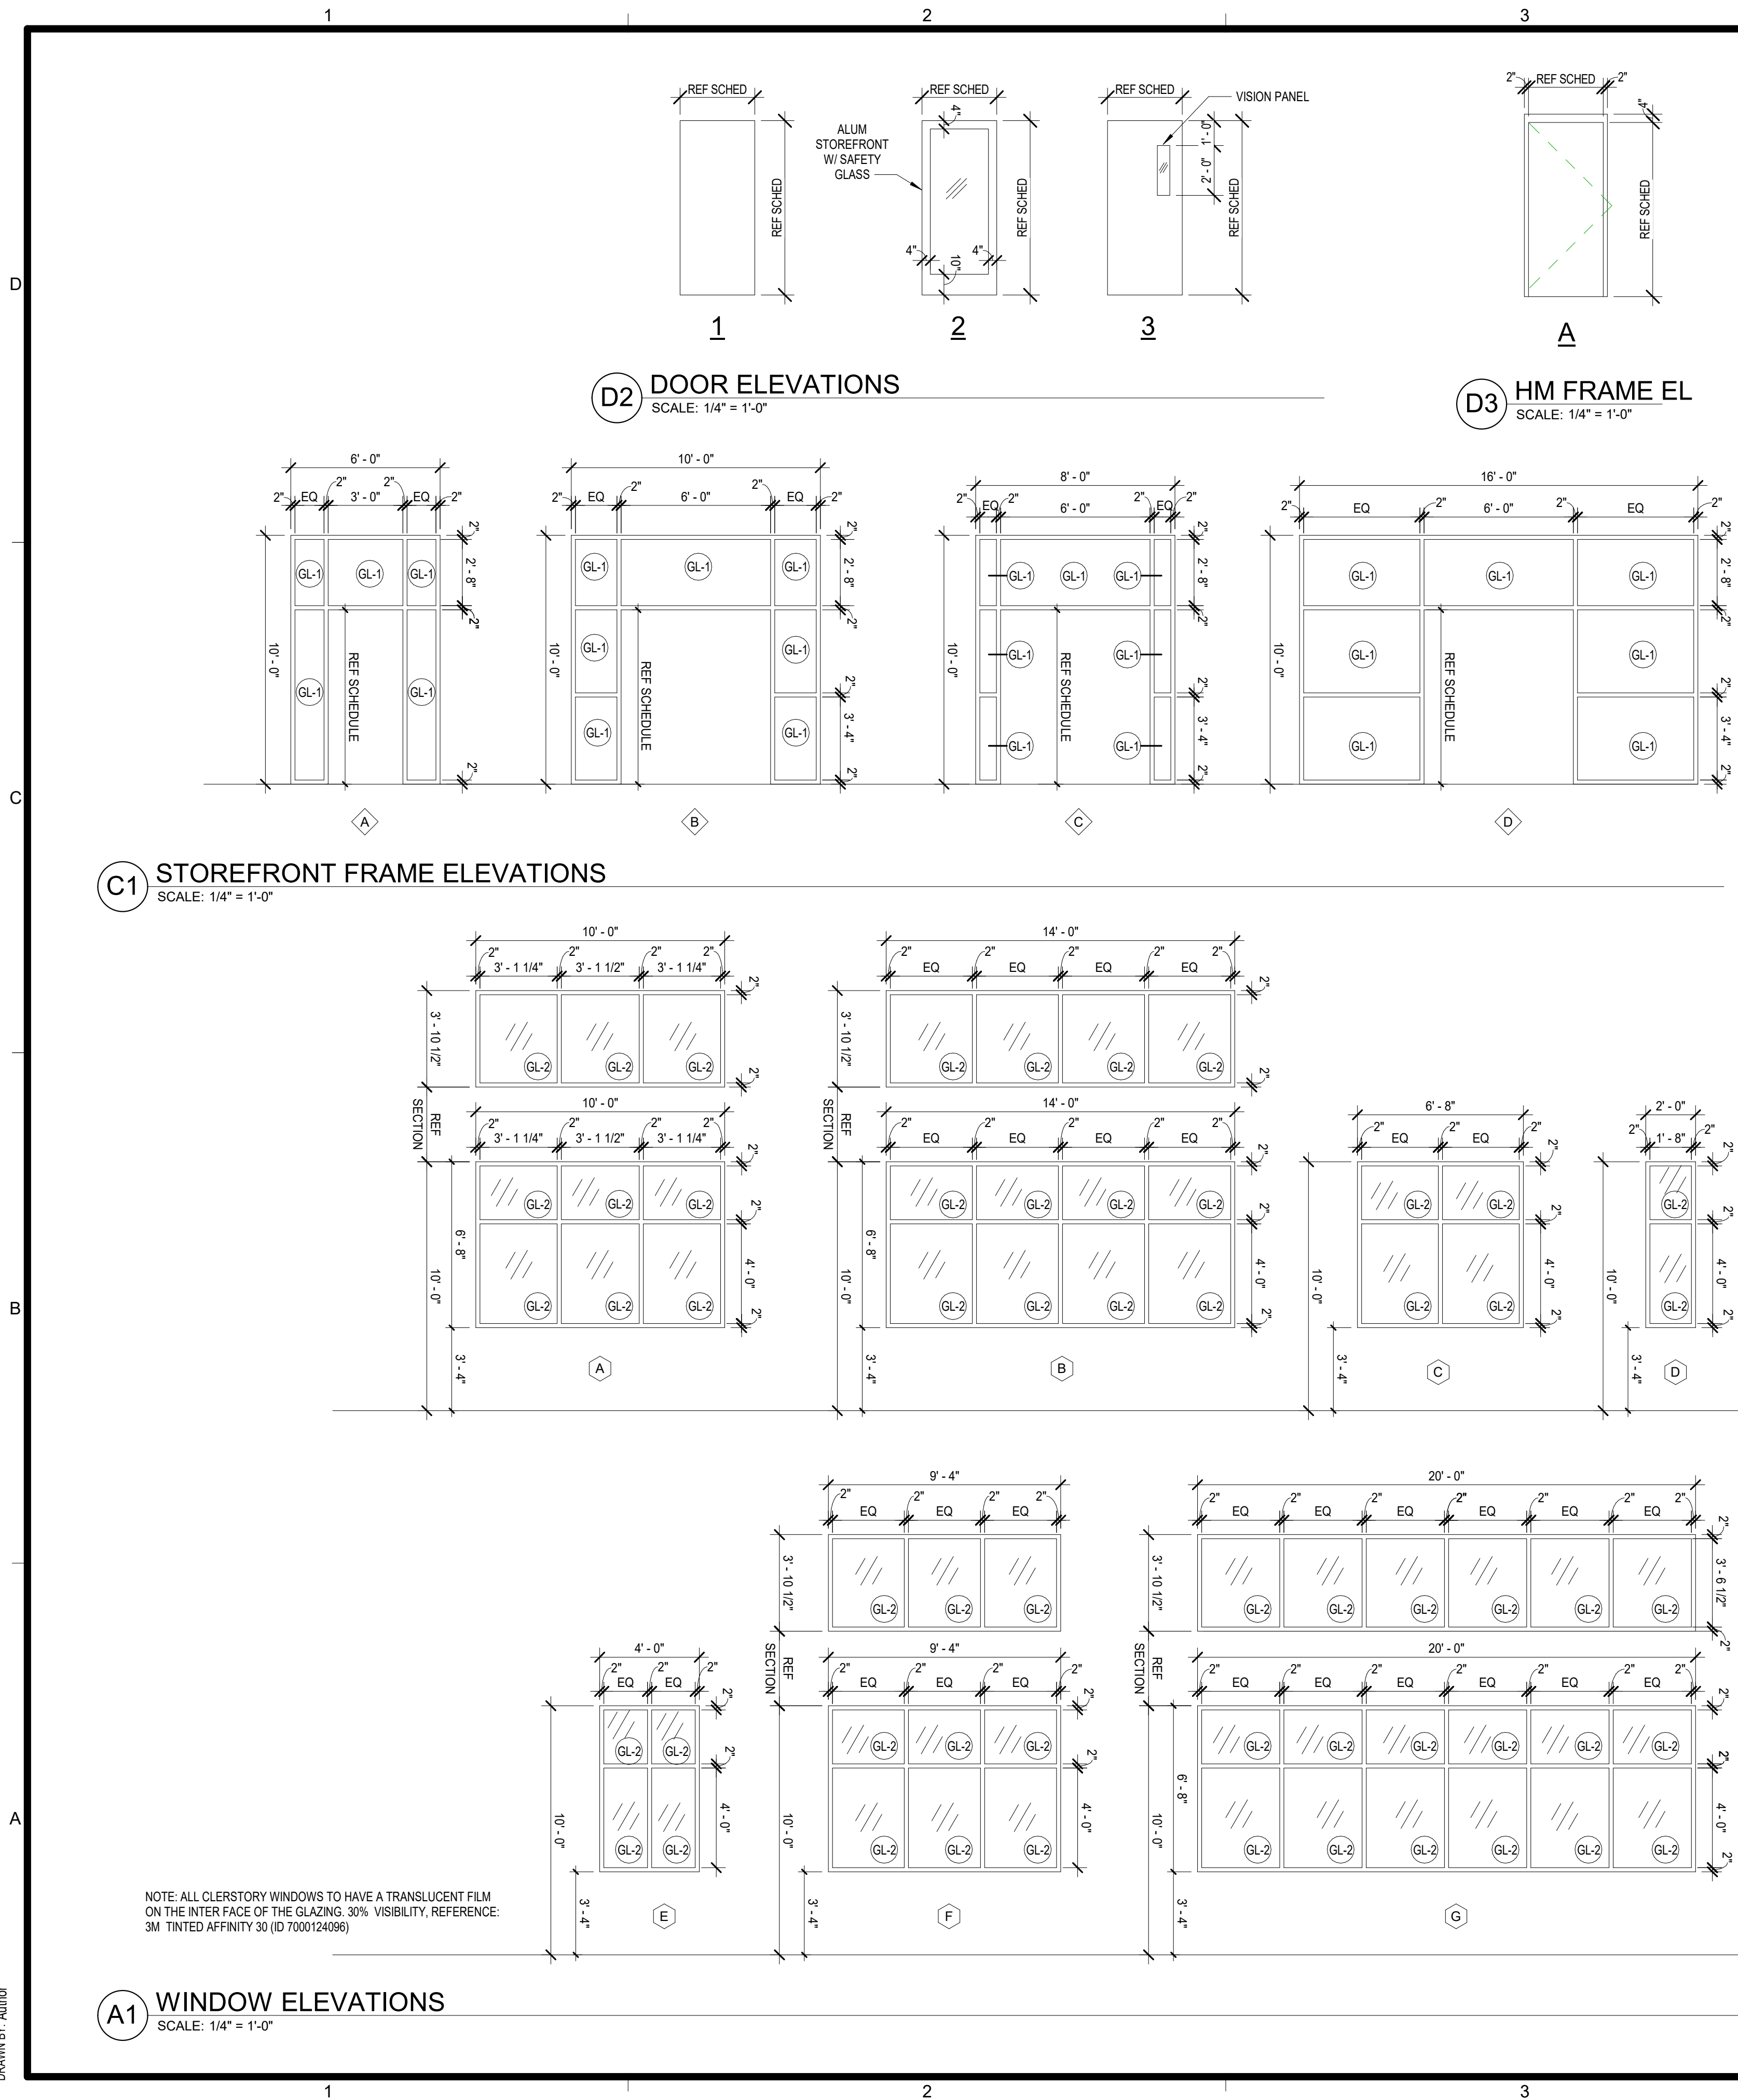


DOOR SCHEDULE														
DOOR					FRAME						HARDWARE	DOOR WIDTH	DOOR HEIGHT	NOTE
DOOR #	MATL	FINISH	GLAZ	EL	MATL	FINISH	GLAZ	EL	DETAIL					
									Frame Head	Frame Jamb				
100	ALUM	F	GL-1	2	ALUM	F	GL-1	D	A4	A4	01	3' - 0"	7' - 0"	
101	ALUM	F	GL-1	2	ALUM	F	GL-1	C	A4	A4	01	3' - 0"	7' - 0"	
102	ALUM	F	GL-1	2	ALUM	F	GL-1	C	A4	A4	01	3' - 0"	7' - 0"	
103	ALUM	F	GL-1	2	ALUM	F	GL-1	B	A4	A4	01	3' - 0"	7' - 0"	
104	ALUM	F	GL-1	2	ALUM	F	GL-1	B	A4	A4	01	3' - 0"	7' - 0"	
105	HM	PT	-	1	HM	PT	-	D3	C4	B4	02	3' - 0"	7' - 0"	
106	HM	PT	-	1	HM	PT	-	D3	C4	B4	02	3' - 0"	7' - 0"	
107	HM	PT	-	1	HM	PT	-	D3	C4	B4	02	3' - 0"	7' - 0"	
108	HM	PT	-	1	HM	PT	-	D3	C4	B4	02	3' - 0"	7' - 0"	
109	HM	PT	-	1	HM	PT	-	D3	C4	B4	02	3' - 0"	7' - 0"	
110	ALUM	F	GL-1	2	ALUM	F	GL-1	A	A4	A4	03	3' - 0"	7' - 0"	
111	HM	PT	-	1	HM	PT	-	D3	C4	B4	02	3' - 0"	7' - 0"	NO RAIN DRIP
112	HM	PT	-	1	HM	PT	-	D3	C4	B4	02	3' - 0"	3' - 0"	


GL-1 = TEMPERED INSULATED GLAZING
GL-2 = CLEAR INSULATED GLAZING
ALUM = ALUMINUM
HM = HOLLOW METAL
PT = PAINT
TF = TRANSPARENT FINISH
FF = FACTORY FINISH

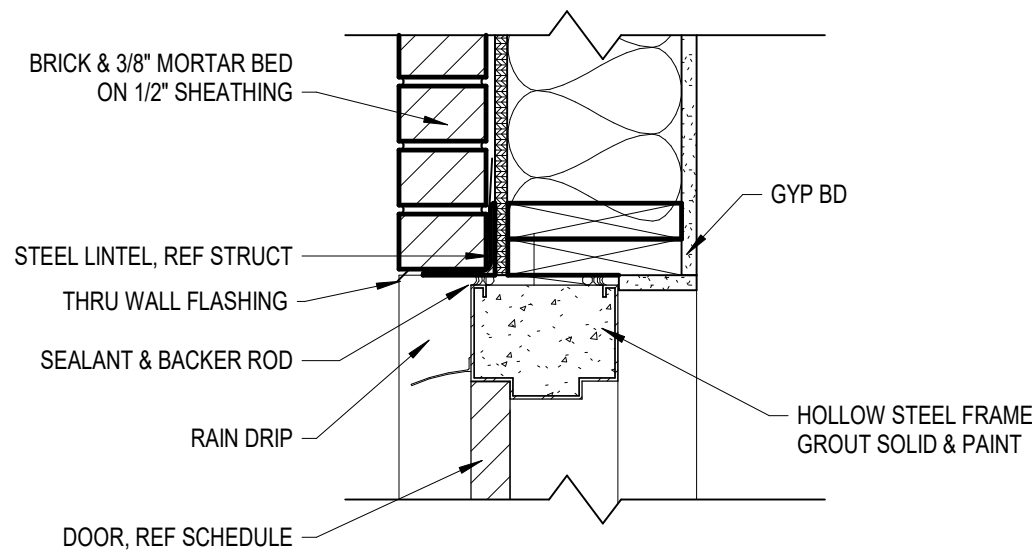

C4 HM HEAD DETAIL
SCALE: 1 1/2" = 1'-0"

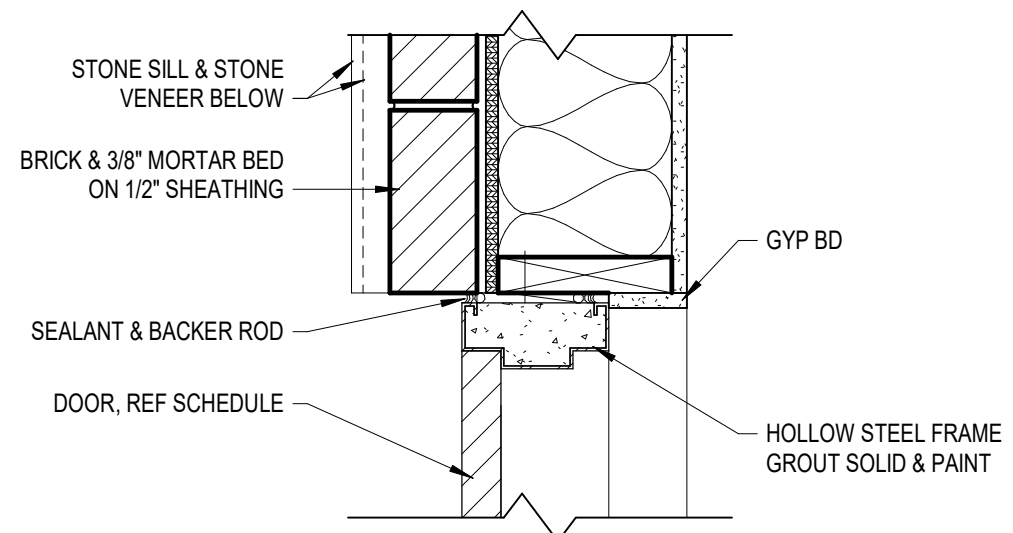

B4 HM JAMB DETAIL
SCALE: 1 1/2" = 1'-0"

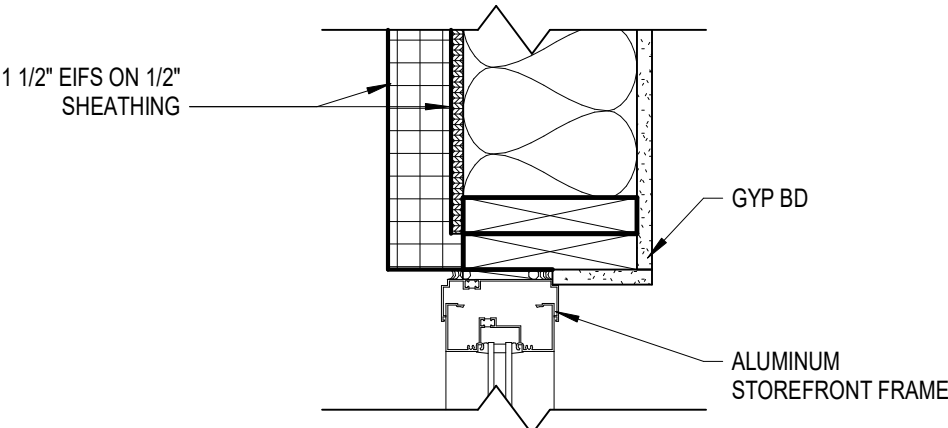


A4 STOREFRONT HEAD / JAMB DETAIL
SCALE: 1 1/2" = 1'-0"

DOOR HARDWARE SCHEDULE - SET 01 STOREFRONT				
QTY.	DESCRIPTION	MODEL	FINISH	MFG.
3 PR.	HINGES	BB1191 4 1/2" x 4 1/2" NRP	US10B	HAGER
1 EA.	EXIT DEVICE	1692	DC13	FALCON
1 EA.	EXIT DEVICE	1690	DC13	FALCON
2 EA.	66" LADDER PULL	66LPBS	US26/626	CRL
2 EA.	CLOSER	SC70-18	DC13	FALCON
2 EA.	STOP	100S	DC13	FALCON
1 EA.	THRESHOLD	350	DKB	NGP
2 EA.	DOOR SWEEP	200NA	DKB	NGP
1 EA.	PERIMETER SEAL	160S	DKB	NGP
1 EA.	ASTRAGAL	672	DKB	NGP

DOOR HARDWARE SCHEDULE - SET 02 SERVICE DOOR				
QTY.	DESCRIPTION	MODEL	FINISH	MFG.
1 EA.	ROTON HINGE SURFACE MOUNT	70-210HD-84	ALUM	ROTON
1 EA.	EXIT DEVICE RIM SURFACE MOUNT	4501-48-26D	26D/626	HAGER
1 EA.	CLOSER 5100 HOLD OPEN STOP	5100-4DHOS-ALUM	ALUM	HAGER
1 EA.	ARMOR PLATE 20"x40" S.S.	190S-20X40-32D	32D	HAGER
1 EA.	WEATHER STRIPPING NEOPRENE	873S-N-4284-MILL	ML	HAGER
1 EA.	DOOR BOTTOM SWEEP NEOPRENE	750SN-42-CLR	CL	HAGER
1 EA.	NGP STEEL SECURITY ASTRAGAL 83"	1392SP-USP-83	PRIME COAT	NGP
1 EA.	HALF SADDLE THRESHOLD 5"x1/2"x42"	431S-42-MIL	MIL	HAGER
1 EA.	OVERHEAD RAIN DRIP GUARD	810S-46-MIL	AL	HAGER
1 EA.	WIDE ANGLE PEEP HOLE SET @ 45° AFF			

DOOR HARDWARE SCHEDULE - SET 03 STOREFRONT				
QTY.	DESCRIPTION	MODEL	FINISH	MFG.
3 PR.	HINGES	BB1191 4 1/2" x 4 1/2" NRP	US10B	HAGER
1 EA.	EXIT DEVICE	1692	DC13	FALCON
1 EA.	66" LADDER PULL	66LPBS	US26/626	CRL
1 EA.	CLOSER	SC70-18	DC13	FALCON
1 EA.	STOP	100S	DC13	FALCON
1 EA.	THRESHOLD	350	DKB	NGP
1 EA.	DOOR SWEEP	200NA	DKB	NGP
1 EA.	PERIMETER SEAL	160S	DKB	NGP

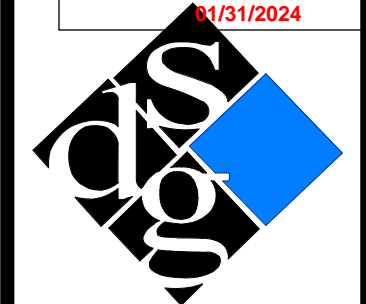

schwerdt design group
architecture | interiors | planning
2231 sw wanamaker rd. suite 303
topeka, kansas 66614-4275
phone: 785.273.7540
fax: 785.273.7579
500 north broadway suite 200
oklahoma city, ok 73102
phone: 405.231.3105
fax: 405.231.3115



MICHAEL K HAMPTON
ARCHITECT (MO# A-2008027042)
SCHWERDT DESIGN GROUP INC
MISSOURI STATE CERTIFICATE
OF AUTHORITY #00353876

CORE & SHELL BUILDING
STREETS OF WEST PRYOR LOT 13
1020 NW PRYOR ROAD, LEES SUMMIT, MISSOURI

SUBMISSION DATES
12-27-2023

SHEET TITLE
GLASS & DOOR
SCHEDULES

PROJECT NUMBER
235008

SHEET NUMBER
A-601

FILE PATH: C:\Users\grad\harris\Documents\01190008.125 - Streets of West Pryor - Lot 13_Gradster.rvt
DATE: 12/27/2023 11:41:36 AM
DRAWN BY: GSH

STRUCTURAL GENERAL NOTES

GENERAL NOTES:

ALL STRUCTURAL DRAWINGS SHALL BE USED IN CONJUNCTION WITH THE OTHER PROJECT DRAWINGS AND SPECIFICATIONS. THE MATERIAL REQUIREMENTS IN THESE NOTES ARE TO BE CONSIDERED AS MINIMUM. SPECIFICATIONS SHALL GOVERN WHEN MORE STRINGENT.

VERIFY ALL DIMENSIONS SHOWN WITH ARCHITECTURAL DRAWINGS AND EXISTING CONDITIONS PRIOR TO CONSTRUCTION. DISCREPANCIES SHALL BE RESOLVED BEFORE PROCEEDING WITH CONSTRUCTION. CONTRACTOR SHALL COORDINATE THE WORK OF ALL TRADES AND MAKE NECESSARY INVESTIGATIONS AND FIELD MEASUREMENTS. INFORM ENGINEER OF ALL DISCREPANCIES.

THE CONTRACTOR SHALL VERIFY THE SIZE AND LOCATIONS OF PENETRATIONS AND EMBEDDED ITEMS THROUGH THE STRUCTURE FOR ALL TRADES. PENETRATIONS SHALL BE SUBJECT TO APPROVAL BY THE ARCHITECT AND STRUCTURAL ENGINEER.

SEE MECHANICAL, ELECTRICAL, ARCHITECTURAL DRAWINGS FOR ANCHORS, PIPE SLEEVES, CONDUITS OR OTHER ITEMS TO BE EMBEDDED IN OR PASS THROUGH CONCRETE. IN GENERAL, EMBEDMENTS AND PENETRATIONS LESS THAN 12 INCHES IN DIAMETER ARE NOT SHOWN ON THE STRUCTURAL DRAWINGS.

SEE ARCHITECTURAL DRAWINGS FOR DOOR HEIGHTS AND WALL OPENING DIMENSIONS.

STRUCTURAL ELEMENTS ARE NON-SELF SUPPORTING AND REQUIRE INTERACTION WITH OTHER ELEMENTS FOR STABILITY. FRAMING AND WALLS SHALL BE TEMPORARILY BRACED BY THE CONTRACTOR UNTIL PERMANENT BRACING, FLOOR AND ROOF DECKS AND WALLS HAVE BEEN INSTALLED AND CONNECTIONS BETWEEN THESE ELEMENTS HAVE BEEN MADE.

SUPPORT OF ALL NON-STRUCTURAL ELEMENTS SHALL BE THE RESPONSIBILITY OF THE CONTRACTOR. NON-STRUCTURAL ELEMENTS ARE THOSE THAT DO NOT CONTRIBUTE TO THE DIRECT LOAD PATH OF BOTH THE GRAVITY AND LATERAL FORCE RESISTING SYSTEMS. THESE ELEMENTS INCLUDE, BUT ARE NOT LIMITED TO PARTITIONS, FINISHES, MILLWORK, MECHANICAL EQUIPMENT, DUCTWORK, PIPING, LIGHT FIXTURES, ELECTRICAL CONDUIT, STORAGE RACKS, ETC. THE CONTRACTOR SHALL BE RESPONSIBLE FOR ENSURING THAT THESE ELEMENTS ARE ADEQUATELY CONNECTED TO THE STRUCTURE TO RESIST ALL APPLIED LOADS. NOTIFY THE STRUCTURAL ENGINEER OF RECORD IF UNUSUAL SUPPORT CONDITIONS EXIST.

WORK REQUIRING SPECIAL INSPECTIONS SHALL BE INSPECTED ACCORDING TO THE BUILDING CODE AND INCLUDES: CONCRETE, REINFORCING STEEL, STRUCTURAL WELDING, HIGH-STRENGTH BOLTING, AND MASONRY. RE: SPECIAL INSPECTION PROGRAM TABLE WHEN APPLICABLE.

DESIGN CRITERIA:

BUILDING CODE: 2018 INTERNATIONAL BUILDING CODE AS ADOPTED AND AMENDED BY THE CITY OF LEE'S SUMMIT, MISSOURI.

RISK CATEGORY: II

LIVE LOADS:
ROOF: 20 PSF

SNOW LOADS:
GROUND SNOW LOAD, Pg: 20 PSF
FLAT-ROOF SNOW LOAD, Pf: 20 PSF
SNOW EXPOSURE FACTOR, Ce: 0.9
SNOW LOAD IMPORTANCE FACTOR, Is: 1.0
THERMAL FACTOR, Ct: 1.0

WIND LOAD:
BASIC WIND SPEED: 115 MPH
EXPOSURE CATEGORY: C
BASIC INTERNAL PRESSURE COEFFICIENT, Gcpi: ±0.18
BASIC COMPONENTS AND CLADDING PRESSURE (ADJUSTED TO COMPLY WITH BUILDING CODE):
±20 PSF @ INTERIOR ZONES
±25 PSF @ END ZONES

SEISMIC LOAD:
SEISMIC IMPORTANCE FACTOR, Ie: 1.0
SPECTRAL RESPONSE ACCELERATIONS:
Ss: 0.1563
S1: 0.0570
SPECTRAL RESPONSE COEFFICIENTS:
Sds: 0.167
Sd1: 0.091
SITE CLASS: D
SEISMIC DESIGN CATEGORY: B
BASIC SEISMIC-FORCE-RESISTING SYSTEM: LIGHT-FRAMED WALLS WITH WOOD STRUCTURAL PANELS & STEEL ORDINARY MOMENT FRAMES
DESIGN BASE SHEAR: Cs x W
SEISMIC RESPONSE COEFFICIENTS, Cs: 0.0256 & 0.0476
RESPONSE MODIFICATION FAIOR, R: 6.5 & 3.5
ANALYSIS PROCEDURE: EQUIVALENT LATERAL FORCE

FOUNDATION AND EARTHWORK NOTES:

REFER TO THE GEOTECHNICAL EXPLORATION AND FOUNDATION RECOMMENDATIONS: WEST PRYORVILLAGE, LEE'S SUMMIT, MISSOURI / COOK, FLATT, & STROBEL ENGINEERS PA, KANSAS CITY, KANSAS (CFS NO 18-5125) / JUNE 15, 2018.

THE FOUNDATION BEARING MATERIAL SHALL BE INSPECTED AND APPROVED BY A GEOTECHNICAL ENGINEER BEFORE FOUNDATIONS ARE CONSTRUCTED.

AT STEPPED FOOTINGS, THE LOWER FOOTING SHALL BE PLACED FIRST.

FOUNDATIONS HAVE BEEN DESIGNED FOR A NET ALLOWABLE SOIL BEARING PRESSURE OF 2,500 PSF FOR CONTINUOUS FOOTINGS AND 3,000 PSF FOR ISOLATED SPREAD FOOTINGS. FOUNDATIONS SHALL BEAR DIRECTLY ON A 24-INCH THICK, GEOGRID REINFORCED AGGREGATE PAD (GRAP) DESIGNED AND CONSTRUCTED AS OUTLINED IN THE GEOTECHNICAL REPORT, SECTION 7.2.

WALL FOUNDATION SHALL BEAR AT MINIMUM OF 3'-0" BELOW ADJACENT FINISH GRADE, UNLESS OTHERWISE NOTED.

UNUSUAL CONDITIONS OR CHANGES TO THE FOUNDATIONS AS REQUIRED BY FIELD CONDITIONS SHALL BE REFERRED TO THE ENGINEER FOR APPROVAL.

REFER TO GEOTECHNICAL REPORT FOR SUBGRADE PREP REQUIREMENTS FOR SLAB-ON-GRADE CONSTRUCTION. PREPARED SUBGRADES EXCAVATED TO INSTALL UTILITIES BELOW FLOOR SLABS SHALL BE BACKFILLED AND COMPACTED AS SPECIFIED BY THE GEOTECHNICAL ENGINEER.

REFER TO GEOTECHNICAL REPORT FOR COMPACTION REQUIREMENTS.

MAINTAIN ALL EXCAVATIONS FREE OF WATER.

CONCRETE NOTES:

CONCRETE SHALL HAVE THE FOLLOWING UNLESS OTHERWISE SPECIFIED (SELECT PROPORTIONS FOR CONCRETE IN ACCORDANCE WITH ACI 318):

	MAX WATER/CEMENT RATIO	MINIMUM COMPRESSIVE STRENGTH AT 28 DAYS
INTERIOR SLAB ON GRADE	0.45	3,000 PSI
FOOTINGS	0.45	4,500 PSI
FOUNDATION WALLS	0.45	4,500 PSI
GRADE BEAMS	0.45	4,500 PSI
DRILLED PIERS	0.50	4,000 PSI
CONCRETE ON STEEL DECK	0.45	3,000 PSI

REINFORCING STEEL SHALL BE BILLET STEEL CONFORMING TO ASTM A615, GRADE 60.

WELDED WIRE FABRIC SHALL CONFORM TO ASTM A185.

CEMENT SHALL CONFORM TO ASTM C150, TYPE I OR II.

AGGREGATES SHALL CONFORM TO ASTM C33. COARSE AGGREGATE SHALL CONSIST OF 1" MAXIMUM AGGREGATE SIZE. COMBINED GRADATION SHALL HAVE A UNIFORM DISTRIBUTION AS FOLLOWS:
5-20% RETAINED ON 3/4", 1/2", 3/8", NO. 4, NO. 8, NO. 16, NO. 30 AND NO. 50 SIEVES; LESS THAN 5% PASSING NO. 50 SIEVE.

MATERIALS AND ADMIXTURES SHALL NOT CONTAIN CALCIUM CHLORIDE.

ALL EXTERIOR AND CONCRETE EXPOSED TO FREEZE/THAW CYCLES SHALL BE AIR-ENTRAINED 6%(±) BY VOLUME. THIS INCLUDES BUT IS NOT LIMITED TO FOOTINGS, FOUNDATION WALLS AND GRADE BEAMS.

SLEEVES, OPENINGS, OR OTHER ATTACHMENTS NOT SHOWN ON DRAWINGS SHALL BE APPROVED BY THE ENGINEER PRIOR TO PLACING CONCRETE.

MINIMUM TENSION LAP SPLICE LENGTHS AND TENSION DEVELOPMENT LENGTHS SHALL BE AS SCHEDULED, UNLESS NOTED OTHERWISE ON THE DRAWINGS. WELDED WIRE FABRIC SHALL LAP ONE (1) FULL SQUARE PLUS TWO (2) INCHES.

MAINTAIN CONCRETE COVER AS SCHEDULED.

REINFORCING STEEL FABRICATION AND INSTALLATION SHALL BE IN ACCORDANCE WITH THE LATEST EDITION OF THE CRSI MANUAL OF STANDARD PRACTICE.

ALL REINFORCING AND EMBEDDED ANCHOR BOLTS SHALL BE ACCURATELY PLACED AND TIED PRIOR TO POURING CONCRETE. "STABBING" OF DOWELS OR ANCHOR BOLTS IS NOT ALLOWED.

CONSTRUCTION JOINTS IN WALLS AND ELEVATED FORMED SLABS SHALL BE KEYED (1 1/2" DEEP BY 1/3 MEMBER AREA) AND REINFORCING SHALL CONTINUE THROUGH JOINT OR BE TENSION LAP SPLICED. CONSTRUCTION JOINTS SHALL BE LOCATED BY THE CONTRACTOR TO LEAST IMPAIR THE STRUCTURE. JOINT LOCATIONS SHALL BE APPROVED BY THE ENGINEER.

EMBEDDED CONDUIT SHALL NOT BE LARGER IN OUTSIDE DIMENSION THAN 1/3 THE OVERALL THICKNESS OF SLAB, WALL OR BEAM IN WHICH THEY ARE EMBEDDED. THEY SHALL NOT BE SPACED CLOSER THAN 3 DIAMETERS OR WIDTHS ON CENTER.

CONDUIT LOCATED WITH CONCRETE SECTIONS SHALL COMPLY WITH ACI 318 REQUIREMENTS.

INTERIOR FLOOR SLABS SHALL COMPLY WITH ACI 117, SHALL MEET THE REQUIREMENTS OF A TYPE 5, SINGLE COURSE, HARD STEEL-TROWELED FINISH AS DESCRIBED IN ACI 302, AND SHALL ACHIEVE AN OVERALL FF25/FL20 TOLERANCE.

ADHESIVE ANCHORS IN CONCRETE OR FULLY GROUTED MASONRY SHALL BE ITW RAMSET/REDHEAD EPCON CERAMIC 6 SYSTEM, HILTI HY200, OR SIMPSON AT-XP. ADHESIVE ANCHORS FOR HOLLOW BLOCK AND OTHER MASONRY SHALL BE HILTI HY270 OR SIMPSON SET-XP.

STRUCTURAL STEEL ENCASED WITHIN CONCRETE SHALL COMPLY WITH AISC TOLERANCES.

MASONRY NOTES:

CONSTRUCT MASONRY IN ACCORDANCE WITH THE IBC. MASONRY REQUIRES LEVEL 1 QUALITY ASSURANCE (RE: SPECS). ALL MASONRY SHALL BE LAID IN RUNNING (COMMON) BOND USING THE LOW-LIFT METHOD OF GROUTING. REFER ARCHITECTURAL PLAN FOR ALL BLOCK COURSING.

MASONRY DESIGN IS BASED ON A MINIMUM COMPRESSIVE STRENGTH (F'm) OF ASSEMBLY OF 1,500 PSI.

MASONRY UNITS SHALL MEET THE REQUIREMENTS OF ASTM C-90, GRADE N, WITH A NET AREA COMPRESSIVE STRENGTH OF 1,900 PSI.

MORTAR SHALL BE PREPARED IN ACCORDANCE WITH ASTM C-270. PROVIDE TYPE M MORTAR AT ALL MASONRY BELOW GRADE AND TYPE S AT ALL OTHER MASONRY.

GROUT SHALL BE PREPARED IN ACCORDANCE WITH ASTM C-476, WITH A MINIMUM COMPRESSIVE STRENGTH OF 2,000 PSI AT 28 DAYS.

REINFORCING STEEL SHALL BE BILLET STEEL CONFORMING TO ASTM A615, GRADE 60.

LAP SPLICE BAR REINFORCEMENT FOR MASONRY PER LAP SCHEDULE AND JOINT REINFORCEMENT A MINIMUM OF 6 INCHES.

CONCRETE MASONRY UNITS BELOW GRADE SHALL BE SOLID GROUTED.

CELLS WITH REINFORCING SHALL BE SOLID GROUTED AND VIBRATED.

STRUCTURAL STEEL NOTES:

STRUCTURAL STEEL SHALL CONFORM TO THE FOLLOWING, UNLESS OTHERWISE NOTED:
WIDE FLANGE SHAPES (W, WT): ASTM A992 (Fy=50 KSI)
OTHER ROLLED SHAPES (M, S, HP, C, L): ASTM A36 (Fy=36 KSI)
STEEL PIPE: ASTM A53, GRADE B (Fy=35 KSI)
SQUARE AND RECTANGULAR TUBE: ASTM A500, GRADE B (Fy=46 KSI)
ANCHOR BOLTS: ASTM F1554, GRADE 36
HEADED ANCHOR STUDS: ASTM A108, GRADES 1010 TO 1020
PLATES AND BARS: ASTM A36 (Fy=36 KSI)

SHEAR CONNECTORS AND HEADED WELDED STUDS OF TYPE AND SIZE NOTED SHALL BE TYPE B.

STRUCTURAL STEEL SHALL BE FABRICATED AND ERECTED IN ACCORDANCE WITH GOOD STANDARD PRACTICE AND IS THE RESPONSIBILITY OF THE CONTRACTOR.

PROPER FIT IN THE FIELD OF STRUCTURAL STEEL SHALL BE IN ACCORDANCE WITH GOOD STANDARD PRACTICE AND IS THE RESPONSIBILITY OF THE CONTRACTOR.

THE FABRICATOR SHALL BE RESPONSIBLE FOR THE DESIGN AND PERFORMANCE OF ALL CONNECTIONS NOT FULLY DESIGNED OR DETAILED ON THE CONTRACT DOCUMENTS.

ANCHOR BOLTS SHALL BE ASTM F1554, A36 UNO. ANCHOR BOLTS SHALL BE SET WITH TEMPLATES WITH THE APPROPRIATE BOLT PROJECTION, 4" MINIMUM UNO. PROVIDE DOUBLE NUTS AND DOUBLE WASHERS FOR STEEL COLUMN ANCHOR BOLTS TO ALLOW FOR ADJUSTMENT IN BASE PLATE ELEVATION.

NON-SHRINK GROUT UNDER BASE PLATES SHALL BE NON-METALLIC WITH A MINIMUM COMPRESSIVE STRENGTH OF 5,000 PSI AT 28 DAYS.

HIGH STRENGTH BOLTED CONNECTIONS SHALL CONFORM TO THE AISC SPECIFICATIONS FOR STRUCTURAL JOINTS USING A325 BOLTS. UNLESS OTHERWISE NOTED, HIGH STRENGTH BOLTS MAY BE TIGHTENED BY ANY METHOD THEREIN. REGARDLESS OF THE METHOD USED IN TIGHTENING, A HARDENED WASHER SHALL BE USED UNDER THE TURNED ELEMENT. UNLESS OTHERWISE NOTED, BOLTED CONNECTIONS SHALL BE MADE WITH 3/4"Ø, ASTM A325 HIGH STRENGTH BOLTS.

CONNECTIONS REQUIRING FULL PRETENSIONING ARE SLIP-CRITICAL, AND INCLUDE BOLTED COLUMN SPLICES AND CONNECTIONS SUBJECT TO DIRECT TENSION.

ALL WELDING SHALL BE DONE IN ACCORDANCE WITH THE LATEST EDITION OF THE STRUCTURAL WELDING CODE, AWS D1.1. UNLESS NOTED OTHERWISE, MINIMUM WELD SIZE SHALL BE PER AISC 360, BUT SHALL BE NO LESS THAN 3/16" FILLET.

FIELD WELDING SHALL NOT BE STARTED UNTIL JOINT ELEMENTS ARE BOLTED IN INTIMATE CONTACT AND/OR ADJUSTED TO DIMENSIONS INDICATED WITH ALLOWANCE FOR EXPECTED WELD SHRINKAGE. MAINTAIN PLUMBNESS AND TRUENESS OF THE STRUCTURE.

FIELD WELDS FOR STRUCTURAL STEEL SHALL BE MADE WITH LOW HYDROGEN ELECTRODES. WELD FILLER METAL SHALL HAVE A MINIMUM TENSILE STRENGTH OF 70 KSI.

WOOD NOTES:

GENERAL STRUCTURAL WOOD FRAMING SHALL MEET THE MINIMUM STRESS REQUIREMENTS FOR DOUGLAS-FIR #2 AND SHALL BEAR THE STAMP OF AN APPROVED TESTING AGENCY.

ROOF SHEATHING SHALL BE 5/8" (19/32" MIN) PLYWOOD WITH A SPAN RATING OF AT LEAST 32/16. PANELS SHALL BE NAILED WITH 10d NAILS AT 6" O.C. AT PANEL EDGES AND 12" O.C. AT INTERMEDIATE SUPPORTS. 1/8" GAP BETWEEN INDIVIDUAL SHEETS. PLYWOOD SHALL BE APA RATED C-D EXTERIOR AND SHALL BEAR THE STAMP OF AN APPROVED TESTING AGENCY.

ALL WOOD-TO-WOOD CONNECTIONS SHALL MEET THE MINIMUM NAILING REQUIREMENTS OF THE BUILDING CODE.

PROVIDE SIMPSON CONNECTION HARDWARE AS SHOWN ON THE DRAWINGS. SUBSTITUTIONS MUST BE APPROVED BY THE ARCHITECT AND STRUCTURAL ENGINEER PRIOR TO USE. INSTALL CONNECTION HARDWARE ACCORDING TO THE MANUFACTURER'S SPECIFICATIONS.

WALL SHEATHING SHALL BE 1/2" OSB ON THE EXTERIOR FACE OF ALL EXTERIOR WALLS. PANELS SHALL BE NAILED WITH 10d GALVANIZED NAILS AT 4" O.C. AT PANEL EDGES AND 12" O.C. AT INTERMEDIATE SUPPORTS. ALL PANEL EDGES SHALL BE BLOCKED.

INSTALL ALL ROOF PLYWOOD SHEATHING WITH THE LONG DIMENSION OF THE PANEL PERPENDICULAR TO THE SUPPORTS WITH A MINIMUM OF TWO SPANS FOR EACH PANEL. STAGGER ALL END JOINTS. PROVIDE 1/8" SPACE AT PANEL JOINTS FOR EXPANSION PER APA.

PREFABRICATED WOOD TRUSS NOTES:

SPECIAL INSPECTIONS OF THE FABRICATION PROCESS OF PRE-FABRICATED WOOD STRUCTURAL ELEMENTS AND ASSEMBLIES SHALL BE IN ACCORDANCE WITH THE IBC.

TRUSSES SHALL BE CONFIGURED TO FOLLOW FINAL ROOF LINES, UNLESS NOTED OTHERWISE.

TRUSSES SHALL BE DESIGNED FOR ALL LOAD COMBINATIONS REQUIRED BY THE BUILDING CODE. IN NO CASE SHALL THE DEAD LOAD BE LESS THAN 15 PSF ON THE TOP CHORD AND 10 PSF ON THE BOTTOM CHORD.

TRUSS MANUFACTURER SHALL SUPPLY ALL TRUSS CONNECTIONS USING PREFABRICATED STEEL CONNECTORS AS REQUIRED.

CONTRACTOR SHALL BE RESPONSIBLE FOR PROVIDING ALL TEMPORARY AND PERMANENT BRACING IN ADDITION TO ANY BRACING INDICATED ON THE PLANS.

ALL TEMPORARY AND PERMANENT BRACING FOR INDIVIDUAL TRUSS MEMBERS SHALL BE DESIGNED BY AND STAMPED BY A PROFESSIONAL ENGINEER PROVIDED BY CONTRACTOR AND/OR TRUSS MANUFACTURER. APPLIED ROOF SHEATHING AND OTHER ROOFING MATERIALS SHALL NOT BE ASSUMED TO PROVIDE SUFFICIENT BRACING FOR TRUSS CHORDS.

SHOP FABRICATED WOOD TRUSSES SHALL MEET DESIGN SPECIFICATIONS FOR METAL PLATE CONNECTED WOOD TRUSSES BY THE TRUSS PLATE INSTITUTE. PROVIDE PERMANENT AND TEMPORARY BRACING ACCORDING TO THE MANUFACTURER'S RECOMMENDATIONS.

COORDINATE ALL TRUSS DETAILS WITH ARCHITECTURAL PLANS.

SPLICE & DEVELOPMENT LENGTHS FOR REINFORCEMENT
(UNLESS NOTED OTHERWISE ON THE DRAWINGS)

fy = 60,000 psi
f'c = 3,000 psi

BAR SIZE	LENGTH OF LAPPED SPLICES FOR REINFORCEMENT (INCHES)		LENGTH OF END ANCHORAGE FOR DEVELOPMENT OF REINFORCEMENT (INCHES)			HOOK LENGTH	BAR SIZE
	TOP BARS*	OTHERS	TOP BARS*	OTHERS	HOOKED BARS		
3	28	22	22	17	9	6	3
4	38	29	29	22	11	8	4
5	47	36	36	28	14	10	5
6	56	43	43	33	17	12	6
7	81	63	63	48	20	14	7
8	93	72	72	55	22	16	8
9	105	81	81	62	25	20	9
10	118	91	91	70	28	22	10
11	131	101	101	78	31	24	11
14	--	--	121	93	38	31	14
18	--	--	161	124	50	41	18

*TOP BARS ARE HORIZONTAL BARS SO PLACED THAT MORE THAN 12" OF CONCRETE IS CAST IN THE MEMBER BELOW THE BAR. HORIZONTAL BARS IN WALLS ARE TO BE CONSIDERED AS TOP BARS. VERTICAL BARS MAY BE CONSIDERED AS OTHER BARS.

UNLESS EITHER OF THE FOLLOWING TWO CASES EXIST FOR STRAIGHT BARS, THE DEVELOPMENT OR SPLICE LENGTH FOR STRAIGHT BARS IN THE ABOVE TABLE MUST BE MULTIPLIED BY 1.5:

- THE CLEAR SPACING OF BARS BEING DEVELOPED OR SPLICED IS GREATER THAN OR EQUAL TO ONE BAR DIAMETER, THE CLEAR COVER IS GREATER THAN OR EQUAL TO ONE BAR DIAMETER, AND STIRRUPS OR TIES PROVIDED THROUGHOUT THE DEVELOPMENT OR SPLICE LENGTH MEET OR EXCEED THE CODE MINIMUM.
- THE CLEAR SPACING OF BARS BEING DEVELOPED OR SPLICED IS GREATER THAN OR EQUAL TO TWO BAR DIAMETERS AND THE CLEAR COVER IS GREATER THAN OR EQUAL TO ONE BAR DIAMETER.

THE DEVELOPMENT LENGTH FOR HOOKED BARS, SIZE 11 AND SMALLER, PLACED WITH SIDE COVER GREATER THAN OR EQUAL TO 2 1/2" AND COVER ON THE BAR EXTENSION BEYOND THE HOOD (90° HOOK ONLY) GREATER THAN OR EQUAL TO 2", MAY BE MULTIPLIED BY 0.7.

VALUES IN THE ABOVE TABLE ARE NOT TO BE USED FOR EPOXY COATED REINFORCING AND/OR REINFORCING PLACED IN CONCRETE CONTAINING LIGHTWEIGHT AGGREGATE.

CONCRETE COVER FOR REINFORCEMENT
(UNLESS NOTED OTHERWISE ON THE DRAWINGS)

LOCATION	MINIMUM COVER
CONCRETE CAST AGAINST AND PERMANENTLY EXPOSED TO EARTH	3"
CONCRETE EXPOSED TO EARTH OR WEATHER: #6 AND LARGER #5 AND SMALLER	2" 1 1/2"
CONCRETE NOT EXPOSED TO WEATHER OR IN CONTACT WITH THE GROUND: SLABS, WALLS, AND JOISTS: #14 AND LARGER #11 AND SMALLER BEAMS AND COLUMNS	1 1/2" 3/4" 1 1/2"

CERTUS
STRUCTURAL ENGINEERS
900 S. Kansas Avenue; Suite 400
Topeka, Kansas 66612
Phone: (785) 291-0400
Fax: (785) 291-0401
Proj #:01190008.125
Certificate Of Authorization
E-1392
REVIT 2023 LOCAL

RELEASED FOR CONSTRUCTION
As Noted on Plans Review
Development Services Department
Lee's Summit, Missouri
01/31/2024

schwerdt design group
architecture | interiors | planning
2231 sw wanamaker rd, suite 303
topeka, kansas 66614-4275
phone: 785.273.7540
fax: 785.273.7579
500 north broadway, suite 200
oklahoma city, ok 73102
phone: 405.231.3105
fax: 405.231.3115

**CORE & SHELL BUILDING FOR
STREETS OF WEST PRIOR LOT 13**
LEES SUMMIT, MISSOURI

SUBMISSION DATES
12/27/2023

SHEET TITLE
GENERAL NOTES

PROJECT NUMBER
230117

SHEET NUMBER
S-001

FILEPATH: C:\Users\grad\harris\Documents\01190008.125 - Streets of West Pryor - Lot 13_Gradster.rvt
DATE: 12/27/2023 11:41:38 AM
DRAWN BY: Author

FOUNDATION PLAN

SCALE: 1/8" = 1'-0"

FLOOR CONSTRUCTION: 4" CONCRETE SLAB ON GRADE REINFORCE w/6X6 - W2.9XW2.9 WELDED WIRE FABRIC. LOCATE REINFORCING 1 1/2" BELOW TOP OF SLAB. PROVIDE 6" LAYER OF GRANULAR LEVELING COURSE (#57 STONE) BELOW SLAB. VAPOR BARRIER SHALL BE PLACED DIRECTLY OVER GRANULAR FILL AND UNDER SLAB. REFERENCE ARCHITECTURAL AND SPECIFICATIONS FOR FURTHER DETAILS.

THE BUILDING FLOOR SLAB SHALL BE WITHIN A FLATNESS TOLERANCE OF 1/4" PER 10'-0".

TOSL - TOP OF SLAB ELEVATION: 100.0 = SITE ELEVATION = 993.00

TOF - TOP OF FOOTING ELEVATION: 99.4, UNLESS NOTED THUS: TOF (ELEV)

SJ - SLAB JOINT
C-(#) - DENOTES COLUMN MARK, REFERENCE SCHEDULE
F-(#) - DENOTES FOOTING MARK, REFERENCE SCHEDULE
BP-(#) - DENOTES COLUMN BASE PLATE TYPE, REFERENCE DETAILS

COORDINATE ALL PENETRATIONS THROUGH THE SLAB AND ALL UNDER SLAB ITEMS WITH OTHER TRADES BEFORE CONSTRUCTION.

VERIFY ALL DIMENSIONS SHOWN WITH ARCHITECTURAL AND EXISTING CONDITIONS PRIOR TO CONSTRUCTION. INFORM ENGINEER OF ALL DISCREPANCIES.

COLUMN SCHEDULE

MARK	SIZE
C-1	HSS4X4X1/4
C-2	HSS5X5X1/4
C-3	HSS6X6X1/4

FOOTING SCHEDULE

MARK	SIZE (LxWxD)	REINFORCING
F-1	4'-0x4'-0x1'-4	(5) #4 EW
F-2	3'-6x3'-6x1'-4	(4) #4 EW
F-3	3'-0x3'-0x3'-0	(4) #4 EW
F-4	2'-6x2'-6x3'-0	(3) #4 EW



schwertdt design group
architecture | interiors | planning
2231 sw wanamaker rd, suite 303
topeka, kansas 66614-4275
phone: 785.233.7540
fax: 785.233.7579
500 north broadway, suite 200
oklahoma city, ok 73102
phone: 405.231.3105
fax: 405.231.3115



CORE & SHELL BUILDING FOR STREETS OF WEST PRIOR LOT 13 LEES SUMMIT, MISSOURI

SUBMISSION DATES
12/27/2023


SHEET TITLE
FOUNDATION PLAN

PROJECT NUMBER
230117


SHEET NUMBER
S-101

CERTUS
STRUCTURAL ENGINEERS
900 S. Kansas Avenue; Suite 400
Topeka, Kansas 66612
Phone: (785) 291-0400
Fax: (785) 291-0401
Proj #:01190008.125
Certificate Of Authorization
E-1392
REVIT 2023 LOCAL

FILEPATH: C:\Users\gradv\harris\Documents\01190008.125 - Streets of West Pryor - Lot 13_Gradster.rvt
DATE: 1/22/2024 11:43:38 AM
DRAWN BY: Author

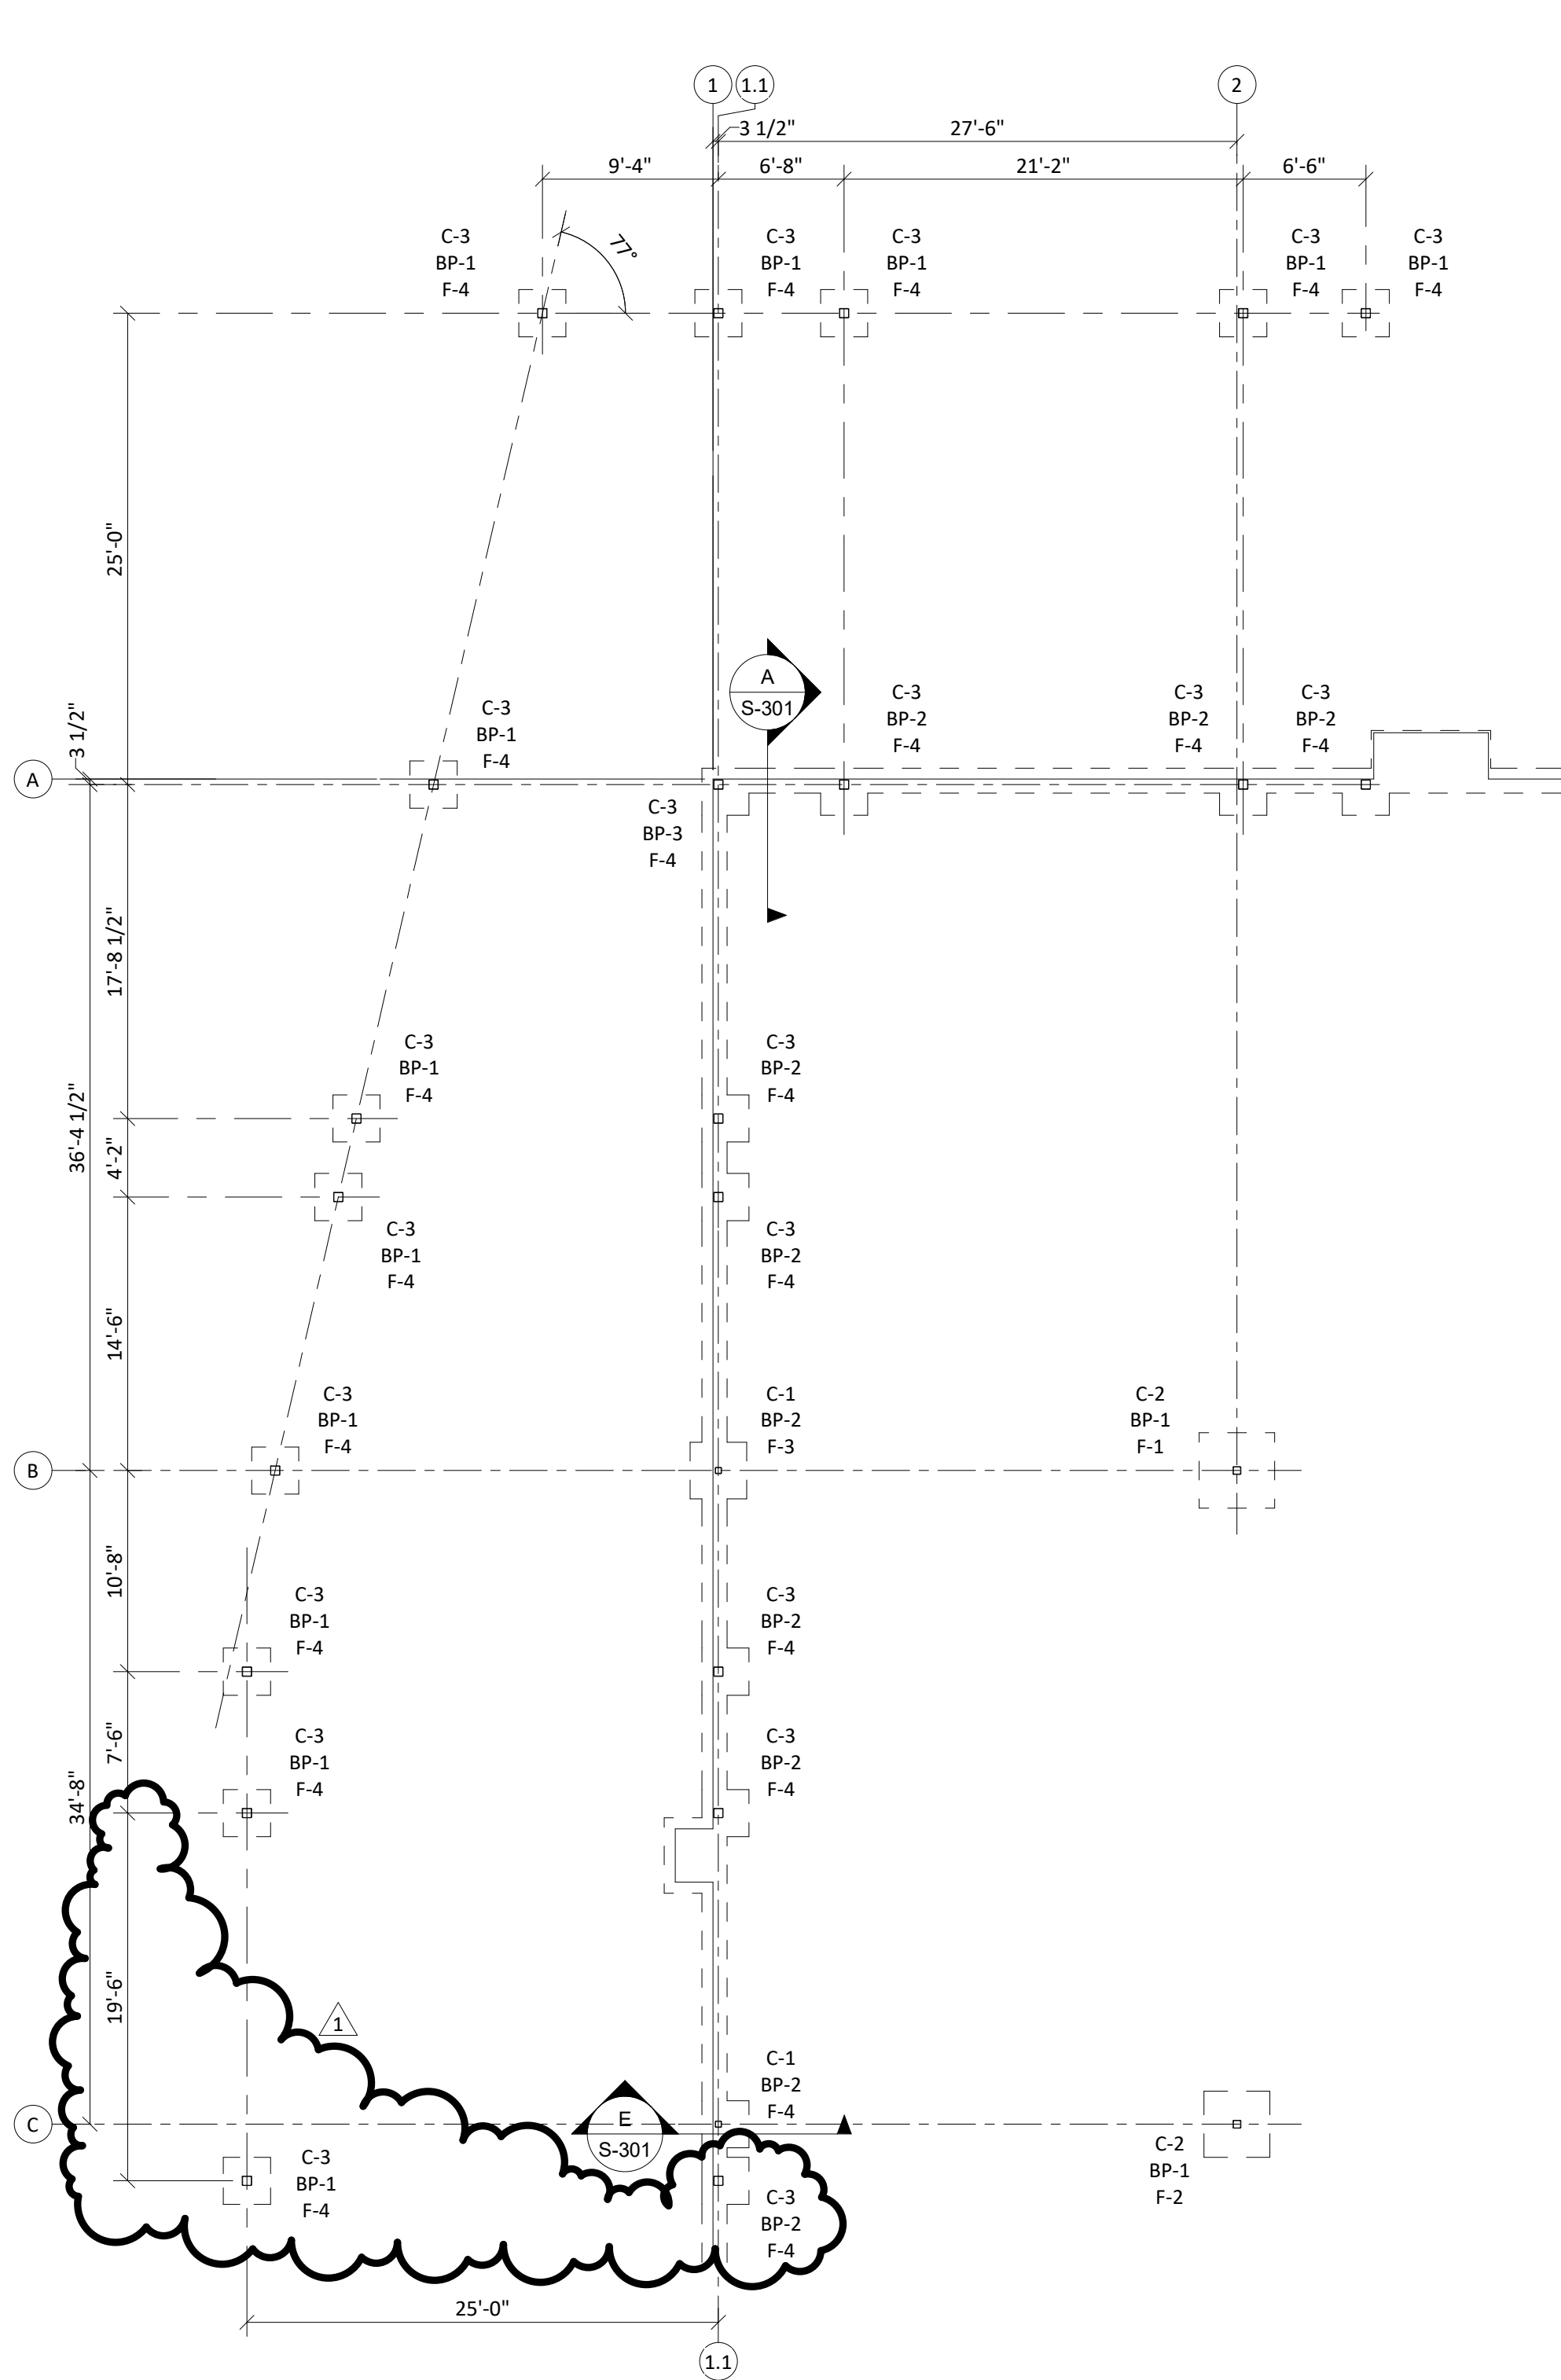

1 FOUNDATION PLAN
SCALE: 1/8" = 1'-0"

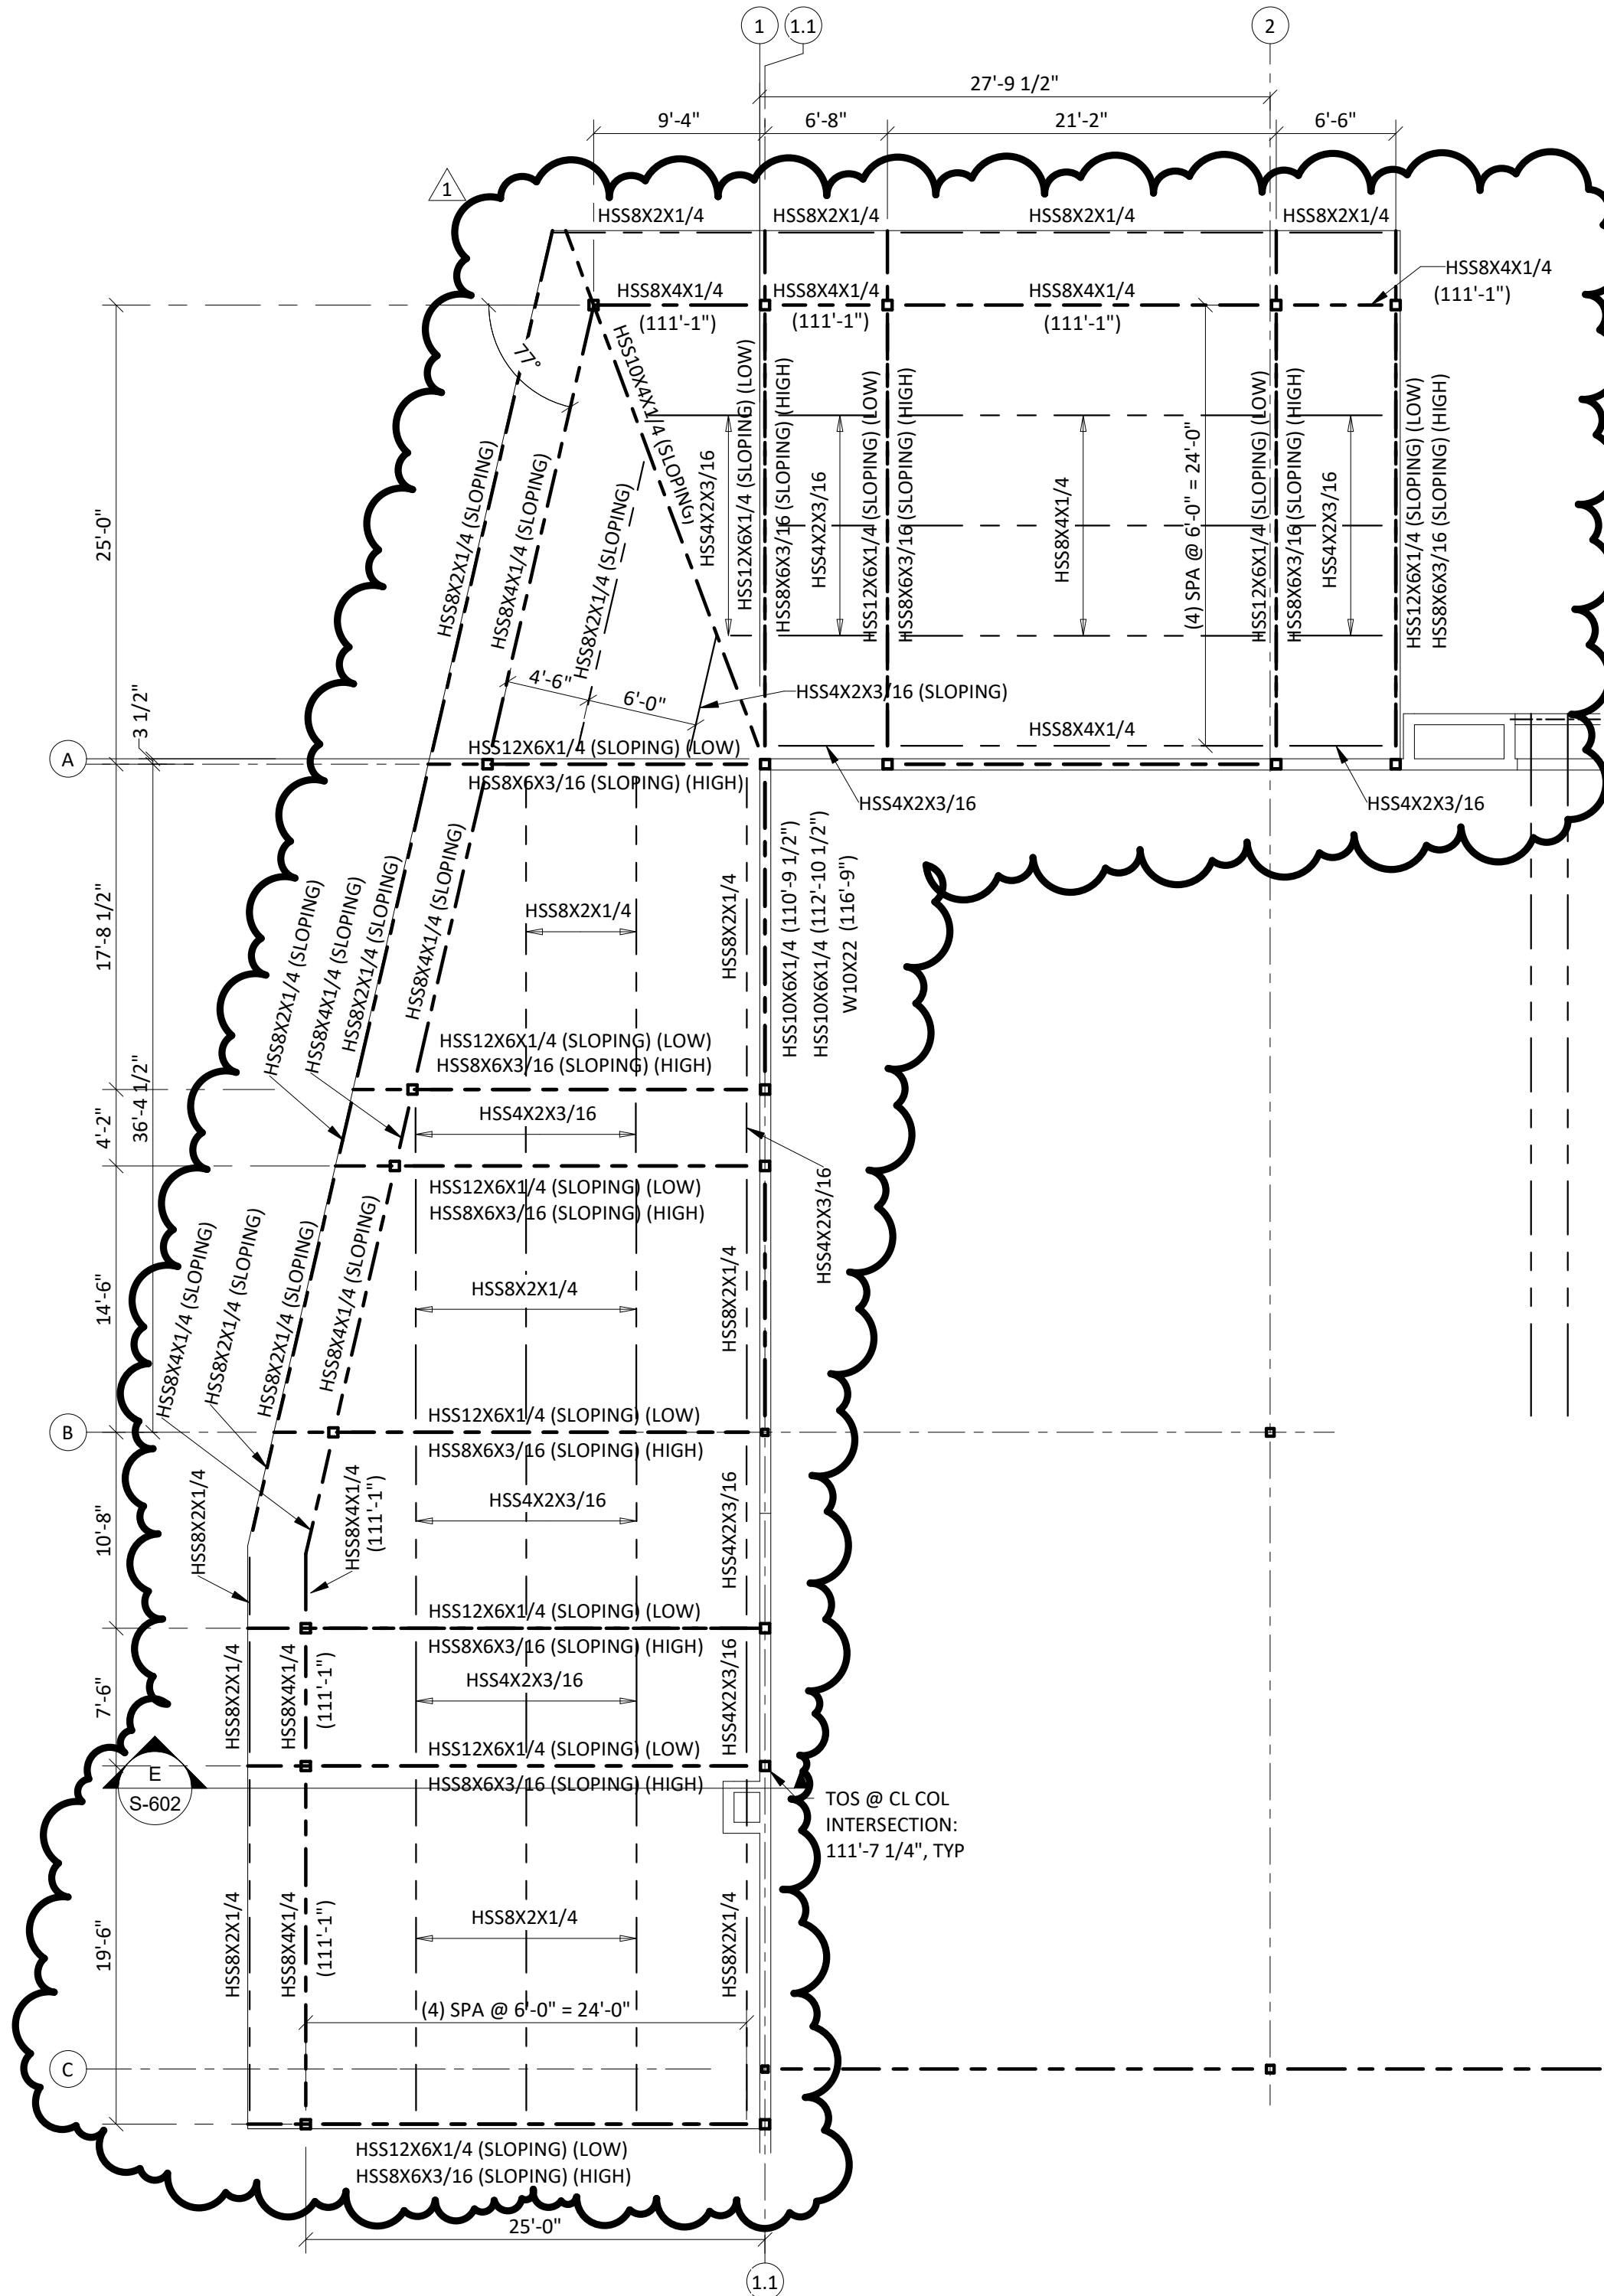

2 ROOF FRAMING PLAN
SCALE: 1/8" = 1'-0"

1
ROOF CONSTRUCTION: 1 1/2"x22GA WIDE RIB (TYPE B) GALVANIZED STEEL DECK ON STEEL JOISTS. ATTACH DECK TO ALL SUPPORTING ELEMENTS WITH 5/8"Ø PUDDLE WELDS AND 36/5 PATTERN IN THE FIELD AND 6" AT PERIMETER. PROVIDE (3) #10 TEK SCREW SIDE LAP CONNECTIONS EQUALLY SPACED.

CERTUS
STRUCTURAL ENGINEERS
900 S. Kansas Avenue; Suite 400
Topeka, Kansas 66612
Phone: (785) 291-0400
Fax: (785) 291-0401
Proj #:01190008.125
Certificate Of Authorization
E-1392
REVIT 2023 LOCAL

CORE & SHELL BUILDING FOR
STREETS OF WEST PRYOR LOT 13
LEES SUMMIT, MISSOURI

SUBMISSION DATES
12/27/2023
ADD #1 01/19/2024


SHEET TITLE
CANOPY FOUNDATION & FRAMING PLANS

PROJECT NUMBER
230117

SHEET NUMBER
S-102

FILEPATH: C:\Users\grad\harris\Documents\01190008.125 - Streets of West Pryor - Lot 13_Gradster.rvt
DATE: 1/22/2024 11:43:39 AM
DRAWN BY: Author

NOTE: FACE OF STUD ALIGNS WITH THE CONCRETE SLAB EDGE FOR ALL EXTERIOR WALLS. ALL PLAN DIMENSIONS TO EXTERIOR WALLS ARE TO FACE OF STUD/FACE OF CONCRETE SLAB. ALL DIMENSIONS TO INTERIOR WALLS ARE TO FACE OF STUD/STRUCTURAL WALL.

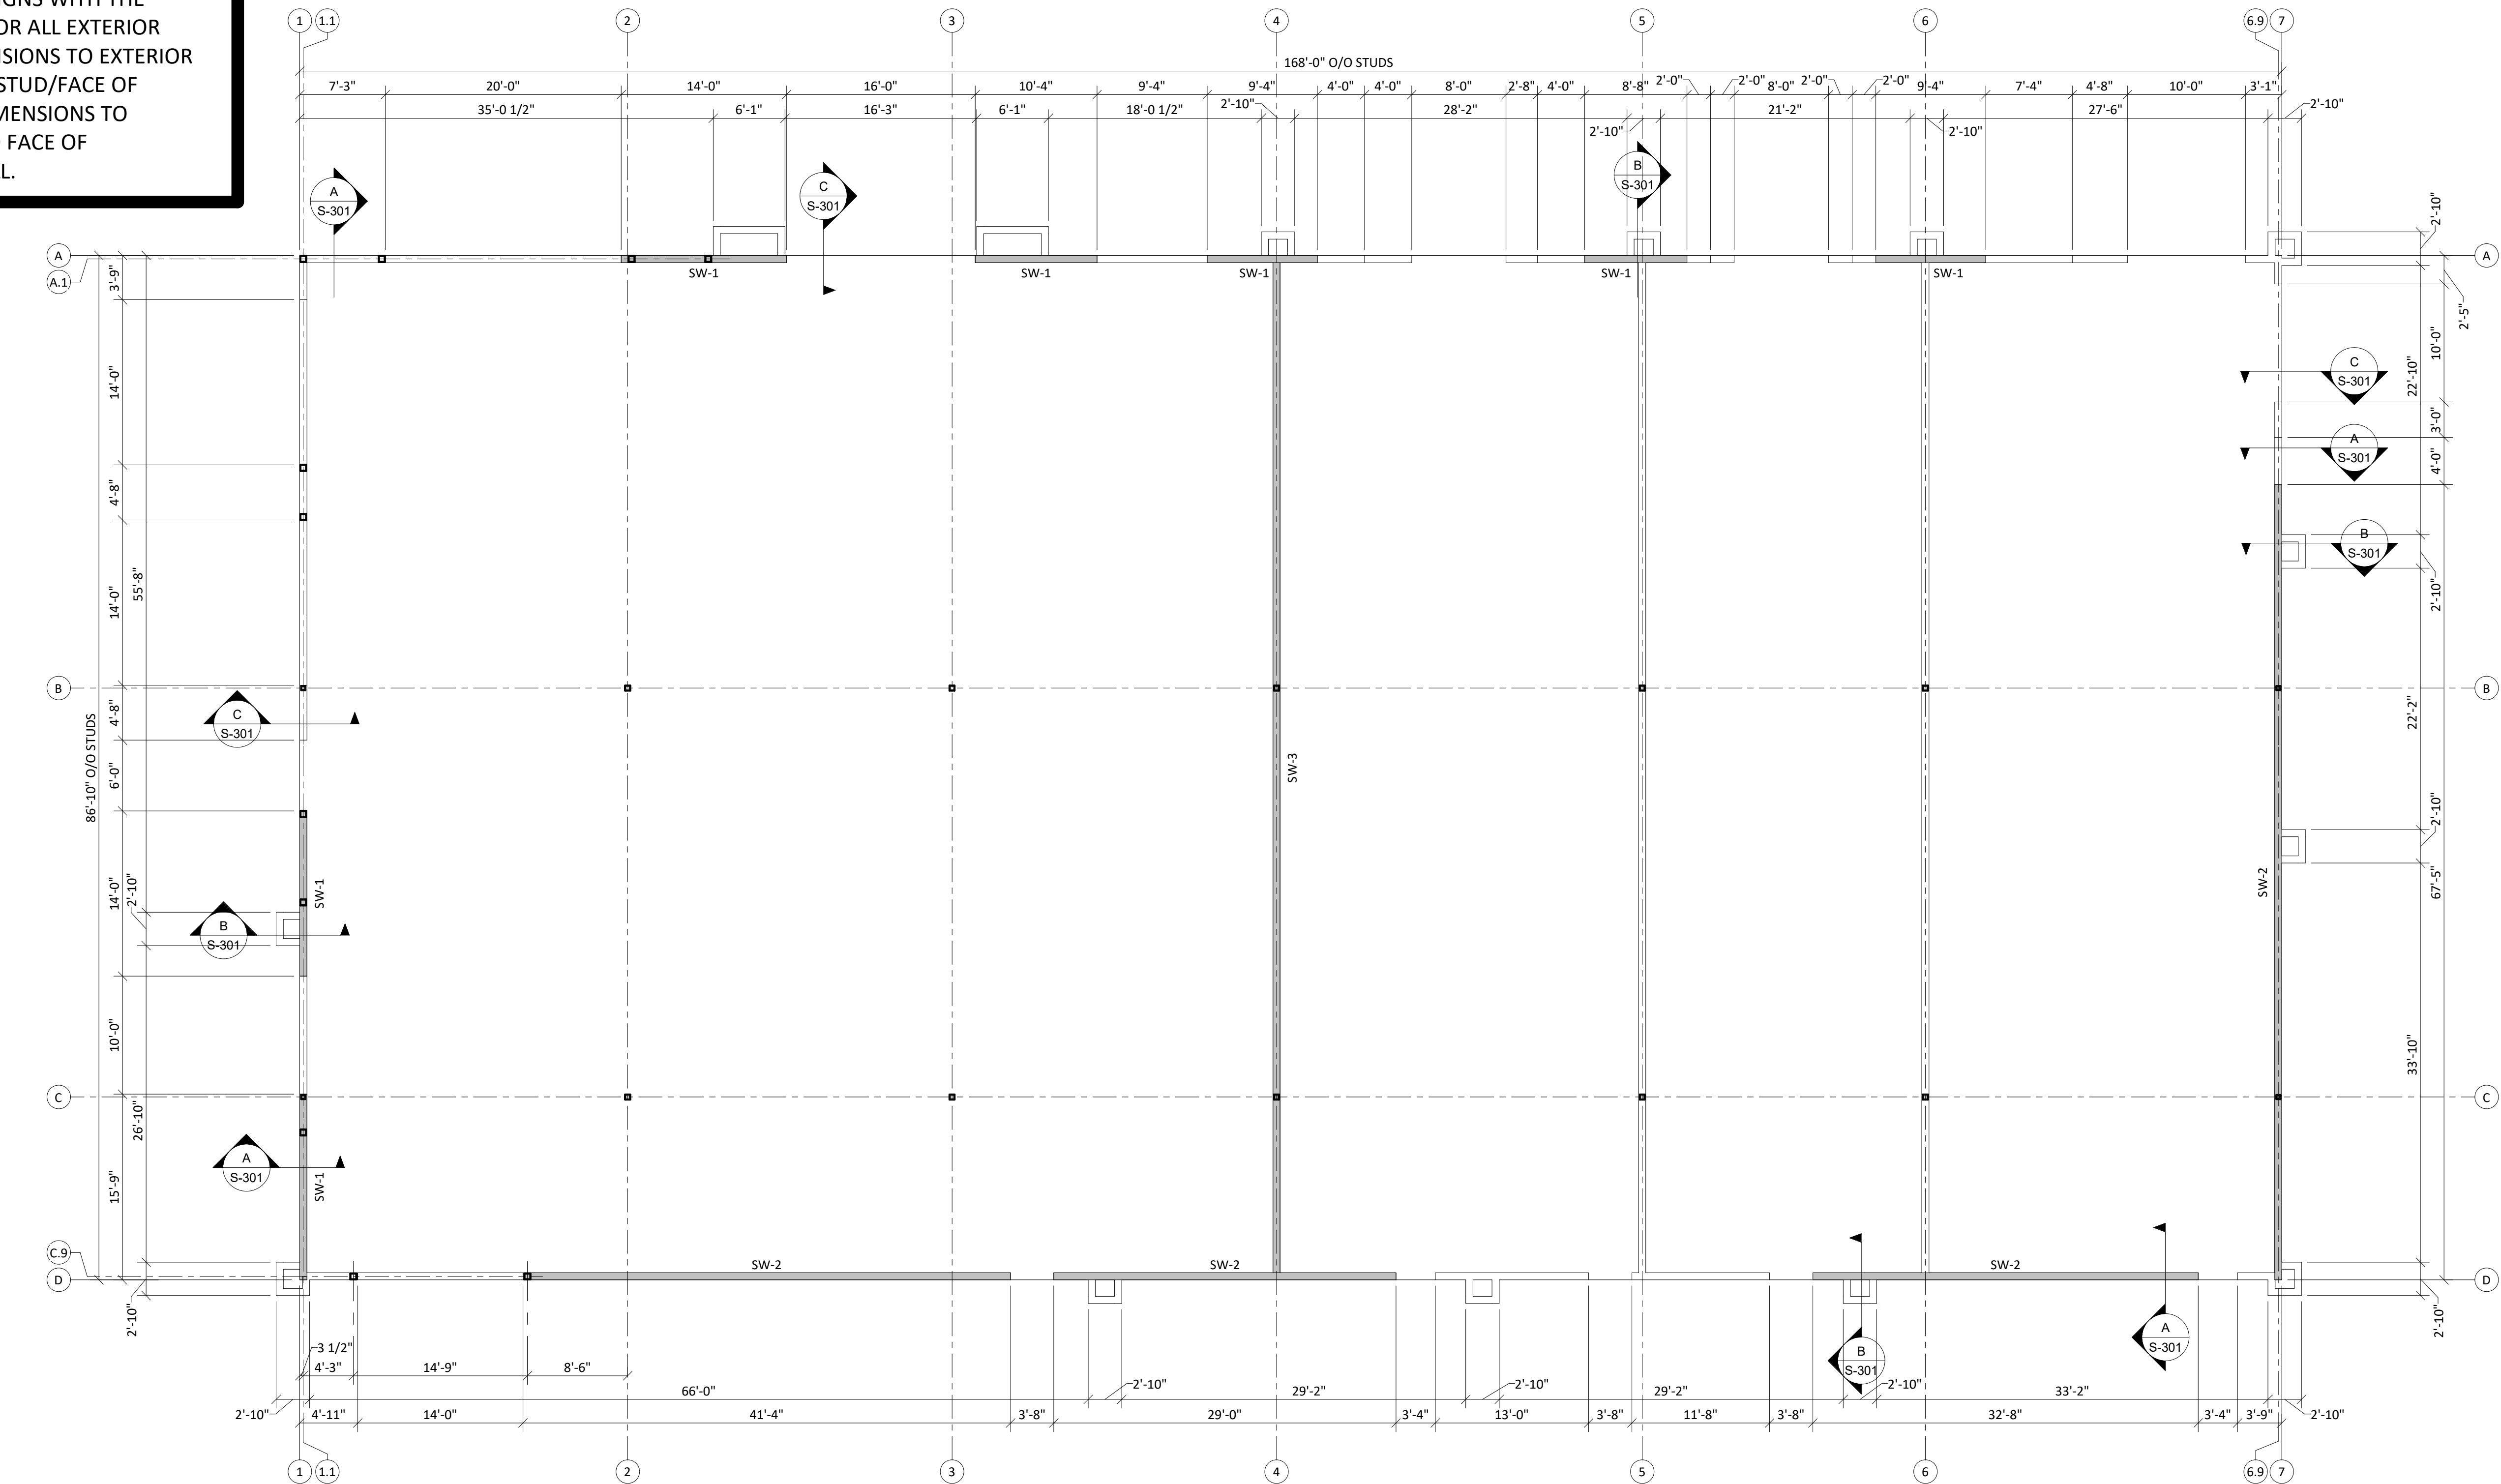

WALL FRAMING PLAN

SCALE: 1/8" = 1'-0"

WALL CONSTRUCTION: TYPICAL EXTERIOR WALL CONSTRUCTION SHALL BE 2x8 WOOD STUDS @ 16" MAXIMUM ON CENTER. MINIMUM (2) TRIMMER STUDS AND (2) KING STUDS SHALL BE PROVIDED AT ALL OPENINGS IN EXTERIOR, BEARING, AND SHEAR WALLS. TYPICAL INTERIOR SHEAR WALL CONSTRUCTION SHALL BE 2x6 WOOD STUDS @ 16" ON CENTER. REFERENCE HEADER SCHEDULE FOR CONDITIONS REQUIRING ADDITIONAL STUDS. DOUBLE TOP PLATE SHALL BE CONTINUOUS AND SHALL BE SPLICED PER TYPICAL DETAIL. SEE SHEAR WALL SCHEDULE FOR FURTHER INFORMATION ON CONSTRUCTION OF SHEAR WALLS.

INDICATES LOCATION OF SHEARWALL

SW-(#) - SHEARWALL MARK, REFERENCE SCHEDULE

VERIFY ALL DIMENSIONS SHOWN WITH ARCHITECTURAL AND EXISTING CONDITIONS PRIOR TO CONSTRUCTION. INFORM ENGINEER OF ALL DISCREPANCIES.

WOOD SHEARWALL (SW) SCHEDULE

MARK	STUD SIZE & SPACING	SHEATHING MATERIAL	EDGE NAILING	FIELD NAILING	COMPRESSION CHORD (MIN)	HOLDOWN	SILL PLATE ANCHOR BOLT AT FDN
SW-1	2x8@16	1/2" OSB ZIP SYSTEM PANELS BLOCKED ONE SIDE OF WALL	8d COMMON @4" OC	8d COMMON @12" OC	(3) 2x8 WD STUDS	HDU8-SD2.5 7/8"Ø AB	5/8"Ø AB AT 1'-4" OR 3/4"Ø AB AT 2'-0" OC
SW-2	2x8@16	1/2" OSB ZIP SYSTEM PANELS BLOCKED ONE SIDE OF WALL	8d COMMON @6" OC	8d COMMON @12" OC	(2) 2x8 WD STUDS	HDU4-SD2.5 5/8"Ø AB	5/8"Ø AB AT 2'-0" OR 3/4"Ø AB AT 2'-8" OC
SW-3	2x6@16	5/8" (MIN) GYPSUM BOARD BLOCKED BOTH SIDES OF WALL	5d COOLER @4" OC	5d COOLER @4" OC	(2) 2x6 WD STUDS	HDU4-SD2.5 5/8"Ø AB	5/8"Ø AB AT 2'-0" OR 3/4"Ø AB AT 2'-8" OC

CERTUS
STRUCTURAL ENGINEERS
900 S. Kansas Avenue; Suite 400
Topeka, Kansas 66612
Phone: (785) 291-0400
Fax: (785) 291-0401
Proj #: 01190008.125
Certificate Of Authorization
E-1392
REVIT 2023 LOCAL

CORE & SHELL BUILDING FOR STREETS OF WEST PRYOR LOT 13 LEES SUMMIT, MISSOURI

SUBMISSION DATES
12/27/2023
ADD #1 01/19/2024

SHEET TITLE
WALL FRAMING PLAN

PROJECT NUMBER
230117

SHEET NUMBER
S-103

FILEPATH: C:\Users\grad\Documents\01190008.125 - Streets of West Pryor - Lot 13_Gradster.rvt
DATE: 12/27/2023 11:41:48 AM
DRAWN BY: Author

ROOF FRAMING PLAN

SCALE: 1/8" = 1'-0"

ROOF CONSTRUCTION: WOOD SHEATHING (19/32" MIN) OVER PREFAB WOOD ROOF TRUSSES @ 2'-0" OC MAX. SHEATHING SHALL BE CONTINUOUS UNDER AREAS OF OVERBUILD. REFERENCE GENERAL NOTES FOR SHEATHING SPECIFICATIONS AND ATTACHMENT.

DESIGN ALL TRUSSES FOR 15 PSF NET UPLIFT.

PROVIDE BRIDGING AS PRESCRIBED BY THE TRUSS MANUFACTURER REQUIREMENTS.

TOS - TOP OF STEEL ELEVATION: NOTED THUS (ELEV)

TOP OF PARAPET = RE: ARCH, 126-0 (MAX)


TRUSS BEARING ELEVATION = 117-0

TYPICAL HEADERS IN OPENINGS LESS THAN 4'-0" SHALL BE (4) 2X8 OR DEEPER. ALL HEADERS IN OPENINGS UP TO 6'-6" SHALL BE (4) 2X10 OR DEEPER. ALL HEADERS IN OPENINGS UP TO 8'-4" SHALL BE (4) 2X12. CONSTRUCT HEADERS PER "TYPICAL HEADER CONSTRUCTION" DETAIL." ALL HEADERS SHALL HAVE (1) TRIMMER MINIMUM AND (2) DEDICATED STUDS MINIMUM. PROVIDE (2) TRIMMERS AT OPENINGS LARGER THAN 7'-4".

INTELS: LOOSE BRICK INTELS FOR DOOR AND WINDOW OPENINGS UP TO 8'-4" SHALL BE 15X5X3/8 GALVANIZED (ASTM A36)

DESIGN ROOF TRUSSES TO SUPPORT RTU LOADS AT LOCATIONS SHOWN. NOTIFY ENGINEER IF WEIGHTS, SIZES, OR LOCATIONS VARY FROM THAT SHOWN.

VERIFY ALL DIMENSIONS SHOWN WITH ARCHITECTURAL DRAWINGS PRIOR TO CONSTRUCTION. INFORM ENGINEER OF ALL DISCREPANCIES.

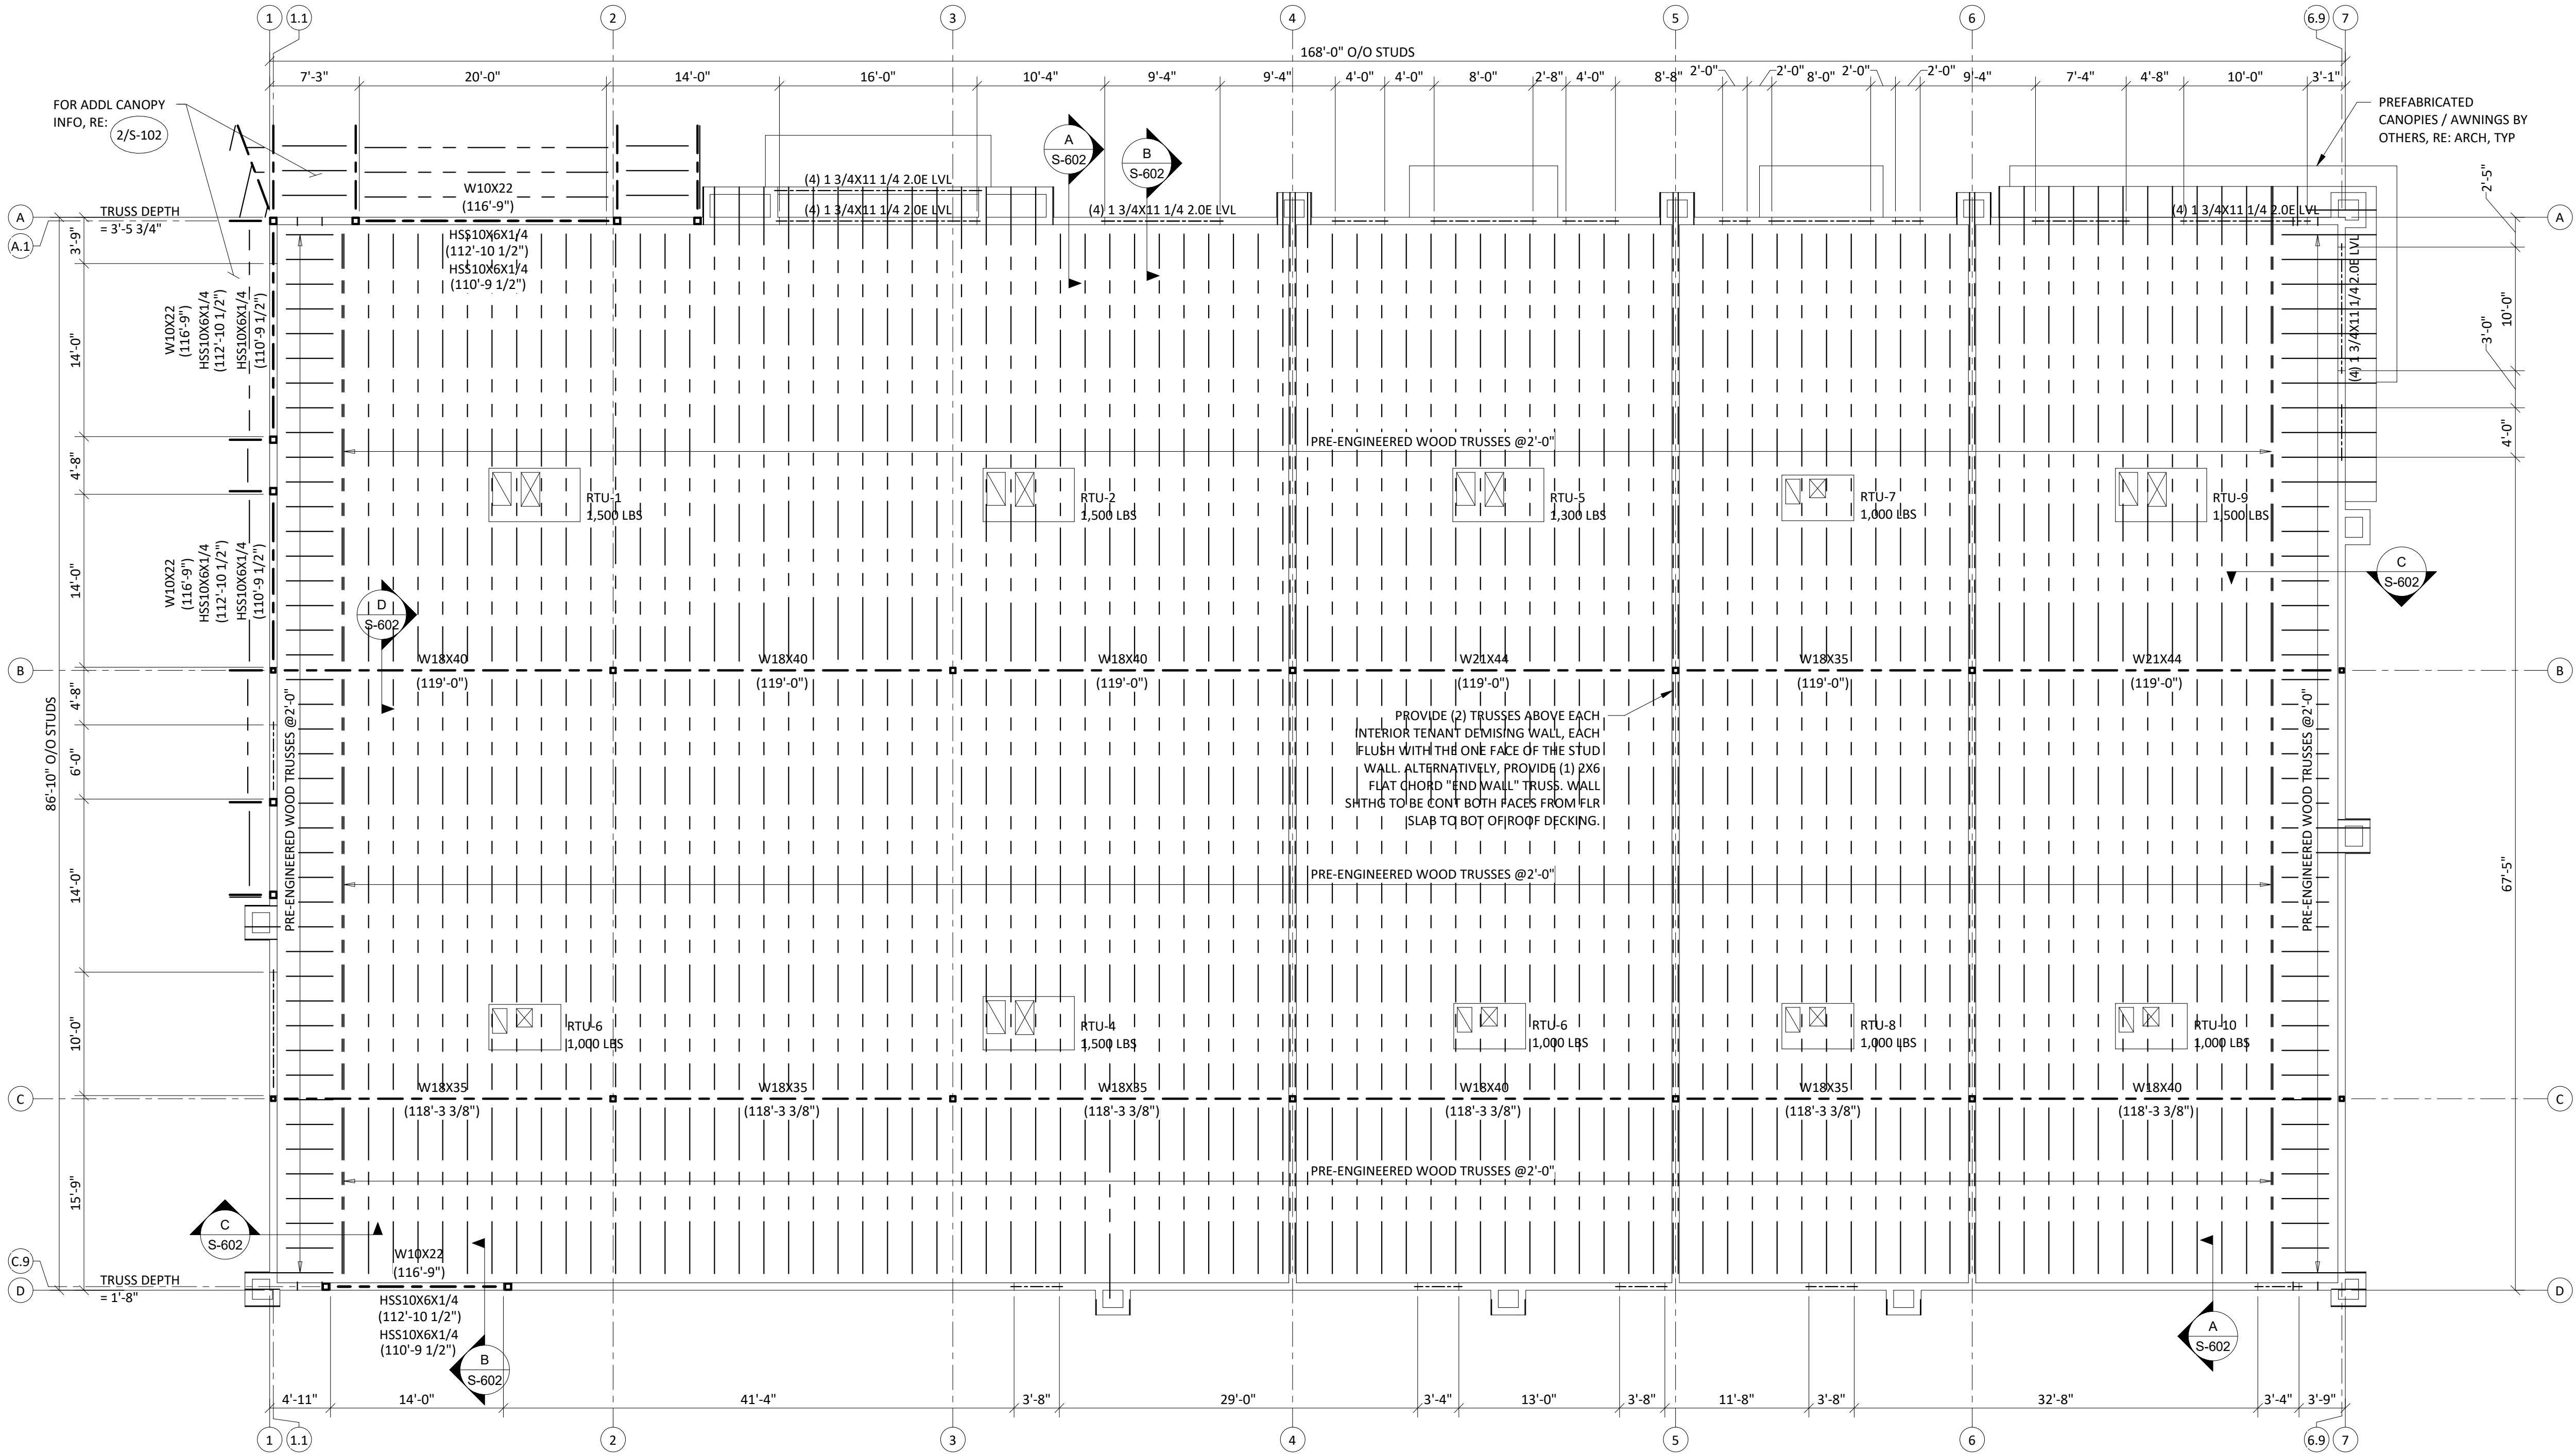

CERTUS
STRUCTURAL ENGINEERS
900 S. Kansas Avenue; Suite 400
Topeka, Kansas 66612
Phone: (785) 291-0400
Fax: (785) 291-0401
Proj #:01190008.125
Certificate Of Authorization
E-1392
REVIT 2023 LOCAL

schwerdt design group
architecture | interiors | planning
2231 sw wanamaker rd suite 303
topeka, kansas 66614-4275
phone: 785.213.7540
fax: 785.273.7579
500 north broadway suite 200
oklahoma city, ok 73102
phone: 405.231.3105
fax: 405.231.3115

STATE OF MISSOURI
KEVIN S. VOLLMER
NUMBER PE-2005011704
PROFESSIONAL ENGINEER

CORE & SHELL BUILDING FOR STREETS OF WEST PRIOR LOT 13 LEES SUMMIT, MISSOURI


SUBMISSION DATES
12/27/2023

SHEET TITLE
ROOF FRAMING PLAN

PROJECT NUMBER
230117

SHEET NUMBER
S-104

FILEPATH: C:\Users\grad\harris\Documents\01190008.125 - Streets of West Pryor - Lot 13_Gradster.rvt
DATE: 1/22/2024 11:43:43 AM
DRAWN BY: Author

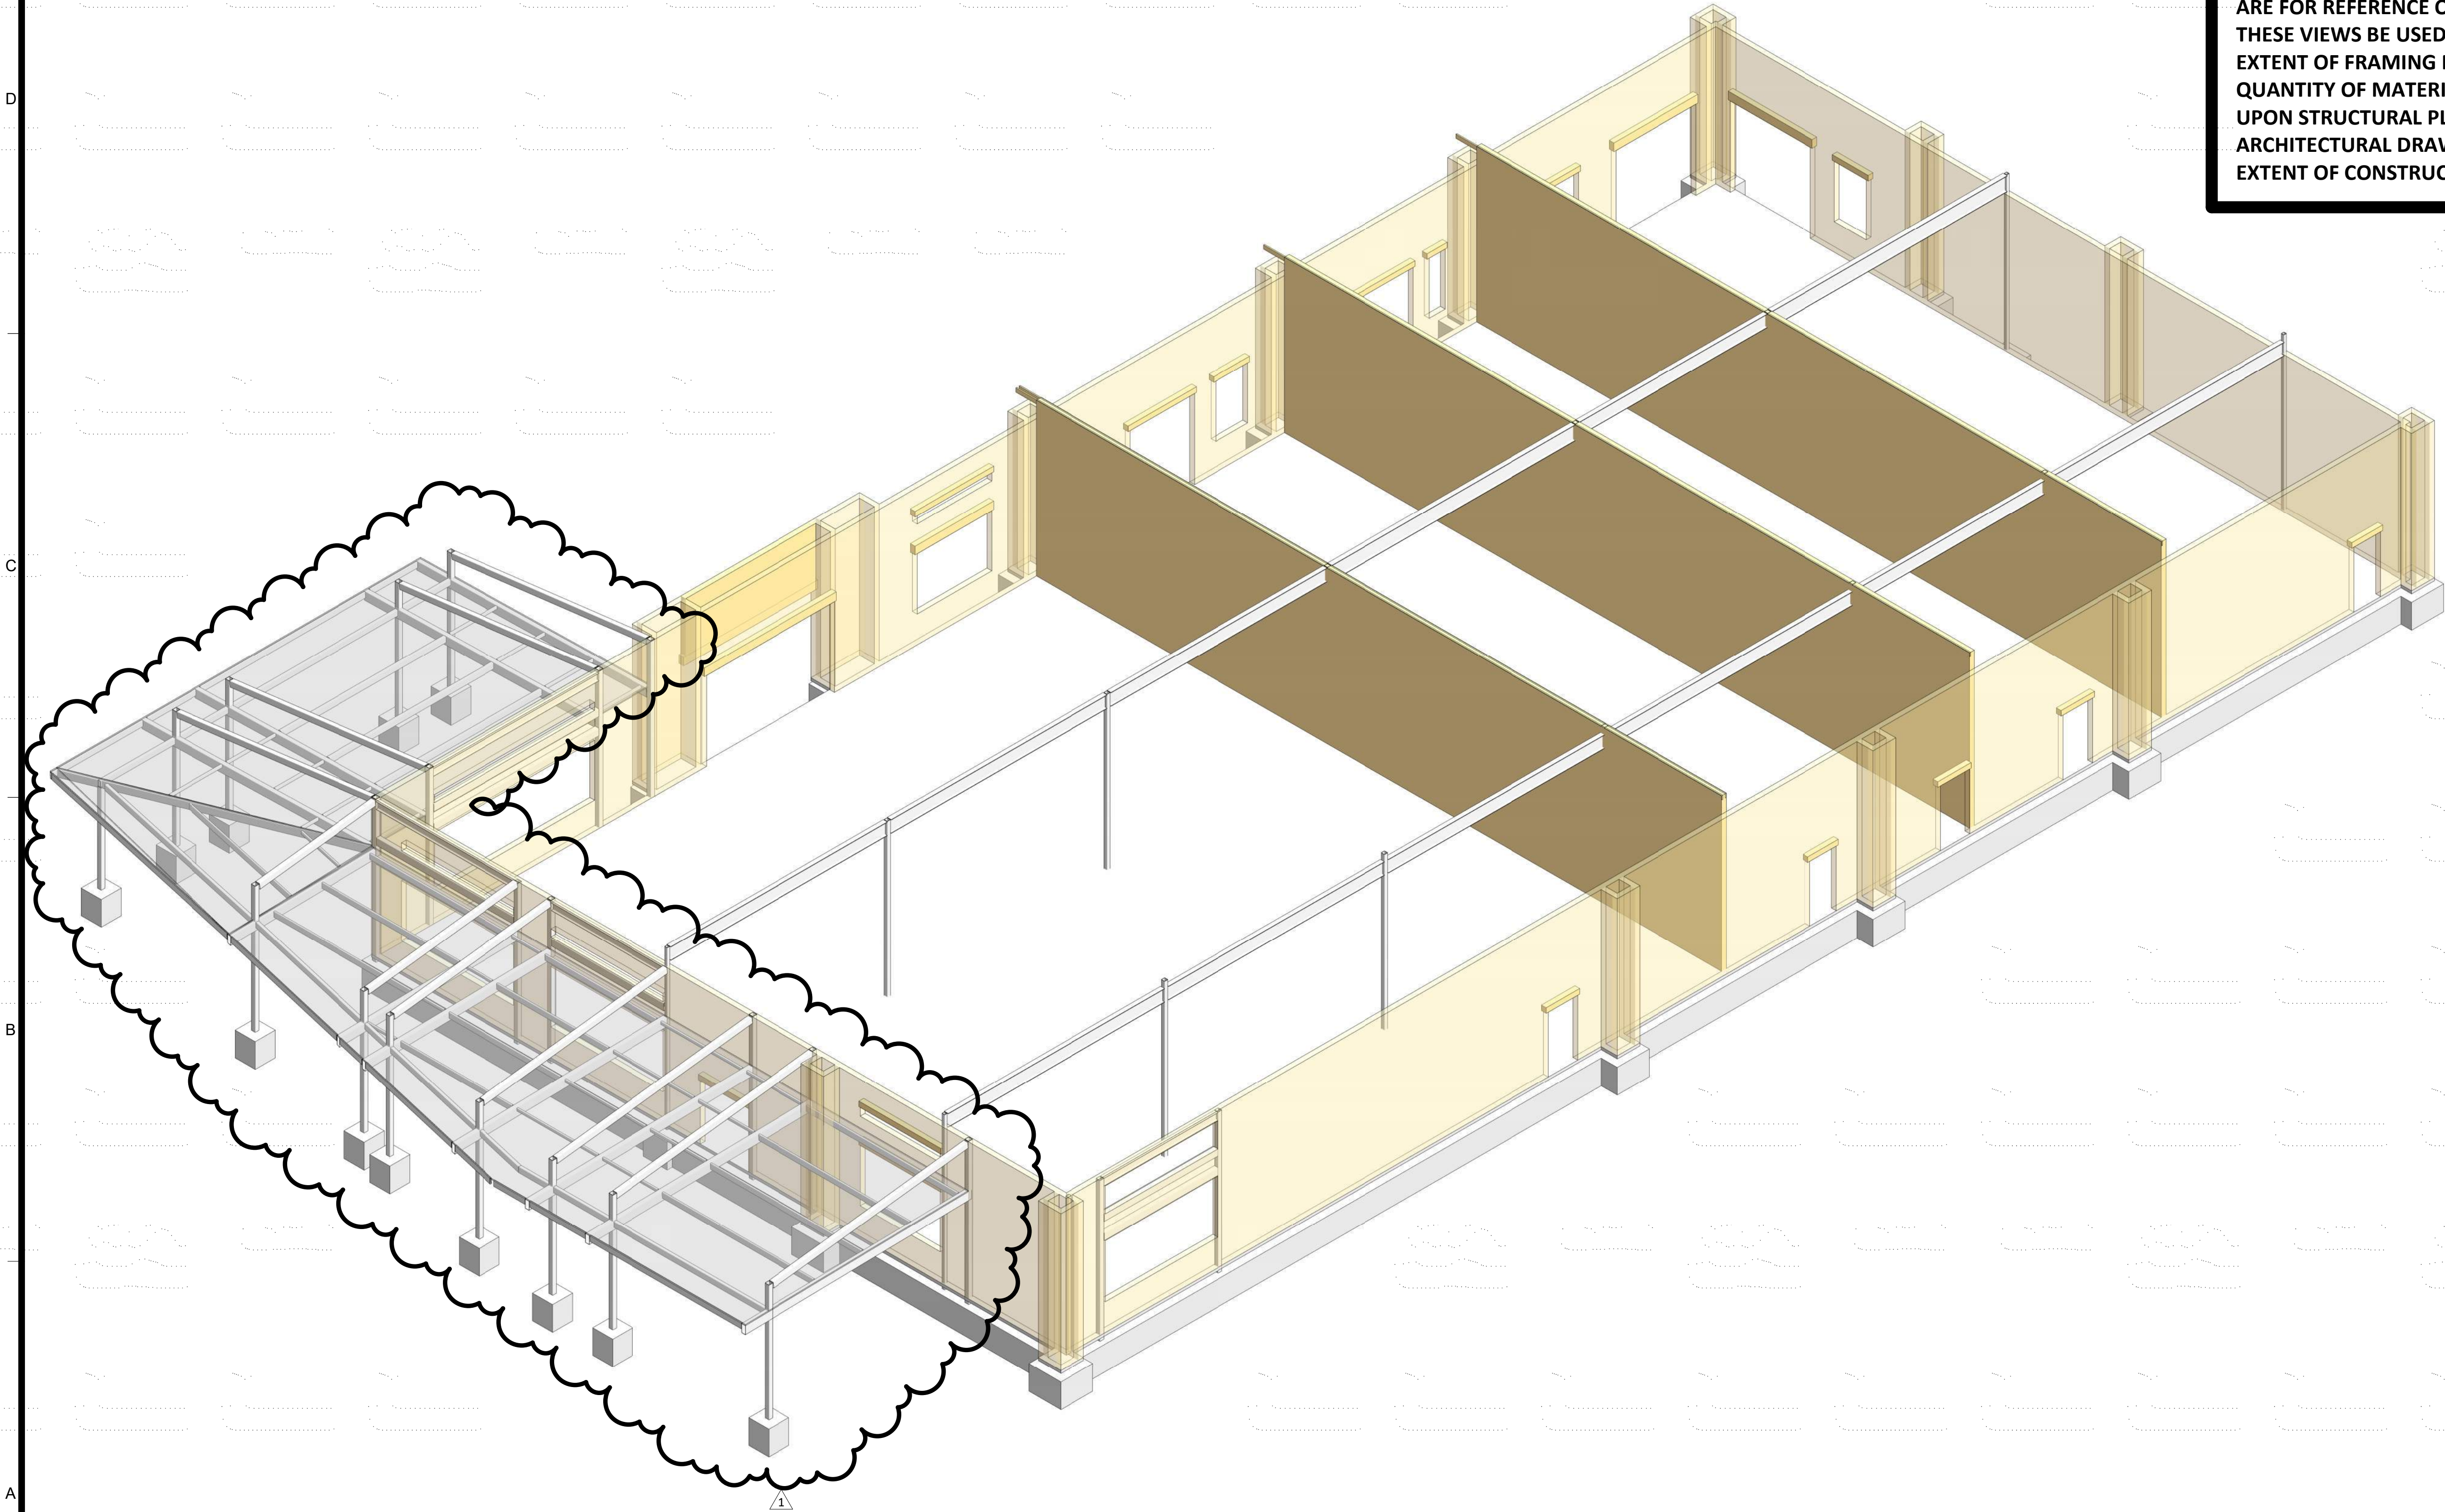

1 STRUCTURAL STEEL ISOMETRIC VIEW FROM NW CORNER
SCALE: NONE

ISOMETRIC VIEWS ARE INTENDED TO SHOW
GENERAL FRAMING CONFIGURATIONS AND
ARE FOR REFERENCE ONLY. IN NO WAY SHALL
THESE VIEWS BE USED TO CONVEY THE FULL
EXTENT OF FRAMING MATERIALS REQUIRED.
QUANTITY OF MATERIALS SHALL BE BASED
UPON STRUCTURAL PLANS, DETAILS,
ARCHITECTURAL DRAWINGS, AND THE FULL
EXTENT OF CONSTRUCTION DOCUMENTS.

CERTUS
STRUCTURAL ENGINEERS
900 S. Kansas Avenue; Suite 400
Topeka, Kansas 66612
Phone: (785) 291-0400
Fax: (785) 291-0401
Proj #: 01190008.125
Certificate Of Authorization
E-1392
REVIT 2023 LOCAL

CORE & SHELL BUILDING FOR
STREETS OF WEST PRYOR LOT 13
LEES SUMMIT, MISSOURI

SUBMISSION DATES
12/27/2023
ADD #1 01/19/2024

SHEET TITLE
NW FRAMING ISOMETRIC

PROJECT NUMBER
230117


SHEET NUMBER
S-201

RELEASED FOR
CONSTRUCTION
As Noted on Plans Review
Development Services Department
Lee's Summit, Missouri
01/31/2024

schwerdt design group
architecture | interiors | planning
2231 sw wanamaker rd suite 303
topeka, kansas 66614-4275
phone: 785.213.7540
fax: 785.273.7579
500 north broadway suite 200
oklahoma city, ok 73102
phone: 405.231.3105
fax: 405.231.3115

STATE OF MISSOURI
KEVIN'S
FOURTEENTH
NUMBER
PE-2005011704
PROFESSIONAL ENGINEER

FILEPATH: C:\Users\grad\harris\Documents\01190008.125 - Streets of West Pryor - Lot 13_Gradster.rvt
DATE: 1/22/2024 11:43:48 AM
DRAWN BY: Author

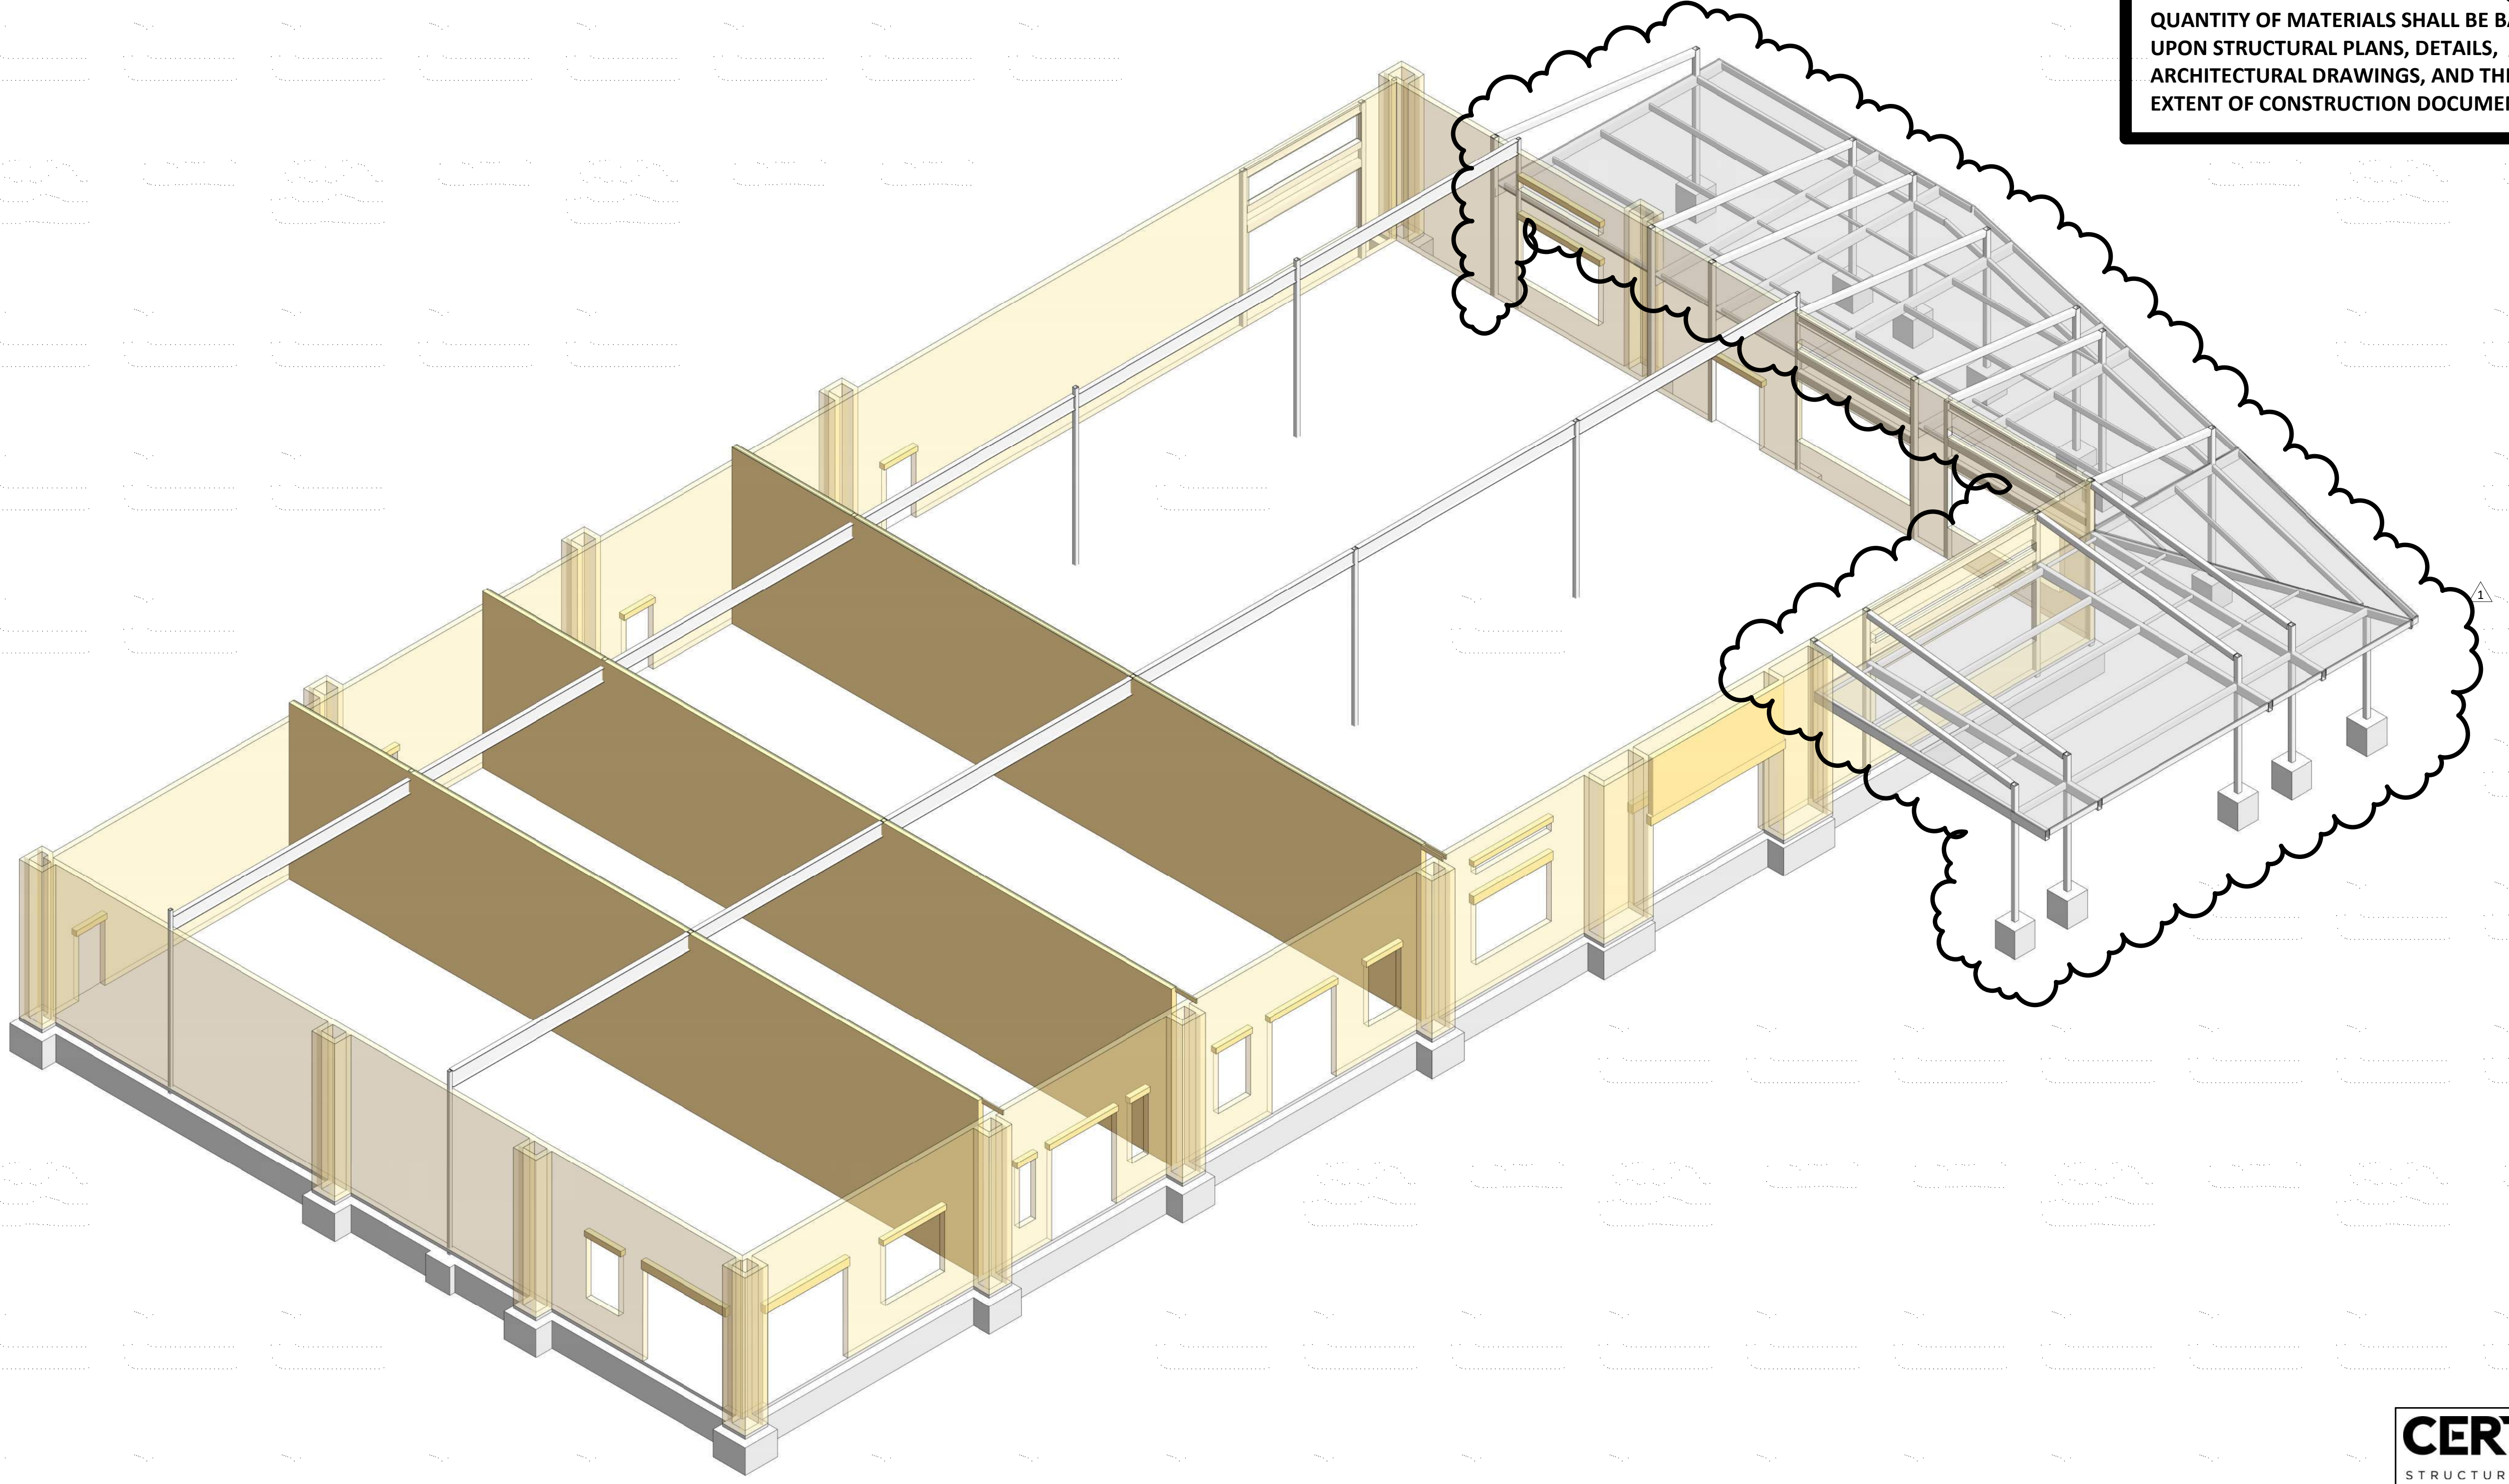

ISOMETRIC VIEWS ARE INTENDED TO SHOW
GENERAL FRAMING CONFIGURATIONS AND
ARE FOR REFERENCE ONLY. IN NO WAY SHALL
THESE VIEWS BE USED TO CONVEY THE FULL
EXTENT OF FRAMING MATERIALS REQUIRED.
QUANTITY OF MATERIALS SHALL BE BASED
UPON STRUCTURAL PLANS, DETAILS,
ARCHITECTURAL DRAWINGS, AND THE FULL
EXTENT OF CONSTRUCTION DOCUMENTS.

1 STRUCTURAL STEEL ISOMETRIC VIEW FROM SE CORNER
SCALE: NONE

CERTUS
STRUCTURAL ENGINEERS
900 S. Kansas Avenue; Suite 400
Topeka, Kansas 66612
Phone: (785) 291-0400
Fax: (785) 291-0401
Proj #: 01190008.125
Certificate Of Authorization
E-1392
REVIT 2023 LOCAL

RELEASED FOR
CONSTRUCTION
As Noted on Plans Review
Development Services Department
Lee's Summit, Missouri
01/31/2024

schwerdt design group
architecture | interiors | planning
2231 sw wanamaker rd suite 303
topeka, kansas 66614-4275
phone: 785.213.7540
fax: 785.273.7579
500 north broadway suite 200
oklahoma city, ok 73102
phone: 405.231.3105
fax: 405.231.3115

STATE OF MISSOURI
JENNIFER L. SCHWERT
NUMBER
PE-2005011704
PROFESSIONAL ENGINEER

**CORE & SHELL BUILDING FOR
STREETS OF WEST PRYOR LOT 13**
LEES SUMMIT, MISSOURI

SUBMISSION DATES
12/27/2023
ADD #1 01/19/2024

SHEET TITLE
SE FRAMING ISOMETRIC

PROJECT NUMBER
230117

SHEET NUMBER
S-202

FILEPATH: C:\Users\grady.harris\Documents\01190008.125 - Streets of West Pryor - Lot 13_Gradster.rvt
DATE: 12/27/2023 11:42:09 AM
DRAWN BY: Author


1

2


3

4


5

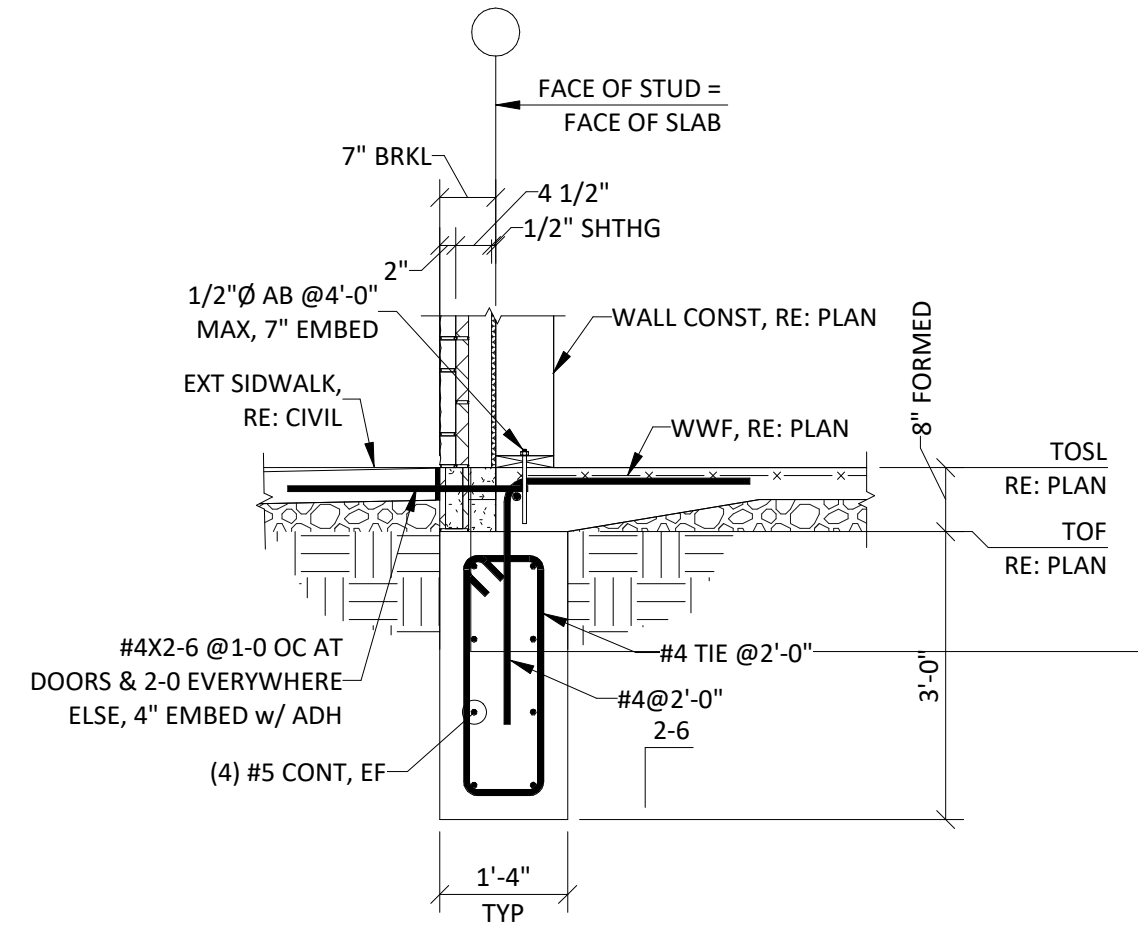


A SECTION
SCALE: NONE

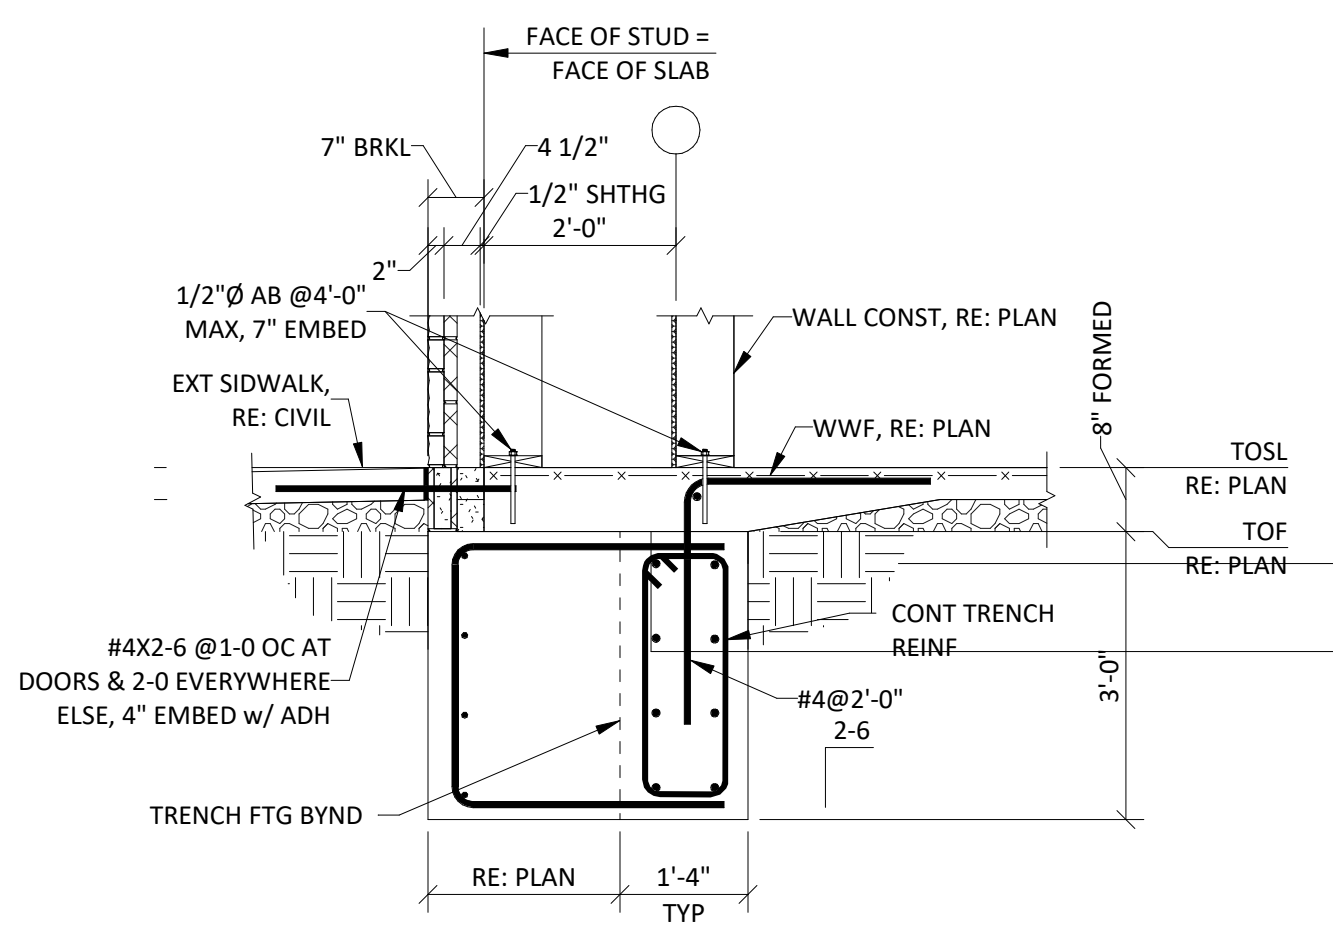


B SECTION
SCALE: NONE

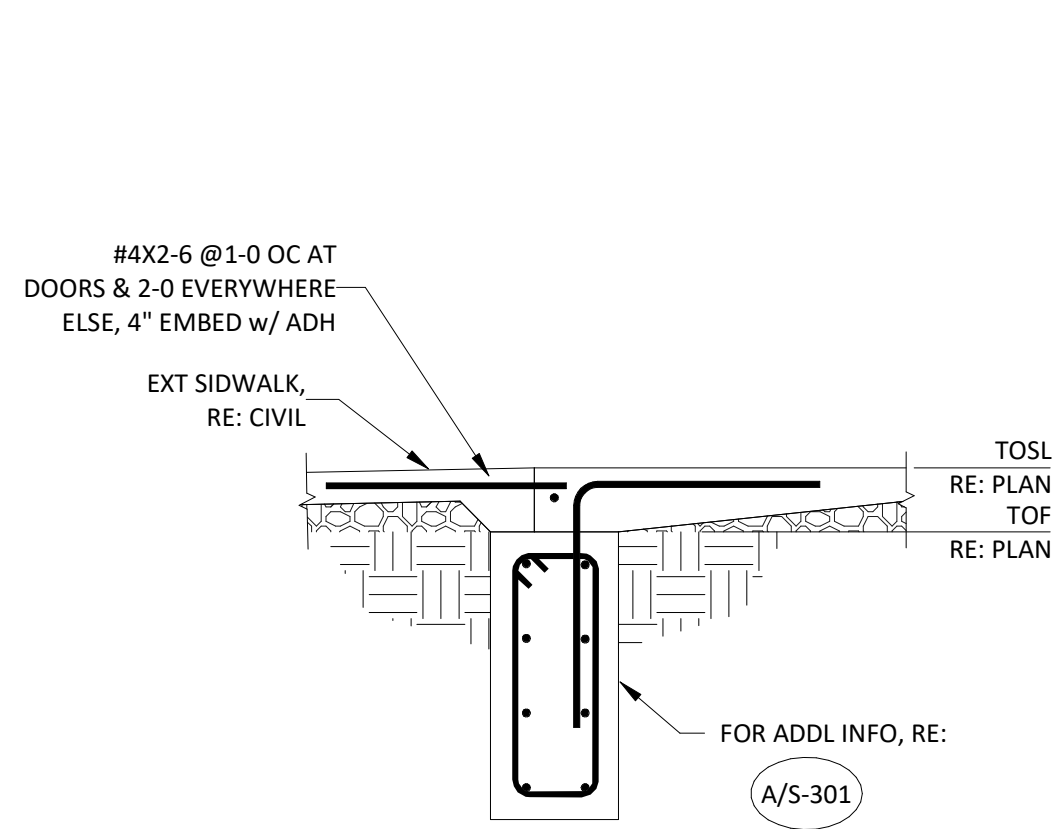


C SECTION
SCALE: NONE

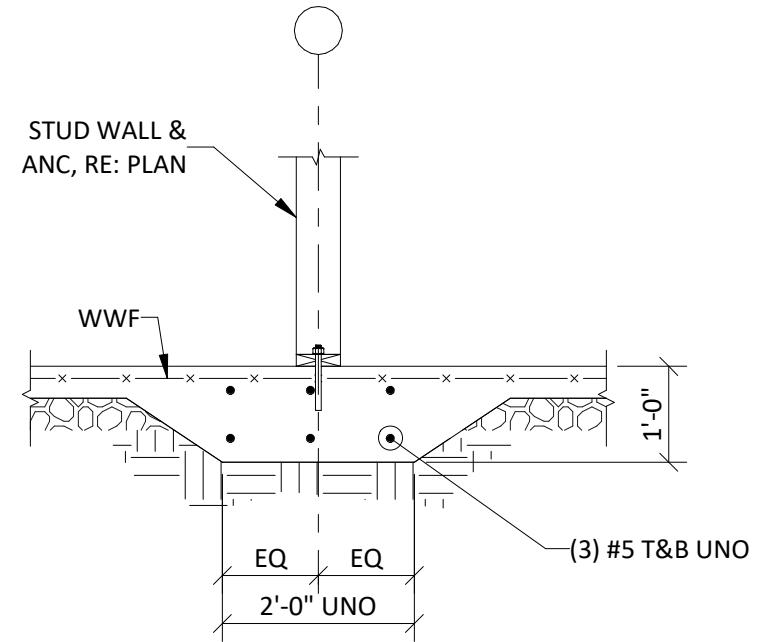


D SECTION
SCALE: NONE

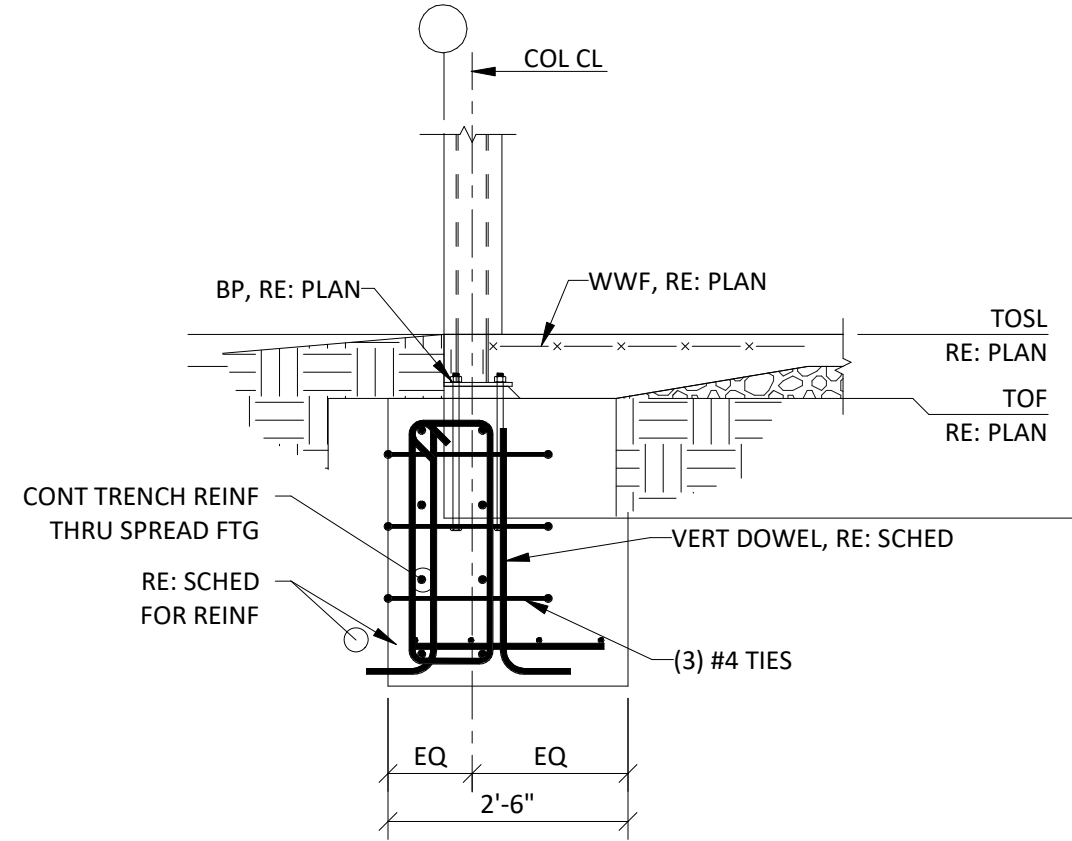


E SECTION
SCALE: NONE

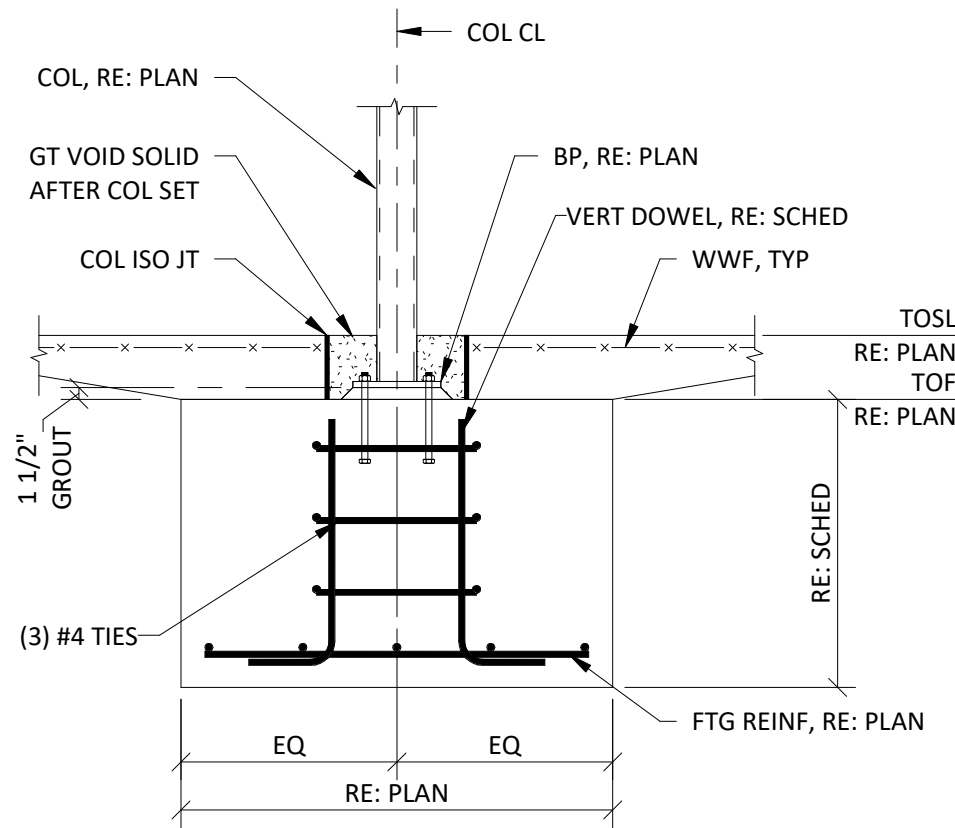


F SECTION
SCALE: NONE

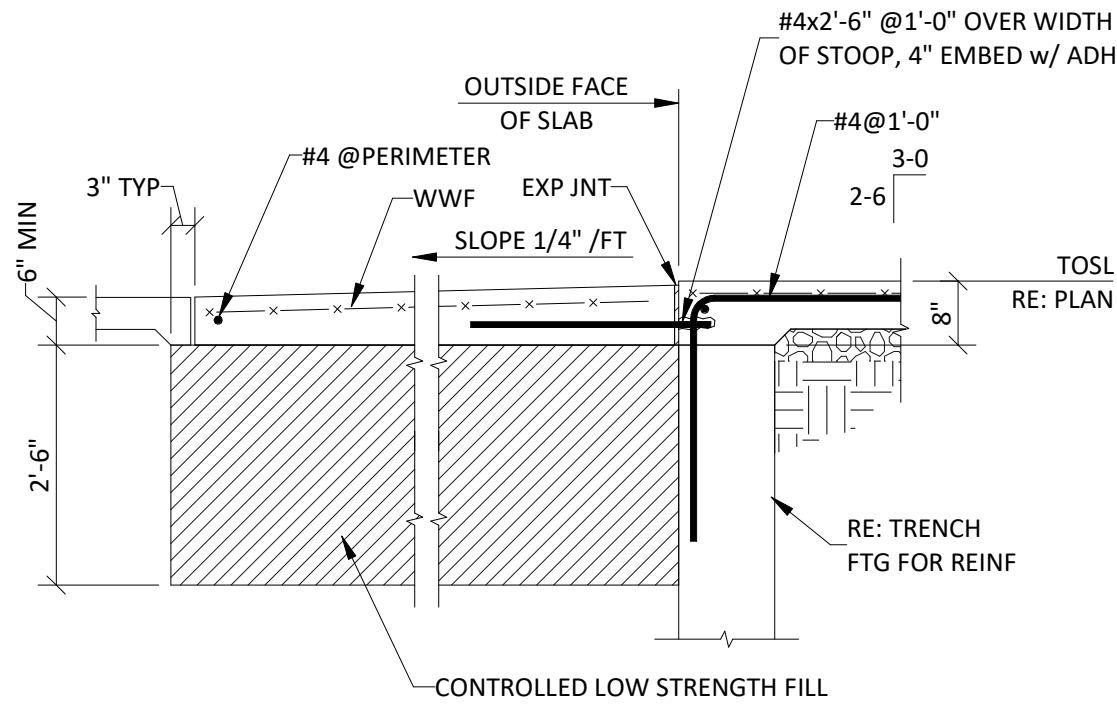


G SECTION
SCALE: NONE

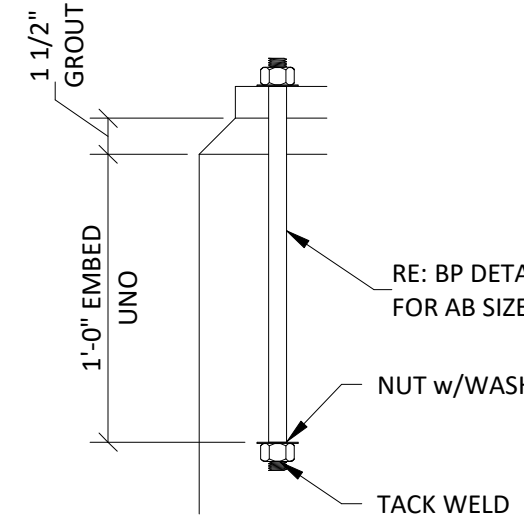

1 TYPICAL ANCHOR BOLT DETAIL
SCALE: NONE

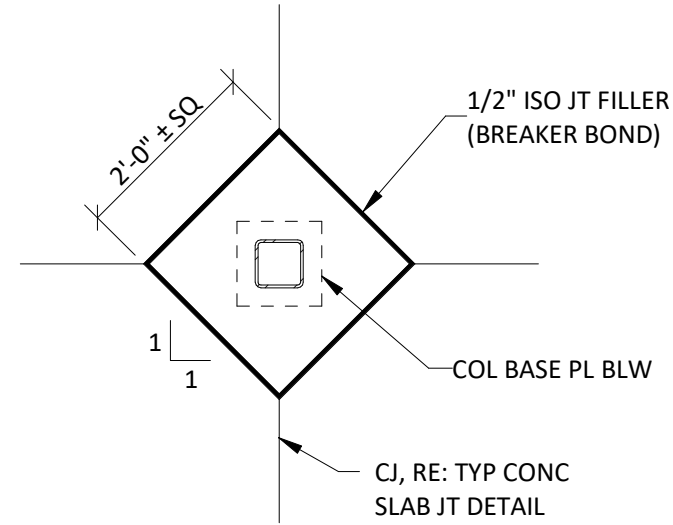


2 TYPICAL COLUMN ISOLATION IN
SLAB ON GRADE DETAIL
SCALE: NONE

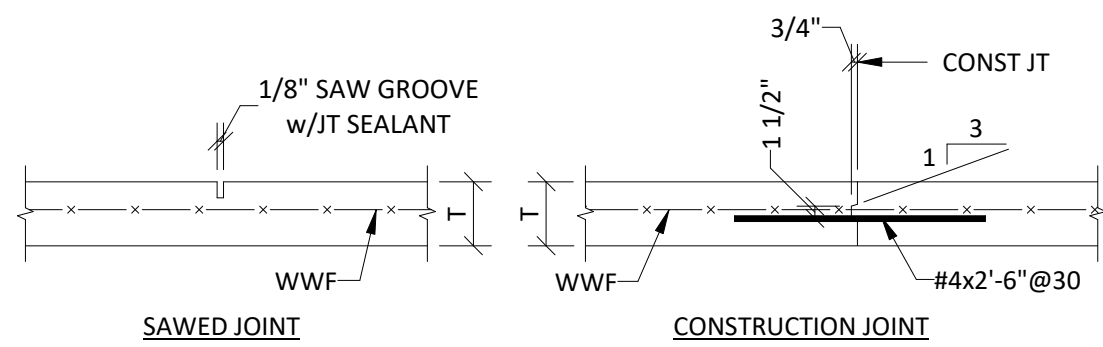


NOTE: ALL SLABS ON GRADE SHALL BE CONSTRUCTED WITH CONTROL JOINTS IN SQUARE OR RECTANGULAR PATTERNS WITH A LENGTH TO WIDTH RATION OF 1/2 OR LESS. CONTROL JOINTS SHALL BE SPACED NO FURTHER APART THAN 10'-0". AT THE CONTRACTORS OPTION, CONSTRUCTION JOINT MAY BE USED IN LIEU OF ANY CONTROL JOINT.


3 TYPICAL CONCRETE SLAB JOINT DETAIL
SCALE: NONE

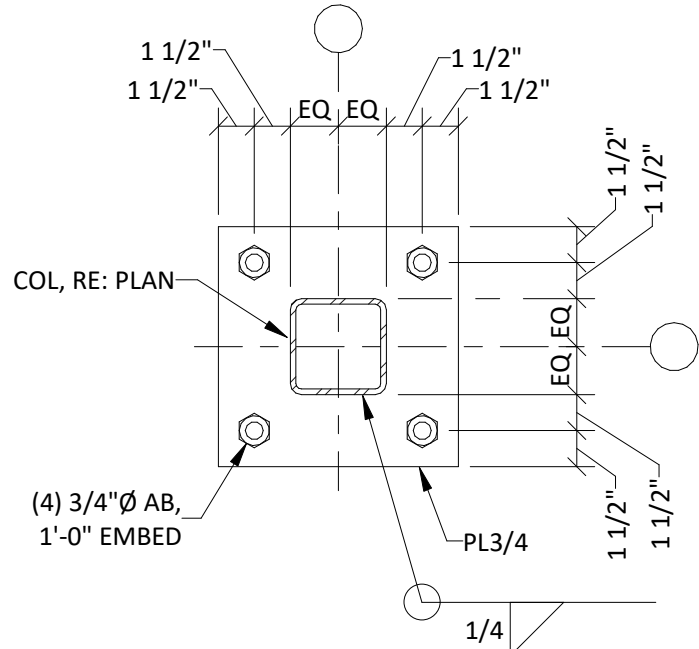


4 BASEPLATE DETAILS
SCALE: NONE

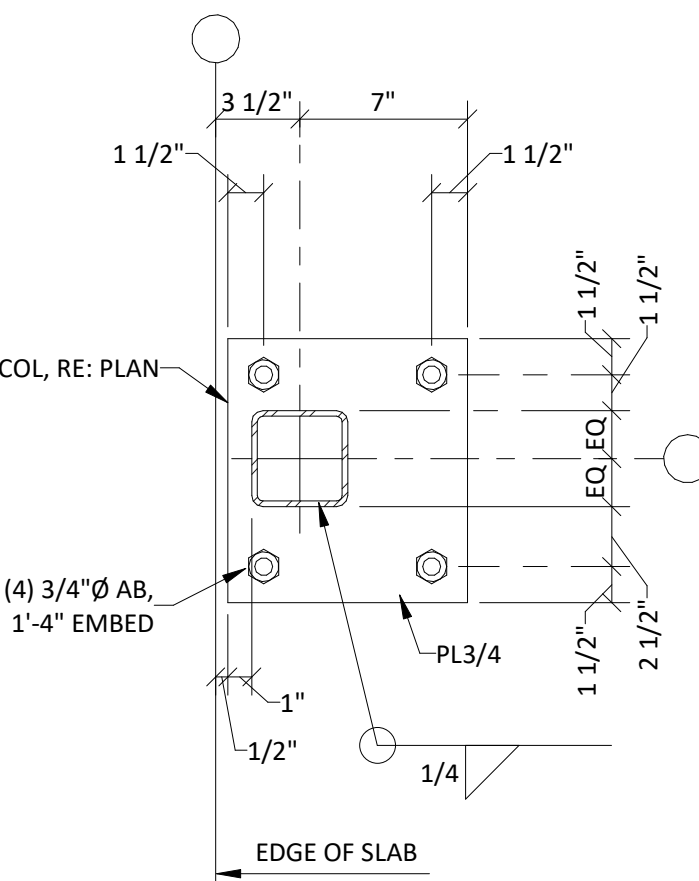

BP-2

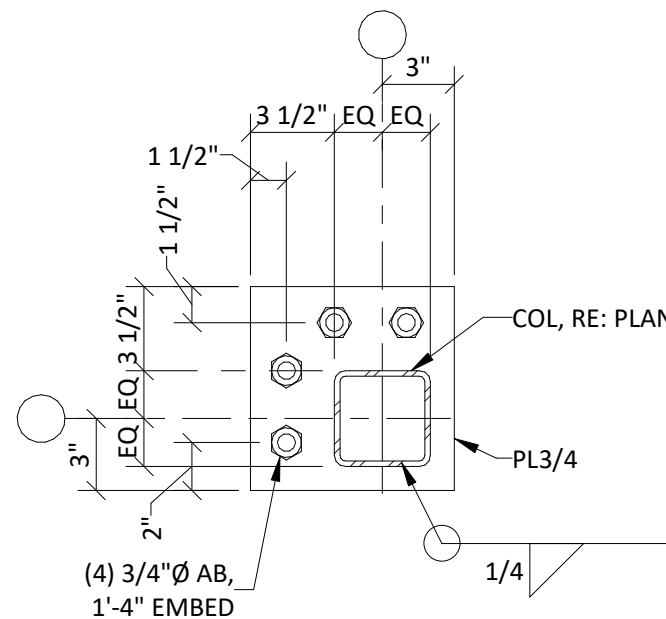

BP-3

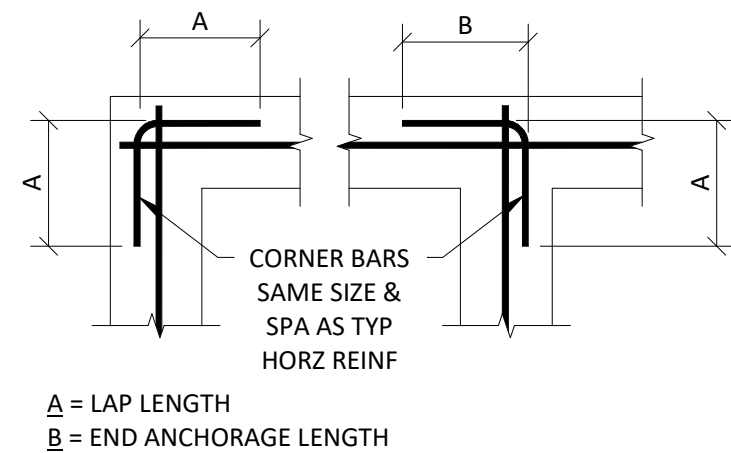

5 TYPICAL CORNER REINFORCEMENT
DETAIL (ONE CURTAIN)
SCALE: NONE

CERTUS
STRUCTURAL ENGINEERS
900 S. Kansas Avenue; Suite 400
Topeka, Kansas 66612
Phone: (785) 291-0400
Fax: (785) 291-0401
Proj #:01190008.125
Certificate Of Authorization
E-1392
REVIT 2023 LOCAL

FILEPATH: C:\Users\grad\harris\Documents\01190008.125 - Streets of West Pryor - Lot 13_Gradster.rvt
DATE: 12/27/2023 11:42:11 AM
DRAWN BY: Author


1

2


3

4


5

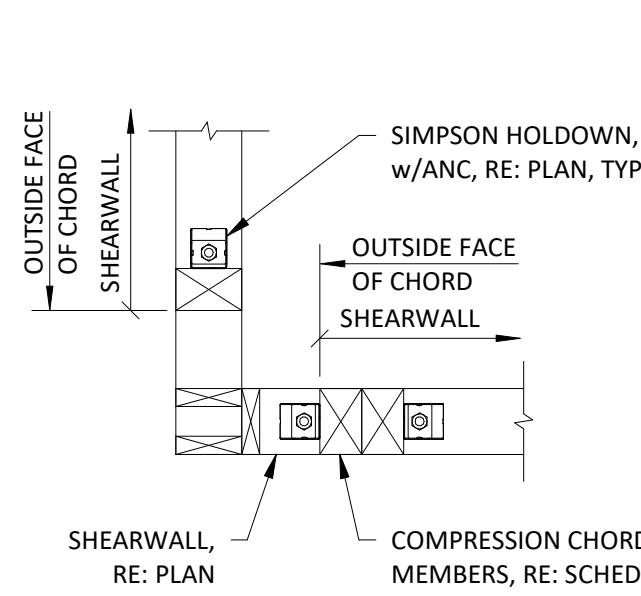


1 TYPICAL HOLDOWN ASSEMBLY CORNER (ALTERNATE)
SCALE: NONE

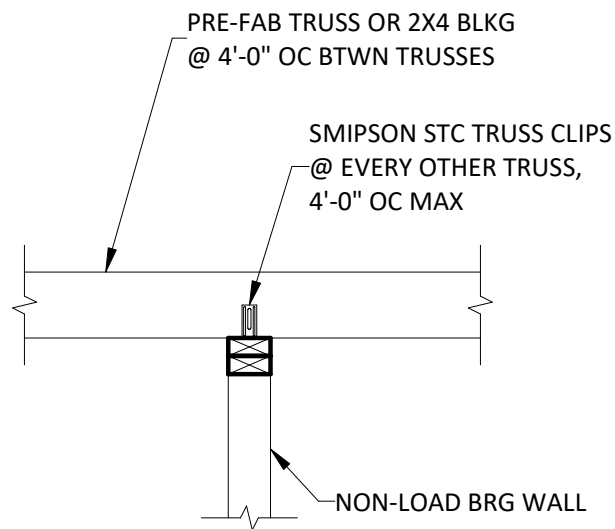


2 NON-LOAD BEARING WALL LATERAL SUPPORT DETAIL
SCALE: NONE

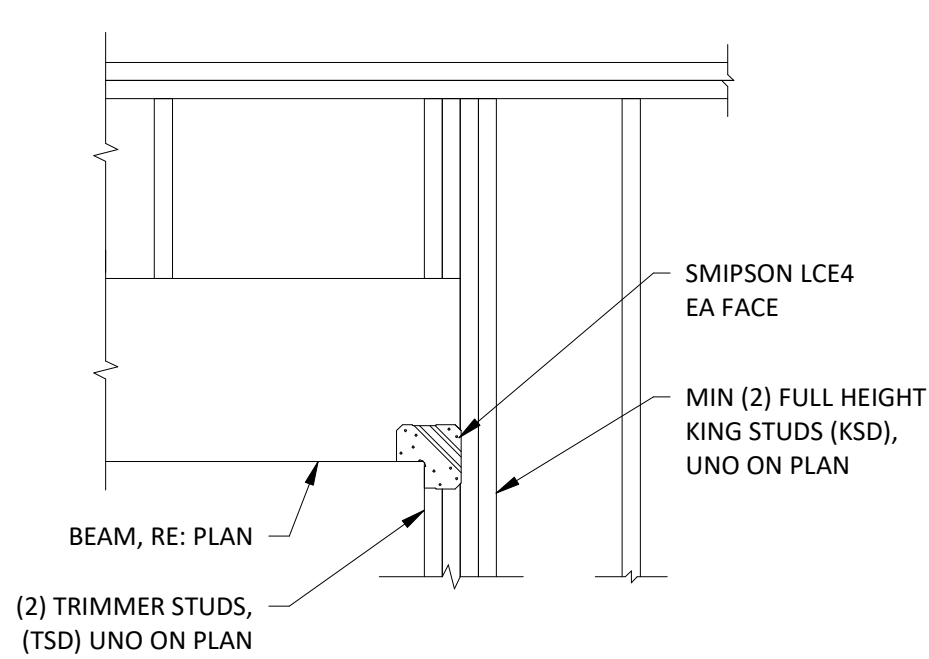

3 TYPICAL HEADER CONSTRUCTION DETAIL
SCALE: NONE

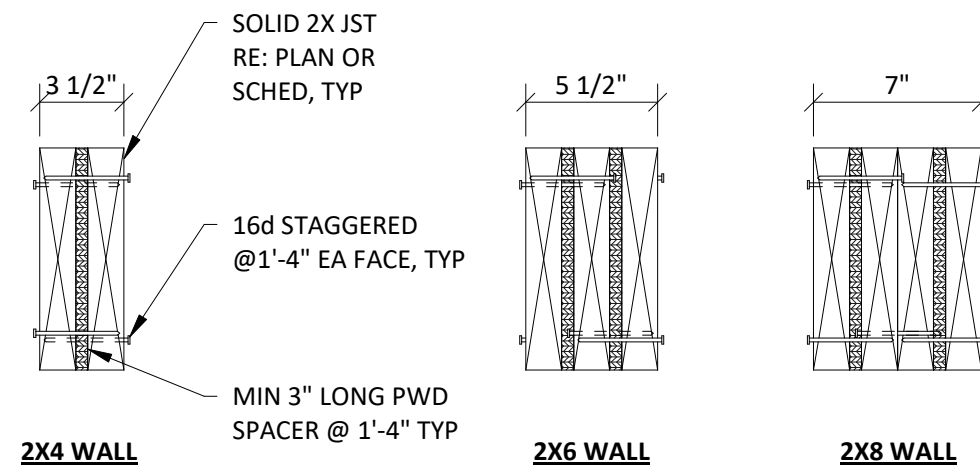


4 TYPICAL BUILT-UP HEADER CONSTRUCTION
SCALE: NONE

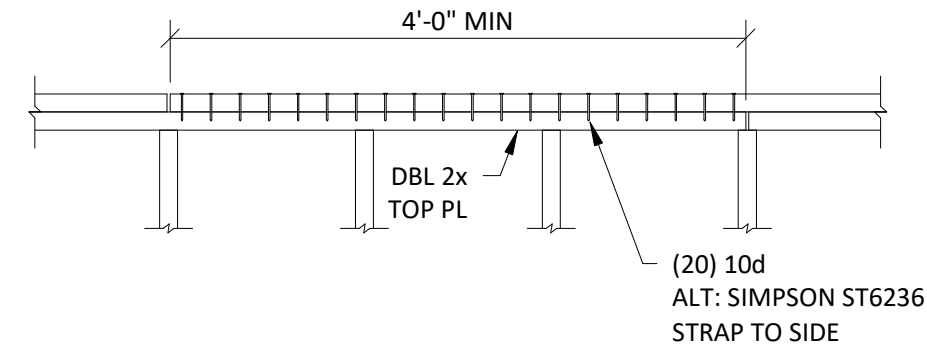


- NOTES:
1. SPLICE REQUIRED OVER ALL SHEARWALLS AND ALL EXTERIOR AND BEARING WALLS.
 2. SPECIFIC SPLICE REQUIREMENTS DO NOT APPLY TO INTERIOR NON-SHEARWALLS OR TOP OF PARAPET WALLS UNLESS NOTED OTHERWISE.


5 TYPICAL TOP PLATE SPLICE DETAIL
SCALE: NONE

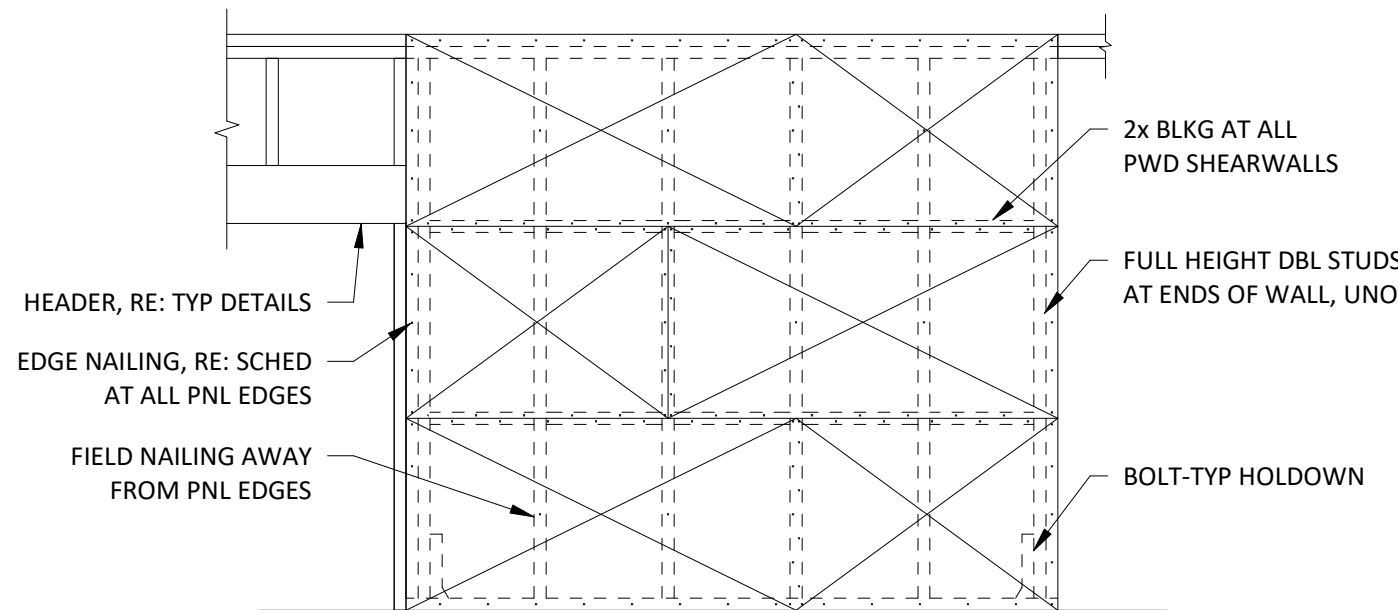


6 TYPICAL SHEARWALL CONSTRUCTION
SCALE: NONE

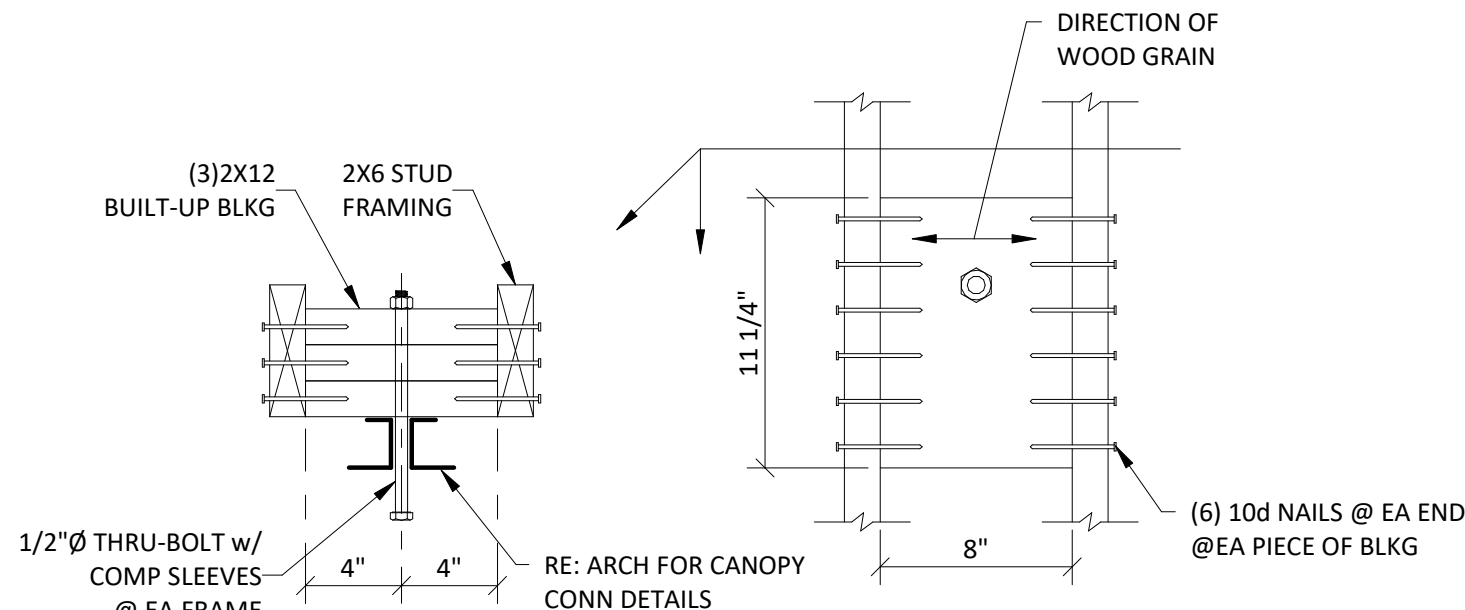


7 TYPICAL CANOPY CONNECTION BLOCKING DETAIL
SCALE: NONE

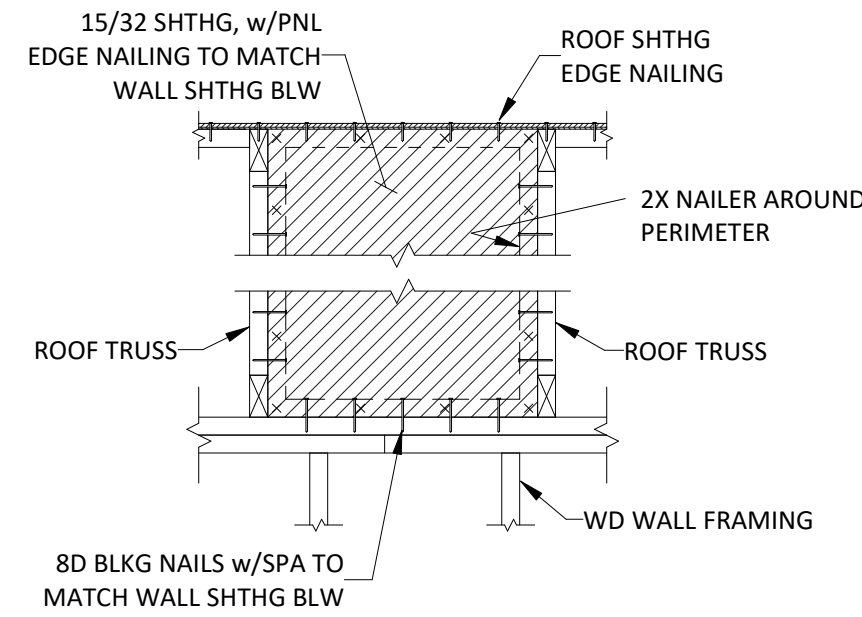


8 TYPICAL SHEAR BLOCKING BETWEEN TRUSSES
SCALE: NONE

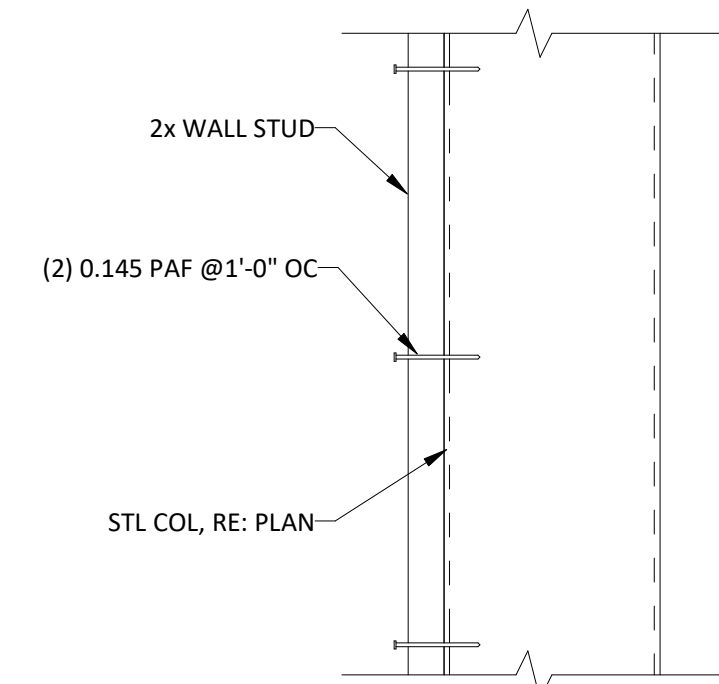

9 TYPICAL SHEARWALL TERMINATION AT STEEL COLUMN DETAIL
SCALE: NONE

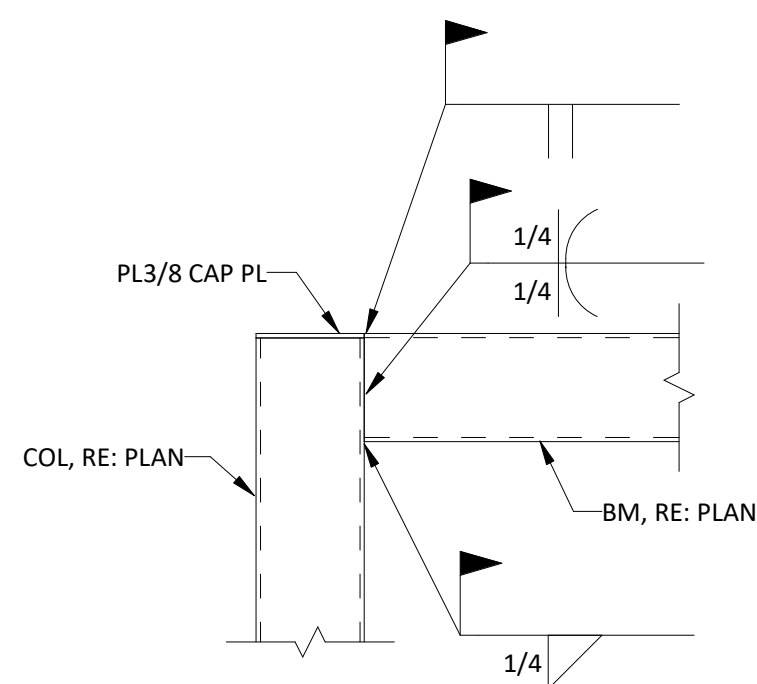

10 TYPICAL TUBE COLUMN TO BEAM CONNECTION
SCALE: NONE

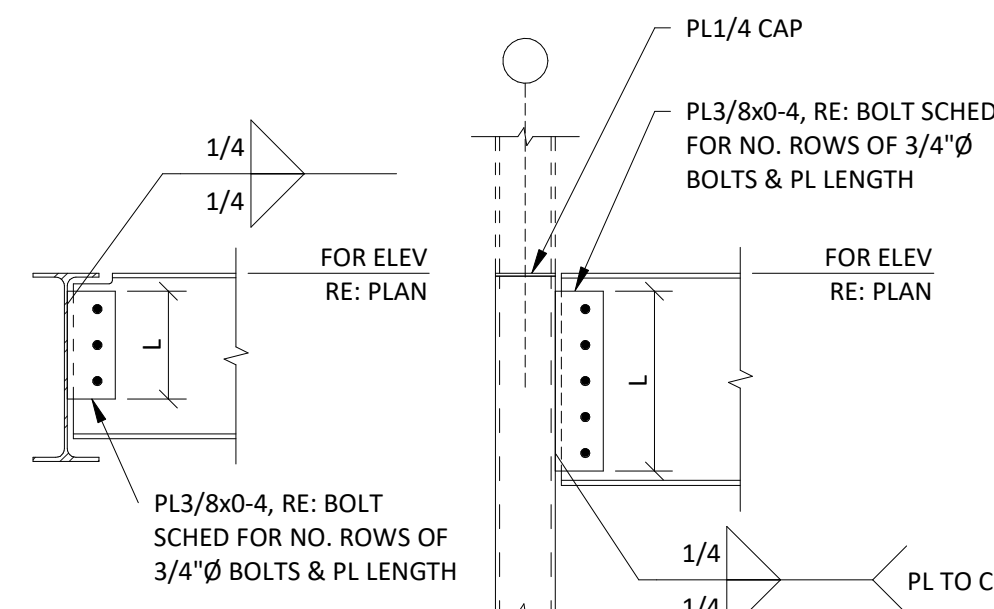

TYPICAL BM TO BM CONN

TYPICAL BM TO COL CONN

11 TYPICAL WIDE FLANGE STEEL CONNECTIONS DETAIL
SCALE: NONE

BOLT SCHEDULE		
CONNECTION BEAM SIZE	LENGTH (L)	(#) ROWS OF BOLTS
W8, W10	6"	2
W12, W14	9"	3
W16	1'-0"	4
W18	1'-3"	5
W21	1'-6"	6
W24, W27	1'-9"	7
W30, W33	2'-6"	10

NOTE: BOLTS SHALL BE 3/4" Ø A325 AT 3" CENTERS, UNLESS NOTED OTHERWISE

CERTUS
STRUCTURAL ENGINEERS
900 S. Kansas Avenue; Suite 400
Topeka, Kansas 66612
Phone: (785) 291-0400
Fax: (785) 291-0401
Proj #:01190008.125
Certificate Of Authorization
E-1392
REVIT 2023 LOCAL

schwerdt design group
architecture | interiors | planning
2231 sw wanamaker rd, suite 303
topeka, kansas 66614-4275
phone: 785.213.7540
fax: 785.273.7579
500 north broadway, suite 200
oklahoma city, ok 73102
phone: 405.231.3105
fax: 405.231.3115

STATE OF MISSOURI
KEVIN S. VOLLRATH
NUMBER PE-2005011704
PROFESSIONAL ENGINEER

CORE & SHELL BUILDING FOR
STREETS OF WEST PRIOR LOT 13
LEES SUMMIT, MISSOURI






SUBMISSION DATES
12/27/2023

SHEET TITLE
FRAMING DETAILS & SECTIONS I

PROJECT NUMBER
230117

SHEET NUMBER
S-601

FILEPATH: C:\Users\grad\harris\Documents\01190008.125 - Streets of West Pryor - Lot 13_Gradster.rvt
DATE: 1/22/2024 11:43:48 AM
DRAWN BY: Author

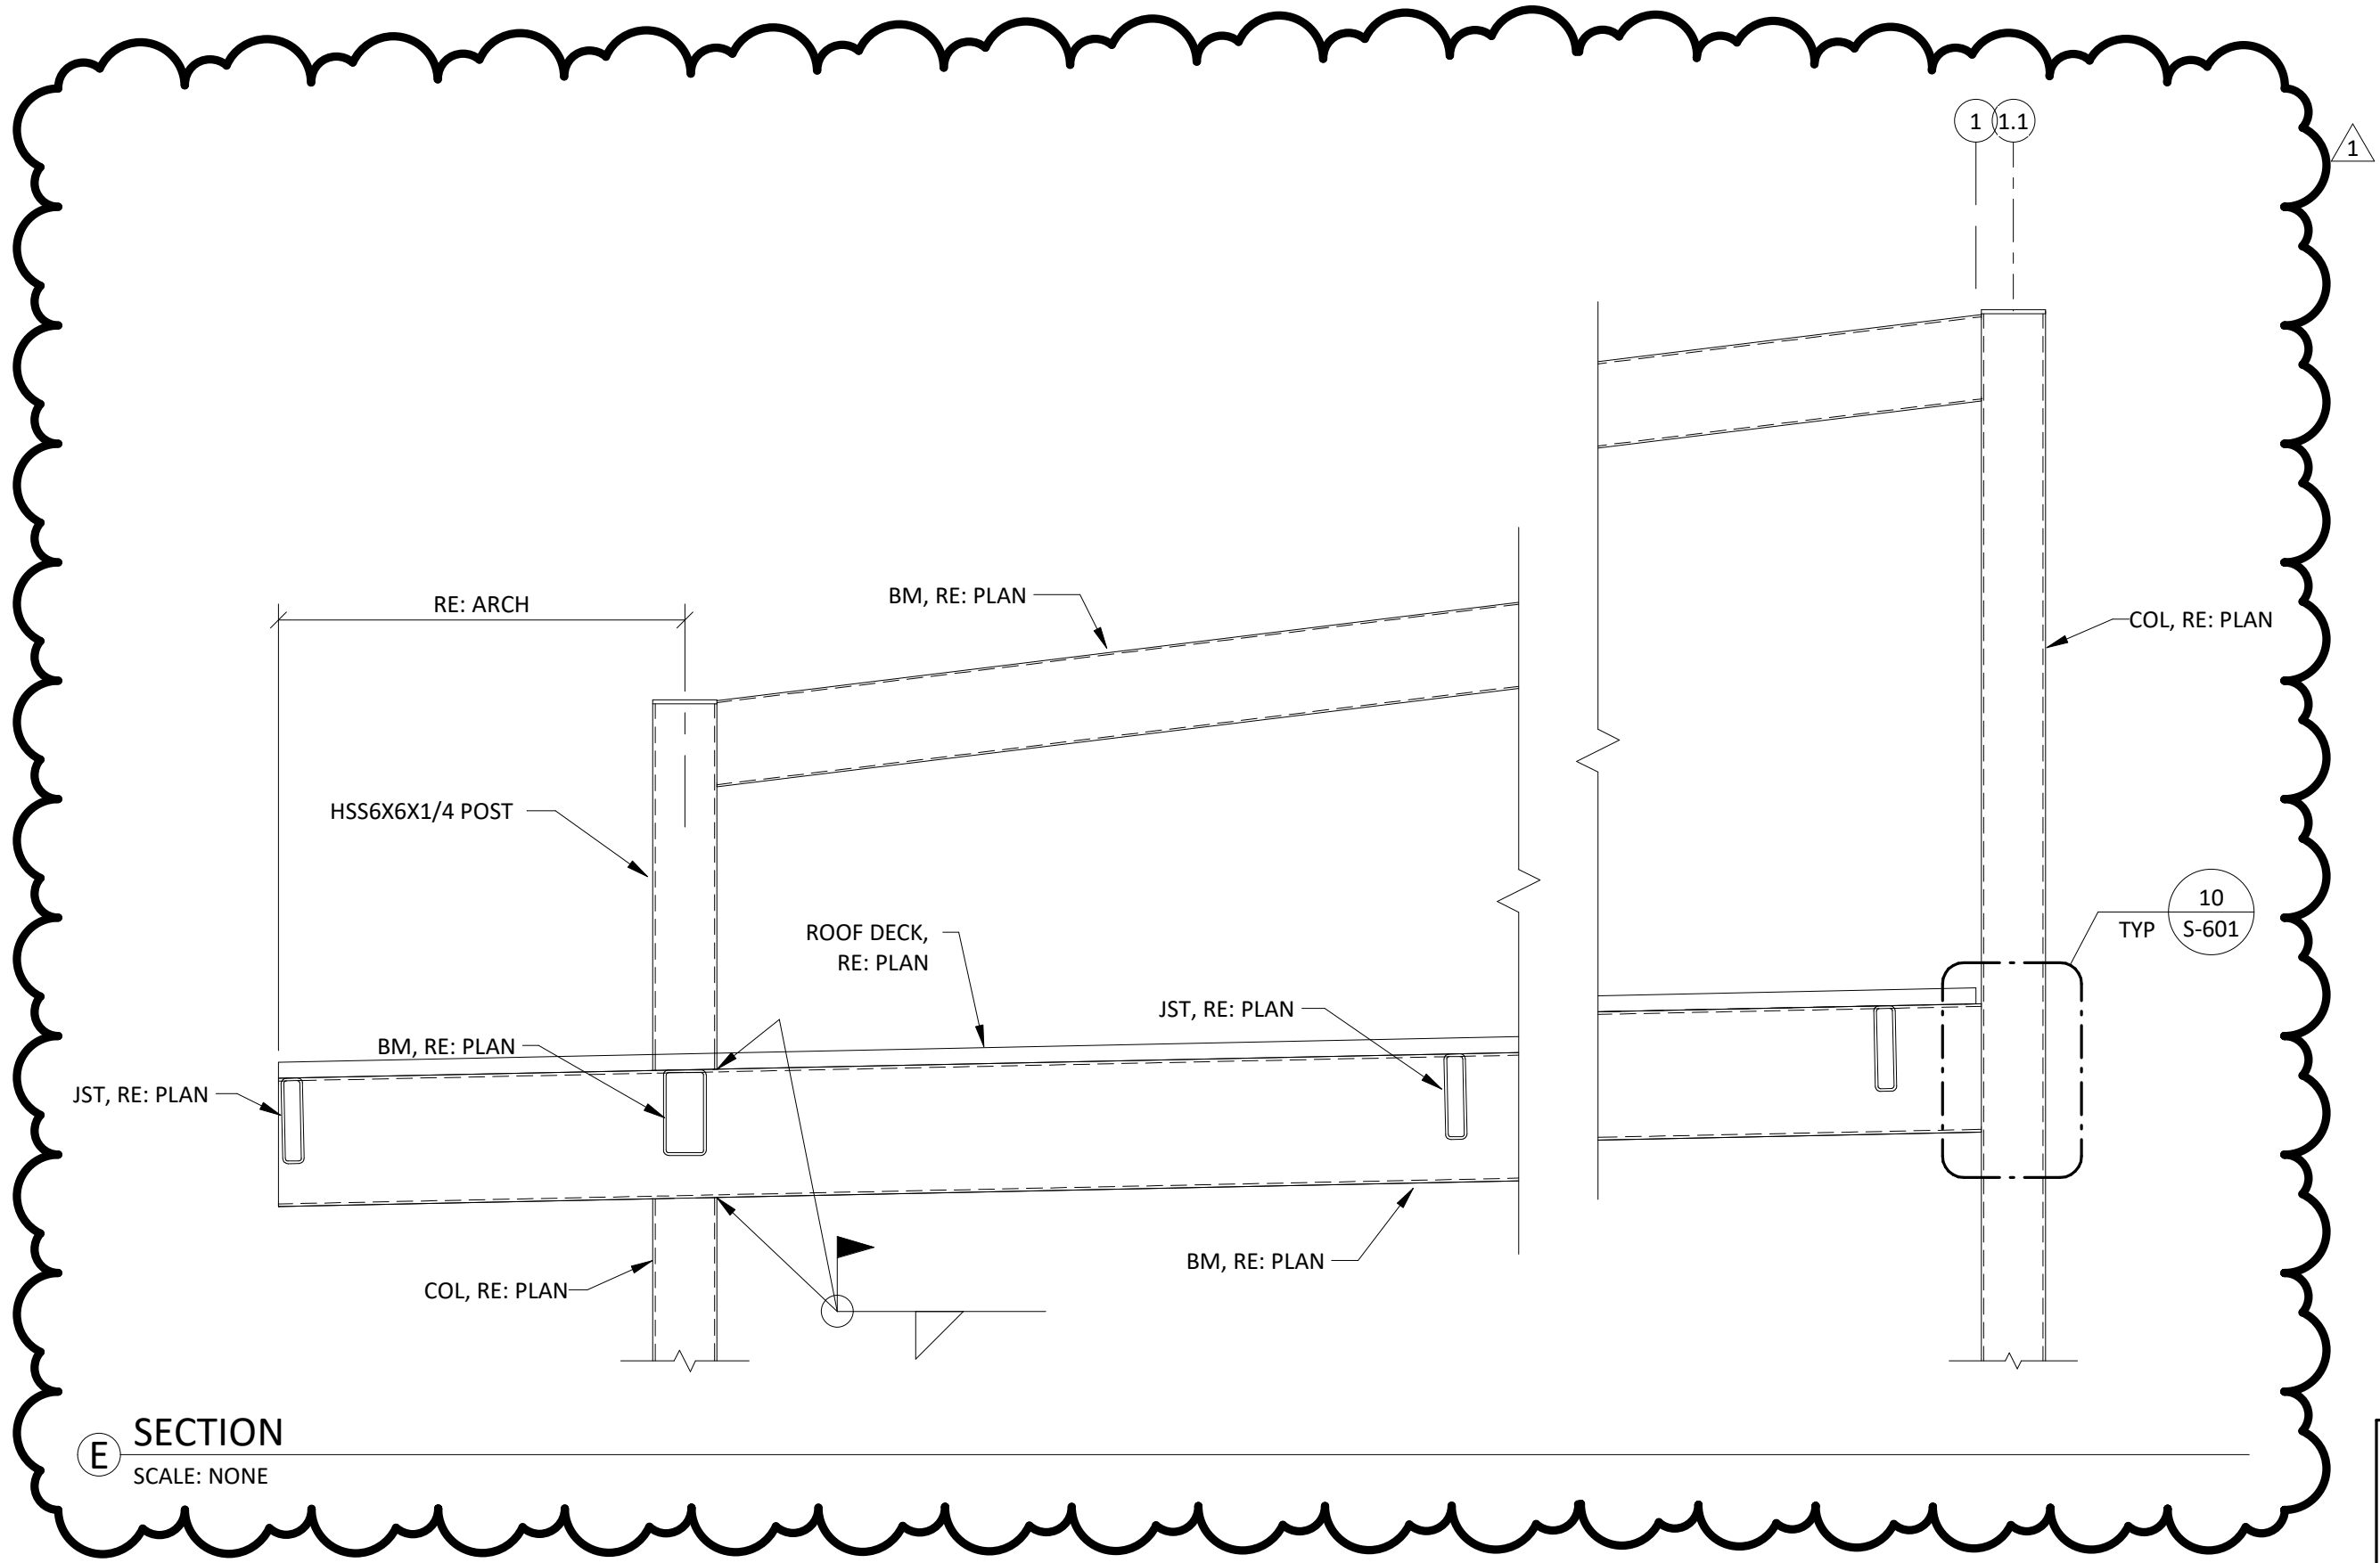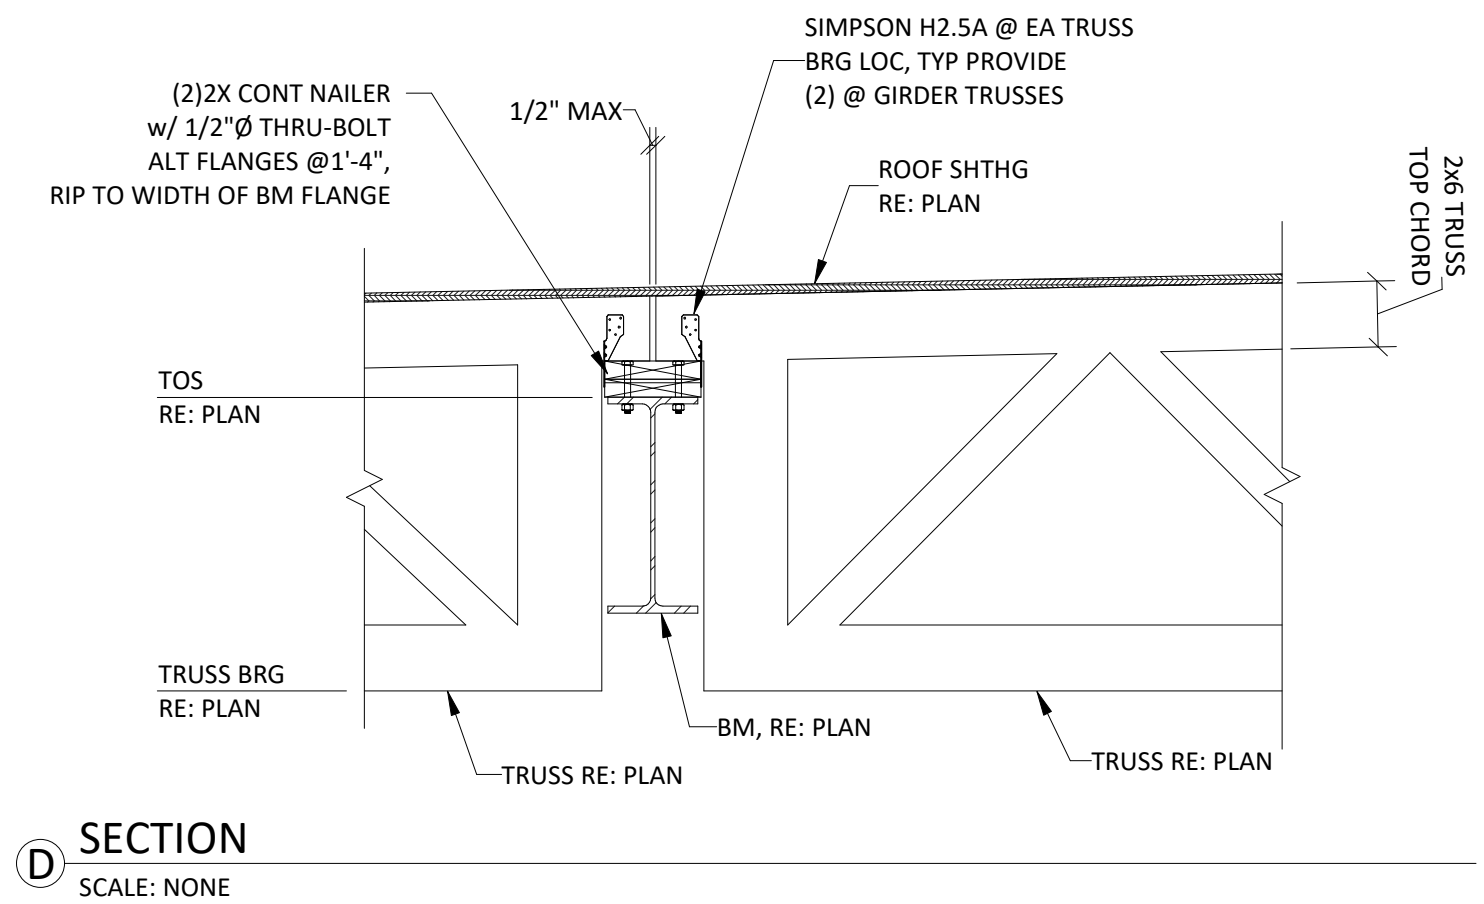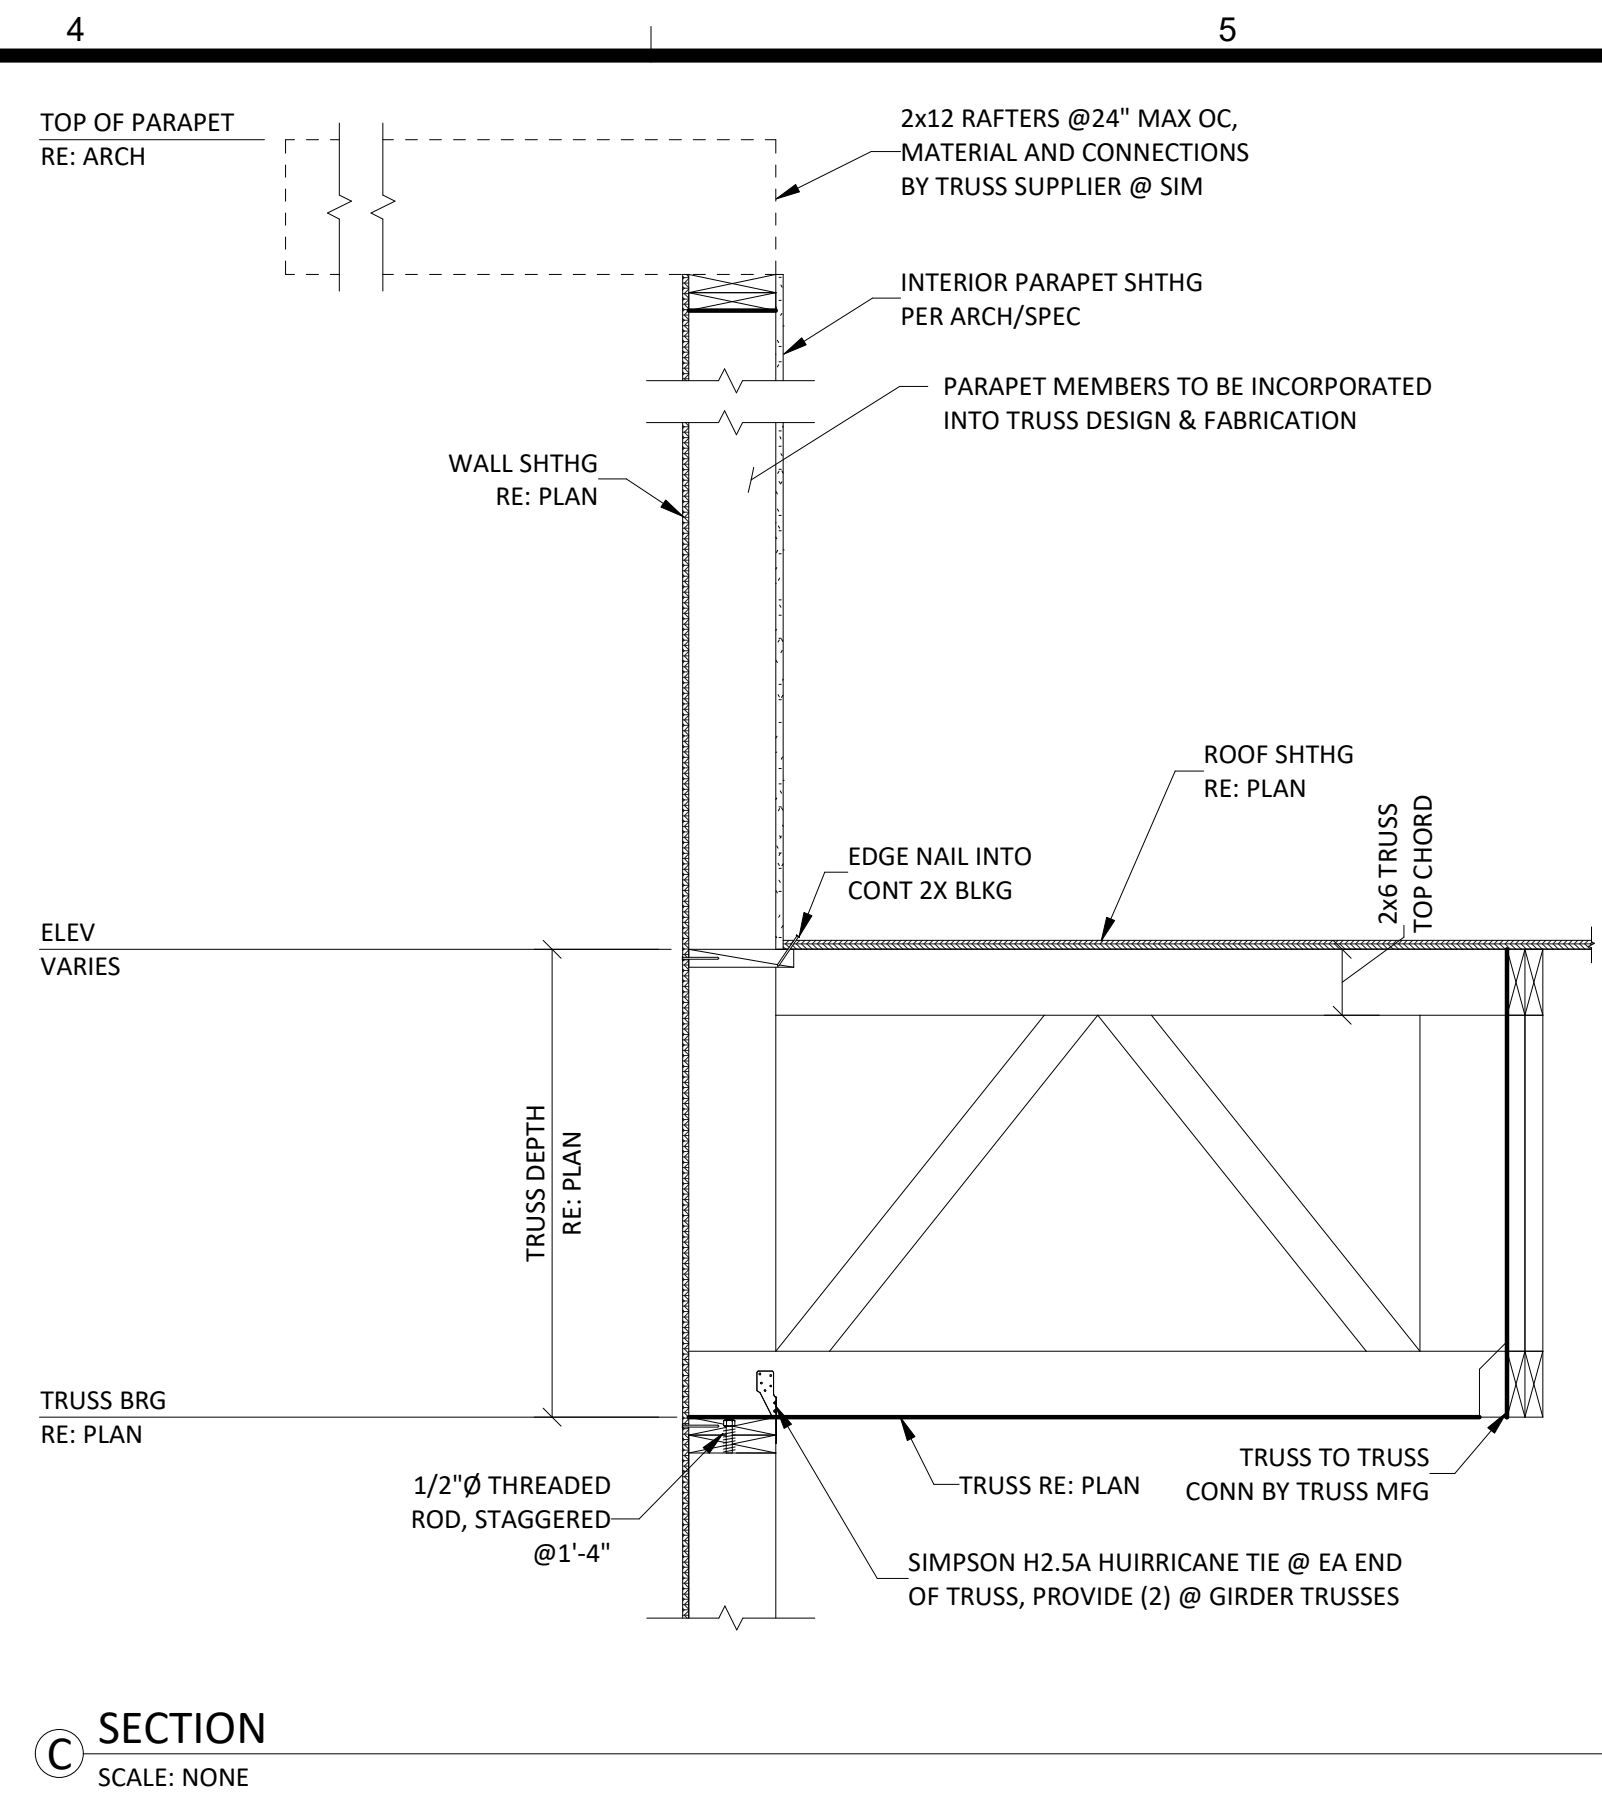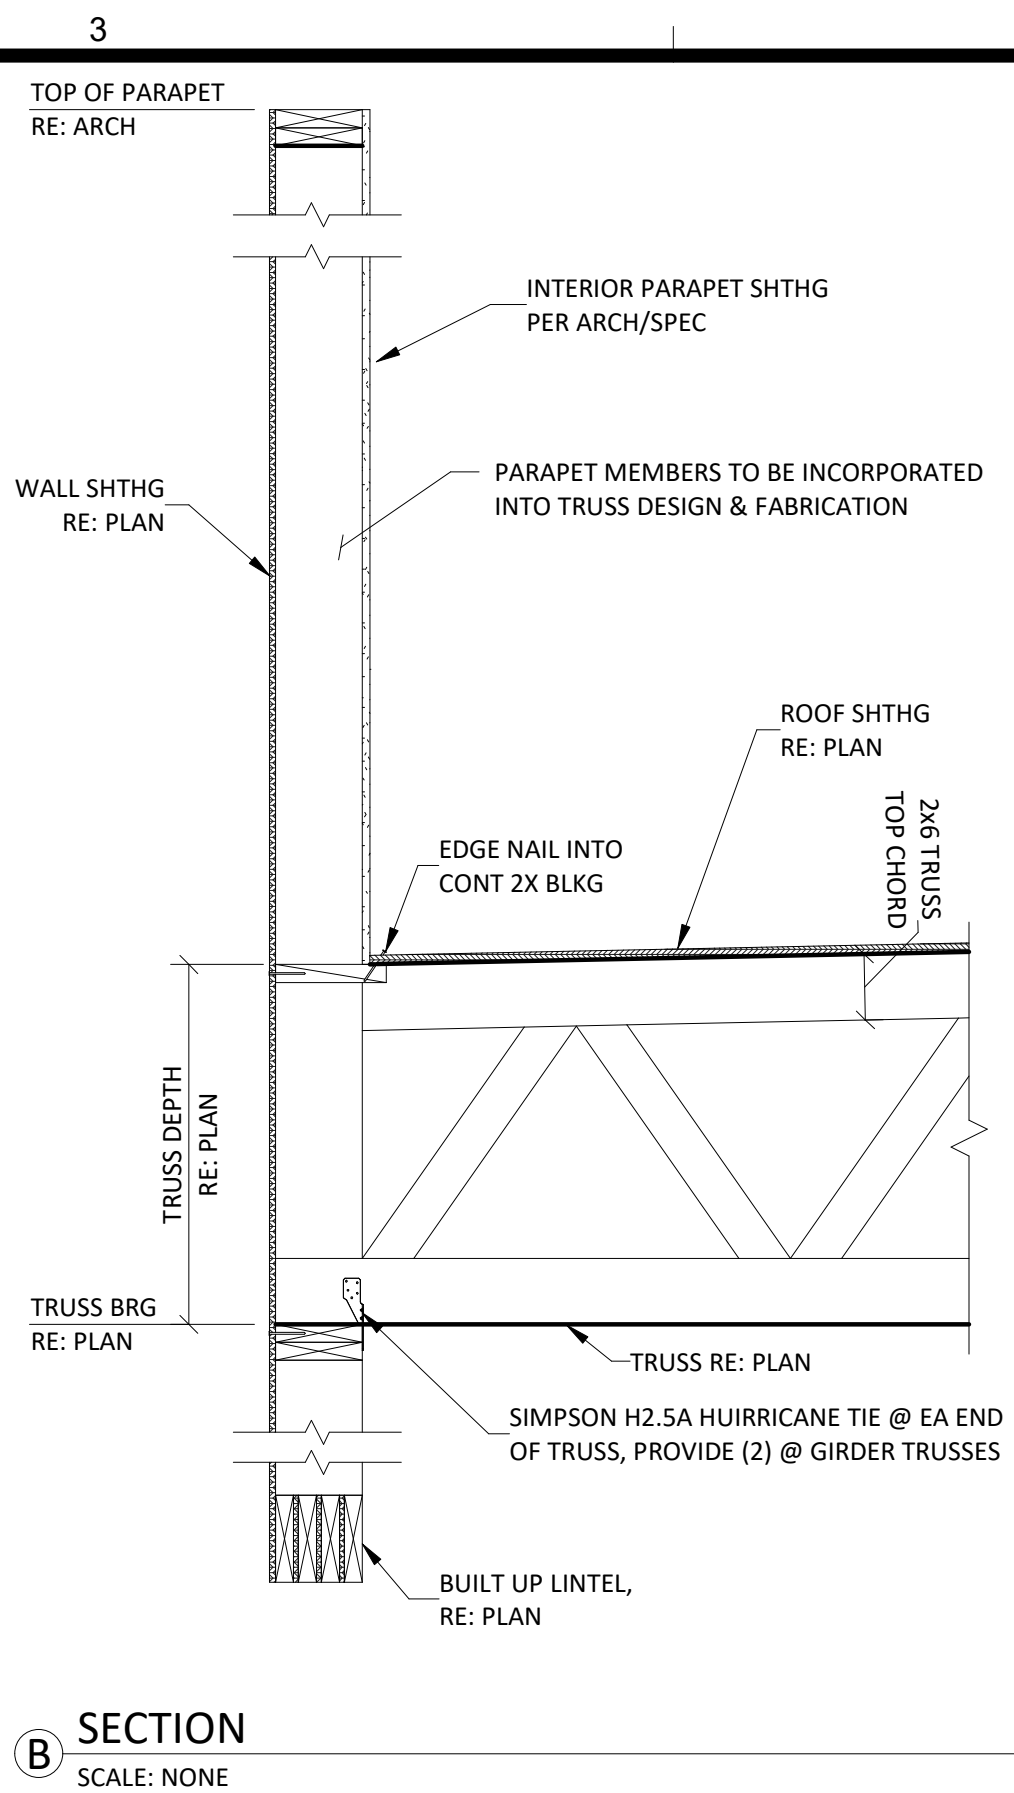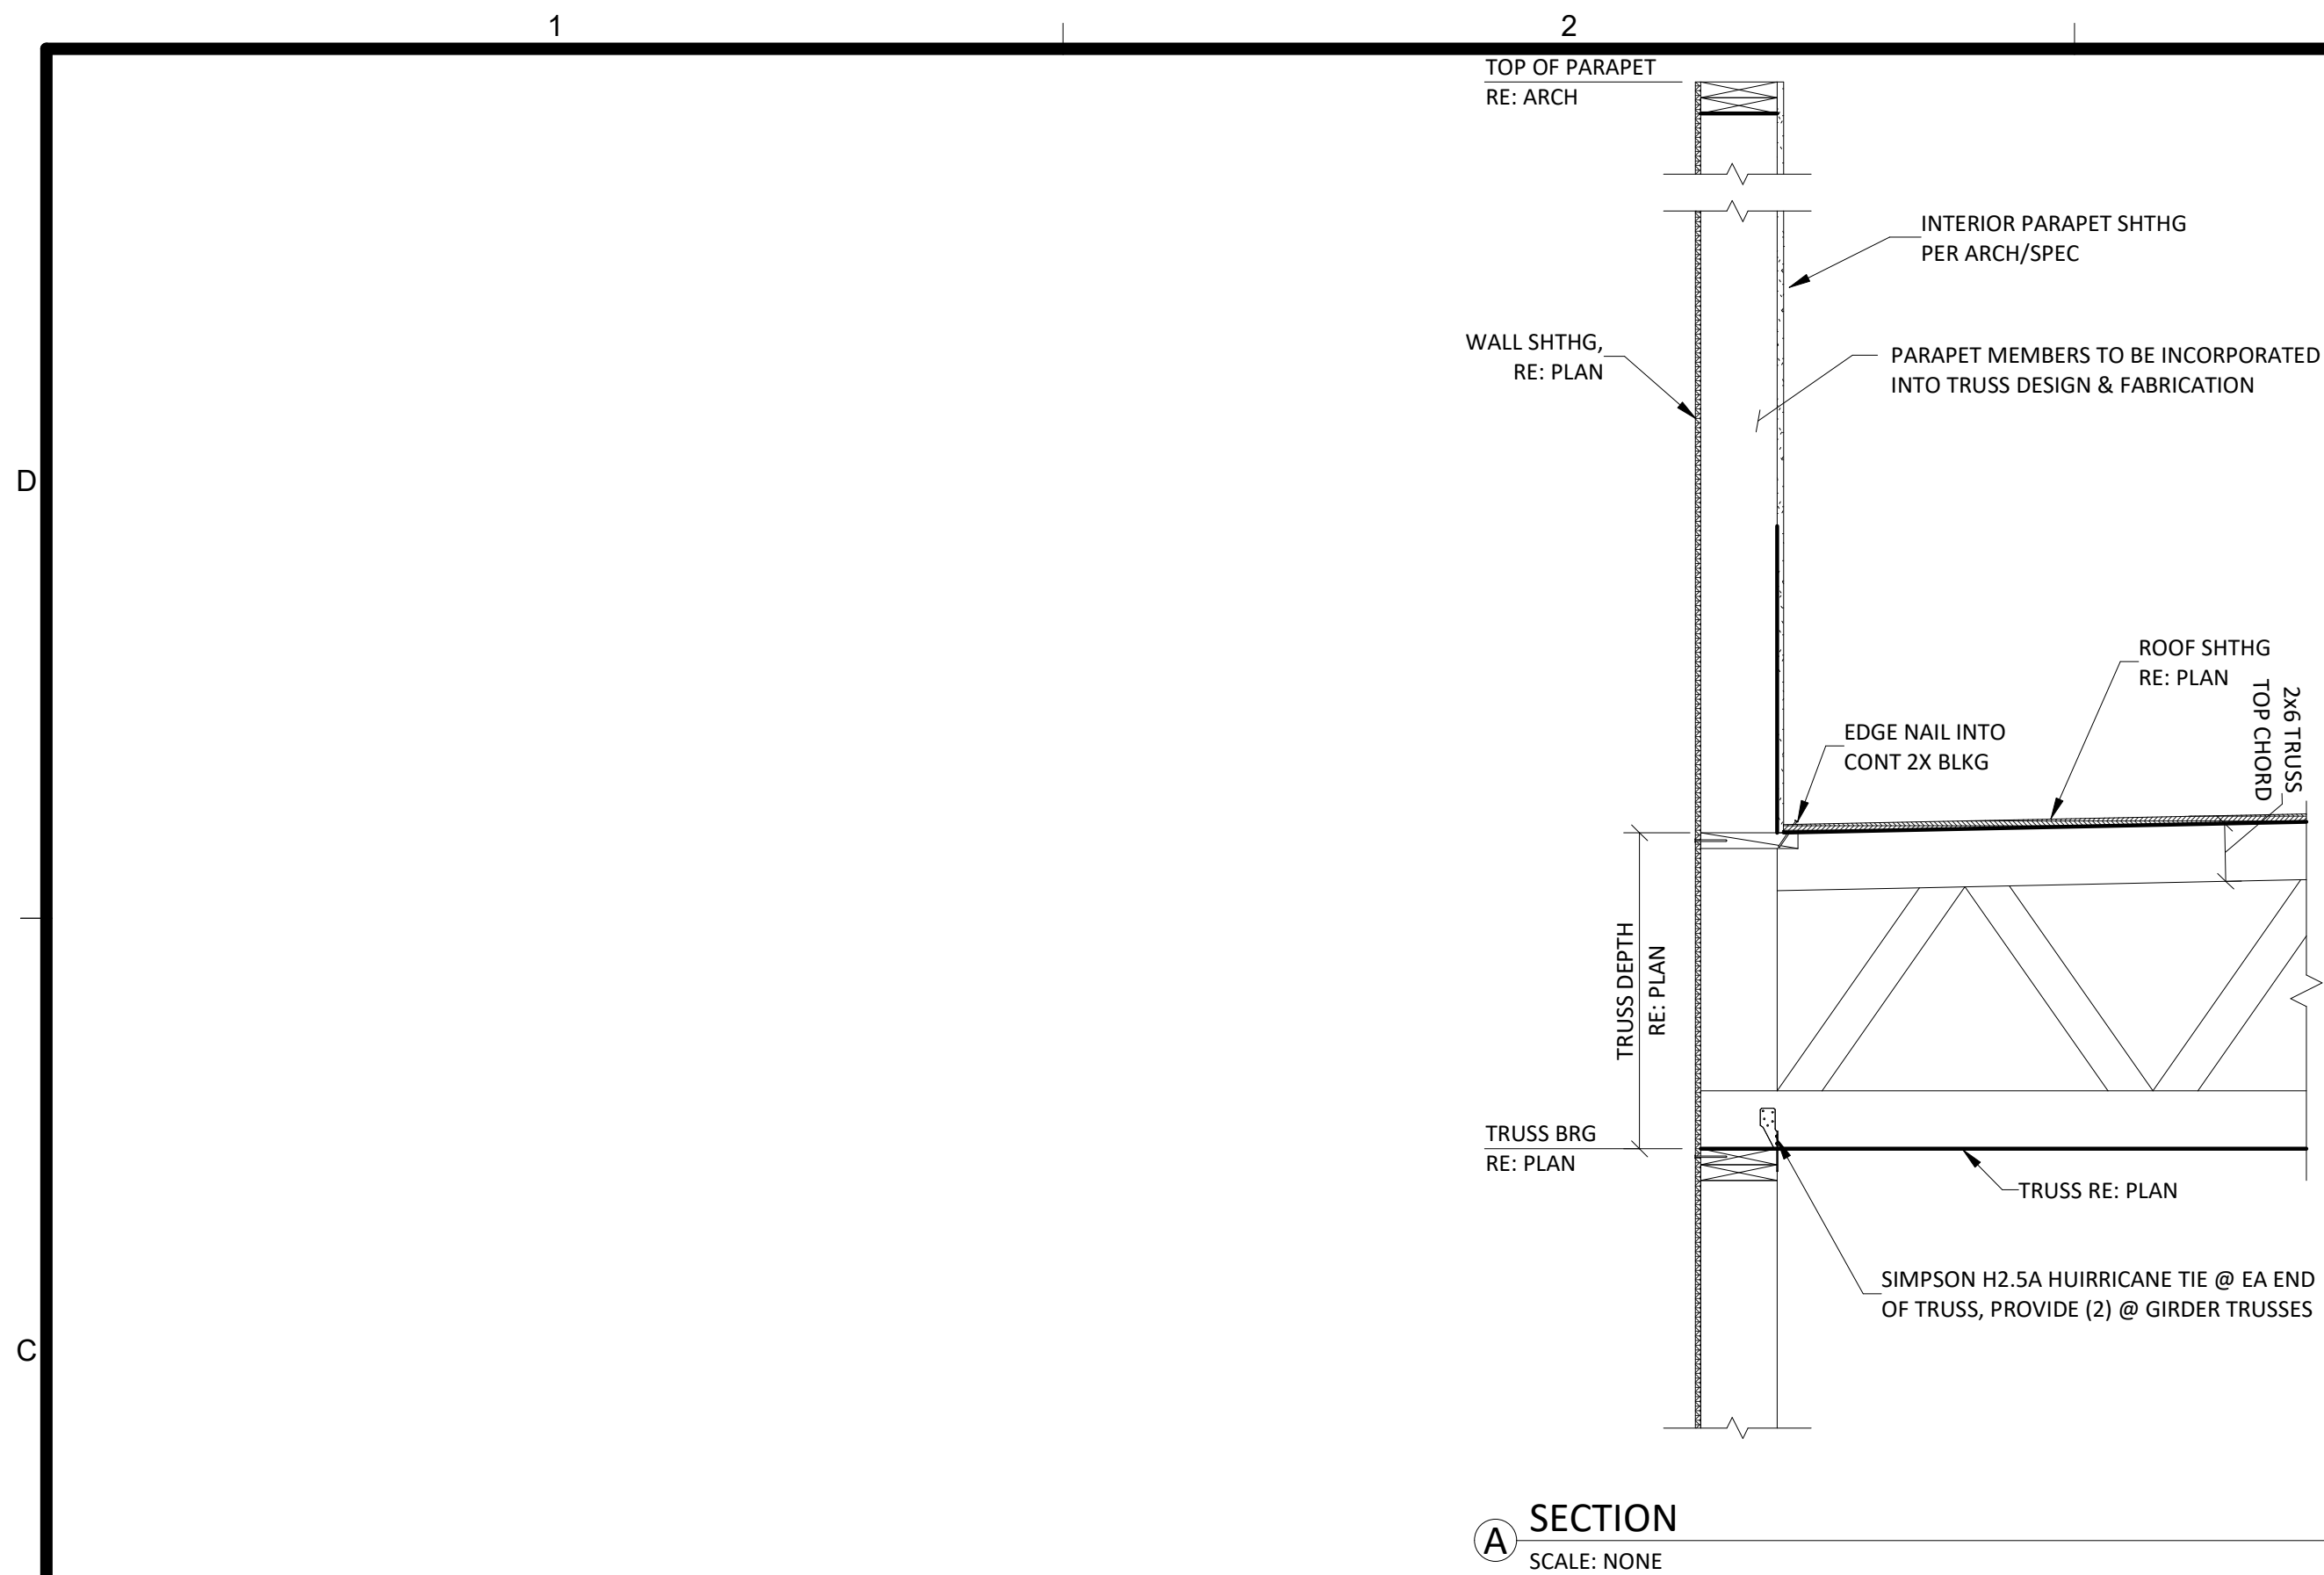

CERTUS
STRUCTURAL ENGINEERS
900 S. Kansas Avenue; Suite 400
Topeka, Kansas 66612
Phone: (785) 291-0400
Fax: (785) 291-0401
Proj #:01190008.125
Certificate Of Authorization
E-1392
REVIT 2023 LOCAL

RELEASED FOR
CONSTRUCTION
As Noted on Plans Review
Development Services Department
Lee's Summit, Missouri
01/31/2024

schwerdt design group
architecture | interiors | planning
2231 sw wanamaker rd, suite 303
topeka, kansas 66614-4275
phone: 785.233.7540
fax: 785.233.7579
500 north broadway, suite 200
oklahoma city, ok 73102
phone: 405.231.3105
fax: 405.231.3115



CORE & SHELL BUILDING FOR
STREETS OF WEST PRYOR LOT 13
LEES SUMMIT, MISSOURI


SUBMISSION DATES
12/27/2023
ADD #1 01/19/2024

SHEET TITLE
FRAMING DETAILS &
SECTIONS II

PROJECT NUMBER
230117

SHEET NUMBER
S-602

FILEPATH: C:\Users\grad\harris\Documents\01190008.125 - Streets of West Pryor - Lot 13_Gradster.rvt
DATE: 12/27/2023 11:42:13 AM
DRAWN BY: Author

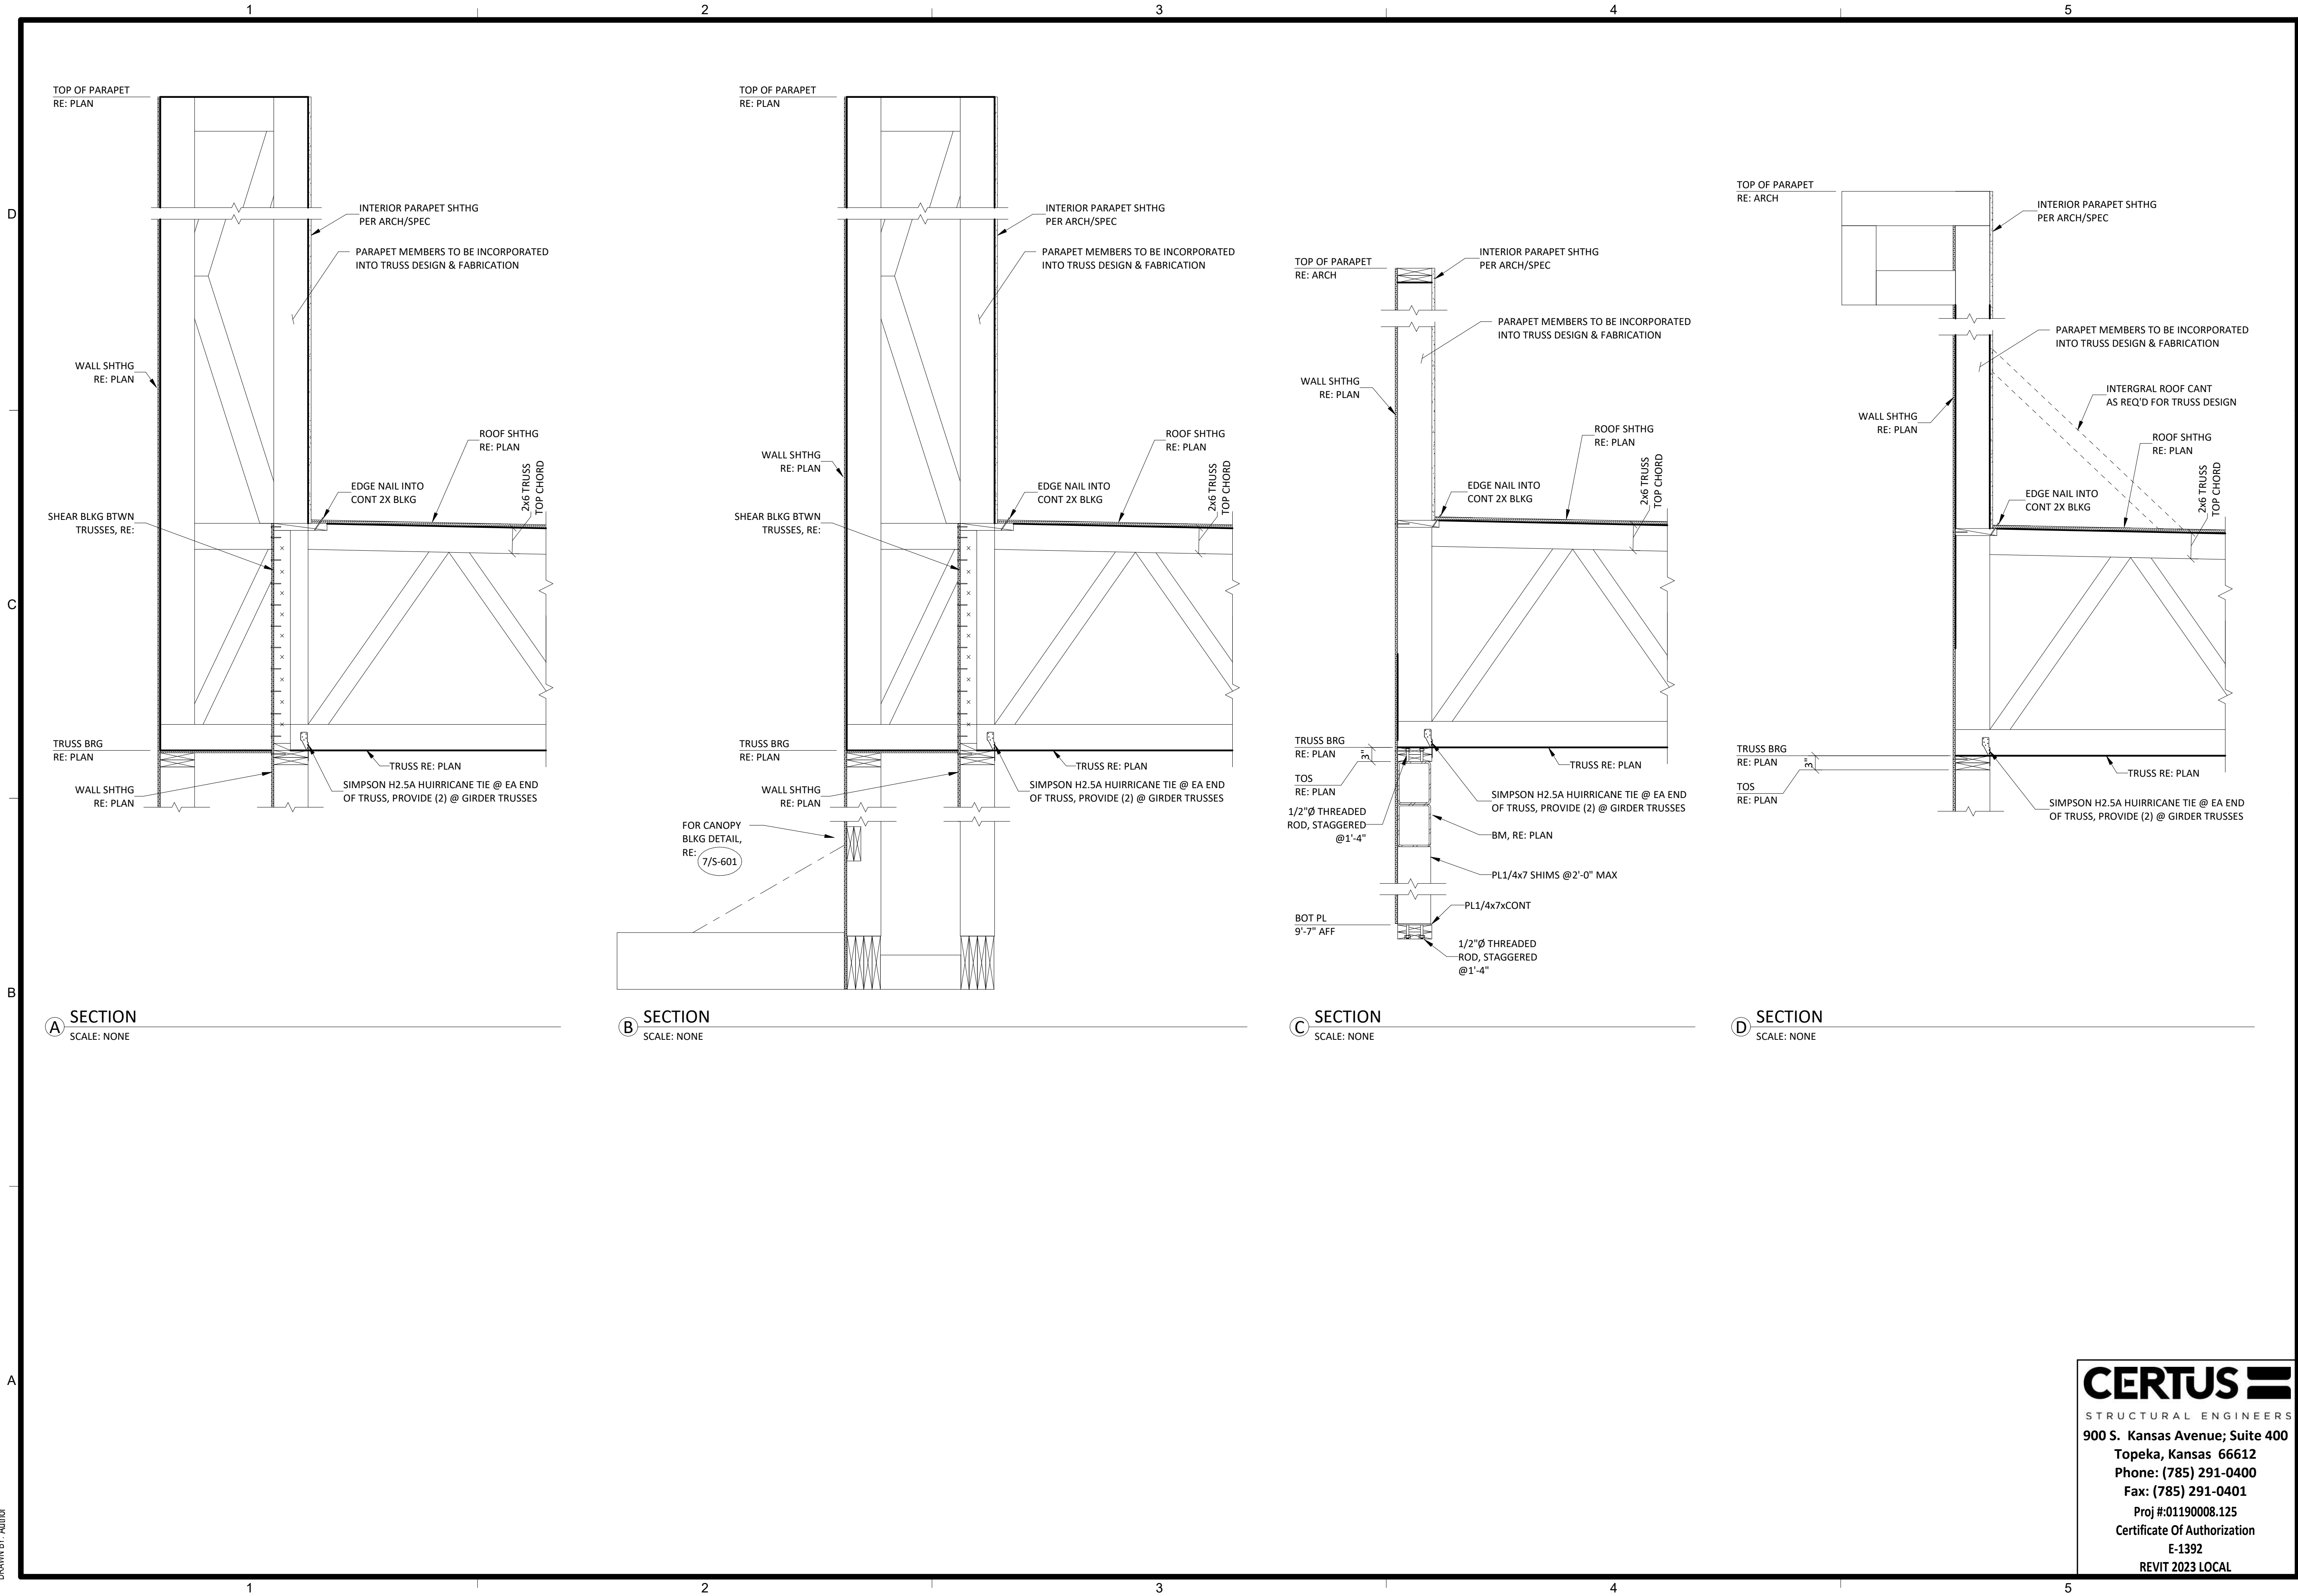

CORE & SHELL BUILDING FOR
STREETS OF WEST PRYOR LOT 13
LEES SUMMIT, MISSOURI

SUBMISSION DATES
12/27/2023

SHEET TITLE
FRAMING DETAILS & SECTIONS III

PROJECT NUMBER
230117

SHEET NUMBER
S-603



schwerdt design group

architecture|interiors|planning

2231 sw wanamaker rd suite 303
topeka, kansas 66614-4275
phone: 785.273.7540
fax: 785.273.7579

500 north broadway suite 200
oklahoma city, ok 73102
phone: 405.231.3105
fax: 405.231.3115



Bryan Leinwetter - Engineer
MOR PE-2020020297

**CORE & SHELL BUILDING
STREETS OF WEST PRYOR LOT 13
LEES SUMMIT, MISSOURI**

SUBMISSION DATES

DECEMBER 27, 2023

SHEET TITLE
PLUMBING PLAN

PROJECT NUMBER
235008

SHEET NUMBER
M-101



PEARSON KENT MCKINLEY RAAF ENGINEERS LLC
2949 SW WANAMAKER DR., TOPEKA, KANSAS 66614
785.273.2447 WWW.PKMRENG.COM

23.293

**GAS PIPE LOAD AND SIZING
TENANT A**

TOTAL RTU GAS LOAD = 540 MBH
TOTAL LENGTH OF GAS PIPING = 130 FEET
GAS PIPING MAIN SIZE = 3"

**GAS PIPE LOAD AND SIZING
TENANT B**


TOTAL RTU GAS LOAD = 200 MBH
TOTAL LENGTH OF GAS PIPING = 100 FEET
GAS PIPING MAIN SIZE = 1-1/2"

**GAS PIPE LOAD AND SIZING
TENANT C**

TOTAL RTU GAS LOAD = 160 MBH
TOTAL LENGTH OF GAS PIPING = 120 FEET
GAS PIPING MAIN SIZE = 1-1/2"

**GAS PIPE LOAD AND SIZING
TENANT D**

TOTAL RTU GAS LOAD = 200 MBH
TOTAL LENGTH OF GAS PIPING = 150 FEET
GAS PIPING MAIN SIZE = 1-1/2"

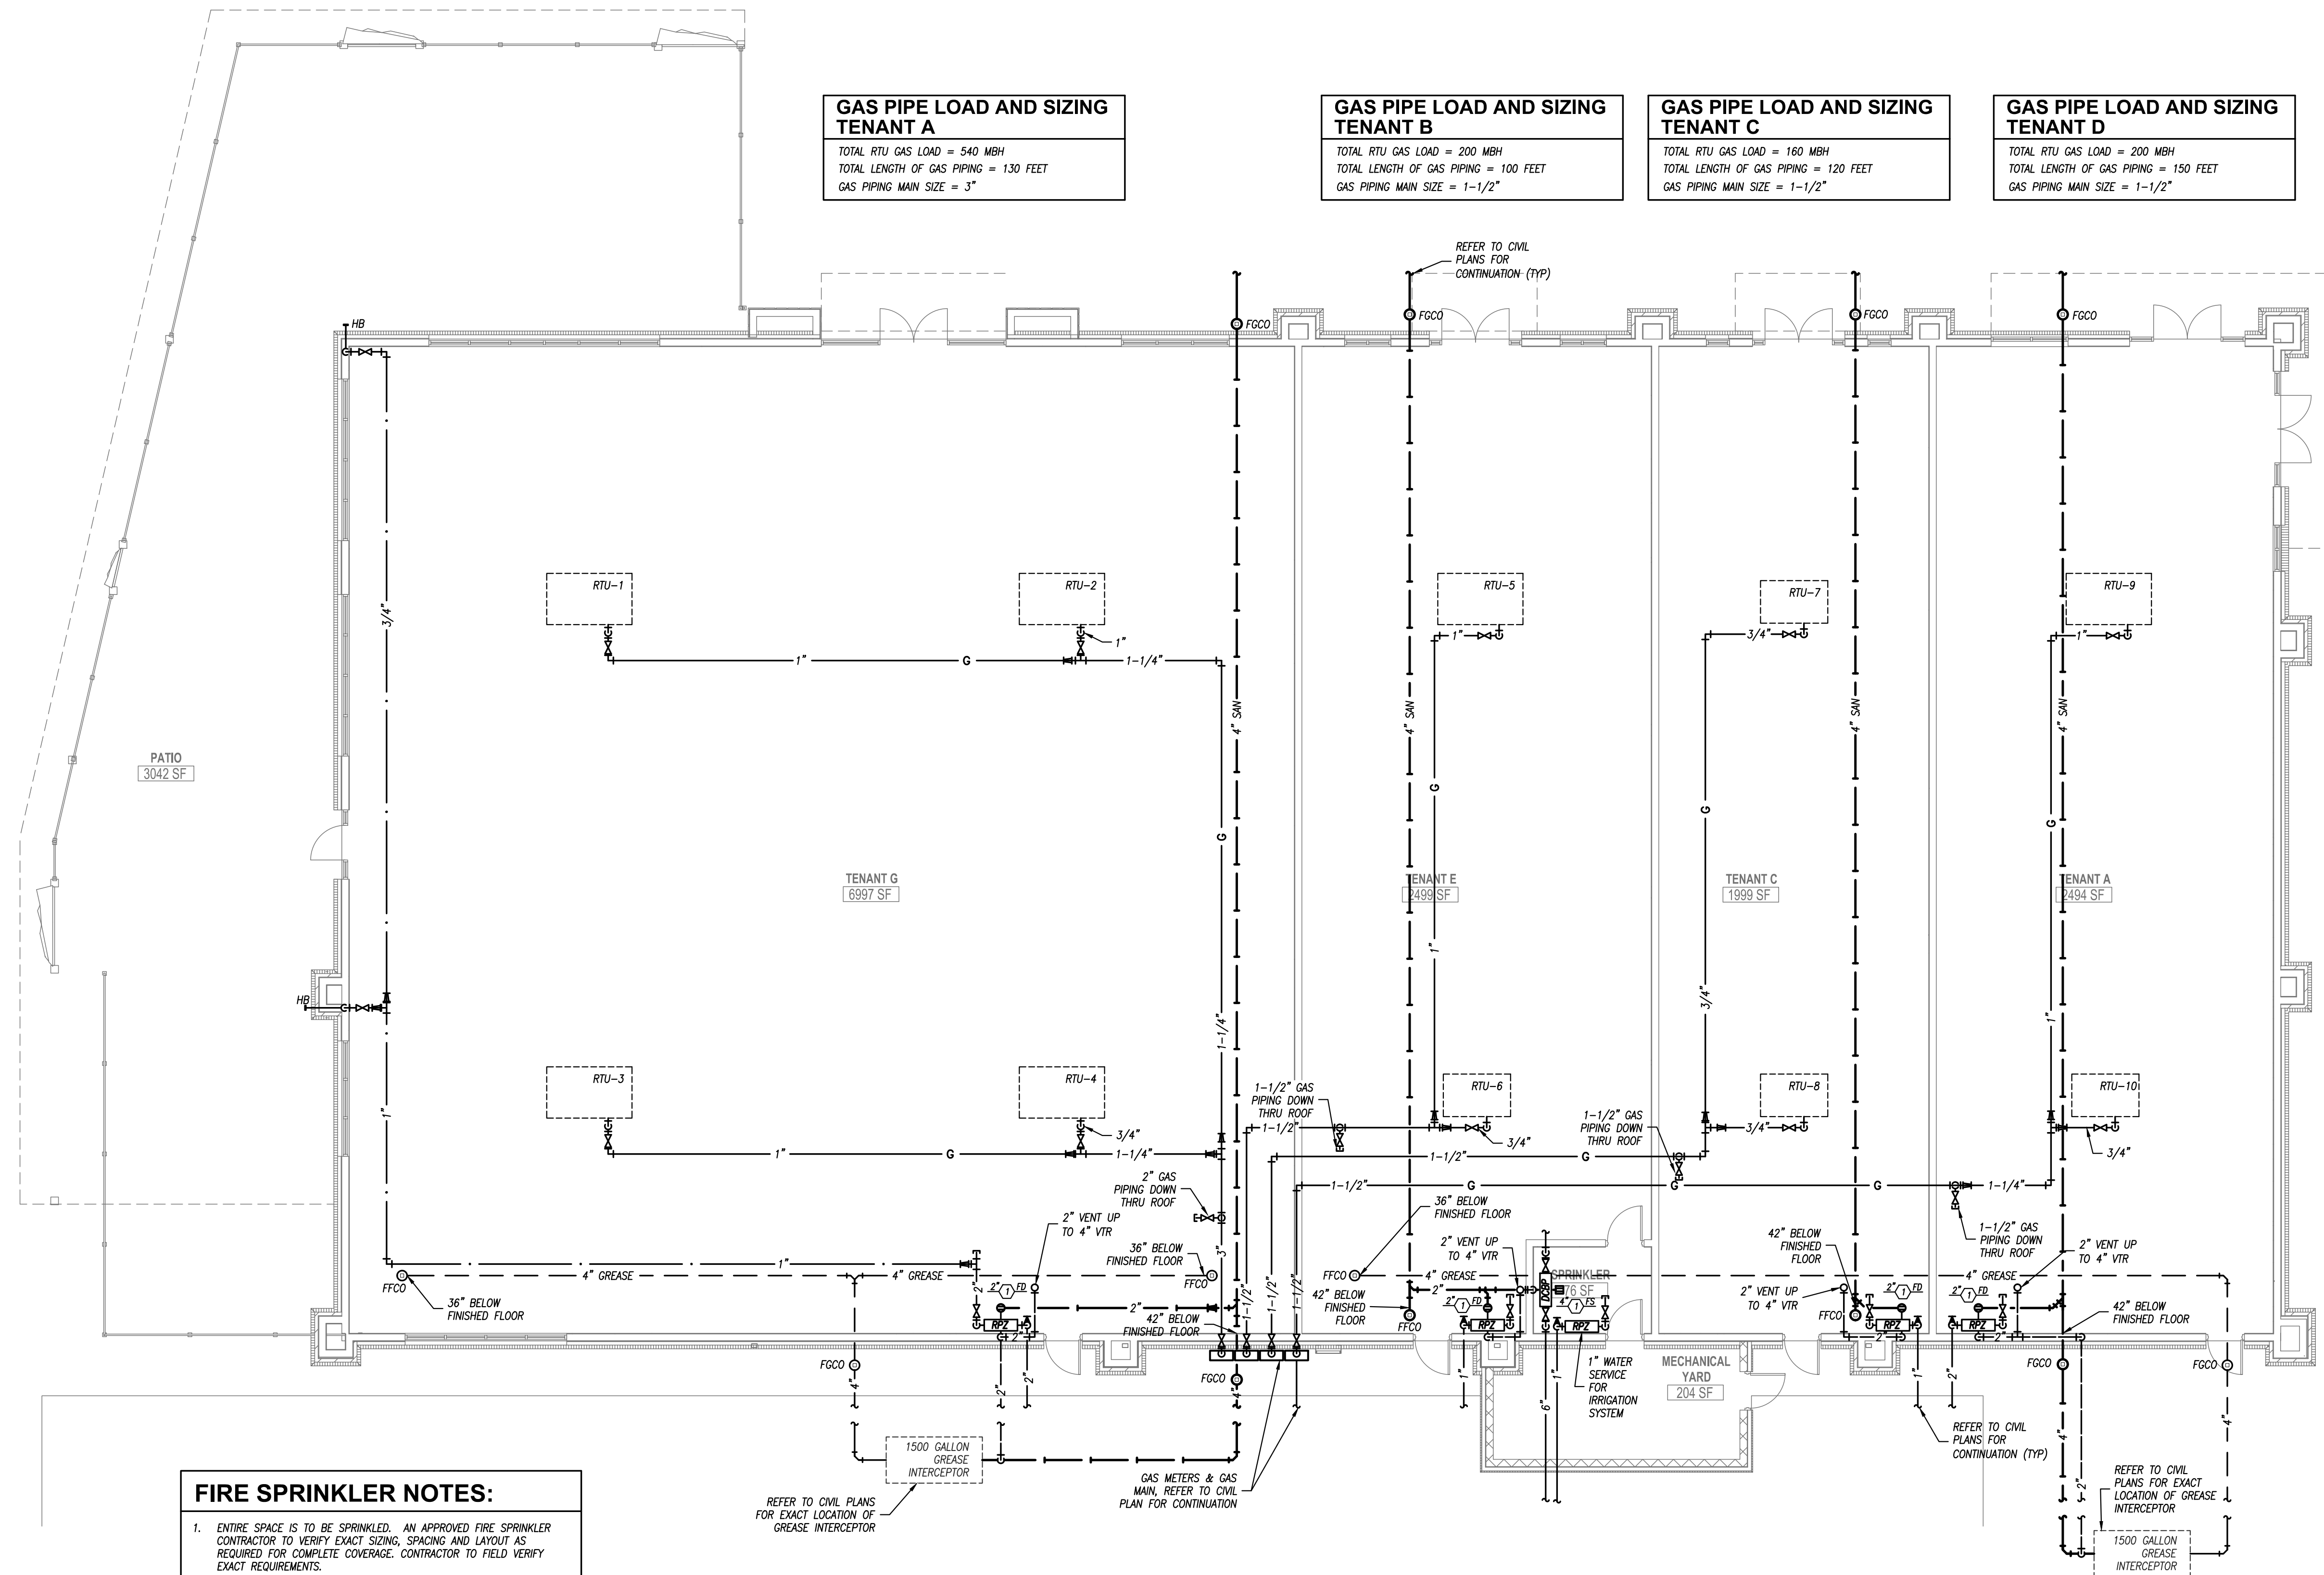


FIRE SPRINKLER NOTES:

- ENTIRE SPACE IS TO BE SPRINKLED. AN APPROVED FIRE SPRINKLER CONTRACTOR TO VERIFY EXACT SIZING, SPACING AND LAYOUT AS REQUIRED FOR COMPLETE COVERAGE. CONTRACTOR TO FIELD VERIFY EXACT REQUIREMENTS.
- THE FIRE SPRINKLER SYSTEM MUST BE INSTALLED AND COMPLY WITH NFPA, LATEST EDITION, THE LIFE SAFETY CODE, AND THE INTERNATIONAL FIRE CODE.
- SUBMIT PLANS AND SUBMITTALS TO THE FIRE MARSHAL. THE SYSTEM SHALL BE INSPECTED FOR COMPLIANCE BY THE FIRE INSPECTOR.



FLOOR PLAN - PLUMBING

1/8" = 1'-0"

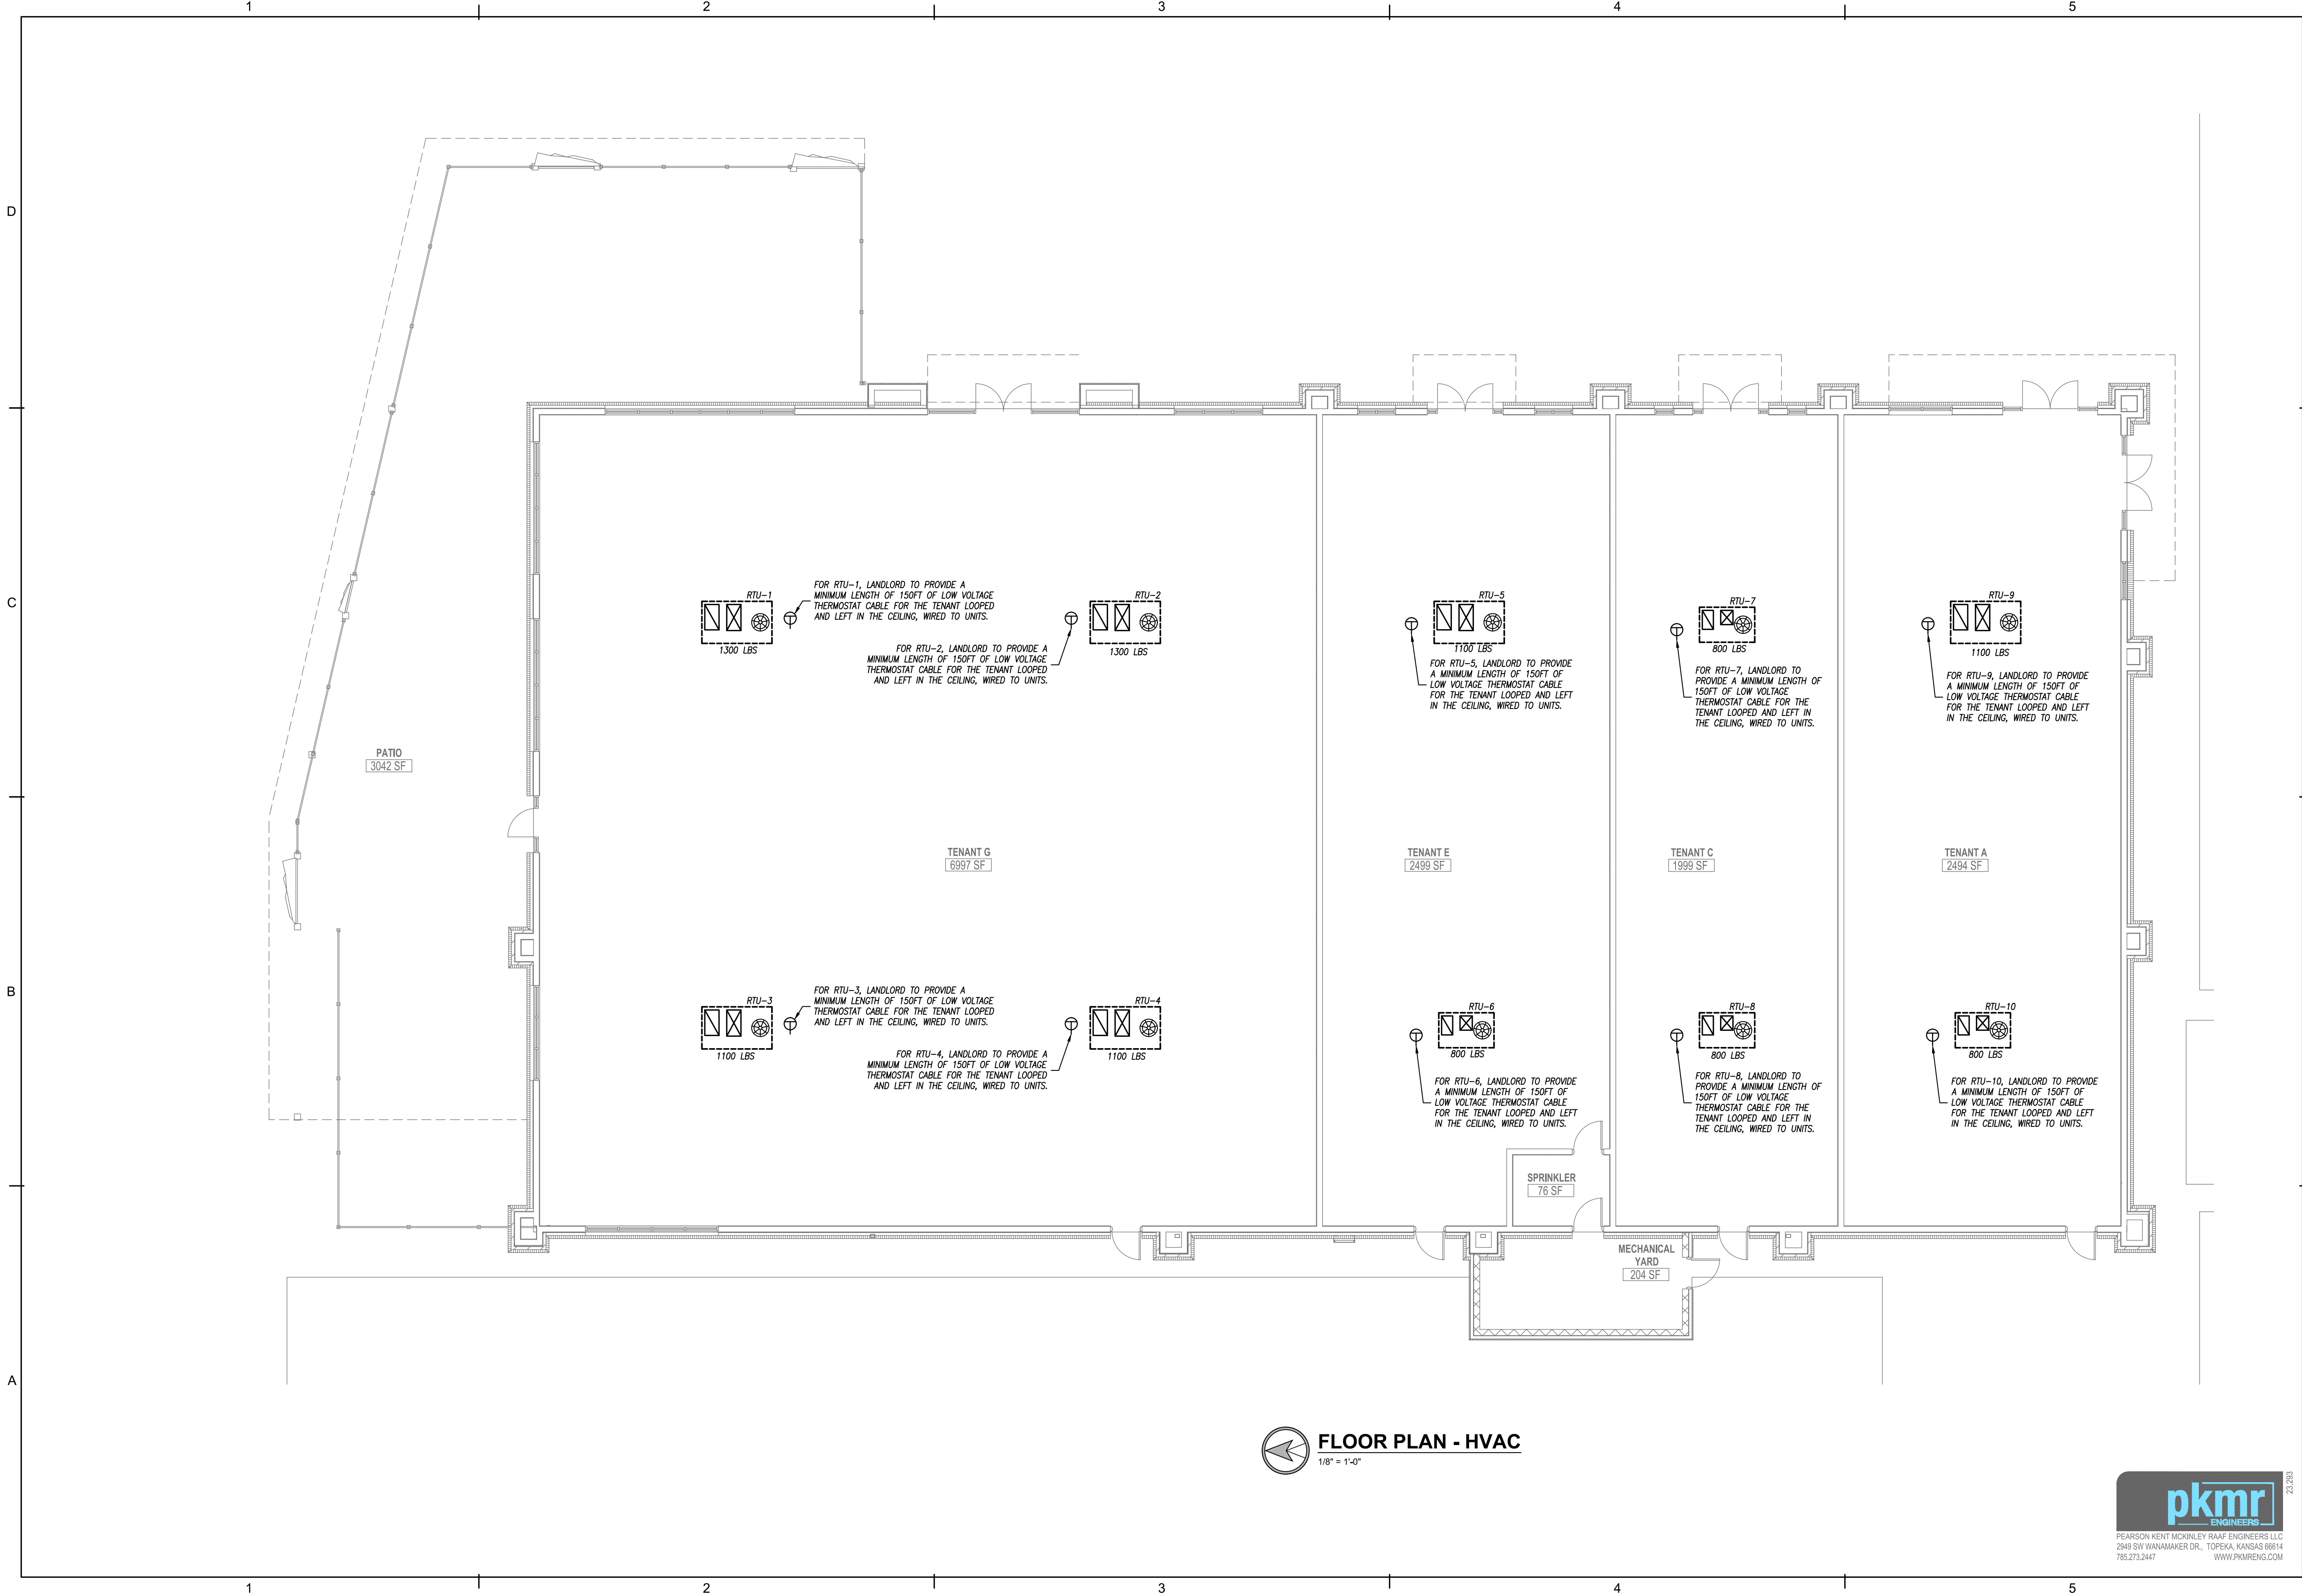

RELEASED FOR
CONSTRUCTION
As Noted on Plans Review
Development Services Department
Lee's Summit, Missouri
01/31/2024

schwerdt design group
architecture|interiors|planning
2231 sw wanamaker rd suite 303
topeka, kansas 66614-4275
phone: 785.273.7540
fax: 785.273.7579
500 north broadway suite 200
oklahoma city, ok 73102
phone: 405.231.3105
fax: 405.231.3115

BRYAN
LEINWETTER
NUMBER
PE-2020020297

Bryan Leinwetter - Engineer
MOR PE-2020020297

CORE & SHELL BUILDING
STREETS OF WEST PRYOR LOT 13
LEES SUMMIT, MISSOURI

SUBMISSION DATES DECEMBER 27, 2023
SHEET TITLE HVAC PLAN
PROJECT NUMBER 235008
SHEET NUMBER M-201



schwerdt design group

architecture|interiors|planning
2231 sw wanamaker rd suite 303
topeka, kansas 66614-4275
phone: 785.273.7540
fax: 785.273.7579

500 north broadway suite 200
oklahoma city, ok 73102
phone: 405.231.3105
fax: 405.231.3115



Bryan Leinwetter - Engineer
MO# PE-2020020297


CORE & SHELL BUILDING
STREETS OF WEST PRYOR LOT 13
LEES SUMMIT, MISSOURI

SUBMISSION DATES
DECEMBER 27, 2023
JANUARY 19, 2024


SHEET TITLE
MECHANICAL DETAILS
& SCHEDULES

PROJECT NUMBER
235008


SHEET NUMBER
M-301

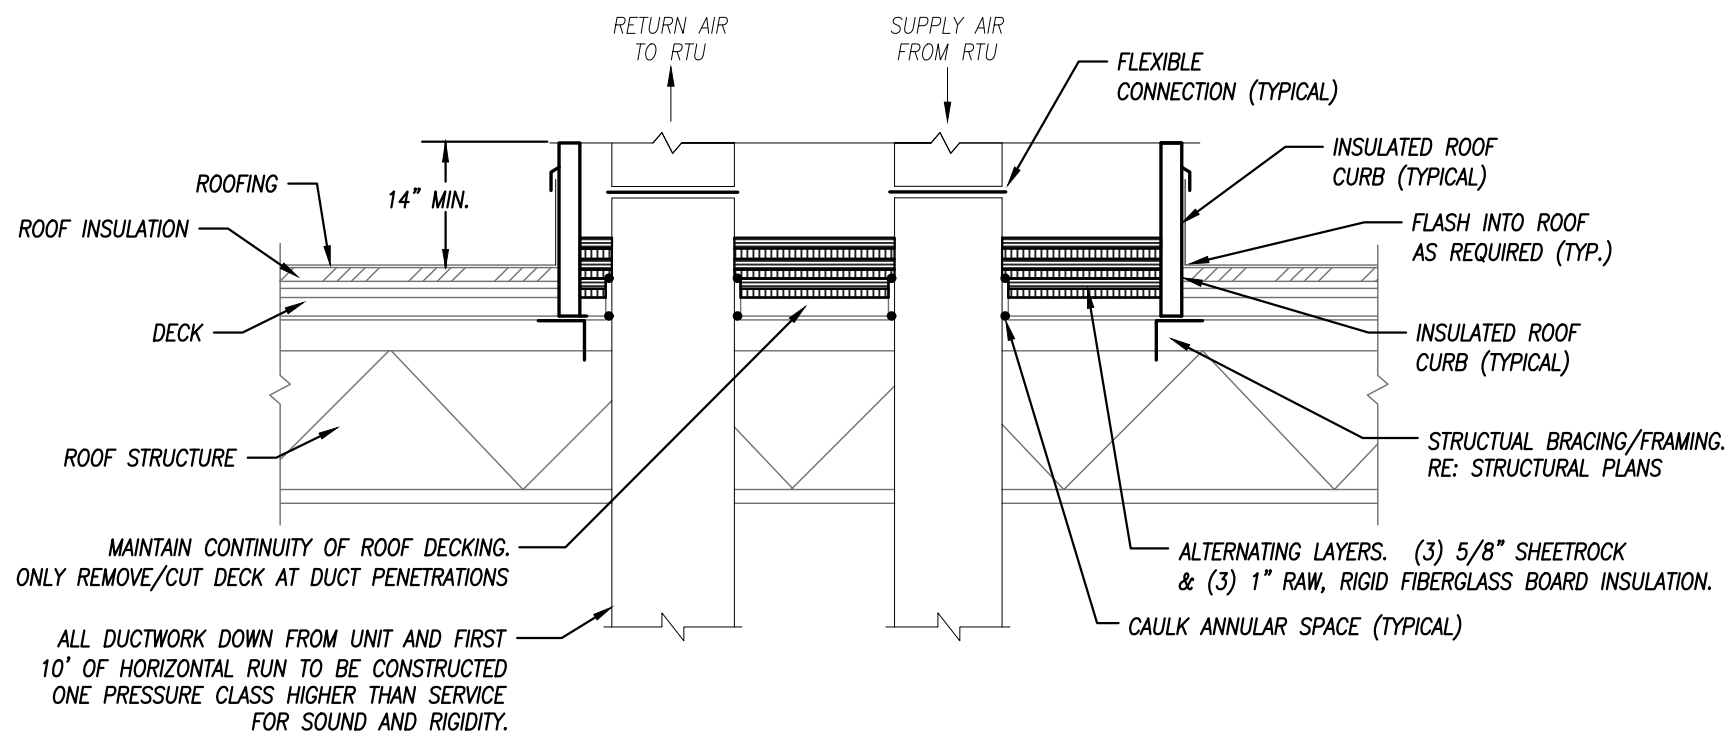


ROOFTOP UNIT CURB DETAIL
NOT TO SCALE 561-01

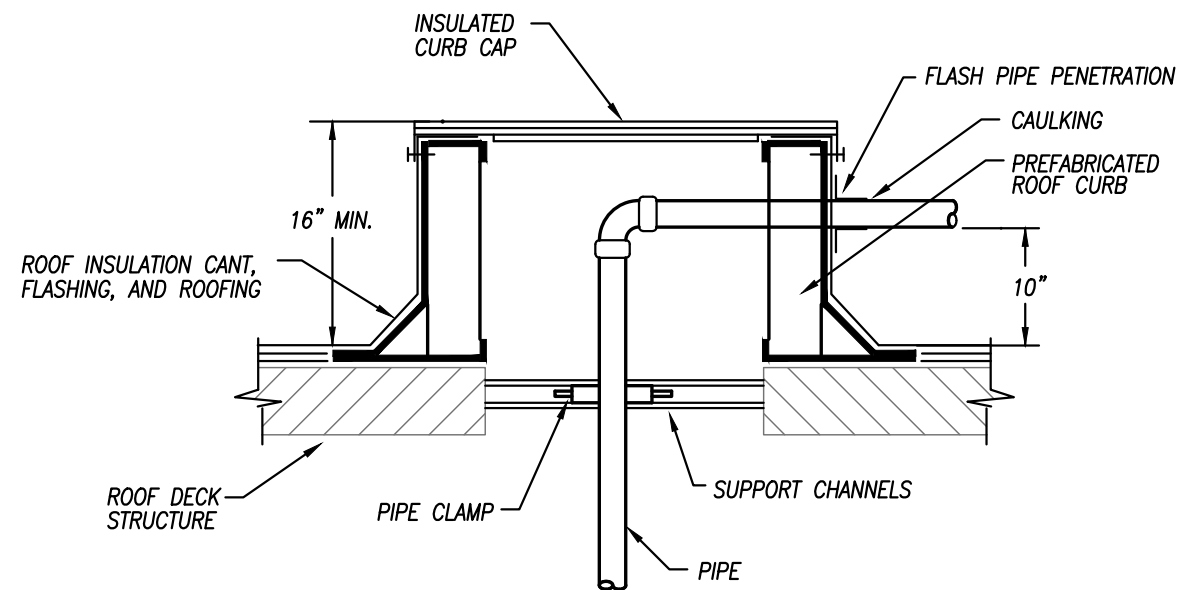


ROOF PIPE CURB PENETRATION
NOT TO SCALE 503-01

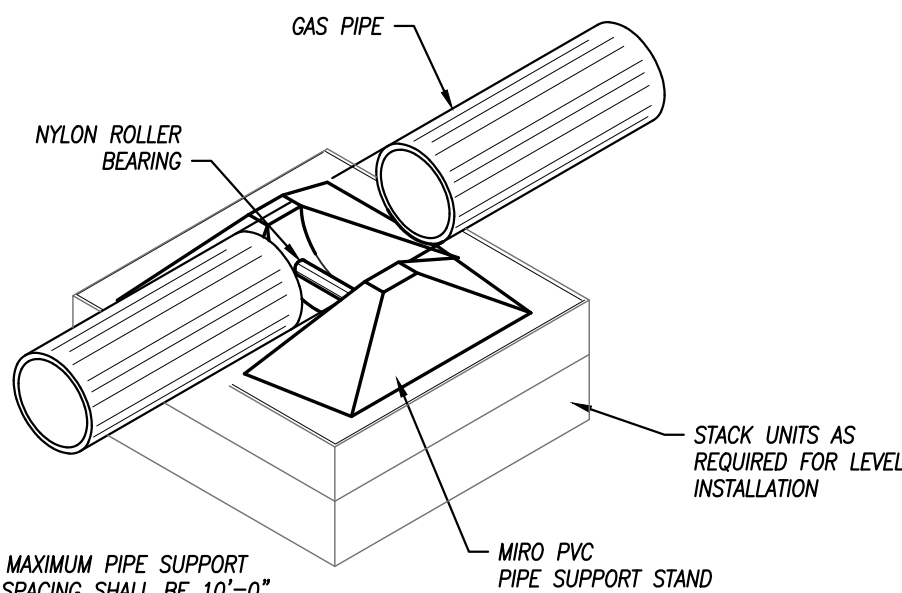

ROOF SUPPORT FOR GAS LINE
NOT TO SCALE 502-07

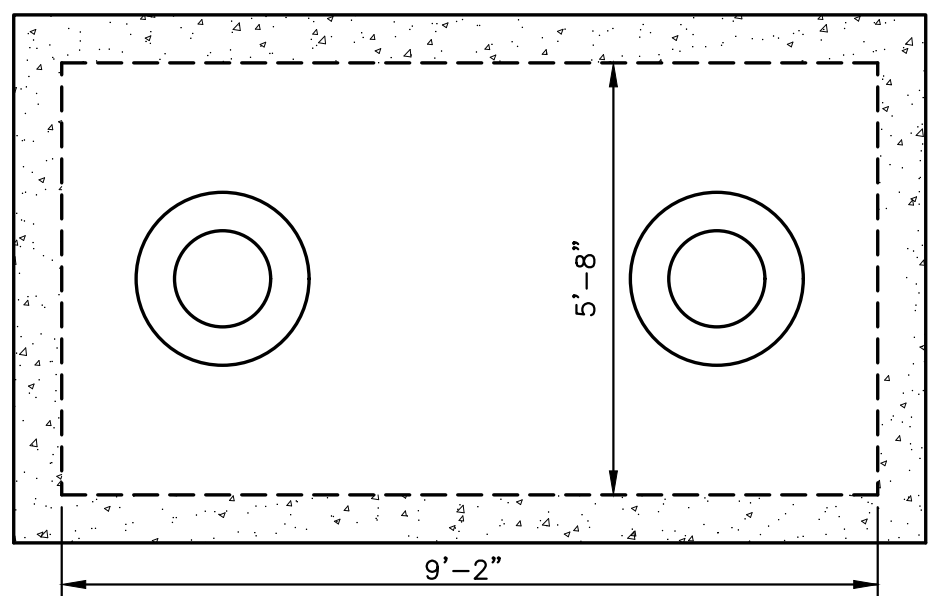

GREASE TRAP DETAIL
NO SCALE

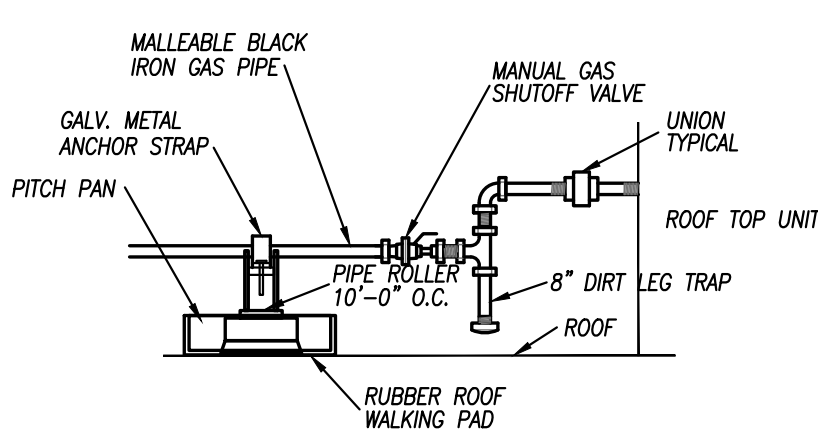

ROOF TOP UNIT GAS CONNECTION DETAIL
NO SCALE

ROOF TOP UNIT SCHEDULE - THREE PHASE ELECTRIC WITH GAS HEAT

PLAN MARK	MANUFACTURER	MODEL NUMBER	SIZE	REFRIGERANT	MINIMUM EFFICIENCY	AIRFLOW	COMPRESSORS	COOLING CAPACITY	CFM	EXTERNAL STATIC	OA CFM	HEATING CAPACITY	ELECTRICAL	WEIGHT	FILTER	NOTES
RTU-1	TRANE	YSC 120 E3	10 TON	R-410A	14.6 IEER	DOWN OR HORIZONTAL	(2) SCROLLS	119,000 BTUH	4,000	1.5"	400	150 MBH	208 V, 3 PH, 60 AMP	1300 LBS	MERV 13	1,2,3
RTU-2	TRANE	YSC 120 E3	10 TON	R-410A	14.6 IEER	DOWN OR HORIZONTAL	(2) SCROLLS	119,000 BTUH	4,000	1.5"	400	150 MBH	208 V, 3 PH, 60 AMP	1300 LBS	MERV 13	1,2,3
RTU-3	TRANE	YSC 092 E3	7.5 TON	R-410A	14.6 IEER	DOWN OR HORIZONTAL	(2) SCROLLS	94,000 BTUH	3,000	1.2"	300	120 MBH	208 V, 3 PH, 50 AMP	1100 LBS	MERV 13	1,2,3
RTU-4	TRANE	YSC 092 E3	7.5 TON	R-410A	14.6 IEER	DOWN OR HORIZONTAL	(2) SCROLLS	94,000 BTUH	3,000	1.2"	300	120 MBH	208 V, 3 PH, 50 AMP	1100 LBS	MERV 13	1,2,3
RTU-5	TRANE	YSC 092 E3	7.5 TON	R-410A	14.6 IEER	DOWN OR HORIZONTAL	(2) SCROLLS	94,000 BTUH	3,000	1.2"	300	120 MBH	208 V, 3 PH, 50 AMP	1100 LBS	MERV 13	1,2,3
RTU-6	TRANE	YSC 060 E3	5 TON	R-410A	14 SEER	DOWN OR HORIZONTAL	(1) SCROLL	60,100 BTUH	2,000	1.0"	200	80 MBH	208 V, 3 PH, 40 AMP	800 LBS	MERV 13	1,2,3
RTU-7	TRANE	YSC 060 E3	5 TON	R-410A	14 SEER	DOWN OR HORIZONTAL	(1) SCROLL	60,100 BTUH	2,000	1.0"	200	80 MBH	208 V, 3 PH, 40 AMP	800 LBS	MERV 13	1,2,3
RTU-8	TRANE	YSC 060 E3	5 TON	R-410A	14 SEER	DOWN OR HORIZONTAL	(1) SCROLL	60,100 BTUH	2,000	1.0"	200	80 MBH	208 V, 3 PH, 40 AMP	800 LBS	MERV 13	1,2,3
RTU-9	TRANE	YSC 092 E3	7.5 TON	R-410A	14.6 IEER	DOWN OR HORIZONTAL	(2) SCROLLS	94,000 BTUH	3,000	1.2"	300	120 MBH	208 V, 3 PH, 50 AMP	1100 LBS	MERV 13	1,2,3
RTU-10	TRANE	YSC 060 E3	5 TON	R-410A	14 SEER	DOWN OR HORIZONTAL	(1) SCROLL	60,100 BTUH	2,000	1.0"	200	80 MBH	208 V, 3 PH, 40 AMP	800 LBS	MERV 13	1,2,3

NOTES LEGEND


1. PROVIDE ROOF CURB, DISCONNECT SWITCH, HAIL GUARDS, AND ECONOMIZER
2. PROVIDE WALL MOUNTED 7-DAY PROGRAMMABLE THERMOSTAT
3. PROVIDE INTERNAL VIBRATION ISOLATION FOR THE RTU FAN AND COMPRESSORS
4. PROVIDE ROOF CURB WITH VIBRATION ISOLATION RAILS

PIPING MATERIAL & INSULATION SCHEDULE


PIPING SYSTEM	SIZE	TYPE/SCHED	MATERIAL	ACCEPTABLE FITTINGS	FIELD TEST PRESSURE/TIME	ALLOWABLE IN PLENUMS	INSULATION	
							TYPE	THICKNESS
DOMESTIC COLD WATER	1/2"-2-1/2"	L	COPPER	SOLDER, PRO-PRESS	130 PSI - 1/2HR	YES	FIBERGLASS W/ ASJ	1/2"
DOMESTIC HOT WATER & HW RETURN	1/2"-2-1/2"	L	COPPER	SOLDER, PRO-PRESS	130 PSI - 1/2HR	YES	FIBERGLASS W/ ASJ	1"
NATURAL GAS - ABOVE GRADE	2-1/2 & Up	SCH. 40	STEEL- SEEMED	WELDED	75 PSI - 1HR	YES	----	----
NATURAL GAS - ABOVE GRADE	1/2"-2"	SCH. 40	STEEL- SEAMLESS	THREADED IRON	75 PSI - 1HR	YES	----	----
SOIL & WASTE BELOW GRADE	2"-8"	SCH. 40	PVC	SOLVENT JOINED	10 FT - 1/2HR	NO	----	----
DOM. WATER SERVICE BELOW GRADE	4"-8"	AWWA C111	DUCTILE IRON	AWWA C111. MECH JOINTS	130 PSI - 1/2HR	YES	----	----
DOM. WATER SERVICE BELOW GRADE	1"-3"	K	COPPER	CONTINUOUS TUBING, BRAZED	130 PSI - 1/2HR	YES	----	----
DOM. WATER SERVICE BELOW GRADE	1"-3"	DR 9	HDPE	CONTINUOUS TUBING, FUSED	130 PSI - 1/2HR	NO	----	----

NOTES

1. ALL PIPING AND MATERIALS IN PLENUMS MUST MEET ASTM E84 FLAME/SMOKE RATING OF 25/50.
2. ALL INSULATION THICKNESSES SHALL MEET ASHRAE 90.1 - 2007 REQUIREMENTS AT A MINIMUM.
3. REFER TO SPECIFICATIONS FOR MORE DETAILED INFORMATION.

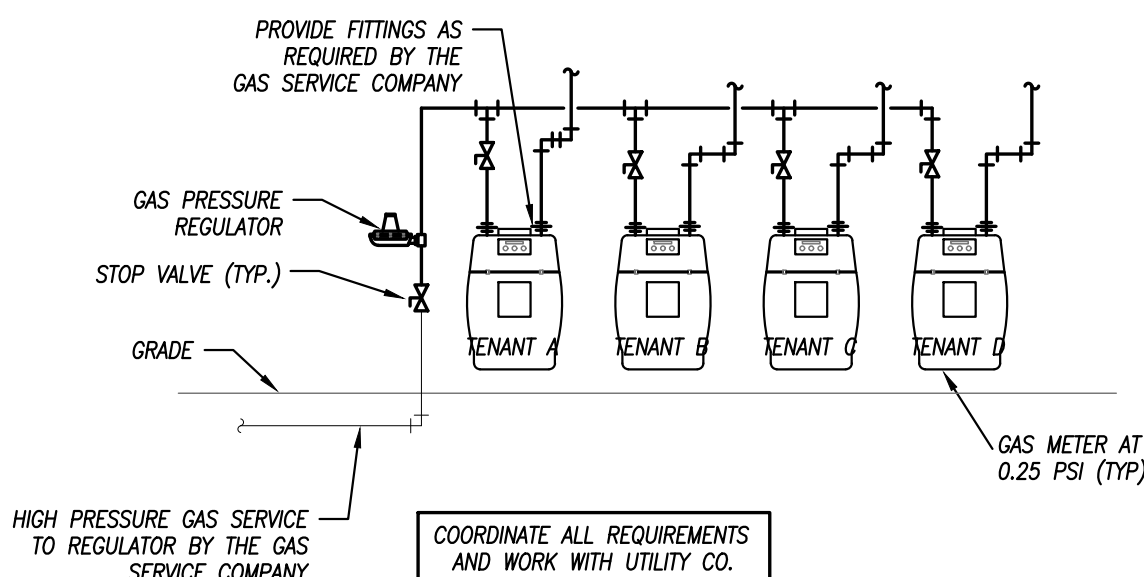

GAS SERVICE DETAIL
NOT TO SCALE

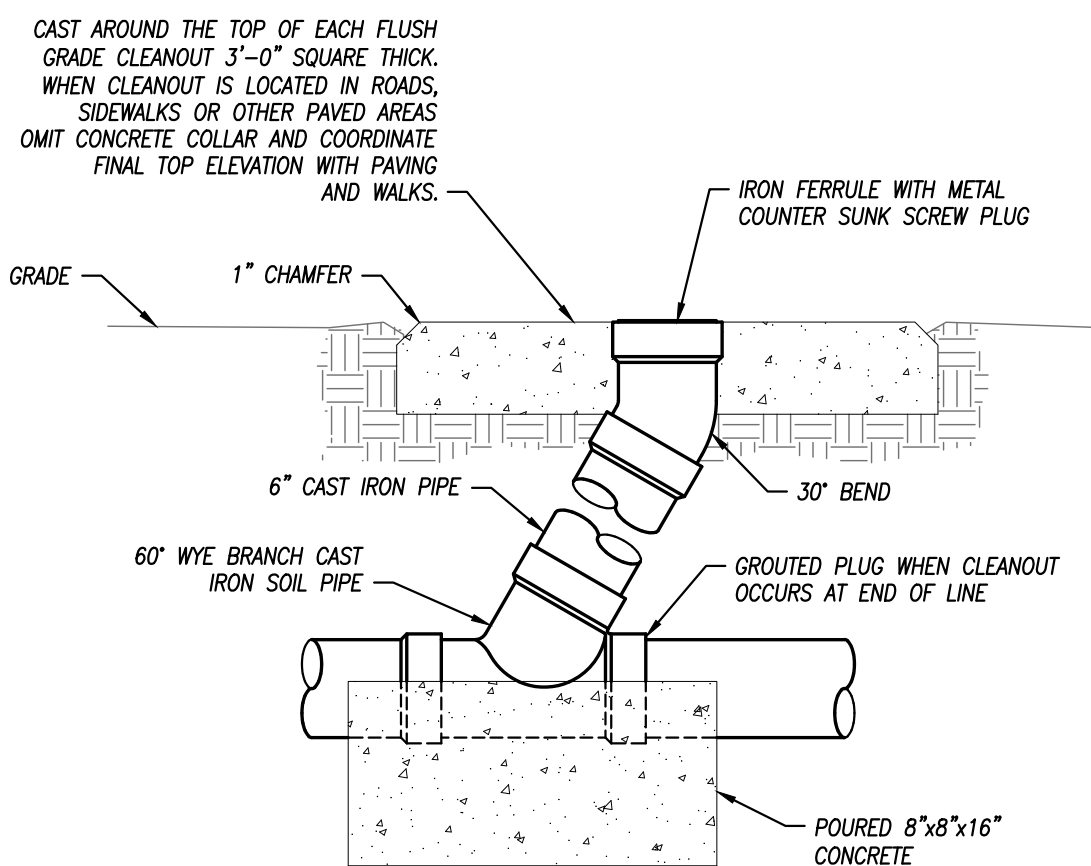

FLUSH GRADE CLEANOUT DETAIL
NOT TO SCALE 525-01

FLOOR DRAIN SCHEDULE


PLAN MARK	MANUFACTURER	MODEL NUMBER	SERVICE	TOPI/GRATE SIZE	WASTE SIZE	REMARKS
FD-1	WADE	1100	FLOOR DRAIN	6"Ø	3"	1
FS-1	WADE	9100	FLOOR SINK	12"x12"	4"	2

REMARKS:

1. PROVIDE WITH NICKEL BRONZE TOP AND TRAP SEAL.
2. PROVIDE WITH 3/4" GRATE.

NOTES:

1. BACKFLOW PREVENTER MANUFACTURER AND INSTALLATION SHALL BE AS APPROVED BY LOCAL AND STATE AUTHORITIES AND IN ACCORDANCE TO LISTING OF DEVICE.
2. ALL PIPING TO BE RIGIDLY SUPPORTED AND INSTALLED IN SUCH A MANNER AS TO BE DRAINABLE.

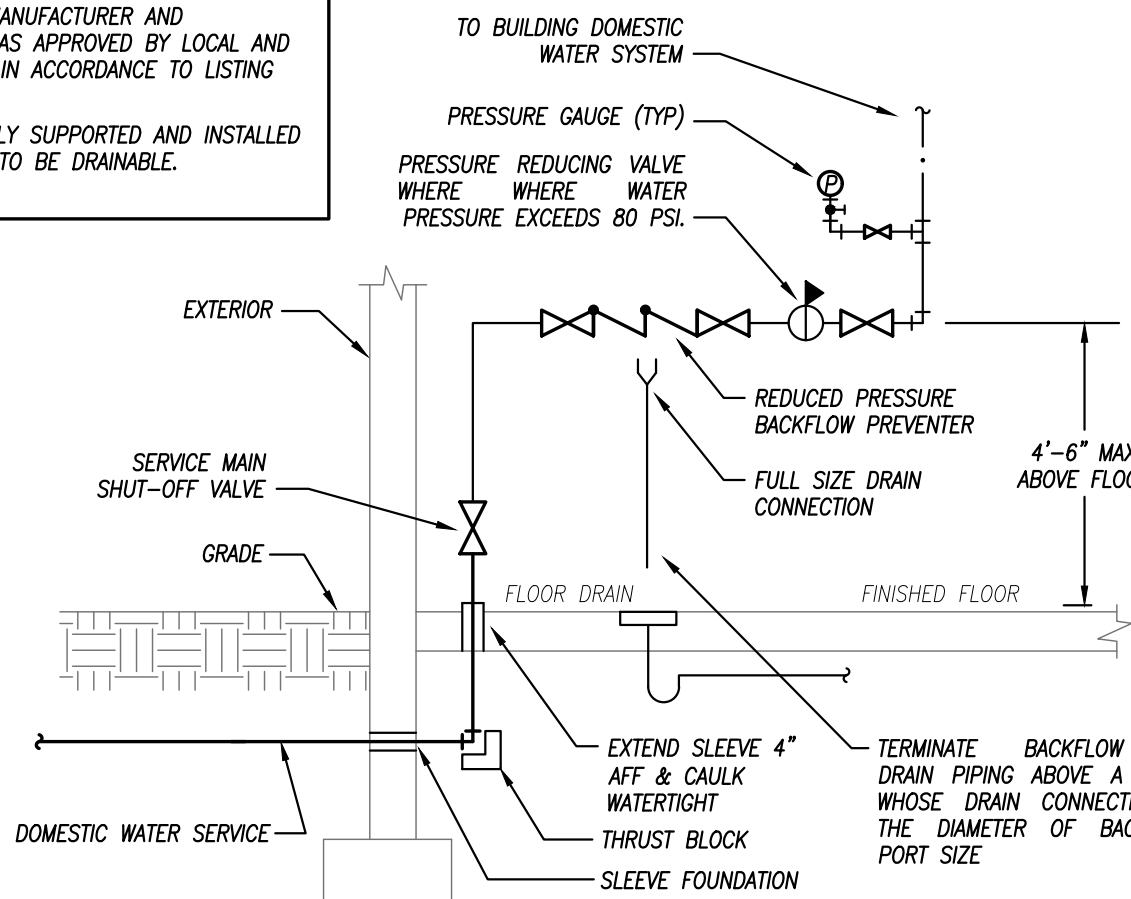

WATER SERVICE REDUCED PRESSURE BACKFLOW PREVENTER DETAIL
NOT TO SCALE KCMO STANDARDS 511-02k





schwerdt design group

architecture|interiors|planning
2231 sw wanamaker rd suite 303
topeka, kansas 66614-4275
phone: 785.273.7540
fax: 785.273.7579

500 north broadway suite 200
oklahoma city, ok 73102
phone: 405.231.3105
fax: 405.231.3115



Bryan Leinwetter - Engineer
MO# PE-2020020297

**CORE & SHELL BUILDING
STREETS OF WEST PRYOR LOT 13
LEES SUMMIT, MISSOURI**

SUBMISSION DATES
DECEMBER 27, 2023

SHEET TITLE
POWER PLAN


PROJECT NUMBER
235008

SHEET NUMBER
E-101



PEARSON KENT MCKINLEY RAAF ENGINEERS LLC
2949 SW WANAMAKER DR., TOPEKA, KANSAS 66614
785.273.2447 WWW.PKMRENG.COM

23.293

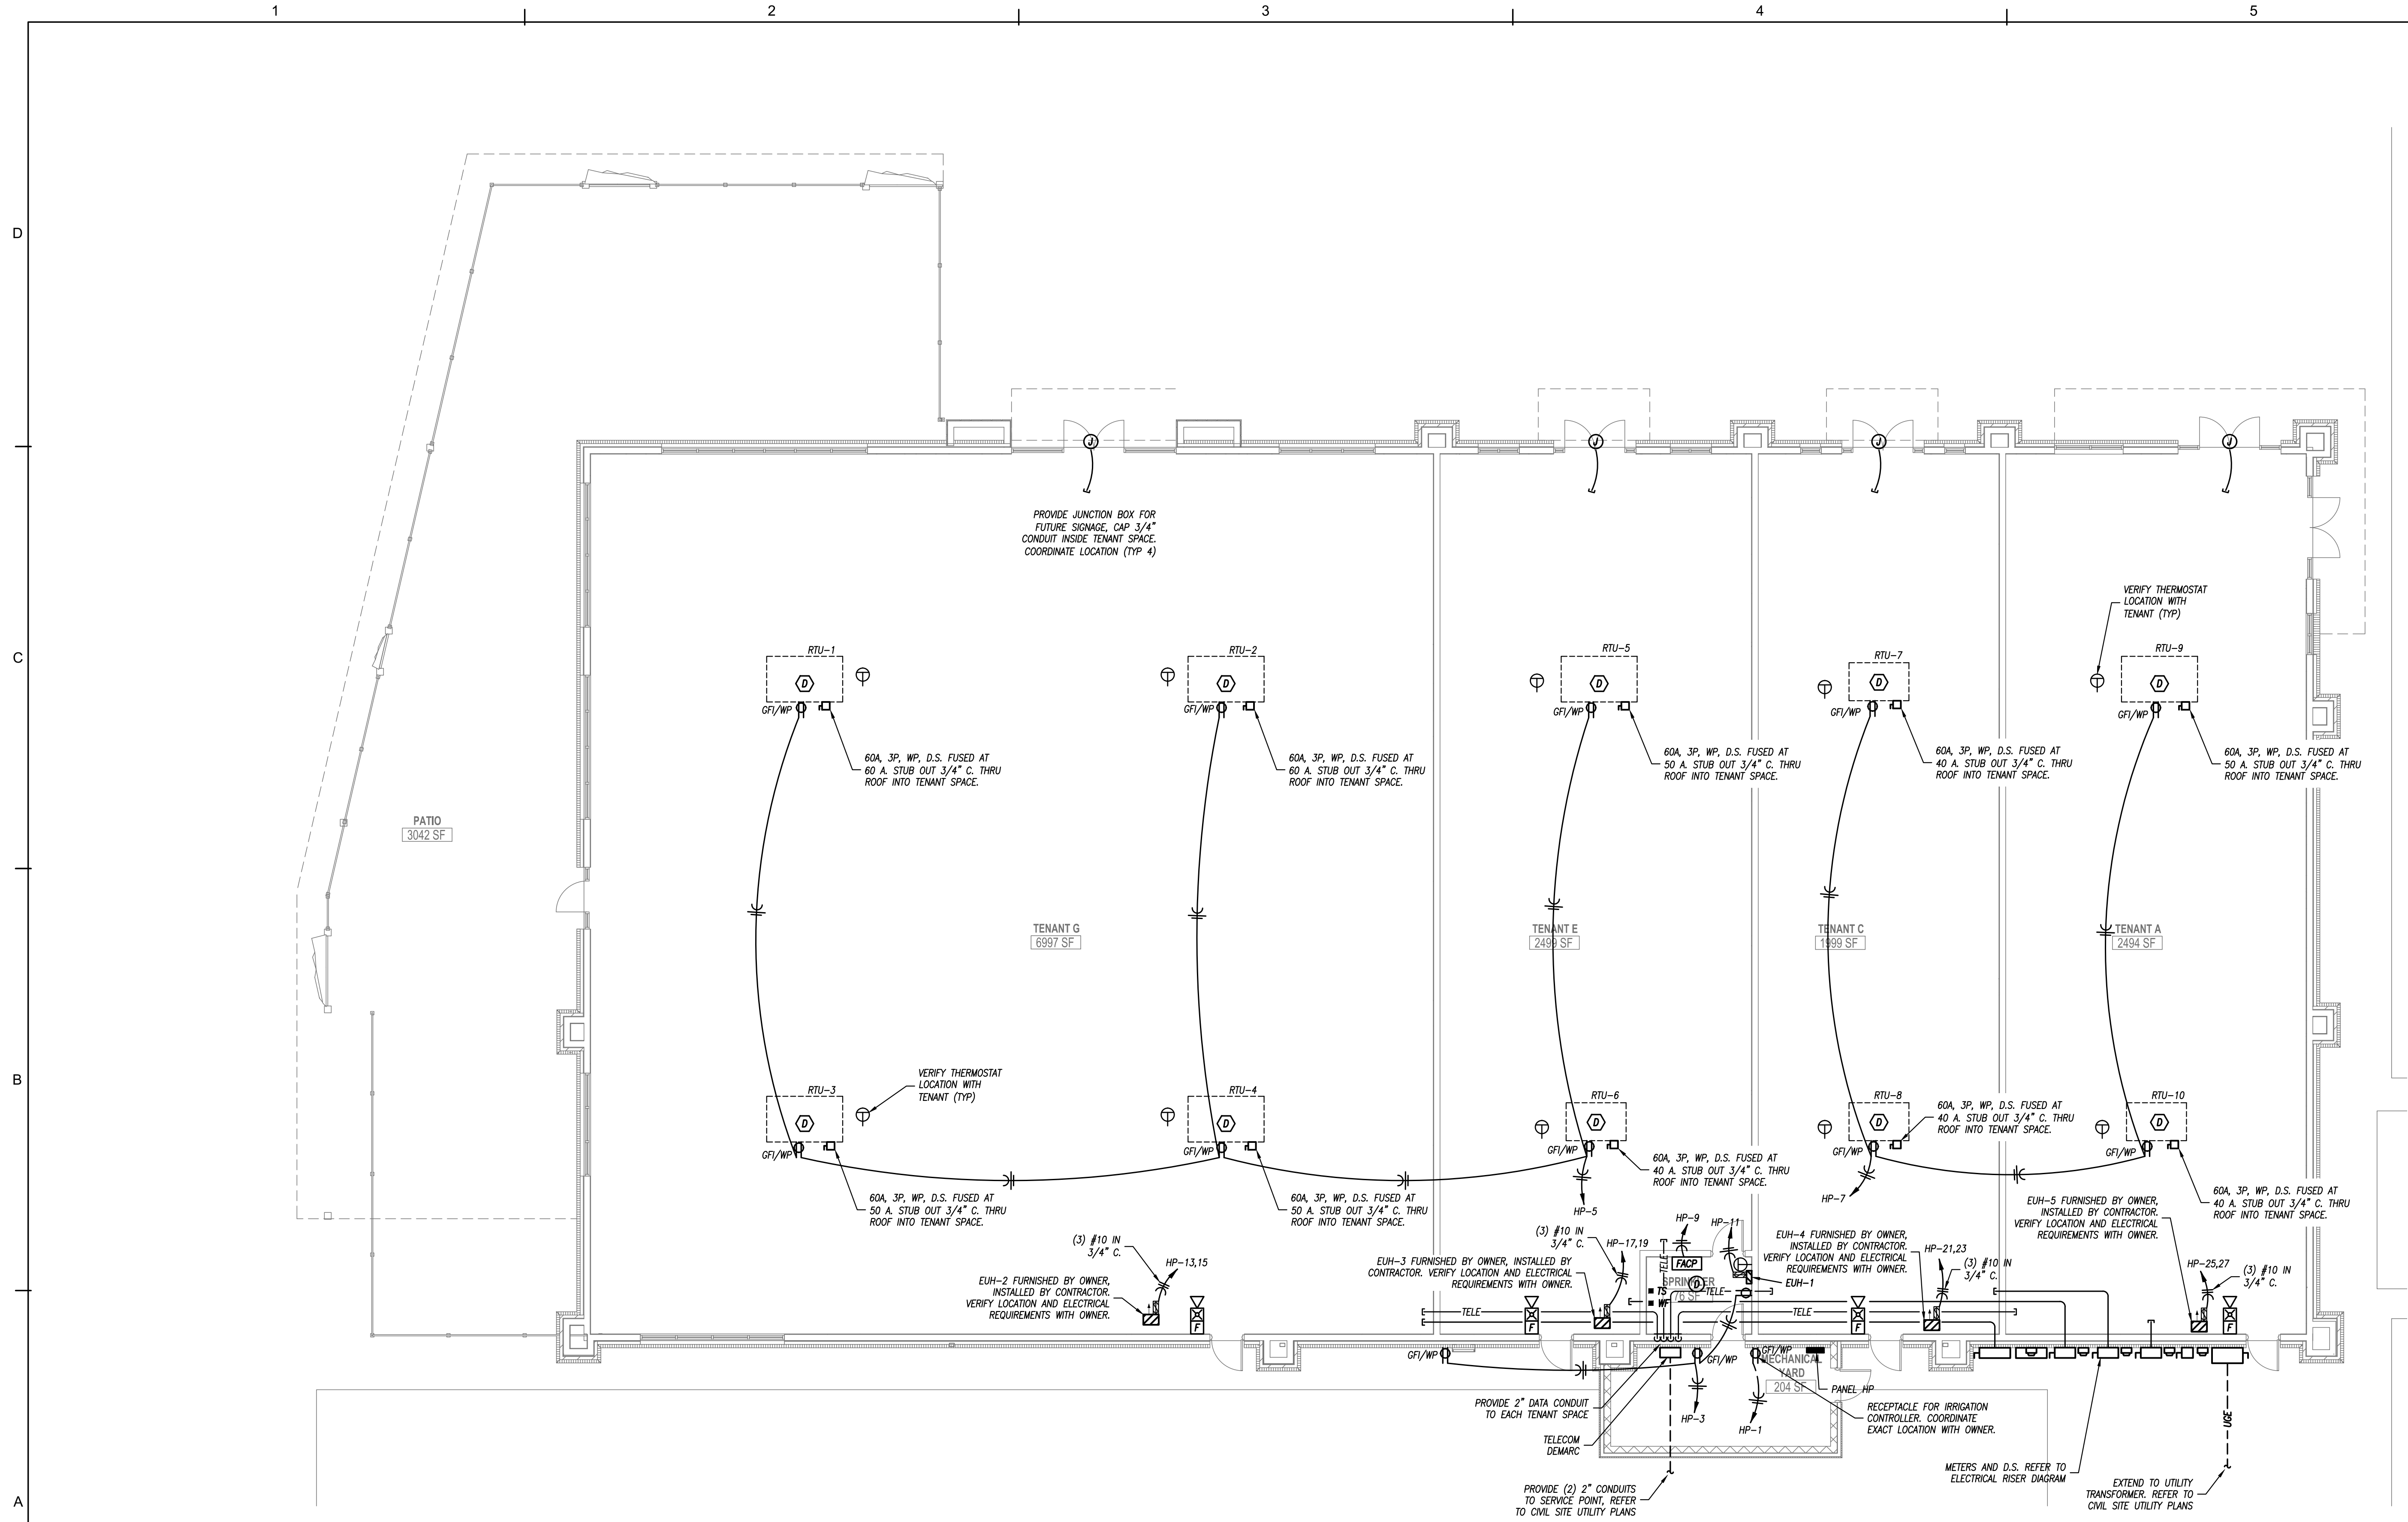

FLOOR PLAN - POWER
1/8" = 1'-0"



2231 sw wanamaker rd
topeka, kansas 66614-4275
phone: 785.273.7540
fax: 785.273.7579

500 north broadway
oklahoma city, ok 73102
phone: 405.231.3105
fax: 405.231.3115



Bryan Leinwetter - Engineer
MOR PE-2020020297

CORE & SHELL BUILDING
STREETS OF WEST PRYOR LOT 13
LEES SUMMIT, MISSOURI

SUBMISSION DATES
DECEMBER 27, 2023
JANUARY 19, 2024

SHEET TITLE
ELECTRICAL DETAILS
& SCHEDULES

PROJECT NUMBER
235008

SHEET NUMBER
E-102




PEARSON KENT MCKINLEY RAAF ENGINEERS LLC
2949 SW WANAMAKER DR., TOPEKA, KANSAS 66614
785.273.2447 WWW.PKURENG.COM

PANELBOARD SCHEDULE

PANEL DESIGNATION	MAIN BUS AMPS: 100		VOLTAGE: 120/240V		MOUNTING: SURFACE	
HP	MAIN BREAKER: 100		PHASE/WIRE: 3PH/4W		LOCATION: EXTERIOR	
	PANEL TYPE: NEMA 3R				MINIMUM AIC: 22K	
CIRCUIT DESCRIPTION	CKT.	BKR.	CKT.	CKT.	CKT.	BKR.
	P	AMP	NO.	NO.	AMP	P
IRRIGATION CONTROLLER	1	20	1	2	20	1
RECEPTACLES & LIGHTS	1	20	3	4	20	1
ROOFTOP RECEPTACLES	1	20	5	6	20	2
ROOFTOP RECEPTACLES	1	20	7	8		
FACP	1	20	9	10	20	2
EUH-1	1	20	11	12		
ELECTRIC UNIT HEATER (VERIFY)	2	30	13	14	20	1
			15	16	20	1
ELECTRIC UNIT HEATER (VERIFY)	2	30	17	18	20	1
			19	20	20	1
ELECTRIC UNIT HEATER (VERIFY)	2	30	21	22	20	1
			23	24	20	1
ELECTRIC UNIT HEATER (VERIFY)	2	30	25	26		
			27	28		
SPACE			29	30		

NOTES:
NEMA 3R RATED PANEL WITH LOCKABLE COVER
VERIFY BREAKER SIZES FOR ELECTRIC UNIT HEATERS WITH OWNER

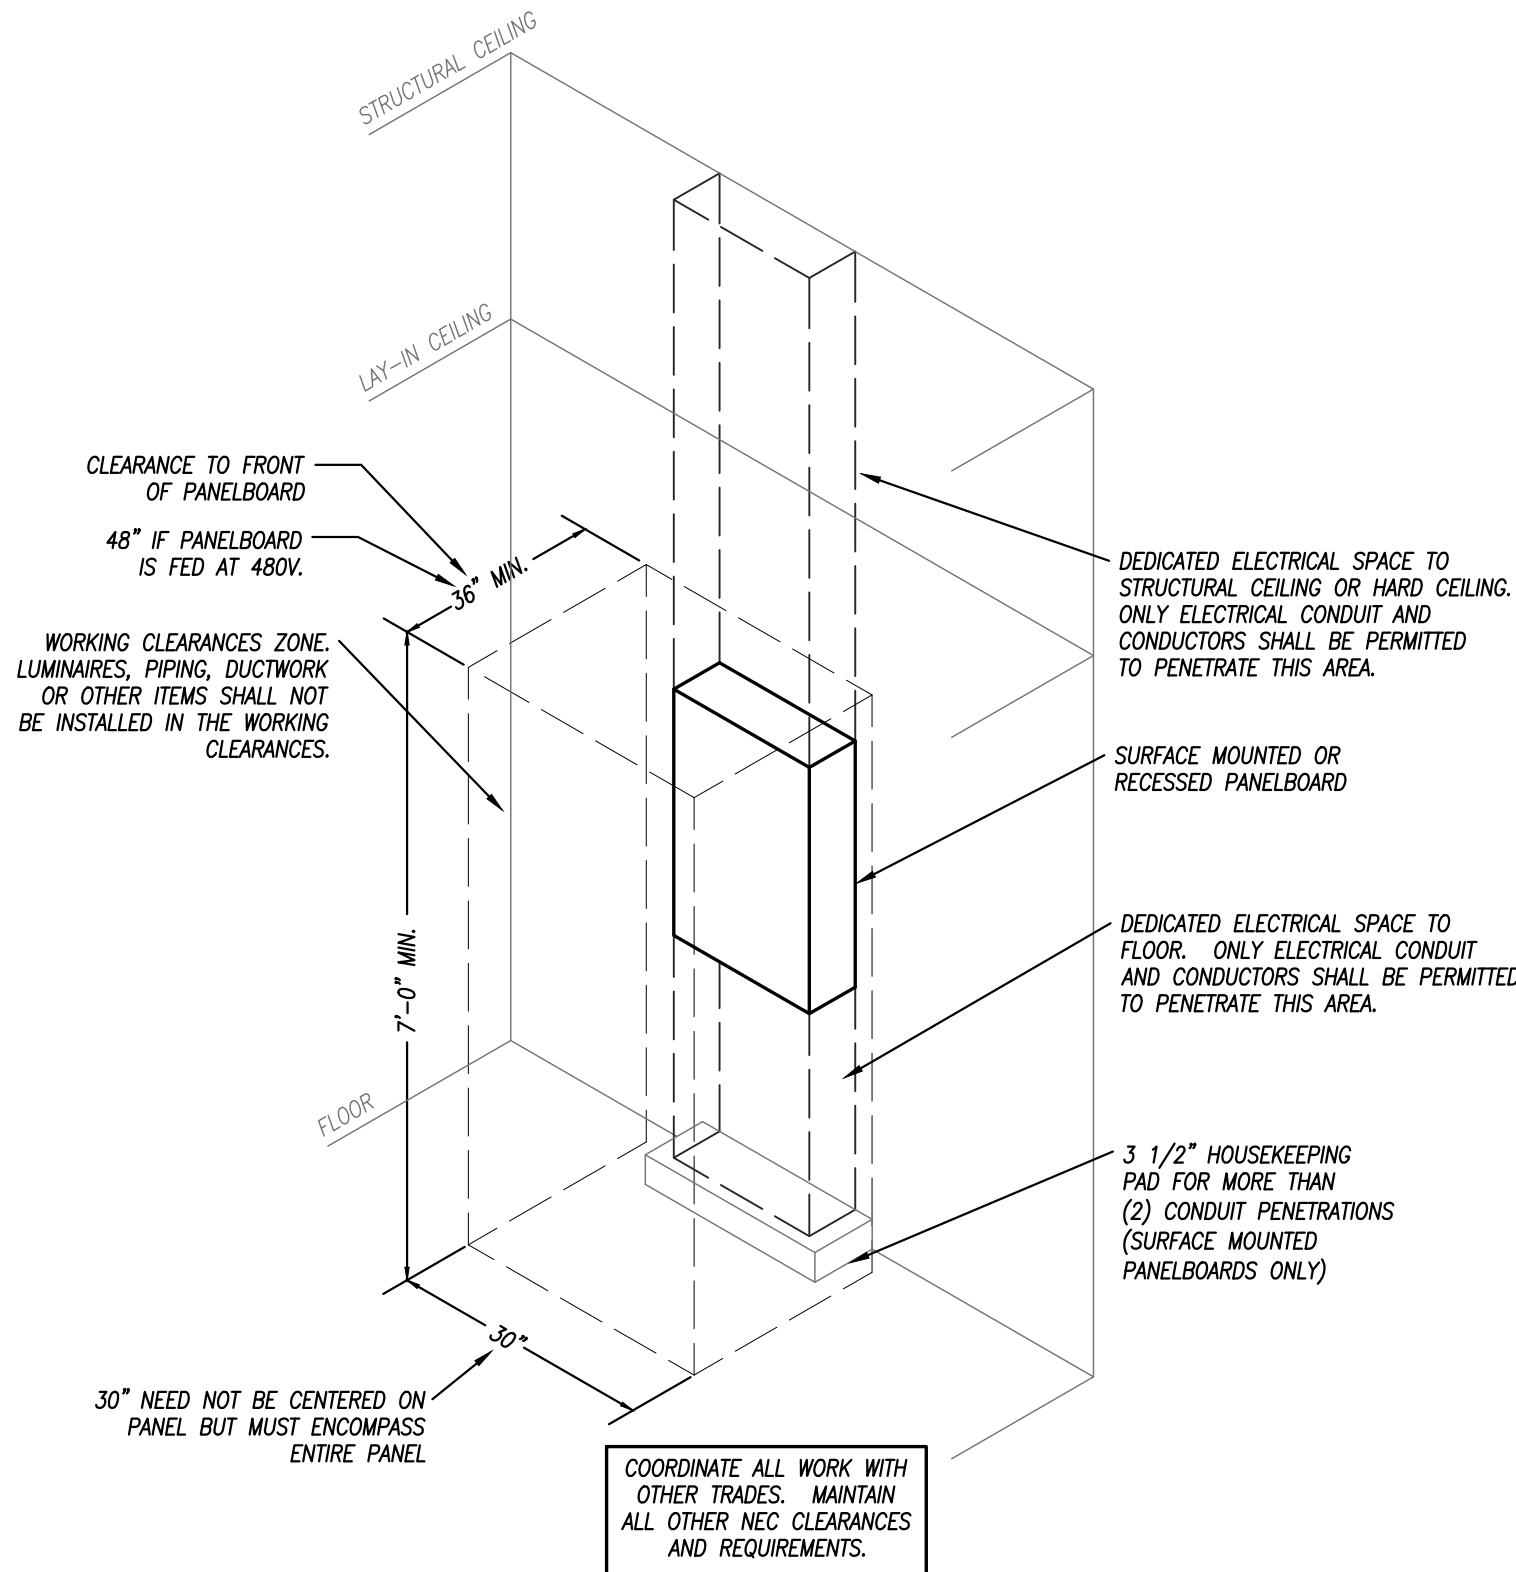

TYPICAL PANELBOARD INSTALLATION DETAIL

NOT TO SCALE

ELECTRIC UNIT HEATER SCHEDULE


PLAN MARK	MANUFACTURER	MODEL NUMBER	CAPACITY (WATTS)	ELECTRICAL	NOTES
EUH-1	BERKO	FRA1512F	1500 WATTS	120V., 1Ø, 20 AMP	1
EUH-2	-	BY OWNER	5000 WATTS	208V., 1Ø, 30 AMP	2
EUH-3	-	BY OWNER	5000 WATTS	208V., 1Ø, 30 AMP	2
EUH-4	-	BY OWNER	5000 WATTS	208V., 1Ø, 30 AMP	2
EUH-5	-	BY OWNER	5000 WATTS	208V., 1Ø, 30 AMP	2

NOTES LEGEND

1. PROVIDE SURFACE WALL MOUNTED HEATER WITH ADJUSTABLE THERMOSTAT AND DISCONNECT
2. FURNISHED BY OWNER, INSTALLED BY CONTRACTOR. VERIFY ALL ELECTRICAL REQUIREMENTS WITH OWNER.


ELECTRICAL RISER KEYED NOTES

- 1 (4) #3 AND (1) #8 GRD. IN 1-1/4" C.
- 2 2 SETS OF (4) #3/0 AND (1) #3 GRD. IN 2-1/2" C. EACH SET
- 3 3 SETS OF (4) #300 AND (1) #1/0 GRD. IN 3" C. EACH SET
- 4 400A, 3P, NEMA 3R, D.S FUSED AT 400A
- 5 100A, 3P, NEMA 3R, D.S FUSED AT 100A

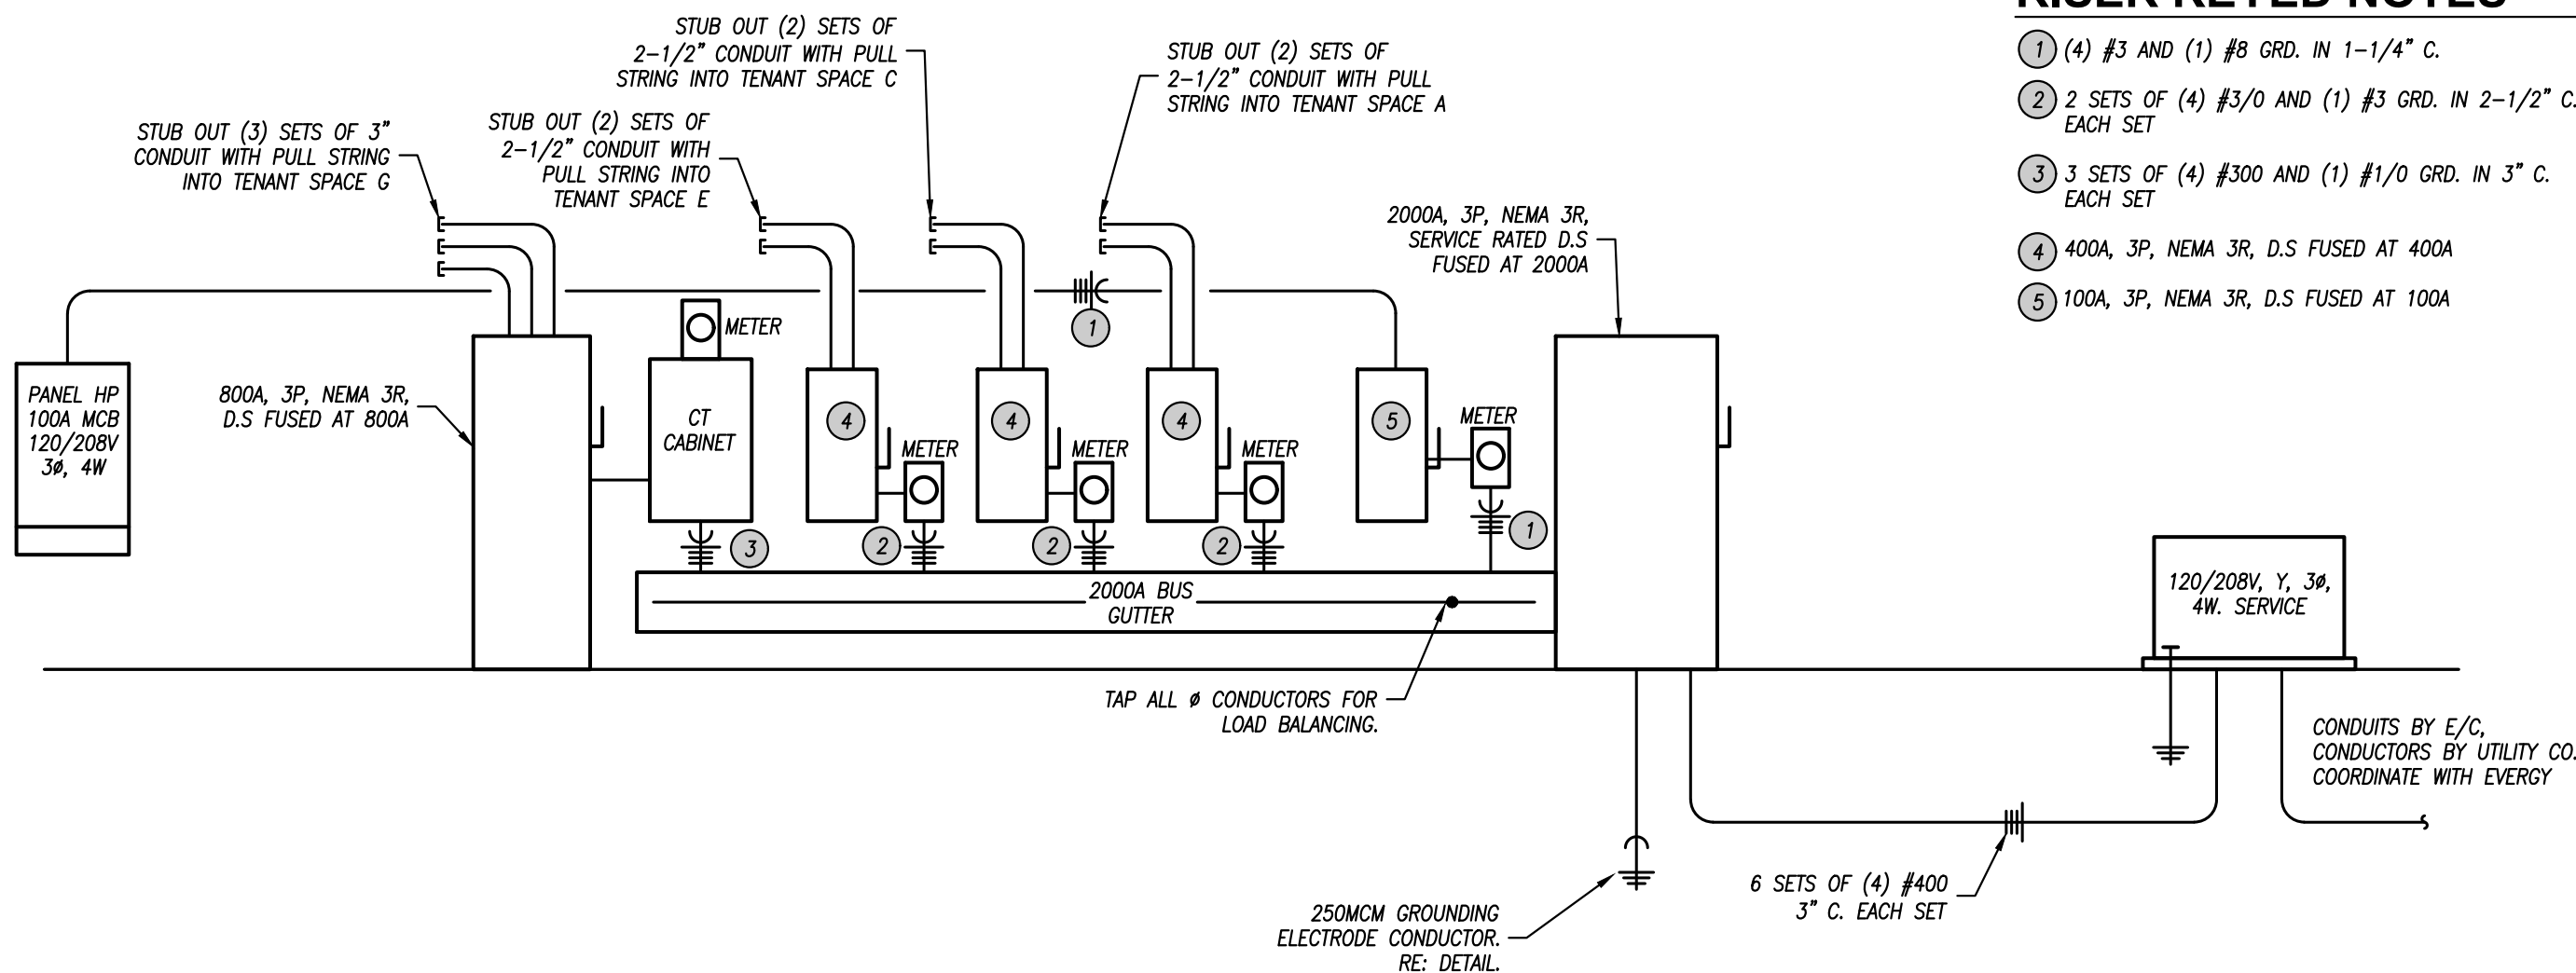

ELECTRICAL RISER DIAGRAM

NO SCALE

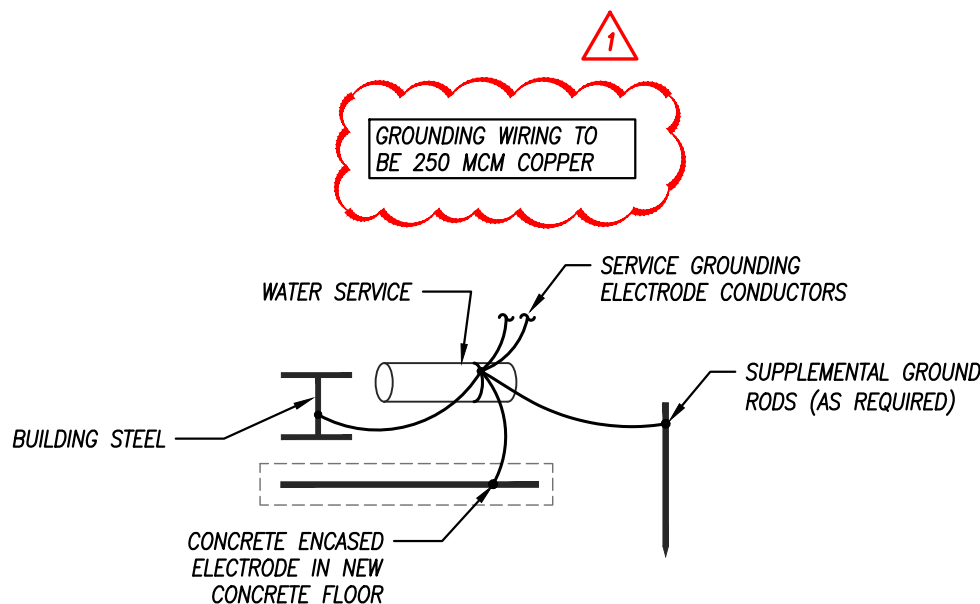

GROUNDING ELECTRODE SYSTEM

N.T.S



schwerdt design group

architecture|interiors|planning

2231 sw wanamaker rd suite 303
topeka, kansas 66614-4275
phone: 785.273.7540
fax: 785.273.7579

500 north broadway suite 200
oklahoma city, ok 73102
phone: 405.231.3105
fax: 405.231.3115



Bryan Leinwetter - Engineer
MO# PE-2020020297

**CORE & SHELL BUILDING
STREETS OF WEST PRYOR LOT 13
LEES SUMMIT, MISSOURI**


SUBMISSION DATES

DECEMBER 27, 2023

SHEET TITLE
LIGHTING PLAN

PROJECT NUMBER
235008

SHEET NUMBER
E-201

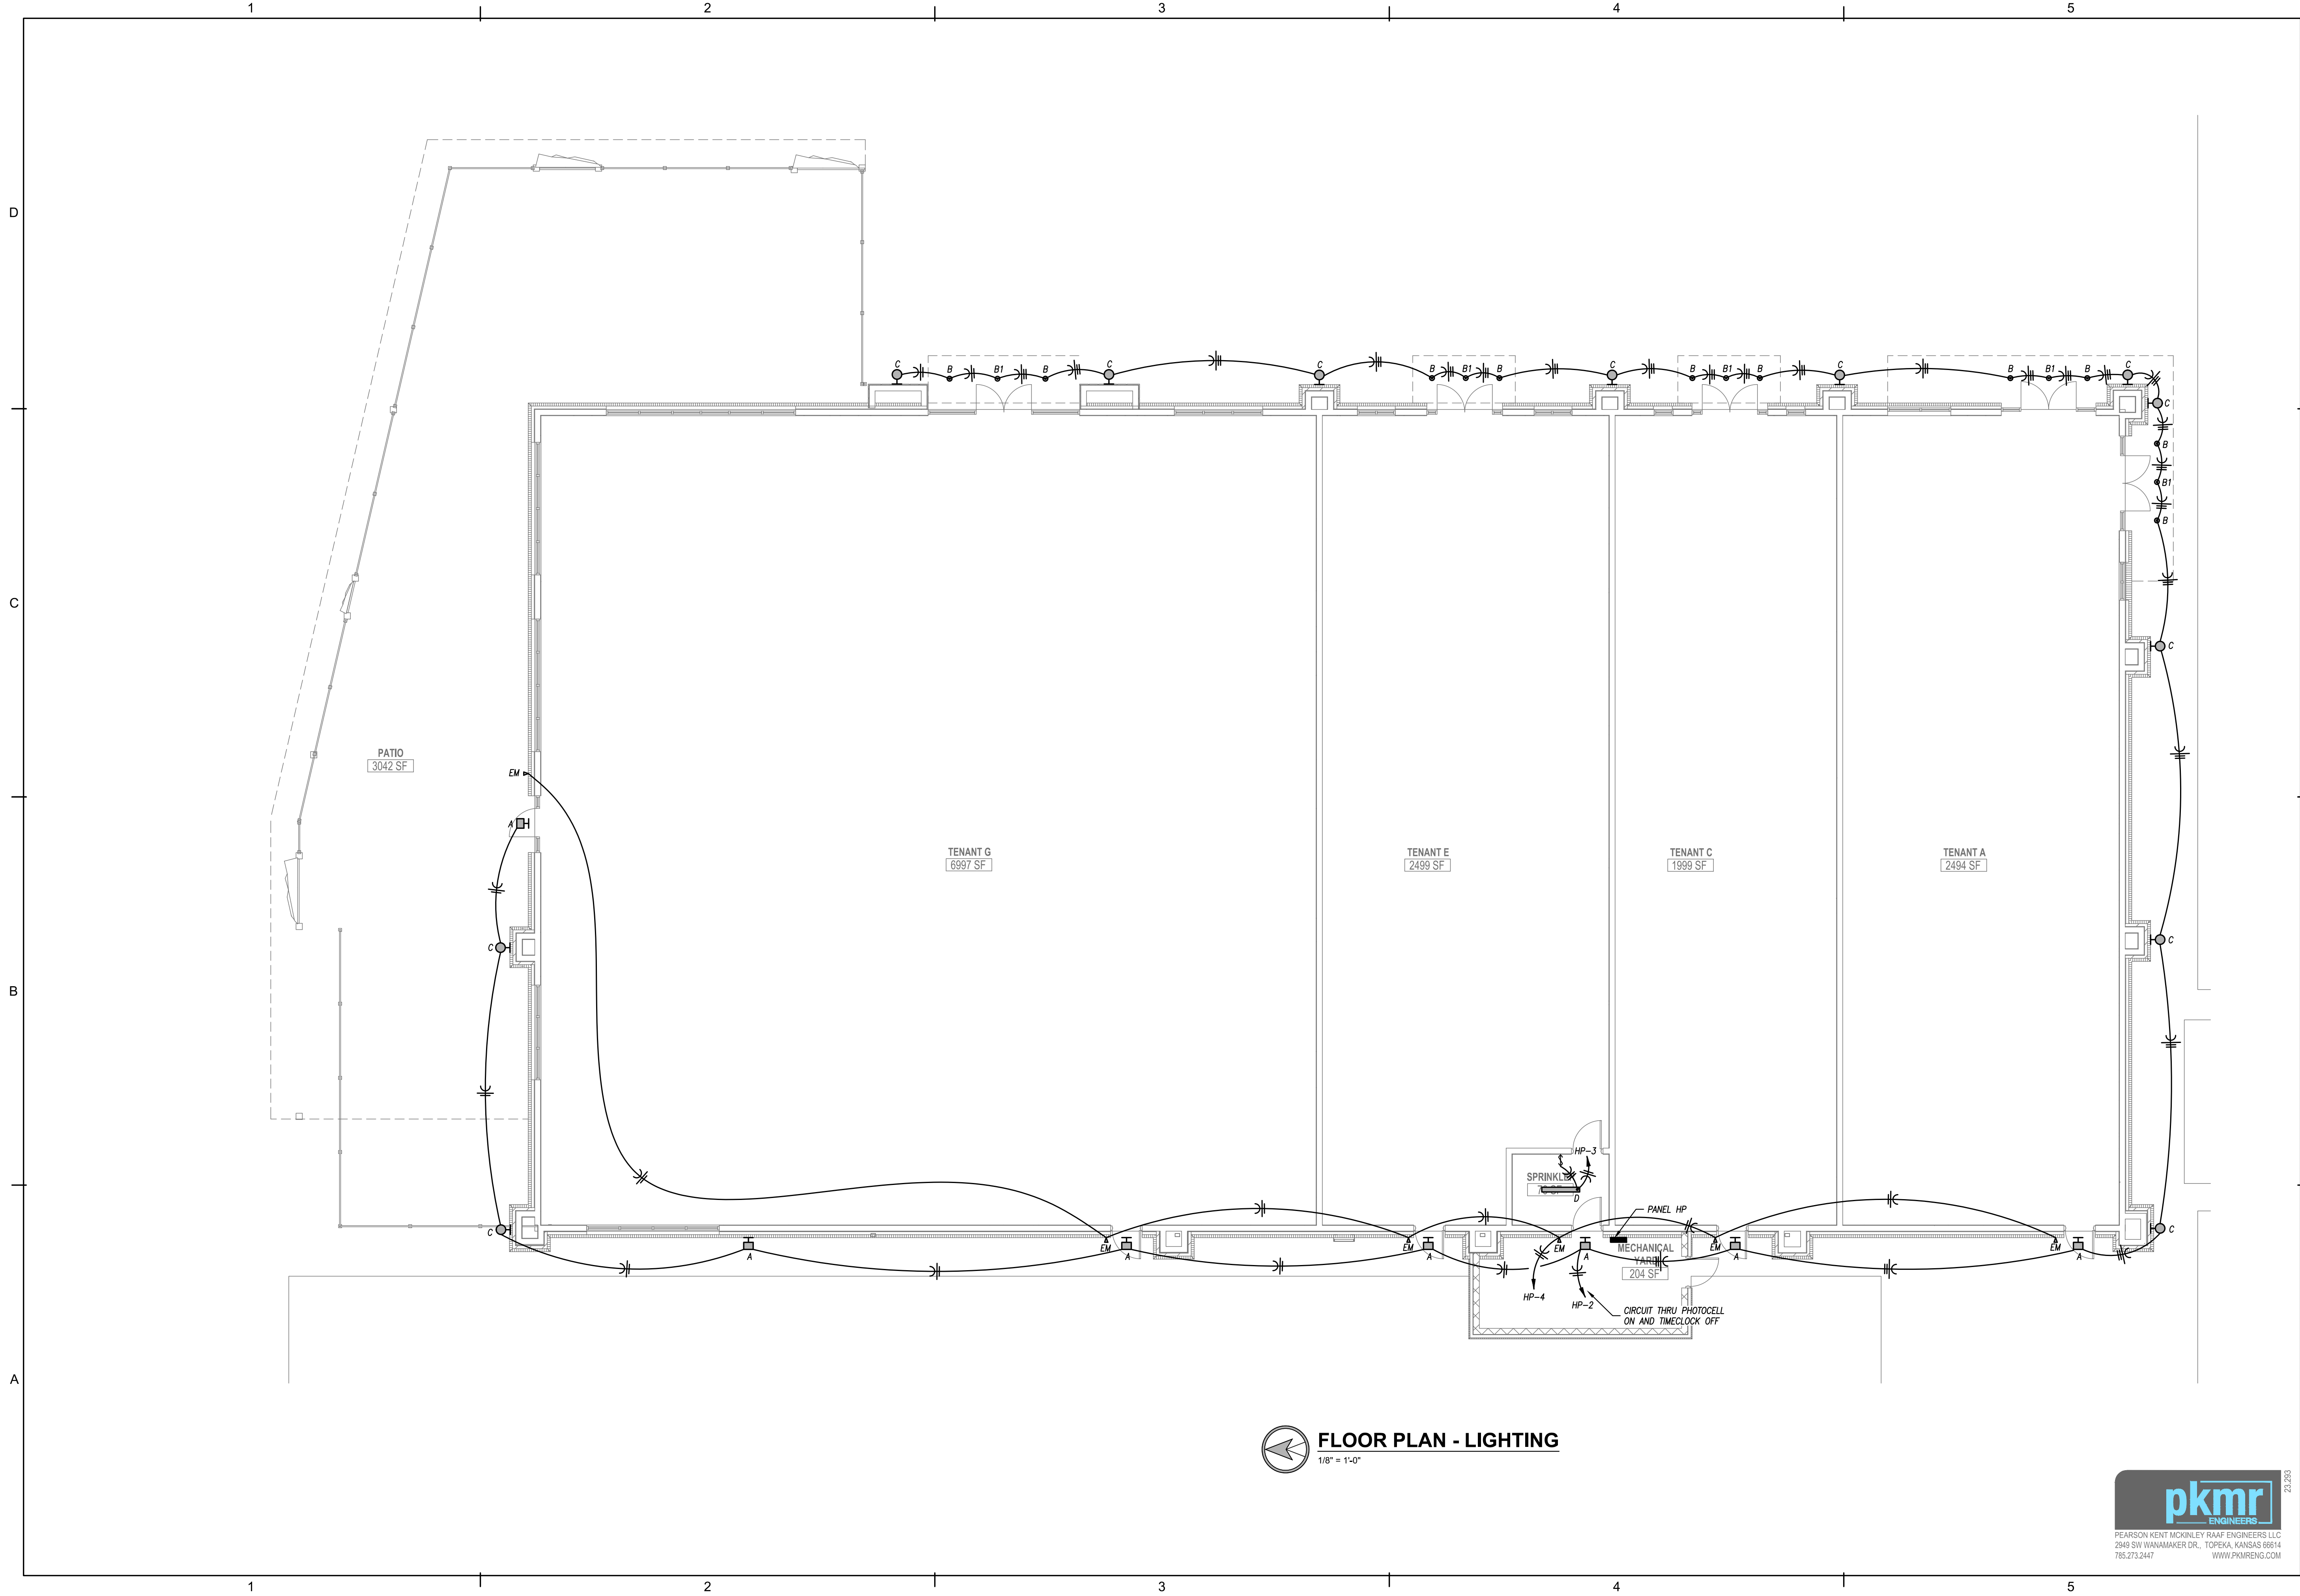

PEARSON KENT MCKINLEY RAAF ENGINEERS LLC
2949 SW WANAMAKER DR., TOPEKA, KANSAS 66614
785.273.2447 WWW.PKMRENG.COM



2231 sw wanamaker rd
topeka, kansas 66614-4275
phone: 785.273.7540
fax: 785.273.7579

500 north broadway
oklahoma city, ok 73102
phone: 405.231.3105
fax: 405.231.3115



Bryan Leinwetter - Engineer
MOR PE-2020020297

CORE & SHELL BUILDING STREETS OF WEST PRYOR LOT 13 LEES SUMMIT, MISSOURI

SUBMISSION DATES
DECEMBER 27, 2023
JANUARY 19, 2024

SHEET TITLE
SITE LIGHTING
PLAN

PROJECT NUMBER
235008


SHEET NUMBER
E-202



PEARSON KENT MCKINLEY RAAF ENGINEERS LLC
2949 SW WANAMAKER DR., TOPEKA, KANSAS 66614
785.273.2447 WWW.PKMRENG.COM


LIGHT FIXTURE SCHEDULE							
PLAN MARK	MANUFACTURER	MODEL NUMBER	MOUNTING	FINISH	LAMP CODE	LAMP QUANTITY	NOTES
AA	MCGRAW-EDISON	GALN-SA2C-740-U-T4FT	25' POLE	BRONZE	108W LED PER HEAD	1	1,2,3,5
BB	MCGRAW-EDISON	GALN-SA2C-740-U-T4FT-2@180 DEG	25' POLE	BRONZE	108W LED PER HEAD	2	1,2,3,5
CC	MCGRAW-EDISON	GALN-SA2C-740-U-T2	10' POLE	BRONZE	108W LED PER HEAD	1	1,2,3,5
A	LITHONIA	WPX1-LED-P2-30K-MVOLT-ET4WC-DOBXD	WALL/SURFACE	BRONZE	24W LED	-	1,2
B	GREEN CREATIVE	12NCDRL6DIM/930/EXT	RECESSED	BLACK	12W LED	-	1,2,3,6
B1	GREEN CREATIVE	12NCDRL6DIM/930/EXT-EM	RECESSED	BLACK	12W LED	-	1,2,3,4,6
C	AFX	BMW517800L30MYBZ	WALL/SURFACE	BRONZE	1,800 LUMENS/19W	-	1,2
D	WILLIAMS	75L-4-L50/835-AF12125-DIM-UNV	SURFACE	WHITE	5,000 LUMENS/43W	-	-
EM	DUAL LITE	PG-HTR	SURFACE WALL/CEILING	BY ARCHITECT	LED	-	1,2,4

- NOTES LEGEND
- 1 - PROVIDE WET LOCATION RATED FIXTURE
 - 2 - PROVIDE COLD LOCATION RATED DRIVER
 - 3 - PROVIDE SQUARE STRAIGHT STEEL POLE RATED FOR 100 MPH WIND GUSTS, PRIMED AND PAINTED TO MATCH FIXTURE
 - 4 - PROVIDE EMERGENCY BATTERY
 - 5 - PROVIDE ALL ACCESSORIES FOR A COMPLETE INSTALLATION.
 - 6 - PROVIDE WEATHER PROOF JUNCTION BOX FOR DRIVERS AND ELECTRICAL CONNECTIONS ABOVE SOFFIT.

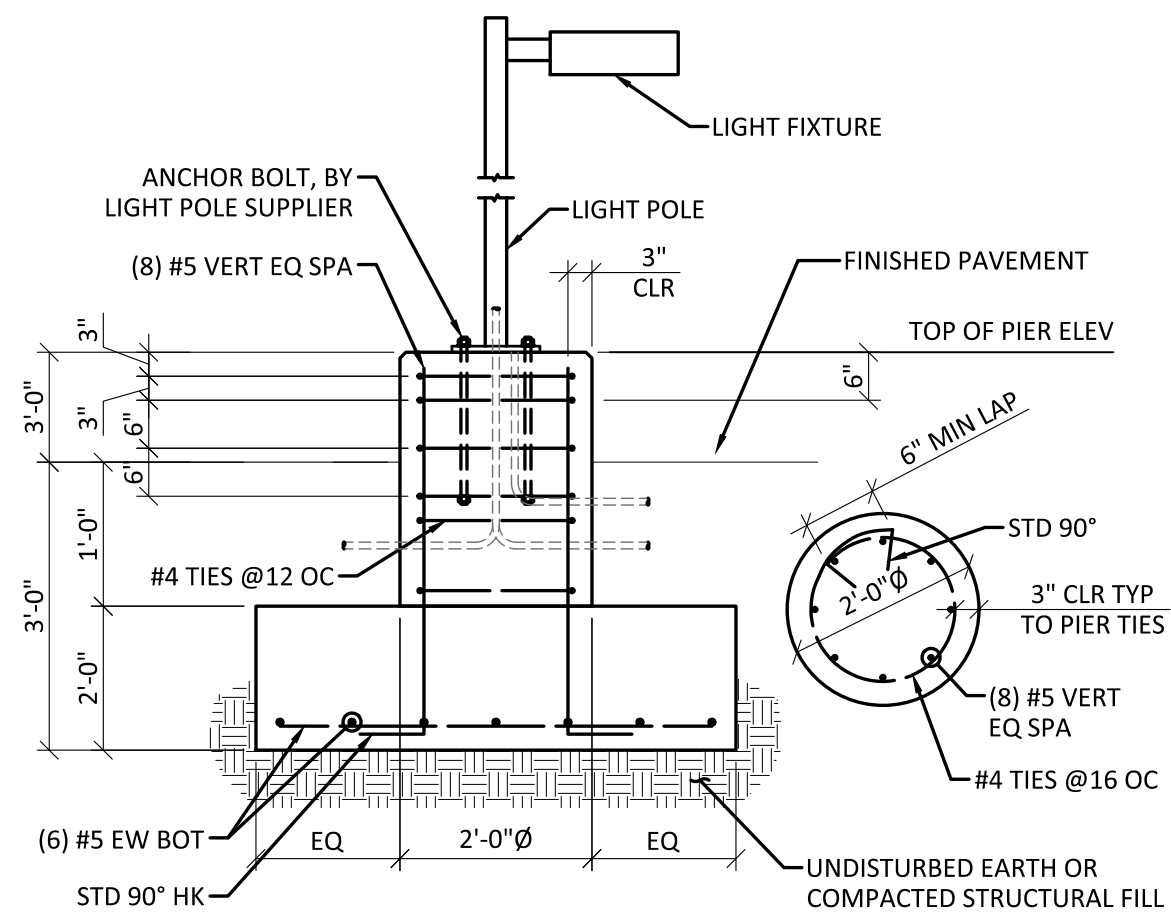


TYPICAL LIGHT POLE BASE DETAIL

SCALE: NONE

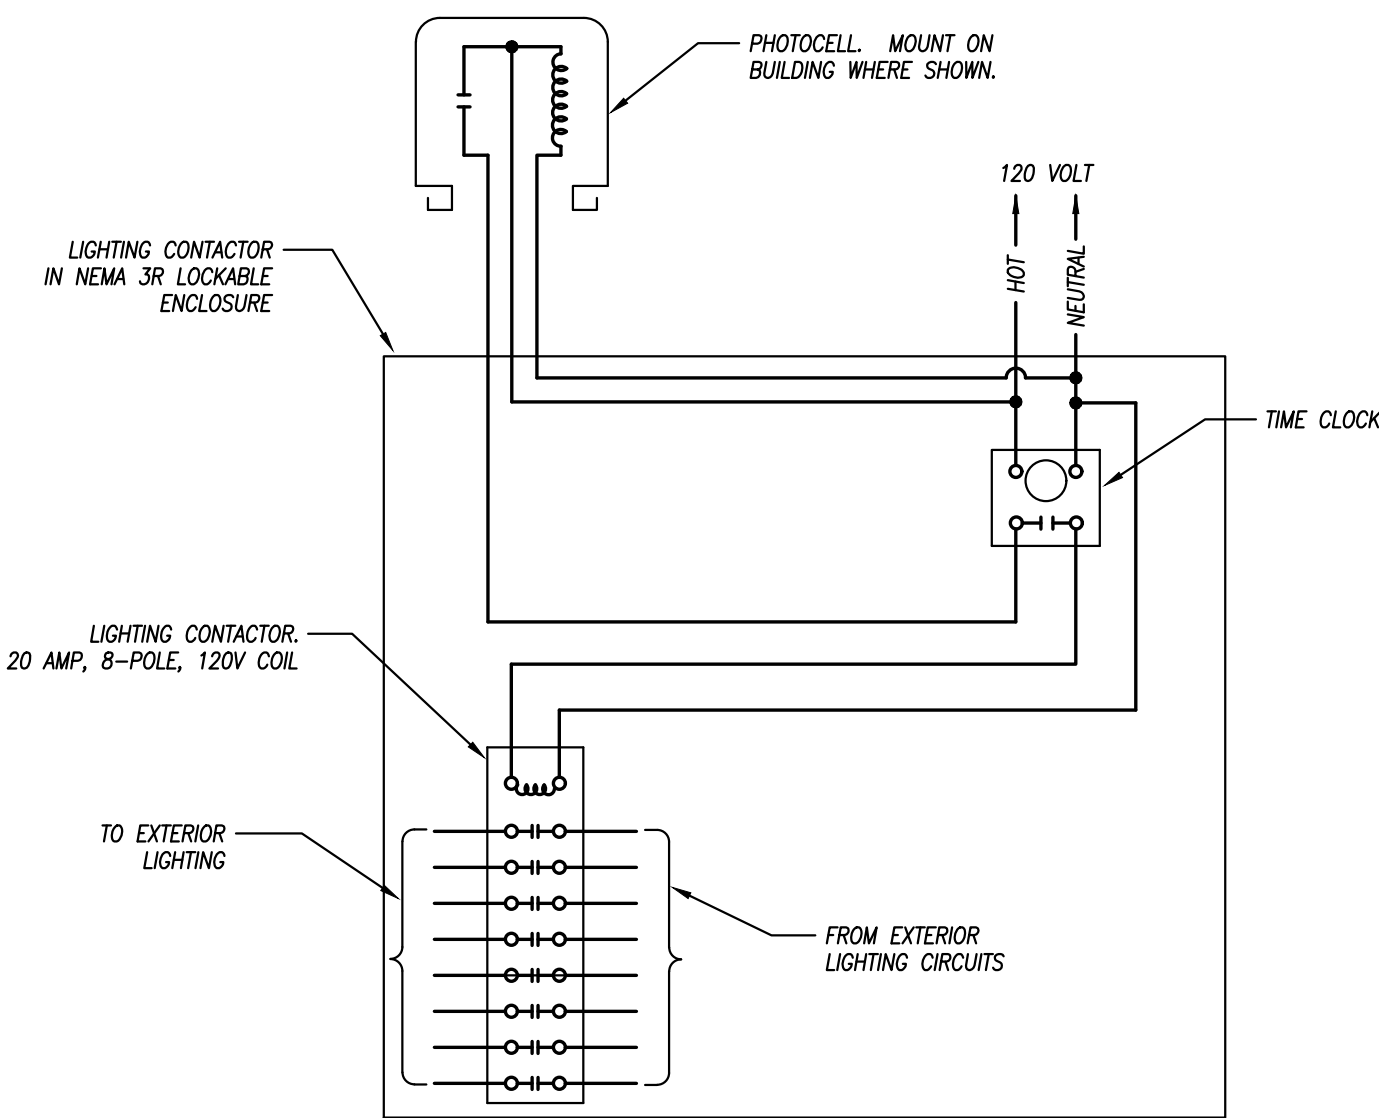

EXTERIOR LIGHTING CONTROL

NOT TO SCALE

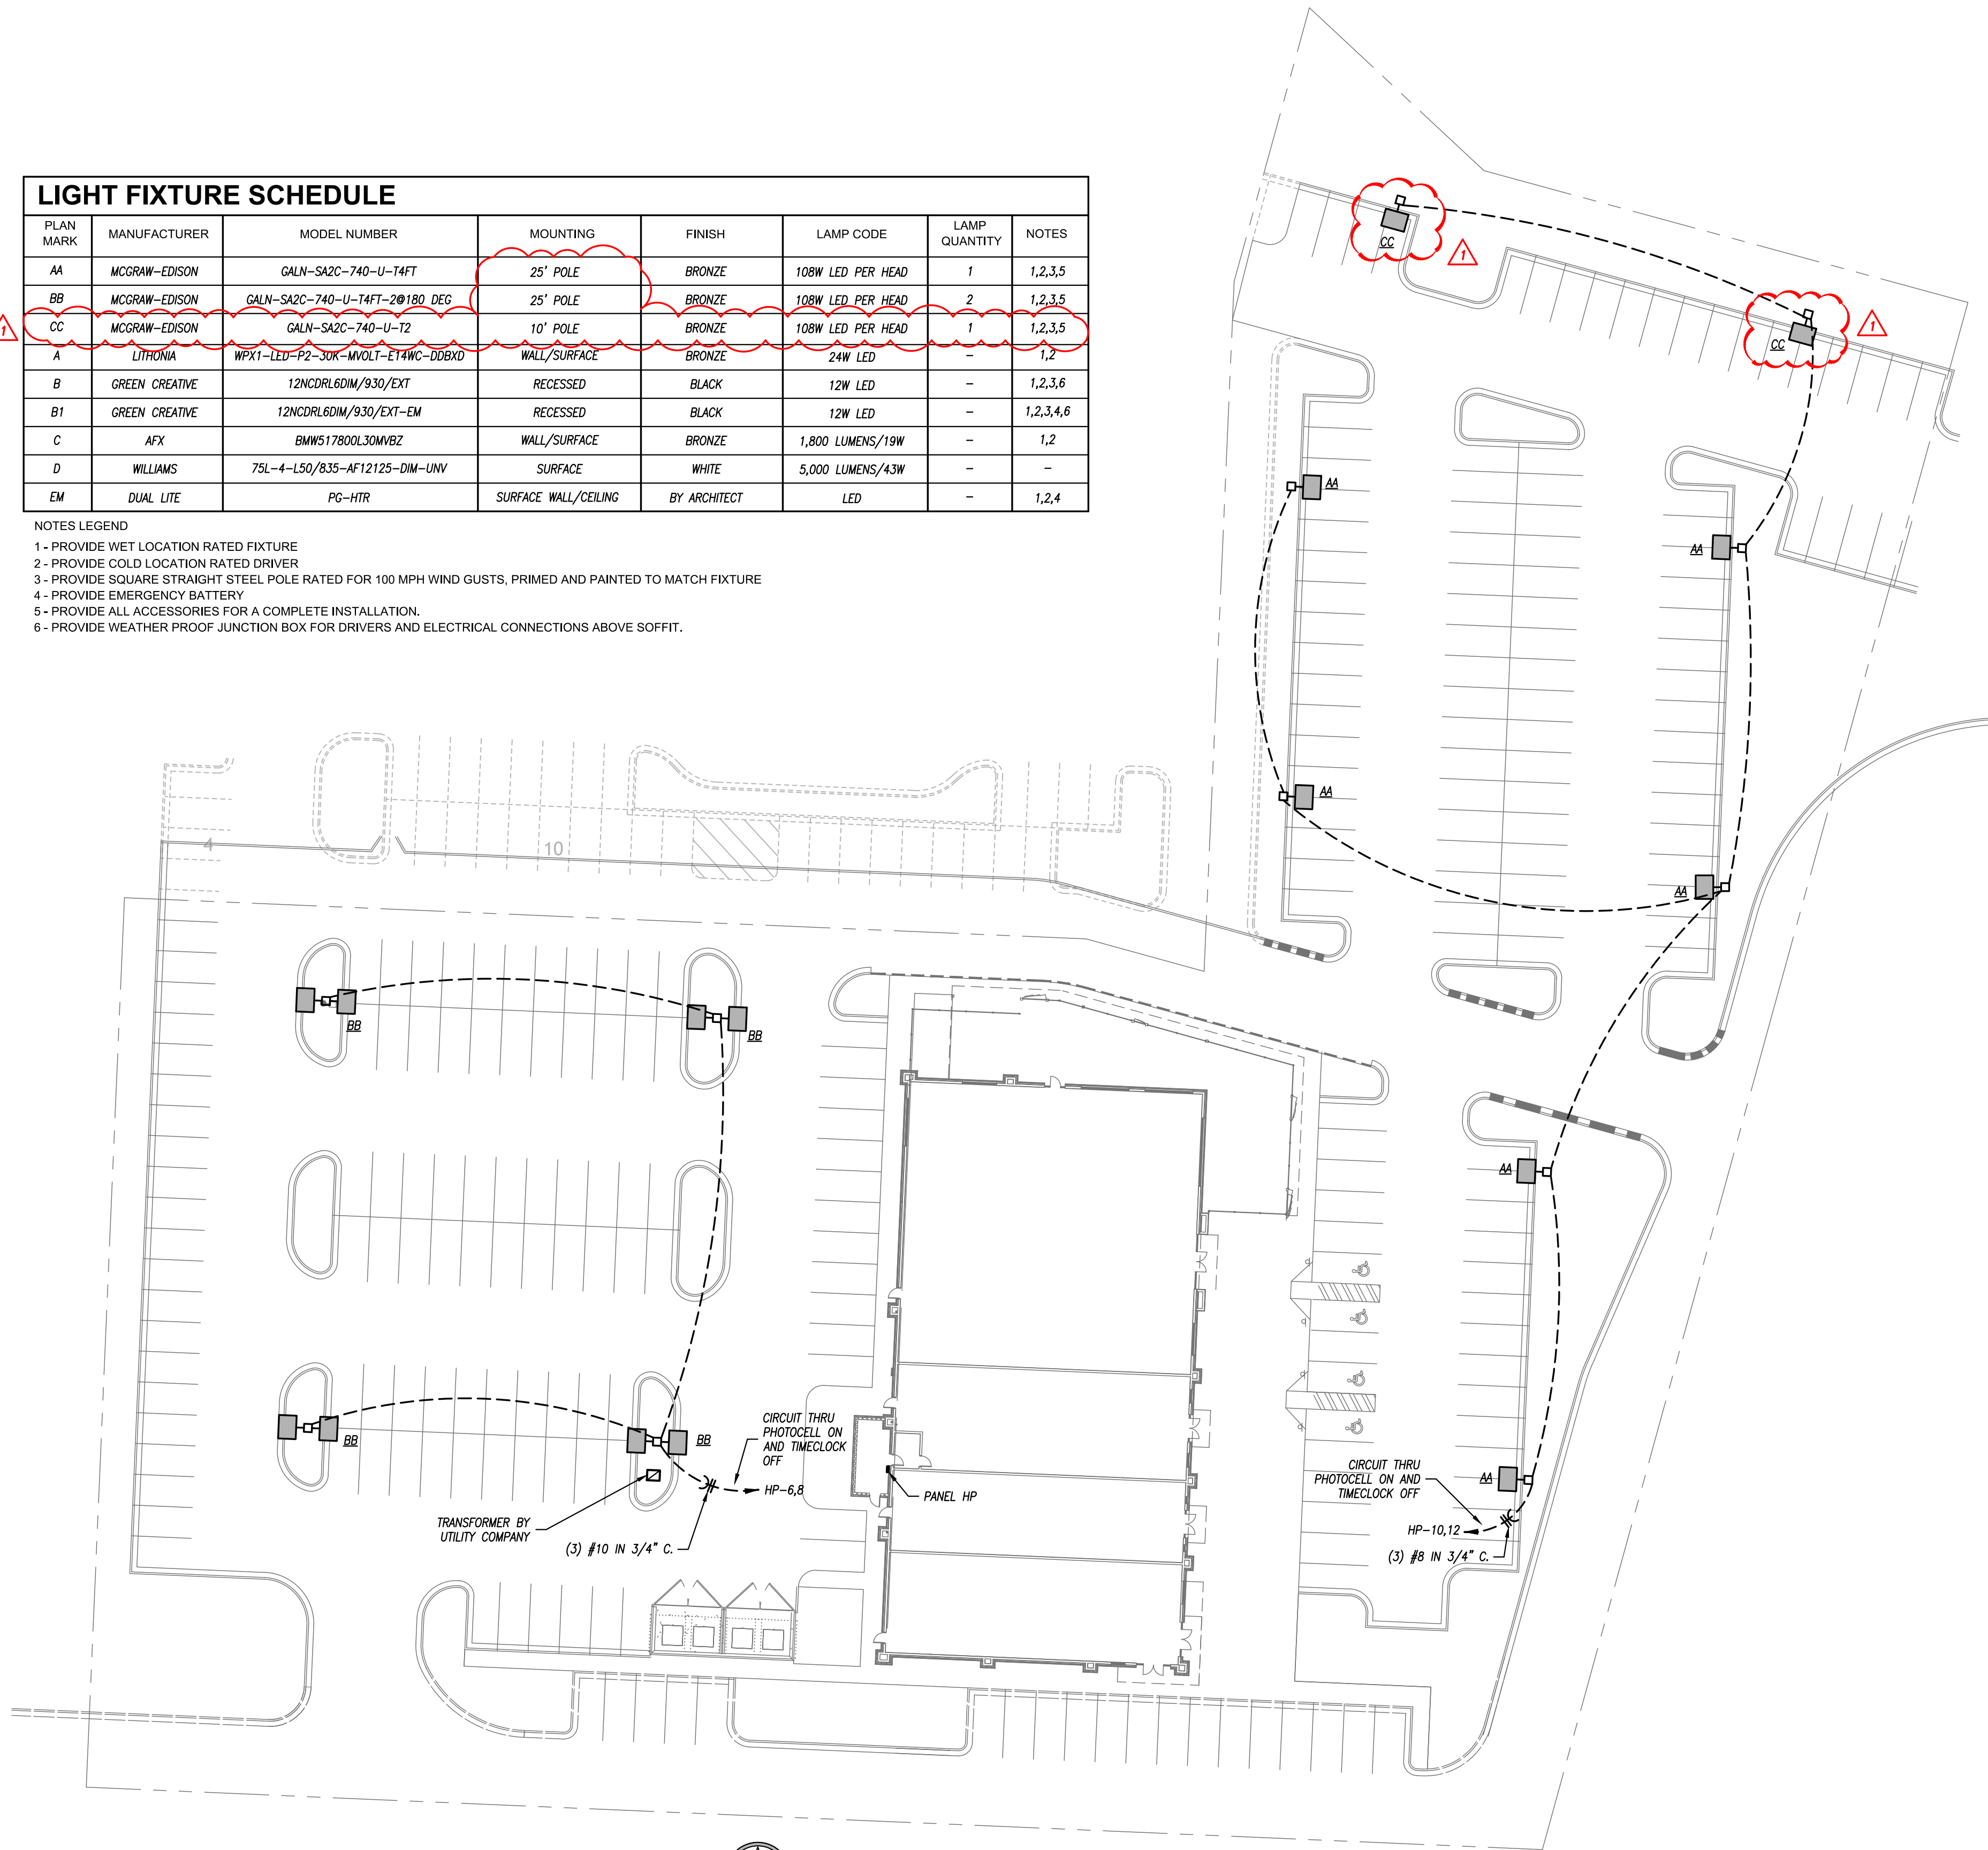

SITE PLAN - LIGHTING

1" = 30'-0"



schwerdt design group

architecture|interiors|planning

2231 sw wanamaker rd suite 303
topeka, kansas 66614-4275
phone: 785.273.7540
fax: 785.273.7579

500 north broadway suite 200
oklahoma city, ok 73102
phone: 405.231.3105
fax: 405.231.3115



Bryan Leinwetter - Engineer
MOR PE-2020020297


**CORE & SHELL BUILDING
STREETS OF WEST PRYOR LOT 13
LEES SUMMIT, MISSOURI**

SUBMISSION DATES
DECEMBER 27, 2023
JANUARY 19, 2024

SHEET TITLE
SITE PHOTOMETRIC
PLAN

PROJECT NUMBER
235008

SHEET NUMBER
E-203

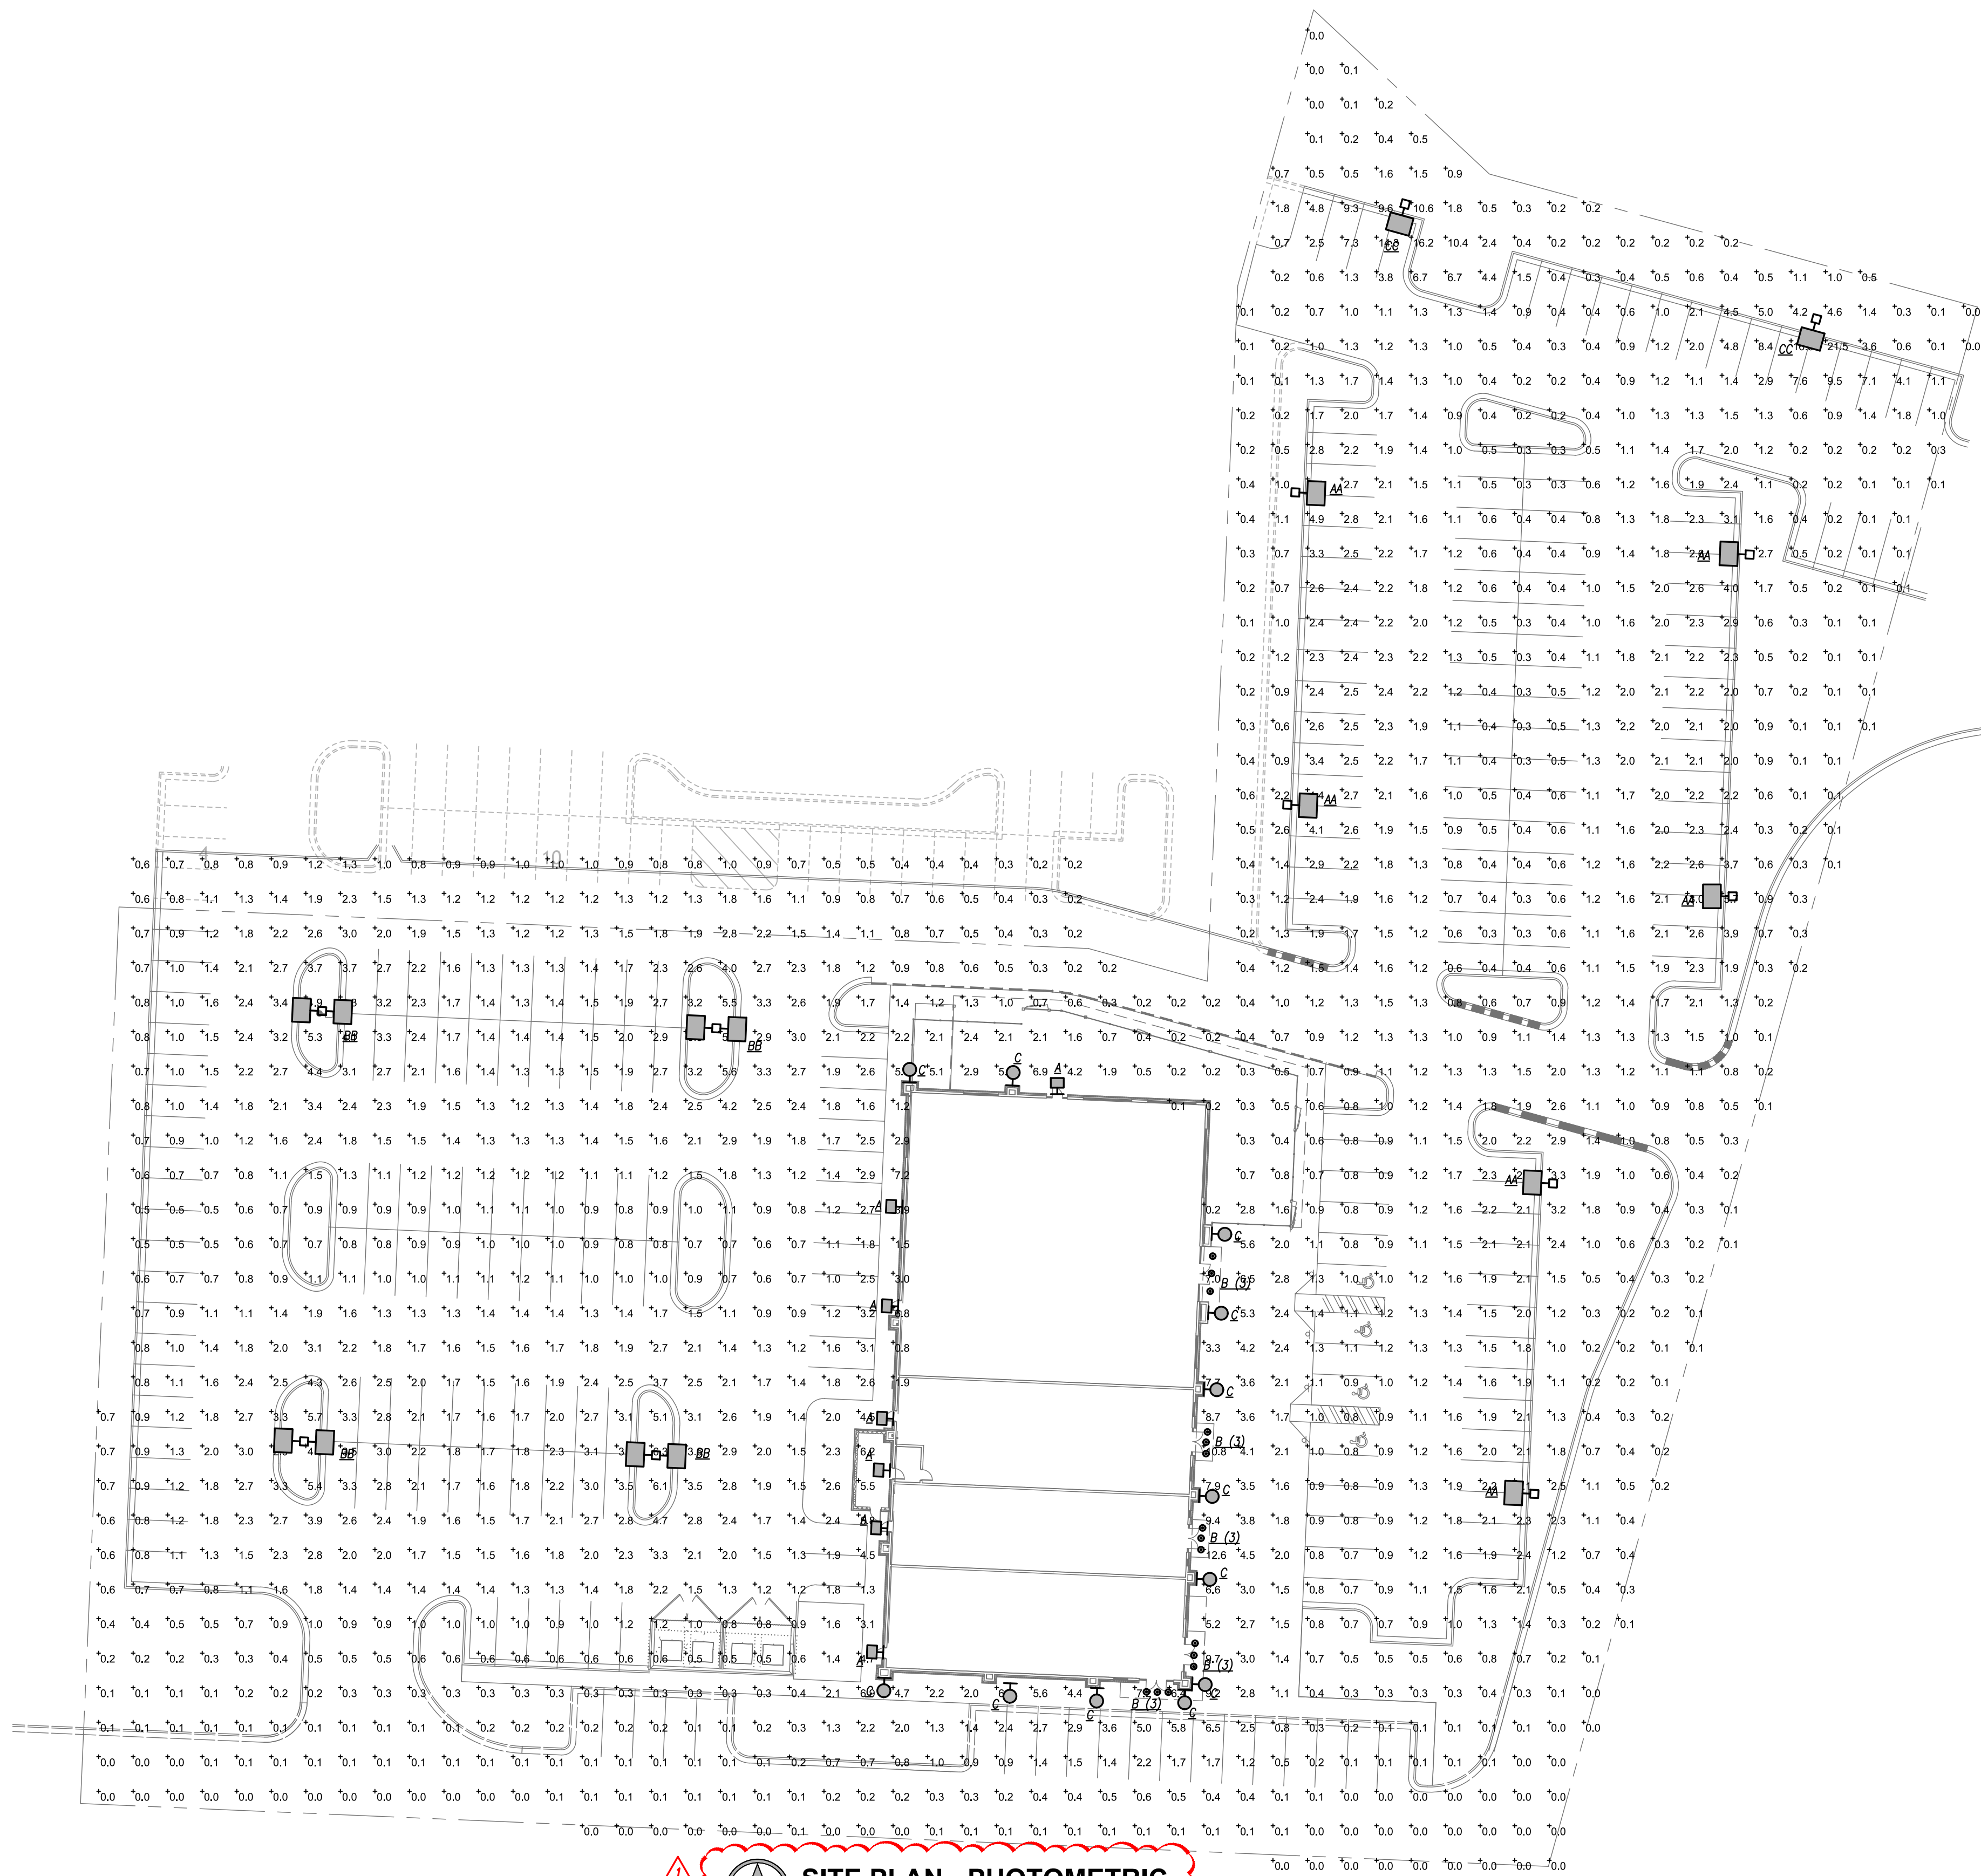

SITE PLAN - PHOTOMETRIC
1" = 30'-0"



PEARSON KENT MCKINLEY RAAF ENGINEERS LLC
2949 SW WANAMAKER DR., TOPEKA, KANSAS 66614
785.273.2447 WWW.PKMR.ENG.COM