

10'-0" CEILING
8'-0" TALL MAIN LEVEL DOORS
MAIN LEVEL
SCALE: 1/4" = 1'-0"

MAIN LEVEL: 2185 SQ. FT.
LOWER LEVEL: 1417 SQ. FT.
TOTAL: 3602 SQ. FT.


GARAGE: 700 SQ. FT.
COV. OUT/LIV: 239 SQ. FT.
UNFIN. BASEMENT: 576 SQ. FT.

JOIST SCHEDULE	
D	2' X 6' #2 CEILING JOIST @ 16' O.C.

0.8-29 ***** = WALL BRACING PER FRAMING NOTE #1
AND PER CALCULATIONS ON SHEET S.I.1.

FRAMING NOTES

1. BASEMENT LEVEL EXTERIOR WOOD-FRAMED WALLS SHALL BE SIZED AT 7/16" DISC APA RAYS. 8" BAY COMMON WALLS, 4" OR AT EACHES 6" 12" IN THE FIELD. SMART PANEL, OR EQUIV. INSTALLED PER MANUFACTURER'S RECOMMENDATIONS.
2. 2" X 4" X 1 1/4" L-GIRTS MAX. GYPSUM BOARD OVER STUDS SPACED 24" MAX FASTENED W/ 16 D - 1 1/4" TYPE S OR S-EQUALS. SCORP 3/8" X 4" DISC. A FIELD OR MIN. 4'0" SECTIONS END OF WALL OR MIN. 4'0" SECTION FOR BOTH SIDES
3. /XXXXXXXXXXXX/ FOR EXTERIOR INTERIOR WALL.
4. 2" X 4" 12" R HEADERS AT ALL EXTERIOR AND INTERIOR BEARING WALLS UNLESS OTHERWISE
5. 10M TIES 3/4" X 4" DISC (TYPICAL)
6. RUN STUDS TO FULL HEIGHT OF RAISED PLATE WALLS
7. BLOCK STUDS ABOVE BEAMS, CANTILEVERS AND 1-JUSTED STUDS WITH JUSTS INTERMITTENTLY REINFORCED WITH 1-JUSTED.
8. PROVIDE 1" TYPE STUDS FOR SLOID BEARING WALLS WITH BEAMS. BEAMS SHALL BE 2" X 4" MAX. SHALL HAVE DOUBLE KING STUDS AT END AND JOINTS UNIFORM
9. ALL UNDOORSE WALLS SHALL BE 4IN. UNLESS NOTED OTHERWISE
10. ALL WALLS TO BE FRAMED W/ MIN. STUDS 2" X 4'S 8' 16" DISC, UNLESS NOTED OTHERWISE
11. 1/2" X 4" ANCHOR BOLTS W/ 1/2" EMBEDMENT 8' 48" DISC. MAX. & VERTICAL 2' 4" OF END OF EACH PLATE LEVEL
12. 1/4" DISC. STUDS ON PLAYS MAY BE REPLACED WITH 3/4" OF 1/4" X 4" GULAM BEAMS OF THE SAME DEPTH, AND THE FOLLOWING W/OUT
13. 1/4" LVL PILES 1" X 3/4" GULAM
14. 3/4" LVL PILES 1" X 3/4" GULAM
15. A NEW FOUNDATION SHALL BEAR ON ORIGINAL SOIL, WITH MINIMUM BEARING CAPACITY OF 1500 PSF. A GEOTECHNICAL ENGINEER IS RECOMMENDED FOR VERIFICATION OF THESE CONDITIONS. UNDER THE EXCAVATION PHASE, ENGINEER OF RECORD ASSUMES NO RESPONSIBILITY FOR CONSTRUCTION NOT VERIFIED TO BE FOUND ON ANYTHING BUT THE MINIMUM REQUIRED REQUIREMENTS.
16. CONTRACTOR SHALL NOTIFY ENGINEER OF RECORD BEFORE CONSTRUCTION OF ANY DEFLECTION LIMITATIONS MORE STRINGENT THAN CODE MINIMUMS ARE AND PENALTIES.

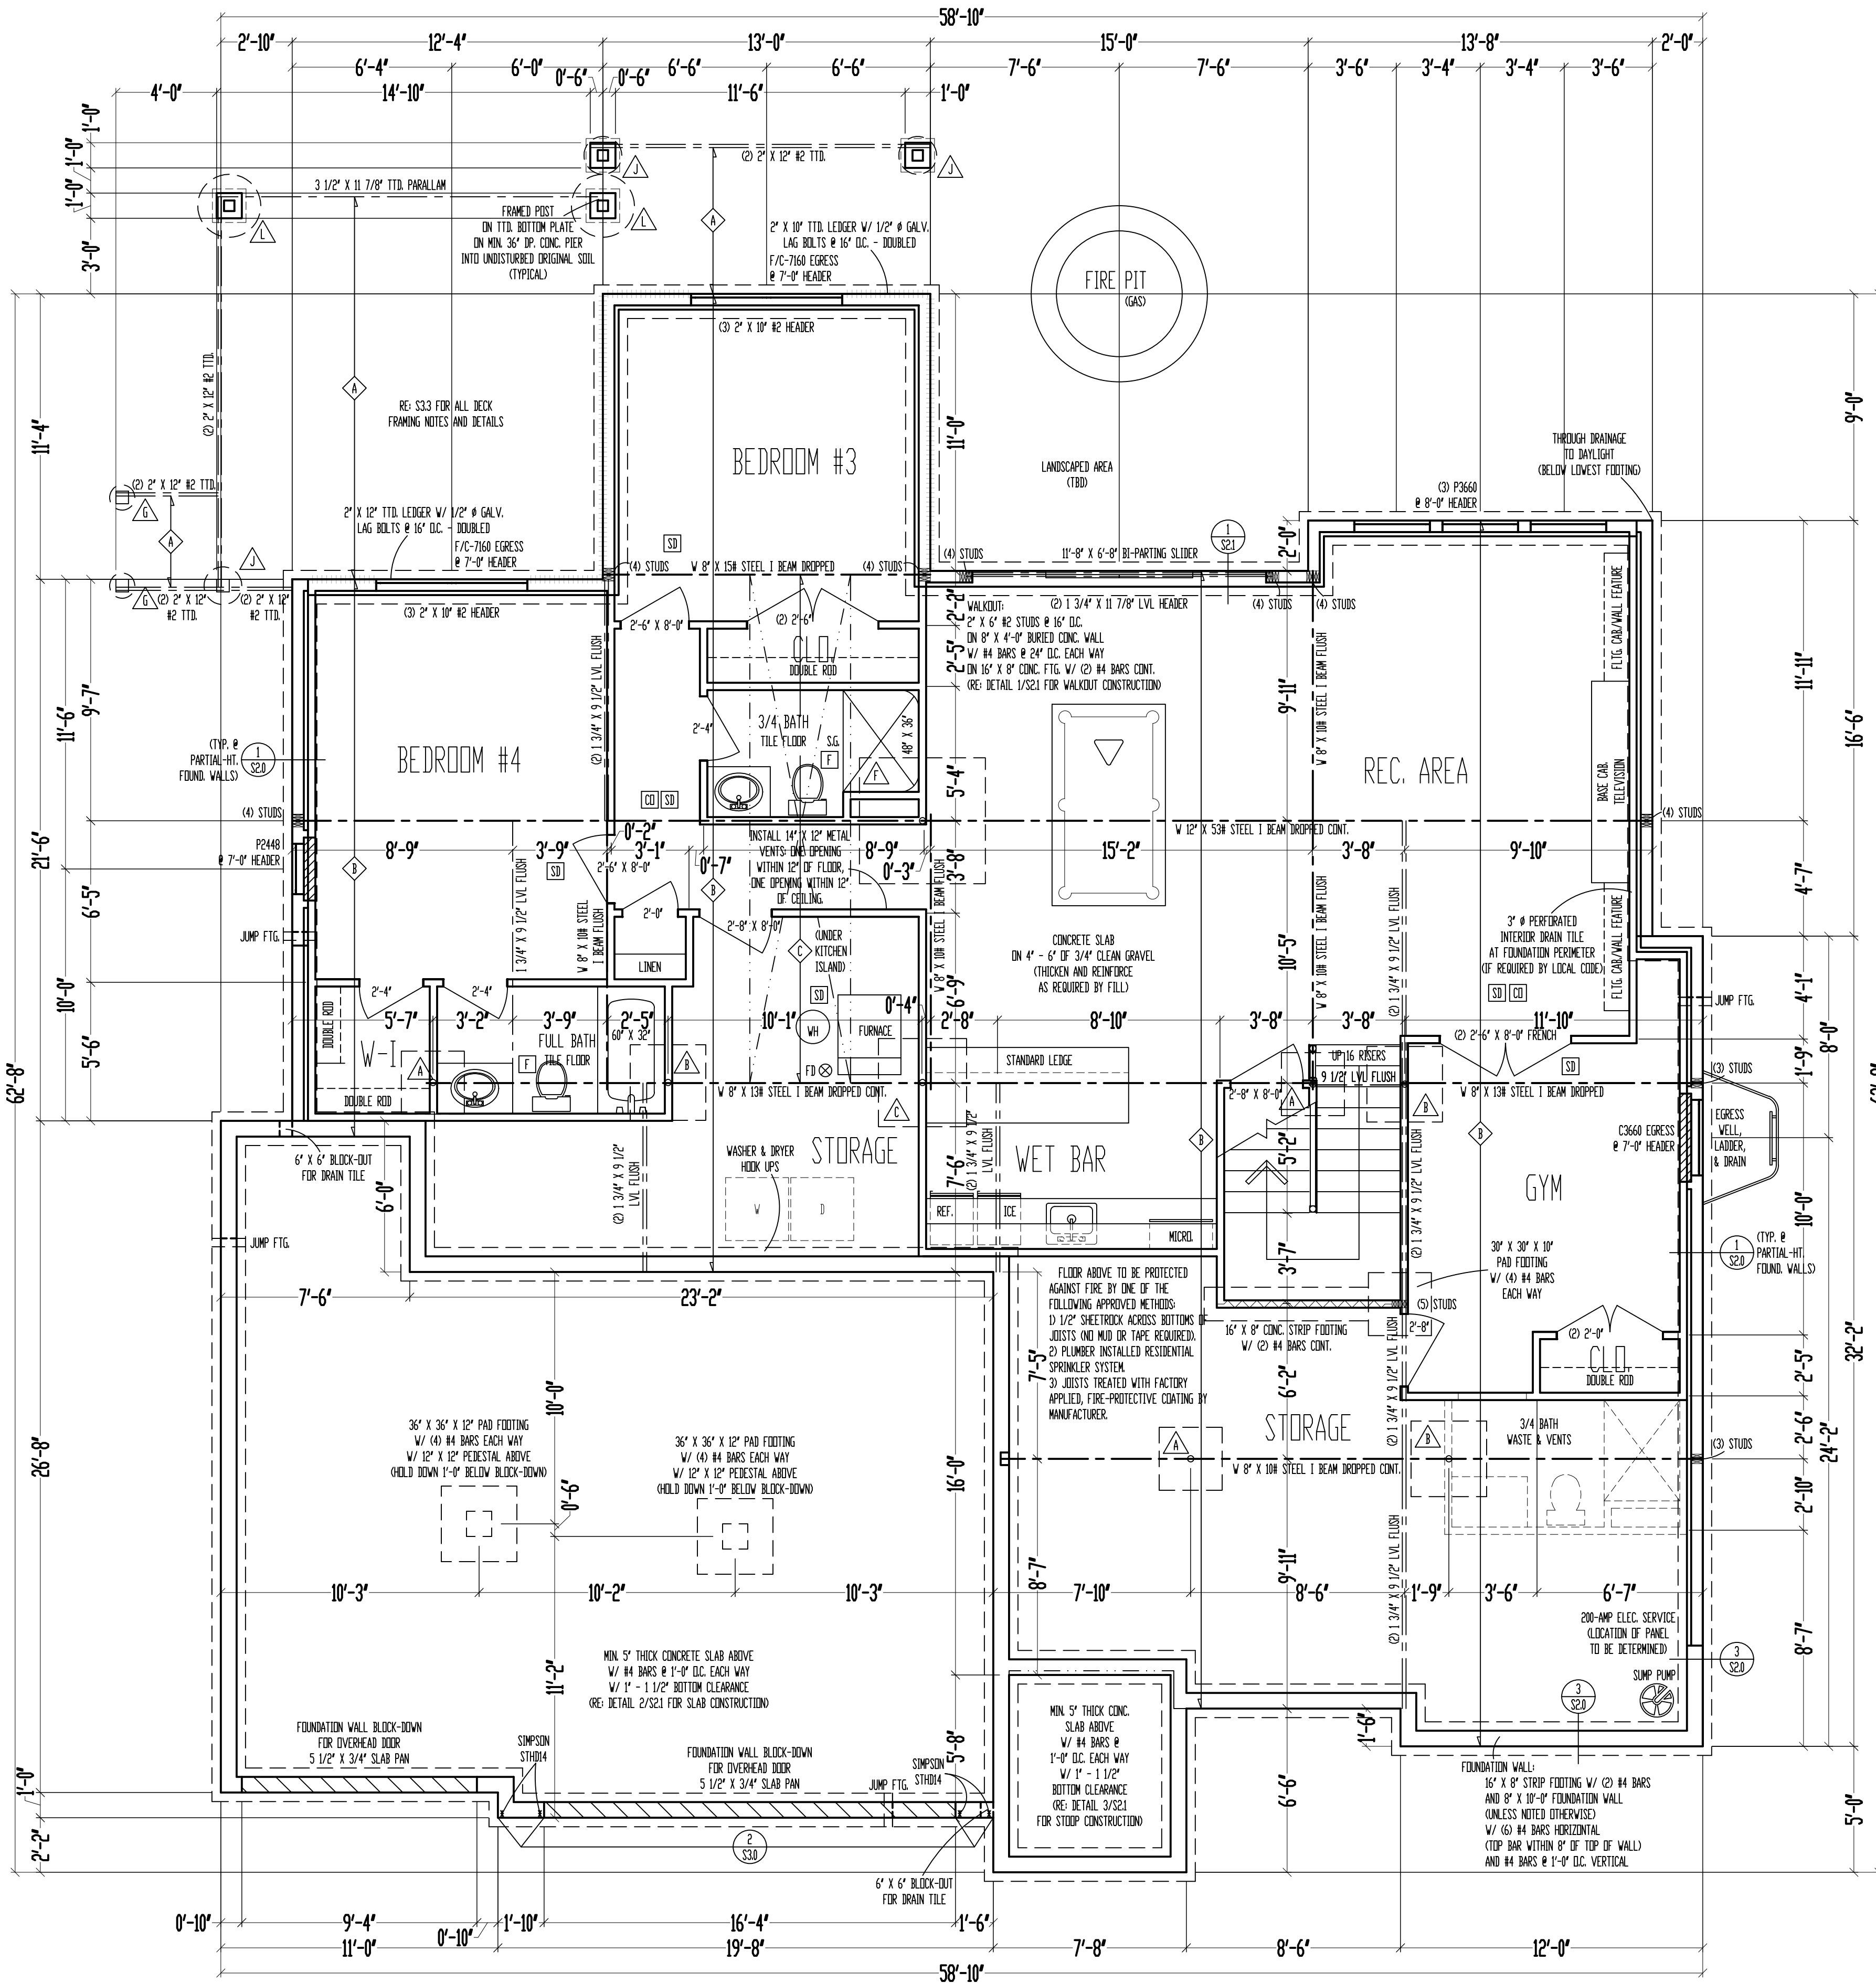

9'-0" FOUNDATION WALLS
(UNLESS NOTED OTHERWISE)
ON 16" X 8" STRIP FOOTINGS
(STEP WHERE GRADE REQUIRES)

9 1/2" I-JOIST
FLOOR SYSTEM ABOVE
2" X 6" EXT. WALLS
FOUNDATION
SCALE: 1/4" = 1'-0"

***** WALL BRACING PER FRAMING
NOTE #1 AND PER CALCULATIONS ON SHEET SLL

- FRAMING NOTES:
1. BASEMENT LEVEL EXTERIOR WOOD-FRAMED WALLS SHALL BE SHEATHED W/ 7/16" OSB. APA PANELS W/ 84 COMMON NAILS @ 6" O.C. AT EDGES & @ 12" O.C. IN THE FIELD. SMART PANEL, OR EQUAL, INSTALLED PER MANUFACTURER'S SPECIFICATIONS.
 2. 1/4" MIN. GYPSUM BOARD OVER STUDS SPACED 24" MAX. FASTENED W/ NO. 6 - 1 1/4" TYPE W OR S DRYWALL SCREWS @ 7" O.C. EDGES & FIELD. MIN. 8'-0" SECTIONS ONE SIDE OF WALL OR MIN. 4'-0" SECTION FOR BOTH SIDES.
 3. 1/4" MIN. GYPSUM BOARD OVER STUDS SPACED 24" MAX. FASTENED W/ NO. 6 - 1 1/4" TYPE W OR S DRYWALL SCREWS @ 7" O.C. EDGES & FIELD. MIN. 8'-0" SECTIONS ONE SIDE OF WALL OR MIN. 4'-0" SECTION FOR BOTH SIDES.
 4. (2) 2" X 10" #2 HEADER AT ALL EXTERIOR AND LOAD BEARING WALLS, UNLESS NOTED OTHERWISE.
 5. LVL'S @ 4'-0" O.C. (TYPICAL).
 6. RUN STUDS THE FULL HEIGHT OF RAISED PLATE WALLS.
 7. BLOCK JOISTS ABOVE BEAMS, CANTILEVERS AND LOAD BEARING WALLS WITH JOIST MATERIAL ONIT REQUIRED WITH I-JOISTS.
 8. PROVIDE MULTIPLE STUDS FOR SOLID BEARING BELOW ALL BEAMS.
 9. ALL DESIGNATED 2" X 6" WALLS SHALL HAVE DOUBLE KING STUDS AT DOOR AND WINDOW OPENINGS.
 10. ALL UNSURE WALLS SHALL BE 45", UNLESS NOTED OTHERWISE.
 11. ALL WALLS TO BE FRAMED W/ MIN. STUD GRADE 2" X 4'S @ 16" O.C. UNLESS NOTED OTHERWISE.
 12. 1/2" #4 ANCHOR BOLTS W/ MIN. 7" EMBEDMENT @ 48" O.C. MAX. & WITHIN 6" - 12" OF END OF EACH PLATE LENGTH.
 13. LVL'S SHOWN ON PLANS MAY BE REPLACED WITH 10" OF GRADE 24F-V4 GLULAM BEAMS OF THE SAME DEPTH, AND THE FOLLOWING WIDTHS:
(2) 1 3/4" LVL PLIES = 3 1/2" GLULAM
(2) 1 3/4" LVL PLIES = 5 1/2" GLULAM
 14. NEW FOUNDATION SHALL BEAR ON ORIGINAL SOIL WITH MINIMUM BEARING CAPACITY OF 1500 PSF. A GEOTECHNICAL ENGINEER IS RECOMMENDED FOR VERIFICATION OF THESE CONDITIONS DURING THE EXCAVATION PHASE. ENGINEER OF RECORD ASSUMES NO RESPONSIBILITY FOR CONSTRUCTION NOT VERIFIED TO BE FOUND ON ANYTHING SHORT OF THE ABOVEMENTIONED REQUIREMENTS.
 15. CONTRACTOR SHALL NOTIFY ENGINEER OF RECORD BEFORE CONSTRUCTION OF ANY DEFLECTION LIMITATIONS MORE STRINGENT THAN CODE MINIMUMS ABOVE ANY OPENINGS.

STEEL COLUMN & PAD FOOTING SCHEDULE	
△	3" X 11 GA. STEEL COLUMN ON 36" X 36" X 10" PAD FOOTING W/ (4) #4 BARS EACH WAY (2530)
△	3 1/2" X 11 GA. STEEL COLUMN ON 36" X 36" X 10" PAD FOOTING W/ (4) #4 BARS EACH WAY (2530)
△	2" SCH. 40 STEEL COLUMN ON 42" X 42" X 12" PAD FOOTING W/ (6) #4 BARS EACH WAY (2450)
△	3 1/2" SCH. 40 STEEL COLUMN ON 48" X 48" X 12" PAD FOOTING W/ (6) #4 BARS EACH WAY (2450)
△	3 1/2" SCH. 40 STEEL COLUMN ON 54" X 54" X 14" PAD FOOTING W/ (7) #4 BARS EACH WAY (4050)
△	3 1/2" SCH. 40 STEEL COLUMN ON 60" X 60" X 14" PAD FOOTING W/ (8) #4 BARS EACH WAY (5080)

PIER FOOTING SCHEDULE	
△	12" # PIER FTG.
△	16" # PIER FTG.
△	18" # PIER FTG.
△	24" # PIER FTG.
△	30" # PIER FTG.

JOIST SCHEDULE	
◇	2" X 12" #2 TTD FLOOR JOIST @ 16" O.C.
◇	9 1/2" LPI-20 FLOOR JOIST @ 16" O.C. CONT.
◇	9 1/2" LPI-20 FLOOR JOIST @ 12" O.C. CONT.

These plans and specifications are protected under federal copyright laws.
Copyright © 2024 Viewpoint Residential Design, LLC.
Care and effort have gone into the creation and design of this plan. However, the user of these plans assumes all responsibility for any damages, injuries, or losses that may result from the use of these plans. The Designer does not warrant the suitability of these plans for use on your specific site. Consult your architect to determine the suitability of these plans for your specific site and application.

"For God so loved the world, that he gave his only begotten Son, that whosoever believeth in him should not perish, but have everlasting life." (John 3:16)

VIEWPOINT
RESIDENTIAL DESIGN LLC
Office: (816) 554-0400
Email: jleifer@viewpointdesign.net

Site Description:
Lot 10, Woodland Oaks
Street Address:
2528 NE Woodland Oak Cir.,
Lee's Summit, Missouri

Designed for:
Nate & Susanna WEGNER
General Contractor:
Walker Custom Homes, LLC



Date: 2-2-AD 2024
Rev. 1:
Rev. 2:
Rev. 3:

Sheet Title:
FOUNDATION PLAN

Sheet No.:
A-4 of 4

FASTENER SCHEDULE FOR STRUCTURAL MEMBERS		
DESCRIPTION OF BUILDING ELEMENTS	NUMBER AND TYPE OF FASTENER	SPACING AND LOCATION
ROOF ¹		
BLOCKING BETWEEN JOISTS OR RAFTERS TO TOP PLATE, TOE NAIL	4-8d (2½" x 0.113")	TOENAIL
CEILING JOISTS TO PLATE, TOE NAIL	4-8d (2½" x 0.113")	PER JOIST, TOENAIL
CEILING JOISTS NOT ATTACHED TO PARALLEL RAFTER, LAPS OVER PARTITIONS, FACE NAIL	4-10d (3" x 0.128")	FACE NAIL
CEILING JOIST TO PARALLEL RAFTER (HEEL JOINT)	TBLE R802.5.2	FACE NAIL
COLLAR TIE TO RAFTER, FACE NAIL OR 1 ½" x 20 GA. RIDGE STRAP TO RAFTER	4-10d (3" x 0.128")	FACE NAIL, EACH RAFTER
RAFTER OR ROOF TRUSS TO PLATE	3-16d BOX NAILS (3½" x 0.135") OR 3-10d COMMON NAILS (3" x 0.148")	2 TOE NAILS ON ONE SIDE AND 1 TOE NAIL ON OPPOSITE SIDE OF EACH RAFTER OR TRUSS
ROOF RAFTERS TO RIDGE, VALLEY, OR HIP RAFTERS OR ROOF RAFTER TO MINIMUM 2" RIDGE BEAM	4-16d (3 ½" x 0.135") - TOENAIL; 3-16d BOX (3 ½" x 0.135") - END NAIL	TOENAIL, END NAIL
WALL		
STUD TO STUD (NOT AT BRACED WALL PANELS)	10d (3" x 0.128")	16" O.C. FACE NAIL
STUD TO STUD AND ABUTTING STUDS AT INTERSECTING WALL CORNERS (AT BRACED WALL PANELS)	16d (3½" x 0.135")	12" O.C. FACE NAIL
BUILT-UP HEADER, TWO PIECES WITH ½" SPACER	16d (3½" x 0.135")	12" O.C. EACH EDGE FACE NAIL
CONTINUOUS HEADER TO STUD	4-8d (2½" x 0.131")	TOENAIL
TOP PLATE TO TOP PLATE	10d (3" x 0.128")	12" O.C. FACE NAIL
DOUBLE TOP PLATE SPLICE	8-16d COMMON (3 ½" x 0.162")	FACE NAIL ON EACH SIDE OF END JOINT (MIN. 24" LAP SPLICE LENGTH EACH SIDE OF END JOINT)
BOTTOM PLATE TO JOIST, RIM JOIST, BAND JOIST, OR BLOCKING (NOT AT BRACED WALL PANELS)	16d COMMON (3 ½" x 0.162")	16" O.C. FACE NAIL
BOTTOM PLATE TO JOIST, RIM JOIST, BAND JOIST, OR BLOCKING (AT BRACED WALL PANEL)	3-16d BOX (3 ½" x 0.135")	3 EACH 16" O.C. FACE NAIL
TOP OR SOLE PLATE TO STUD, END NAIL	4-8d BOX (2 ½" x 0.113") - TOENAIL; 3-16d BOX (3 ½" x 0.135") - END NAIL	TOENAIL, END NAIL (SEE LEFT)
TOP PLATES, LAPS AT CORNERS AND INTERSECTIONS	3-10d BOX (3" x 0.128")	FACE NAIL
1" BRACE TO EACH STUD AND PLATE	3-8d BOX (2 ½" x 0.113")	FACE NAIL
1"x6" SHEATHING TO EACH BEARING	3-8d BOX (2 ½" x 0.113")	FACE NAIL
1"x8" SHEATHING TO EACH BEARING	3-8d BOX (2 ½" x 0.113") - FACE NAIL; WIDER THAN 1"x8" - 4-8d BOX (2 ½" x 0.113")	FACE NAIL
FLOOR		
JOIST TO SILL, TOP PLATE, OR GIRDER	4-8d BOX (2 ½" x 0.113")	TOE NAIL
RIM JOIST, BAND JOIST, OR BLOCKING TO SILL OR TOP PLATE (ROOF APPLICATIONS ALSO)	8d BOX (2 ½" x 0.113")	4" O.C. TOE NAIL
1" x 6" SUBFLOOR OR LESS TO EACH JOIST	3-8d BOX (2 ½" x 0.113")	FACE NAIL
2" SUBFLOOR TO JOIST OR GIRDER	3-16d BOX (3 ½" x 0.135")	BLIND AND FACE NAIL
2" PLANKS (PLAN & BEAM - FLOOR AND ROOF)	3-16d BOX (3 ½" x 0.135")	AT EACH BEARING, FACE NAIL
BAND OR RIM JOIST TO JOIST	3-16d COMMON (3 ½" x 0.162")	END NAIL
BUILT-UP GIRDERS AND BEAMS, 2-INCH LUMBER LAYERS	10d BOX (3" x 0.128")	24" O.C. FACE NAIL AT TOP AND BOTTOM STAGGERED ON OPPOSITE SIDES
LEDGER STRIP SUPPORTING JOISTS OR RAFTERS	4-16d BOX (3 ½" x 0.135")	AT EACH JOIST OR RAFTER, FACE NAIL
BRIDGING OR BLOCKING TO JOIST	2-10d BOX (3" x 0.128")	EACH END, TOENAIL

FASTENER SCHEDULE FOR STRUCTURAL MEMBERS			
DESCRIPTION OF BUILDING MATERIALS	DESCRIPTION OF FASTENER	EDGE SPACING (INCHES)	INTERMEDIATE SUPPORTS (INCHES)
WOOD STRUCTURAL PANELS, SUBFLOOR, ROOF AND INTERIOR WALL SHEATHING TO FRAMING AND PARTICLEBOARD WALL SHEATHING TO FRAMING			
¾" - ⅝"	6d COMMON (2" x 0.113") NAIL (SUBFLOOR, WALL) 8d COMMON NAIL (ROOF)	6	12
⅞" - 1"	8d COMMON NAIL (2½" x 0.131")	6	12
1½" - 1⅝"	10d COMMON (3" x 0.148") NAIL OR 8d (2½" x 0.131") DEFORMED NAIL	6	12
OTHER WALL SHEATHING ¹			
½" STRUCTURAL CELLULOSIC FIBERBOARD SHEATHING	1 ½" GALVANIZED ROOFING NAIL, ½" HEAD DIAMETER, OR 1 ½" LONG 16 GA. STAPLE WITH ½" OR 1" CROWN	3	6
⅝" STRUCTURAL CELLULOSIC FIBERBOARD SHEATHING	1 ½" GALVANIZED ROOFING NAIL, ½" HEAD DIAMETER, OR 1 ½" LONG 16 GA. STAPLE WITH ½" OR 1" CROWN	3	6
½" GYPSUM SHEATHING	1½" GALVANIZED ROOFING NAIL; STAPLE GALVANIZED, 1½" LONG; 1½" SCREWS, TYPE W OR S	7	7
¾" GYPSUM SHEATHING	1½" GALVANIZED ROOFING NAIL; STAPLE GALVANIZED, 1½" LONG; 1½" SCREWS, TYPE W OR S	7	7
WOOD STRUCTURAL PANELS, COMBINATION SUBFLOOR UNDERLAYMENT TO FRAMING			
¾" AND LESS	8d DEFORMED (2" x 0.120") NAIL OR 8d COMMON (2½" x 0.131") NAIL	6	12
¾" - 1"	8d COMMON (2½" x 0.131") NAIL OR 8d DEFORMED (2½" x 0.120") NAIL	6	12
1½" - 1⅝"	10d COMMON (3" x 0.148") NAIL OR 8d DEFORMED (2½" x 0.120") NAIL	6	12

1. IF INFORMATION LISTED ON PLAN SHEETS CONTRADICTS INFORMATION IN THIS TABLE, INFORMATION ON PLANS TAKES PRECEDENCE OVER INFORMATION LISTED IN THIS TABLE

FOUNDATION NOTES

- CONCRETE SHALL BE AIR-ENTRAINED BETWEEN 5%-7% WITH A MINIMUM 28-DAY COMPRESSIVE STRENGTH OF 2500 PSI FOR BASEMENT AND INTERIOR FLOOR SLABS-ON-GRADE, 3000 PSI FOR FOUNDATION WALLS, AND 3500 PSI FOR PORCHES AND GARAGE FLOOR SLABS.
- THE FOUNDATION DESIGN SHALL COMPLY WITH THE ENFORCING JURISDICTIONS RESIDENTIAL FOUNDATION STANDARDS
- PROVIDE A MINIMUM 4"-DIAMETER PERFORATED DRAIN PIPE ALONG PERIMETER OF USABLE SPACE AT FOOTING LEVEL OR OTHER EQUIVALENT MATERIALS PER IRC SECTION R405.1. THE PIPE SHALL BE COVERED WITH A MINIMUM OF 6" OF GRAVEL OR CRUSHED ROCK. THE DRAIN SHALL DAYLIGHT BELOW FOOTING LEVEL OR TERMINATE IN A MINIMUM 20 GALLON SUMP PIT.
- FOUNDATION SHALL BE DESIGNED FOR A BEARING CAPACITY OF 1500 PSF AND FOUNDED ON COMPETENT ORIGINAL SOIL AS DETERMINED AND CONFIRMED BY A LICENSED GEOTECHNICAL ENGINEER OR ENGINEERING GEOLOGIST. ENGINEER OF RECORD ASSUMES NO RESPONSIBILITY FOR CONSTRUCTION NOT VERIFIED TO BE FOUNDED ON ANY SOIL WITH THE FOREMENTIONED MINIMUM PROPERTIES.
- FOOTINGS SHALL BE A MINIMUM OF 16" WIDE x 8" DEEP AND SHALL HAVE A MINIMUM OF (2) CONTINUOUS GRADE 40 #4 BARS WITH 3" BOTTOM CLEARANCE. BOTTOM OF FOOTING SHALL BE LOCATED A MINIMUM OF 3'-0" BELOW GRADE FOR FROST PROTECTION.
- CONCRETE PADS SUPPORTING COLUMN LOADS SHALL BE NO SMALLER THAN 2'-0" x 2'-0" x 1'-0" DEEP WITH A MINIMUM OF (4) GRADE 40 #4 BARS EACH WAY WITH 3" BOTTOM CLEARANCE.
- FOUNDATION WALLS SHALL BE A MINIMUM OF 8" NOMINAL WIDTH AND SHALL HAVE HOIZONTAL GRADE 40 #4 BARS AT 2'-0" O.C. MAX. WITH VERTICAL #4 BARS AS REQUIRED ON FOUNDATION CROSS SECTION ON SHEET S2.0
- REINFORCEMENT SHALL LAP A MINIMUM OF 2'-0" (CLASS B SPLICE)
- INTERIOR BEARING WALLS AND COLUMNS SHALL BE ISOLATED FROM THE BASEMENT FLOOR SLAB
- BASEMENT FLOOR SLAB SHALL BE A MINIMUM OF 4" THICK ON A MINIMUM BASE COURSE OF 4" TO 6" OF SAND, GRAVEL OR CRUSHED ROCK. BETWEEN THE BASE COURSE AND FLOOR SLAB SHALL BE PLACED A 6-MIL POLY VAPOR RETARDER WITH MINIMUM OVERLAP OF 6" AT DISCONTINUITIES
- IF A FLOOR IS TO BE SUPPORTED BY A MINIMUM OF 2'-0" OF GRANULAR FILL OR 8" OF EARTH, BASEMENT SLAB SHALL BE DESIGNED BY A LICENSED ENGINEER
- SILL PLATES SHALL BE ANCHORED TO THE FOUNDATION WALL WITH ½" Ø ANCHOR BOLTS EMBEDDED A MINIMUM OF 7" INTO CENTER OF WALL STEM AND SHALL BE INSTALLED AT A MAXIMUM OF 6'-0" O.C. (OR AS NOTED ON PLANS) AND SHALL BE INSTALLED WITHIN 6" TO 12" OF EACH END OF EACH SILL PLATE LENGTH, PER IRC SECTION R403.1.6
- FOUNDATION WINDOW WELLS SHALL BE PROVIDED WITH MINIMUM DIMENSIONS AS SHOWN IN DETAIL ON SHEET S2.0
- THE GARAGE FLOOR SHALL SLOPE TOWARD THE VEHICLE DOORS OR TO A TRENCH OR UNTRAPPED DRAIN THAT DISCHARGES TO THE EXTERIOR, ABOVE GRADE

FRAMING NOTES

- ALL DIMENSIONAL LUMBER SHALL BE DOUGLAS-FIR-LARCH GRADE #2, UNLESS NOTED OTHERWISE ON PLANS
- ALL INTERIOR LOAD-BEARING AND EXTERIOR WALL HEADERS SHALL BE (2) #2 - 2x10's, UNLESS NOTED OTHERWISE ON PLANS
- BLOCK OVER BEAMS AND AT CANTILEVERS AND DOOR JAMBS
- INTERIOR NON-BEARING WALLS RESTING ON BASEMENT SLAB SHALL BE ISOLATED FROM ABOVE FRAMING BY A MINIMUM OF ½"
- ALL HEADERS/BEAMS SHALL BEAR ON A MINIMUM OF (2) 2x4 POSTS (KING AND JACK STUDS), UNLESS NOTED OTHERWISE
- WHERE JOISTS SPAN PARALLEL TO FOUNDATION, BLOCKING SHALL BE PROVIDED IN THE TWO SPACES MOST ADJACENT TO THE FOUNDATION WALL AT 4'-0" O.C. FOR THE PURPOSE OF TRANSFERRING LATERAL FOUNDATION WALL LOAD TO THE FLOOR DIAPHRAGM. FASTEN JOISTS AND BLOCKING TO SILL PLATE WITH (4) 10d NAILS. IF MECHANICAL DUCTWORK IS INSTALLED IN ONE OF THESE FIRST TWO BAYS, FASTEN 2x4's FLAT AT 4'-0" O.C. BETWEEN JOIST(S) AND/OR SILL AND PROVIDE BLOCKING AS PRESCRIBED ABOVE IN THE NEXT TWO JOIST BAYS. SECURE 2x4's TO JOIST(S)/SILL PLATE WITH (4) 10d NAILS.
- ALL WOOD MATERIAL SUPPORTED ON CONCRETE OR MASONRY SHALL BE TREATED OR OF DECAY-RESISTANT MATERIAL
- JOISTS UNDER BEARING PARTITIONS ON PLANS HAVE BEEN SIZED TO SUPPORT THE DESIGN LOAD.
- JOISTS FRAMING INTO THE FACE OF A STEEL OR WOOD BEAM SHALL BE SUPPORTED WITH APPROPRIATE COLD-FORMED STEEL JOIST HANGERS
- JOISTS FRAMED ON TOP OF STRUCTURAL MEMBER SHALL BE SUPPORTED AT EN DS BY FULL-DEPTH SOLID BLOCKING MIN. 1½" IN THICKNESS OR BY FASTENING RIM TO JOISTS PER FASTENING TABLE TO LEFT
- ALL WALL COVERINGS SHALL COMPLY WITH IRC SECTION R702.3
- ALL RAFTERS AND COLLAR TIES SHALL COMPLY WITH IRC SECTION R802.3.
- ALL RAFTERS SHALL HAVE 2x4 COLLAR TIES @ 4'-0" O.C. IN UPPER ⅓ OF VERTICAL DISTANCE BETWEEN CEILING AND ROOF
- BLOCKING BETWEEN JOISTS UNDER A LOAD-BEARING WALL IS NOT REQUIRED
- PER IRC SECTION 501.3, BOTTOM OF ALL FLOOR ASSEMBLIES ABOVE UNFINISHED AREAS SHALL BE PROVIDED WITH A ½" GYPSUM BOARD MEMBRANE OR SPRINKLER SYSTEM WHEN FLOOR SYSTEM IS CONSTRUCTED OF OTHER THAN DIMENSION LUMBER OR STRUCTURAL COMPOSITE LUMBER EQUAL TO OR GREATER THAN 2x10 NOMINAL DIMENSION(WHERE REQUIRED BY ENFORCING JURISDICTION)
- ENGINEERED LVL's SHALL HAVE MINIMUM PROPERTIES OF Fb = 2600 psi, E=1900 ksi, AND Fv=285 psi
- ENGINEERED PARALLAMS SHALL HAVE MINIMUM PROPERTIES OF Fb = 2600 psi, E = 2000 ksi, AND Fv = 290 psi
- COLUMN CONNECTION TO STEEL BEAMS SHALL BE WITH A CLIP POST CAP WITH ALL FOUR TAB EARS BENT AROUND THE BOTTOM FLANGE OF THE BEAM. FOR A BEARING PLATE, FOUR HOLES SHALL BE DRILLED IN THE BOTTOM FLANGE OF THE STEEL BEAM TO MATCH THE HOLE PATTERN OF THE PLATE. ½" x 2" BOLTS SHALL THEN BE INSTALLED WITH A FLAT WASHER, LOCK WASHER, AND A NUT IN EACH OF THE HOLES. THE POST CAP MAY BE WELDED TO THE STEEL BEAM IN ACCORDANCE WITH AWS D1.1-92 AS AN ALTERNATIVE, AND WOULD NEED TO BE INSPECTED BY AN AWS-CERTIFIED INSPECTOR.
- WHEN MECHANICAL EQUIPMENT IS LOCATED IN AN ENCLOSED ROOM, THERE SHALL BE (2) 14"x12" VENTS LOCATED IN A WALL COMMON WITH ADDITIONAL LIVING AREA. ONE VENT SHALL BE LOCATED SUCH THAT THE BOTTOM OF THE VENT BEGINS 12" FROM THE FLOOR AND THE OTHER VENT SHALL BE LOCATED SUCH THAT THE TOP OF THE VENT BEGINS 12" FROM THE CEILING.
- ALL ROOF SHEATHING SHALL BE ⅝" OSB WITH 8d COMMON NAILS @ 6" O.C. AT PANEL EDGES AND @ 12" O.C. IN FIELD

GLAZING NOTES

- GLAZING IN HAZARDOUS LOCATIONS AS IDENTIFIED IN IRC SECTION R308.4 SHALL BE OF APPROVED SAFETY GLAZING MATERIALS. GLASS IN STORM DOORS, INDIVIDUAL FIXED OR OPENABLE PANELS ADJACENT TO A DOOR WHERE THE NEAREST VERTICAL EDGE IS WITHIN A 2'-0" ARC OF THE DOOR IN A CLOSED POSITION AND FOR WHICH THE BOTTOM EDGE IS WITHIN 5'-0" OF THE FLOOR, WALLS ENCLOSEING STAIRWAYS AND LANDINGS WHERE THE GLAZING IS WITHIN 5'-0" OF THE TOP OR BOTTOM OF THE STAIR ENCLOSEURES FOR SPAS, TUBS, SHOWERS, AND WHIRLPOLS, GLAZING IN FIXED OR OPENABLE PANELS EXCEEDING NINE SQUARE FEET AND FOR WHICH THE BOTTOM EDGE IS LESS THAN 1'-6" ABOVE THE FLOOR OR WALKING SURFACE WITHIN 3'-0".
- ALL OPERABLE WINDOWS SHALL HAVE FLAT PROTECTION PER IRC SECTION R612.2

ATTIC VENTILATION

- ENCLOSED ATTICS SHALL HAVE CROSS VENTILATION FOR EACH SEPARATE SPACE BY VENTILATING OPENINGS PROTECTED AGAINST THE ENTRANCE OF RAIN OR SNOW. VENTILATING OPENINGS SHALL BE PROVIDED WITH CORROSION-RESISTANT WIRE MESH, WITH ½" TO ¾" OPENINGS. THE TOTAL FREE VENTILATING AREA SHALL NOT BE LESS THAN ⅓ OF THE AREA OF SPACE VENTILATED, EXCEPT WHERE THE VENTILATORS ARE LOCATED IN THE UPPER PORTION OF THE SPACE TO BE VENTILATED - THE REQUIRED AREA MAY BE REDUCED TO 1/300.

EMERGENCY EGRESS

- PROVIDE A MINIMUM OF ONE WINDOW FOR EACH BEDROOM THAT HAS A MINIMUM OPENABLE AREA OF 5.7 SQUARE FEET WITH A MINIMUM OPENABLE HEIGHT OF 2'-0" AND A MINIMUM WIDTH OF 1'-9". IN ADDITION, THE OPENABLE PORTION OF EGRESS WINDOWS SHALL NOT EXCEED 3'-8" ABOVE THE ADJOINING FLOOR OR PERMANENT STEP.
- PROVIDE SMOKE ALARMS IN EACH SLEEPING ROOM, OUTSIDE OF EACH SLEEPING AREA AND ON EACH FLOOR, INCLUDING BASEMENT (IF APPLICABLE). ALARMS SHALL BE HARDWIRED TOGETHER SO THAT THE ACTIVATION OF ONE SMOKE ALARM WILL ACTIVATE ALL SMOKE ALARMS IN THE DWELLING. PROVIDE CARBON MONOXIDE DETECTORS OUTSIDE EACH SLEEPING AREA.

MASONRY VENEER

- MASONRY VENEER SHALL BE ANCHORED TO THE SUPPORTING WALL STUDS WITH CORROSION-RESISTANT METAL TIES EMBEDDED IN MORTAR OR GROUT AND EXTENDING INTO THE VENEER A MINIMUM OF 1½", WITH NOT LESS THAN ¾" MORTAR OR GROUT COVER TO OUTSIDE FACE.
- VEENER TIES, IF STRAND WIRE, SHALL NOT BE LESS IN THICKNESS THAN NO. 9 U.S. GAGE WIRE AND SHALL HAVE A HOOK EMBEDDED IN THE MORTAR JOINT, OR IF SHEET METAL, SHALL BE NOT LESS THAN NO. 22 U.S. GAGE BY ½" CORRUGATED.
- EACH TIE SHALL SUPPORT NOT MORE THAN 2.67 SQUARE FEET OF WALL AREA AND SHALL BE SPACED NOT MORE THAN 32 INCHES ON CENTER HORIZONTALLY AND 24 INCHES ON CENTER VERTICALLY.
- VEENER TIES AROUND WALL OPENINGS: ADDITIONAL METAL TIES SHALL BE PROVIDED AROUND ALL WALL OPENINGS GREATER THAN 16 INCHES IN EITHER DIMENSION. METAL TIES AROUND THE PERIMETER OF OPENINGS SHALL BE SPACED NOT MORE THAN 3 FEET ON CENTER AND PLACED WITHIN 12 INCHES OF THE WALL OPENING.

GARAGE NOTES

- DOOR(S) BETWEEN THE GARAGE AND DWELLING SHALL BE MINIMUM 1½" SOLID CORE OR HONEY-COMBED STEEL DOOR WITH 20-MINUTE FIRE RATING EQUIPPED WITH A SELF-CLOSING DEVICE
- VEHICLE DOORS AND FRAMES SHALL BE DESIGNED AND INSTALLED TO MEET THE 115-MPH 3-SECOND GUST LOADING PER DASHA 108 AND ASTM E 330-96 PER IRC 2018

MULTIPLE-PLY WOOD BEAM FASTENING SCHEDULE					
DIMENSIONAL LUMBER BEAM SIZE/TYPE	FASTENERS	LVL BEAM SIZE/TYPE	FASTENERS	LVL BEAM SIZE/TYPE	FASTENERS
(2) 2x	(2) ROWS 10d @ 12" O.C. ONE SIDE	(2) 1 ½" UP TO 11 ½" DEPTH	(2) ROWS 16d @ 12" O.C. ONE SIDE	(3) 1 ¾" x 14" DEPTH	(3) ROWS 16d @ 12" O.C. BOTH SIDES
(3) 2x	(2) ROWS 10d @ 12" O.C. BOTH SIDES	(2) 1 ½" 14" DEPTH	(3) ROWS 16d @ 12" O.C. ONE SIDE	(4) 1 ¾" UP TO 11 ½" DEPTH	(2) ROWS ½" x 5" SIMPSON SDS OR SDWS SCREWS @ 16" O.C. STAGGERED TOP & BOTTOM BOTH SIDES
(4) 2x	(2) ROWS ½" x 5" SIMPSON SDS SCREWS @ 16" O.C. STAGGERED TOP & BOTTOM, BOTH SIDES	(3) 1 ¾" UP TO 11 ½" DEPTH	(2) ROWS OF 16d @ 12" O.C. BOTH SIDES	(4) 1 ¾" x 14" DEPTH	(3) ROWS ½" x 5" SIMPSON SDS OR SDWS SCREWS @ 16" O.C. STAGGERED TOP & BOTTOM BOTH SIDES

GARAGE NOTES (CONTINUED)

- THE GARAGE SHALL BE SEPARATED FROM THE DWELLING AND ITS ATTIC AREAS BY MINIMUM ¾" GYP. BOARD APPLIED TO THE GARAGE SIDE OF FRAMING. WHERE HABITABLE SPACE OCCURS ABOVE THE GARAGE, THE GARAGE CEILING ASSEMBLY SHALL BE PROTECTED WITH A MINIMUM ¾" TYPE X GYP. BOARD. WHERE A FLOOR/CEILING SPACE IS PROVIDED ABOVE THE GARAGE COLUMNS AND BEAMS SUPPORTING THE SEPARATION SHALL ALSO BE PROTECTED WITH ¾" GYP. BOARD.
- GARAGE DOOR H-FRAME FOR THE ATTACHMENT OF THE TRACK AND COUNTER BALANCE SHALL CONSIST OF THE FOLLOWING: 2x6 VERTICAL JAMBS RUNNING FROM FLOOR TO CEILING AND SHALL BE FASTENED WITH 2½" x 0.120" NAILS AT 7" O.C. STAGGERED WITH (7) 3½" x 0.120" NAILS THROUGH THE JAMB INTO THE HEADER. MINIMUM 2x8 HEADER FOR ATTACHMENT OF COUNTER BALANCE SYSTEM.

DESIGN LOADING (PER TABLE R301.5)

USE	MINIMUM UNIFORMLY DISTRIBUTED LIVE LOADS (PSF)	
	LIVE LOAD	DEAD LOAD
UNINHABITABLE ATTICS WITHOUT STORAGE	10	10
UNINHABITABLE ATTICS WITH LIMITED STORAGE	20	10
HABITABLE ATTICS AND ATTICS SERVED WITH FIXED STAIRS	30	10
BALCONIES (EXTERIOR) AND DECKS	40	10 ^d
FIRE ESCAPES	40	10
GUARDRAILS AND HANDRAILS ^a	200 ^c	-
GUARDRAIL IN-FILL COMPONENTS ^b	50 ^c	-
PASSENGER VEHICLE GARAGES	50	DEPENDENT UPON SLAB CONSTRUCTION
ROOMS OTHER THAN SLEEPING ROOM	40	10 ^d
SLEEPING ROOM	30	10 ^d
STAIRS	40	10 ^d

- A single concentrated load applied in any direction at any point along the top.
- Guard in-fill components (all those except the handrail), ballusters and panel fillers shall be designed to withstand a horizontally applied normal load of 50 pounds on an area equal to one square foot. This load need not be assumed to act concurrently with any other live load requirement.
- Clazing used in handrail assemblies and guards shall be designed with a safety factor of 4. The safety factor shall be applied to each of the concentrated loads applied to the top of the rail, and to the load on the in-fill components. These loads shall be determined independently of one another, and loads are assumed not to occur with any other live load.
- An additional dead loading of 10 psf shall be applied where thinslet tile floor is to be installed. An additional dead loading of 50 psf shall be applied where mudset tile floor is to be installed.

INSULATION/EFFICIENCY

- BUILDING ENVELOPE INSULATION SHALL COMPLY WITH IRC TABLE N1102.1.1 OR THE 2012 IECC (SEE SHEET S3.1 FOR FRAMING DETAILS AND TABLES ON THIS SHEET FOR MORE INFORMATION)
- CATHEDRAL VAULTED CEILING FRAMING SHALL BE FRAMED WITH A MINIMUM INSULATION VALUE OF R-38. IF VAULTED RAFTERS DO NOT PROVIDE REQUIRED DEPTH TO ACHIEVE R-38 INSULATION BUILDER SHALL FUR DOWN RAFTERS PER DETAILS PROVIDED ON SHEET S3.1.

INSULATION AND FENESTRATION REQUIREMENTS BY COMPONENT (TABLE N1102.1.1)	
CLIMATE ZONE	4-A
FENESTRATION U-FACTOR	0.35
SKYLIGHT U-FACTOR	0.55
GLAZED FENESTRATION SHGC	0.40
CEILING R-VALUE	49
WOOD FRAME WALL R-VALUE	15
MASS WALL R-VALUE	8 / 13
FLOOR R-VALUE	19
BASEMENT WALL R-VALUE	10-CONTINUOUS OR 13-CAVITY
SLAB R-VALUE AND DEPTH	10 AT 2'-0"
CRAWL SPACE WALL R-VALUE	10-CONTINUOUS OR 13-CAVITY
DUCTWORK EXPOSED TO OUTSIDE AIR R-VALUE	8
DUCTWORK NOT EXPOSED TO OUTSIDE AIR R-VALUE	6
CATHEDRAL VAULTED CEILING R-VALUE	38

DUCT SEALING

N1102.2.2 (R403.2.2) SEALING (MANDATORY): DUCTS, AIR HANDLERS, AND FILTER BOXES SHALL BE SEALED. JOINTS AND SEAMS SHALL COMPLY WITH SECTION M1601.4.1 OF 2018 IRC.

EXCEPTIONS:

- AIR-IMPERMEABLE SPRAY FOAM PRODUCTS SHALL BE PERMITTED TO BE APPLIED WITHOUT ADDITIONAL JOINT SEALS.
- WHERE A DUCT CONNECTION IS MADE THAT IS PARTIALLY INACCESSIBLE, THREE SCREWS OR RIVETS SHALL BE EQUALLY SPACED ON THE EXPOSED PORTION OF THE JOINT SO AS TO PREVENT A HINGE EFFECT
- CONTINUOUSLY WELDED AND LOCKING-TYPE LONGITUDINAL JOINTS AND SEAMS IN DUCTS OPERATING AT STATIC PRESSURES LESS THAN 2 INCHES OF WATER COLUMN PRESSURE CLASSIFICATION SHALL NOT REQUIRE ADDITIONAL CLOSURE SYSTEMS.

DUCT TIGHTNESS SHALL BE VERIFIED BY EITHER OF THE FOLLOWING:

- POST-CONSTRUCTION TEST: TOTAL LEAKAGE SHALL BE LESS THAN OR EQUAL TO 4 CFM PER 100 SQUARE FEET OF CONDITIONED FLOOR AREA WHEN TESTED AT A PRESSURE DIFFERENTIAL OF 0.1 INCHES W.G. ACROSS THE ENTIRE SYSTEM, INCLUDING THE MANUFACTURER'S AIR HANDLER ENCLOSURE. ALL REGISTER BOOTHS SHALL BE TAPED OR OTHERWISE SEALED DURING THE TEST.
- ROUGH-IN TEST: TOTAL LEAKAGE SHALL BE LESS THAN OR EQUAL TO 4 CFM PER 100 SQUARE FEET OF CONDITIONED FLOOR AREA WHEN TESTED AT A PRESSURE DIFFERENTIAL OF 0.1 INCHES W.G. ACROSS THE SYSTEM, INCLUDING THE MANUFACTURER'S AIR HANDLER ENCLOSURE. ALL REGISTERS SHALL BE TAPED OR OTHERWISE SEALED DURING THE TEST. IF THE AIR HANDLER IS NOT INSTALLED AT THE TIME OF THE TEST, TOTAL LEAKAGE SHALL BE LESS THAN OR EQUAL TO 3 CFM PER 100 SQUARE FEET OF CONDITIONED FLOOR AREA.

EXCEPTION: THE TOTAL LEAKAGE TEST IS NOT REQUIRED FOR DUCTS AND AIR HANDLERS LOCATED ENTIRELY WITHIN THE BUILDING THERMAL ENVELOPE.

MECHANICAL VENTILATION SYSTEM FAN EFFICACY			
FAN LOCATION	AIR FLOW RATE MINIMUM (CFM)	MINIMUM EFFICACY (CFM/WATT)	AIR FLOW RATE MAXIMUM (CFM)
RANGE HOODS	ANY	2.8	ANY
IN-LINE FAN	ANY	2.8	ANY
BATHROOM, UTILITY ROOM	10	1.4	90
BATHROOM, UTILITY ROOM	90	2.8	ANY



VISTA
-STRUCTURAL-
ENGINEERING, LLC

11575 SW PACIFIC HWY # 2262 * TIGARD, OREGON 97225
OFFICE: 971.233.6099 * MOBILE: 971.233.6099 *
* DENNIS@VISTASTRUCTURAL.COM * VISTASTRUCTURAL.COM

CLIENT: WALKER CUSTOM HOMES, LLC

JOB TITLE: WLO010 WEGNER
LOT 10, WOODLAND OAKS - FINAL PLAT

LOCATION: 2528 NE WOODLAND OAK DR.
LEE'S SUMMIT, MISSOURI



DENNIS HEIER
NUMBER
FE-2018001772
PROFESSIONAL ENGINEER
1-18-2024

NO.	DATE	REVISION	BY

DRAWING TITLE

STRUCTURAL NOTES

ENGINEER: DMH	CHECKED BY: DMH
JOB NO.	DRAWN BY: DMH
DATE: 01-18-24	
SHEET NUMBER	

S1.0

RESIDENTIAL SEISMIC & WIND ANALYSIS

DETERMINE WEIGHT OF HOUSE:

LOCATION	DEAD LOAD (psf)	AREA (ft²)	WEIGHT (lbs.)	
ROOF	10	3192	31920	
CEILING	10	3192	31920	
FIRST FLOOR	10	3192	31920	
FIRST FLOOR EXT. WALL DL	WALL LENGTH (ft)	WALL HEIGHT (ft)	WALL UNIT WT. (psf)	WEIGHT (lbs)
	243	10	24300	
FIRST FLOOR INT. PARTITION WALL DL	DEAD LOAD (psf)	AREA (ft²)	WEIGHT (lbs)	
	6	3192	19152	

PROJECTED AREAS (WIND DESIGN PER 115 MPH 3-SECOND GUST, EXPOSURE C AND MEAN ROOF HEIGHT <= 30 FT ASSUMED)

FRONT-TO-BACK				SIDE-TO-SIDE			
AREA	LOAD			AREA	LOAD		
SLOPED ROOF	273	1202		SLOPED ROOF	365	1590	
VERT. ROOF	50	697	CUMULATIVE	VERT. ROOF	15	207	CUMULATIVE
1ST	647.13	9024	11070	1ST	689.37	9515	11459
BSMT*	0	0	0	BSMT*	147	2558	8287

PRESSURE (PSF) - PER ASCE CH. 6

SLOPED ROOF	ZONE B	5.9	ZONE C	11.6	2a (FIG. 28.6-1, ASCE7)
WALL VERT. ROOF	ZONE A	17.4	ZONE D	3.4	11.766
MEAN ROOF HT., ft	23				

a) If there is a walkout wall to be sheathed, determine tributary wind area and enter here. If no walkout, enter 0 for area.

$q_{t10}=0.00256K_zK_{zt}K_dV^2$ (ASCE7-10 Velocity Pressure)

$q_{t10_ASD}=0.6q_{t10}$ (Design Velocity Pressure for ASD analysis under ASCE7-10 and IRC/IBC 2012)

1ST FLOOR TRIBUTARY WEIGHT

BASEMENT TRIBUTARY WEIGHT

S_g (SITE GROUND MOTION - %g - FROM ASCE7 SEISMIC MAP)

F_a (from ASCE7 Table 11.4-1)

S_{0S} (= 2/3 * S_s * F_a)

R (from ASCE7 Table 12.2-1)

75990

75990

12.0%

1.6

0.128

6.5

SEISMIC SHEAR

LOCATION

1ST FLOOR

BASEMENT

From ASCE7 (Eq. 12.8-1):

V (= 1.2 * S_{0S} * W / R) (lbs.)

1796

1796

Sheathing Location	Min. Sheathing Schedule	Fastening Schedule	Allowable Shear (#/LF)	Code Reference
Exterior (Option #1)	7/16" APA Rated Plywood/OSB	1-1/2" 16ga. Staples w/ 1" penetration @ 8" O.C Edges, 6" O.C Field For 24" stud spacing, 12" O.C Field For 16" stud spacing	155	per IBC, Table 2306.3(1)
Exterior (Option #2)	7/16" APA Rated Plywood/OSB	1-1/2" 16ga. Staples w/ 1" penetration @ 4" O.C Edges, 6" O.C Field For 24" stud spacing, 12" O.C Field For 16" stud spacing	230	per IBC, Table 2306.3(1)
Exterior (Option #3)	7/16" APA Rated Plywood/OSB	1-1/2" 16ga. Staples w/ 1" penetration @ 3" O.C Edges, 6" O.C Field For 24" stud spacing, 12" O.C Field For 16" stud spacing	310	per IBC, Table 2306.3(1)
Exterior (Option #4)	7/16" APA Rated Plywood/OSB or shiplap panel sheathing, or 3/8" shiplap panel sheathing with tighter nail spacing	8d Common Nails w/ 1-3/8" penetration @ 6" O.C. Edges, 12" O.C. Field for 7/16" APA-rated plywood/OSB or shiplap panel sheathing OR @ 4" O.C. Edges, 12" O.C. Field for 3/8" shiplap panel sheathing	220	AF&PA SDPWS Table 4.3A
Exterior (Option #5)	7/16" APA Rated Plywood/OSB or shiplap panel sheathing, or 3/8" shiplap panel sheathing with tighter nail spacing	8d Common Nails w/ 1-3/8" penetration @ 4" O.C. Edges, 12" O.C. Field for 7/16" APA-rated plywood/OSB or shiplap panel sheathing OR @ 3" O.C. Edges, 12" O.C. Field for 3/8" shiplap panel sheathing	320	AF&PA SDPWS Table 4.3A
Exterior (Option #6)	7/16" APA Rated Plywood/OSB or shiplap panel sheathing, or 3/8" shiplap panel sheathing with tighter nail spacing and double studs at each panel edge	8d Common Nails w/ 1-3/8" penetration @ 3" O.C. Edges, 12" O.C. Field	410	AF&PA SDPWS Table 4.3A
Interior	1/2" Gypsum Board	No. 6- 1 1/4" Type W or S Screws @ 8" O.C. Edges, 12" O.C. Field	60	per IBC, Table 2306.4.4
Interior	16 Ga. Simpson/USP Type WB Steel X-Brace (or equal)	(3) 16d @ end studs & (1) 8d @ intermediate studs (per manufacture specifications - see detail on sheet S3)	325	

EXTERIOR SHEATHING OPTION FOR FIRST FLOOR	6	WIDTH OF 1ST STORY (FT.)	58.83	WIDTH OF 2ND STORY (FT.)	1
EXTERIOR SHEATHING OPTION FOR BASEMENT WALLS	4	DEPTH OF 1ST STORY (FT.)	62.67	DEPTH OF 2ND STORY (FT.)	1
		BACK WALL OF GARAGE (FT.)	0		
		GAR. WALL: 1=F-B, 2=S-S	2		

EXTERIOR STRUCTURAL WALL LENGTHS (ft.) & RESISTANCES

	SEISMIC				WIND			
	FRONT-TO-BACK	RESISTANCE (lbs.)	SIDE-TO-SIDE	RESISTANCE (lbs.)	FRONT-TO-BACK	RESISTANCE (lbs.)	SIDE-TO-SIDE	RESISTANCE (lbs.)
1ST FLOOR	92	43240	16	7520	92	60536	16	10528
BASEMENT	0	0	25	7000	0	0	25	9800

1ST FLOOR FRONT-TO-BACK

1ST FLOOR SIDE-TO-SIDE

BASEMENT FRONT-TO-BACK

BASEMENT SIDE-TO-SIDE

ADDITIONAL RESISTANCE REQUIRED

SEISMIC	WIND
0	0
0	931
0	0
0	0

Anchor Bolt Spacing (in.)

diameter (in.)	
0.5	944
Shear value (per NDS)	205.2
Spacing F-B (inches)	186.1
spacing S-S (inches)	

16d Nail Spacing req'd at bottom plate (in)

1st Floor F-B	1st Floor S-S
31	28

RESISTANCE REQUIRED IN ADDITION TO RESISTANCE PROVIDED BY EXTERIOR WALLS**

	ADDITIONAL RESISTANCE REQUIRED (POUNDS)	PORTAL FRAMES OR PERF. SHEAR WALL RESISTANCE	INTERIOR X-BRACES (325#/BRACE)	INTERIOR WALL LENGTH W/ 1/2" GYPSUM BOARD PER TABLE (FT.)	INT. WALL LENGTH SHEATHED W/ OSB (TOTAL LENGTH, ONE SIDE, FT.)	RESISTANCE PROVIDED BY ADDITIONAL METHODS (POUNDS)	OK?
1ST FLOOR FRONT-TO-BACK	0				0	0	YES
1ST FLOOR SIDE-TO-SIDE	931				48	31584	YES
BASEMENT FRONT-TO-BACK	0				0	0	YES
BASEMENT SIDE-TO-SIDE	0				0	0	YES

**NOTES: 1) SEE ATTACHED CALCULATIONS FOR PORTAL FRAME OR PERFORATED SHEAR WALL RESISTANCE CAPACITIES (IF APPLICABLE).
2) SEE SHEET S1 FOR INTERIOR STEEL X-BRACE INSTALLATION. 3) INTERIOR WALLS SHEATHED WITH OSB SHALL BE ATTACHED WITH SAME STAPLE/NAILING PATTERN AS EXTERIOR OSB ON SAME FLOOR (SEE TABLE ABOVE) AND ARE ONLY APPLICABLE FOR FULL-HEIGHT SECTIONS OF 2'-8" OR LONGER.
ALL LATERAL BRACING ACHIEVED AT EXTERIOR WALLS AND WALLS DIRECTLY ON FOUNDATIONS; THEREFORE, NO INTERIOR BRACING PER 2012 IRC SECTION R502.2.1 IS REQUIRED.

WIND UPLIFT ANALYSIS

	X/12	DEGREES					
ROOF PITCH (MAX)	4	18.4	PITCH OF 6 OR LESS: EOH -13.3, E -7.2, G -5.2				
		ASCE 7					
	LENGTH (FT.)	PRESSURE (PSF)	LINEAL FT. OF OH	UPLIFT PER FT* (LBS)			
OVERHANG	1	16.56	245	16.56			
	TOTAL AREA (FT²)	ZONE E AREA (FT²)	ZONE G AREA (FT²)	PRESSURE ZN. G (PSF)	TOTAL FORCE (LBS)	FORCE PER LINEAL FT. @ PERIMETER (LBS)	
MAIN ROOF**	3686.8761	-506.691024	4193.567124	15.12	10.5	36371	149.7

*ALONG PERIMETER

**INSIDE EXTERIOR WALLS

TOTAL UPLIFT PER LINEAL FOOT ALONG EXTERIOR (POUNDS)

166.2

UPLIFT OK

RESISTANCE DUE TO DEAD WEIGHT & (3) 16d TOENAILS

251.6

NOTE FOR CONSTRUCTION:
THE CONTINUOUS STRUCTURAL PANEL SHEATHING BRACING METHOD REQUIRES USE OF THE ABOVE TABLE FOR SHEATHING OF THE ENTIRE STRUCTURE. IN ADDITION, FRAMING MEMBERS SHALL BE @ 16" O.C. MAX., UNBLOCKED, AND W/ SHEATHING APPLIED DIRECTLY TO FRAMING MEMBERS

NOTE FOR DESIGN:
ALL WALLS USED IN THE CALCULATION OF THE RESISTANCE FOR THIS STRUCTURE SHALL HAVE A MINIMUM UNINTERRUPTED HEIGHT OF 8'-0" AND LENGTH OF 2'-8". ALLOWABLE RESISTANCES HAVE BEEN #/FT AND INCREASED BY 40% FOR WIND LOADS, PER VALUES IN 2012 IBC SECTION 2306 AND AF&PA SDPWS TABLE 4.3A. FOR EXAMPLE, 7/16" APA-RATED SHEATHING WITH 8d @ 6" & 12" HAS A SEISMIC SHEAR VALUE OF 240 A WIND SHEAR VALUE OF 335#/FT - 40% GREATER THAN THAT OF SEISMIC)

NOTE: SOIL SITE CLASS ASSUMED TO BE CLASS D. IF SITE CONDITIONS ARE DETERMINED TO BE CLASS E OR F, CONSULT ENGINEER BEFORE PROCEEDING WITH CONSTRUCTION

1 BRACED RAFTER CONSTRUCTION
S1.1 / SCALE: 1" = 1'-0" (16x24) OR 1/2" = 1'-0" (24x48)

Combustion Air Calculation

Per 2018 IRC Section G2407.5

Appliance #1

Furnace

100000 BTU/h

Appliance #2

BTU/h

Appliance #3

Water Heater

50000 BTU/h

Total BTU/hr

150000 BTU/h

Area of Combined Space (floor where appliances are located)

958 ft²

Ceiling Height in Usable Space

8.5 ft

Note: Per 2018 IRC Section G2407.5.3.2, The volumes of spaces in different stories shall be considered as communicating spaces where such spaces are connected by one or more openings in doors or floors having a total minimum free area of 2 square inches per 1,000 BTU/h of total input rating of all appliances

Is floor where appliances are located open to adjacent level?

Yes

If Yes, what is the area of open space adjacent to appliance area?

0

Per 2018 IRC Section G2407.5.1 (Standard Method), the minimum required volume shall be 50 cubic feet per 1,000 BTU/hr

(Total BTU/hr / 1,000 BTU/hr x 50 ft³)

7500 ft³

Required air space in combined areas:

Required combined area:

882 ft²

Area of Combined Space > Required combined area?

OK

Per Section G2407.5.3.1, each opening shall have a minimum free area of 1 square inch per 1,000 BTU/hr of the total input rating of all appliances in the space, but not less than 100 square inches. One opening shall commence within 12 inches of the top and one opening shall commence within 12 inches of the bottom of the enclosure. The minimum dimension of air openings shall be not less than 3 inches.

Minmum required opening area:

150 in²

Minimum grill size:

14 x 11 (inches)

Note: two grills required - one within 12" of floor, one within 12" of clg.

CLIENT: WALKER CUSTOM HOMES, LLC
JOB TITLE: WLO010 WEGNER
LOT 10, WOODLAND OAKS - FINAL PLAT
LOCATION: 2528 NE WOODLAND OAK DR.
LEE'S SUMMIT, MISSOURI

NO.	DATE	REVISION	BY

DRAWING TITLE

STRUCTURAL CALCULATIONS

ENGINEER: DMH

CHECKED BY: DMH

JOB NO.

DRAWN BY: DMH

DATE: 01-18-24

SHEET NUMBER

S1.1

RELEASE FOR CONSTRUCTION
AS NOTED FOR PLAN REVIEW
DEVELOPMENT SERVICES
LEE'S SUMMIT, MISSOURI
02/13/2024

GENERAL NOTES

1. PLANS ARE DESIGNED AND REVIEWED IN ACCORDANCE WITH THE 2018 IRC AS ADOPTED BY THE CITY OF OVERLAND PARK
2. RESIDENTIAL CONCRETE AND ASPHALT DRIVEWAY SLABS SHALL BE A MIN. 4" THICK. THE DRIVEWAY SHALL HAVE A CONSTANT SLOPE SO AS TO AVOID PONDING OF WATER. THE SLOPE SHALL BE AWAY FRO THE HOUSE OR BUILDING OR DRAIN BY MEANS APPROVED BY THE BUILDING OFFICIAL
3. APPROVED NUMBERS OR ADDRESSES SHALL BE PROVIDED FOR ALL NEW BUILDING IN SUCH A POSITION AS TO BE PLAINLY VISIBLE AND LEGIBLE FRO THE STREET OR ROAD FRONTING THE PROPERTY AND LOCATED NOT MORE THAN 50 FEET FROM THE PROPERTY LINE. ADDRESS CHARACTERS SHALL HAVE A CONTRASTING BACKGROUND AND HAVE A MIN. HEIGHT OF 4"
4. SINGLE FAMILY DWELLINGS SHALL HAVE THE ABILITY TO ILLUMINATE THE ADDRESS AND NUMBERS DURING THE HOURS OF DARKNESS WITH A POWER SOURCE CONNECTED TO THE HOUSE ELECTRICAL SYSTEM OR OTHER APPROVED SOURCE OF ILLUMINATION.
5. EXCEPT FOR VEHICULAR ACCESS DOORS, ALL EXTERIOR SWINGING DOORS OF RESIDENTIAL BUILDINGS AND ATTACHED GARAGES, INCLUDING THE DOORS LEADING FROM THE GARAGE AREA INTO THE DWELLING UNIT SHALL COMPLY WITH SECTIONS R328.2.5 THROUGH R328.2.5 FOR THE TYPE OF DOOR INSTALLED.
6. WHERE INSTALLED, EXTERIOR WOOD DOORS SHALL BE OF SOLID CORE CONSTRUCTION SUCH AS HIGH-DENSITY PARTICLE BOARD, SOLID WOOD, OR WOOD BLOCK CORE WITH A MINIMUM THICKNESS OF 1½" AT ANY POINT. DOORS WITH PANEL INSERTS SHALL BE SOLID WOOD. THE PANELS SHALL BE A MINIMUM OF 1" THICK. THE TAPERED PORTION OF THE PANEL THAT INSERTS INTO THE GROOVE OF THE DOOR SHALL BE A MINIMUM OF ¼" THICK. THE GROOVE SHALL BE A DADO GROOVE OR APPLIED MOLDING CONSTRUCTION. THE GROOVE SHALL BE A MINIMUM OF ½" IN DEPTH.
7. WHERE INSTALLED, EXTERIOR STEEL DOORS SHALL BE A MINIMUM THICKNESS OF 24 GAUGE
8. FIBERGLASS DOORS SHALL HAVE A MINIMUM SKIN THICKNESS OF ⅝" AND HAVE REINFORRCEMENT MATERIAL AT THE LOCATION OF THE DEADBOLT
9. WHERE INSTALLED, THE INACTIVE LEAF OF AN EXTERIOR DOUBLE DOOR SHALL BE PROVIDED WITH FLUSH BOLTS HAVING AN ENGAGEMENT OF NOT LESS THAN 1" INTO THE HEAD AND THRESHOLD OF THE DOOR FRAME
10. WHERE INSTALLED, EXTERIOR SLIDING DOORS SHALL COMPLY WITH ALL OF THE FOLLOWING REQUIREMENTS: A) SLIDING DOOR ASSEMBLIES SHALL BE INSTALLED TO PREVENT THE REMOVAL OF THE PANELS AND THE GLAZING FROM THE EXTERIOR WITH THE INSTALLATION OF SHIMS OR SCREWS IN THE UPPER TRACK AND B) ALL SLIDING GLASS DOORS SHALL BE EQUIPPED WITH A SECONDARY LOCKING DEVICE CONSISTING OF A METAL PIN OR A SURFACE MOUNTED BOLT ASSEMBLY. METAL PINS SHALL BE INSTALLED AT THE INTERSECTION OF THE INNER AND OUTER PANELS OF THE INSIDE DOOR AND SHALL NOT PENETRATE THE FRAME'S EXTERIOR SURFACE. THE SURFACE MOUNTED BOLT ASSEMBLY SHALL BE INSTALLED A THE BASE OF THE DOOR.
11. WOOD DOOR FRAMES SHALL COMPLY WITH ALL OF THE FOLLOWING REQUIREMENTS: A) ALL EXTERIOR DOOR FRAMES SHALL BE SET IN FRAME OPENINGS CONSTRUCTED OF DOUBLE STUDDING OR EQUIVALENT CONSTRUCTION, INCLUDING GARAGE DOOR, BUT EXCLUDING OVERHEAD DOORS. DOOR FRAMES, INCLUDING THOSE WITH SIDELIGHTS SHALL BE REINFORCED IN ACCORDANCE WITH ASTM F476-84 GRADE 40, AND B) IN WOOD FRAMING, HORIZONTAL BLOCKING SHALL BE PLACED BETWEEN STUDS AT THE DOOR LOCK HEIGHT FOR THREE STUDS SPACES OR EQUIVALENT BRACING ON EACH SIDE OF THE DOOR OPENING.
12. ALL EXTERIOR DOOR FRAMES (INCLUDING THE DOOR LEADING FROM THE GARAGE TO THE DWELLING UNIT) SHALL BE CONSTRUCTED OF 18 GAUGE OR HEAVIER STEEL AND REINFORCED AT THE HINGES AND STRIKES. ALL STEEL FRAMES SHALL BE ANCHORED TO THE WALL IN ACCORDANCE WITH MANUFACTURER SPECIFICATIONS. SUPPORTING WALL STRUCTURES SHALL CONSIST OF DOUBLE STUDDING OR FRAMING OF EQUIVALENT STRENGTH. FRAMES SHALL BE INSTALLED TO ELIMINATE TOLERANCES INSIDE THE ROUGH OPENING.
13. DOOR JAMBS SHALL BE INSTALLED WITH SOLID BACKING IN A MANNER SO NO VOID EXITS BETWEEN THE STRIKE SIDE OF THE JAMB AND THE FRAME OPENING FOR A VERTICAL DISTANCE OF 12" EACH SIDE OF THE STRIKE. FILLER MATERIAL SHALL CONSIST OF A SOLID WOOD BLOCK.
14. DOOR STOPS ON WOODEN JAMBS FOR IN-SWITCHING DOORS SHALL BE OF ONE-PIECE CONSTRUCTION. JAMBS FOR ALL DOORS SHALL BE CONSTRUCTED OR PROTECTED SO AS TO PREVENT VIOLATION OF THE STRIKE.
15. HINGES FOR EXTERIOR SWINGING DOORS SHALL COMPLY WITH THE FOLLOWING: A) AT LEAST TWO SCREWS 3" IN LENGTH PENETRATING AT LEAST 1" INTO WALL STRUCTURE SHALL BE USED. SOLID WOOD FILLERS OR SHIMS SHALL BE USED TO ELIMINATE ANY SPACE BETWEEN THE WALL STRUCTURE AND DOOR FRAME BEHIND EACH HINGE, AND B) HINGES FOR OUT-SWINGING DOORS SHALL BE EQUIPPED WITH MECHANICAL INTERLOCK TO PRECLUDE THE REMOVAL OF THE DOOR FROM THE EXTERIOR.
16. EXTERIOR DOOR STRIKE PLATES SHALL BE A MINIMUM OF 18 GAUGE METAL WITH FOUR OFFSET SCREW HOLES. STRIKE PLATES SHALL BE ATTACHED TO WOOD WITH NOT LESS THAN 3" SCREWS, WHICH SHALL HAVE A MINIMUM OF 1" PENETRATION INTO THE NEAREST STUD. NOTE: FOR SIDE LIGHTED UNITS, REFER TO SECTION R328.4.6
17. ALL EXTERIOR DOORS SHALL HAVE ESCUTCHEON PLATES OR WRAP-AROUND DOOR CHANNELS INSTALLED AROUND THE LOCK PROTECTING THE DOOR'S EDGE
18. EXTERIOR DOORS SHALL BE PROVIDED WITH A LOCKING DEVICE COMPLYING WITH ONE OF THE FOLLOWING: SINGLE CYLINDER DEADBOLT SHALL HAVE A MINIMUM PROJECTION OF 1". THE DEADBOLT SHALL PENETRATE AT LEAST ¾" INTO THE STRIKE RECEIVING THE PROJECTED BOLT. THE CYLINDER SHALL HAVE A TWIST-RESISTANT TAPERED HARDENED STEEL CYLINDER GUARD. THE CYLINDER SHALL HAVE A MINIMUM OF FIVE PIN TUMBLERS. SHALL BE CONNECTED TO THE INNER PORTION OF THE LOCK BY SOLID METAL CONNECTING SCREWS AT LEAST ⅝" IN DIAMETER AND 2½" IN LENGTH. BOLT ASSEMBLY (BOLT HOUSING) UNIT SHALL BE OF SINGLE PIECE CONSTRUCTION. ALL DEADBOLTS SHALL MEET ANSI GRADE 2 SPECIFICATIONS.
19. ALL MAIN OR FRONT ENTRY DOORS TO DWELLING UNITS SHALL BE ARRANGED SO THAT THE OCCUPANT HAS A VIEW OF THE AREA IMMEDIATELY OUTSIDE THE DOOR WITHOUT OPENING THE DOOR. THE VIEW MAY BE PROVIDED BY A DOOR VIEWER HAVING A FIELD OF VIEW OF NOT LESS THAN 180 DEGREES THROUGH WINDOWS OR THROUGH VIEW PORTS.
20. SIDE LIGHT DOOR UNITS SHALL HAVE FRAMING OF DOUBLE STUD CONSTRUCTION OR EQUIVALENT CONSTRUCTION COMPLYING WITH SECTIONS R328.3.1, R328.3.2 AND R3828.3.3. THE DOOR FRAME THAT SEPARATES THE DOOR OPENING FROM THE SIDE LIGHT, WHETHER ON THE LATCH SIDE OR THE HINGE SIDE, SHALL BE DOUBLE STUD CONSTRUCTION OR EQUIVALENT CONSTRUCTION COMPLYING WITH SECTIONS R328.3.1 AND R328.3.2. DOUBLE STUD CONSTRUCTION OR CONSTRUCTION OF EQUIVALENT STRENGTH SHALL EXIST BETWEEN THE GLAZING UNIT OF THE SIDE LIGHT AND WALL STRUCTURE OF THE DWELLING.
21. ALL FRONT AND STREET SIDE DOOR ENTRANCES SHOULD BE PROTECTED WITH A MINIMUM OF ONE LIGHT OUTLET HAVING A MINIMUM OF SIXTY WATTS OF LIGHTING (OR ENERGY EFFICIENT EQUIVALENT), INSTALLED SO THAT THE LIGHT SOURCE IS NOT READILY ACCESSIBLE.
22. HOMES WITH WINDOWS OR DOORS NEAR GROUND LEVEL BELOW EIGHT FEET ON THE REAR SIDE OF THE HOUSE SHALL BE EQUIPPED WITH A MINIMUM OF ONE LIGHT OUTLET HAVING 100 WATT LIGHTING (OR ENERGY EFFICIENT EQUIVALENT) AND SHALL BE OF THE FLOOD LIGHT TYPE. THOSE FIXTURES PLACED BELOW EIGHT FEET SHALL BE FIXTURES MANUFACTURED SUCH THAT THE LIGHT SOURCE IS NOT READILY ACCESSIBLE.
23. BASEMENT FLOOR SLABS SHALL BE ISOLATED FROM COLUMN PADS, INTERIOR COLUMNS AND INTERIOR BEARING WALLS TO FACILITATE DIFFERENTIAL MOVEMENT. NONBEARING WALLS SUPPORTED ON BASEMENT FLOOR SLABS SHALL BE PROVIDED WITH A MINIMUM ONE-INCH EXPANSION JOINT TO FACILITATE DIFFERENTIAL MOVEMENT BETWEEN THE FLOOR SLAB AND THE FLOOR FRAMING ABOVE. ISOLATION AND/ORR AN EXPANSION JOINT IS NOT REQUIRED WITHIN SIX INCHES OF THE EXTERIOR WALLS
24. ONE LAYER OF NO. 15 ASPHALT FELT, FREE FROM HOLES AND BREAKS, COMPLYING WITH ASTM D226 FOR TYPE 1 FELT OR OTHER APPROVED WATER-RESISTIVE BARRIER WHERE APPLIED OVER STUDS OR SHEATHING OF ALL EXTERIOR WALLS. SUCH FELT OR MATERIAL SHALL BE APPLIED HORIZONTALLY, WITH THE UPPER LAYER LAPPED OVER THE LOWER LAYER NOT LESS THAN 2 INCHES. WHERE JOINTS OCCUR, FELT SHALL BE LAPPED NOT LESS THAN 6 INCHES. THE FELT OR OTHER APPROVED MATERIAL SHALL BE CONTINUOUS TO THE TOP OF WALLS AND TERMINATED AT PENETRATIONS AND BUILDING APPENDAGES IN A MANNER TO MEET THE REQUIREMENTS OF THE EXTERIOR WALL ENVELOPE AS DESCRIBED IN SECTION R703.1. EXOEPTIONS: OMISSION OF THE WATER-RESISTIVE BARRIER IS PERMITTED IN THE FOLLOWING SITUATIONS - A) IN DETACHED ACCESSORY BUILDINGS, AND B) UNDER EXTERIOR WALL FINISH MATERIALS AS PERMITTED IN TABLE R703.4
25. IN AREAS WHERE EXPANSIVE OR COLLAPSIBLE SOILS ARE KNOWN TO EXIST, ALL DWELLINGS SHALL HAVE A CONTROLLED METHOD OF WATER DISPOSAL FROM ROOFS THAT WILL COLLECT AND DISCHARGE ALL ROOF DRAINAGE TO THE GROUND SURFACE AT LEAST 3 FEET FROM FOUNDATION WALLS OR TO AN APPROVED DRAINAGE SYSTEM.
26. EXTERIOR WALLS ASSOCIATED WITH CONDITIONED BASEMENTS SHALL BE INSULATED FROM THE TOP OF THE BASEMENT WALLS DOWN TO 10'-0" BELOW GRADE OR TO THE BASEMENT FLOOR, WHICHEVER IS LESS. WALLS ASSOCIATED WITH UNCONDITIONED BASEMENTS SHALL MEET THIS REQUIREMENT UNLESS THE FLOOR OVERHEAD IS INSULATED IN ACCORDANCE WITH SECTIONS N1102.1 AND N1102.2.5. EXCEPTION: EXTERIOR BASEMENT WALLS MADE OF CONCRETE OR MASONRY ARE NOT REQUIRED TO BE INSULATED WHEN SUCH WALLS ARE NOT ADJACENT TO FINISHED SPACE AND ARE MORE THAN 50% BELOW GRADE. EXTERIOR BASEMENT WALLS MADE OF CONCRETE AND MASONRY SHALL BE INSULATED WHENEVER THE ADJACENT INTERIOR SPACE IS FINISHED

ALLOWABLE LOAD FOR PNEUMATIC OR MECHANICALLY DRIVEN NAILS AND STAPLES							
FASTENER DESCRIPTION	NAIL GUN NAILS/WIRE DIA.	WIRE GA.	PENETRATION REQUIRED INTO MAIN MEMBER FOR LATERAL STRENGTH (IN.)	ALLOWABLE LOADS (LBS.)			
				LATERAL STRENGTH		WITHDRAWL STRENGTH	
				SP	DFL	SP	DFL
16 GA. STAPLE	0.0630	16	1	51	-	36	32
15 GA. STAPLE	0.0720	15	1	64	-	42	37
14 GA. STAPLE	0.0800	14	1	75	-	46	41
6d COOLER NAIL	0.0920	13	1	46	-	27	23
6d SINKER NAIL							
6d BOX NAIL	0.0990	12 1/2	1 1/8	61	55	31	24
6d CASING NAIL							
7d COOLER NAIL							
6d COMMON NAIL							
8d COOLER NAIL	0.1130	11.5000	1 1/4	79	72	35	28
8d SINKER NAIL							
8d BOX NAIL							
8d CASING NAIL							
6d RING SHANK NAIL	0.1200	11	1.3750	89	81	41	32
6d SCREW SHANK NAIL							
8d RING SHANK NAIL							
8d SCREW SHANK NAIL							
10d COOLER NAIL	0.1280	10.5000	1.5000	89	81	36	31
10d SINKER NAIL							
12d SHORT							
10d BOX NAILS	0.1280	10.5000	1.5000	101	93	40	31
12d BOX NAILS							
10d CASING NAILS							
8d COMMON NAILS	0.1310	10.2500	1.5000	106	97	41	32
16d SHORT NAILS							
12d SINKER NAILS	0.1350	10	1.5000	113	103	42	33
16d BOX NAILS							
10d RING SHANK NAILS	0.1350	10	1.6250	113	103	46	36
10d SCREW SHANK NAILS							
12d RING SHANK NAILS							
12d SCREW SHANK NAILS							
10d COMMON NAILS	0.1480	9	1.6250	128	118	46	36
12d COMMON NAILS							
16d SINKER NAILS							
20d BOX NAILS							
30d BOX NAILS	0.1480	9	1.7500	128	118	50	40
16d RING SHANK NAILS							
16d SCREW SHANK NAILS							
16d COMMON NAILS	0.1620	8	1.7500	154	141	50	40
40d BOX NAILS							
20d RING SHANK NAILS	0.1770	7	2.1250	178	163	59	47
20d SCREW SHANK NAILS							
20d SINKER NAILS	0.1770	7	2.1250	178	163	54	43
20d COMMON NAILS							
30d SINKER NAILS	0.1480	9	2.1250	170	166	59	47




CLIENT: WALKER CUSTOM HOMES, LLC
JOB TITLE: WLO010 WEGNER LOT 10, WOODLAND OAKS - FINAL PLAT
LOCATION: 2528 NE WOODLAND OAK DR. LEE'S SUMMIT, MISSOURI




NO.	DATE	REVISION	BY
DRAWING TITLE			
STRUCTURAL NOTES			
ENGINEER: DMH		CHECKED BY: DMH	
JOB NO.		DRAWN BY: DMH	
DATE: 01-18-24			
SHEET NUMBER			

S1.2

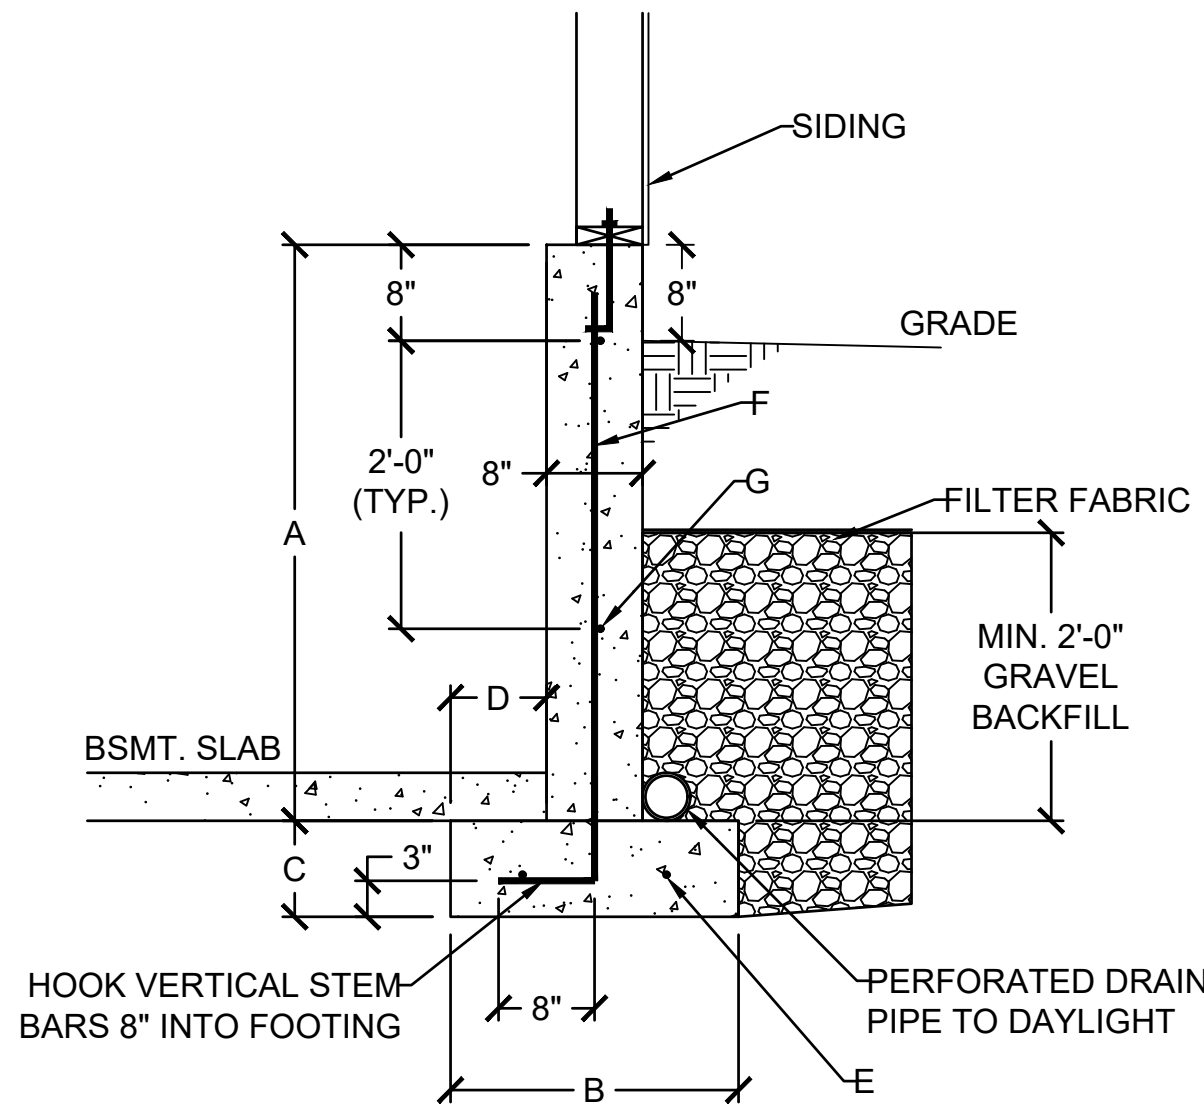


DAYLIGHT BASEMENT WALL SCHEDULE						
A	B	C	D	E	F	G
4'-0"	1'-6"	0'-8"	0'-5"	(2) #4	#4 VERT. @ 12" O.C.	(2) #4 HORIZ.
5'-0"	2'-0"	0'-8"	0'-7"	(2) #4	#4 VERT. @ 12" O.C.	(3) #4 HORIZ.
6'-0"	2'-6"	0'-8"	0'-10"	(3) #4	#4 VERT. @ 12" O.C.	(3) #4 HORIZ.


1 DAYLIGHT WALL CONSTRUCTION
S2.0 SCALE: 1/2" = 1'-0" (18x24) OR 3/4" = 1'-0" (24x36)

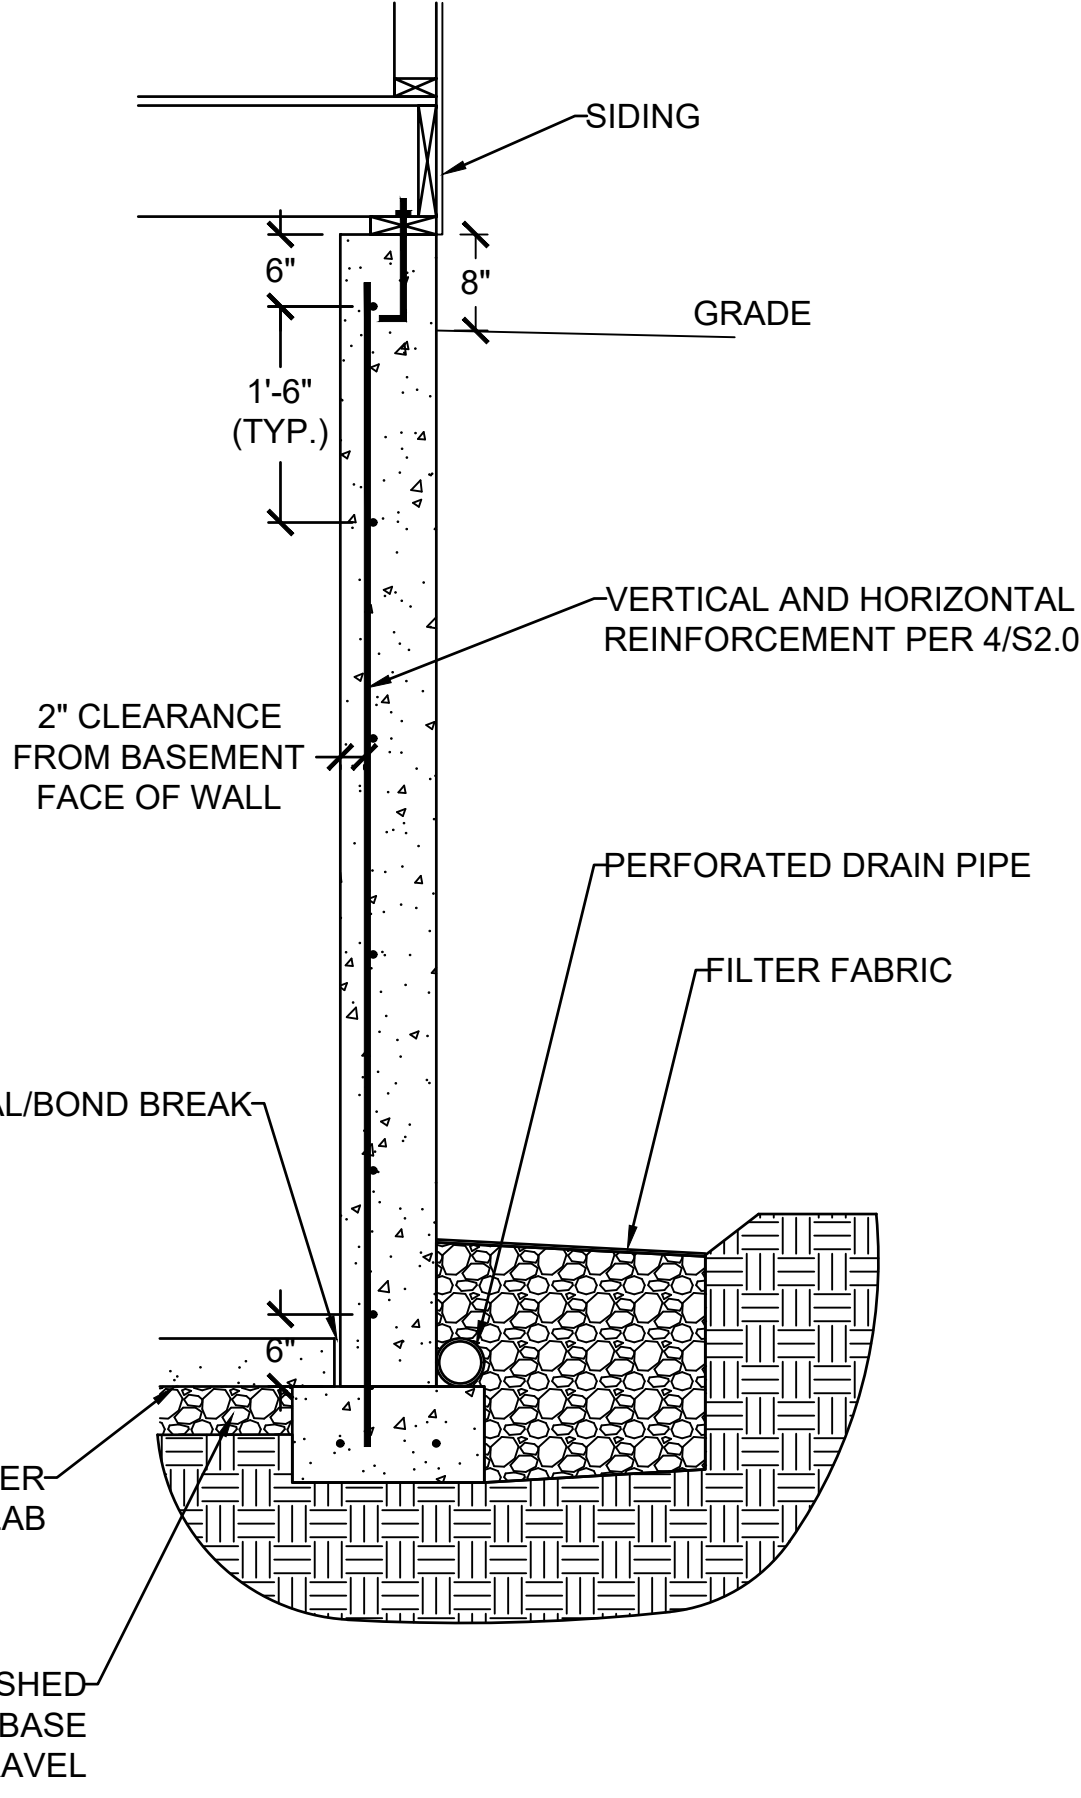


3 CONCRETE WALL SECTION
S2.0 SCALE: 1/2" = 1'-0" (18x24) OR 3/4" = 1'-0" (24x36)

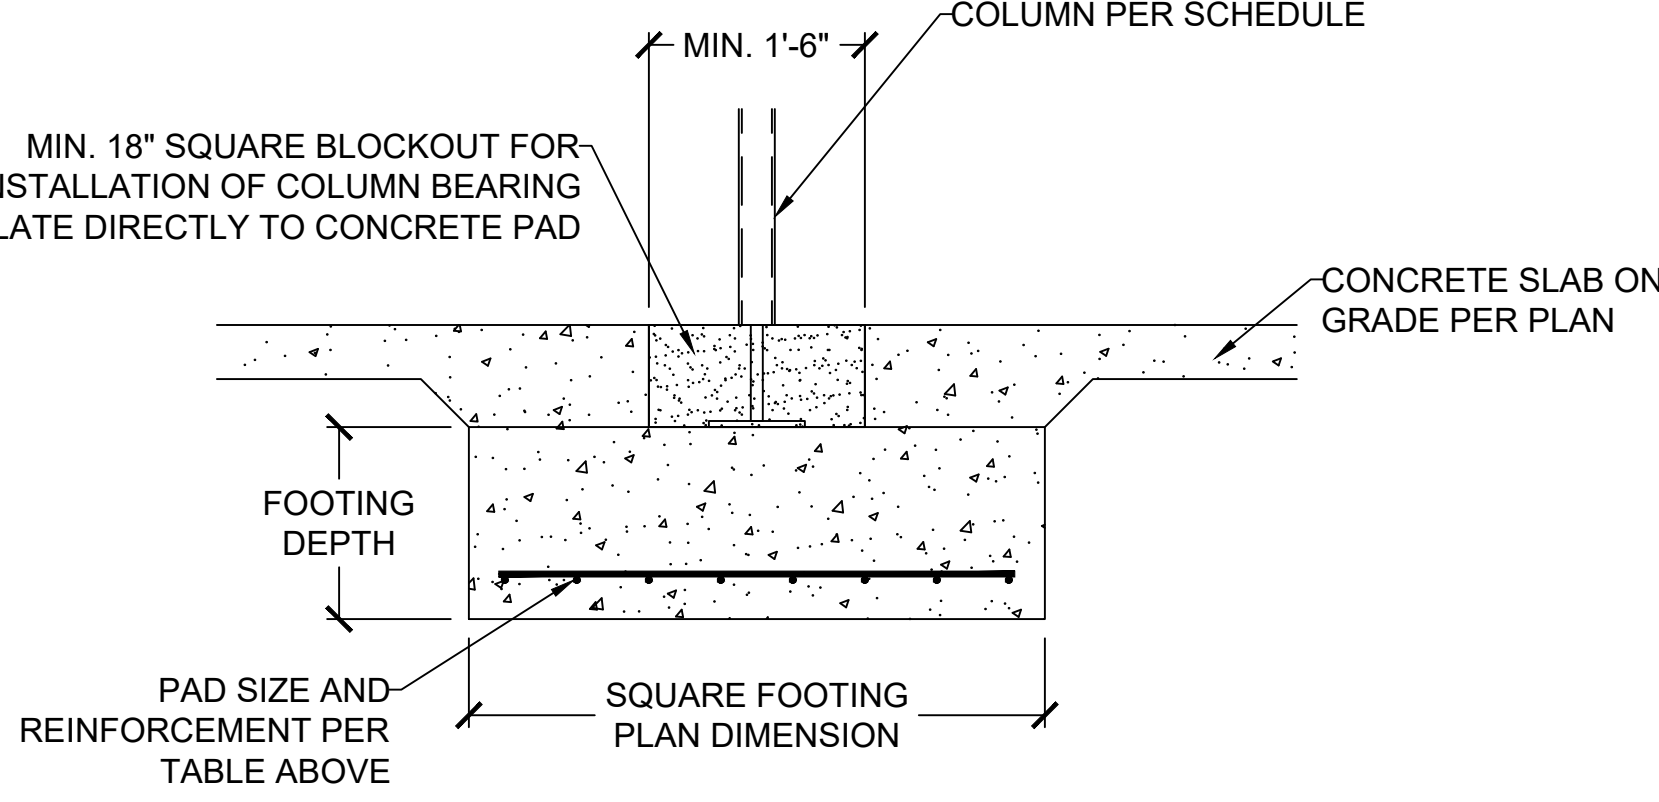

2 COLUMN AND BEARING PAD SCHEDULE
S2.0 SCALE: 1/2" = 1'-0" (18x24) OR 3/4" = 1'-0" (24x36)

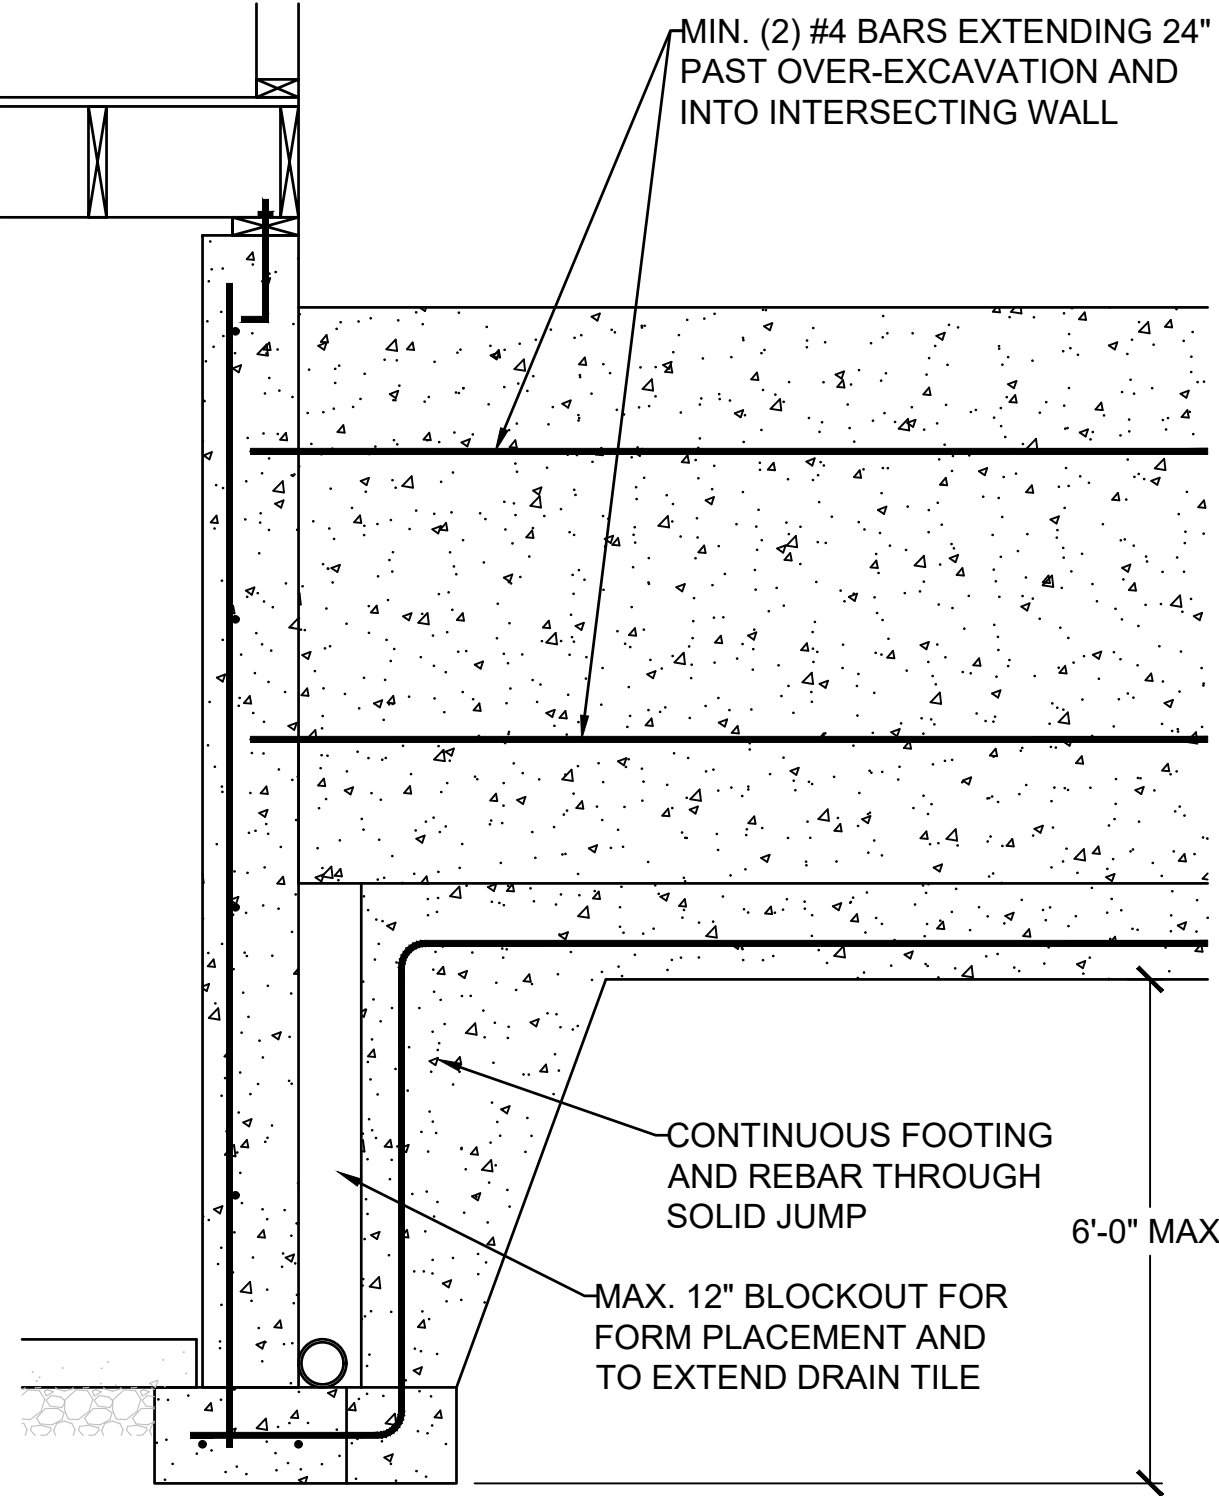


5 SOLID JUMP
S2.0 SCALE: 1/2" = 1'-0" (18x24) OR 3/4" = 1'-0" (24x36)

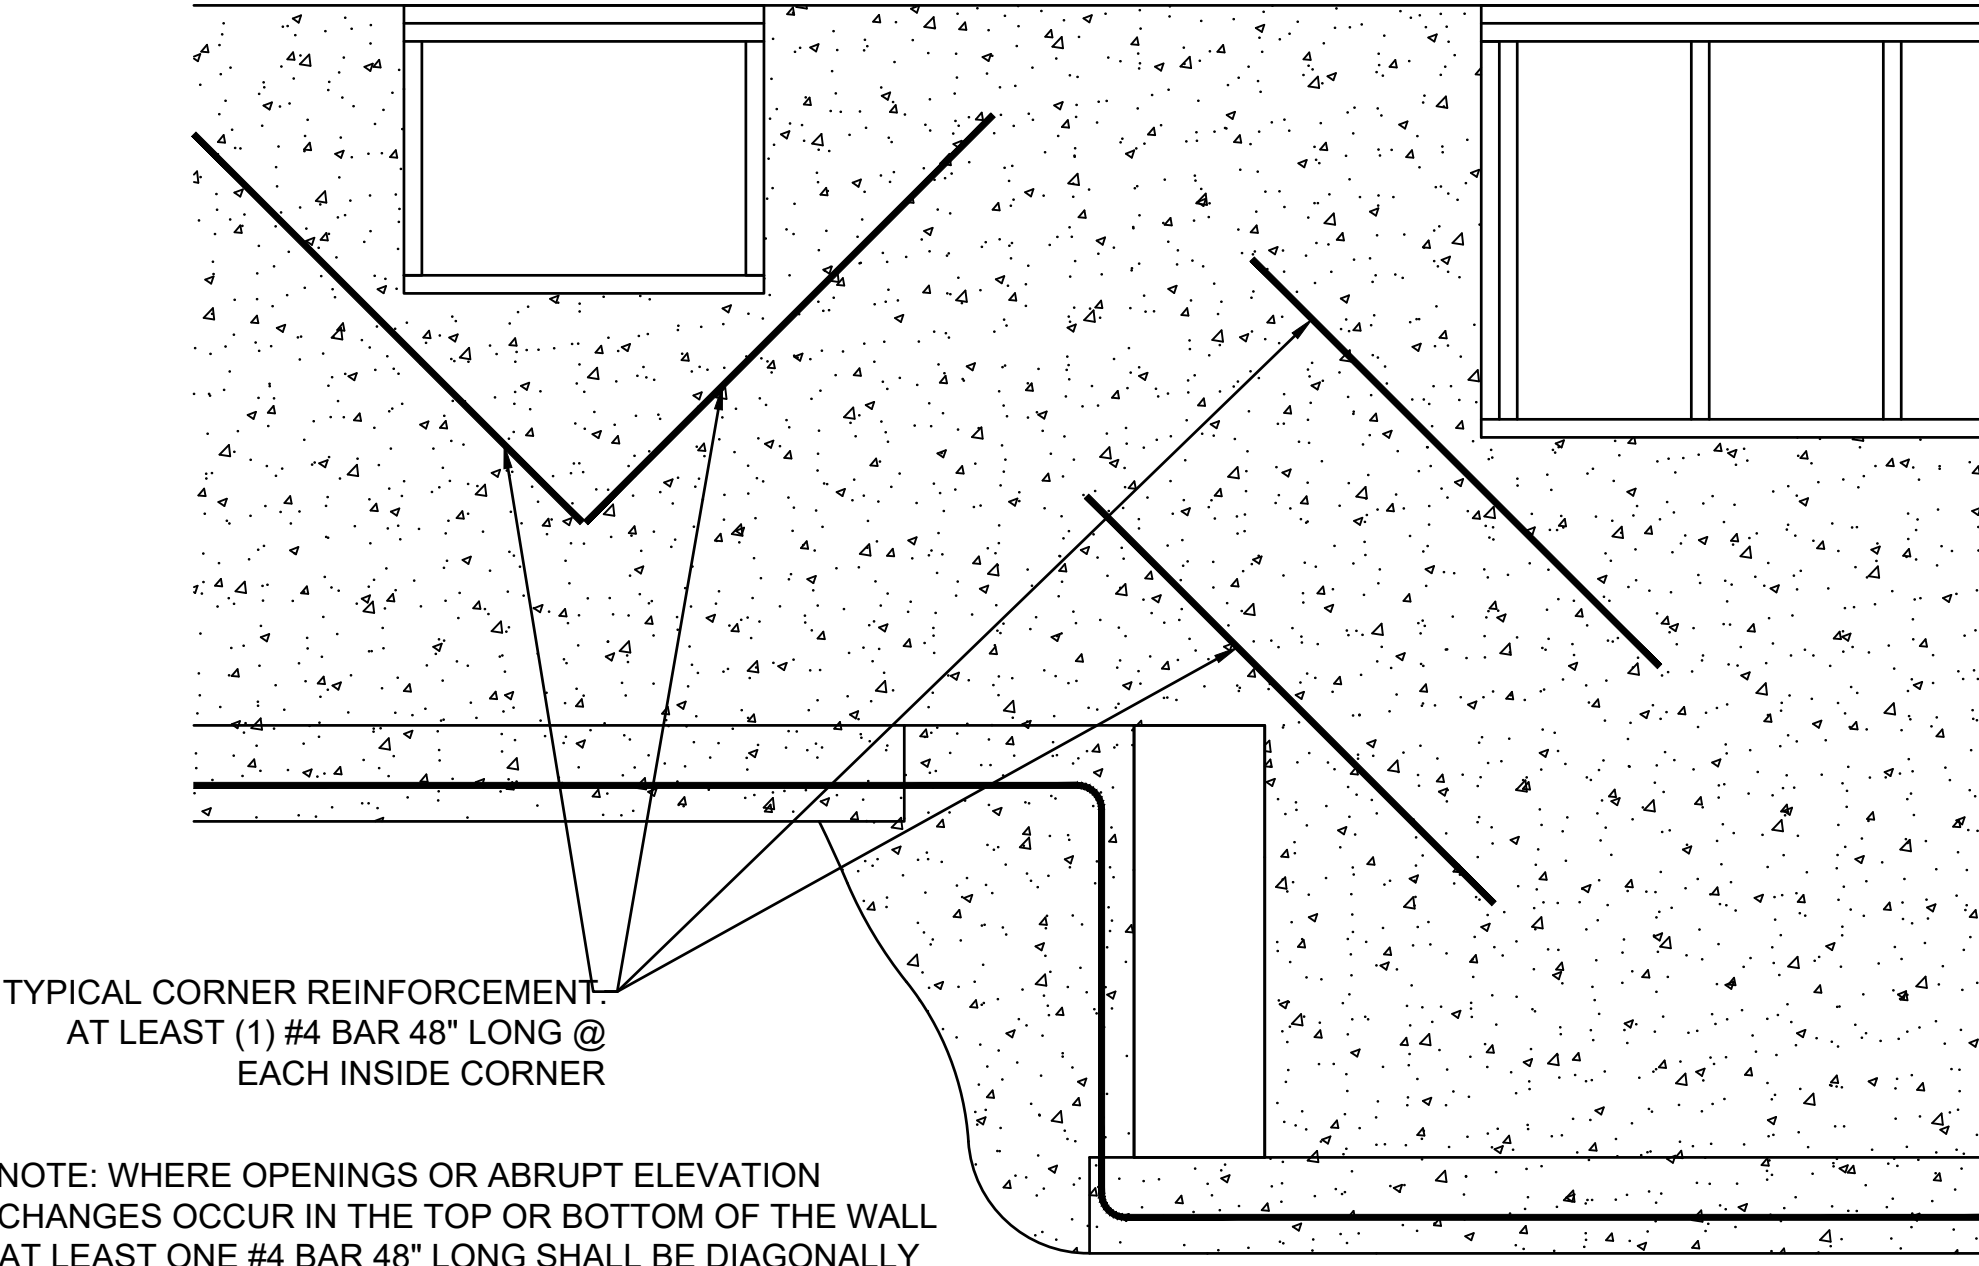


6 REINFORCEMENT AT OPENING CORNERS AND STEP CORNERS @ INSIDE CORNERS
S2.0 SCALE: 1/2" = 1'-0" (18x24) OR 3/4" = 1'-0" (24x36)

NOTE: WHERE FLOOR JOIST RUNS PARALLEL TO FDN WALL, SOLID BLOCK OUTSIDE 3 JOIST SPACES @ 36" OC ALIGNING BLOCKING WITH THE ANCHOR BOLT

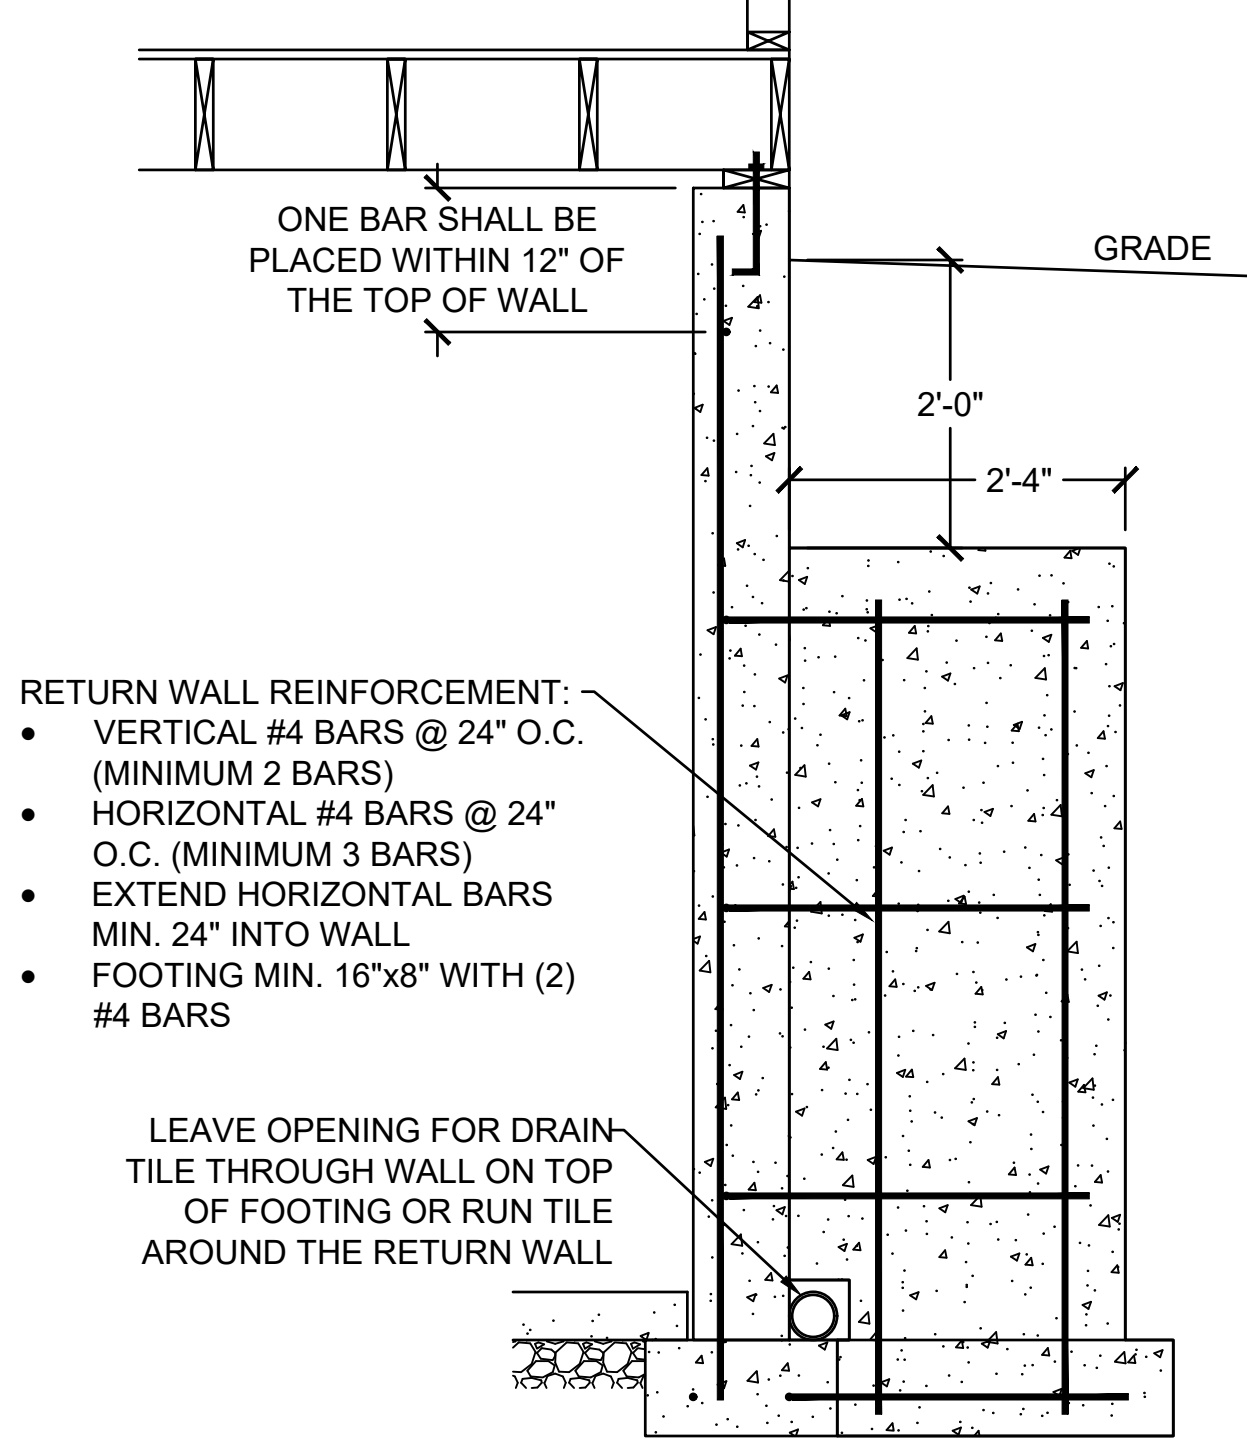

7 RETURN WALL DETAIL
S2.0 SCALE: 1/2" = 1'-0" (18x24) OR 3/4" = 1'-0" (24x36)

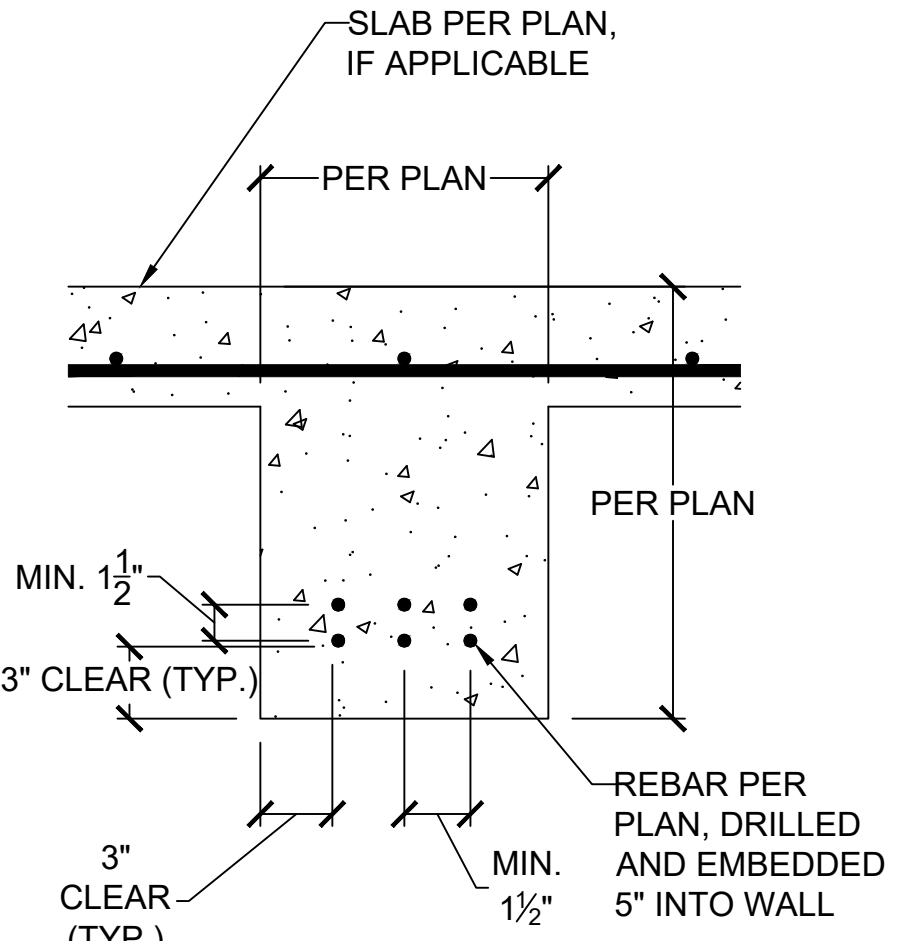

8 CONCRETE GRADE BEAM
S2.0 SCALE: 1" = 1'-0" (18x24) OR 1 1/2" = 1'-0" (24x36)

VERTICAL REINFORCEMENT SPACING						
CONCRETE STRENGTH/GRADE REINFORCEMENT (#4 BARS)	8" THICK WALL			10" THICK WALL		
	8'	9'	10'	8'	9'	10'
3,000 PSI/ GRADE 40	24	24	16	24	24	18
3,500 PSI/ GRADE 40	24	24	16	24	24	18
3,000 PSI/ GRADE 60	24	24	16	24	24	18
3,500 PSI/ GRADE 60	24	24	16	24	24	18
HORIZONTAL REINFORCEMENT - MINIMUM GRADE 40 STEEL						
ONE BAR 12" FROM TOP OF WALL; MAX. SPACING 24" OC	6-#4	7-#4	7-#4	6-#4	7-#4	7-#4

- FOOTNOTES:
- WALL HEIGHT IS MEASURED FROM THE TOP OF THE WALL TO THE TOP OF THE FLOOR SLAB
 - VERTICAL REINFORCEMENT FOR CONCRETE WALLS THAT ARE NOT FULL HEIGHT, AND FOR REINFORCEMENT SPACING 24" OC, REINFORCEMENT MAY BE PLACED IN THE MIDDLE OF THE WALL. OTHER WALLS SHALL HAVE VERTICAL REINFORCEMENT AS FOLLOWS:
A) 8" WALL - MINIMUM 5" FROM THE OUTSIDE FACE
B) 10" WALL - MINIMUM 6 3/4" FROM THE OUTSIDE FACE
C) EXTEND BARS TO WITHIN 8" OF THE TOP OF THE WALL
 - REINFORCEMENT CLEARANCES:
A) CONCRETE EXPOSED TO EARTH - MINIMUM 1 1/2"
B) NOT EXPOSED TO WEATHER (INTERIOR SIDE OF WALLS) - 3/4"
C) CONCRETE EXPOSED TO WEATHER (TOP CLEARANCE IN GARAGE AND DRIVEWAY SLABS) - 1 1/2"
 - HORIZONTAL REINFORCEMENT:
A) ONE BAR SHALL BE PLACED WITHIN 12" OF THE TOP OF THE WALL
B) OTHER BARS SHALL BE EQUALLY SPACED WITH SPACING NOT TO EXCEED 24" OC
C) HORIZONTAL BARS SHOULD BE AS CLOSE TO THE TENSION FACE AS POSSIBLE (INTERIOR) AND BEHIND THE VERTICAL REINFORCEMENT (I.E. 2" TOWARD THE INSIDE)
D) SUPPLEMENTAL REINFORCEMENT AT CORNERS - PLACE (1) #4 BAR 48" LONG AT 45 DEGREE ANGLE AT CORNERS OF OPENINGS. PLACE REINFORCEMENT WITHIN 6" OF THE EDGE OF INSIDE CORNERS.
 - REINFORCEMENT SHALL BE LAPPED A MINIMUM 24" AT ENDS, SPLICES, AND AROUND CORNERS.
 - AT MASONRY LEDGES THE MINIMUM WALL THICKNESS SHALL BE 3 1/2". LEDGES SHALL NOT EXCEED A DEPTH OF MORE THAN 24" BELOW THE TOP OF THE WALL. FOR WALL THICKNESSES LESS THAN 4" PROVIDE #4 BARS AT MAX. 24" OC TO WITHIN 8" OF THE TOP OF THE WALL.
 - STRAIGHT WALLS MORE THAN 5' TALL AND MORE THAN 16 FEET LONG SHALL BE PROVIDED WITH EXTERIOR BRACED RETURN WALLS. WALL LENGTH SHALL BE MEASURED USING INSIDE THE SHORTEST DIMENSION BETWEEN INTERSECTING WALLS
 - WALL SHALL NOT BE BACKFILLED UNTIL FLOOR SYSTEM AND DIAPHRAGM ARE IN PLACE

4 FOUNDATION WALL REINFORCEMENT TABLE
S2.0 NO SCALE



11575 SW PACIFIC HWY # 2262 * TIGARD, OREGON 97225
OFFICE: 971.233.6099 * MOBILE: 971.233.6099 *
* DENNIS@VISTASTRUCTURAL.COM * VISTASTRUCTURAL.COM

CLIENT: WALKER CUSTOM HOMES, LLC

JOB TITLE: WLO010 WEGNER

LOT 10, WOODLAND OAKS - FINAL PLAT





LOCATION: 2528 NE WOODLAND OAK DR.

LEE'S SUMMIT, MISSOURI





NO.	DATE	REVISION	BY
DRAWING TITLE			
FOUNDATION DETAILS			
ENGINEER: DMH		CHECKED BY: DMH	
JOB NO.		DRAWN BY: DMH	
DATE: 01-18-24			
SHEET NUMBER			

S2.0

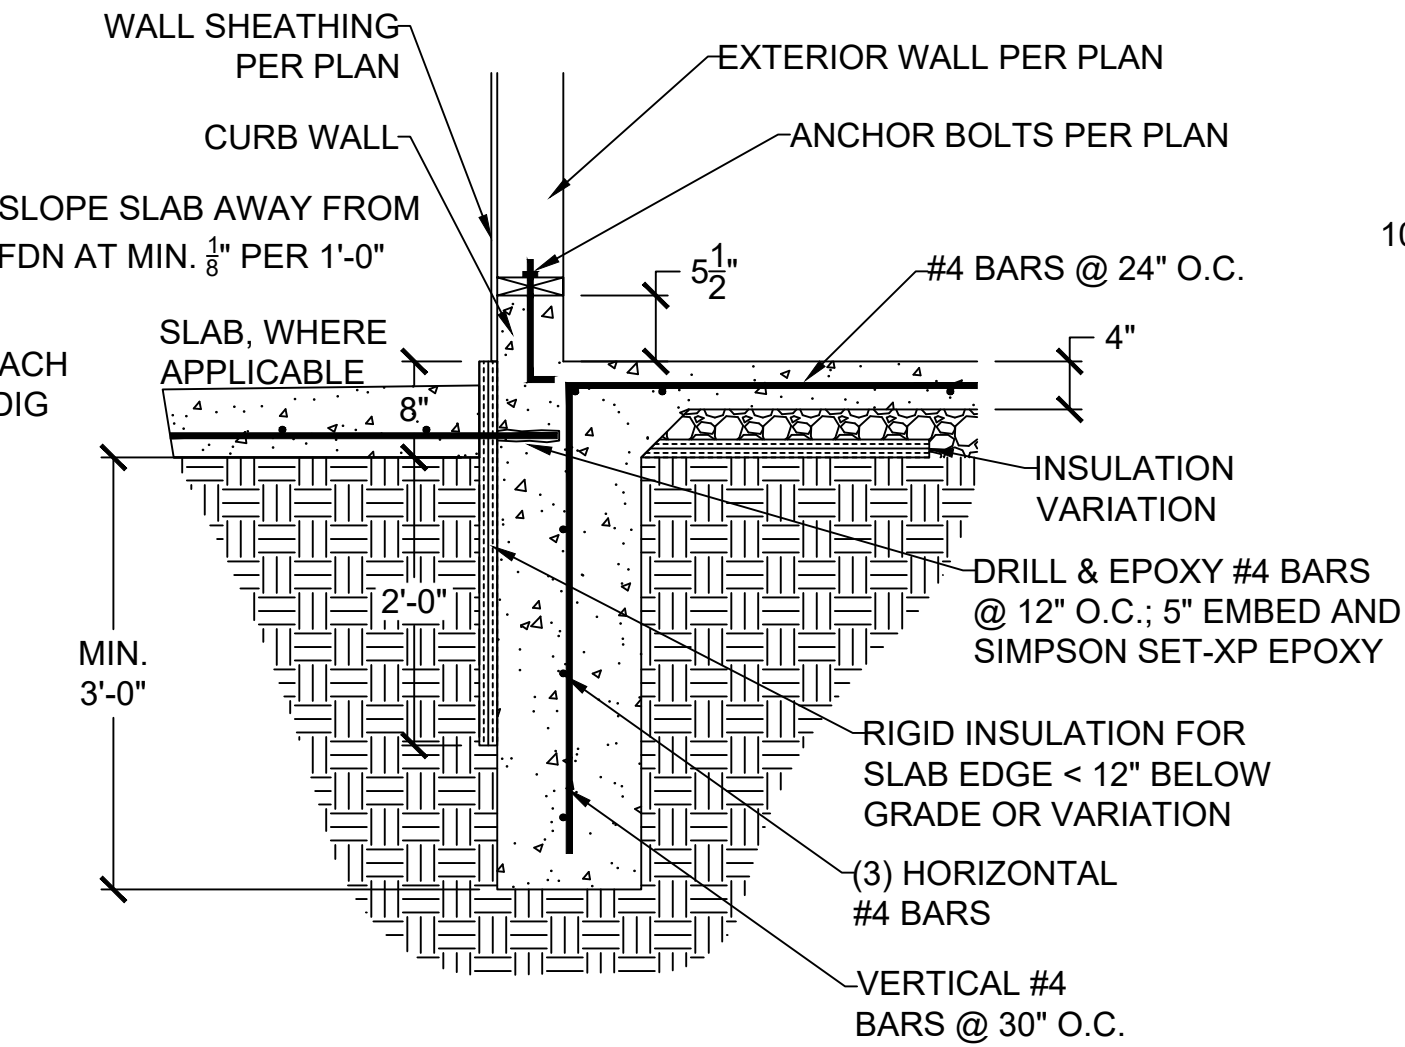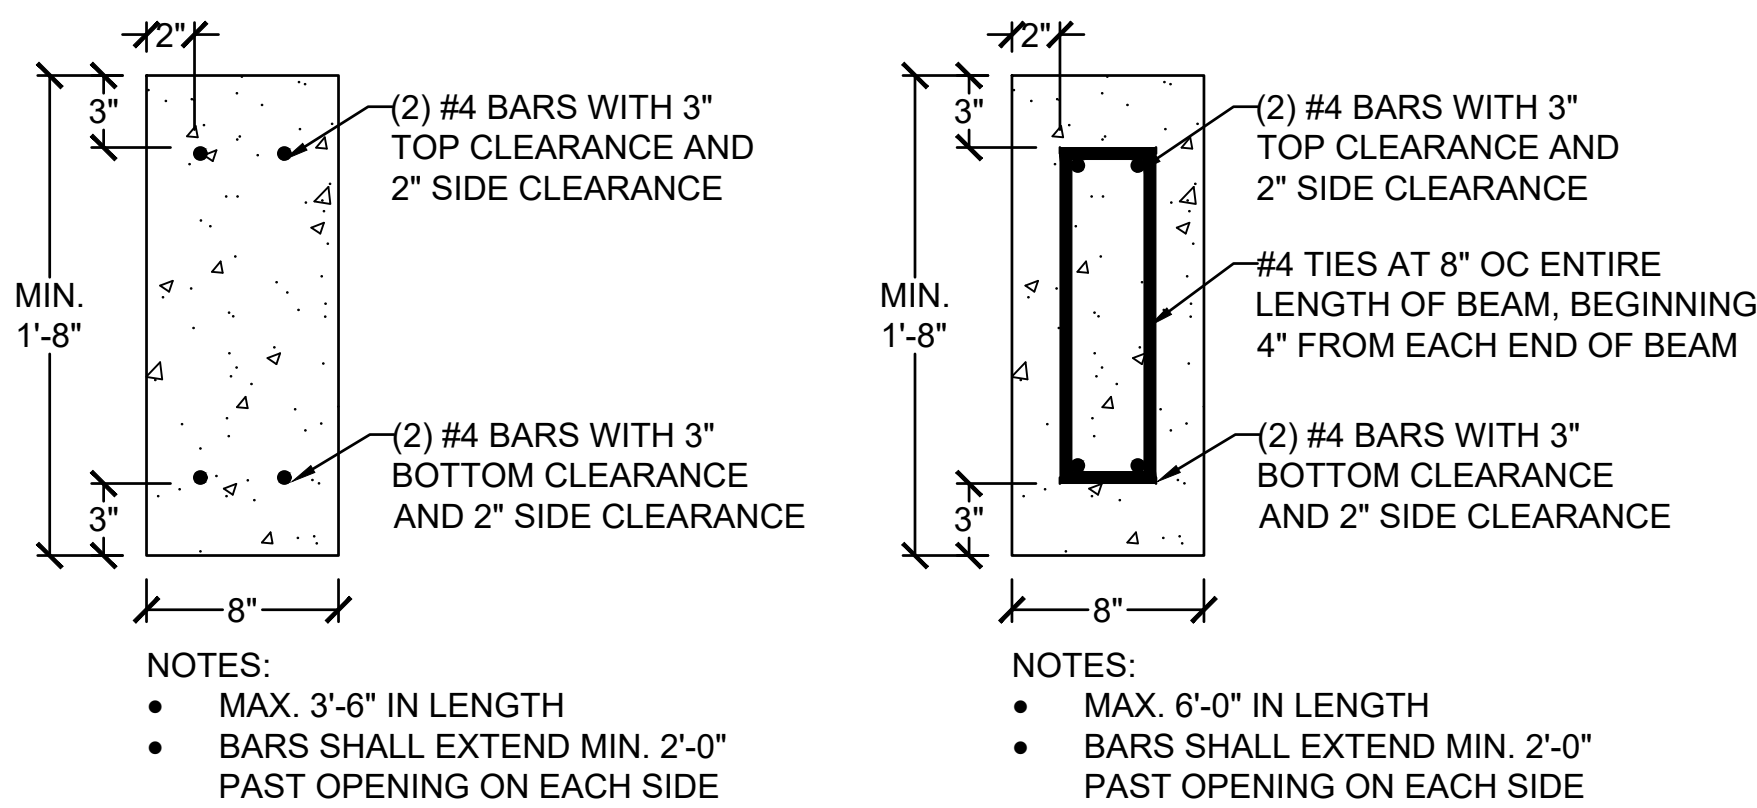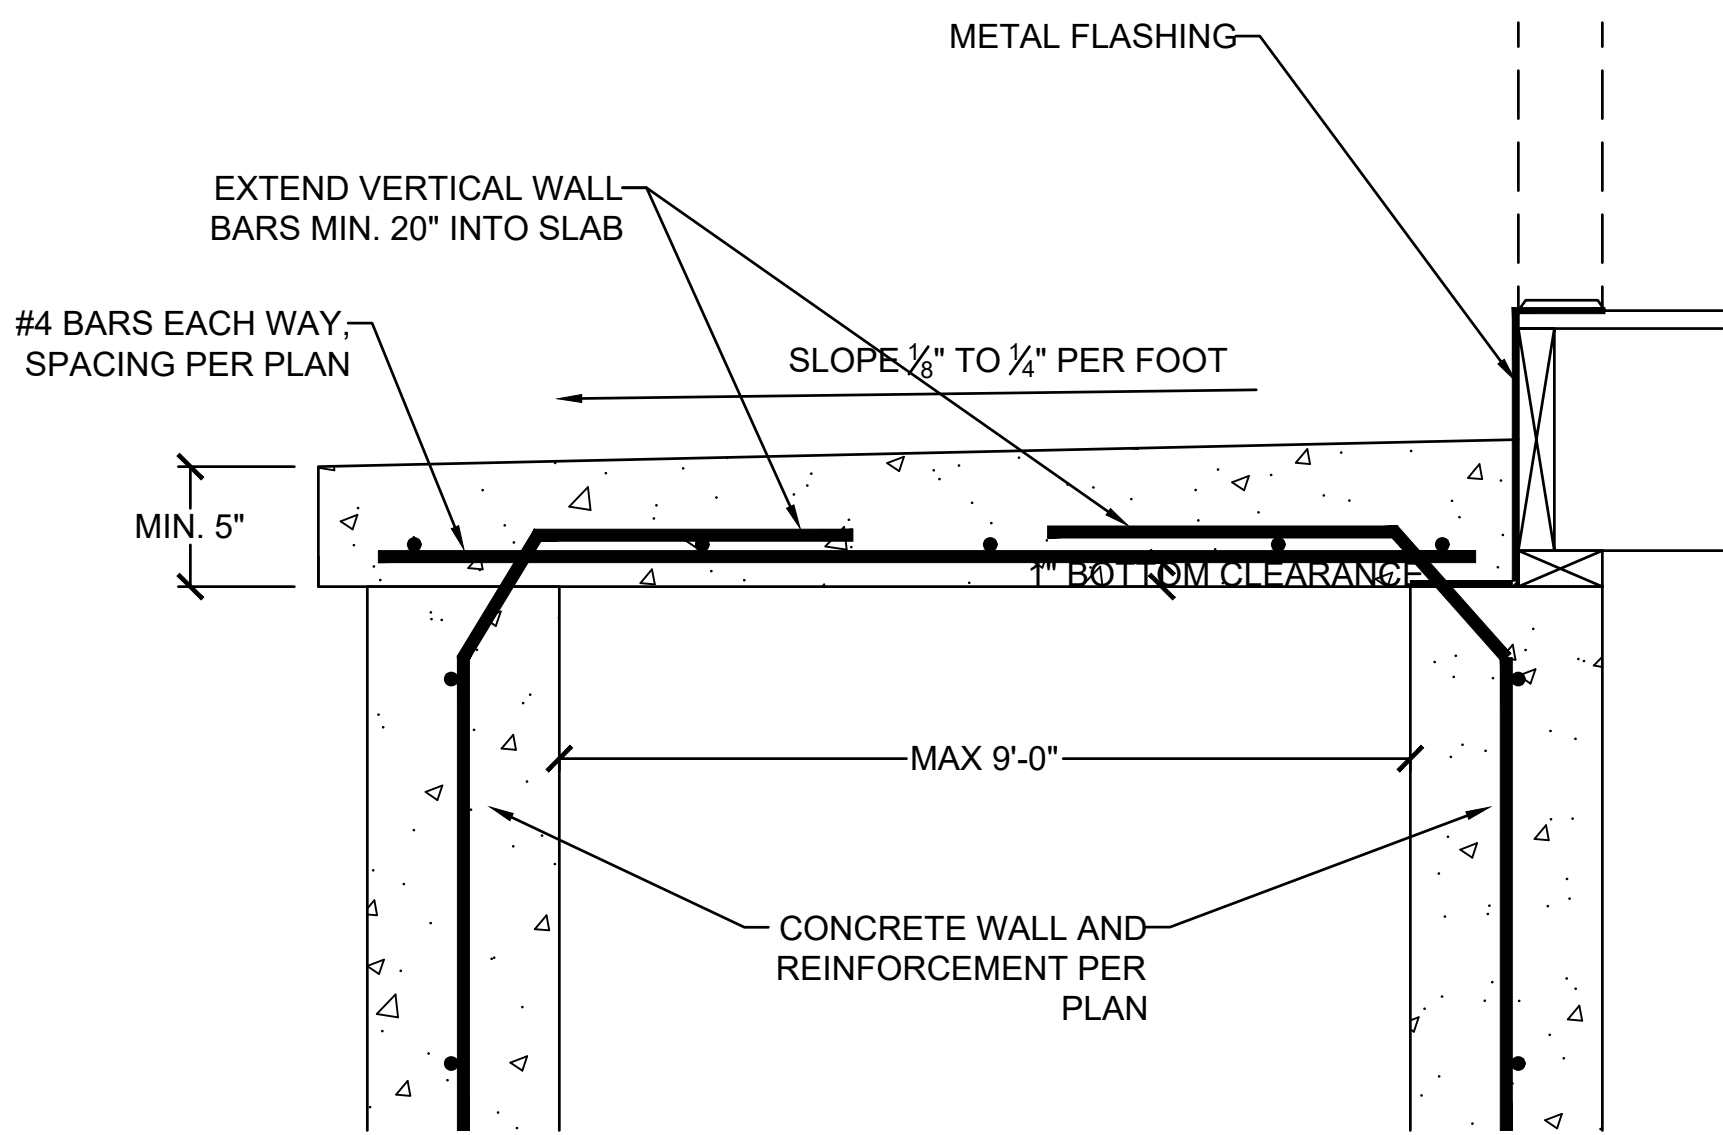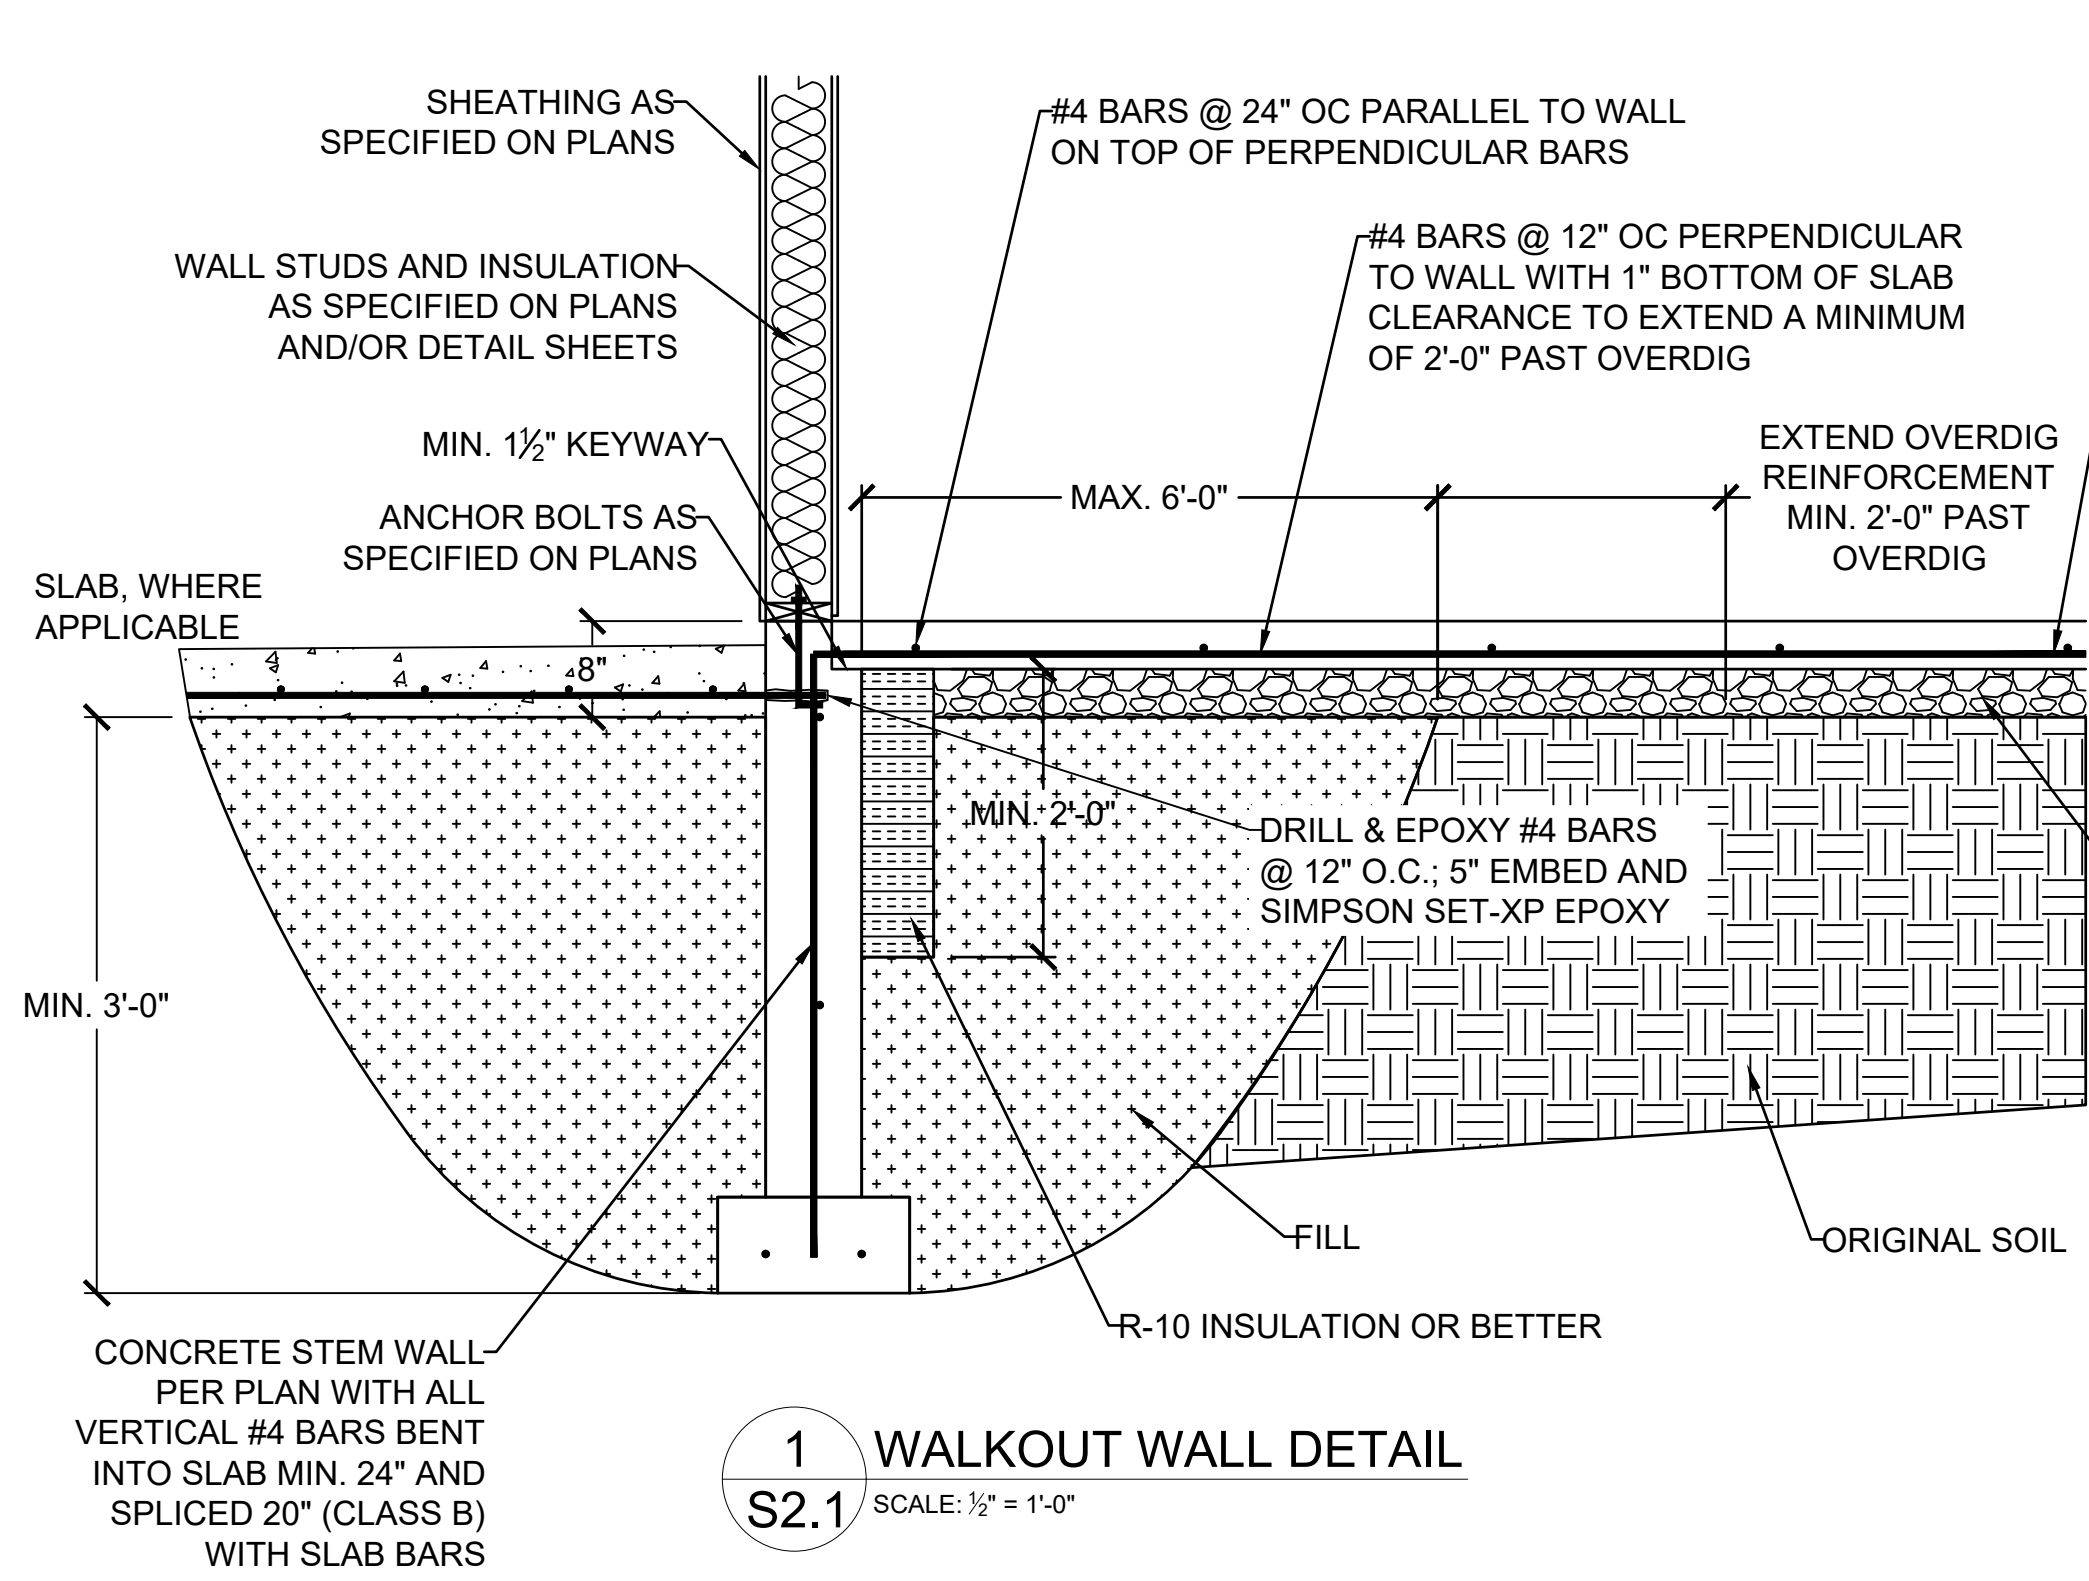


1 WALKOUT FOUNDATION DETAIL
S2.1 SCALE: 1/2" = 1'-0"


(ALTERNATE)

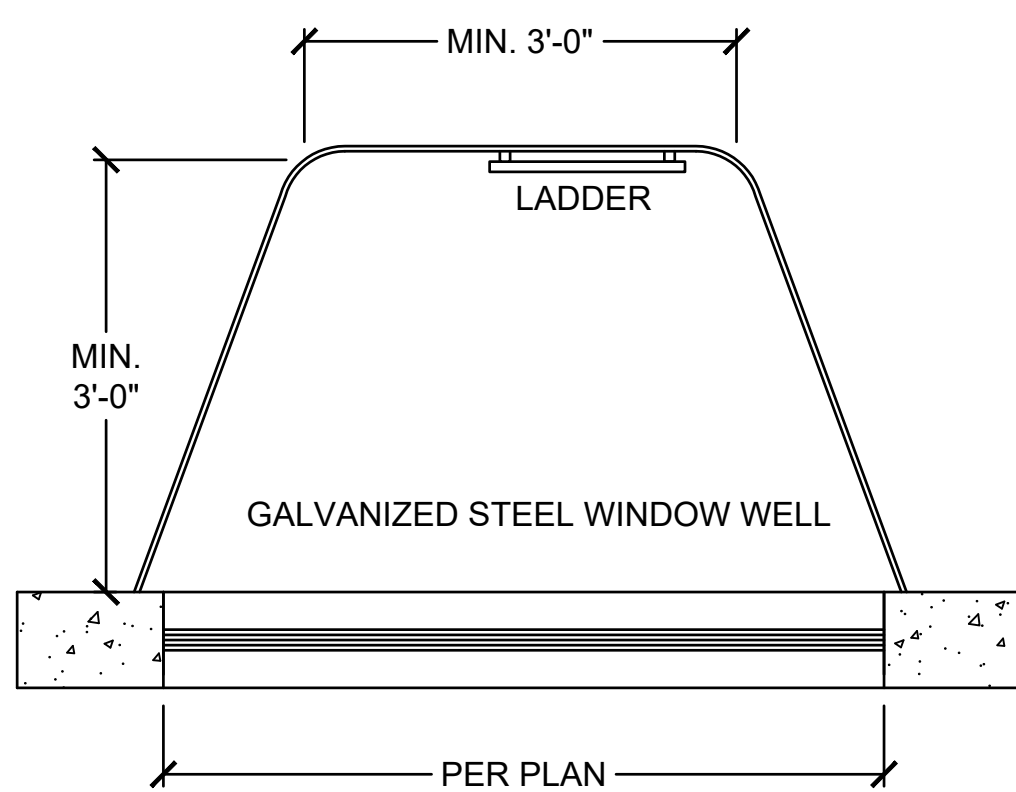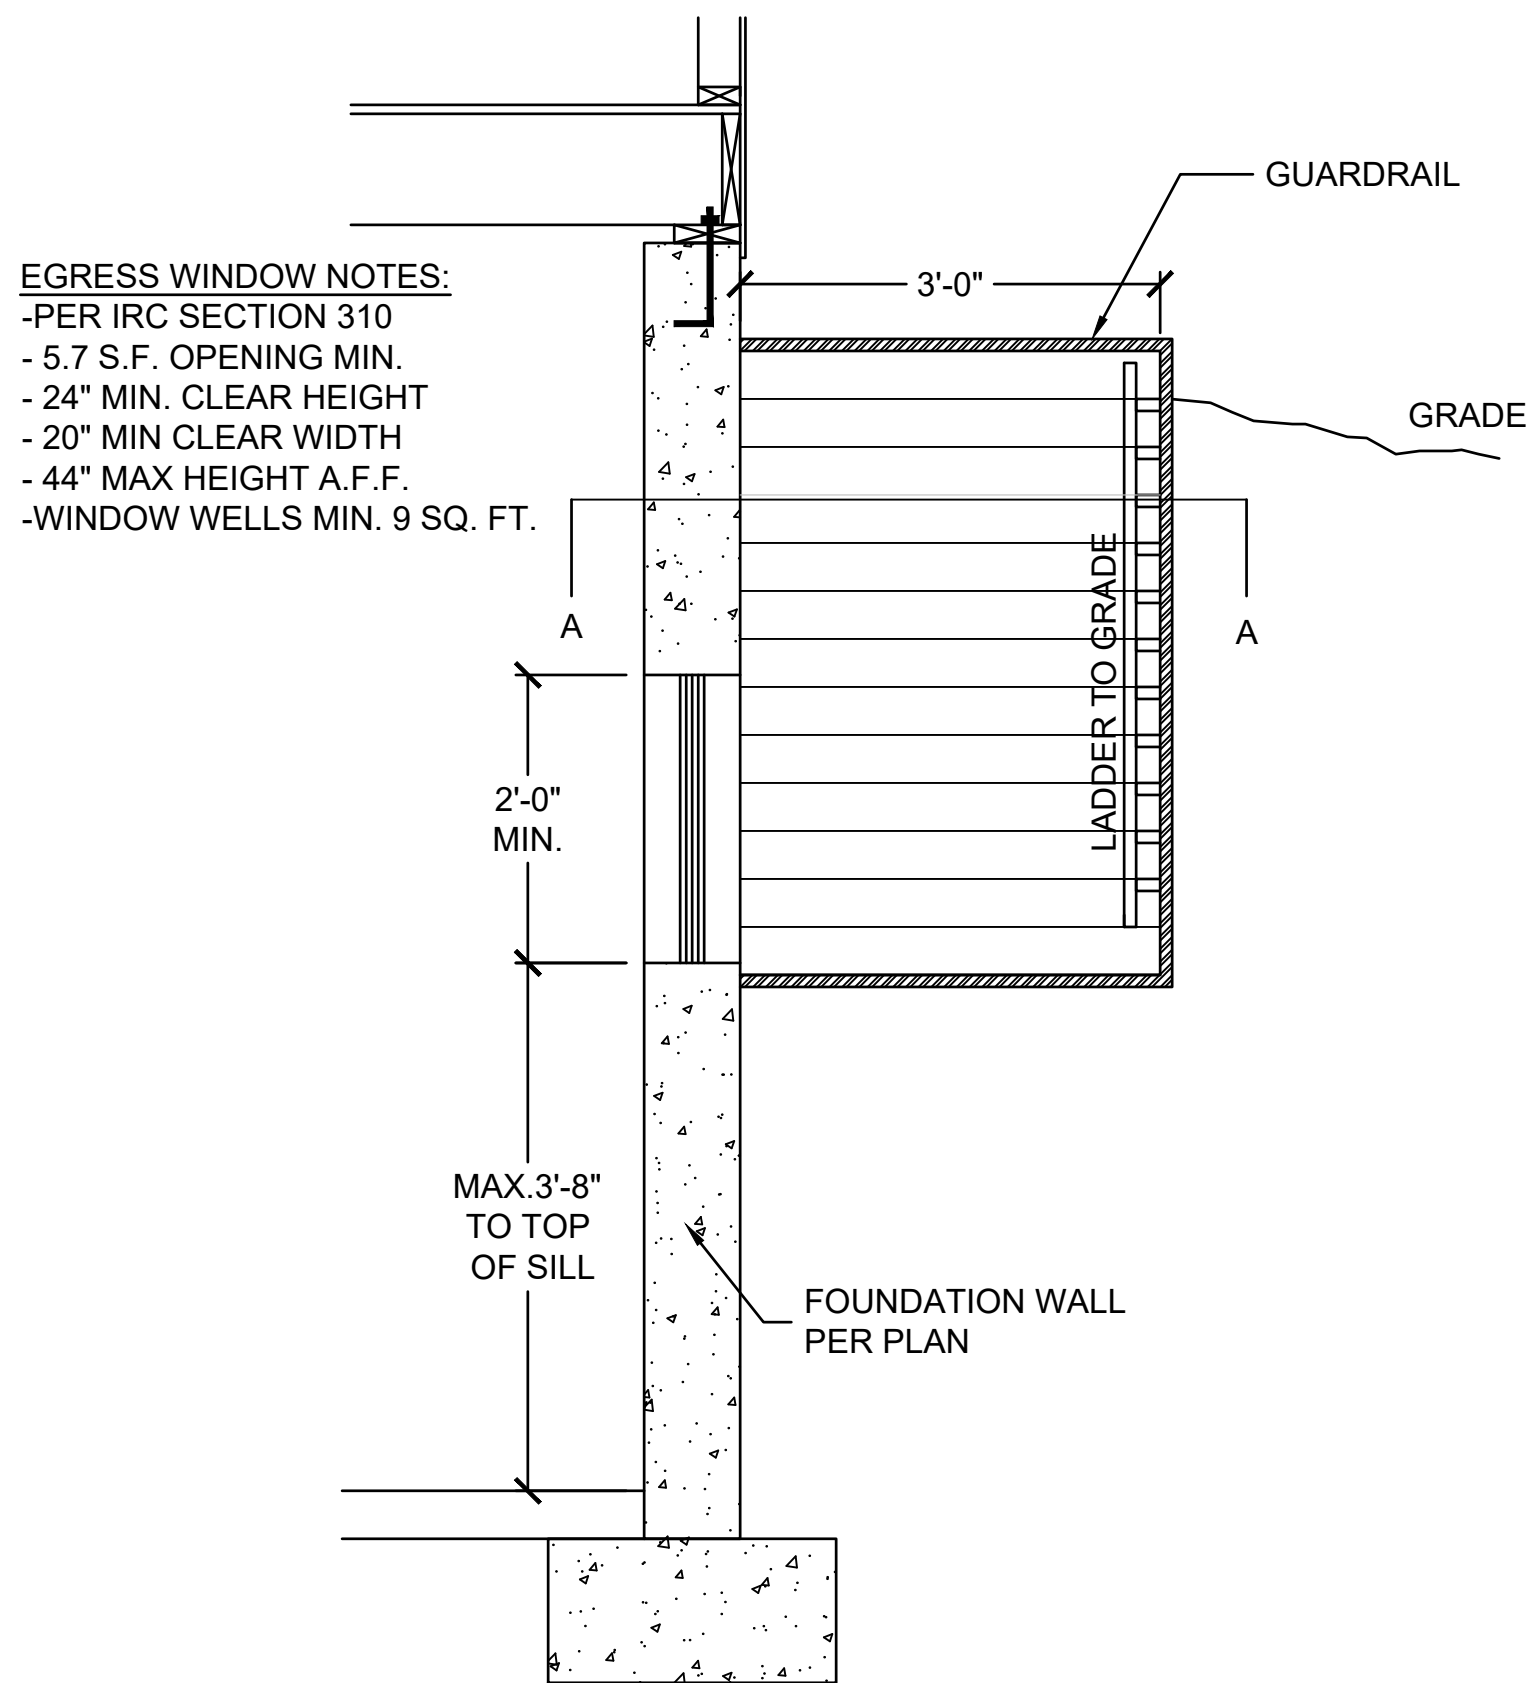


SECTION A-A

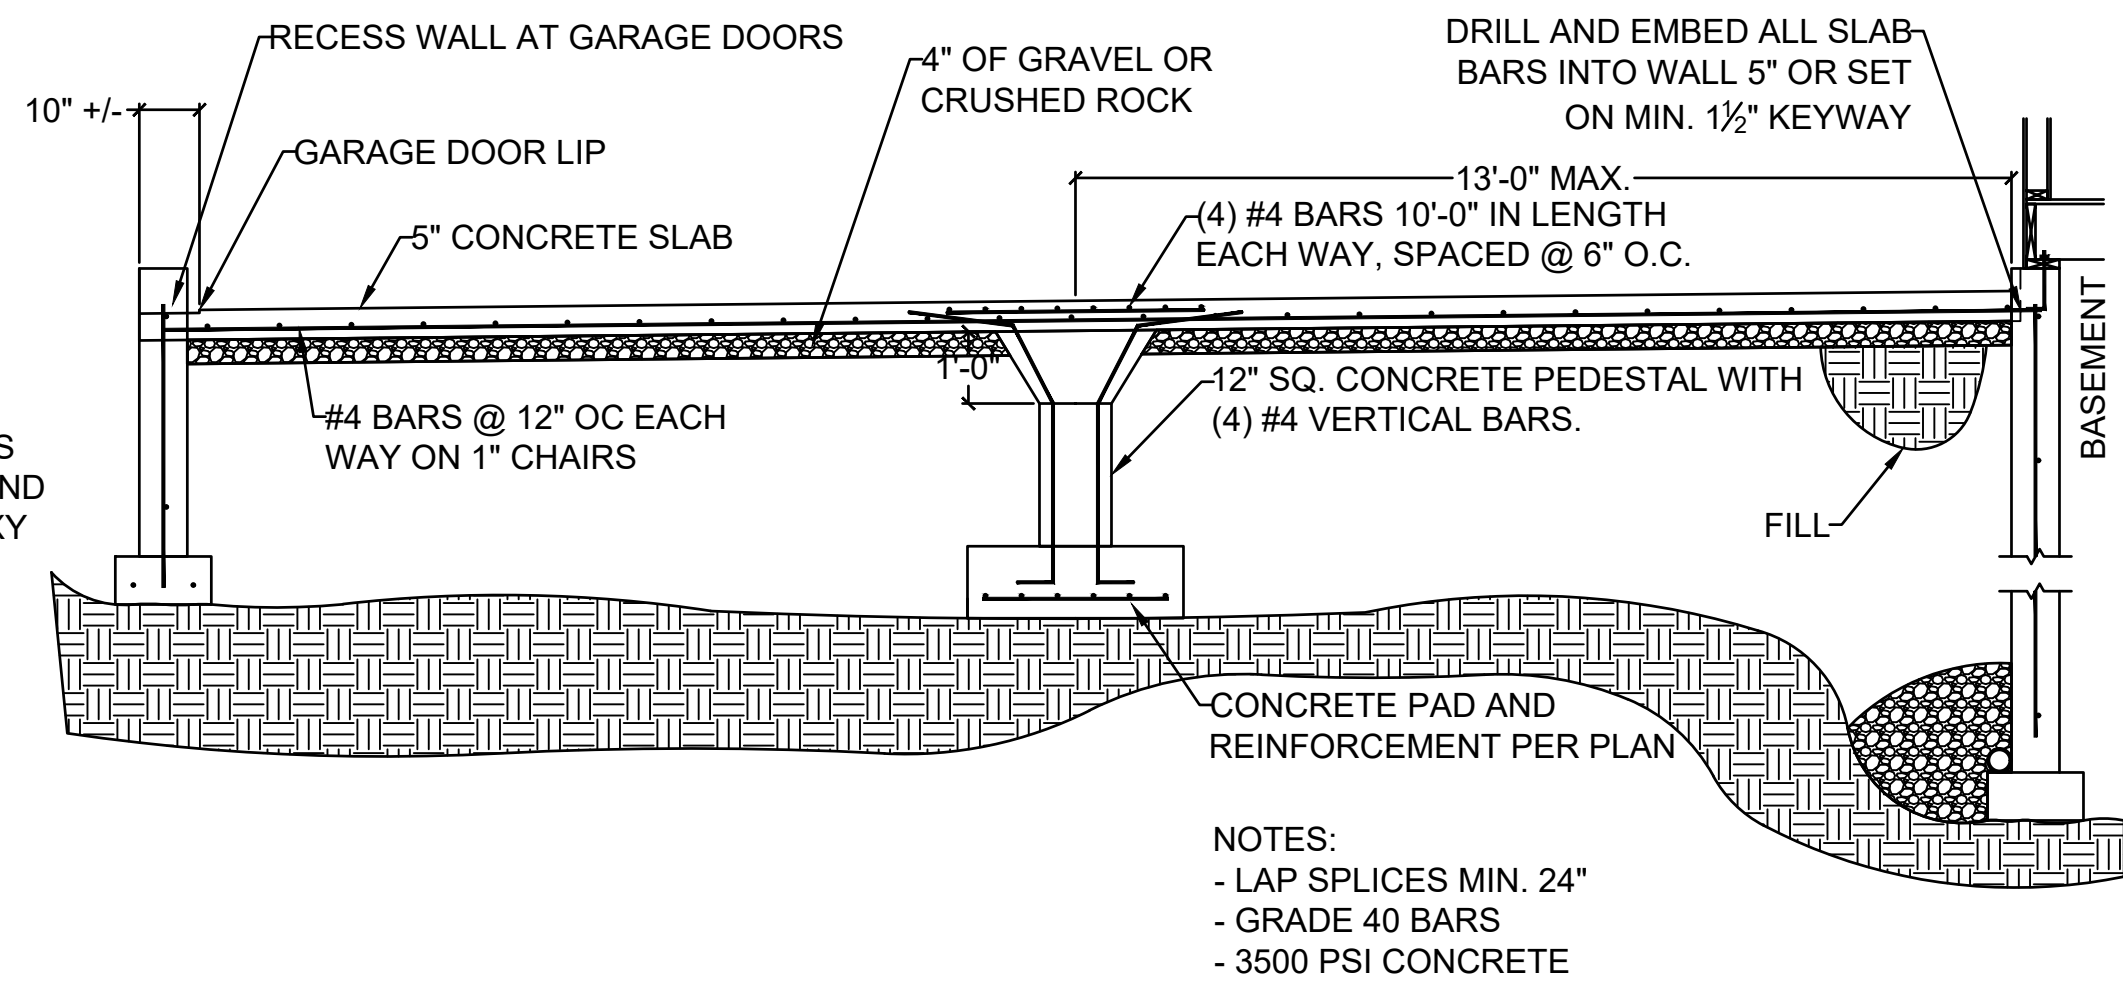


- NOTES:
- LAP SPLICES MIN. 24"
- GRADE 40 BARS
- 3500 PSI CONCRETE

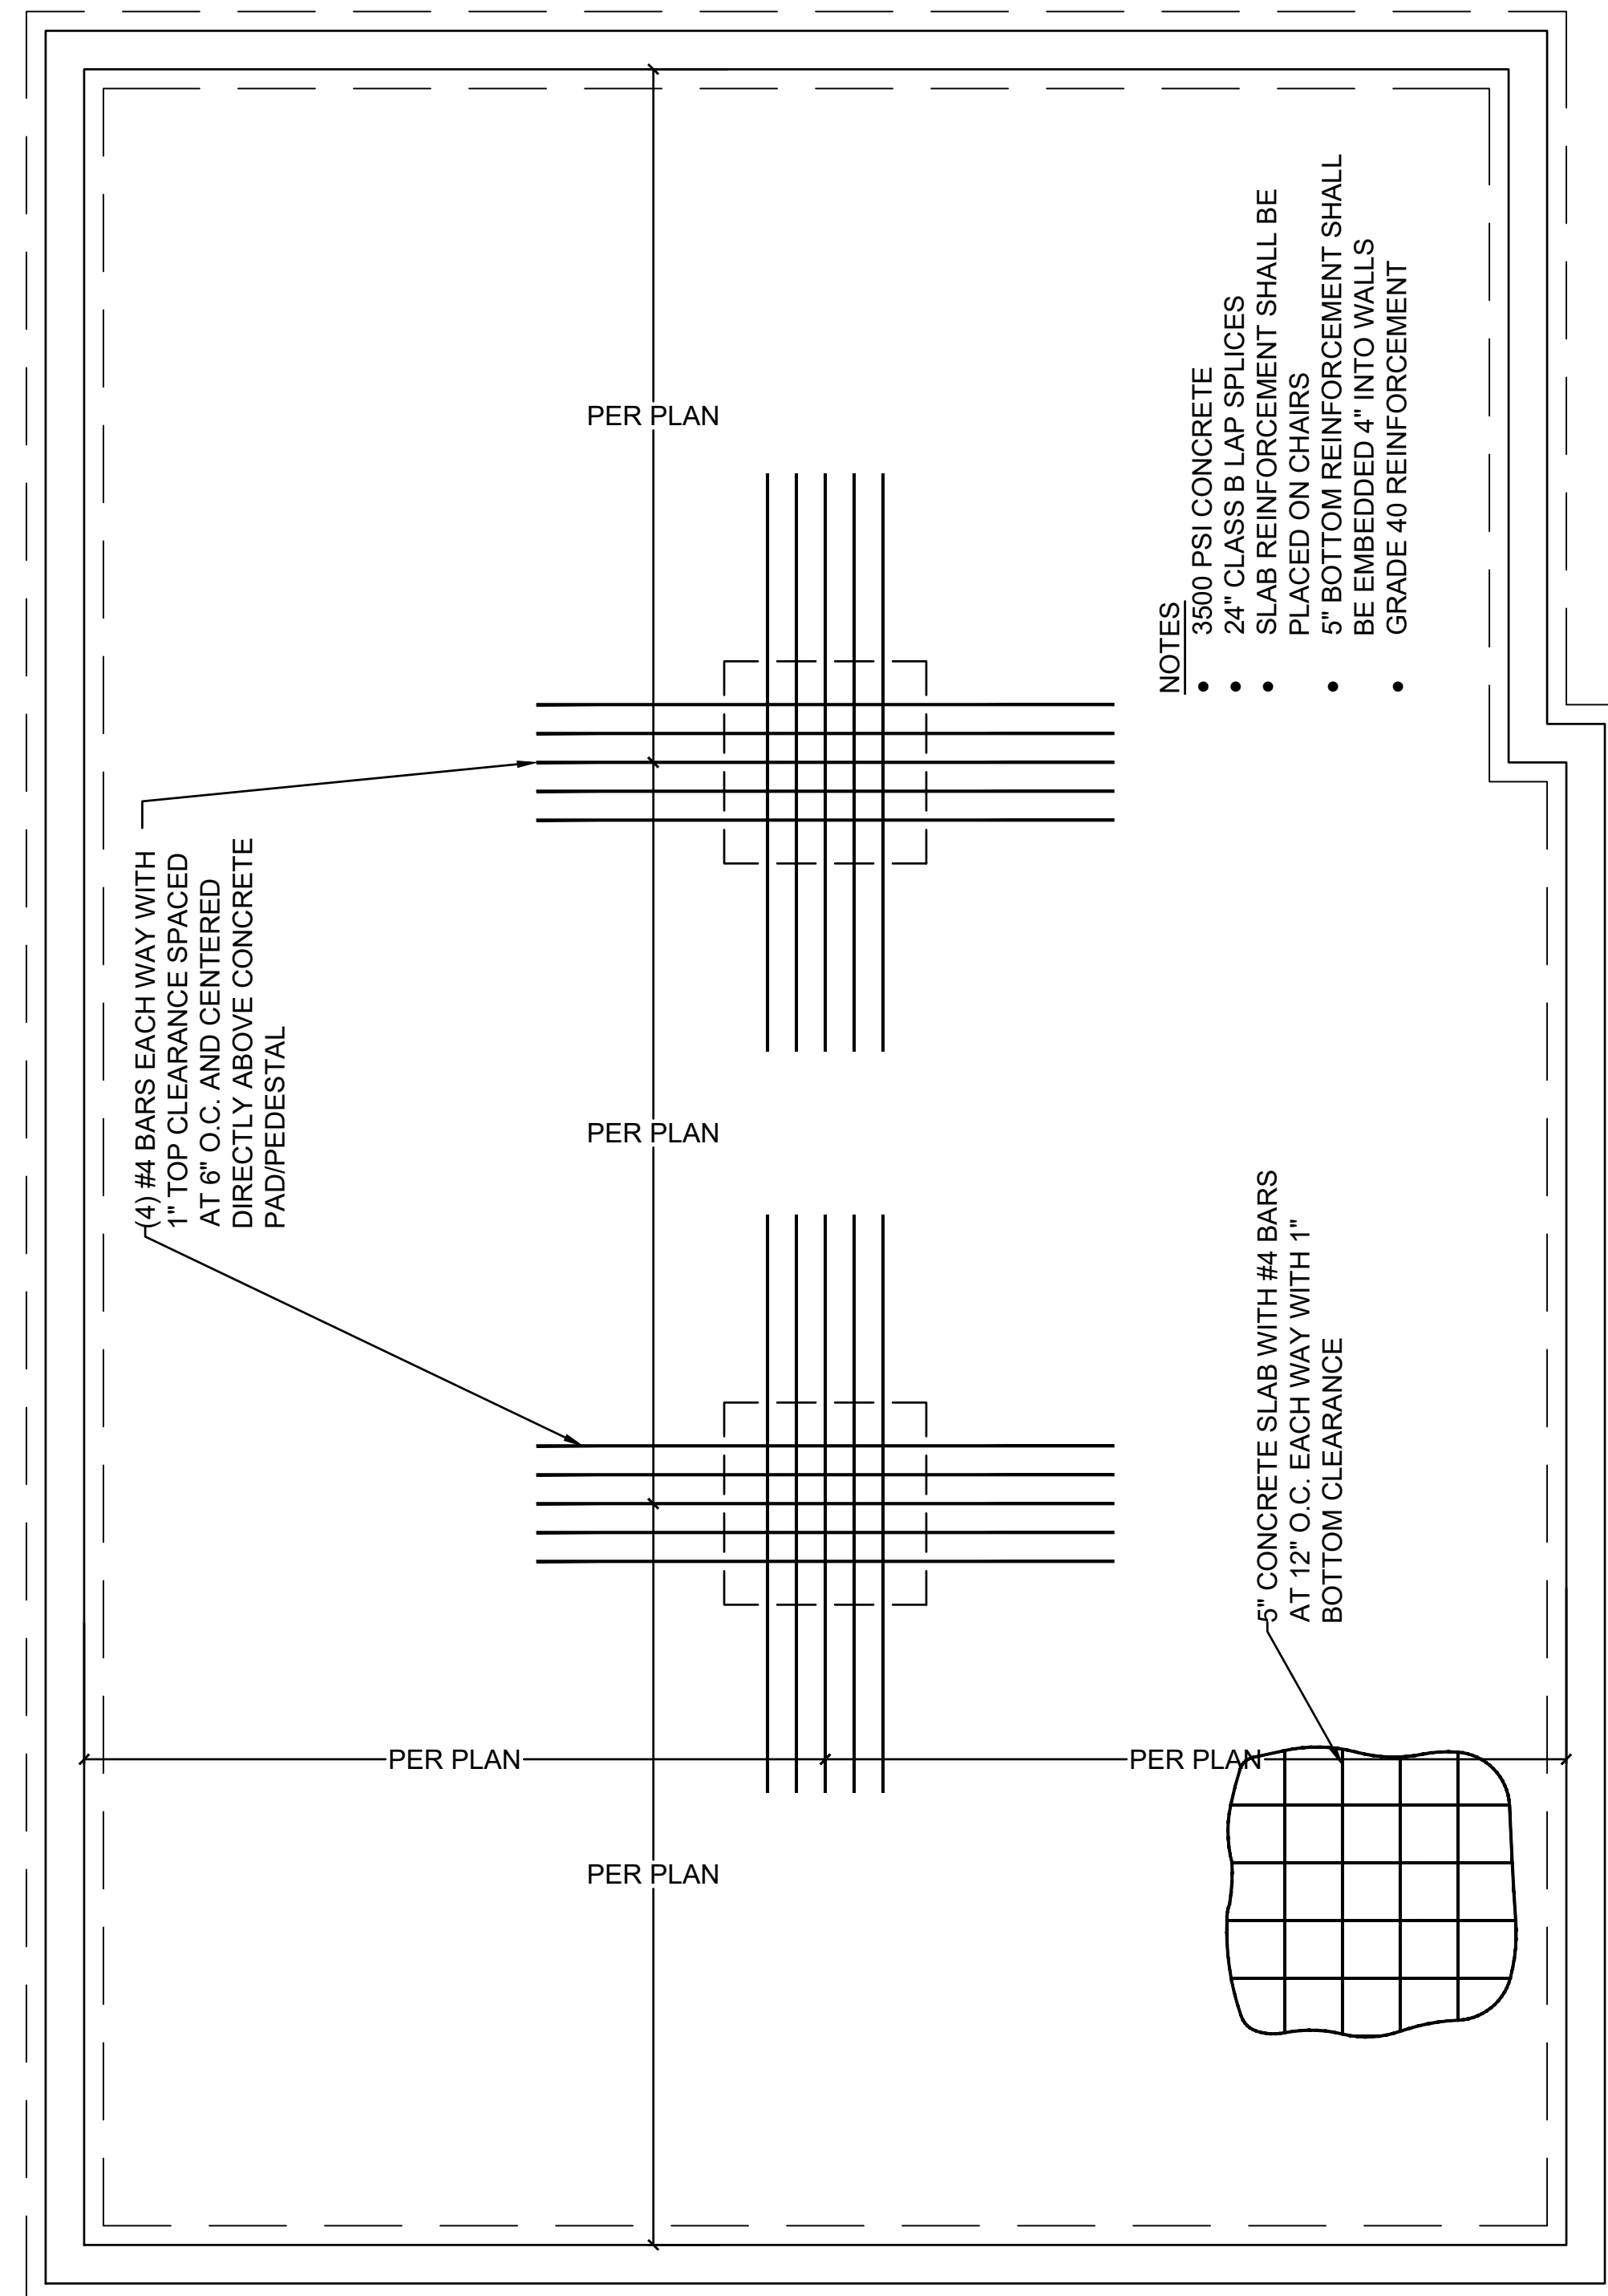


- NOTES:
• 3500 PSI CONCRETE
• 24" CLASS B LAP SPLICES
• SLAB REINFORCEMENT SHALL BE PLACED ON CHAIRS
• 5" BOTTOM REINFORCEMENT SHALL BE EMBEDDED 4" INTO WALLS
• GRADE 40 REINFORCEMENT

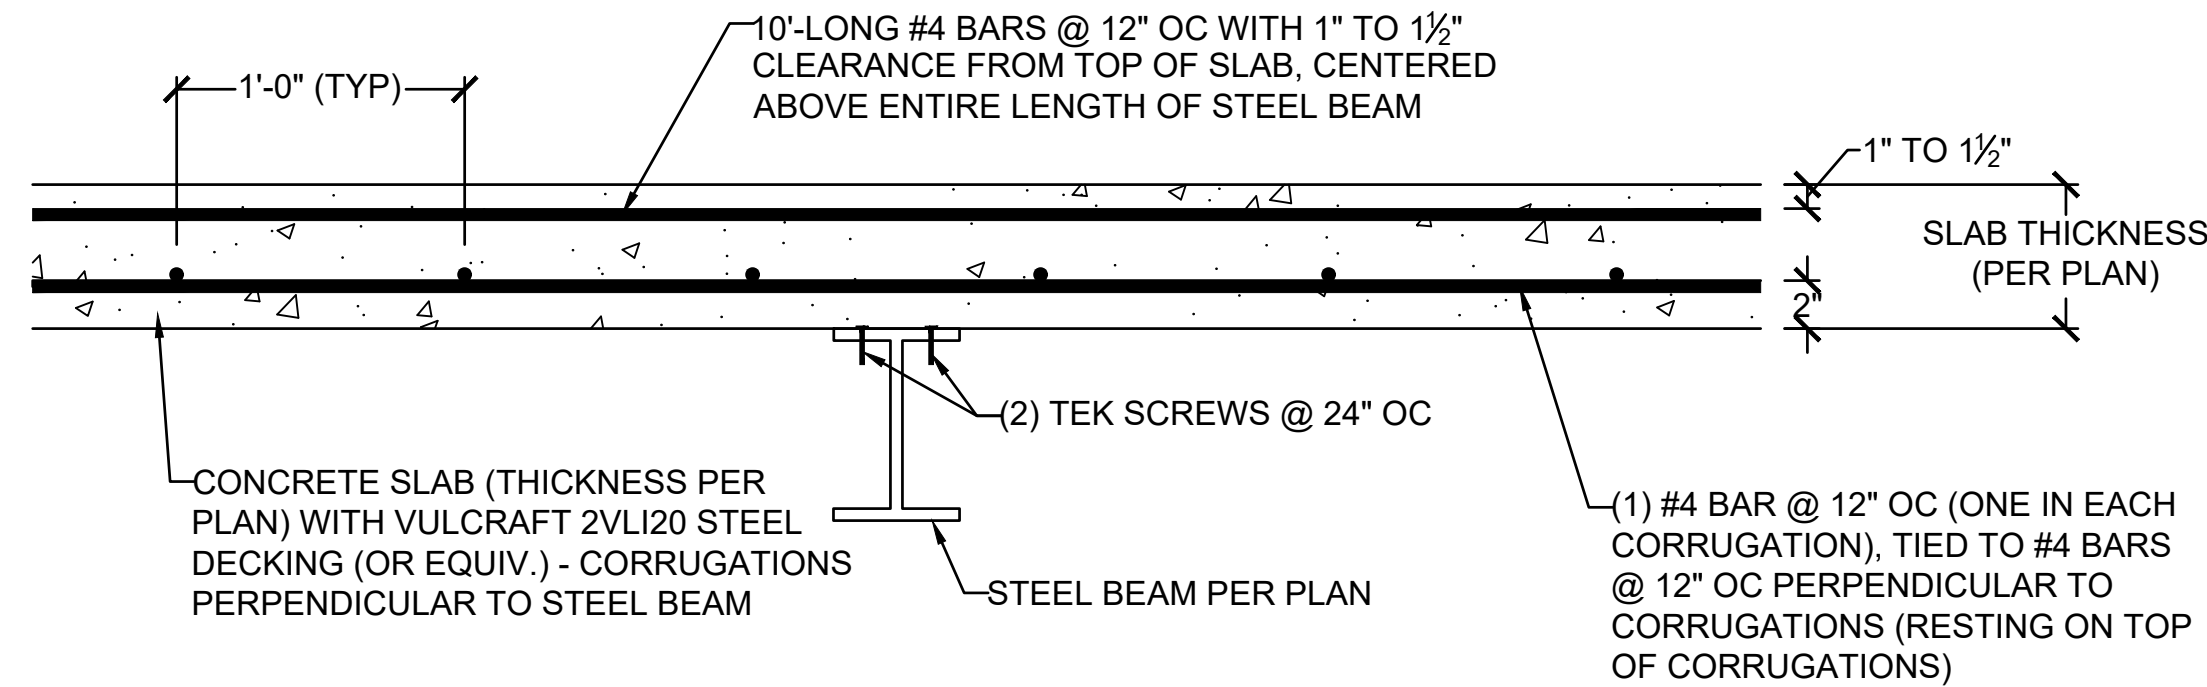


1 SUSPENDED SLAB CROSS SECTION AT STEEL BEAM
S2.2 SCALE: 1" = 1'-0" (18x24) OR 1 1/2" = 1'-0" (24x36)

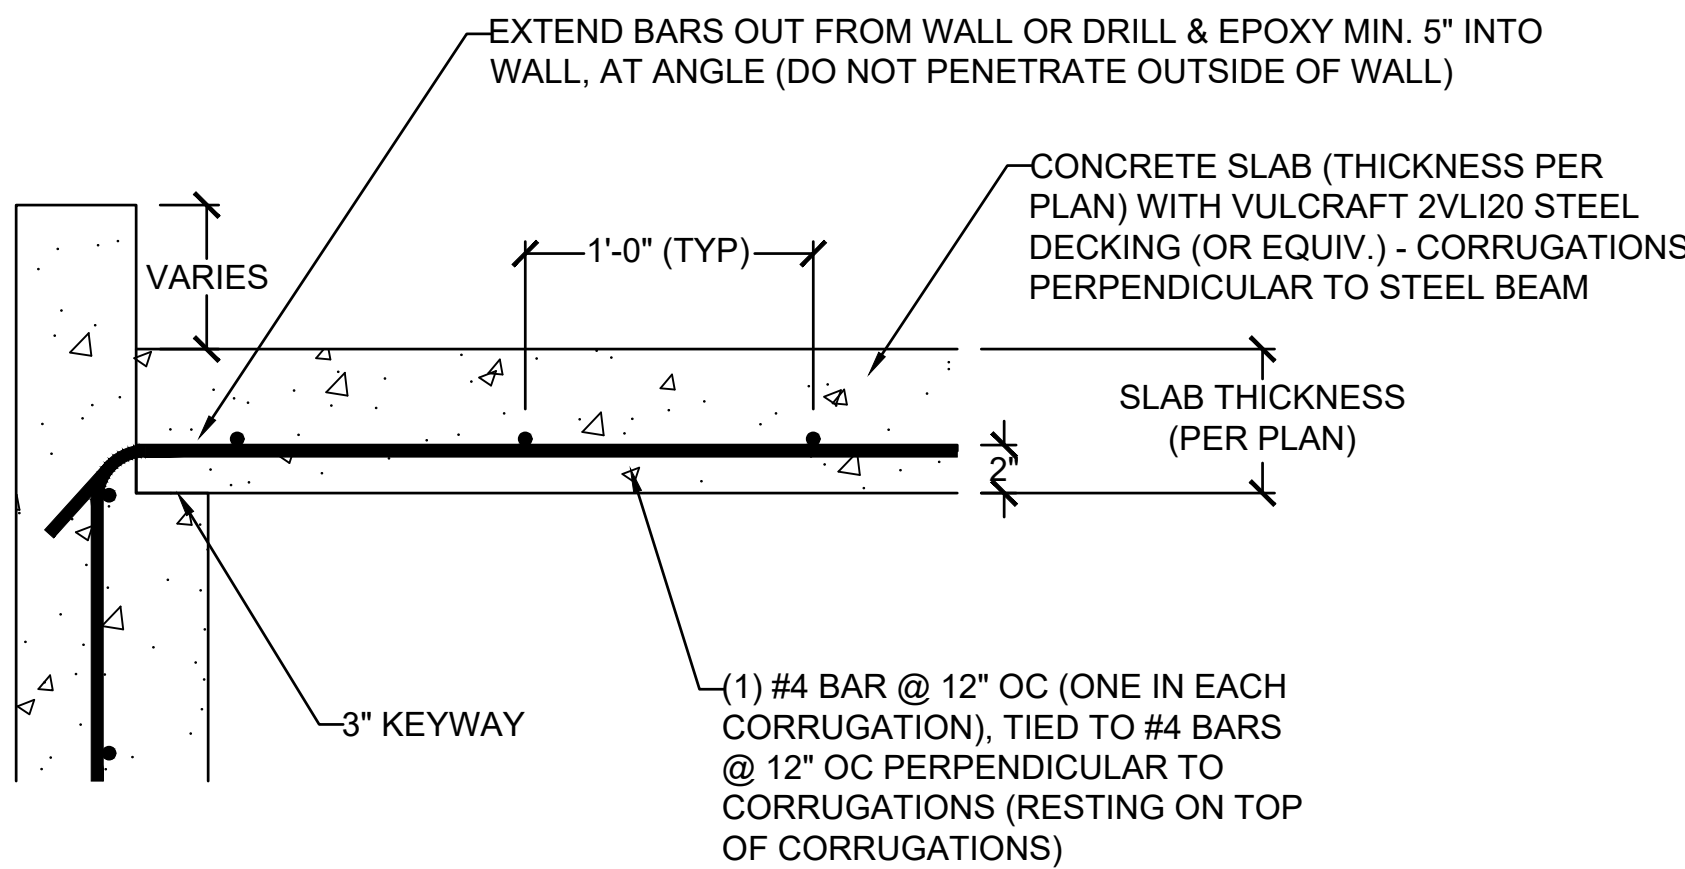


2 SUSPENDED SLAB CROSS SECTION AT WALL
S2.2 SCALE: 1" = 1'-0" (18x24) OR 1 1/2" = 1'-0" (24x36)

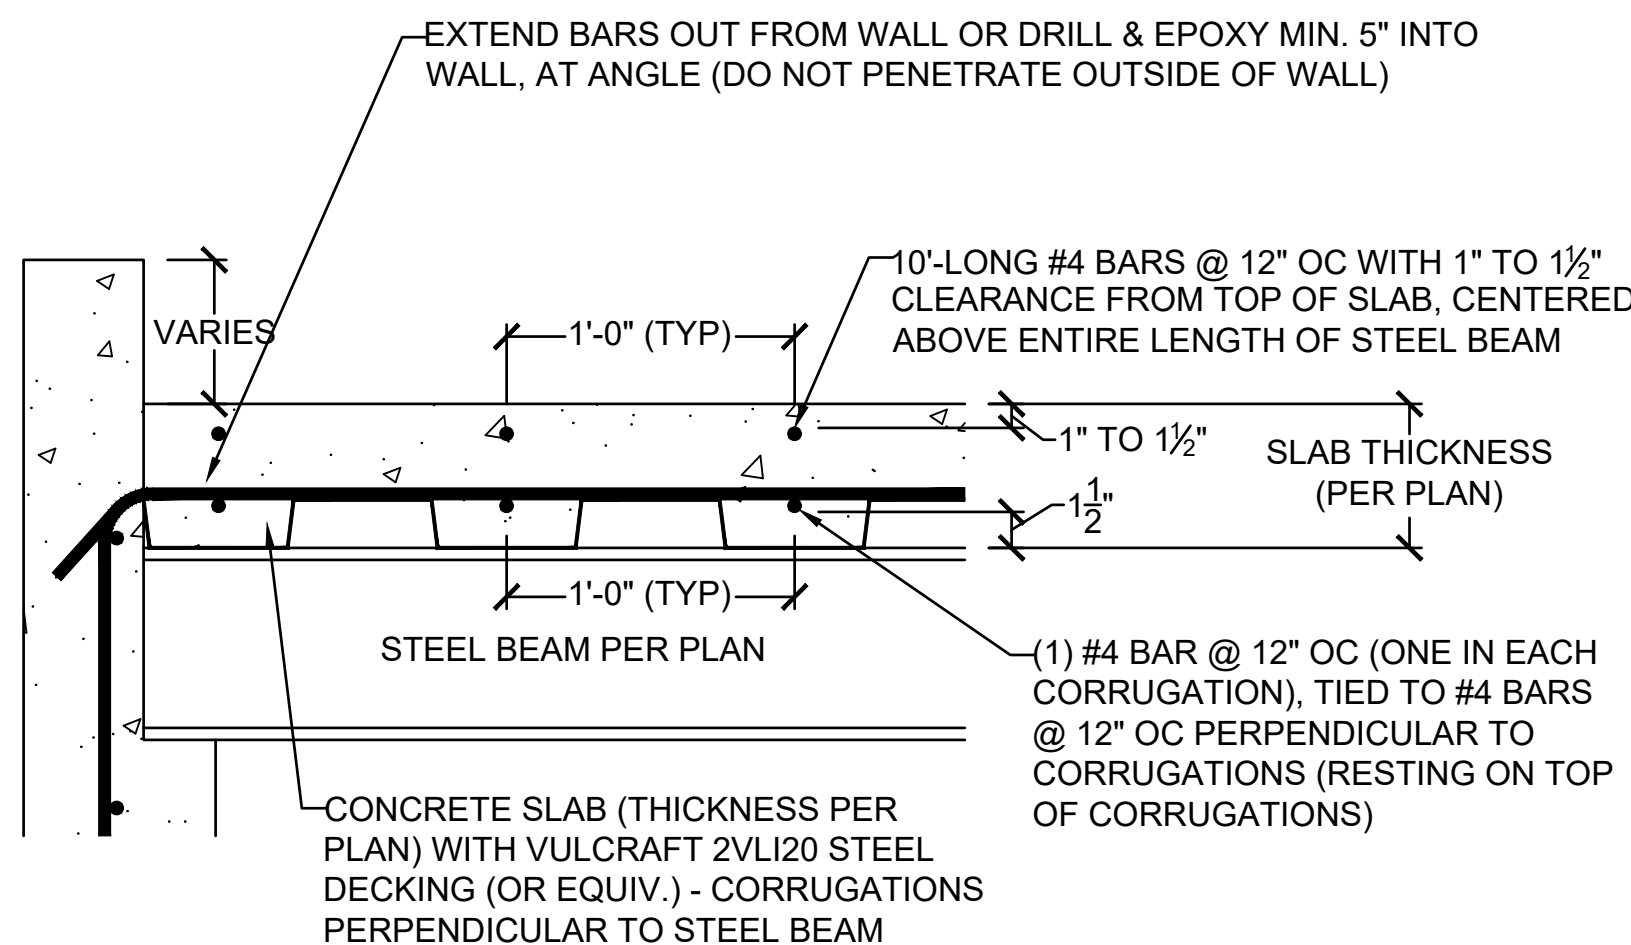


3 SUSPENDED SLAB CROSS SECTION AT STEEL BEAM/WALL
S2.2 SCALE: 1" = 1'-0" (18x24) OR 1 1/2" = 1'-0" (24x36)

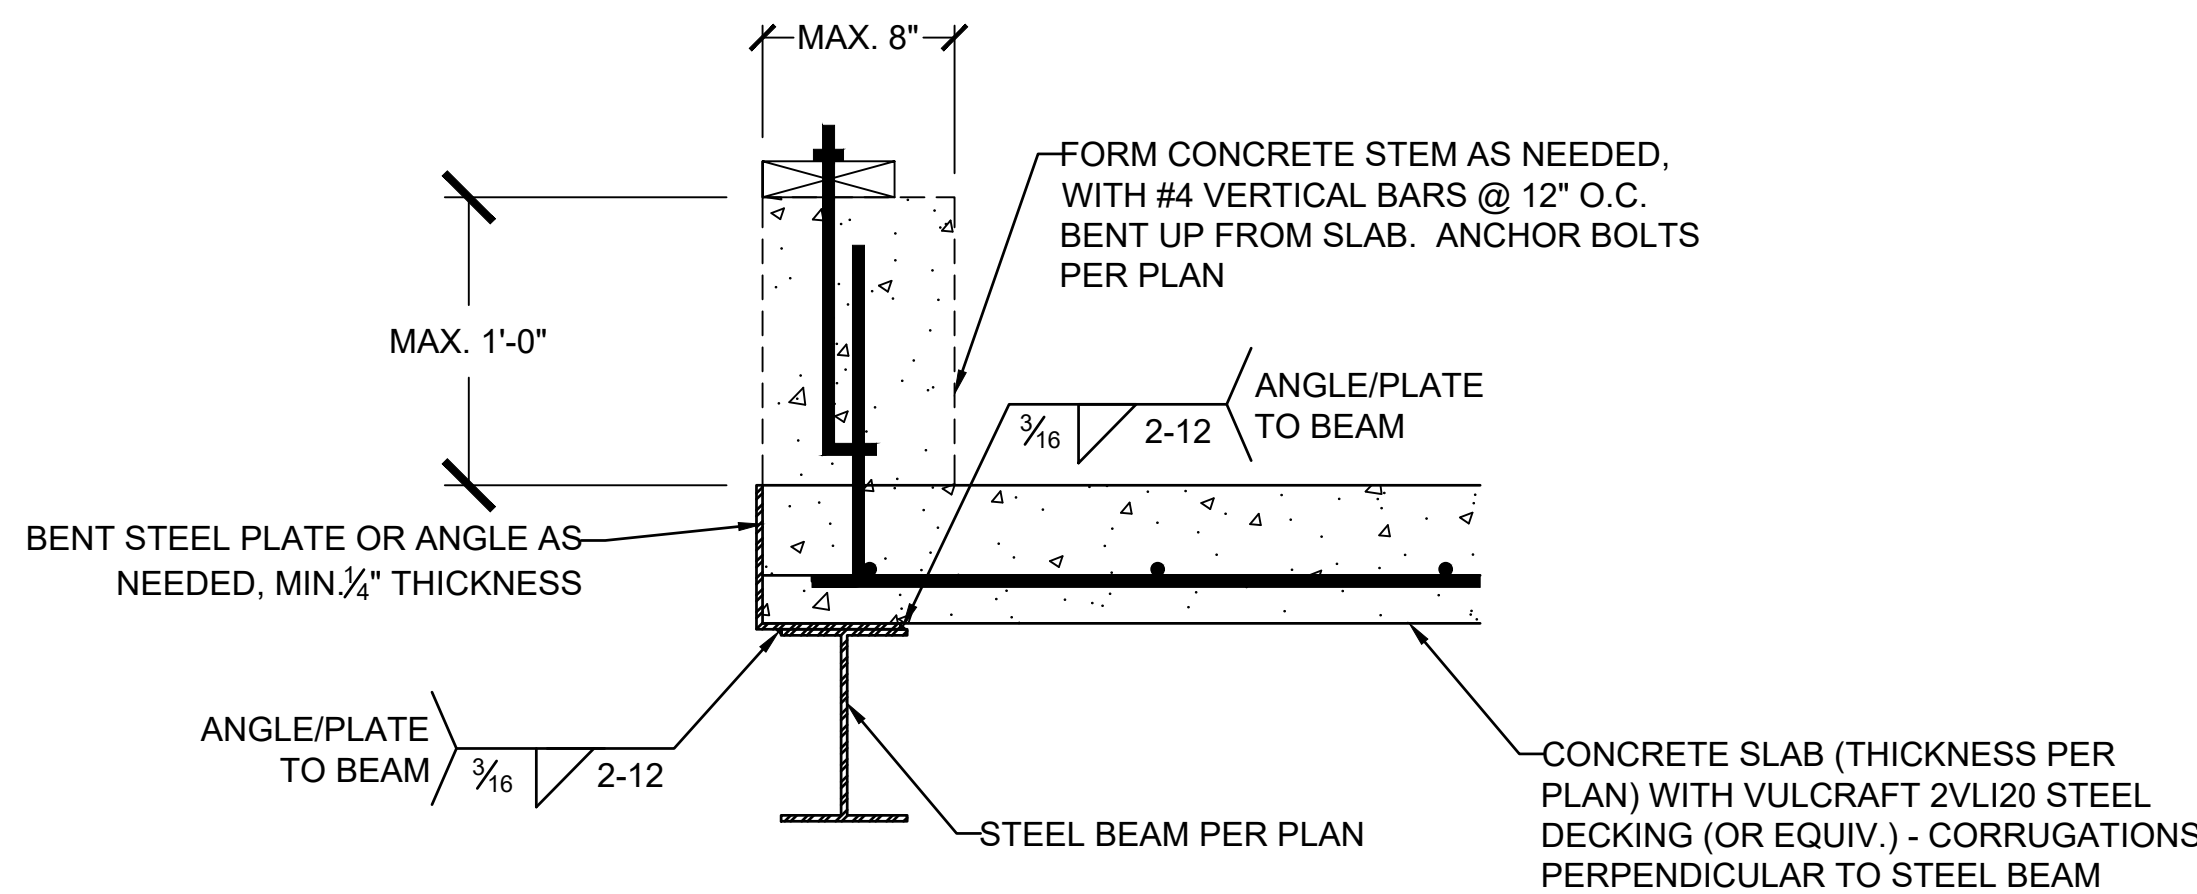

4 SUSPENDED SLAB CROSS SECTION AT POUR STOP
S2.2 SCALE: 1" = 1'-0" (18x24) OR 1 1/2" = 1'-0" (24x36)

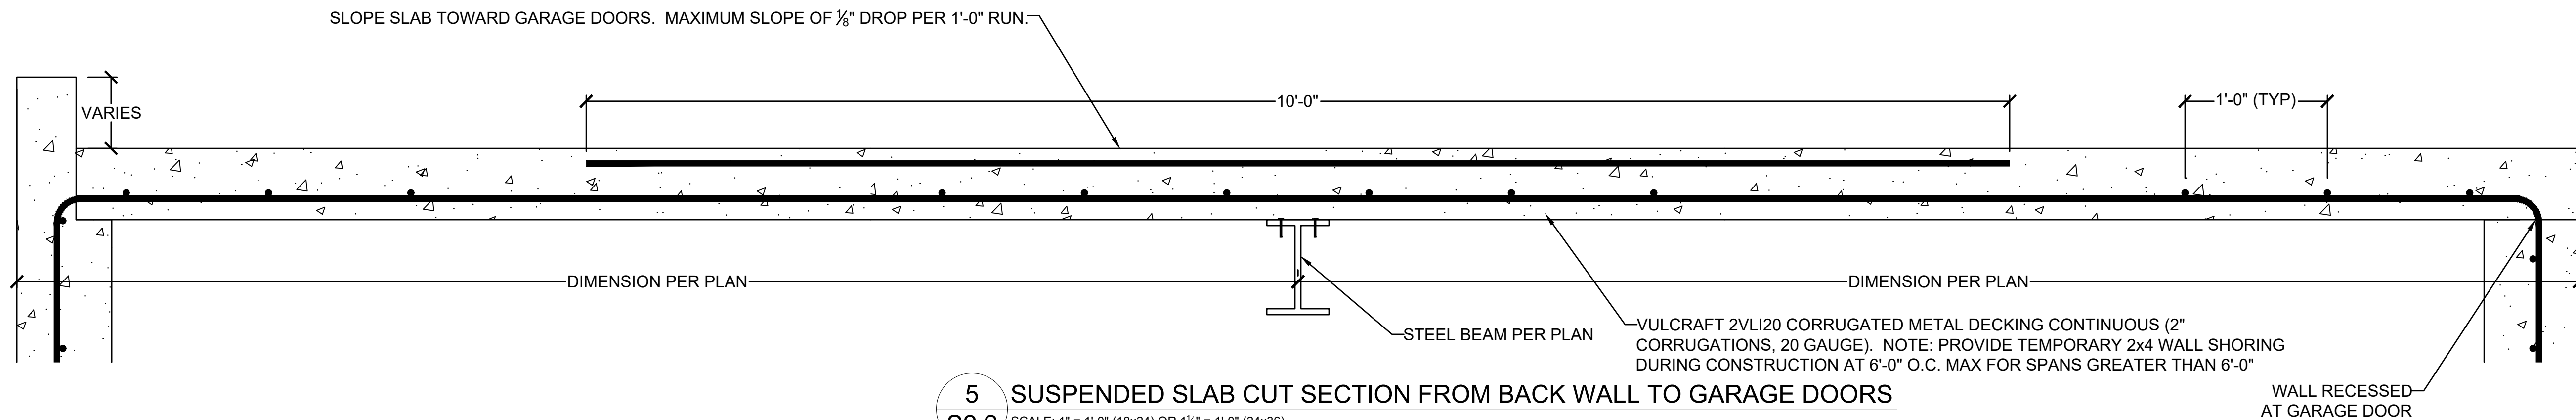

5 SUSPENDED SLAB CUT SECTION FROM BACK WALL TO GARAGE DOORS
S2.2 SCALE: 1" = 1'-0" (18x24) OR 1 1/2" = 1'-0" (24x36)

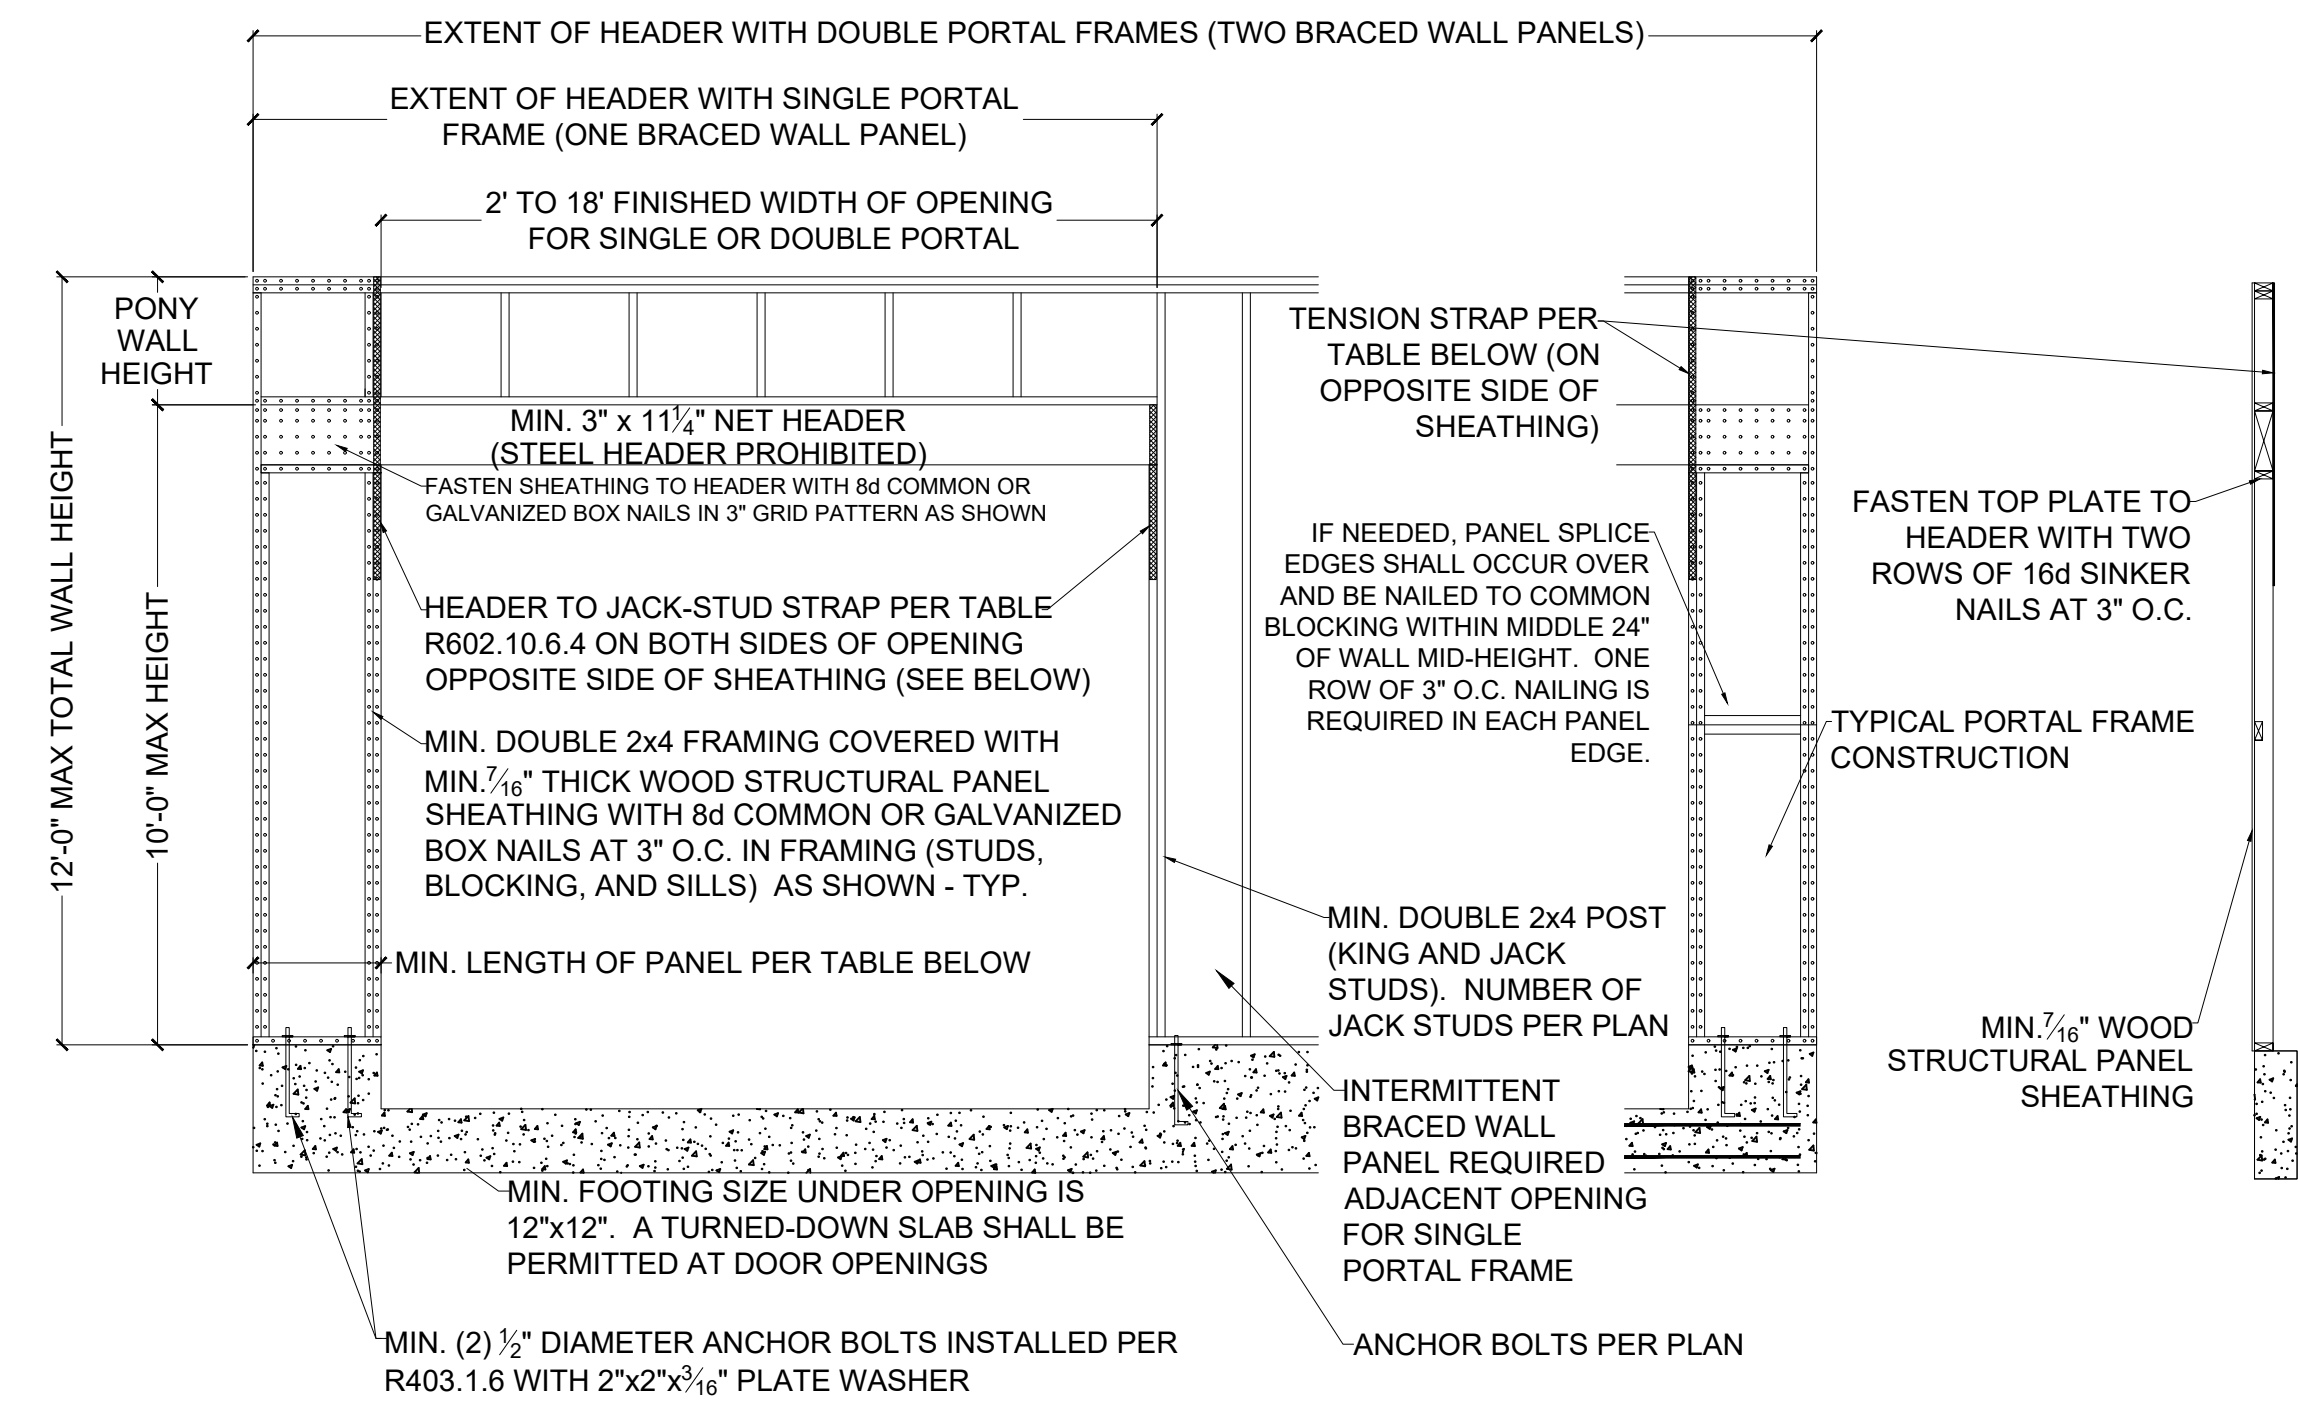


2 METHOD PFG (PORTAL FRAME AT GARAGE
S3.0 DOOR) - PER FIGURE IRC R602.10.6.3

SCALE: $\frac{1}{4}" = 1'-0"$ (18x24) OR $\frac{3}{8}" = 1'-0"$ (24x36)

TENSION STRAP REQUIRED FOR HEADER TO JACK STUD FOR DETAILS 1/S3.0 AND 2/S3.0 (FROM TABLE R602.10.6.4)			
MAX GARAGE OPENING (FT.)	PONY WALL WALL HT. (FT.)	REQUIRED SIMPSON STRAP	NAILS REQUIRED IN EACH STRAP END LENGTH
18'-0"	0'-0"	CS20	0'-9" (7) 8d
9'-0"	1'-0"	CS20	0'-9" (7) 8d
18'-0"	1'-0"	CS14	1'-4" (15) 8d
9'-0"	2'-0"	CS18	0'-11" (9) 8d
18'-0"	2'-0"	CMSTC16	1'-8" (25) 16d SINKER
9'-0"	4'-0"	CMSTC16	1'-8" (25) 16d SINKER
16'-0"	4'-0"	CMST14	2'-6" (33) 10d

MINIMUM PANEL LENGTH FOR DETAIL 2/S3.0 (INCHES)				
WALL HEIGHT				
8 FEET	9 FEET	10 FEET	11 FEET	12 FEET
24	27	30	33 ^a	36 ^a

a. Maximum opening height for PFG is 10 feet in accordance with Figure R602.10.6.3, but wall height may be increased to 12 feet with pony wall

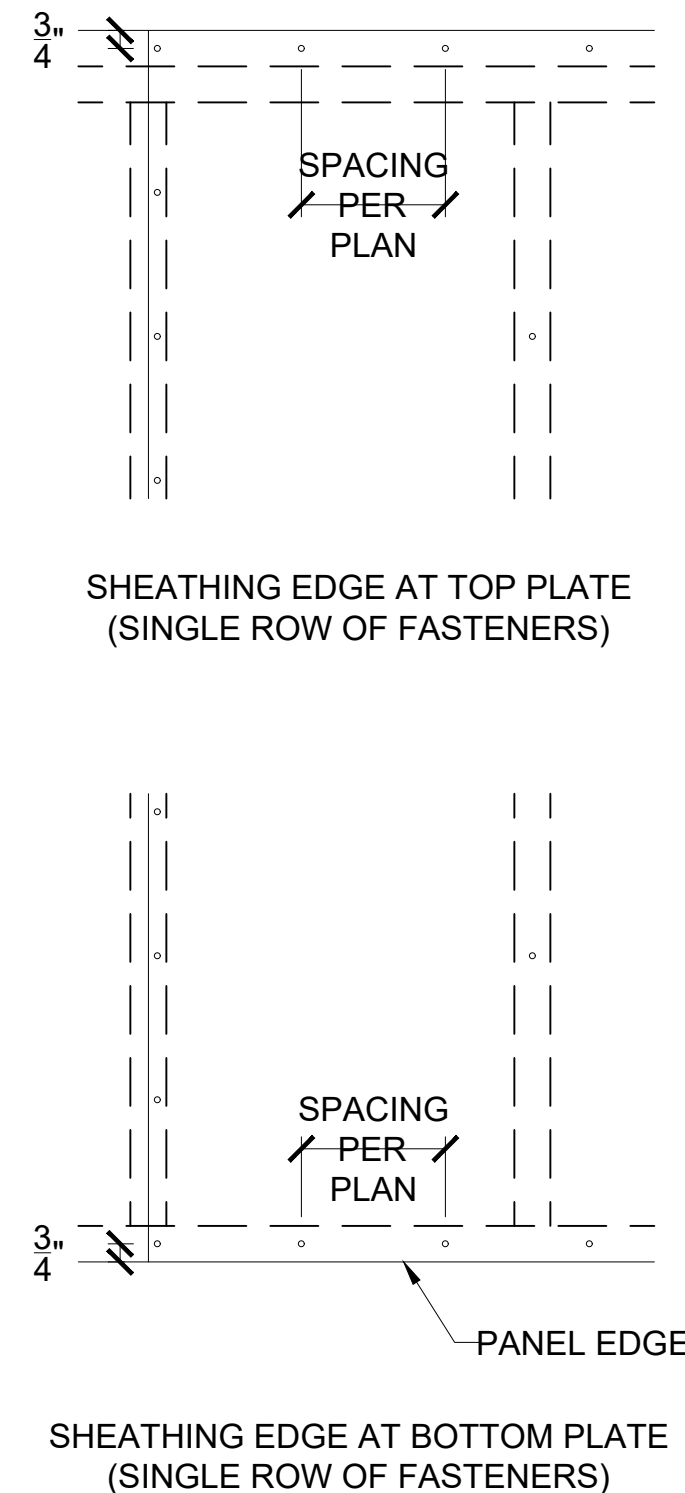

4 SHEATHING EDGE AT TOP S3.0 AND BOTTOM PLATES

SCALE: 1" = 1'-0" (18x24) OR 1½" = 1'-0" (24x36)

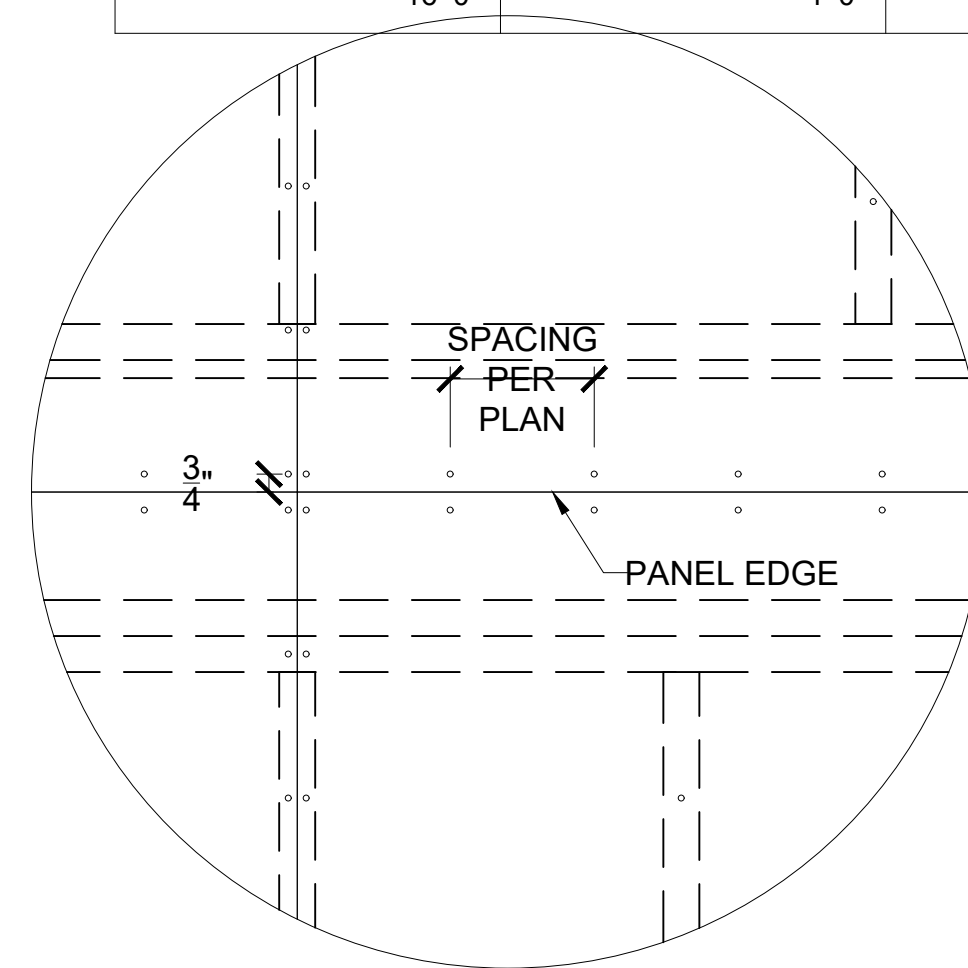



Figure 1 is a plan view of a circular panel. It shows a circular boundary with a central square area labeled "SPACING PER PLAN". A horizontal line across the middle is labeled "PANEL EDGE". On the left side, there are two vertical lines with dimensions 3 and 4 indicated. The diagram illustrates the layout of the grid within the panel.

Diagram illustrating the connection between the roof structure and the ceiling structure:

- RAFTERS OR PRE-MANUFACTURED ROOF TRUSSES PER PLAN
- ROOF SHEATHING PER PLAN
- (3) 8d NAILS THROUGH EACH END OF 2x4 BRACE
- 2x4 BRACE @ EACH RAFTER/CEILING JOIST
- 2x8 CEILING RIM
- 2x6 CEILING JOIST PER PLAN
- TOENAIL EACH CEILING JOIST TO TOP PLATE WITH (3) 8d NAILS
- DOUBLE 2x TOP PLATE
- EXTERIOR WALL

7 RAFTER BEARING OPTION DETAIL

SCALE: 1" = 1'-0" (18x24) OR 1½" = 1'-0" (24x36)

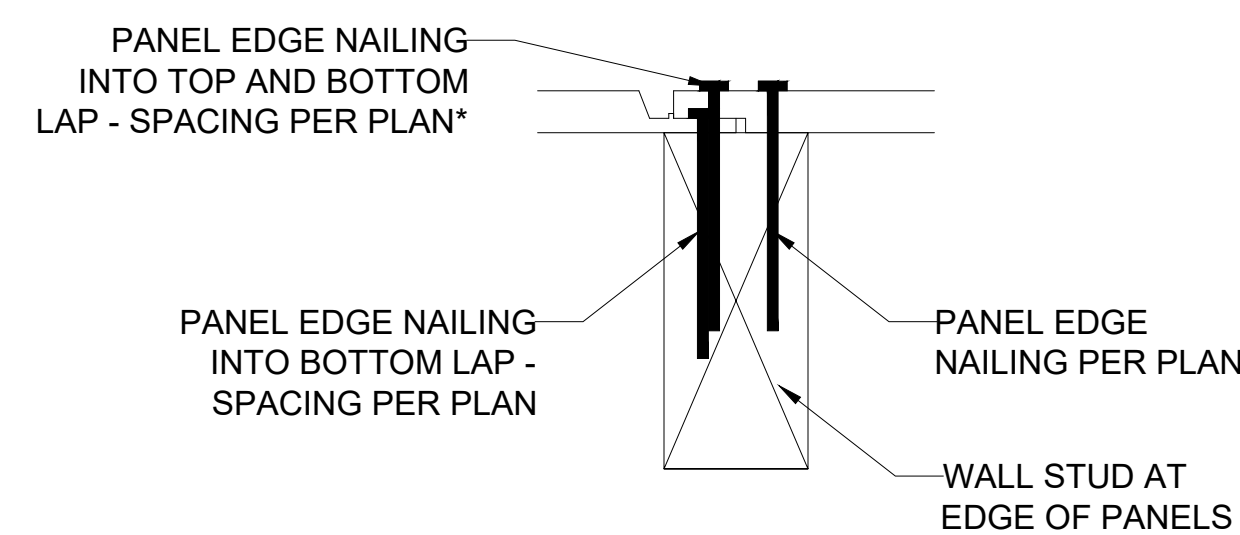

*NOTE: NAILING INTO TOP AND BOTTOM LAP IS IN ADDITION TO NAILING REQUIRED INTO BOTTOM LAP. FOR EXAMPLE, IF PLAN CALLS FOR NAILS @ 6" O.C. AT EDGES, BOTTOM LAP SHALL BE FASTENED AT 6" O.C AND, IN ADDITION, NAILING SHALL ALSO BE INSTALLED THROUGH TOP AND BOTTOM LAP @ 6" O.C. STAGGERED 3" FROM BOTTOM LAP NAILING

SCALE: $\frac{1}{2}" = 1'-0"$ (18x24) OR $\frac{3}{4}" = 1'-0"$ (24x36)


[illegible]

DRAWING TITLE

FRAMING DETAILS


ENGINEER: DMH	CHECKED BY: DMH
JOB NO.	DRAWN BY: DMH
DATE: 01-18-24	
SHEET NUMBER	

S3.0

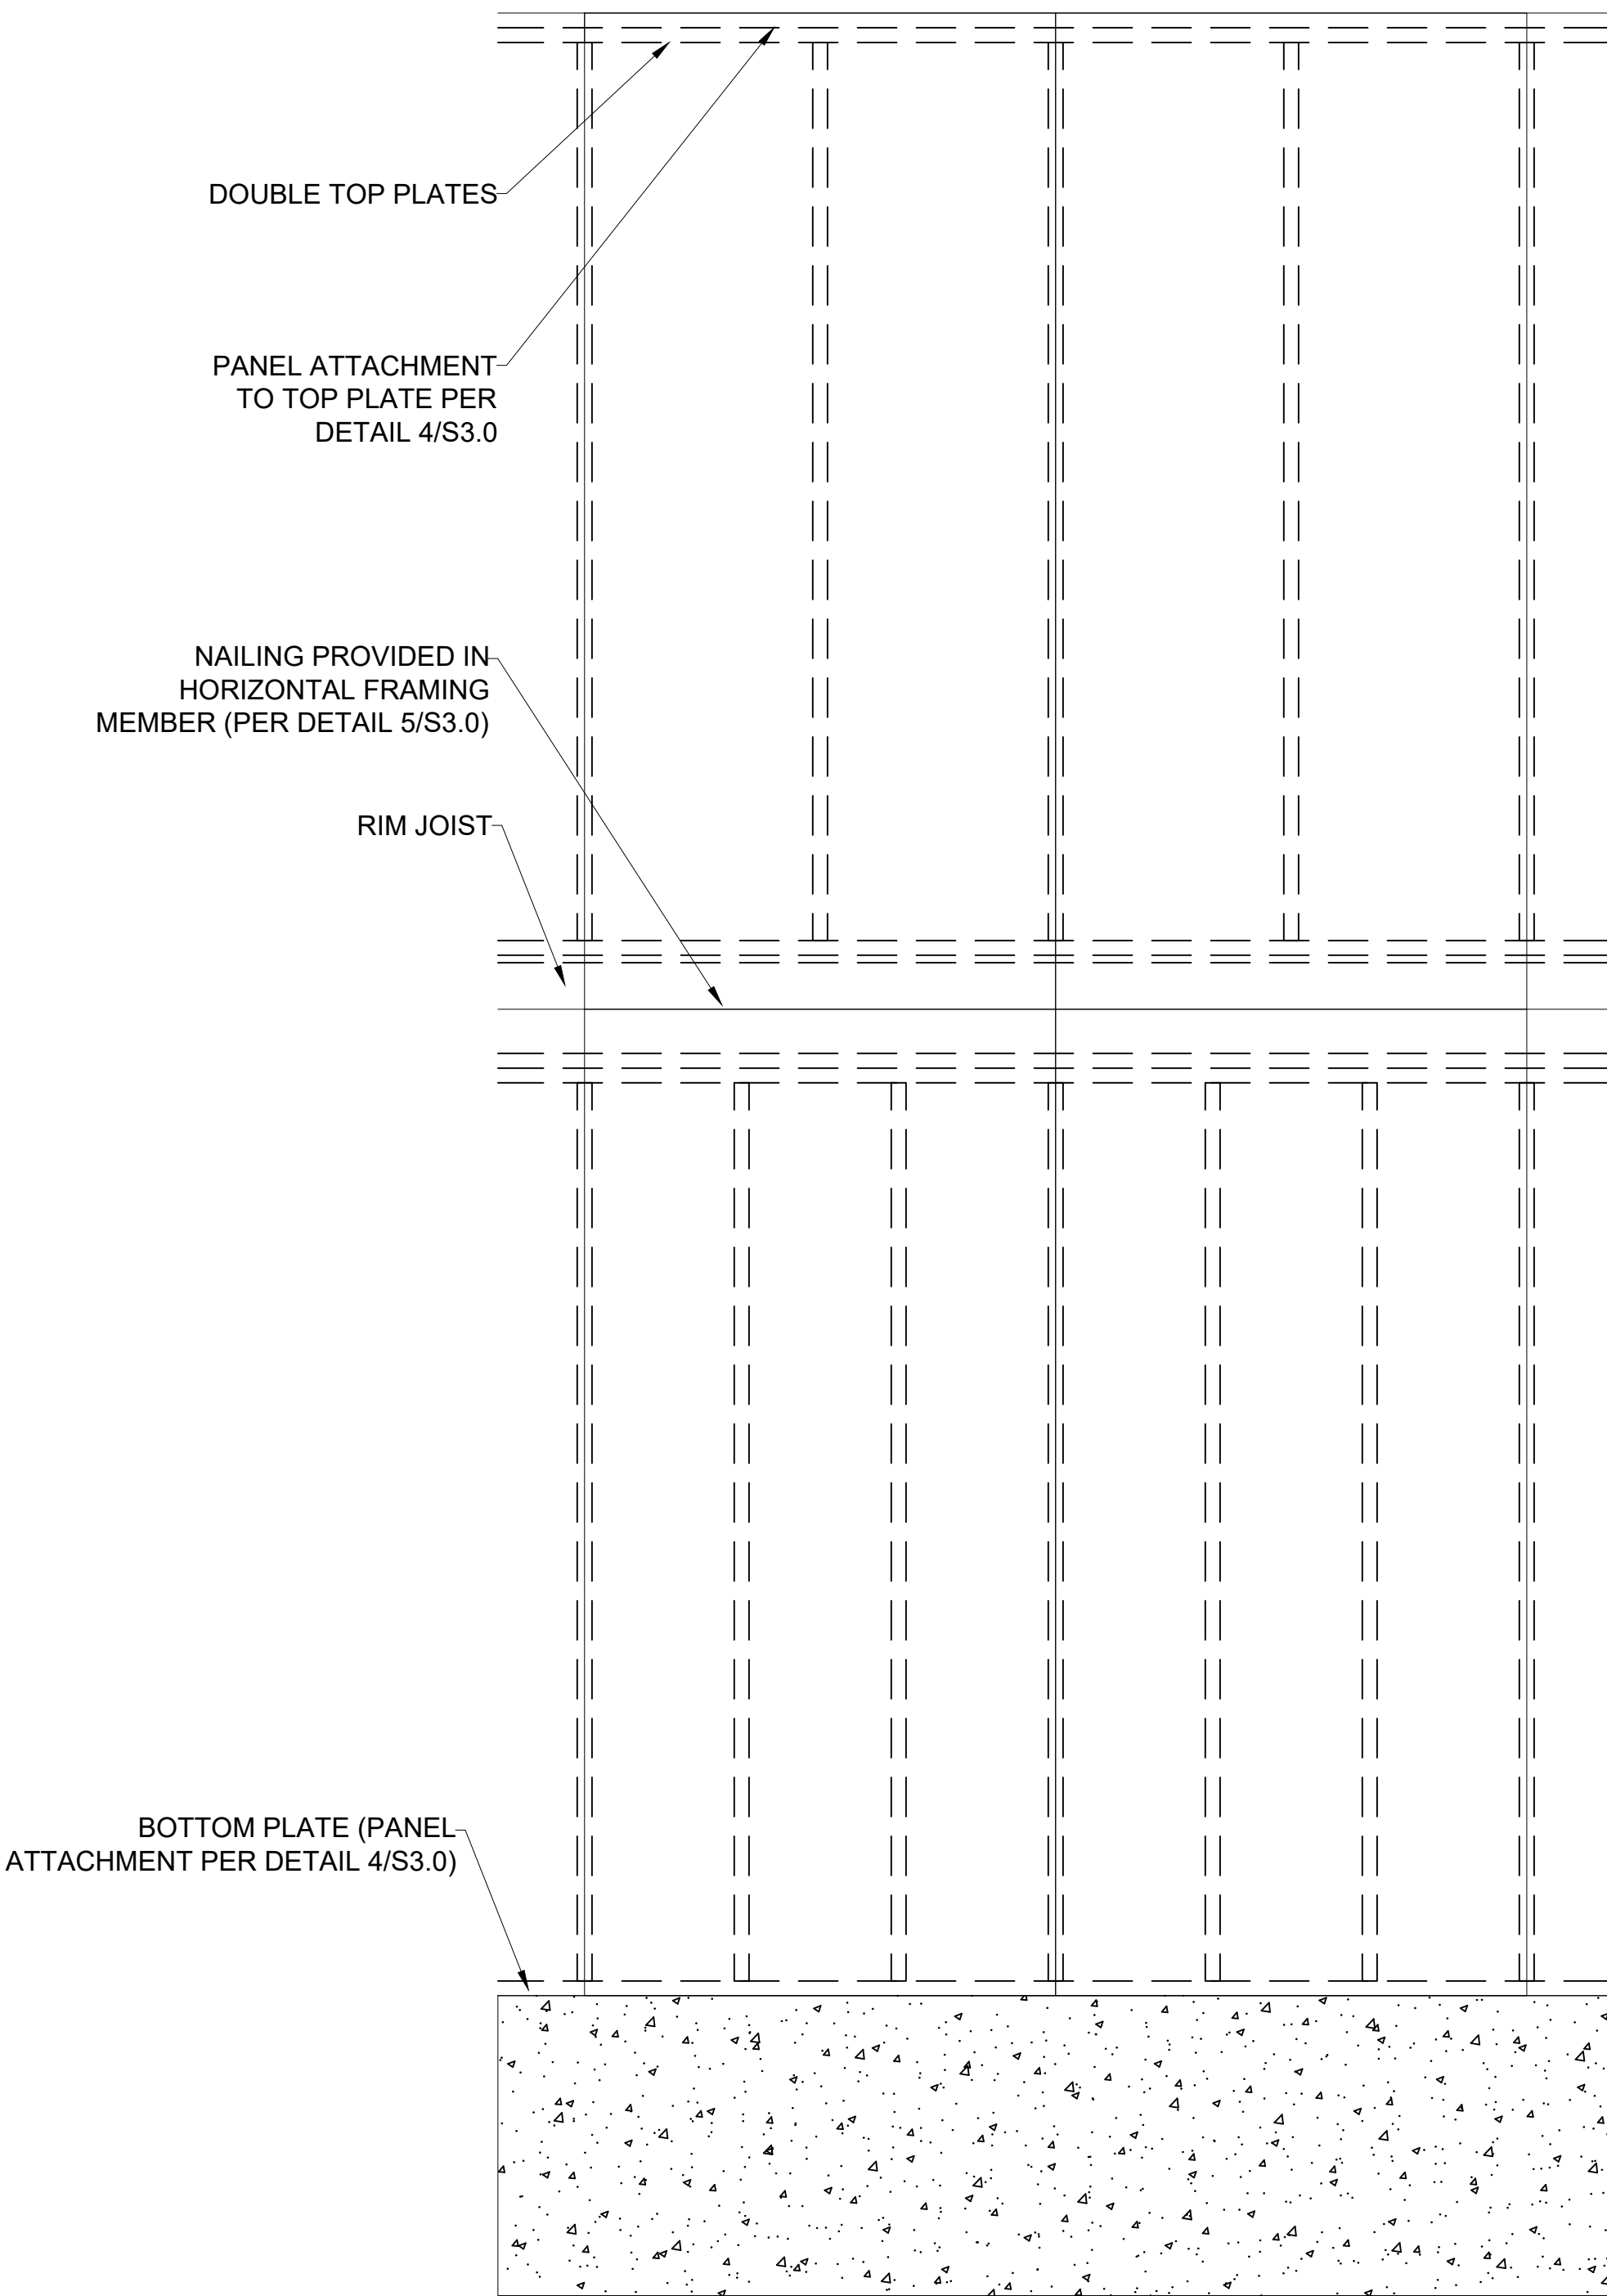


1 EXTERIOR WALL SHEATHING PANEL ATTACHMENT
S3.1 PANEL SPLICE OVER HORIZONTAL FRAMING MEMBER

SCALE: 1/2" = 1'-0" (18x24) OR 3/4" = 1'-0" (24x36)

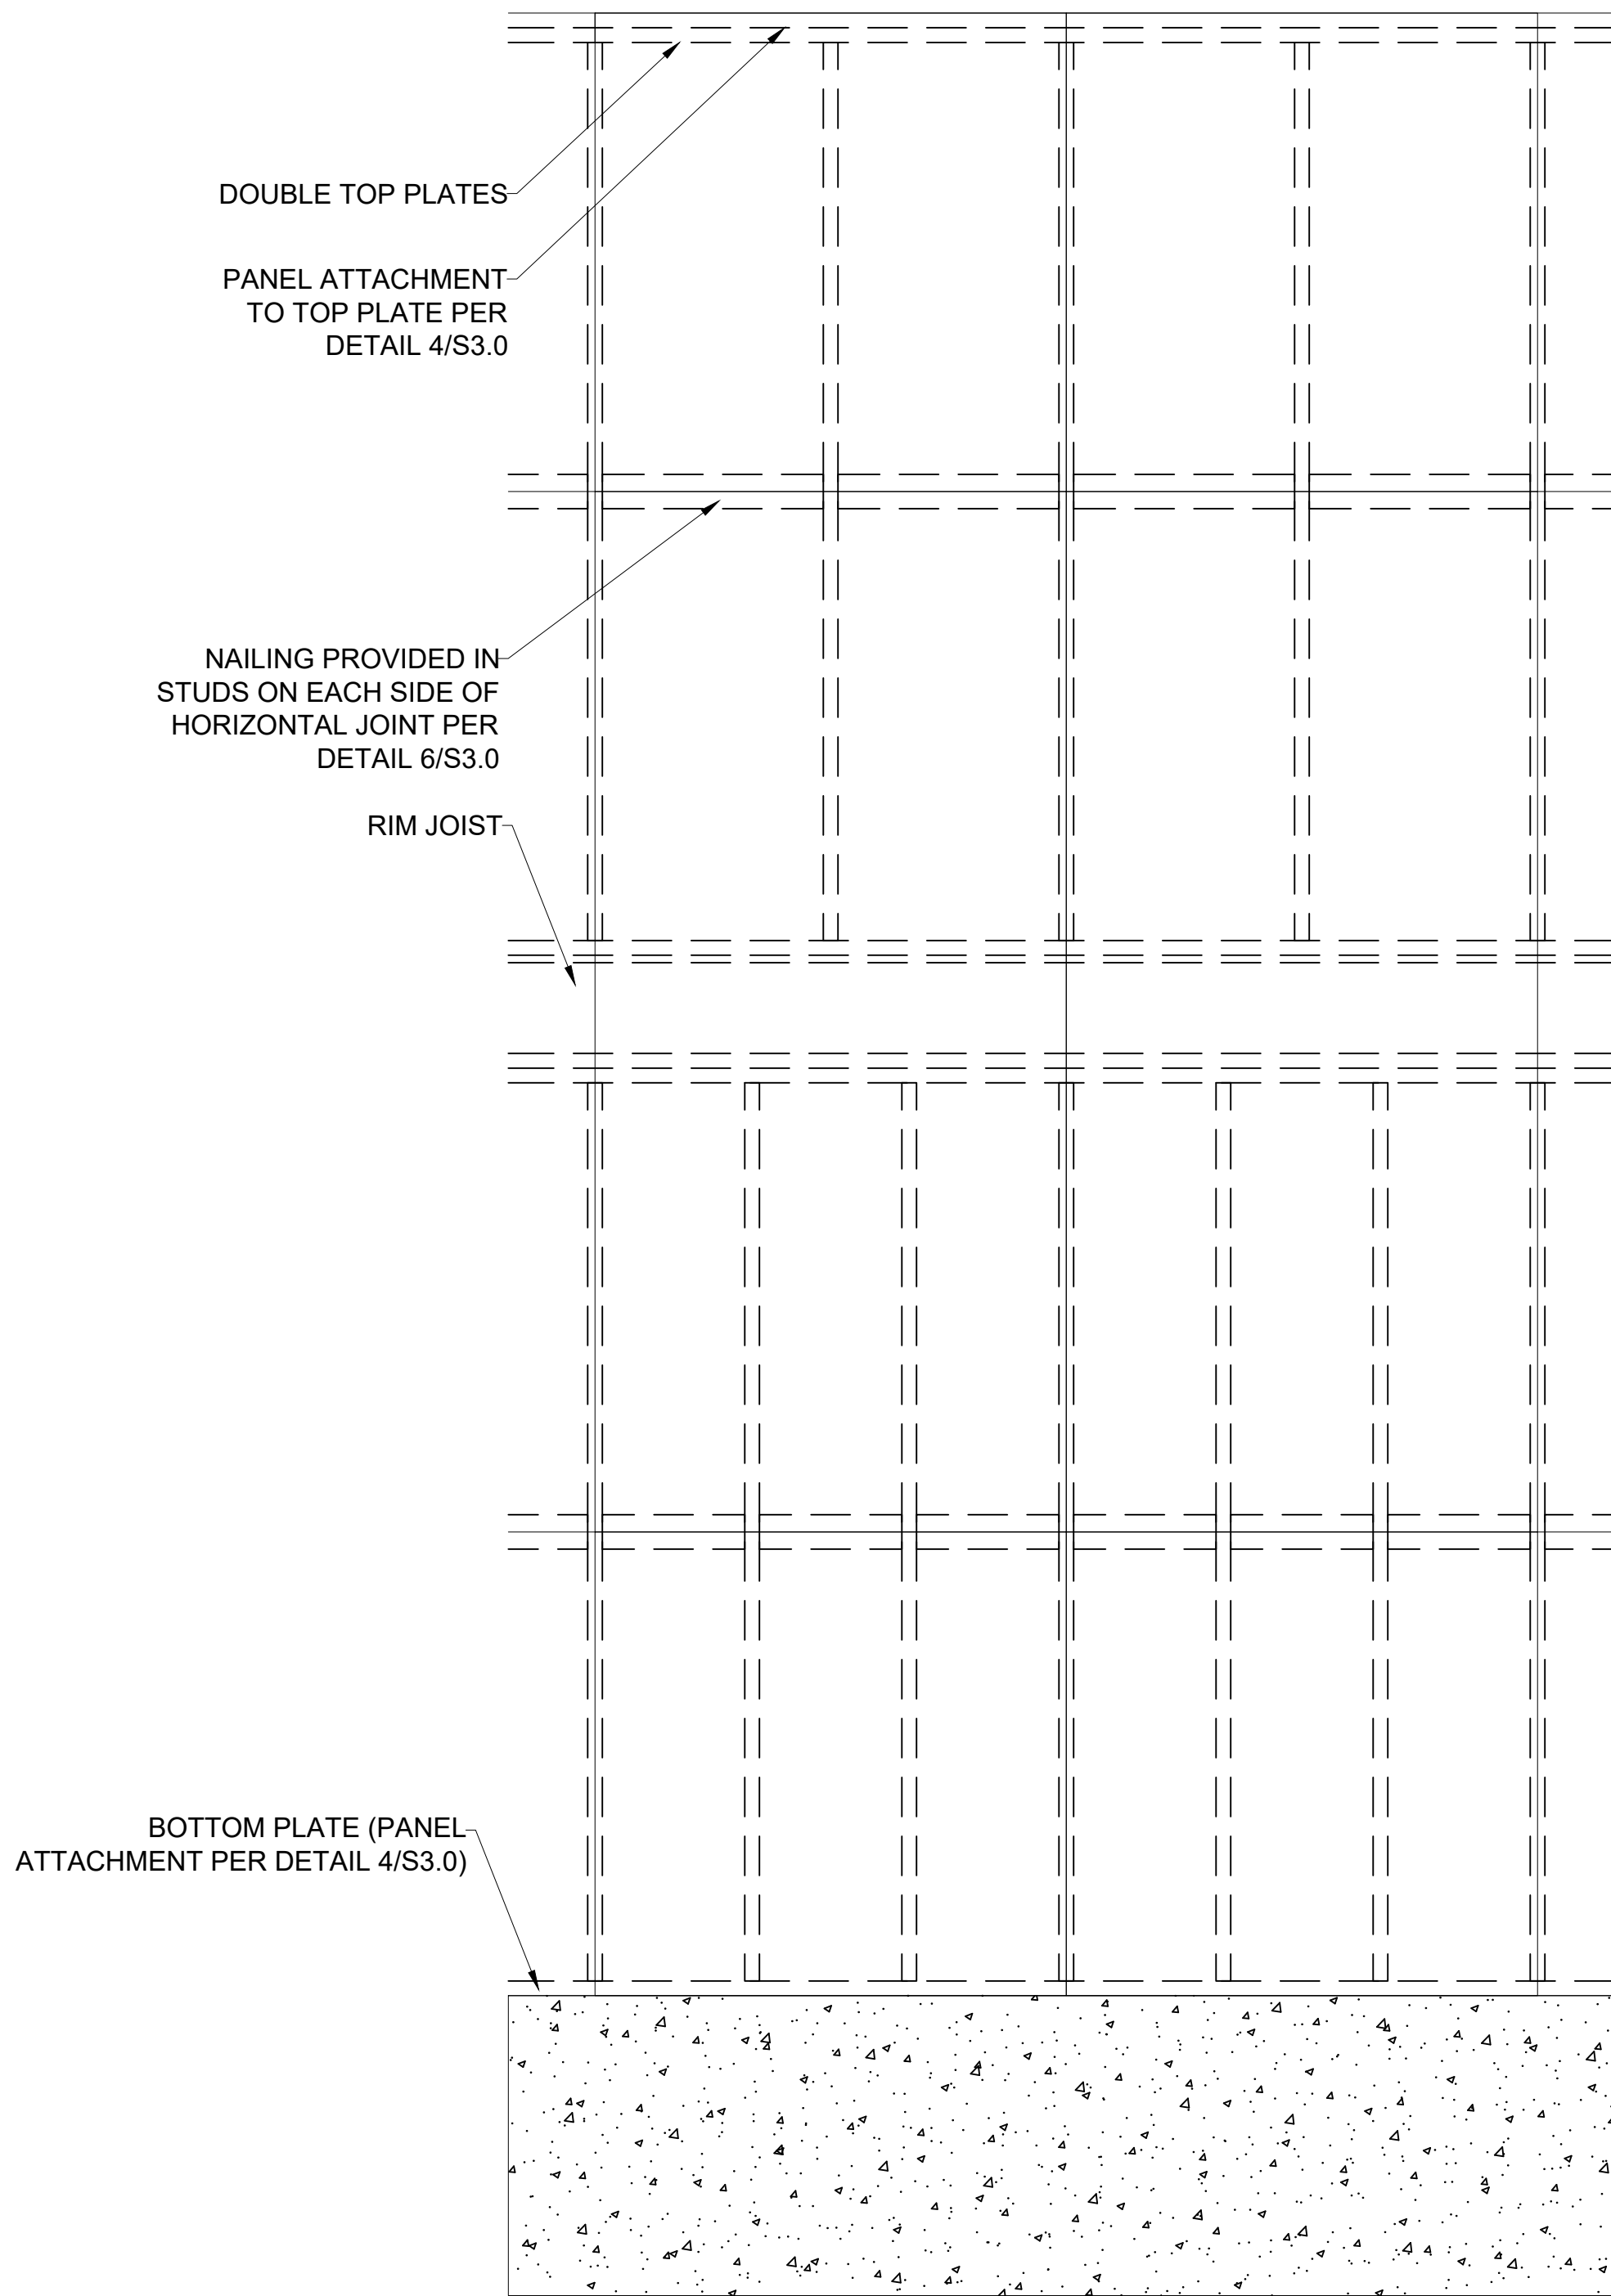


2 EXTERIOR WALL SHEATHING PANEL ATTACHMENT
S3.1 PANEL SPLICE OCCURRING ACROSS STUDS

SCALE: 1/2" = 1'-0" (18x24) OR 3/4" = 1'-0" (24x36)

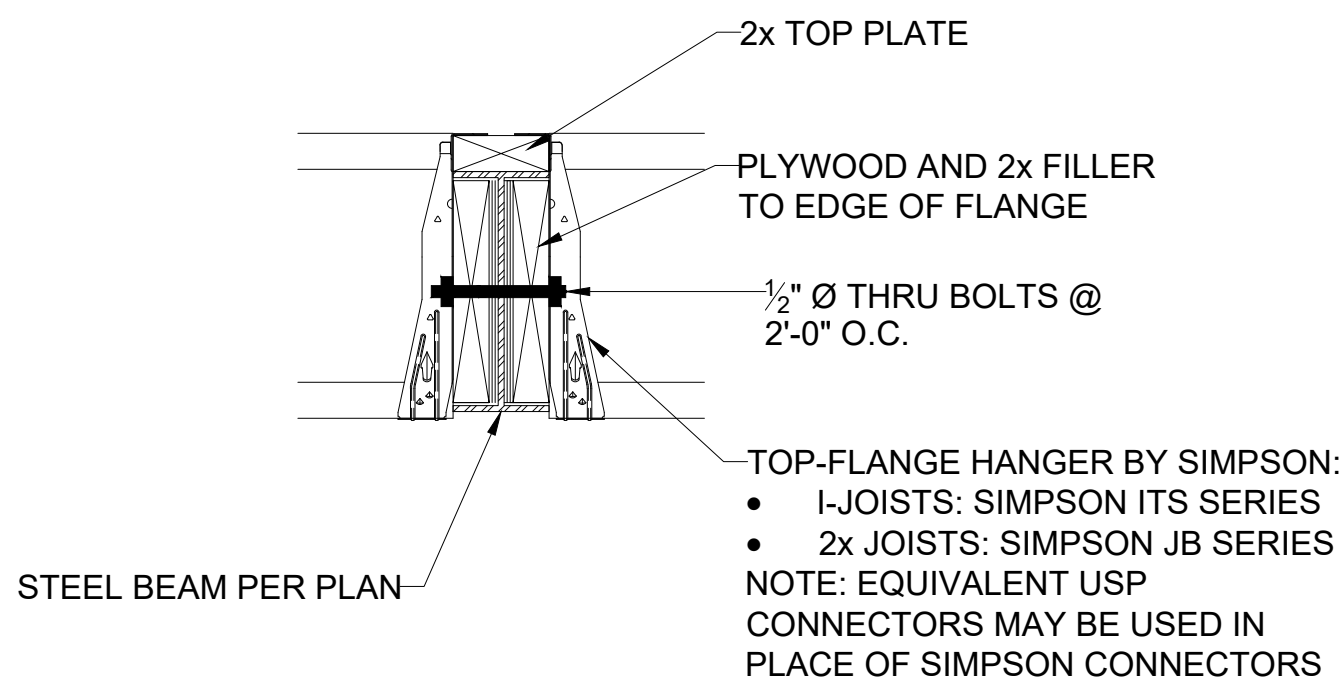


4 FLOOR JOIST TO FLUSH STEEL BEAM DETAIL
S3.1

SCALE: 1" = 1'-0" (18x24) OR 1 1/2" = 1'-0" (24x36)

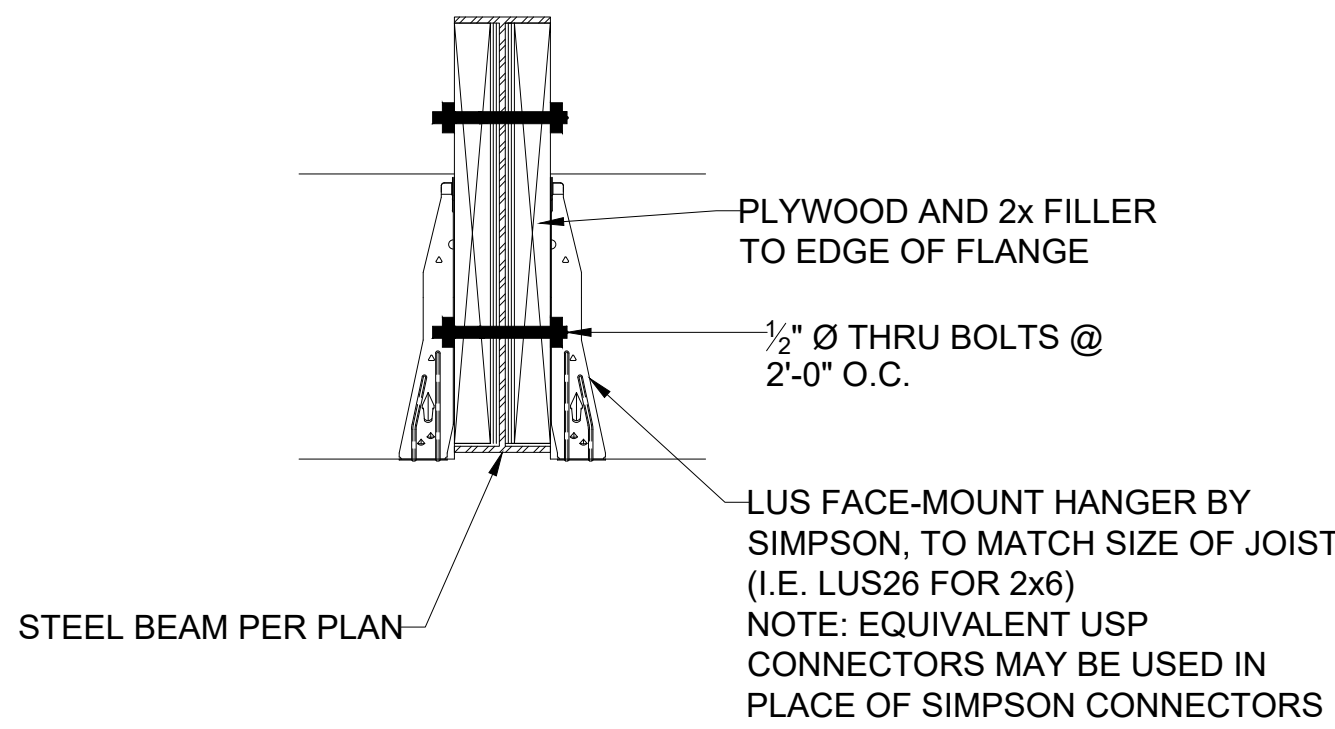

5 CEILING JOIST TO FLUSH STEEL BEAM DETAIL
S3.1

SCALE: 1" = 1'-0" (18x24) OR 1 1/2" = 1'-0" (24x36)

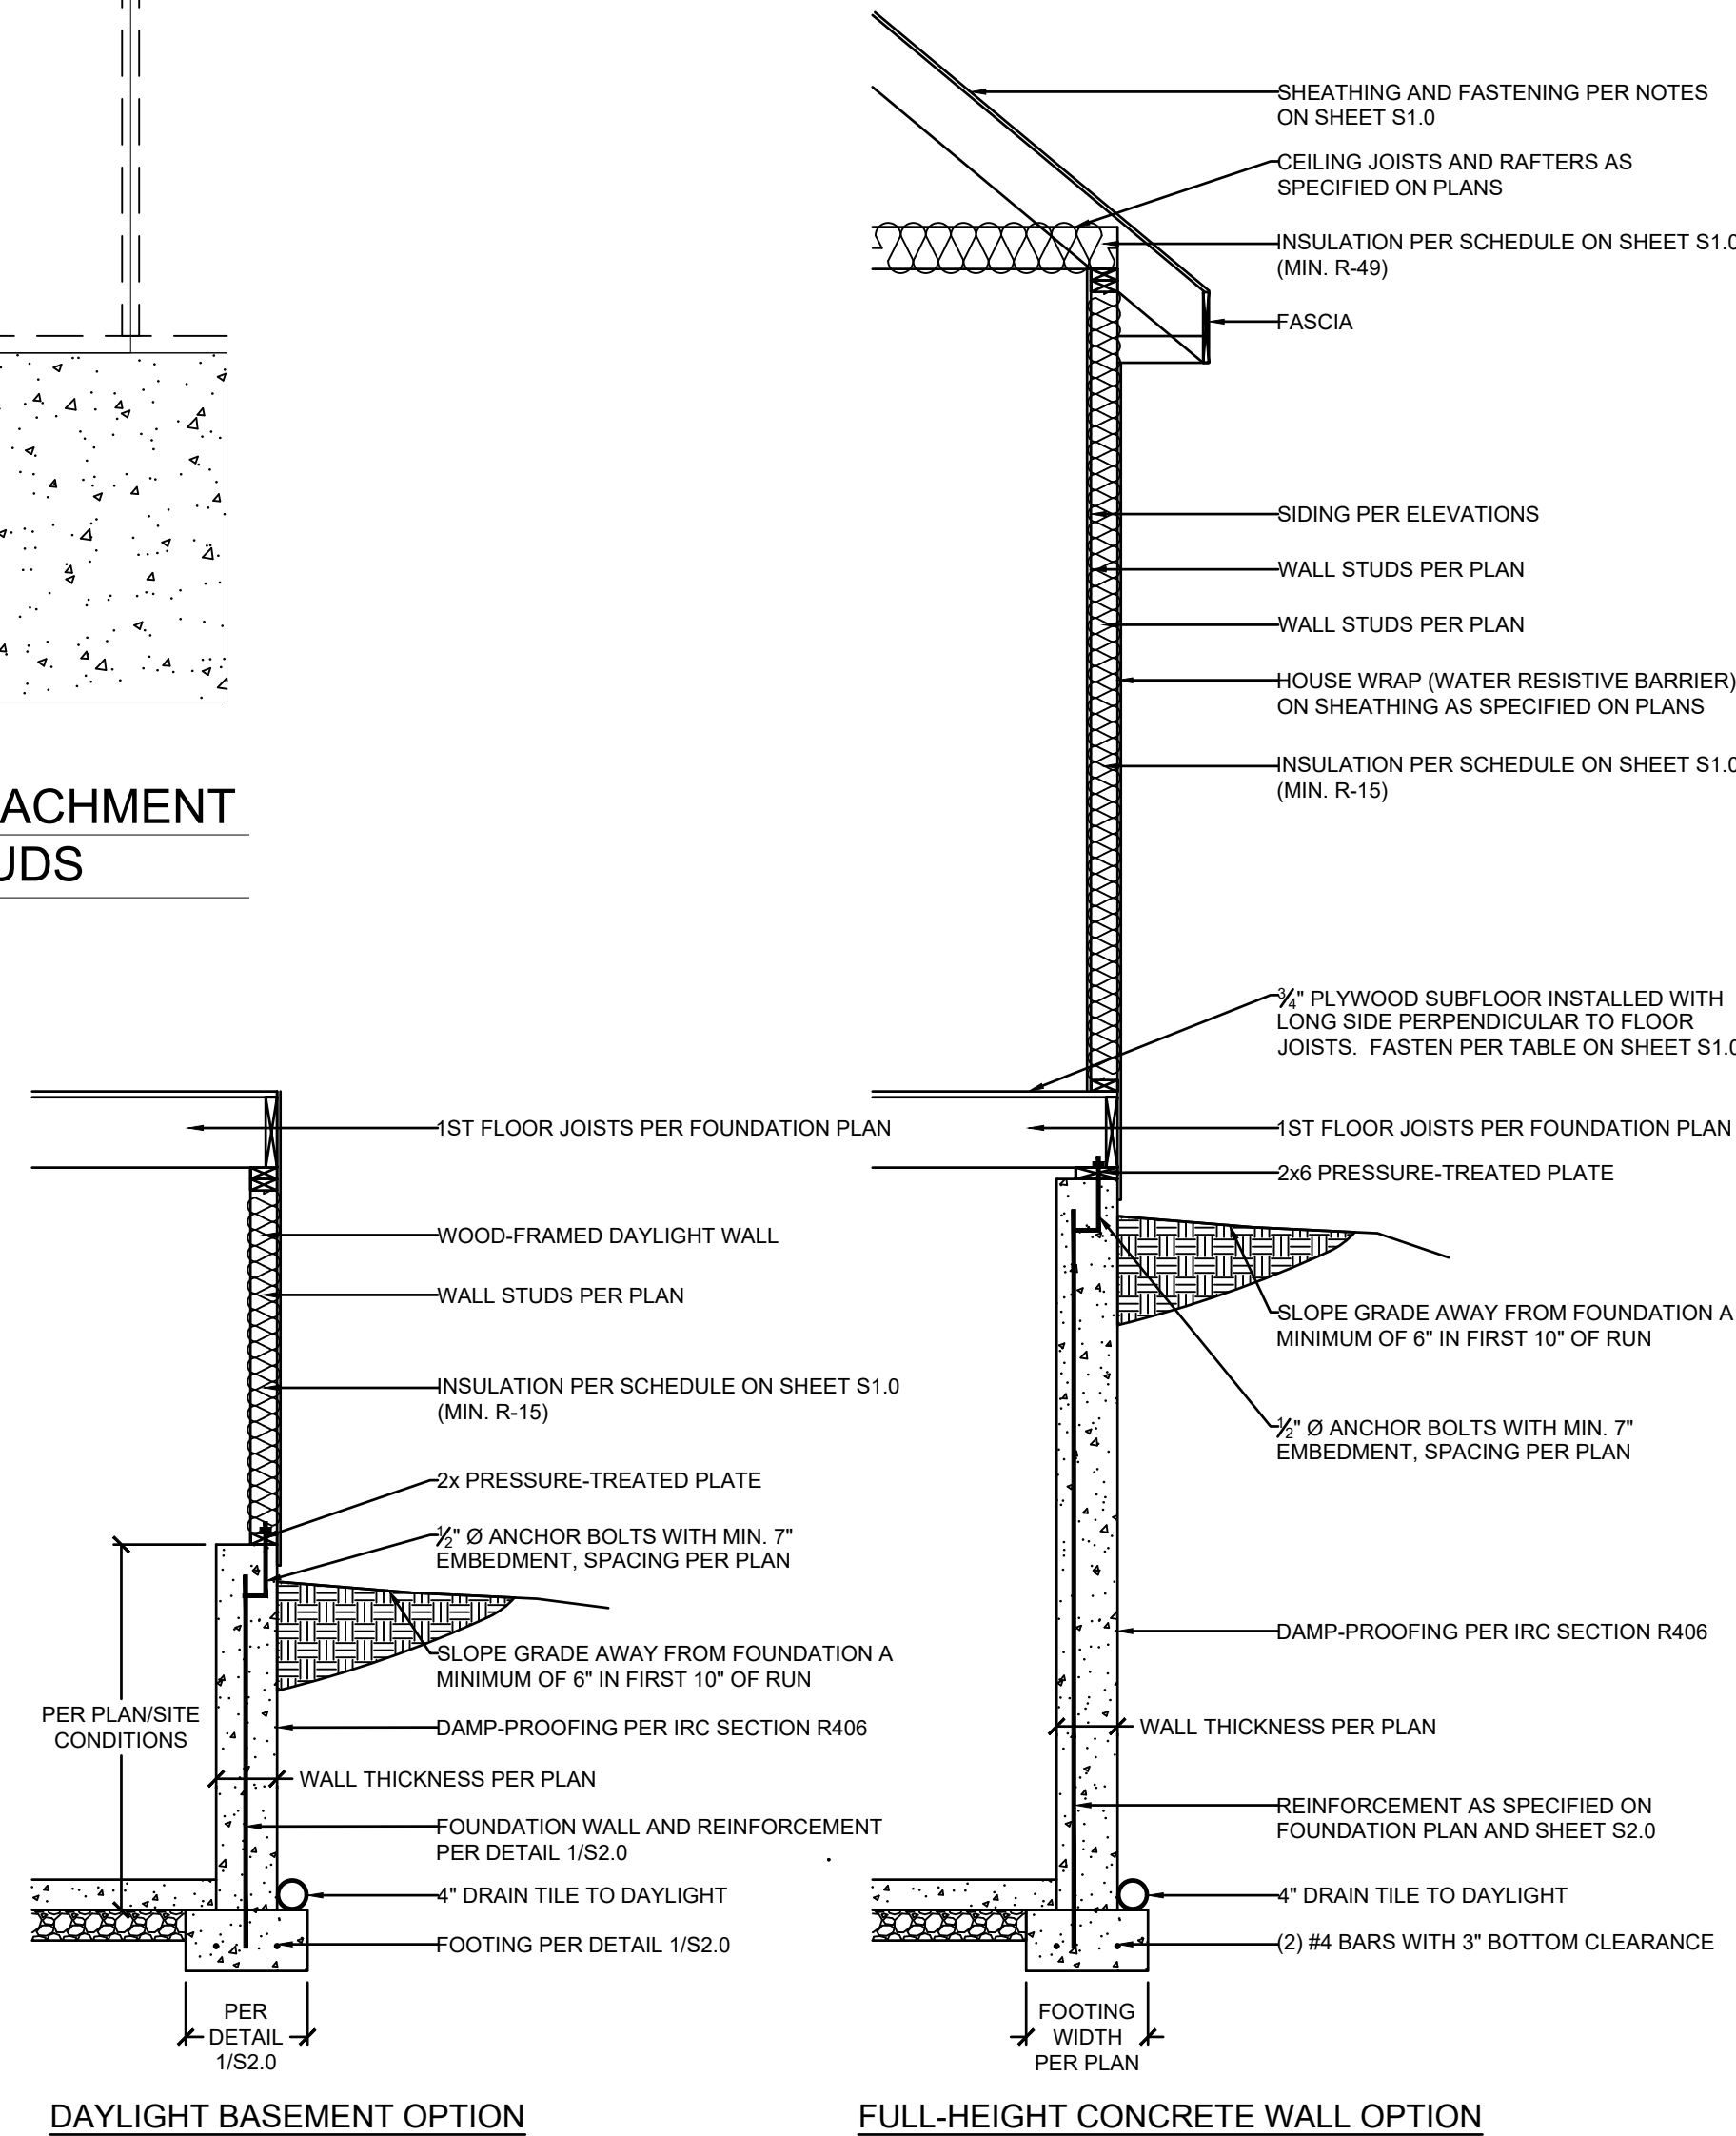


3 EXTERIOR WALL SECTION
S3.1

SCALE: 3/4" = 1'-0"




CLIENT: WALKER CUSTOM HOMES, LLC
JOB TITLE: WLO010 WEGNER
LOT 10, WOODLAND OAKS - FINAL PLAT
LOCATION: 2528 NE WOODLAND OAK DR.
LEE'S SUMMIT, MISSOURI

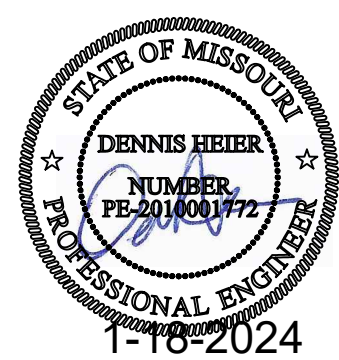


NO.	DATE	REVISION	BY
DRAWING TITLE			
FRAMING DETAILS			
ENGINEER: DMH		CHECKED BY: DMH	
JOB NO.		DRAWN BY: DMH	
DATE: 01-18-24			
SHEET NUMBER			

S3.1

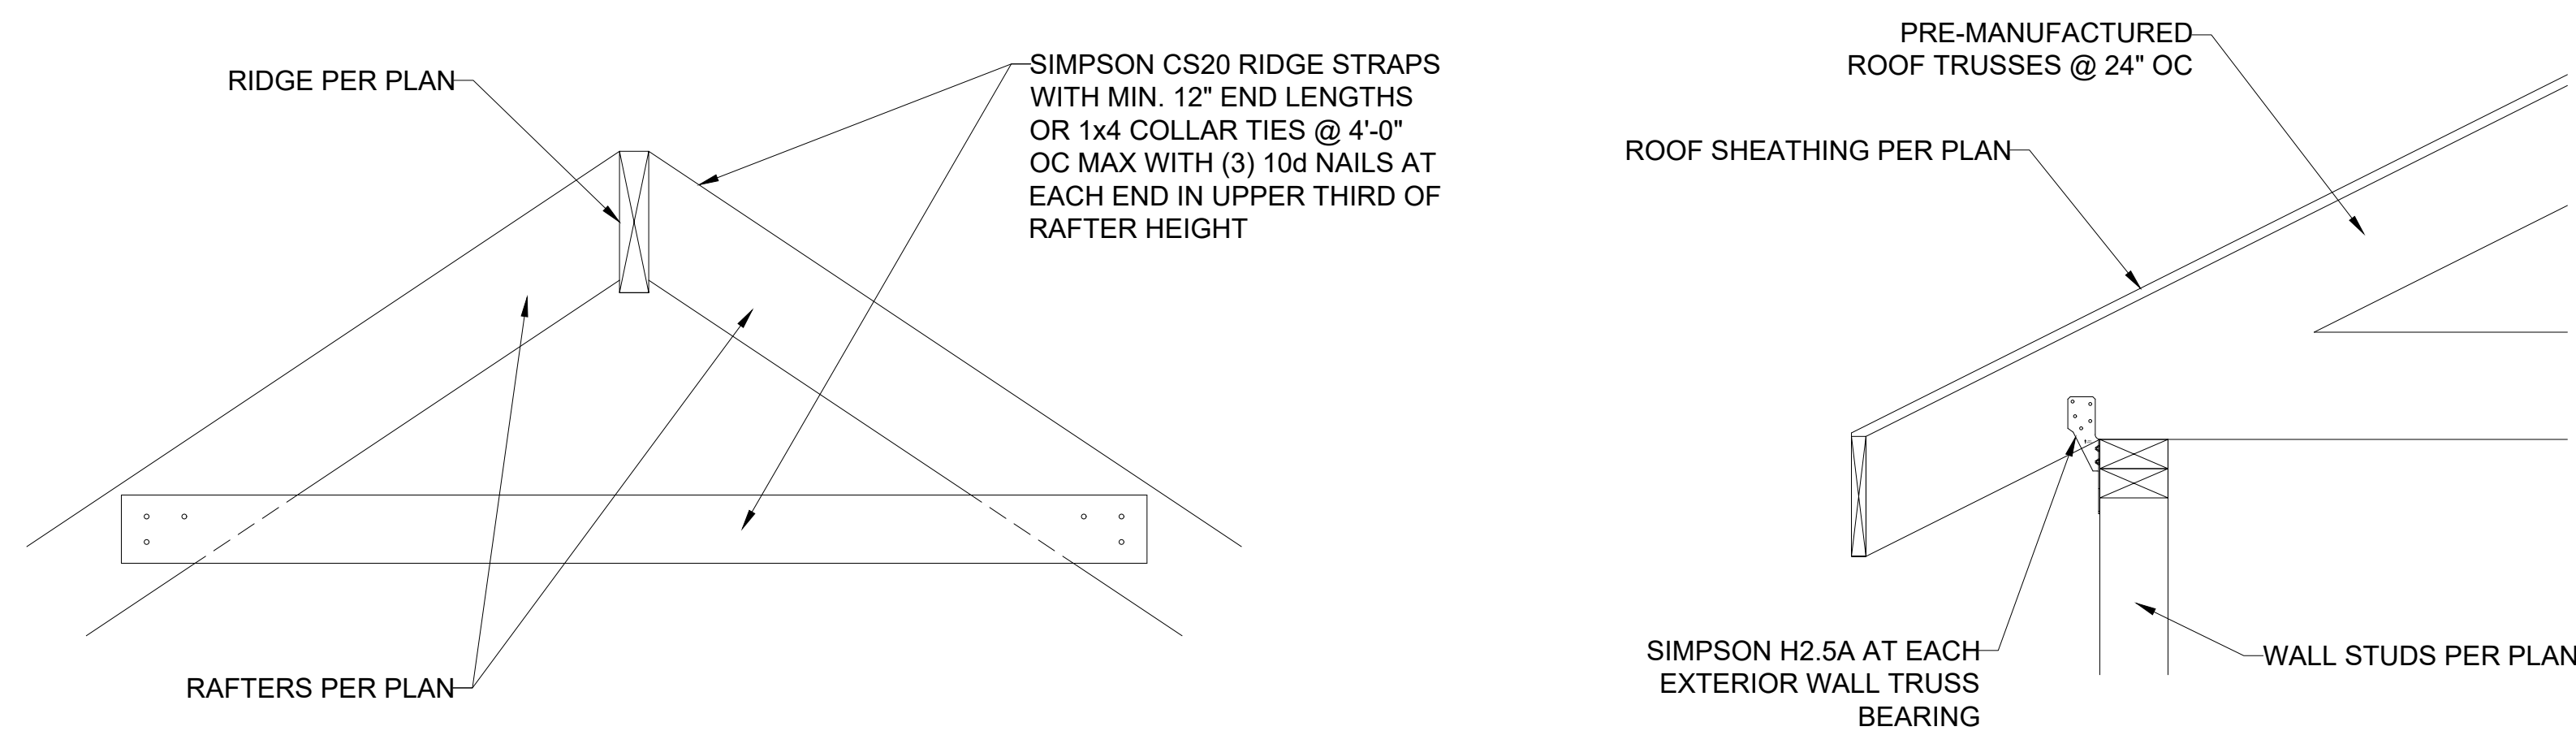


1 RIDGE FRAMING DETAIL

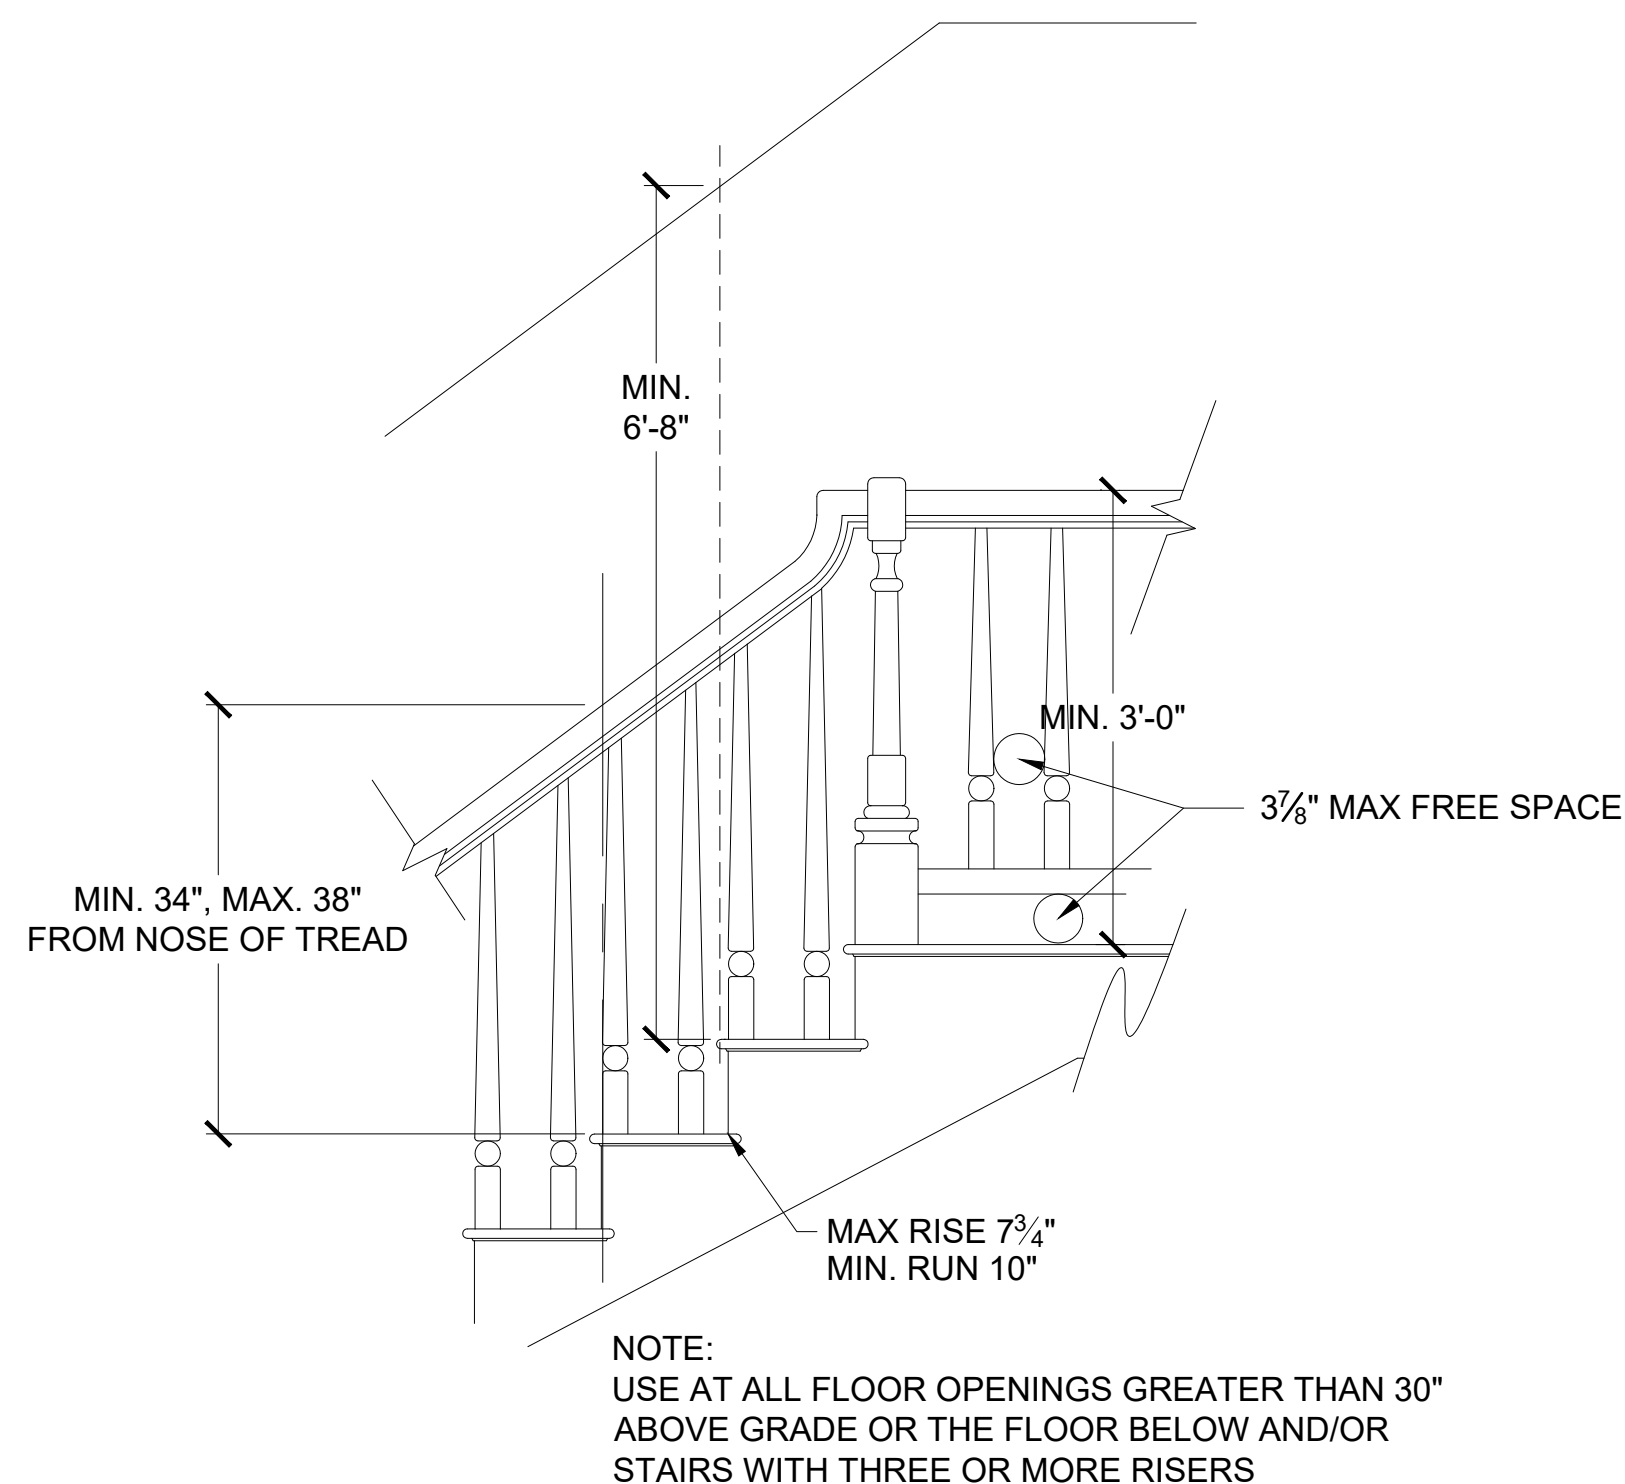


4 STAIR AND HANDRAIL/GUARDRAIL DETAIL


S3.2 SCALE: $\frac{1}{2}" = 1'-0"$ (18x24) OR $\frac{3}{4}" = 1'-0"$ (24x36)

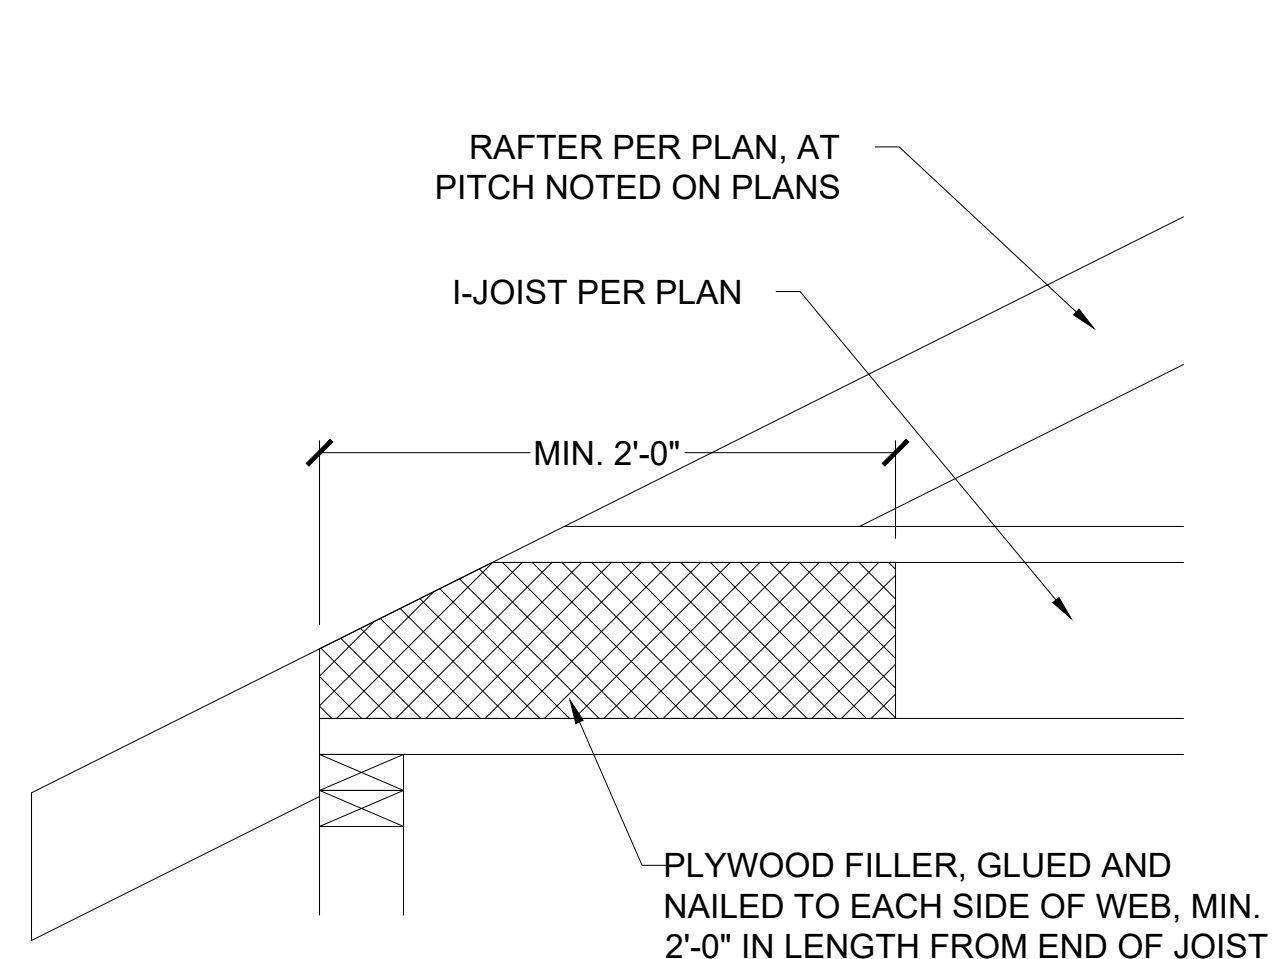


9 COPED I-JOIST REINFORCEMENT

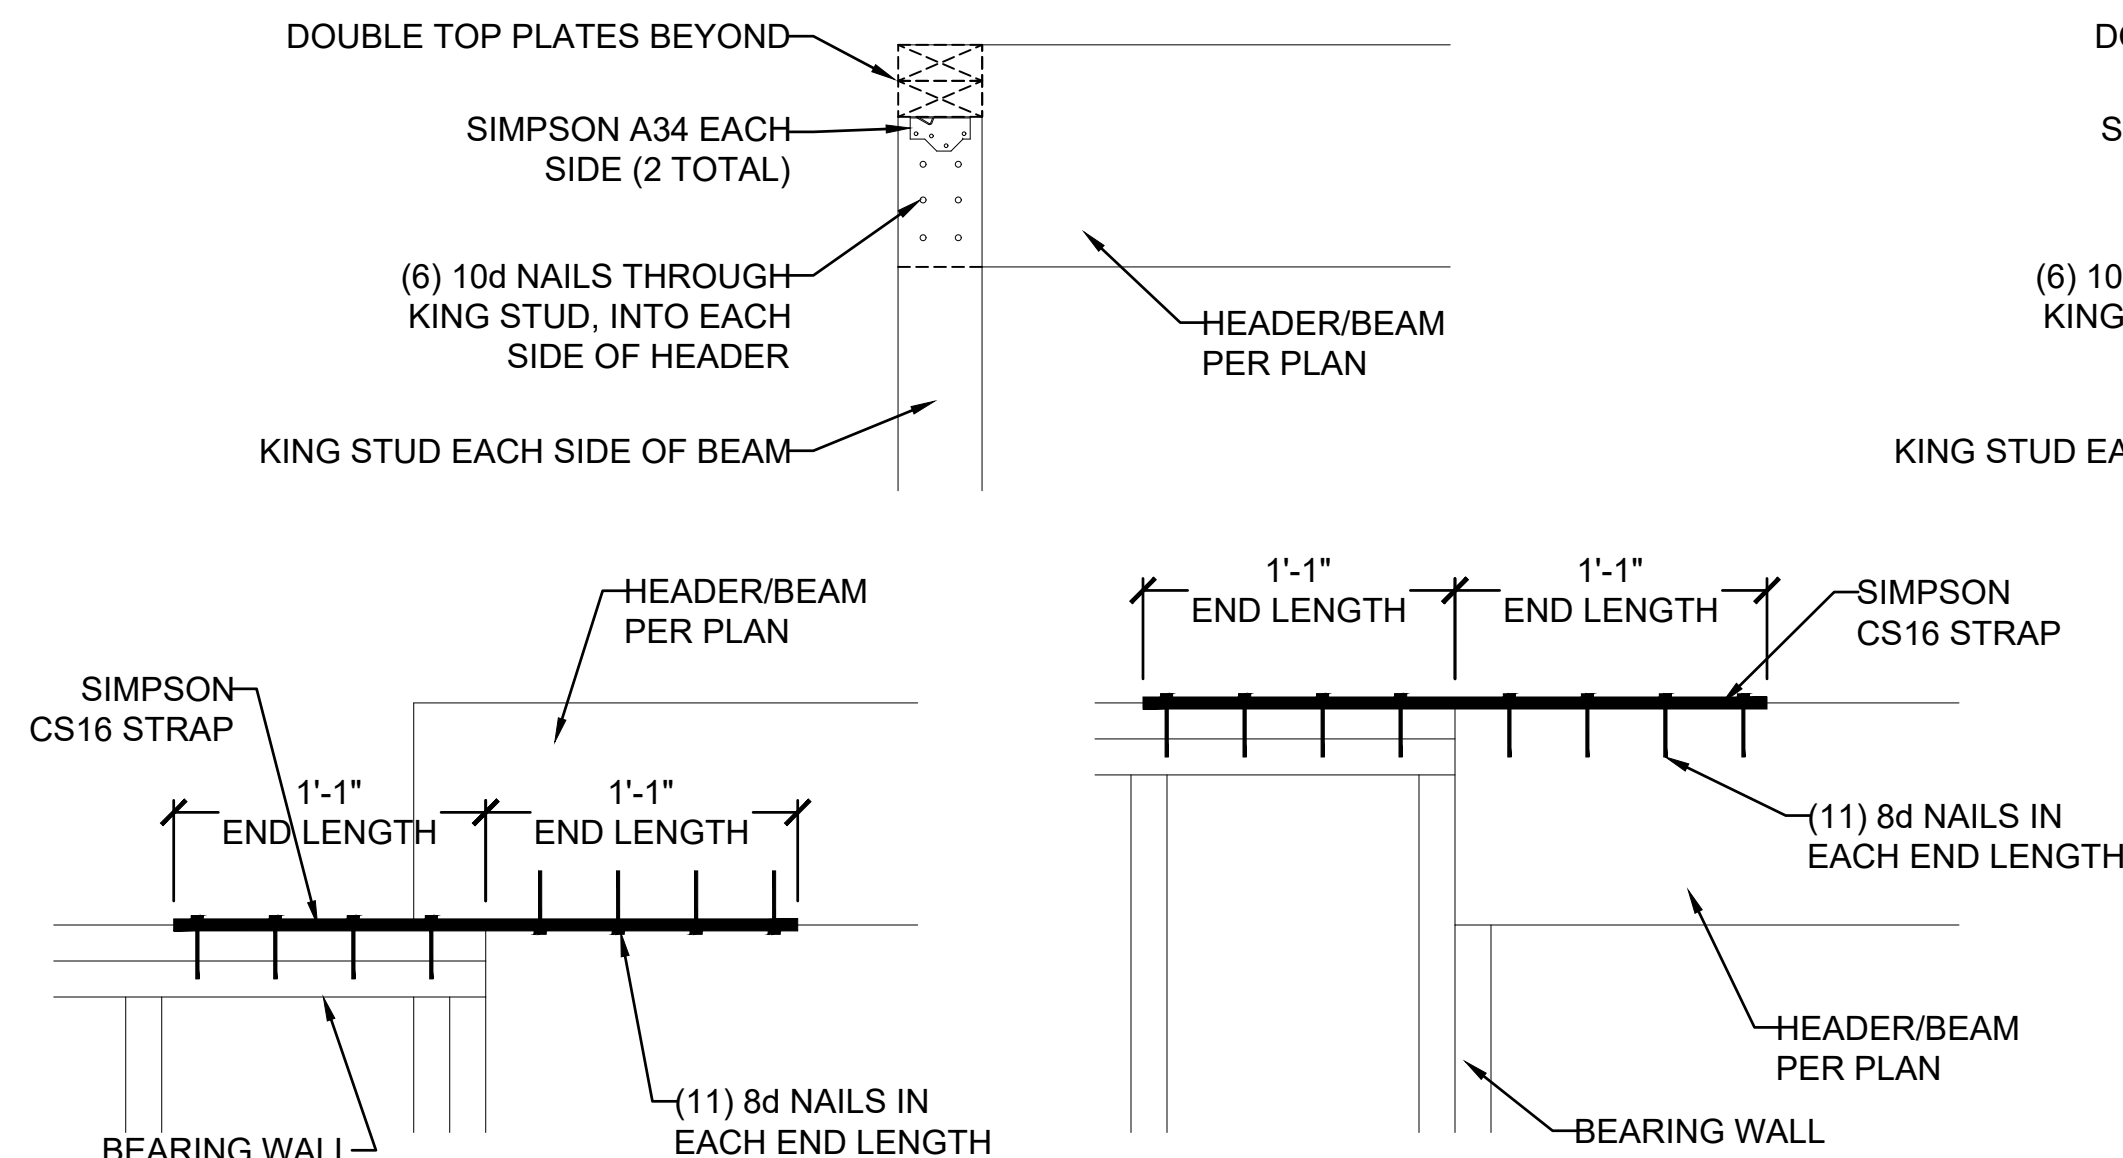


10 HEADER/BREAM CONNECTION OPTIONS AT OUTDOOR/OPEN SPACE
 S3.2 SCALE: 1" = 1'-0" (18x24) OR 1/2" = 1'-0" (24x36)

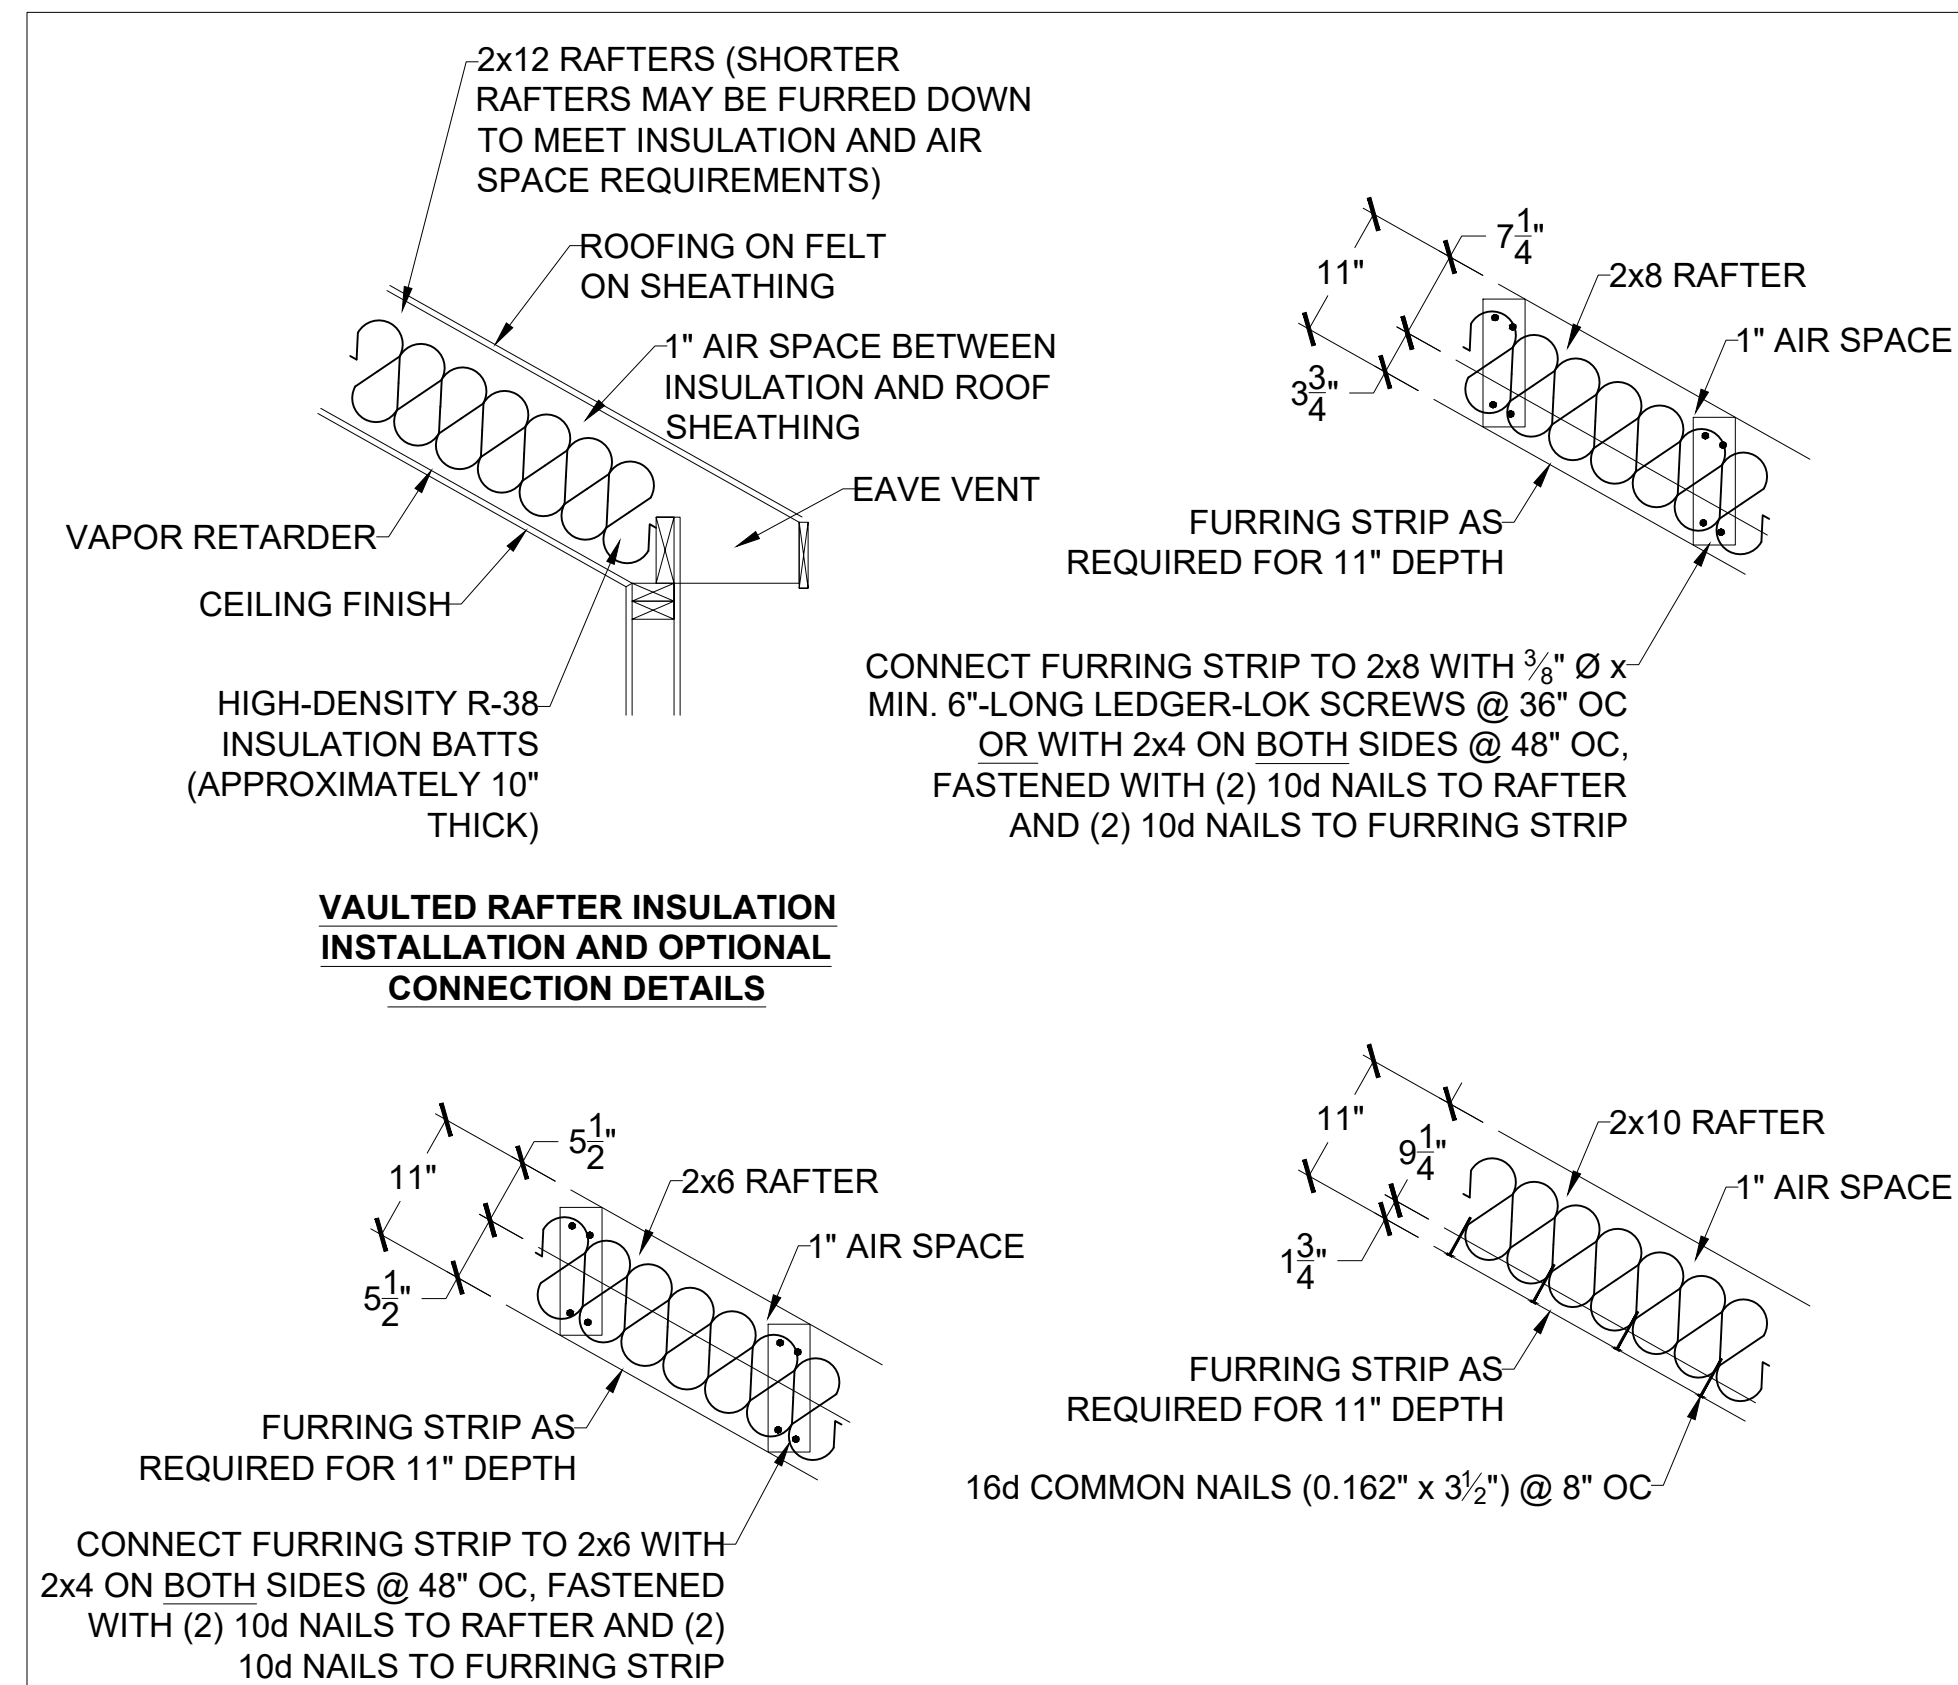

3 VAULTED RAFTER INSULATION DETAILS

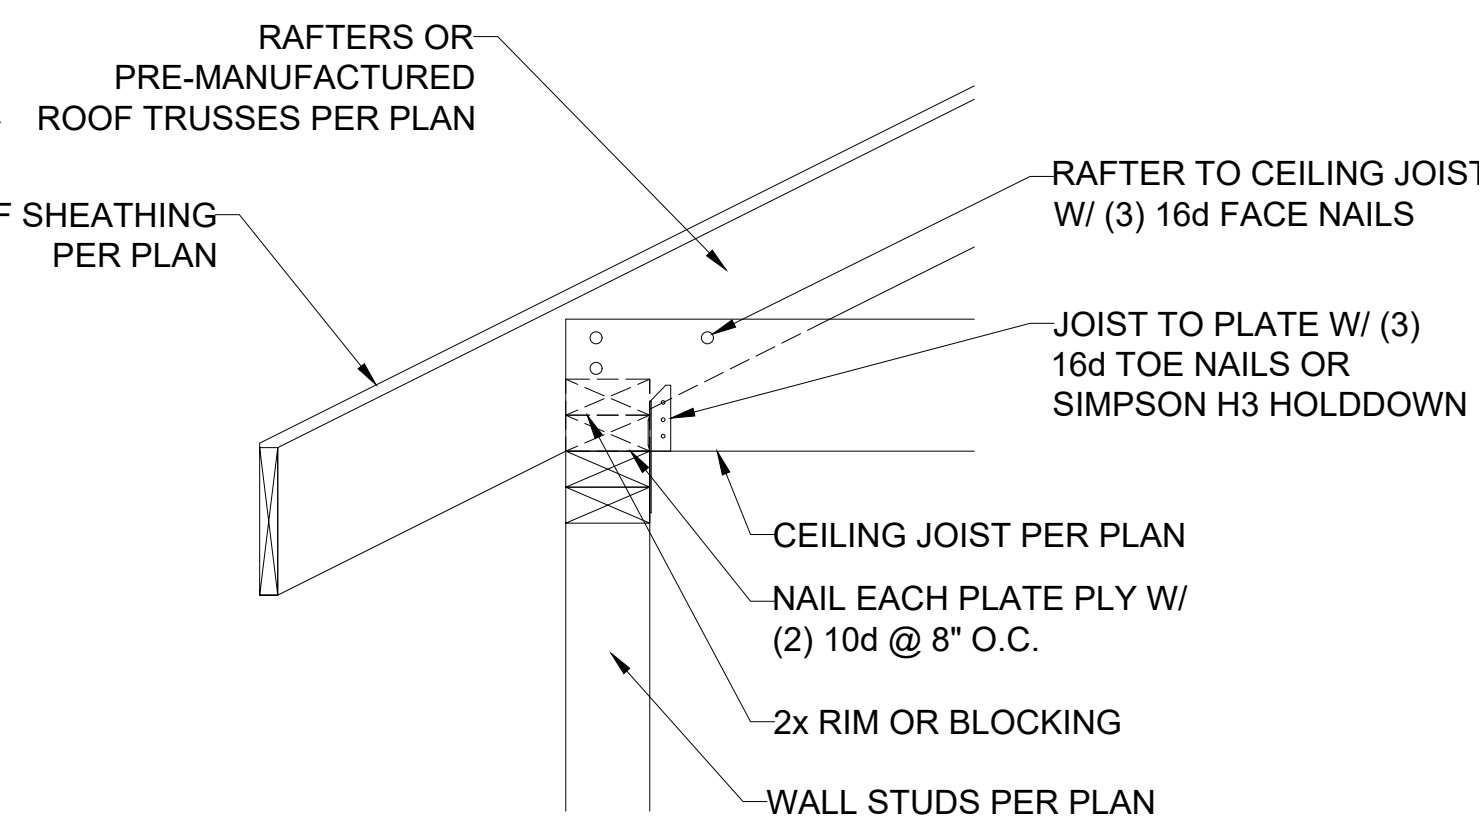

7 RAFTER BEARING OPTION DETAIL

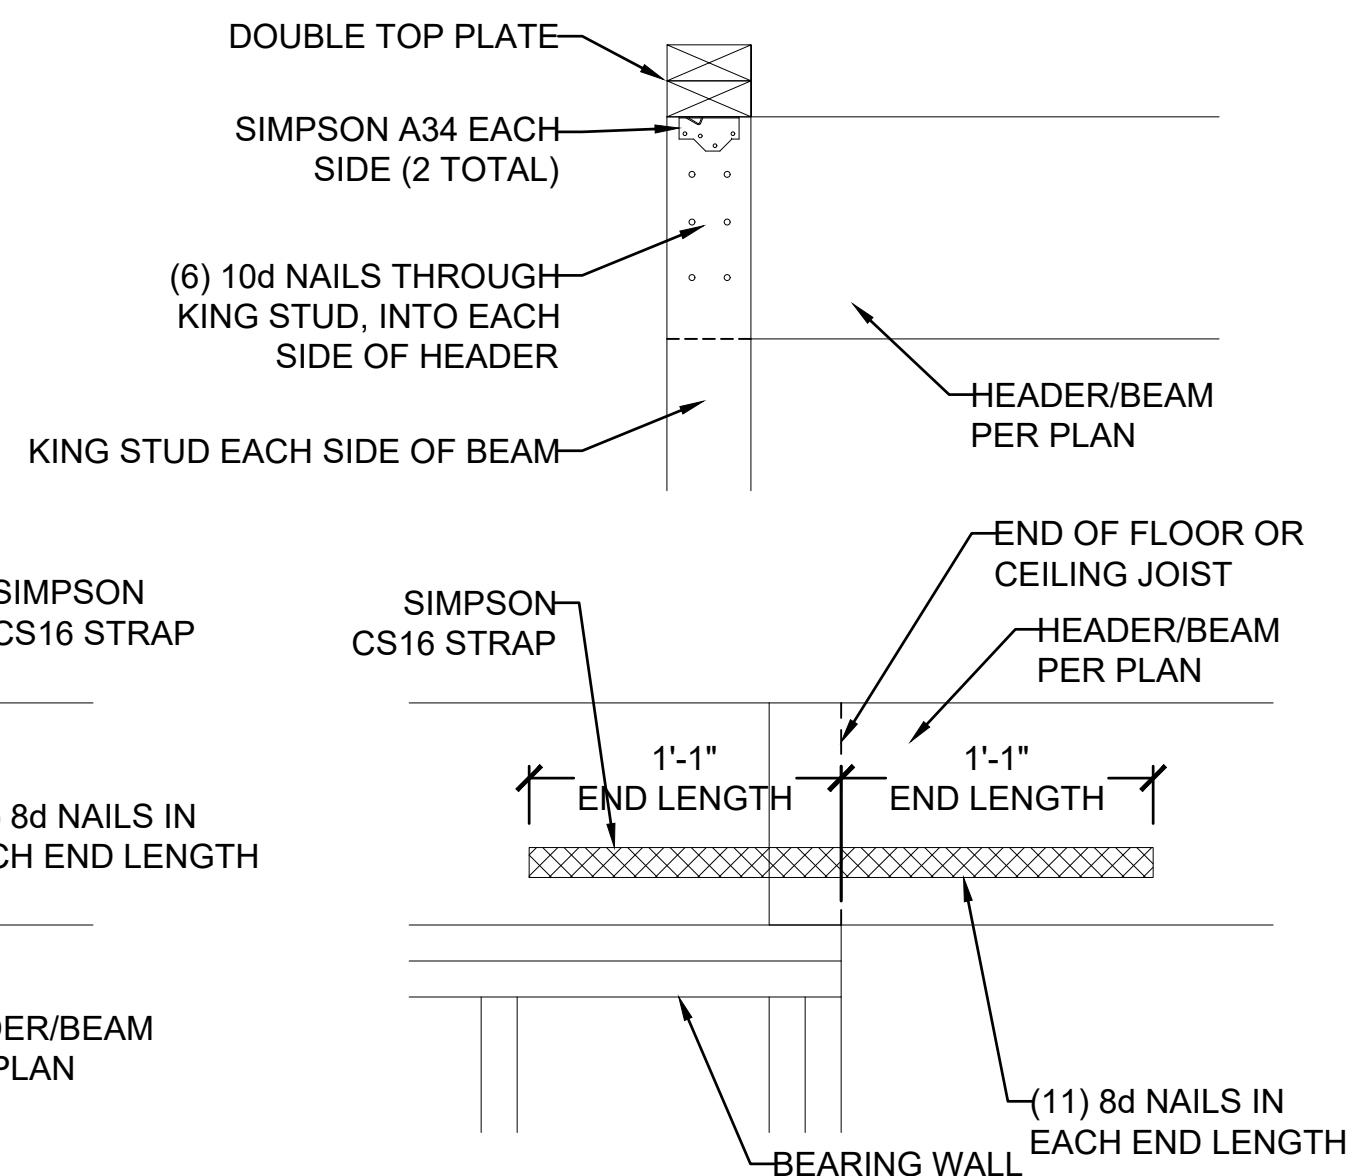

8 MAXIMUM ALLOWABLE LENGTH OF S3.2 WOOD WALL STUDS (IRC TABLE 602.3.1)

HEIGHT (FT.)	SPACING (INCHES O.C.)			
	24	16	12	8
SUPPORTING A ROOF ONLY				
10 OR LESS	2x4	2x4	2x4	2x4
12	2x6	2x4	2x4	2x4
14	2x6	2x6	2x6	2x4
16	2x6	2x6	2x6	2x4
18	DR	2x6	2x6	2x6
20	DR	DR	2x6	2x6
SUPPORTING ONE FLOOR AND A ROOF				
10 OR LESS	2x6	2x4	2x4	2x4
12	2x6	2x6	2x6	2x4
14	2x6	2x6	2x6	2x6
16	DR	2x6	2x6	2x6
18	DR	2x6	2x6	2x6
20	DR	DR	2x6	2x6
SUPPORTING TWO FLOORS AND A ROOF				
10 OR LESS	2x6	2x6	2x4	2x4
12	2x6	2x6	2x6	2x6
14	2x6	2x6	2x6	2x6
16	DR	2x6	2x6	2x6
18	DR	DR	2x6	2x6
20	DR	DR	DR	2x6

NOTES:

- 1) DR = DESIGN REQUIRED
- 2) UTILITY, STANDARD, STUD AND #3 GRADE LUMBER OF ANY SPECIES ARE NOT PERMITTED
- 3) THIS TABLE DOES NOT APPLY FOR STUDS SUPPORTING MEMBERS WITH A TRIB. LENGTH GREATER THAN 6'-0"



CLIENT: WALKER CUSTOM HOMES, LLC
JOB TITLE: WLO010 WEGNER
LOT 10, WOODLAND OAKS - FINAL PLAT
LOCATION: 2528 NE WOODLAND OAK DR.
LEE'S SUMMIT, MISSOURI

[illegible]

DRAWING TITLE		

FRAMING DETAILS









ENGINEER: DMH	CHECKED BY: DMH
JOB NO.	DRAWN BY: DMH
DATE: 01-18-24	
SHEET NUMBER	

S3.2



DECK JOIST SPAN	$\frac{1}{2}$ " Ø GALV. LAG OR $\frac{3}{8}$ " Ø LEDGER-LOK SPACING
10'-0" OR LESS	16" OC
10'-0" - 13'-11"	12" OC OR @ 16" OC DOUBLED EVERY OTHER
14'-0" - 18'-0"	8" OC OR @ 16" OC DOUBLED


SCALE: 1" = 1'-0" (18x24) OR 1½" = 1'-0" (24x36)

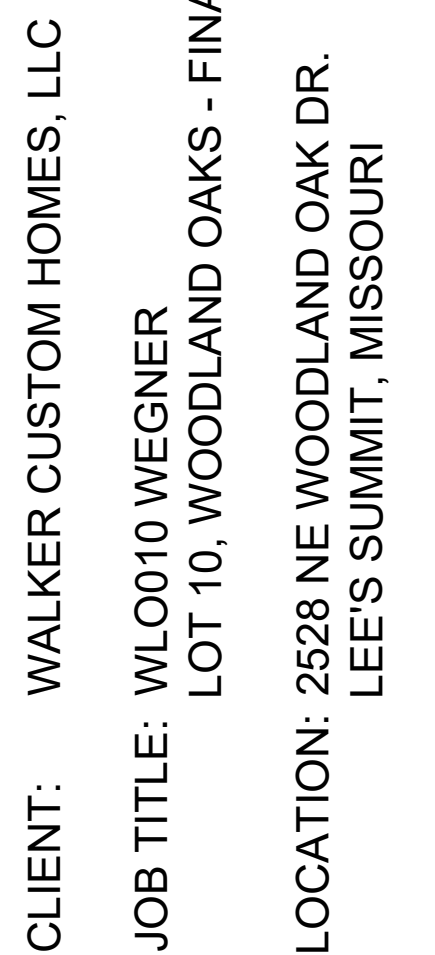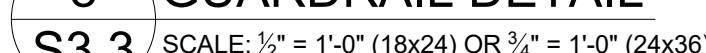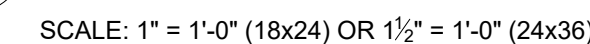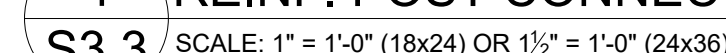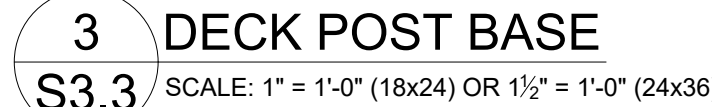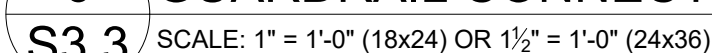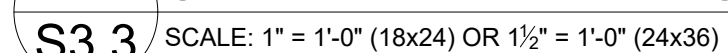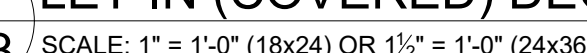


FRAMING DETAILS

ENGINEER: DMH	CHECKED BY: DMH
B NO.	DRAWN BY: DMH
DATE: 01-18-24	
SHEET NUMBER	


S3.3a

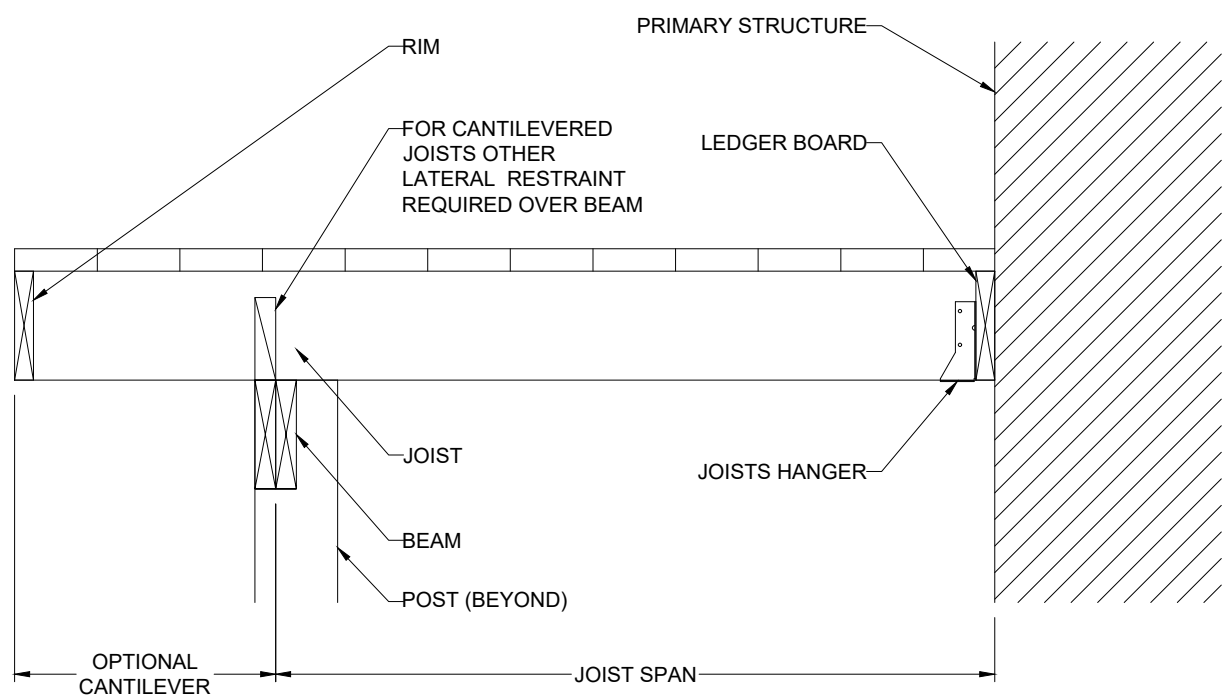


CANTILEVERED JOISTS WITH DROPPED BEAM

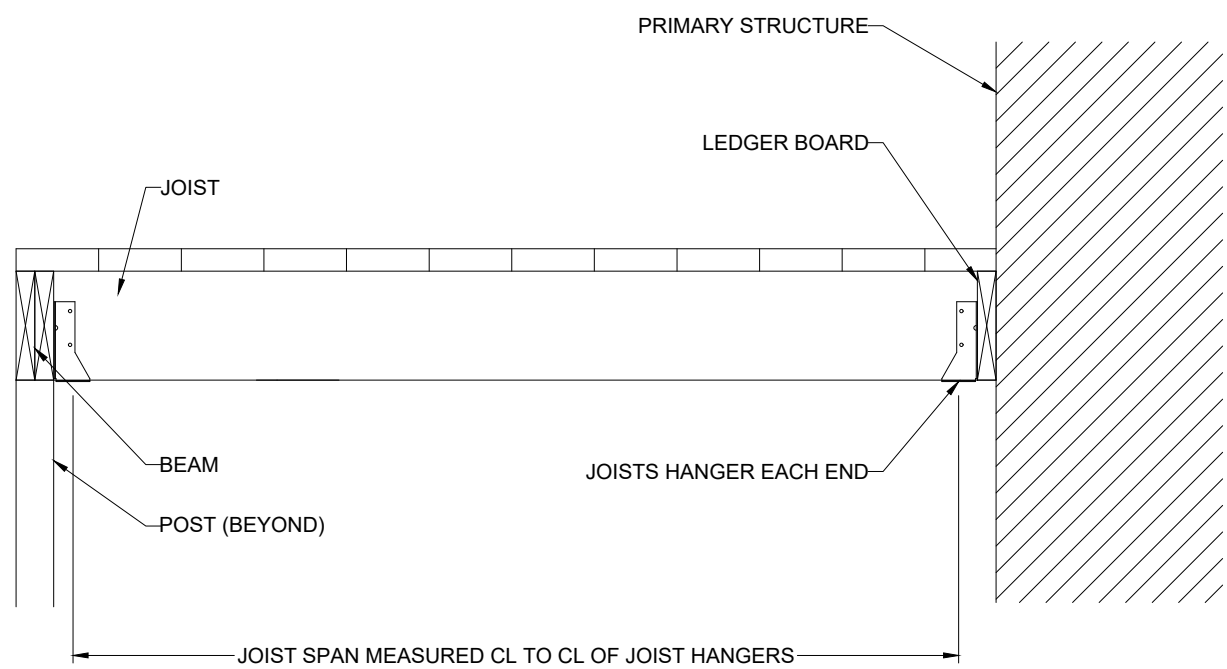

JOISTS WITH FLUSH BEAM

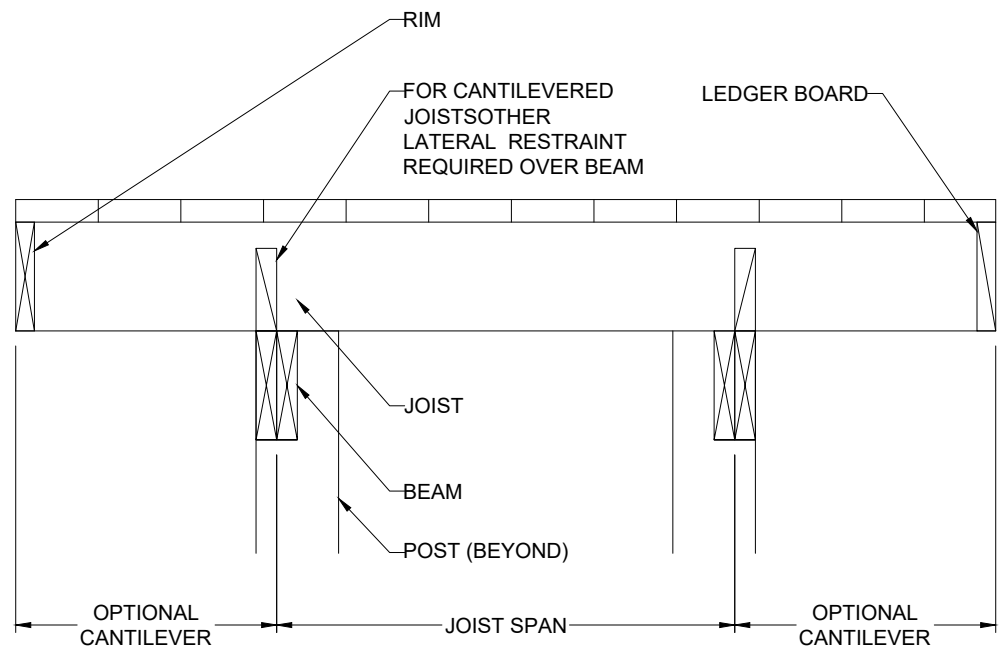


JOISTS ON FREE-STANDING DECK WITH DROPPED BEAM

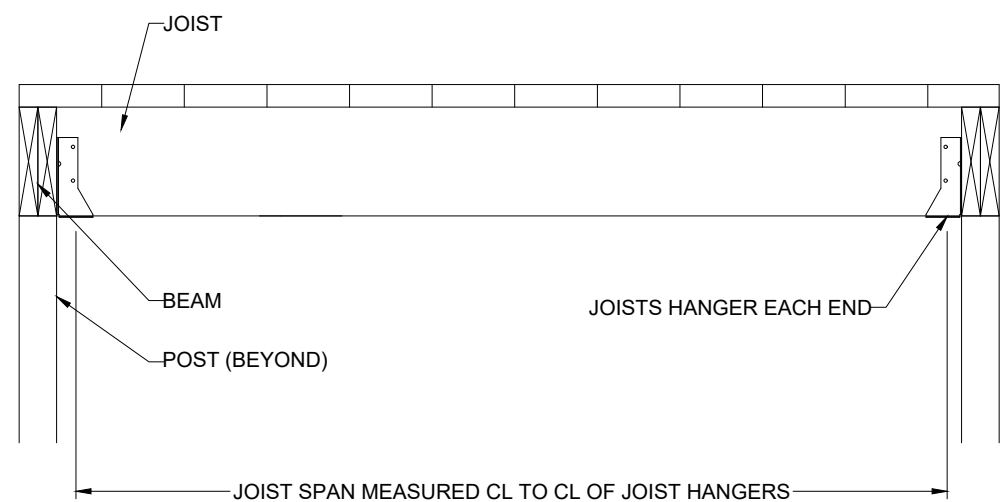


JOISTS WITH FLUSH BEAM

10 TYP. DECK JOIST SPANS
S3.3 SCALE: 1" = 1'-0" (18x24) OR 1/2" = 1'-0" (24x36)

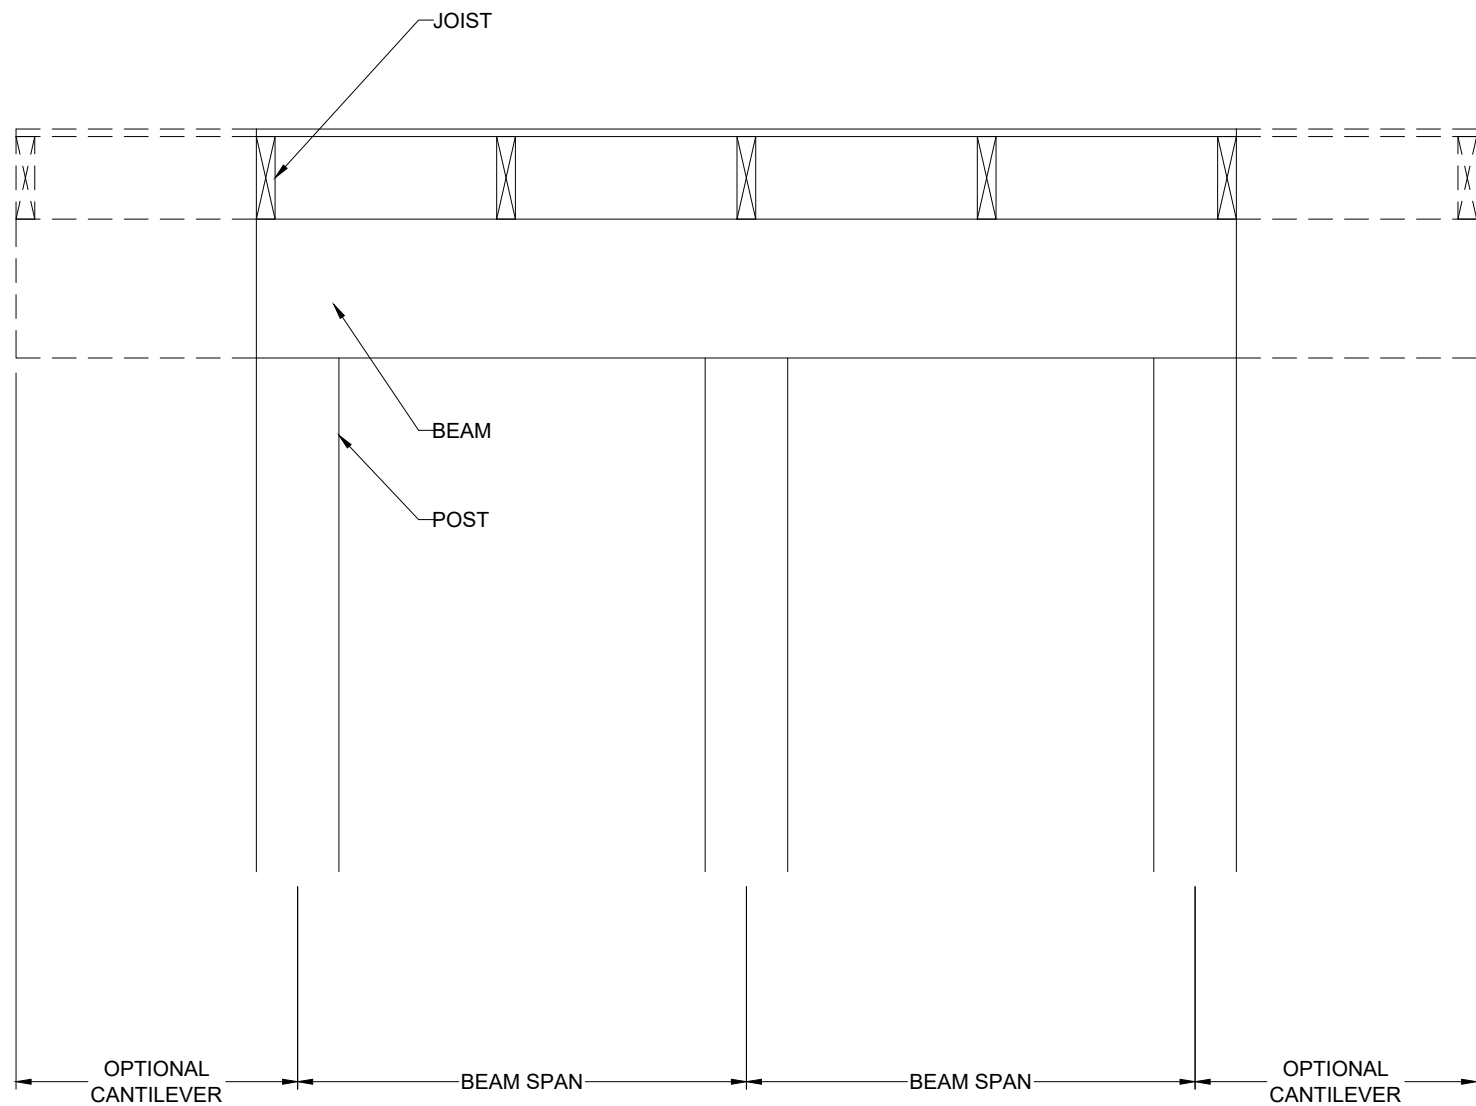

DROPPED BEAM

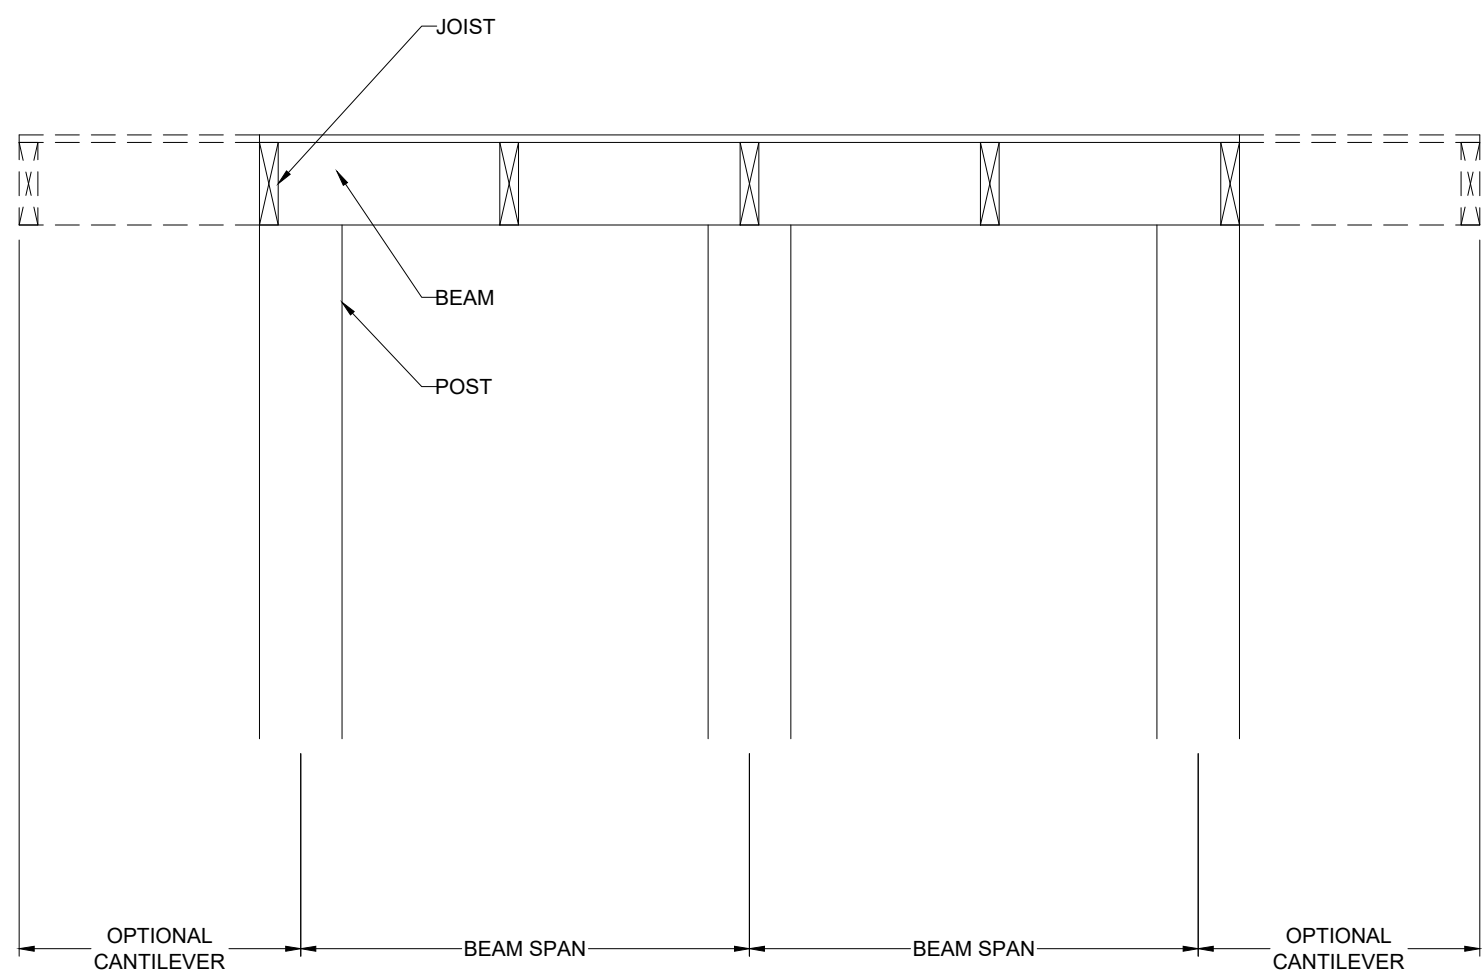

FLUSH BEAM

11 TYP. DECK JOIST SPANS
S3.3 SCALE: 1" = 1'-0" (18x24) OR 1/2" = 1'-0" (24x36)



11575 SW PACIFIC HWY # 2262 * TIGARD, OREGON 97225
OFFICE: 971.233.6099 * MOBILE: 971.233.6099 *
* DENNIS@VISTASTRUCTURAL.COM * VISTASTRUCTURAL.COM

CLIENT: WALKER CUSTOM HOMES, LLC
JOB TITLE: WLO010 WEGNER LOT 10, WOODLAND OAKS - FINAL PLAT
LOCATION: 2528 NE WOODLAND OAK DR. LEE'S SUMMIT, MISSOURI



NO.	DATE	REVISION	BY
DRAWING TITLE			
FRAMING DETAILS			
ENGINEER: DMH		CHECKED BY: DMH	
JOB NO.		DRAWN BY: DMH	
DATE: 01-18-24			
SHEET NUMBER			

S3.3b



To whom it may concern,

This is regards to condition related to address 2528 NE Woodland Oak Cir Permit 20240530. In regards to floor truss coverage application. We plan to sheetrock the underside of all unfinished spaces per Lee's Summit code.

Thanks

Jason Walker

RELEASE FOR CONSTRUCTION
AS NOTED FOR PLAN REVIEW
DEVELOPMENT SERVICES
LEE'S SUMMIT, MISSOURI

02/13/2024