



# SCHWERDT DESIGN GROUP, INC

Architecture

Interiors

Planning

Topeka, Kansas  
Oklahoma City, Oklahoma

---

---

## ARCHITECT'S SUPPLEMENTAL INSTRUCTION NO. 1

---

---

**DATE:** February 16,  
2024

**PROJECT NO:** 235008.00

**RE: Civil and MEP  
revisions**

**Streets of West Pryor – Lot 13**

---

The Work shall be carried out in accordance with the following supplemental instructions issued in accordance with the Contract Documents without change in Contract Sum or Contract Time. If changes in Contract Sum or Contract Time are required, Contractor shall submit Change Order Request in a timely manner.

ASI No. 1 is part of the contract Bid and Construction Documents and shall govern in the performance of the Work.

**DESCRIPTION:**

**Civil Items:**

**Item C1: Tree and Mulch type revised . See attached Civil sheets**

**Mechanical Items:**

**Item M1: Updated Photometrics. See attached MEP sheets**

**END OF ASI- 1**

# FINAL DEVELOPMENT PLANS

## FOR

# LOT 13A OF WEST PRYOR

### LEE'S SUMMIT

**UTILITIES**  
 Electric Service  
 EVERGY  
 Nathan Michael  
 913-347-4310  
 nathan.michael@kcpl.com

Gas Service  
 Spire  
 Katie Darnell  
 816-969-2247  
 katie.darnell@spireenergy.com


Water/Sanitary Sewer  
 Water Utilities Department  
 1200 SE Hamblen Road  
 Lee's Summit, Mo 64081  
 Jeff Thorn  
 816-969-1900  
 jeff.thorn@cityofls.net

Communication Service  
 AT&T Carrie Cilke  
 816-703-4386  
 cc3527@att.com

Time Warner Cable  
 Steve Baxter  
 913-643-1928  
 steve.baxter@charter.com

Comcast  
 Ryan Alkire  
 816-795-2218  
 ryan.alkire@cable.comcast.com

Google Fiber  
 Becky Davis  
 913-725-8745  
 rebeccadavis@google.com

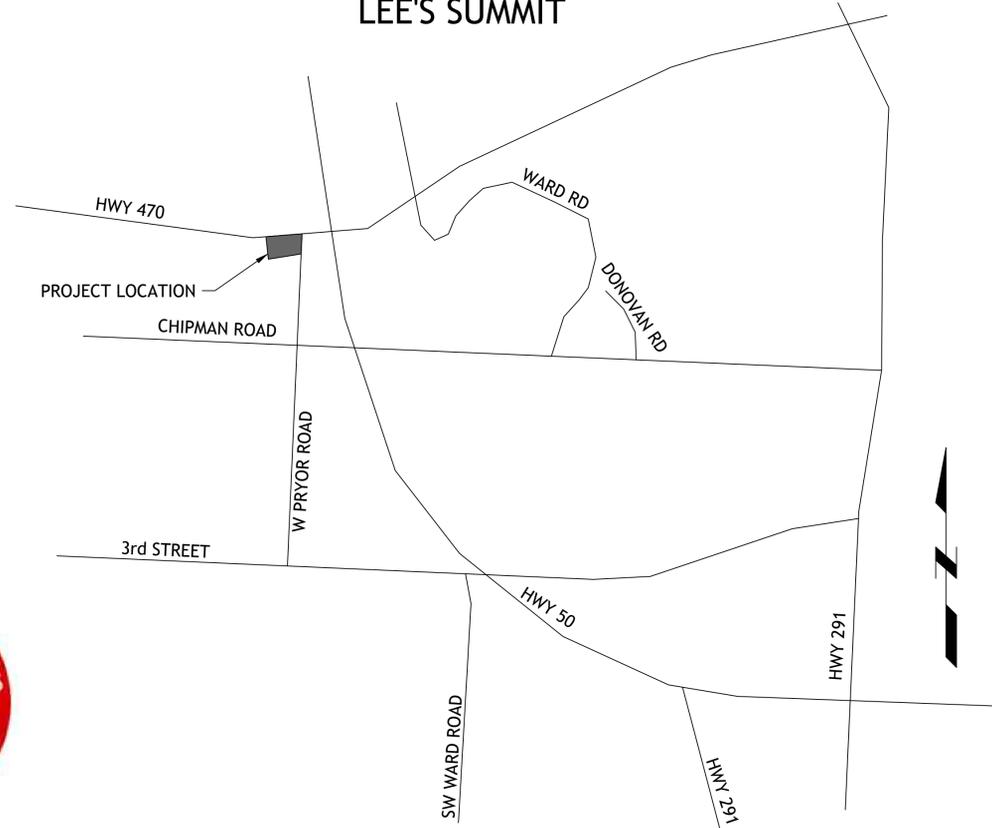

LOCATION MAP

#### INDEX OF SHEETS

- C-1 COVER SHEET
- C-2 EXISTING CONDITIONS
- C-3 SITE PLAN
- C-4 UTILITY PLAN
- C-5 GRADING PLAN
- C-6 EROSION CONTROL PLAN
- C-7 EROSION CONTROL DETAILS
- C-8 STORM LINE C PLAN AND PROFILE
- C-8.1 STORM LINE F PLAN AND PROFILE
- C-9 WATERLINE A PLAN AND PROFILE
- C-10 WATERLINE B & C PLAN AND PROFILE
- C-11 DETAILS
- C-12 DETAILS
- C-13 DETAILS
- L-1 LANDSCAPE PLAN

SM Engineering  
  
 5507 High Meadow Circle  
 Manhattan Kansas, 66503  
 smcivilengr@gmail.com  
 785.341.9747

Drawings and/or Specifications are original proprietary work and property of the Engineer and intended specifically for this project. Use of items contained herein without consent of the Engineer is prohibited. Drawings illustrate best information available to the Engineer. Field verification of actual elements, conditions, and dimensions is required.

Revisions  
 11-29-23 CITY COMMENTS  
 1-4-24 PER CLIENT  
 1-16-24 PER EVERGY

#### UTILITY STATEMENT:

THE UNDERGROUND UTILITIES SHOWN HEREON ARE FROM FIELD SURVEY INFORMATION OF ONE-CALL LOCATED UTILITIES, FIELD SURVEY INFORMATION OF ABOVE GROUND OBSERVABLE EVIDENCE, AND/OR THE SCALING AND PLOTTING OF EXISTING UTILITY MAPS AND DRAWINGS AVAILABLE TO THE SURVEYOR AT THE TIME OF SURVEY. THE SURVEYOR MAKES NO GUARANTEE THAT THE UNDERGROUND UTILITIES SHOWN COMPRISE ALL SUCH UTILITIES IN THE AREA, EITHER IN SERVICE OR ABANDONED. FURTHERMORE, THE SURVEYOR DOES NOT WARRANT THAT THE UNDERGROUND UTILITIES SHOWN ARE IN THE EXACT LOCATION INDICATED ALTHOUGH HE DOES CERTIFY THAT THEY ARE LOCATED AS ACCURATELY AS POSSIBLE FROM INFORMATION AVAILABLE. THE SURVEYOR HAS NOT PHYSICALLY LOCATED THE UNDERGROUND UTILITIES BY EXCAVATION UNLESS OTHERWISE NOTED ON THIS SURVEY.

#### SAFETY NOTICE TO CONTRACTOR

IN ACCORDANCE WITH GENERALLY ACCEPTED CONSTRUCTION PRACTICE, THE CONTRACTOR WILL BE SOLELY AND COMPLETELY RESPONSIBLE FOR CONDITIONS OF THE JOB SITE, INCLUDING SAFETY OF ALL PERSONS AND PROPERTY DURING PERFORMANCE OF THE WORK. THIS REQUIREMENT WILL APPLY CONTINUOUSLY AND NOT BE LIMITED TO NORMAL WORKING HOURS.

#### WARRANTY/DISCLAIMER

THE DESIGNS REPRESENTED IN THESE PLANS ARE IN ACCORDANCE WITH ESTABLISHED PRACTICES OF CIVIL ENGINEERING FOR THE DESIGN FUNCTIONS AND USES INTENDED BY THE OWNER AT THIS TIME. HOWEVER, NEITHER SM ENGINEERING NOR ITS PERSONNEL CAN OR DO WARRANT THESE DESIGNS OR PLANS AS CONSTRUCTED, EXCEPT IN THE SPECIFIC CASES WHERE SM ENGINEERING PERSONNEL INSPECT AND CONTROL THE PHYSICAL CONSTRUCTION ON A CONTEMPORARY BASIS AT THE SITE.

#### CAUTION- NOTICE TO CONTRACTOR

THE CONTRACTOR IS SPECIFICALLY CAUTIONED THAT THE LOCATION AND/OR ELEVATION OF EXISTING UTILITIES AS SHOWN ON THESE PLANS IS BASED ON RECORDS OF THE VARIOUS UTILITY COMPANIES AND, WHERE POSSIBLE, MEASUREMENTS TAKEN IN THE FIELD. THE INFORMATION IS NOT TO BE RELIED ON AS BEING EXACT OR COMPLETE. THE CONTRACTOR MUST CALL THE APPROPRIATE UTILITY COMPANY AT LEAST 72 HOURS BEFORE ANY EXCAVATION TO REQUEST EXACT FIELD LOCATION OF UTILITIES. IT SHALL BE THE RESPONSIBILITY OF THE CONTRACTOR TO RELOCATE ALL EXISTING UTILITIES WHICH CONFLICT WITH PROPOSED IMPROVEMENTS SHOWN ON THE PLANS. THE CONTRACTOR SHALL EXPOSE EXISTING UTILITIES AT LOCATIONS OF POSSIBLE CONFLICTS PRIOR TO ANY CONSTRUCTION.

#### LEGAL DESCRIPTION:

LOT 13A, STREETS OF WEST PRYOR, LEE'S SUMMIT, JACKSON COUNTY MISSOURI

#### BENCHMARKS:

#1 CHISELED "SQUARE" ON TOP OF CURB POINT OF INTERSECTION OF WEST PARK PARKING LOT AT EAST DRIVE ENTRANCE  
 ELEVATION 985.05

#2 CHISELED "SQUARE" ON NORTHWEST CORNER AREA INLET, 25' EAST OF CURB LINE AND ON-LINE WITH SOUTH CURB OF LOWENSTEIN DRIVE AT 90° BEND IN ROAD  
 ELEVATION 971.06

#### NOTE

1. ALL CONSTRUCTION SHALL FOLLOW THE CITY OF LEE'S SUMMIT DESIGN AND CONSTRUCTION MANUAL AS ADOPTED BY ORDINANCE 5813. WHERE DISCREPANCIES EXIST BETWEEN THESE PLANS AND THE DESIGN AND CONSTRUCTION MANUAL, THE MORE STRINGENT SHALL PREVAIL.
2. THERE ARE NO GAS/OIL WELLS PER MDNR DATABASE OF OIL & GAS PERMITS
3. SITE IS LOCATED WITHIN FEMA ZONE X, AREAS OF MINIMAL FLOODING PER FEMA 29095C0416G DATED 1-20-17.

#### DEVELOPER

STREETS OF WEST PRYOR, LLC  
 DAVID N. OLSON  
 7200 W 133rd ST, SUITE 150  
 CELL: OVERLAND PARK, KS 66213  
 314-413-3598

#### ENGINEER

SM ENGINEERING  
 5507 High Meadow Circle  
 Manhattan Kansas, 66503  
 smcivilengr@gmail.com  
 785.341.9747




SAMUEL D. MALINOWSKY  
 PROFESSIONAL ENGINEER

LOT 13A OF  
 WEST PRYOR  
 LEE'S SUMMIT, MISSOURI

sheet  
**C1.0**  
 Civil  
 COVER SHEET  
 permit  
 19 OCTOBER 2023



Revisions  
 11-29-23 CITY COMMENTS

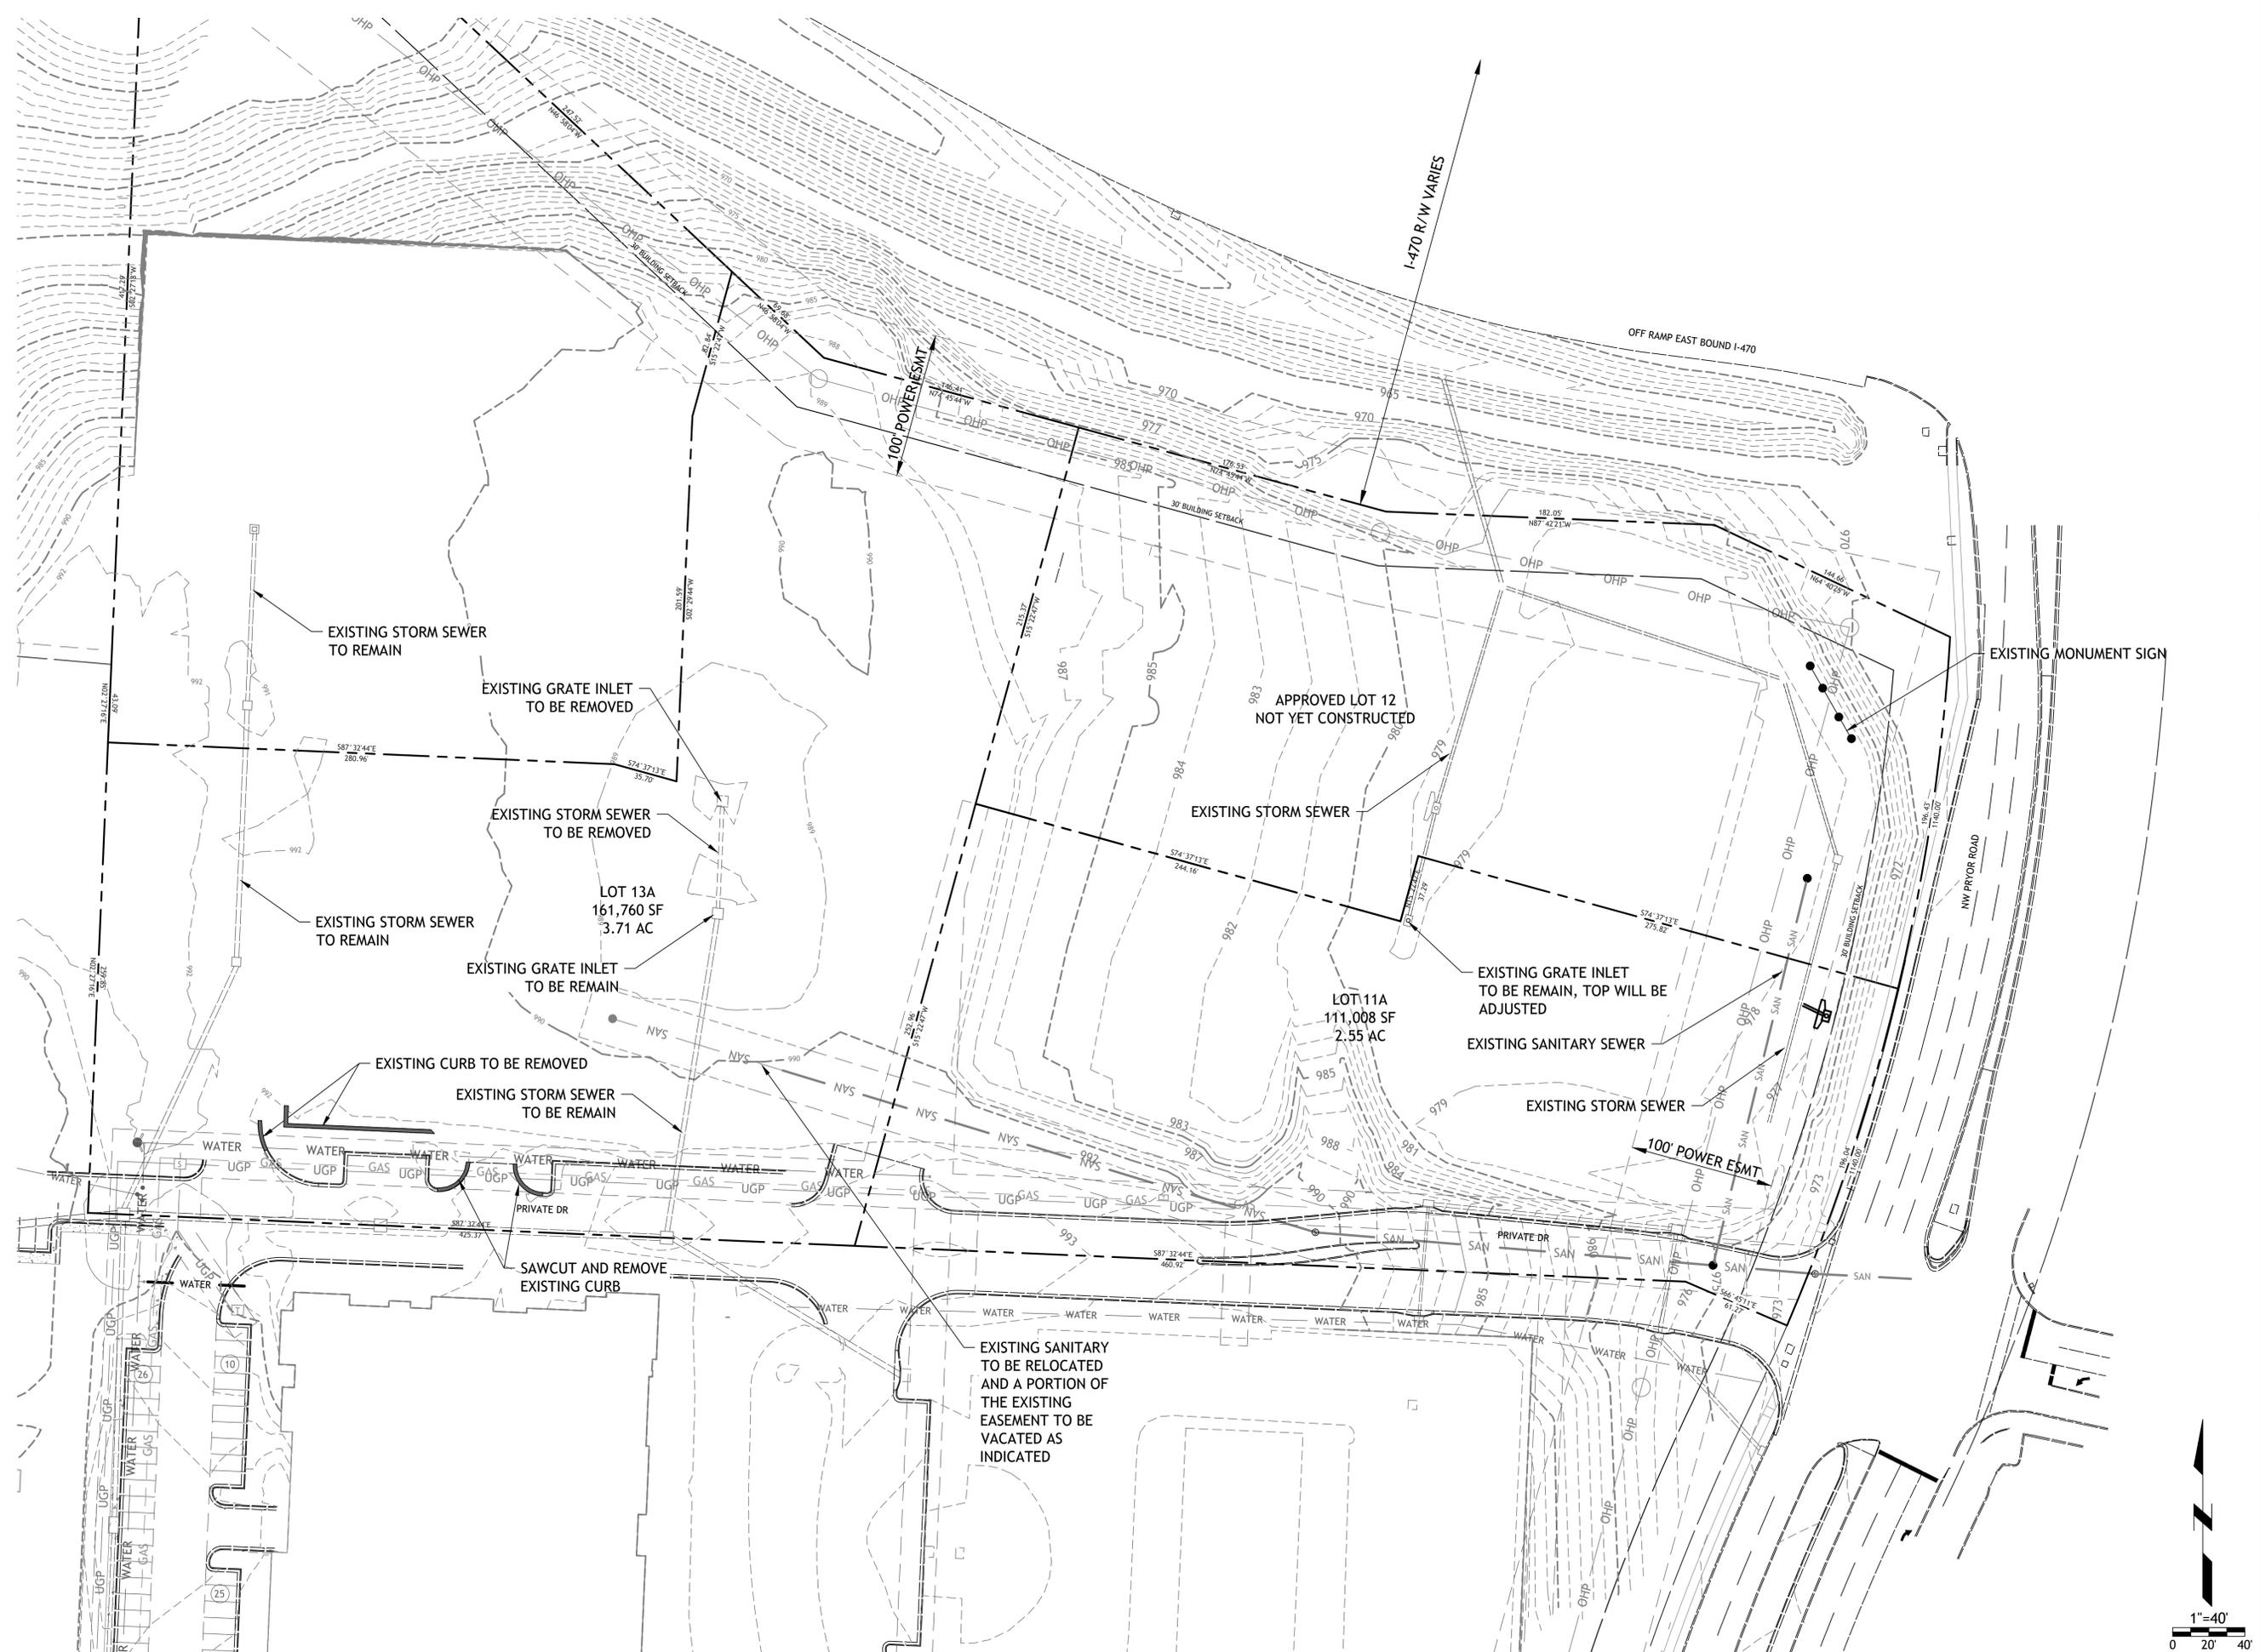

**LOT 13A OF  
 WEST PRYOR**  
 LEES SUMMIT, MISSOURI

Drawings and/or Specifications are original proprietary work and property of the Engineer and intended specifically for this project. Use of items contained herein without consent of the Engineer is prohibited. Drawings illustrate best information available to the Engineer. Field verification of actual elements, conditions, and dimensions is required.

**SITE DATA**

LOT 13	
TOTAL SITE	3.71ac (161,760sf)
PAVEMENT AREA	118,941,sf
BUILDING	12,000sf
TOTAL	130,941sf
OPEN SPACE	30,819sf (19.1%)
PARKING REQUIRED	14/1000sf
PROVIDED	247
FAR	0.074

**CONSTRUCTION NOTES:**


- COORDINATE START-UP AND ALL CONSTRUCTION ACTIVITIES WITH OWNER.
- CONSTRUCTION METHODS AND MATERIALS NOT SPECIFIED IN THESE PLANS ARE TO MEET OR EXCEED THE STANDARD SPECIFICATIONS.
- ALL CONSTRUCTION WORK AND UTILITY WORK OUTSIDE OF PROPERTY BOUNDARIES SHALL BE PERFORMED IN COOPERATION WITH AND IN ACCORDANCE WITH REGULATIONS OF THE AUTHORITIES CONCERNED.
- PUBLIC CONVENIENCE AND SAFETY: THE CONTRACTOR SHALL CONDUCT THE WORK IN A MANNER THAT WILL INSURE, AS FAR AS PRACTICABLE, THE LEAST OBSTRUCTION TO TRAFFIC, AND SHALL PROVIDE FOR THE CONVENIENCE AND SAFETY OF THE GENERAL PUBLIC AND RESIDENTS ALONG AND ADJACENT TO STREETS IN THE CONSTRUCTION AREA.
- ALL DIMENSIONS SHOWN ARE TO THE BACK OF CURB UNLESS OTHERWISE NOTED.
- ACCESSIBLE STALLS SHOWN WITH A "VAN" SHALL BE 16'-0" MIN. AND SHALL HAVE A SIGN DESIGNATING "VAN-ACCESSIBLE". SEE DETAIL 102.

**NOTE:**

- CONTRACTOR SHALL REFER TO ARCHITECTURAL PLANS FOR EXACT LOCATIONS AND DIMENSIONS OF ENTRANCE. SLOPED PAVING, EXIT PORCHES AND RAMPS, PRECISE BUILDING DIMENSIONS AND EXACT BUILDING UTILITY ENTRANCE LOCATIONS.
- THESE PLANS HAVE NOT BEEN VERIFIED WITH FINAL ARCHITECTURAL CONTRACT DRAWINGS. CONTRACTOR SHALL VERIFY AND NOTIFY THE ENGINEER OF ANY DISCREPANCIES. CONTRACTOR IS FULLY RESPONSIBLE FOR REVIEW AND COORDINATION OF ALL DRAWINGS AND CONTRACTOR DOCUMENTS.
- ALL DIMENSIONS ARE PERPENDICULAR TO PROPERTY LINE.
- ACTUAL SIGN LOCATIONS TO BE COORDINATED WITH CONSTRUCTION MANAGER.




Revisions  
11-29-23 CITY COMMENTS  
1-4-24 PER CLIENT  
1-16-24 PER EVERGY

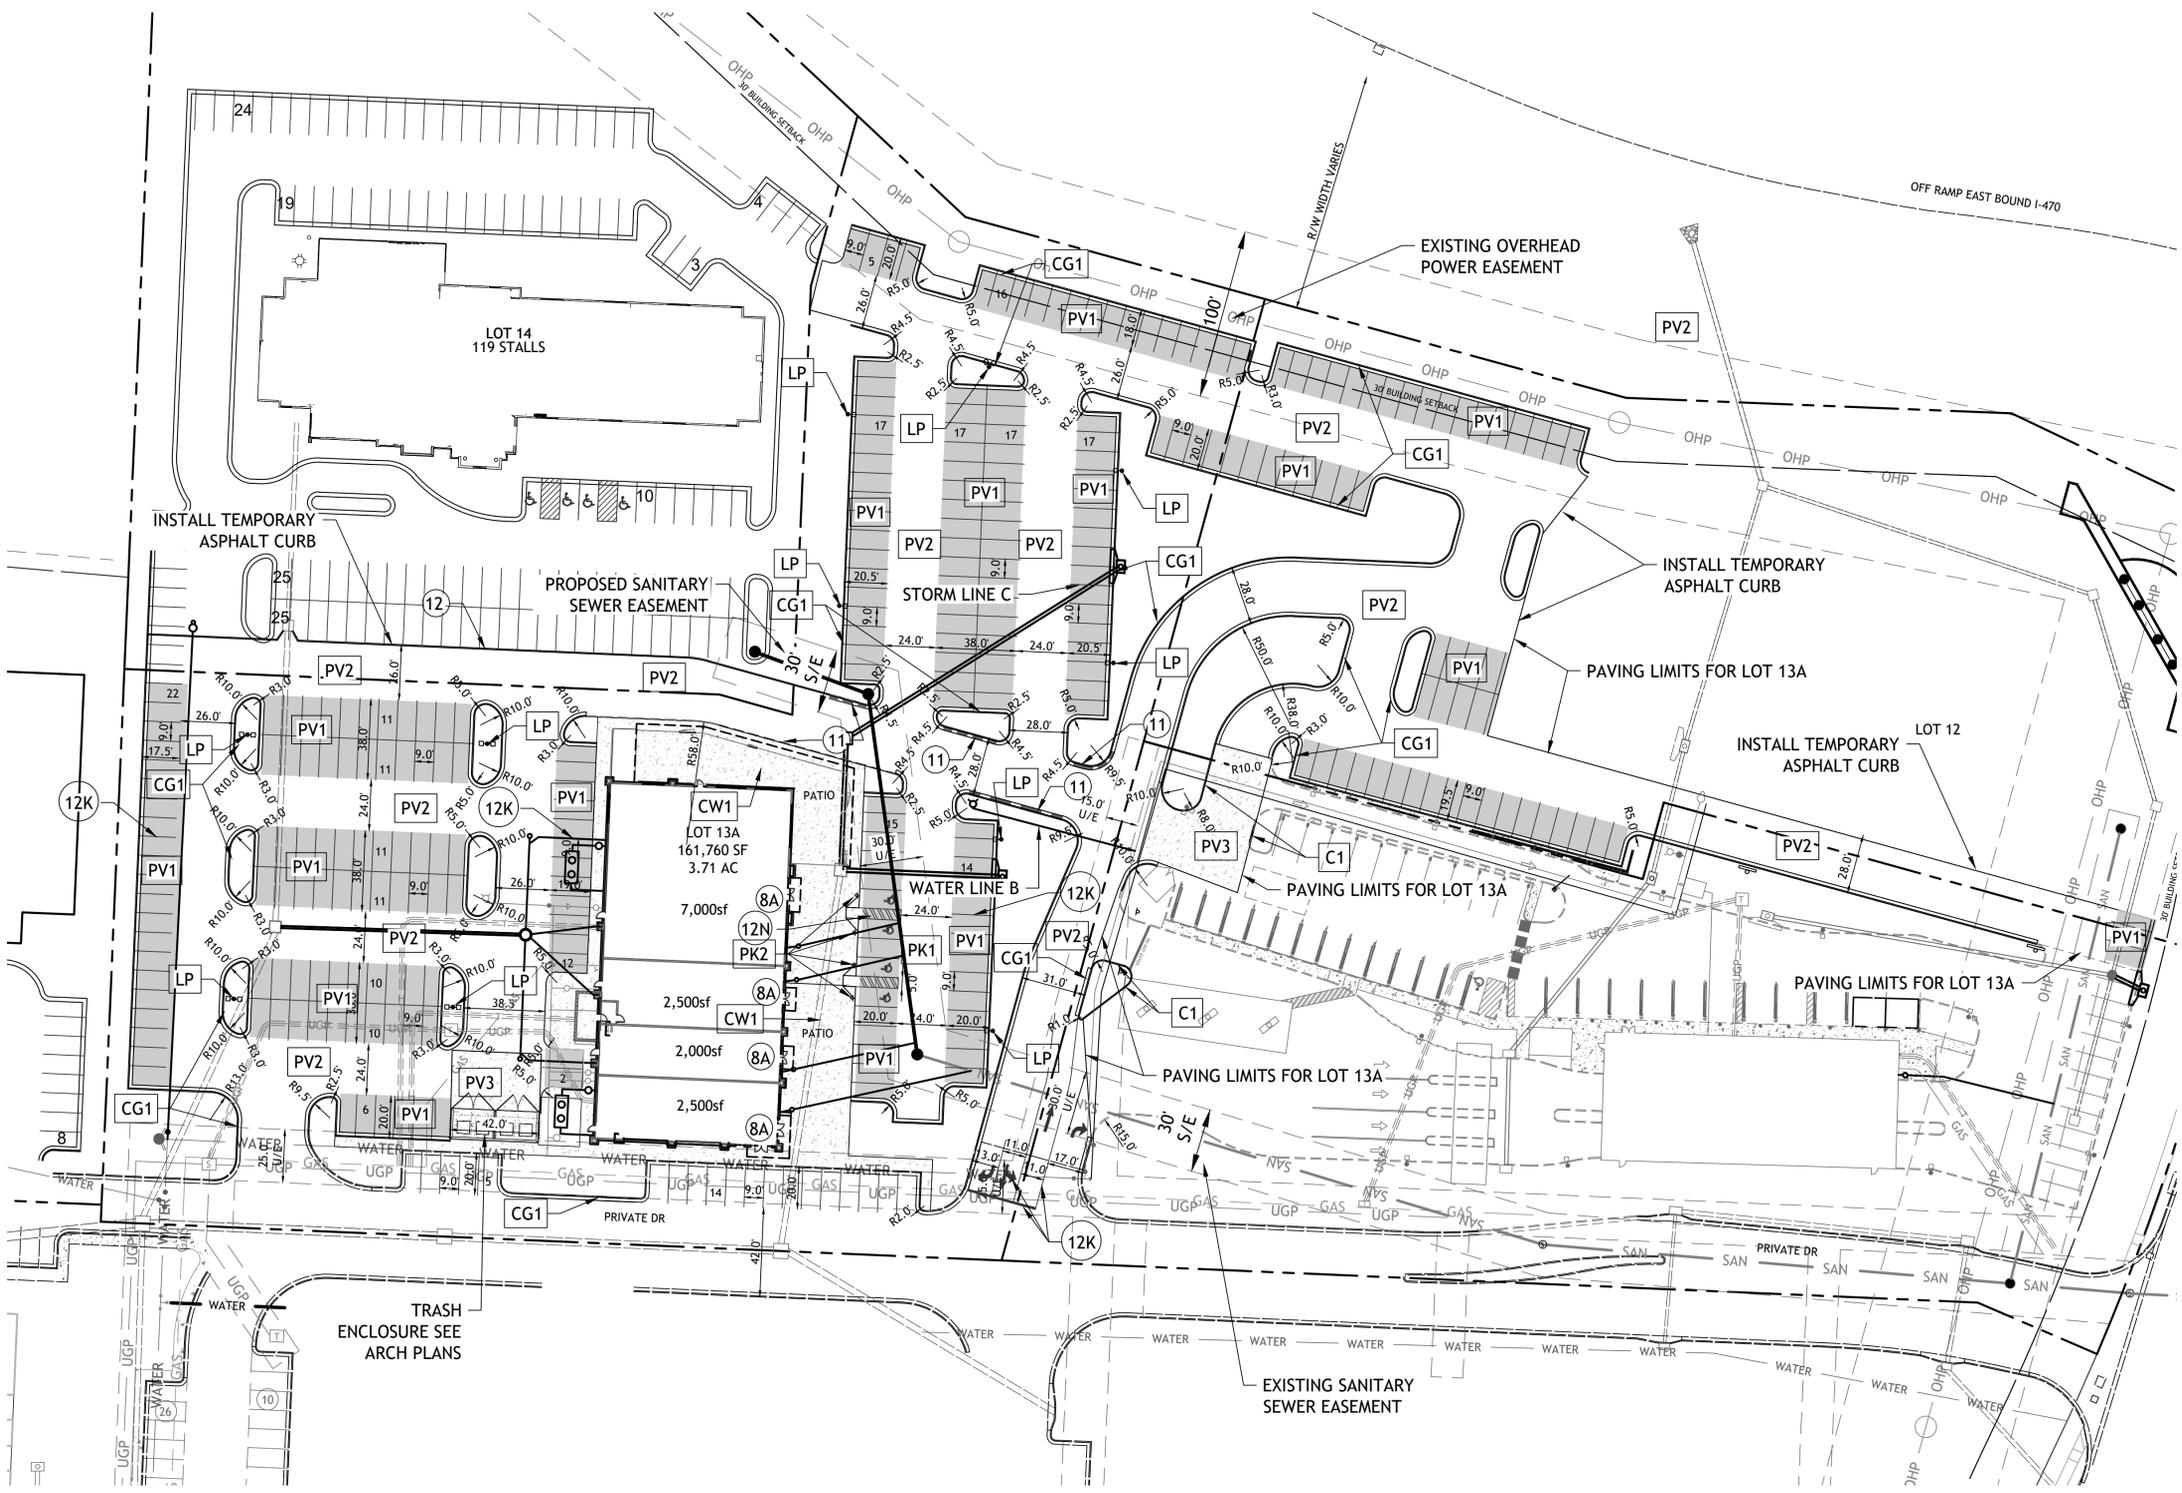

**NOTE:**  
LOT LINES SHOWN ARE PROPOSED  
LOTS 11 & 14 TO BE REPLATTED TO SHOW  
PROPOSED LOT LINES.


- SEE DETAIL SHEET FOR THE FOLLOWING DETAILS:
- PK-1 96" ACCESSIBLE & VAN ACCESSIBLE SPACE STRIPING
  - PK-2 ACCESSIBLE SIGN
  - SG-1 BOLLARD DETAIL
  - C1 STRAIGHT BACK CURB
  - CG-1 TYPE B CURB AND GUTTER
  - CW1 CURB WALK AT BUILDING
  - PV1 REGULAR DUTY PAVEMENT
  - PV2 HEAVY DUTY ASPHALT PAVEMENT
  - PV3 HEAVY DUTY CONCRETE PAVEMENT
  - CW2 SIDEWALK
  - LP LIGHT POLE (SEE ARCH PLANS)

- NOTES:**
- 8A DOOR (SEE ARCH. PLANS)
  - 12K YELLOW PARKING LOT STRIPING (SHERWIN-WILLIAMS TM 2160 LEAD FREE OR APPROVED EQUAL)
  - 12N 4" YELLOW STRIPES 3'-0" O.C.
  - 11 PAINT CURB RED WITH "FIRE LANE - NO PARKING" 4" WHITE LETTERS NO MORE THAN 15' APART
  - 12 PAINT 6" WIDE RED STRIPE WITH "FIRE LANE - NO PARKING" 4" WHITE LETTERS

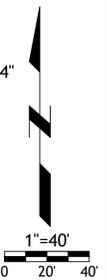

**LOT 13A OF WEST PRYOR**  
 LEES SUMMIT, MISSOURI


Drawings and/or Specifications are original proprietary work and property of the Engineer and intended specifically for this project. Use of items contained herein without consent of the Engineer is prohibited. Drawings illustrate best information available to the Engineer. Field verification of actual elements, conditions, and dimensions is required.

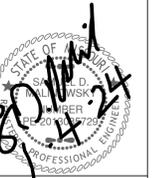

Revisions  
11-29-23 CITY COMMENTS  
1-4-24 PER CLIENT

**UTILITY NOTES:**

1. ALL UTILITY AND STORM SEWER TRENCHES CONSTRUCTED UNDER AREAS THAT RECEIVE PAVING SHALL BE BACKFILLED TO 18 INCHES ABOVE THE TOP OF THE PIPE WITH SELECT GRANULAR MATERIAL PLACED ON EIGHT-INCH LIFTS, AND COMPACTED TO 95% MODIFIED PROCTOR DENSITY.
2. CONTRACTOR SHALL NOT OPEN, TURN OFF, INTERFERE WITH, OR ATTACH ANY PIPE OR HOSE TO OR TAP ANY WATER MAIN BELONGING TO THE CITY UNLESS DULY AUTHORIZED TO DO SO BY THE CITY. ANY ADVERSE CONSEQUENCE OF ANY SCHEDULED OR UNSCHEDULED DISRUPTIONS OF SERVICE TO THE PUBLIC ARE TO BE THE LIABILITY OF THE CONTRACTOR. SM ENGINEERING AND OWNER ARE TO BE HELD HARMLESS.
3. ALL WATER AND SANITARY SEWER SYSTEMS THAT ARE TO BE PUBLIC LINES SHALL BE CONSTRUCTED IN ACCORDANCE WITH SPECIFICATIONS PREVIOUSLY APPROVED BY THE CITY OF LEE'S SUMMIT AND THE STATE OF MISSOURI AND SHALL BE INSPECTED BY THE CITY. IT IS THE CONTRACTOR'S RESPONSIBILITY TO ASSURE THAT THIS INSPECTION OCCURS.
4. LOCATIONS SHOWN FOR PROPOSED WATER LINES ARE APPROXIMATE. VARIATIONS MAY BE MADE, WITH APPROVAL OF THE ENGINEER, TO AVOID CONFLICTS.
5. CONTRACTOR TO INSTALL TRACING TAPE ALONG ALL NON-METALLIC WATER MAINS AND SERVICE LINES PER SPECIFICATIONS.
6. CONTRACTOR SHALL EXPOSE EXISTING UTILITIES AT LOCATIONS OF POSSIBLE CONFLICT AND POINTS OF CONNECTION PRIOR TO ANY CONSTRUCTION OF NEW UTILITIES.
7. WATER LINES SHALL HAVE A MINIMUM COVER OF 42 INCHES. ALL VALVES ON MAINS AND FIRE HYDRANT LEADS SHALL BE WITH VALVE BOX ASSEMBLIES. THE SIZE OF VALVE BOX ASSEMBLY TO BE INSTALLED IS DETERMINED BY THE TYPE AND SIZE OF VALVE. VALVE BOX CAPS SHALL HAVE THE WORD "WATER".
8. A MINIMUM HORIZONTAL DISTANCE OF 10 FEET SHALL BE MAINTAINED BETWEEN PARALLEL WATER AND SANITARY SEWER LINES. WHEN IT IS NECESSARY FOR ANY WATER LINE TO CROSS A SANITARY SEWER LINE, THE SEWER LINE SHALL BE CONSTRUCTED OF DUCTILE IRON PIPE AT LEAST 10 FEET EITHER SIDE OF THE WATER LINE UNLESS THE WATER LINE IS AT LEAST 2 FEET CLEAR DISTANCE ABOVE THE SANITARY SEWER LINE.
9. INSTALL 2" TYPE "K" COPPER FROM THE MAIN TO 10' BEYOND METER AND EITHER TYPE "K" OR POLYETHYLENE PLASTIC TUBING (PE 3608) TO STOP AND WASTE VALVE INSIDE BUILDING.
10. CONTRACTOR RESPONSIBLE FOR PROVIDING CASEMENT FOR ELECTRICAL SERVICE PER KCPL&L
11. SANITARY SEWER SERVICE CONNECTIONS WILL BE MADE WITH A CUT IN WYE

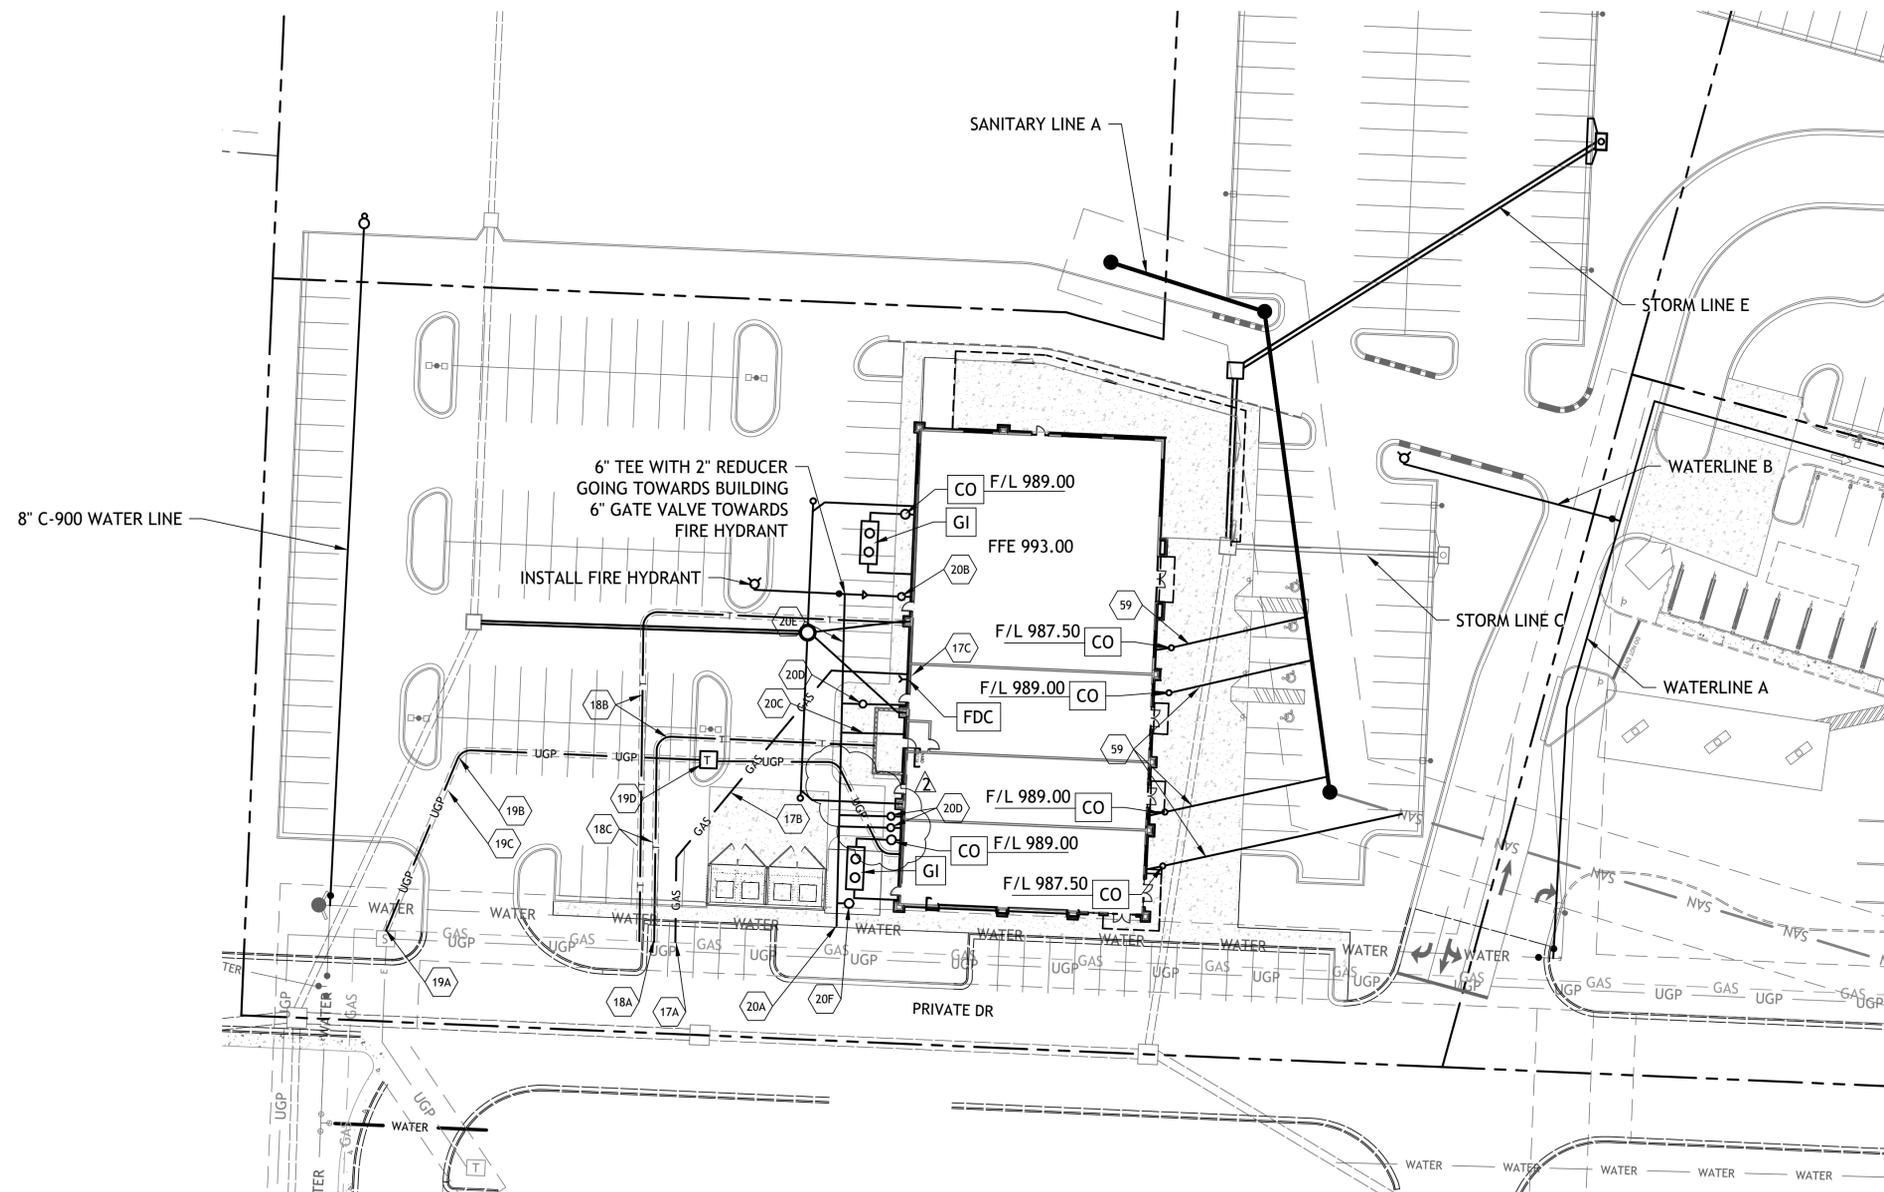

**DETAILS**


MS1	TRENCH AND BEDDING DETAILS
SS2	2-WAY CLEAN-OUT
FH	FIRE HYDRANT
CO	CLEANOUT
GI	GREASE INTERCEPTOR (1,500 GAL)

**NOTES**

- |     |   |
|-----|---|
| 17A | POINT OF CONNECTION - GAS SERVICE   |
| 17B | GAS SERVICE (BY GAS COMPANY)  |
| 17C | GAS METER   |
| 18A | POINT OF CONNECTION - TELEPHONE SERVICE - COORDINATE WITH TELEPHONE COMPANY |
| 18B | UNDERGROUND TELEPHONE SERVICE PER LOCAL TELEPHONE COMPANY                   |
| 18C | 2-2" CONDUITS INSTALLED BY CONTRACTOR - TELEPHONE SERVICE                   |
| 19A | POINT OF CONNECTION - ELECTRICAL SERVICE                                    |
| 19C | 4" CONDUIT WITH STEEL SWEEPS INSTALLED BY CONTRACTOR - ELECTRIC SERVICE     |
| 19D | TRANSFORMER PAD   |
| 20A | POINT OF CONNECTION - WATER SERVICE   |
| 20B | 2" TAP AND METER WITH 2" SERVICE LINE                                       |
| 20C | 6" FIRE LINE  |
| 20D | 1" TAP AND METER WITH 1"  |
| 20E | 6" C-900 WATERLINE  |
| 59  | 4" SANITARY SEWER SERVICE LINE  |
| 20F | 1" TAP AND METER WITH 1" SERVICE LINE FOR IRRIGATION                        |

**UTILITY STATEMENT:**

THE UNDERGROUND UTILITIES SHOWN HEREON ARE FROM FIELD SURVEY INFORMATION OF ONE-CALL LOCATED UTILITIES, FIELD SURVEY INFORMATION OF ABOVE GROUND OBSERVABLE EVIDENCE, AND/OR THE SCALING AND PLOTTING OF EXISTING UTILITY MAPS AND DRAWINGS AVAILABLE TO THE SURVEYOR AT THE TIME OF SURVEY. THE SURVEYOR MAKES NO GUARANTEE THAT THE UNDERGROUND UTILITIES SHOWN COMPRISE ALL SUCH UTILITIES IN THE AREA, EITHER IN SERVICE OR ABANDONED. FURTHERMORE, THE SURVEYOR DOES NOT WARRANT THAT THE UNDERGROUND UTILITIES SHOWN ARE IN THE EXACT LOCATION INDICATED ALTHOUGH HE DOES CERTIFY THAT THEY ARE LOCATED AS ACCURATELY AS POSSIBLE FROM INFORMATION AVAILABLE. THE SURVEYOR HAS NOT PHYSICALLY LOCATED THE UNDERGROUND UTILITIES BY EXCAVATION UNLESS OTHERWISE NOTED ON THIS SURVEY.

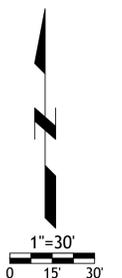


**LOT 13A OF WEST PRYOR**  
 LEE'S SUMMIT, MISSOURI

sheet


**C4.0**

Civil  
UTILITY PLAN  
permit  
19 OCTOBER 2023

Drawings and/or Specifications are original proprietary work and property of the Engineer and intended specifically for this project. Use of items contained herein without consent of the Engineer is prohibited. Drawings illustrate best information available to the Engineer. Field verification of actual elements, conditions, and dimensions is required.

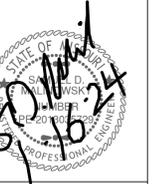


Revisions  
11-29-23 CITY COMMENTS  
1-4-24 PER CLIENT  
1-16-24 PER EVERGY

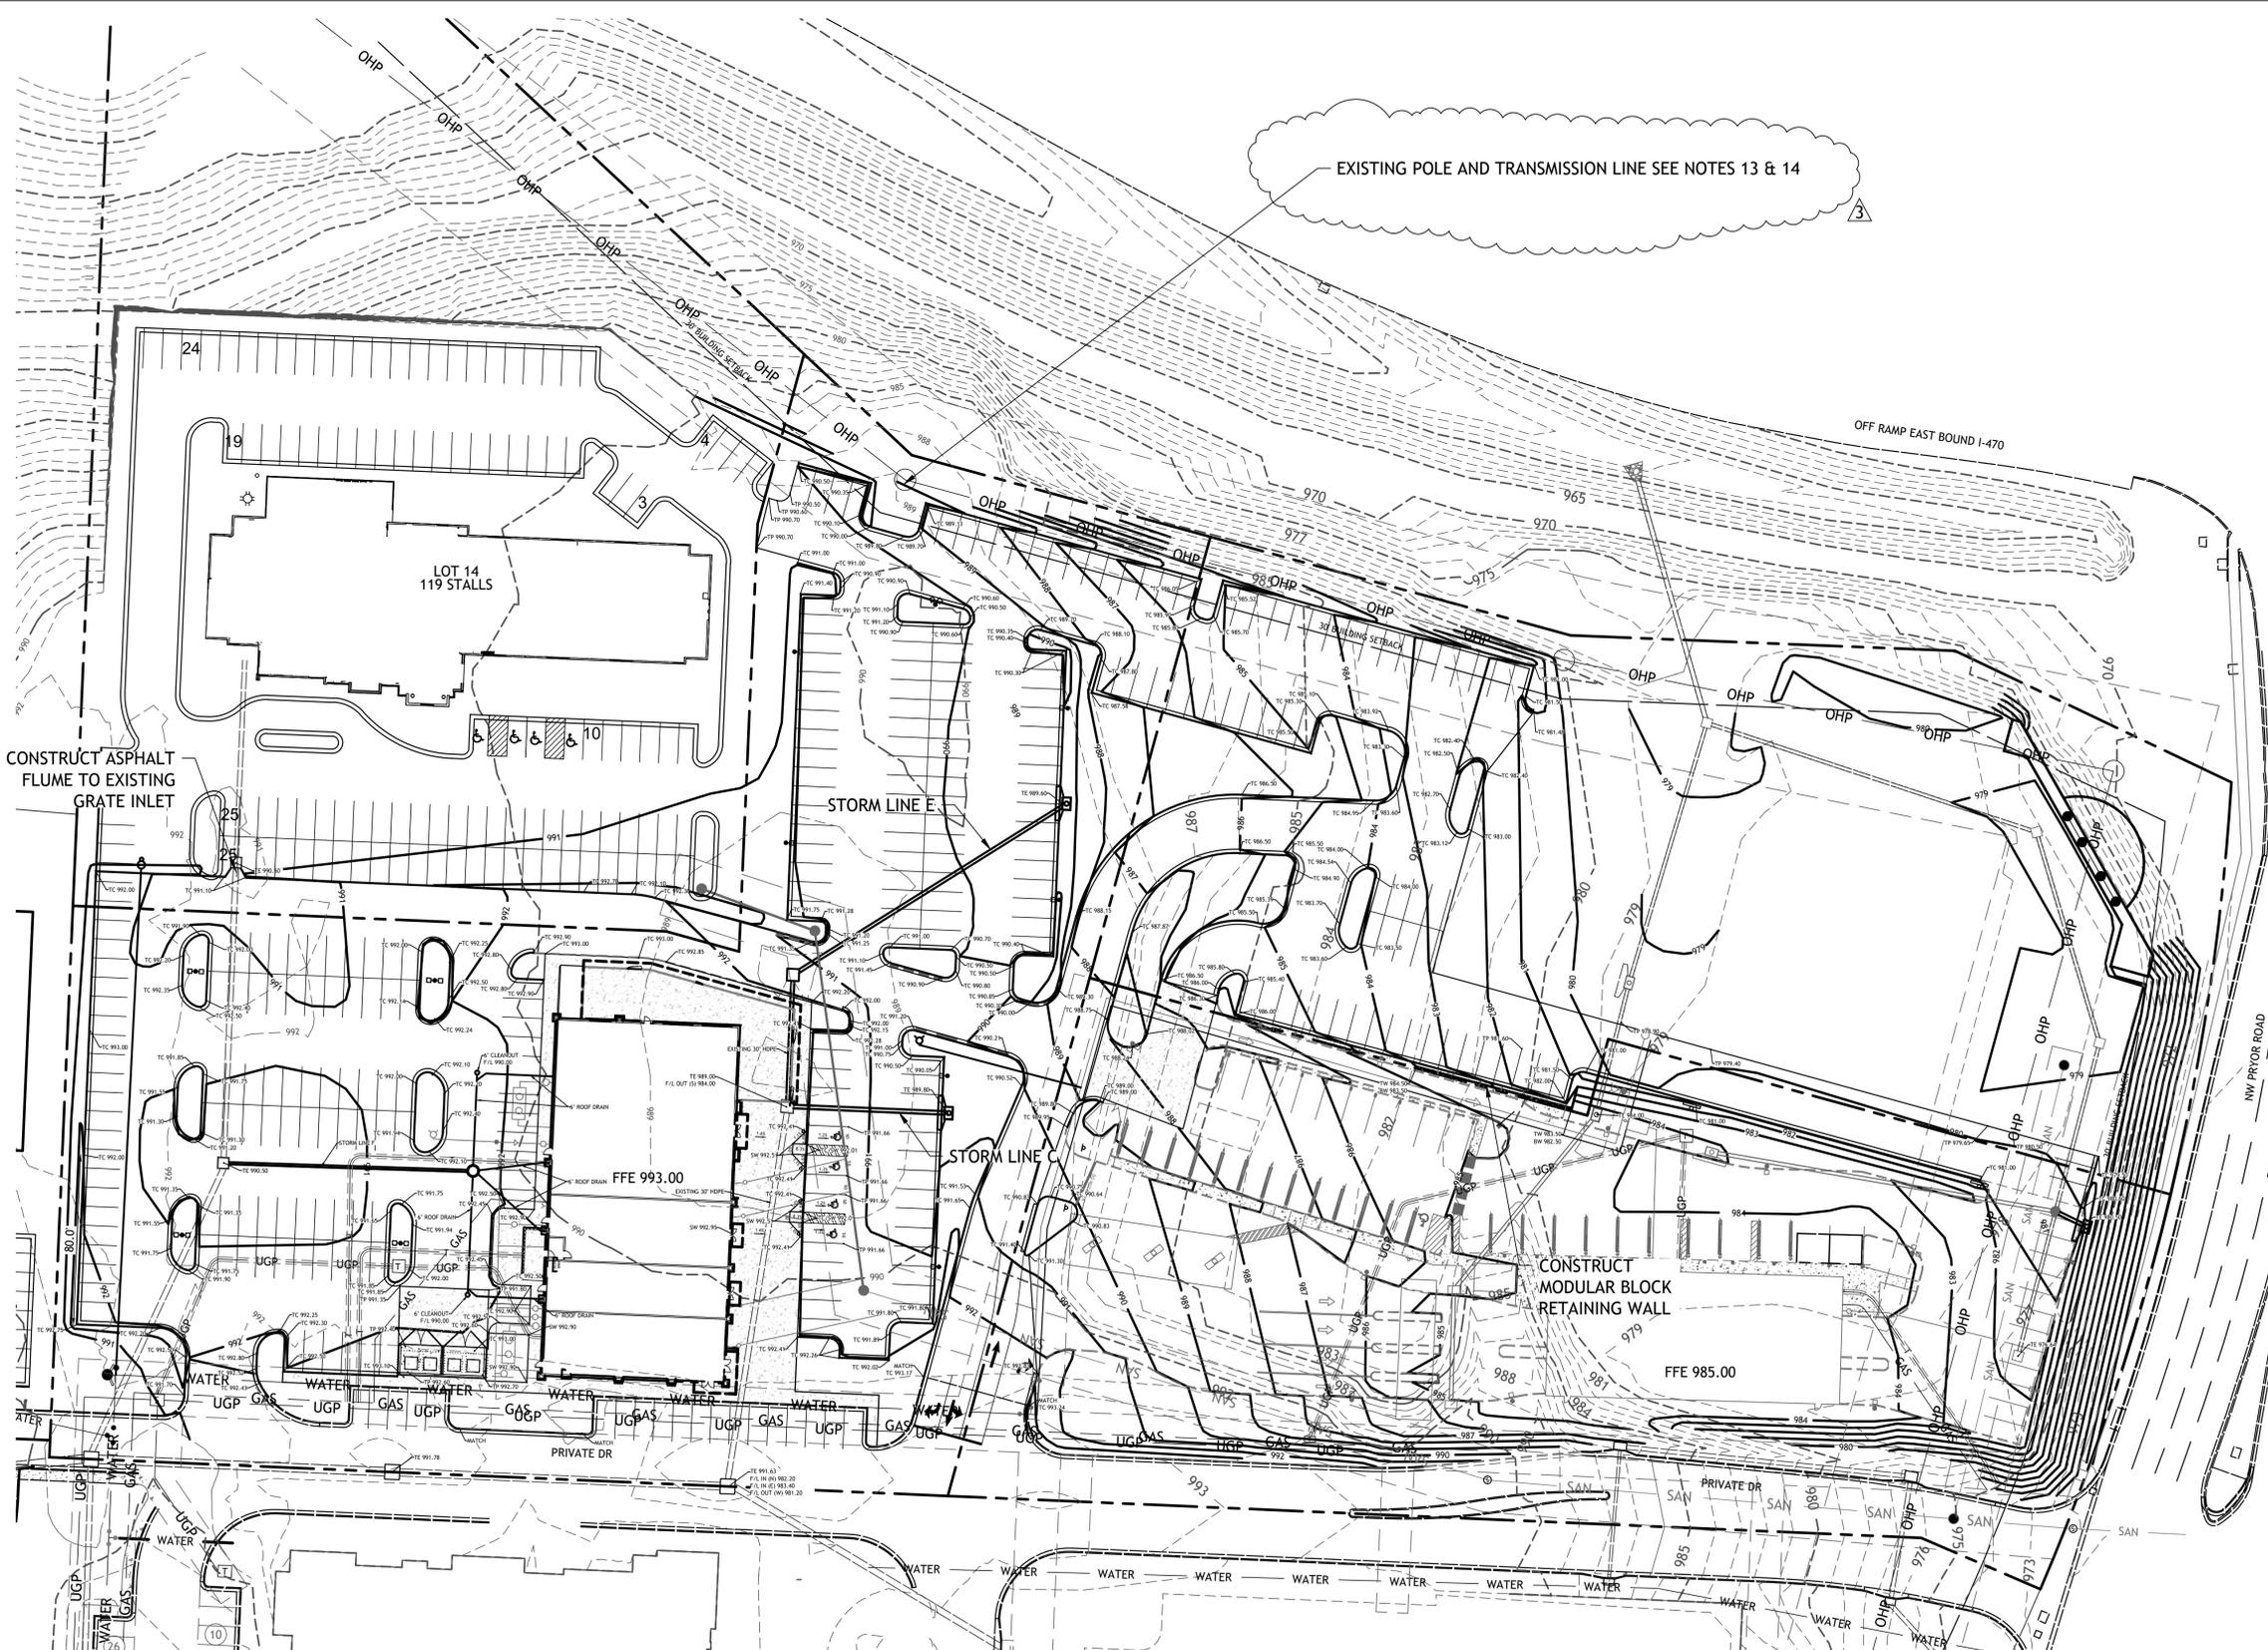


- GRADING NOTES:**
- EARTHWORK UNDER THE BUILDING SHALL COMPLY WITH THE PROJECT ARCHITECTURAL PLANS. OTHER FILL MATERIAL SHALL BE MADE IN LIFTS NOT TO EXCEED EIGHT INCHES DEPTH COMPACTED TO 95% STANDARD PROCTOR DENSITY. FILL MATERIAL MAY INCLUDE ROCK FROM ON-SITE EXCAVATION IF CAREFULLY PLACED SO THAT LARGE STONES ARE WELL DISTRIBUTED AND VOIDS ARE COMPLETELY FILLED WITH SMALLER STONES, EARTH, SAND OR GRAVEL TO FURNISH A SOLID EMBANKMENT. NO ROCK LARGER THAN THREE INCHES IN ANY DIMENSION NOR ANY SHALE SHALL BE PLACED IN THE TOP 12 INCHES OF EMBANKMENT.
  - AREAS THAT ARE TO BE CUT TO SUBGRADE LEVELS SHALL BE PROOF ROLLED WITH A MODERATELY HEAVY LOADED DUMP TRUCK OR SIMILAR APPROVED CONSTRUCTION EQUIPMENT TO DETECT UNSUITABLE SOIL CONDITIONS.
  - IN ALL AREAS OF EXCAVATION, IF UNSUITABLE SOIL CONDITIONS ARE ENCOUNTERED, A QUALIFIED GEOTECHNICAL ENGINEER SHALL RECOMMEND TO THE OWNER THE METHODS OF UNDERCUTTING AND REPLACEMENT OF PROPERLY COMPACTED, APPROVED FILL MATERIAL. ALL PROOF ROLLING AND UNDERCUTTING SHOULD BE PERFORMED DURING A PERIOD OF DRY WEATHER.
  - CONTRACTOR SHALL USE SILT FENCE OR OTHER MEANS OF CONTROLLING EROSION ALONG THE EDGE OF THE PROPERTY OR OTHER BOTTOM OF SLOPE LOCATIONS.
  - CONTRACTOR IS TO REMOVE AND DISPOSE OF ALL DEBRIS, RUBBISH AND OTHER MATERIALS RESULTING FROM PREVIOUS AND CURRENT DEMOLITION OPERATIONS.
  - THE CONTRACTOR SHALL TAKE ALL PRECAUTIONS NECESSARY TO AVOID PROPERTY DAMAGE TO ADJACENT PROPERTIES DURING THE CONSTRUCTION PHASES OF THIS PROJECT. THE CONTRACTOR WILL BE HELD SOLELY RESPONSIBLE FOR ANY DAMAGES TO THE ADJACENT PROPERTIES OCCURRING DURING THE CONSTRUCTION PHASES OF THIS PROJECT.
  - IT IS NOT THE DUTY OF THE ENGINEER OR THE OWNER TO REVIEW THE ADEQUACY OF THE CONTRACTOR'S SAFETY MEASURES, IN, ON OR NEAR THE CONSTRUCTION SITE AT ANY TIME DURING CONSTRUCTION.
  - PIPE LENGTHS ARE CENTER TO CENTER OF STRUCTURE OR TO END OF END SECTIONS.
  - HANDICAP STALLS SHALL MEET ADA REQUIREMENTS AND SHALL NOT EXCEED 2% SLOPE IN ANY DIRECTION AT THE BUILDING ENTRY AND ACCESSIBLE PARKING STALLS. SLOPES EXCEEDING 2.0% WILL BE REPLACED AT THE CONTRACTOR'S EXPENSE.
  - ALL CONSTRUCTION TRAFFIC, TEMPORARY TRAFFIC CONTROL DEVICES AND PAVEMENT MARKINGS SHALL CONFORM TO REQUIREMENTS OF THE LATEST MANUAL OF UNIFORM TRAFFIC CONTROL DEVICES.
  - CONTRACTOR TO PLACE 8" LOW PERMEABILITY LVC FOR BUILDING PAD
  - CONTRACTOR TO CONSTRUCT THROATS TO CURB INLETS.
  - NO HEAVY EQUIPMENT ALLOWED WITHIN 5' OF EXISTING POLE FOUNDATION TOP OF FOUNDATION SHALL REMAIN 2' ABOVE EXISTING GROUND UPON COMPLETION OF CONSTRUCTION.
  - AT NO TIME SHALL CONSTRUCTION EQUIPMENT BE ALLOWED WITH 20' OF ANY PART OF THE TRANSMISSION LINE.

**NOTE**  
ANY GRADING SHOWN ON LOT 11 OTHER THAN WHAT IS REQUIRED FOR THE ACCESS DRIVES INDICATED ON THE SITE PLAN IS SHOWN FOR INFORMATION ONLY AND IS NOT PART OF THESE PLANS.

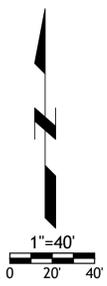

**LOT 13A OF  
WEST PRYOR**  
LEE'S SUMMIT, MISSOURI


Drawings and/or Specifications are original proprietary work and property of the Engineer and intended specifically for this project. Use of items contained herein without consent of the Engineer is prohibited. Drawings illustrate best information available to the Engineer. Field verification of actual elements, conditions, and dimensions is required.

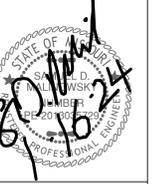

Revisions  
11-29-23 CITY COMMENTS  
1-4-24 PER CLIENT  
1-16-24 PER EVERGY


LOT 13A OF  
WEST PRYOR  
LEES SUMMIT, MISSOURI

- NOTES:
- Prior to Land Disturbance activities, the following shall occur:
    - Identify the limits of construction on the ground with easily recognizable indications such as construction staking, construction fencing and placement of physical barriers or other means acceptable to the City Inspector and in conformance with the erosion and pollution control plan;
    - Construct a stabilized entrance/parking/staging area;
    - Install perimeter controls and protect any existing stormwater inlets;
    - Request an initial inspection of the installed Phase I pollution control measures designated on the approved erosion and pollution control plan. Land disturbance work shall not proceed until there is a passed inspection MoDNR general requirements
  - The site shall comply with all requirements of the MoDNR general requirements
    - Immediate initiation of temporary stabilization BMPs on disturbed areas where construction activities have temporarily ceased on that portion of the project site if construction activities will not resume for a period exceeding 14 calendar days. Temporary stabilization may include establishment of vegetation, geotextiles, mulches or other techniques to reduce or eliminate erosion until either final stabilization can be achieved or until further construction activities take place to re-disturb the area. This stabilization must be completed within 14 calendar days;
    - Inspection of erosion and sediment control measures shall be performed to meet or exceed the minimum inspection frequency in the MoDNR General Permit. At a minimum, inspections shall be performed during all phases of construction at least once every 14 days and within 24 hours of each precipitation event.
    - An inspection log shall be maintained and shall be available for review by the regulatory authority;
    - The erosion and pollution control plan shall be routinely updated to show all modifications and amendments to the original plan. A copy of the erosion and pollution control plan shall be kept on site and made available for review by the regulatory authority.
  - Temporary seeding shall only be used for periods not to exceed 12 months. For final stabilization, temporary seeding shall only be used to establish vegetation outside the permanent seeding or sodding dates as specified in the Standard Specifications. Final stabilization requires a uniform perennial vegetative cover with a density of 70% over 100% of disturbed area.
  - Erosion and pollution control shall be provided for the duration of a project. All installed erosion and pollution control BMPs shall be maintained in a manner that preserves their effectiveness. If the City determines that the BMPs in place do not provide adequate erosion and pollution control at any time during the project, additional or alternate measures that provide effective control shall be required.
  - Concrete wash or rinse water from concrete mixing equipment, Tools and/or ready-mix trucks, etc. may not be discharged into or be allowed to run to any existing water body or portion of the storm water system. One or more locations for concrete washout will be designated on site, such that discharges during concrete washout will be contained in a small area where waste concrete can solidify in place. Proper signage will be installed to direct users to the concrete washout. Concrete washouts must be handled prior to pouring any concrete.
  - Silt fences and sediment control BMPs which are shown along the back of curb must be installed within two weeks of curb backfill and prior to placement of base asphalt. Exact locations of these erosion control methods may be field adjusted to minimize conflicts with utility construction. However, anticipated disturbance by utility construction shall not delay installation.
  - Required sediment basins and traps shall be installed as early as possible during mass grading. Sediment basins and traps shall be cleaned out when the sediment capacity has been reduced by 20% of its original design volume.
  - All manufactured BMPs such as erosion control blankets, TRMs, biodegradable logs, filter socks, synthetic sediment barriers and hydraulic erosion control shall be installed as directed by the manufacturer.
  - The above requirements are the responsibility of the permittee for the site. Responsibility may be transferred to another party by the permittee, but the permittee shall remain liable by the City of Lee's Summit if any of the above conditions are not met.

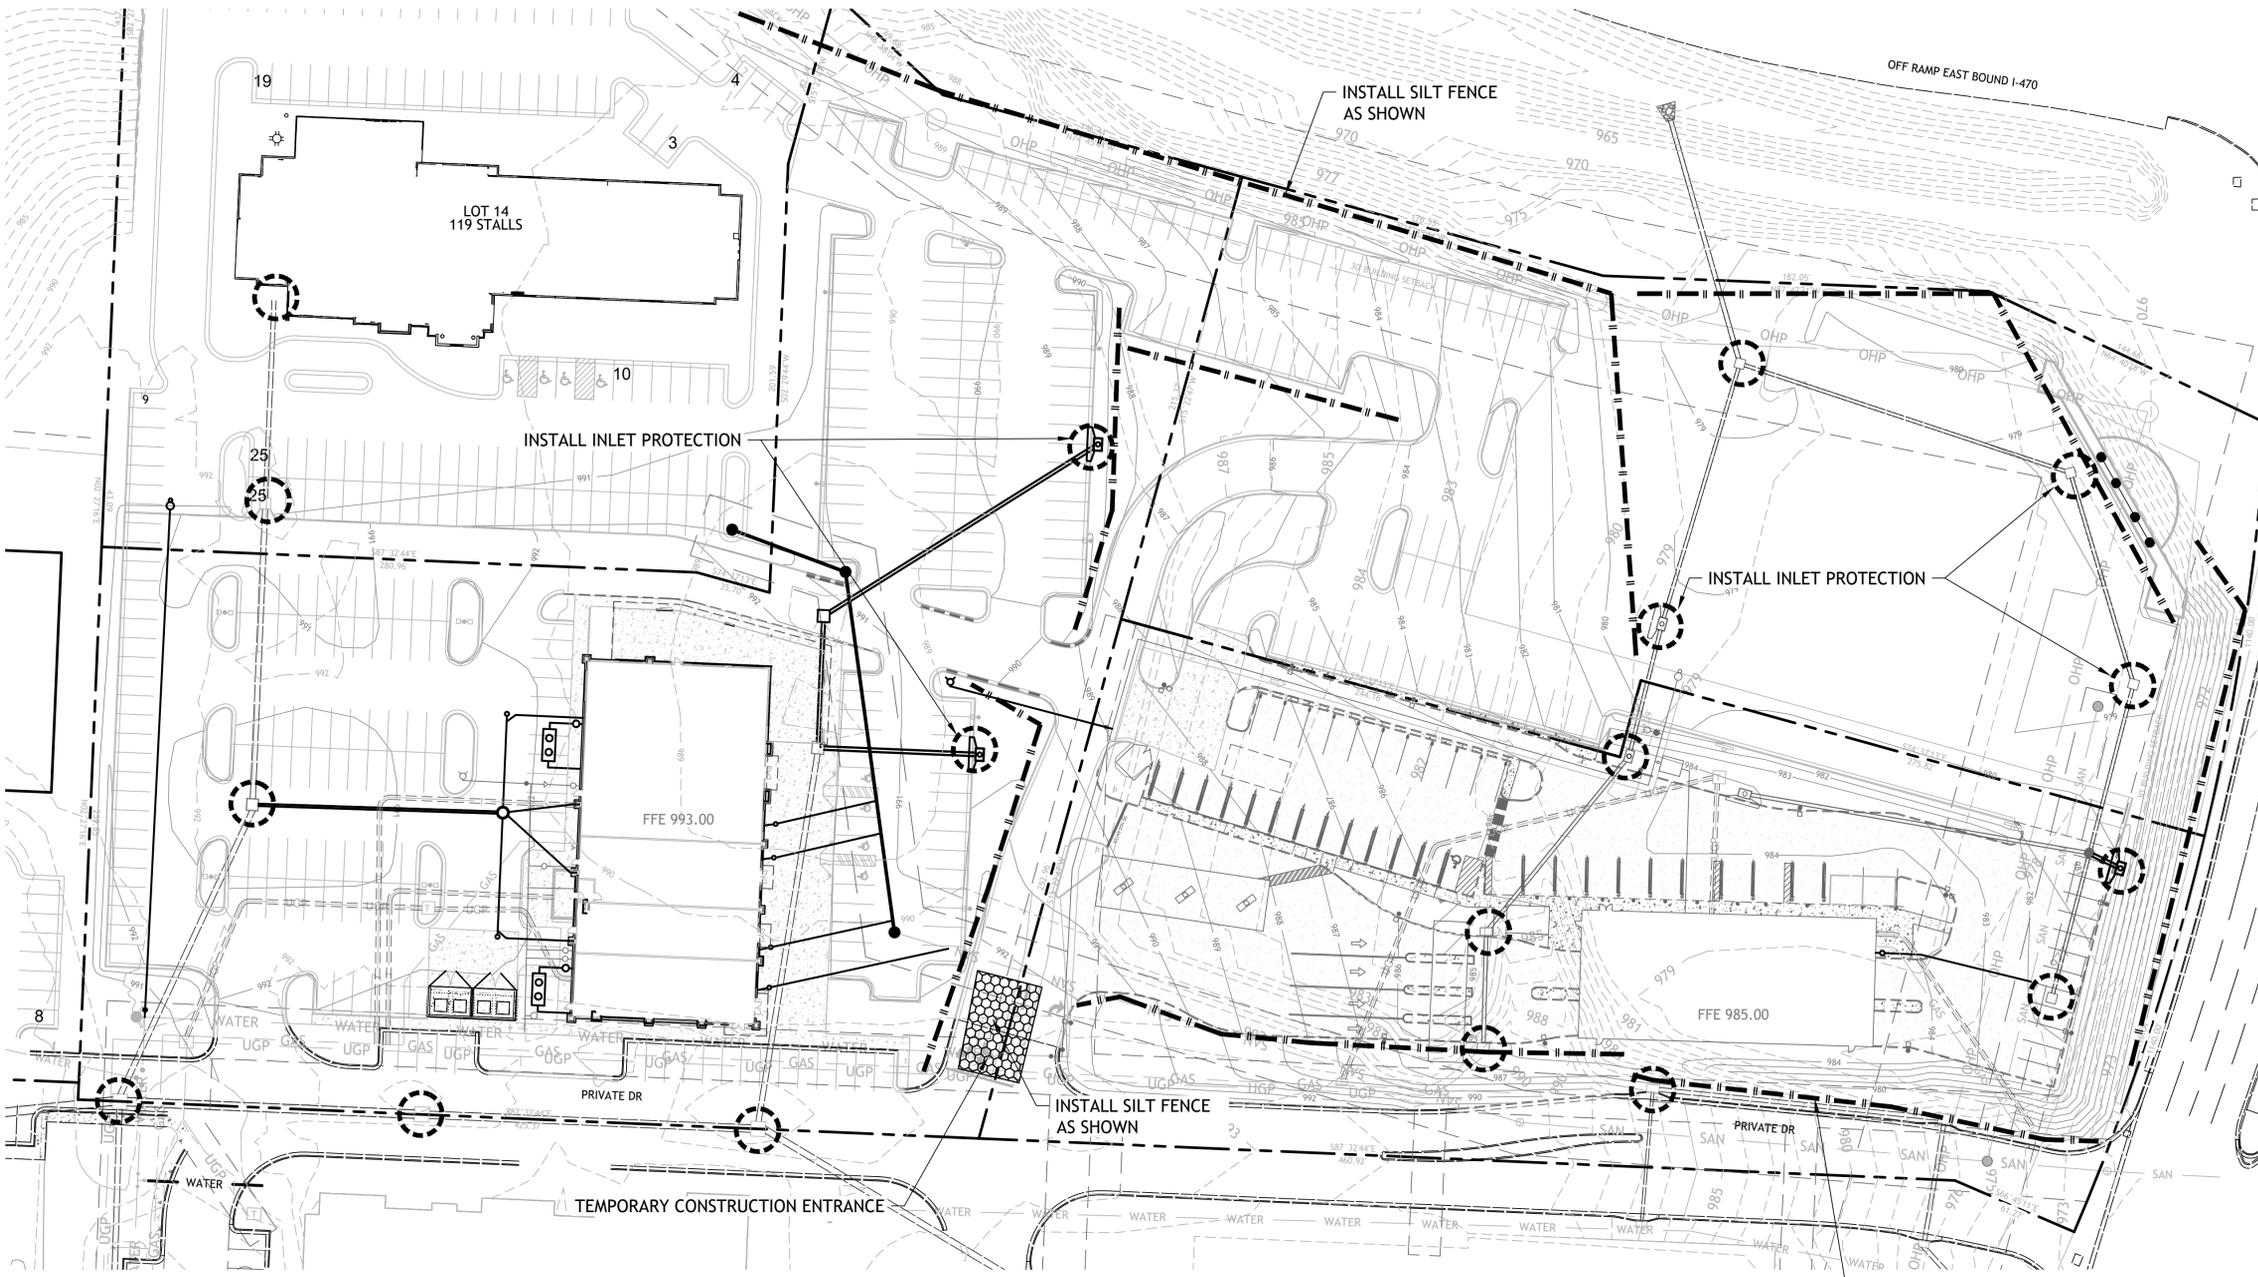

**LEGEND**

- SILT FENCE
- INLET PROTECTION
- TEMPORARY CONSTRUCTION ENTRANCE

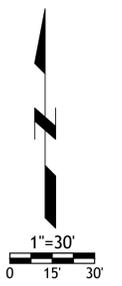


Drawings and/or Specifications are original proprietary work and property of the Engineer and intended specifically for this project. Use of items contained herein without consent of the Engineer is prohibited. Drawings illustrate best information available to the Engineer. Field verification of actual elements, conditions, and dimensions is required.




Revisions  
11-29-23 CITY COMMENTS


LOT 13A OF  
WEST PRYOR  
LEES SUMMIT, MISSOURI

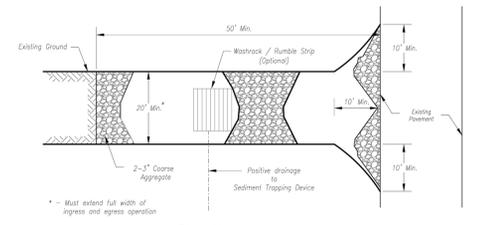

Plan View  
Not to Scale

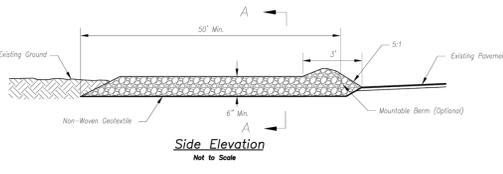

Side Elevation  
Not to Scale

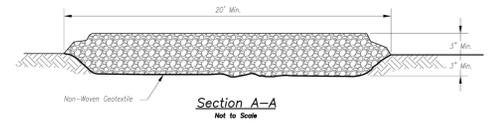


Section A-A  
Not to Scale

**Notes for Concrete Washout:**

1. Concrete washout areas shall be installed prior to any concrete placement on site.
2. Concrete washout areas shall include a flat substrate pit sized relative to the amount of concrete to be placed on site. The slopes leading out of the substrate pit shall be 5:1. The vehicle tracking pad shall be sloped towards the concrete washout area.
3. Vehicle tracking control is required at the access point to all concrete washout areas.
4. Signs shall be placed at the construction site entrance, washout area and elsewhere as necessary to clearly indicate the location(s) of the concrete washout area(s) to operators of concrete trucks and pump rigs.
5. A one-way impervious liner may be required along the bottom and sides of the substrate pit in sandy or gravelly soils.

**Maintenance for Concrete Washout:**


1. Concrete washout materials shall be removed once the materials have filled the washout to approximately 75% full.
2. Concrete washout areas shall be enlarged as necessary to maintain capacity for washed concrete.
3. Concrete washout water, washed pieces of concrete and all other debris in the substrate pit shall be transported from the job site in a water-tight container and disposed of properly.
4. Concrete washout areas shall remain in place until all concrete for the project is placed.
5. When concrete washout areas are removed, excavations shall be filled with suitable compacted backfill and basins, any disturbed areas associated with the installation, maintenance, and/or removal of the concrete washout areas shall be stabilized.

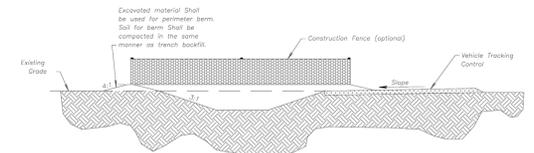

**CONCRETE WASHOUT**

<b>AMERICAN PUBLIC WORKS ASSOCIATION</b>	
<b>KANSAS CITY METRO CHAPTER</b>	
<b>CONSTRUCTION ENTRANCE AND CONCRETE WASHOUT</b>	<b>STANDARD DRAWING NUMBER ESC-01 ADOPTED: 10/24/2016</b>

Construction Entrance modified from 2015 Overland Park Standard Details for Erosion and Sediment Control; Concrete Washout modified from 2009 City of Great Bend Standard Drawings.

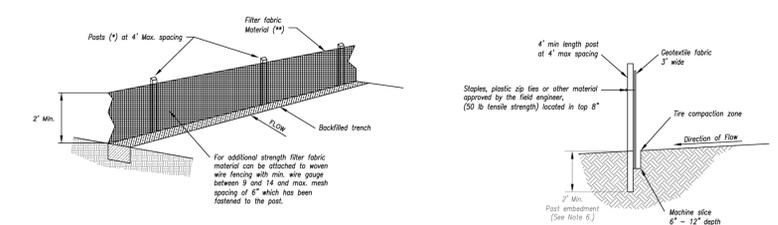

- (\*) EODIS  
- MIN. LENGTH 4'  
- HARDWOOD 1 1/2" x 1 R<sub>4</sub>"  
- NO.2 SOUTHERN PINE 2 1/2" x 2 1/2"  
- STEEL 1.33 LB/FT
- (\*\*) Geotextile Fabric shall meet the requirements of ASTM D 2888

**SILT FENCE DETAILS**  
Not to Scale

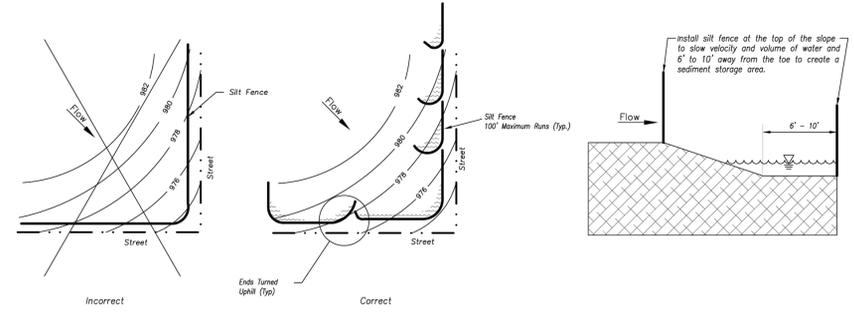


Figure A


**SILT FENCE LAYOUT**  
Not to Scale

**Notes:**

1. In order to contain water, the ends of the silt fence must be turned uphill (Figure A).
2. Long perimeter runs of silt fence must be limited to 100'. Runs should be broken up into several smaller segments to minimize water concentrations (Figure A).
3. Long slopes should be broken up with intermediate rows of silt fence to slow runoff velocities.
4. Attach fabric to upstream side of post.
5. Install posts a minimum of 2' into the ground.
6. Trenching will only be allowed for small or difficult installations, where sloping machine cannot be reasonably used.

**Maintenance:**



1. Remove and dispose of sediment deposits when the deposit approaches 1/2 the height of silt fence.
2. Repair as necessary to maintain function and structure.

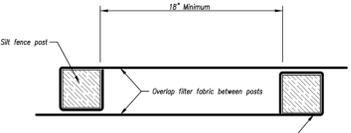


**JOINING FENCE SECTIONS**  
Not to Scale

<b>AMERICAN PUBLIC WORKS ASSOCIATION</b>	
<b>KANSAS CITY METRO CHAPTER</b>	
<b>SILT FENCE</b>	<b>STANDARD DRAWING NUMBER ESC-03 ADOPTED: 10/24/2016</b>


Modified from 2015 Overland Park Standard Details for Erosion and Sediment Control.

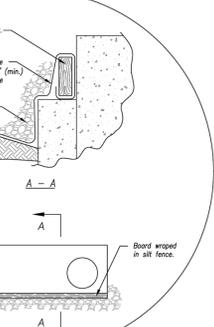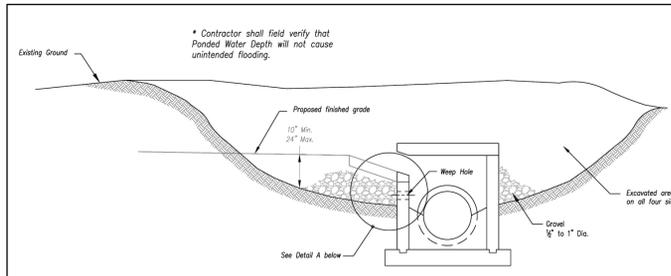

**EARLY STAGE CURB INLET**  
(Open Box and Prior to Pouring Curb and Inlet Throat)

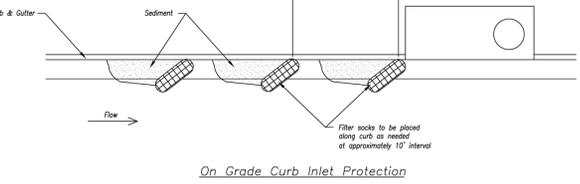

**On Grade Curb Inlet Protection**

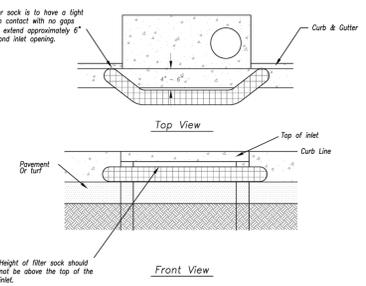

**Sump Inlet Sediment Filter**

**Notes:**

1. Immediately following inlet construction and prior to construction of curb and inlet throat, protect inlet opening by installing 2" x 10" (min.) board wrapped in silt fence. Structures shall have excavated storage area on all four sides to allow setting of sediment (Early Stage Curb Inlet).
2. When inlet is completed and curb poured, filter socks or approved equal should be used (Late Stage Curb Inlet). Straw wattles are not approved for curb inlet use.
3. Contractor to field verify ponding water shall not create a traffic hazard.

**Maintenance:**


1. Remove deposited sediment from excavated storage areas when available storage has been reduced by 50%.
2. Remove deposited sediment from filter socks or similar when any accumulation of sediment is visible.
3. Repair or replace as necessary to maintain function and integrity of installation.

**LATE STAGE CURB INLET**  
(After Pouring Curb and Inlet Throat)

<b>AMERICAN PUBLIC WORKS ASSOCIATION</b>	
<b>KANSAS CITY METRO CHAPTER</b>	
<b>CURB INLET PROTECTION</b>	<b>STANDARD DRAWING NUMBER ESC-06 ADOPTED: 10/24/2016</b>

Modified from 2015 Overland Park Standard Details for Erosion and Sediment Control.

Drawings and/or Specifications are original proprietary work and property of the Engineer and intended specifically for this project. Use of items contained herein without consent of the Engineer is prohibited. Drawings illustrate best information available to the Engineer. Field verification of actual elements, conditions, and dimensions is required.


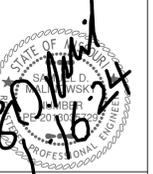


Revisions  
11-29-23 CITY COMMENTS  
1-4-24 PER CLIENT  
1-16-24 PER EVERGY




LOT 13A OF  
WEST PRYOR  
LEES SUMMIT, MISSOURI

100 Year Storm Calculations


Line No.	Line ID	Area ID	Drain Area (ac)	Runoff Coeff (C)	Inlet Time (min)	Incr Q (cfs)	Known Q (cfs)	Flow Rate (cfs)	Line Length (ft)	Line Size (in)	Vel Ave (ft/s)	Capac. Full (cfs)	Invert Dn (ft)	Invert Up (ft)	Line Slope (%)	Grnd/Rim Elev Up (ft)	HGL Dn (ft)	HGL Up (ft)	HGL Junct (ft)
1	B2-F1	F1	0.800	0.75	5.0	7.74	0.00	32.45	150.00	30	6.61	31.77	980.20	981.10	0.60	990.50	982.70	983.59	983.72
2	F1-K2	K2	0.750	0.75	5.0	7.25	0.00	21.51	140.00	30	4.38	31.00	981.30	982.10	0.57	990.50	984.30	984.69	984.75
3	K2-K3	K3	1.600	0.70	5.0	14.44	0.00	14.44	98.00	24	4.69	20.44	982.60	983.40	0.82	990.00	984.89	985.24	985.31
4	F1-F2	F2	0.320	0.90	5.0	3.71	0.00	3.71	118.00	12	5.57	4.02	987.00	988.50	1.27	991.80	987.77	989.32	989.32
5	B4-C1		0.000	0.00	0.0	0.00	0.00	10.06	178.00	30	3.56	41.24	982.20	984.00	1.01	992.50	984.70	985.06	985.06
6	C1-E1		0.000	0.00	0.0	0.00	0.00	6.49	62.00	18	4.66	7.28	984.20	984.50	0.48	991.50	985.30	985.60	985.73
7	E1-E2	E2	0.640	0.80	5.0	6.60	0.00	6.60	152.00	18	5.45	8.91	985.00	986.09	0.72	989.00	985.96	987.08	987.08
8	C1-C2	C2	0.360	0.80	5.0	3.71	0.00	3.71	76.00	18	5.38	15.24	984.50	986.10	2.11	989.80	985.04	986.84	986.84

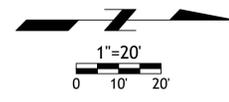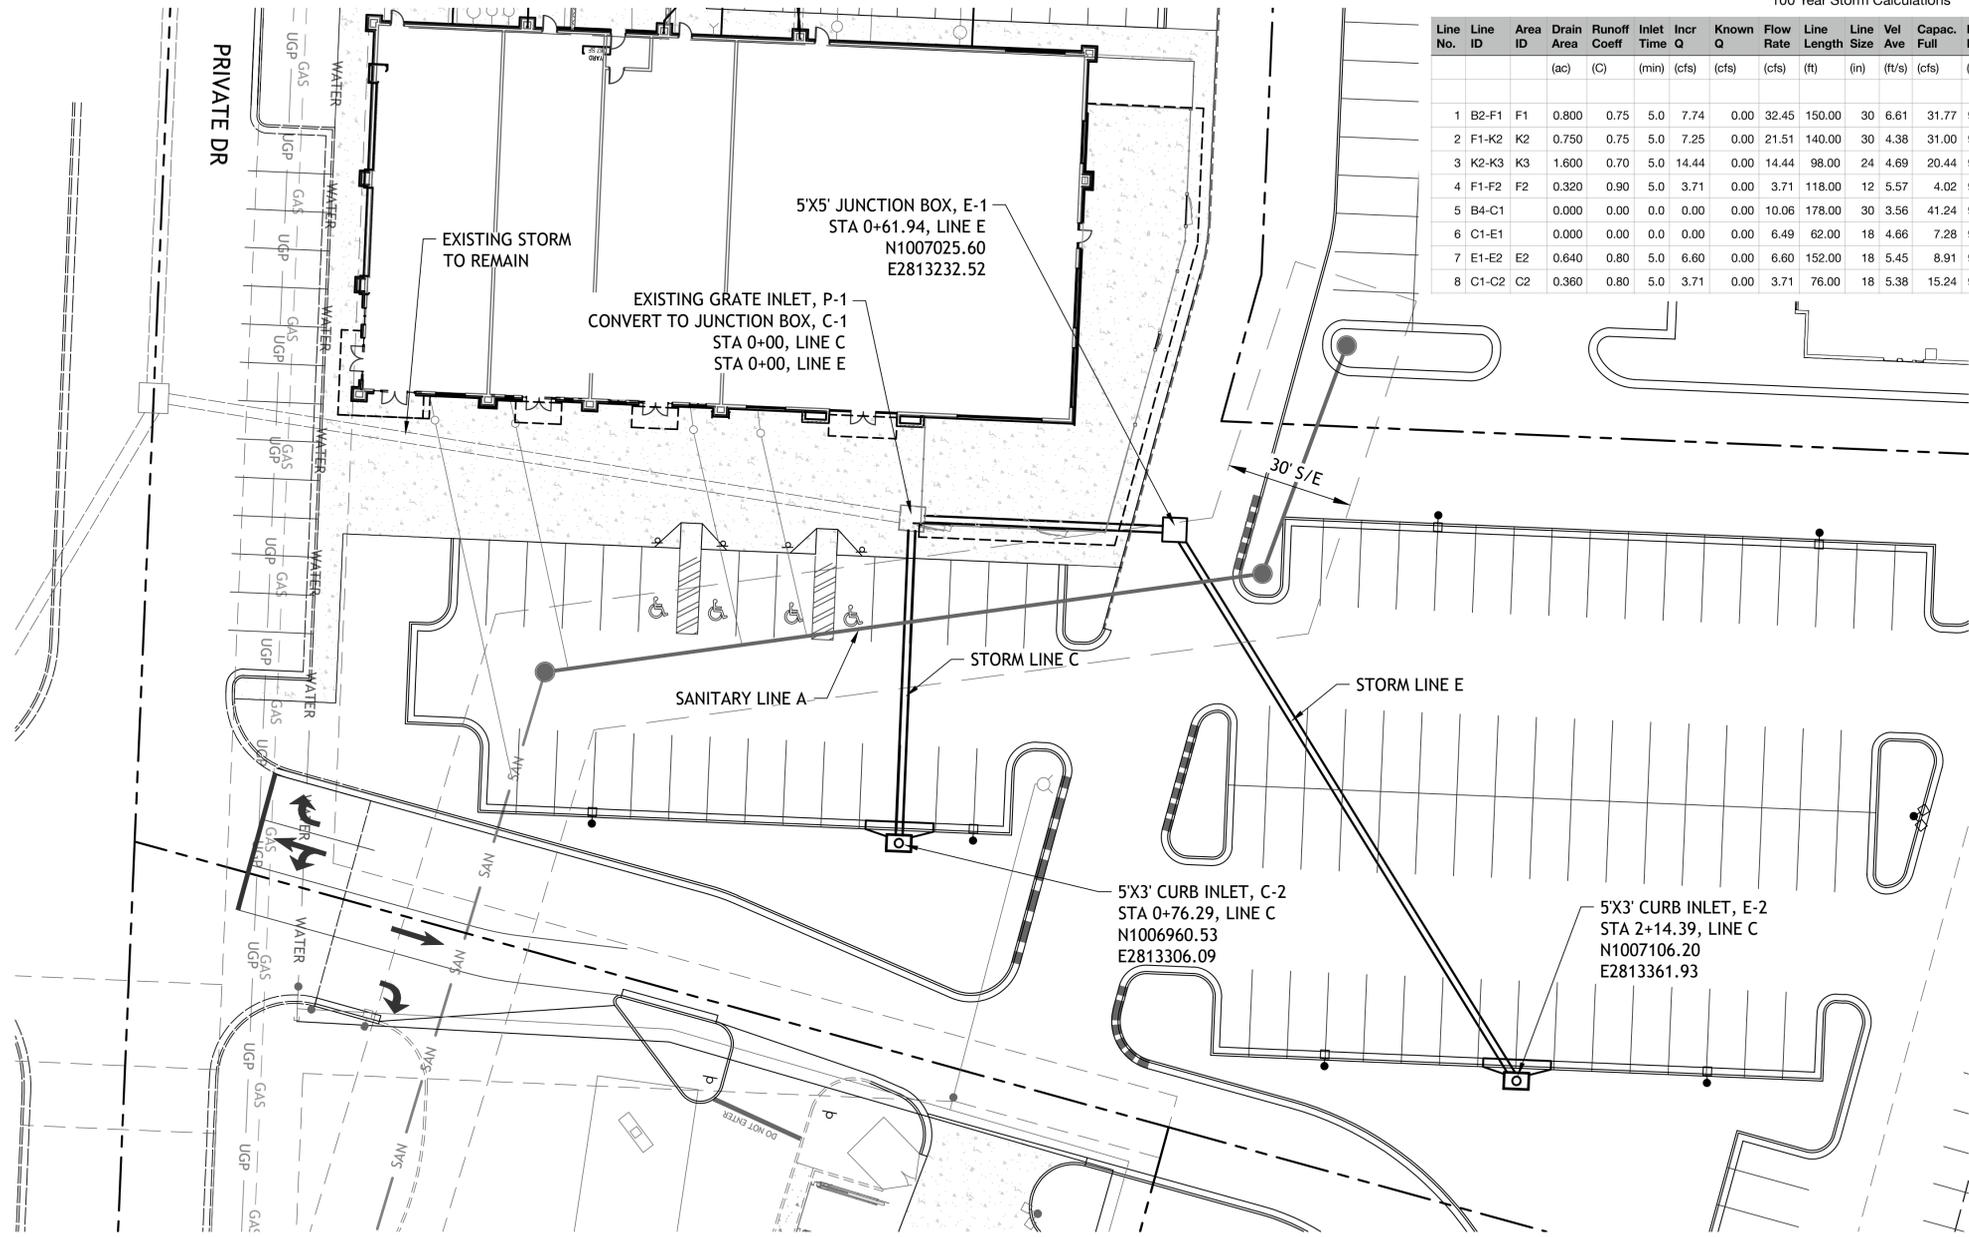


NOTE  
COMPACTED FILL SHALL BE PLACED TO A MINIMUM OF 18"  
ABOVE THE TOP OF THE PIPE PRIOR TO INSTALLATION.

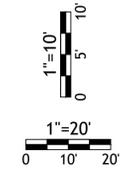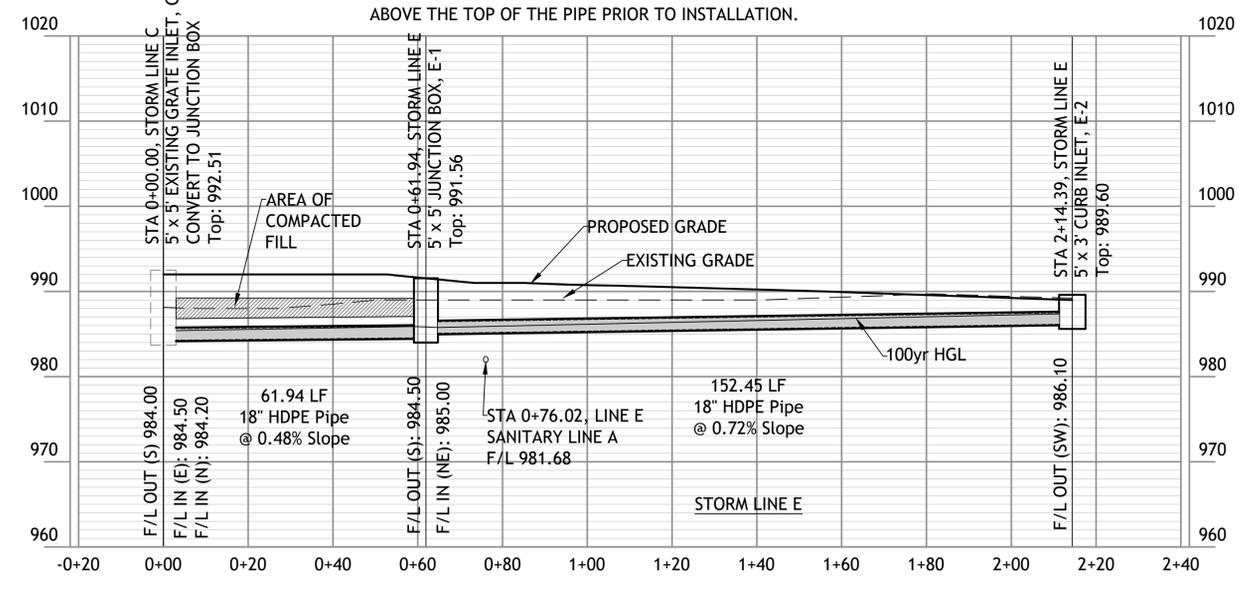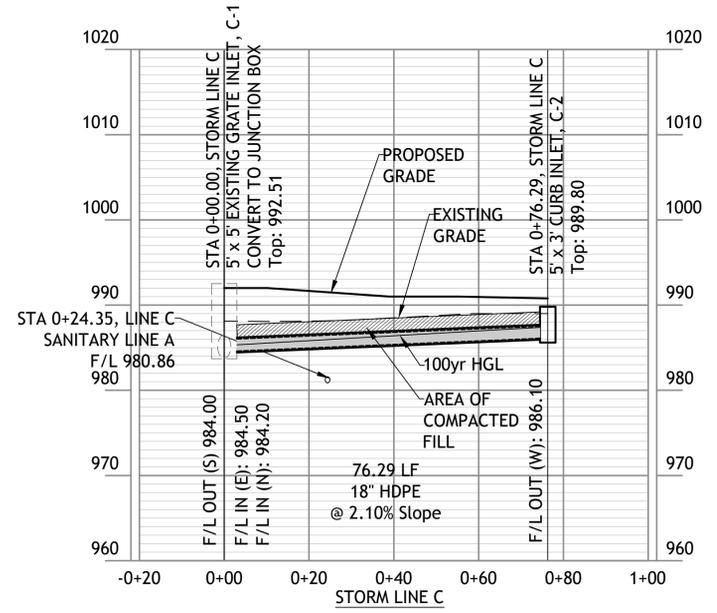


Drawings and/or Specifications are original proprietary work and property of the Engineer and intended specifically for this project. Use of items contained herein without consent of the Engineer is prohibited. Drawings illustrate best information available to the Engineer. Field verification of actual elements, conditions, and dimensions is required.

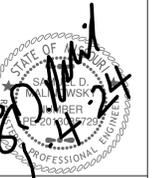

Revisions  
 11-29-23 CITY COMMENTS  
 1-4-24 PER CLIENT

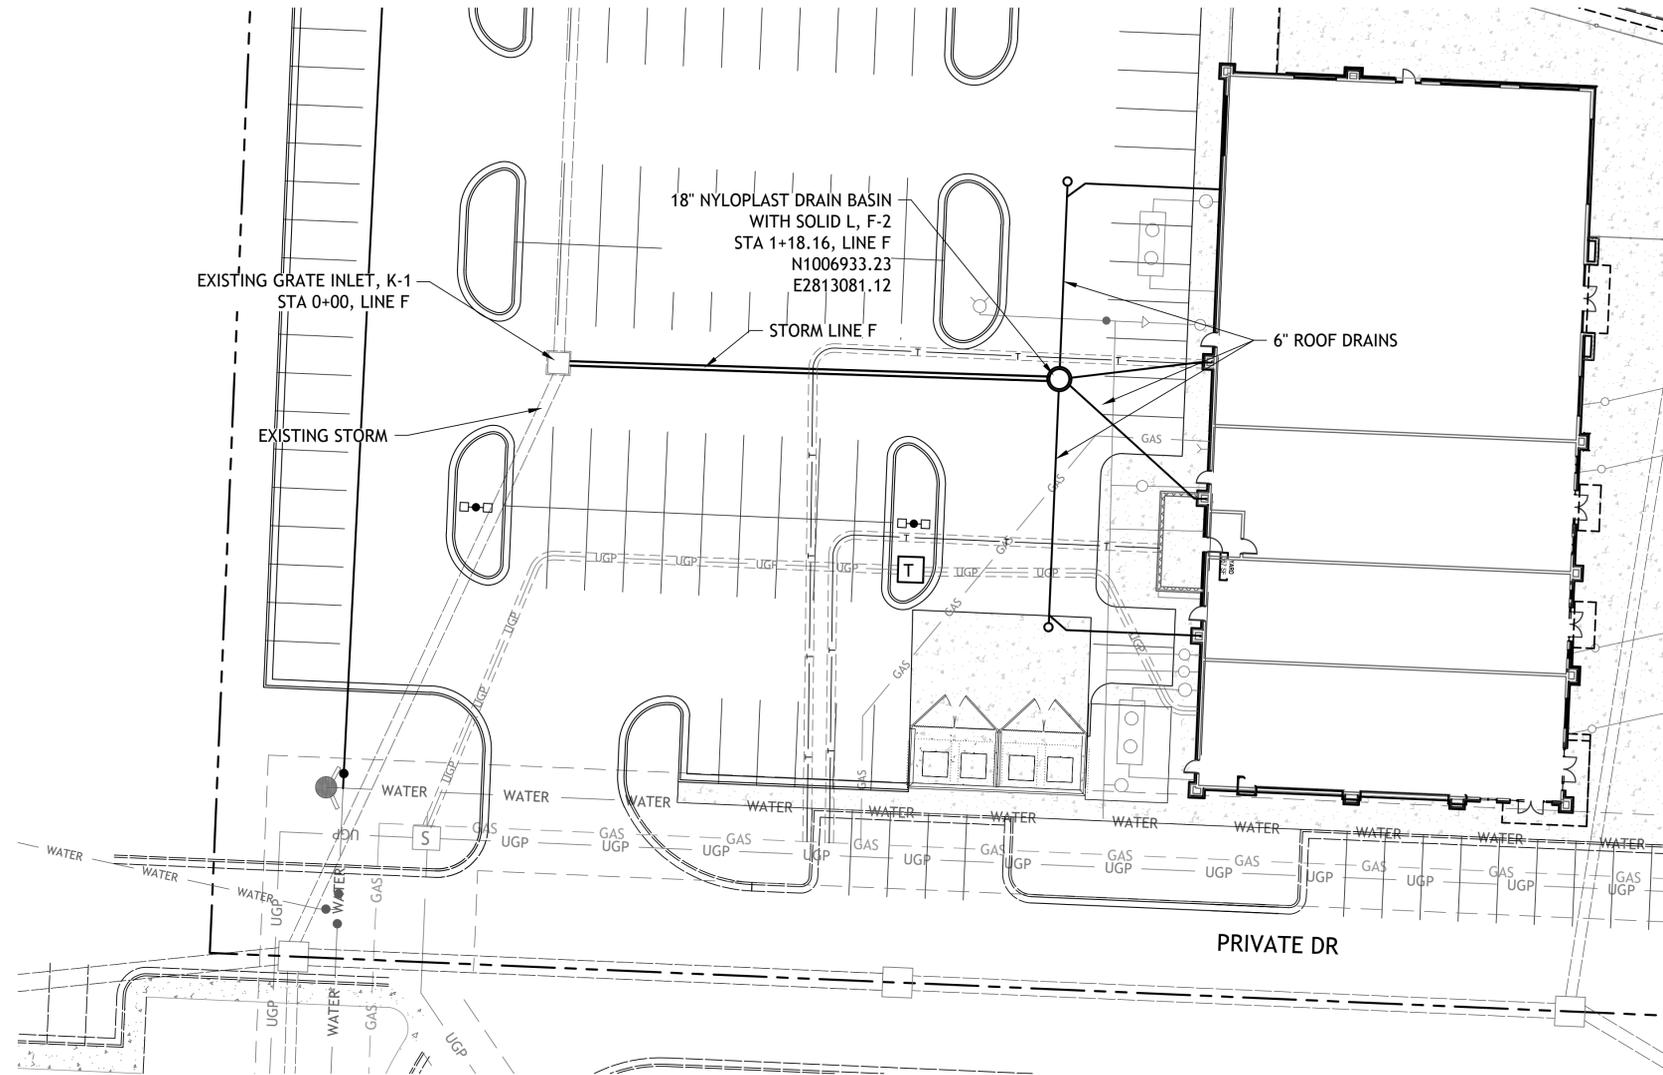


NOTE  
 COMPACTED FILL SHALL BE PLACED TO A MINIMUM OF 18"  
 ABOVE THE TOP OF THE PIPE PRIOR TO INSTALLATION.

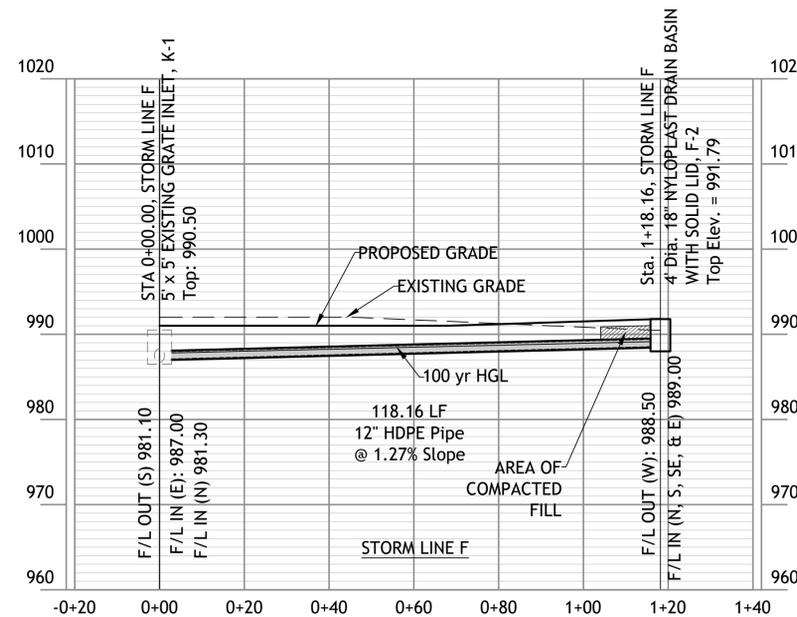


100 Year Storm Calculations

Line No.	Line ID	Area ID	Drain Area (ac)	Runoff Coeff (C)	Inlet Time (min)	Incr Q (cfs)	Known Q (cfs)	Flow Rate (cfs)	Line Length (ft)	Line Size (in)	Vel Ave (ft/s)	Capac. Full (cfs)	Invert Dn (ft)	Invert Up (ft)	Line Slope (%)	Grnd/Rim Elev Up (ft)	HGL Dn (ft)	HGL Up (ft)	HGL Junct (ft)
1	B2-F1	F1	0.800	0.75	5.0	7.74	0.00	32.45	150.00	30	6.61	31.77	980.20	981.10	0.60	990.50	982.70	983.59	983.72
2	F1-K2	K2	0.750	0.75	5.0	7.25	0.00	21.51	140.00	30	4.38	31.00	981.30	982.10	0.57	990.50	984.30	984.69	984.75
3	K2-K3	K3	1.600	0.70	5.0	14.44	0.00	14.44	98.00	24	4.69	20.44	982.60	983.40	0.82	990.00	984.89	985.24	985.31
4	F1-F2	F2	0.320	0.90	5.0	3.71	0.00	3.71	118.00	12	5.57	4.02	987.00	988.50	1.27	991.80	987.77	989.32	989.32
5	B4-C1		0.000	0.00	0.0	0.00	0.00	10.06	178.00	30	3.56	41.24	982.20	984.00	1.01	992.50	984.70	985.06	985.06
6	C1-E1		0.000	0.00	0.0	0.00	0.00	6.49	62.00	18	4.66	7.28	984.20	984.50	0.48	991.50	985.30	985.60	985.73
7	E1-E2	E2	0.640	0.80	5.0	6.60	0.00	6.60	152.00	18	5.45	8.91	985.00	986.09	0.72	989.00	985.96	987.08	987.08
8	C1-C2	C2	0.360	0.80	5.0	3.71	0.00	3.71	76.00	18	5.38	15.24	984.50	986.10	2.11	989.80	985.04	986.84	986.84


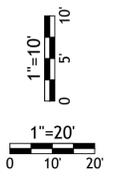


**LOT 13A OF WEST PRYOR**  
 LEES SUMMIT, MISSOURI


Drawings and/or Specifications are original proprietary work and property of the Engineer and intended specifically for this project. Use of items contained herein without consent of the Engineer is prohibited. Drawings illustrate best information available to the Engineer. Field verification of actual elements, conditions, and dimensions is required.

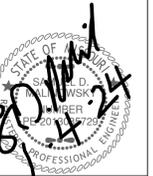

Revisions  
11-29-23 CITY COMMENTS  
1-4-24 PER CLIENT

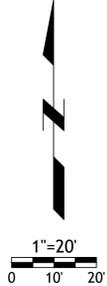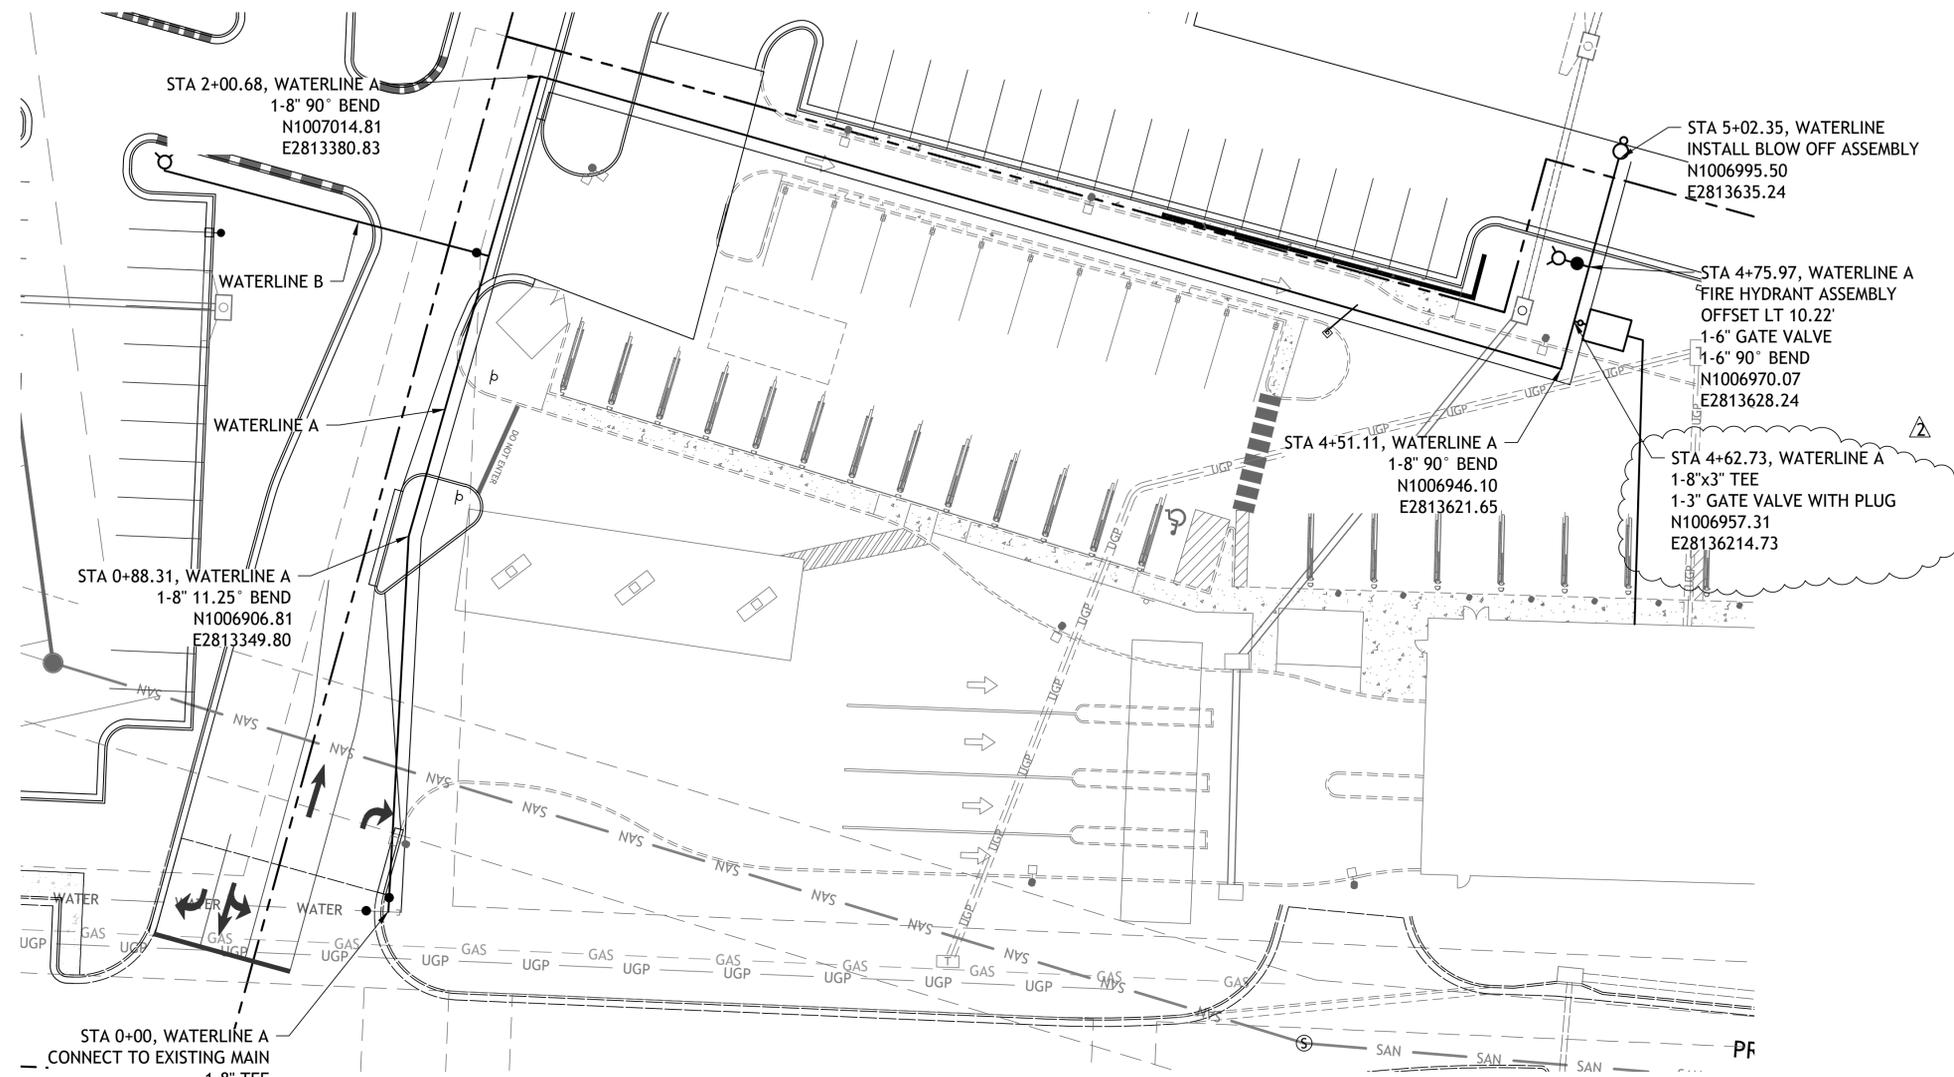

NOTE  
COMPACTED FILL SHALL BE PLACED TO A MINIMUM OF 18"  
ABOVE THE TOP OF THE PIPE PRIOR TO INSTALLATION.

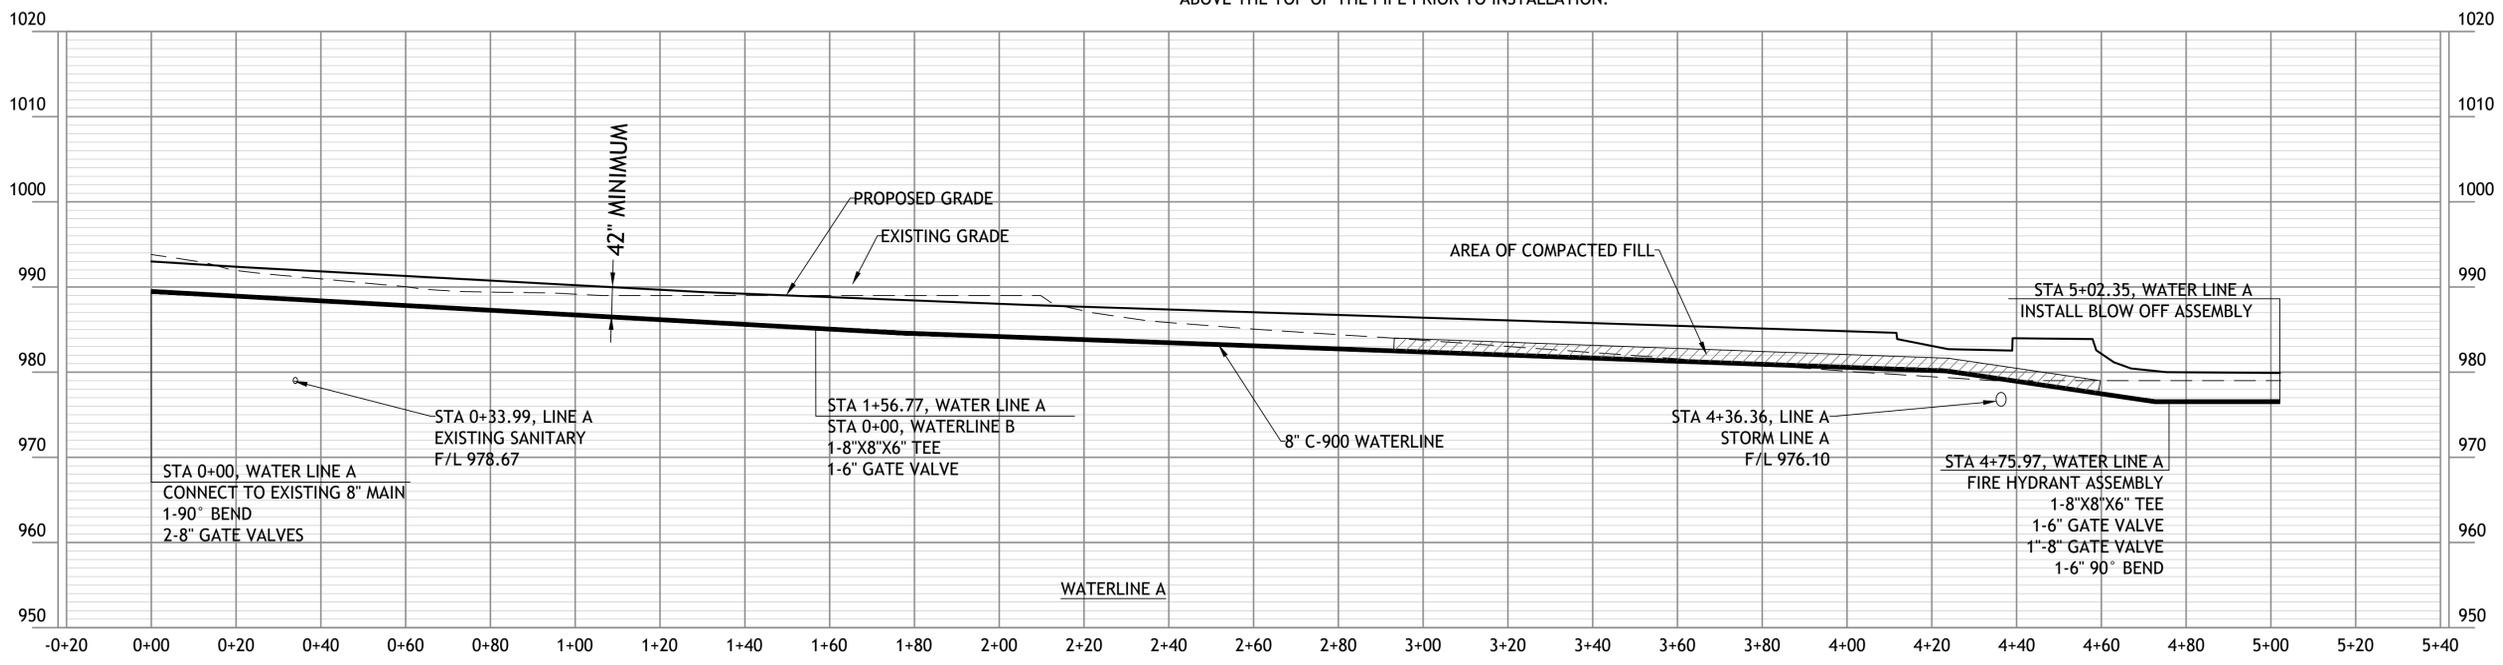


LOT 13A OF  
WEST PRYOR  
LEES SUMMIT, MISSOURI




Drawings and/or Specifications are original proprietary work and property of the Engineer and intended specifically for this project. Use of items contained herein without consent of the Engineer is prohibited. Drawings illustrate best information available to the Engineer. Field verification of actual elements, conditions, and dimensions is required.



Revisions  
11-29-23 CITY COMMENTS

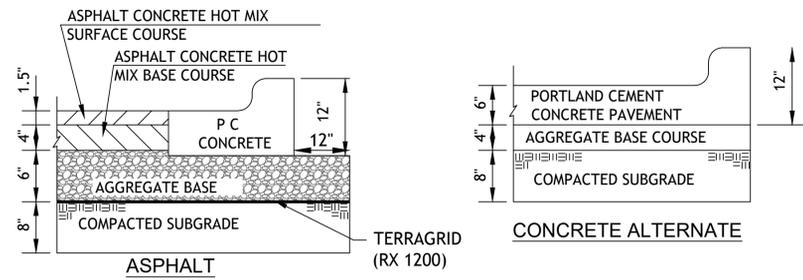

**REGULAR DUTY PAVING PV1**


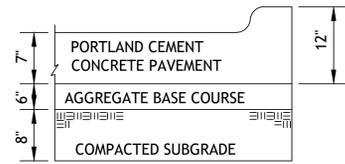


**HEAVY DUTY CONCRETE PV3**


1. FLEXIBLE PAVEMENT SHALL BE IN ACCORDANCE WITH THE LATEST EDITION OF THE MISSOURI DEPARTMENT OF TRANSPORTATION STANDARD SPECIFICATIONS.

ASPHALT SURFACE COURSE - APWA TYPE 3-01  
ASPHALT BASE COURSE - APWA TYPE 2-01  
AGGREGATE BASE MODOT TYPE 5 OR EQUIVALENT

2. PORTLAND CEMENT CONCRETE SHALL HAVE A MINIMUM COMPRESSIVE STRENGTH OF 4000 PSI AT 28 DAYS WITH 6% ENTRAINED AIR ±2% AND SHALL MEET OR EXCEED THE SPECIFICATIONS SET FORTH IN THE LATEST EDITION OF THE MISSOURI DEPARTMENT OF TRANSPORTATION STANDARD SPECIFICATIONS.

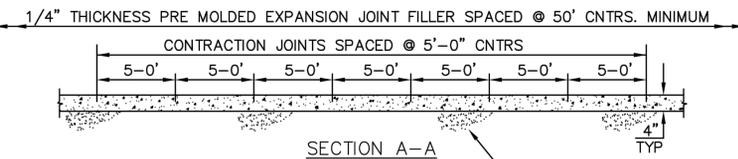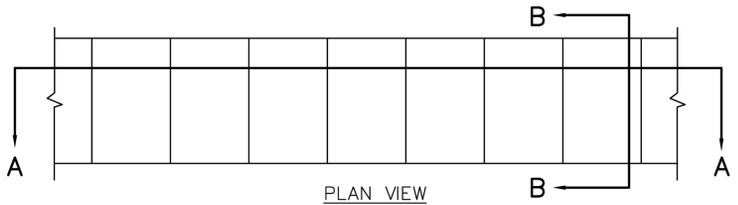

NOTE: WHERE SIDEWALKS ARE INTEGRAL WITH DRIVE ENTRANCES INCREASE DEPTH TO 6" AND PROVIDE REINFORCING USING 6x6 #10 WIRE MINIMUM.

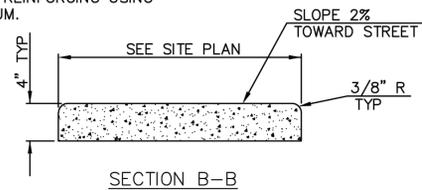


**CONCRETE SIDEWALK CW2**


NOTE: CONCRETE SHALL BE CLASS A WITH  $f_c = 3000$  PSI.

**BEDDING**  
1/2" - 3/4" CLEAN AGGREGATE, HAND TAMPED OR MECHANICALLY COMPACTED IN MAX. 4" LIFTS  
**INITIAL BACKFILL**  
- UNDER PAVED AREAS OR WITHIN 4" HORIZONTAL OF PAVED AREAS  
1/2" - 3/4" CLEAN AGGREGATE, HAND TAMPED OR MECHANICALLY COMPACTED IN MAX. 4" LIFTS  
- UNDER OPEN AREAS  
1/2" - 3/4" CLEAN AGGREGATE, HAND TAMPED OR MECHANICALLY COMPACTED IN MAX. 4" LIFTS  
**FINAL BACKFILL**  
- UNDER PAVED AREAS OR WITHIN 4" HORIZONTAL OF PAVED AREAS  
ON-SITE OR IMPORTED MATERIAL FREE OF MUCK, FROZEN MATERIAL, EXCESS MOISTURE, ORGANICS, TOPSOIL, RUBBISH, CONSTRUCTION DEBRIS, ROCK OR BRICK LARGER THAN 8", COMPACTED TO 95% OF STANDARD DENSITY PER ASTM D-698  
- UNDER OPEN AREAS  
ON-SITE OR IMPORTED MATERIAL FREE OF MUCK, FROZEN MATERIAL, EXCESS MOISTURE, ORGANICS, TOPSOIL, RUBBISH, CONSTRUCTION DEBRIS, ROCK OR BRICK LARGER THAN 8", COMPACTED TO 90% OF STANDARD DENSITY PER ASTM D-698

BEDDING DEPTH BELOW PIPE		
PIPE DIAMETER	IN SOIL	IN ROCK
24" AND LESS	6"	6"
27" THRU 60"	6"	9"

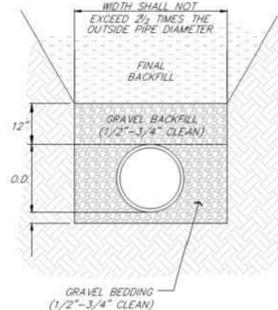


PIPE BEDDING DETAIL  
NOT TO SCALE

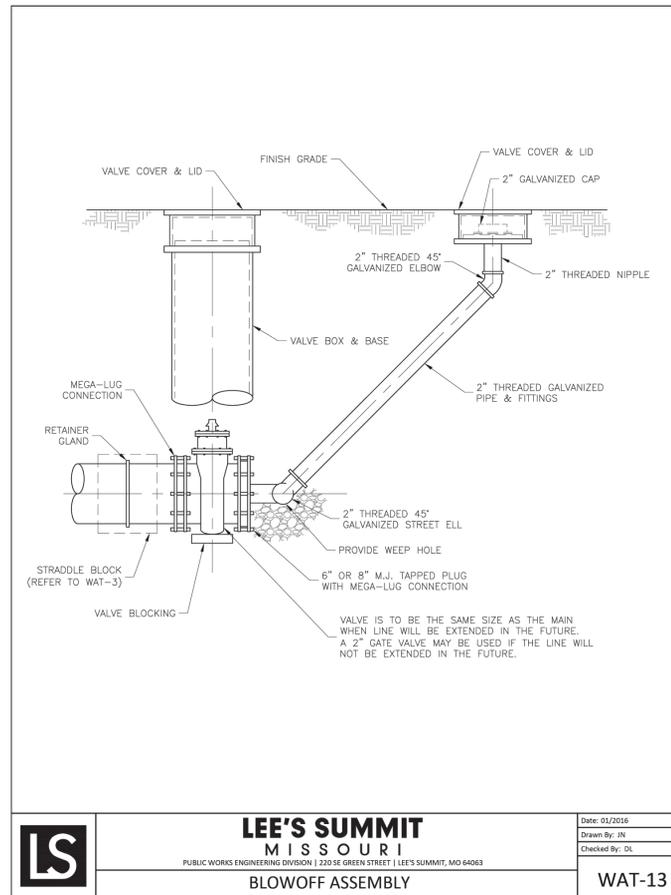

**LEE'S SUMMIT MISSOURI**  
PUBLIC WORKS ENGINEERING DIVISION | 220 SE GREEN STREET | LEE'S SUMMIT, MO 64063  
**BLOWOFF ASSEMBLY**


Date: 02/2016  
Drawn By: JN  
Checked By: DL  
**WAT-13**

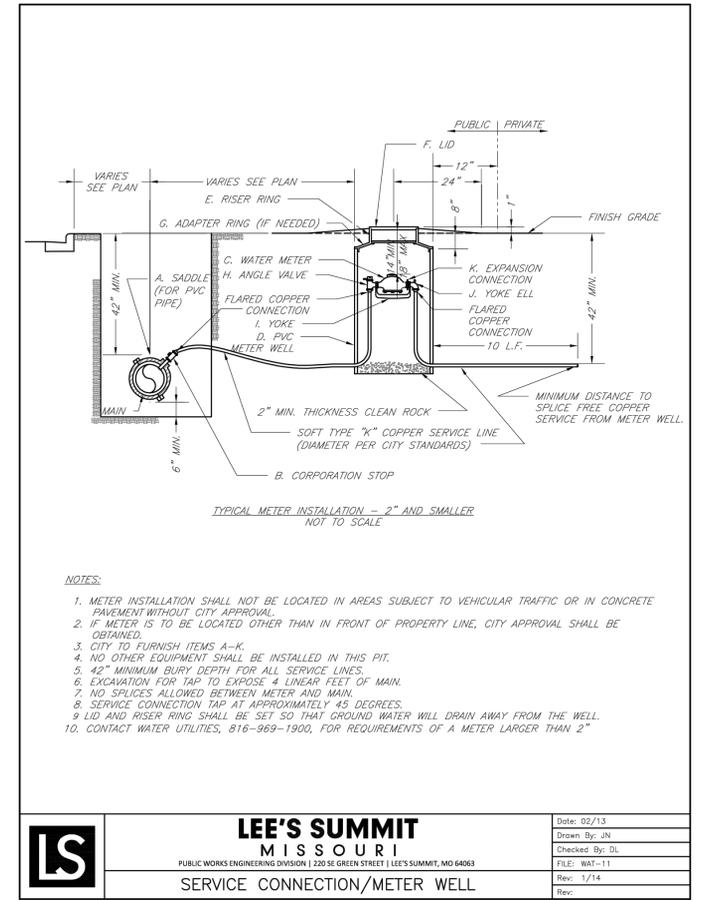

- NOTES:**
- METER INSTALLATION SHALL NOT BE LOCATED IN AREAS SUBJECT TO VEHICULAR TRAFFIC OR IN CONCRETE PAVEMENT WITHOUT CITY APPROVAL.
  - IF METER IS TO BE LOCATED OTHER THAN IN FRONT OF PROPERTY LINE, CITY APPROVAL SHALL BE OBTAINED.
  - CITY TO FURNISH ITEMS A-K.
  - NO OTHER EQUIPMENT SHALL BE INSTALLED IN THIS PIT.
  - 42" MINIMUM BURY DEPTH FOR ALL SERVICE LINES.
  - EXCAVATION FOR TAP TO EXPOSE 4 LINEAR FEET OF MAIN.
  - NO SPLICES ALLOWED BETWEEN METER AND MAIN.
  - SERVICE CONNECTION TAP AT APPROXIMATELY 45 DEGREES.
  - LID AND RISER RING SHALL BE SET SO THAT GROUND WATER WILL DRAIN AWAY FROM THE WELL.
  - CONTACT WATER UTILITIES, 816-969-1900, FOR REQUIREMENTS OF A METER LARGER THAN 2"

**LEE'S SUMMIT MISSOURI**  
PUBLIC WORKS ENGINEERING DIVISION | 220 SE GREEN STREET | LEE'S SUMMIT, MO 64063  
**SERVICE CONNECTION/METER WELL**


Date: 02/13  
Drawn By: JN  
Checked By: DL  
FILE: WAT-11  
Rev: 1/14  
Rev:

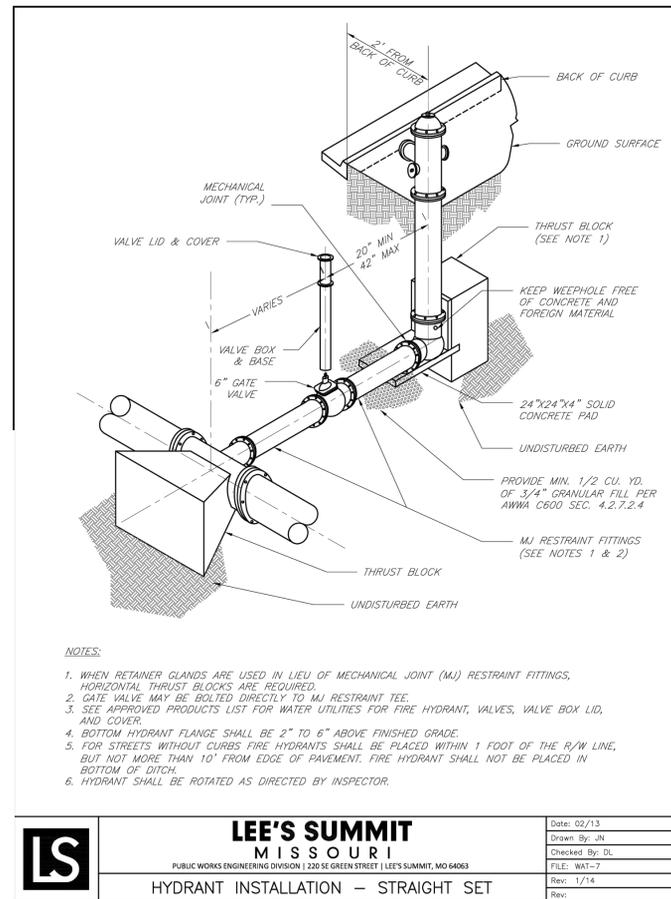

- NOTES:**
- WHEN RETAINER GLANDS ARE USED IN LIEU OF MECHANICAL JOINT (MJ) RESTRAINT FITTINGS, HORIZONTAL THRUST BLOCKS ARE REQUIRED.
  - GATE VALVE MAY BE BOLTED DIRECTLY TO MJ RESTRAINT TEE.
  - SEE APPROVED PRODUCTS LIST FOR WATER UTILITIES FOR FIRE HYDRANT, VALVES, VALVE BOX LID, AND COVER.
  - BOTTOM HYDRANT FLANGE SHALL BE 2" TO 6" ABOVE FINISHED GRADE.
  - FOR STREETS WITHOUT CURBS FIRE HYDRANTS SHALL BE PLACED WITHIN 1 FOOT OF THE R/W LINE, BUT NOT MORE THAN 10' FROM EDGE OF PAVEMENT. FIRE HYDRANT SHALL NOT BE PLACED IN BOTTOM OF DITCH.
  - HYDRANT SHALL BE ROTATED AS DIRECTED BY INSPECTOR.

**LEE'S SUMMIT MISSOURI**  
PUBLIC WORKS ENGINEERING DIVISION | 220 SE GREEN STREET | LEE'S SUMMIT, MO 64063  
**HYDRANT INSTALLATION - STRAIGHT SET**

Date: 02/13  
Drawn By: JN  
Checked By: DL  
FILE: WAT-7  
Rev: 1/14  
Rev:

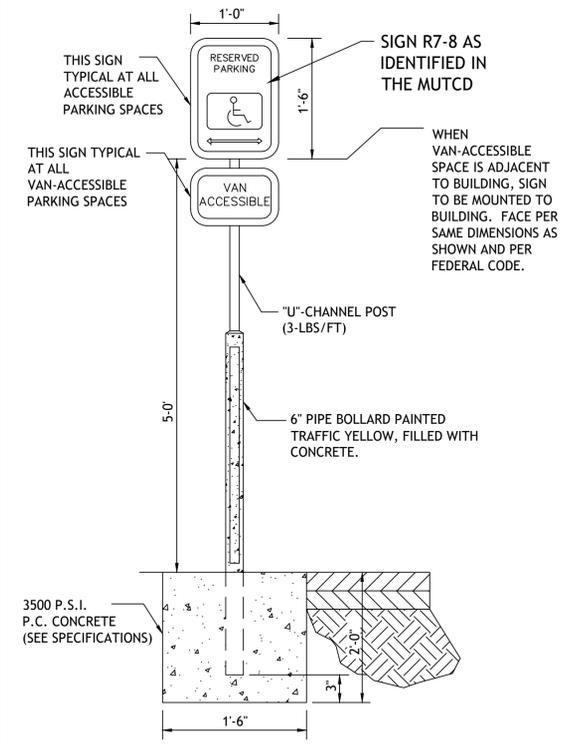



**ACCESSIBLE PARKING SIGN PK2**

LOT 13A OF WEST PRYOR

Drawings and/or Specifications are original proprietary work and property of the Engineer and intended specifically for this project. Use of items contained herein without consent of the Engineer is prohibited. Drawings illustrate best information available to the Engineer. Field verification of actual elements, conditions, and dimensions is required.





Revisions  
11-29-23 CITY COMMENTS

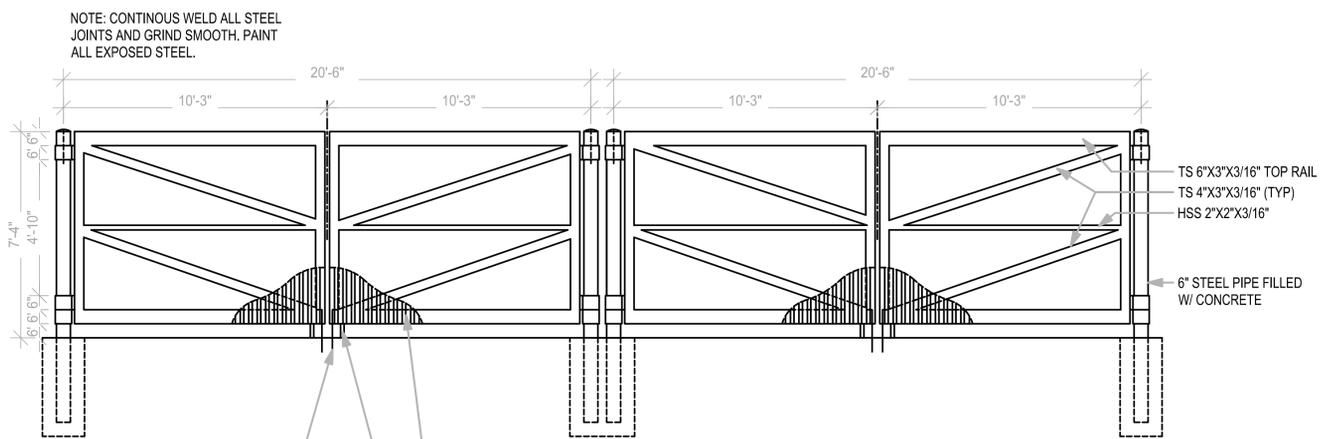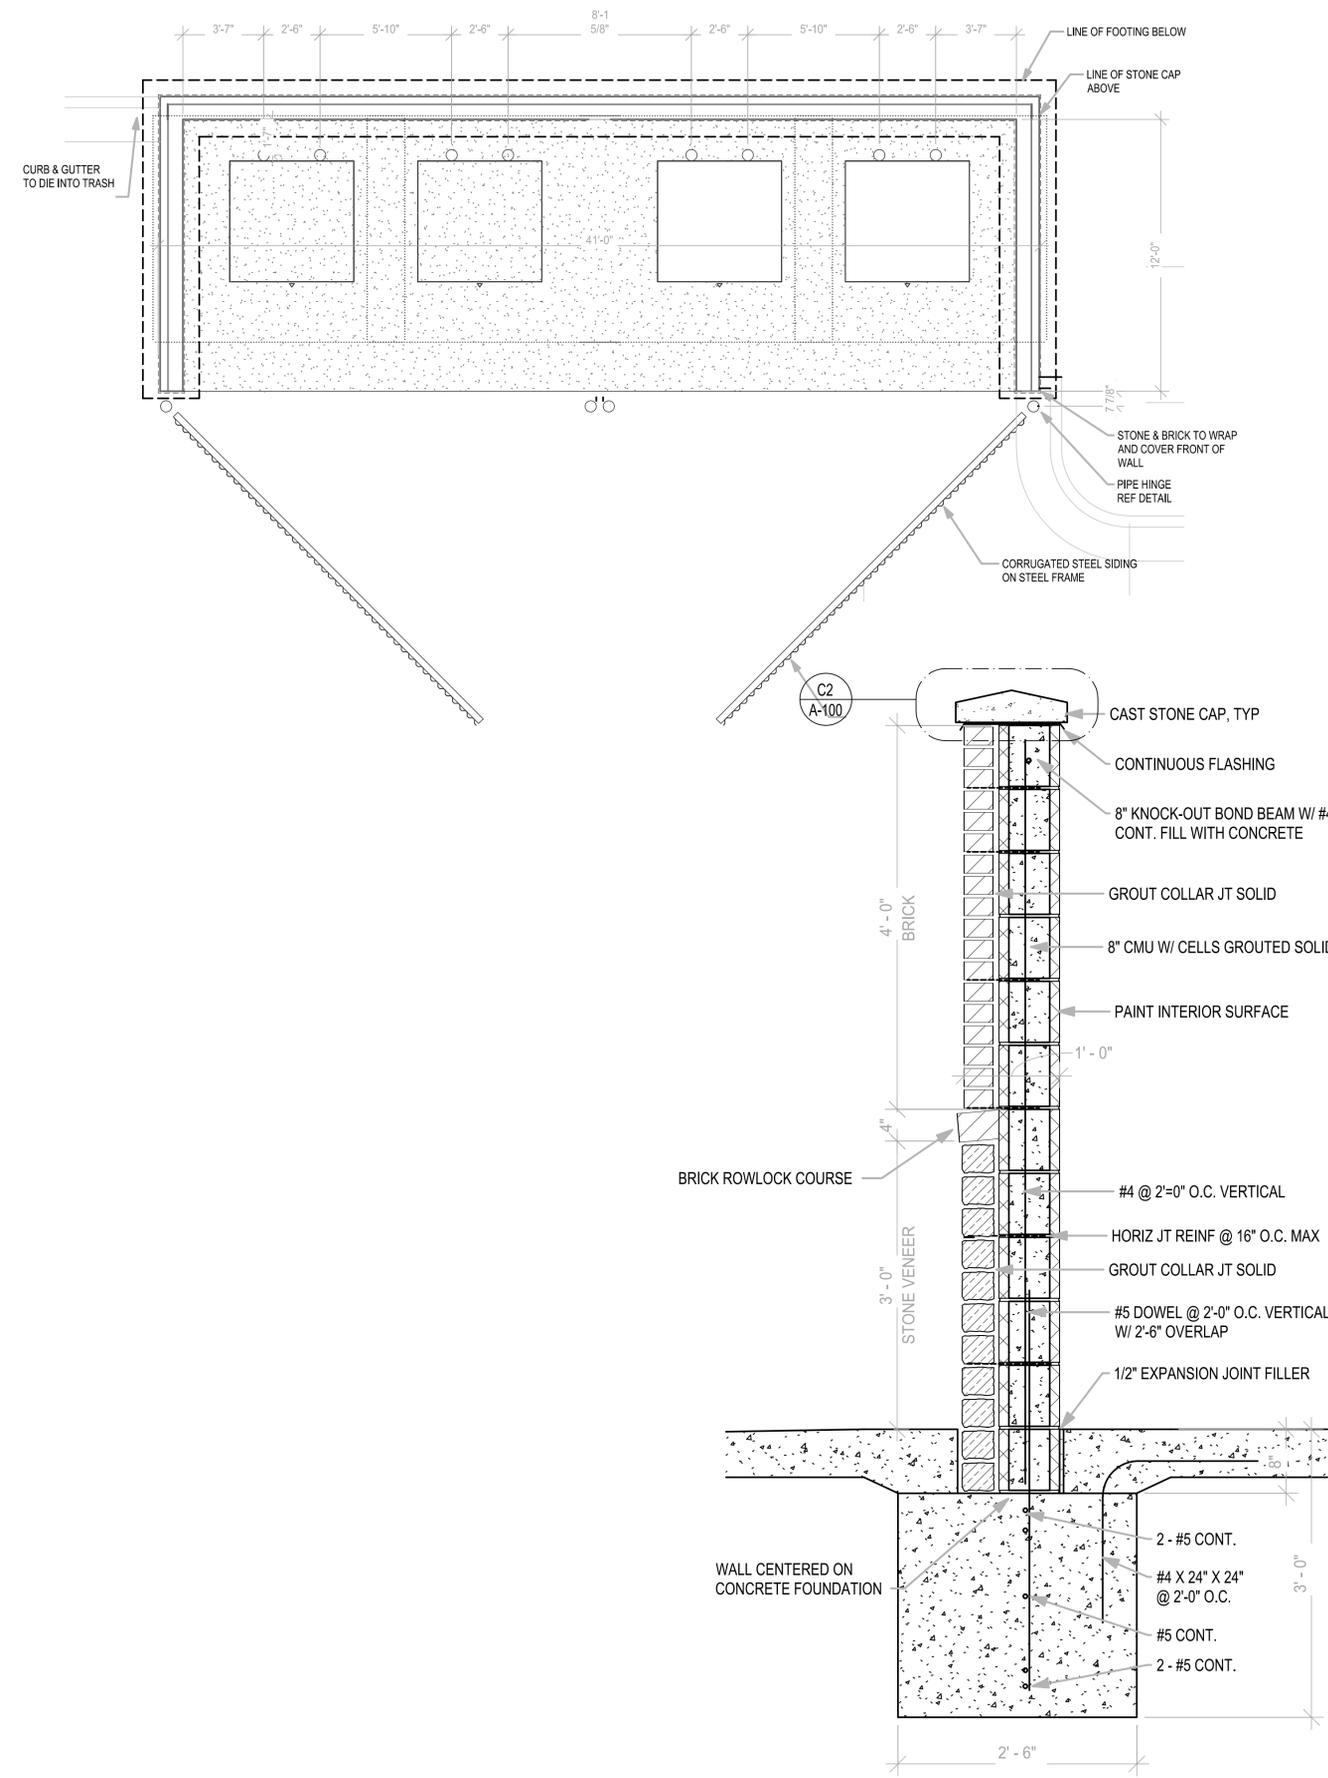

STANLEY 1010 18" CANE BOLT W/ BLACK WEATHER GUARD FINISH (OR SIM.) @ EACH GATE, DRILL HOLES IN PAVING FOR EA. BOLT

FIRESTONE UNA-CLAD VR-CLASSIC OMEGA 22GA GALVANIZED STEEL PANELS, KYNAR FINISH. ATTACH TO TOP AND BOTTOM RAIL @ 16" O.C., ATTACH TO DIAGONAL AND VERTICAL RAILS @ 24" O.C.

PROVIDE ADJUSTABLE WHEEL ON END OF EACH GATE DOOR. ENSURE HINGES ARE LOOSE ENOUGH FOR WHEEL TO FOLLOW GRADE WHEN SWUNG OPEN TO SUPPORT DOOR.

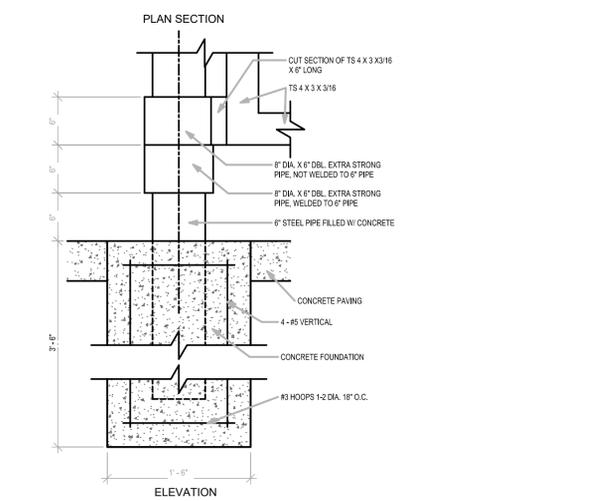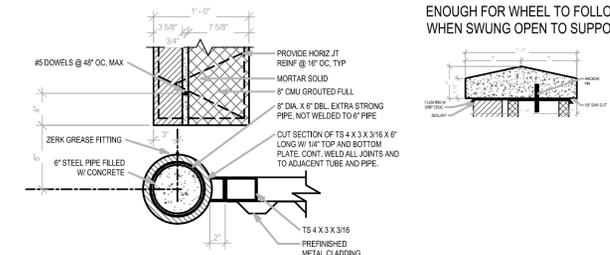

LOT 13A OF  
WEST PRYOR  
LEES-SUMMIT, MISSOURI





Drawings and/or Specifications are original proprietary work and property of the Engineer and intended specifically for this project. Use of items contained herein without consent of the Engineer is prohibited. Drawings illustrate best information available to the Engineer. Field verification of actual elements, conditions, and dimensions is required.







Revisions  
11-29-23 CITY COMMENTS


LOT 13A OF WEST PRYOR  
LEES-SUMMIT, MISSOURI

**LEE'S SUMMIT MISSOURI**  
 STANDARD DETAILS  
 CITY OF LEES-SUMMIT, MO  
 LEES-SUMMIT, JACKSON COUNTY, MO  
 PUBLIC WORKS ENGINEERING DIVISION | 2202 E. GREEN STREET | LEES-SUMMIT, MO 64080  
 GEN-4

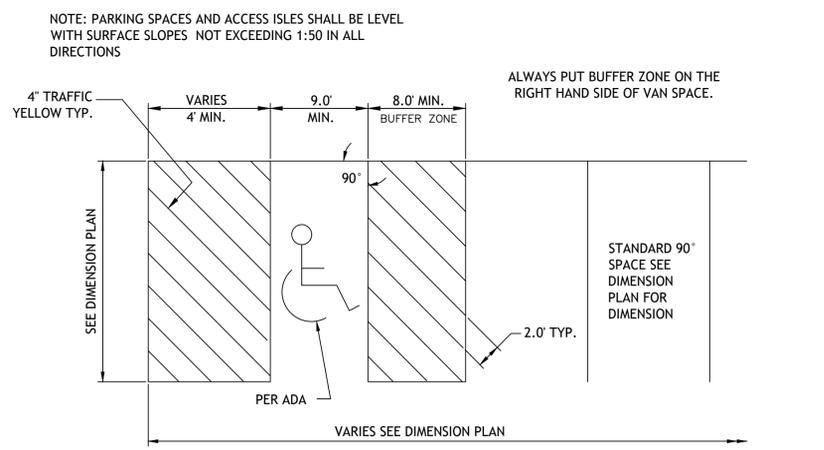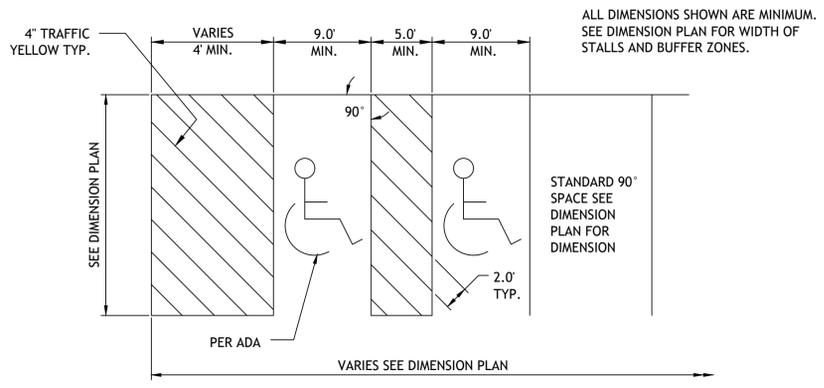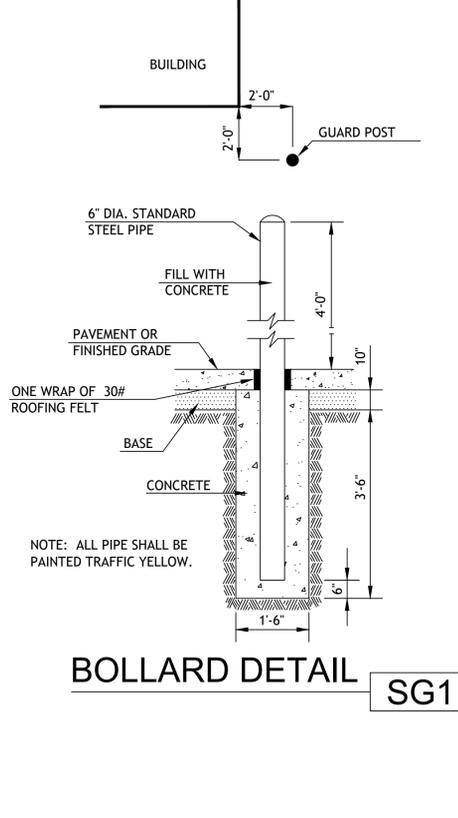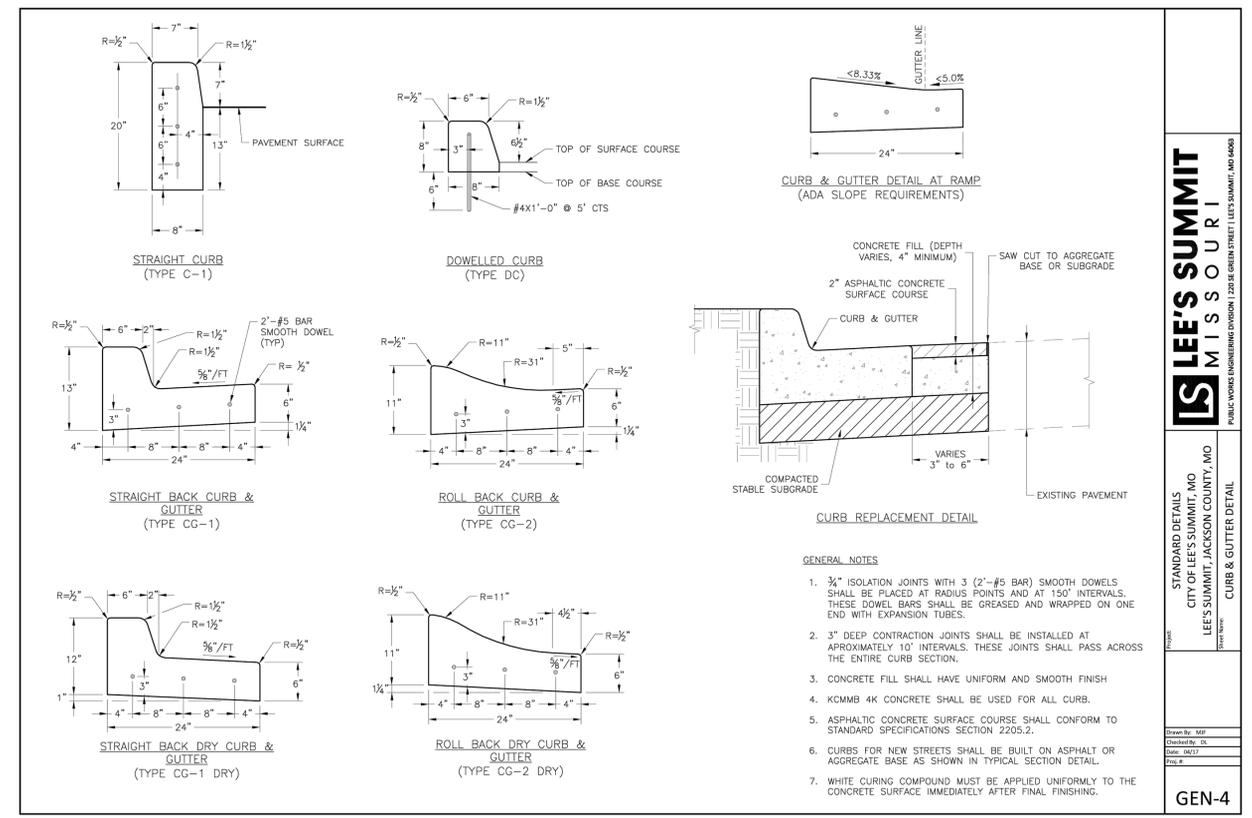

**90° ACCESSIBLE & VAN ACCESSIBLE SPACE STRIPING PK1**

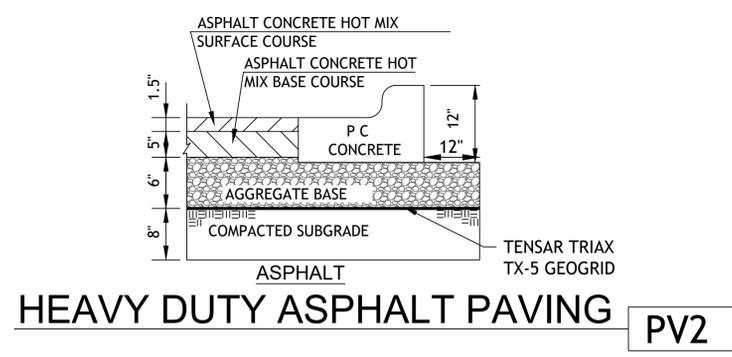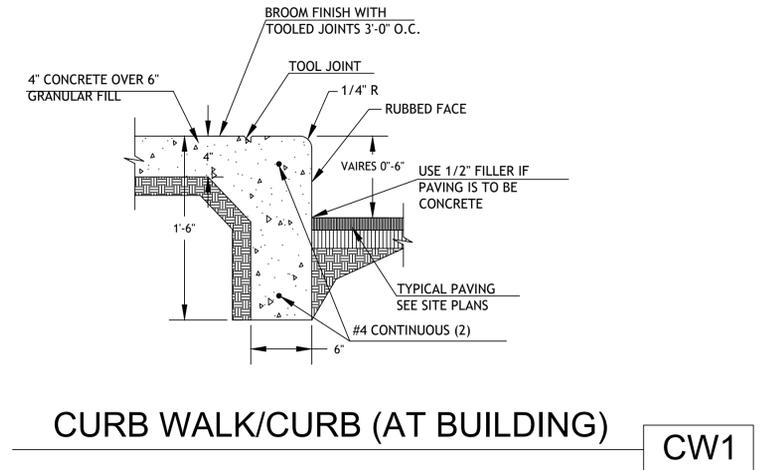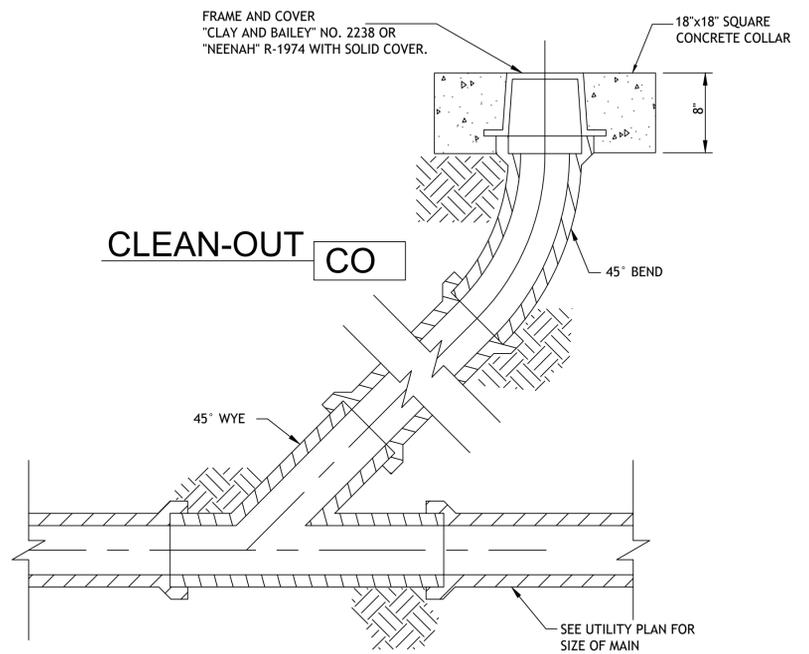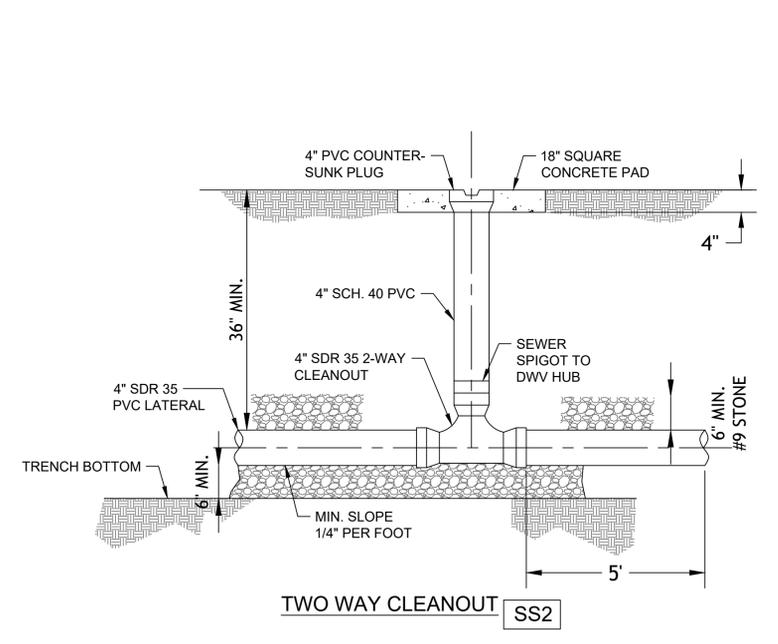

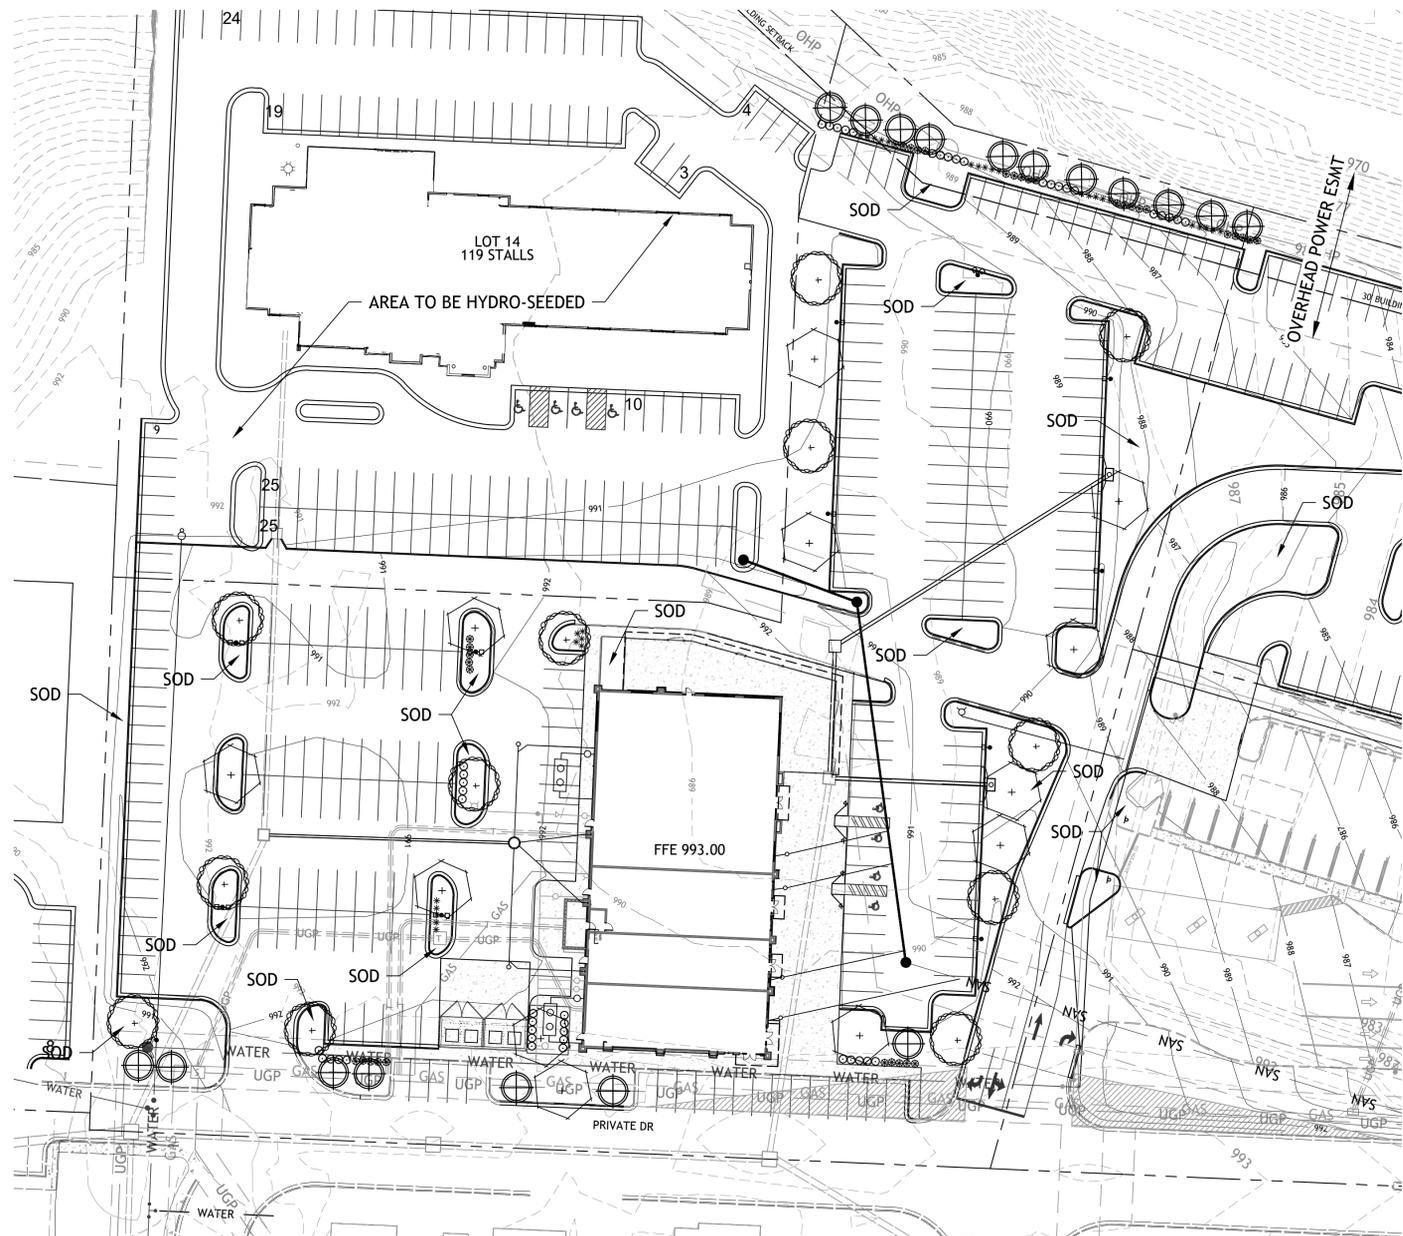

**LANDSCAPE NOTES**  
 CONTRACTOR REQUIRED TO LOCATE ALL UTILITIES BEFORE INSTALLATION TO BEGIN.

Contractor shall verify all landscape material quantities and shall report any discrepancies to the Landscape Architect prior to installation.

No plant material substitutions are allowed without Landscape Architect or Owners approval.

Contractor shall guarantee all landscape work and plant material for a period of one year from date of acceptance of the work by the Owner. Any plant material which dies during the one year guarantee period shall be replaced by the contractor during normal planting seasons.

Contractor shall be responsible for maintenance of the plants until completion of the job and acceptance by the Owner.

Successful landscape contractor shall be responsible for design that complies with minimum irrigation requirements, and installation of an irrigation system. Irrigation system to be approved by the owner before starting any installation.

All plant material shall be specimen quality stock as determined in the "American Standards For Nursery Stock" published by The American Association of Nurserymen, free of plant diseases and pest, of typical growth of the species and having a healthy, normal root system.

Sizes indicated on the plant list are the minimum, acceptable size. In no case will sizes less than specified be accepted.

All shrub beds within lawn areas to receive a manicured edge.

All shrub beds shall be mulched with 3" of shredded chocolate mulch.

All sod areas to be fertilized & sodded with a Turf-Type-Tall Fescue seed blend.

All areas to be sodded unless noted otherwise.

All seed areas shall be hydro-seeded with a Turf-Type-Tall Fescue seed blend.

**IRRIGATION NOTE**

- SUCCESSFUL LANDSCAPE CONTRACTOR SHALL BE RESPONSIBLE FOR DESIGN THAT COMPLIES WITH MINIMUM IRRIGATION REQUIREMENTS, AND INSTALLATION OF AN IRRIGATION SYSTEM. IRRIGATION SYSTEM TO BE APPROVED BY THE OWNER BEFORE STARTING ANY INSTALLATION.
- IRRIGATION SYSTEM SHALL PROVIDE A CONSTANT ON ON ZONE FOR FOUNTAIN
- IRRIGATION CONTROLLER TO BE MOUNTED ON OUTSIDE WALL OF BUILDING. PROVIDE TEMPORARY SUPPORT PRIOR TO BUILDING CONSTRUCTION.
- ALL AREAS WITHIN LOT 11 & 13 BOUNDARY TO BE IRRIGATED

**MOWING NOTE**  
 CONTRACTOR SHALL BE RESPONSIBLE FOR FIRST 2 MOWINGS OF ALL AREAS OF GRASS.

SM Engineering  
**SME**  
 5507 High Meadow Circle  
 Manhattan Kansas, 66503  
 smcivlengr@gmail.com  
 785.341.9747

Drawings and/or Specifications are original proprietary work and property of the Engineer and intended specifically for this project. Use of items contained herein without consent of the Engineer's prohibited. Drawings illustrate best information available to the Engineer. Field verification of actual elements, conditions, and dimensions is required.



Revisions  
 11-29-23 CITY COMMENTS  
 1-4-24 PER CLIENT  
 1-16-24 PER EVERGY

**LOT 13**  
 470 HWY = 216'  
 REQUIRED:  
 STREET TREES 1/30' = 7  
 SHRUBS 1/20' = 11

PROVIDED:  
 ORNAMENTALS = 11  
 SHRUBS = 60



PRIVATE DR (SOUTH) = 425'  
 REQUIRED:  
 STREET TREES 1/30' = 14  
 SHRUBS 1/20' = 21

PROVIDED:  
 SHADE = 7  
 ORNAMENTALS = 7  
 SHRUBS = 30


INTERIOR PARKING  
 TOTAL PARKING SURFACE = 80,928 SF  
 REQUIRED  
 5% LANDSCAPE AREA = 4,046 SF  
 PROVIDED = 5,530 SF

OPEN SPACE TREES  
 OPEN SPACE = 30,819SF  
 REQUIRED  
 TREES 1 / 5,000SF = 6  
 SHRUBS 2 / 5,000SF = 12

PROVIDED  
 SHADE TREES = 17  
 SHRUBS = 20

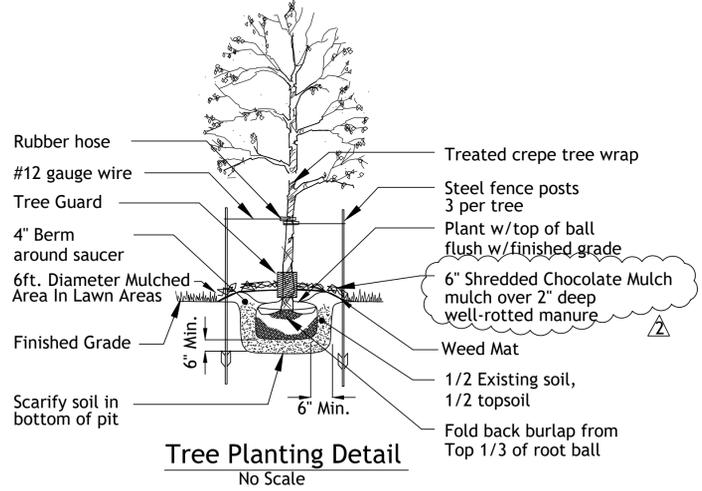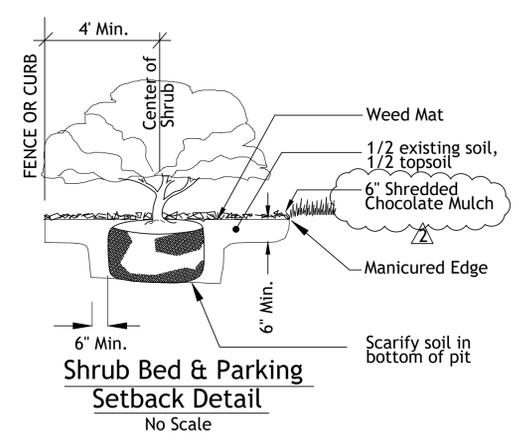

**Typical Utility Box Screening Details**


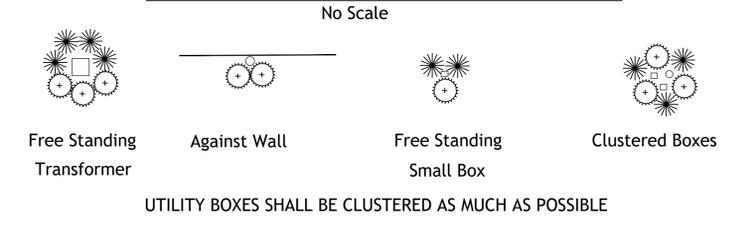


**Shrub List**


Symbol	Quantity	Common Name	Botanical Name	Size	Condition	Spacing
⊙	45	Seagreen Juniper	Juniperus Chinensis 'Seagreen'	18"-24"sp.	Cont.	4'o.c.
⊗	35	Dwarf Winged Euonymus	Euonymus Alatus 'Compactus'	18"-24"sp.	Cont.	4'o.c.
*	30	Morning Light Maiden Grass	Miscanthos Sinensis 'Morning Light'	18"-24"sp.	Cont.	4'o.c.

**Tree List**

Symbol	Quantity	Common Name	Botanical Name	Size	Condition	Spacing
⊕	12	October Glory Maple	Acer Rubrum 'October Glory'	3" cal	BB	As Shown
⊕	12	Skyline Honeylocust	Gleditsia Triacanthos 'Skyline'	3" cal	BB	As Shown
⊕	18	Cercis Ruby Falls (Redbud)	Cercis canadensis 'Ruby Falls'	3"cal	BB	As Shown

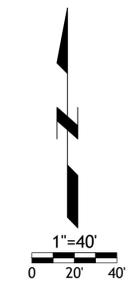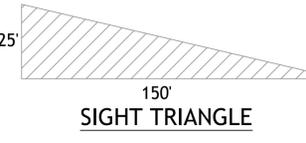


**LOT 13A OF WEST PRYOR**  
 LEE'S SUMMIT, MISSOURI

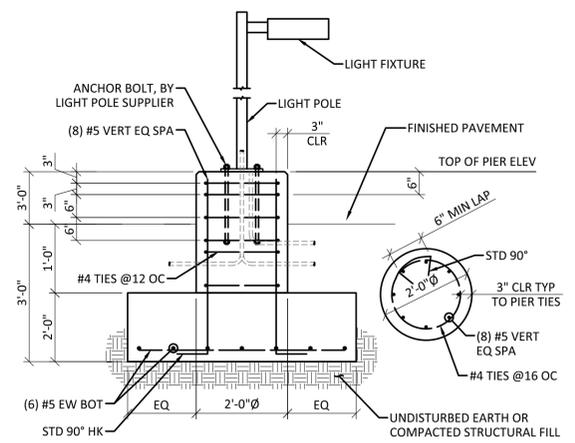


**TYPICAL LIGHT POLE BASE DETAIL**  
SCALE: NONE

PLAN MARK	MANUFACTURER	MODEL NUMBER	MOUNTING	FINISH	LAMP CODE	LAMP QUANTITY	NOTES
AA	MCGRAW-EDISON	GALN-SA2C-740-U-TAFT	25' POLE	BRONZE	108W LED PER HEAD	1	1,2,3,5
BB	MCGRAW-EDISON	GALN-SA2C-740-U-TAFT-2Ø180 DEG	25' POLE	BRONZE	108W LED PER HEAD	2	1,2,3,5
CC	MCGRAW-EDISON	GALN-SA2C-740-U-TAFT-2Ø90 DEG	25' POLE	BRONZE	108W LED PER HEAD	1	1,2,3,5
DD	MCGRAW-EDISON	GALN-SA2C-740-U-T3FT	25' POLE	BRONZE	108W LED PER HEAD	1	1,2,3,5
EE	MCGRAW-EDISON	GALN-SA2C-740-U-5MQ	25' POLE	BRONZE	108W LED PER HEAD	1	1,2,3,5
A	LITHONIA	WPX1-LED-P2-30K-MVOLT-E14WC-DOBXD	WALL/SURFACE	BRONZE	24W LED	-	1,2
B	GREEN CREATIVE	12NCDRL6DIM/930/EXT	RECESSED	BLACK	12W LED	-	1,2,3,6
B1	GREEN CREATIVE	12NCDRL6DIM/930/EXT-EM	RECESSED	BLACK	12W LED	-	1,2,3,4,6
C	AFX	BMWS17800L30MVBZ	WALL/SURFACE	BRONZE	1,800 LUMENS/19W	-	1,2
D	WILLIAMS	75L-4-L50/835-AF12125-DIM-UNV	SURFACE	WHITE	5,000 LUMENS/43W	-	-
EM	DUAL LITE	PG-HTR	SURFACE WALL/CEILING	BY ARCHITECT	LED	-	1,2,4


- NOTES LEGEND**
- 1 - PROVIDE WET LOCATION RATED FIXTURE
  - 2 - PROVIDE COLD LOCATION RATED DRIVER
  - 3 - PROVIDE SQUARE STRAIGHT STEEL POLE RATED FOR 100 MPH WIND GUSTS, PRIMED AND PAINTED TO MATCH FIXTURE
  - 4 - PROVIDE EMERGENCY BATTERY
  - 5 - PROVIDE ALL ACCESSORIES FOR A COMPLETE INSTALLATION.
  - 6 - PROVIDE WEATHER PROOF JUNCTION BOX FOR DRIVERS AND ELECTRICAL CONNECTIONS ABOVE SOFFIT.

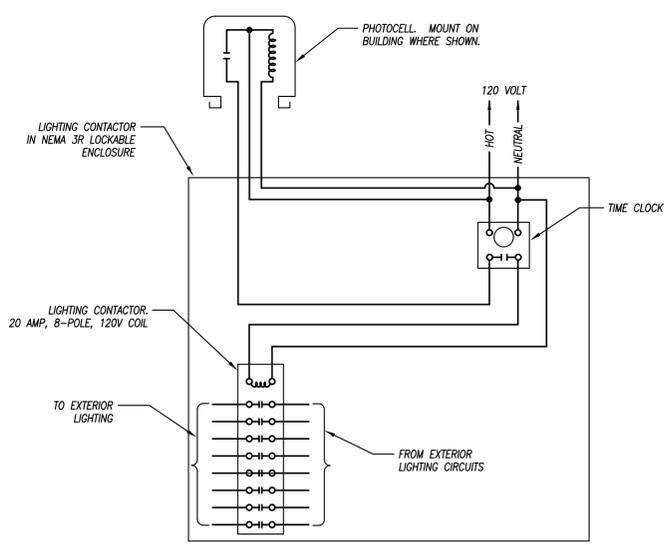


**EXTERIOR LIGHTING CONTROL**  
NOT TO SCALE

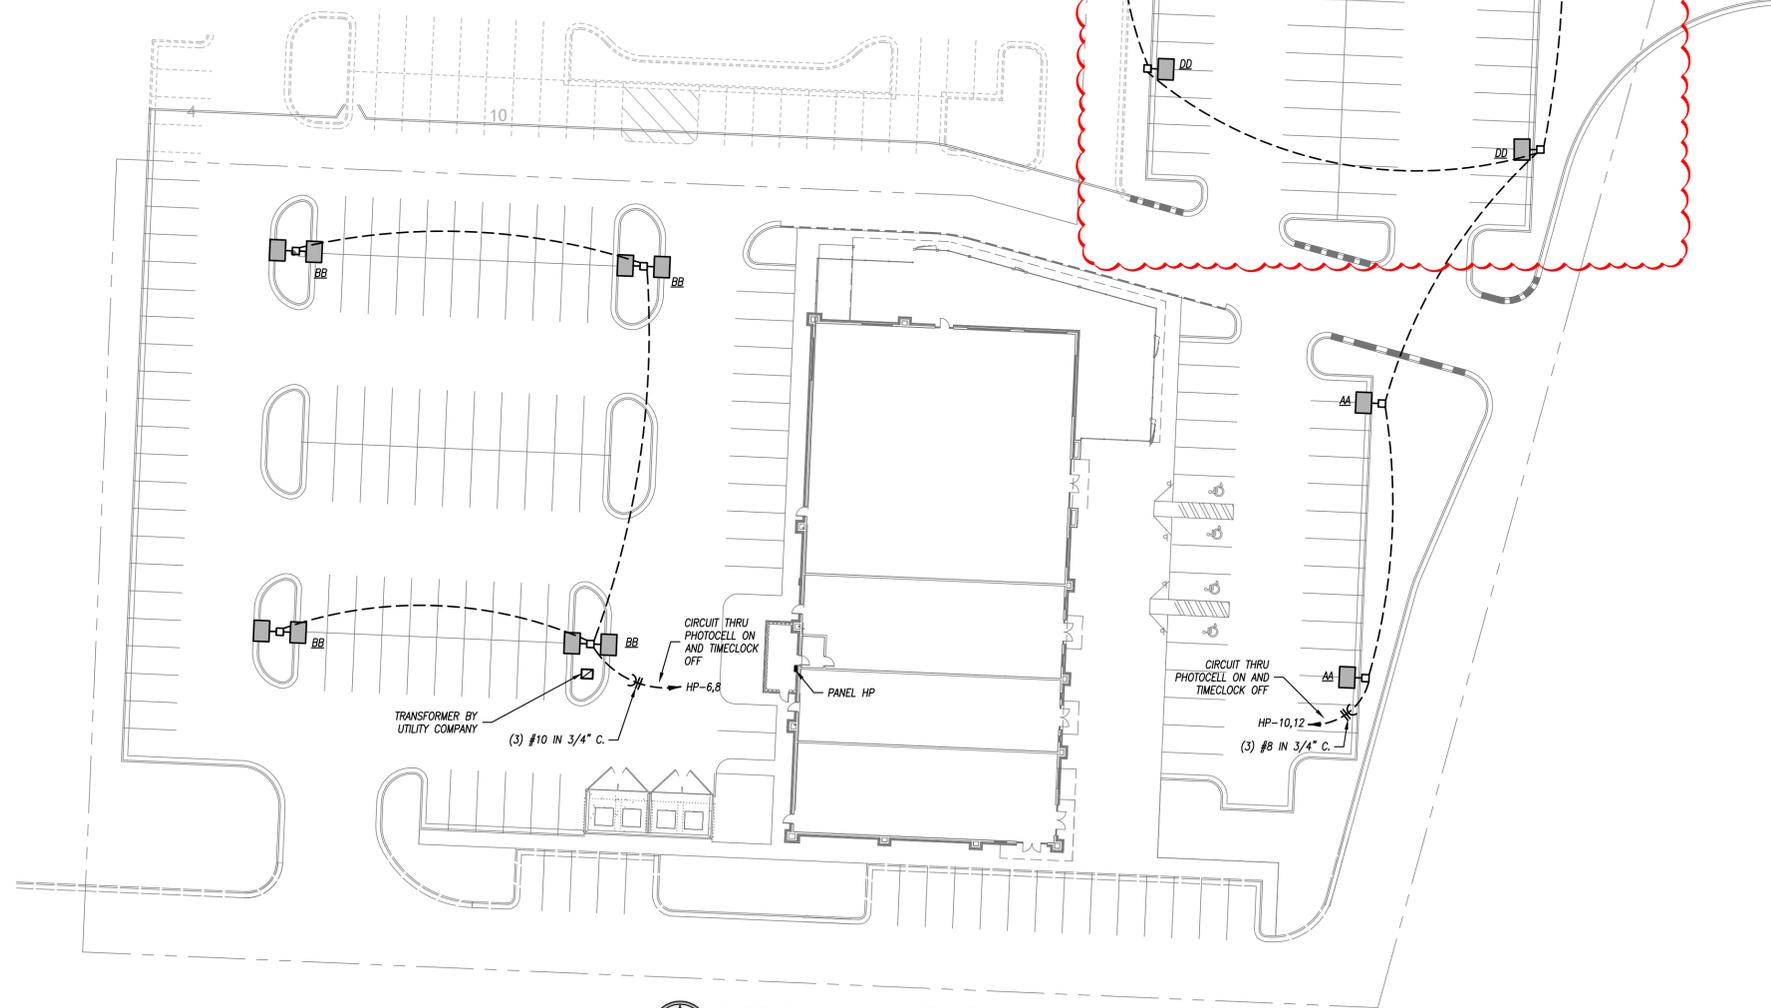

**SITE PLAN - LIGHTING**  
1" = 30'-0"

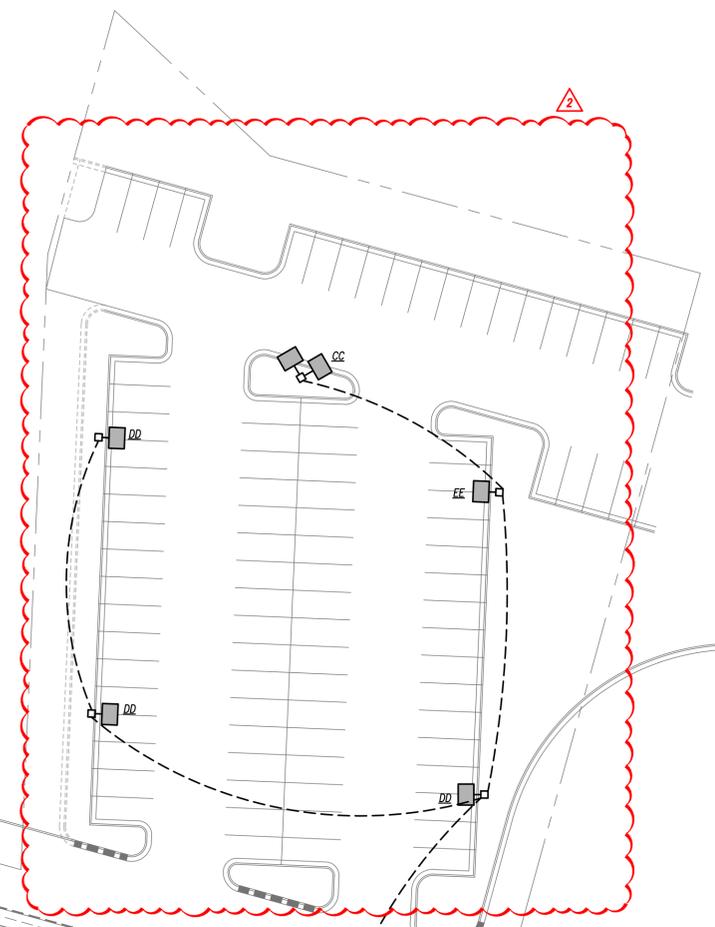

**schwerdt design group**  
architecture|interiors|planning  
2231 sw wanamaker rd suite 303  
topeka, kansas 66614-4275  
phone: 785.273.7540  
fax: 785.273.7579  
500 north broadway suite 200  
oklahoma city, ok 73102  
phone: 405.231.3105  
fax: 405.231.3115

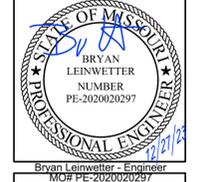

Bryan Leinwetter - Engineer  
MO# PE-2020020297

**CORE & SHELL BUILDING**  
**STREETS OF WEST PRYOR LOT 13**  
LEES SUMMIT, MISSOURI

SUBMISSION DATES
DECEMBER 27, 2023
JANUARY 16, 2024
FEBRUARY 7, 2024

SHEET TITLE  
SITE LIGHTING  
PLAN

PROJECT NUMBER  
**235008**

SHEET NUMBER  
**E-202**



