




2/16/2024 1:39:56 PM


Autodesk Docs://23104.00 - John Knox Village - Lindbergh/23104.00-JKV-Courtyards-Building E-Architectural CENTRAL.rvt

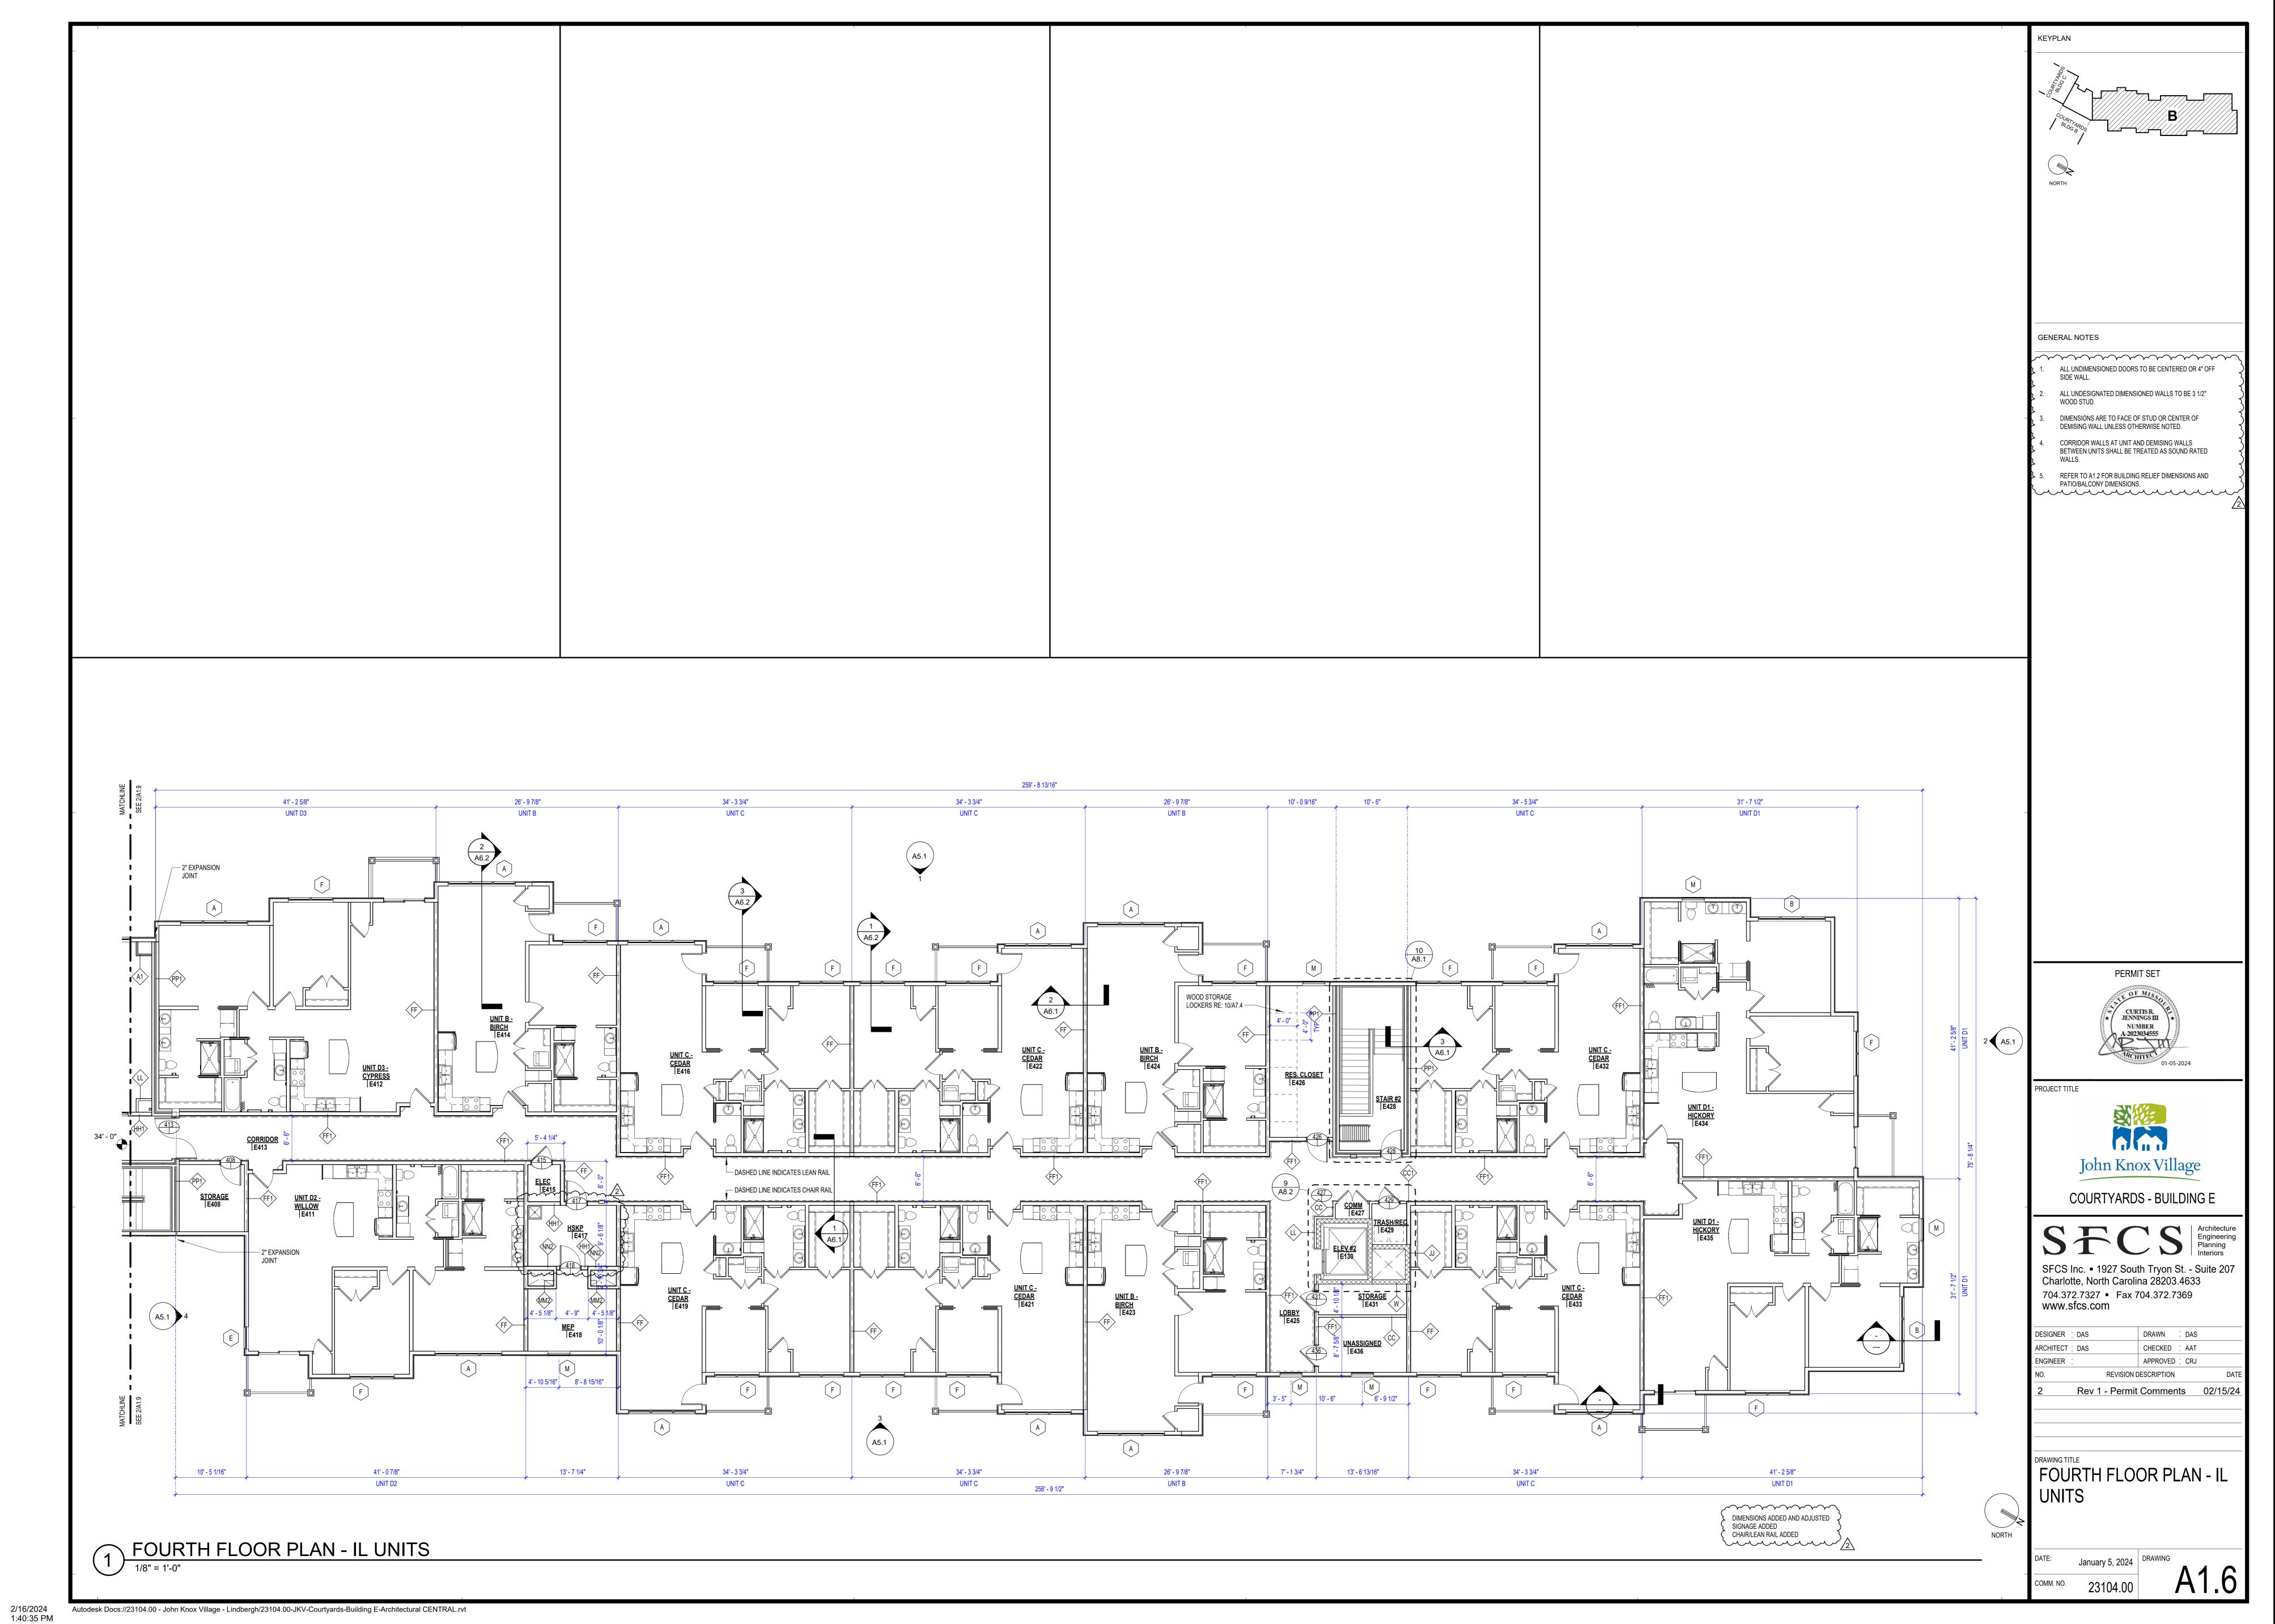


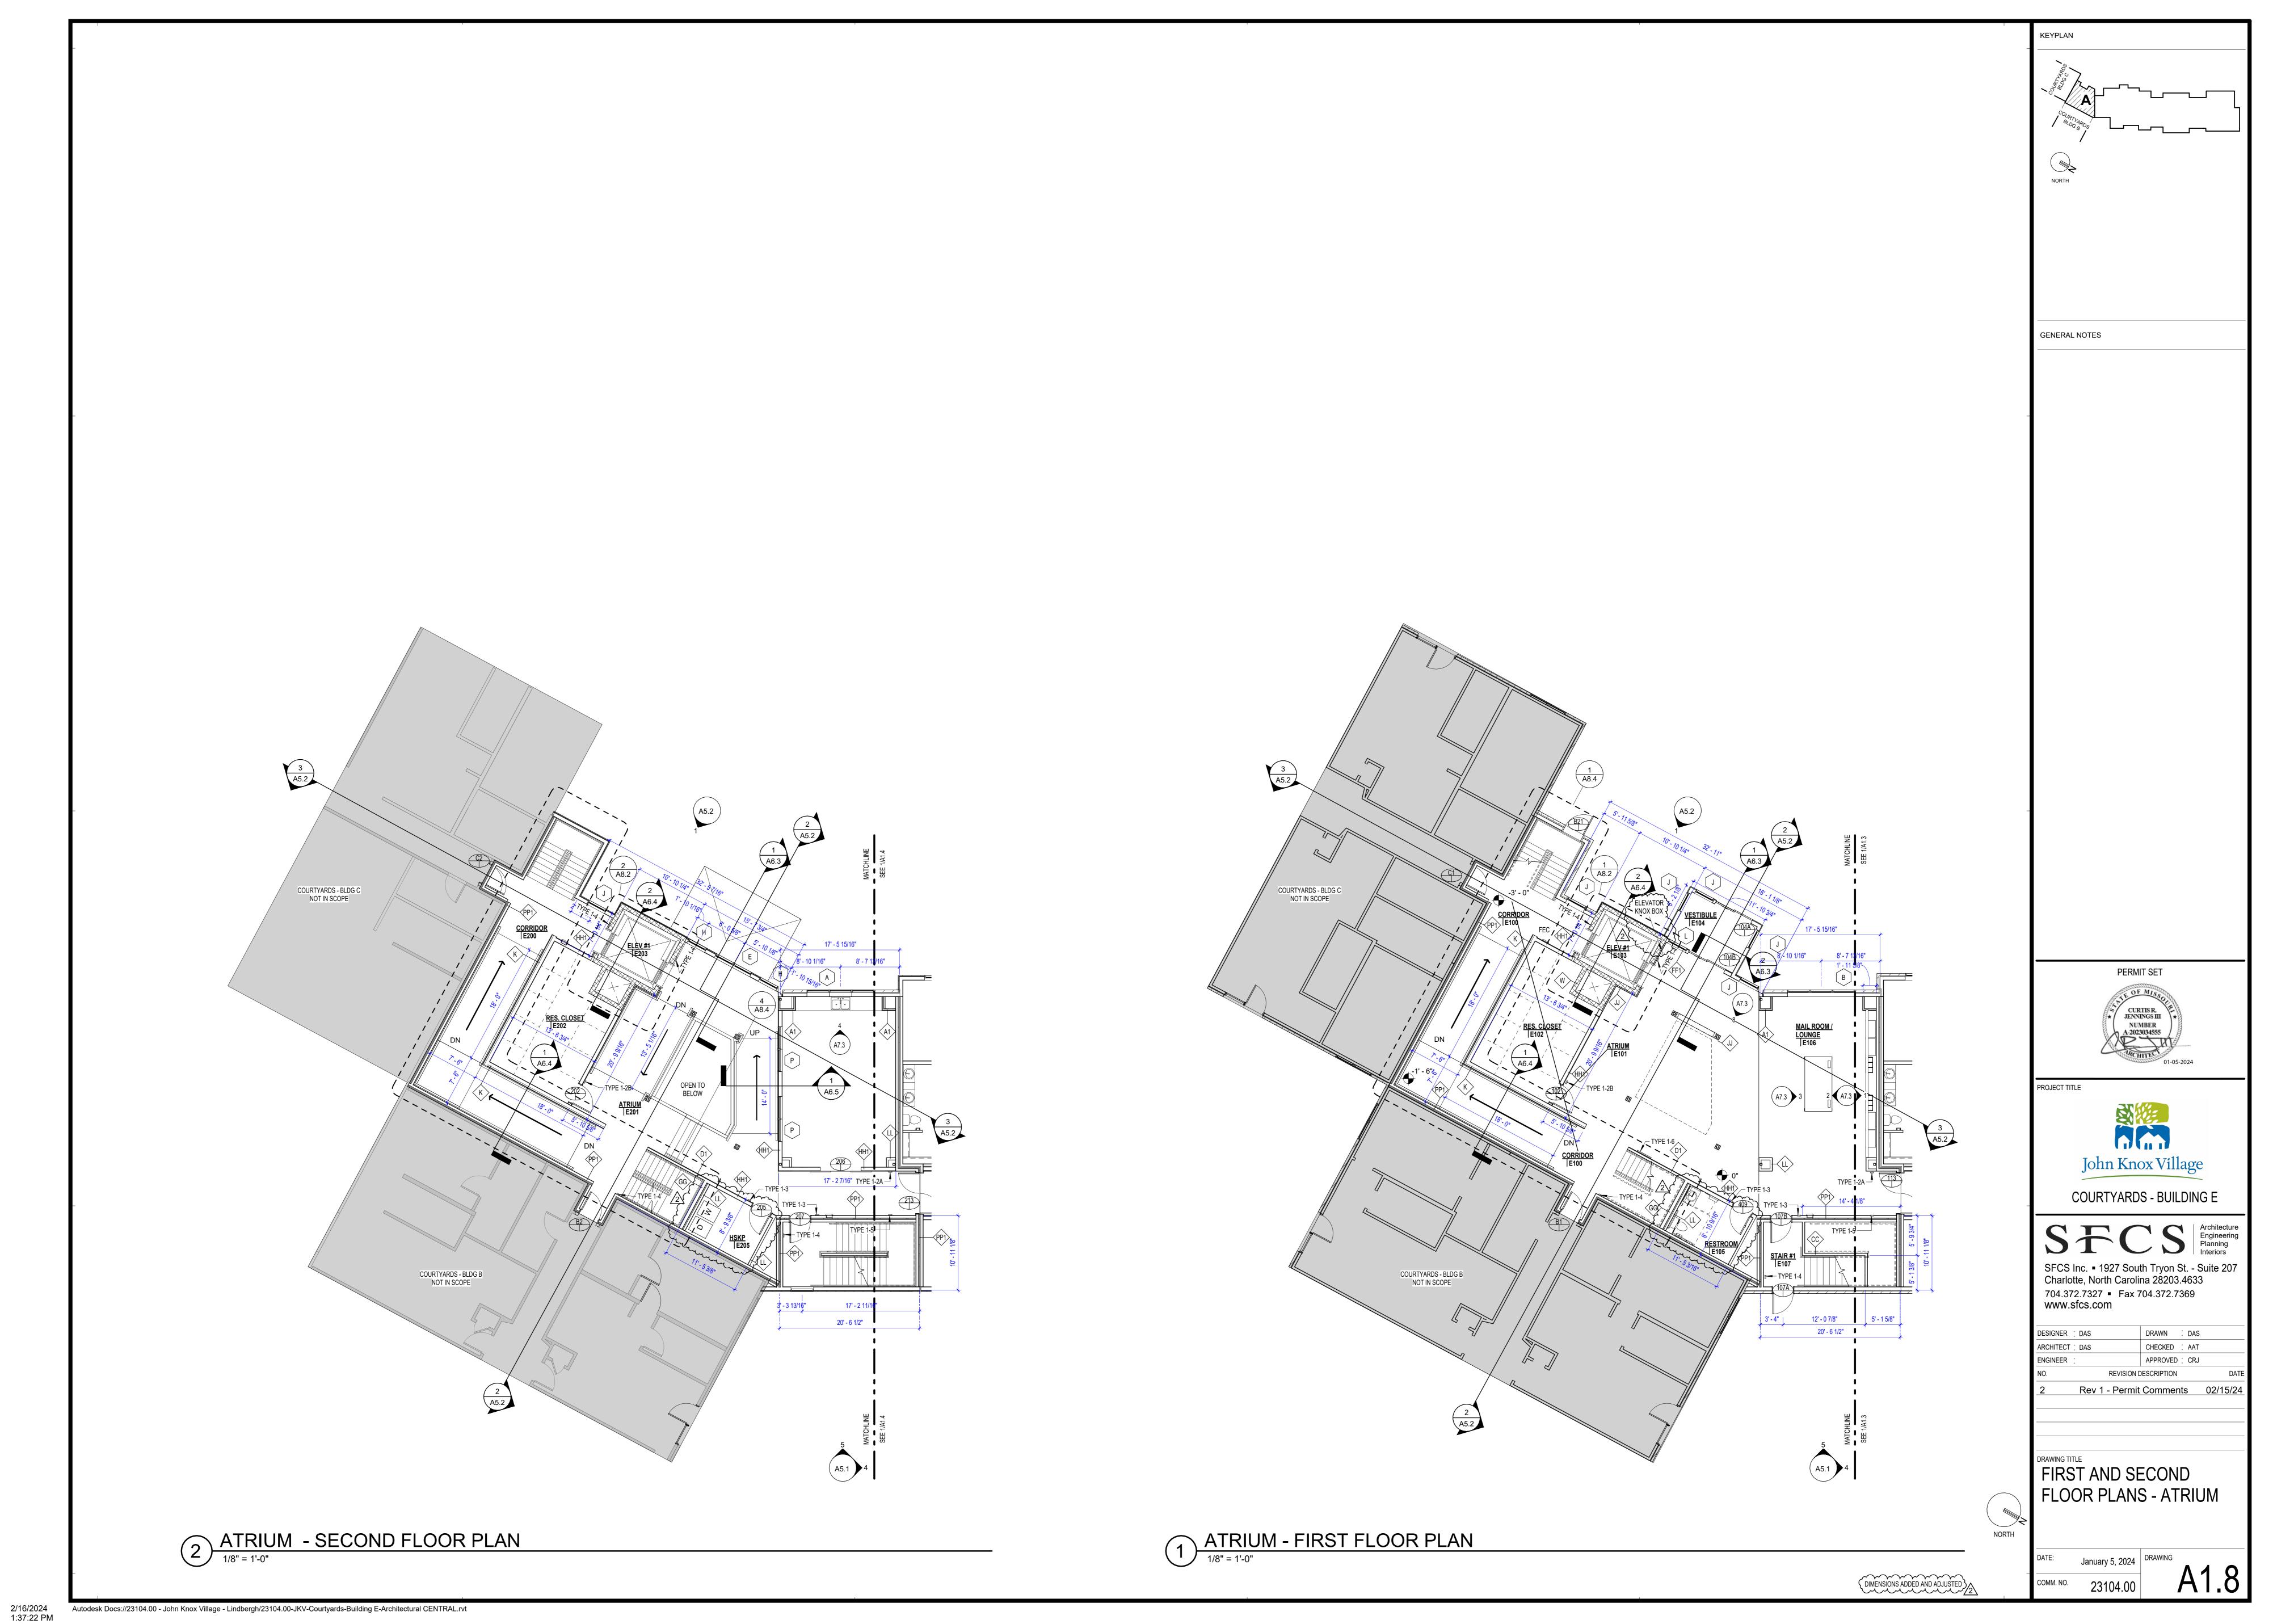

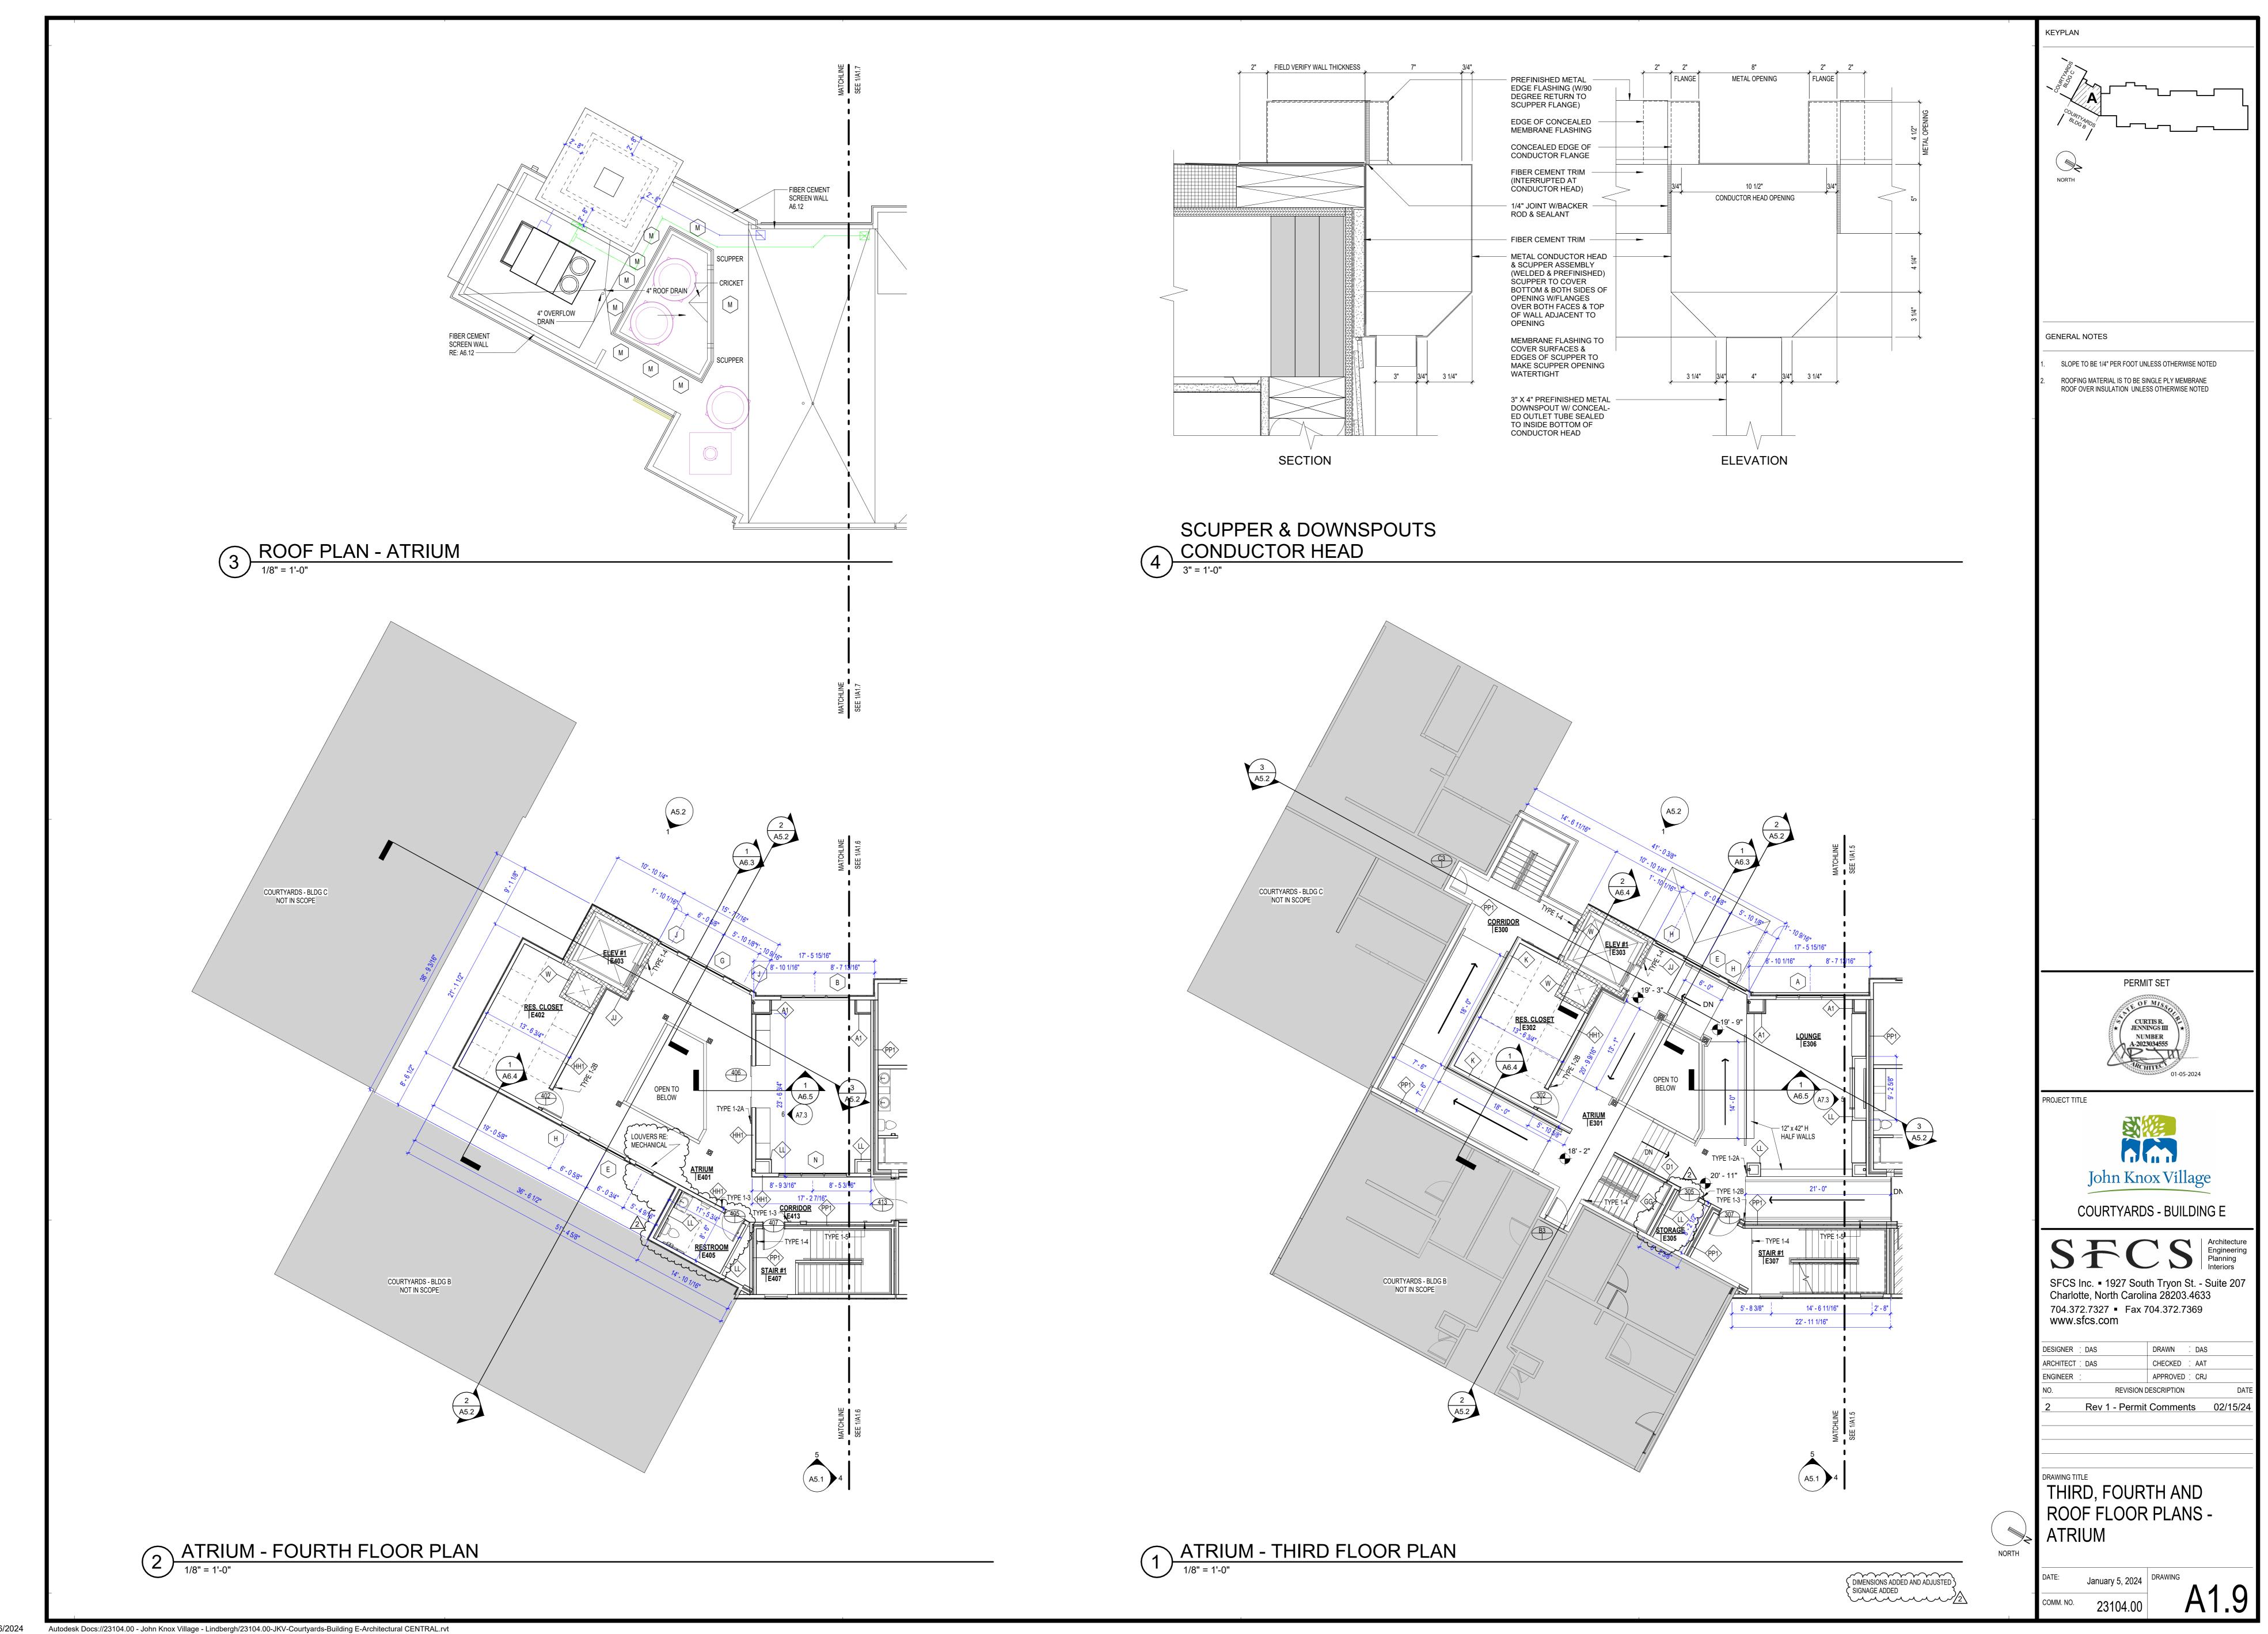

2/16/2024 1:41:40 PM

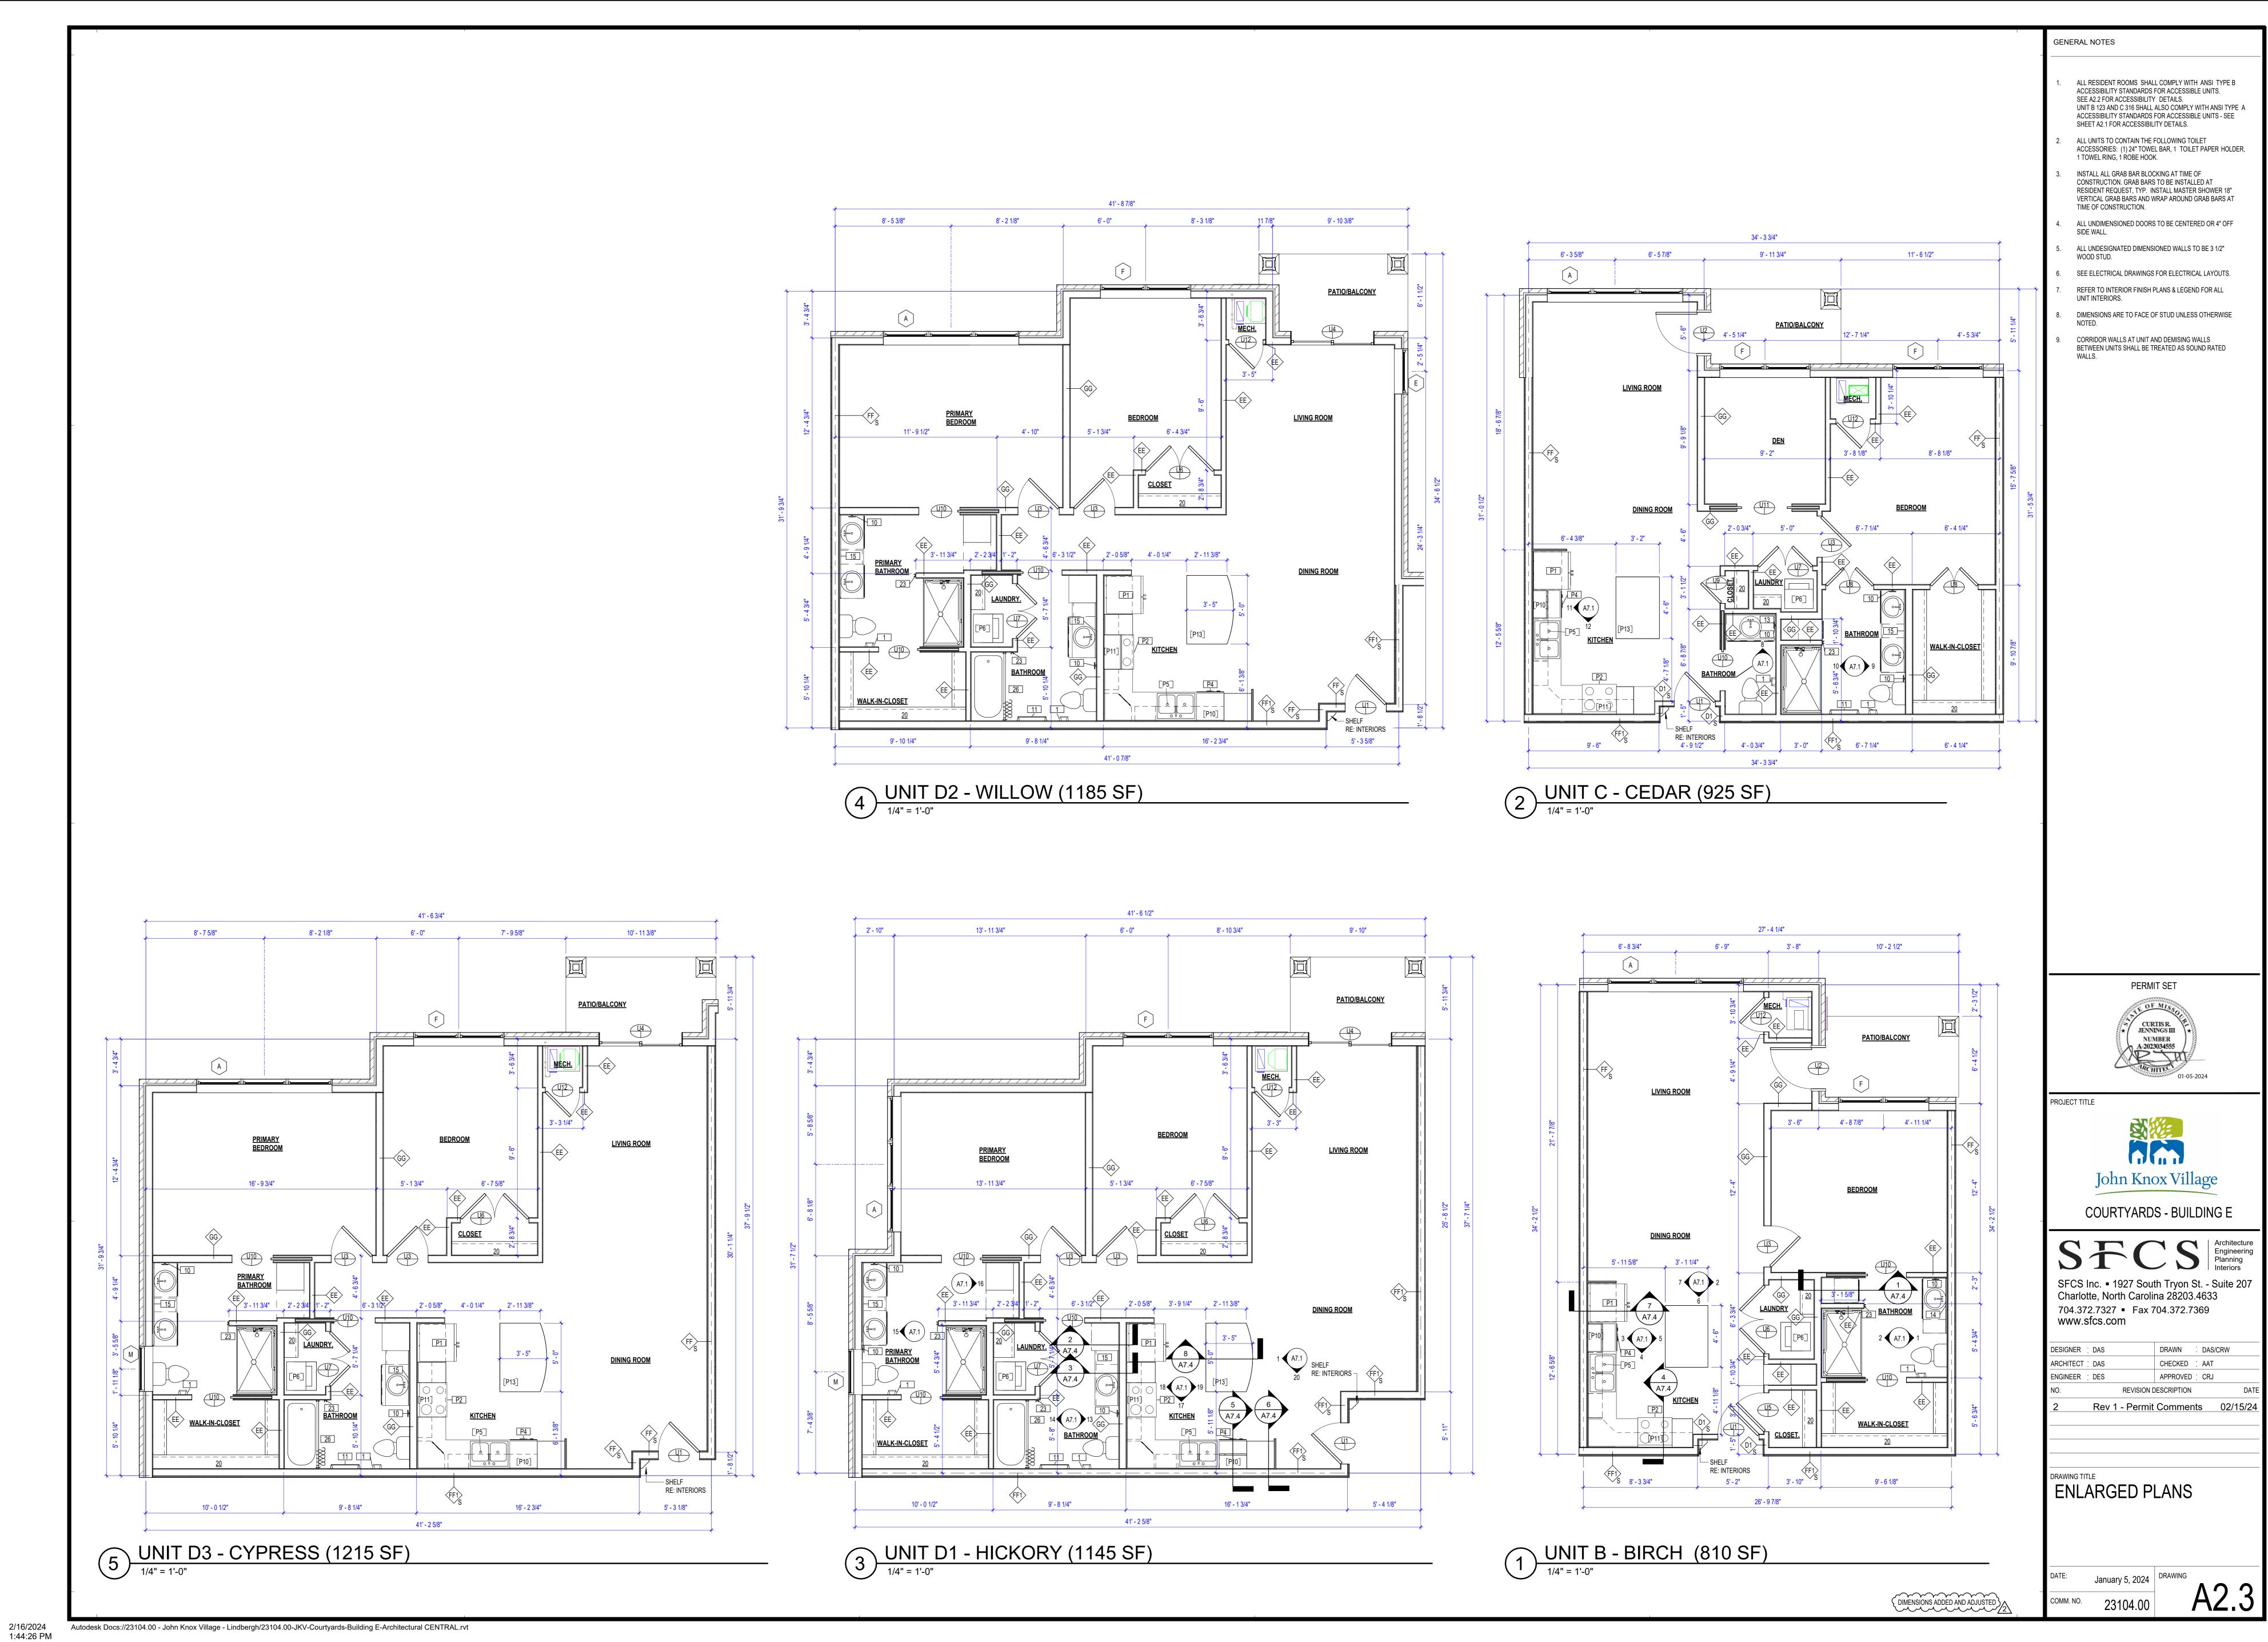

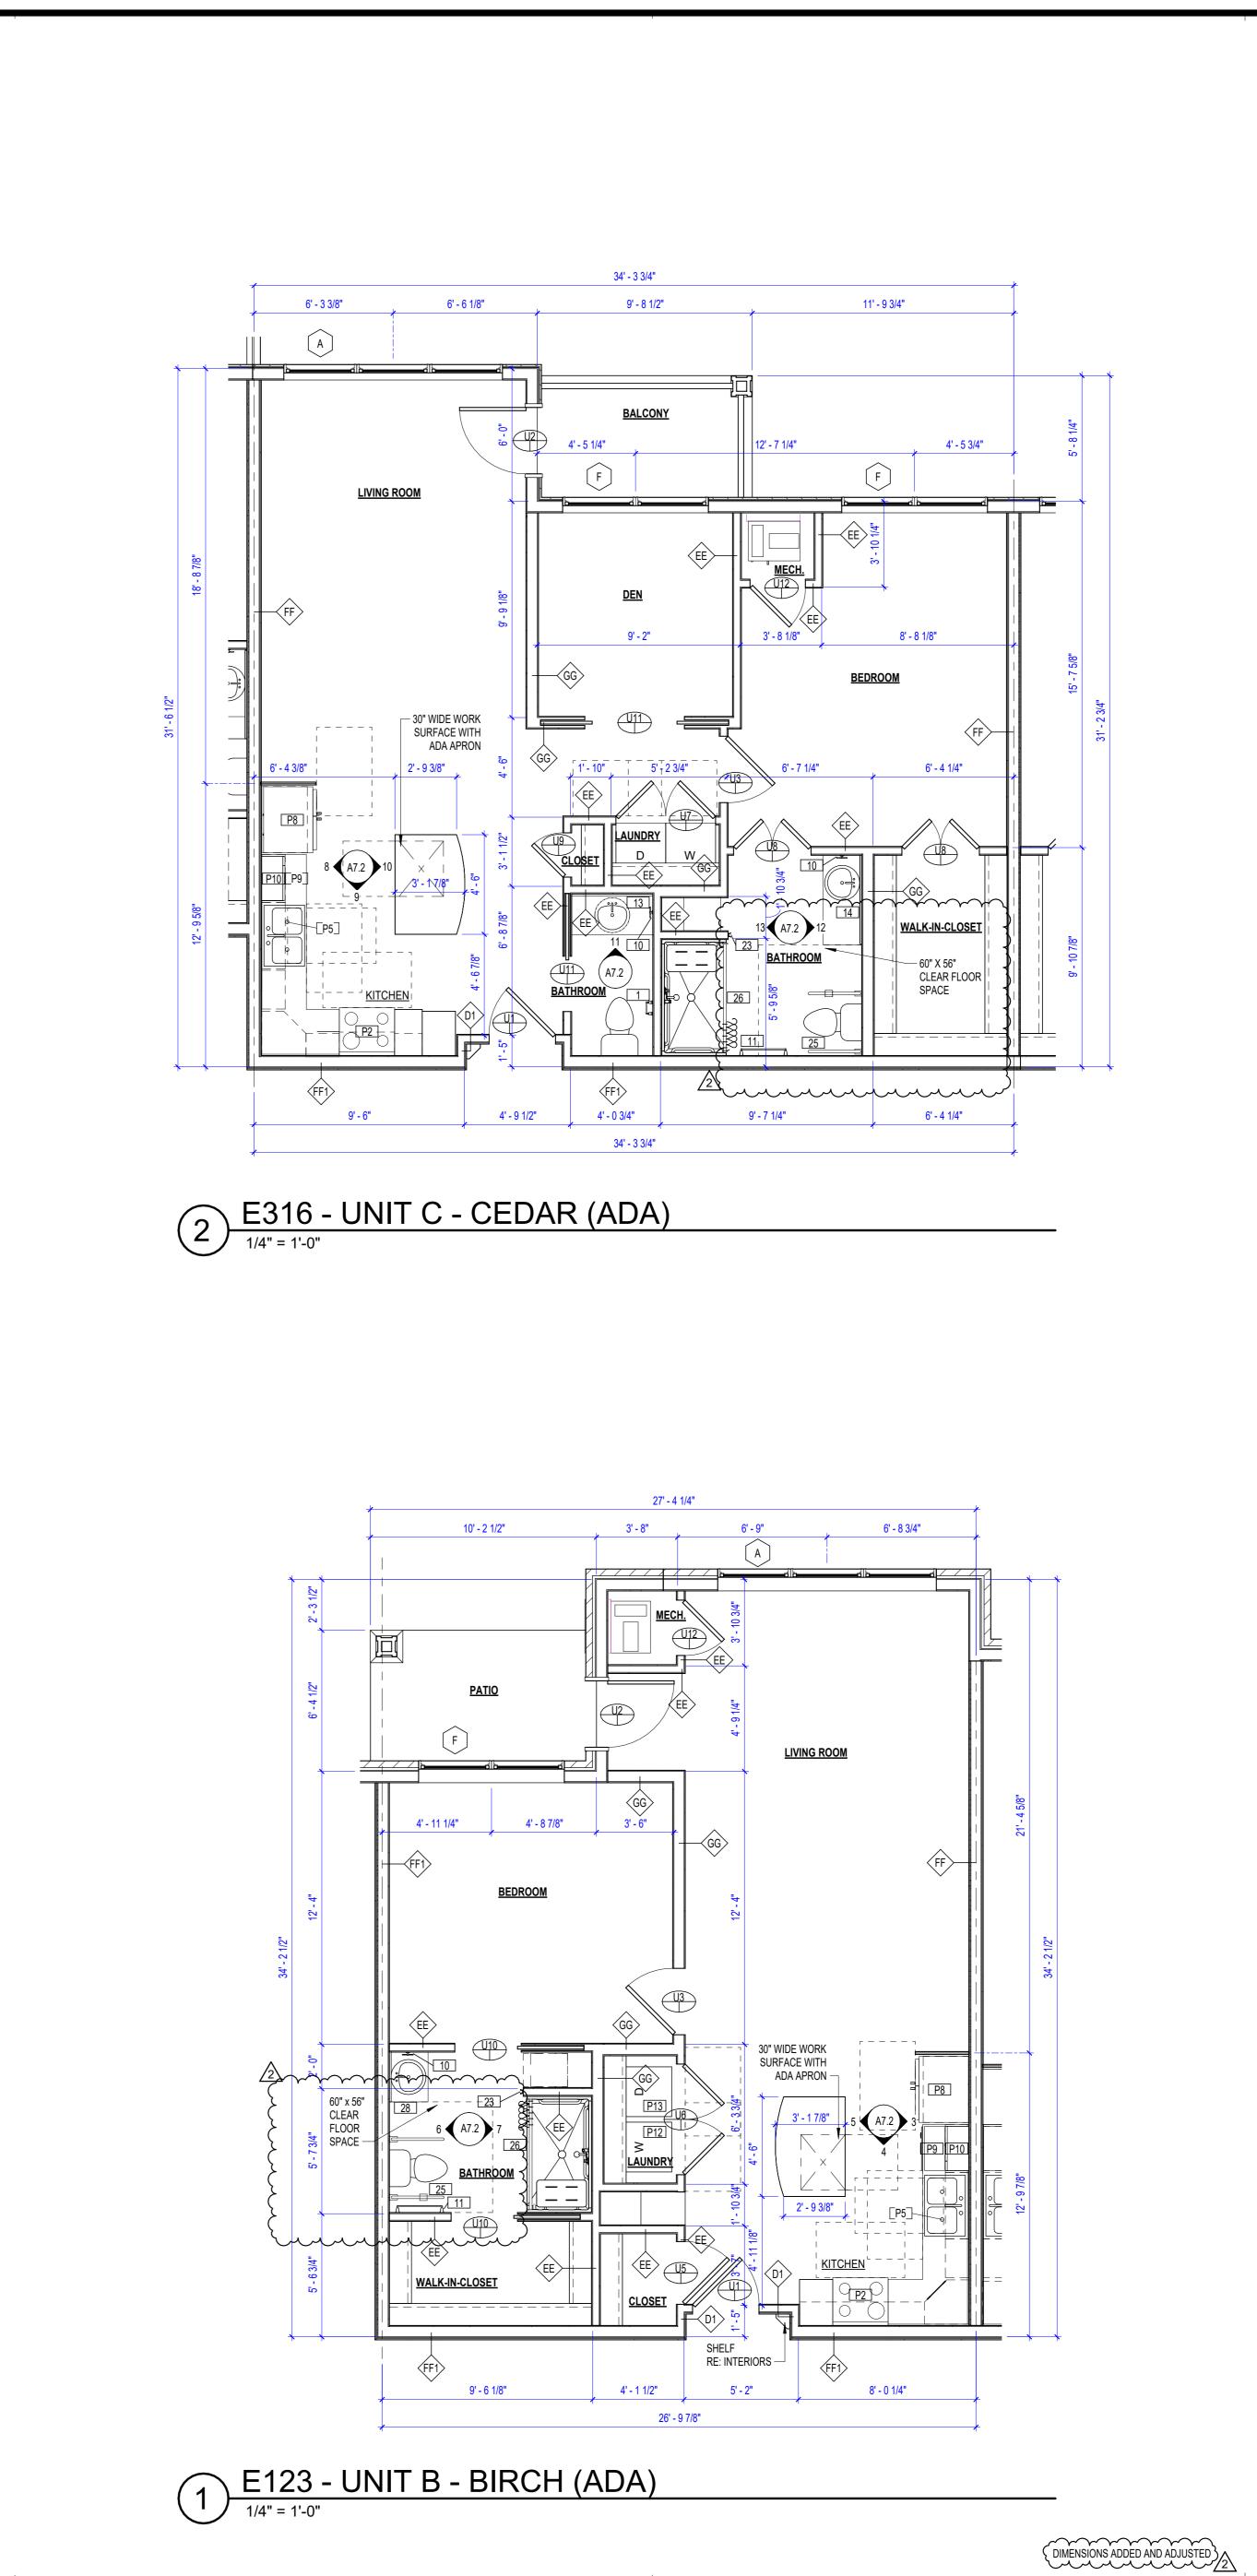


GENERAL NOTES

- ALL RESIDENT ROOMS SHALL COMPLY WITH ANSI TYPE B ACCESSIBILITY STANDARDS FOR ACCESSIBLE UNITS. SEE A2.2 FOR ACCESSIBILITY DETAILS. UNIT B 123 AND C 316 SHALL ALSO COMPLY WITH ANSI TYPE A ACCESSIBILITY STANDARDS FOR ACCESSIBLE UNITS - SEE SHEET A2.1 FOR ACCESSIBILITY DETAILS.
- ALL UNITS TO CONTAIN THE FOLLOWING TOILET ACCESSORIES: (1) 24" TOWEL BAR, 1 TOILET PAPER HOLDER, 1 TOWEL RING, 1 ROBE HOOK.
- INSTALL ALL GRAB BAR BLOCKING AT TIME OF CONSTRUCTION. GRAB BARS TO BE INSTALLED AT RESIDENT REQUEST, TYP. INSTALL MASTER SHOWER 18" VERTICAL GRAB BARS AND WRAP AROUND GRAB BARS AT TIME OF CONSTRUCTION.
- . ALL UNDIMENSIONED DOORS TO BE CENTERED OR 4" OFF
- . ALL UNDESIGNATED DIMENSIONED WALLS TO BE 3 1/2"
- 6. SEE ELECTRICAL DRAWINGS FOR ELECTRICAL LAYOUTS.
- REFER TO INTERIOR FINISH PLANS & LEGEND FOR ALL
- UNIT INTERIORS.
- DIMENSIONS ARE TO FACE OF STUD UNLESS OTHERWISE
- CORRIDOR WALLS AT UNIT AND DEMISING WALLS BETWEEN UNITS SHALL BE TREATED AS SOUND RATED



PROJECT TITLE

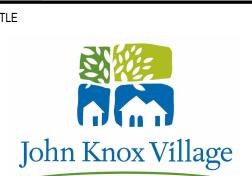


COURTYARDS - BUILDING E

SFCS Inc. • 1927 South Tryon St. - Suite 207 Charlotte, North Carolina 28203.4633

704.372.7327 • Fax 704.372.7369 www.sfcs.com DESIGNER : DAS

ARCHITECT : DAS CHECKED : AAT APPROVED : CRJ REVISION DESCRIPTION Rev 1 - Permit Comments 02/15/24

DRAWING TITLE ENLARGED PLANS

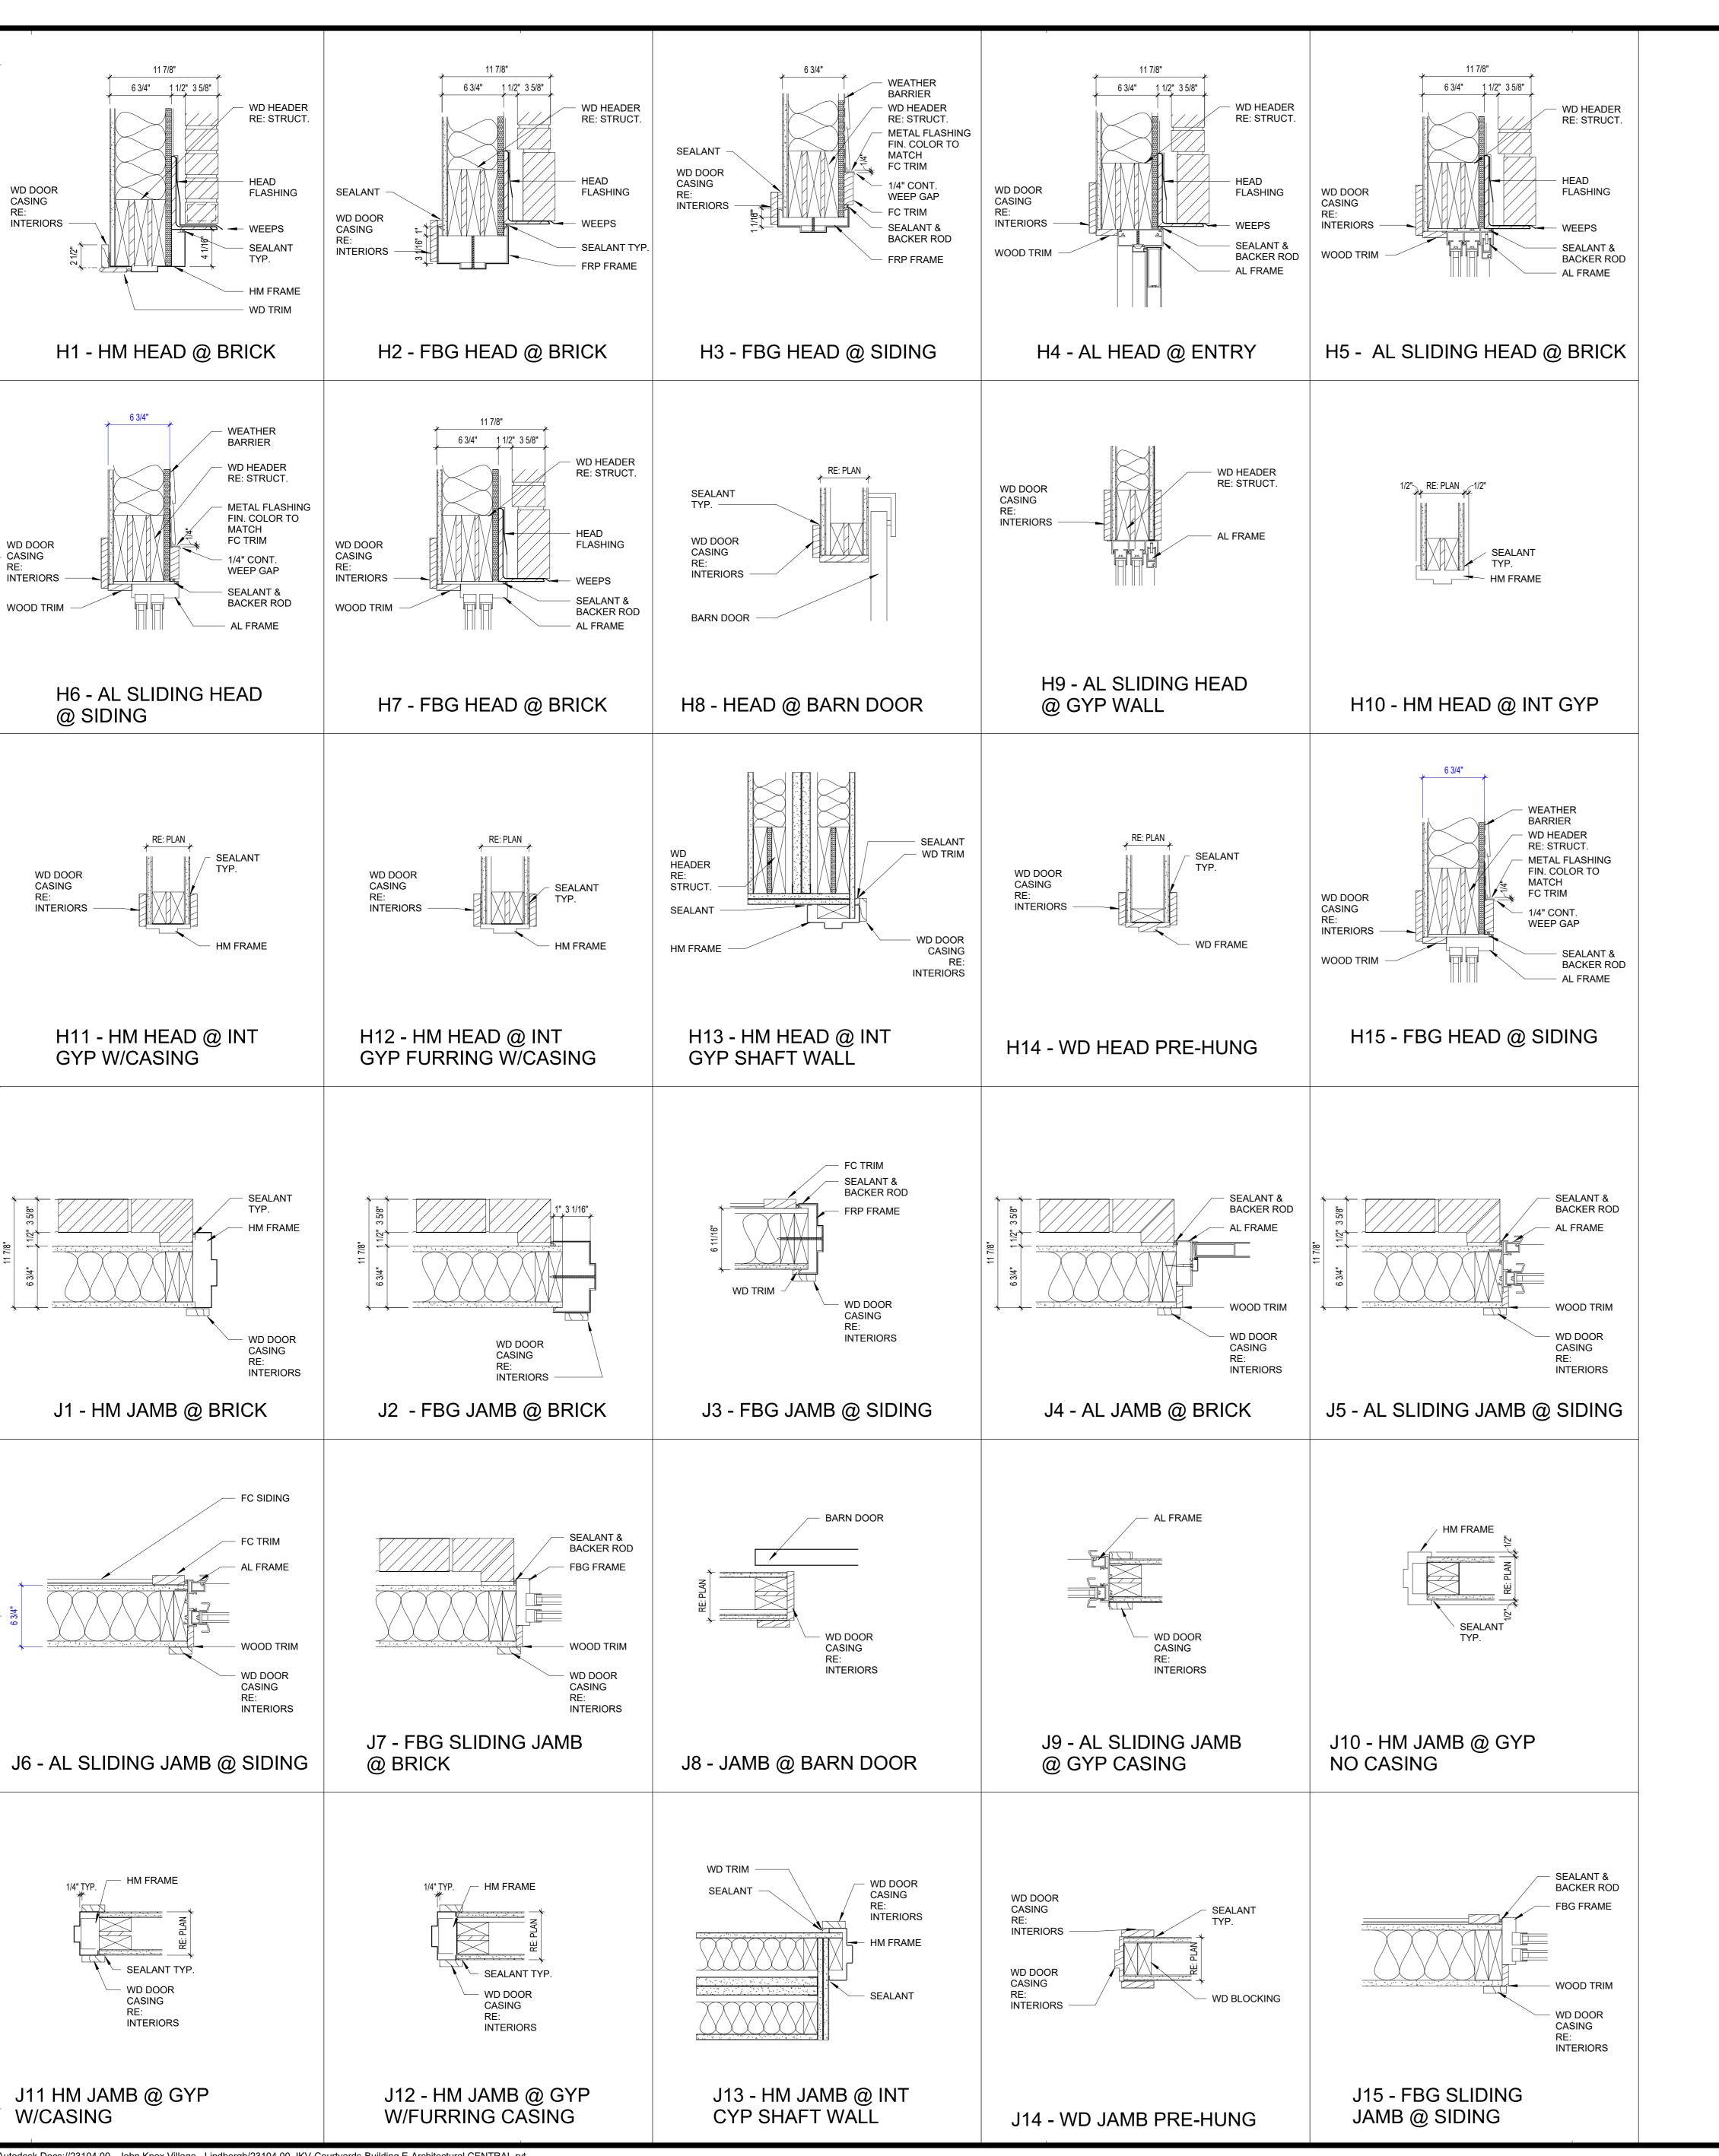

		D	OOR		DOO		FRAME		<b></b>	HARDWA		1.	DOORS ARE TO BE INSTALLED SO THE BACK OF THE
ROOM	ELEV	TYPE	WIDTH	HEIGHT	FIRE RATING	ELEV	HEAD	JAMB	LOCK	CLOS	ACCESS CNTRL	Comments	TO FACE OF WALL AT INSIDE CORNER, UNLESS NOTE
102	F	WD	3' - 0"	6' - 8"	20 MIN	1	H12	J12	2	X		,	
104A	FG FG	AL	6' - 0"	7' - 0"		2	H6	J6	8		}	Integrated with Smoke Control System	
104B	FG	AL	6' - 0"	7' - 0"		2	H9	J9	8		x {	Integrated with Smoke Control	
107A	F	HM	3' - 0"	7' - 0"		2	H1	J1	7	X		System	
107B	FG_	HM	3' - 0"		90 MIN	1	H13	J13	6	^	^	un mariant	
108A	FG	AL	6' - 0"	7' - 0"		2	H1	J1	8	X			
108B 113	F	AL HM	6' - 0" (2) 3' - 0"	7' - 0" 6' - 8"	90 MIN	3	H9 H13	J9 J13	8 5	X	X		
115	F	WD	3' - 0"	6' - 8"	20 MIN	1	H12	J12					
117	F	WD	3' - 0"	6' - 8"	20 MIN	1	H12	J12	10 <u>2</u>				
118 120	F FG	WD WD	3' - 0"			1	H10 H11	J10 J11	(11A)	X			
125	FG	AL	3' - 0"_	7' - 0"		2	H4	J4	9		Х		
126	F	WD			20 MIN	1	H12	J12	2	X			
127 128A	F	WD HM	3' - 0"	6' - 8" 7' - 0"		1	H10 H1	J10 J1	7	X	Х		
128B	F	HM	3' - 0"		90 MIN	1	H12	J12	6	X			
129	F	WD	3' - 0"		20 MIN	1	H12	J12	2	X			
136 202	F F	WD WD	3' - 0" 3' - 0"		45 MIN 20 MIN	1 1	H12	J12 J12	10	X			
205	F_	WD	3' - 0"	6' - 8"	20 MIN	1	H12	J12	1	X			
206 207	F	WD HM	(2) 3' - 0"	6' - 8" 6' - 8"	90 MIN	1	H8 H13	J8	11 6	X			
207	F	WD	3' - 0"		90 MIN 20 MIN	1	H13	J13 J12	2	X			
213	F	HM	(2) 3' - 0"	6' - 8"	90 MIN	3	H13	J13	5	X			
215	F F	WD	3' - 0" 3' - 0"		20 MINI	1	H12	J12	10	V			
217 218	F	WD WD	3' - 0"		20 MIN	1 1	H12 H10	J12 J10	10	X			
226	F	WD	3' 0" 4' - 6"	6' - 8"	20 MIN	1	H12	J12	2	X			
227 228	F	WD HM	3' - 0"	6' - 8"	90 MIN	1	H10 H13	J10 J13	6	X			
229	F	WD	3' - 0"		20 MIN	1	H12	J12	2	X			
231	F	WD	3' - 0"	6' - 8"	20 MIN	1	H12	J12	2	Х			
236 302	F F	WD WD	3' - 0" 3' - 0"		20 MIN 20 MIN	1 1	H12	J12 J12	2	X			
305	F	WD	3' - 0"		20 MIN	1	H12	J12	10	X			
307	F	HM	3' - 0"		90 MIN	1	H13	J13	6	X			
308 313	F F	WD HM	3' - 0" (2) 3' - 0"	_	90 MIN 90 MIN	3	H13	J13 J13	10 5	X			
315	F	WD	3' - 0"		20 MIN	1	H12	J12	10	X			
317	F	WD	3' - 0"		20 MIN	1	H12	J12	10	X			
318 326	F	WD	3' - 0" 2' - 6"		20 MIN	1	H10 H12	J10 J12	10	X			
327	<u></u> -	WD	4' - 6"_	6' - 8"	20 101114	1	H10	J10	4				
328	F	HM	3' - 0"		90 MIN	1	H13	J13	6	X			
329 331	F F	WD WD	3' - 0" 3' - 0"		20 MIN 20 MIN	1 1	H12	J12 J12	2 2	X			
336	F	WD	3' - 0"	6' - 8"	20 MIN	1	H12	J12	1	X			
402 405	F	WD WD	3' - 0" 3' - 0"		20 MIN 20 MIN	1	H12	J12 J12	3	X			
406	F	WD	(2) 3' - 0"		20 IVIIIN	1	H8	J8	11	^			
407	F	HM	3' - 0"	6' - 8"	90 MIN	1	H13	J13	6	X			
408 409	F F	WD WD	3' - 0" 3' - 0"		20 MIN 20 MIN	1	H12	J12 J12	3	X			
413	F	HM	(2) 3' - 0"		90 MIN	1	H13	J13	5	X			
415	F	WD	3' - 0"	6' - 8"	20 MIN	1	H12	J12	10	X			
417 418	F F	WD WD	3' - 0" 		20 MIN	1	H12 H10	J12 J10	10	X			
426	F F	WD	3' - 0"		20 MIN	1	H10	J12	2	X			
427		WD		6' - 8"			H10	J10	4				
428 429	F F	HM WD	3' - 0" 3' - 0"		90 MIN 20 MIN	1	H13 H12	J13 J12	6 2	X			
431	F	WD	3' - 0"		20 MIN	1	H12	J12	2	X			
436	F	WD	3' - 0"		20 MIN	1	H12	J12	1	X			
B1 B2	F FG	HM HM	3' - 0" 		90 MIN 90 MIN	1 1	H13	J13	6	X			
В3	FG F	HM	3' - 0"_ 3' - 0"		90 MIN	1	H13	J13	6	X			
B21		AL	<u> </u>	7' - 0"	00.100		H4	J4	9	X			
C1 C2	F F	HM HM	3' - 0" 3' - 0"		90 MIN 90 MIN	1 1	H13	J13 J13	6	X			
C3	F	HM	3' - 0"		90 MIN	1	H13	J13	6	X			
IARK TY	YPE MATE		OOR DTH PAIR	R HEIGHT	FIRE RATING	ELEV	FRAME HEAD	JAMB	HW SET		C	OMMENTS	
U1 PD				6'-8"	20 MIN		H12	J12	12				
U2 FG	G-1 FBC	G 3'-0'	)"	6'-8"			H2/H3	J2/J3	16	EXTERIO	R - INTEGRAL	BLINDS	
U3 PC				6'-8" 6'-8"			H14 H7/H15	J14 J7/J15	15 20	EXTERIO	R - INTEGRAL	BLINDS	
U5 PD	D-1 DF	2'-10	0"	6'-8"			H14	J14	13				
	D-1 DF		R 2'-6"	6'-8"			H14	J14	14				
	D-1 DF D-1 DF		R 2'-0" R 1'-9"	6'-8" 6'-8"			H14 H14	J14 J14	14 21				
	יום ו ו-עי					_							
U8 PC		2'-0'		6'-8" 6'-8"			H14 H14	J14 J14	13 17				

FIBERGLASS DOORS BASIS OF DESIGN - JELD WEN DESIGN-PRO SERIES

PERMIT SET CURTIS R. JENNINGS III NUMBER A-2023034555

PROJECT TITLE




COURTYARDS - BUILDING E

SFCS Inc. • 1927 South Tryon St. - Suite 207 Charlotte, North Carolina 28203.4633

704.372.7327 • Fax 704.372.7369 www.sfcs.com DESIGNER : DAS ARCHITECT : DAS CHECKED : AAT APPROVED : CRJ REVISION DESCRIPTION

Rev 1 - Permit Comments 02/15/24

DOOR SCHEDULE

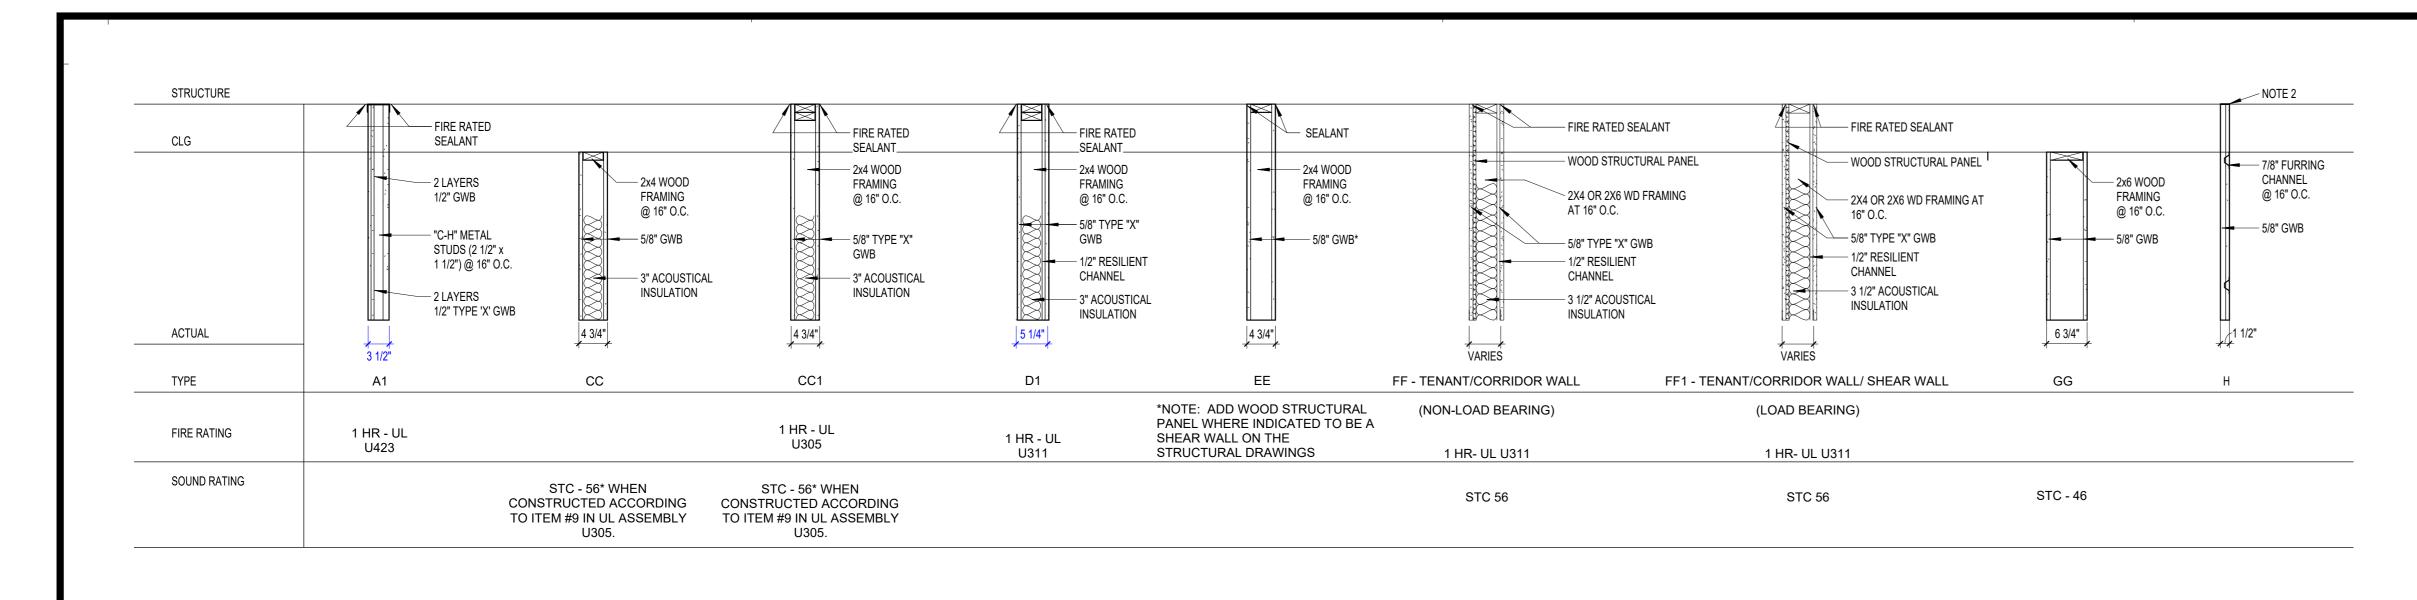

STRUCTURE							3/4"3/4" ***	
CLG	SEALANT  SEALANT  SEALANT  STATE OF THE PROPERTY OF THE PROPER		11	N-71	FIRE RATED SEALANT	FIRE RATED SEALANT_		FIRE RATED SEALANT
ACTUAL	2X6 WD FRAMING AT 16" O.C.  1/2" RESILIENT CHANNEL  3 1/2" ACOUSTICAL INSULATION  WOOD STRUCTURAL PANEL	2x4 WOOD FRAMING @ 16" O.C. 	2x6 WOOD FRAMING @ 16" O.C. WITH 2X4 FRAMING 	2x4 WOOD FRAMING @ 16" O.C. 5/8" GWB 3" ACOUSTICAL INSULATION	2x4 WOOD FRAMING @ 16" O.C.  5/8" TYPE "X" GWB  3" ACOUSTICAL INSULATION	2x6 WOOD FRAMING @ 16" O.C. 5/8" TYPE "X" GWB	3/4" AIRSPACE  2 LAYERS OF 1" GYPSUM SHAFT LINER WITH ATTACHMENT CLIPS  2X4 WD FRAMING AT 16" O.C.  5/8" TYPE "X" GWB	8" CMU LOOSE FILL INSULATION
TYPE	HH - CORRIDOR (NON-LOAD BEARING)	JJ	К	LL	MM2	NN2	PP1 (LOAD BEARING)	W
FIRE RATING	-		1 HR		1 HR - UL U311	1 HR - UL U311	2 HR- UL U347	2 HR CMU UL U906
SOUND RATING	STC-50							

DESCRIPTION

ACCESSIBLE UNITS (SS = STAINLESS STEEL) - COUNTER-DEPTH

HSHSS STAINLESS STEEL

SJSS STAINLESS STEEL

SSNSS STAINLESS STEEL

SLSS STAINLESS STEEL

SLSS STAINLESS STEEL

SJSS STAINLESS STEEL

WHITE SEE UNIT PLANS FOR LOCATION

ACCESSIBLE UNITS (SS = STAINLESS STEEL)

SSNWW WHITE SEE UNIT PLANS FOR LOCATION

SSNWW WHITE SEE UNIT PLANS FOR LOCATION

GWB SHALL BE ACOUSTICALLY SEALED TO STRUCTURE AT SOUND RATED PARTITIONS. APPLY SEALANT AROUND ALL CUT OUTS IN GWB WALL. CAULK SIDES AND BACK OF ELECTRICAL NOTE 4: PROVIDE DEEP LEG TOP TRACK RUNNERS FOR MINIMUM 5/8" DEFLECTION GAP. NOTE 5: DESIGNATED STC RATINGS APPLY TO SOUND RATED PARTITIONS.

PARTITIIONS TYPES3/4" = 1'-0"

APPLIANCE SCHEDULE

REFRIGERATOR

DISHWASHER

WASHER DRYER

REFRIGERATOR

DISHWASHER

**MICROWAVE** 

GARBAGE DISPOSAL

NOT USED

ITEM

UNDERCOUNTER REFRIGERATOR

UNDER THE CABINET HOOD

MARK

P3

P5

P7

P9

P10

P12


P13 DRYER

PARTITION NOTES:

NOTE 1: SOUND RATING WHERE NOTED ON PLANS.

LINE OF SUBSTRATE.

ЛІ Е.		DITE				
JILE	T ACCESSORY SCHE	DOLE			1	T
ARK	ITEM	MODEL #/FIN	MANUF	MT.HT.	SIZE	REMARKS
1	TOILET PAPER HOLDER	YB5408BN	MOEN: KINGSLEY SERIES/BRUSHED NICKEL	CENTERLINE AT 21" AFF		TO BE INSTALLED IN ALL RESIDENT UNIT TOILETS
2	TOILET PAPER DISPENSER	56798	GEORGIA PACIFIC	CENTERLINE AT 19" AFF		TO BE INSTALLED IN ALL PUBLIC TOILETS
3	VERTICAL GRAB BAR	YG5418BN	MOEN: KINGSLEY SERIES/BRUSHED NICKEL	BOTTOM AT 41" AFF	18"	PROVIDE BLOCKING ALL UNITS AND INSTALL WHERE NOTED IN CUSTOMIZATION
4	GRAB BAR	YG5436BN	MOEN: KINGSLEY SERIES/BRUSHED NICKEL	TOP AT 36" AFF	36"	PROVIDE BLOCKING ALL UNITS AND INSTALL WHERE NOTED IN CUSTOMIZATION
5	GRAB BAR	YG5442BN	MOEN: KINGSLEY SERIES/BRUSHED NICKEL	TOP AT 36" AFF	42"	PROVIDE BLOCKING ALL UNITS AND INSTALL WHERE NOTED IN CUSTOMIZATION
6	VERTICAL GRAB BAR	B-6806X18	BOBRICK/SATIN FINISH	BOTTOM AT 41" AFF	18"	INSTALL AT ALL UNIT MASTER BATH SHOWERS
7	GRAB BAR	B-6806X36	BOBRICK/SATIN FINISH	TOP AT 36" AFF	36"	PROVIDE BLOCKING/TO BE INSTALLED IN ALL PUBLIC TOILETS
8	GRAB BAR	B-6806X42	BOBRICK/SATIN FINISH	TOP AT 36" AFF	42"	PROVIDE BLOCKING/TO BE INSTALLED IN ALL PUBLIC TOILETS
9	COMBINATION GRAB BAR	CUSTOM-SEE PLAN	BY SHOWER MANUFACTURER	TOP AT 36" @ SHOWER FF		INSTALL AT ALL UNIT MASTER BATH SHOWERS
0	TOWEL RING	YB5486BN	MOEN: KINGSLEY SERIES/BRUSHED NICKEL	CENTERLINE AT 50" AFF		PROVIDE BLOCKING/TO BE INSTALLED IN ALL RESIDENT UNIT TOILETS
1	TOWEL BAR	YG5424BN	MOEN: KINGSLEY SERIES/BRUSHED NICKEL	CENTERLINE AT 46" AFF	24"	PROVIDE BLOCKING/TO BE INSTALLED IN ALL RESIDENT UNIT TOILETS
2	MIRROR	CUSTOM	GUARDIAN INDUSTRIES W/ 2" FLAT STOCK FRAME	MIRROR BOTTOM AT 40" AFF	36"W X 38" H	MIRROR BOTTOM AT 38" AFF IN ACCESSIBLE UNITS
3	MIRROR	CUSTOM	GUARDIAN INDUSTRIES W/ 2" FLAT STOCK FRAME	MIRROR BOTTOM AT 40" AFF	44"W X 38" H	MIRROR BOTTOM AT 38" AFF IN ACCESSIBLE UNITS
4	MIRROR	CUSTOM	GUARDIAN INDUSTRIES W/ 2" FLAT STOCK FRAME	MIRROR BOTTOM AT 40" AFF	48"W X 38" H	MIRROR BOTTOM AT 38" AFF IN ACCESSIBLE UNITS
5	MIRROR	CUSTOM	GUARDIAN INDUSTRIES W/ 2" FLAT STOCK FRAME	MIRROR BOTTOM AT 40" AFF	72"W X 38" H	MIRROR BOTTOM AT 38" AFF IN ACCESSIBLE UNITS
6	SHOWER DOOR		SOUTHEASTERN ALUMINUM SLIDING BYPASS			FINISH 16 (ARCHITECTURAL) TO BE INSTALLED IN ALL RESIDENT UNIT SHOWERS
7	SOAP DISPENSER	52054	GEORGIA PACIFIC			TO BE INSTALLED IN ALL PUBLIC TOILETS
8	SANITARY NAPKIN DISPOSAL	B-270	BOBRICK/SATIN FINISH	TOP AT 30" AFF		PROVIDE BLOCKING/TO BE INSTALLED IN ALL WOMENS PUBLIC TOILETS AND UNI-SEX TOILETS
9	TOWEL DISPENSER/WASTE REC.	59451	GEORGIA PACIFIC	TOWEL DISPENSER AT 48" AFF		TO BE INSTALLED IN ALL PUBLIC TOILETS
20	CLOSET SHELF AND ROD	CLOSETMAID VINYL	COATED STEEL 12" DEPTH SHELF & ROD WIRE SHELF	CENTERLINE AT 66" AFF		PROVIDE BLOCKING/TO BE INSTALLED IN ALL RESIDENT UNITS. CENTERLINE AT 48" AFF AT ALL ACCESSIBLE UNI
21	CLOSET SHELF AND ROD	CLOSETMAID VINYL	COATED STEEL 8" DEPTH SHELF & ROD WIRE SHELF	CENTERLINE AT 66" AFF		PROVIDE BLOCKING/TO BE INSTALLED IN ALL RESIDENT UNITS. CENTERLINE AT 48" AFF AT ALL ACCESSIBLE UNI
22	DOUBLE ROBE HOOK	6727	BOBRICK/SATIN FINISH	CENTERLINE AT 48" AFF		TO BE INSTALLED IN ALL PUBLIC TOILETS
23	DOUBLE ROBE HOOK		LIBERTY HARDWARE WINDEMERE (STAINLESS)	CENTERLINE AT 66" AFF		PROVIDE BLOCKING/TO BE INSTALLED IN ALL RESIDENT UNITS. CENTERLINE AT 48" AFF AT ALL ACCESSIBLE UNI
24	FOLDING SHOWER SEAT	B-5191	BOBRICK/SATIN FINISH			TO BE INSTALLED IN BOTH ADA SHOWERS
25	FOLD DOWN GRAB BARS	3413-25	ASI			W/INTEGRAL TOILET PAPER HOLDER
26	SHOWERCURTAIN ROD	DN2160BN	MOEN/BRUSHED NICKEL	CENTERLINE AT 76" AFF		TO BE INSTALLED IN RESIDENT UNIT TUBS

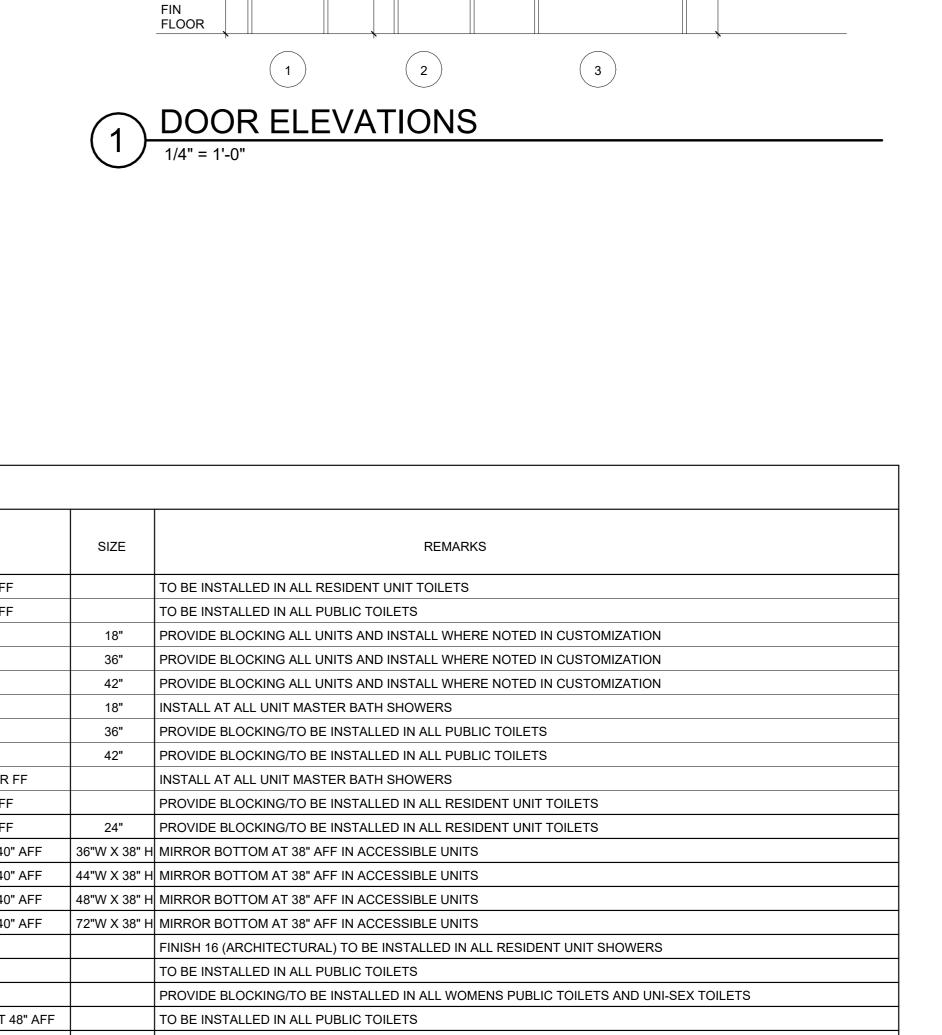

(FULL GLASS) (FG W/ SIMULATED DIVIDED LITES)

(NARROW VISION)

(HALF GLASS)

NOTE: ALL GLAZING IN FIXED AND OPERABLE

DOORS SHALL BE SAFETY GLAZING PER SECTION

(FLUSH)

PD (PANEL)

PD-1

PANELS OF

FIN **FLOOR** 

FIN FLOOR



PROJECT TITLE



COURTYARDS - BUILDING E

SFCS Inc. • 1927 South Tryon St. - Suite 207 Charlotte, North Carolina 28203.4633 704.372.7327 • Fax 704.372.7369

DESIGNER : DAS DRAWN DAS ARCHITECT : DAS CHECKED : AAT APPROVED : CRJ REVISION DESCRIPTION

www.sfcs.com

Rev 1 - Permit Comments 02/15/24

PARTITION TYPES, APPLIANCE SCH. & TOILET

ACCESSORY SCH.

APPLIANCE SCHEDULE

12" = 1'-0"

TOILET ACCESSORY SCHEDULE

12" = 1'-0"

2 HR FIREWALL

10:33:06 AM

MANUF

GENERAL ELECTRIC

MODEL#

GDF645

GFC530V

GCE06GSHSB

GZS22DSJSS

GLDA696F


PEM31

JVX3300

GFW550


GFD55E

WKE100H\_A/WKG101\_A

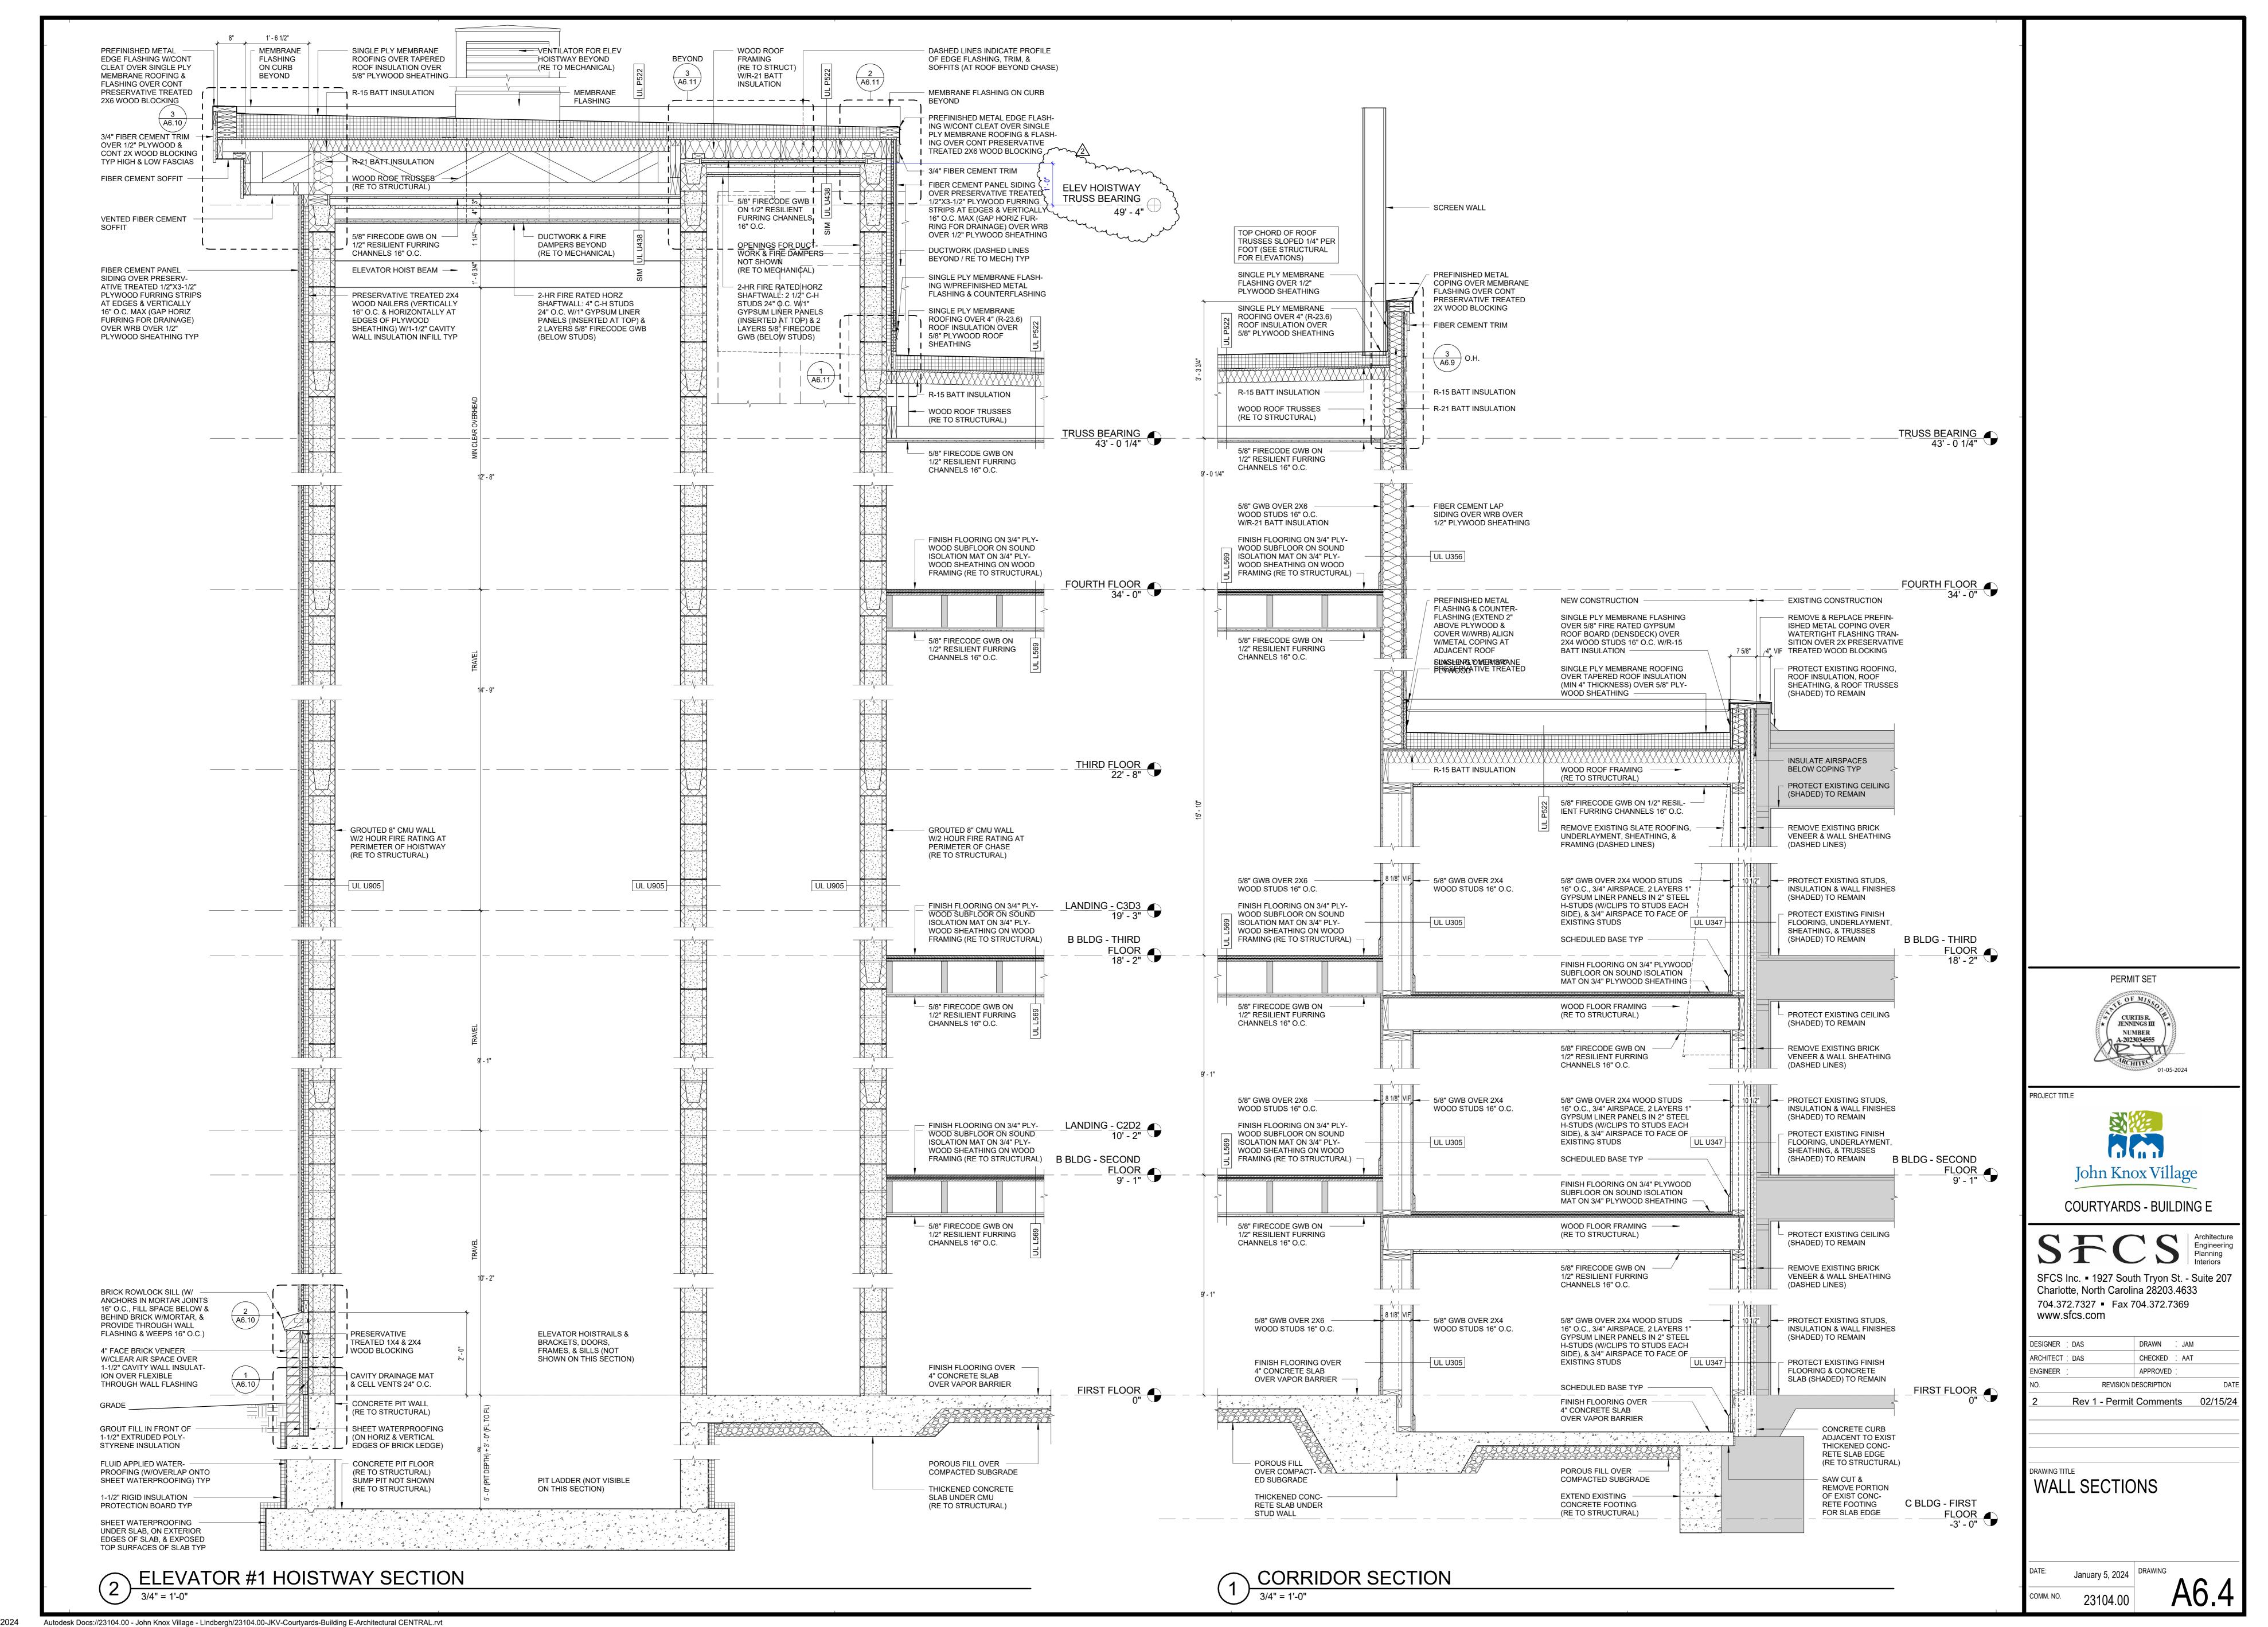



2/15/2024


5:51:30 PM

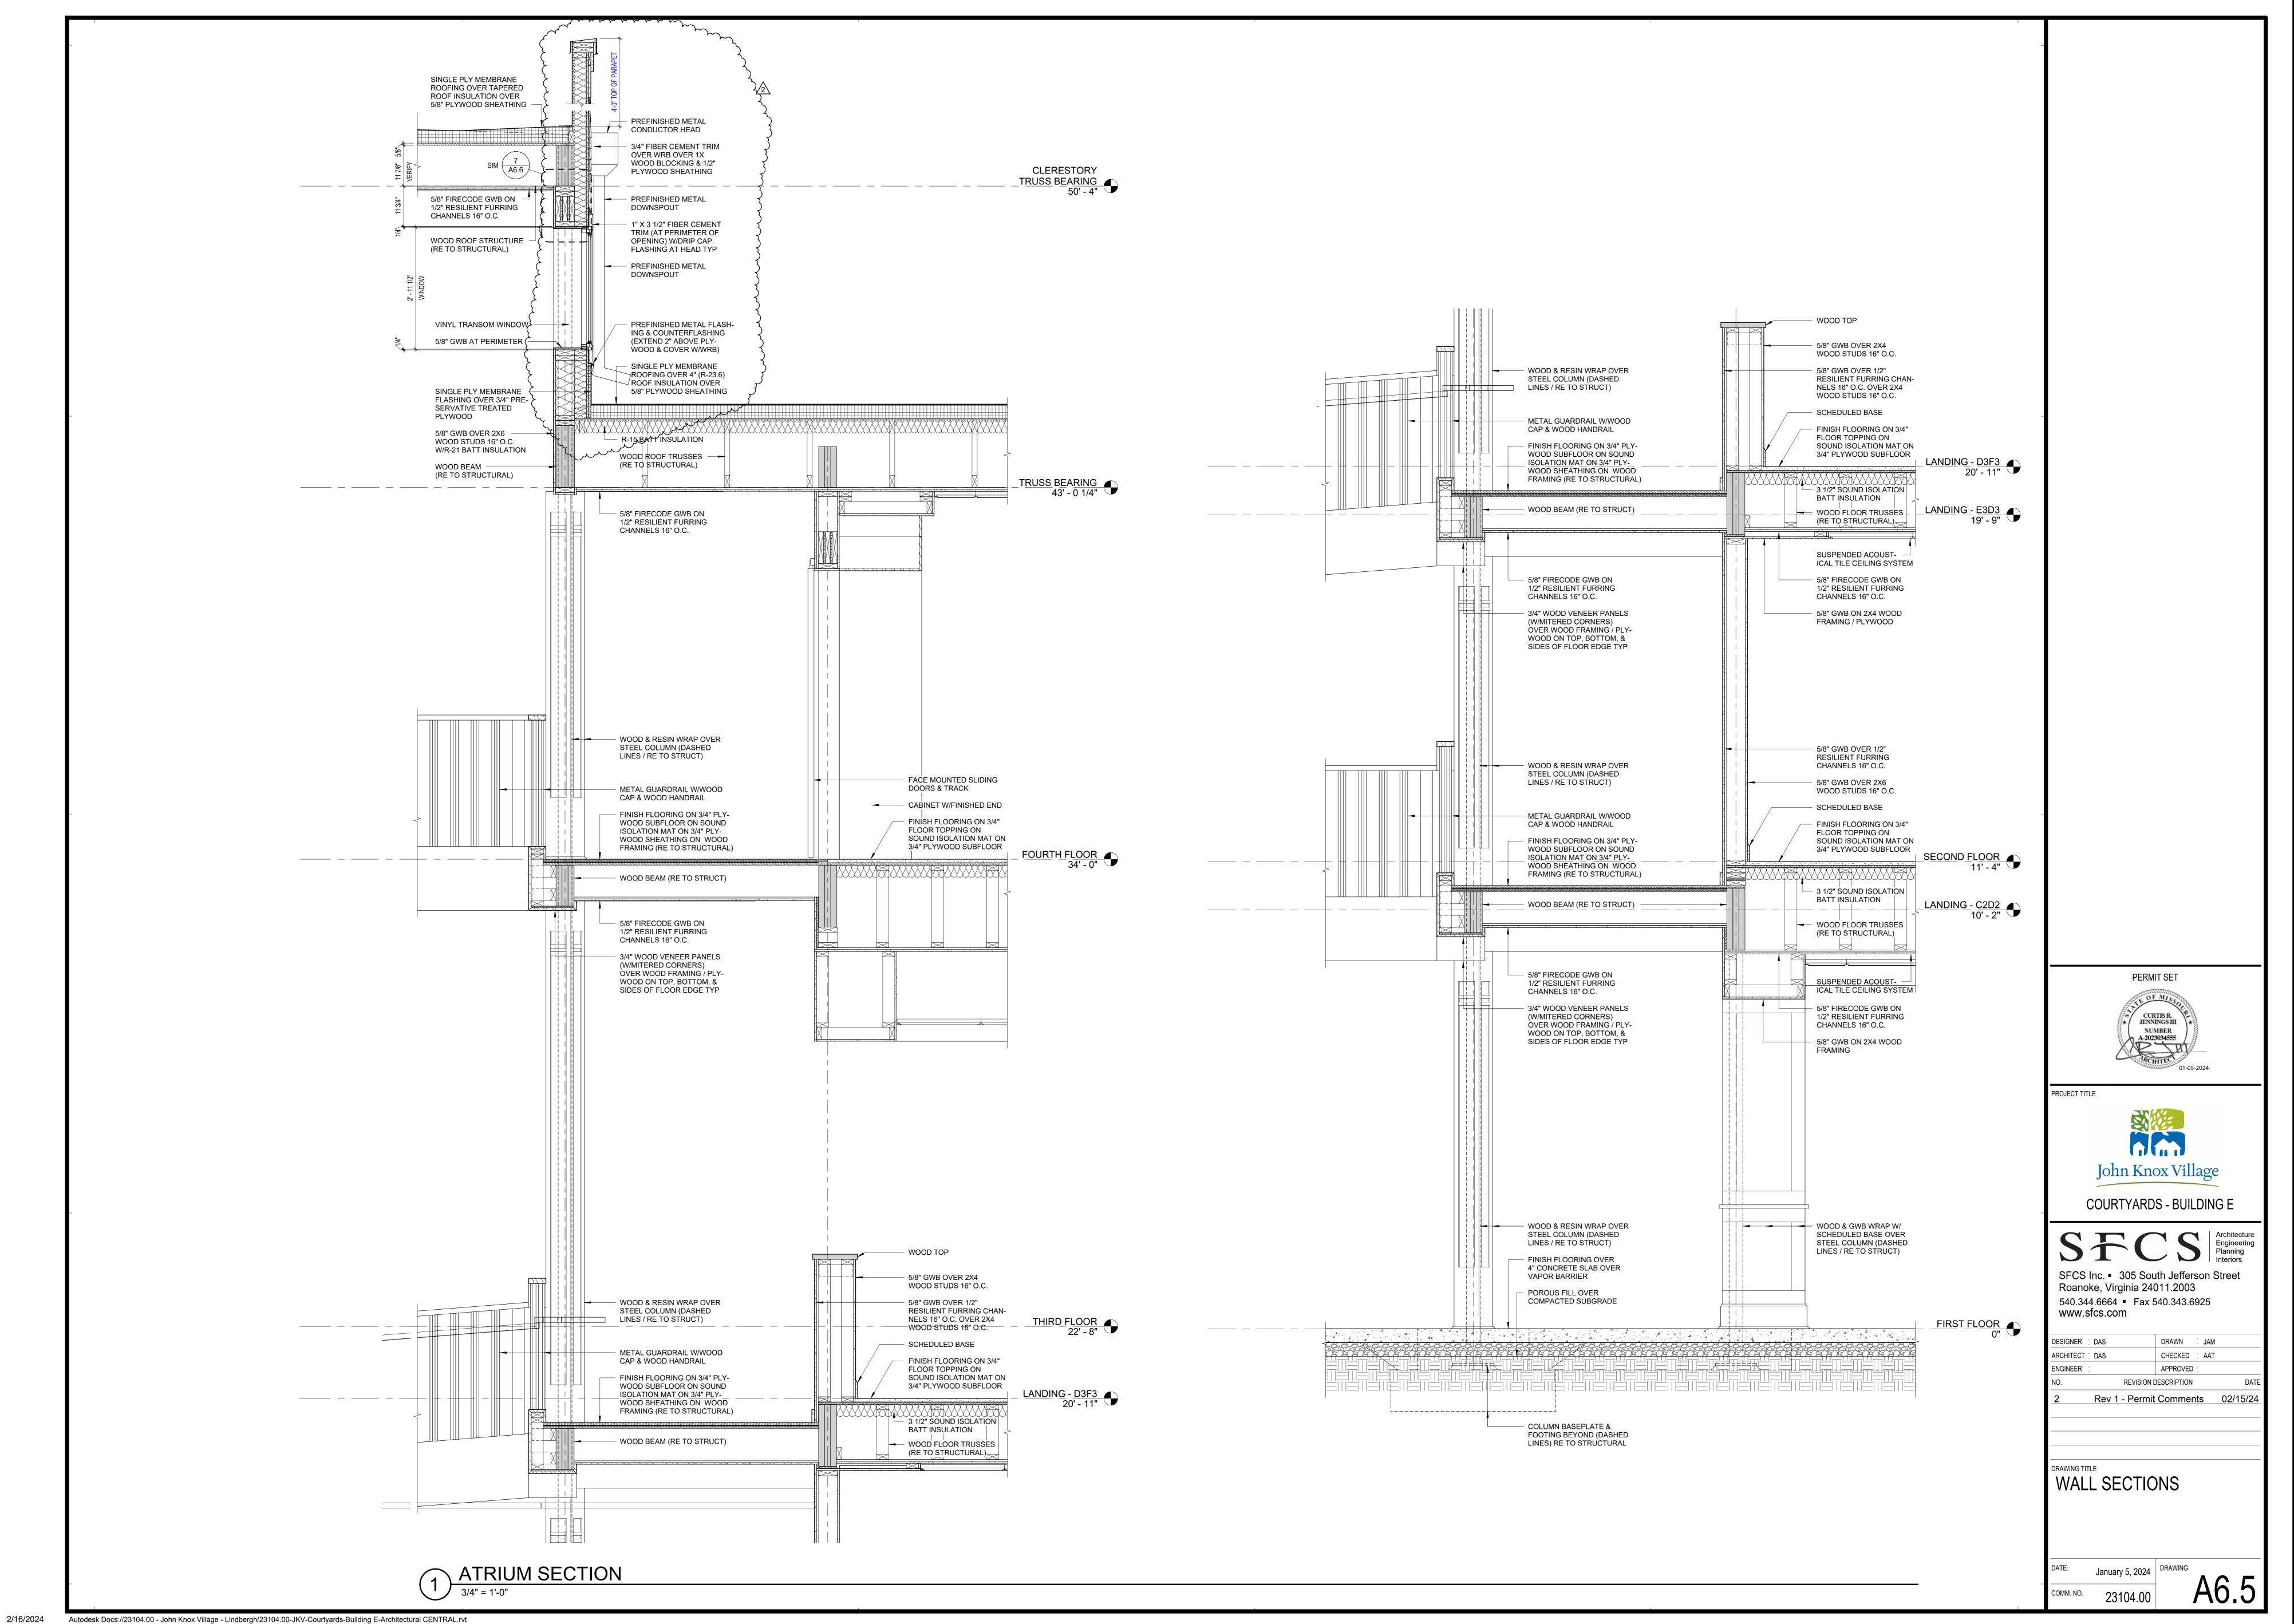



1:31:19 PM

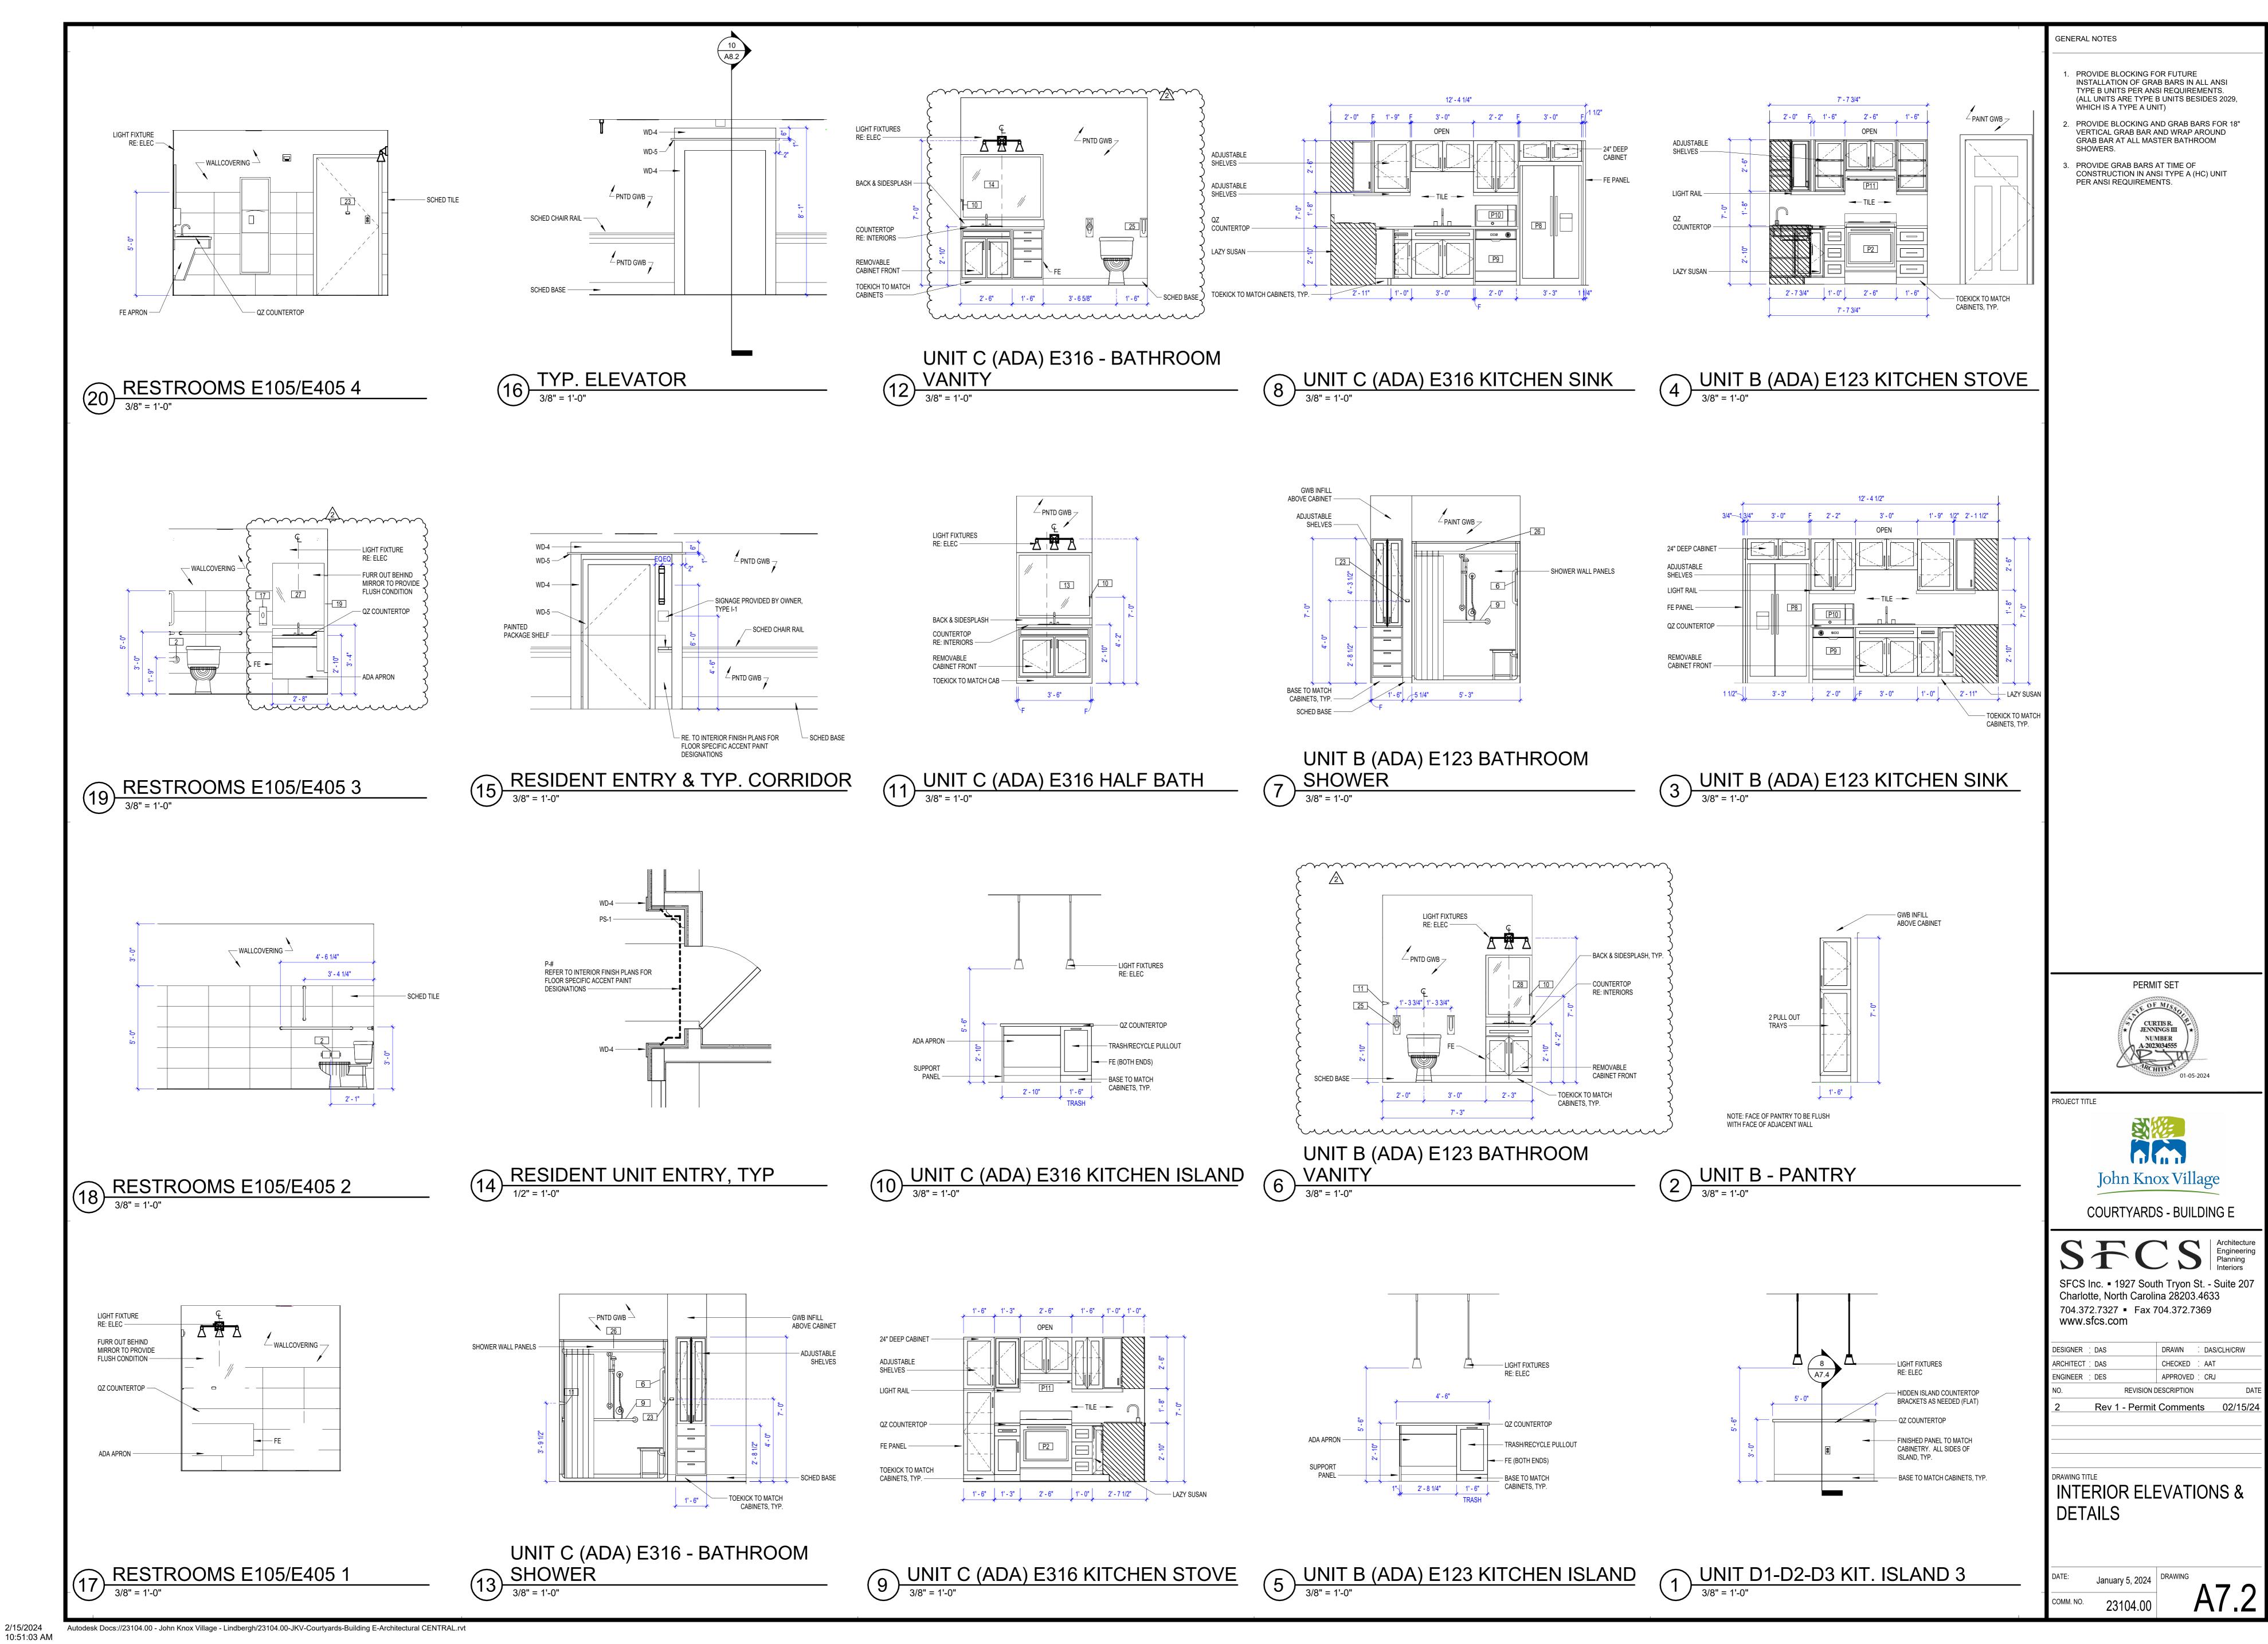

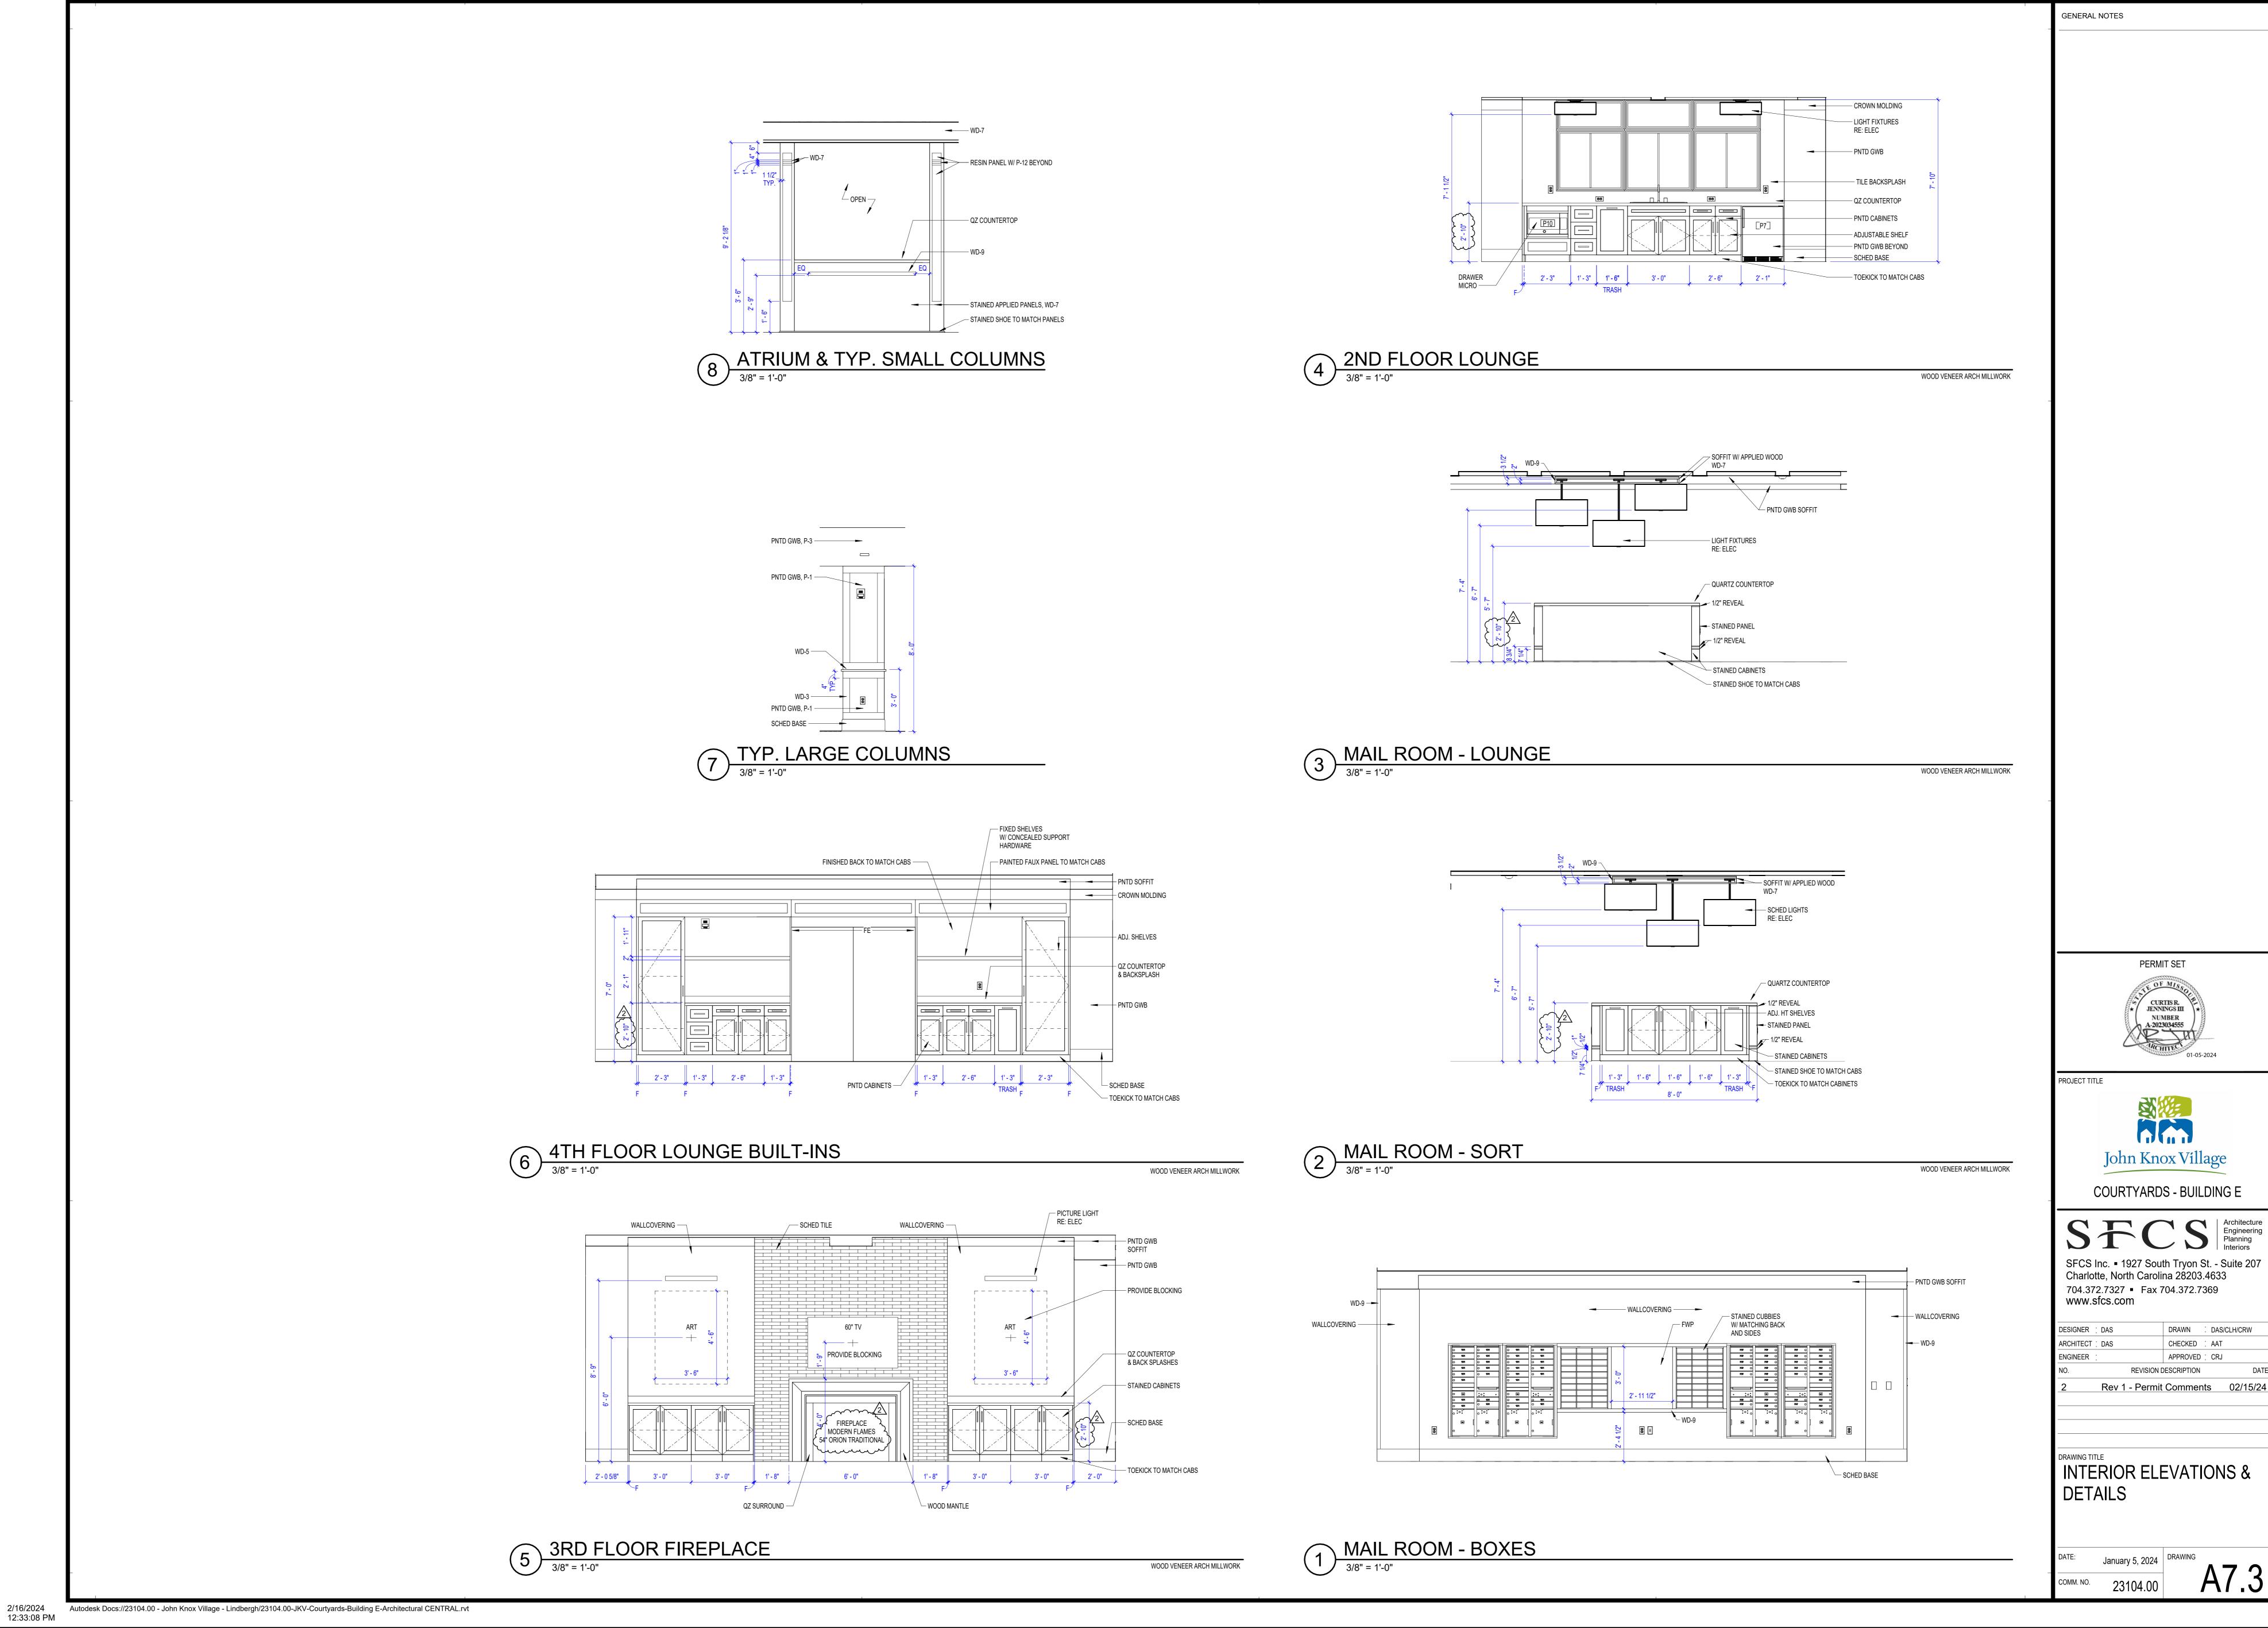

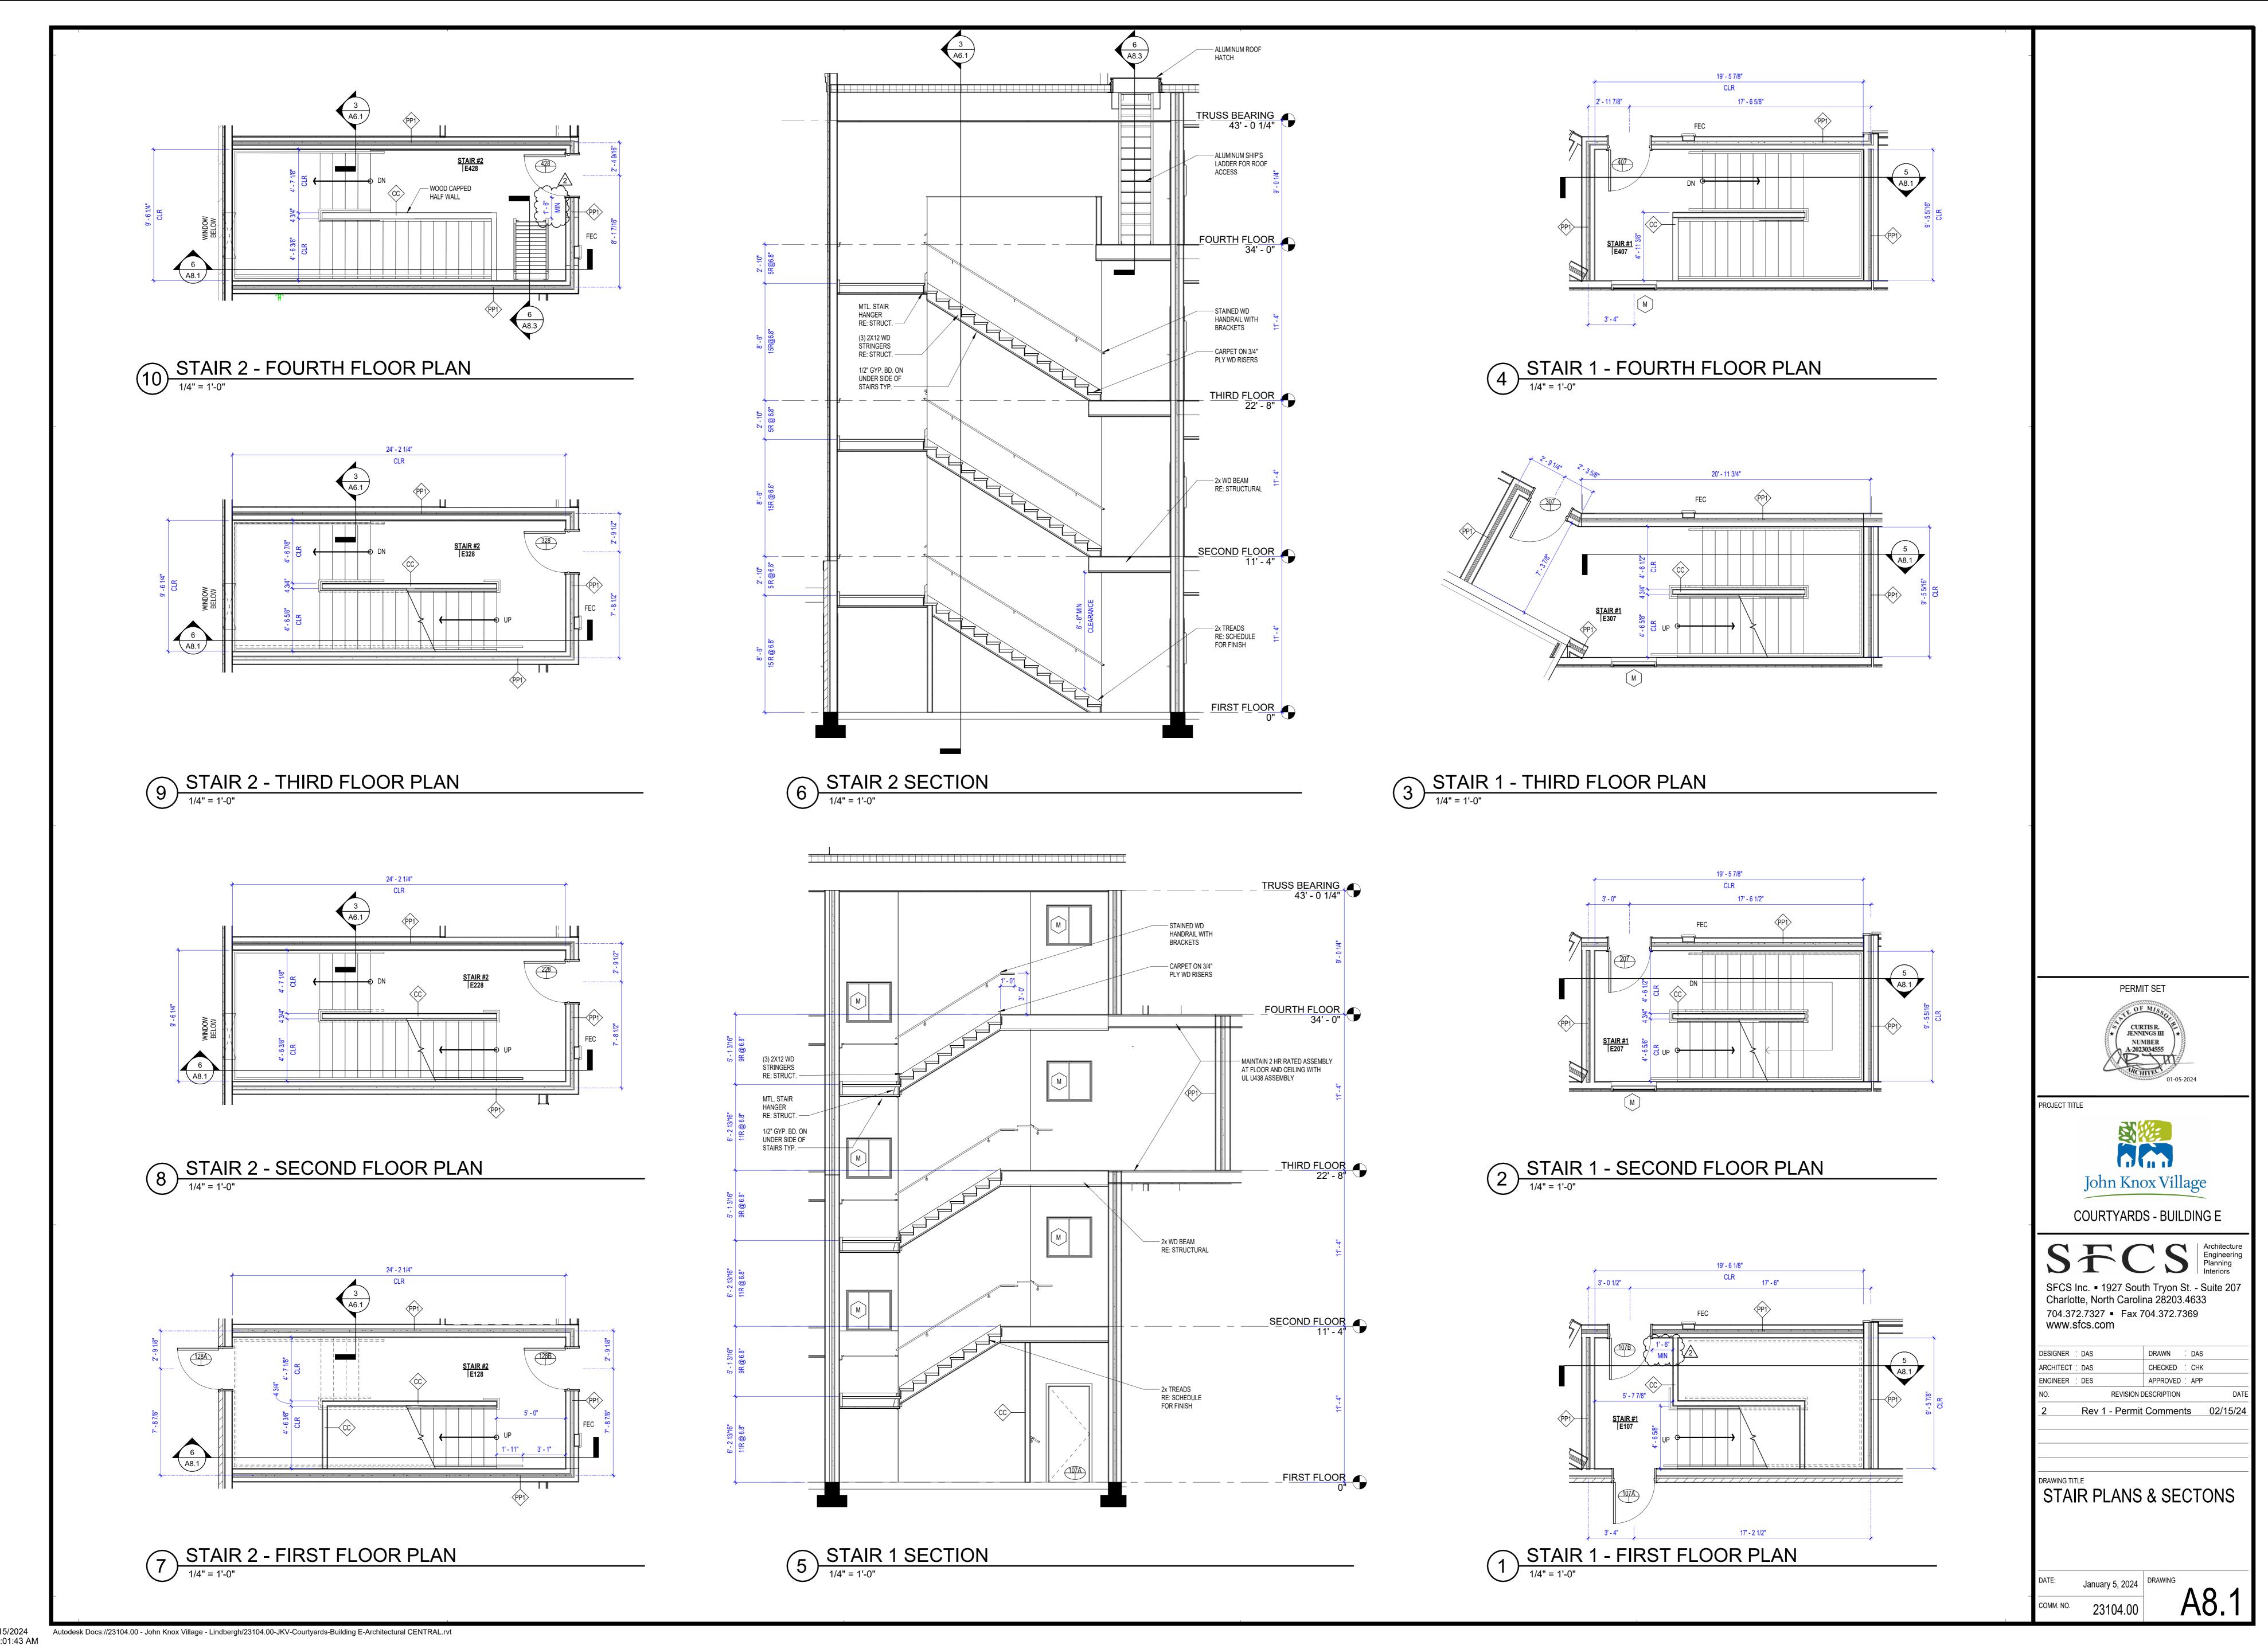

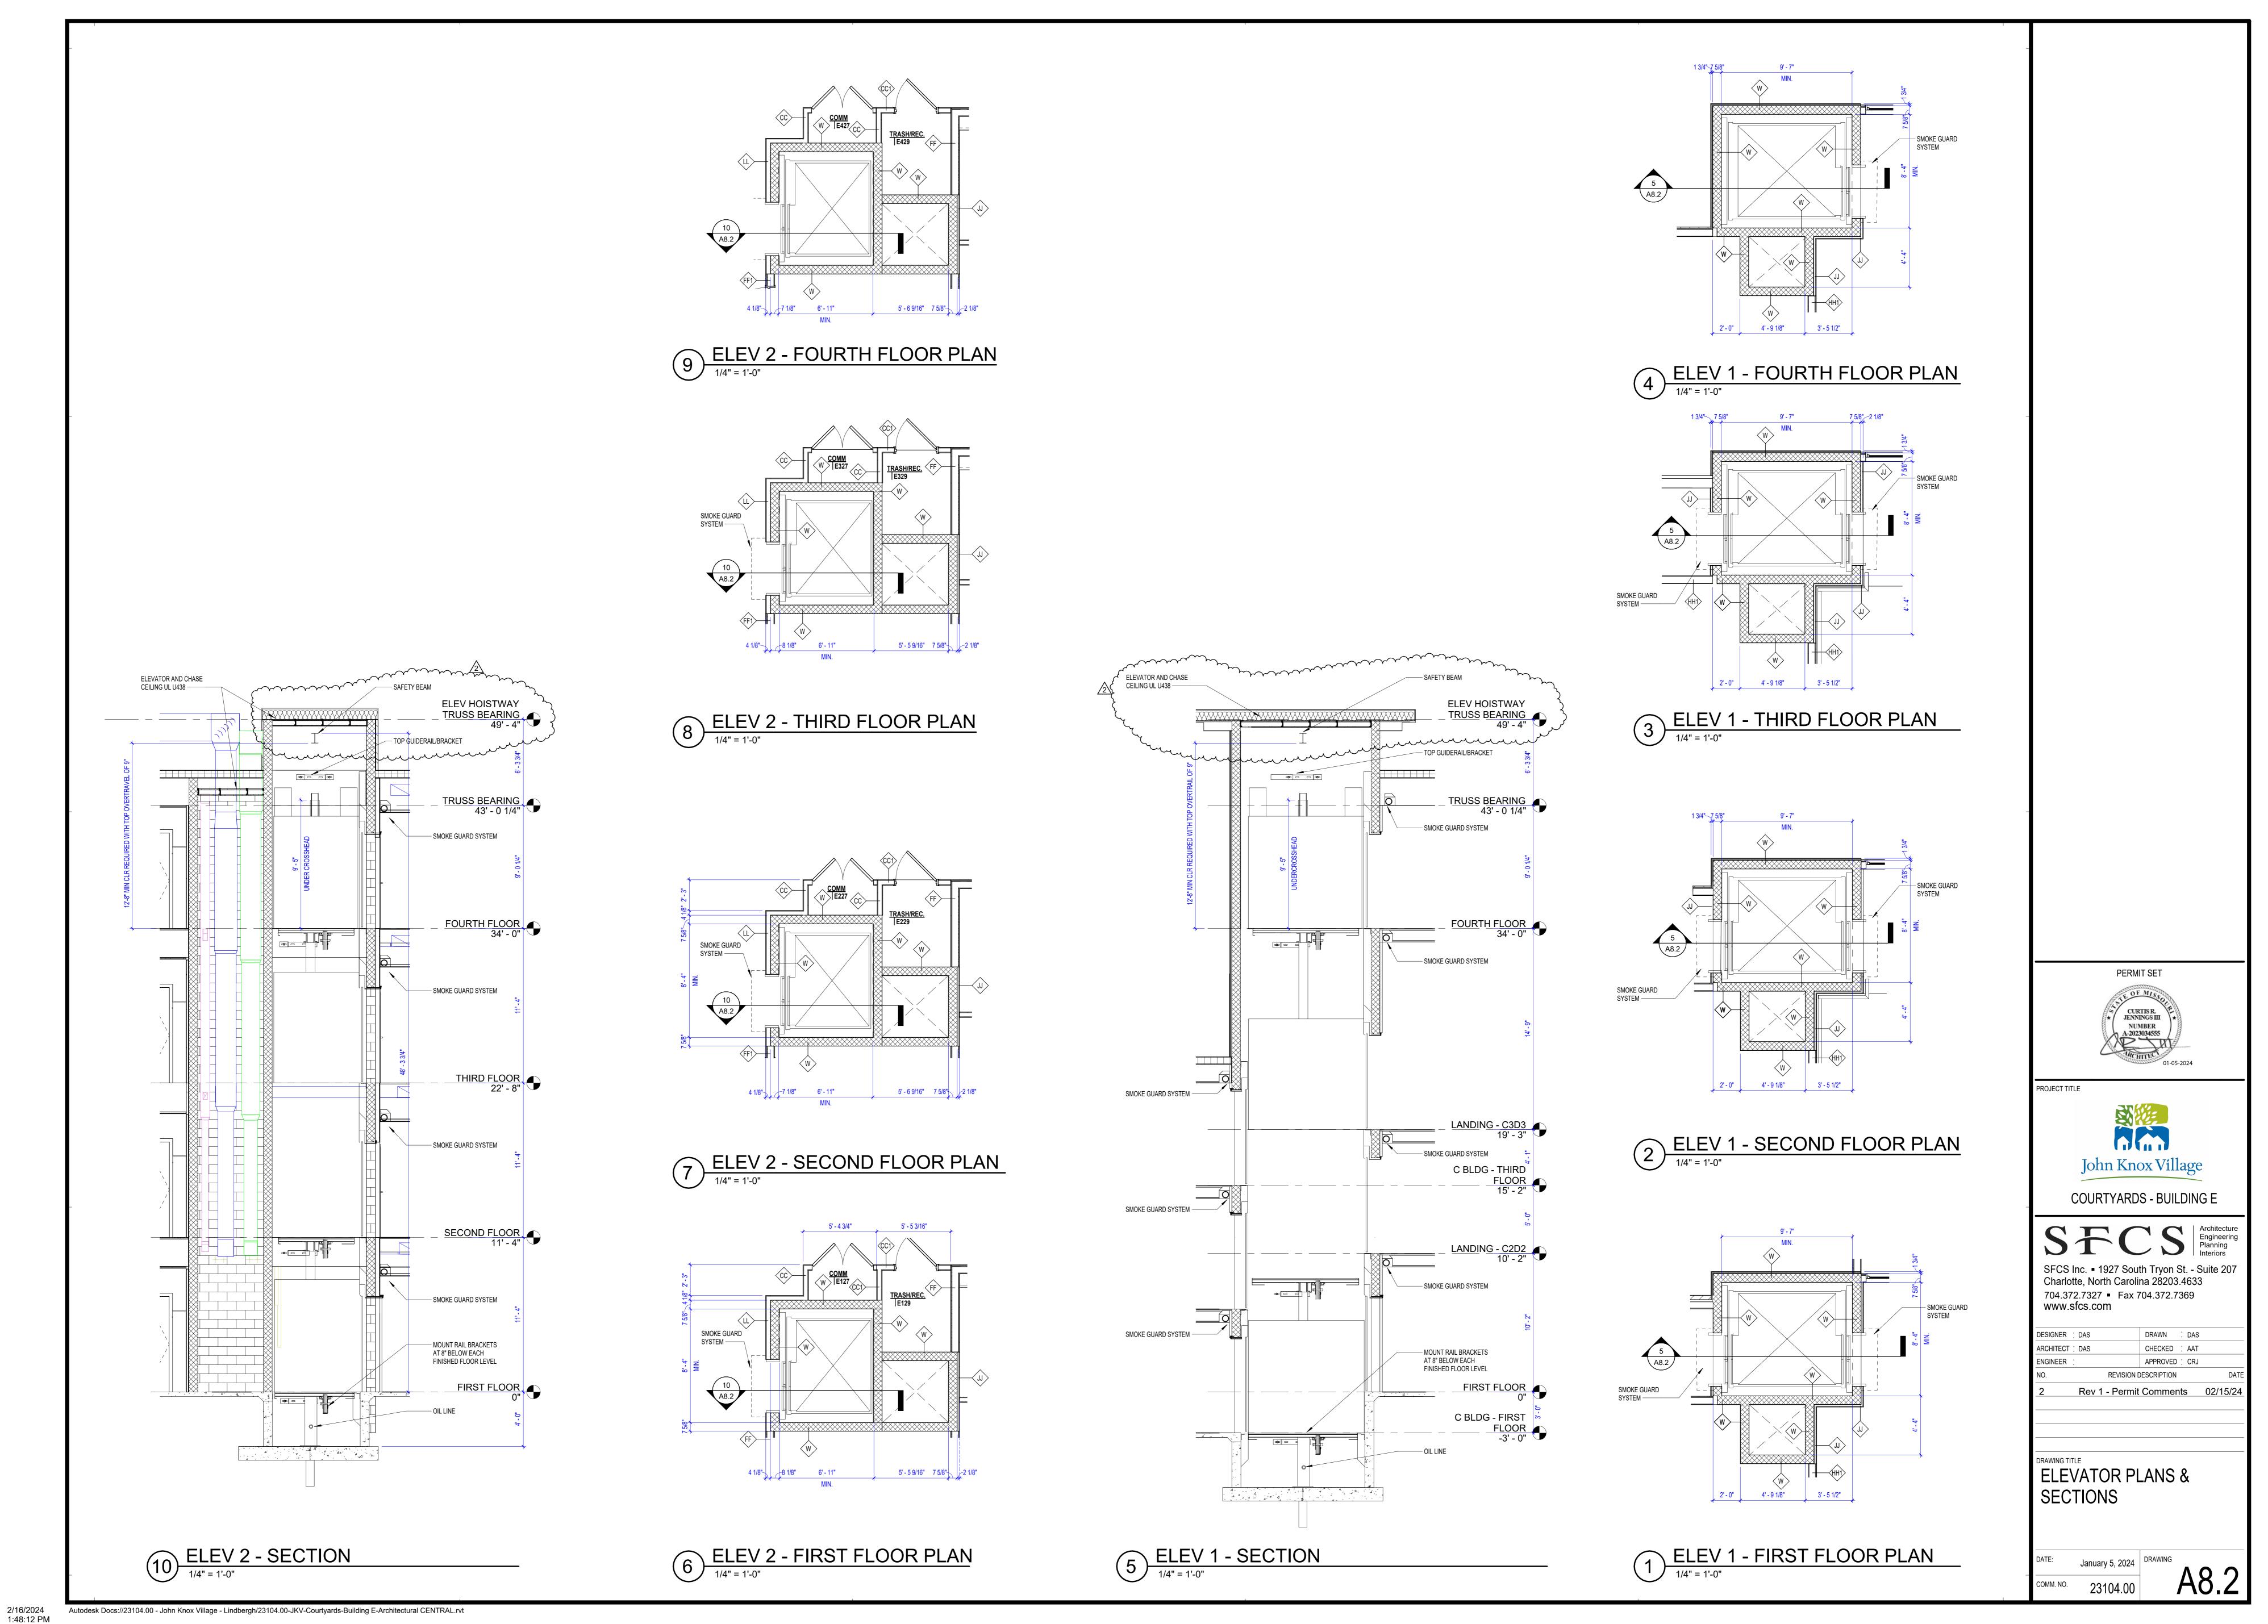

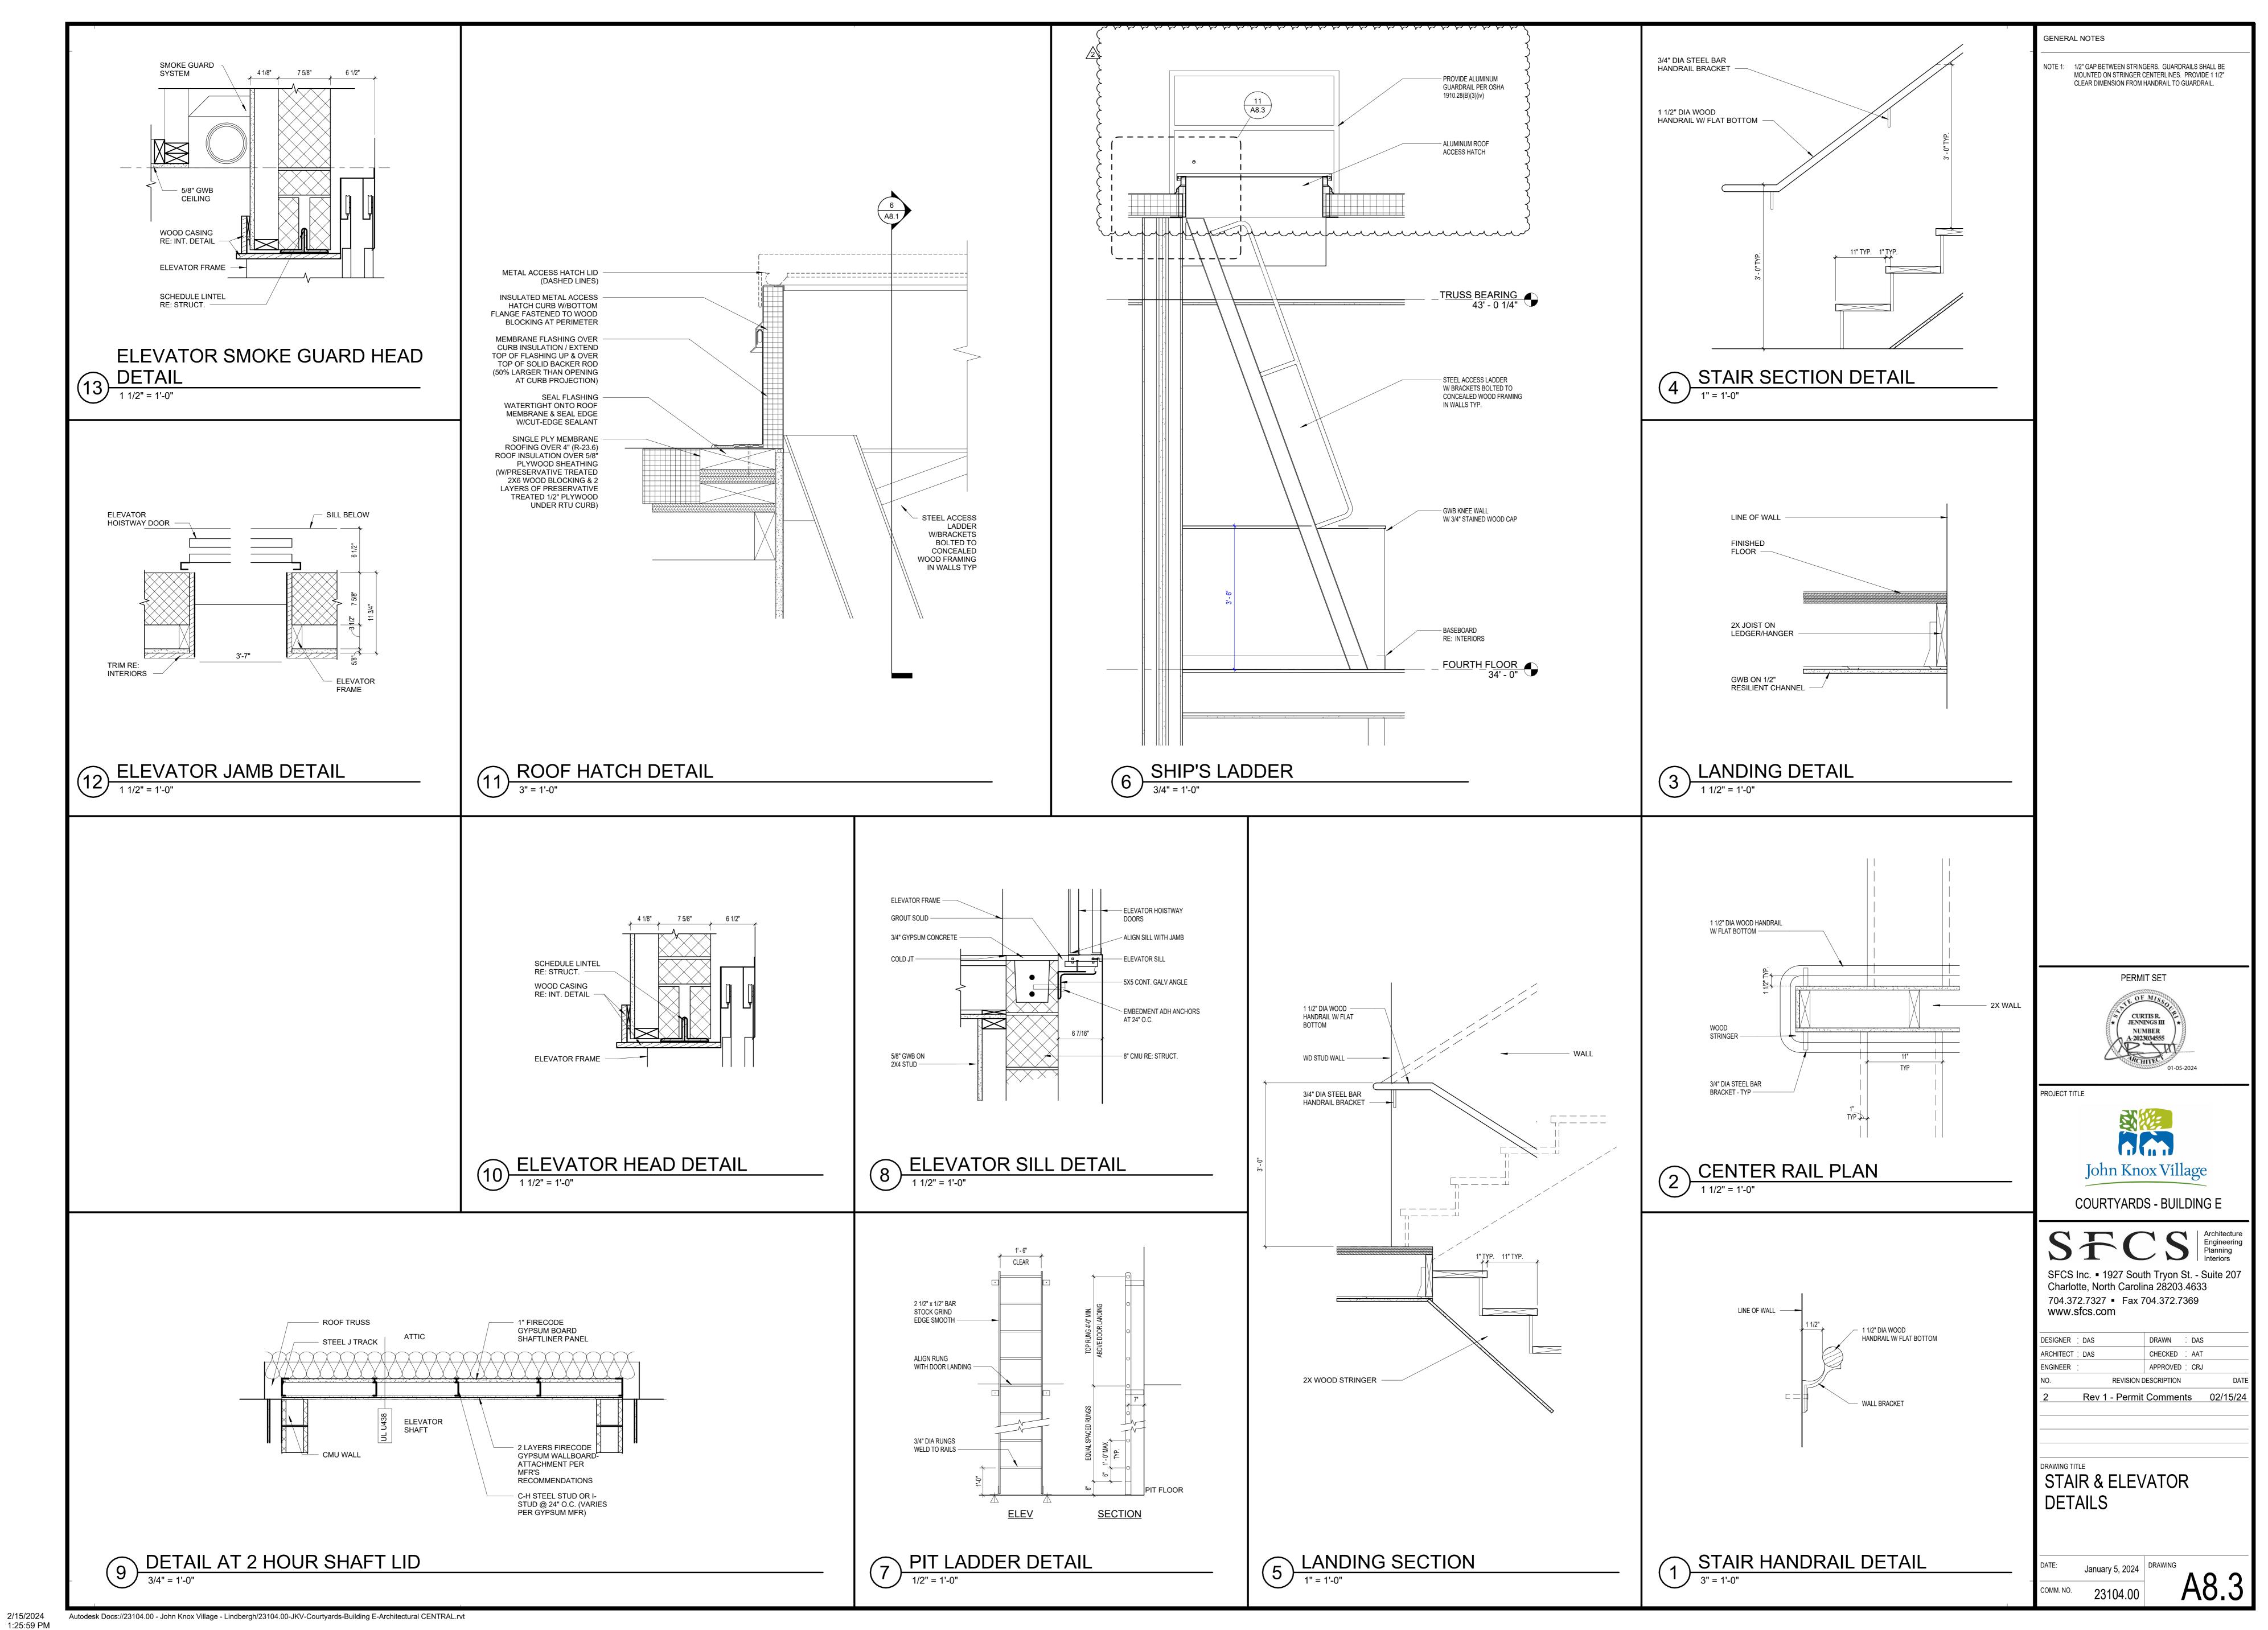

PERMIT SET

CURTIS R.

JENNINGS III

NUMBER

A-2023034555

01-05-2024

PROJECT TITLE

GENERAL NOTES



COURTYARDS - BUILDING E

Architecture Engineering Planning Interiors

SFCS Inc. • 1927 South Tryon St. - Suite 207 Charlotte, North Carolina 28203.4633

704.372.7327 • Fax 704.372.7369

DESIGNER :	DAS	DRAWN : CLH,	CRW		
ARCHITECT :	DAS	CHECKED : KED			
ENGINEER :	DES	APPROVED ; CRJ			
NO.	REVISION D	DATE			
2	Rev 1 - Permit Comments 02/15/24				


FINISH LEGEND

www.sfcs.com

TE: January 5, 2024 DRAWING

10.1

Autodesk Docs://23104.00 - John Knox Village - Lindbergh/23104.00-JKV-Courtyards-Building E-Architectural CENTRAL.rvt

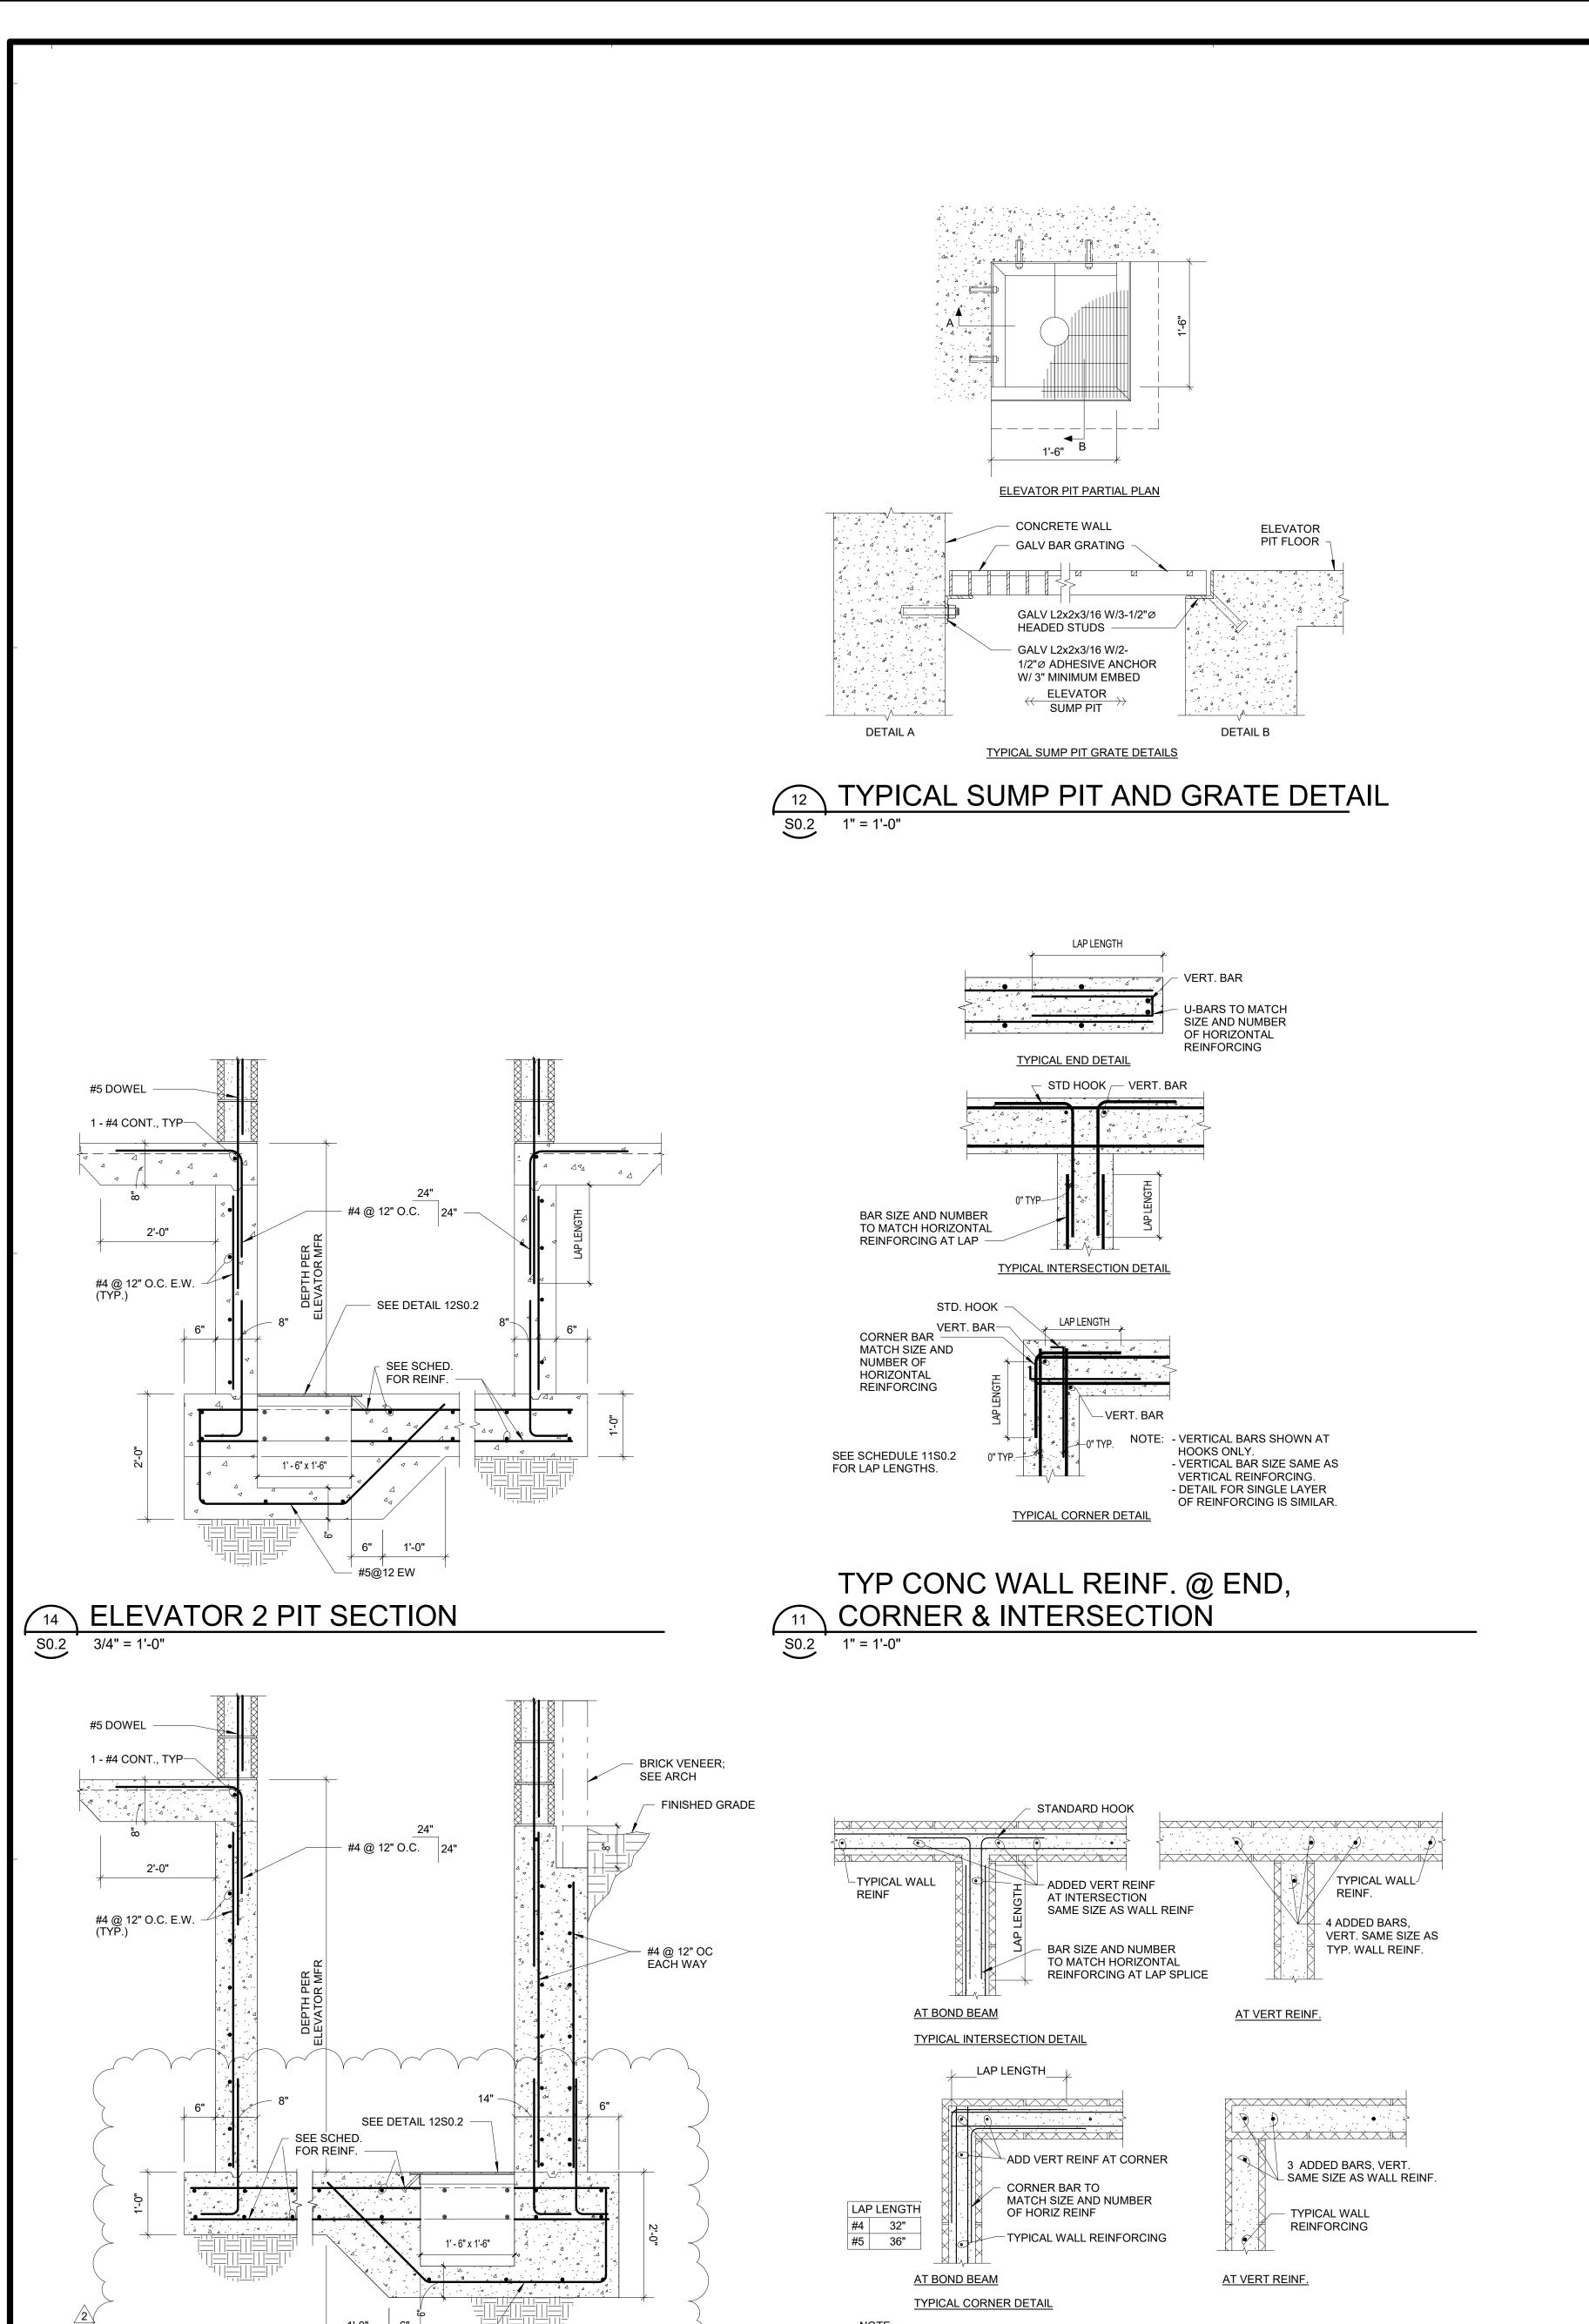

AT WALL ENDS, TERMINATE BOND BEAM BARS WITH STANDARD HOOK

CMU BOND BEAM REINF DETAILS

AND PROVIDE VERTICAL BAR IN THE FIRST 2 END CELLS.

MARK	SIZE	JAMB STUD	KING STUD
$(\widehat{H1})$	(2)-1.75X9.25 LVL	2-2x6	3-2x6
$(\widehat{H2})$	(2)-1.75X9.25 LVL	2-2x6	2-2x6
$(\widehat{H3})$	(2)-1.75X9.25 LVL	2-2x6	1-2x6
$(\widehat{H4})$	(3)-1.75X11.25 LVL	2-2x6	1-2x6
$(\widehat{H5})$	(2)-2x8	2-2x6	1-2x6
$(\widehat{H6})$	(2)-2x10	2-2x6	1-2x6
$(\widehat{H7})$	(3)-2x8	2-2x6	1-2x6
$(\widehat{H8})$	(3)-2x8	2-2x6	2-2x6
( <del>H</del> 9)	(3)-2x10	2-2x6	1-2x6
H10	(3)-2x16	1-2x6	3-2x6
H11	(2)-2x8	2-2x4	1-2x4



LINTEL SCHEDULE						
MARK		SIZE	BEARING			
L1		8" WIDE x 8" DEEP CMU LINTEL W/ 2 - #5 BOTTOM	8"			

1. ALL LINTELS SHALL CONFORM TO ARCHITECTURAL HEAD DETAILS.



POST SCHEDULE					
MARK	SIZE				
(P1)	6 X 6 SOUTHERN PINE				
(P2)	5.25 X 5.25 PSL				
(P3)	3.5 X 3.5 PSL				
(P4)	7 X 7 PSL				

7	WOOD POST SCHEDULE
S0.2	N.T.S.

LOAD-BEARING WALL STUD SCHEDULE							
LOCATION	STORY	STUD SIZE & SPACING	WOOD SPECIES AND GRADE				
EXTERIOR WALLS	ALL FLOORS	2X6 @ 16" OC					
STAIR SHAFT WALLS AT CORRIDOR	1ST FLOOR	2-2X4 @ 16" OC					
OTHER STAIR SHAFT WALLS	ALL FLOORS	2X4 @ 16" OC					
CORDIDOR WALLS	2ND, 3RD & 4TH FLOORS	2X6 @ 16" OC	SPRUCE PINE FIR, NO. 1/NO. 2				
CORRIDOR WALLS	1ST FLOOR	2-2X6 @ 16" OC					
2V4 CORRIDOR WALLS	2ND, 3RD & 4TH FLOORS	2X4 @ 16" OC					
2X4 CORRIDOR WALLS	1ST FLOOR	2-2X4 @ 16" OC					

2X6 @ 16" OC

6	BEARING WALL STUD SCHEDULE
S0.2	N.T.S.

OTHER INTERIOR WALLS

	COLU	MN S	CHED	ULE	
MARK	DESCRIPTION	BASE PLATE	BASE PL THK	ANCHOR BOLT	REMARKS
C1	HSS 4x4x3/8	BP-1	3/4"	AB-1	
C2	HSS 6x6x1/2	BP-2	3/4"	AB-2	

# 3 STEEL COLUMN SCHEDULE S0.2 N.T.S.

1) ANCHOR BOLTS - ASTM F1554 2) NUTS - ASTM A563, GRADE A, HEAVY HEX

5 STEEL COL ANCHOR BOLTS

SO.2 1 1/2" = 1'-0"

3) PLATE - ASTM A36 4) PROVIDE HOLE IN PLATE WASHER = BOLT DIAMETER + 1/16".

·							
	GRADE BEAM SCHEDULE						
	MARK SIZE (WIDTH X DEPTH)		REINFORCING				
	GB-1	16" X 28"	SEE SECTION 4/S2.1				
	GB-2	24" X 28"	SEE SECTION 2/S2.1				
	GB-26	30" X 28"	SEE SECTION 3/S2.1				



FOOTING SCHEDULE				
MARK	SIZE	THICKNESS	REINFORCING (BOTTOM U.N.O.)	
F3.0	3'-0" SQUARE	12"	3 - #5 EA WAY	
F4.0	4'-0" SQUARE	12"	4 - #5 EA WAY	
F5.0	5'-0" SQUARE	14"	5 - #5 EA WAY	
MAT #1	SEE PLAN	12"	#5@12 EA WAY, TOP & BOTTOM	

1 FOOTING SCHEDULE

	FASNACHT NUMBER PE-2022006433 01/05/24 TONAL ENGINEERS
PROJECT TITLE	




COURTYARDS - BUILDI	NG E
SFCS	Architecture Engineering Planning Interiors
SFCS Inc. • 1927 South Tryon St. Charlotte, North Carolina 28203.46	633
704.372.7327 • Fax 704.372.7369	9


www.sfcs.co	om			
DESIGNER : DAS		DRAWN	BSW	
ARCHITECT : DAS		CHECKED	BDT	
ENGINEER : LBF		APPROVED	Approve	r
NO.	REVISION [	DESCRIPTION		D
0 051/4	DEDIAIT	0014145	 Τ0	01451

DESIGNER , DAS	DRAWN . BOW	
ARCHITECT : DAS	CHECKED : BDT	
ENGINEER ; LBF	APPROVED : Approv	/er
NO. REVISION D	DESCRIPTION	DA
2 REV 1- PERMIT	COMMENTS	2/15/2
İ		


TYPICAL SECTIONS AND DETAILS

13 ELEVATOR 1 PIT SECTION

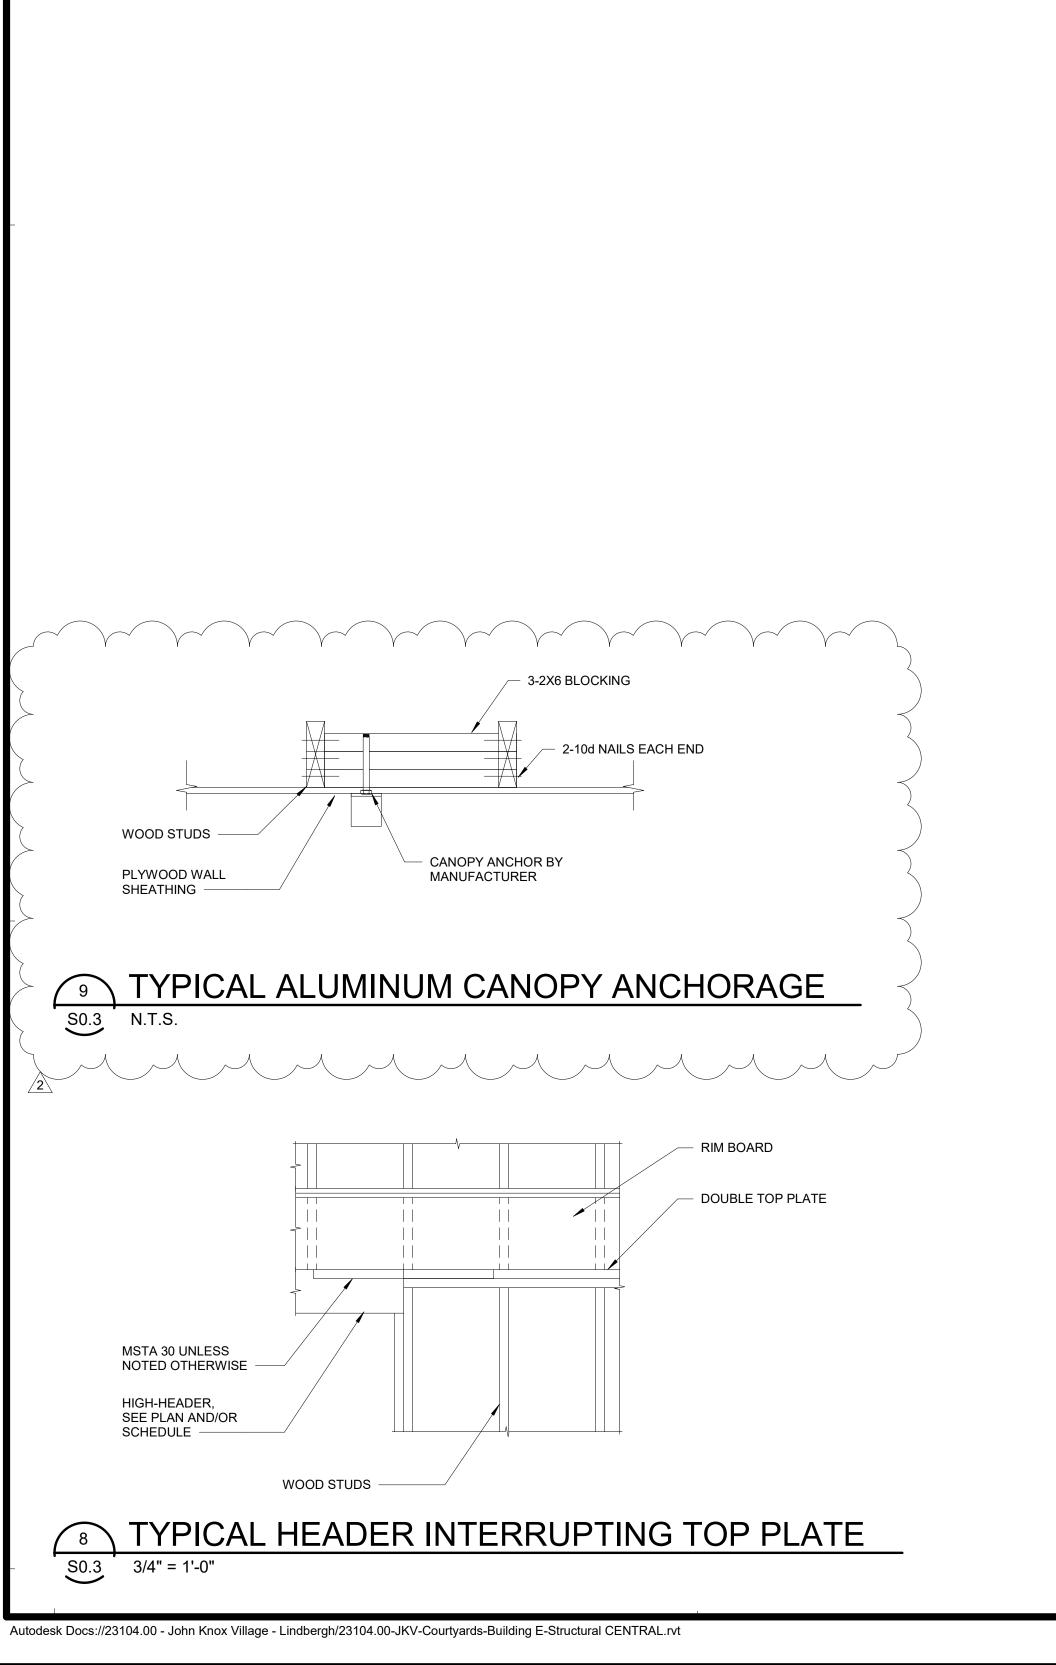


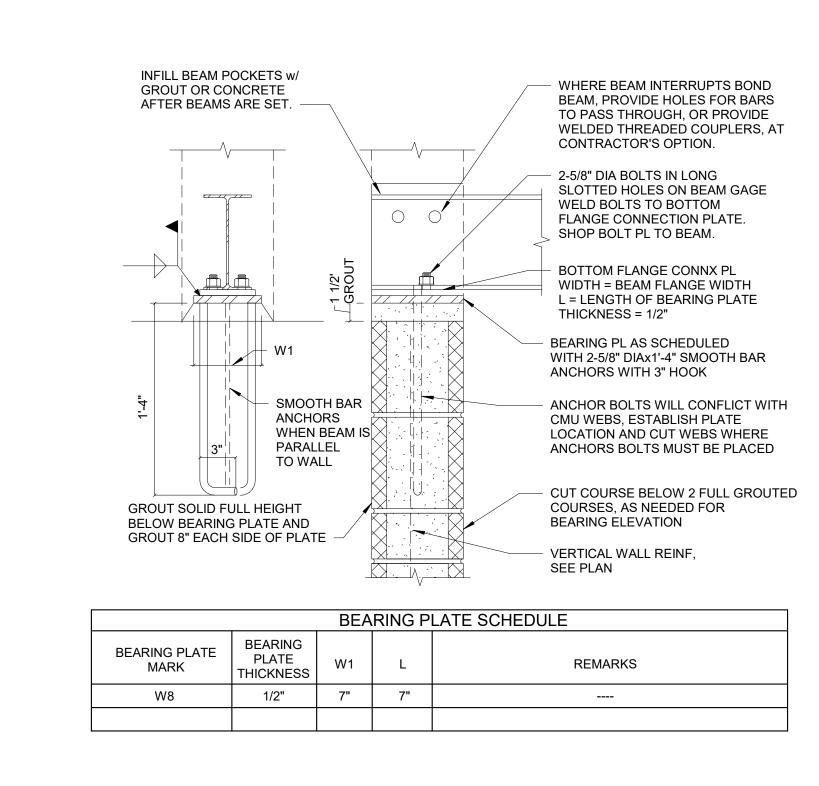

### BEARING PLATE SCHEDULE S0.3 N.T.S.

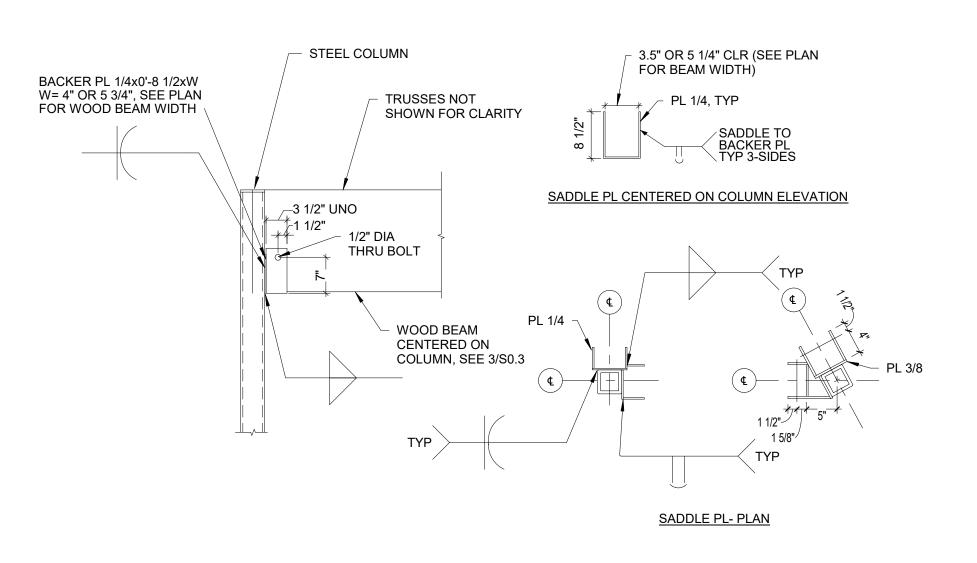


#### TYP WOOD BEAM TO STL COL S0.3 3/4" = 1'-0"

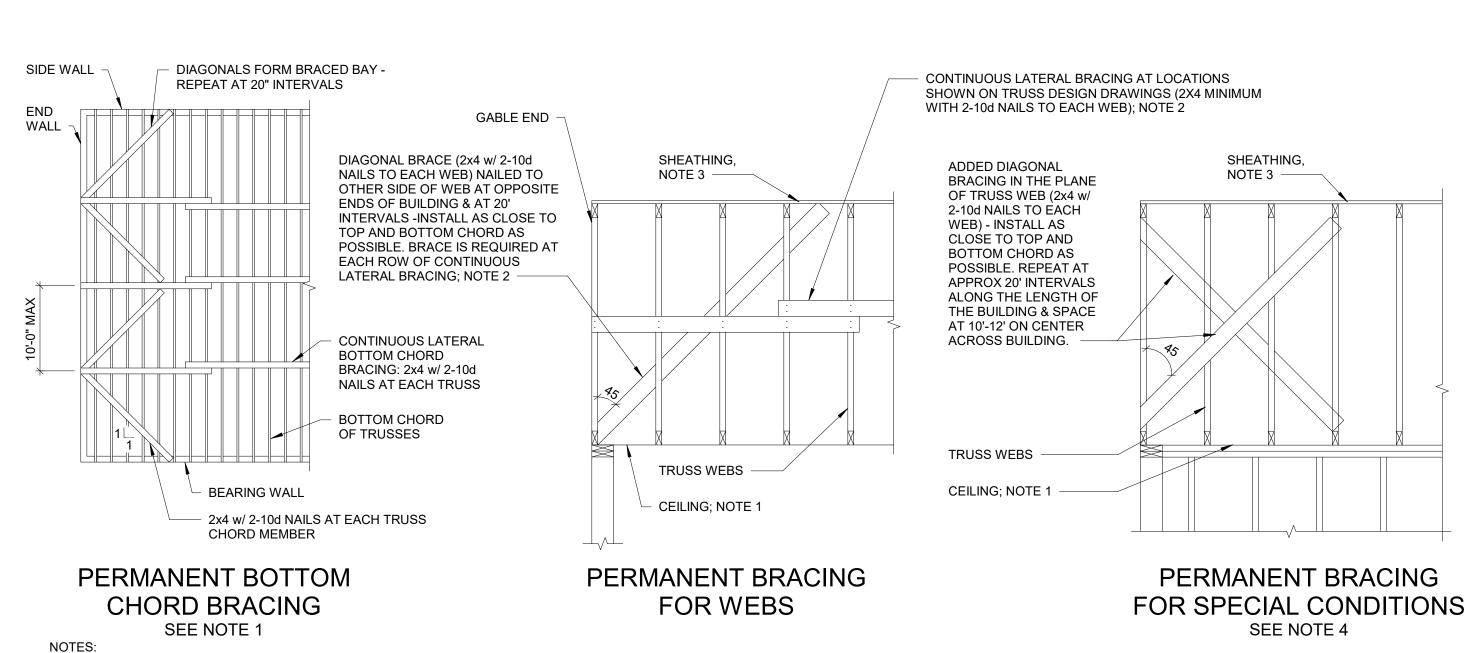


1. BOTTOM CHORD BRACING IS NOT REQUIRED WHERE 5/8" GYPSUM IS DIRECTLY FASTENED AT 12" OC OR LESS TO TRUSS BOTTOM CHORD OR WHERE RESILIENT CHANNEL IS SPACED 12" OC OR LESS WITH 5/8" 2. PERMANENT DIAGONAL BRACING BRACING IS FOR OVERALL BUILDING STABILITY AND SHALL BE INSTALLED IN ADDITION TO THE CONTINUOUS PERMANENT LATERAL BRACING AT LOCATIONS SHOWN BY THE DELEGATED TRUSS DESIGNER TO RESIST BUCKLING OF COMPRESSION TRUSS MEMBERS. SEE BCSI-B3 FOR ALTERNATIVE WEB REINFORCEMENT OPTIONS WHEN INSTALLING CONTINUOUS LATERAL BRACING AND DIAGONAL BRACING IS NOT PRACTICAL OR DESIRED. 3. WHERE TRUSSES DO NOT RECIEVE CONTINUOUS PLYWOOD SHEATHING NAILED TO THE TOP CHORD, PROVIDE TOP CHORD BRACING PER BCSI-B3. 4. SWAY BRACING IS REQUIRED AT TRUSSES WHERE CONTINUOUS LATERAL BRACING AND DIAGONAL BRACING ARE NOT PROVIDED.

\ PERMANENT LATERAL BRACING FOR WOOD TRUSSES

(1) CS20 STRAP -TYPICAL HEADERS AT ROOF

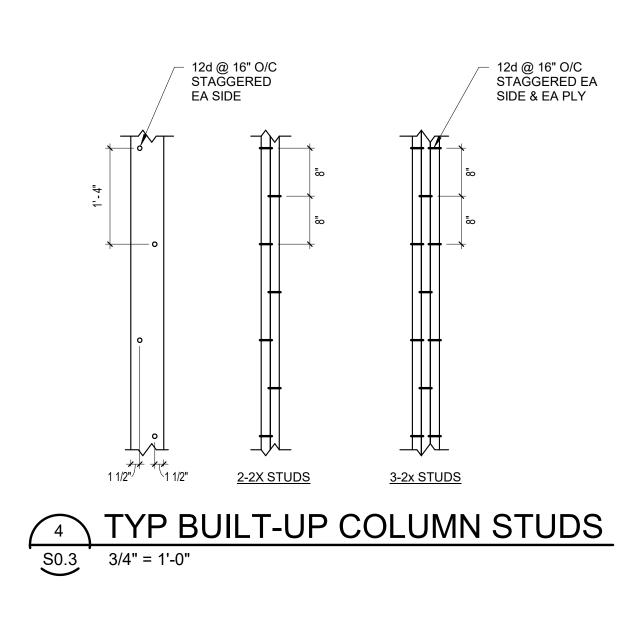


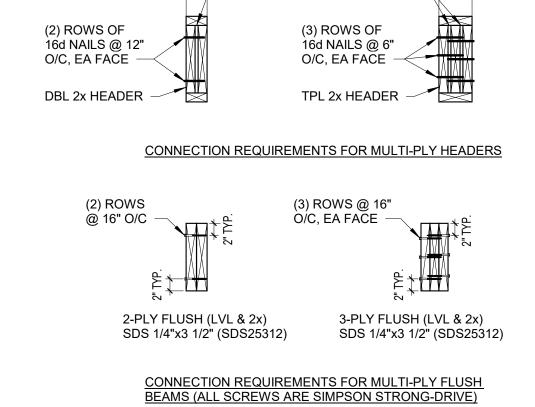


1/2" PLYWOOD SHEATHING w/ (2) ROWS OF 8d NAILS @


6" O/C (NOT REQ'D FOR LVL)



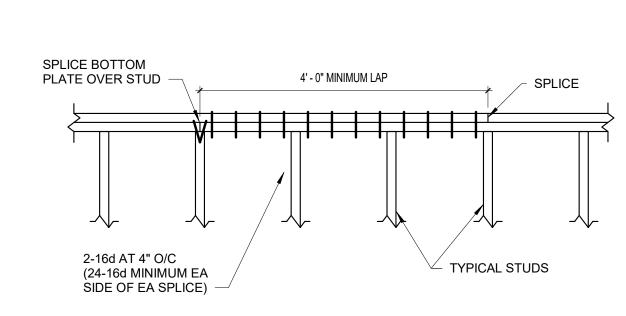

#### TYPICAL TOP PLATE SPLICE S0.3 3/4" = 1'-0"

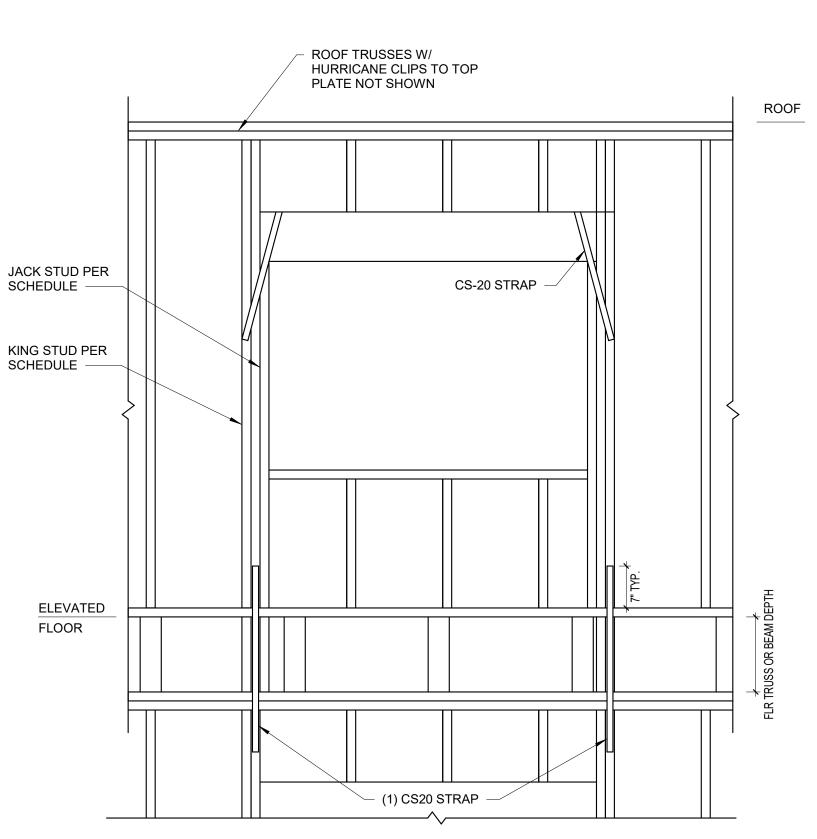

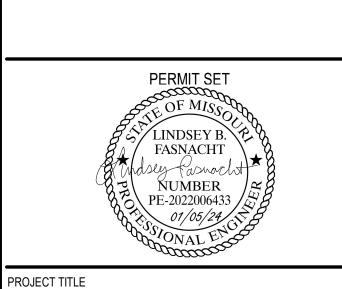


John Knox Village


**COURTYARDS - BUILDING E** SFCS Inc. • 1927 South Tryon St. - Suite 207 Charlotte, North Carolina 28203.4633


704.372.7327 • Fax 704.372.7369 www.sfcs.com DESIGNER : DAS DRAWN : BSW ARCHITECT : DAS CHECKED : BDT APPROVED : Approver REVISION DESCRIPTION

REV 1- PERMIT COMMENTS 2/15/24


TYPICAL SECTIONS AND **DETAILS** 

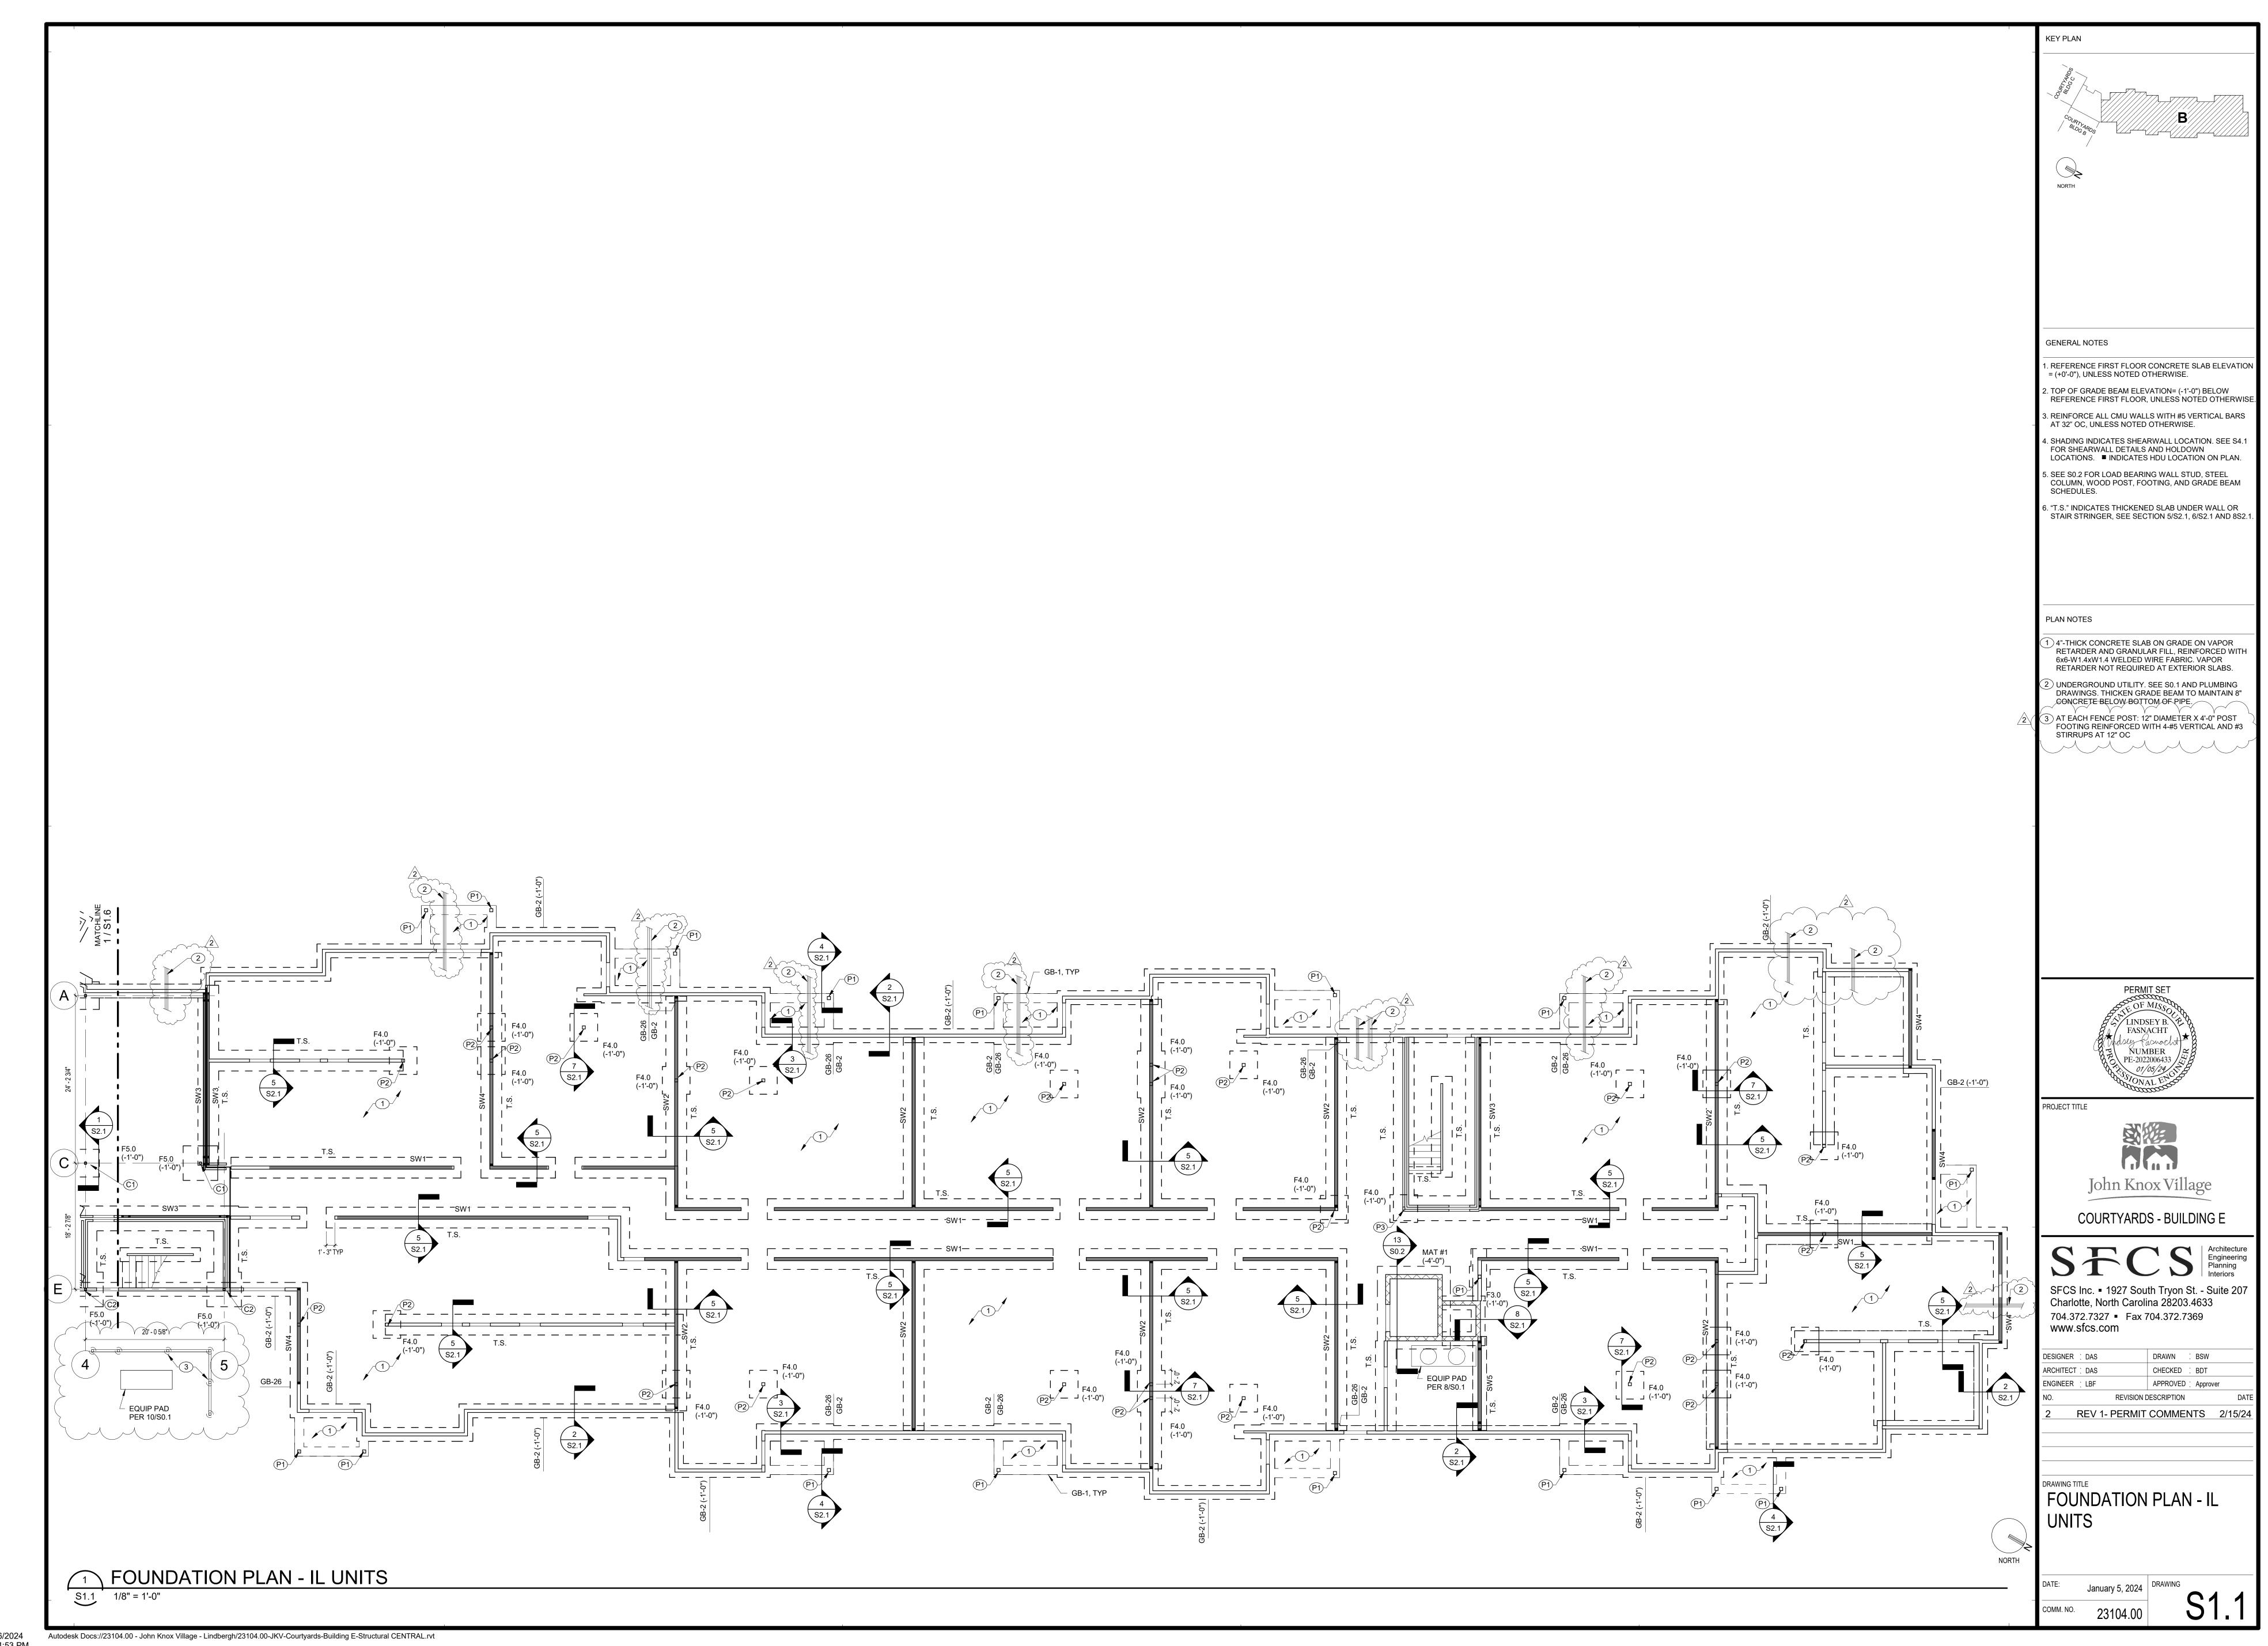


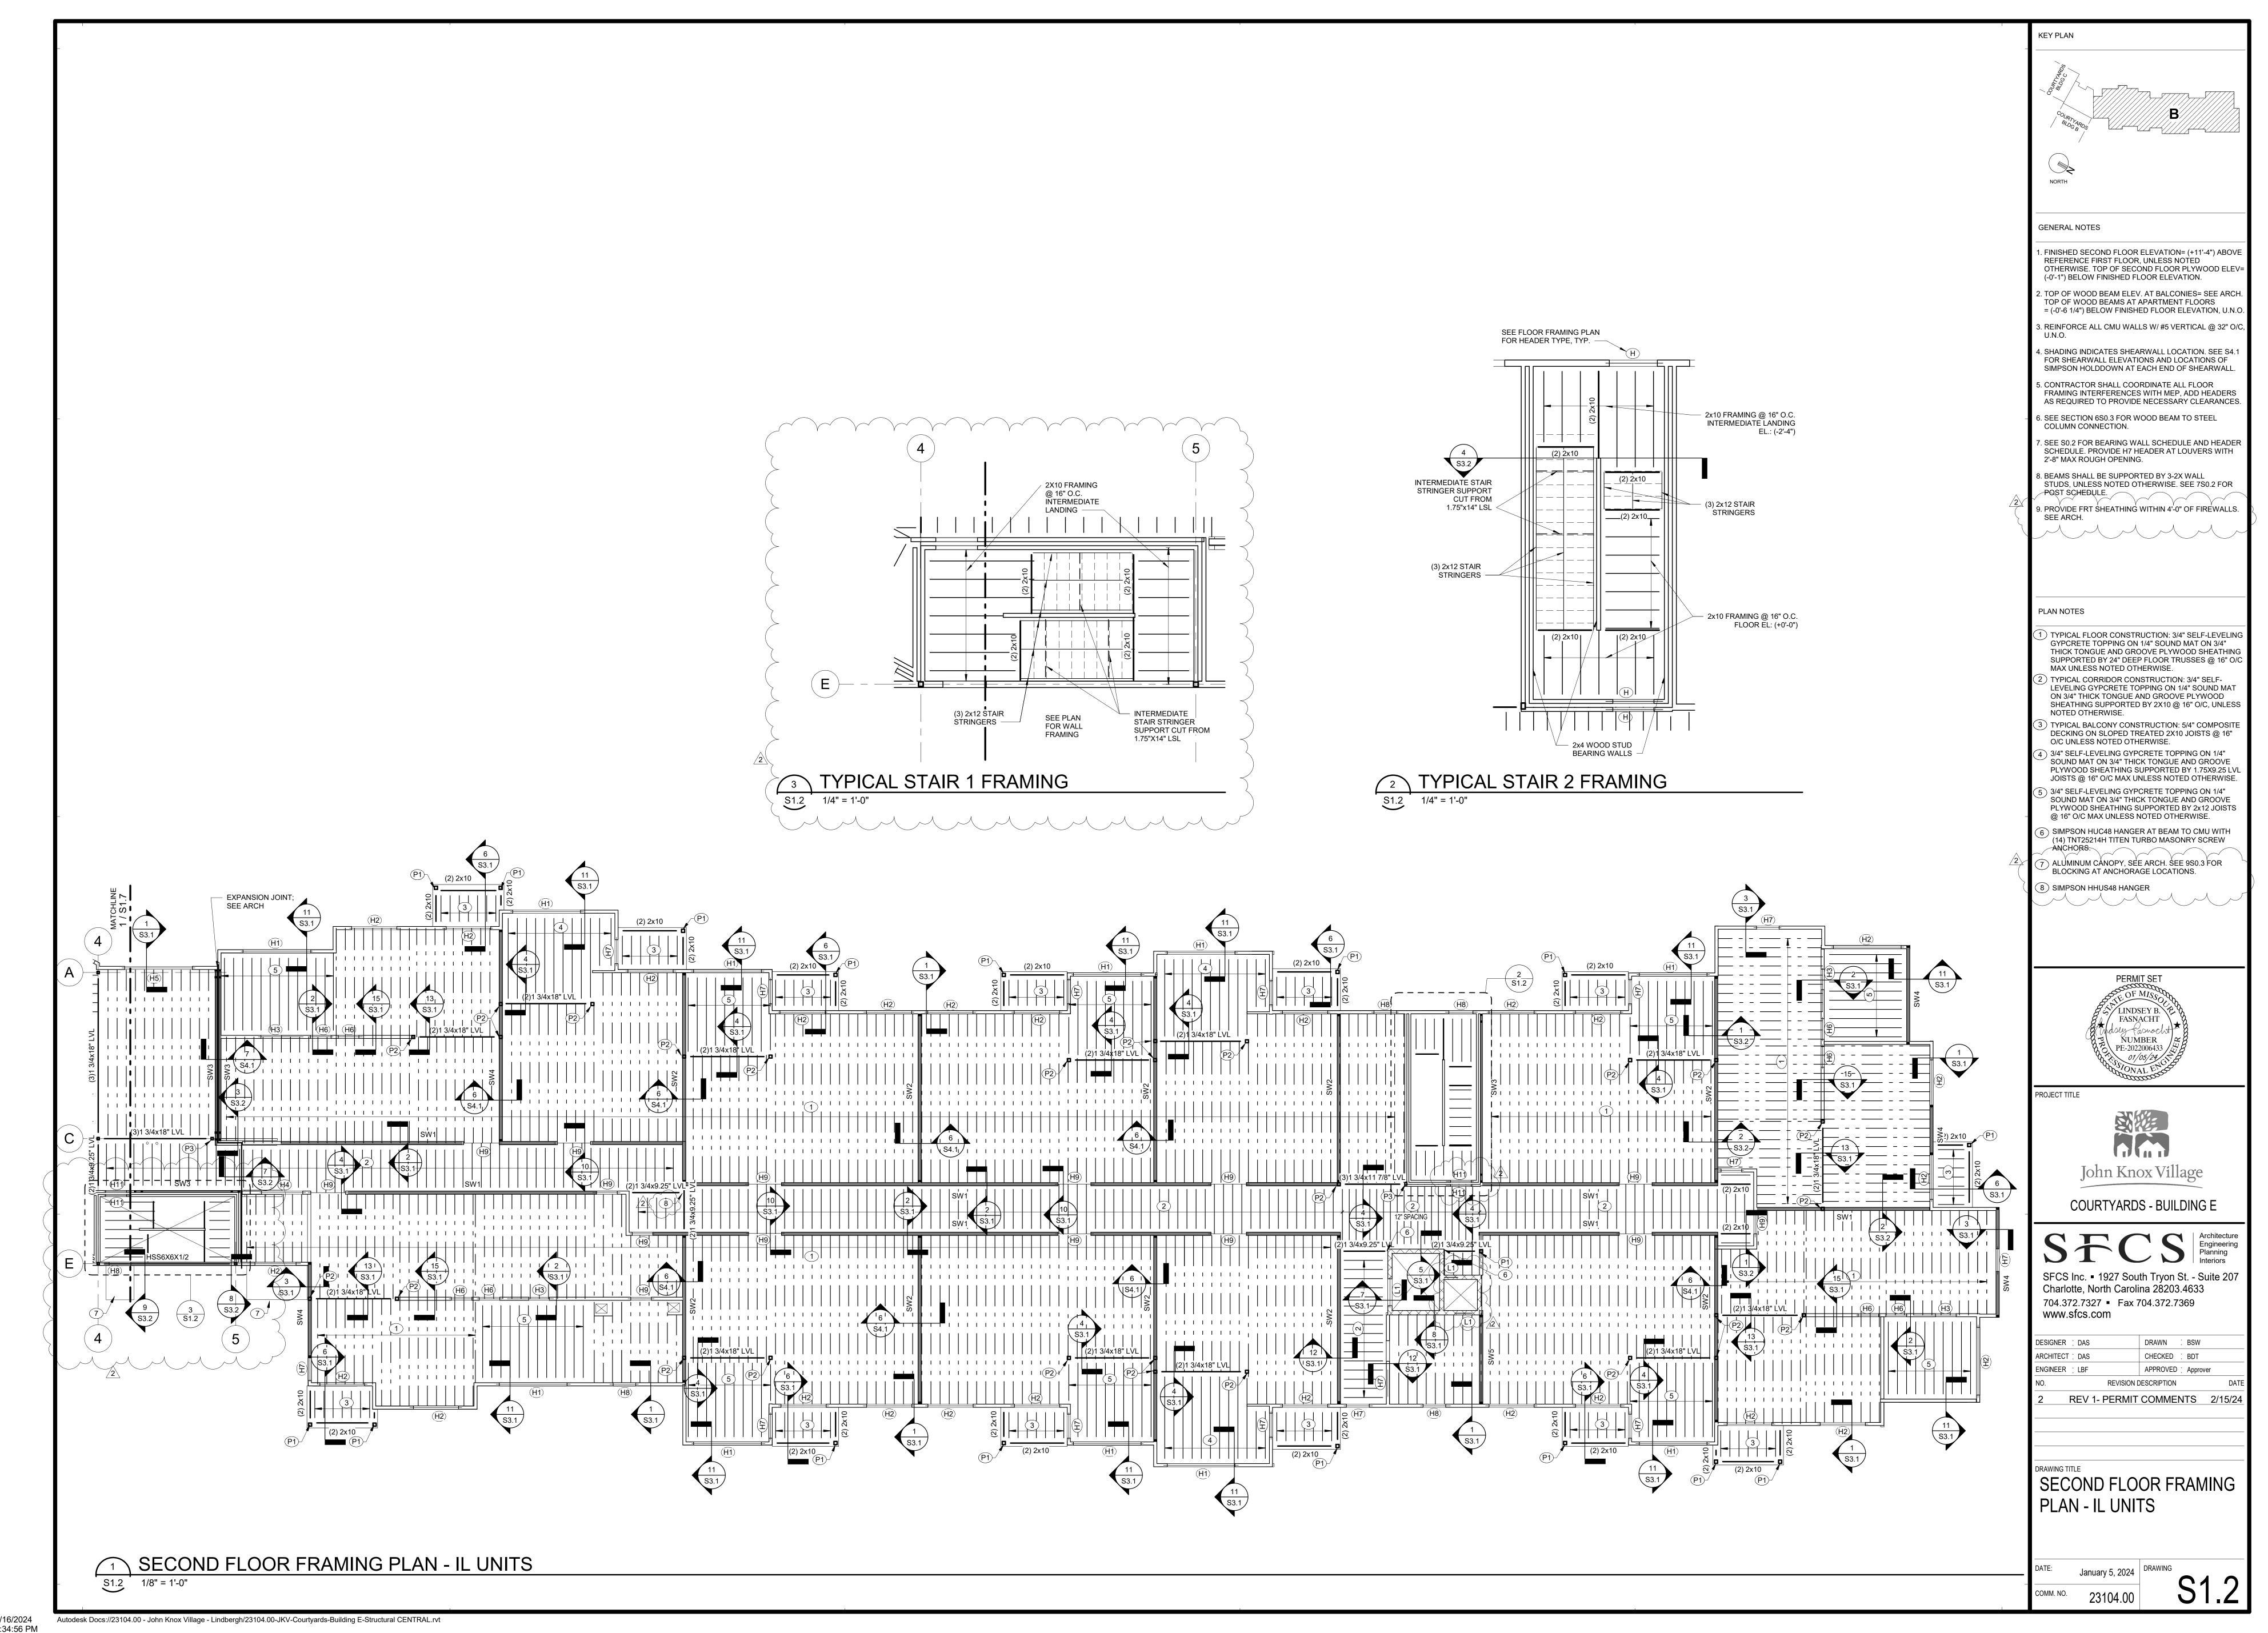


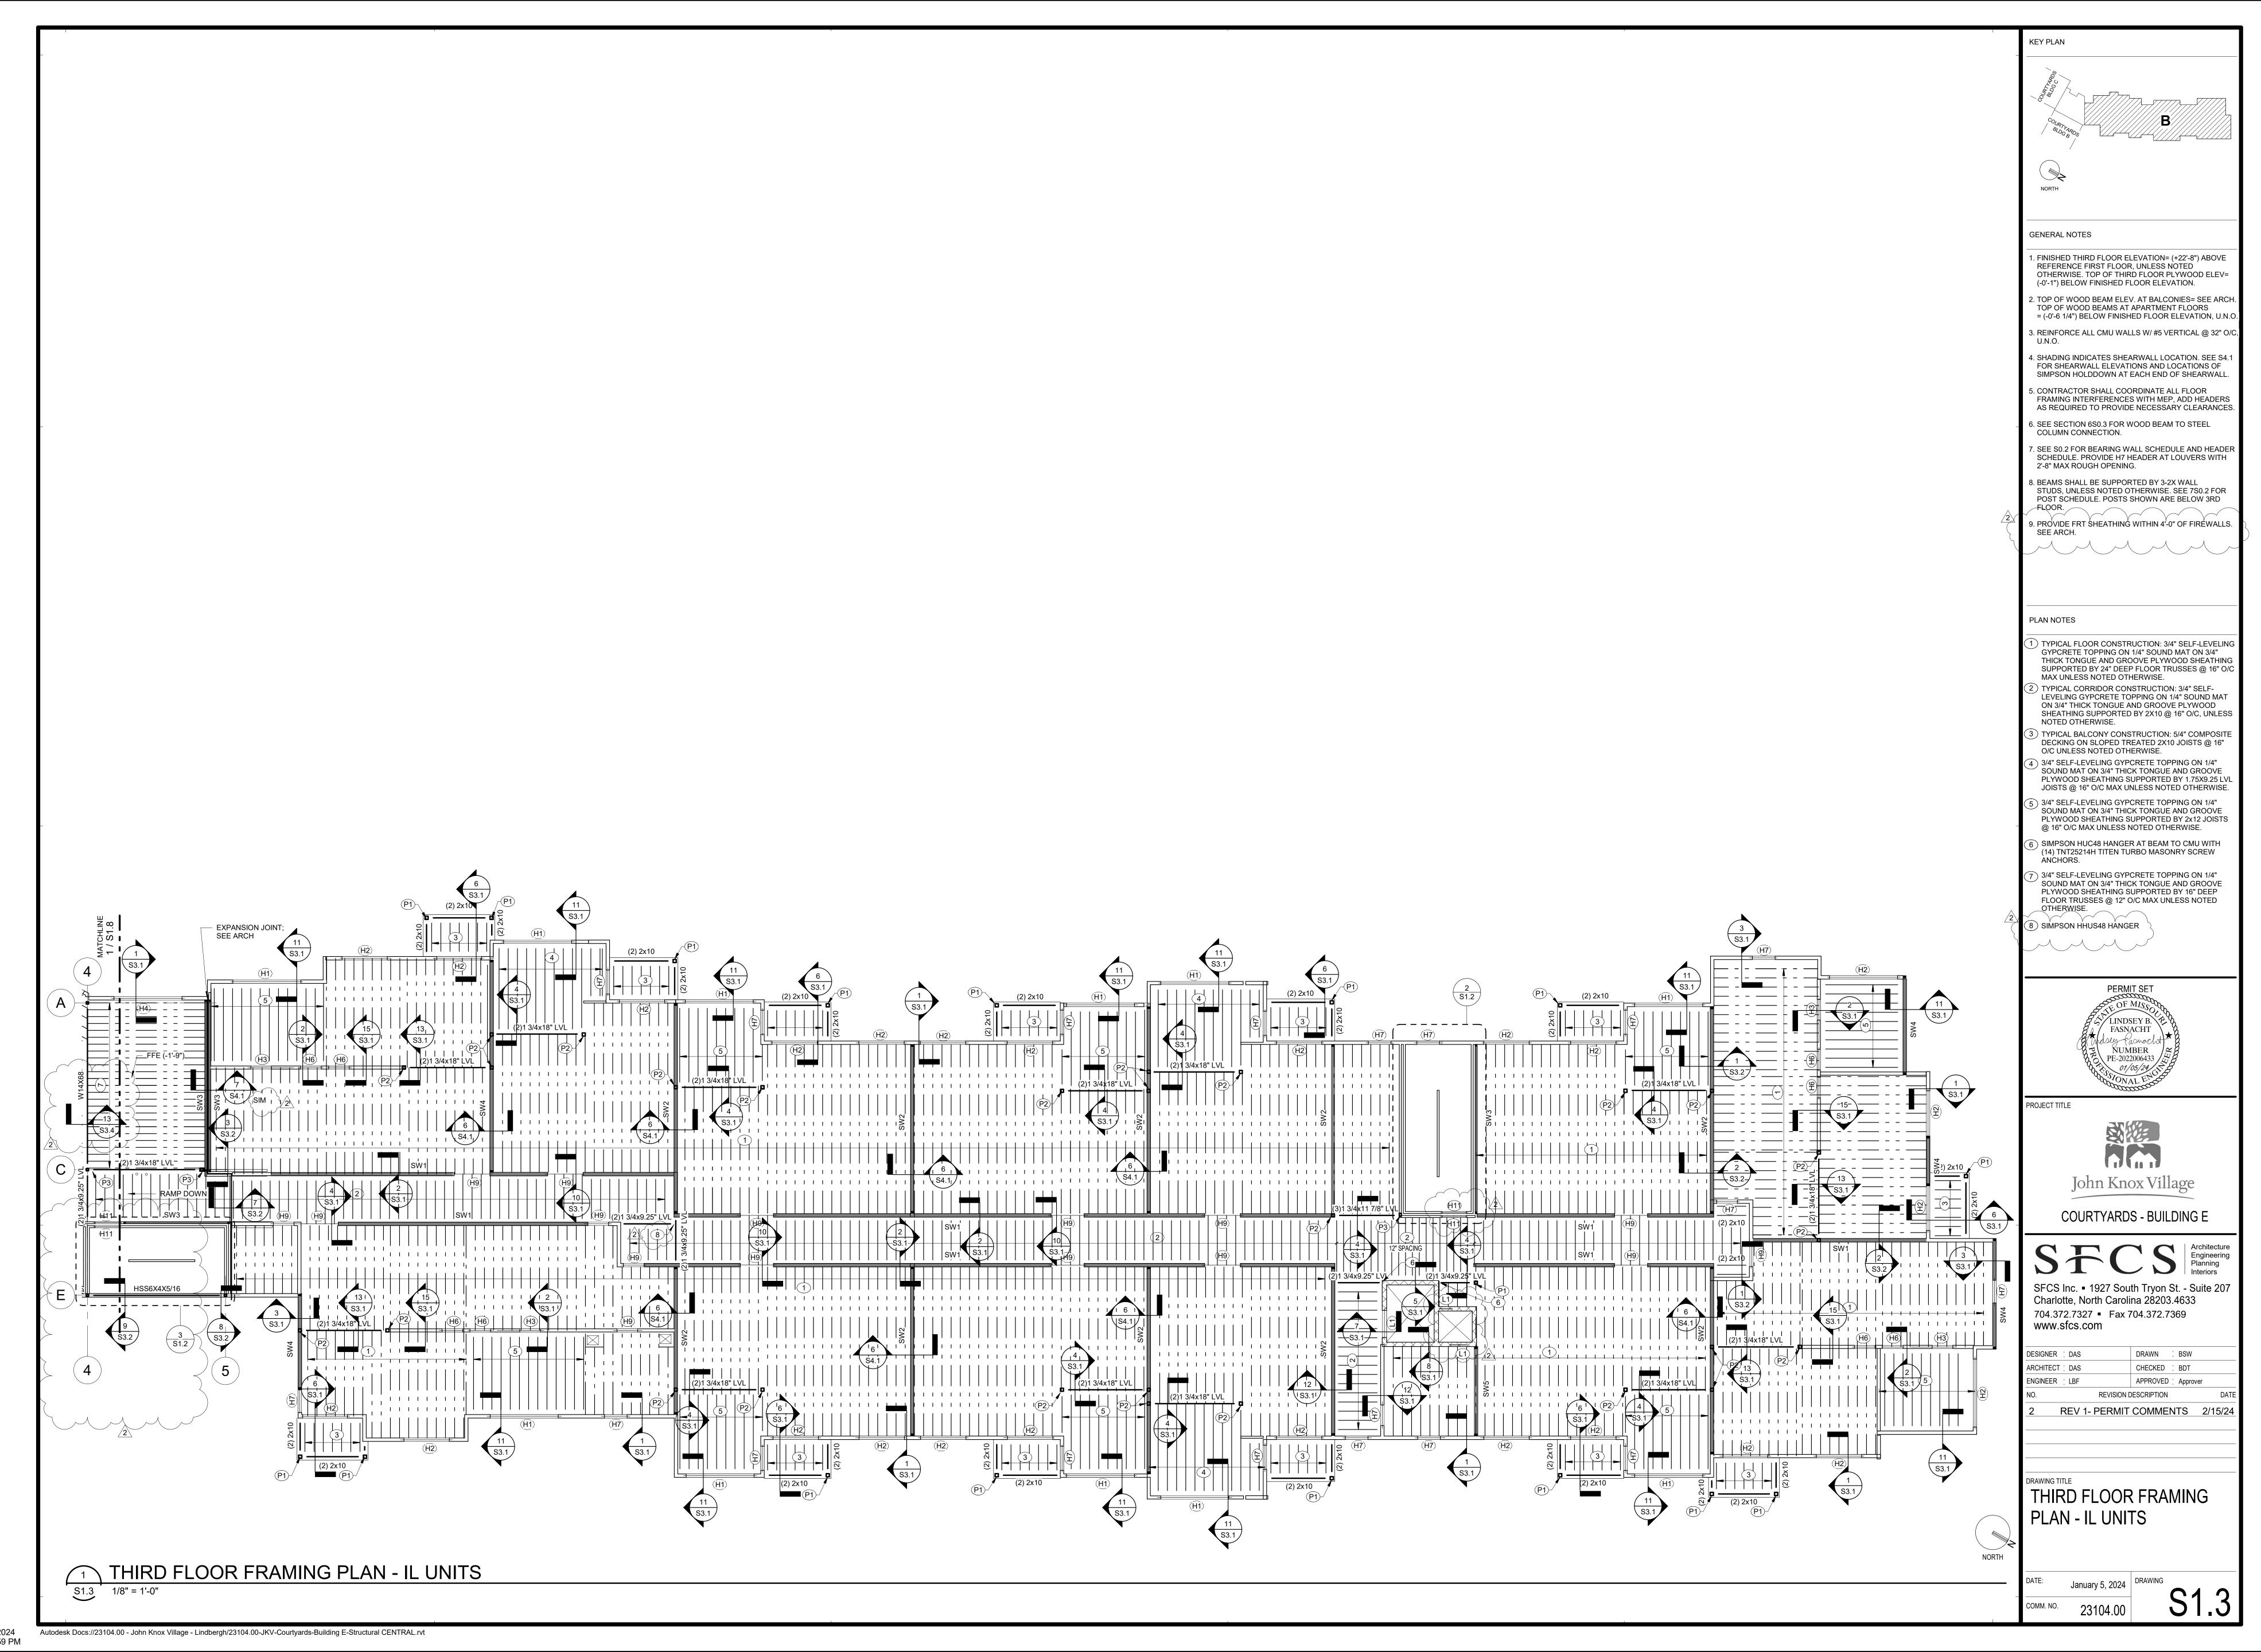


2/16/2 3:34:5

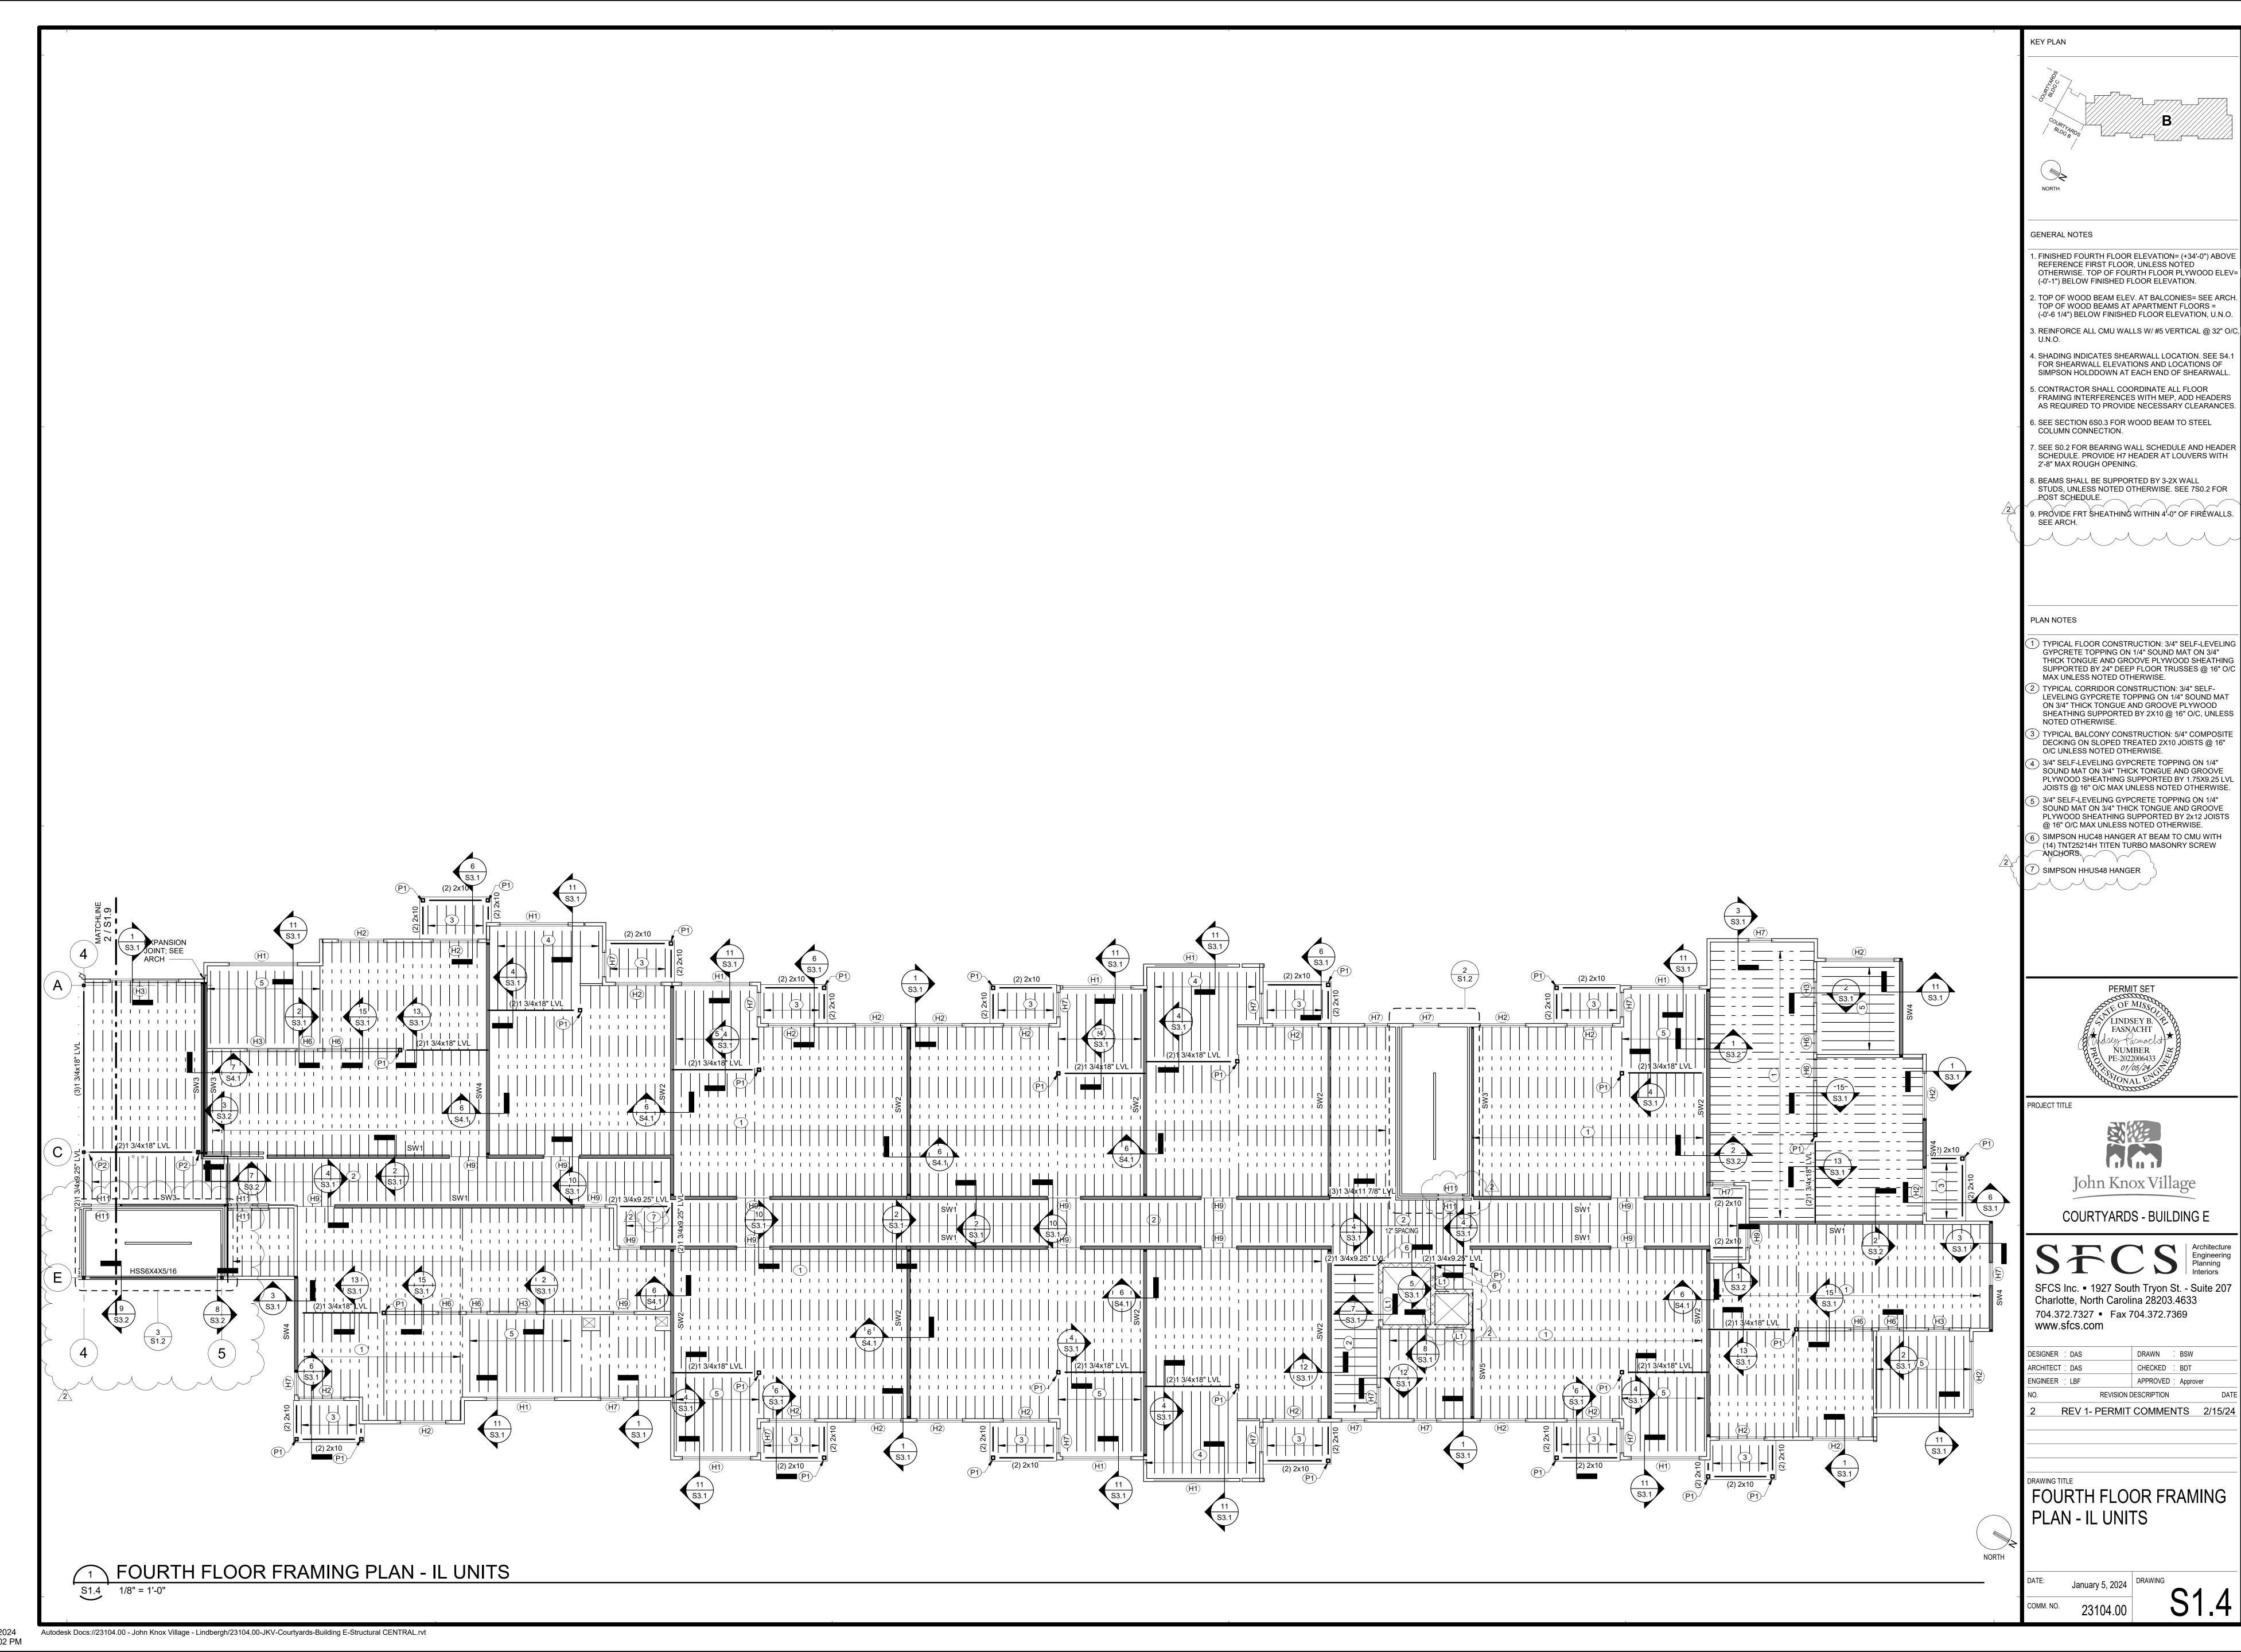


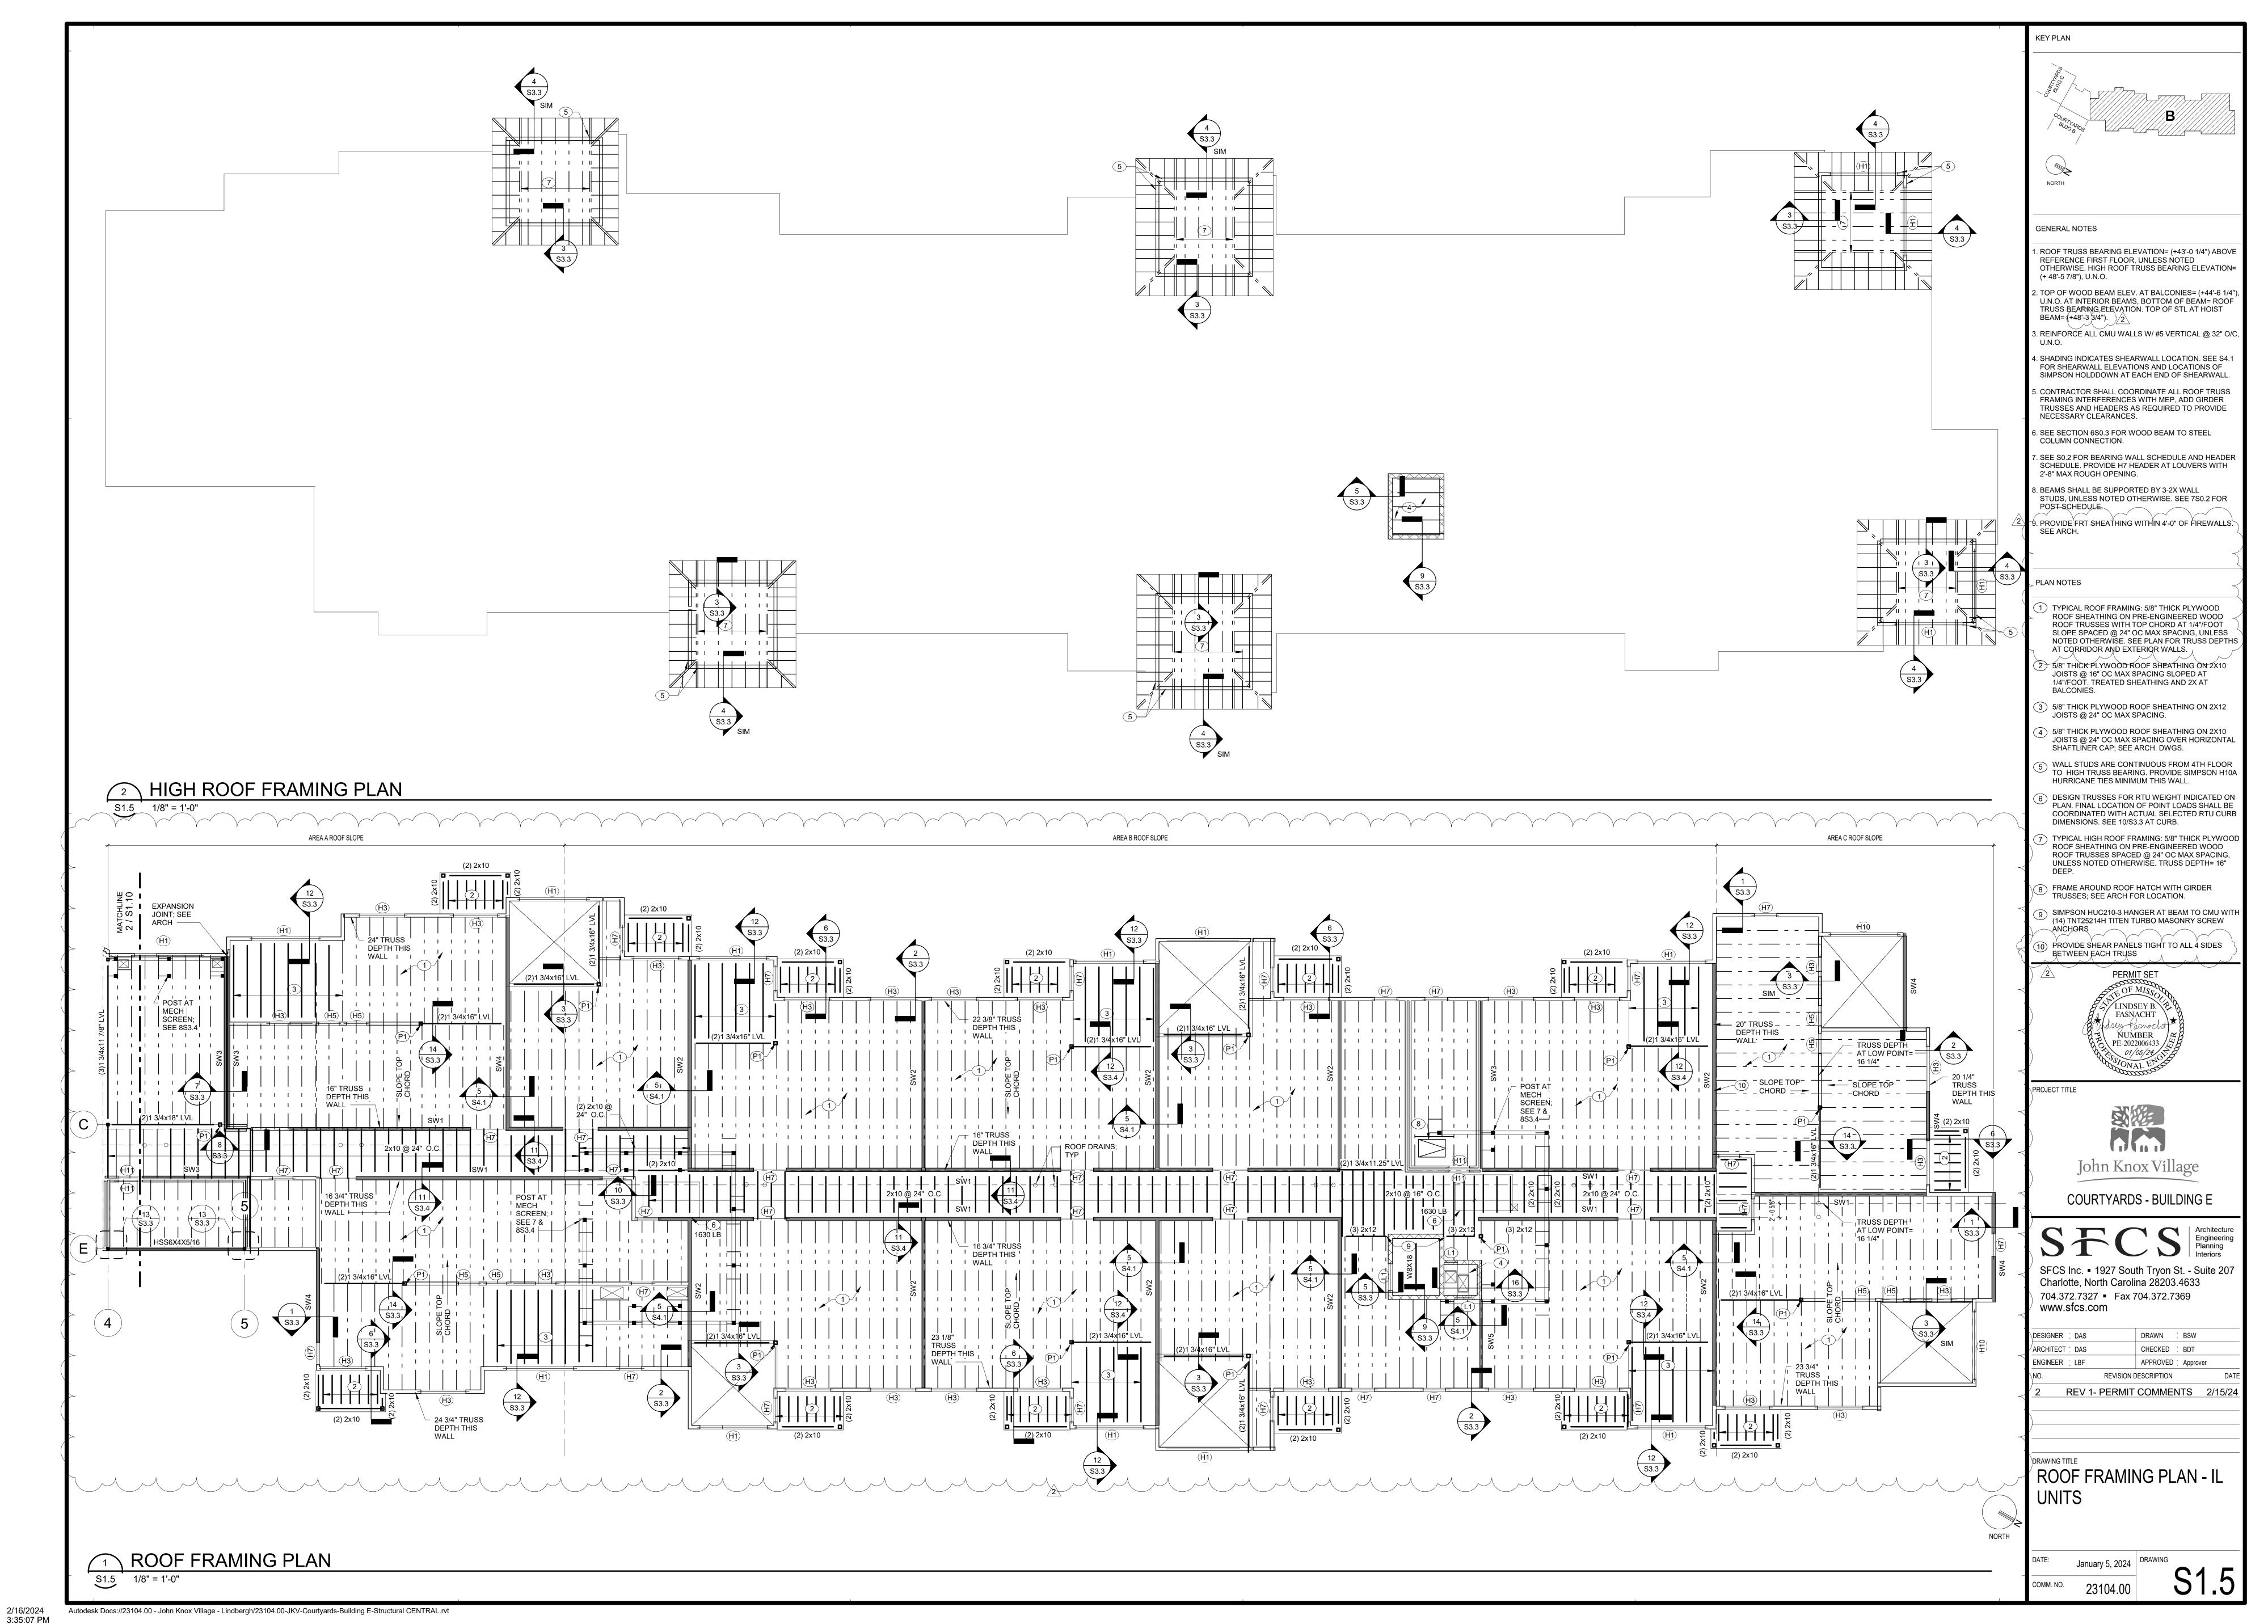

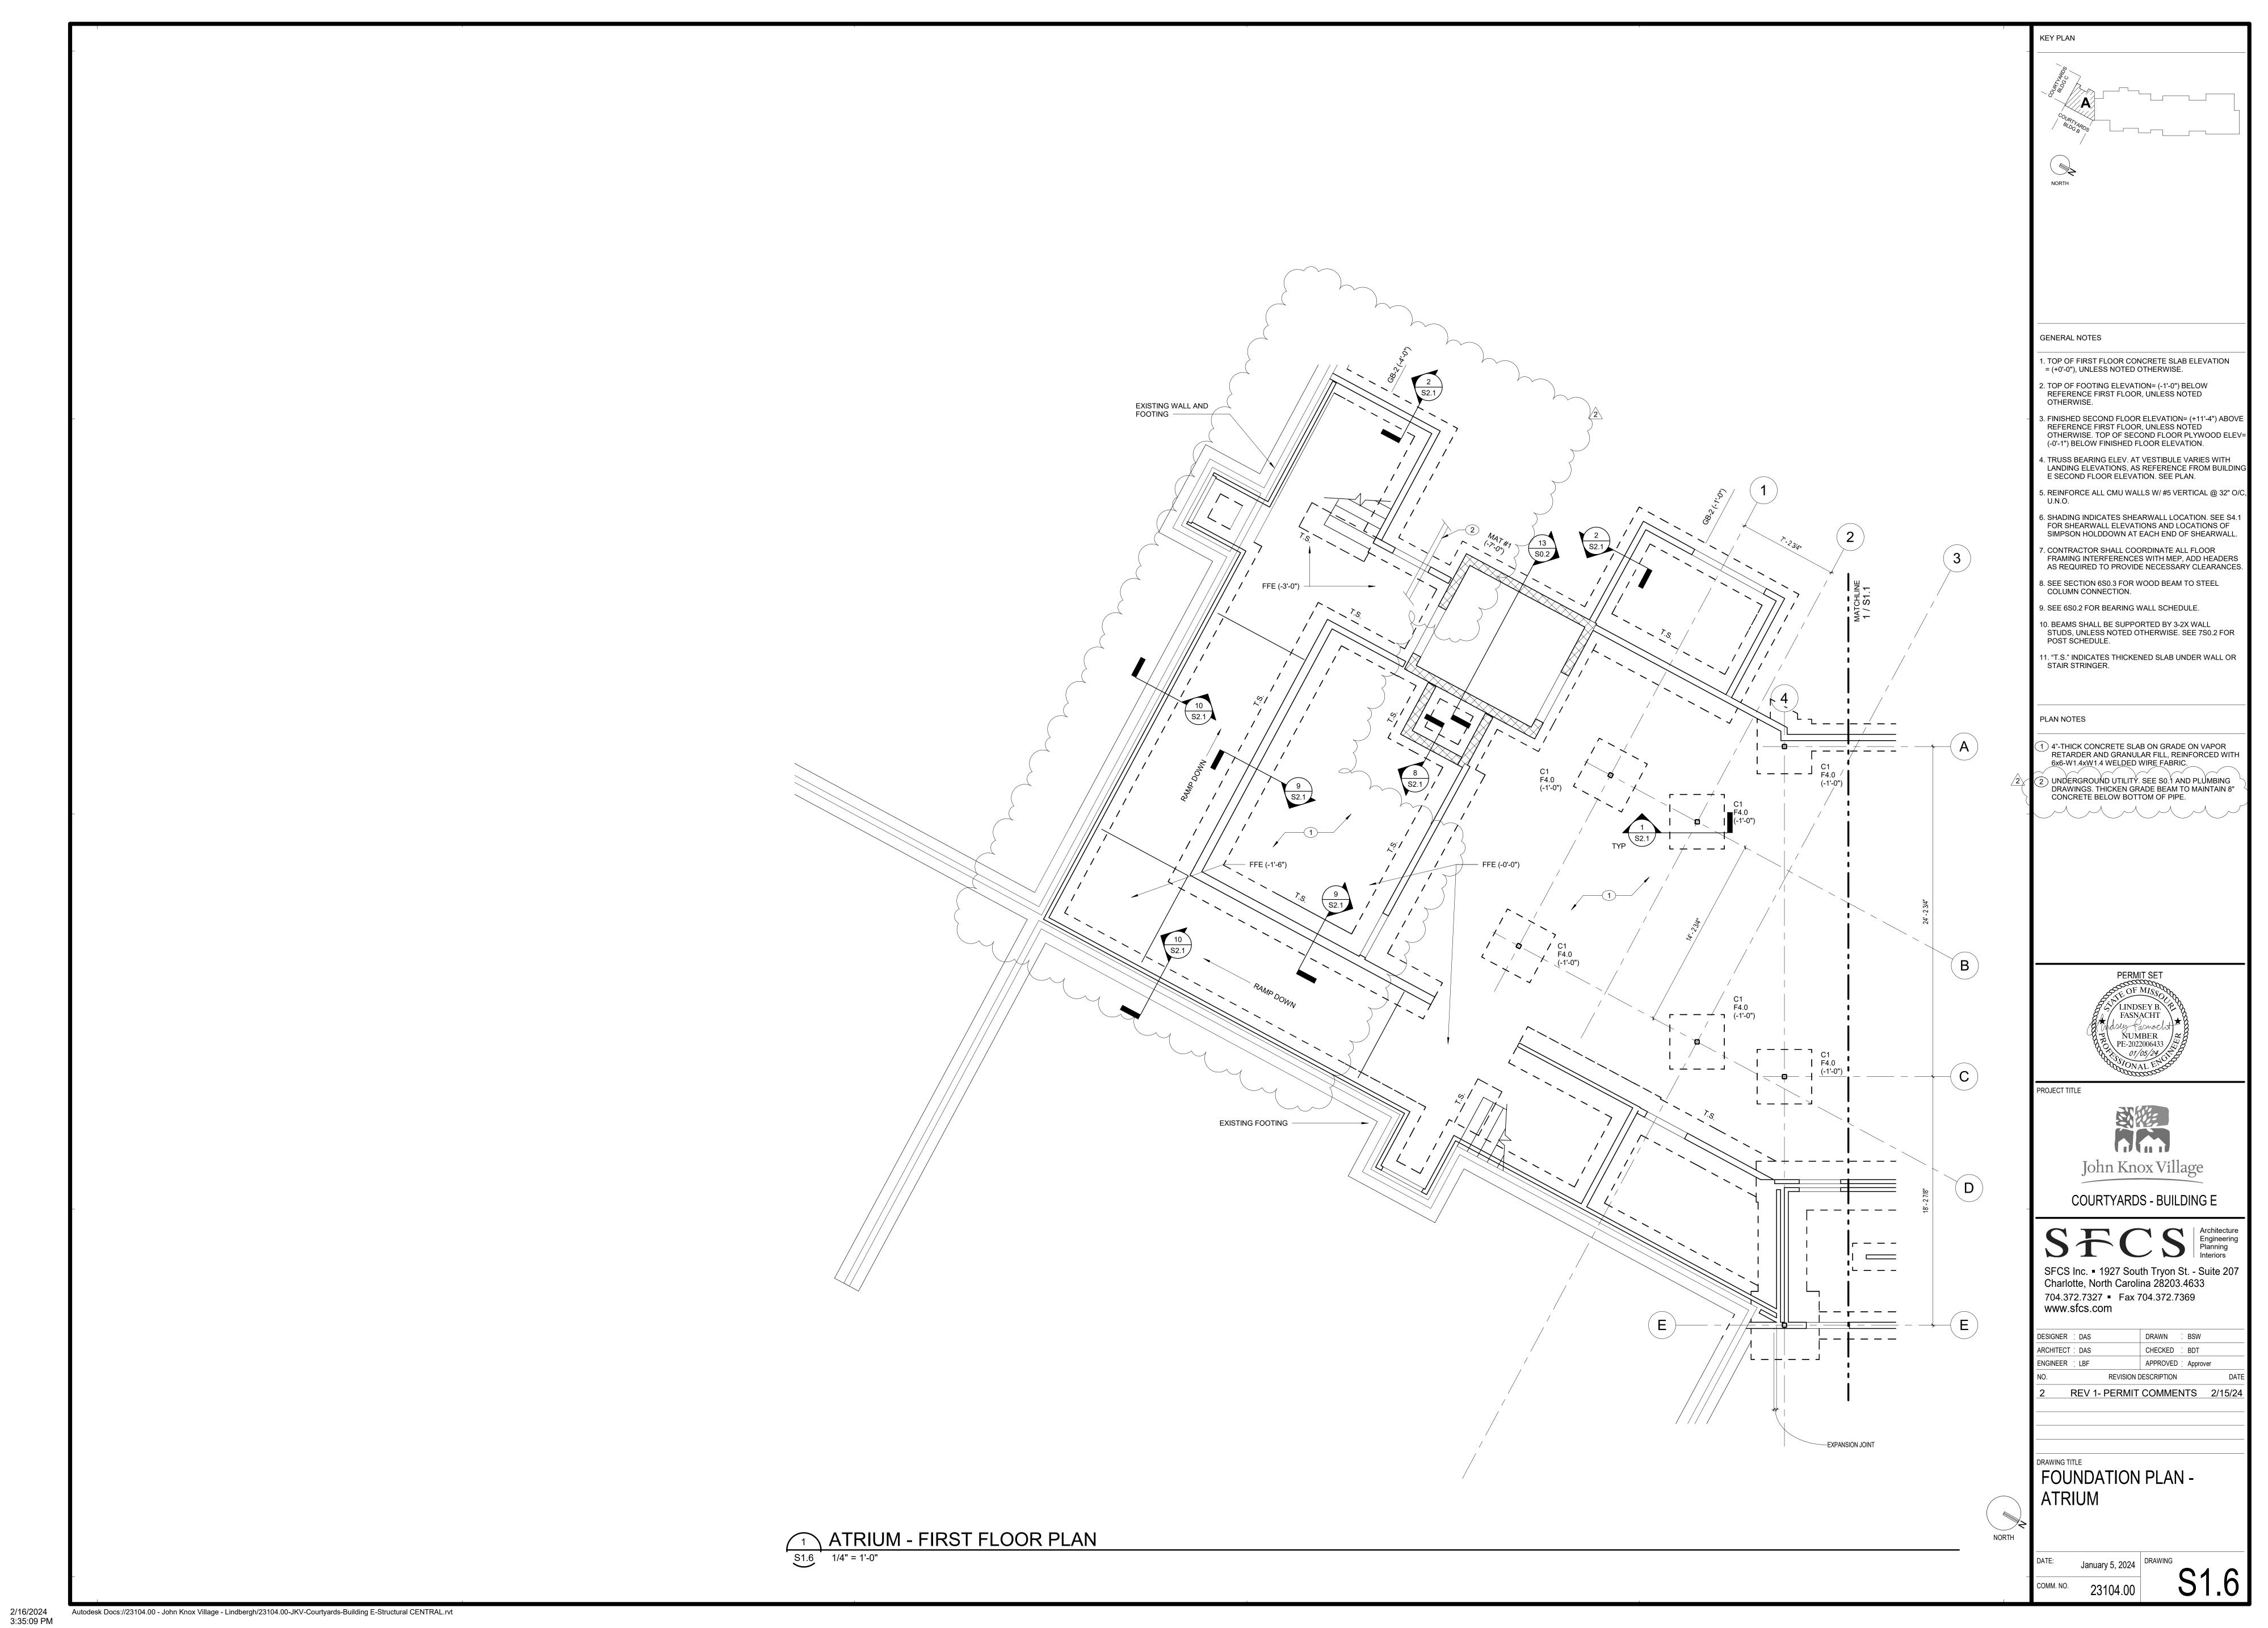


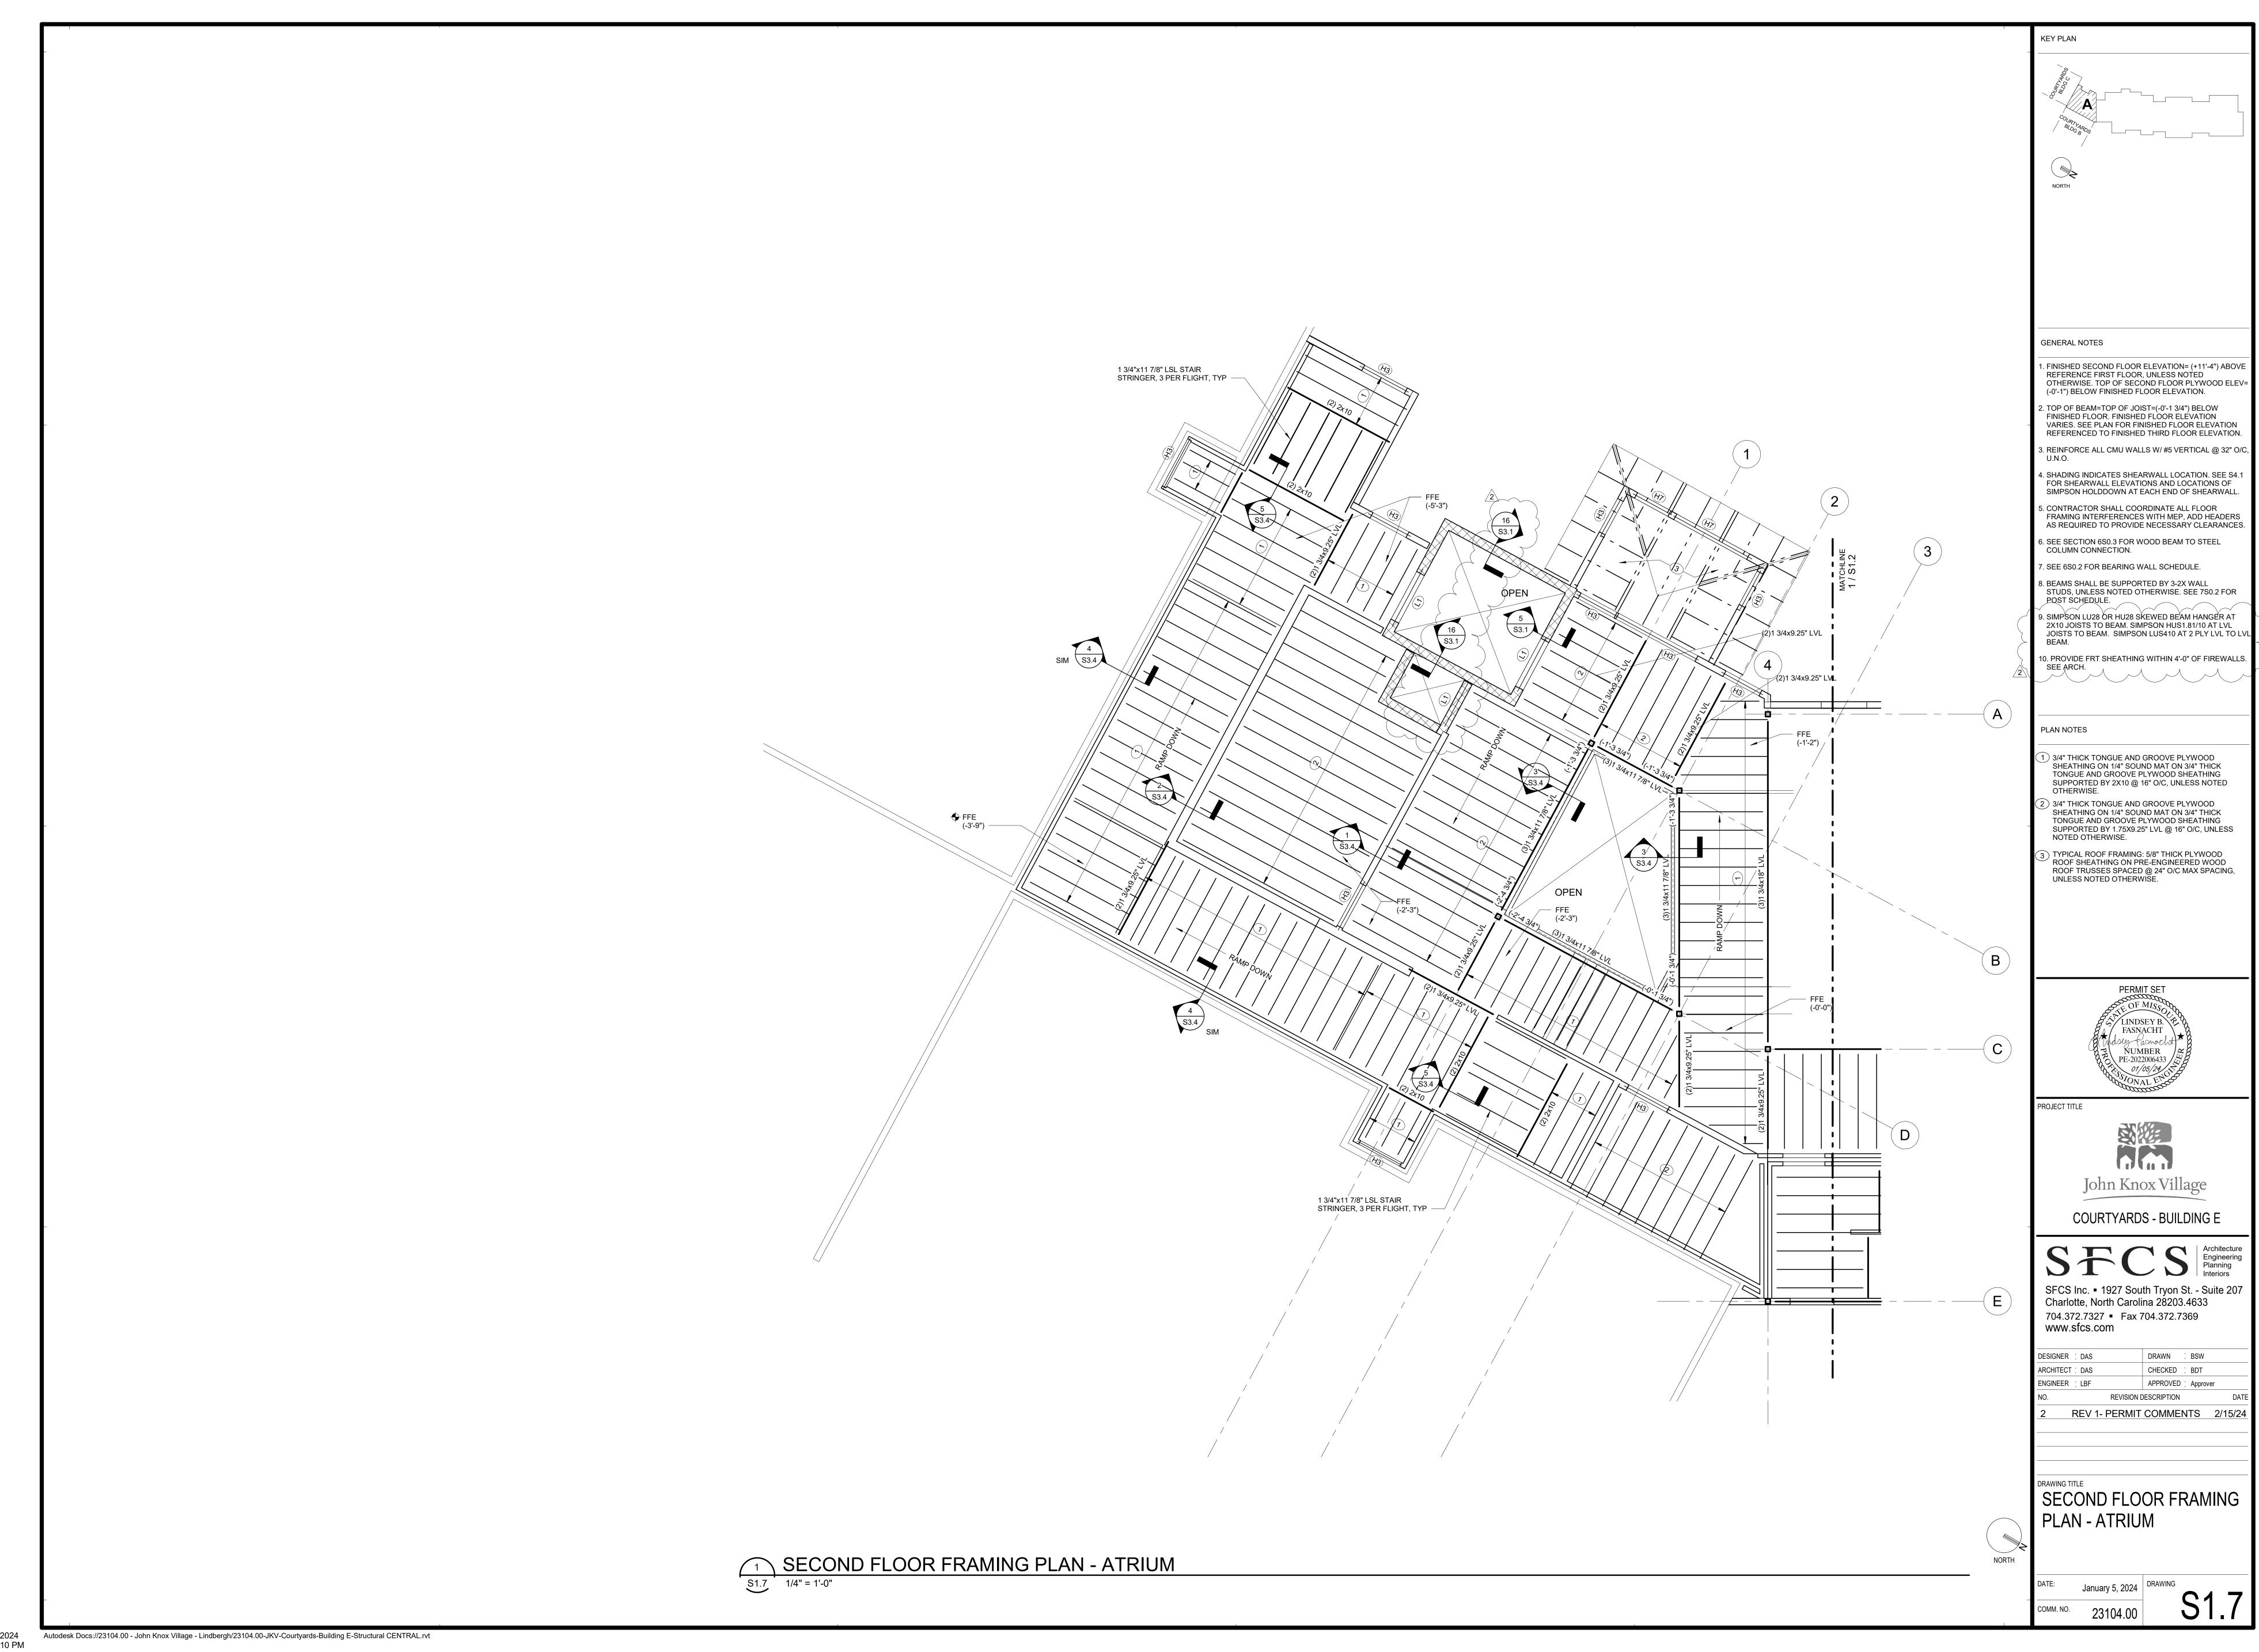



2/16/2024 3:35:10 F

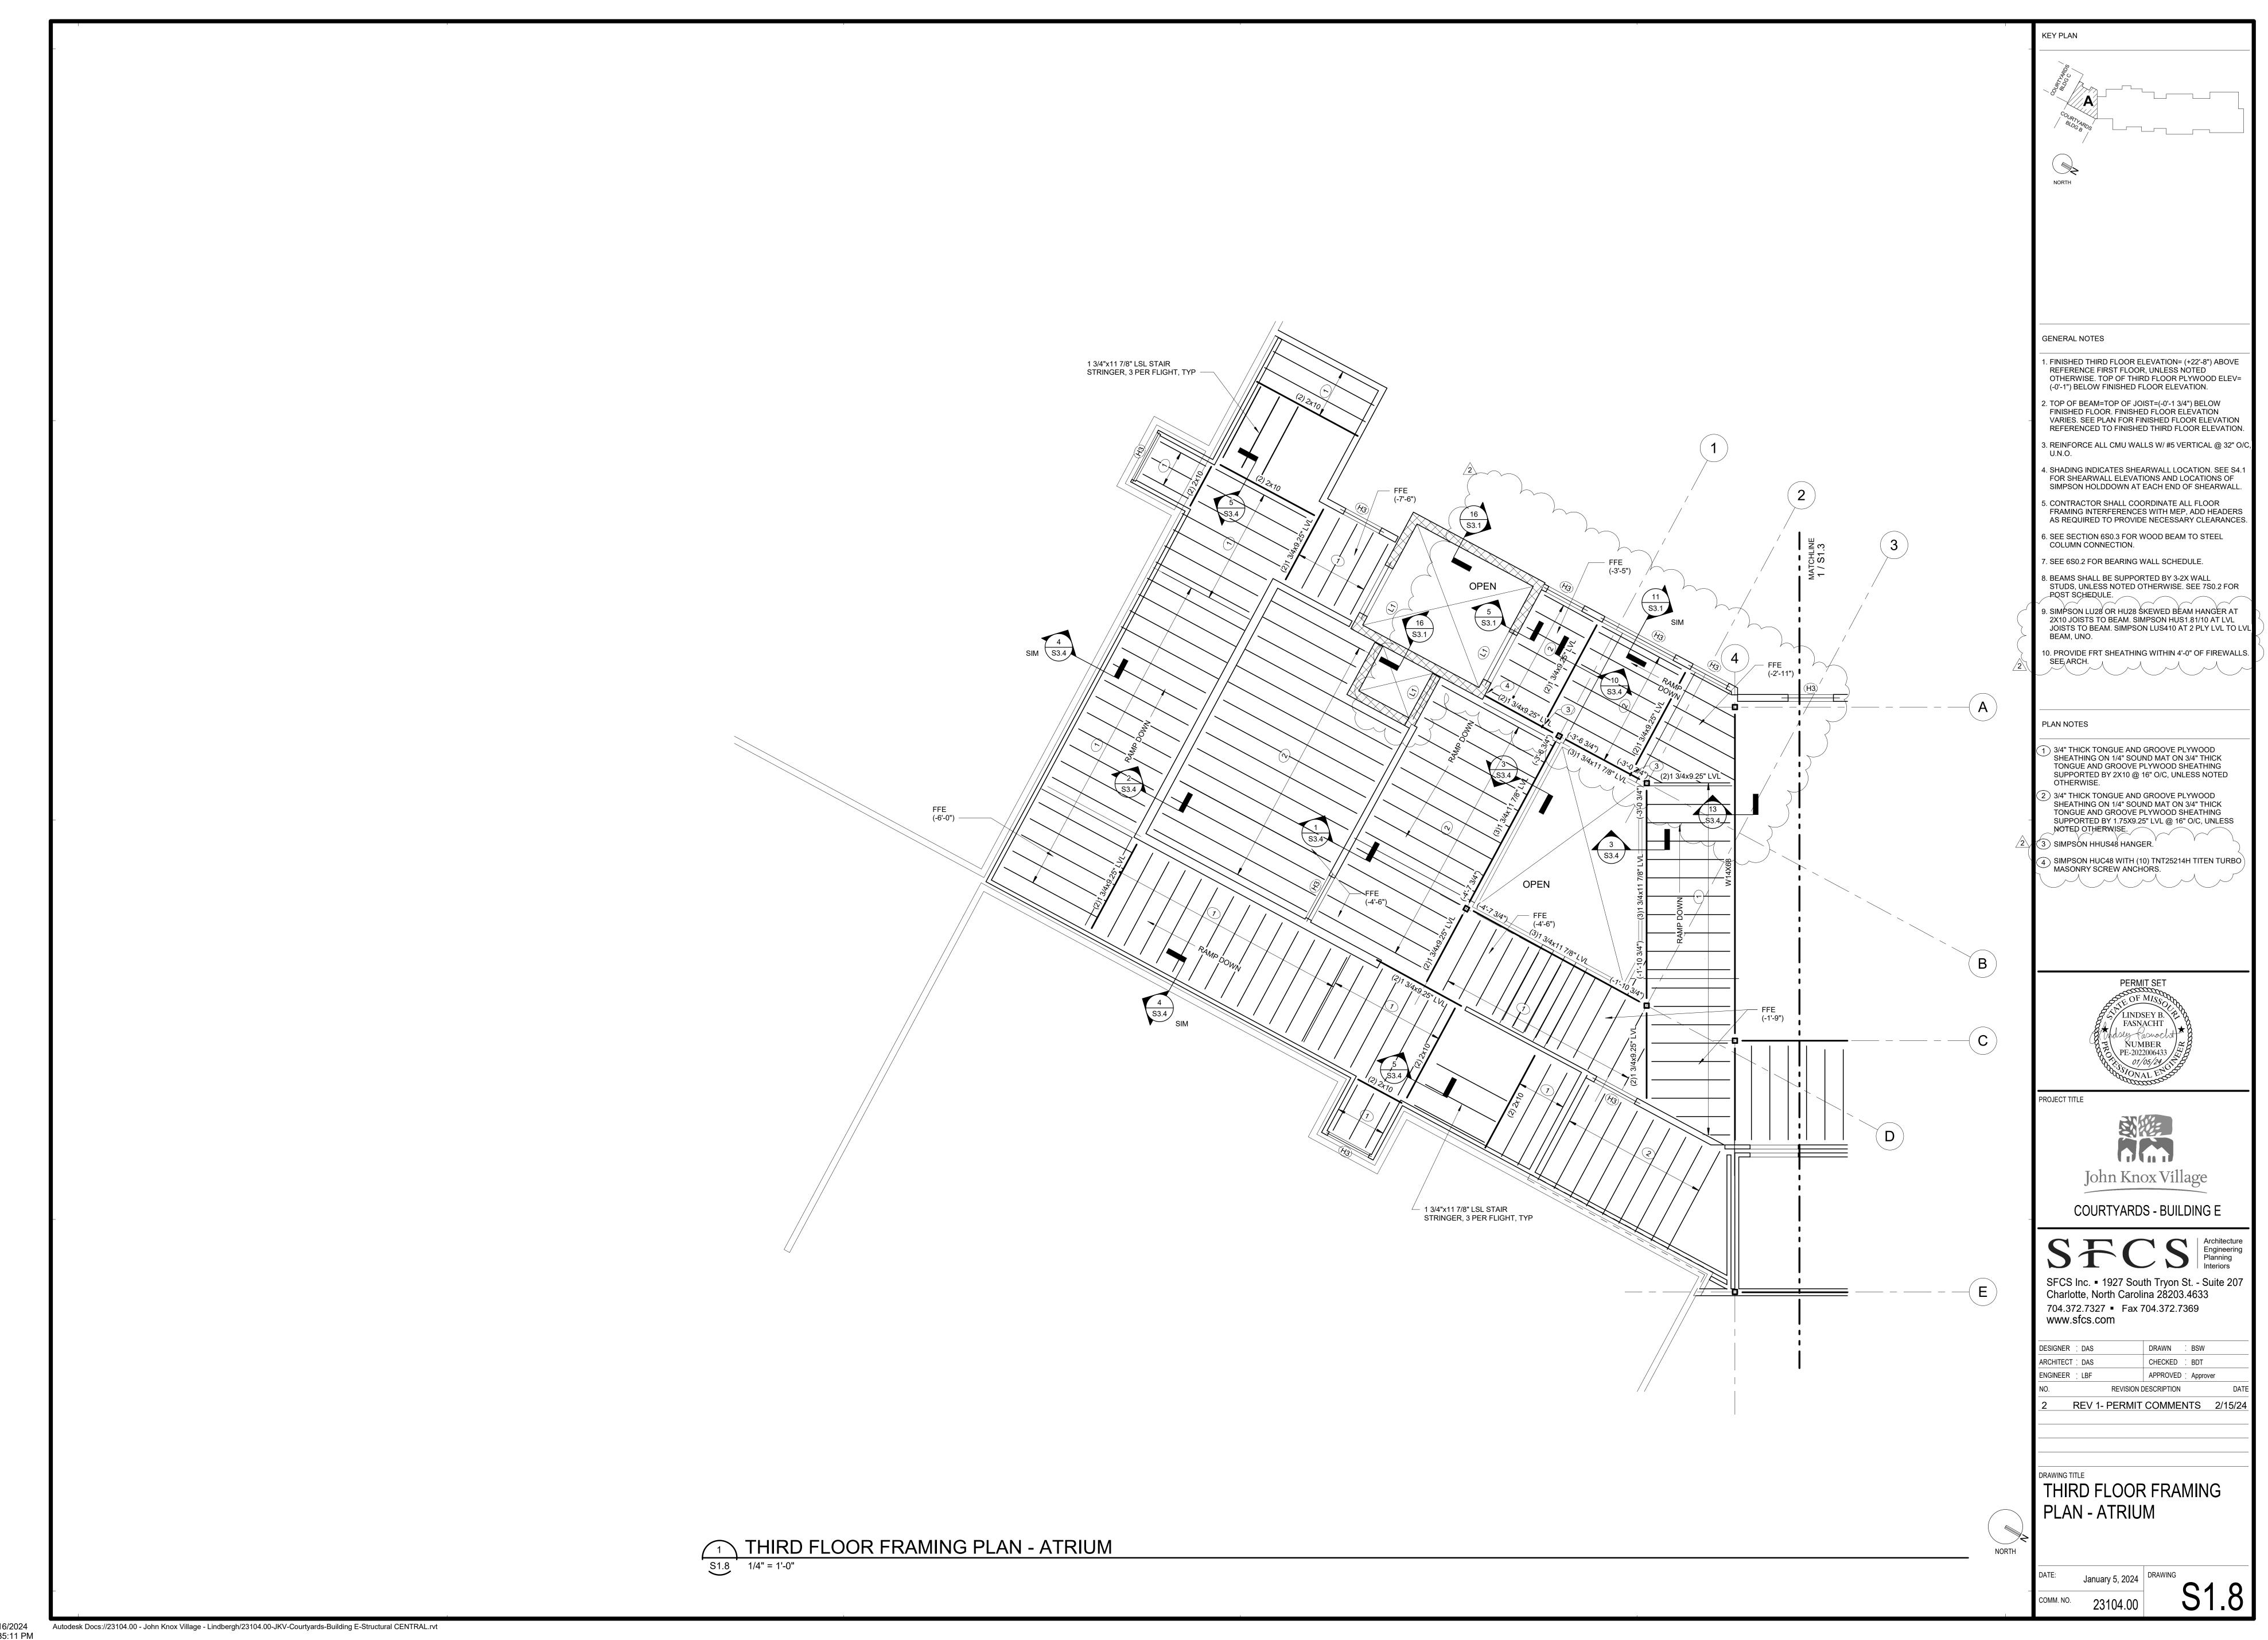


2/16/20:

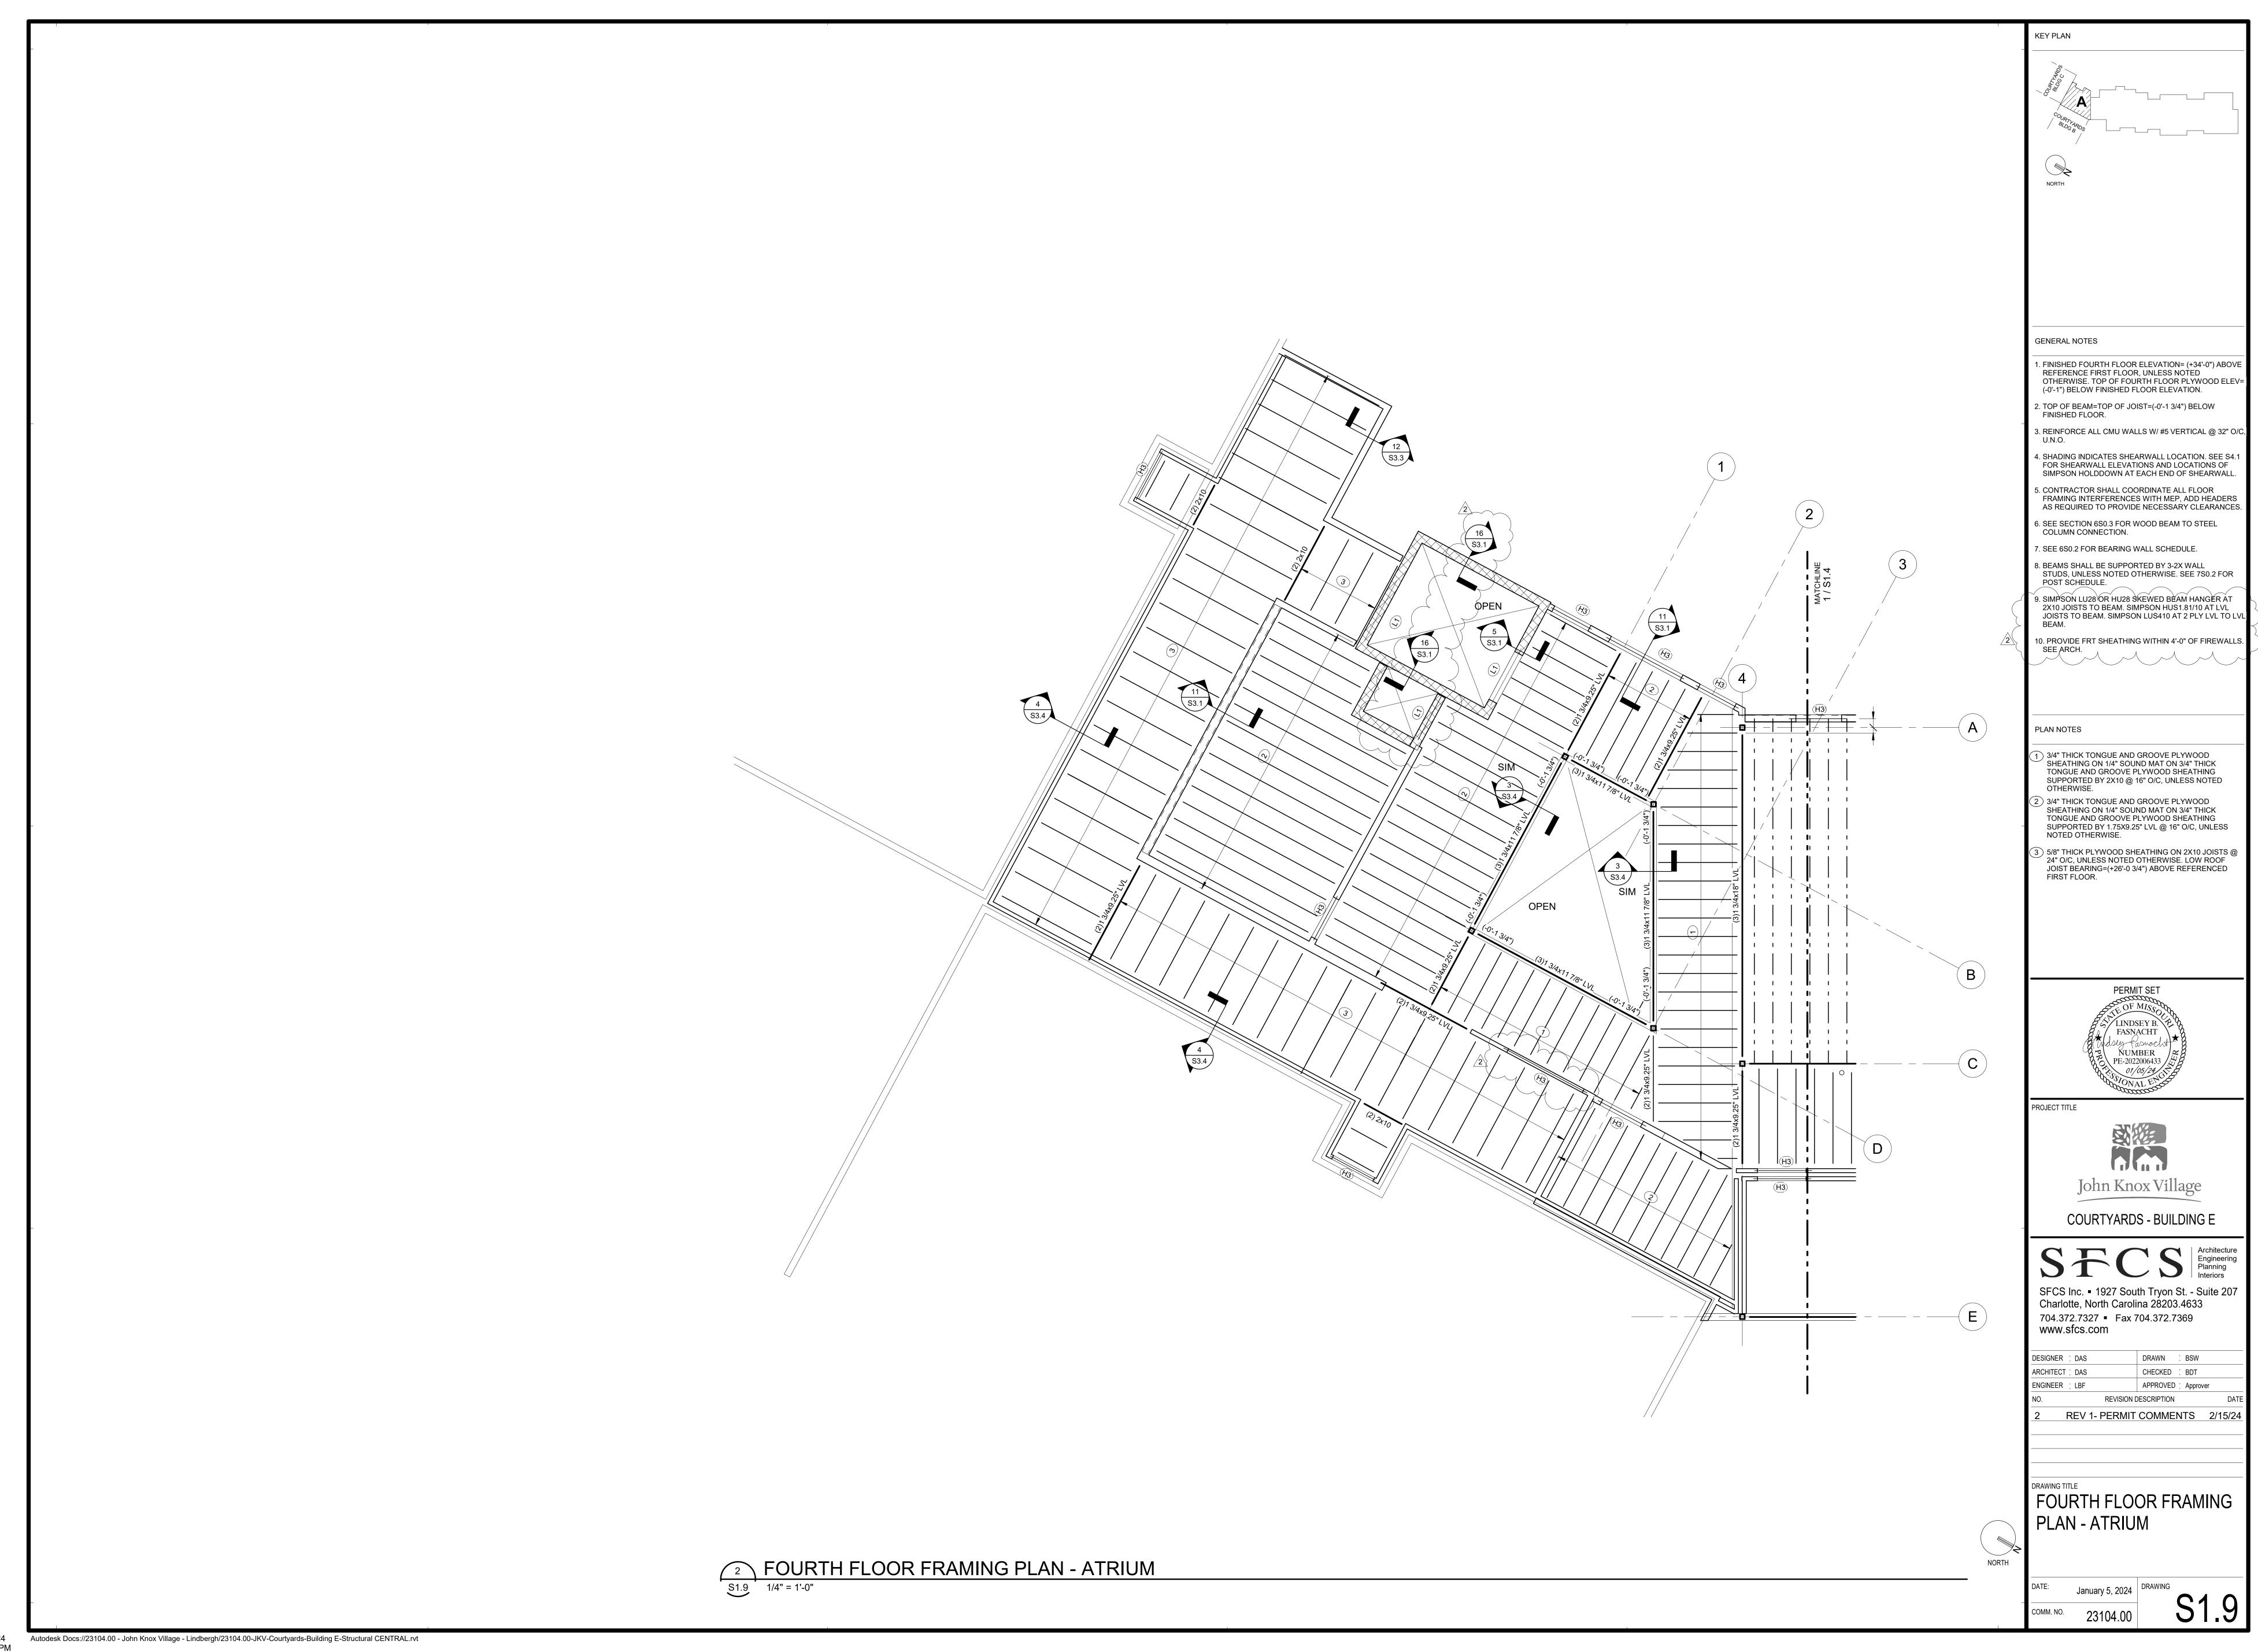

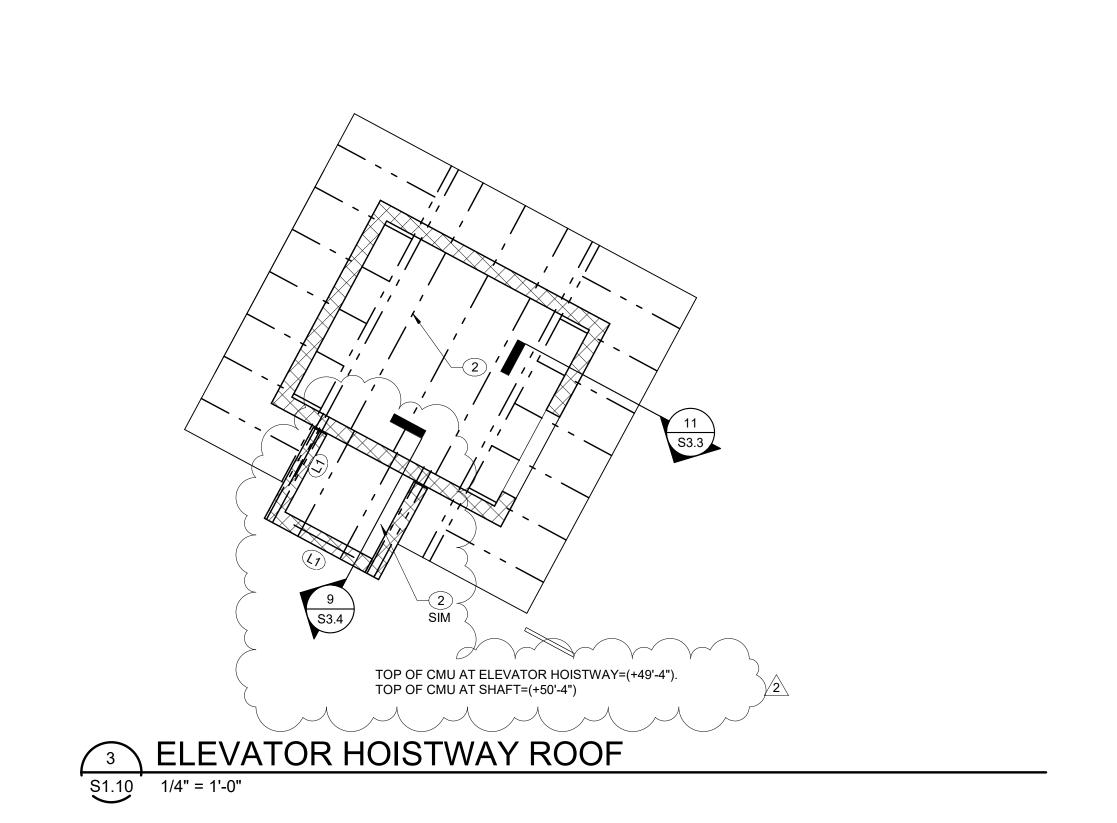

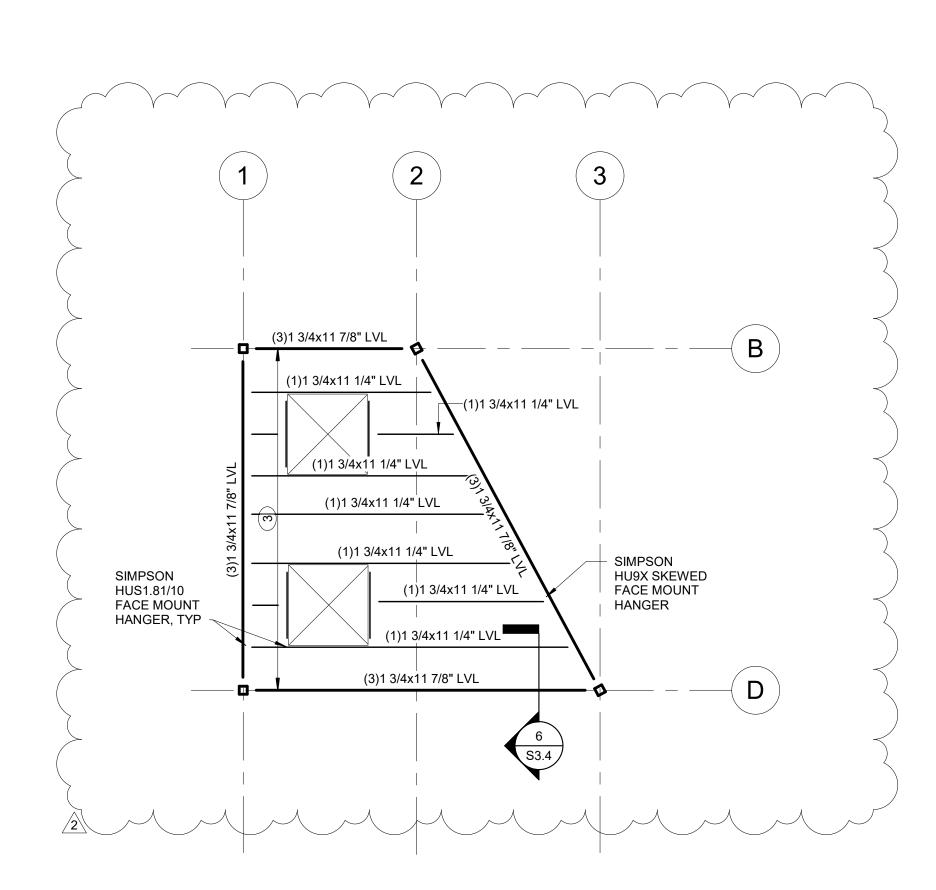



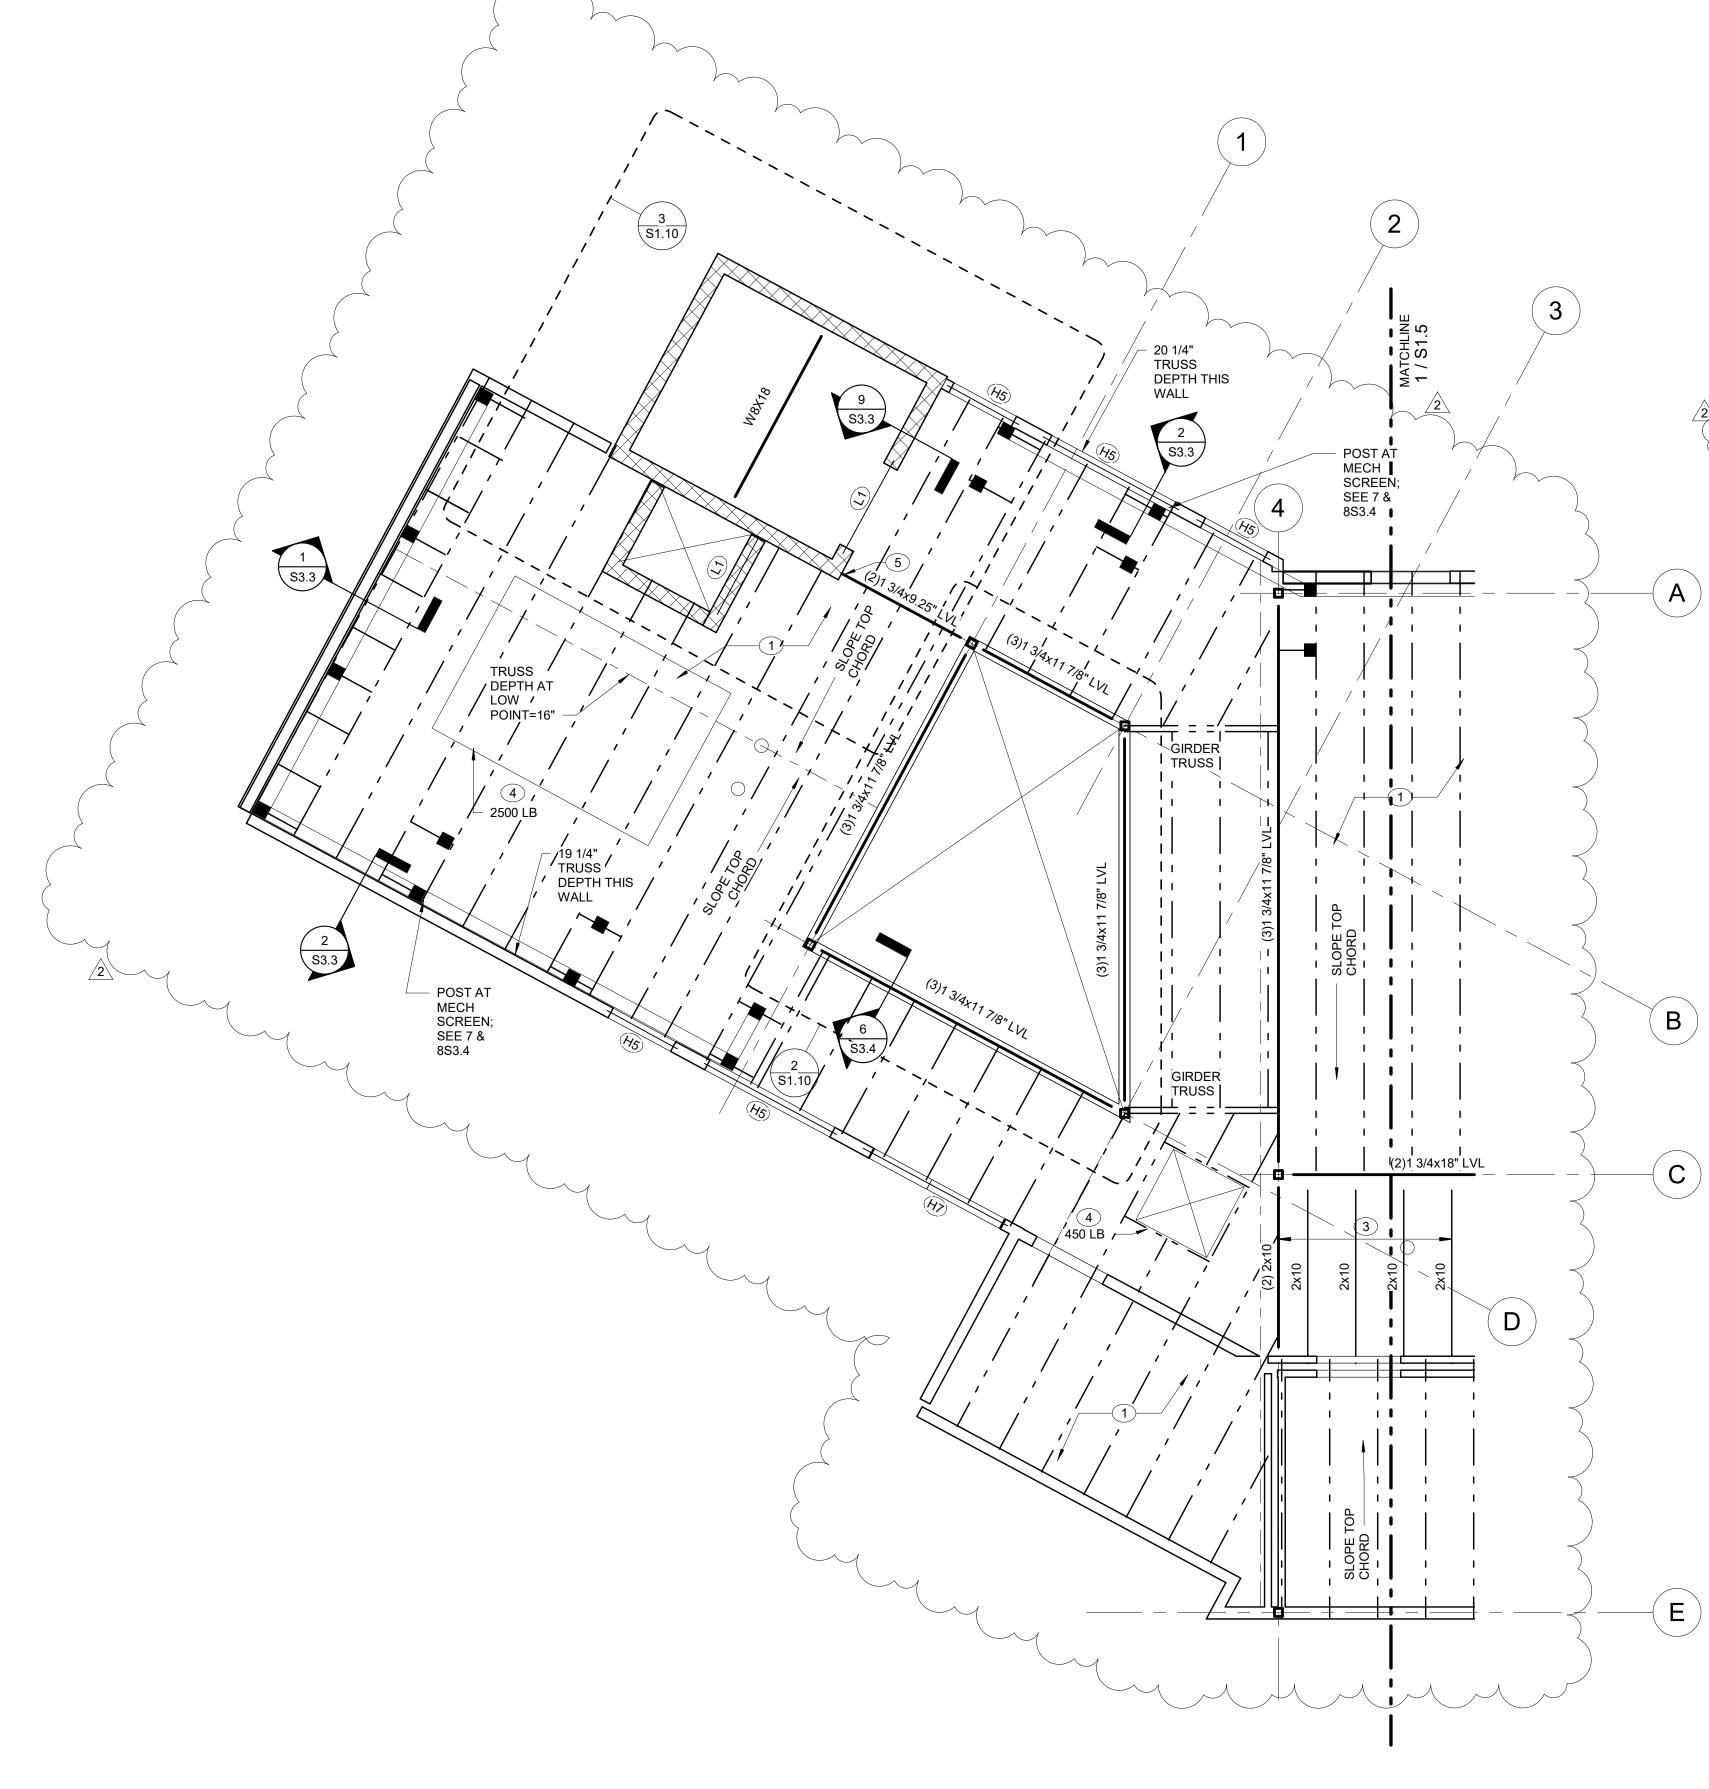

1 ROOF FRAMING PLAN - ATRIUM

S1.10 1/4" = 1'-0"

**GENERAL NOTES** 

KEY PLAN

1. ROOF TRUSS BEARING ELEVATION= (+43'-0 1/4") ABOVE REFERENCE FIRST FLOOR, UNLESS NOTED
OTHERWISE. CLERESTORY JOIST BEARING
ELEVATION=(+50'-4"), U.N.O. ELEVATOR HOISTWAY
JOIST BEARING=(+48'-11").

2. BOTTOM OF WOOD BEAM= ROOF TRUSS BEARING ELEVATION. TOP OF STL AT HOIST BEAM= (+48'-3, 3/4"). 3. REINFORCE ALL CMU WALLS W/ #5 VERTICAL @ 32" O/

4. SHADING INDICATES SHEARWALL LOCATION. SEE S4.1 FOR SHEARWALL ELEVATIONS AND LOCATIONS OF SIMPSON HOLDDOWN AT EACH END OF SHEARWALL. 5. CONTRACTOR SHALL COORDINATE ALL ROOF TRUSS FRAMING INTERFERENCES WITH MEP, ADD GIRDER
TRUSSES AND HEADERS AS REQUIRED TO PROVIDE

NECESSARY CLEARANCES. 6. SEE SECTION 6S0.3 FOR WOOD BEAM TO STEEL

COLUMN CONNECTION.

7. SEE 6S0.2 FOR BEARING WALL SCHEDULE. 8. BEAMS SHALL BE SUPPORTED BY 3-2X WALL STUDS, UNLESS NOTED OTHERWISE. SEE 7S0.2 FOR

POST SCHEDULE. 9. PROVIDE FRT SHEATHING WITHIN 4'-0" OF FIREWALLS.

PLAN NOTES

1 TYPICAL ROOF FRAMING: 5/8" THICK PLYWOOD ROOF SHEATHING ON PRE-ENGINEERED WOOD ROOF TRUSSES WITH TOP CHORD AT 1/4"/FOOT SLOPE SPACED @ 24" O/C MAX SPACING, UNLESS NOTED OTHERWISE. MINIMUM TRUSS DEPTH=16"

(2) TYPICAL HIGH ROOF FRAMING: 5/8" THICK PLYWOOD ROOF SHEATHING ON PRE-ENGINEERED WOOD ROOF TRUSSES SPACED @ 24" OC MAX SPACING OVER HORIZONTAL SHAFTLINER CAP; SEE ARCH. TRUSS DEPTH= 16" DEEP. 2X6 @ 24" OC AT SIM.

5/8" THICK PLYWOOD ROOF SHEATHING ON JOISTS @ 24" OC MAX SPACING.

DESIGN TRUSSES FOR RTU WEIGHT INDICATED ON PLAN. FINAL LOCATION OF POINT LOADS SHALL BE COORDINATED WITH ACTUAL SELECTED RTU CURB DIEMSNIONS. SEE 10/S3.3 AT CURB.

SIMPSON HUC48 HANGER AT BEAM TO CMU WITH (14) TNT25214H TITEN TURBO MASONRY SCREW ANCHORS

LINDSEY B. FASNACHT Indsey Pasnocht NUMBER PE-2022006433

PROJECT TITLE

John Knox Village

COURTYARDS - BUILDING E

SFCS Inc. • 1927 South Tryon St. - Suite 207 Charlotte, North Carolina 28203.4633 704.372.7327 • Fax 704.372.7369

DESIGNER : DAS DRAWN : BSW ARCHITECT : DAS CHECKED : BDT APPROVED : Approver REVISION DESCRIPTION


www.sfcs.com


REV 1- PERMIT COMMENTS 2/15/24

ROOF FRAMING PLAN -ATRIUM

Autodesk Docs://23104.00 - John Knox Village - Lindbergh/23104.00-JKV-Courtyards-Building E-Structural CENTRAL.rvt

3:34:53 PM

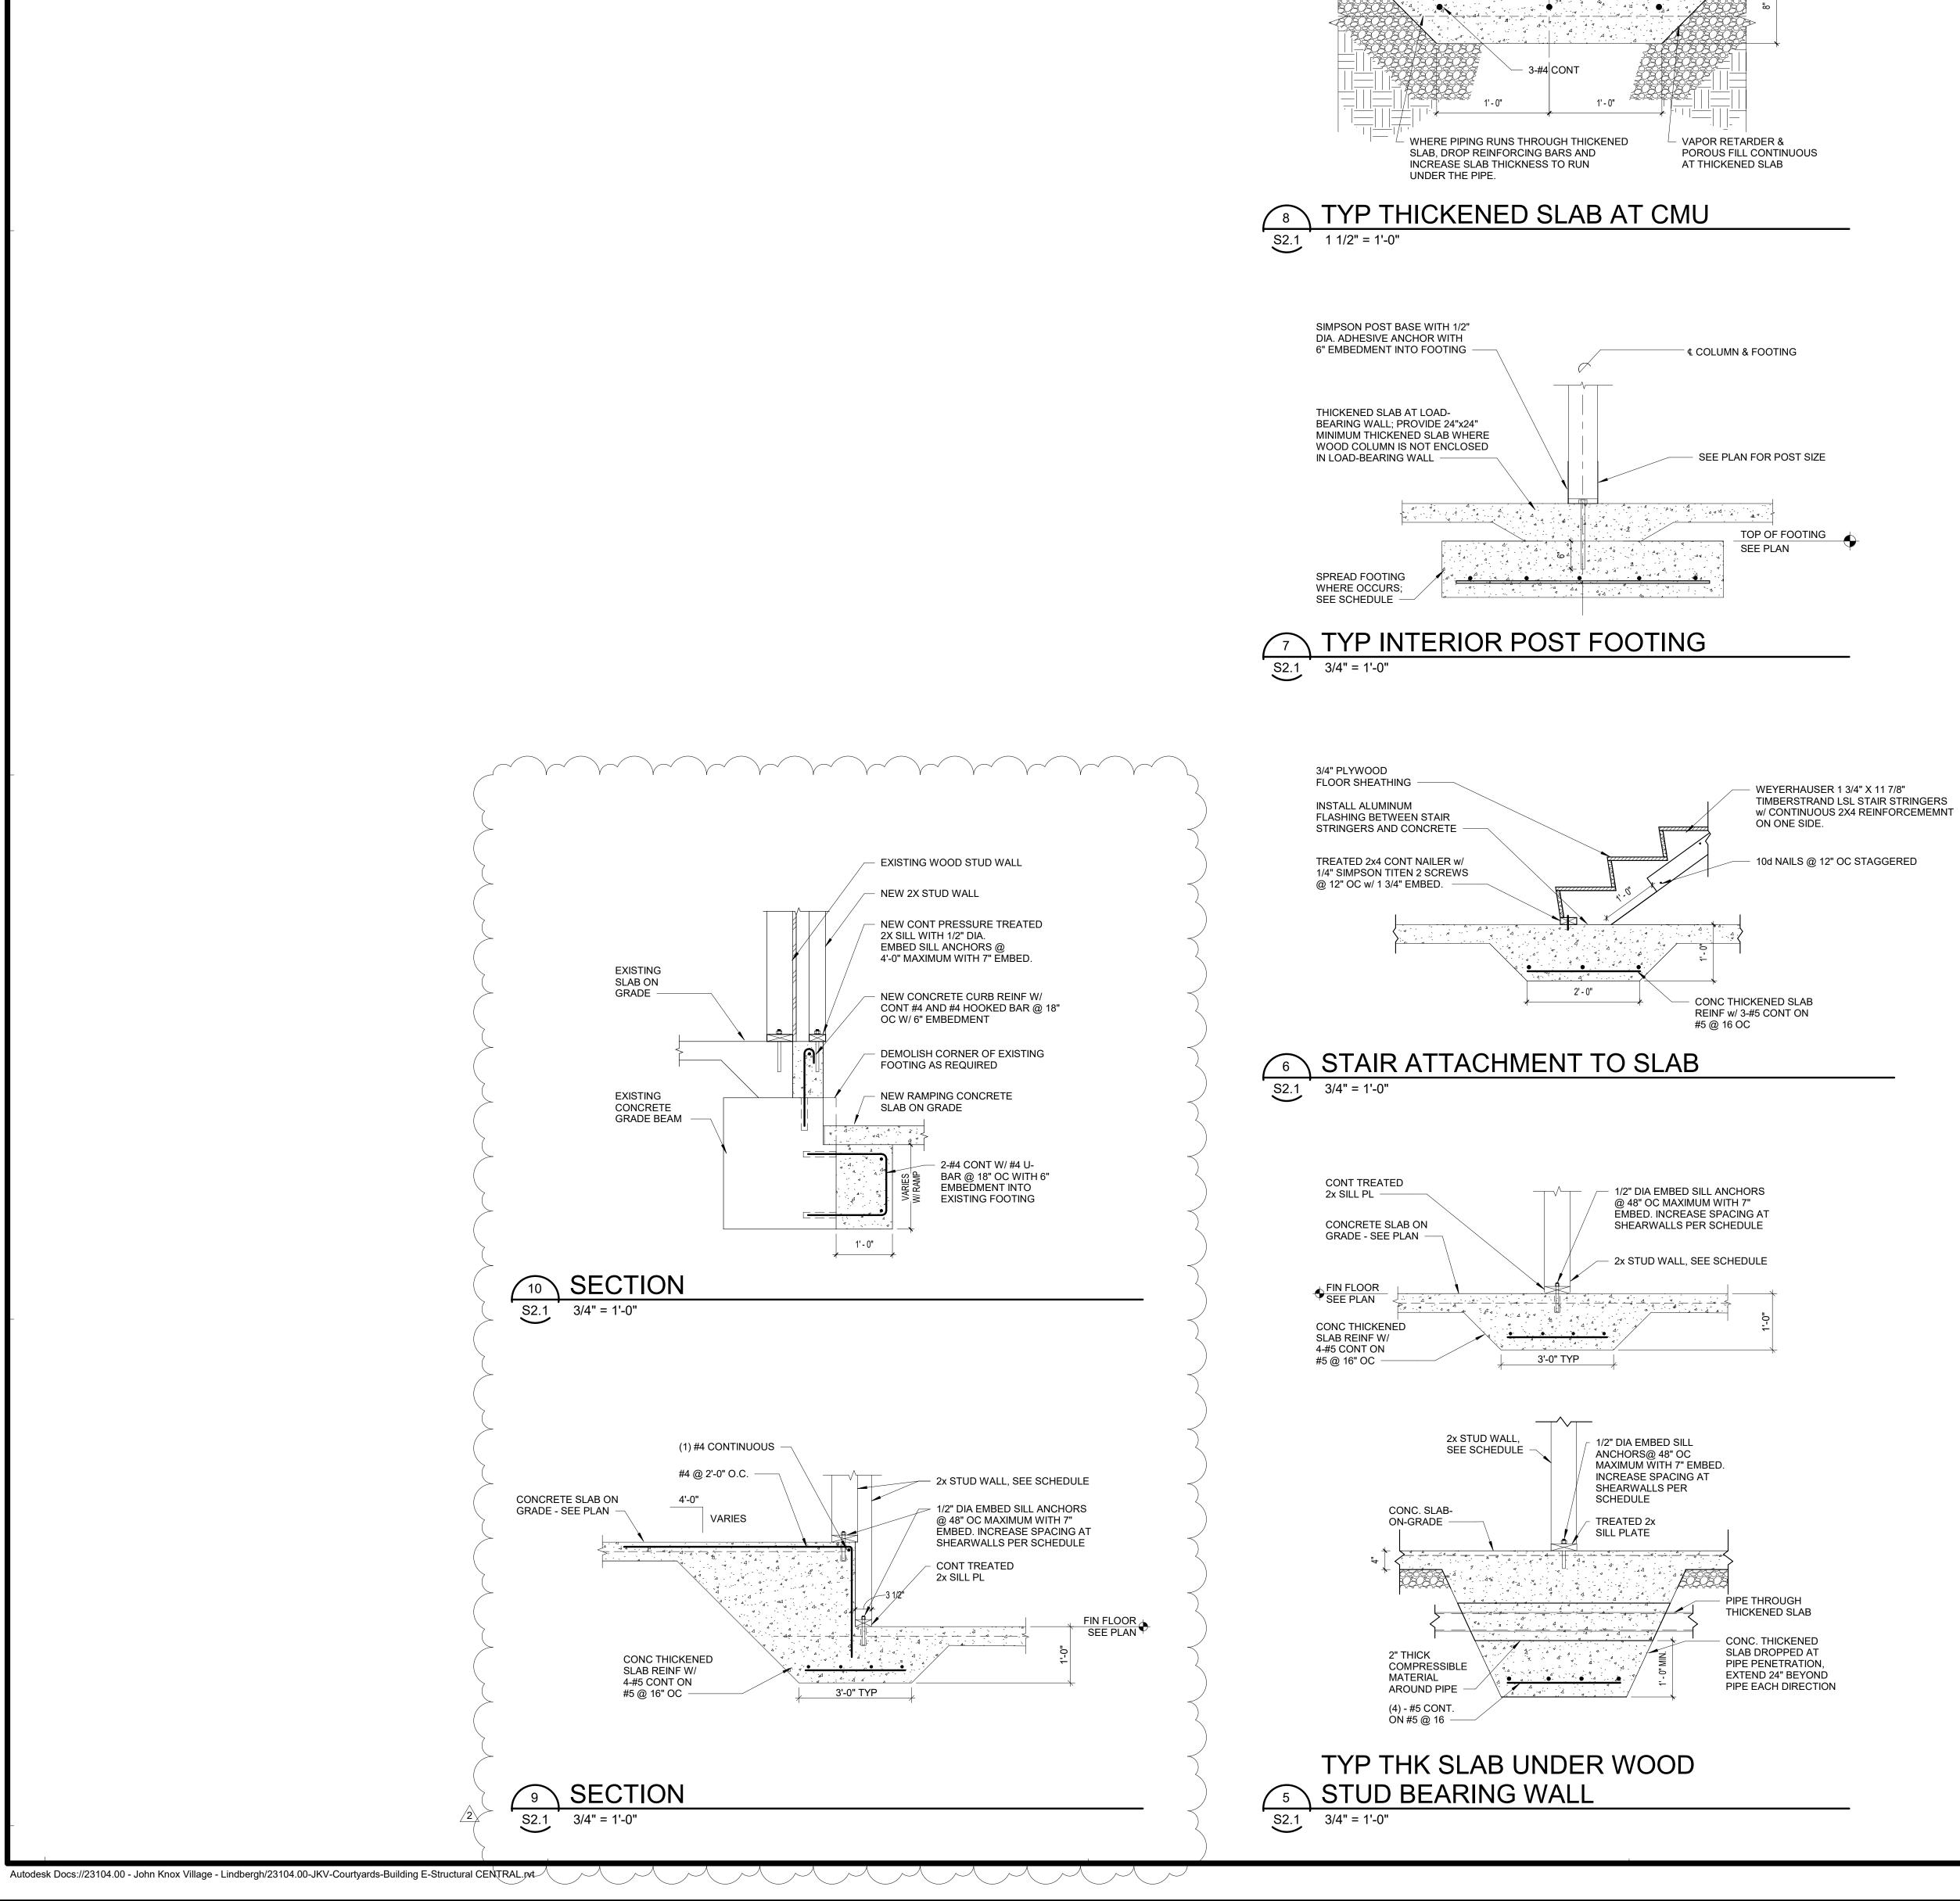

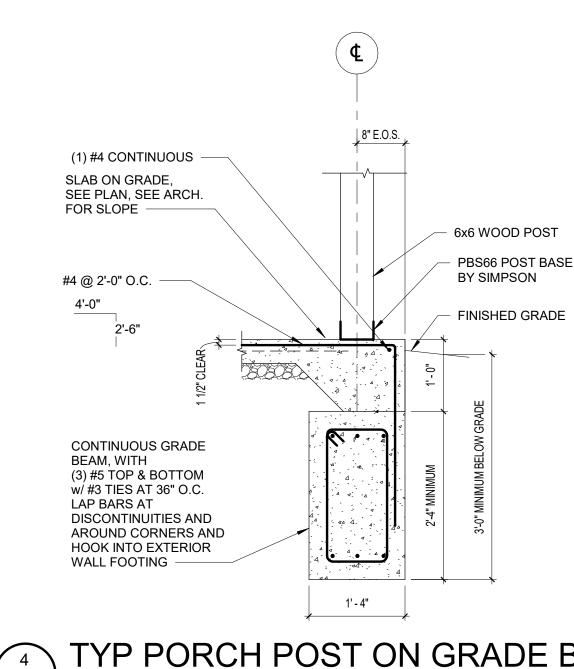

S2.1 3/4" = 1'-0"

CL WALL

CMU SHAFT WALL,

VERTICAL REINFORCING

SEE PLAN

SEE PLAN


DOWELS - SIZE & SPACING TO MATCH VERT WALL

TYPICAL SLAB ON GRADE -


REINF

SEE PLAN


# TYP PORCH POST ON GRADE BEAM

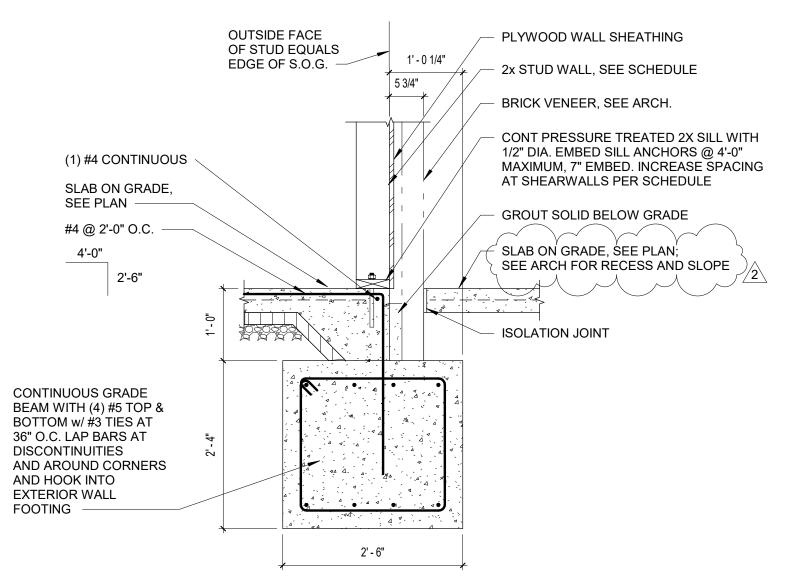

#### TYP GRADE BEAM WITH EXTERIOR SLAB S2.1 3/4" = 1'-0"

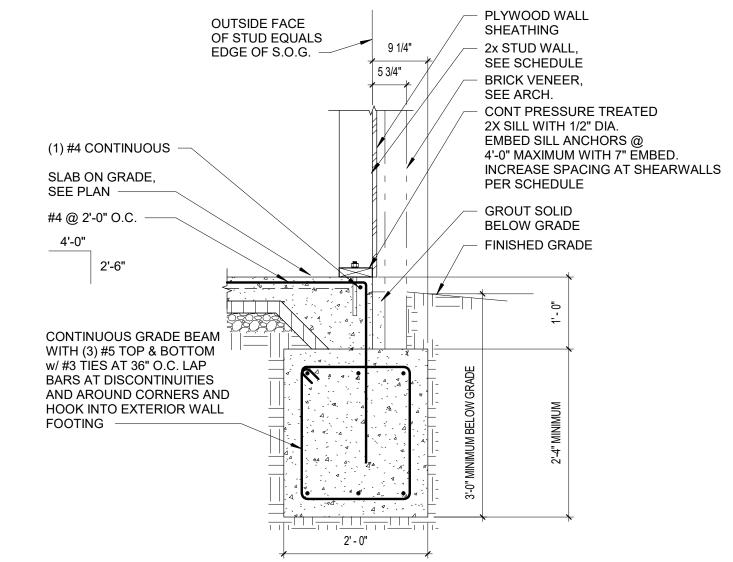


## TYP BEARING WALL ON PERIMETER GRADE BEAM

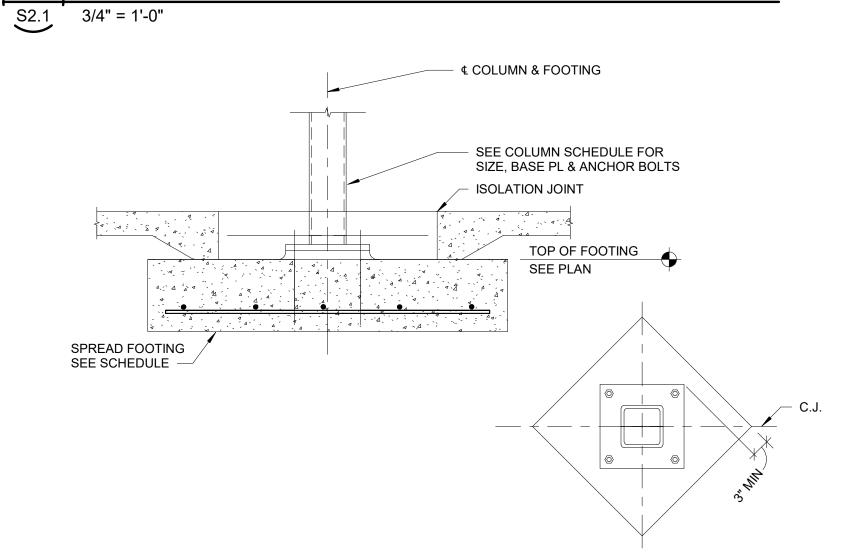

PLAN

1 TYP STEEL COLUMN ON INTERIOR FOOTING S2.1 3/4" = 1'-0"

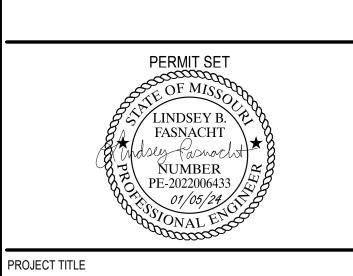


John Knox Village COURTYARDS - BUILDING E


SFCS Inc. • 1927 South Tryon St. - Suite 207 Charlotte, North Carolina 28203.4633 704.372.7327 • Fax 704.372.7369 www.sfcs.com


DESIGNER : DAS	DRAWN : BSW	
ARCHITECT : DAS	CHECKED : BDT	
ENGINEER : LBF	APPROVED : Appro	over
NO. REVISION D	DESCRIPTION	DATE
2 REV 1- PERMIT	COMMENTS	2/15/24


FOUNDATION SECTIONS AND DETAILS


COMM. NO.

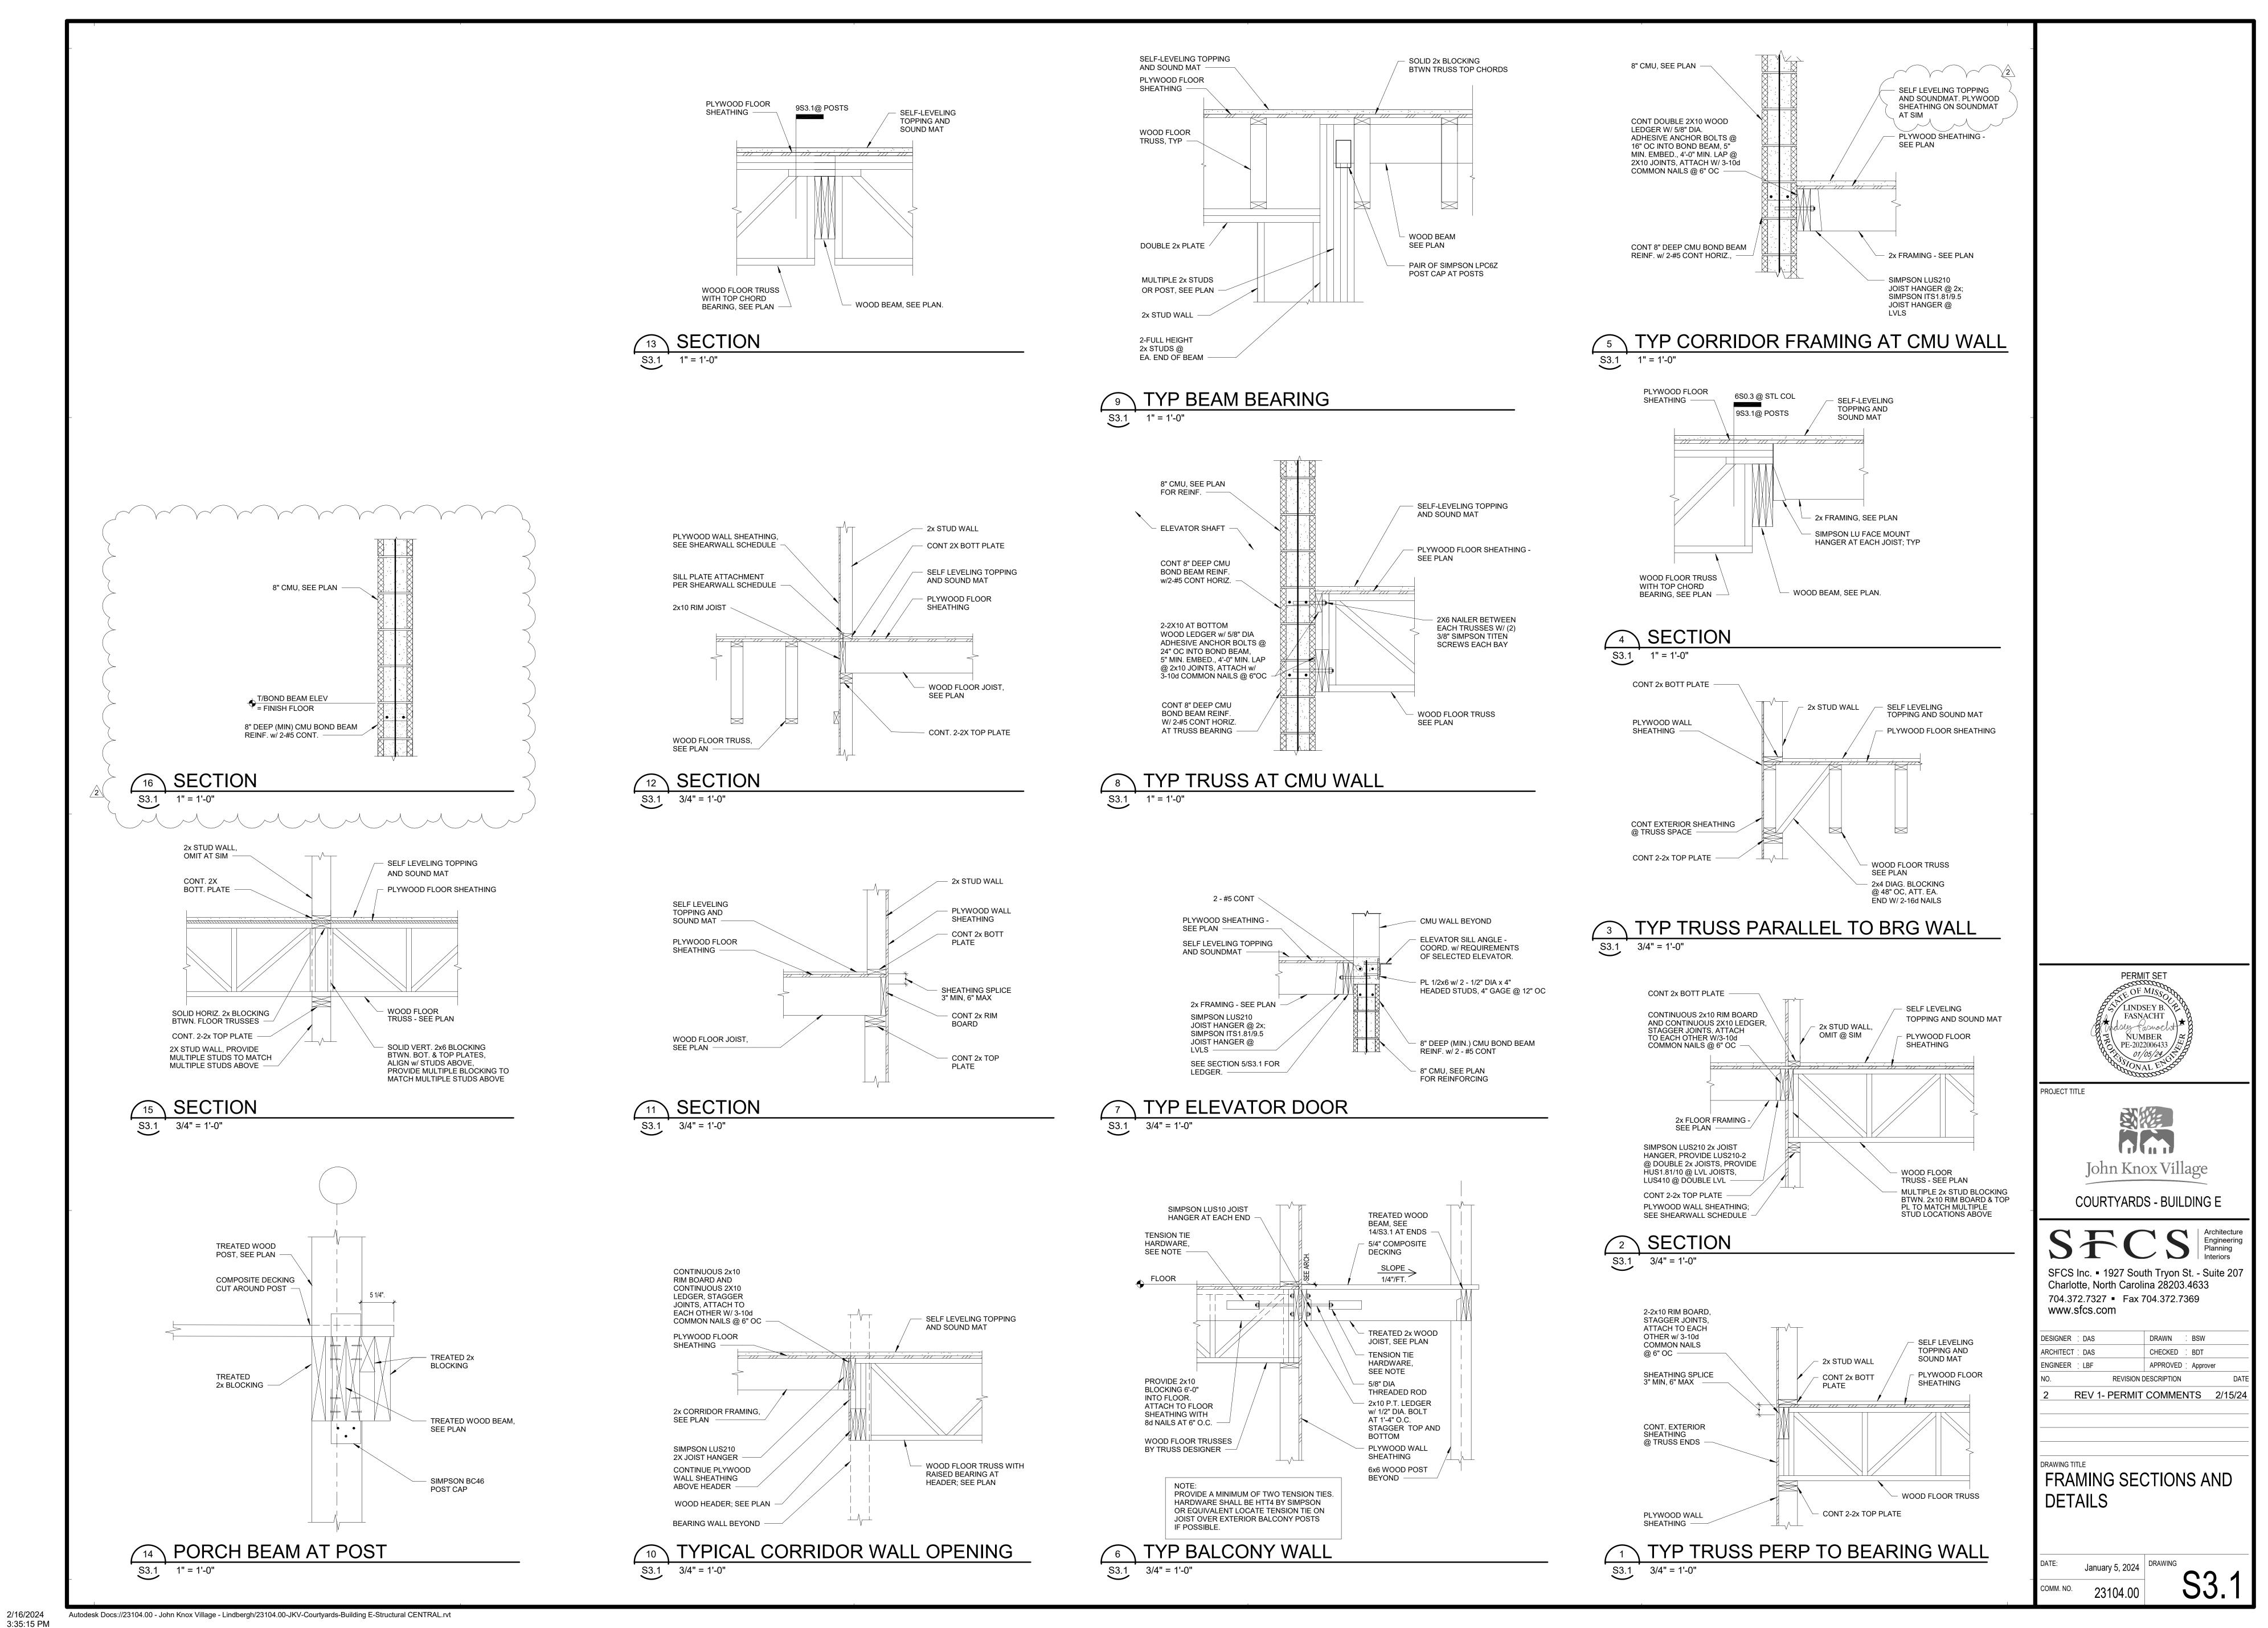

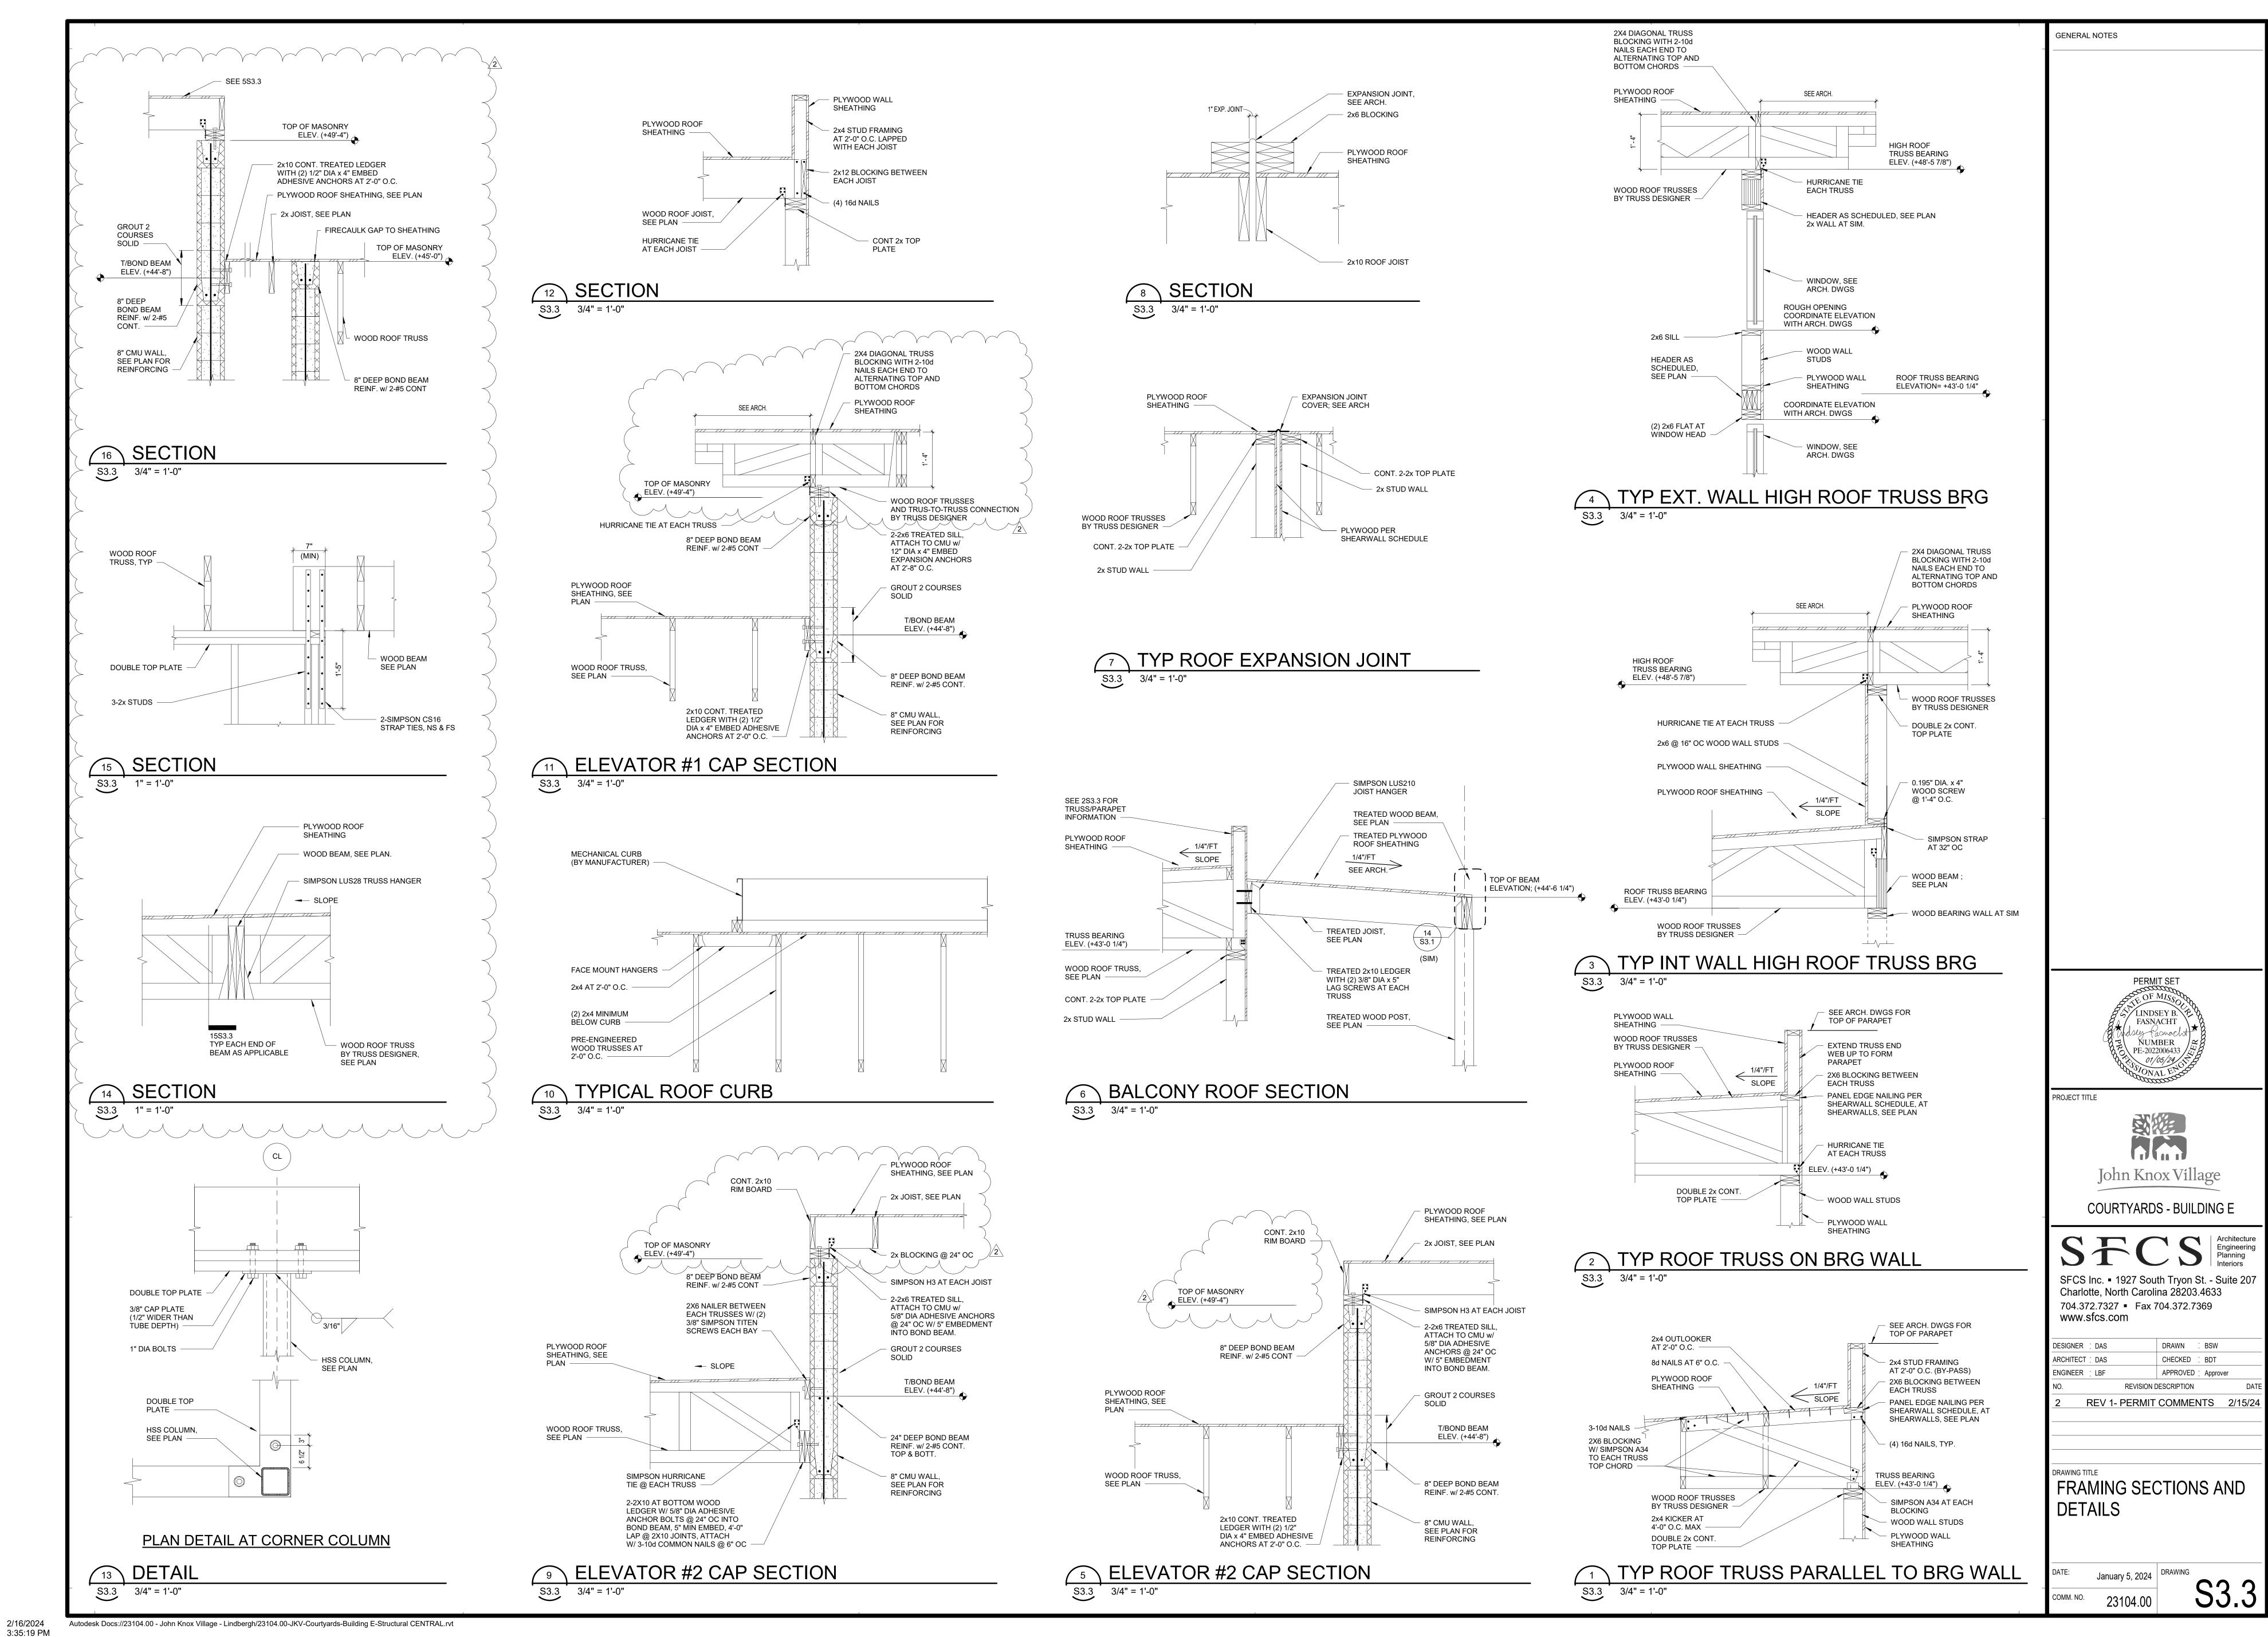

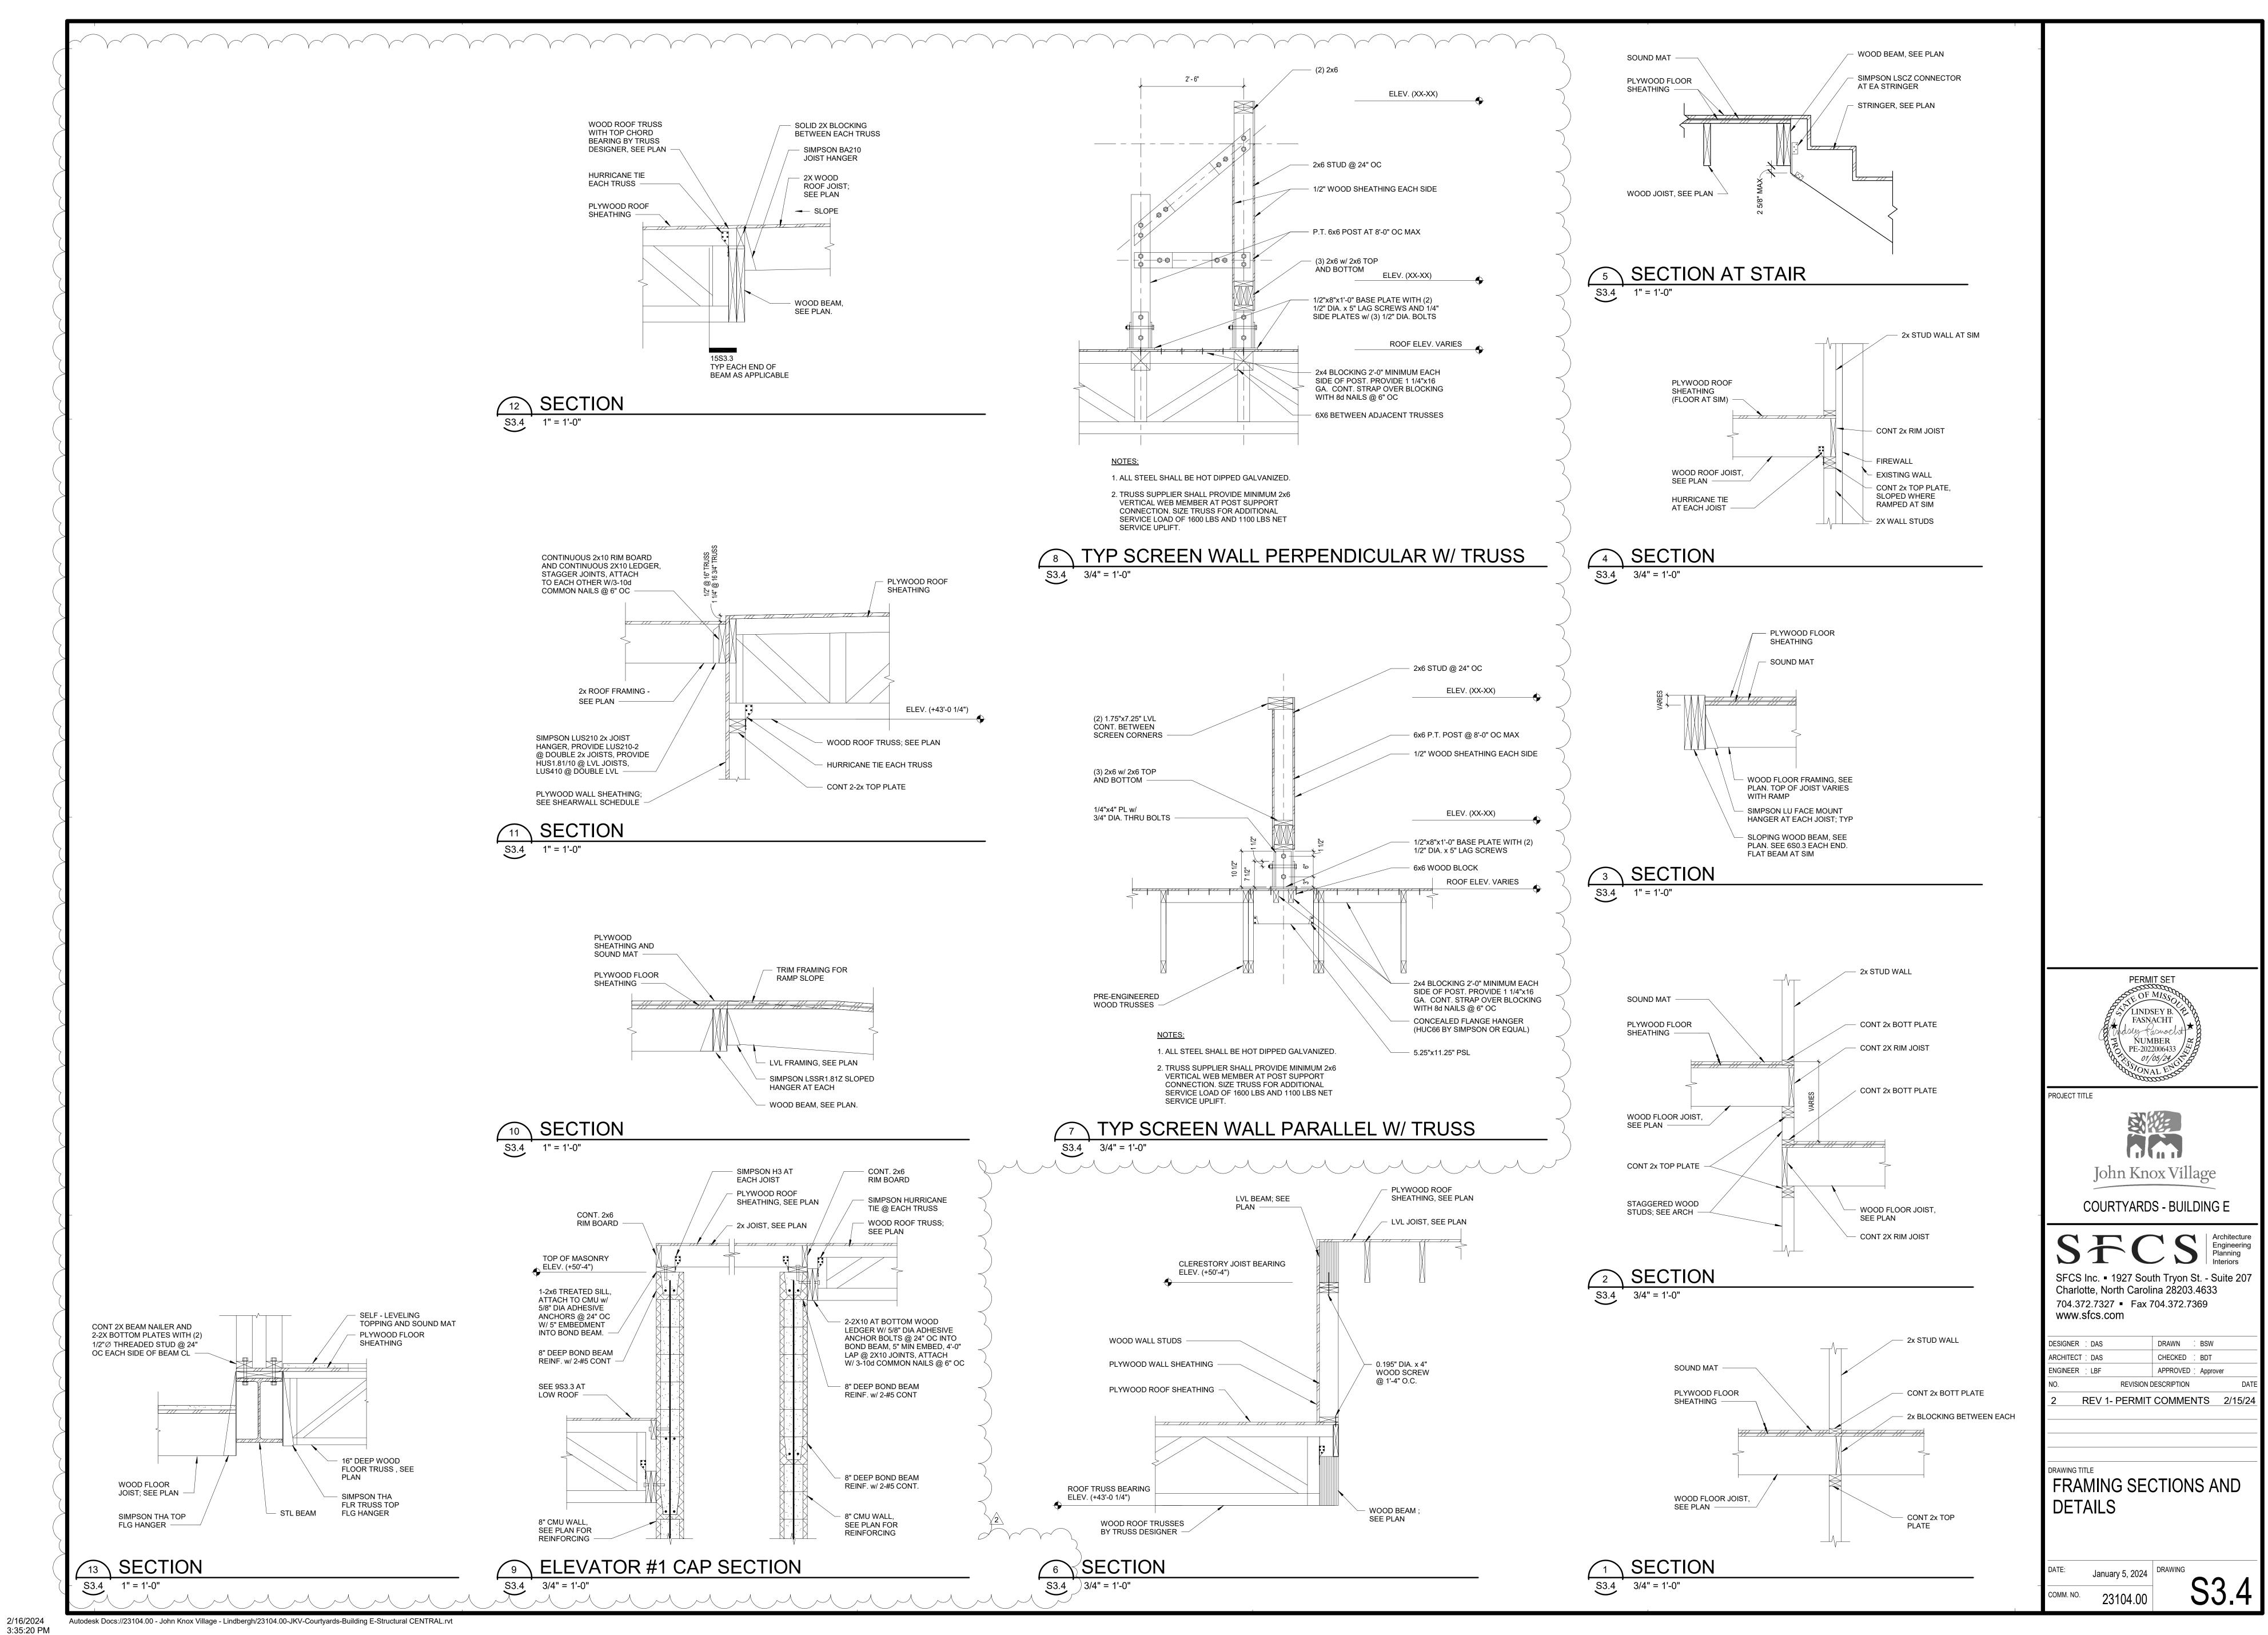

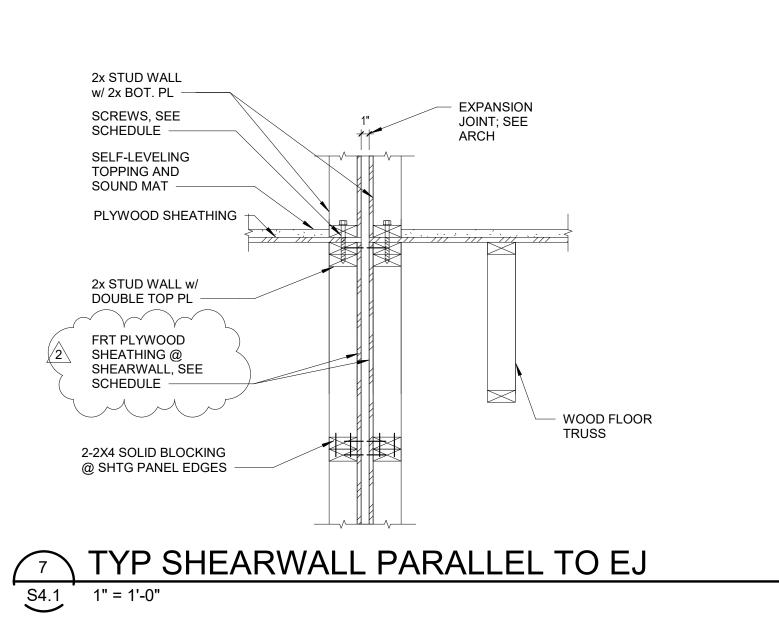

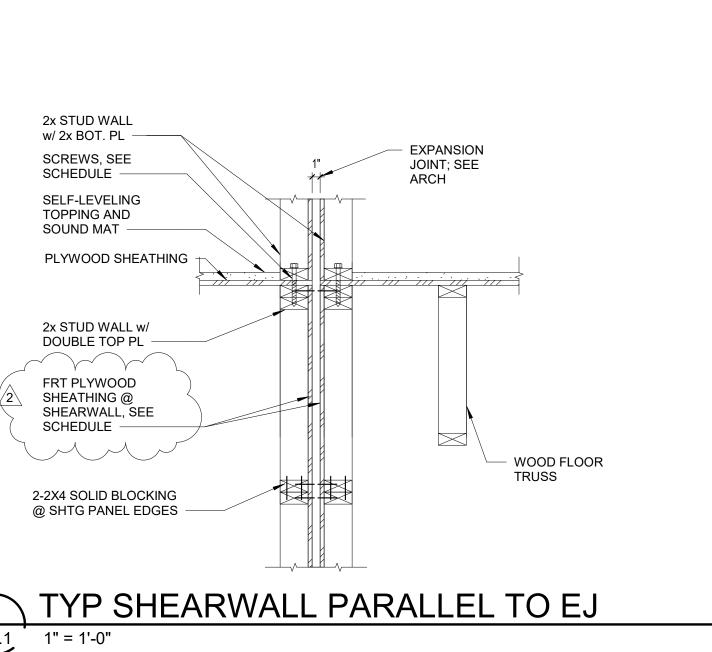

# , PROVIDE FRT SHEATHING AT FIREWALLS. SEE ARCH FOR FIREWALL LOCATIONS. ALLOWABLE UNIT SHEAR CAPACITY FOR WIND, DOES NOT INCLUDE ADJUSTMENT FACTORS. MAINTAIN 3/8" MINIMUM EDGE DISTANCES. EDGE OF THE BOTTOM PLATE ON THE SIDE WITH SHEATHING, 4 SHEARWALL SCHEDULE

	SHEA	ARWALL S	CHEDULE		
	SW1	SW2	SW3	SW4	SW5
PLYWOOD SHEATHING <sup>0</sup>	3/8" 24/0 SPAN RATING	3/8" 24/0 SPAN RATING	3/8" 24/0 SPAN RATING	15/32" 32/16 SPAN RATING	15/32" 32/16 SPAN RATING
WALL TYPE	UNBLOCKED, TYPE II	TYPE I	TYPE I	TYPE II	TYPE I
NAILING AT PANEL EDGES <sup>1</sup>	8d @ 6" OC	8d @ 4" OC	8d @ 4" OC	10d @ 4" OC	10d @ 4" OC
ASD ALLOWABLE UNIT SHEAR CAPACITY <sup>2</sup>	283 PLF	412 PLF	412 PLF	594 PLF	594 PLF
SILL PLATE CONNECTION @ 2ND & 3RD FLOOR <sup>3</sup>	1/4 DIA X 6" LAG SCREW @ 16" OC	1/4 DIA X 6" LAG SCREW @ 8" OC	1/4 DIA X 6" LAG SCREW @ 8" OC	3/8 DIA X 6" LAG SCREW @ 8" OC	3/8 DIA X 6" LAG SCREW @ 8" OC
SILL PLATE CONNECTION @ 4TH FLOOR <sup>3</sup>	1/4 DIA X 6" LAG SCREW @ 32" OC	1/4 DIA X 6" LAG SCREW @ 16" OC	1/4 DIA X 6" LAG SCREW @ 16" OC	1/4 DIA X 6" LAG SCREW @ 8" OC	1/4 DIA X 6" LAG SCREW @ 16" OC
ANCHOR BOLTS <sup>4</sup>	1/2" DIA @ 32" OC	1/2" DIA @ 16" OC	1/2" DIA @ 16" OC	1/2" DIA @ 16" OC	1/2" DIA @ 16" OC
POST & HDU @ 1ST FLOOR <sup>5</sup>	(3)-2X6	(3)-2X6 W/ HDU8	2-(3)-2X4, 12" APART, W/ HDU8	(3)-2X6 W/ HDU14	2-(3)-2X6 W/ 2-HDU8, 12" APART
POST & HDU @ 2ND FLOOR <sup>5</sup>	(3)-2X6	(3)-2X6 W/ HDU8	2-(3)-2X4, 12" APART, W/ HDU8	(3)-2X6 W/ HDU8	(3)-2X6 W/ HDU8
POST & HDU @ REMAINING FLOORS <sup>5</sup>	(3)-2X6	(3)-2X6 W/ HDU8	(3)-2X4 W/ HDU8	(3)-2X6 W/ HDU8	(3)-2X6 W/ HDU8

2x STUD WALL w/2x BOT. PL

TOPPING AND SOUND MAT

DOUBLE 2x TOP PLATE

PLYWOOD SHEATHING

- 2x STUD WALL w/DBL.

ROOF SHEATHING

- 1/2" PLYWOOD SHIM, TYP.

SEE 5S0.3

BOLTS, 10" GAGE

TRUSS BEARING

2x STUD WALL

ELEV. - SEE PLAN

PERMANENT LATERAL BRACING,

CTR. ON BRACING, w/2-5/8"Ø THRU

2-2x4 BLOCKING x 16" LONG,

TOP PL

TYP SHEARWALL PARALLEL TO FLOOR TRUSS

NOTE: AT CONTRACTOR'S OPTION, ELIMINATE TRUSS OVER SHEARWALL AND MOVE DOUBLE TOP PLATE TO BOTTOM OF SHEATHING OR A DRAG TRUSS MAY BE PROVIDED IN LIEU OF SHEATHED TRUSS. CONNECTION TO TOP PLATE BY TRUSS DESIGNER. EXTEND DRAG TRUSS FULL LENGTH OF DIAPHRAGM AND DESIGN DRAG TRUSS FOR 300 PLF (ALLOWABLE WIND).

TYP SHEARWALL PARALLEL TO ROOF TRUSS

@ SHEARWALL, SEE SCHEDULE

PLYWOOD SHEATHING, SEE SHEARWALL SCHEDULE

- SELF-LEVELING

SCREWS, SEE

WOOD FLOOR TRUSS

2-2X4 SOLID BLOCKING

@ SHEATHING PANEL EDGES

1/2" PLYWOOD SHEATHING

8d NAILS @ 4" OC AT ALL PANEL EDGES & 8d NAILS

AT ALL PANEL EDGES) -

@ 12" OC AT INTERIOR WEB

MEMBERS (PROVIDE 2x BLOCKING

ROOF TRUSS -

DBL 2x TOP PL ATT W/ 2-8d

NAILS @ 6" OC -

SHEARWALL, SEE


SCHEDULE

8d NAILS @ 6"OC

SHEARWALL SCHEDULE

NAILING PATTERN INDICATES SIZE AND SPACING AT PANEL EDGES, TOP PLATE, SILL PLATE, AND RIM BOARDS. PROVIDE 12" OC SPACING AT INTERMEDIATE FRAMING. USE 8d OR 10d COMMON NAILS BASED ON SCHEDULE WITH 1 3/8" (8d) OR 1 1/2" (10d) PENETRATION IN FRAMING

PROVIDE 7" EMBEDMENT AND PLATE WASHERS NOT LESS THAN 0.229" x 3" x 3". THE PLATE WASHER SHALL EXTEND TO WITHIN 1/2" OF THE BASIS OF DESIGN ARE SIMPSOM HDU. PROVIDE 7/8" DIA ANCHOR ROD WITH 20" EBMEDMENT AT HDU8 AND 1" DIA ANCHOR ROD WITH 22"

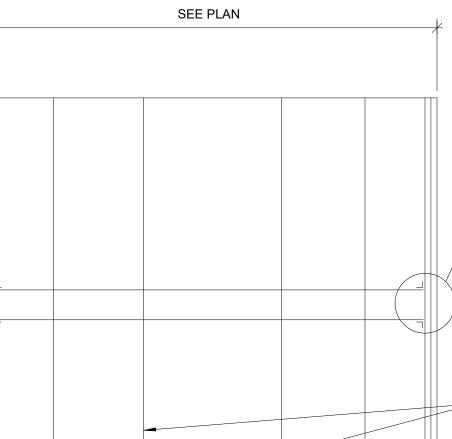

2 TYP HOLDOWN BETWEEN FLOORS

**ROOF TRUSS BRG** SEE PLAN -END POST & HOLDOWN PER SCHEDULE ABOVE & BELOW EACH FLOOR AT EACH END OF SHEARWALL AS INDICATED ON PLAN. SEE 2/S4.1 FOURTH FLOOR SEE PLAN - 2x STUDS @ ALL VERT PANEL EDGES, TYP UNO THIRD FLOOR SEE PLAN SOLID 2x BLOCKING @ HORIZ PANEL EDGES, TYP, UNO SECOND FLOOR SEE PLAN MAX - STUDS @ 16" OC, FIRST STUD WITHIN 1'-0" EACH

- AT OPENINGS WITHIN

TYPE II SHEARWALLS,

PANEL EDGE NAILING

PATTERN APPLIES

OPENING

ABOVE AND BELOW

END/SHEARWALL

- END POST & HOLDOWN

PER SCHEDULE @ EACH

END OF SHEARWALL AS

INDICATED ON PLAN.

FIRST FLOOR SEE PLAN

HOLE IN TOP PLATE

SIDE WHEN HOLE

2x STUD PLYWOOD SHEARWALL, SEE

PLAN & ELEVATION

- CONT. 2-2x BOTTOM PL

- PLYWOOD SHEATHING

─ WOOD FLOOR TRUSS - SEE PLAN

AT SHEAR WALL PROVIDE SIMPSON MTI36 STRAP EA

EXCEEDS 2" IN 2X4 PLATES AND 3 1/4" IN 2X6 PLATES

ROOF OR FLOOR TRUSS

ADD STUD UNDER TRUSS WHEN HOLE IN TOP PLATE EXCEEDS 5/8" DIA

TYP STUD

SPACING

TYPICAL TOP & BOTT PLATE

PENETRATION IN SHEARWALL

─ 2x STUD WALL

TYP WALL STUD -

S4.1 3/4" = 1'-0"

MULTIPLE STUD, SEE

2-2x10 RIM BOARD -

STAGGER JOINTS -

SOLID 2x BLOCKING

STUDS -

S4.1 3/4" = 1'-0"

INFILL BTWN MULTIPLE

SIMPSON HOLDOWN

TOP AND BOTTOM, SEE SHEARWALL ELEVATION

7/8"Ø THREADED ROD - SEE SHEARWALL ELEVATION -

SHEARWALL ELEVATION -

DBL TOP PLATE

TYPICAL SHEARWALL ELEVATION

SHEARWALL ELEVATION S4.1 3/16" = 1'-0"

PLYWOOD SHEATHING PER
 SCHEDULE OVER 2x STUDS @ 16" OC.
 SHEATHING SHALL BE PLACED ON

ONE FACE.

ZY LINDSEY B. Y FASNACHT NUMBER PE-2022006433 PROJECT TITLE

John Knox Village


**COURTYARDS - BUILDING E** SFCS Inc. • 1927 South Tryon St. - Suite 207 Charlotte, North Carolina 28203.4633 704.372.7327 • Fax 704.372.7369 www.sfcs.com

DESIGNER : DAS DRAWN : BSW ARCHITECT : DAS CHECKED : BDT APPROVED : Approver REVISION DESCRIPTION

ENGINEER : LBF REV 1- PERMIT COMMENTS 2/15/24

SHEARWALL DETAILS

Autodesk Docs://23104.00 - John Knox Village - Lindbergh/23104.00-JKV-Courtyards-Building E-Structural CENTRAL.rvt 3:35:22 PM

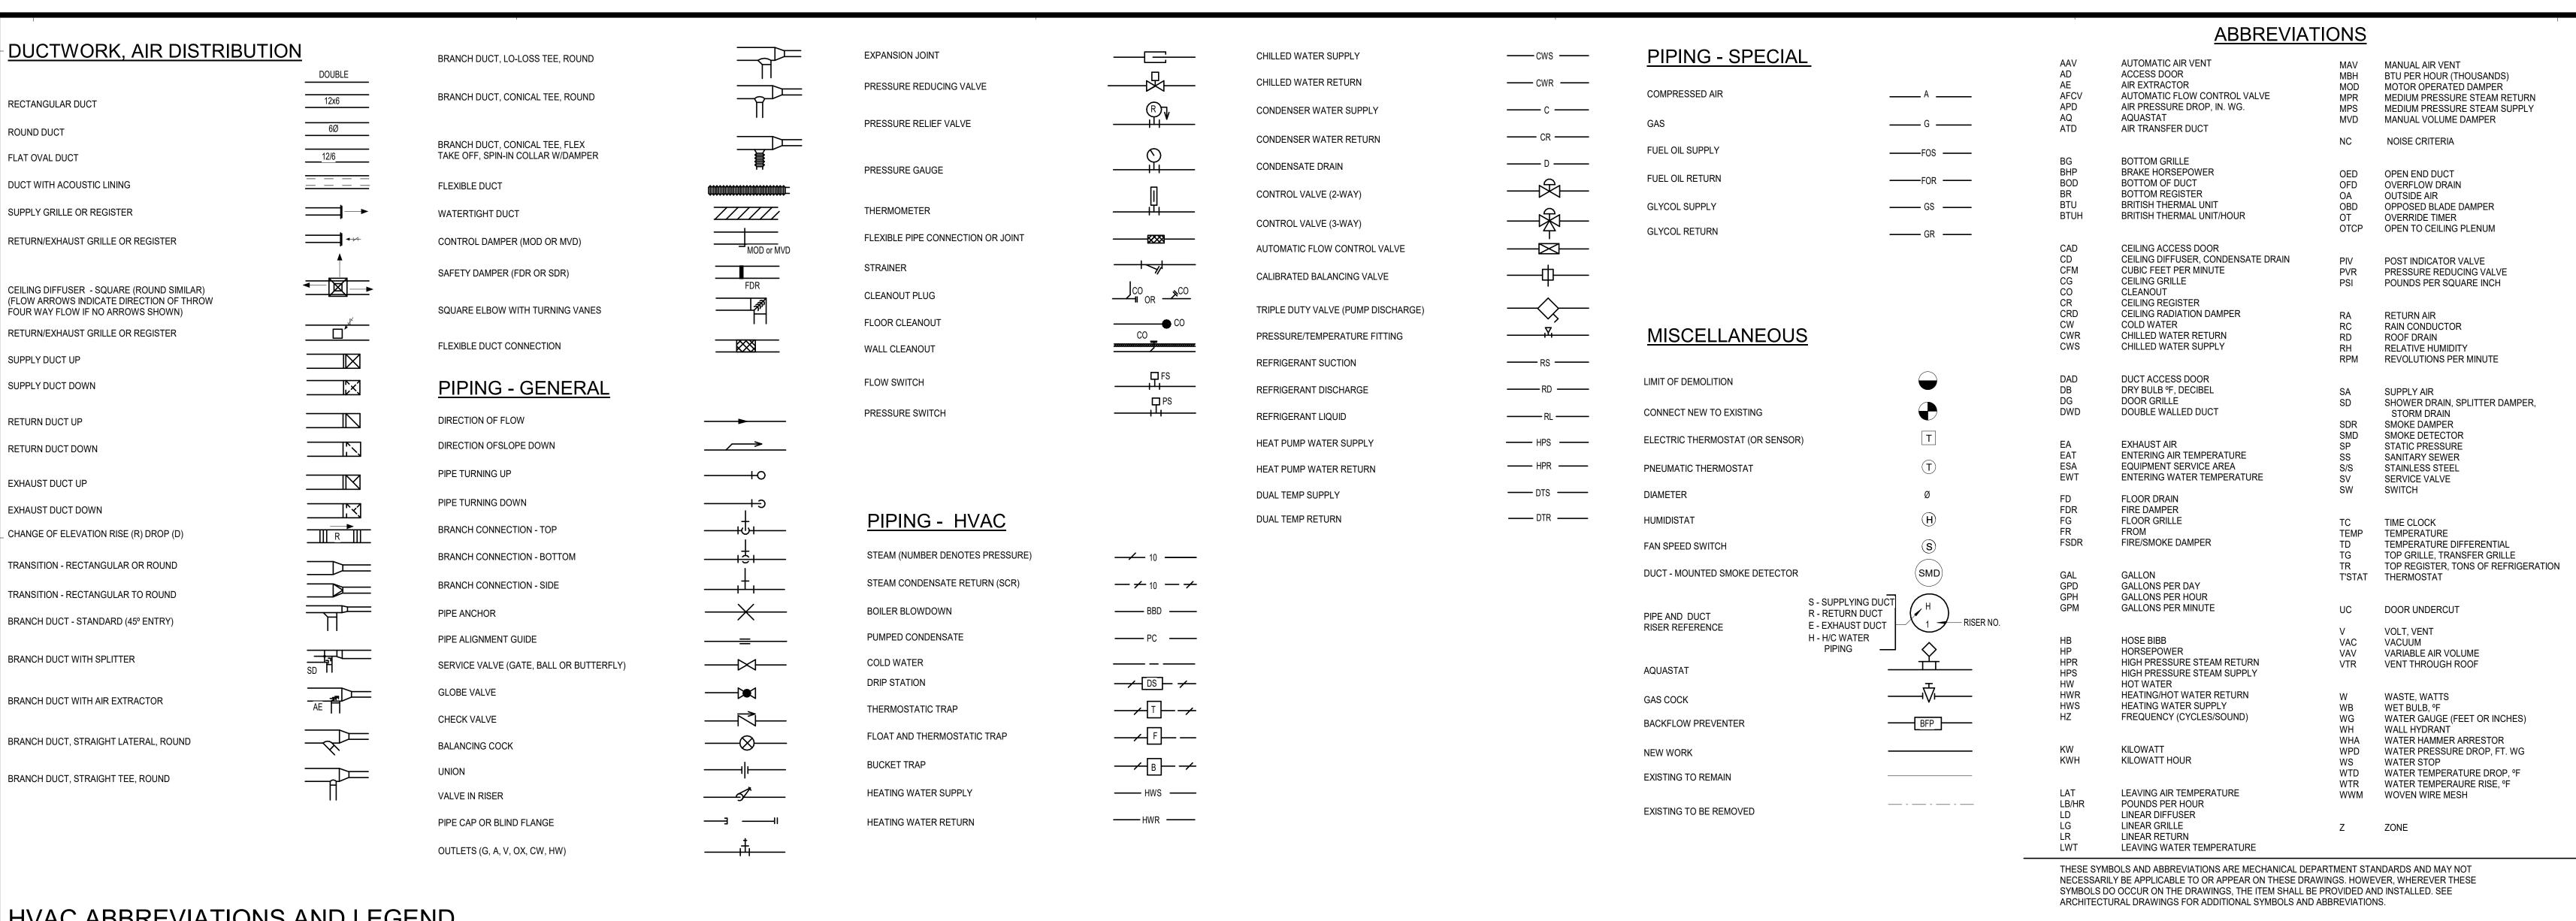

#### HVAC ABBREVIATIONS AND LEGEND

	2 EXHAUST FAN SCHEDULE											
							I	ELECTF	RICAL DATA			
MARK	LOCATION	TYPE	CFM	APPROX. S.P.	DRIVE	FAN RPM	WATTS	H.P.	VOLTAGE/PHASE	MANUFACTURER	ACCESSORIES	CONTROLS
EF-1	BATHROOM	EXHAUST	80	0.25"	DIRECT W/ SPEED - CONTROLLER	950	80	-	120/1	GREENHECK SP-B110	A, B, E, F, G	1
EF-2	RES. STORAGE	EXHAUST	100	0.25	DIRECT W/ SPEED CONTROLLER	1350	-	1/64	120/1	GREENHECK SE1-8-DGEX-QD	A, B, E. H	2
F-1	ROOF - IL	EXHAUST	300	0.375"	DIRECT W/ SPEED CONTROLLER	1050	-	1/4	120/1	GREENHECK GB-081-4	A, B, C, D	2
F-2	ROOF - ATRIUM	EXHAUST	150	0.375"	DIRECT W/ SPEED CONTROLLER	1550	-	1/20	120/1	GREENHECK G-080-D	A, B, C, D	2
SEVF-1	ROOF - ATRIUM	SMOKE EVACUATION	20,420	0.3	DIRECT W/ ECM	377	-	5	208/3	GREENHECK CUBE-480-VG-50	A, B, C, D	3
SEVF-2	ROOF - ATRIUM	SMOKE EVACUATION	20,420	0.3	DIRECT W/ ECM	377		5	208/3	GREENHECK CUBE-480-VG-50	A, B, C, D	3
SEVF-3	ROOF - ATRIUM	SMOKE EVACUATION	20,420	0.3	DIRECT W/ ECM	377		5	208/3	GREENHECK CUBE-480-VG-50	A, B, C, D	3

B: GRAVITY BACKDRAFT DAMPER C: PREFAB ROOF CURB

. SUPPLY FAN VFD

4. POWER EXHAUST FAN

1: WALL MOUNTED ON/OFF SWITCH (PROVIDE INDIVIDUAL CONTROL FOR BOTH FAN AND

2: CONTINUOUS OPERATION

6. FAN MOTORS WITH SHAFT GROUNDING RINGS

7. SINGLE SOURCE POWER CONNECTION

8. SZ VAV CONTROL W/ HOT GAS REHEAT COIL

D: BIRDSCREEN E: HANGING BRACKETS WITH VIBRATION ISOLATION F: EXHAUST GRILLE G: RADIATION DAMPER H: WEATHER HOOD

3. NON-FUSED, UNIT MOUNTED DISCONNECT SWITCH

3. INTERFACE W/ FIRE ALARM SYSTEM AND SMOKE DETECTORS IN SPACE.

	ROOF TOP UNIT SCHEDULE (DX COOLING & NAT GAS HEAT)																							
					COOLING C	APACITY	EFFIC	CIENCY	HEATING	CAPACITY	EFFICIENCY		COMPRESSOR (E	EA)	COND.	FM	EVAP. FM	COMB. FAN		POWER SI	JPPLY			
MARK	CFM	NOMINAL TONAGE	O.A. CFM	E.S.P	TC (BTUH)	SHC (BTUH)	EER	SEER	INPUT (BTUH)	OUTPUT (BTUH)	AFUE	NO	RLA	SYS.KW	QTY	FLA	FLA	FLA	MCA	MOCP	VOLTAGE/PH	WEIGHT	MANUFACTURER	RTU MODEL
RTU-1	3970	12.5	400	1.5"	134,520	95,310	10.8	15.8	250,000	202,500	81%	2	28.4 / 14.10	16.14	1	4.3	11.0	1	71.0	90.0	208/3	1627 LBS.	TRANE	YHJ150A3
RTU-2	3970	12.5	400	1.5"	134,520	95,310	10.8	15.8	250,000	202,500	81%	2	28.4 / 14.10	16.14	1	4.3	11.0	1	71.0	90.0	208/3	1627 LBS.	TRANE	YHJ150A3
RTU-3	5200	15.0	1040	1.5"	161,000	134,200	11.9	12.5	320,000	260,000	81%	2	30.8 / 16.4	16.36	2	2.3	8.9	1	83.0	110.0	208/3	2502 LBS.	TRANE	YHJ180A3
NOTES:								$\searrow$			-													

	VERTICAL PACKAGED TERMINAL AIR CONDITIONER UNITS (THRU WALL)															
			OA	NOMINAL COOLING	HEATING CAP	COMPF	RESSOR	OUTSI	DE FAN	INDO	OR	POV	VER SUP	PLY		
MARK	CFM	ESP	CFM	CAPACITY (BTUH)	(BTUH)	RLA	LRA	HP	RLA	HP	RLA	MCA	МОСР	V/P	MANUFACTURER	MODEL
VPTAC-1	630	0.5	100	18,000	24,500	6.7	37.5	1/8	0.9	1/3	1	34.3	35	208/1	MAGIC-PAK	7MCE4-12-181FP
VPTAC-2	800	0.5	100	24,000	24,500	8.7	38	1/8	0.9	1/3	1.8	34.8	35	208/1	MAGIC-PAK	7MCE4-12-241FP
VPTAC-3	930	0.5	100	30,000	32,700	13.4	72.5	1/4	1.6	1/2	1.2	45.2	50	208/1	MAGIC-PAK	10MCE-12-301FP

1. UNIT OA FLOW RATE SHALL BE BALANCED TO MATCH COMBINED DWELLING UNIT BATHROOM EXHAUST RATE, OR MAXIMUM UNIT OA CAPACITY, WHICHEVER IS LOWER.

		GRILLE & DIFF	USER S	CHEDU	JLE	
MARK	SERVICE	DESCRIPTION	FACE SIZE	NECK SIZE	CFM	BASIS OF DESIGN MANUF. AND MODE
CD-1	SUPPLY	DOUBLE DEFLECTION		8X4	0 - 120	PRICE: 520-FR
CD-2	SUPPLY	DOUBLE DEFLECTION		8X6	125 - 180	PRICE: 520-FR
CD-3	SUPPLY	DOUBLE DEFLECTION		10X6	185 - 220	PRICE: 520-FR
CD-4	SUPPLY	PLAQUE	24X24	8"	0 - 175	PRICE: SPD
CD-5	SUPPLY	PLAQUE	24X24	10"	180 - 270	PRICE: SPD
CD-6	SUPPLY	DOUBLE DEFLECTION		14X8	275 - 390	PRICE: 520
CR-1	RETURN OR EXHAUST	SINGLE DEFLECTION		8X6	60 - 130	PRICE: 530
CR-2	RETURN OR EXHAUST	SINGLE DEFLECTION W/ FILTER		28X12	400-1000	PRICE: 630FF
CR-3	RETURN OR EXHAUST	EGG CRATE W/ FILTER	24X24	22X22	890 - 1400	PRICE: 80FF
CR-4	RETURN OR EXHAUST	SINGLE DEFLECTION W/ FILTER		14X28	490 - 1225	PRICE: 630FF
CR-5	RETURN OR EXHAUST	SINGLE DEFLECTION W/ FILTER		40X24	1250 - 3125	PRICE: 630 -
CR-6	RETURN OR EXHAUST	SINGLE DEFLECTION W/ FILTER		10X12	200 - 550	PRICE: 630FF
CR-7	RETURN OR EXHAUST	EGG CRATE	46 X 46	44 x 44	3500 +	PRICE: 82

ELECTRIC HEATER								
					HEATER			
MARK	LOCATION	BTUH	CFM	KW	AMPS	VOLTAGE/PH	MANUFACTURE - MODEL	ACCESSORIES
EWH-1	STAIRCASE	10,200	245	3.0	14.4	208/1	MARKEL - MODEL F3423T	A,B,C,D

RUSKIN ELF6350DMP

NOTES:
1. HEATING CAPACITY BASED ON 65°F. E.A.T.

B: BUILT-IN THERMOSTAT : ARCHITECTURAL PENCIL PROOF LOUVER D: CABINET FOR SURFACE MOUNTING

L-1 10000 72 48

LOUVER SCHEDULE | WIDTH | HEIGHT | FREE AREA | PRRESSURE DROP BASIS OF DESIGN (IN) (IN) (%) (IN. WG)

0.06

63

## **CONTRACTOR NOTE**

THE LISTED MANUFACTURER'S AND EQUIPMENT HAVE BEEN USED AS THE BASIS OF DESIGN OF THIS PROJECT AND ARE LISTED TO ESTABLISH A STANDARD OF QUALITY AND TO DEFINE CONNECTION AND CLEARANCE REQUIREMENTS. ALL OTHER MANUFACTURERS AND EQUIPMENT OF EQUAL OR BETTER QUALITY MAY BE ACCEPTED UPON REVIEW BY THE ENGINEER, HOWEVER, IF THESE SUBSTITUTIONS ARE MADE, THE CONTRACTOR IS REQUIRED TO COMPLY WITH ALL REQUIREMENTS OF DIVISION 1, ASSUME FULL RESPONSIBILITY FOR ALL COORDINATION ISSUES, AND SHALL SUBMIT WITH THE SHOP DRAWINGS A DETAILED DRAWING SHOWING ALL CHANGES IN THE EQUIPMENT SIZE AND LOCATION, DUCTWORK, PIPING, ELECTRICAL WIRING CONNECTIONS, CLEARANCES, ETC. IF ANY REQUIRED CHANGES INVOLVE OTHER TRADES, THE MECHANICAL SUBCONTRACTOR SHALL INCLUDE WITH THE SHOP DRAWINGS A LETTER INDICATING THAT THE OTHER TRADES HAVE BEEN ADVISED OF THE PROPOSED CHANGES AND SHALL ALSO INCLUDE A STATEMENT AS TO HOW, BY WHOM, AND THE ARRANGEMENT WHEREBY THESE CHANGES WILL BE ACCOMPLISHED. ALL ADDITIONAL COSTS AND PERFORMANCE ISSUES RESULTING FROM THE SUBSTITUTION WILL BE THE RESPONSIBILITY OF THE MECHANICAL SUBCONTRACTOR. THE SUBSTITUTED EQUIPMENT WILL NOT BE PERMITTED TO ADD ELECTRICAL LOAD TO THE PROJECT.


## **HVAC GENERAL NOTES**

- 1. FOR GENERAL AND ARCHITECTURAL ABBREVIATIONS AND SYMBOLS, SEE SHEET A0.0
- 2. DUCT WORK INSTALLATION, CONNECTIONS AND CONSTRUCTION SHALL BE IN ACCORDANCE WITH THE LATEST APPLICABLE SMACNA STANDARDS.
- 3. EQUIPMENT INSTALLATIONS SHALL BE IN ACCORDANCE WITH THE MANUFACTURER'S INSTRUCTIONS. COPY OF INSTRUCTIONS SHALL BE ON JOB SITE AT TIME OF
- 4. DUCT DIMENSIONS INDICATED ARE ACTUAL SHEET METAL SIZES. WHERE ACOUSTIC LINING IS INDICATED (IF SHOWN), THE DUCT SIZES WERE ADJUSTED TO
- 5. DUCTWORK AND PIPING LAYOUTS ARE SCHEMATIC. ALL DROPS, RISES, OR OFFSETS REQUIRED BUT NOT SHOWN SHALL BE PROVIDED AT NO ADDITIONAL COST TO
- 6. DUCT CONNECTIONS TO SIDE WALL OR DUCT MOUNTED REGISTERS AND GRILLES SHALL BE MADE WITH RIGID DUCT. DUCT CONNECTIONS TO CEILING-MOUNTED DIFFUSERS, REGISTERS, AND GRILLES MAY BE WITH RIGID OR FLEXIBLE DUCT (CONTRACTOR OPTION). PROVIDE SMOOTH BENDS IN FLEXIBLE DUCT SECTIONS. 7. ALL TEMPERATURE AND HUMIDITY SENSORS (NON-SPACE ADJUSTABLE) IN PUBLIC AREAS SHALL BE MOUNTED AT 5'-0" AFF. THERMOSTATS FOR NON-PUBLIC, NON-
- RESIDENTIAL AREAS SHALL BE MOUNTED AT 5-0" AFF WITH AN 18" LONG LOOP OF SURPLUS CONTROL WIRE IN WALL CAVITY TO PERMIT THE OWNER TO LOWER THE CONTROL DEVICE IN THE FUTURE IF REQUIRED FOR HANDICAP ACCESS. MOUNT THERMOSTATS AT 48" AFF IN ALL AREAS DESIGNATED AS "ADA-HANDICAP 8. ALL DUCTWORK SHALL BE SEALED ACCORDING TO SMACNA CLASS "A". DUCTWORK SHALL BE CONSTRUCTED IN ACCORDANCE WITH THE FOLLOWING PRESSURE
- SEVF-1 EXHAUST AND ROOFTOP AC UNITS ±2", ALL OTHER SUPPLY, RETURN, AND EXHAUST: ±1". 9. DUCT CONNECTIONS TO ALL AIR HANDLING UNITS, INCLUDING FAN COIL UNITS, INLINE FANS, ETC. SHALL BE MADE USING FLEXIBLE DUCT CONNECTION. ALSO,
- PROVIDE FLEXIBLE DUCT CONNECTIONS WHERE DUCTWORK CROSSES BUILDING EXPANSION JOINTS. 10. LOCATE CEILING AIR DIFFUSERS, REGISTERS AND GRILLES IN THE CENTER OF 2'x2' AND AT THE QUARTER POINT OF 2'x4' ACQUISTICAL TILE CEILING MODULES UNLESS SPECIFICALLY INDICTED OTHERWISE ON THE ARCHITECTURAL REFLECTED CEILING PLANS. REFER TO DIFFUSER, REGISTER, AND GRILLE EQUIPMENT
- 11. PIPING AND EQUIPMENT HANGERS SHALL BE SPACED IN A SYSTEMATIC RANDOM PATTERN AS REQUIRED TO ELIMINATE OVERLOADING INDIVIDUAL STRUCTURAL MEMBERS, THE ESTIMATED WEIGHT ASSIGNED TO PIPE AND EQUIPMENT HANGERS SHALL BE DETERMINED BY THE MECHANICAL CONTRACTOR AND SUBMITTED TO THE GENERAL CONTRACTOR FOR REVIEW, COORDINATION AND APPROVAL PRIOR TO INSTALLATION. THIS REQUIREMENT APPLIES TO ALL MECHANICAL WORK,
- INCLUDING PLUMBING AND FIRE PROTECTION. 12. HEATING/COOLING DESIGN CONDITIONS: <u>LEE'S SUMMIT, MISSOURI</u>
  WINTER 5°F OAT, 75°F, 35% RH INDOORS (ADJUSTED HIGHER THAN ASHRAE TEMPERATURE TO ACCOMMODATE ELDERLY RESIDENTS.)

INSTRUCTIONS RELATED TO RADIATION DAMPERS AND FIRE-RATED CEILING INSTALLATIONS.

SMOKE RATED WALL, FLOOR AND ROOF/CEILING ASSEMBLIES.

- SUMMER 100.0°F DB/80.0°F WB OAT; 75°F, 50% RH INDOORS 13. WHERE MORE THAN ONE SIDE WALL REGISTER IS INSTALLED IN A ROOM, THE CENTERLINE ELEVATION OF EACH REGISTER SHALL BE THE SAME DISTANCE FROM AND LEVEL TO THE PLANE OF THE CEILING.
- 14. MANY OF THE CEILING SPACES ARE EXTREMELY CONGESTED AND WILL REQUIRE SIGNIFICANT ON-SITE FIELD COORDINATION BETWEEN THE CONSTRUCTION TRADES, CONTRACTOR GENERATED COORDINATION DRAWINGS ARE REQUIRED FOR ALL SUCH AREAS AND SHOULD INDICATE STRUCTURE, CEILING FEATURES.
- LIGHT FIXTURES, PLUMBING AND FIRE SERVICE PIPING AND ALL MECHANICAL EQUIPMENT, PIPING AND DUCTWORK. 15. ALL PIPE AND DUCT PENETRATIONS THRU FIRE-RATED WALLS OR FLOOR ASSEMBLIES SHALL BE IN ACCORDANCE WITH AN APPROVED UL AND FIRESTOP SYSTEM FOR THE CONDITIONS ENCOUNTERED AS DEFINED IN THE UL BUILDING MATERIAL DIRECTORY.
- 16. THE ROUTING OF LARGER SIZE SUPPLY AIR DUCTS SHALL TAKE PRECEDENCE OVER SMALLER DUCTS, AND OVER RETURN AND EXHAUST AIR DUCTS. PROVIDE DUCT OFFSETS, RISES AND DROPS AS REQUIRED TO INSTALL DUCTWORK AS CLOSELY TO THE LAYOUT SHOWN ON THESE DOCUMENTS AS POSSIBLE. 17. SEE ARCHITECTURAL FIRE PROTECTION DRAWINGS FOR DETAILS OF FIRE AND SMOKE SEALING REQUIREMENTS AT PENETRATIONS OF ALL UL LISTED FIRE AND

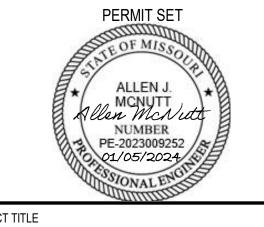

PROJECT TITLE



**COURTYARDS - BUILDING E** 

SFCS Inc. • 305 South Jefferson Street Roanoke, Virginia 24011.2003 540.344.6664 Fax 540.343.6925

www.sfcs.com

DESIGNER : DAS		DRAWN	: JEB	
ARCHITECT : DAS		CHECKED	MAP	
ENGINEER : KFY		APPROVED	) ; AJM	
NO.	REVISION D	DESCRIPTION		
	ARCHITECT : DAS ENGINEER : KFY	ARCHITECT : DAS ENGINEER : KFY	ARCHITECT : DAS CHECKED  ENGINEER : KFY APPROVED	ARCHITECT : DAS CHECKED : MAP ENGINEER : KFY APPROVED : AJM


Rev 1 - Permit Comments


ABBREVIATIONS, LEGENDS, NOTES, AND **EQUIPMENT SCHEDULES -**

February 15, 2024


COMM. NO.


Autodesk Docs://23104.00 - John Knox Village - Lindbergh/23104.00-JKV-Courtyards-Building E-Mechanical CENTRAL.rvt

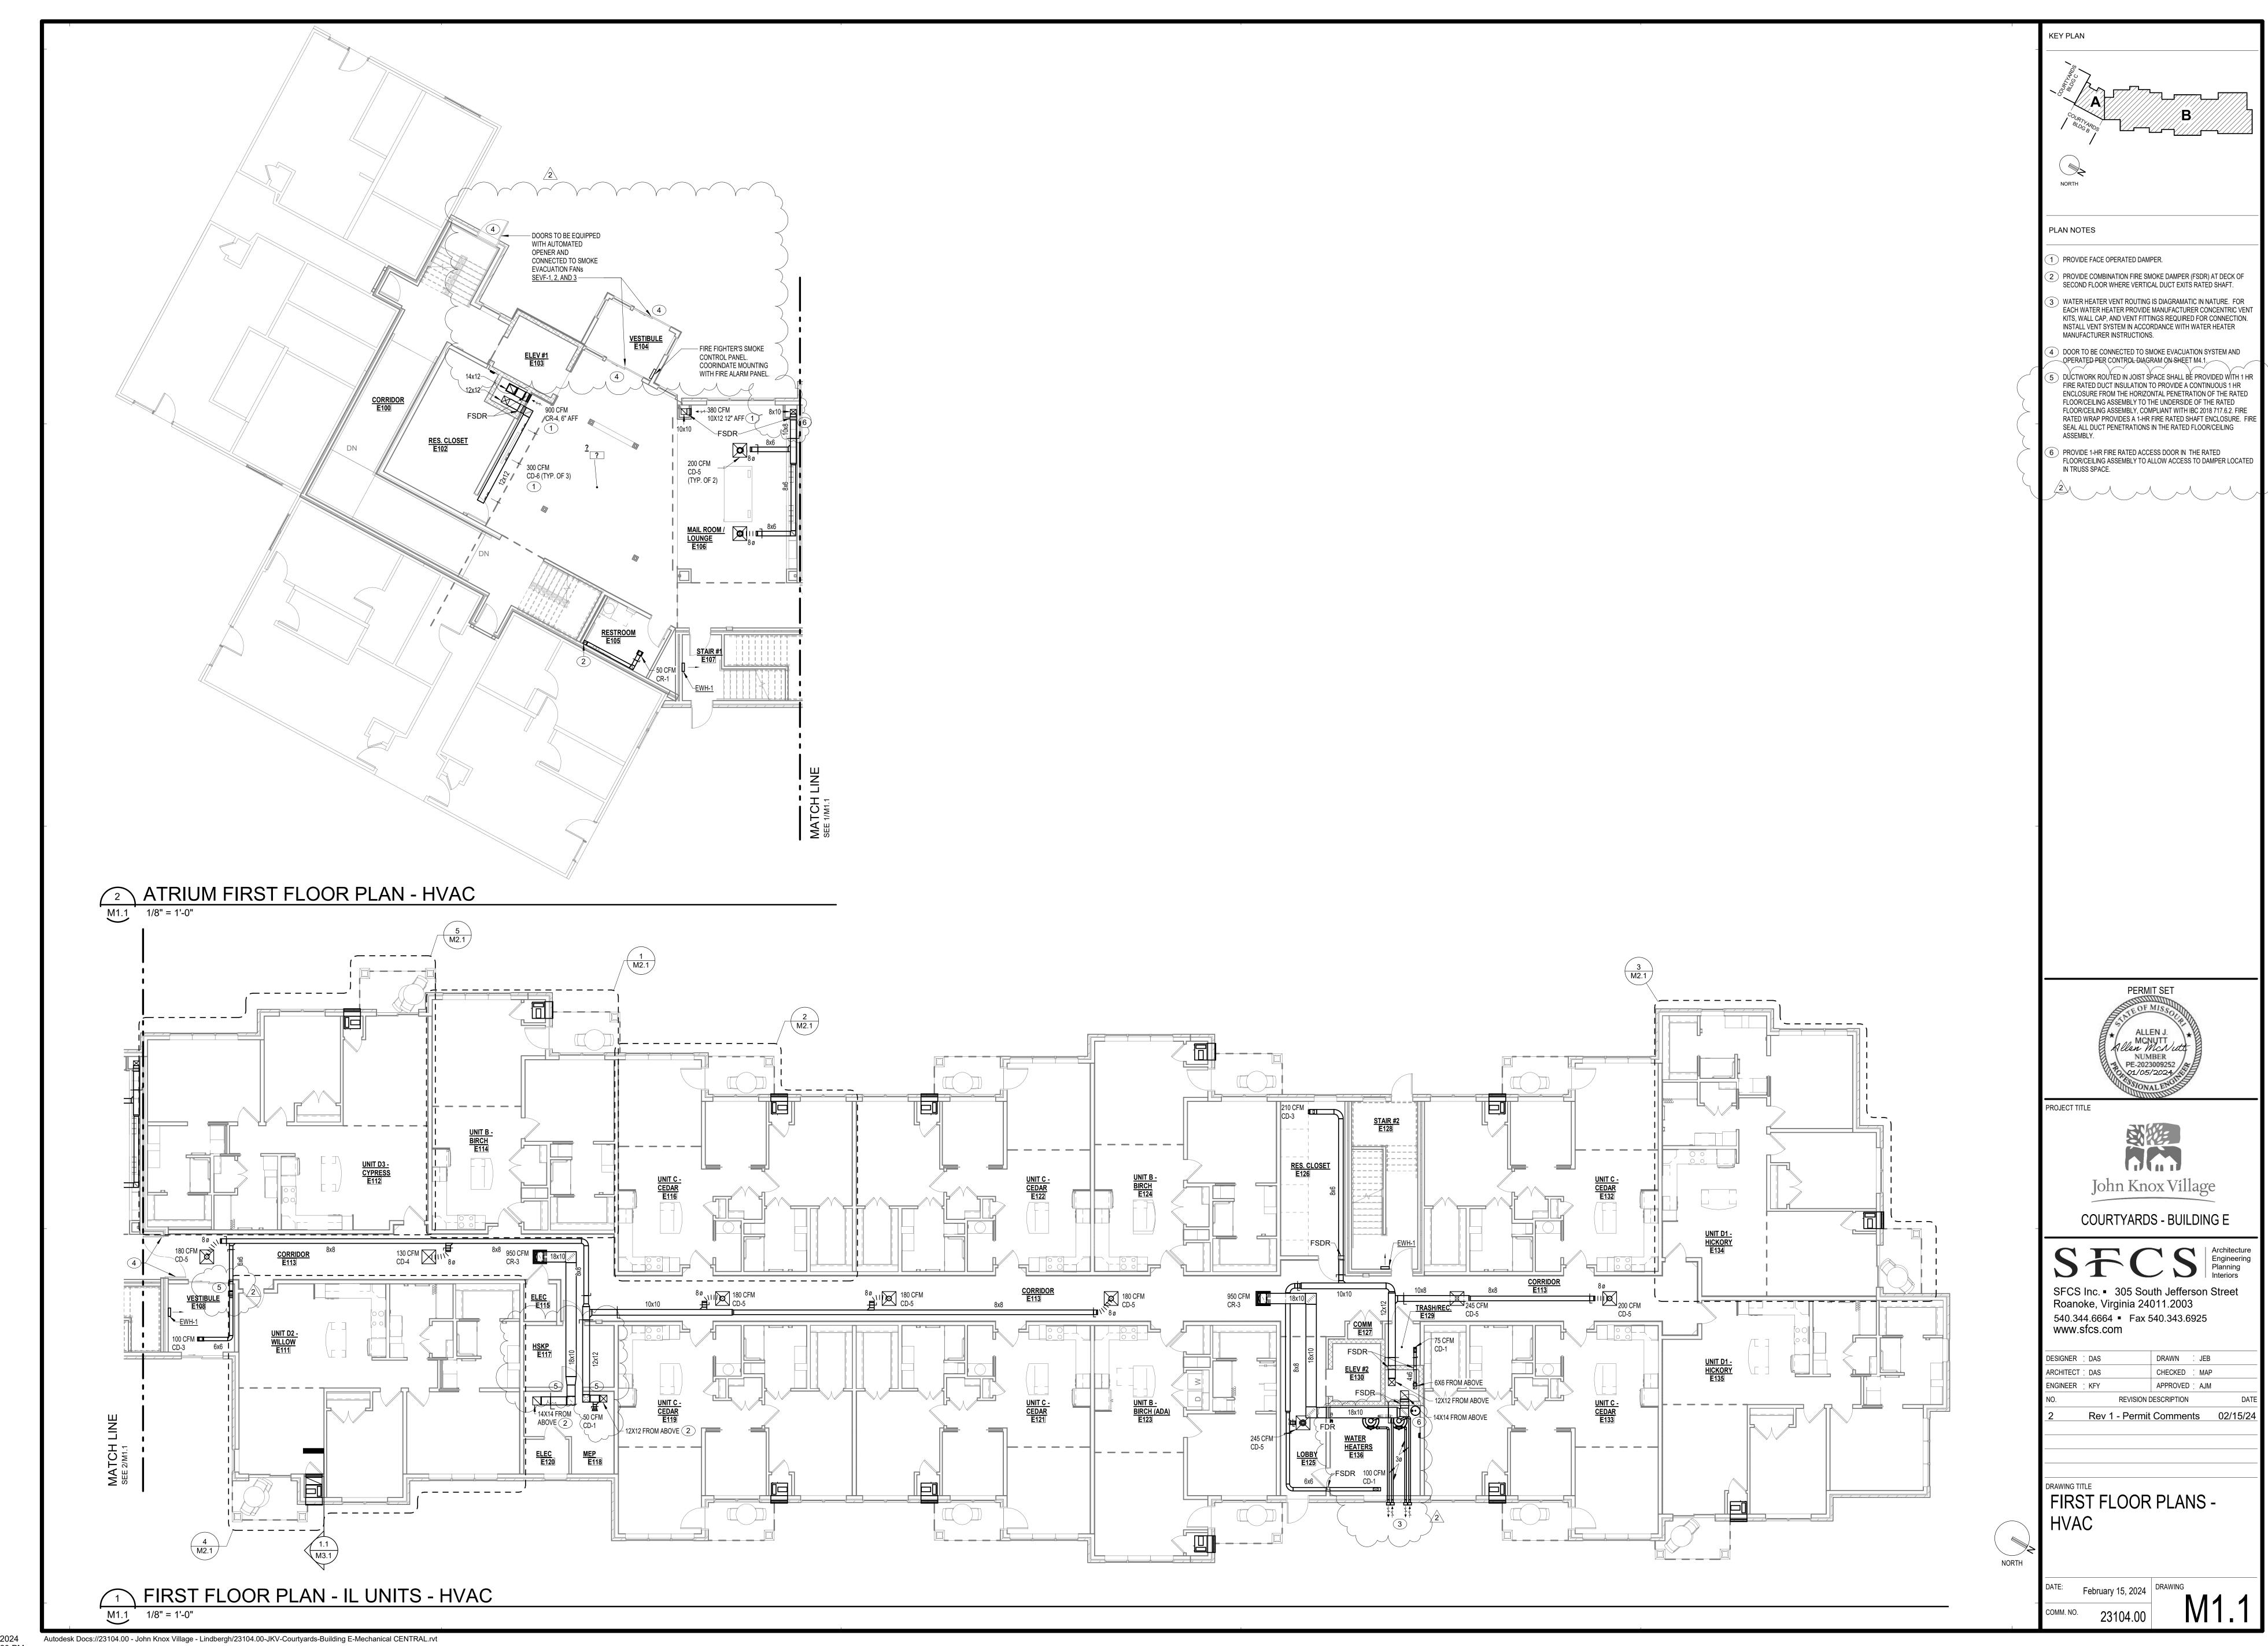


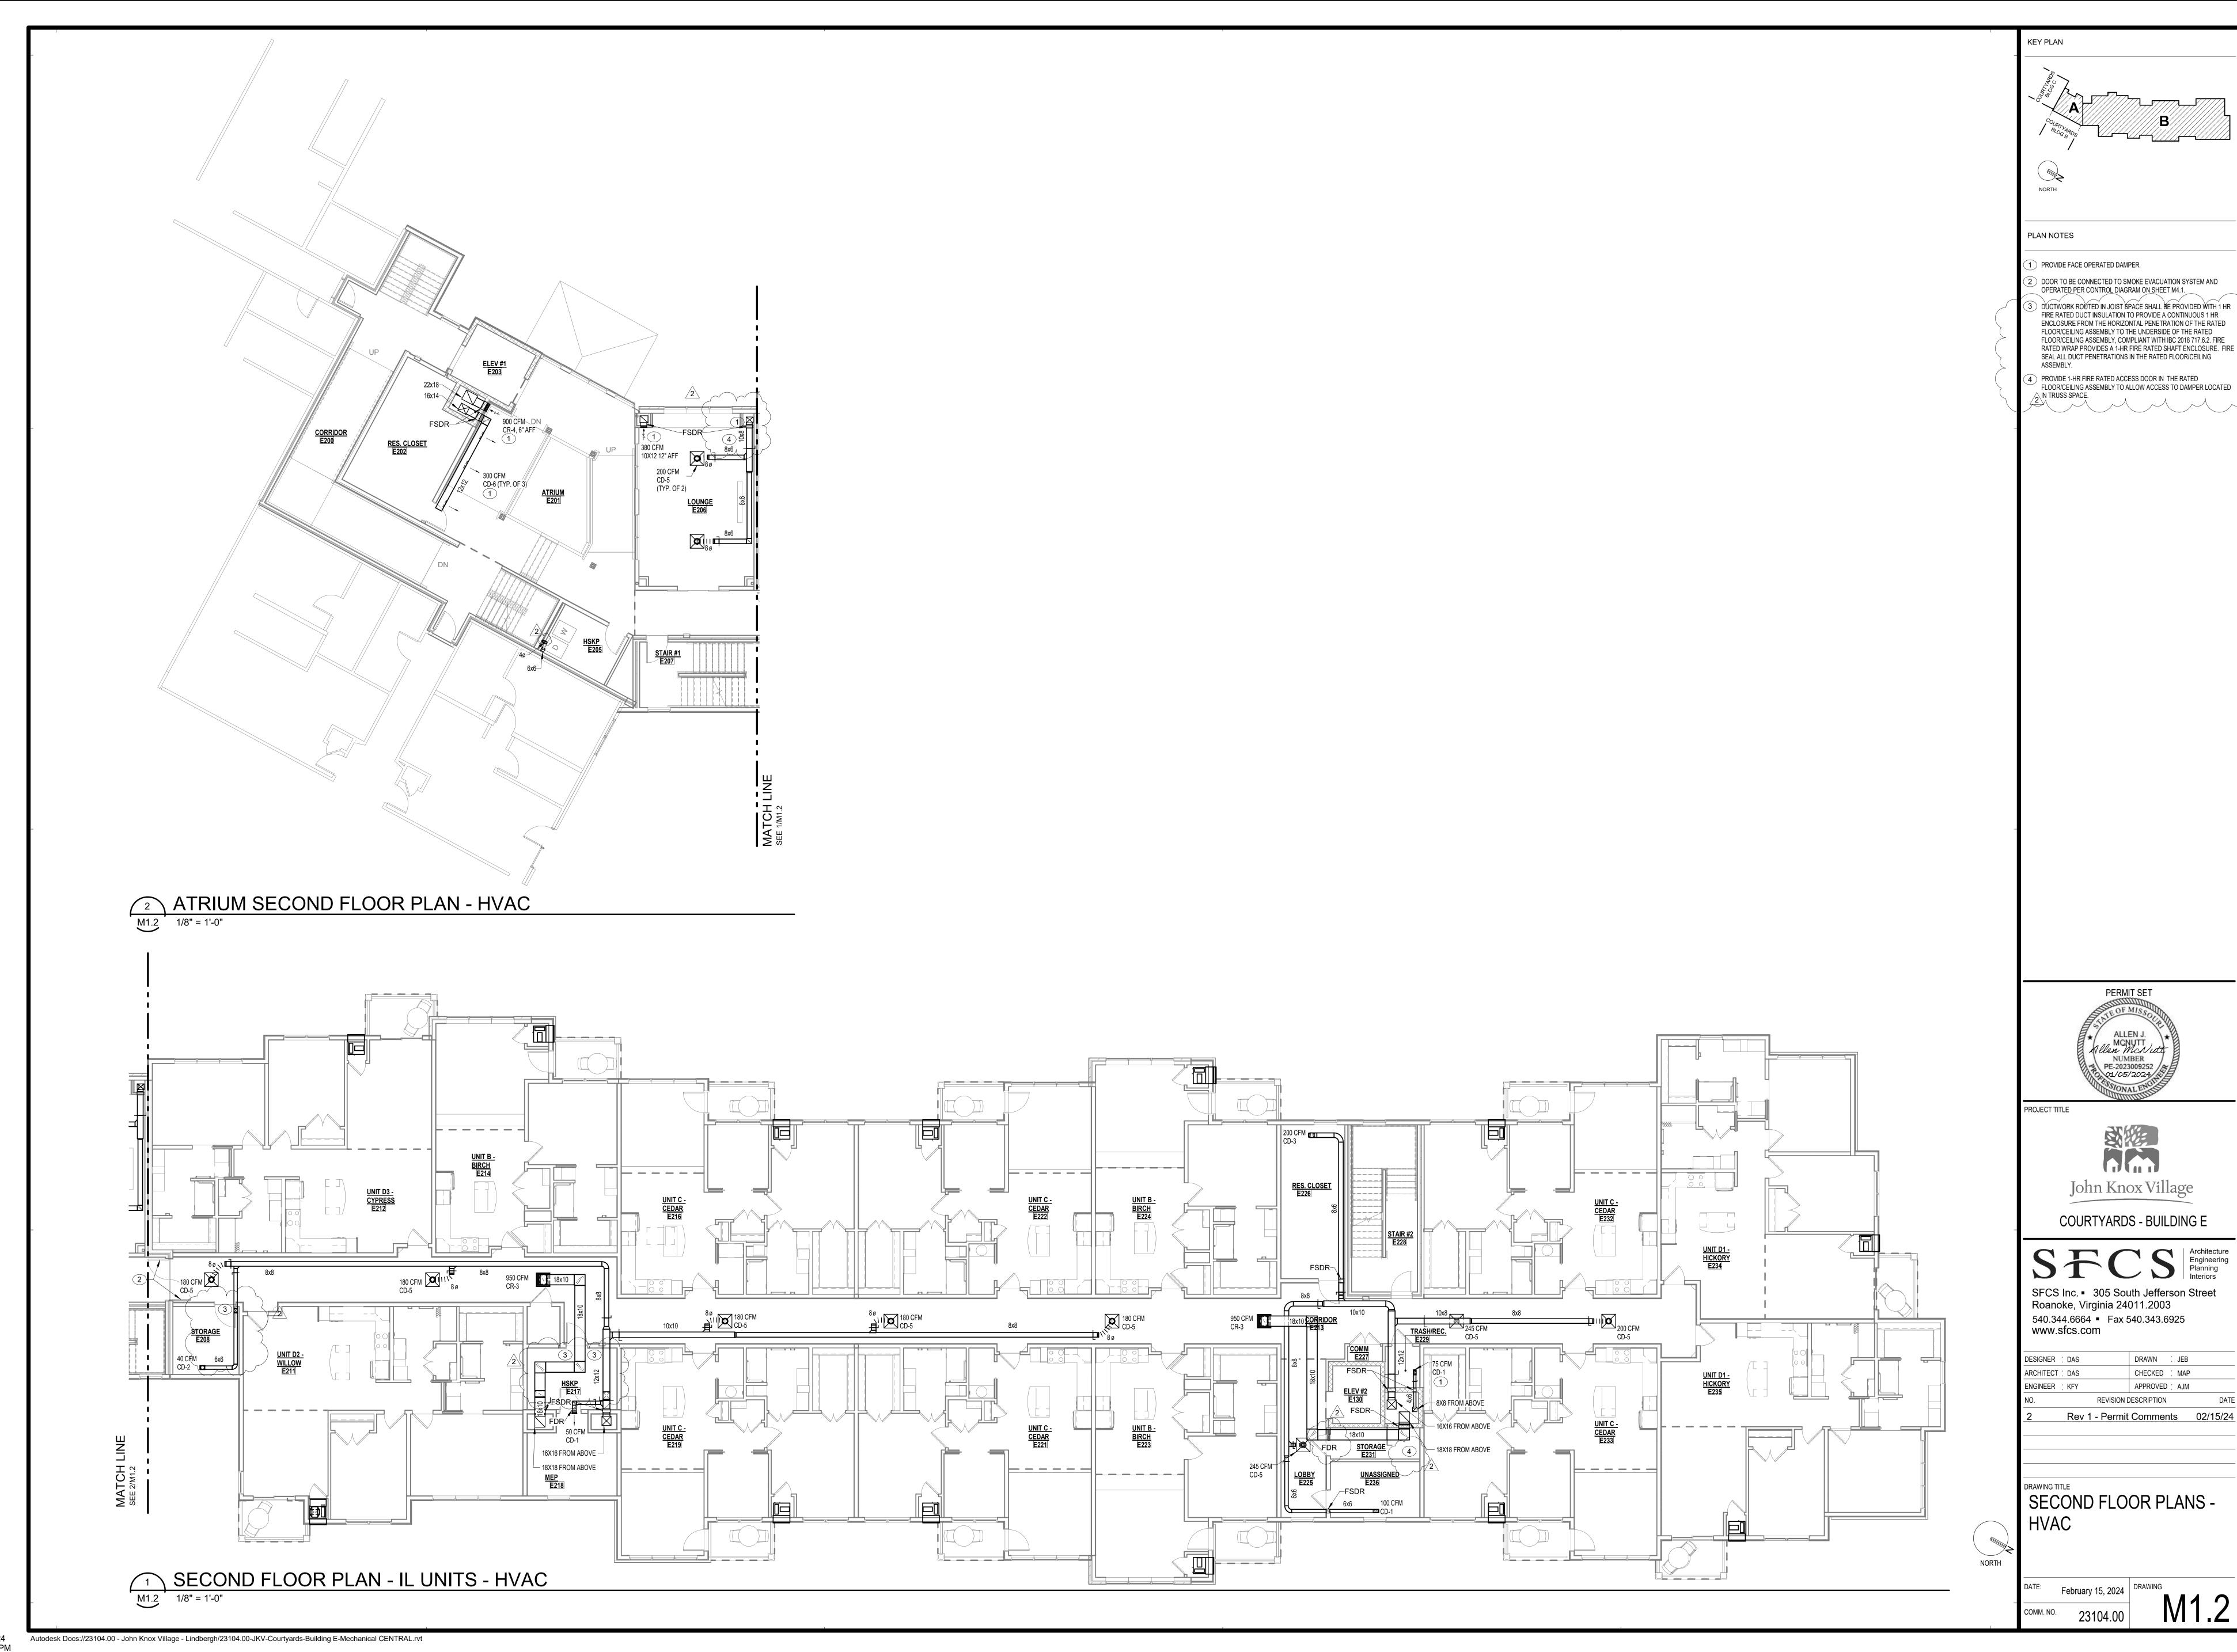

John Knox Village COURTYARDS - BUILDING E SFCS Inc. • 305 South Jefferson Street Roanoke, Virginia 24011.2003
540.344.6664 • Fax 540.343.6925
www.sfcs.com CHECKED : MAP APPROVED ; AJM REVISION DESCRIPTION Rev 1 - Permit Comments 02/15/24 SECOND FLOOR PLANS -

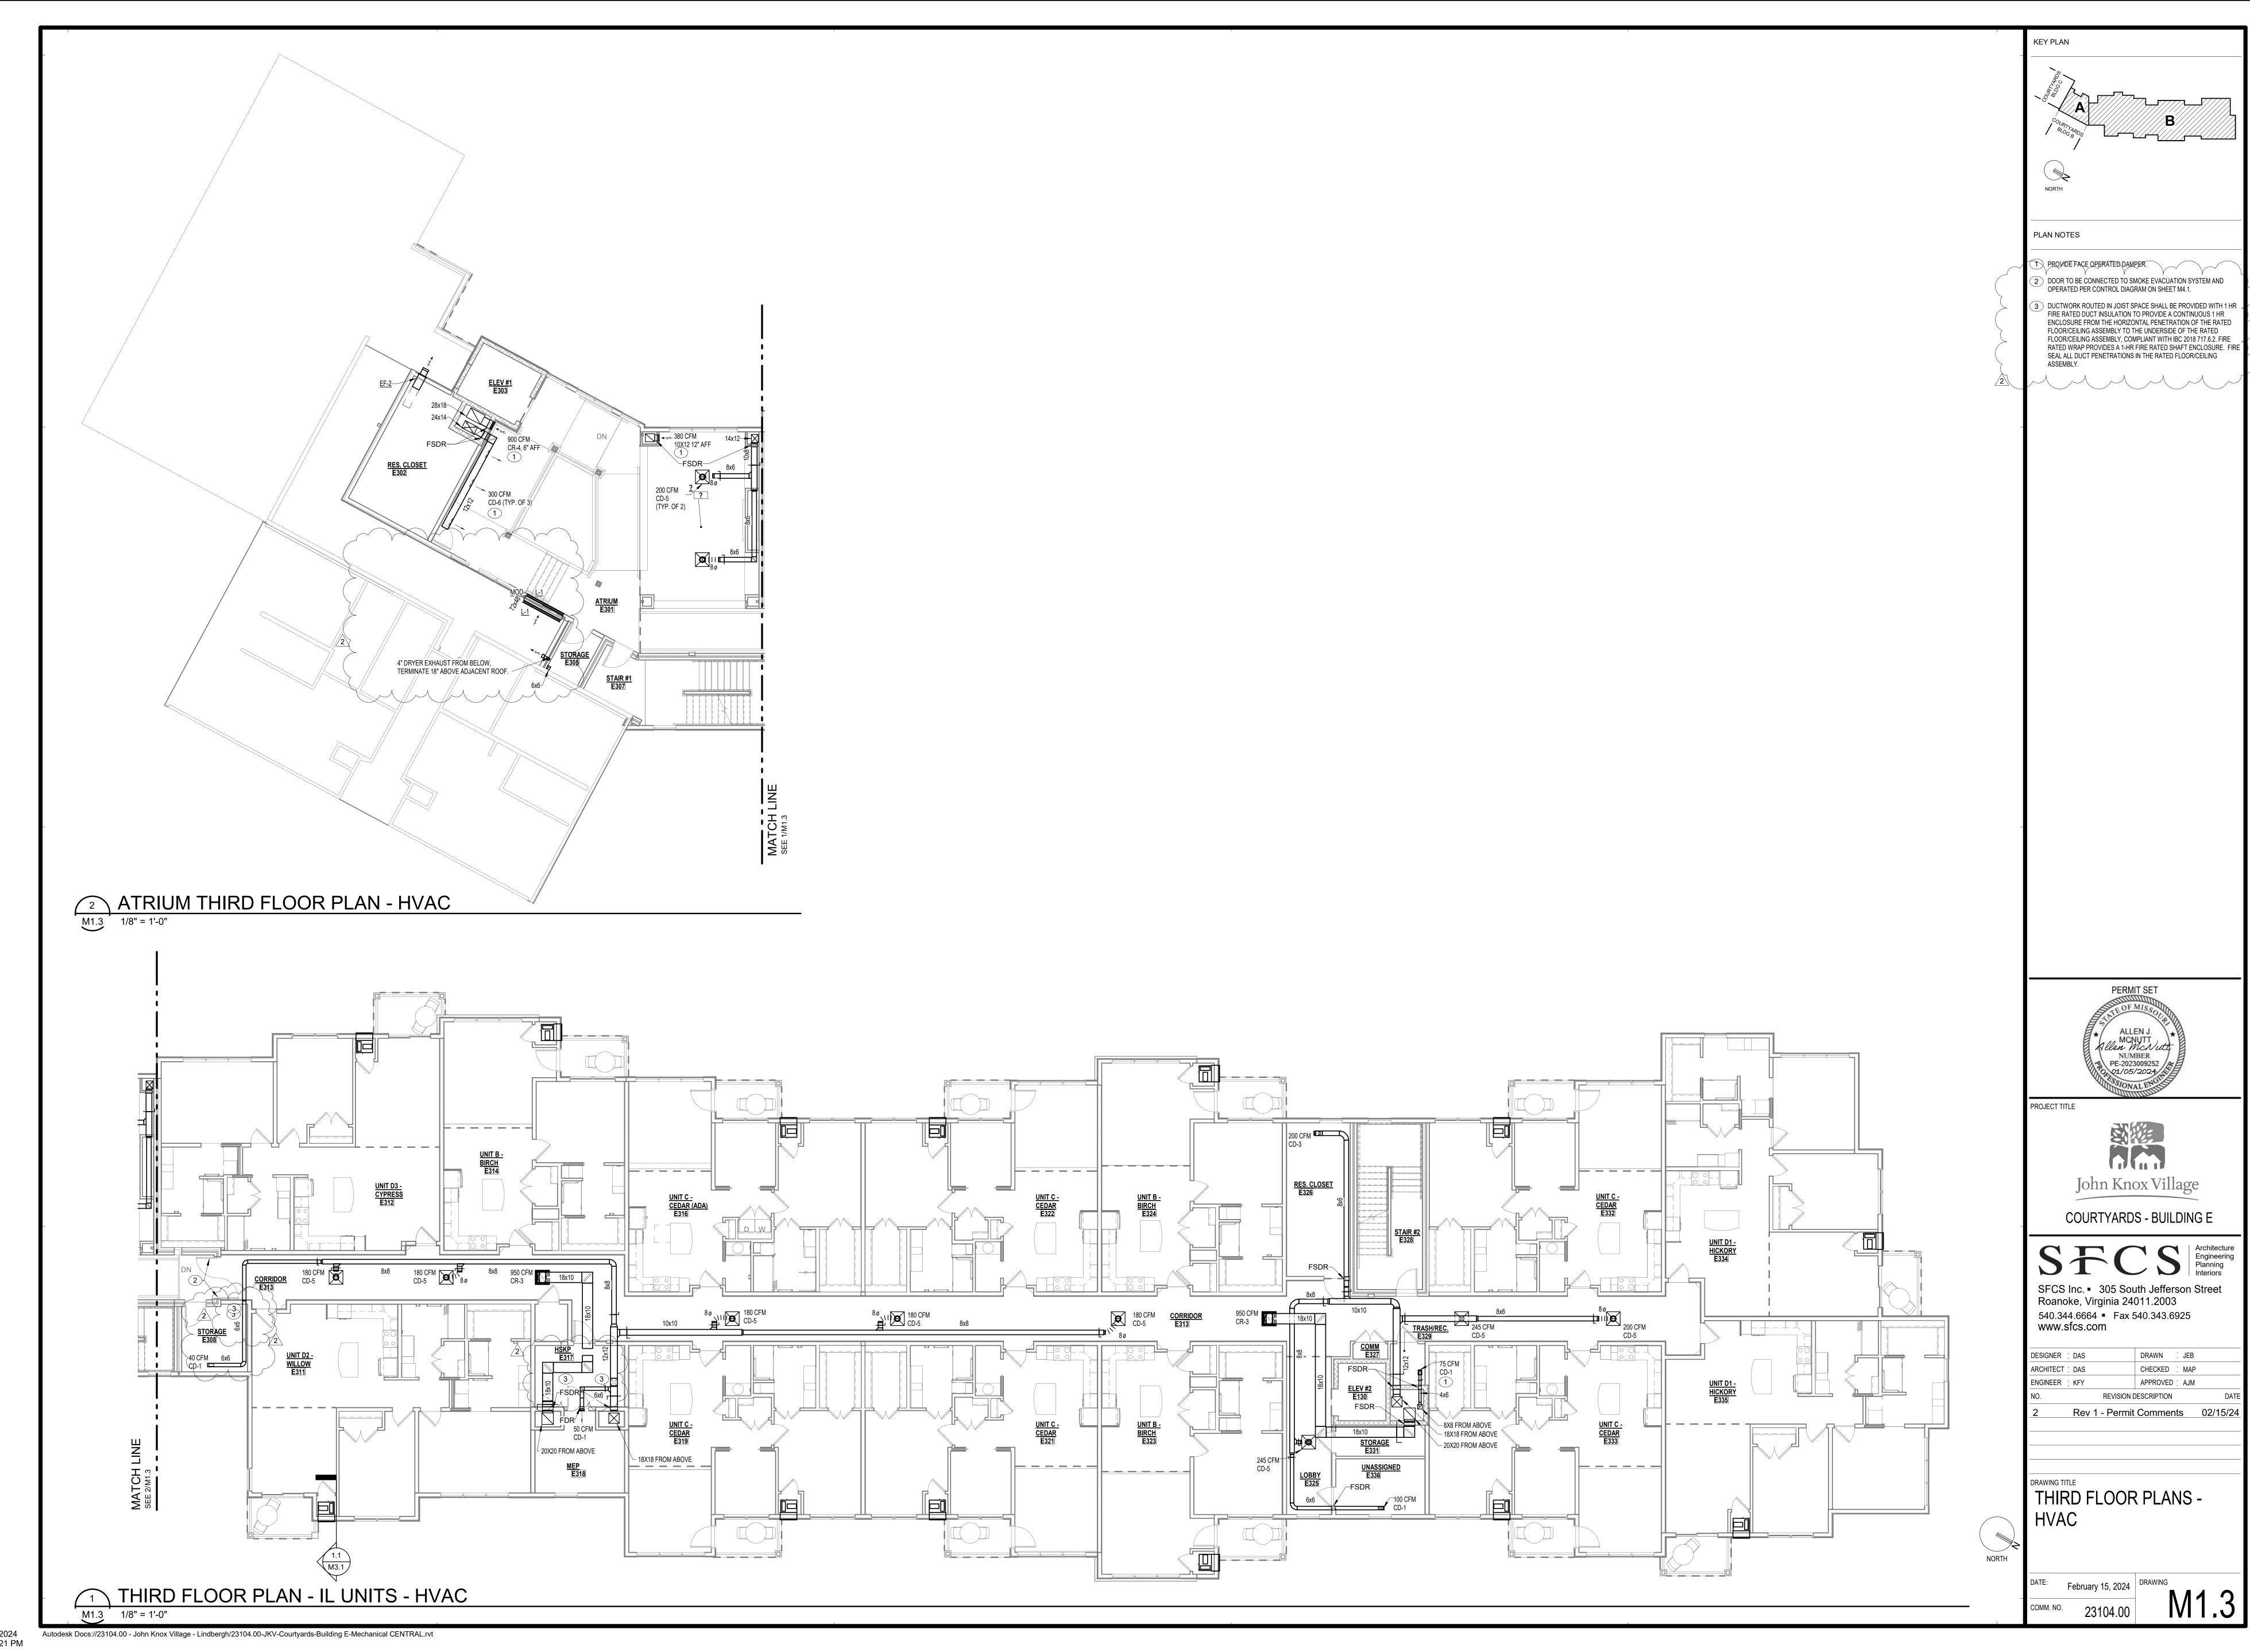

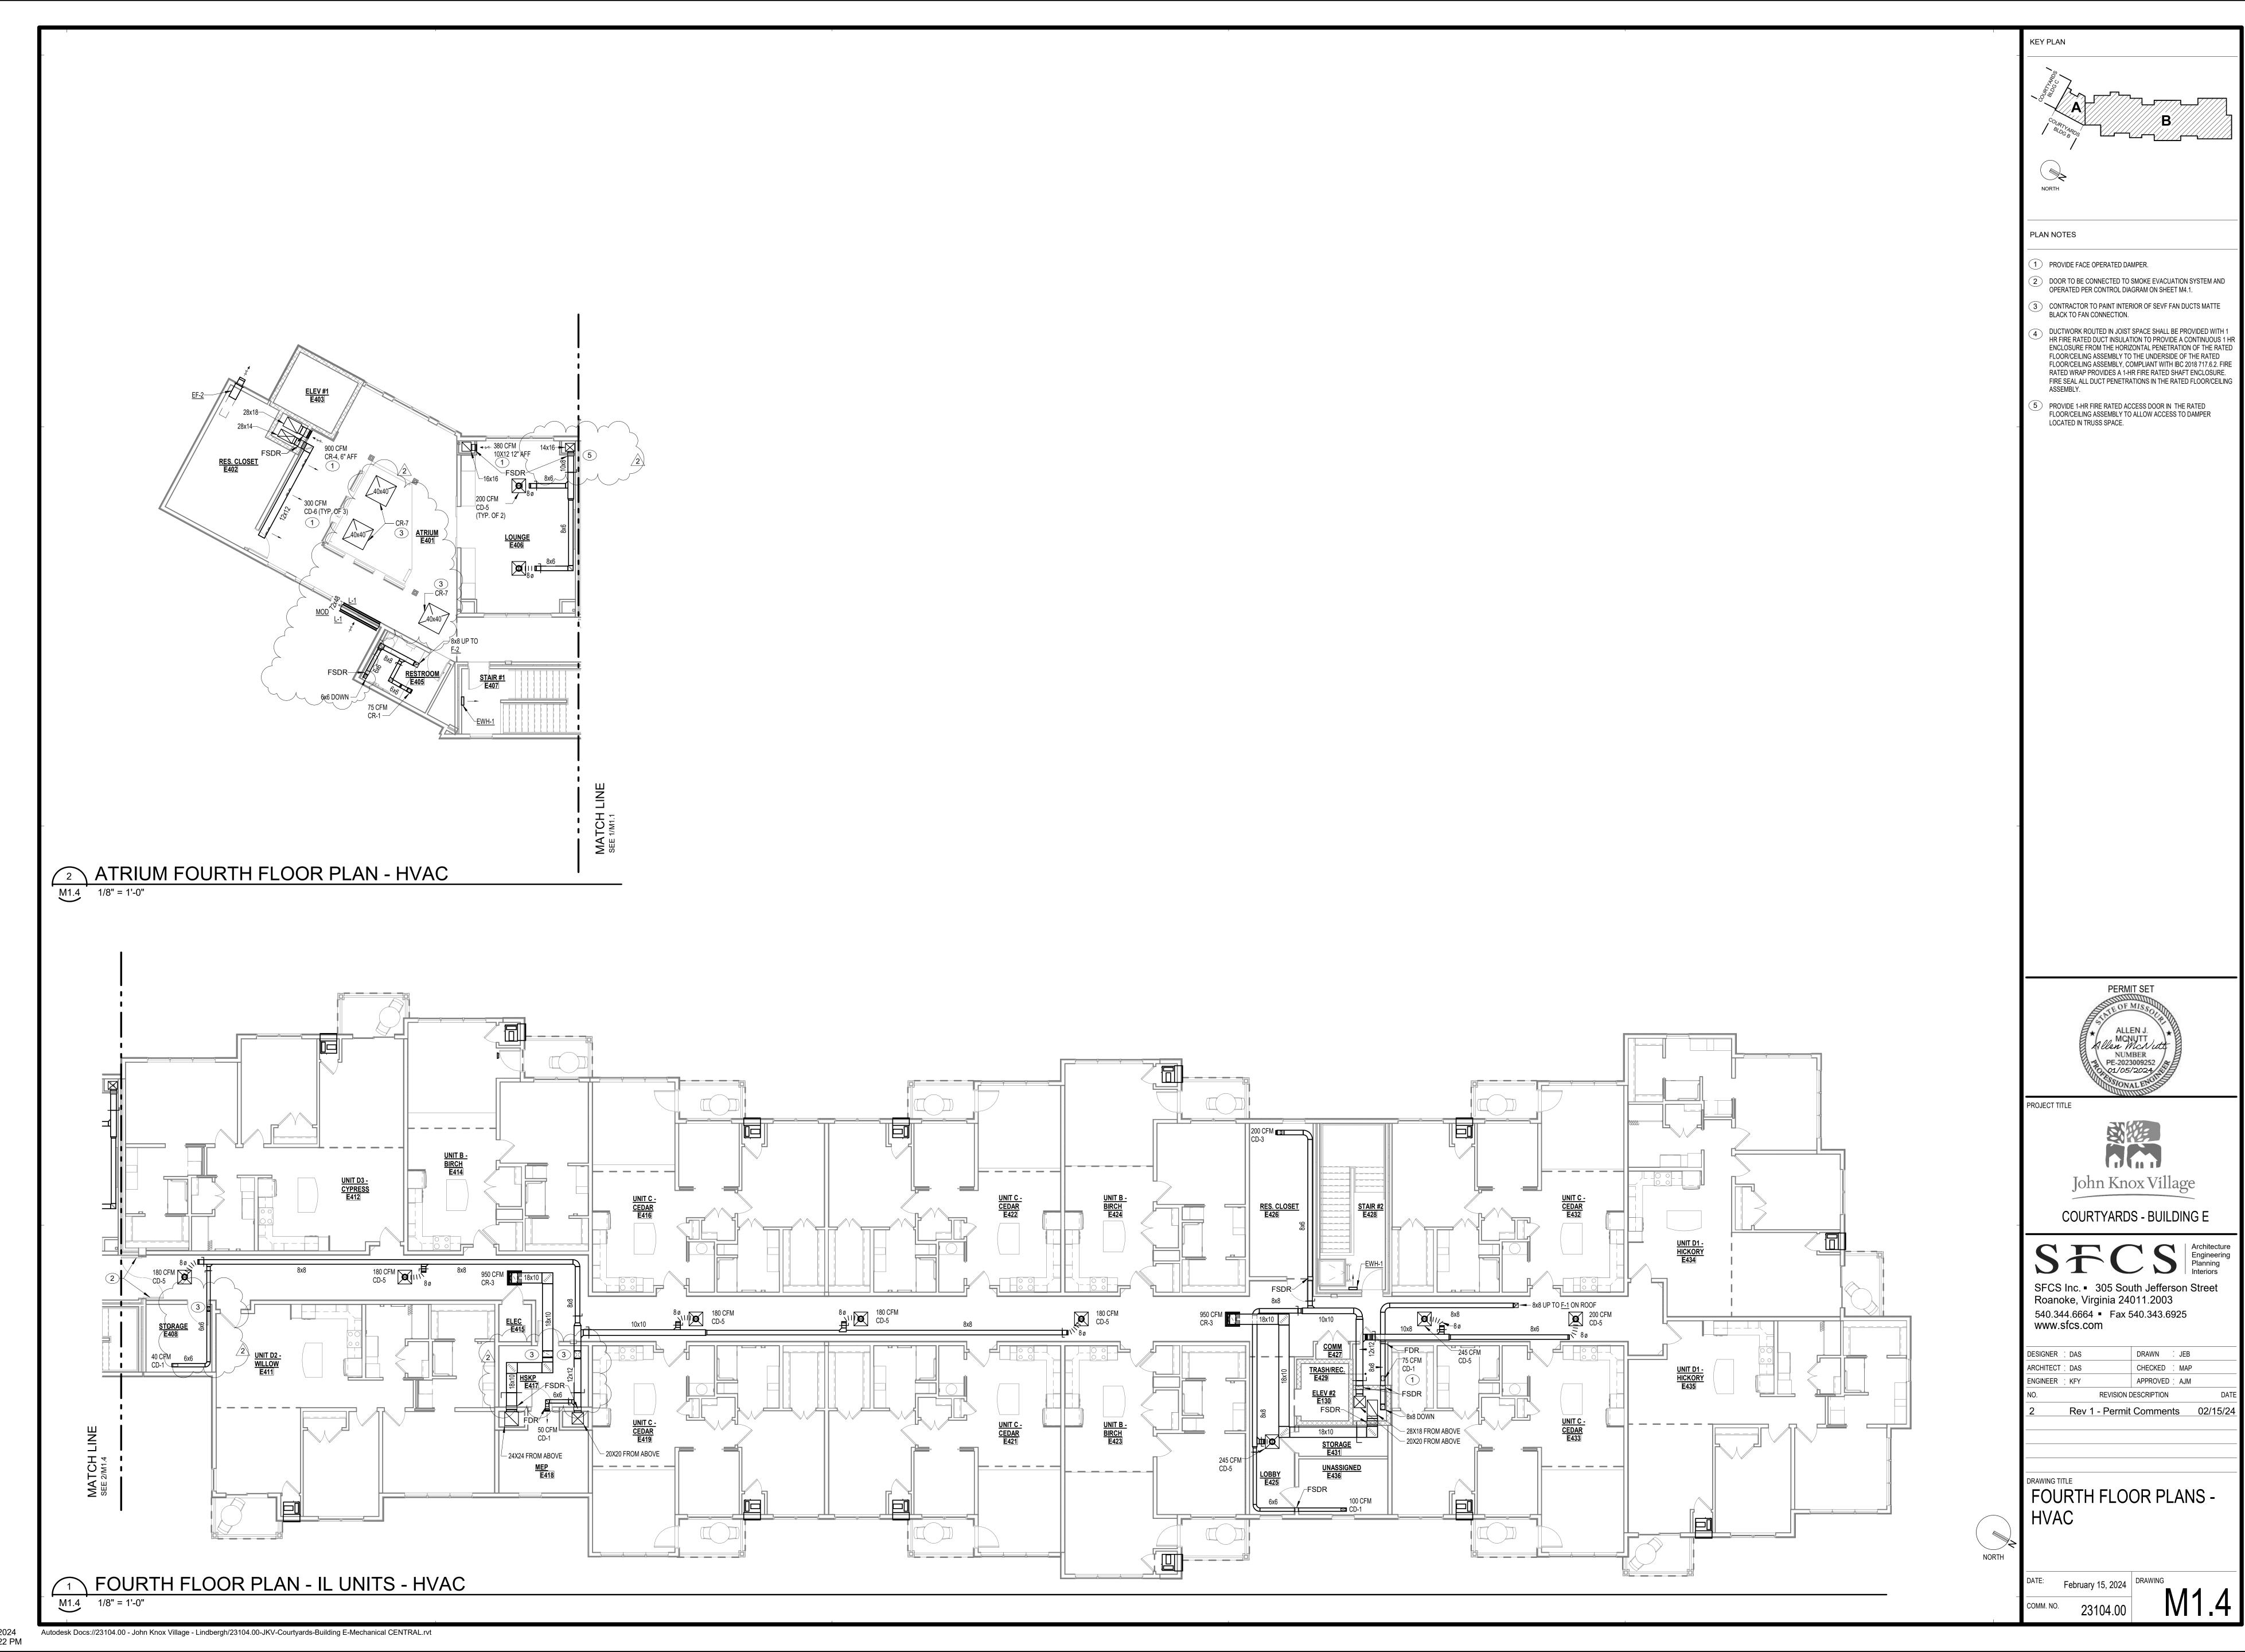

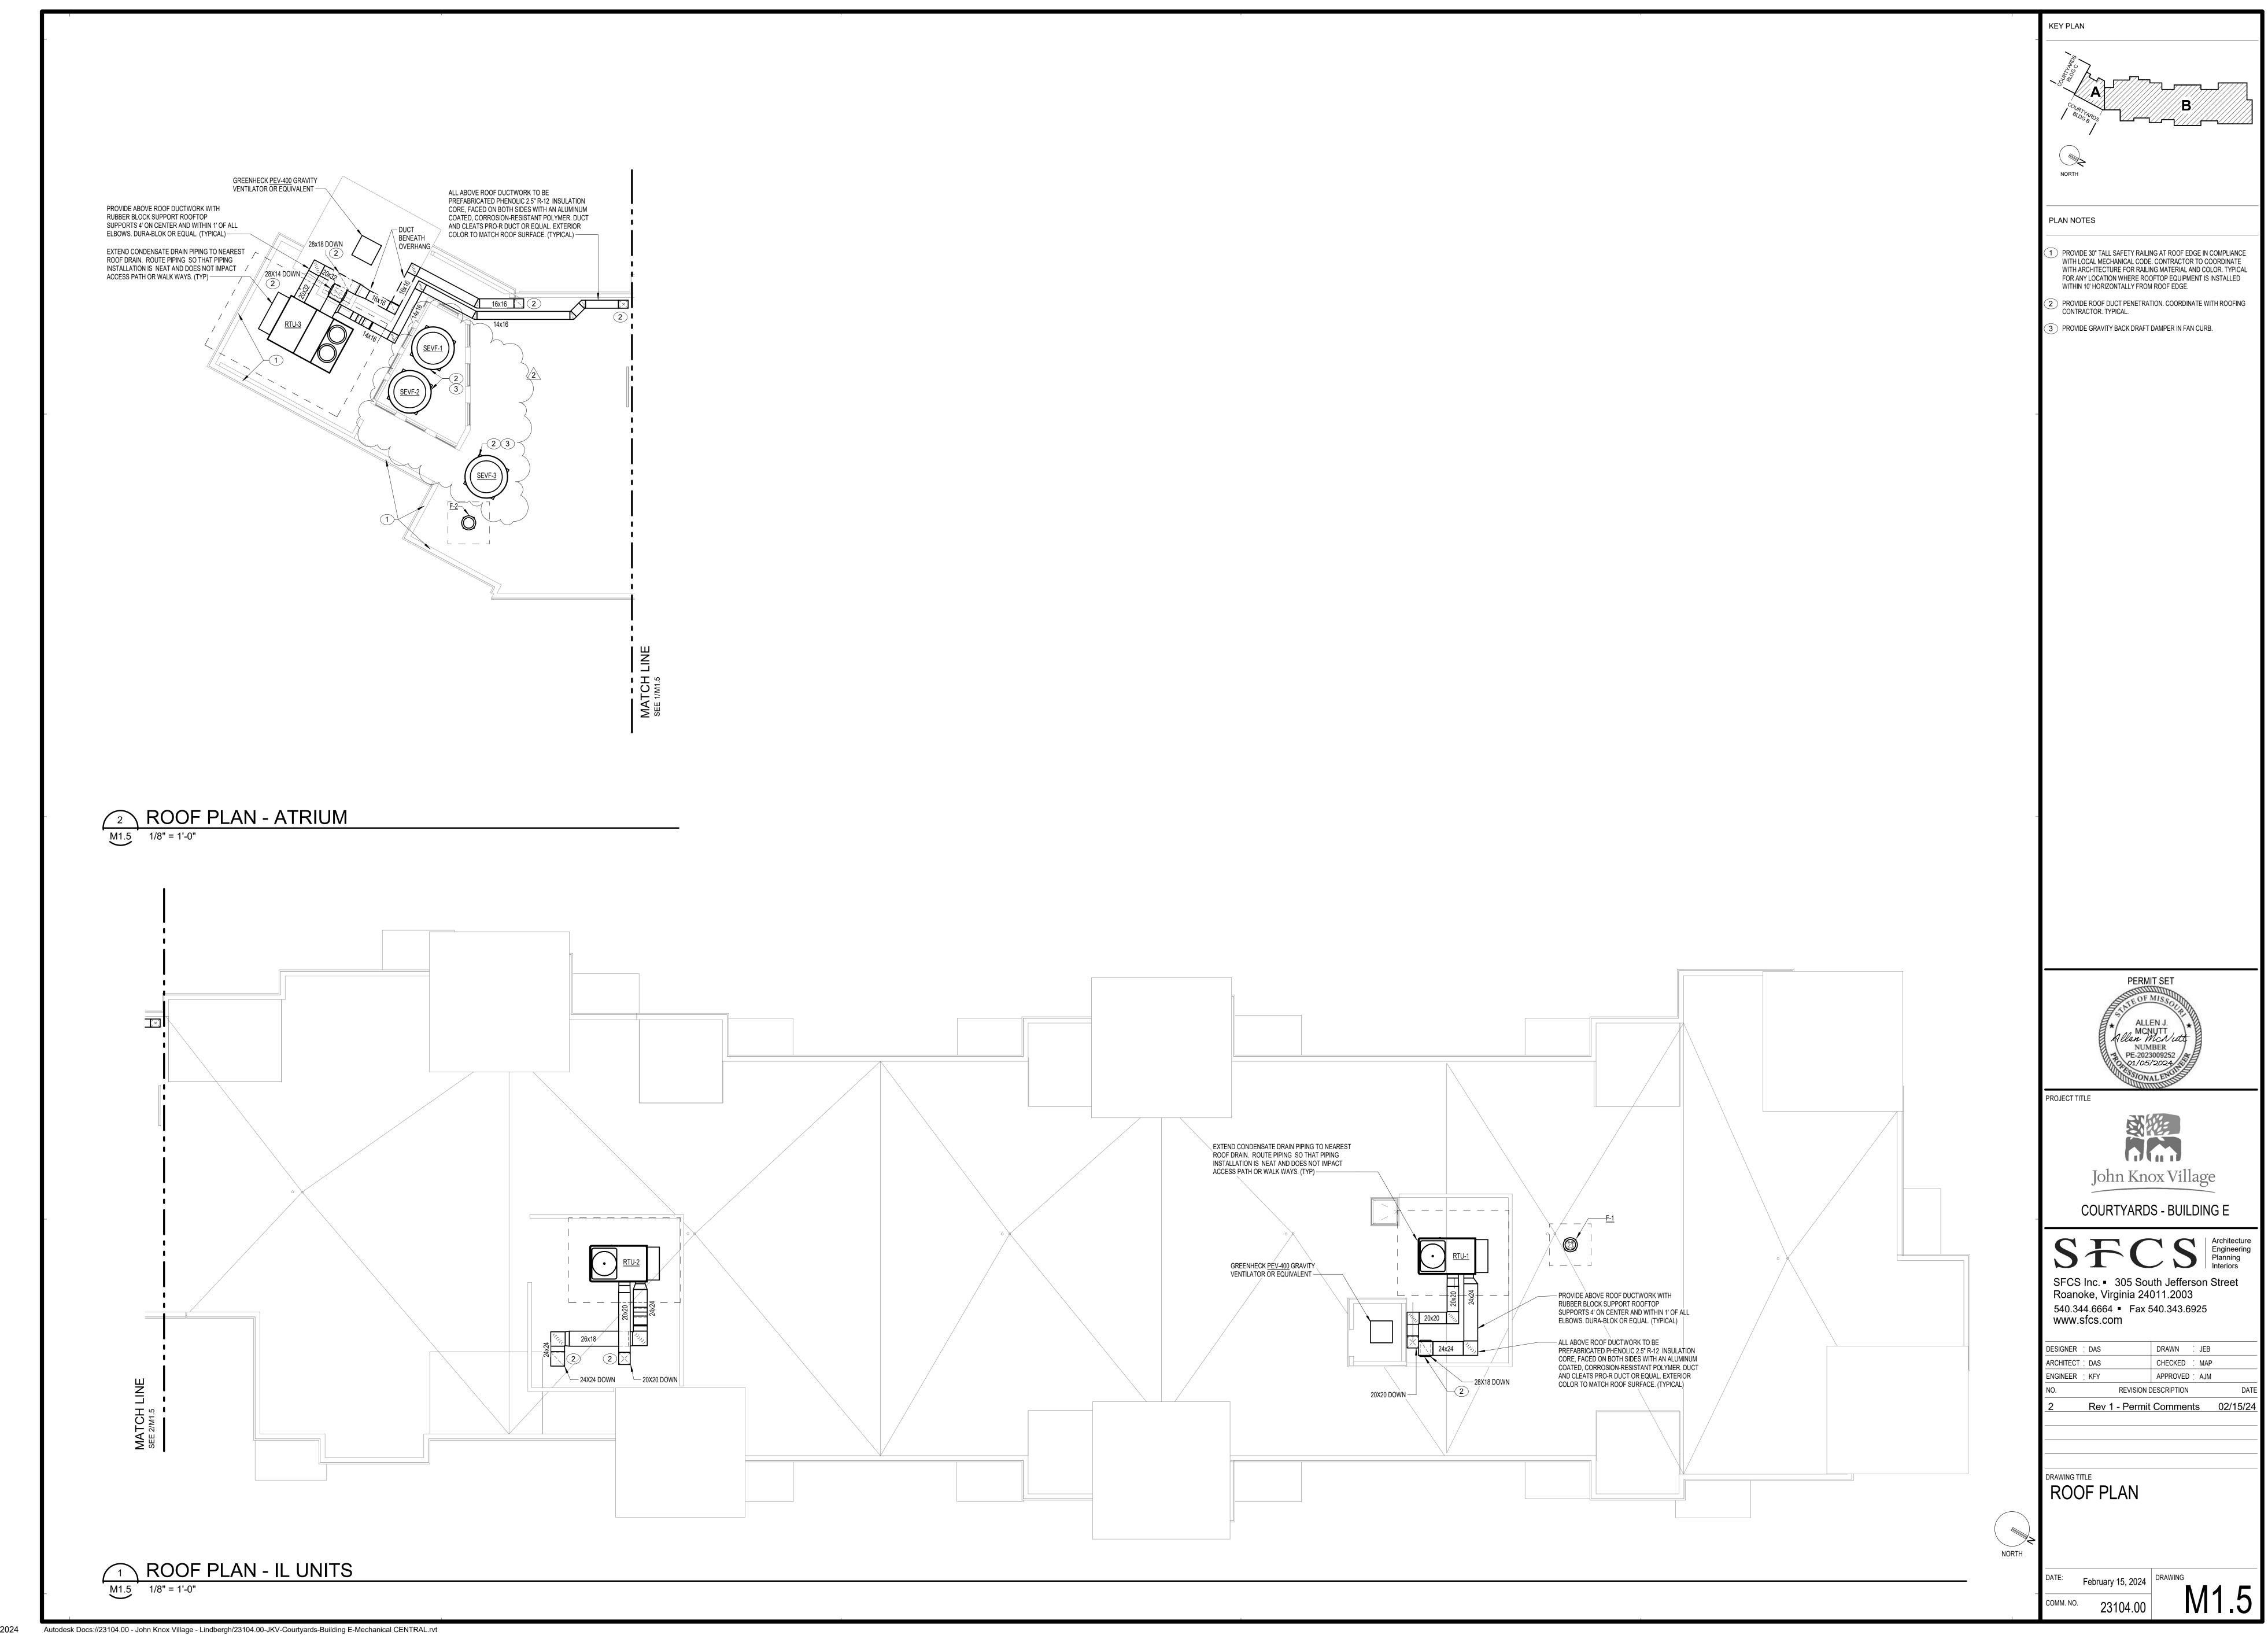

2/16/2024 1:29:24 PM

4 EXTERIOR WALL LOUVER PROVIDED WITH UNIT EXHAUST WALL CAP  $\neg$ EXHAUST WALL CAP 90 CFM CD-1 PRIMARY BEDROOM E469 DINING ROOM E476 8X6 CD-2 ABOVE DOOR, BOTH FACES 5 UNIT D3 - HVAC

M2.1 1/4" = 1'-0"

4 UNIT D2 - HVAC M2.1 1/4" = 1'-0"

3 UNIT D1 - HVAC M2.1 1/4" = 1'-0"

EXHAUST WALL CAP -

WALL CAP

8X6 CD-2 ABOVE DOOR,

210 CFM 8ø


BOTH FACES

2 UNIT C - HVAC M2.1 1/4" = 1'-0"


190 CFM

190 CFM ▼ CD-3 ■


8X6 CD-2 ABOVE DOOR, BOTH FACES —

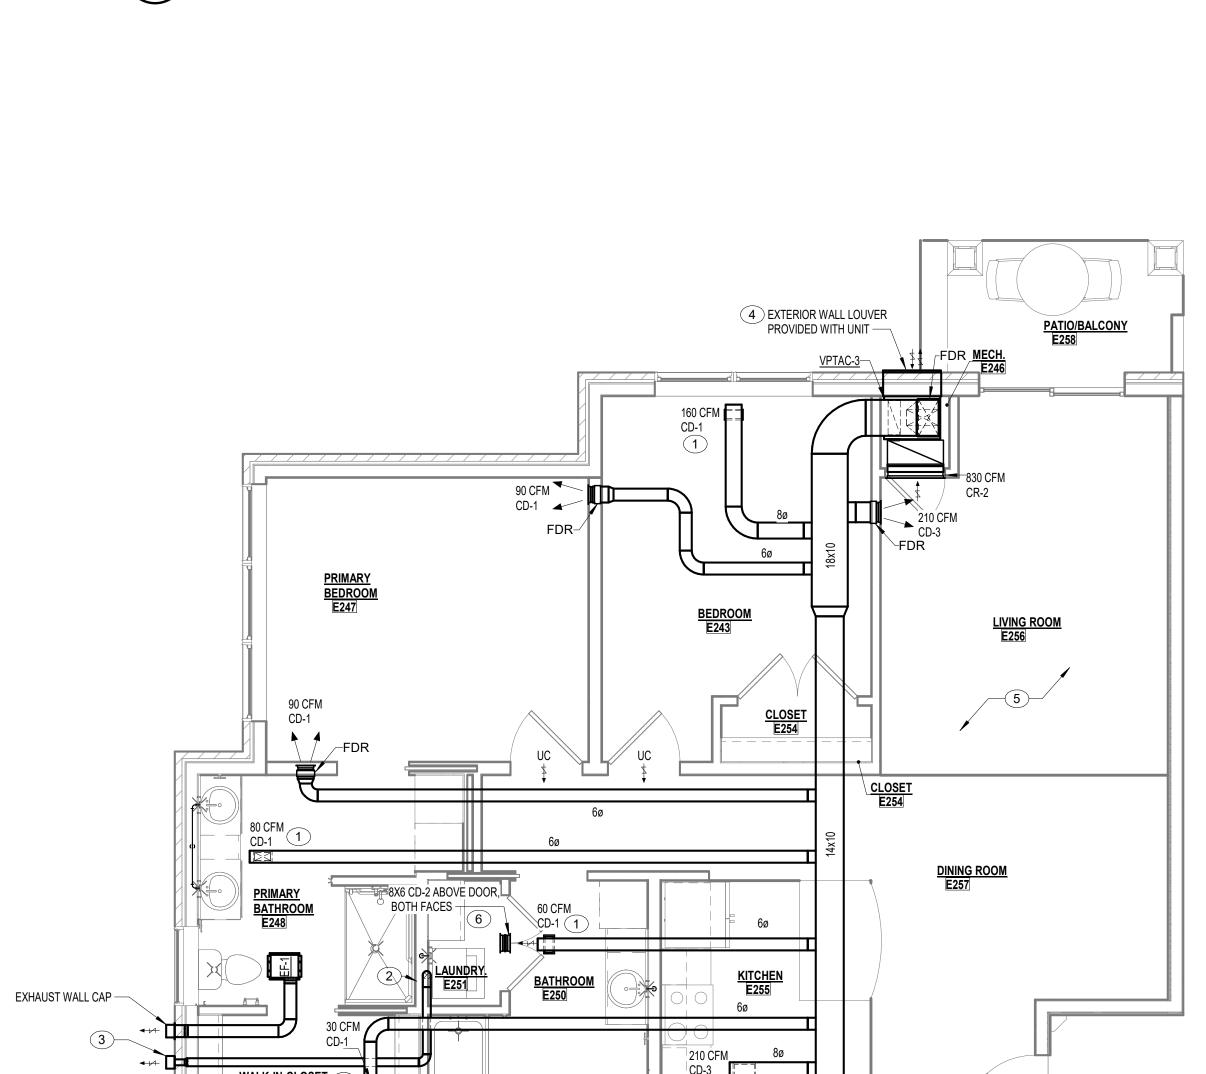

4 EXTERIOR WALL LOUVER PROVIDED WITH UNIT

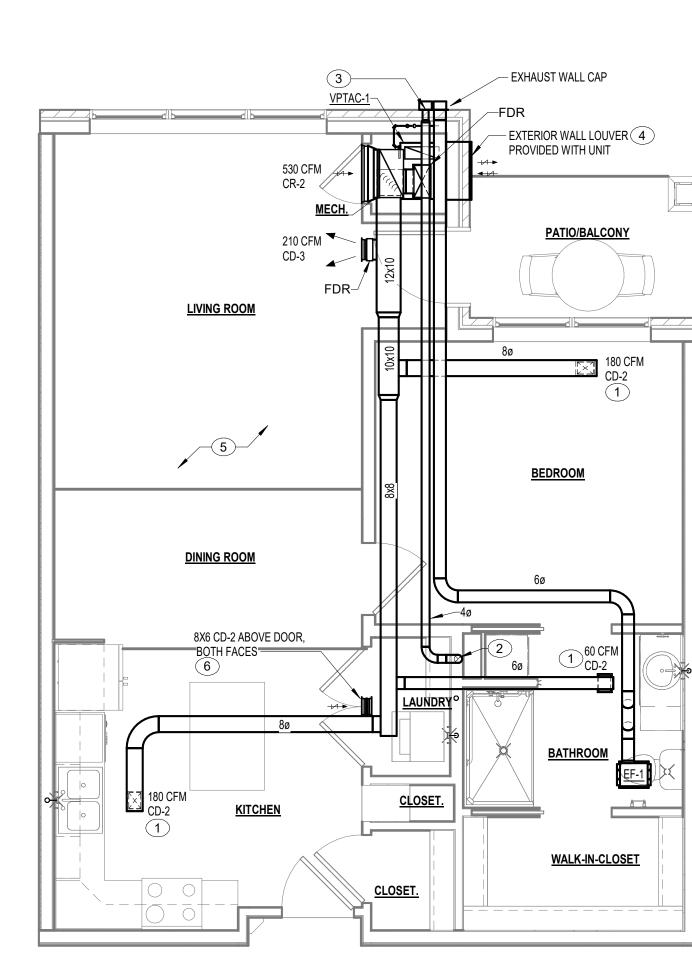

1 UNIT B - HVAC M2.1 1/4" = 1'-0"

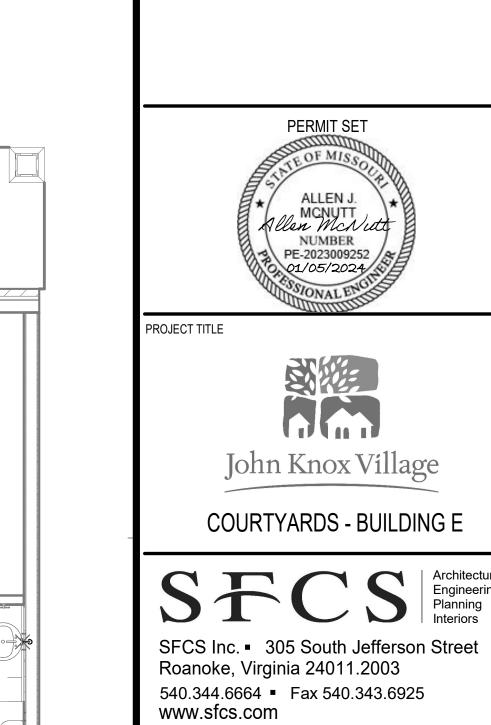

DESIGNER : DAS

ARCHITECT : DAS

PLAN NOTES

EXTERIOR WALL LOUVER 4
PROVIDED WITH UNIT

EXHAUST WALL CAP

PROVIDE CEILING RADIATION DAMPER. TYPICAL OF ALL AIR DEVICE

PENETRATIONS IN RESIDENT UNIT CEILINGS.

3 DRYER VENT WALL CAP WITH BACKDRAFT DAMPER

(4) VTAC OA FLOW RATE SHALL MATCH COMBINED DWELLING UNIT BATHROOM EXHAUST OR MAXIMUM UNIT OA VALUE, WHICHEVER IS

5 PROVIDE FACE OPERATED BALANCING DAMPERS FOR ALL SUPPLY

6 PROVIDE TRANSFER DUCT ABOVE LAUNDRY ROOM DOOR. UTILIZE 8X6 CD-2 ON BOTH FINISHED SURFACES. MOUNTING HEIGHT AFF

SHALL MATCH OTHER SIDEWALL DEVICES VISIBLE IN SAME SPACE.
TYPICAL OF ALL RESIDENT UNIT LAUNDRY ROOMS.

2 4"Ø RIGID DRYER VENT DOWN TO DRYER

REVISION DESCRIPTION


DRAWN : JEB

CHECKED : MAP APPROVED ; AJM


ENLARGED PLANS - HVAC

Autodesk Docs://23104.00 - John Knox Village - Lindbergh/23104.00-JKV-Courtyards-Building E-Mechanical CENTRAL.rvt

2/16/2024 1:29:25 PM

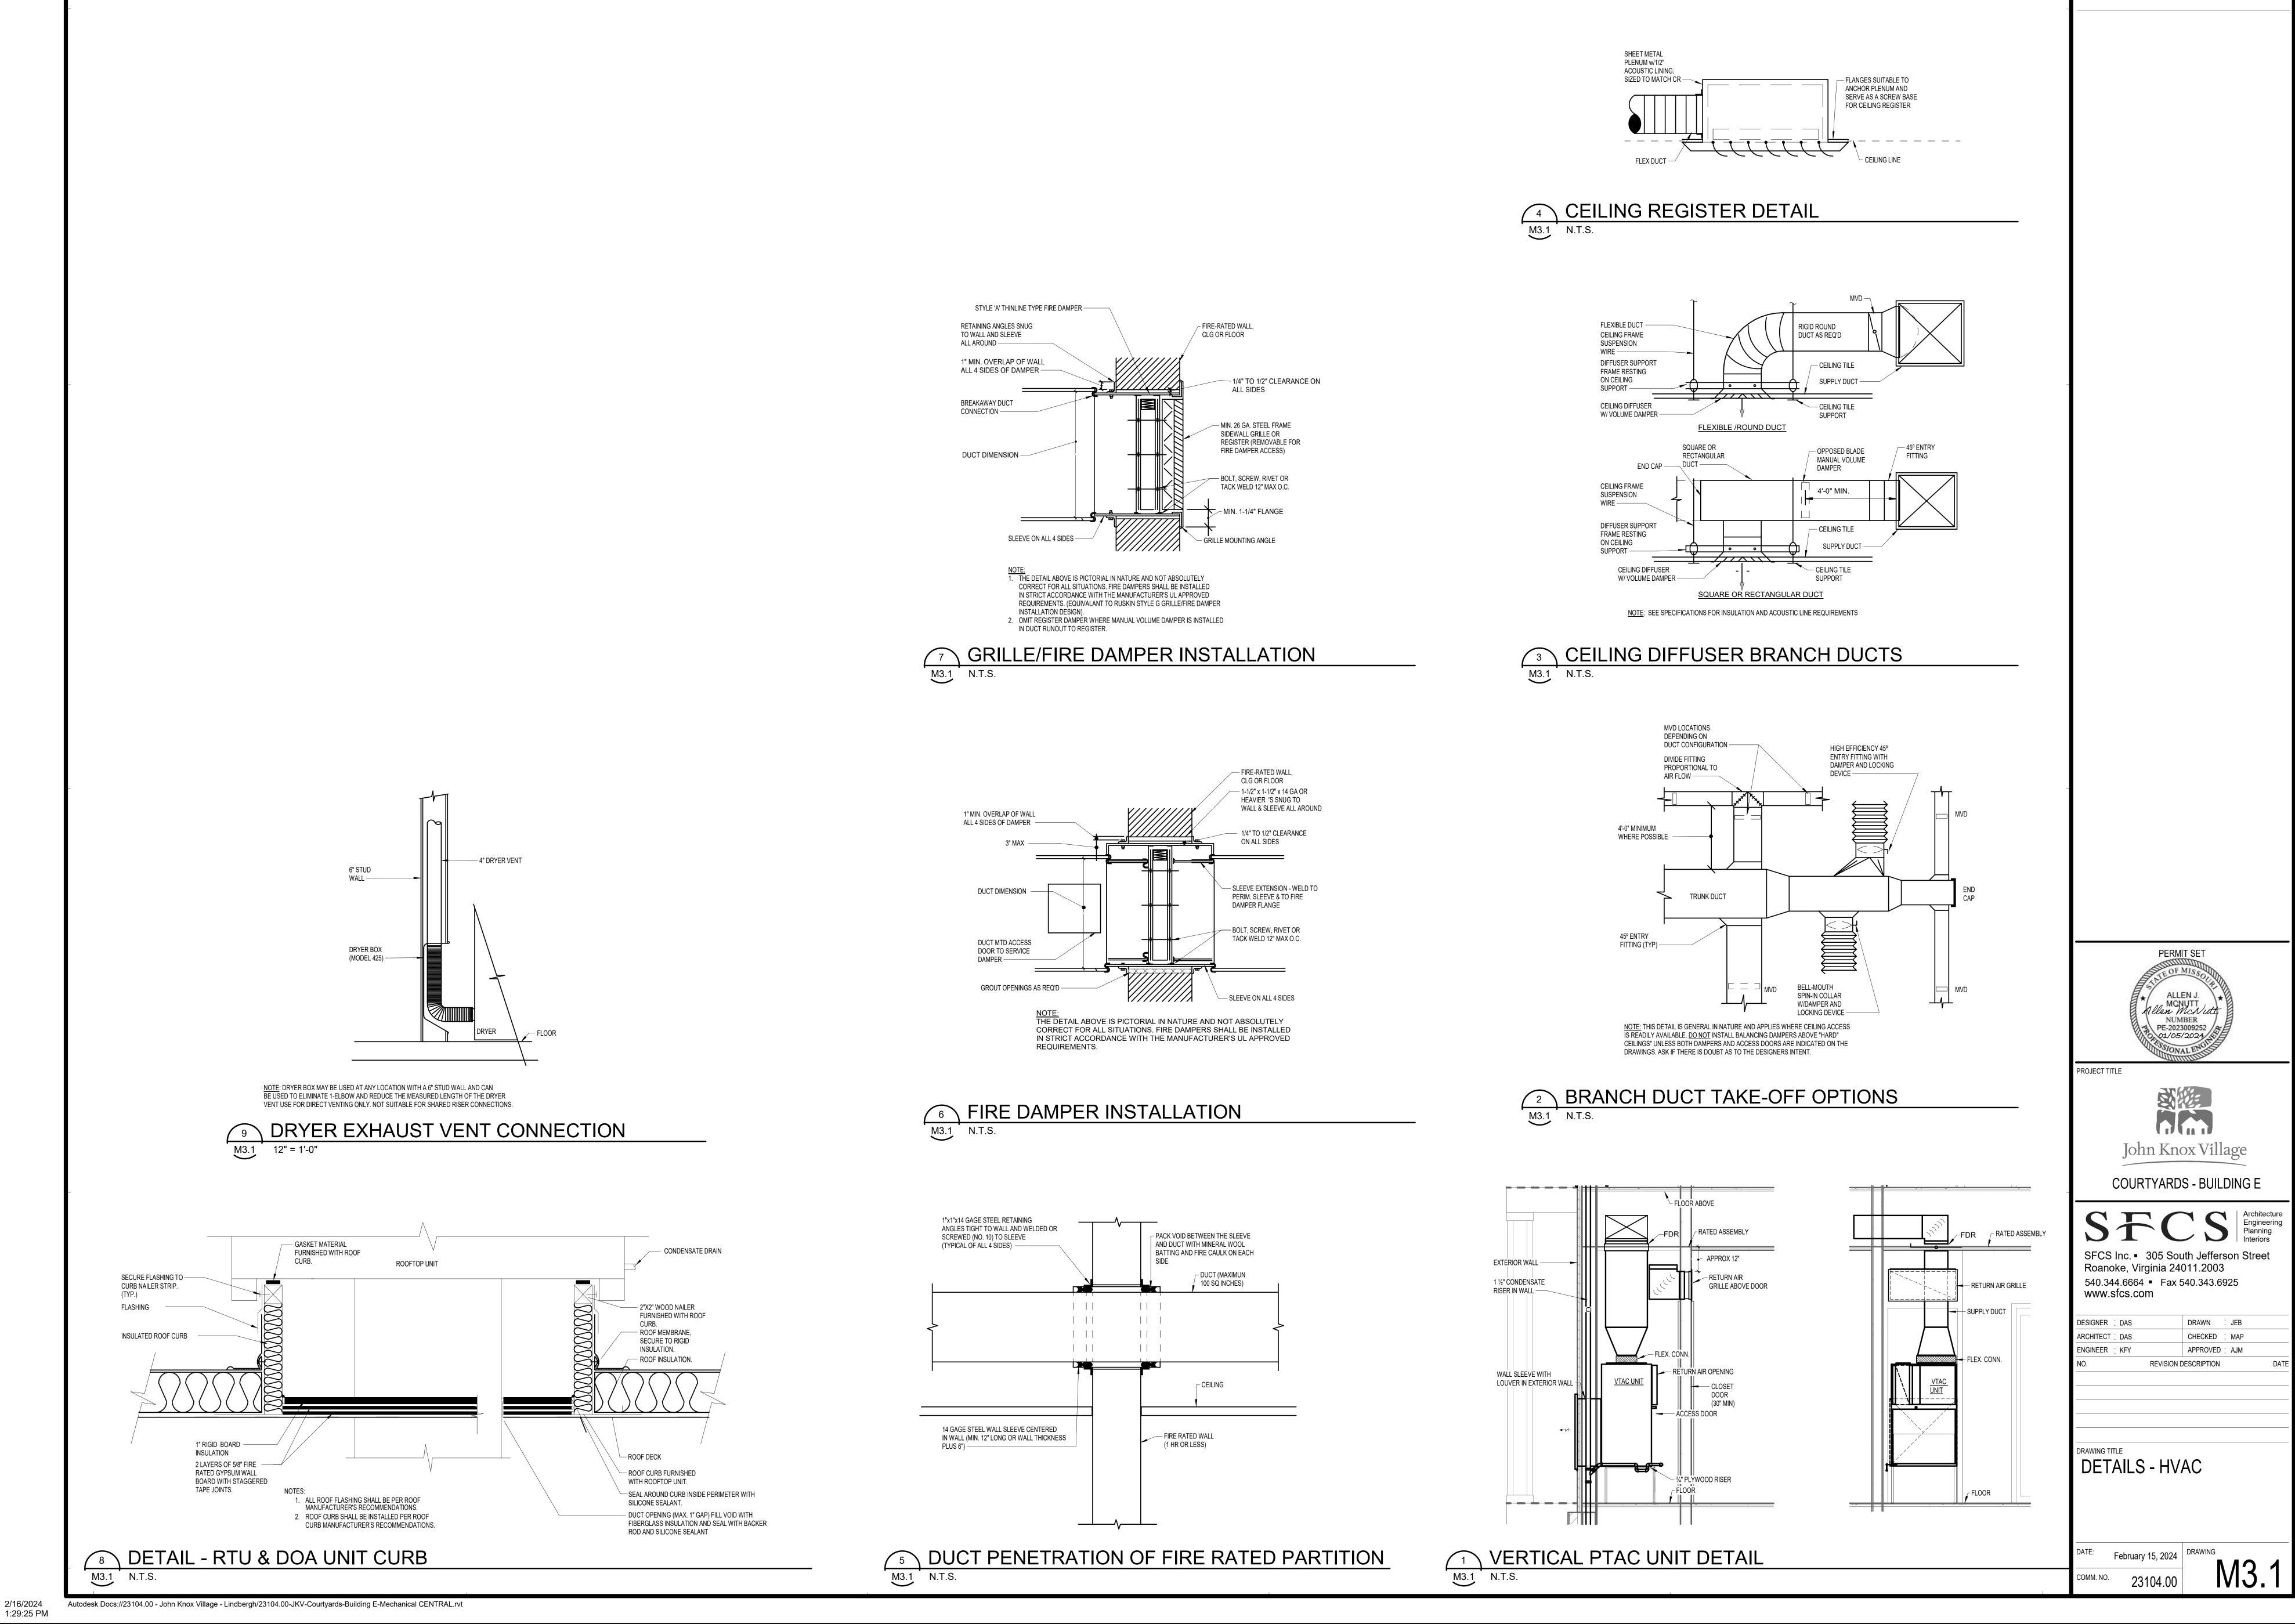

**GENERAL NOTES** 

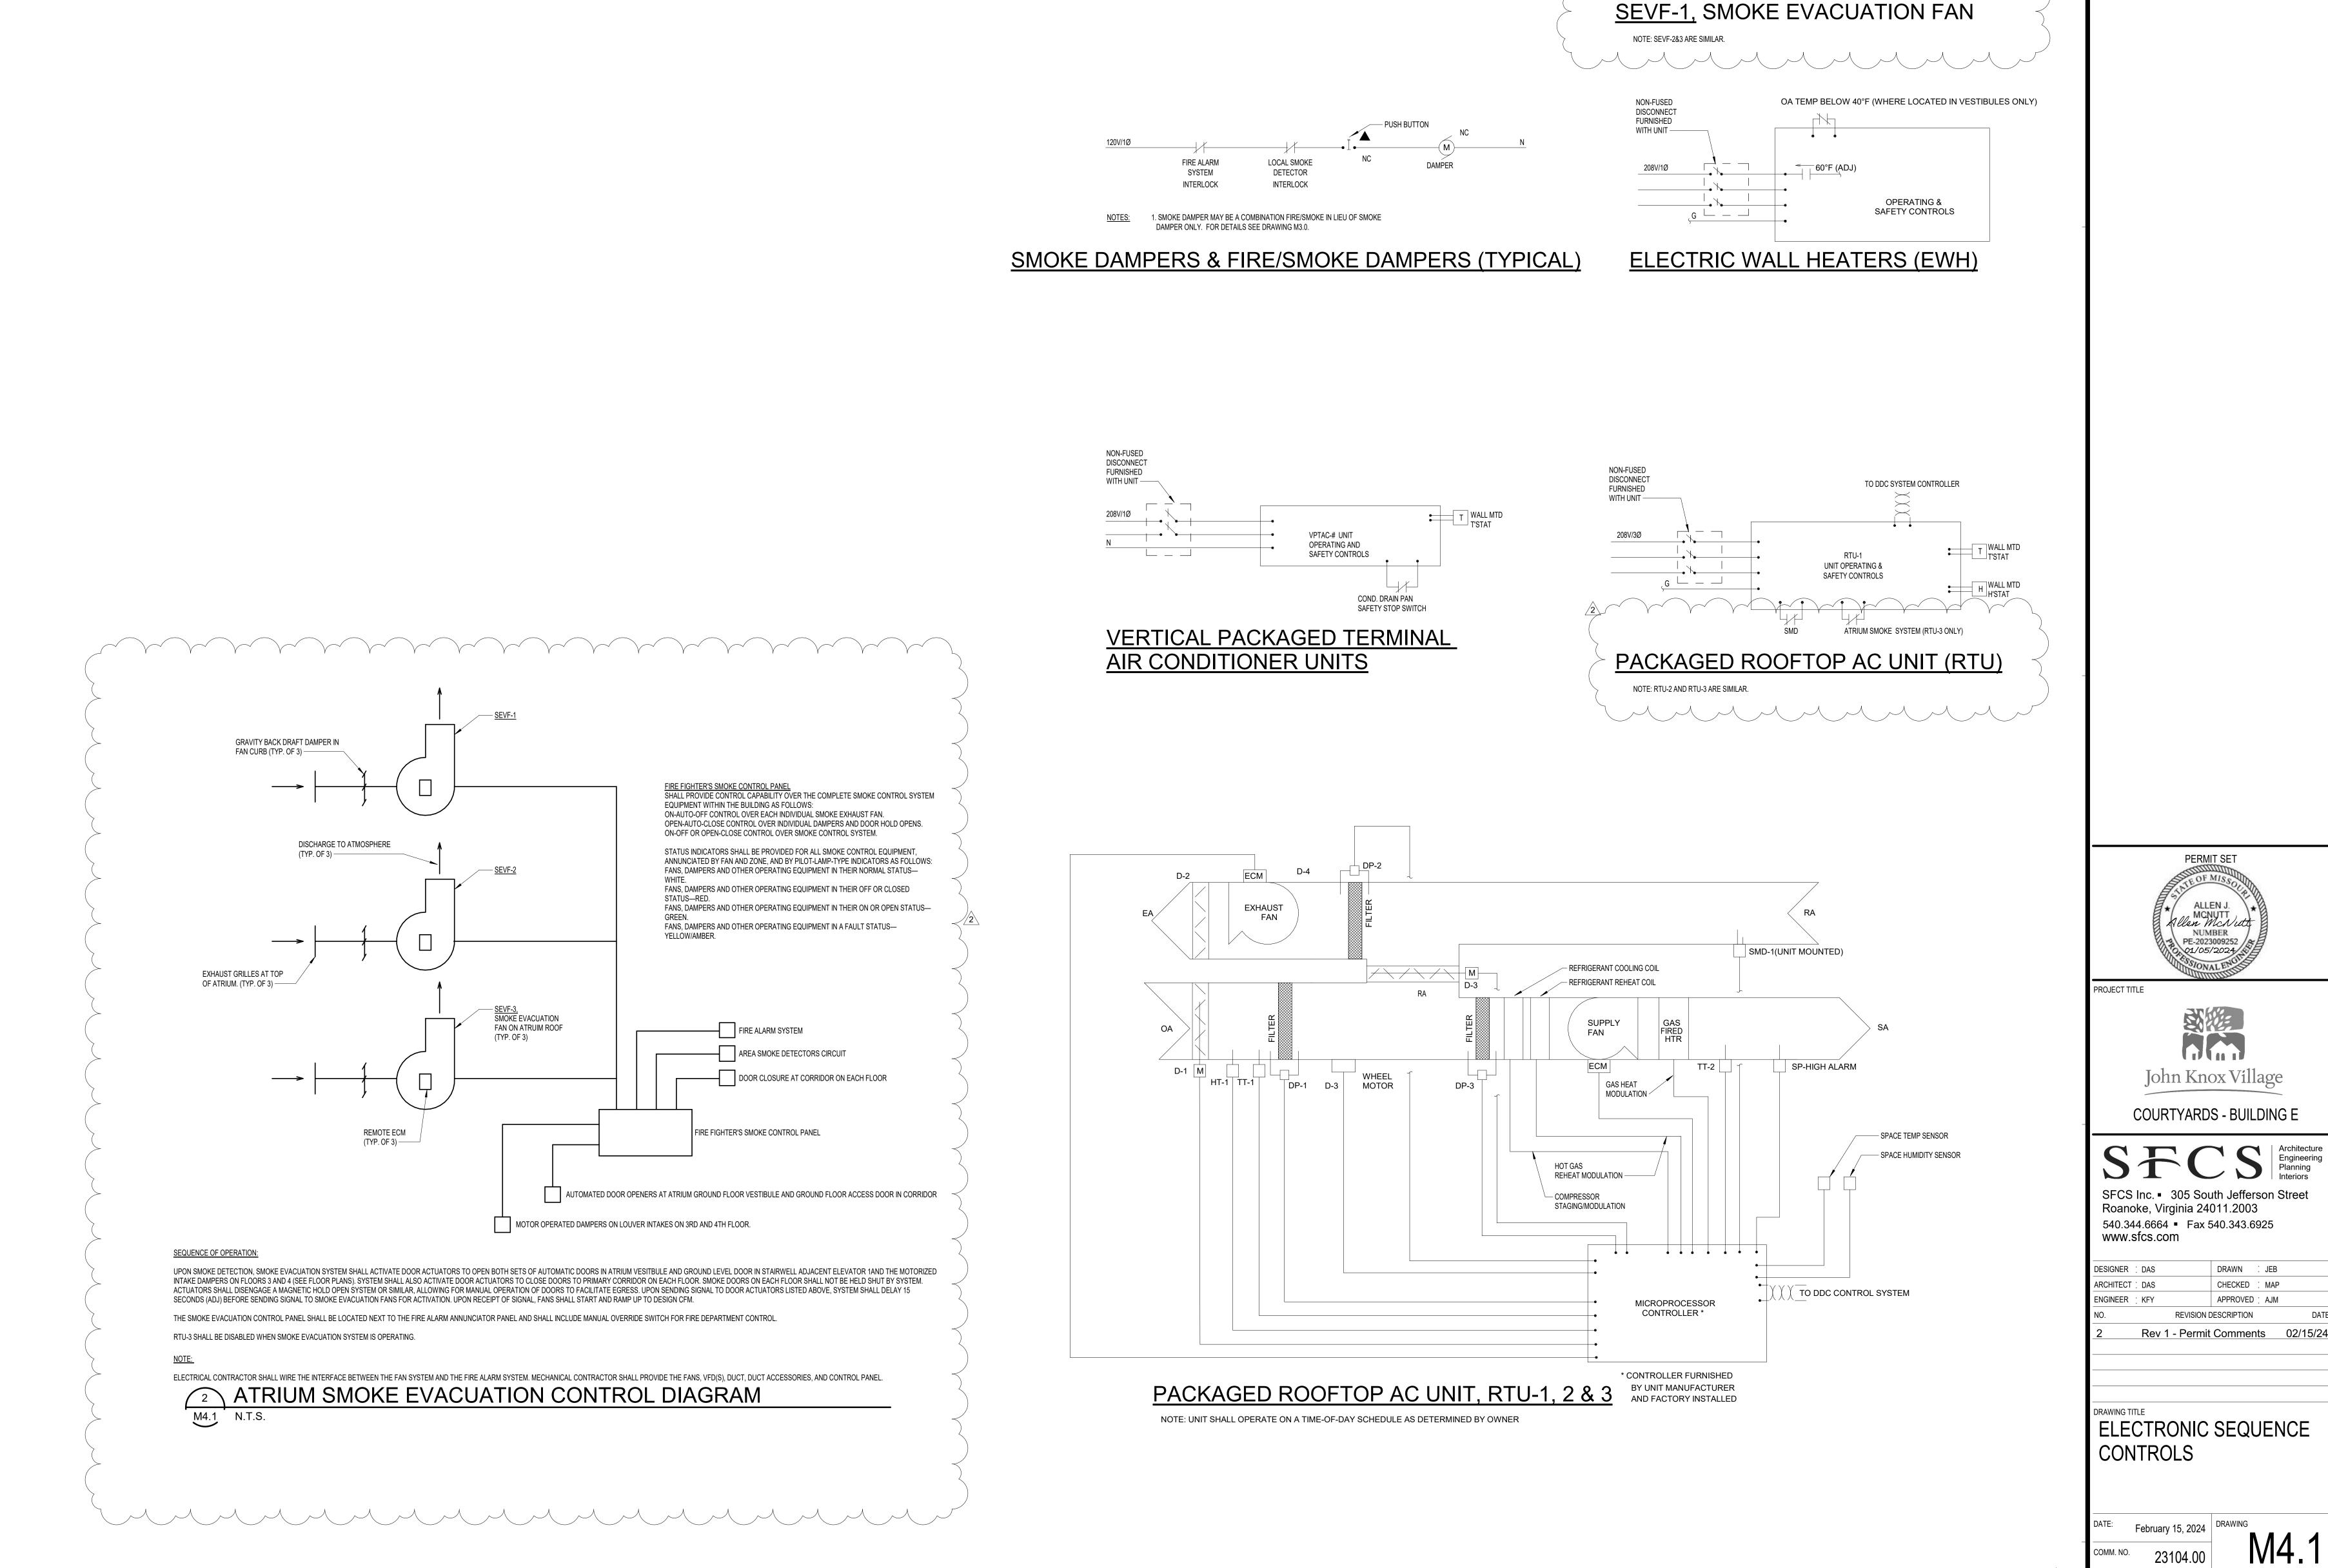

GENERAL NOTES

TO FIRE ALARM SYSTEM

<u>SEVF-1</u> MOTOR ECM CONTROLLER

SMD, IN ATRIUM

DISCONNECT

FURNISHED WITH UNIT -

208V/3Ø

1:29:25 PM

Autodesk Docs://23104.00 - John Knox Village - Lindbergh/23104.00-JKV-Courtyards-Building E-Mechanical CENTRAL.rvt

#### DITIMBING EIVTHDE COLEDITIE

<u>AG</u>	DESCRIPTION	MINIMUM CW	MINIMUM HW	MINIMUM TRAP	MINIMUM SOIL OR WASTE	MINIMUM VENT
	WATER CLOSETS:	7				1
<u>-10</u>	GERBER "VIPER" MODEL 21-518 ELONGATED BOWL, ADA COMPLIANT, FLOOR MOUNTED, WHITE, TANK TYPE, 1.6 GPF BOLT CAPS AND WHITE CLOSED FRONT SEAT WITH COVER, WITH SLOW CLOSE STAINLESS STEEL CHECK HINGES AND ANGLE SUPPLY WITH WHEEL HANDLE STOPS.	1/2"	-	-	3"	1-1/2"
<u>-11</u>	GERBER "VIPER" MODEL 21-518 ELONGATED BOWL, ADA COMPLIANT, FLOOR MOUNTED, WHITE, TANK TYPE, 1.6 GPF BOLT CAPS AND WHITE OPEN FRONT SEAT WITH COVER, WITH SLOW CLOSE STAINLESS STEEL CHECK HINGES AND ANGLE SUPPLY WITH WHEEL HANDLE STOPS.	1/2"	-	-	3"	1-1/2"
	LAVATORIES: PROVIDE COMPLETE UNDER LAVATORY ANTI-MICROBIAL WASTE AND WATER PIPING PROTECTION INSULATION KITS AS MANUFACTURERED BY PLUMBEREX SPECIALTY PRODUCTS, INC., OR TRUEBRO, INC. ON ALL HANDICAPPED LAVATORIES.					
<u>30</u>	LAVATORY BOWL: INTEGRAL WITH COUNTERTOP. SEE ARCHITECTURAL FINISH SPECIFICATIONS. FAUCET: PEERLESS MODEL P136LF-M SINGLE LEVER HANDLE, 1.5 GPM, CHROME FINISH. ACCESSORIES: POP UP DRAIN.	1/2"	1/2"	1-1/4"	1-1/2"	1-1/2"
<u>31</u>	LAVATORY BOWL: AMERICAN STANDARD "OVALYN" MODEL 0496.221, WHITE, UNDERMOUNT BOWL 19-1/4" X 16-1/4".  FAUCET: AMERICAN STANDARD "SELECTRONIC" MODEL 6055.105, BATTERY POWERED SENSOR FAUCET, 0.5 GPM, CHROME FINISH  ACCESSORIES: GRID DRAIN, WATTS MODEL LFUSG-B-M2 POINT OF USE THERMOSTATIC MIXING VALVE CONFORMING TO ASSE 1070, WITH INTEGRAL CHECK VALVES. SET MAXIMUM OUTLET TEMPERATURE TO 110 DEGREES.	1/2"	1/2"	1-1/4"	1-1/2"	1-1/2"
	SINKS: COMPLETE UNDER SINK ANTI-MICROBIAL WASTE AND WATER PIPING PROTECTION INSULATION KITS AS MANUFACTURERED BY PLUMBEREX SPECIALTY PRODUCTS, INC., OR TRUEBRO, INC. ON ALL HANDICAPPED SINKS.					
<u>40</u>	BASIN: ELKAY MODEL ELUH3220, STAINLESS STEEL, DOUBLE BOWL, UNDERMOUNT SINK. 31-1/4" WIDE X 1'-8" LONG X 7-7/8" DEEP. FAUCET: PEERLESS MODEL P6935LF, SINGLE HOLE, SINGLE LEVER HANDLE, PULL DOWN SPRAY, 1.5 GPM, CERAMIC CARTRIDGE, STAINLESS STEEL FINISH ACCESSORIES: BASKET STRAINER DRAIN ASSEMBLY. DO NOT INSTALL INCLUDED DECKPLATE.	1/2"	1/2"	1-1/2"	2"	1-1/2"
<u>41</u>	(BIRCH UNIT E123, CEDAR UNIT E316) BASIN: ELKAY MODEL ELUHAD3118, STAINLESS STEEL, DOUBLE BOWL, ADA COMPLIANT, UNDERMOUNT SINK. 30-3/4" WIDE X 18-1/2" LONG X 5-1/2" DEEP. FAUCET: PEERLESS MODEL P6935LF, SINGLE HOLE, SINGLE LEVER HANDLE, PULL DOWN SPRAY, 1.5 GPM, CERAMIC CARTRIDGE, STAINLESS STEEL FINISH ACCESSORIES: BASKET STRAINER DRAIN ASSEMBLY. DO NOT INSTALL INCLUDED DECKPLATE.	1/2"	1/2"	1-1/2"	2"	1-1/2"
<u>42</u>	MOP SINK: PROFLO MODEL PFMB2424, MOLDED STONE, INTEGRAL DRAIN. 24" WIDE X 24" LONG X 10" DEEP. FAUCET: ZURN MODEL Z843M1 SERVICE SINK FAUCET WITH VACUUM BREAKER AND INTEGRAL CHECK VALVES AND INTEGRAL STOPS. ACCESSORIES: HOSE AND HOSE BRACKET, MOP HANGER, ADJUSTABLE WALL BRACE, PAIL HOOK, STAINLESS STEEL BUMPERGUARDS ON ALL CURBS AND STAINLESS STEEL WALL GUARDS ON ALL ADJACENT WALLS.	1/2"	1/2"	3"	3"	1-1/2"
43	BASIN: ELKAY MODEL ELUHAD3118, STAINLESS STEEL, DOUBLE BOWL, ADA COMPLIANT, UNDERMOUNT SINK. 30-3/4" WIDE X 18-1/2" LONG X 5-1/2" DEEP. FAUCET: PEERLESS MODEL P6935LF, SINGLE HOLE, SINGLE LEVER HANDLE, PULL DOWN SPRAY, 1.5 GPM, CERAMIC CARTRIDGE, STAINLESS STEEL FINISH ACCESSORIES: BASKET STRAINER DRAIN ASSEMBLY. DO NOT INSTALL INCLUDED DECKPLATE.	1/2"	1/2"	1-1/2"	2"	1-1/2"
	SHOWERS/TUB/BATHING UNITS: SHOWERS SHALL HAVE A MAXIMUM FLOW RATE OF 2.5 GALLONS PER MINUTE. UNITS SHALL BE CONFIGURED LEFT-HAND AND RIGHT-HAND UNITS AS REQUIRED BY FLOOR PLAN LAYOUT. PROVIDE INLET CHECK STOPS ON ALL SHOWER VALVES THAT ARE CONNECTED TO HAND-HELD SHOWER WANDS WITH ON/OFF CAPABILITY.					
<u>60</u>	SURROUND: COMFORT DESIGNS MODEL XSS 6036 BF, ONE PIECE, GELCOAT/FIBERGLASS SHOWER MODULE WITH 1" THRESHOLD, GRAB BARS, SEMI-PERMANENT THRESHOLD AND T-SHAPED WATER STOPPER.  SHOWER TRIM: KOHLER "BANCROFT" MODEL K-10583-4 SHOWER TRIM WITH METAL LEVER HANDLE AND SHOWER HEAD WITH KOHLER RITE-TEMP K-8304-KS PRESSURE-BALANCED MIXING SHOWER VALVE WITH INTEGRAL STOPS AND CHECK VALVES, KOHLER "BANCROFT" MODEL K-T10595-4 TRANSFER VALVE, GROHE MODEL 26077EN0 24 INCH SHOWER BAR WITH HAND HELD SHOWER AND 69 INCH HOSE, AND GROHE MODEL 28627EN0 SHOWER OUTLET ELBOW. ALL COMPONENTS TO BE BRUSHED NICKEL FINISH. PROVIDE ALL REQUIRED MATCHING MANUFACTURER ACCESSORIES.  DRAIN: PROVIDE 2" BRUSHED NICKEL FINISH SHOWER DRAIN.	1/2"	1/2"	2"	2"	1-1/2"
<u>61</u>	SURROUND: AQUARIUS MODEL G 6237 BF .75, ONE PIECE, ADA COMPLIANT, ROLL-IN, GELCOAT/FIBERGLASS SHOWER MODULE WITH .75" THRESHOLD, ADA GRAB BARS, FACTORY FOLD UP SEAT, SEMI-PERMANENT THRESHOLD AND T-SHAPED WATER STOPPER.  SHOWER TRIM: KOHLER "BANCROFT" MODEL K-10583-4 SHOWER TRIM WITH METAL LEVER HANDLE AND SHOWER HEAD WITH KOHLER RITE-TEMP K-8304-KS PRESSURE-BALANCED MIXING SHOWER VALVE WITH INTEGRAL STOPS AND CHECK VALVES, KOHLER "BANCROFT" MODEL K-T10595-4 TRANSFER VALVE, GROHE MODEL 26077EN0 24 INCH SHOWER BAR WITH HAND HELD SHOWER AND 69 INCH HOSE, AND GROHE MODEL 28627EN0 SHOWER OUTLET ELBOW. ALL COMPONENTS TO BE BRUSHED NICKEL FINISH. PROVIDE ALL REQUIRED MATCHING MANUFACTURER ACCESSORIES.  DRAIN: PROVIDE 2" BRUSHED NICKEL FINISH SHOWER DRAIN.	1/2"	1/2"	2"	2"	1-1/2"
<u>62</u>	BATHTUB: AMERICAN STANDARD "PRINCETON" MODEL 2390.202, WHITE, ACID RESISTANT PORCELAIN FINISH. TRIM: KOHLER "BANCROFT" MODEL K-T10581-4 BATH TRIM KIT WITH METAL LEVER HANDLE, SHOWER HEAD AND TUB SPOUT WITH KOHLER RITE-TEMP K-8304-KS PRESSURE-BALANCED MIXING SHOWER VALVE WITH INTEGRAL STOPS AND CHECK VALVES, KOHLER "BANCROFT" MODEL K-T10595-4 TRANSFER VALVE, GROHE MODEL 26077EN0 24 INCH SHOWER BAR WITH HAND HELD SHOWER AND 69 INCH HOSE, AND GROHE MODEL 28627EN0 SHOWER OUTLET ELBOW. ALL COMPONENTS TO BE BRUSHED NICKEL FINISH. PROVIDE ALL REQUIRED MATCHING MANUFACTURER ACCESSORIES. DRAIN; PROVIDE BRUSHED NICKEL FINISH TUB DRAIN ASSEMBLY WITH OVERFLOW.	1/2"	1/2"	1-1/2"	1-1/2"	1-1/2"
	MISCELLANEOUS:					
<u>′0</u>	WASHING MACHINE CONNECTION BOX: UNIT SHALL BE RECESSED TYPE, BOX AND FACE PLATE SHALL BE CONSTRUCTED OF 16 GAUGE STEEL WITH EPOXY FINISH, OR HEAVY-DUTY PLASTIC ABS. UNIT SHALL BE FITTED WITH 2-INCH DRAIN CONNECTION WITH OVERFLOW, BOTTOM SUPPLY HOSE CONNECTIONS, AS REQUIRED, WATER HAMMER ARRESTORS CONFORMING TO ASSE 1010. BOXES LOCATED ON RATED CORRIDOR OR RATED UNIT SEPARATION WALL SHAL BE A FIRE-RATED BOX ASSEMBLY APPROVED FOR FIRE-RATED INSTALLATION.	1/2"	1/2"	2"	3"	1-1/2"
<u>71</u>	ICE MAKER CONNECTION BOX: UNIT SHALL BE RECESSED TYPE, BOX AND FACE PLATE SHALL BE CONSTRUCTED OF 16 GAUGE STEEL WITH EPOXY FINISH, OR HEAVY-DUTY PLASTIC ABS. UNIT SHALL BE FITTED WITH CHROME PLATED SUPPLY VALVE. BOXES LOCATED ON RATED CORRIDOR OR RATED UNIT SEPARATION WALL SHALL BE A FIRE-RATED BOX ASSEMBLY APPROVED FOR FIRE-RATED INSTALLATION. MOUNT BOTTOM OF BOX ABOVE TRIM/BASEBOARD.	1/2"	-	-	-	-
<u>1</u>	FREEZE PROOF, AUTOMATIC DRAINING CHROME-PLATED WALL HYDRANT EQUAL TO WOODFORD MODEL #65. MOUNTED 24" ABOVE FINISHED GRADE.	3/4"	-	-	-	-
	PROVIDE BRONZE TRAP PRIMER VALVE WITH AUTOMATIC VACUUM BREAKER COMPLYING WITH ASSE 1018 WITH 1/2" CONNECTIONS MATCHING PIPING SYSTEM. PROVIDE TRAP PRIMERS BY PRECISION PLUMBING PRODUCTS, INC.; JOSAM, MFG. CO.; ZURN INDUSTRIES INC.; SMITH MFG. CO; OR WATTS DRAINAGE.	1/2"	-	-	-	-
	ZURN Z1395 ROOF POST HYDRANT, NON FREEZE, WITH VACUUM BREAKER, 3/4" HOSE CONNECTION. DEPTH OF BURY TO BE BASED UPON 4 FEET SO THAT DRAIN PORT IS LOCATED BELOW ATTIC INSULATION IN CEILING SPACE OF ROOM BELOW. FIELD VERIFY DEPTH OF BURY PRIOR TO ORDERING.	3/4"	-	-	-	-
<u>A</u>	EQUAL TO ZURN Z1700 WATER HAMMER ARRESTOR.	3/4"	_	-		_

- 1. FIXTURES SHALL BE PROVIDED WITH ALL ITEMS, ARTICLES, MATERIALS AND INCIDENTALS, AS REQUIRED, INCLUDING ALL LABOR NECESSARY FOR A COMPLETE PLUMBING INSTALLATION.
- 2. THE PLUMBING CONTRACTOR SHALL CLEAN ALL FIXTURES, POLISH ALL METAL PARTS, CHECK AND ADJUST ALL FITTINGS, FAUCETS AND VALVES. ALL OPERATING INSTRUCTIONS SHALL BE TURNED OVER TO THE GENERAL CONTRACTOR FOR PRESENTATION TO THE OWNER.
- 3. PROVIDE INDIVIDUAL STOPS ON ALL PLUMBING FIXTURES.
- 4. ALL LAVATORY, SINK, LAUNDRY TUB, WATER COOLER AND SIMILAR FIXTURE TRAPS, INCLUDING THOSE MOUNTED IN CASEWORK, SHALL BE CHROME PLATED, CAST BRASS, MINIMUM 17-GAUGE, ADJUSTABLE TYPE WITH CLEANOUT PLUG.
- 5. PROVIDE CHROME PLATED ANGLE STOPS WITH WHEEL HANDLES AT FIXTURE SUPPLY THROUGH WALLS, INCLUDING THOSE MOUNTED IN CASEWORK.
- 6. ALL EXPOSED SUPPLY PIPES, STOPS, FLEXIBLE RISERS, INCLUDING THOSE MOUNTED IN CASEWORK, SHALL HAVE A POLISHED CHROME PLATED FINISH AND BE OF THE SAME MANUFACTURER THROUGHOUT THE JOB.
- 7. ALL EXPOSED SUPPLY PIPES, STOPS, P-TRAP, AND ANY WASTE PIPE IN ADA ACCESSIBLE LOCATIONS SHALL HAVE ADA COMPLIANT UNDER-SINK PROTECTION.
- 8. PROVIDE CHROME PLATED ESCUTCHEONS AT ALL FIXTURE SUPPLY AND WASTE PIPE PENETRATIONS THROUGH WALLS, INCLUDING THOSE MOUNTED IN CASEWORK.
- 9. ALL WATER CLOSET FLUSHING MECHANISMS ON HANDICAP WATER CLOSETS SHALL BE INSTALLED ON THE "WIDE SIDE" OF EACH WATER CLOSET TO MAINTAIN ADA ACCESSIBILITY.
- 10. PROVIDE INLET CHECK STOPS ON ALL FIXTURES (I.E. MOP SINKS, KITCHEN PRE-RINSE SPRAY UNITS, SHOWER VALVES, SPA BATHING UNITS AND SIMILAR FIXTURE(S) SUSCEPTIBLE TO BACKFLOW/CROSS CONNECTION SITUATIONS.
- 11. PROVIDE CONCEALED FIXTURE CARRIERS AND SUPPORTS OF PROPER TYPE AND DESIGN TO SUIT JOB CONDITIONS. PROVIDE CARRIERS BY J.R. SMITH MFG. CO.; ZURN INDUSTRIES, INC.; JOSAM MFG. CO.; WADE DIVISION/TYLER PIPE.
- 12. PLUMBING FIXTURE COLORS SHALL BE SELECTED BY ARCHITECT/OWNER AT A LATER DATE FROM STANDARD FACTORY COLORS, UNLESS OTHERWISE NOTED TO BE DESIGNER COLOR IN SCHEDULE. 13. PLUMBING FIXTURES AND TRIM SPECIFIED IN THIS SCHEDULE ARE TO ESTABLISH A STANDARD LEVEL OF QUALITY. OTHER MANUFACTURERS MAY BE CONSIDERED EQUAL. SEE LISTINGS BELOW FOR SOME MANUFACTURERS CONSIDERED EQUALS. OTHER MANUFACTURERS NOT
- LISTED BELOW MAY ALSO BE CONSIDERED WITH WRITTEN APPROVALS OBTAINED FROM ARCHITECT AND/OR ENGINEER PRIOR TO TEN DAYS BEFORE BIDS ARE DUE. A. <u>VITREOUS CHINA PLUMBING FIXTURES:</u> AMERICAN STANDARD, SLOAN, KOHLER, PROFLO, ZURN
- B. MOP SINKS, LAUNDRY TUBS: FIAT, E.L. MUSTEE, PROFLO, STERN WILLIAMS
- C. <u>STAINLESS STEEL SINKS:</u> ELKAY, DAYTON, JUST, PROFLO
- D. FAUCETS, SHOWER VALVES AND TRIM, FLUSH VALVES: AMERICAN STANDARD, KOHLER, SLOAN, ELKAY, MOEN, T&S BRASS, DELTA, CHICAGO, PROFLO
- E. SHOWER AND TUBS: COMFORT DESIGNS, BEST BATH, AQUA BATH, AQUARIUS, AMERICAN STANDARD, KOHLER, AQUATIC (LASCO)
- 14. PROVIDE SHOP DRAWING/SUBMITTAL AND OPERATIONS MANUAL FOR ALL ITEMS LISTED ABOVE IN PLUMBING FIXTURE SCHEDULE.
- 15. MINIMUM SIZES IN SCHEDULE ABOVE REPRESENT MINIMUM PLUMBING FIXTURE CONNECTIONS ALLOWED AND DOES NOT REFLECT SPECIAL SITUATIONS SUCH AS WET VENTING, WASTE STACK VENTS, COMBINATION WASTE AND VENT SYSTEMS, ETC. REFER TO PLANS AND/OR RISER DIAGRAMS FOR PIPE SIZES AND ADDITIONAL INFORMATION.

## PLUMBING DRAINS/CLEANOUT SCHEDULE

PROVIDE SHOP DRAWING/SUBMITTAL AND OPERATIONS MANUAL FOR ALL ITEMS LISTED BELOW.

CLEANOUTS: CLEANOUTS SHALL BE LINE SIZE UP TO 4". FOR PIPE SIZES LARGER THAN 4" PROVIDE A 4" CLEANOUT, WHERE ALLOWED BY CODE AND AUTHORITY HAVING JURISDICTION. ALL EXTERIOR AND INLINE CLEANOUTS SHALL BE TWO-WAY. EXPOSED HORIZONTAL OR VERTICAL CLEANOUT IN PIPING EXPOSED OR CONCEALED ABOVE ACCESSIBLE CEILINGS. (REFER TO ARCHITECTURAL DRAWINGS FOR FLOOR FINISH INFORMATION. PROVIDE CLEANOUTS AS DESCRIBED BELOW.)

5. IN AREAS SUBJECT TO TRAFFIC (I.E. PARKING GARAGES, PARKING SPACES AND SIMILAR SPACES) PROVIDE HEAVY

WHERE SHEET VINYL FLOORING SIMILAR TO ALTRO, PROTECTALL AND ETC. IS INSTALLED, PROVIDE WATTS MODEL CO-200-RFC7 FLOOR CLEANOUT WITH SURFACE MEMBRANE CLAMP. FOR AREAS WHERE CARPET WILL BE INSTALLED PROVIDE ROUND ADJUSTABLE CLEANOUT WITH CARPET MARKER. 3. BACK OF HOUSE AREAS (I.E. KITCHEN, UTILITY ROOMS, LAUNDRY ROOMS AND SIMILAR SPACES) WHERE TILE FLOORS ARE TO BE INSTALLED, PROVIDE SQUARE ADJUSTABLE CLEANOUT WITH STAINLESS STEEL COVER. 4. IN PUBLIC AREAS (I.E. DINING ROOMS, CORRIDORS, OFFICES, CONFERENCE ROOMS AND SIMILAR SPACES) WHERE TILE FLOORS ARE TO BE INSTALLED, PROVIDE SQUARE ADJUSTABLE CLEANOUT WITH RECESS TILE COVER.

DUTY/TRAFFIC RATED CLEANOUT COVER. CLEANOUT TO GRADE WITH HEAVY DUTY ACCESS COVER CAST IN A 12" X 12" X 4" THICK CONCRETE PAD. (PAD MAY BE ELIMINATED IN POURED CONCRETE SIDEWALKS, DRIVEWAYS, PATIOS, ETC.)

PROVIDE CLEANOUT IN VERTICAL PIPE WITH STAINLESS STEEL ACCESS COVER. (WHERE PIPES ARE CONCEALED IN WALLS

ROOF/OVERFLOW DRAINS: ACCEPTABLE MANUFACTURERS: ZURN, WATTS, JOSAM, JAY R. SMITH, FROET INDUSTRIES. ROOF DRAIN - EQUAL TO ZURN 100. DRAIN SHALL HAVE DURA-COATED CAST IRON BODY WITH POLY-DOME, COMBINATION MEMBRANE FLASHING CLAMP/GRAVEL GUARDS, SUMP RECEIVER, UNDERDECK CLAMPING DEVICE, EXTENSION COLLAR TO SUIT THICKNESS OF INSULATION. OVERFLOW DRAIN - EQUAL TO ZURN Z100-W2. DRAIN SHALL HAVE DURA-COATED CAST IRON BODY WITH POLY-DOME.

INTERNAL OVERFLOW WATER DAM, COMBINATION MEMBRANE FLASHING CLAMP/GRAVEL GUARDS, SUMP, RECEIVER, UNDERDECK CLAMPING DEVICE, EXTENSION COLLAR TO SUIT THICKNESS OF INSULATION. OVERFLOW DISCHARGE SPOUT - EQUAL TO FROET INDUSTRIES MODEL LPS, OVERFLOW DISCHARGE SPOUT, STAINLESS STEEL FRAME WITH STAINLESS STEEL HINGED STRAINER. (GENERAL PURPOSE, BACK OF HOUSE, CONCRETE FLOORS) - FLOOR DRAIN EQUAL TO ZURN ZN415B. DURA-COATED CAST IRON BODY WITH INVERTIBLE MEMBRANE CLAMP AND ADJUSTABLE COLLAR WITH SEEPAGE SLOTS. TYPE "B" ROUND

SLOTS. TYPE "B" ROUND NICKEL BRONZE STRAINER; 5" STRAINER FOR 2" OUTLET, 6" STRAINER FOR 3" OUTLET AND 8" STRAINER FOR 4" OUTLET. (TILE FLOORS, CONCRETE FLOORS) - FLOOR SINK - EQUAL TO ZURN ZN1900. 4" BOTTOM OUTLET, CAST-IRON BODY, ANTI-SPLASH INTERIOR AND SEDIMENT BUCKET, NICKEL BRONZE 1/2 GRATE, 12" SQUARE BY 6" DEEP. Type of the second of the seco

**EQUIPMENT SCHEDULE** 

SPECIFICATIONS FOR ALL ITEMS LISTED IN THIS SCHEDULE.

WATER LEVEL PROBE AND CONTROL PANEL.

ASSEMBLY, BALL VALVES, AND WYE STRAINER ON INLET SIDE OF VALVE.

PROVIDE SHOP DRAWING/SUBMITTAL AND OPERATIONS MANUAL FOR ALL ITEMS LISTED BELOW. PROVIDE EQUIPMENT TAGS PER

WATER HEATER - EQUAL TO A.O. SMITH MODEL NO. BTH-250 NATURAL GAS FIRED ASME WATER HEATER WITH GLASS

RECOVERY CAPACITY OF 327 GPH AT 88°F TEMPERATURE RISE. 250 CFH INPUT RATING; 120V ELECTRICAL

THERMAL EXPANSION COMPENSATOR - EQUAL TO AMTROL ST-25V-C, ASME RATED, 10.3 GALLON CAPACITY.

THERMOSTATIC MIXING VALVE - EQUAL TO LEONARD VALVE "NUCLEUS" MODEL NV-200-LF, 115 GPM AT 10 PSIG

PRESSURE LOSS, 200 PSIG MAXIMUM OPERATING PRESSURE, TEMPERATURE OUTLET RANGE OF 65°F v 186°F v 1111 PRESSURE LOSS, 200 PSIG MAXIMUM OPERATING PRESSURE, TEMPERATURE OUTLET RANGE OF 65°F v 186°F v 1111 PRESSURE LOSS, 200 PSIG MAXIMUM OPERATING PRESSURE, TEMPERATURE OUTLET RANGE OF 65°F v 186°F v 1111 PRESSURE LOSS, 200 PSIG MAXIMUM OPERATING PRESSURE, TEMPERATURE OUTLET RANGE OF 65°F v 186°F v 1111 PRESSURE LOSS, 200 PSIG MAXIMUM OPERATING PRESSURE, TEMPERATURE OUTLET RANGE OF 65°F v 186°F v ABILITY TO CONTROL TEMPERATURE +1-2°F OF SETPOINT, PROVIDE WALL MOUNTING BRACKET. 120V ELECTRICAL

ELEVATOR SUMP PUMP - EQUAL TO STANCOR SE-50 ELEVATOR SUMP PUMP, 1/2 HP, 120V, 1 PHASE. PROVIDE WITH

HOT WATER RECIRCULATION FUMP - EQUAL TO BELL AND GOSSETT ECOCIRC MODEL 55-45, VARIABLE SPEED WITH

BACKFLOW PREVENTER - EQUAL TO ZURN MODEL NO. 975XL3 WITH 2" CONNECTIONS. PROVIDE WITH AIR GAP

CAPACITY OF 25 GPM @ 25 FT/HEAD, 1/2 HP, 208V, 1 PHASE, STAINLESS STEEL CONSTRUCTION.

TANK LINING AND CONDENSATE NEUTRILIZING KIT. HEATER TO HAVE 100 GALLON NOMINAL STORAGE CAPACITY WITH

NICKEL BRONZE STRAINER; 5" STRAINER FOR 2" OUTLET, 6" STRAINER FOR 3" OUTLET AND 8" STRAINER FOR 4" SEEPAGE

### PLUMBING SYMBOLS AND ABBREVIATIONS LEGEND

AIR ADMITTANCE VALVE

ABOVE FINISHED FLOOR ABOVE FINISHED GRADE AUTHORITY HAVING JURISDICTION

BACKFLOW PREVENTER

CUBIC FEET PER HOUR

CIRCULATION PUMP

BRITISH THERMAL UNIT/HOUR

DRAINAGE, WASTE AND VENT

BOOSTER PUMP

CEILING

CLEANOUT

COLD WATER

DECK DRAIN

EXPANSION TANK

DOWN

EXISTING

FLOOR

GALLON

FAHRENHEIT

FIXTURE UNIT

GRADE CLEANOUT

GALLONS PER DAY GALLONS PER HOUR

**GALLONS PER MINUT** 

**GREASE WASTE** 

HOSE BIBB

HORSEPOWER

HOT WATER HOT WATER RETURN

INVERT ELEVATION

NORMALLY CLOSED NORMALLY OPEN

OVERFLOW DRAIN

PARKING DRAIN

ROUTE ABOVE CEILING ROUTE BELOW FLOOR ROOF DRAIN

SEWAGE EJECTOR PUMP

THERMOSTATIC MIXING VALVE

STORM DRAIN

SQUARE FEET SHOWER

SANITARY SEWER STAINLESS STEEL

TRENCH DRAIN

TRAP PRIMER

VENT THRU ROOF

WATER

PRESSURE REDUCING VALVE POUNDS PER SQUARE INCH POLYVINYL CHLORIDE

HEAD

HEATER

KILOWATT

LAVATORY

MINIMUM

FLOOR CLEANOUT FLOOR DRAIN

FINISHED FLOOR ELEVATION

AREA DRAIN

DIRECTION OF FLOW	
PIPE TURNING UP	
PIPE TURNING DOWN	
BRANCH CONNECTION - TOP	
BRANCH CONNECTION - BOTTOM	<del></del>
BRANCH CONNECTION - SIDE	
SERVICE VALVE (BALL OR GATE)	$\longrightarrow$
SERVICE VALVE (BUTTERFLY)	— ø —
CHECK VALVE	—N—
DI-ELECTRIC UNION	——II——
PIPE CAP OR BLIND FLANGE	— — — — — — — — — — — — — — — — — — —
OUTLETS/FIXTURE STOPS (GAS, AIR, VACUUM, OXYGEN)	
PRESSURE REDUCING VALVE	——————————————————————————————————————
FLEXIBLE PIPE CONNECTION OR JOINT	
HOSE BIBB OR FREEZEPROOF WALL HYDRANT	——————————————————————————————————————
GAS SHUT-OFF VALVE	——————————————————————————————————————
GAS SOLENOID VALVE	——————————————————————————————————————
CONNECT NEW TO EXISTING	•
POINT OF DISCONNECTION	$\Theta$
COLD WATER PIPING	
HOT WATER SUPPLY (NUMBER DENOTES TEMPERATURE; NO NUMBER INDICATES 120°F TEMPERATURE SYSTEM)	140
HOT WATER RETURN (NUMBER DENOTES TEMPERATURE; NO NUMBER INDICATES 120°F TEMPERATURE SYSTEM)	
SANITARY SEWER PIPING	
VENT PIPING	=====
ROOF DRAIN STORM PIPING	RD
OVERFLOW DRAIN STORM PIPING	OD
GREASE WASTE PIPING	GW
NATURAL GAS PIPING	G
PIPE REFERENCE	G - GAS D - DWV W - WATER S- STORM  RISER NUMBER

WASTE WATER COLUMN WALL CLEANOUT WALL HYDRANT WHA WATER HAMMER ARRESTOR

WTR


## GENERAL PLUMBING NOTES

1. THE PLUMBING CONTRACTOR SHALL DETERMINE NECESSARY INVERT ELEVATIONS FOR PROPER DRAINAGE AND CONNECTION INTO SEWERS. ALL INVERT ELEVATIONS SHALL BE SET PRIOR TO INSTALLATION.

THESE SYMBOLS AND ABBREVIATIONS ARE PLUMBING DEPARTMENT STANDARDS AND MAY NOT NECESSARILY BE APPLICABLE TO, OR APPEAR ON THESE DRAWINGS. HOWEVER,

WHERE THESE SYMBOLS DO OCCUR ON THE DRAWINGS, THE ITEM SHALL BE PROVIDED AND INSTALLED. SEE ARCHITECTURAL DRAWINGS FOR ADDITIONAL ABBREVIATIONS.

- 2. ALL PIPING PASSING THROUGH FIRE RATED OR FIRE AND SMOKE RATED ASSEMBLIES SHALL BE SLEEVED AND FIRESTOPPED. FIRESTOPPING SHALL COMPLY WITH U.L. LISTING AND REQUIREMENTS FOR ASSEMBLY TYPE BEING PENETRATED.
- 3. PLUMBING CONTRACTOR SHALL NOT CORE DRILL OR DISTURB ANY STRUCTURAL MEMBERS WITHOUT WRITTEN AUTHORIZATION BY THE
- ARCHITECT AND/OR STRUCTURAL ENGINEER. 4. PLUMBING CONTRACTOR SHALL COORDINATE PIPING LOCATIONS AND ROUTING WITH OTHER PIPING DUCTWORK AND ELECTRICAL CONDUIT INSTALLATIONS. PLUMBING CONTRACTOR SHALL REVIEW ARCHITECTURAL DRAWINGS TO ESTABLISH WHERE FURR-DOWNS AND SOFFITS OCCUR AND DIMENSIONS OF SAME SO THAT DISTANCES AND PIPING ROUTING CAN BE PROPERLY COORDINATED. ALL PIPING SHALL BE ROUTED
- 5. PLUMBING CONTRACTOR SHALL AVOID LOCATING HW/CW PIPING IN LOCATIONS WHERE POSSIBILITY OF FREEZING OF SAME EXISTS. CONTRACTOR SHALL ADVISE ENGINEER WHERE THIS CONDITION MAY OCCUR PRIOR TO ROUGH-IN.
- 6. ALL ADA ACCESSIBLE LAVATORIES AND SINKS WITH EXPOSED WATER AND DRAIN PIPES SHALL BE INSULATED TO PROTECT AGAINST CONTACT
- PER ADA REQUIREMENTS. THERE SHALL BE NO SHARP OR ABRASIVE SURFACES. 7. ALL PLUMBING WORK SHALL BE INSTALLED IN COMPLIANCE WITH ALL STATE AND LOCAL CODES.
- 8. COORDINATE ROUTING OF ALL PIPING WITH THE ELECTRICAL CONTRACTOR SO AS NOT TO ROUTE ANY PLUMBING LINES OVER ELECTRICAL
- 9. REFER TO SPECIFICATION SECTION 231123 FACILTY NATURAL-GAS PIPING FOR GAS PIPING AND INSTALLATION INFORMATION.
- 10. ACCESS DOORS TO VALVES, CLEANOUTS AND ETC. TO BE EQUAL TO "ACUDOR" DW OR FW SERIES, ACCESS DOORS FOR DRYWALL INSERTS. PROVIDE FIRE RATED ACCESS DOORS WHERE REQUIRED. COORDINATE WITH GENERAL CONTRACTOR AND VERIFY EXACT LOCATIONS AND SIZES ON SITE. PAINT TO MATCH CEILING OR WALL.
- 11. PLASTIC PIPING SHALL NOT BE INSTALLED IN ANY SPACE THAT IS A RETURN AIR PLENUM. COORDINATE WITH MECHANICAL CONTRACTOR FOR PLENUM LOCATIONS PRIOR TO INSTALLATION OF ANY PIPING. ONLY PLASTIC PIPING THAT IS APPROVED FOR PLENUM SPACES AND IS APPROVED BY THE LOCAL AUTHORITY HAVING JURISDICTION MAY BE INSTALLED IN RETURN AIR PLENUMS.
- 12. PIPING AND EQUIPMENT HANGERS SHALL BE SPACED IN A SYSTEMATIC RANDOM PATTERN AS REQUIRED TO ELIMINATE OVERLOADING INDIVIDUAL STRUCTURAL MEMBERS. THE ESTIMATED WEIGHT ASSIGNED TO PIPE AND EQUIPMENT HANGERS SHALL BE DETERMINED BY THE PLUMBING CONTRACTOR AND SUBMITTED TO THE GENERAL CONTRACTOR FOR REVIEW, COORDINATION AND APPROVAL PRIOR TO INSTALLATION. THIS REQUIREMENT APPLIES TO ALL PLUMBING PIPING.

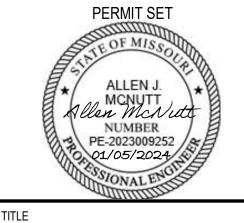

PROJECT TITLE





Charlotte, North Carolina 28203.4633 704.372.7327 • Fax 704.372.7369 www.sfcs.com


DESIGNER :	DAS	DRAWN :	RCK
ARCHITECT :	DAS	CHECKED :	DPW/MAH
ENGINEER :	AJM	APPROVED:	AJM
NO.	REVISION D	ESCRIPTION	DATE
2	Rev 1 - Permit	Comments	02/15/24

PLUMBING - LEGENDS, ABBREVIATIONS AND SCHEDULES

Autodesk Docs://23104.00 - John Knox Village - Lindbergh/23104.00-JKV-Courtyards-Building E-Plumbing CENTRAL.rvt

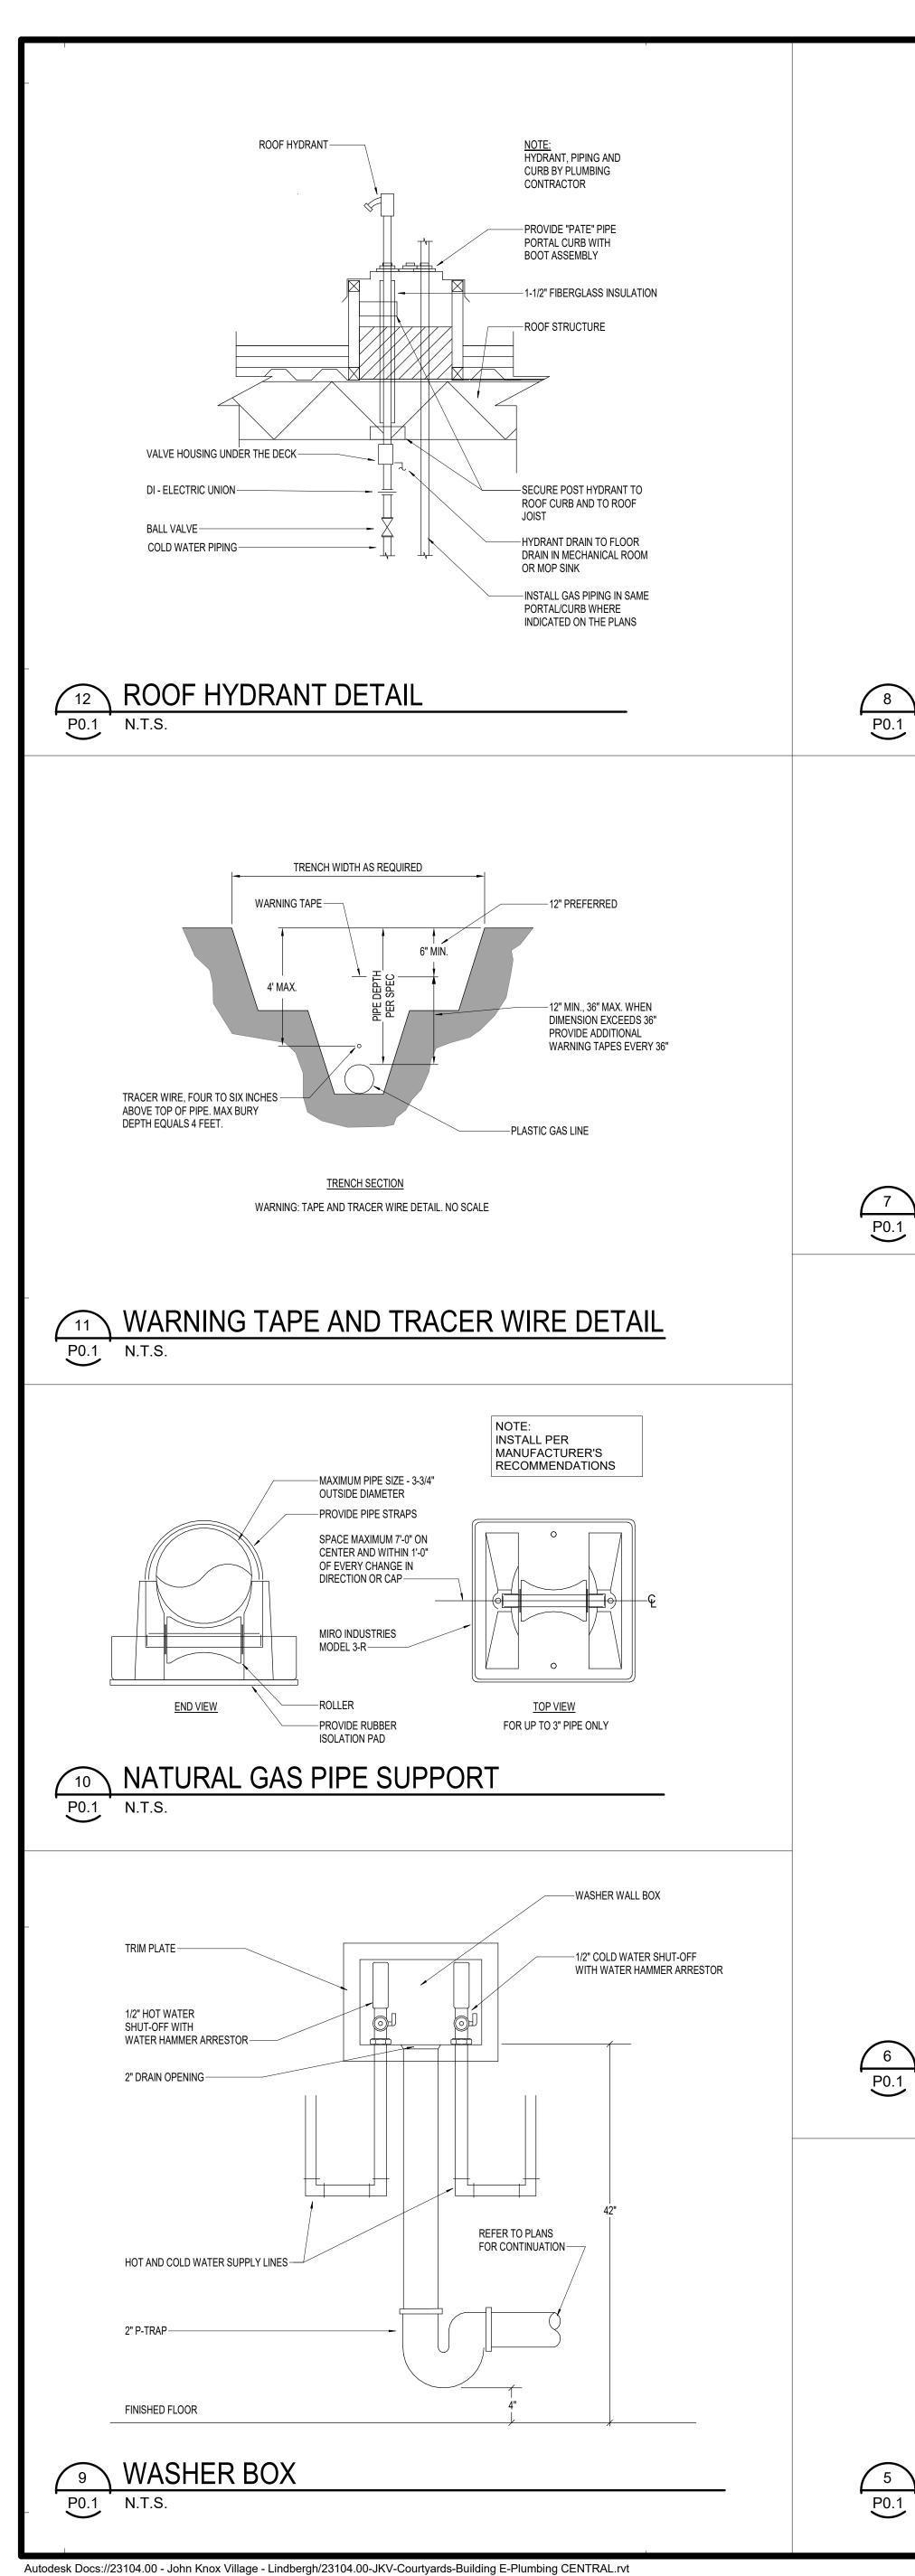

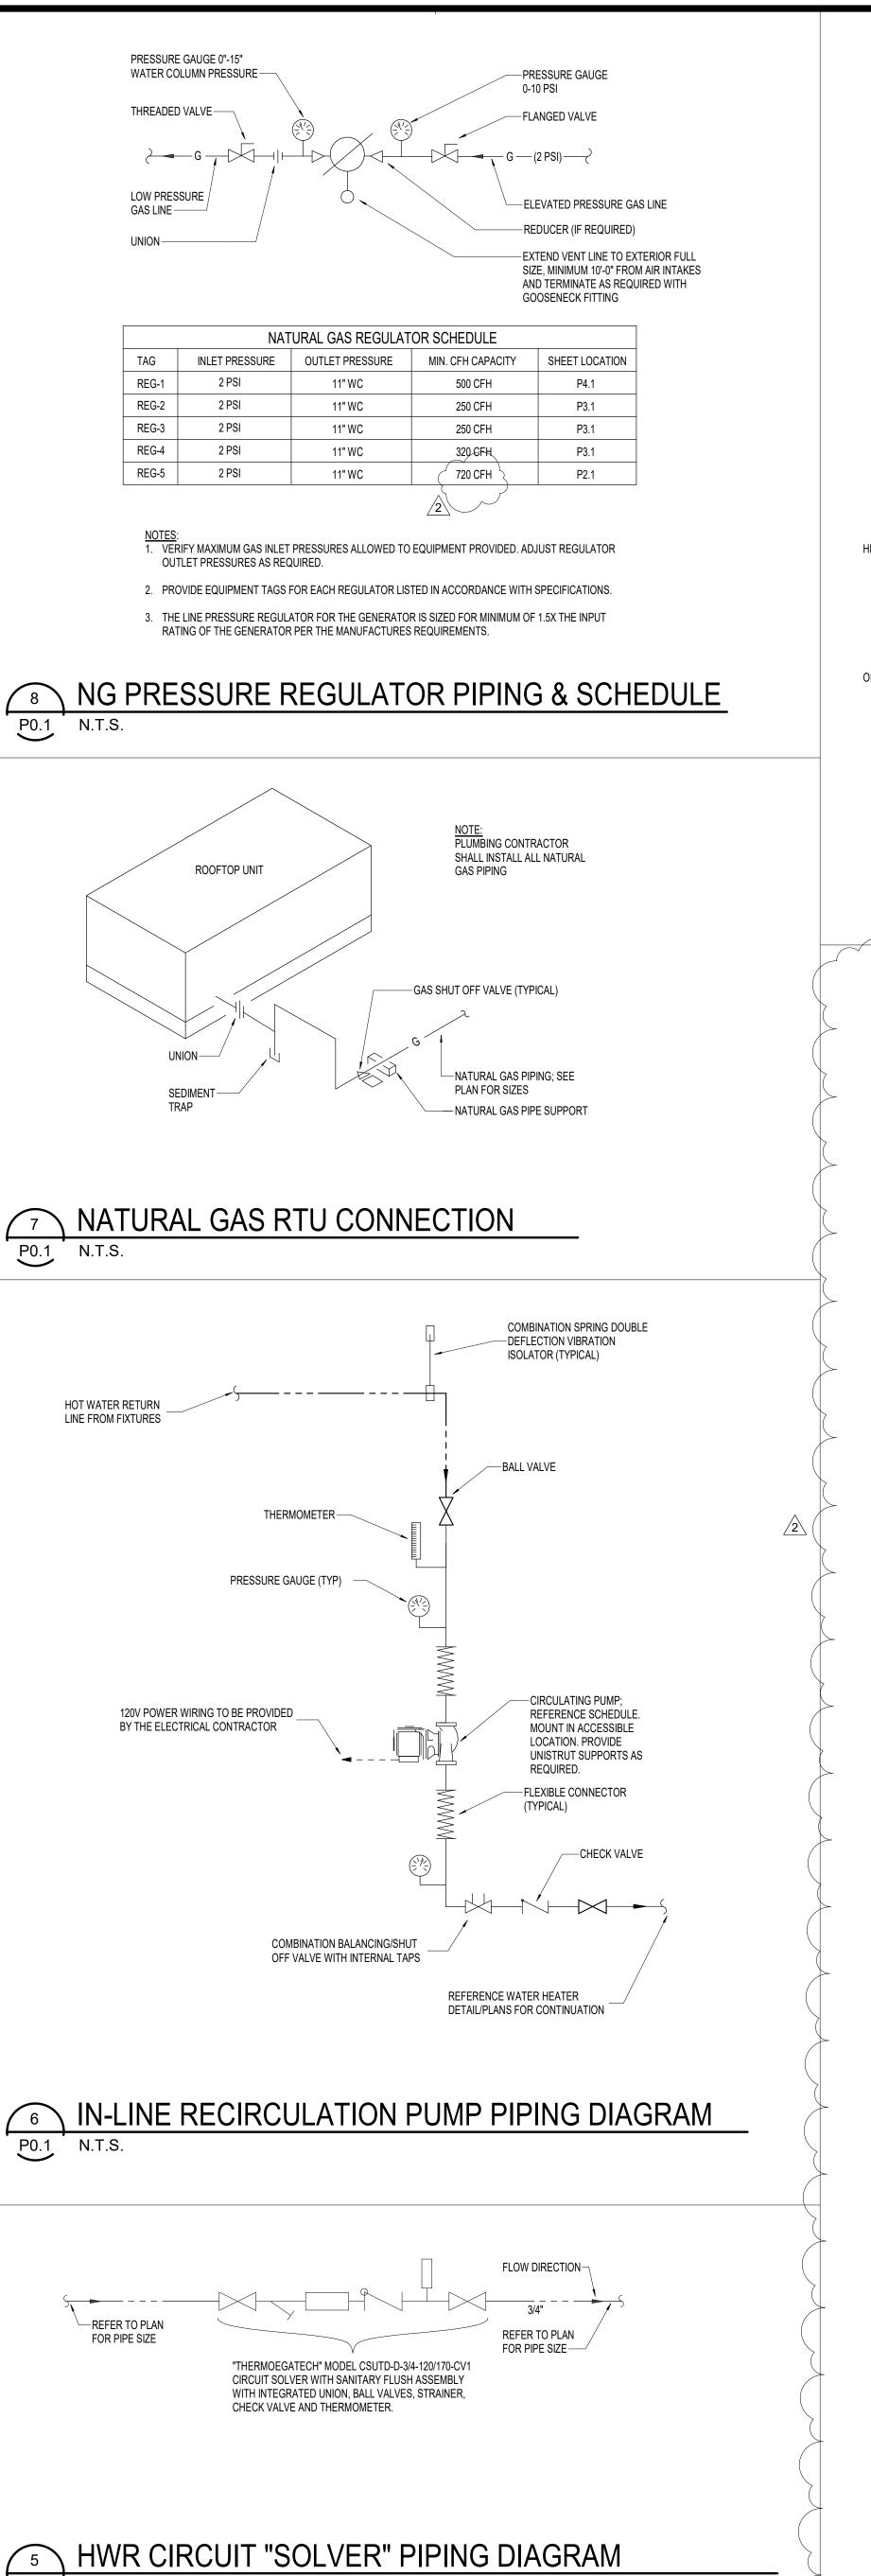


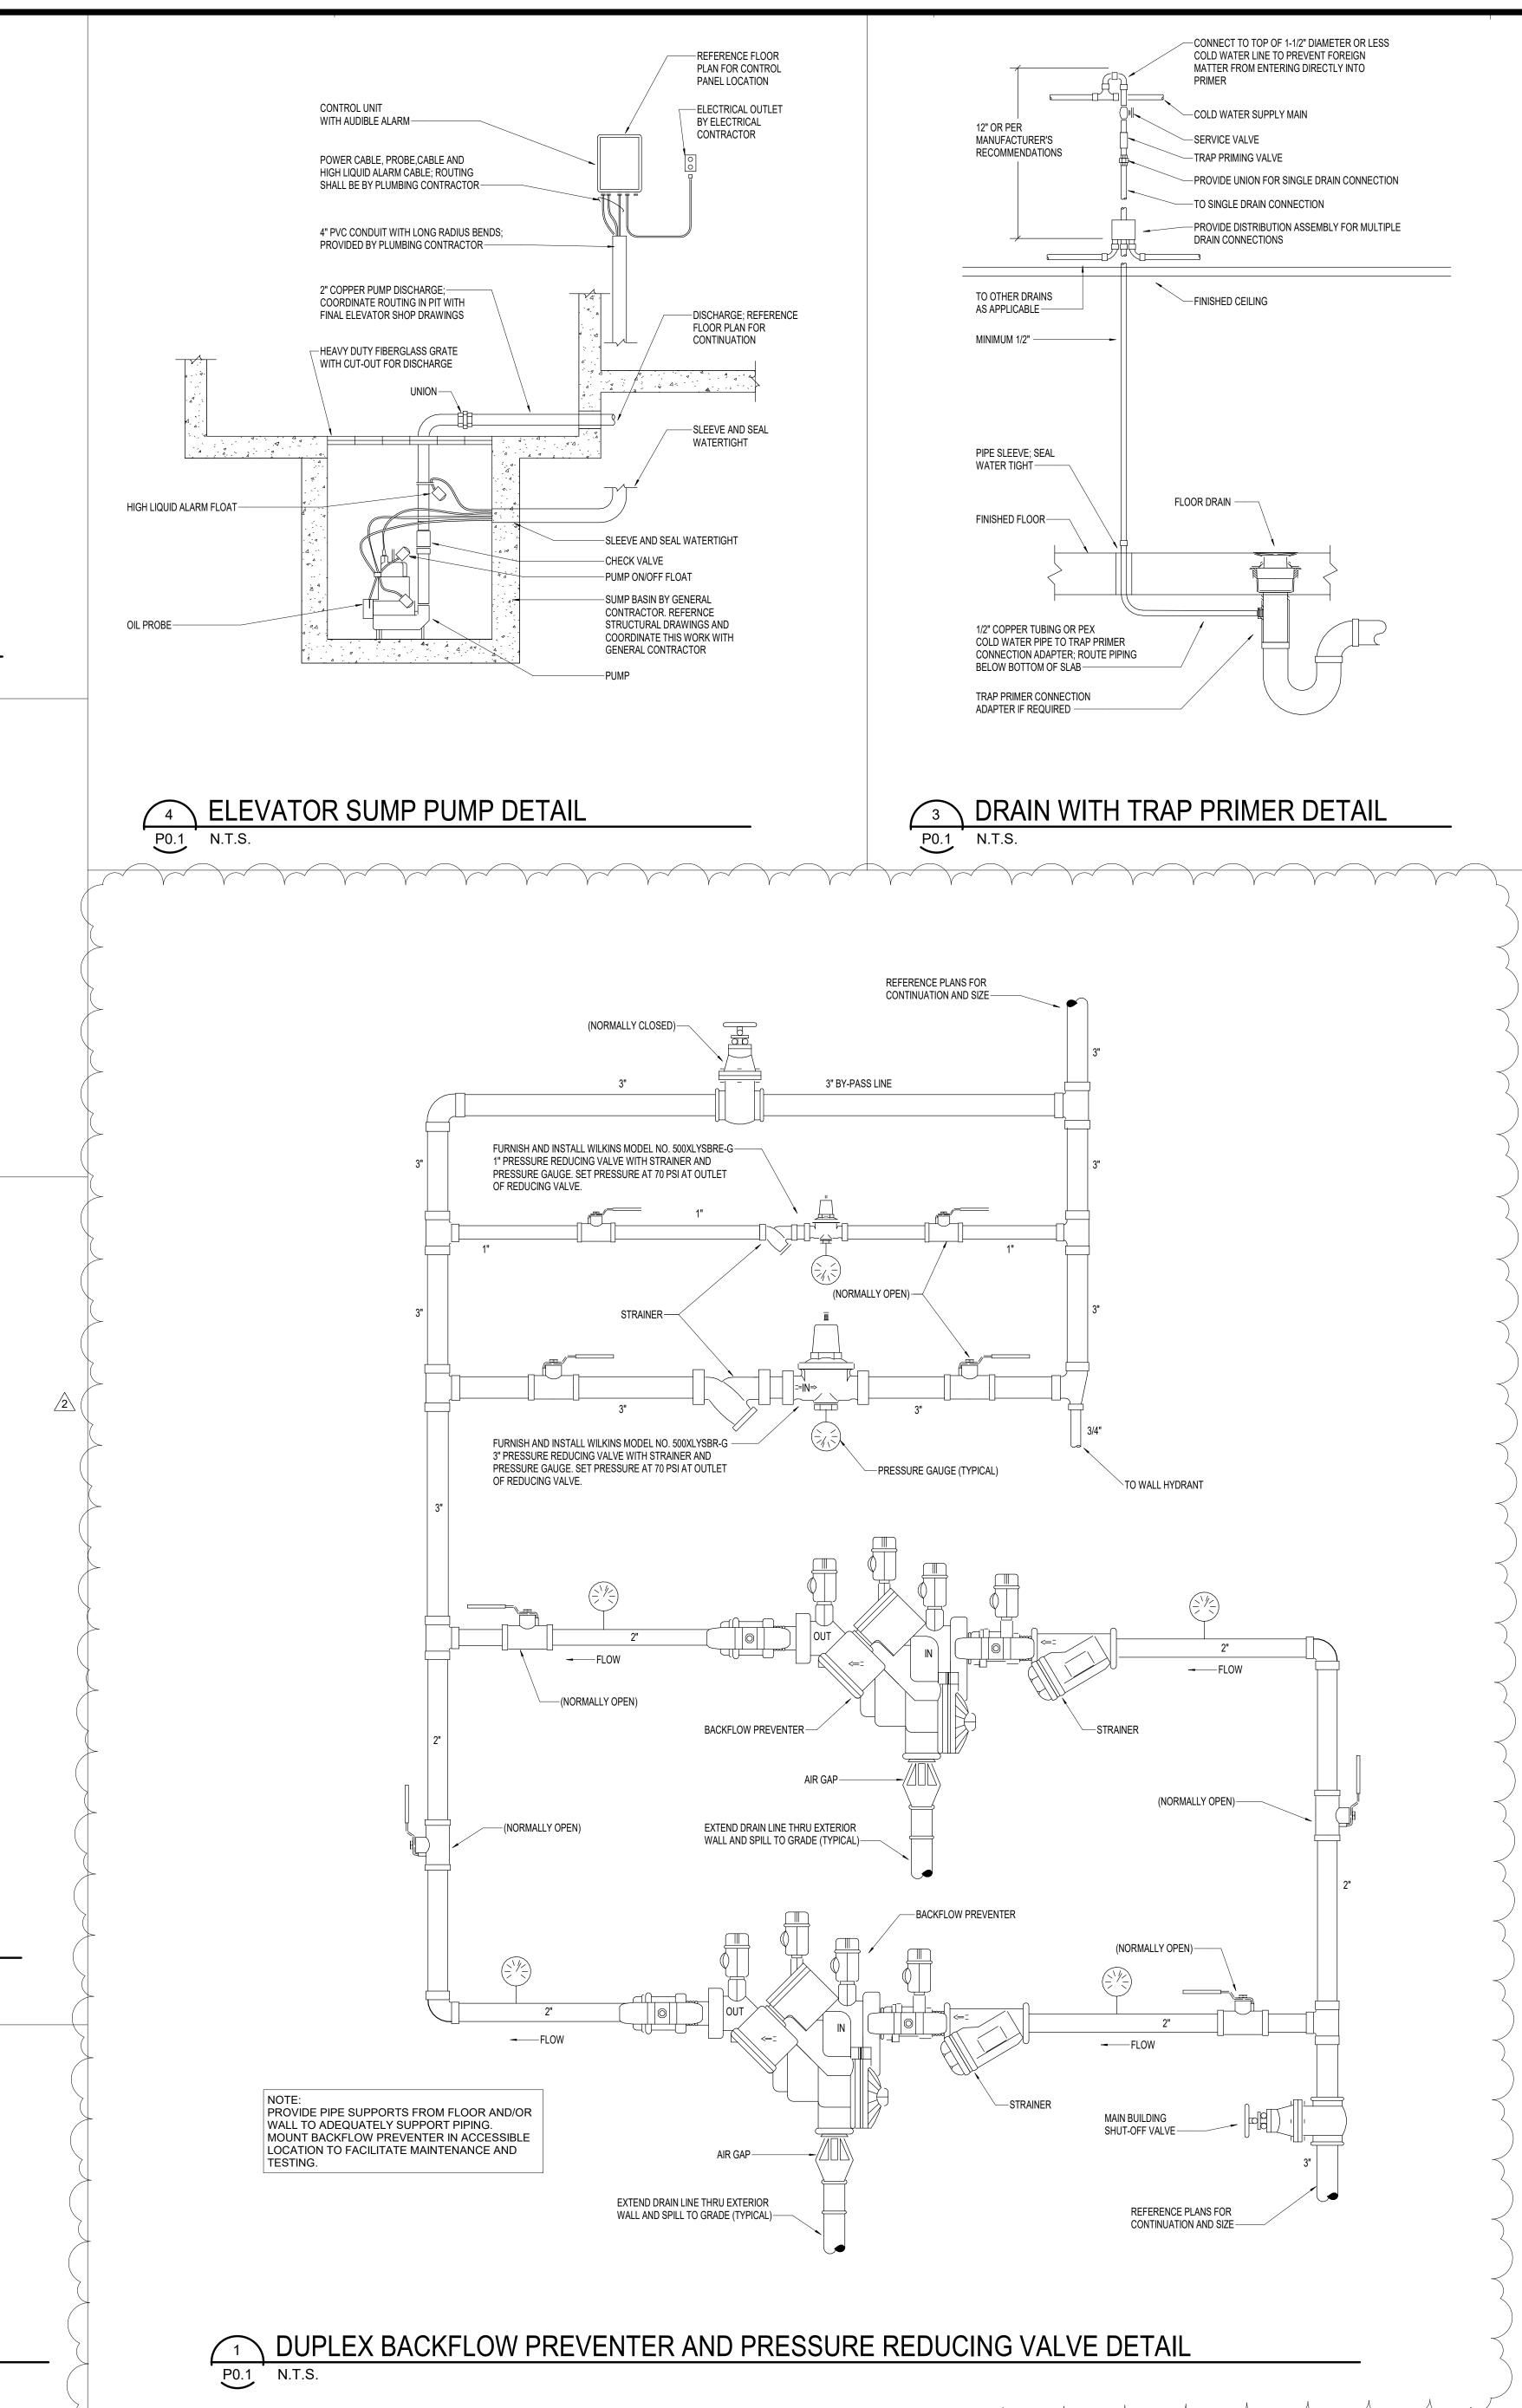




DETAILS - PLUMBING

9:52:03 AM

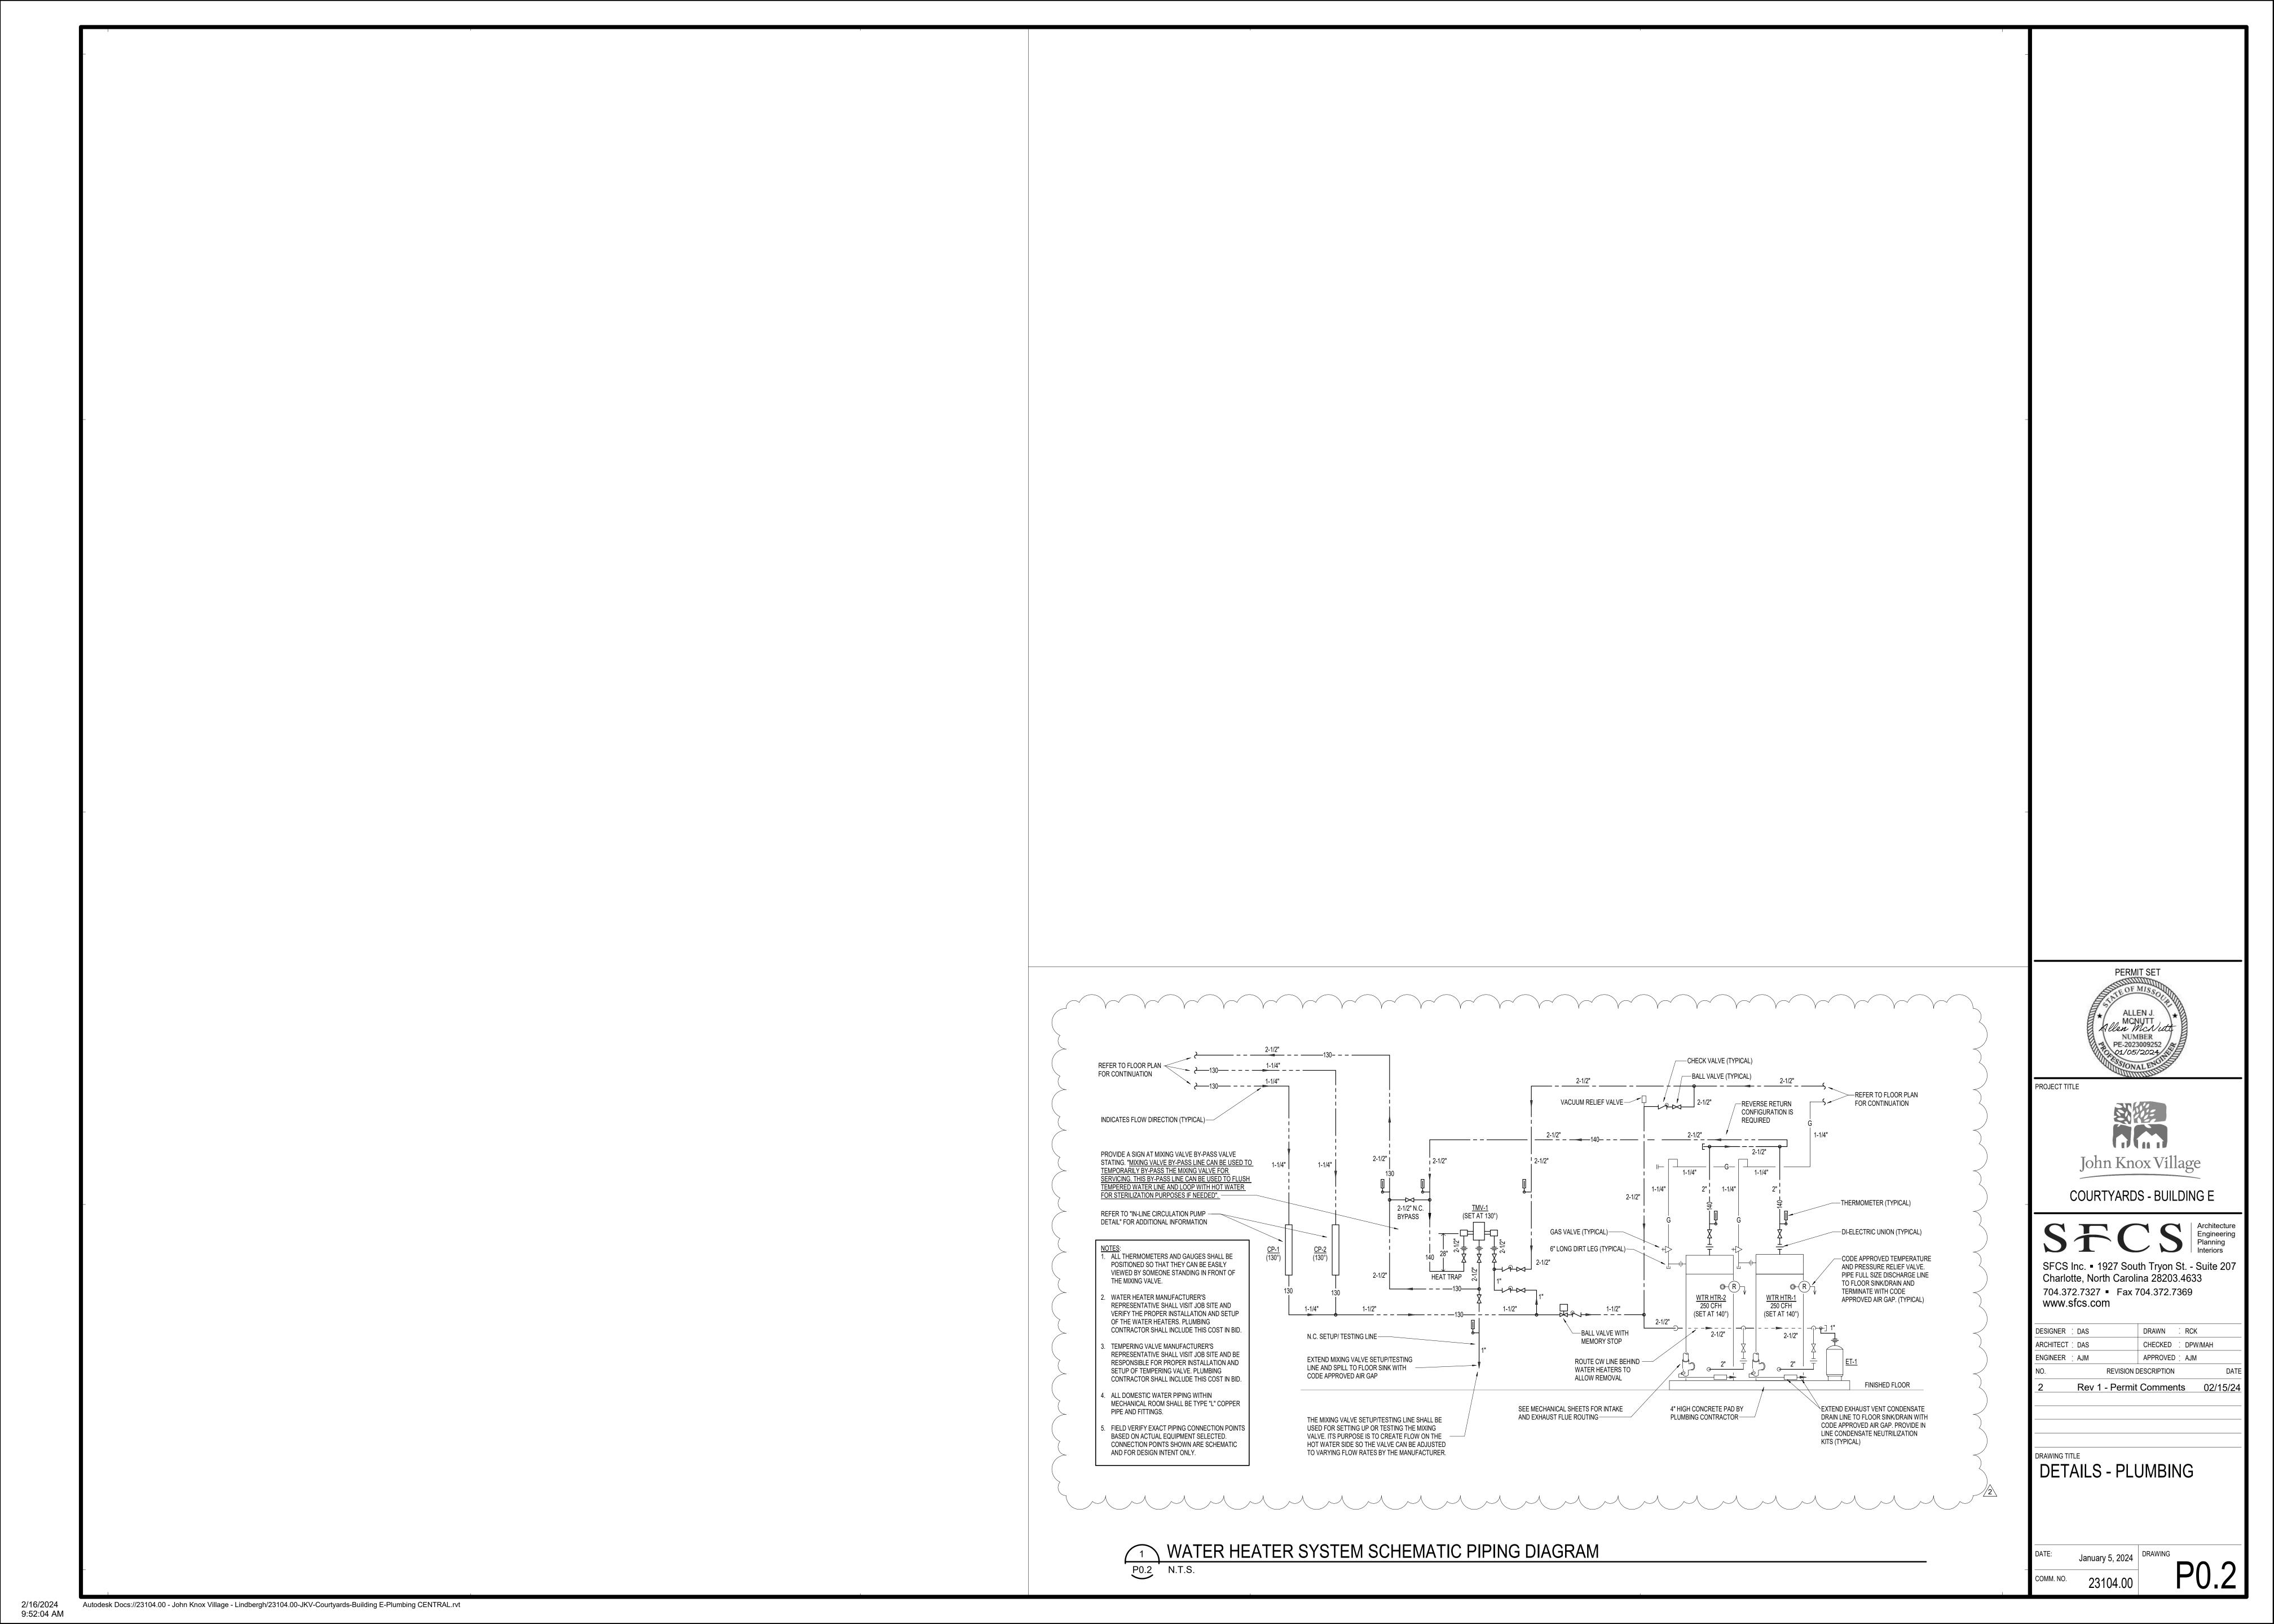

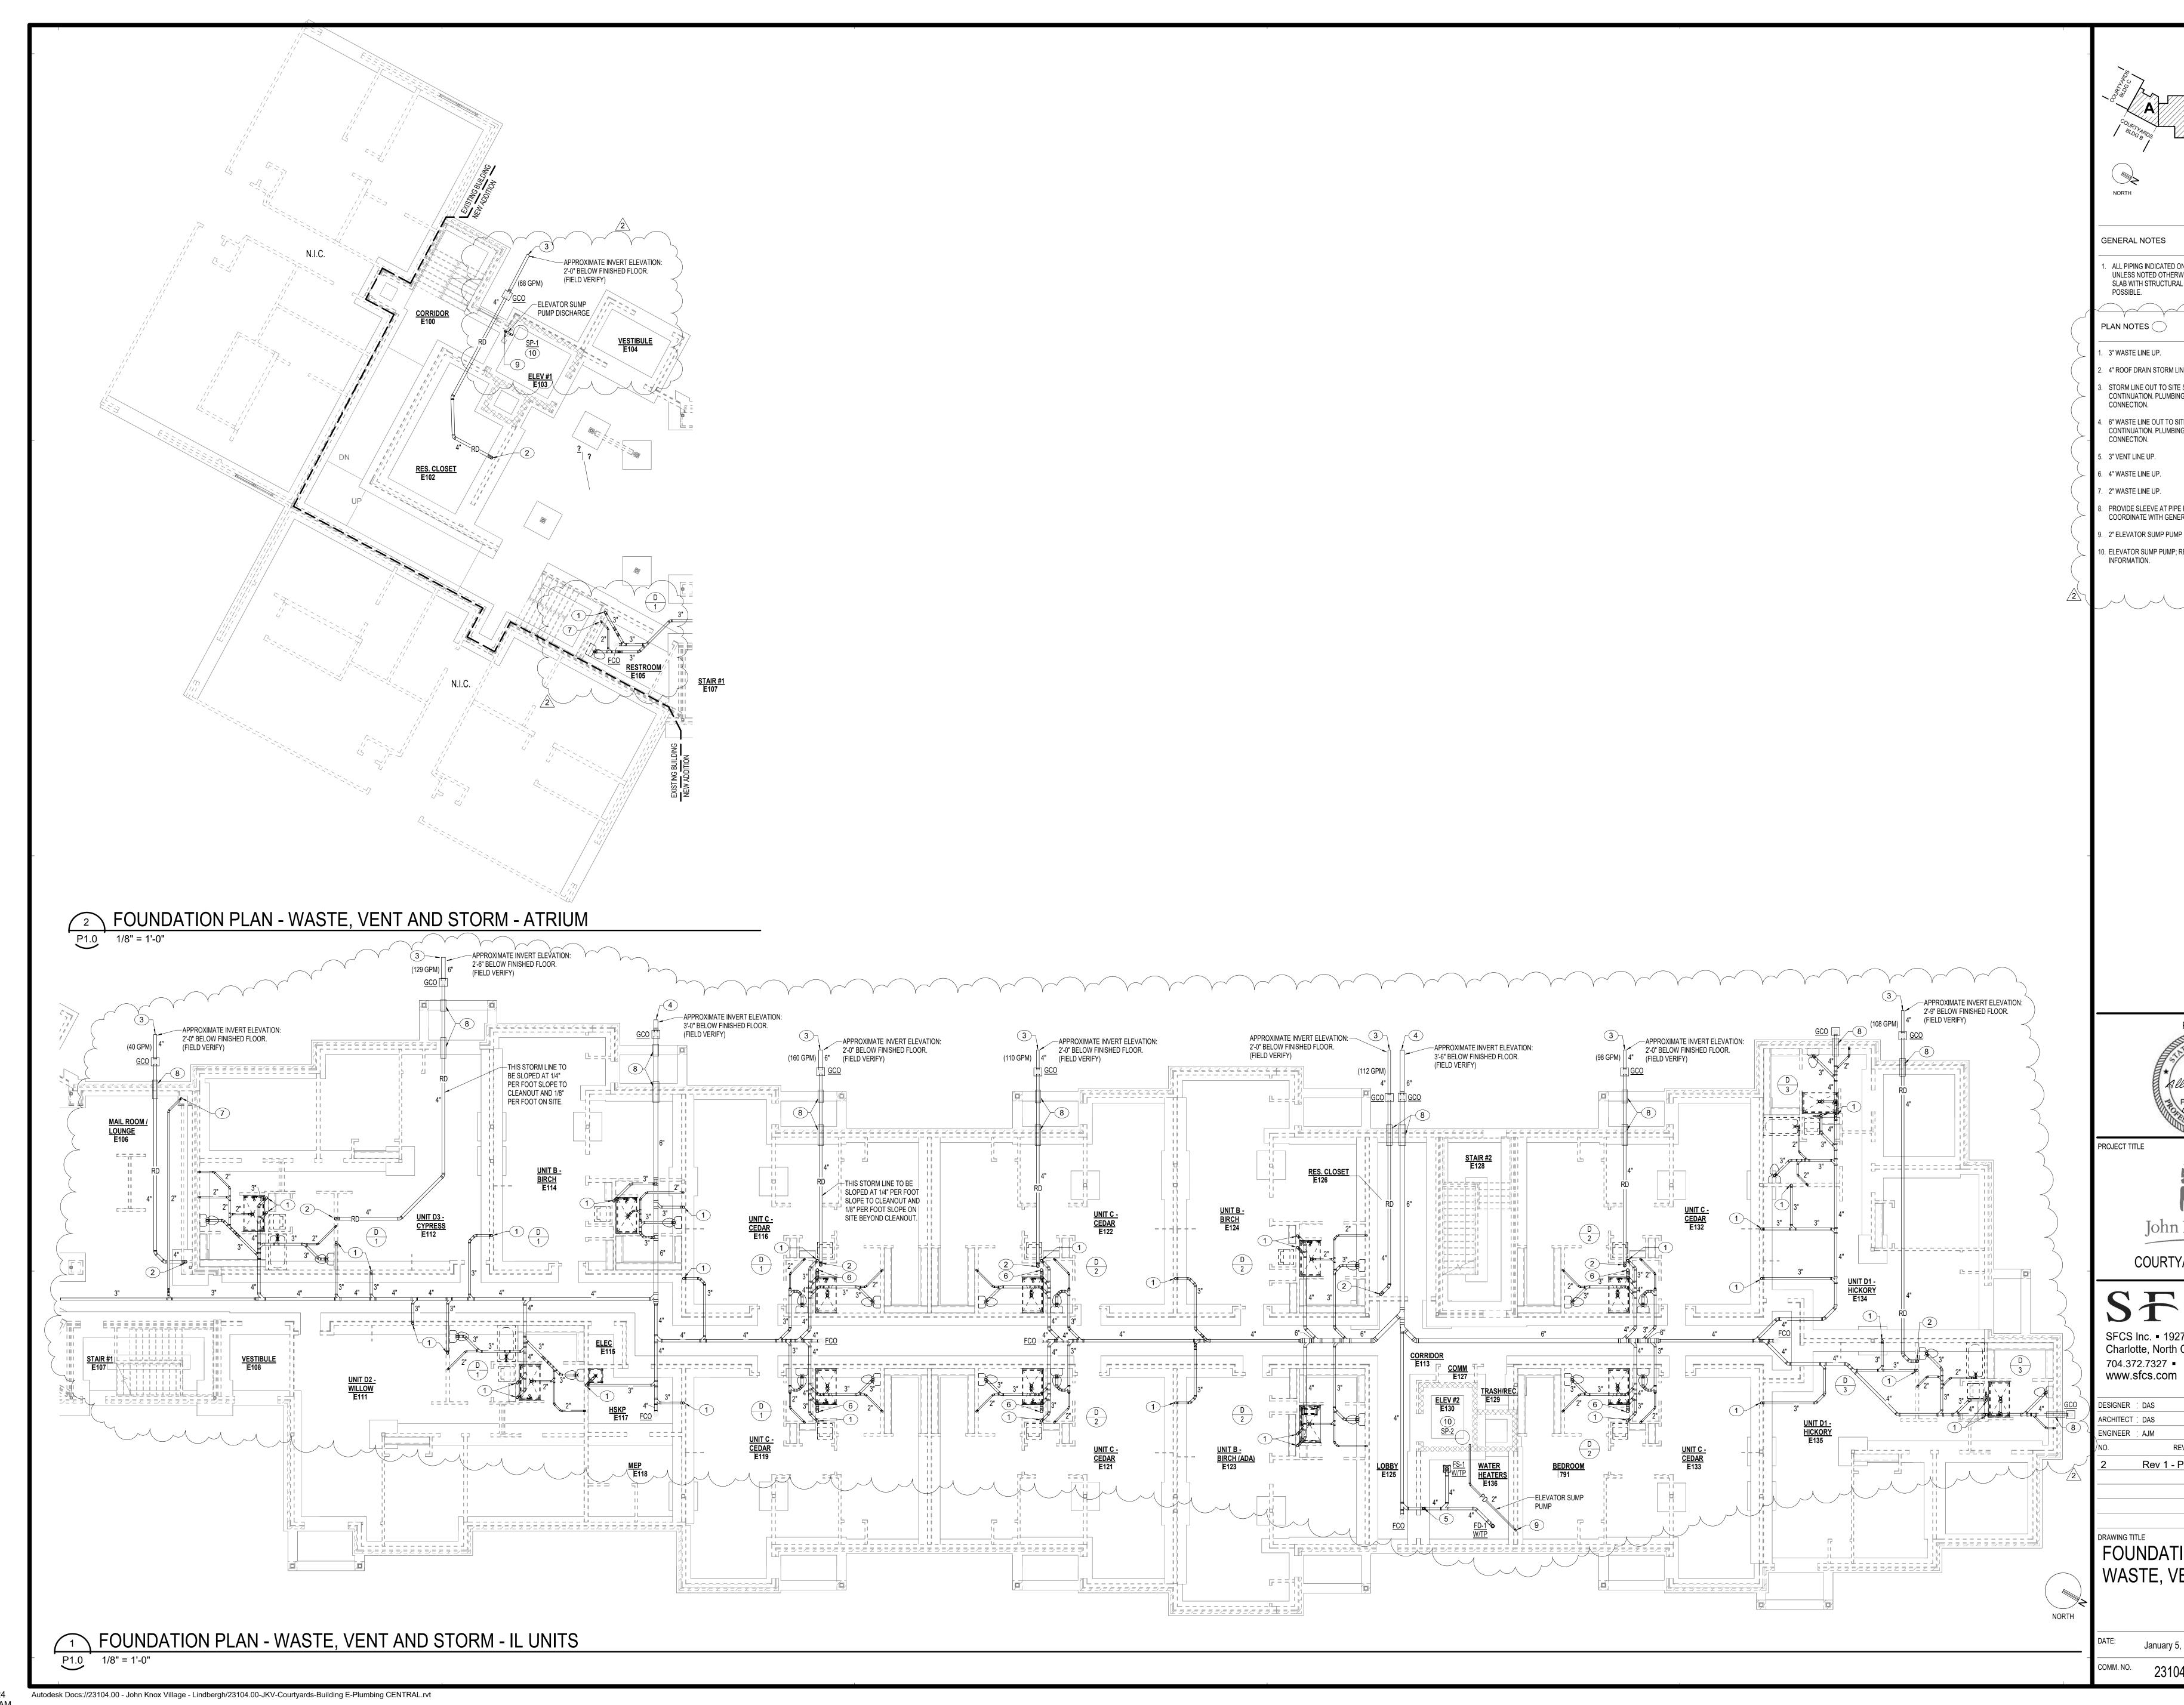

ALL PIPING INDICATED ON THIS SHEET IS TO BE ROUTED BELOW SLAB, UNLESS NOTED OTHERWISE. COORDINATE ROUTING OF PIPING BELOW SLAB WITH STRUCTURAL FOOTINGS TO AVOID CONFLICT WHERE 3. STORM LINE OUT TO SITE 5'-0". REFER TO CIVIL ENGINEERS PLANS FOR CONTINUATION. PLUMBING CONTRACTOR SHALL MAKE FINAL

2. 4" ROOF DRAIN STORM LINE UP.

4. 6" WASTE LINE OUT TO SITE 5'-0". REFER TO CIVIL ENGINEERS PLANS FOR CONTINUATION. PLUMBING CONTRACTOR SHALL MAKE FINAL

B. PROVIDE SLEEVE AT PIPE PENETRATION THROUGH GRADE BEAM. COORDINATE WITH GENERAL CONTRACTOR.

9. 2" ELEVATOR SUMP PUMP DISCHARGE LINE UP. 10. ELEVATOR SUMP PUMP; REFER TO DETAIL, SHEET P0.1 FOR ADDITIONAL


> Allen McNutt NUMBER


John Knox Village **COURTYARDS - BUILDING E** 

SFCS Inc. • 1927 South Tryon St. - Suite 207 Charlotte, North Carolina 28203.4633 704.372.7327 • Fax 704.372.7369

CHECKED : DPW/MAH REVISION DESCRIPTION Rev 1 - Permit Comments 02/15/24

FOUNDATION PLAN -WASTE, VENT AND STORM

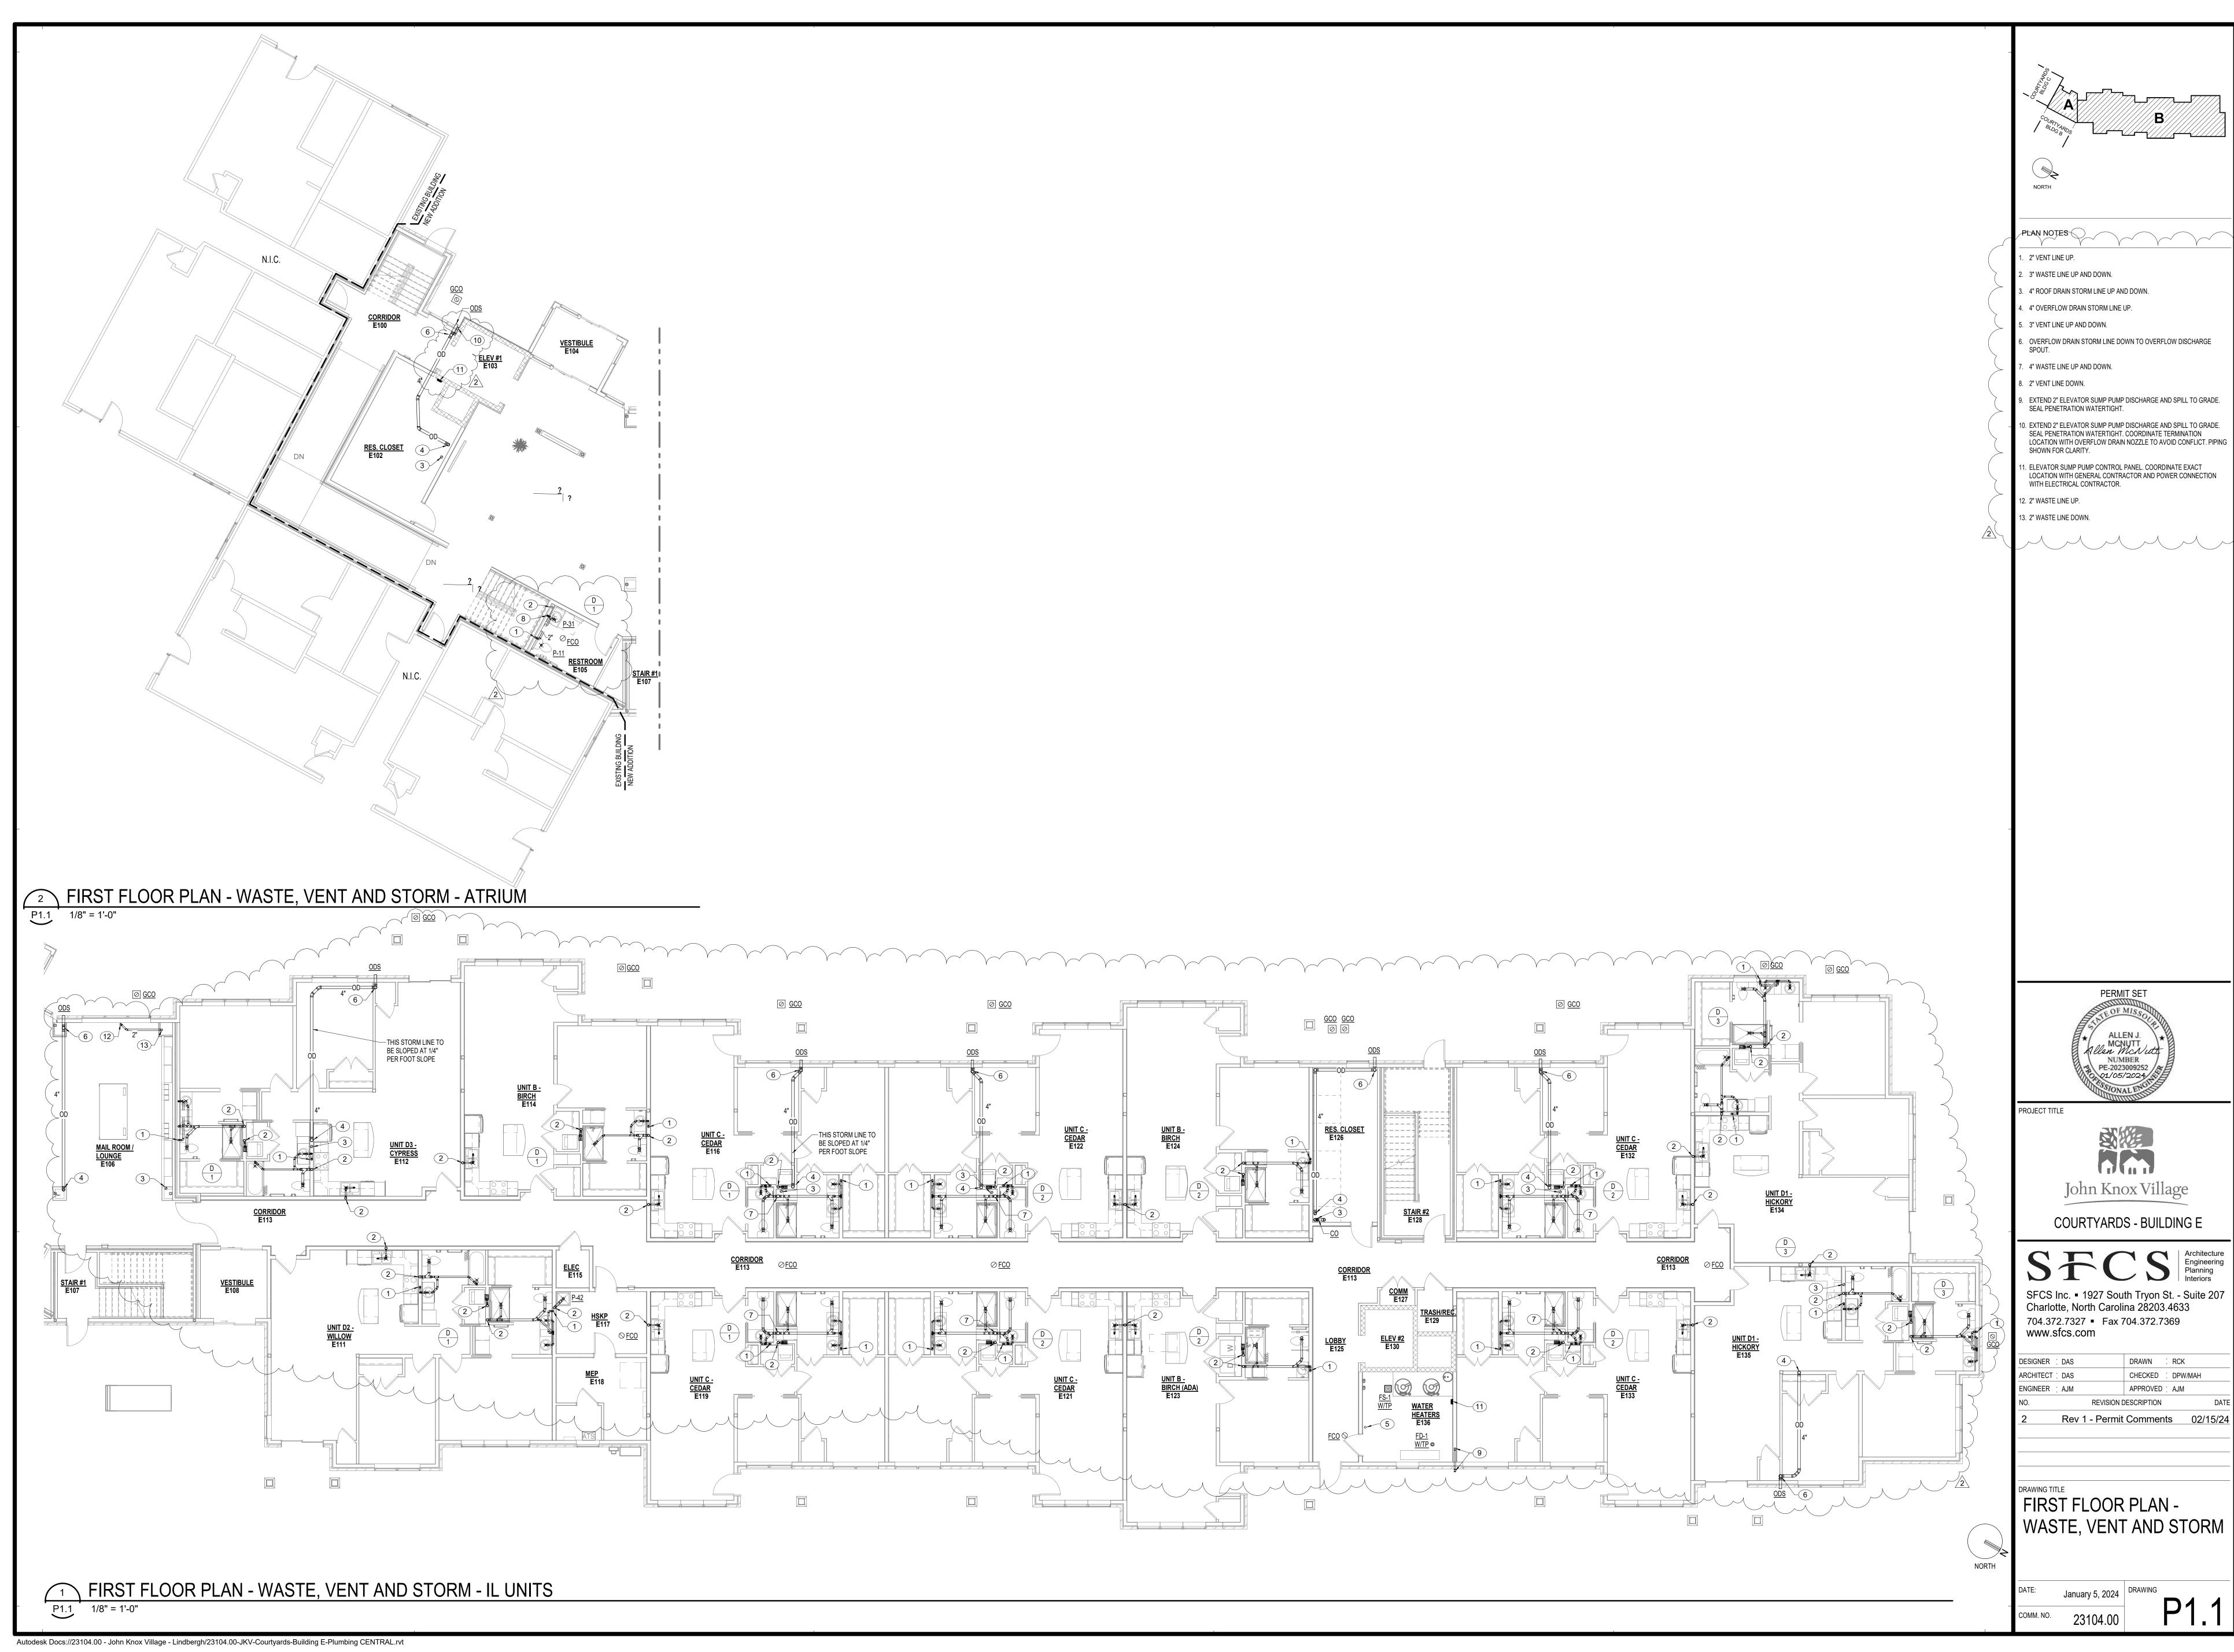

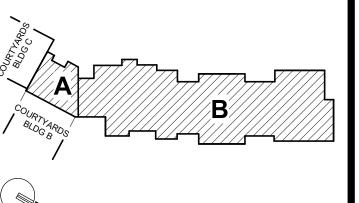

1. 2" VENT LINE UP.

2. 3" WASTE LINE UP AND DOWN.

4. 4" OVERFLOW DRAIN STORM LINE UP.

5. 3" VENT LINE UP AND DOWN.

6. OVERFLOW DRAIN STORM LINE DOWN TO OVERFLOW DISCHARGE

7. 4" WASTE LINE UP AND DOWN.

8. 2" VENT LINE DOWN.

9. EXTEND 2" ELEVATOR SUMP PUMP DISCHARGE AND SPILL TO GRADE. SEAL PENETRATION WATERTIGHT. 10. EXTEND 2" ELEVATOR SUMP PUMP DISCHARGE AND SPILL TO GRADE.
 SEAL PENETRATION WATERTIGHT. COORDINATE TERMINATION

11. ELEVATOR SUMP PUMP CONTROL PANEL. COORDINATE EXACT LOCATION WITH GENERAL CONTRACTOR AND POWER CONNECTION WITH ELECTRICAL CONTRACTOR.

12. 2" WASTE LINE UP.

ALLEN J.
MCNUTT
Allen McNutt
NUMBER

John Knox Village


COURTYARDS - BUILDING E


SFCS Inc. • 1927 South Tryon St. - Suite 207 Charlotte, North Carolina 28203.4633 704.372.7327 • Fax 704.372.7369 www.sfcs.com

REVISION DESCRIPTION

Rev 1 - Permit Comments 02/15/24

FIRST FLOOR PLAN -

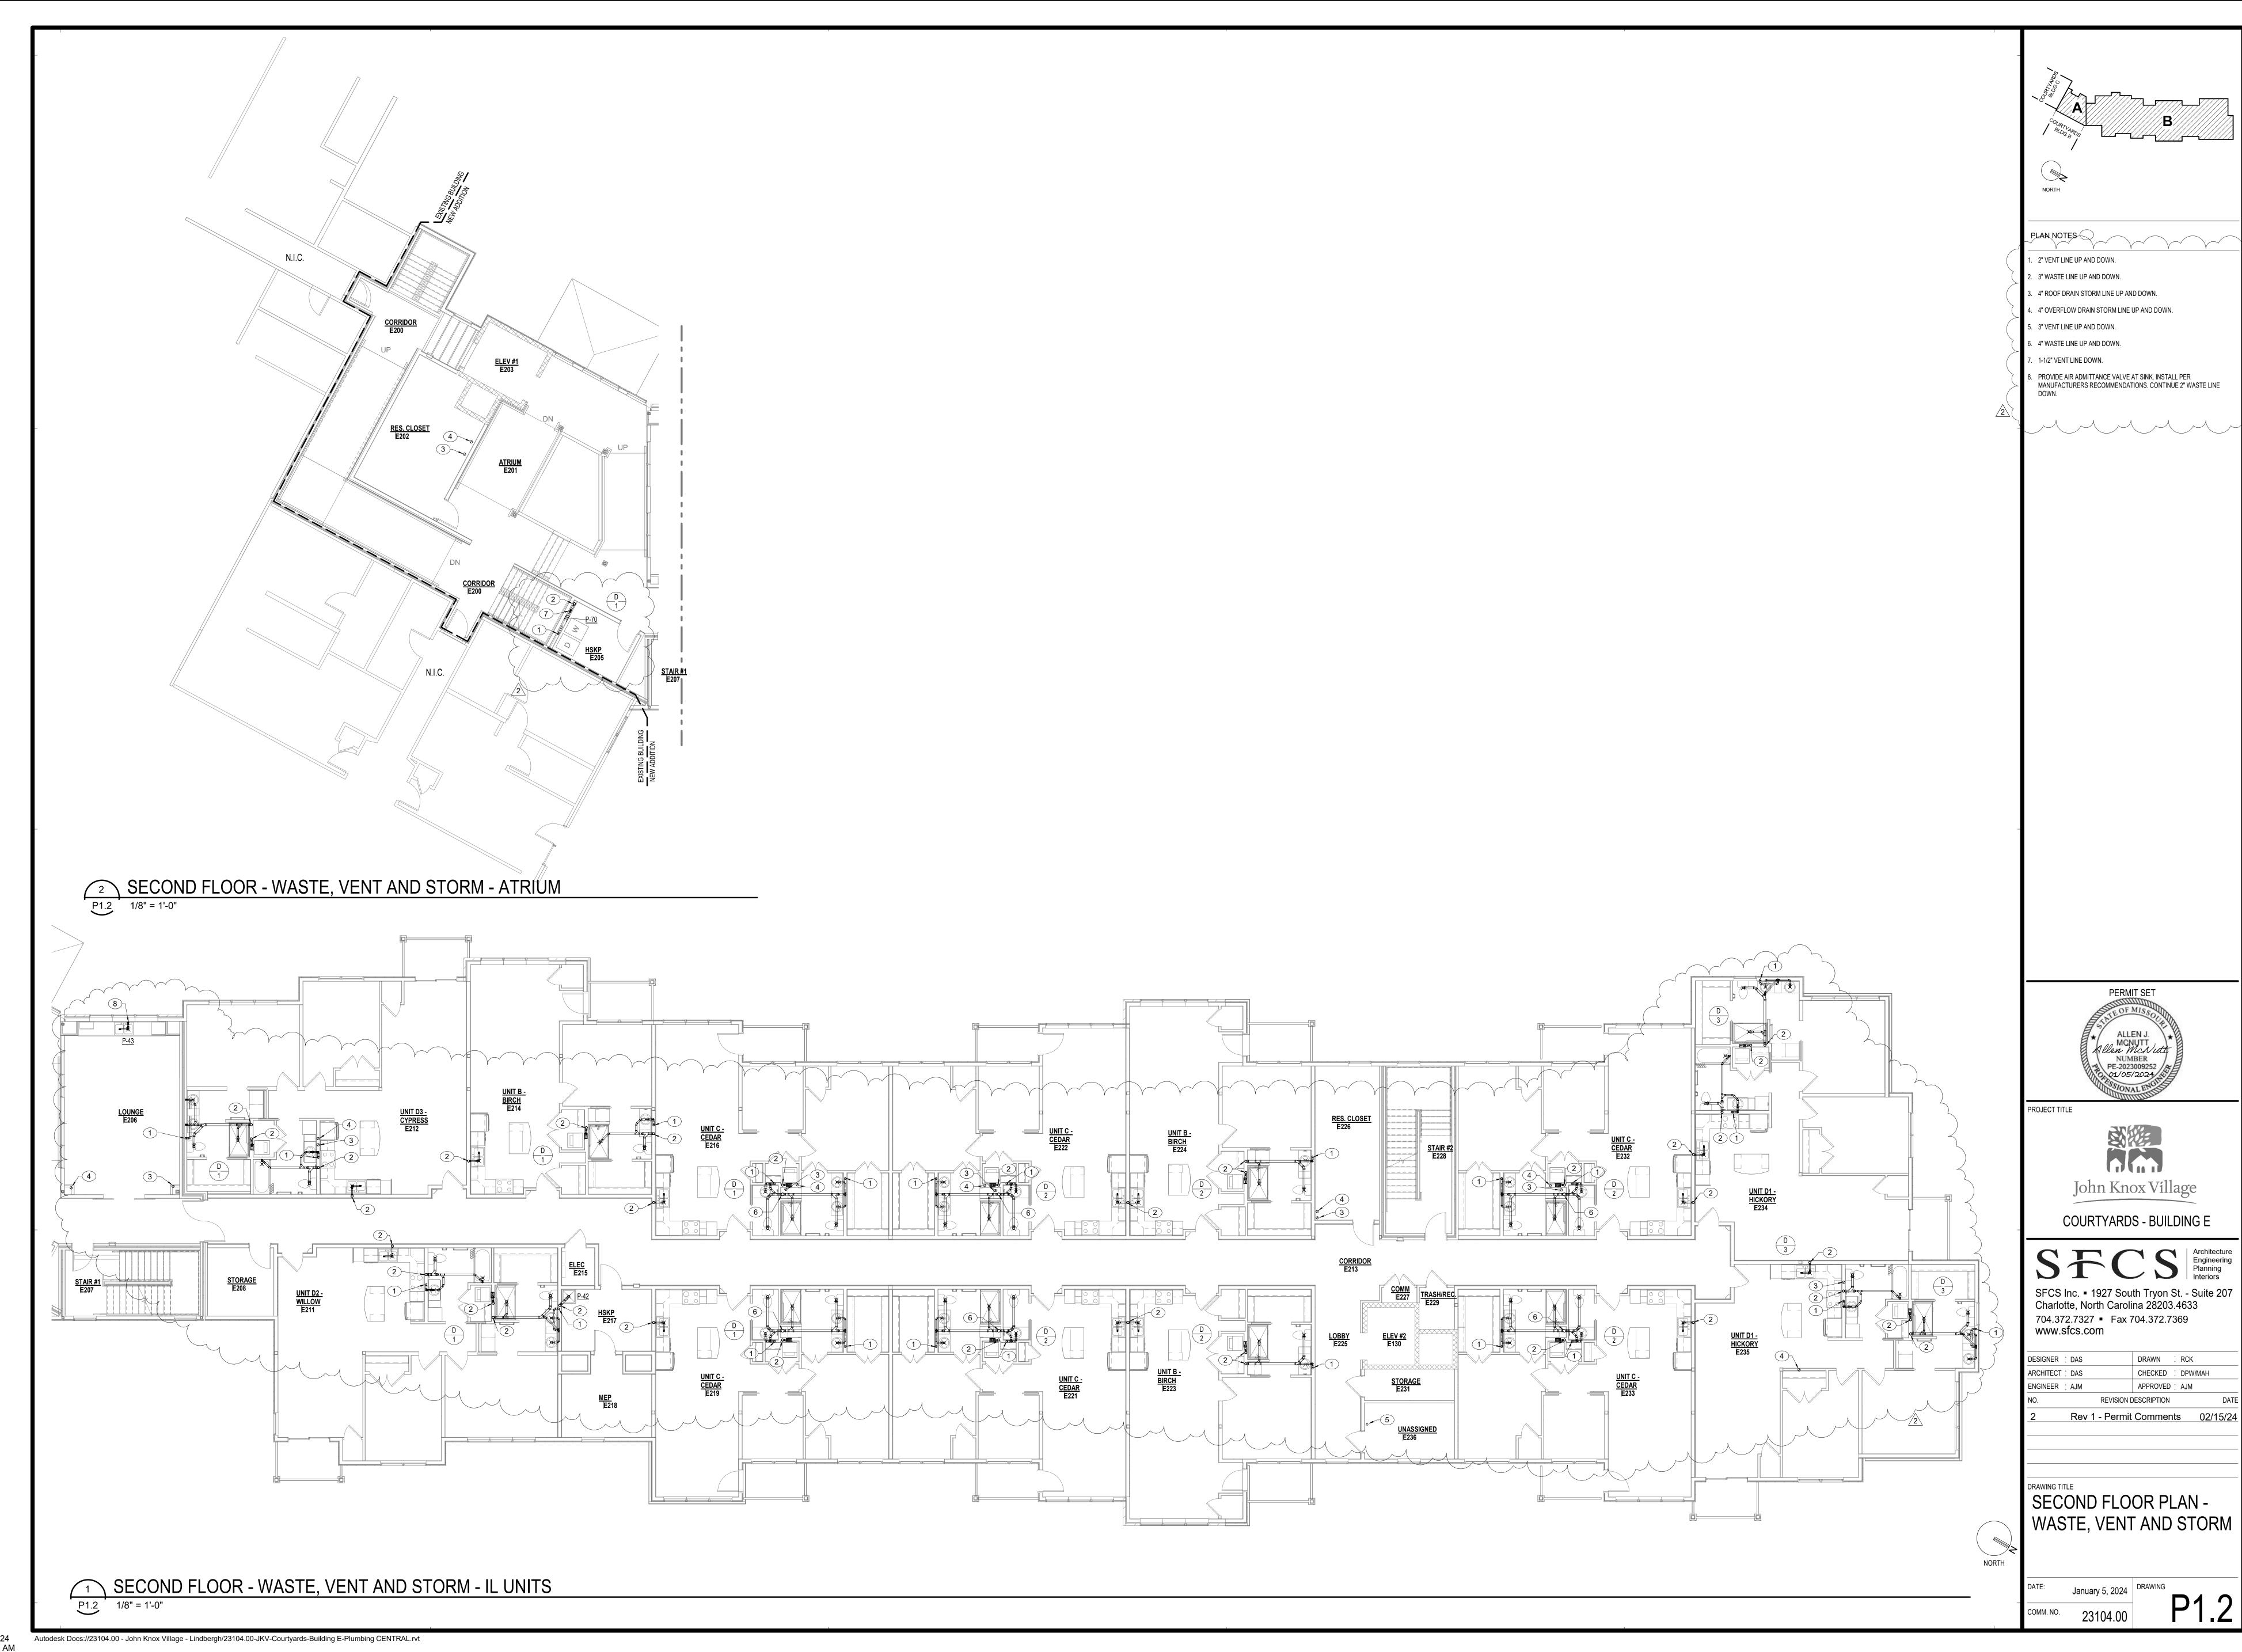

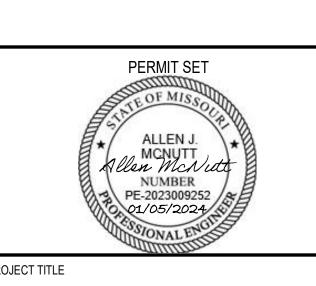





COURTYARDS - BUILDING E

SFCS Inc. • 1927 South Tryon St. - Suite 207 Charlotte, North Carolina 28203.4633 704.372.7327 • Fax 704.372.7369 www.sfcs.com

2	Rev 1 - Permit	Comments	02/15/2
NO.	REVISION [	DESCRIPTION	DA
ENGINEER :	AJM	APPROVED : AJN	1
ARCHITECT :	DAS	CHECKED : DP\	N/MAH
DESIGNER :	DAS	DRAWN : RCI	<

SECOND FLOOR PLAN -

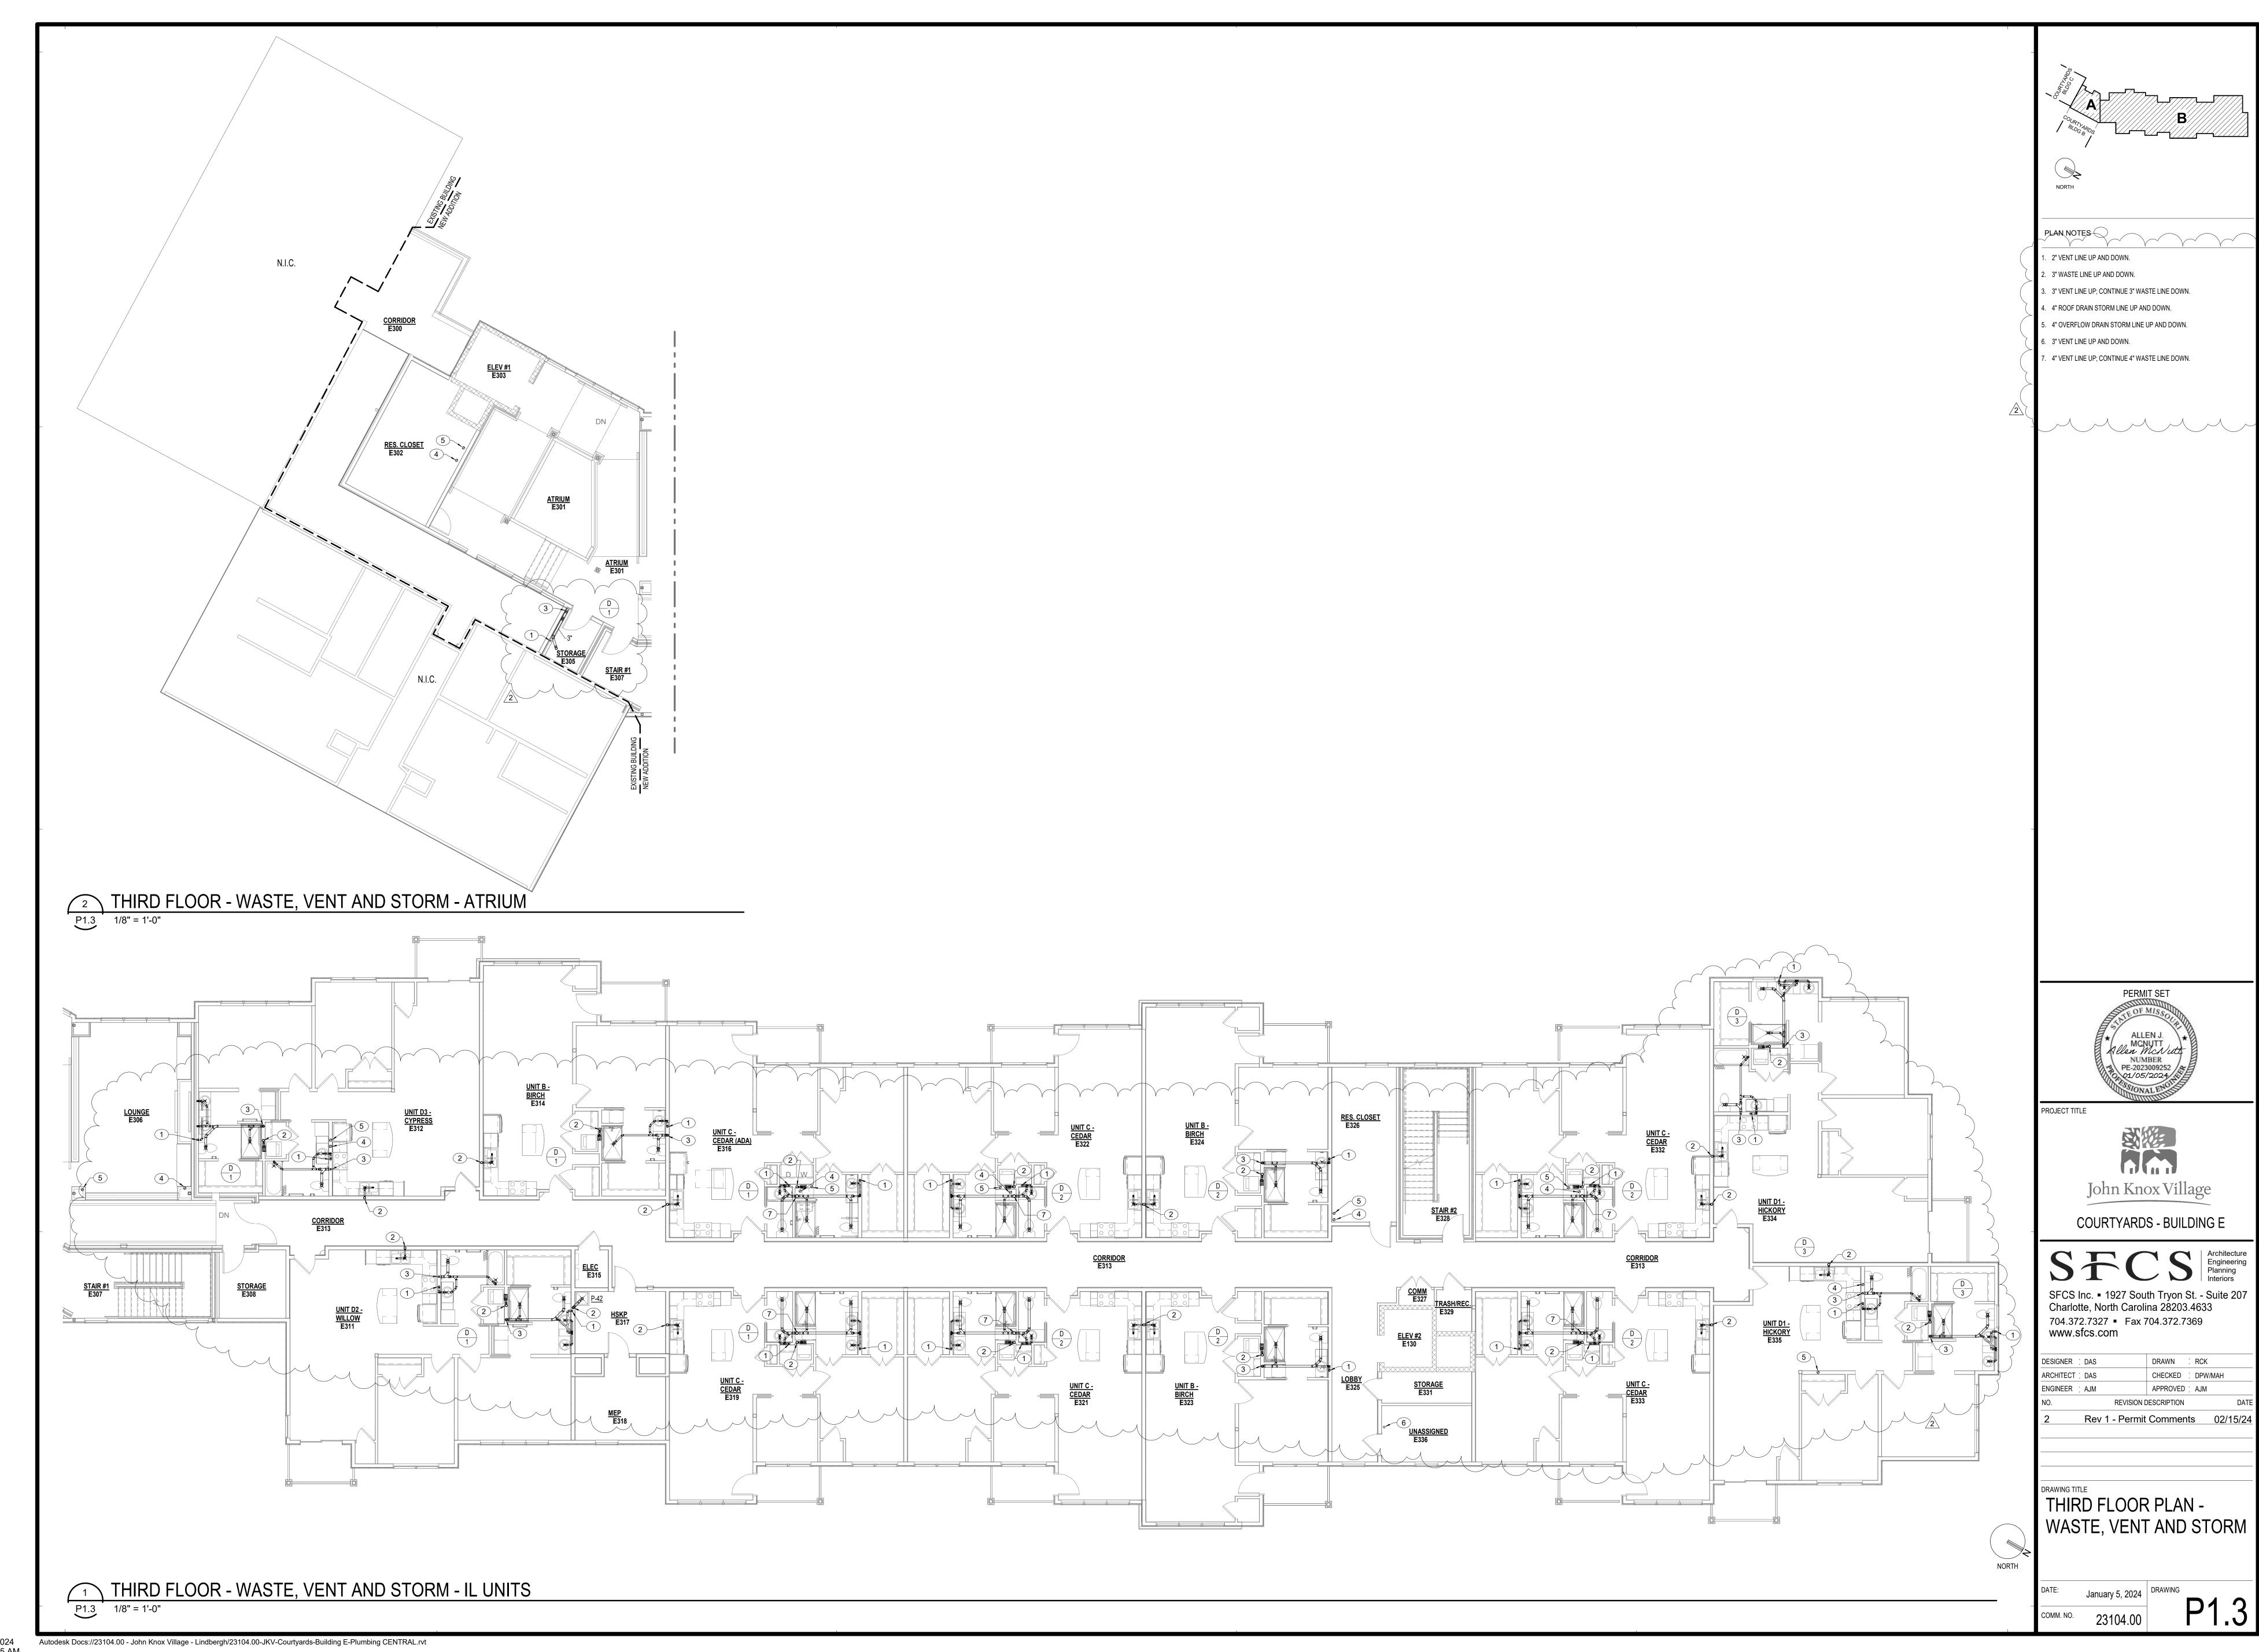

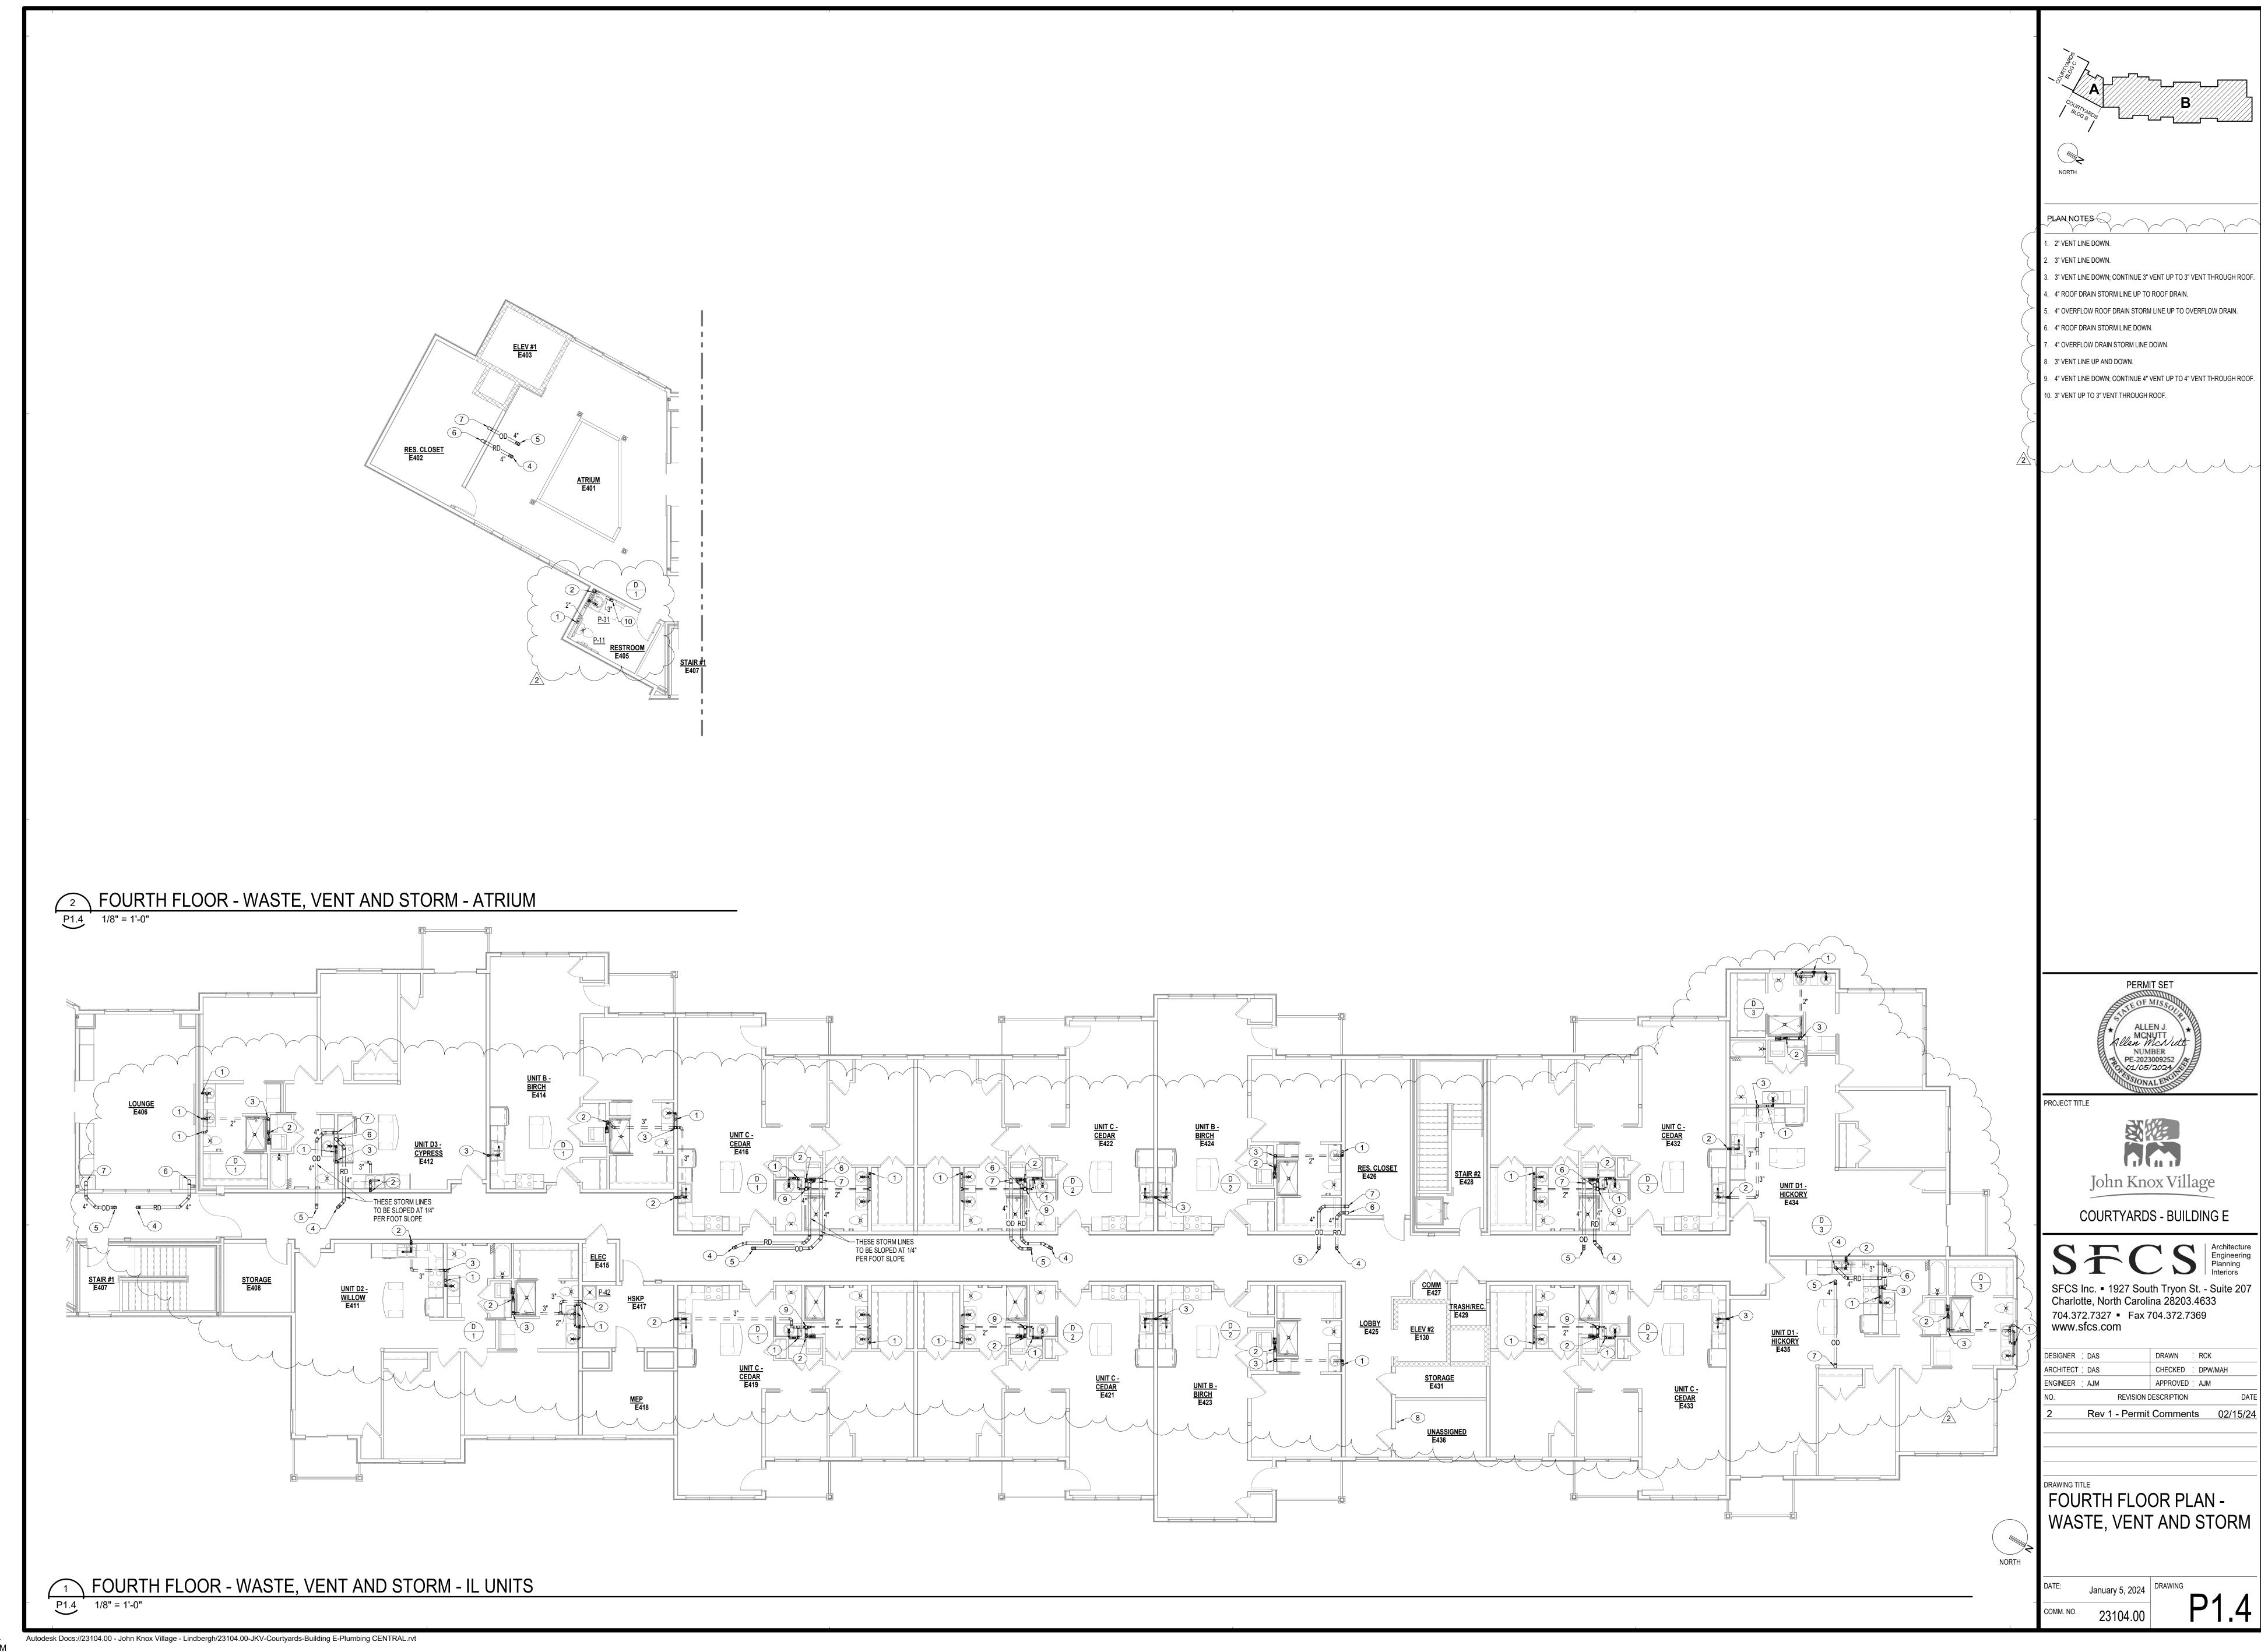

3. 3" VENT LINE DOWN; CONTINUE 3" VENT UP TO 3" VENT THROUGH ROOF.

4. 4" ROOF DRAIN STORM LINE UP TO ROOF DRAIN. 5. 4" OVERFLOW ROOF DRAIN STORM LINE UP TO OVERFLOW DRAIN.

6. 4" ROOF DRAIN STORM LINE DOWN.

7. 4" OVERFLOW DRAIN STORM LINE DOWN.

8. 3" VENT LINE UP AND DOWN.

9. 4" VENT LINE DOWN; CONTINUE 4" VENT UP TO 4" VENT THROUGH ROOF.


John Knox Village

COURTYARDS - BUILDING E


704.372.7327 • Fax 704.372.7369


Rev 1 - Permit Comments 02/15/24

PRAWING TITLE FOURTH FLOOR PLAN -

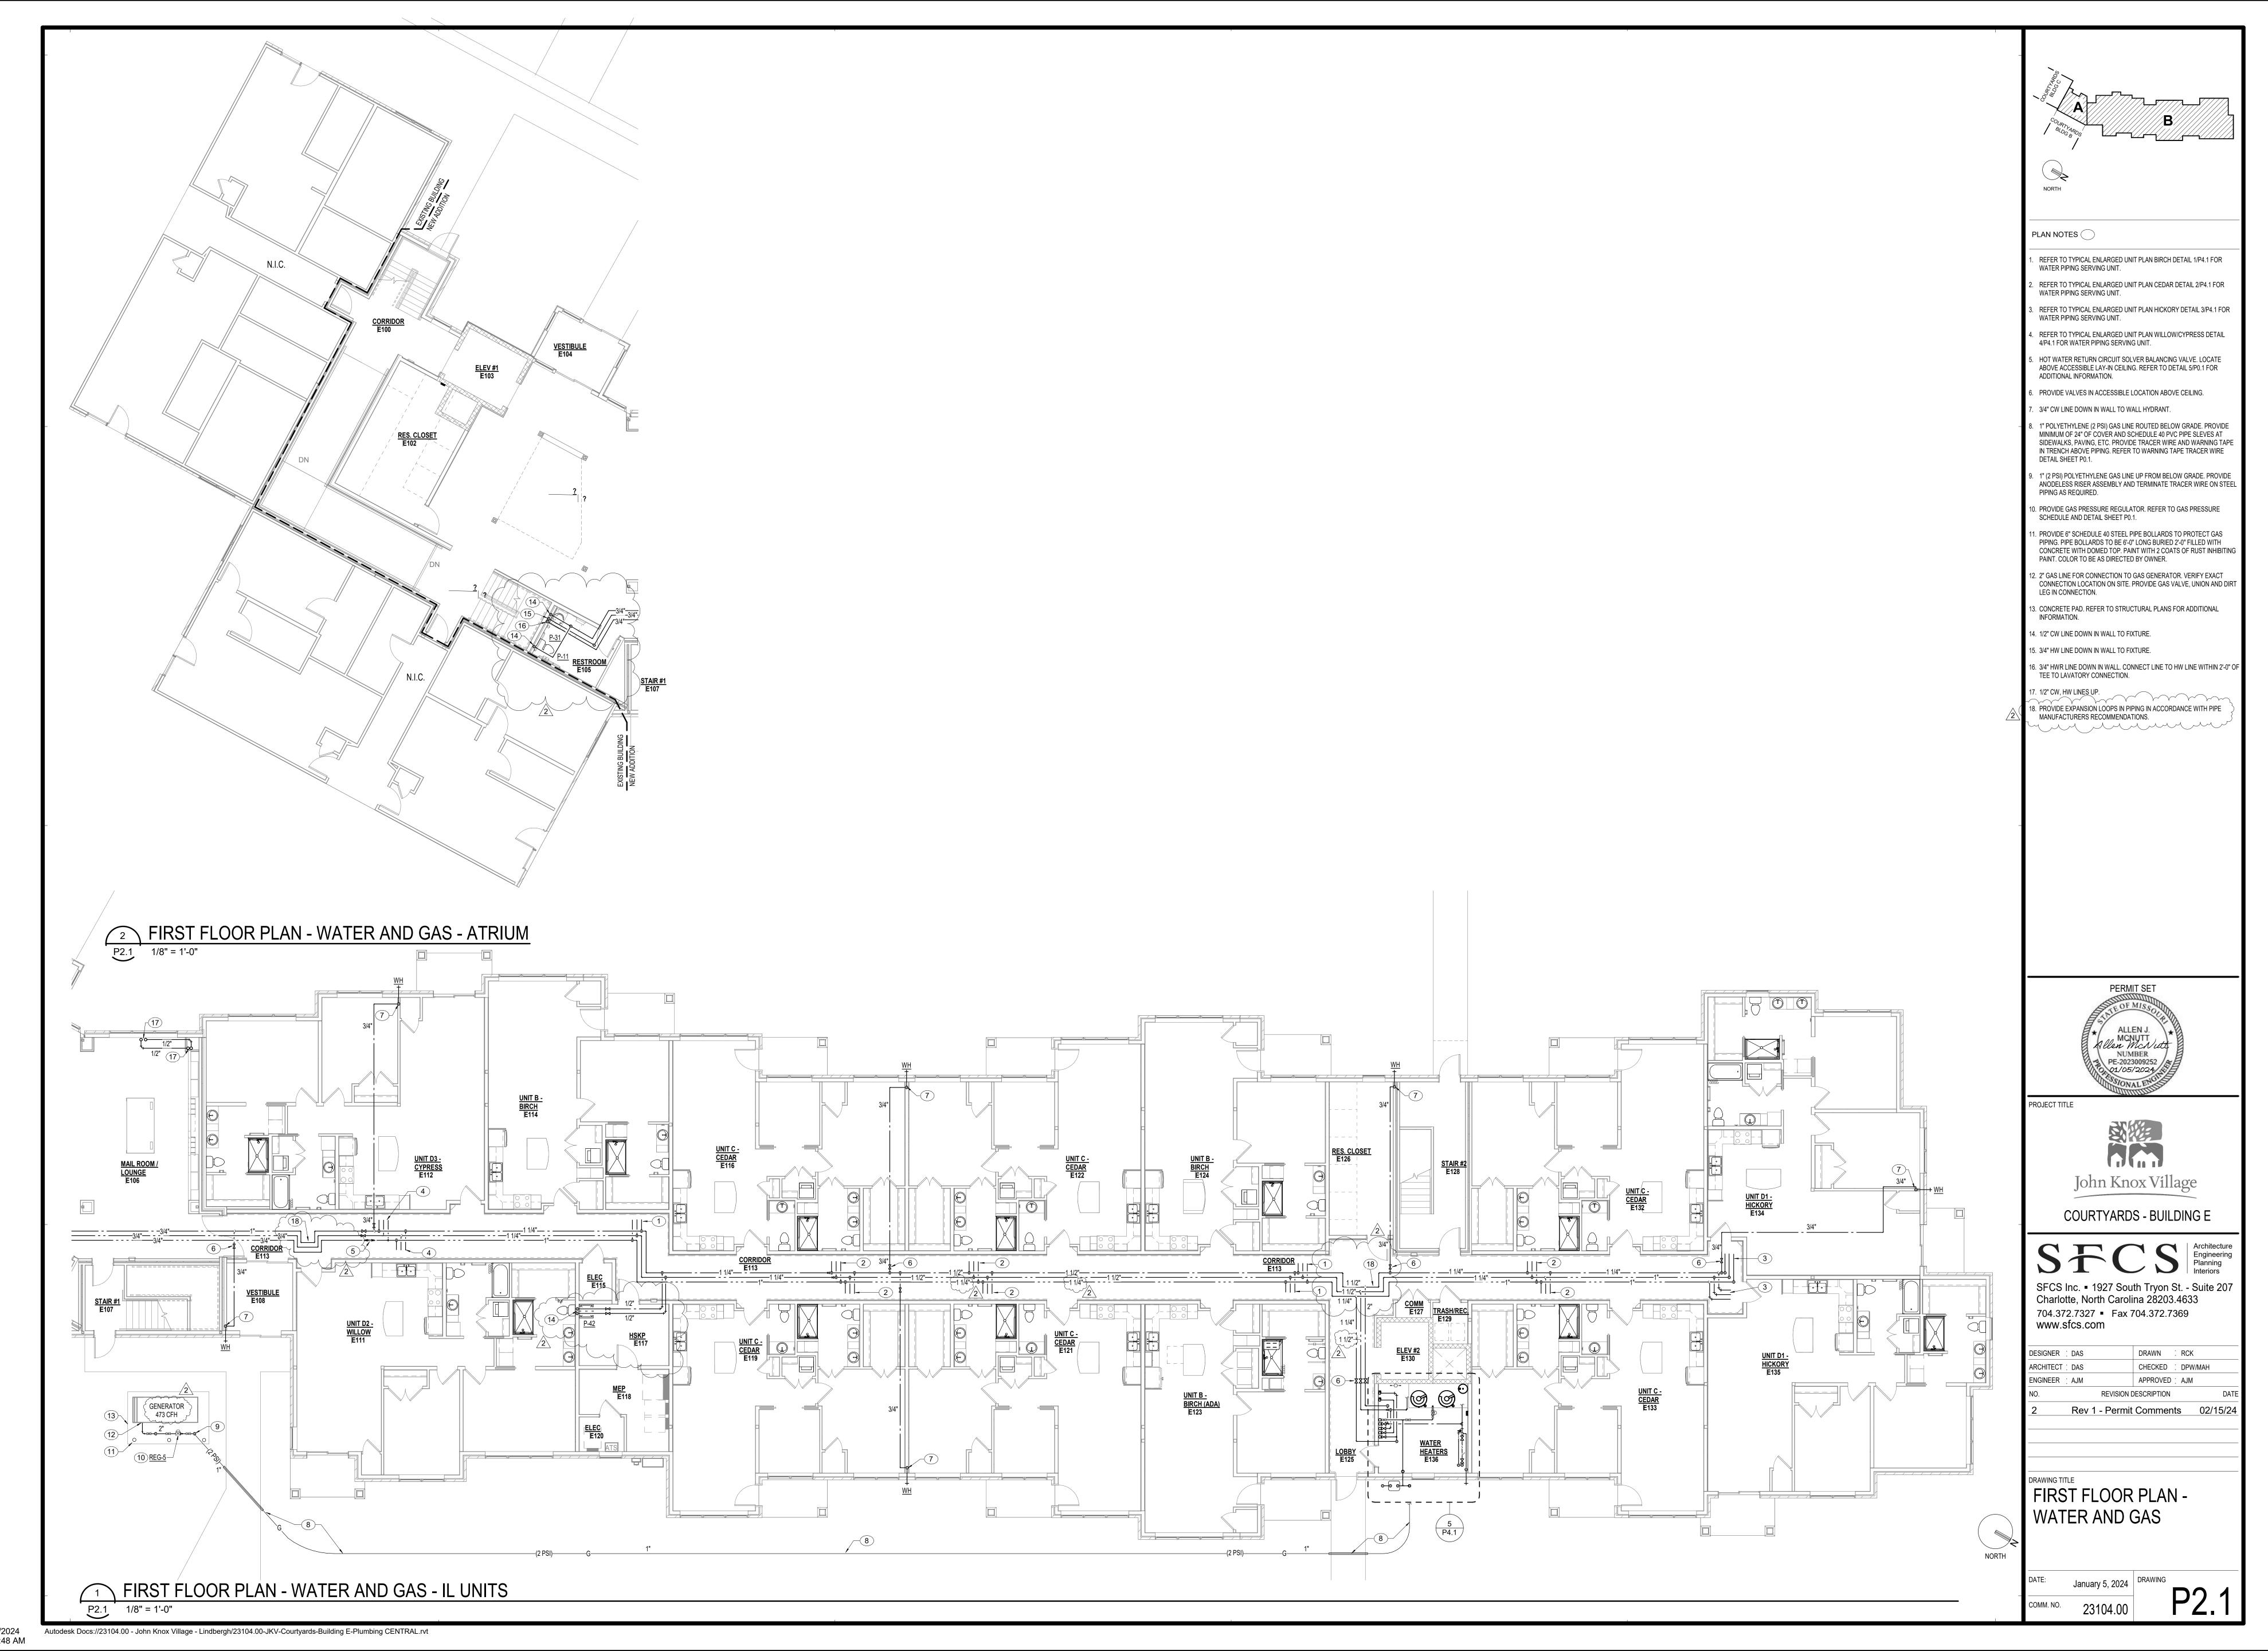

2/16/ 9·52

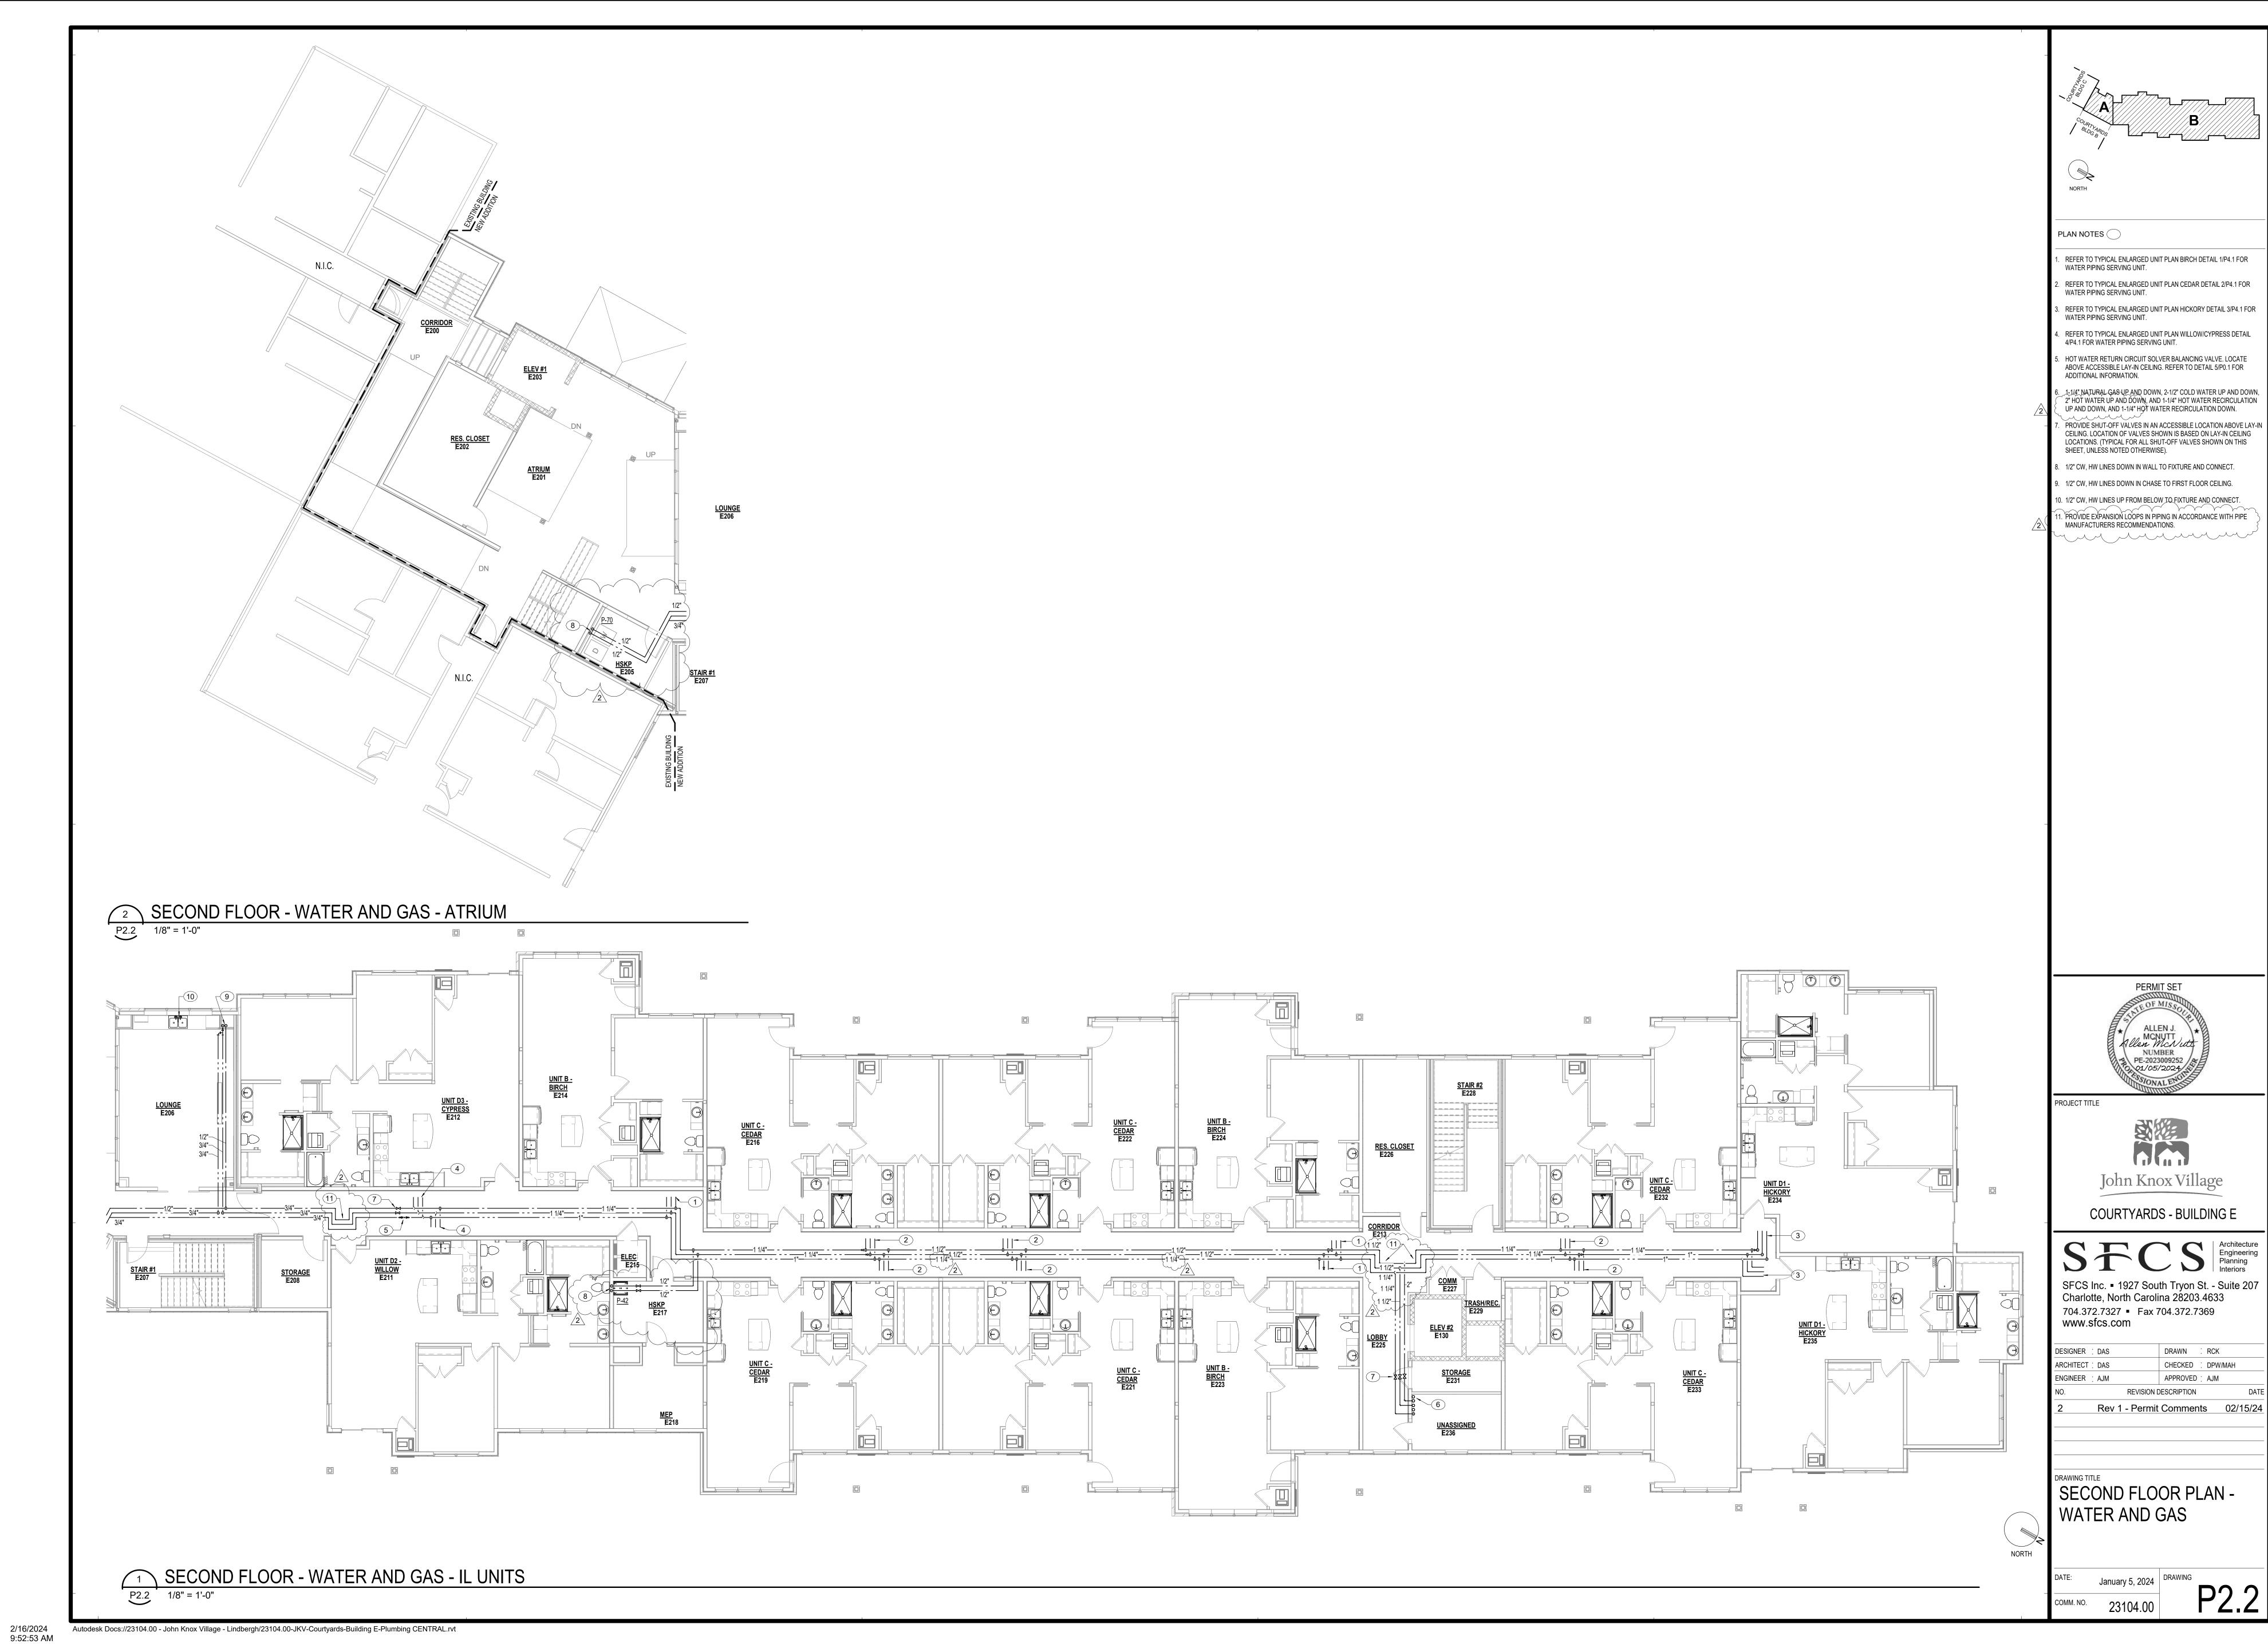

 

John Knox Village


COURTYARDS - BUILDING E

SFCS Inc. • 1927 South Tryon St. - Suite 207 Charlotte, North Carolina 28203.4633 704.372.7327 • Fax 704.372.7369


APPROVED : AJM REVISION DESCRIPTION

Rev 1 - Permit Comments 02/15/24

DRAWING TITLE
SECOND FLOOR PLAN -WATER AND GAS

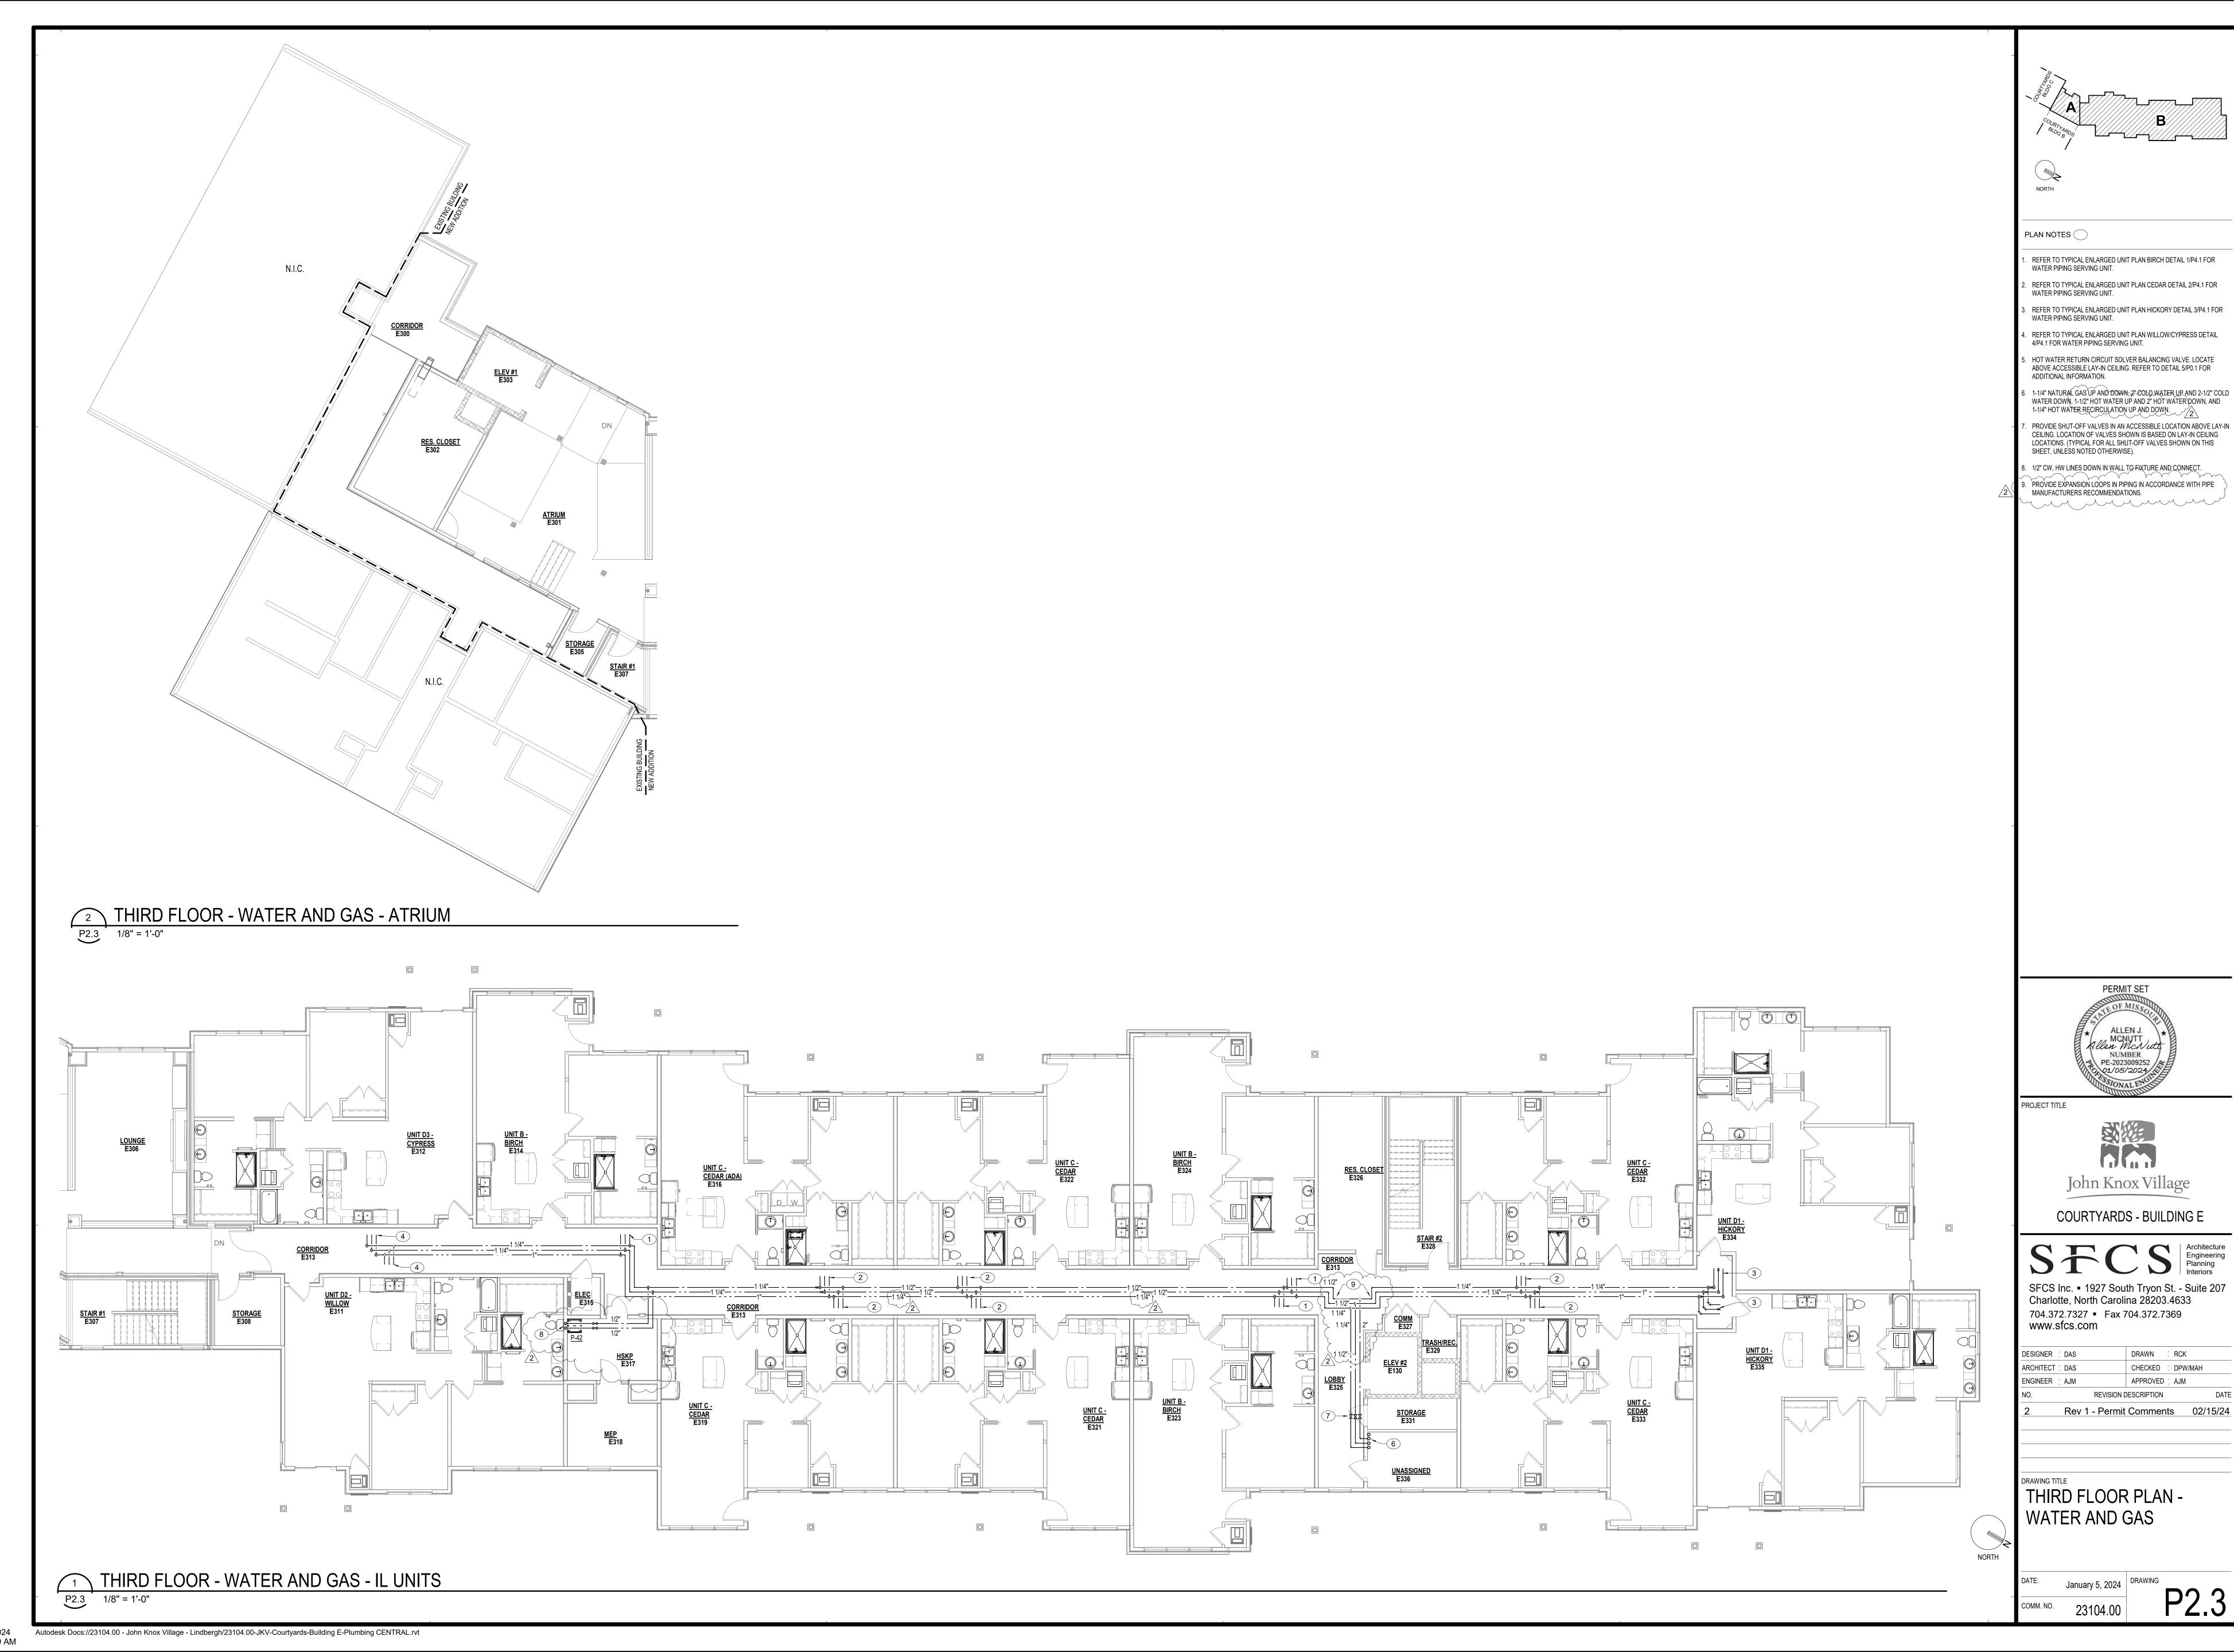

REVISION DESCRIPTION

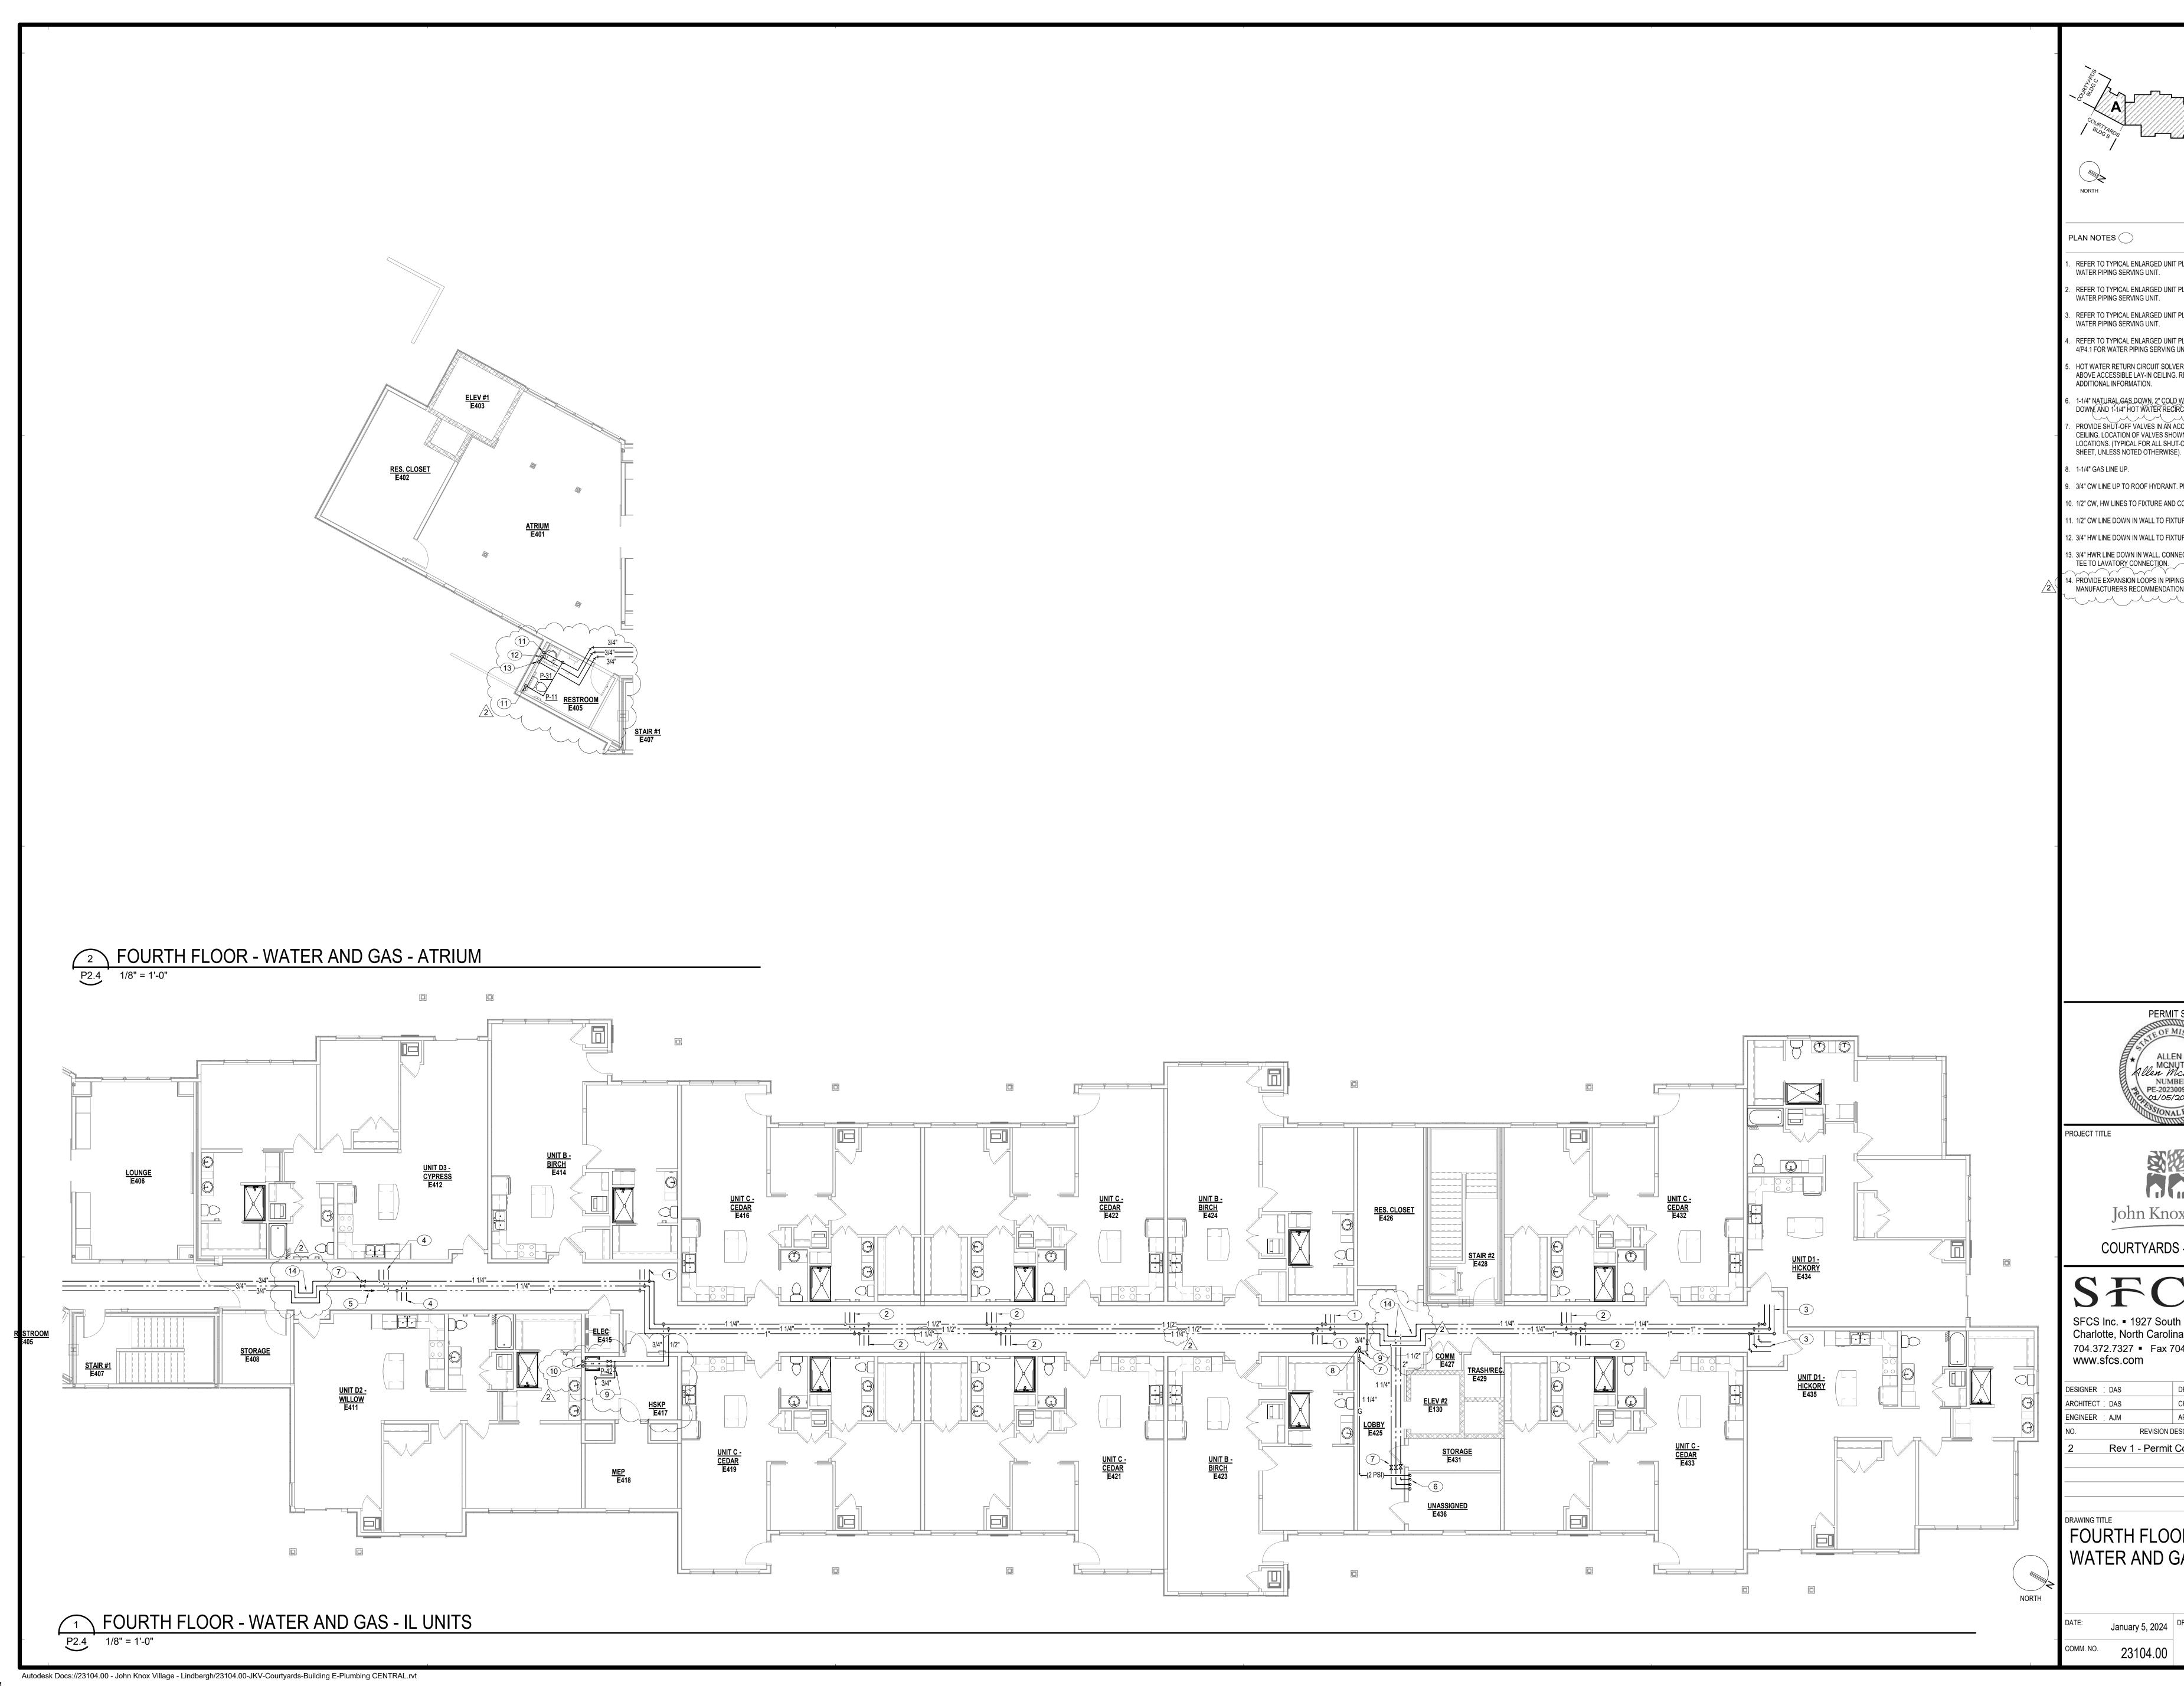

PLAN NOTES

REFER TO TYPICAL ENLARGED UNIT PLAN BIRCH DETAIL 1/P4.1 FOR WATER PIPING SERVING UNIT.

2. REFER TO TYPICAL ENLARGED UNIT PLAN CEDAR DETAIL 2/P4.1 FOR WATER PIPING SERVING UNIT.

B. REFER TO TYPICAL ENLARGED UNIT PLAN HICKORY DETAIL 3/P4.1 FOR WATER PIPING SERVING UNIT.

4/P4.1 FOR WATER PIPING SERVING UNIT.

4. REFER TO TYPICAL ENLARGED UNIT PLAN WILLOW/CYPRESS DETAIL

5. HOT WATER RETURN CIRCUIT SOLVER BALANCING VALVE. LOCATE ABOVE ACCESSIBLE LAY-IN CEILING. REFER TO DETAIL 5/P0.1 FOR ADDITIONAL INFORMATION.

6. 1-1/4" NATURAL GAS DOWN, 2" COLD WATER DOWN, 1-1/2" HOT WATER DOWN, AND 1-1/4" HOT WATER RECIRCULATION DOWN. 7. PROVIDE SHUT-OFF VALVES IN AN ACCESSIBLE LOCATION ABOVE LAY-IN CEILING. LOCATION OF VALVES SHOWN IS BASED ON LAY-IN CEILING LOCATIONS. (TYPICAL FOR ALL SHUT-OFF VALVES SHOWN ON THIS

8. 1-1/4" GAS LINE UP.

9. 3/4" CW LINE UP TO ROOF HYDRANT. PROVIDE SHUT-OFF VALVE IN LINE. 10. 1/2" CW, HW LINES TO FIXTURE AND CONNECT.

11. 1/2" CW LINE DOWN IN WALL TO FIXTURE.

12. 3/4" HW LINE DOWN IN WALL TO FIXTURE.

13. 3/4" HWR LINE DOWN IN WALL. CONNECT LINE TO HW LINE WITHIN 2'-0" OF TEE TO LAVATORY CONNECTION. 14. PROVIDE EXPANSION LOOPS IN PIPING IN ACCORDANCE WITH PIPE MANUFACTURERS RECOMMENDATIONS. 


John Knox Village

COURTYARDS - BUILDING E

SFCS Inc. • 1927 South Tryon St. - Suite 207 Charlotte, North Carolina 28203.4633 704.372.7327 Fax 704.372.7369 www.sfcs.com

REVISION DESCRIPTION Rev 1 - Permit Comments 02/15/24

FOURTH FLOOR PLAN -WATER AND GAS

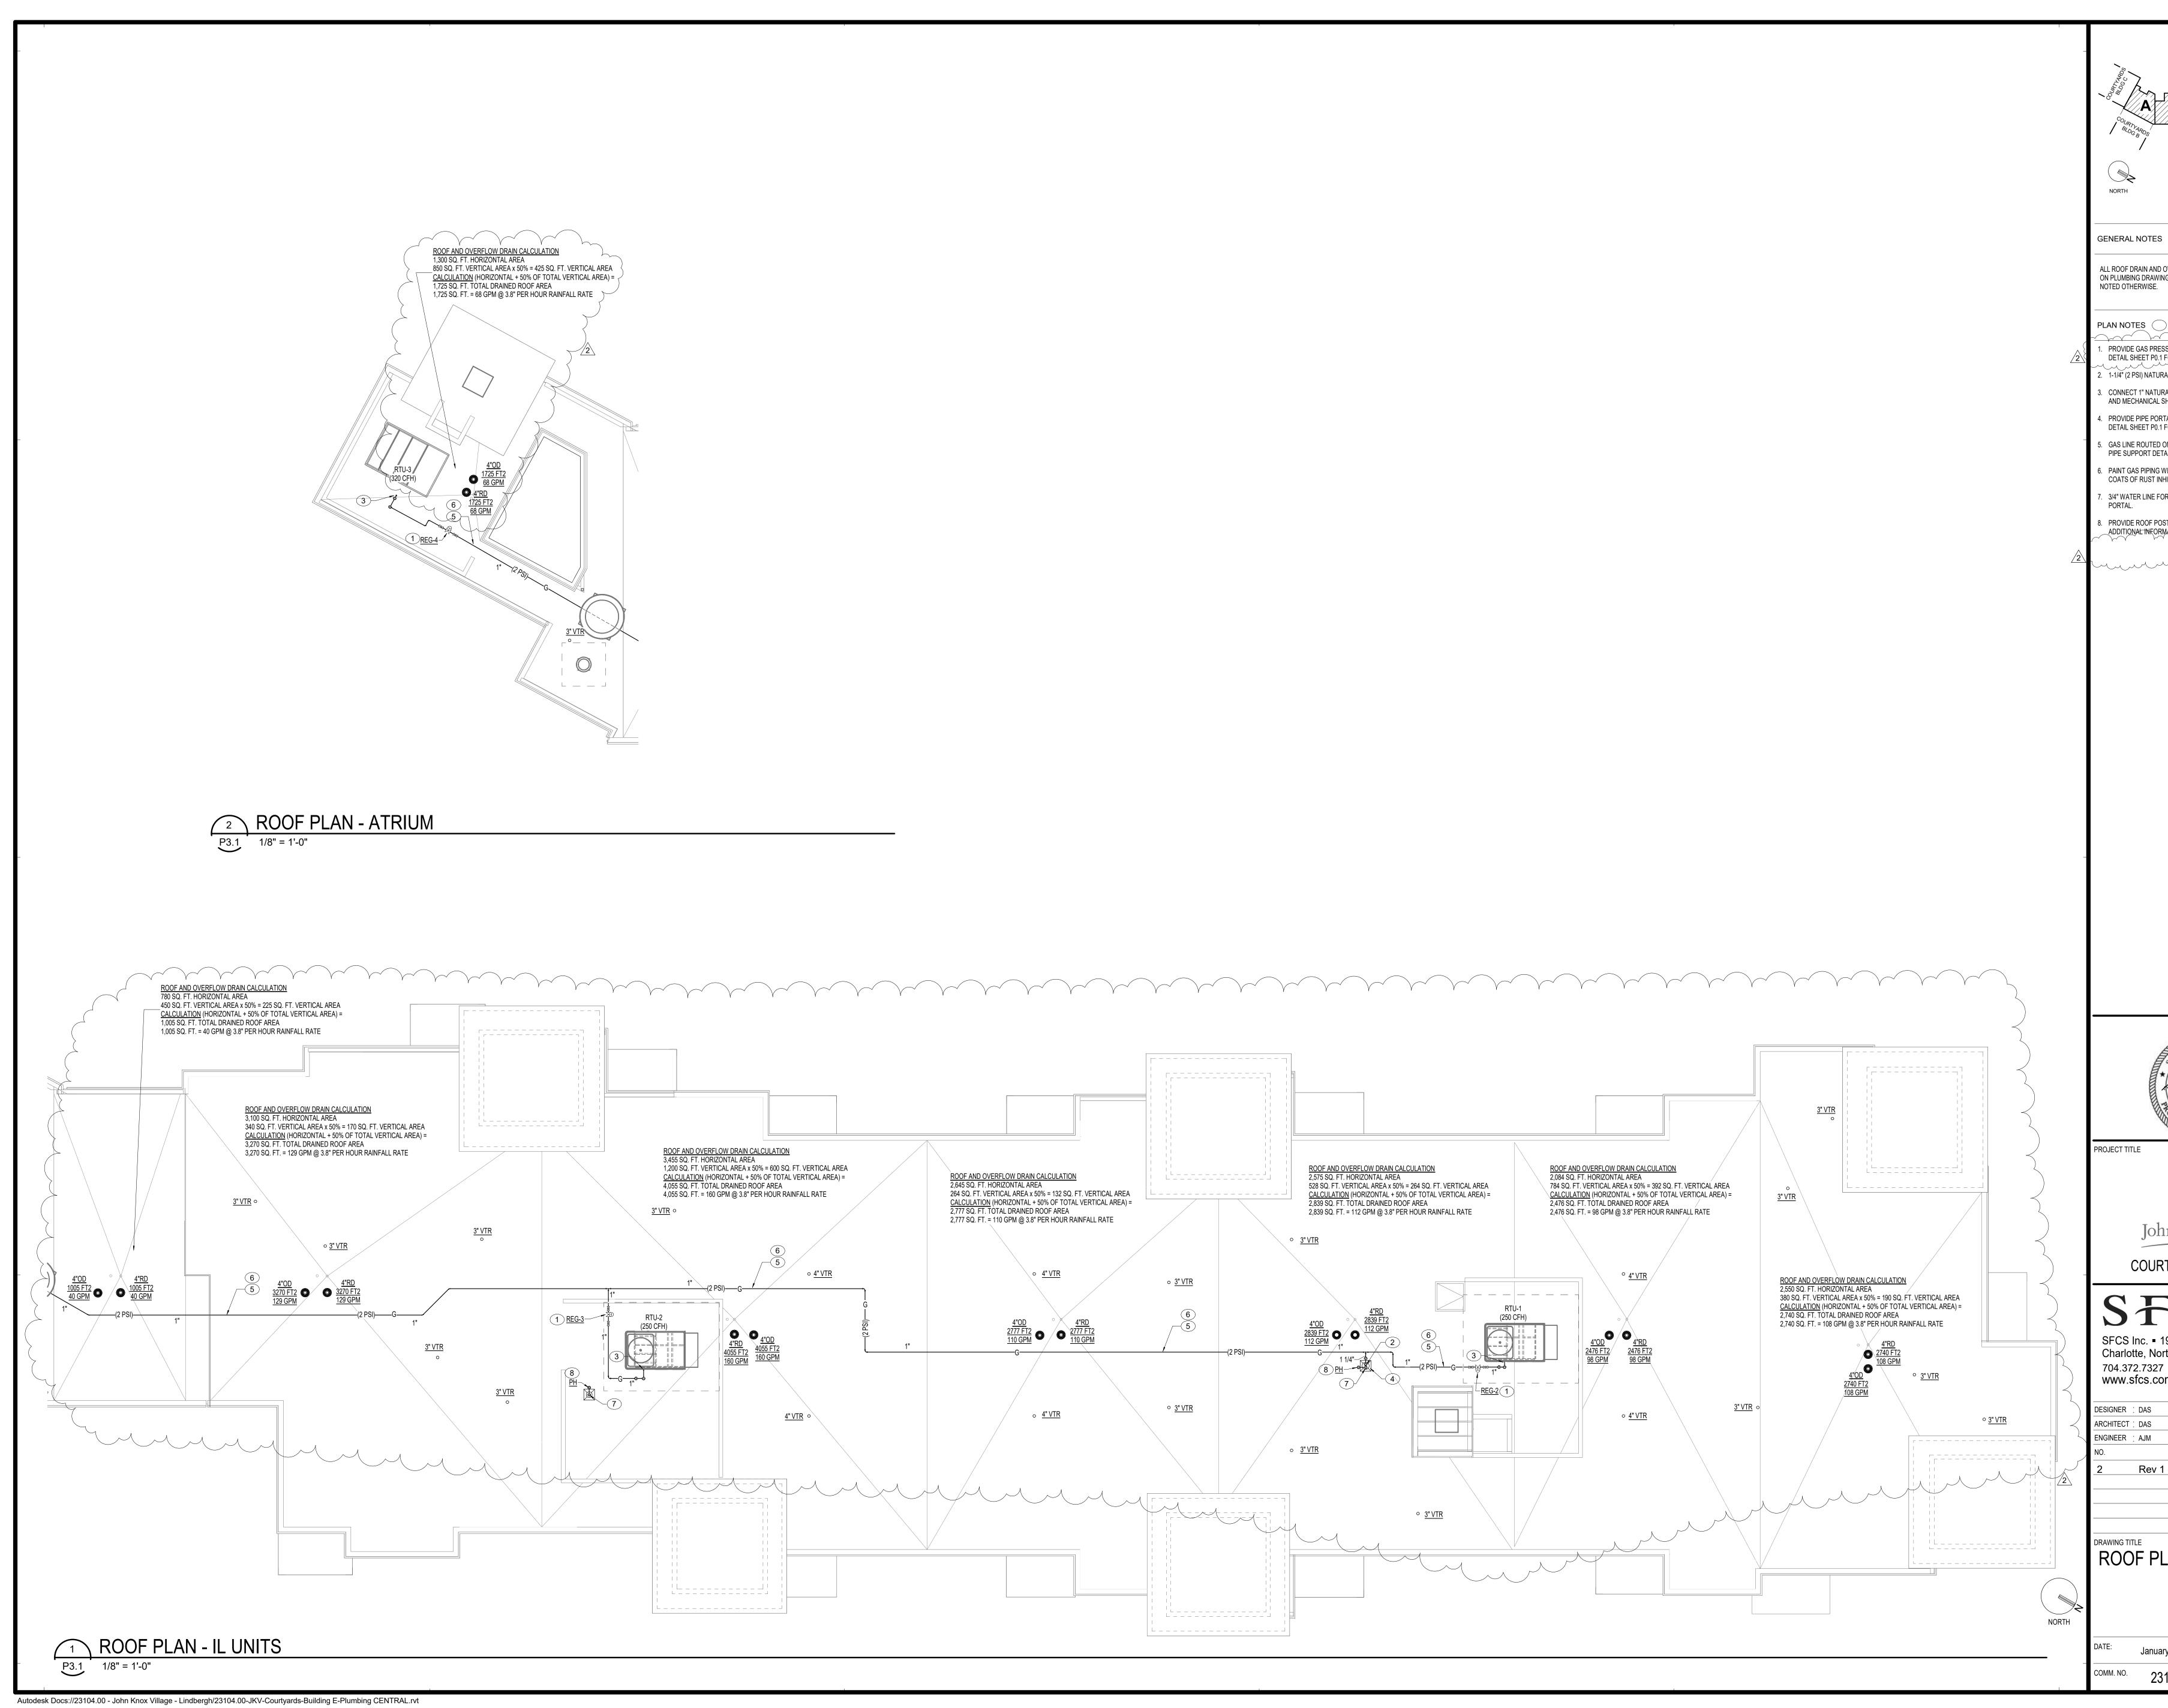

ALL ROOF DRAIN AND OVERFLOW DRAIN STORM PIPING INDICATED ON PLUMBING DRAWINGS IS BASED ON 1/8" PER FOOT SLOPE, UNLESS

PROVIDE GAS PRESSURE REGULATOR. REFER TO SCHEDULE AND

DETAIL SHEET P0.1 FOR ADDITIONAL INFORMATION 2. 1-1/4" (2 PSI) NATURAL GAS DOWN THROUGH PIPE PORTAL. B. CONNECT 1" NATURAL GAS LINE TO ROOFTOP UNIT. SEE DETAIL 7/P0.1 AND MECHANICAL SHEETS FOR MORE INFORMATION.

PROVIDE PIPE PORTAL FOR WATER AND OR GAS LINE. REFER TO DETAIL SHEET P0.1 FOR ADDITIONAL INFORMATION. 5. GAS LINE ROUTED ON ROOF. PROVIDE PIPE SUPPORTS. REFER TO PIPE SUPPORT DETAIL SHEET P0.1 FOR ADDITIONAL INFORMATION. 6. PAINT GAS PIPING WITH 2 COATS OF RUST INHIBITING PRIMER AND 2 COATS OF RUST INHIBITING PAINT.

7. 3/4" WATER LINE FOR ROOF POST HYDRANT DOWN THROUGH PIPE

3. PROVIDE ROOF POST HYDRANT. REFER TO DETAIL SHEET P0.1 FOR

ALLEN J. Allen McNutt NUMBER PE-2023009252 /A

John Knox Village


COURTYARDS - BUILDING E

SFCS Inc. • 1927 South Tryon St. - Suite 207 Charlotte, North Carolina 28203.4633


704.372.7327 • Fax 704.372.7369 www.sfcs.com DRAWN : RCK CHECKED : DPW/MAH


APPROVED : AJM REVISION DESCRIPTION Rev 1 - Permit Comments 02/15/24


ROOF PLAN - PLUMBING

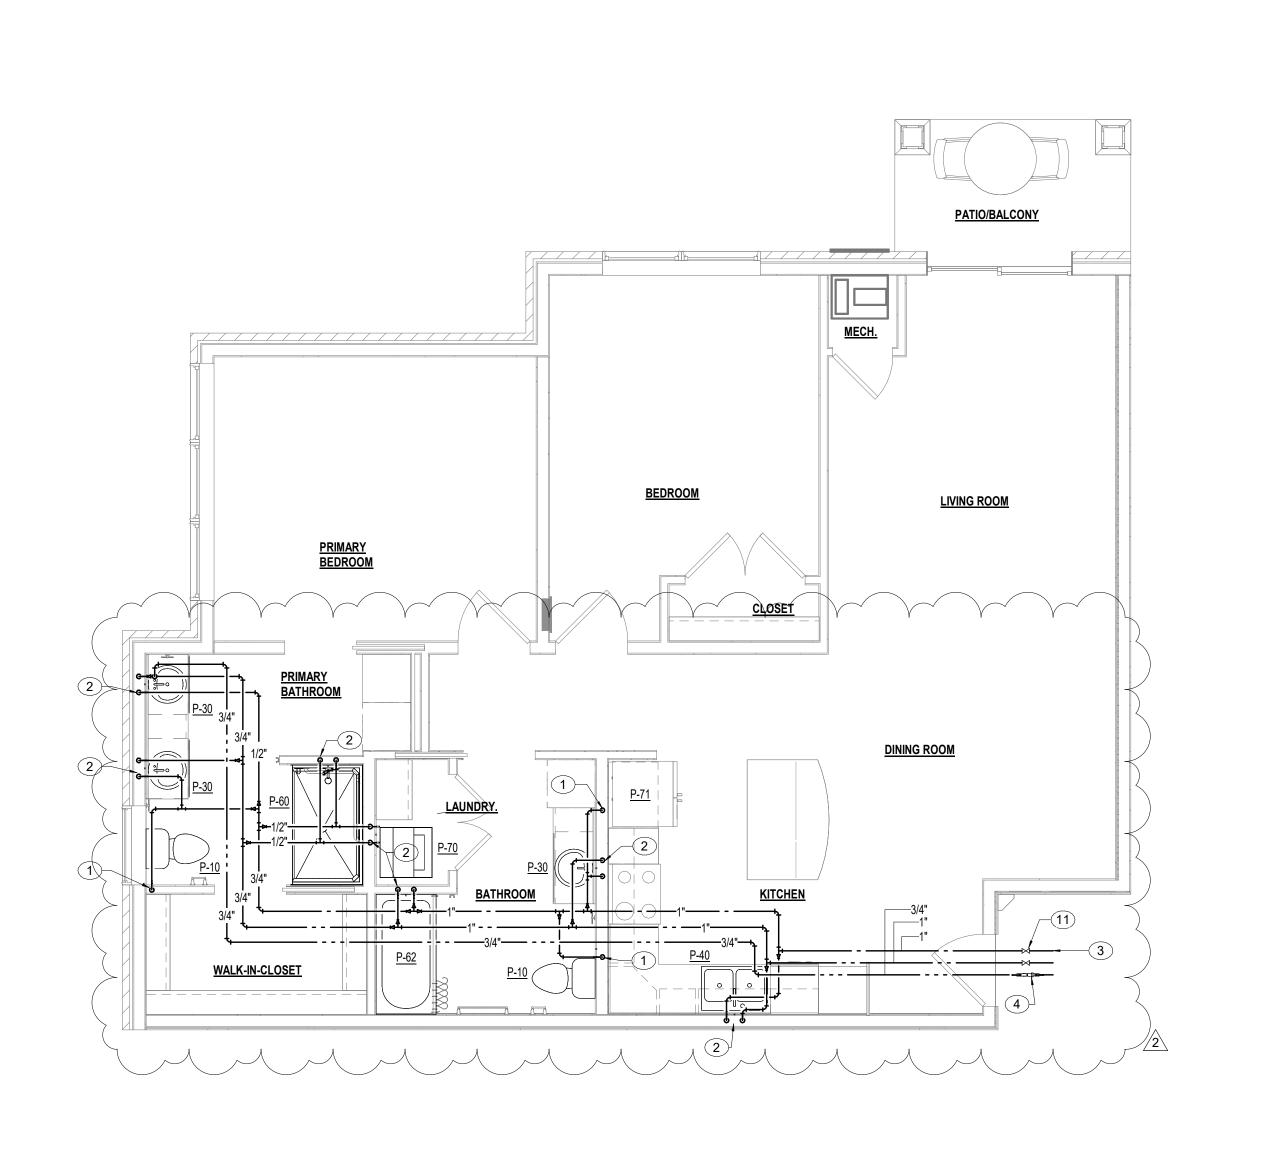



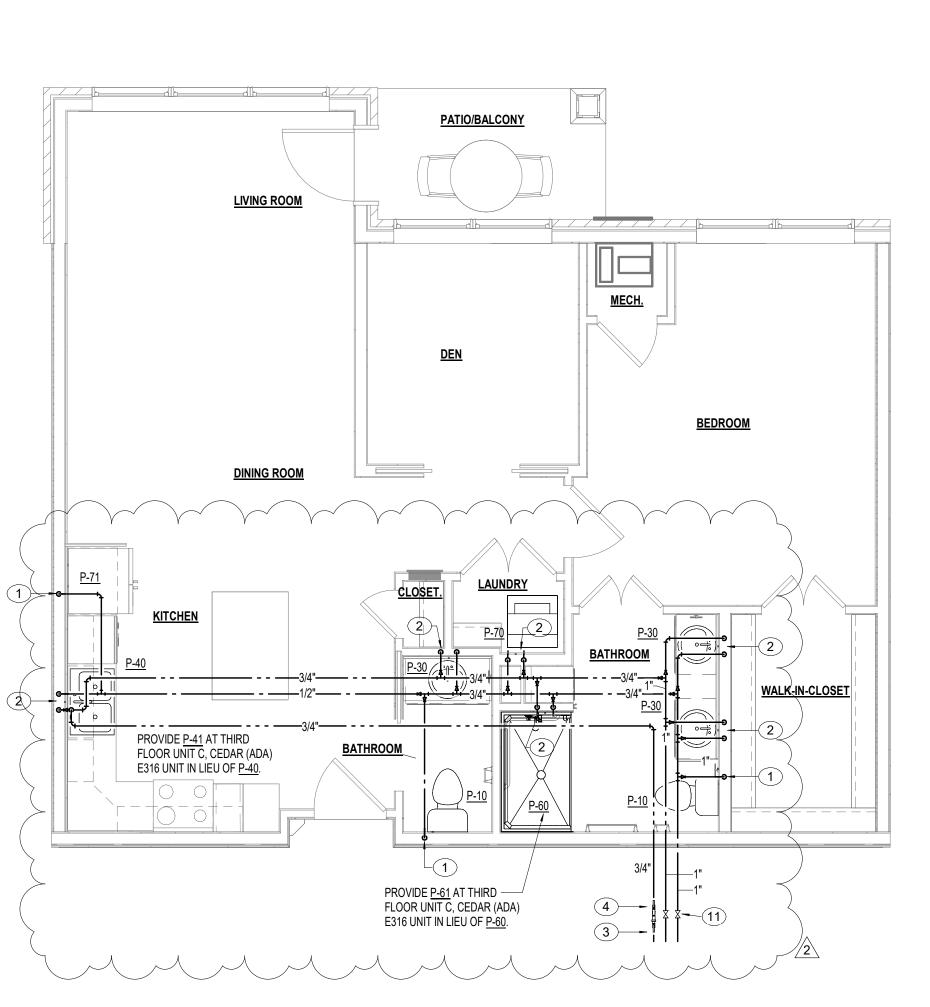

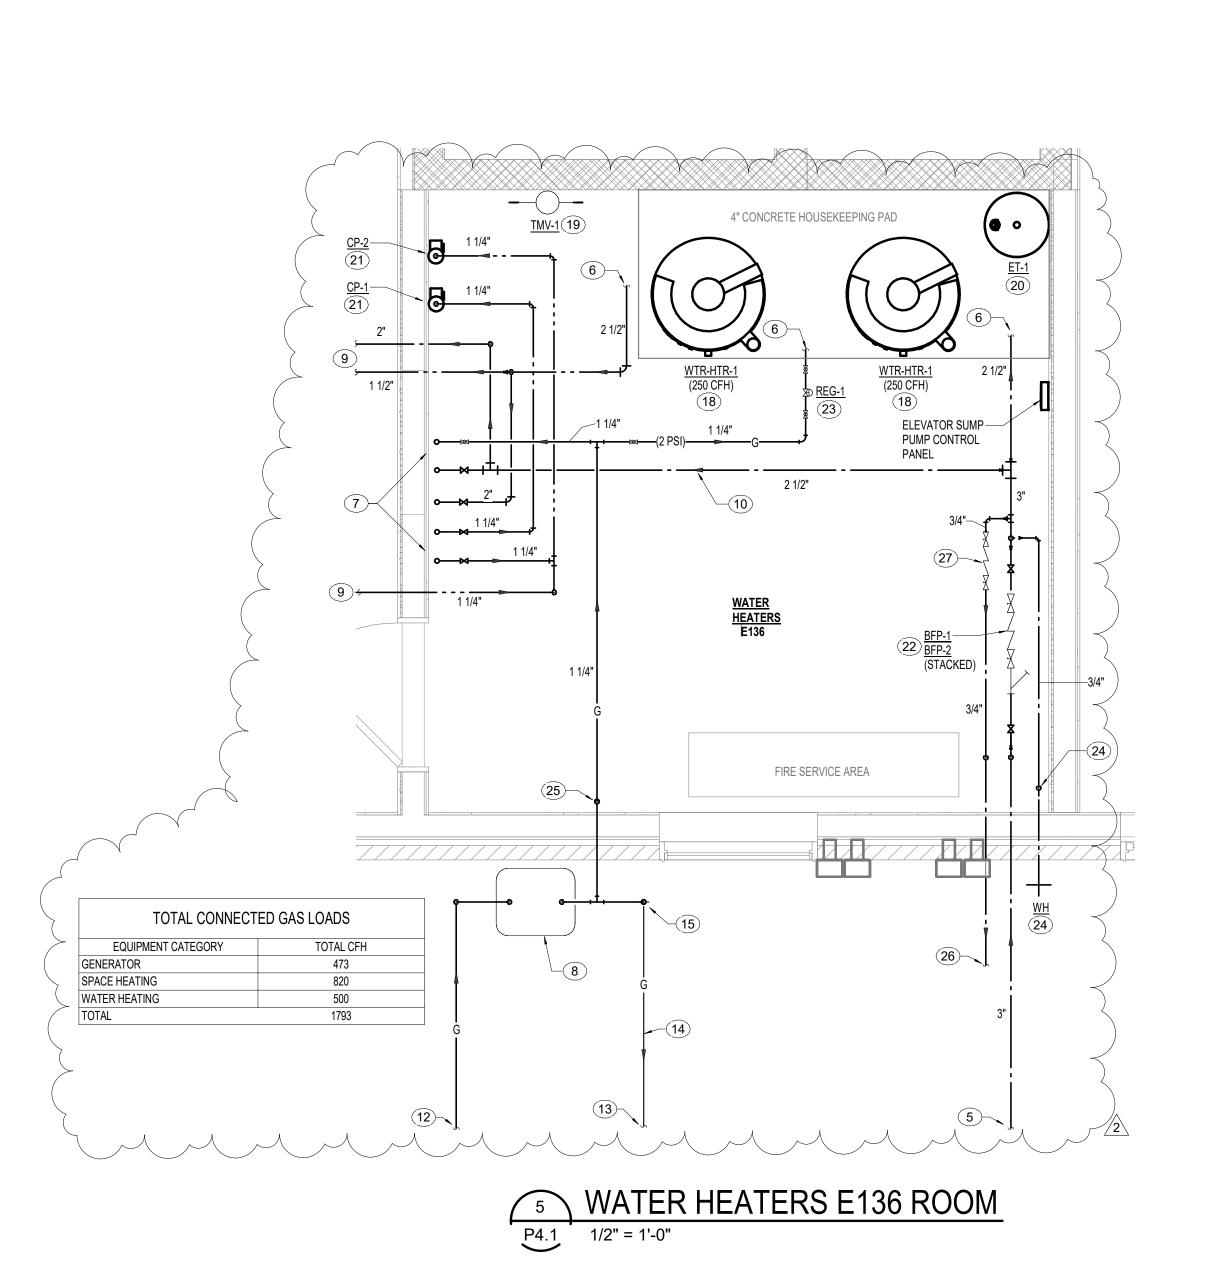

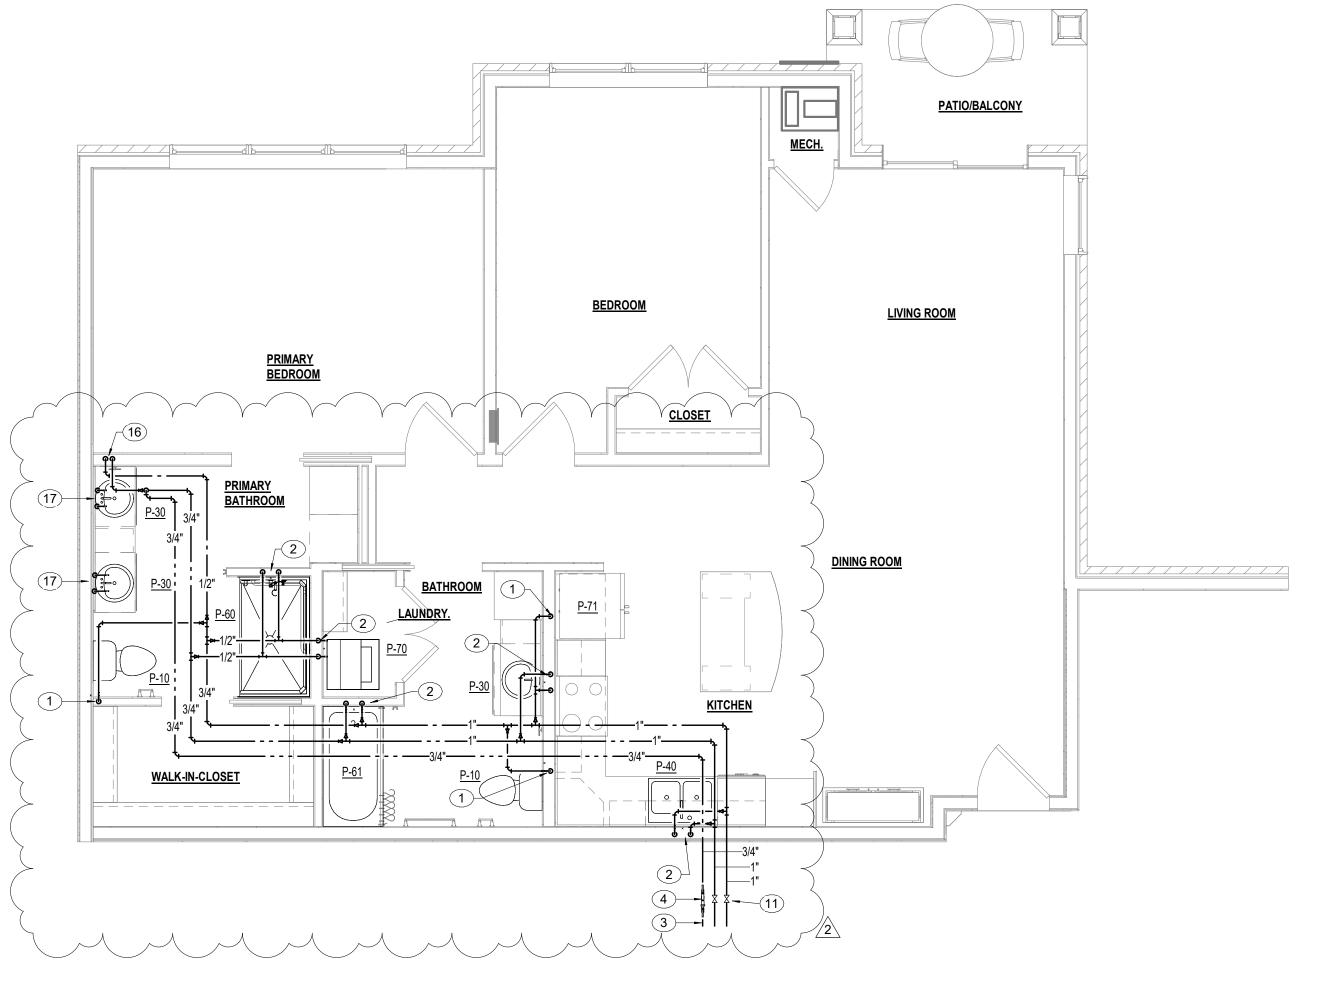

27. PROVIDE 3/4" REDUCED PRESSURE ZONE BACKFLOW PREVENTER EQUAL TO WATTS 909S WITH STRAINER AND VALVES IN CW LINE. EXTEND DRAIN LINE TO NEAREST DRAIN AND SPILL WITH CODE APPROVED AIR GAP. PROVIDE VALVE AND BLOWOUT PORT DOWNSTREAM OF BACKFLOW PREVENTER TO ALLOW FOR DRAINING OF WATER LINE TO DOG PARK.

<u>PLAN NOTES</u> (CONTINUED)

CONTINUATION OF CW LINE TO DOG PARK.

26. 3/4" CW LINE OUT TO SITE 5'-0". SEE CIVIL SITE PLANS FOR

REFER TO FLOOR PLANS FOR ORIENTATION OF UNIT PLANS. UNIT PIPING MAY BE MIRRORED AND/OR OPPOSITE HAND BASED ON THE LOCATION AND CONFIGURATION OF THE UNIT IN THE BUILDING.

PIPING ROUTED IN JOIST SPACE AND THROUGH JOISTS SHALL BE INSTALLED AND LOCATED IN ACCORDANCE WITH JOIST MANUFACTURERS

CONTRACTOR PRIOR TO ROUGH-IN. PIPING SHOWN IS SCHEMATIC AND

RECOMMENDATIONS. COORDINATE PIPE ROUTING WITH GENERAL

PLAN NOTES (

INDICATED FOR DESIGN INTENT.

**GENERAL NOTES** 

. 1/2" CW LINE DOWN TO FIXTURE AND CONNECT.

2. 1/2" CW, 1/2" HW LINES DOWN TO FIXTURE(S) AND CONNECT.

. REFER TO FLOOR PLAN FOR CONTINUATION OF CW, HW LINES AND UNIT SHUT-OFF VALVE LOCATIONS. PROVIDE HOT WATER RETURN "CIRCUIT SOLVER" ASSEMBLY IN AN

ACCESSIBLE LOCATION ABOVE LAY-IN CEILING. REFER TO DETAIL, SHEET P0.1 FOR ADDITIONAL INFORMATION. . 3" DOMESTIC WATER SERVICE. SEE CIVIL SITE PLANS FOR

. REFER TO WATER HEATER SYSTEM SCHEMATIC PIPING DIAGRAM SHEET P0.2 FOR CONTINUATION OF PIPING AND ADDITIONAL INFORMATION.

7. 1-1/4" (2 PSI) NATURAL GAS UP, 2-1/2" COLD WATER, 2" HOT WATER, 1-1/4" HOT WATER RECIRCULATION UP, AND 1-1/4" HOT WATER RECIRCULATION UP.

GAS METER, METER LOOP, PIPING VALVES, BY-PASS, VENTS REGULATORS AND ETC. AS REQUIRED BY LOCAL GAS COMPANY. PAINT ALL EXPOSED GAS PIPING AND ACCESSORIES WITH TWO COATS OF

RUST INHIBITOR TYPE PAINT. COLOR TO BE DETERMINED BY GAS COMPANY. 2 PSIG SERVICE PRESSURE.

9. REFER TO FLOOR PLANS FOR CONTINUATION OF LINES.

\_10. INDICATES FLOW DIRECTION IN PIPE (TYPICAL). 11. PROVIDE SHUT-OFF VALVES IN AN ACCESSIBLE LOCATION ABOVE LAY-IN CEILING. LOCATION OF VALVES SHOWN IS BASED ON LAY-IN CEILING

LOCATIONS. (TYPICAL FOR ALL SHUT-OFF VALVES SHOWN ON THIS SHEET, UNLESS NOTED OTHERWISE). 12. NATURAL GAS OUT TO SITE. REFER TO CIVIL ENGINEERS PLANS FOR

13. REFER TO FIRST FLOOR WATER AND GAS PLAN FOR CONTINUATION OF GAS PIPING TO GENERATOR.

14. 1" POLYETHYLENE (2 PSI) GAS LINE ROUTED BELOW GRADE. PROVIDE MINIMUM OF 24" OF COVER. PROVIDE TRACER WIRE AND WARNING TAPE IN TRENCH ABOVE PIPING. REFER TO WARNING TAPE TRACER WIRE DETAIL SHEET P0.1.

15. 1" (2 PSI) POLYETHYLENE GAS LINE UP FROM BELOW GRADE. PROVIDE ANODELESS RISER ASSEMBLY AND TERMINATE TRACER WIRE ON STEEL PIPING AS REQUIRED.

16. WHERE LAVATORIES ARE LOCATED ON AN EXTERIOR WALL. ROUTE PIPING DOWN IN INTERIOR WALL AND BELOW FLOOR/SLAB TO LAVATORIES LOCATED ON EXTERIOR WALL.

7. 1/2" CW, HW LINES UP FROM BELOW FLOOR/SLAB TO LAVATORY AND CONNECT. NO PIPING TO BE ROUTED IN EXTERIOR WALL. ROUGH-IN PIPING THROUGH BASE CABINET. 18. GAS FIRED WATER HEATER. REFER TO EQUIPMENT SCHEDULE SHEET

P0.0 AND WATER HEATER SYSTEM SCHEMATIC PIPING DIAGRAM SHEE P0.2 FOR ADDITIONAL INFORMATION. 9. THERMOSTATIC MIXING VALVE ASSEMBLY MOUNTED ON WALL 5'-0"

ABOVE FINISHED FLOOR TO CENTERLINE. REFER TO EQUIPMENT SCHEDULE SHEET P0.0 AND WATER HEATER SYSTEM SCHEMATIC PIPING DIAGRAM SHEET P0.2 FOR ADDITIONAL INFORMATION. 20. EXPANSION TANK. REFER TO EQUIPMENT SCHEDULE SHEET P0.0 AND

WATER HEATER SYSTEM SCHEMATIC PIPING DIAGRAM SHEET P0.2 FOR ADDITIONAL INFORMATION.

ABOVE FINISHED FLOOR TO CENTERLINE. REFER TO EQUIPMENT SCHEDULE SHEET P0.0, IN-LINE RECIRCULATION PUMP PIPING DIAGRAM SHEET P0.1 AND WATER HEATER SYSTEM SCHEMATIC PIPING DIAGRAM SHEET P0.2 FOR ADDITIONAL INFORMATION.

1. HOT WATER RETURN CIRCULATING PUMP MOUNTED ON WALL 4'-0"


REFER TO EQUIPMENT SCHEDULE SHEET P0.0 AND BACKFLOW

PREVENTER DETAIL SHEET P0.1 FOR ADDITIONAL INFORMATION. B. GAS PRESSURE REGULATOR STATION. REFER TO DETAIL AND SCHEDULE SHEET P0.1 FOR ADDITIONAL INFORMATION. VERIFY EXACT

24. 3/4" CW LINE DOWN TO WALL HYDRANT AND CONNECT. PROVIDE

SHUT-OFF VALVE IN LINE TO WALL HYDRANT. WALL HYDRANT TO BE USED FOR SYSTEM DRAIN AS WELL.

25. 1-1/4" (2 PSI) GAS LINE UP ON WALL. PROVIDE MAIN GAS SHUT OFF VALVE IN VERTICAL LINE 48" ABOVE FLOOR. PROVIDE SIGN AT VALVE

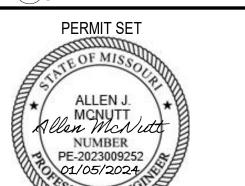

PROJECT TITLE




**COURTYARDS - BUILDING E** 

SFCS Inc. • 1927 South Tryon St. - Suite 207 Charlotte, North Carolina 28203.4633


704.372.7327 • Fax 704.372.7369 www.sfcs.com DESIGNER : DAS DRAWN : RCK ARCHITECT : DAS CHECKED : DPW/MAH


APPROVED : AJM REVISION DESCRIPTION Rev 1 - Permit Comments 02/15/24

**ENLARGED PLANS -**PLUMBING

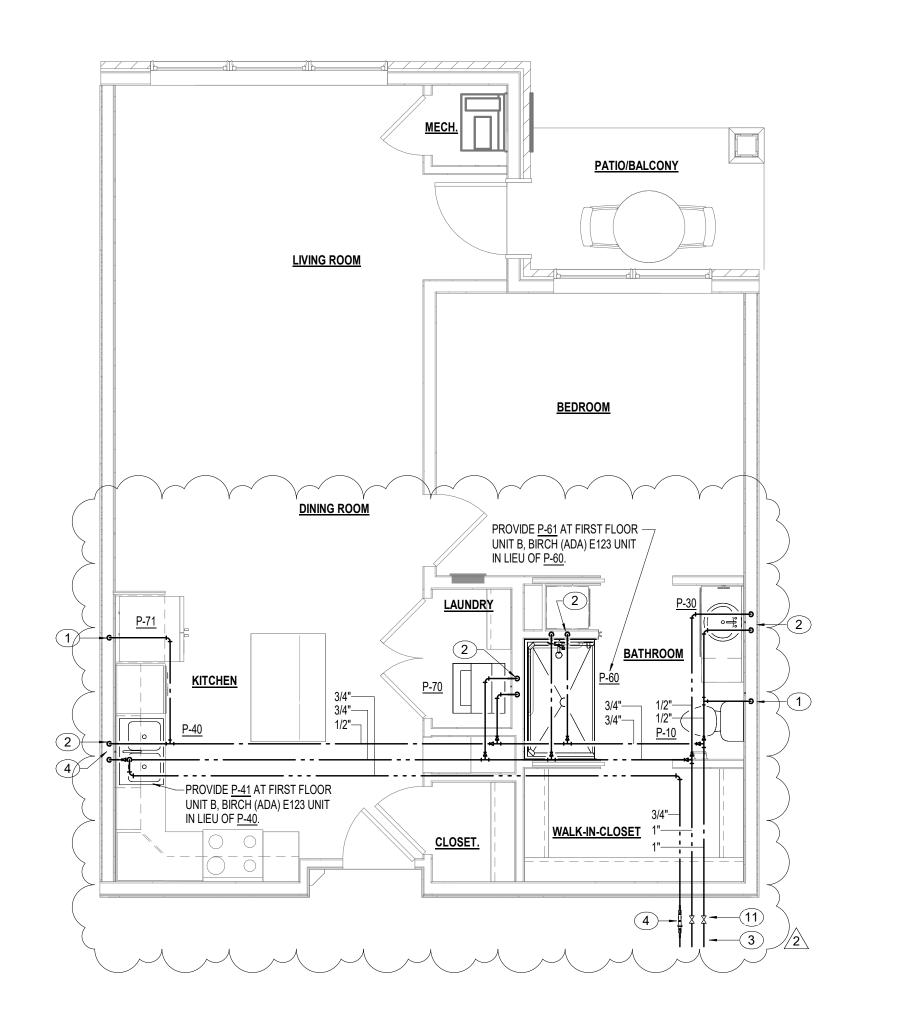


UNIT PLUMBING PLAN - HICKORY

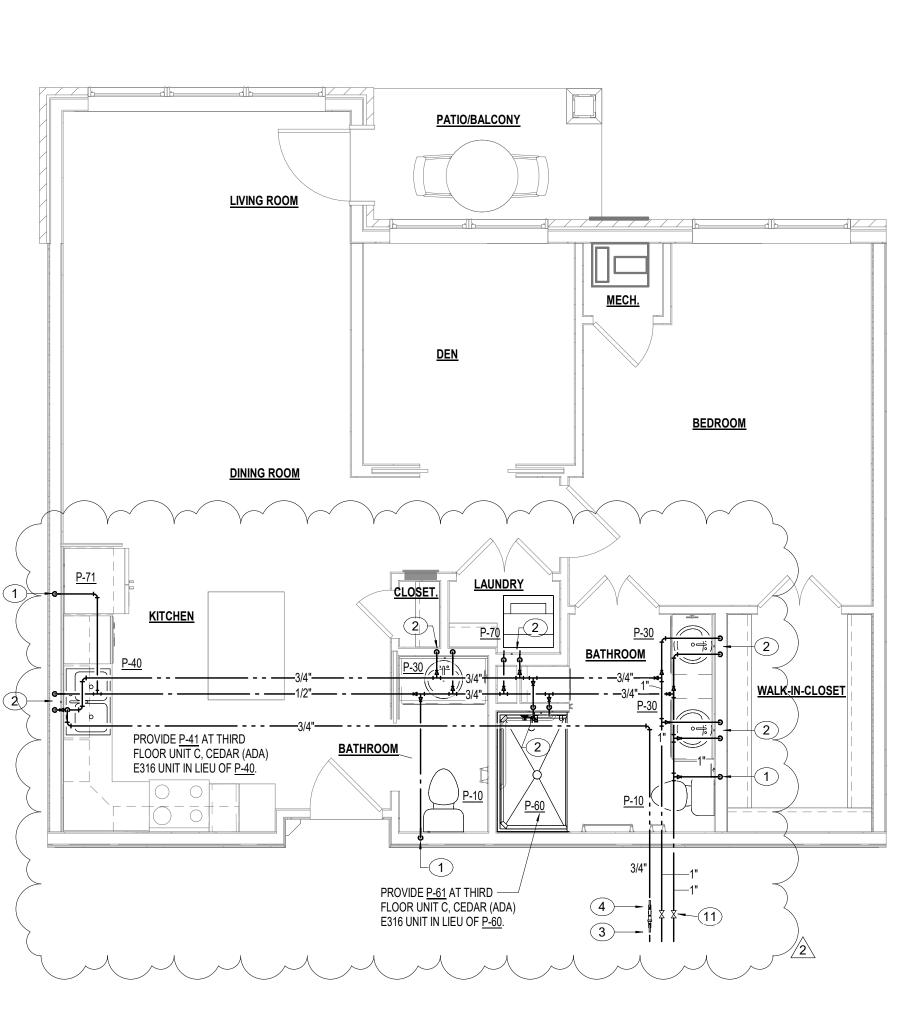


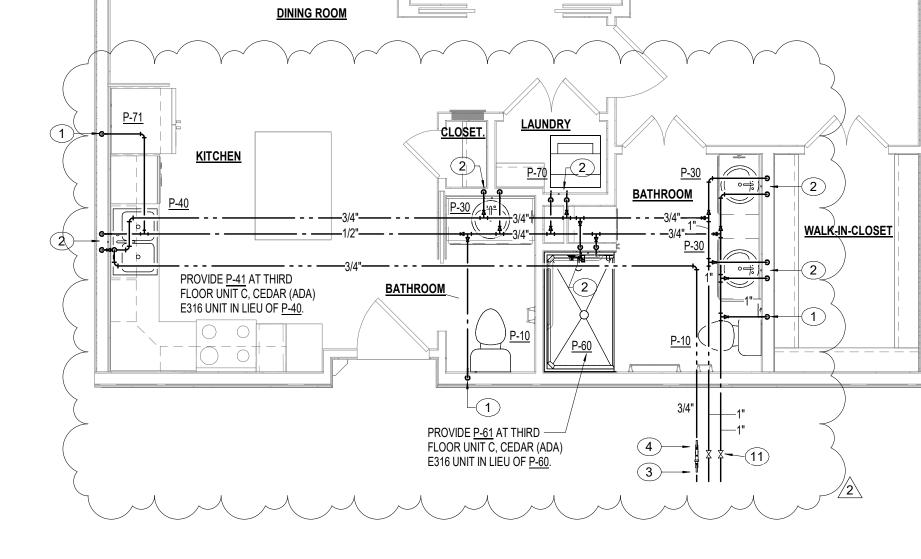





UNIT PLUMBING PLAN - BIRCH
P4.1 1/4" = 1'-0"

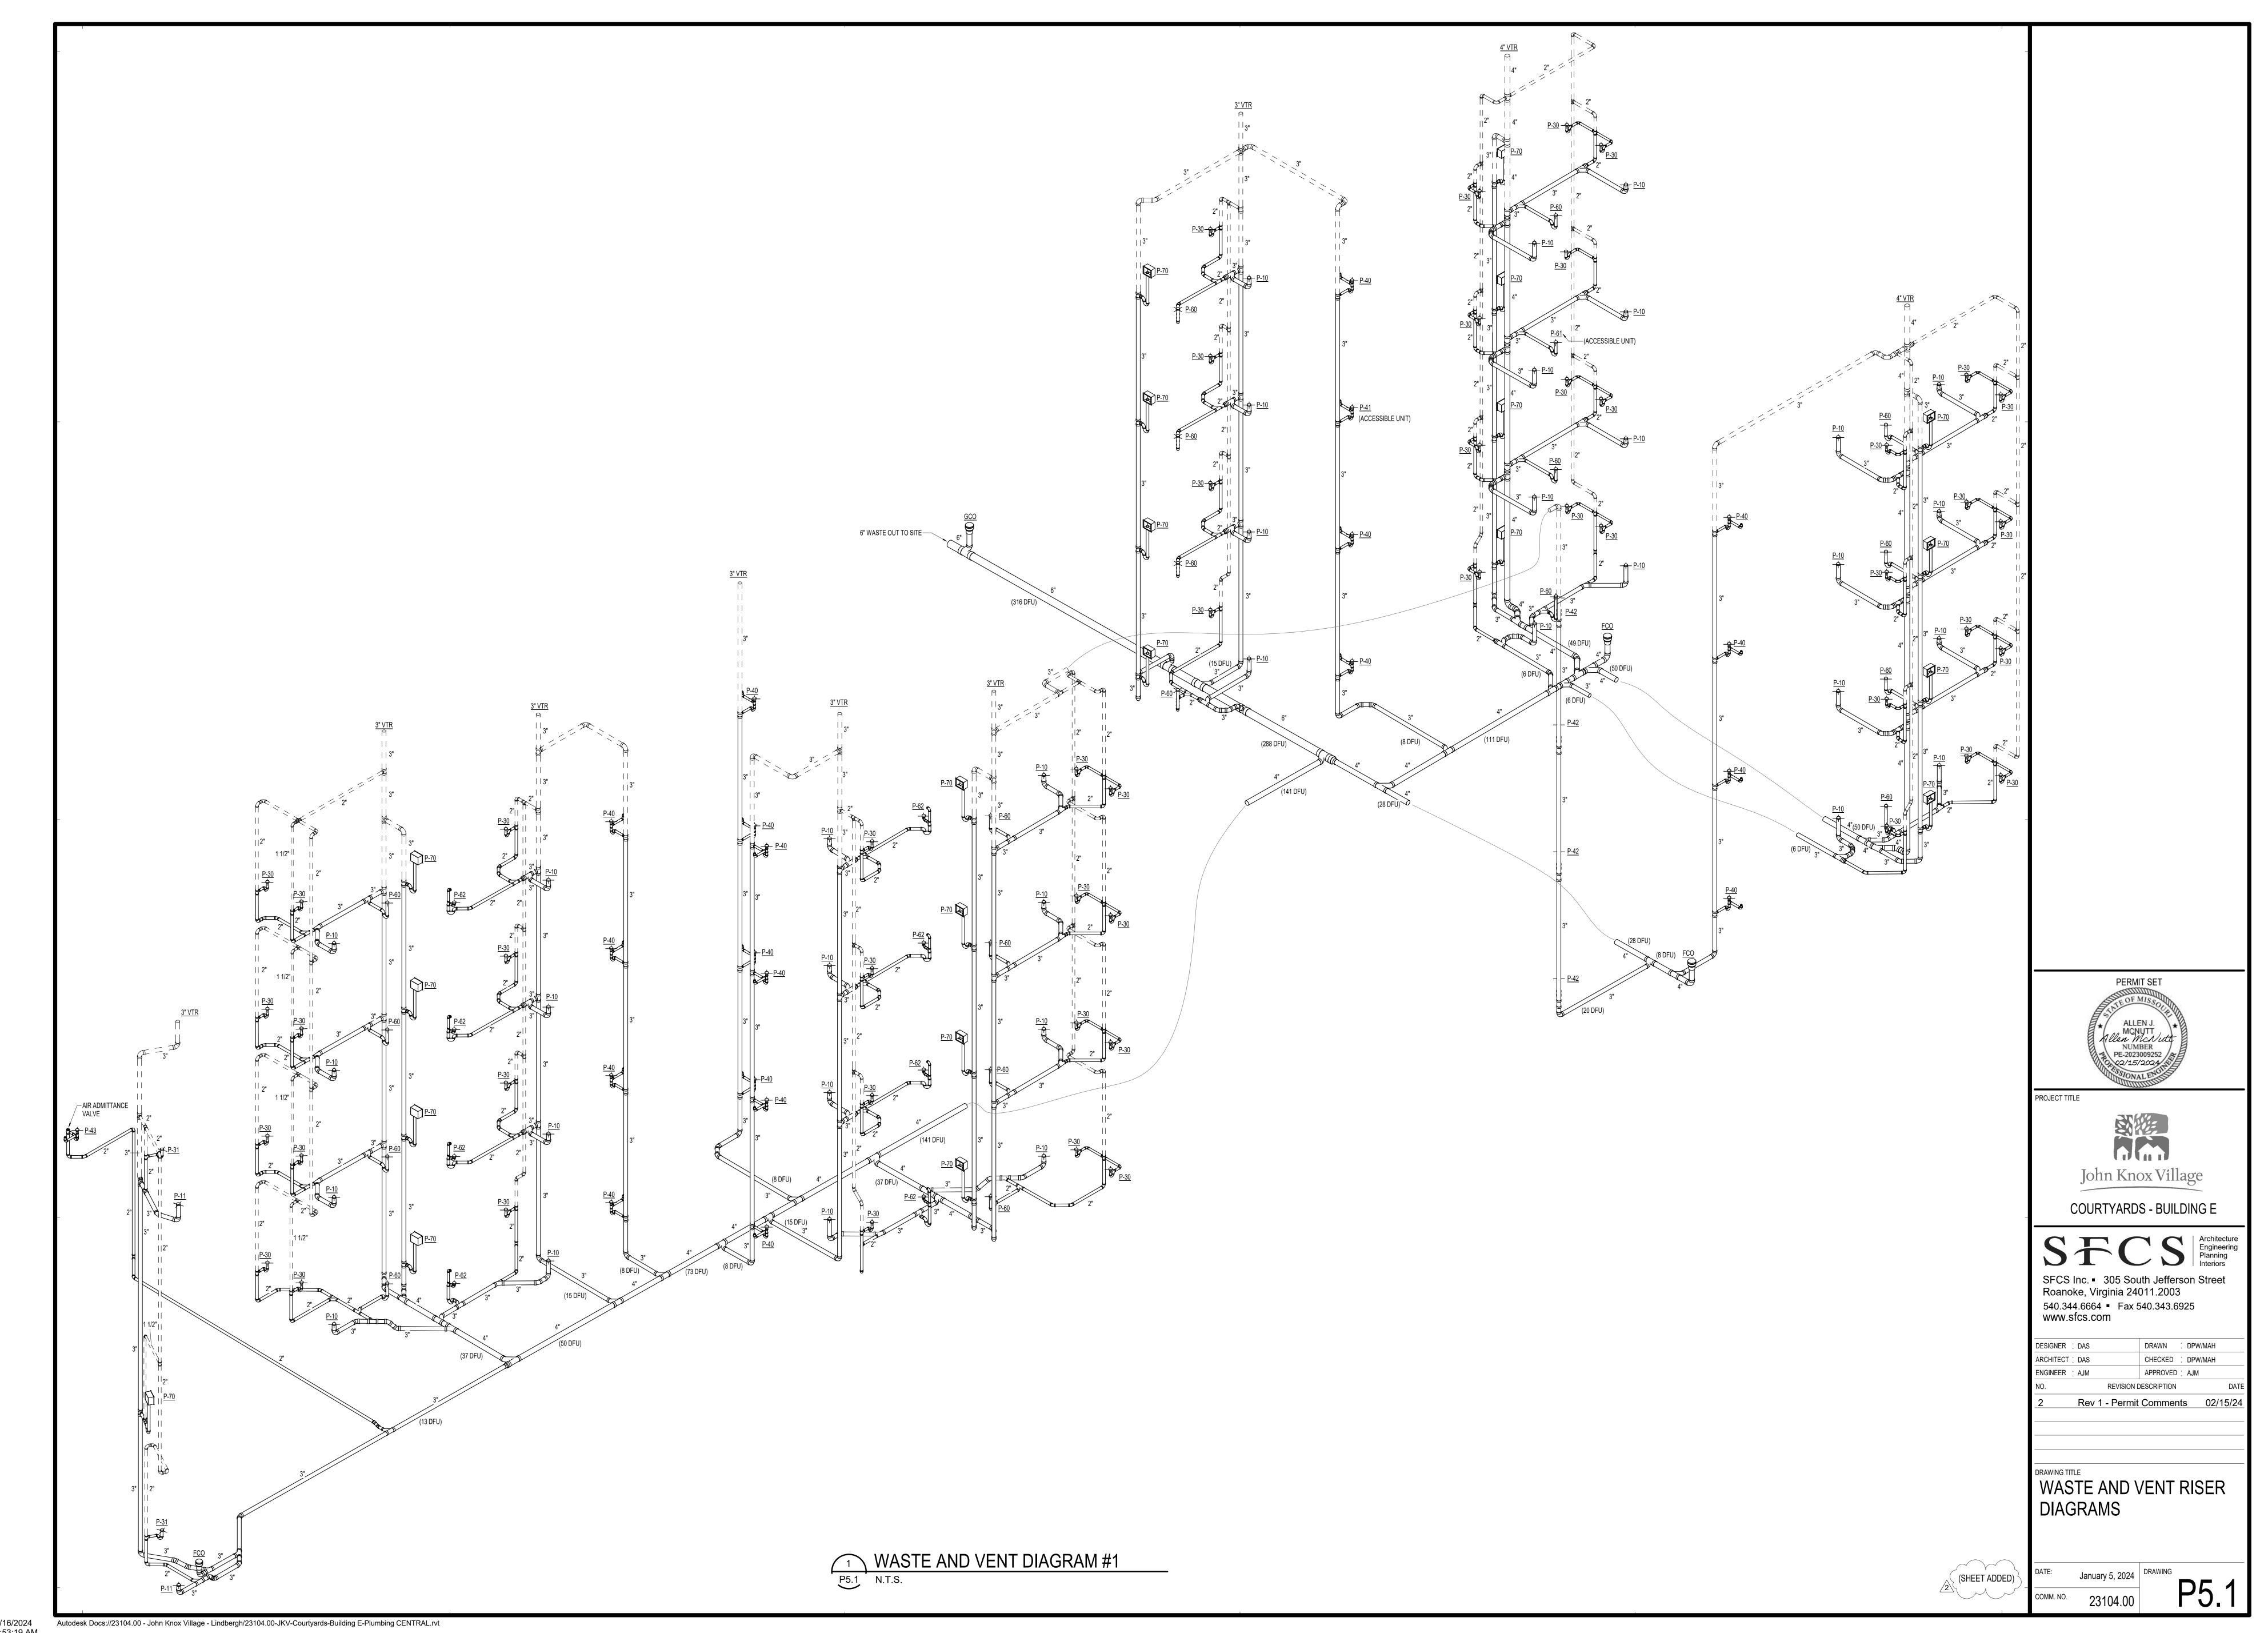

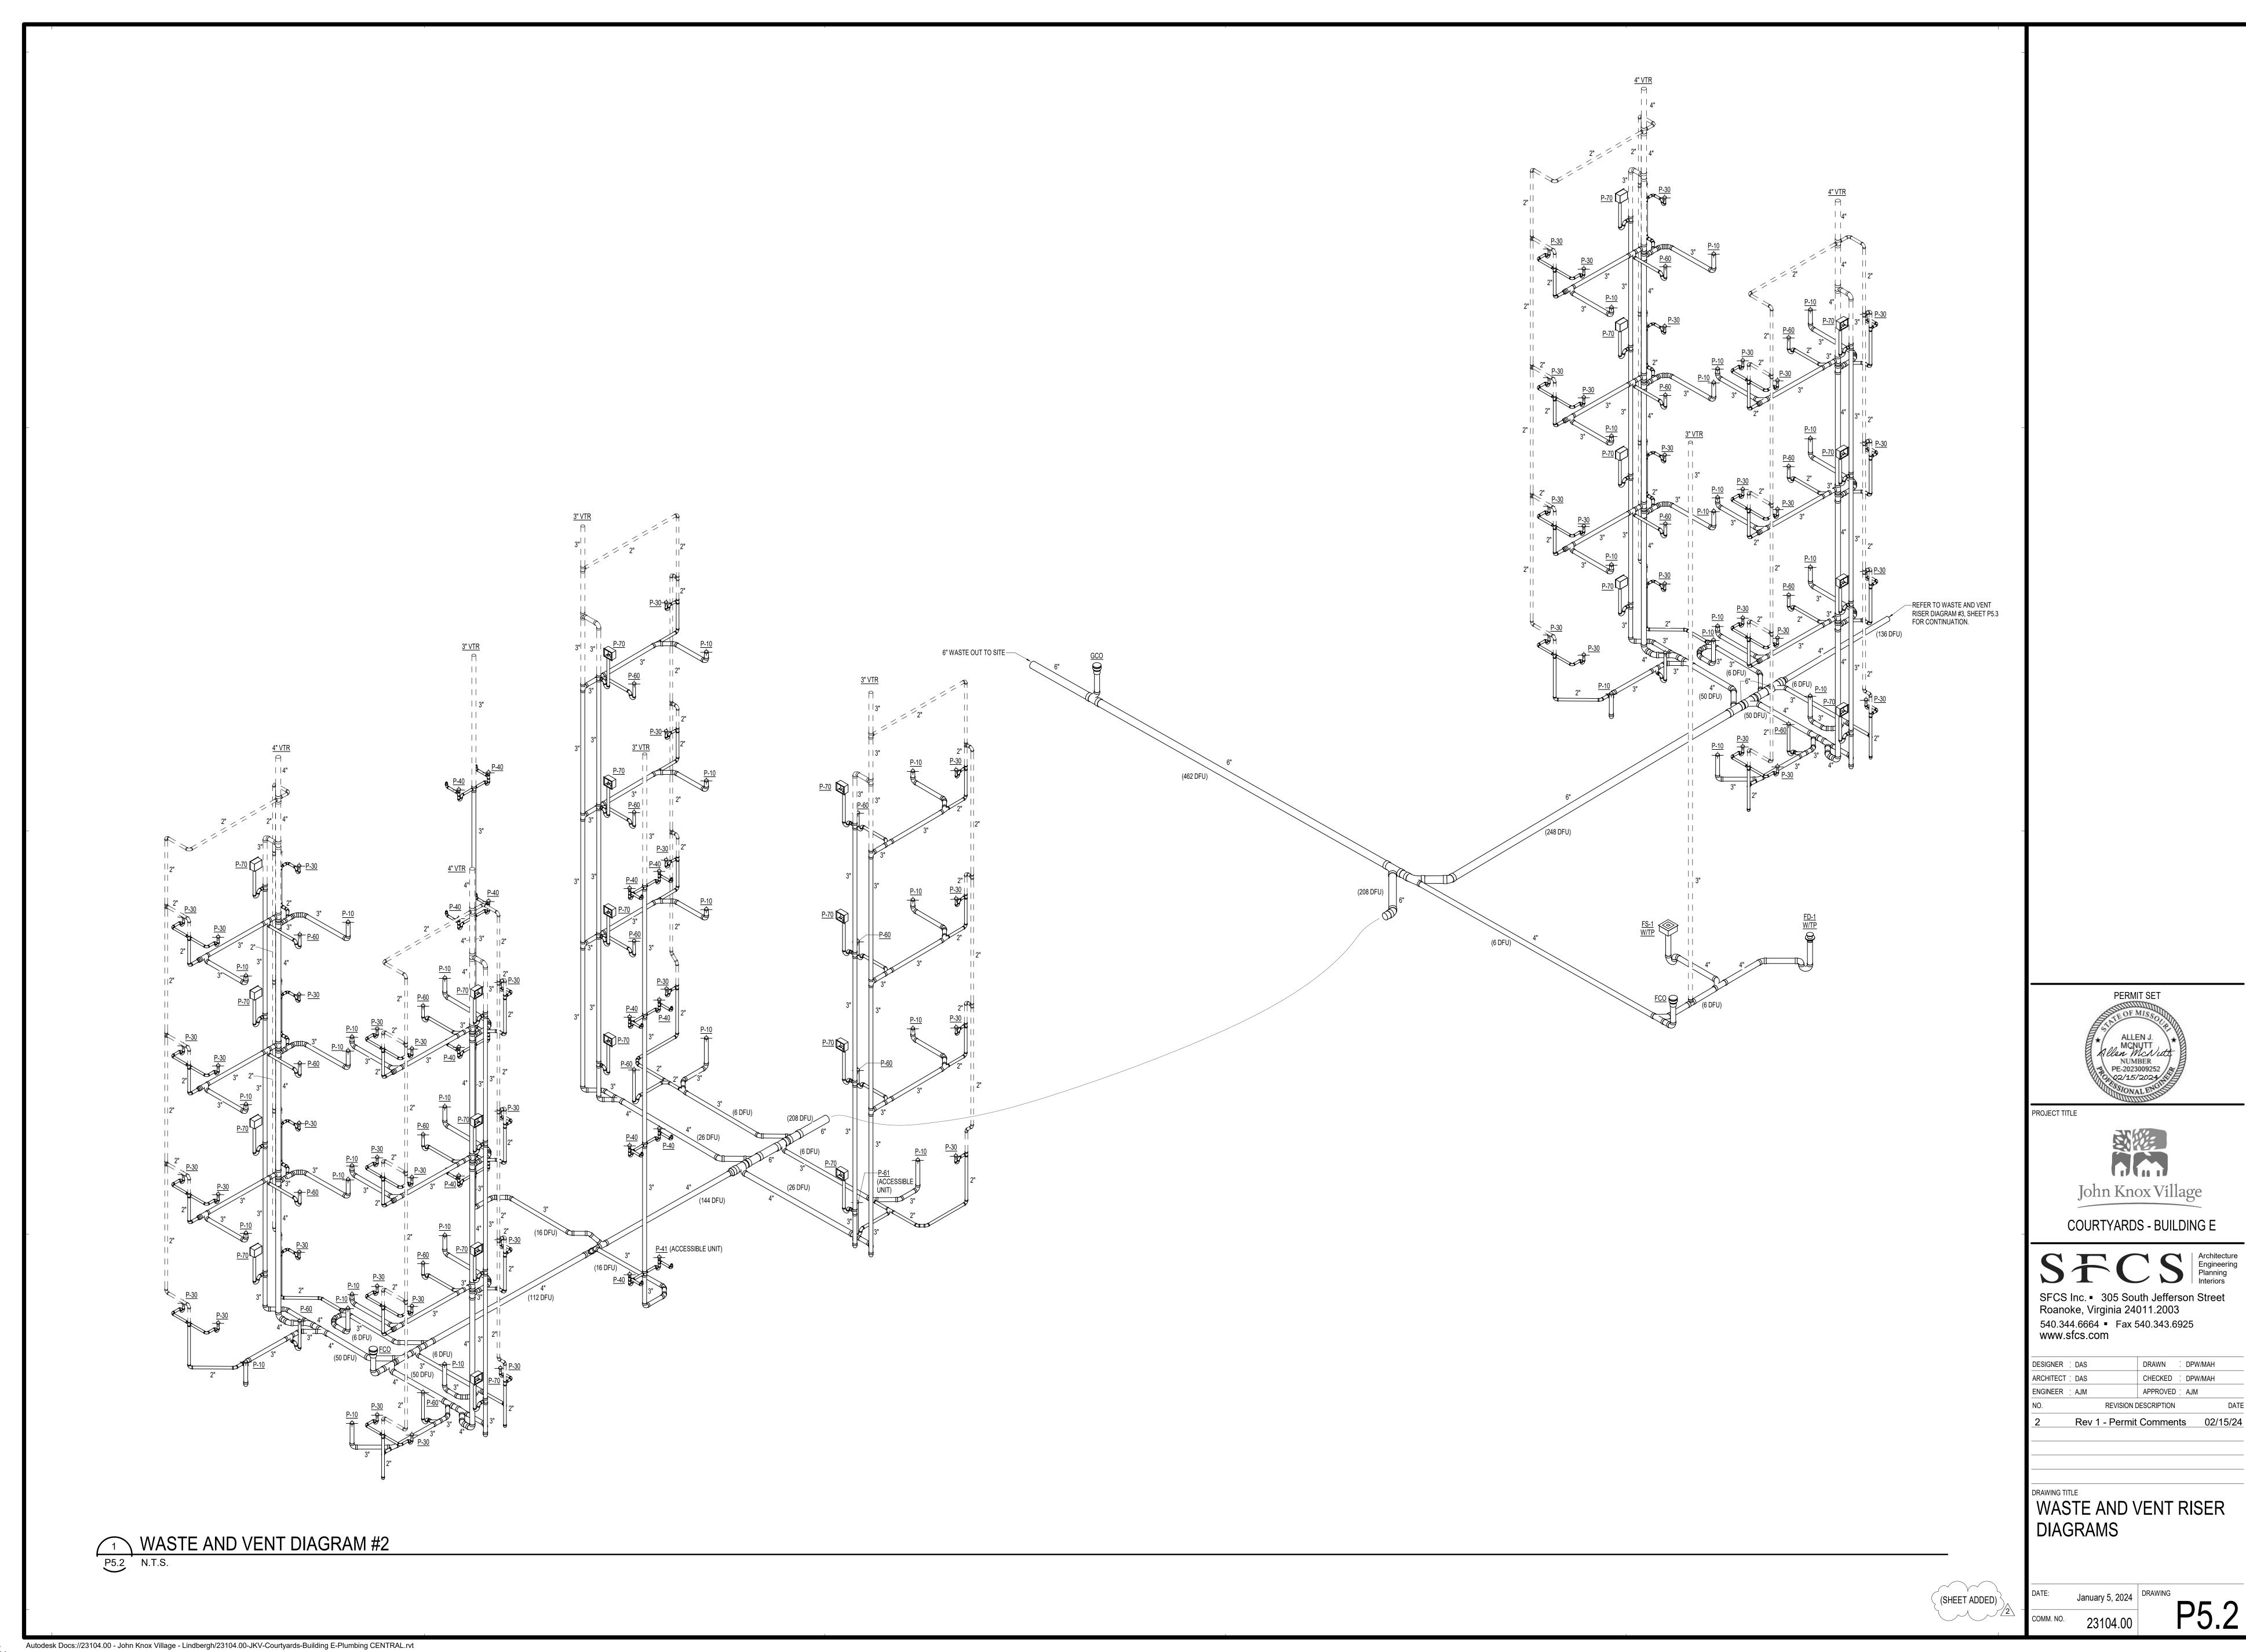

CHECKED : DPW/MAH

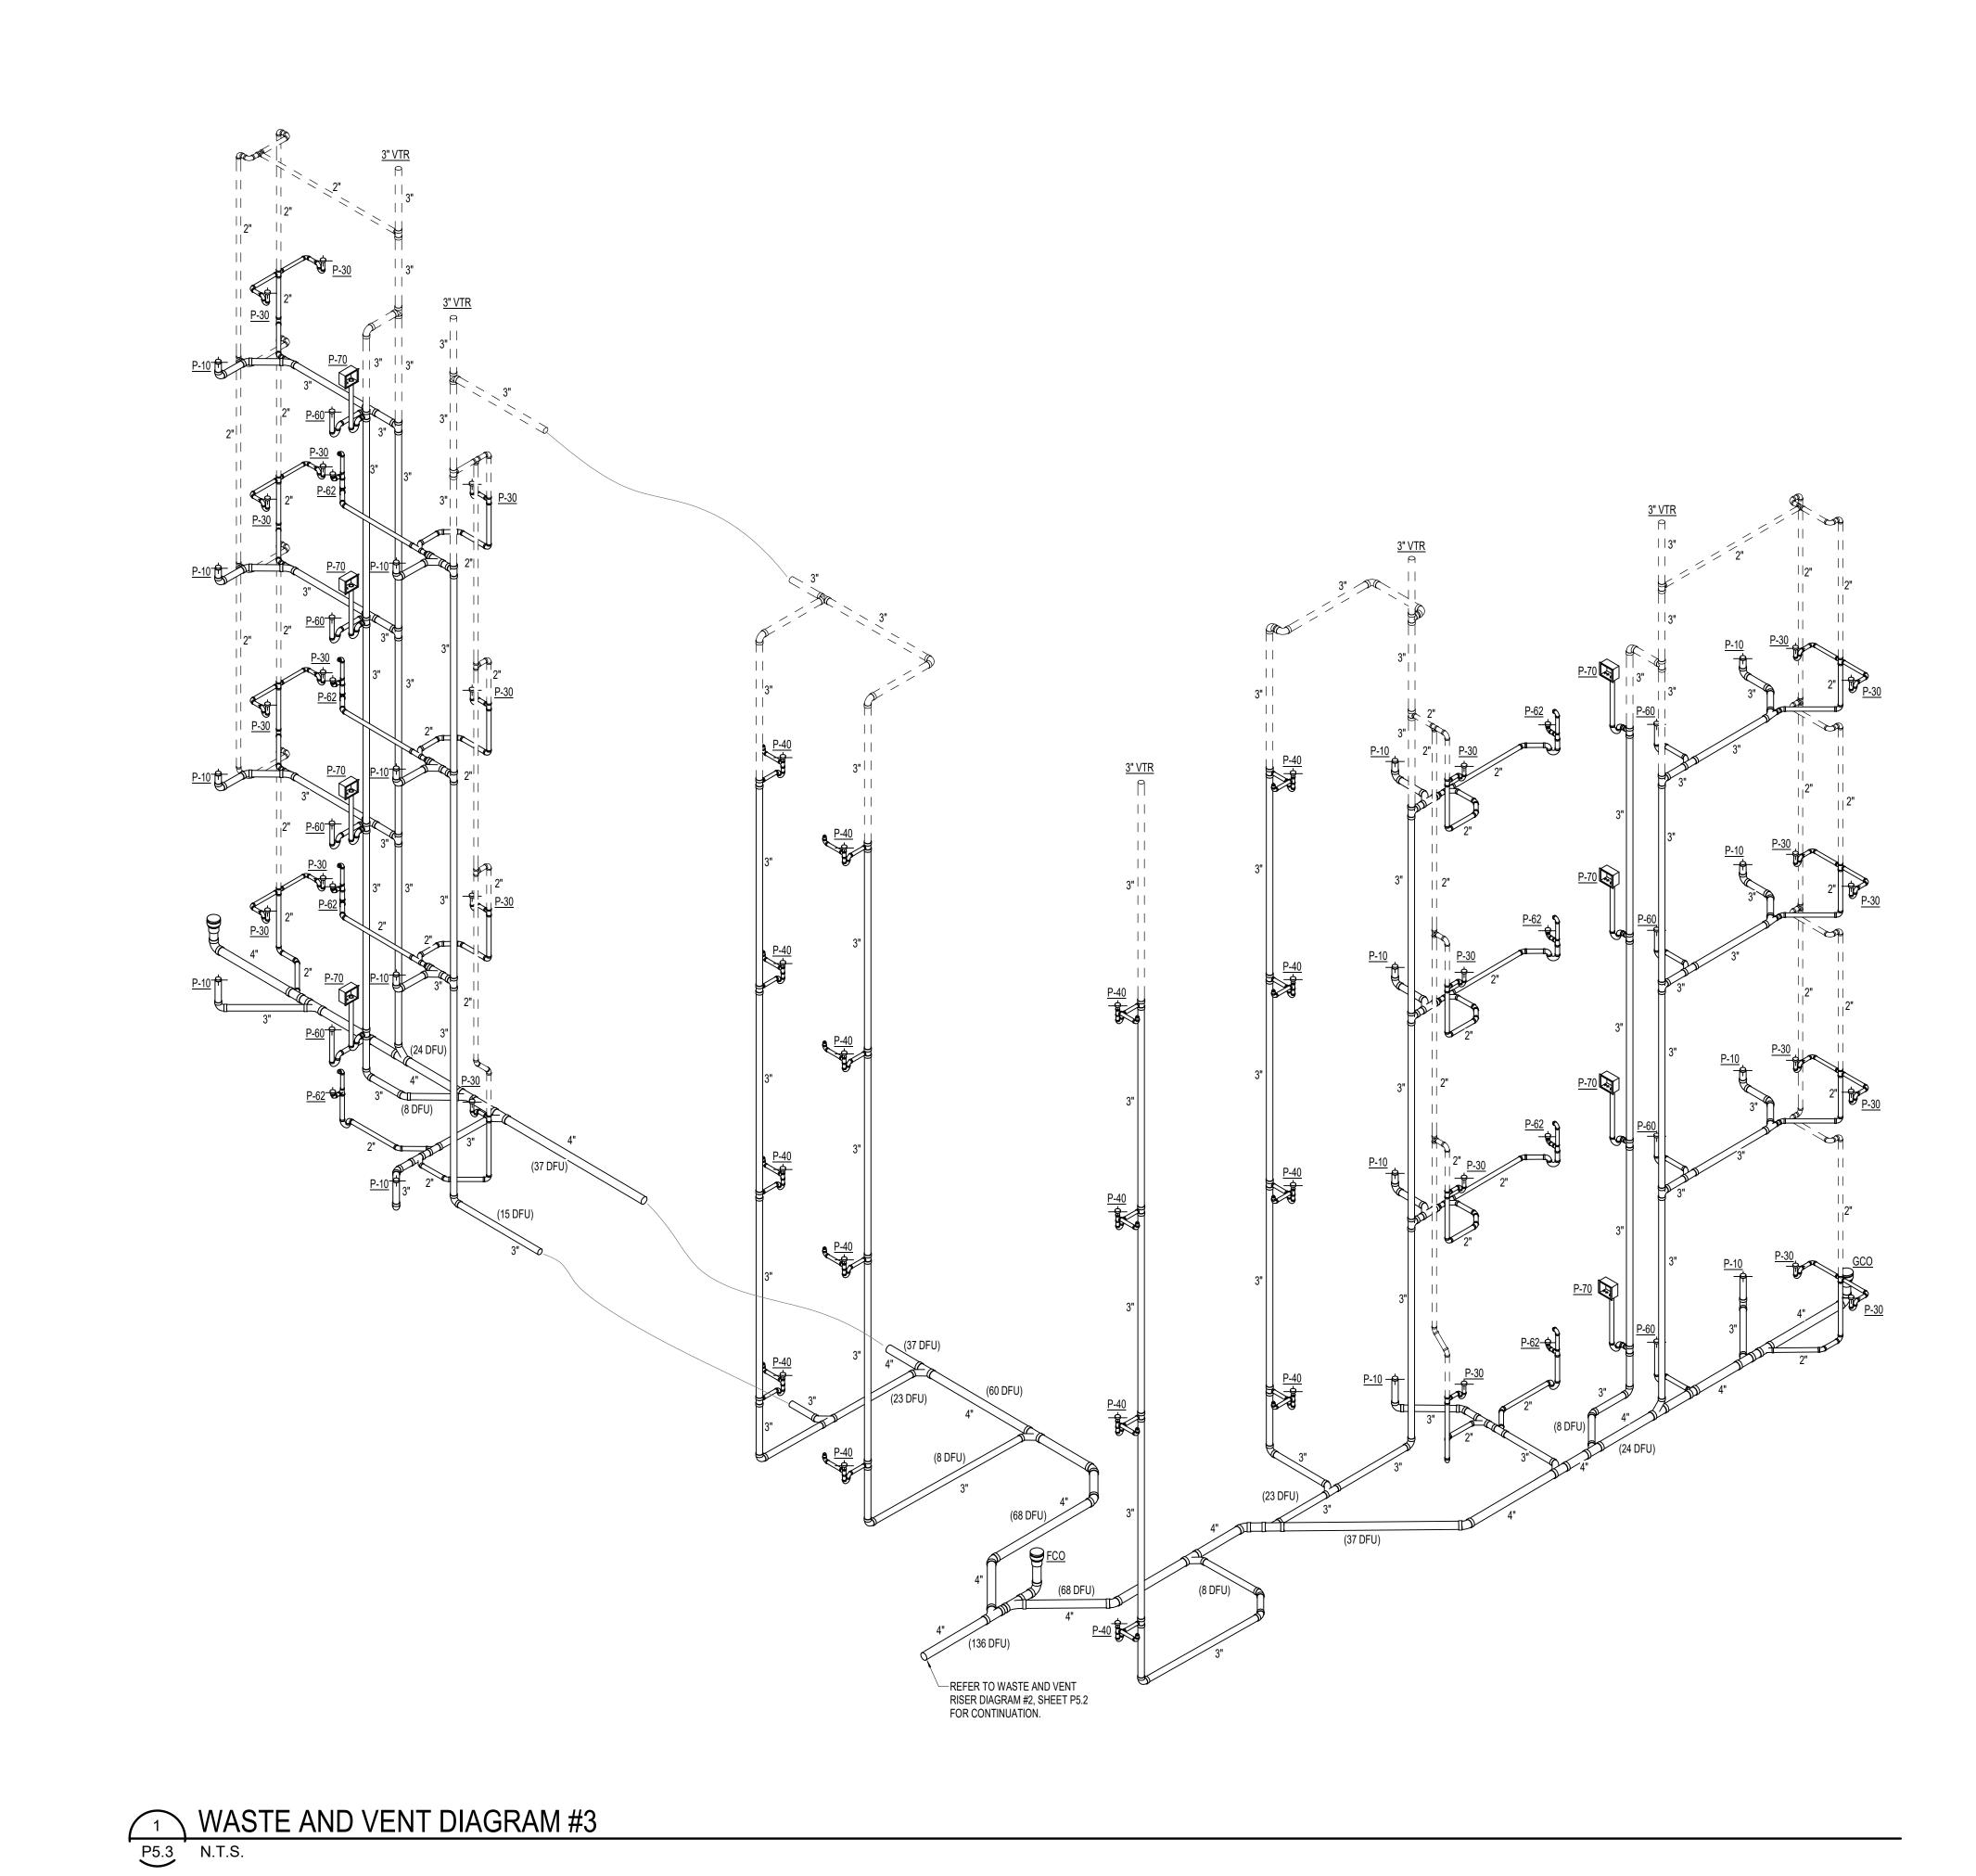

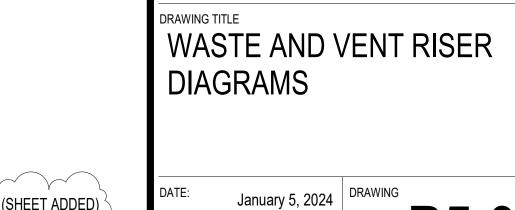

PROJECT TITLE

DESIGNER : DAS ARCHITECT : DAS

John Knox Village

COURTYARDS - BUILDING E

SFCS Inc. • 305 South Jefferson Street Roanoke, Virginia 24011.2003
540.344.6664 • Fax 540.343.6925
www.sfcs.com

REVISION DESCRIPTION

CHECKED : DPW/MAH

APPROVED : AJM

Rev 1 - Permit Comments 02/15/24

2/16/2024 9:53:28 AM

Autodesk Docs://23104.00 - John Knox Village - Lindbergh/23104.00-JKV-Courtyards-Building E-Plumbing CENTRAL.rvt

MECHANICAL & PLUMBING EQUIPMENT ELECTRICAL CONNECTION SCHEDULE

1 2P, 30A, 240V, DISCONNECT SWITCH IN NEMA 1 ENCLOSURE.

1 MANUFACTURER PROVIDED NON-FUSED DISCONNECT SWITCH.

MANUFACTURER PROVIDED NON-FUSED DISCONNECT SWITCH.

MANUFACTURER PROVIDED NON-FUSED DISCONNECT SWITCH.

MANUFACTURER PROVIDED NON-FUSED DISCONNECT SWITCH.

MANUFACTURER PROVIDED NON-FUSED DISCONNECT SWITCH. MANUFACTURER PROVIDED NON-FUSED DISCONNECT SWITCH.

MANUFACTURER PROVIDED NON-FUSED DISCONNECT SWITCH.

MANUFACTURER PROVIDED NON-FUSED DISCONNECT SWITCH.

MANUFACTURER PROVIDED NON-FUSED DISCONNECT SWITCH.

3P, 80A, 240V, DISCONNECT SWITCH IN NEMA 3R ENCLOSURE.

3P, 80A, 240V, DISCONNECT SWITCH IN NEMA 3R ENCLOSURE.

MANUFACTURER PROVIDED DISCONNECT SWITCH AND ECM

MANUFACTURER PROVIDED DISCONNECT SWITCH AND ECM

MANUFACTURER PROVIDED DISCONNECT SWITCH AND ECM

1P,,30A, 240V, DISCONNECT SWITCH IN NEMA 3R ENCLOSURE.

2P, 30A, 240V, DISCONNECT SWITCH IN NEMA 1 ENCLOSURE.

1 2P, 30A, 240V, DISCONNECT SWITCH IN NEMA 1 ENCLOSURE.

2P, 30A, 240V, DISCONNECT SWITCH IN NEMA 1 ENCLOSURE.

2P, 30A, 240V, DISCONNECT SWITCH IN NEMA 1 ENCLOSURE.

1 2P, 30A, 240V, DISCONNECT SWITCH IN NEMA 1 ENCLOSURE.

3/4" 1 JUNCTION BOX

3P, 130A, 240V, DISCONNECT SWITCH IN NEMA 3R ENCLOSURE.

12P.30A, 240V. DISCONNECT SWITCH IN NEMA 3R ENCLOSURE.

MANUFACTURER PROVIDED DISCONNECT SWITCH. MANUFACTURER PROVIDED DISCONNECT SWITCH.

3/4" 1 2P, 30A, 240V, DISCONNECT SWITCH IN NEMA 1 ENCLOSURE.

3/4" 1 MANUFACTURER PROVIDED NON-FUSED DISCONNECT SWITCH.

3/4" 1 MANUFACTURER PROVIDED NON-FUSED DISCONNECT SWITCH.

Disconnect

Panel Circuit Number Rating

32,34,36

LC-D3

20 A VERIFY LOCATION AND CONNECTION REQUIREMENTS PRIOR TO ROUGH-IN.

20 A VERIFY LOCATION AND CONNECTION REQUIREMENTS PRIOR TO ROUGH-IN.

OWN LC-D2 LOAD CENTERS SHOWN ON ENLARGED UNIT PLANS. VE

OWN LC-D3 LOAD CENTERS SHOWN ON ENLARGED UNIT PLANS. VE 20 A VERIFY LOCATION AND CONNECTION REQUIREMENTS PRIOR TO ROUGH-IN.

20 A VERIFY LOCATION AND CONNECTION REQUIREMENTS PRIOR TO ROUGH-IN.

20 A VERIFY LOCATION AND CONNECTION REQUIREMENTS PRIOR TO ROUGH-IN.

90 A VERIFY LOCATION AND CONNECTION REQUIREMENTS PRIOR TO ROUGH-IN.

90 A VERIFY LOCATION AND CONNECTION REQUIREMENTS PRIOR TO ROUGH-IN.

30 A VERIFY LOCATION AND CONNECTION REQUIREMENTS PRIOR TO ROUGH-IN 30 A VERIFY LOCATION AND CONNECTION REQUIREMENTS PRIOR TO ROUGH-IN

30 A VERIFY LOCATION AND CONNECTION REQUIREMENTS PRIOR TO ROUGH-IN

20 A VERIFY LOCATION AND CONNECTION REQUIREMENTS PRIOR TO ROUGH-IN.

20 A VERIFY LOCATION AND CONNECTION REQUIREMENTS PRIOR TO ROUGH-IN.

LC-D3 LOAD CENTERS SHOWN ON ENLARGED UNIT PLANS. VE

20 A VERIFY LOCATION AND CONNECTION REQUIREMENTS PRIOR TO ROUGH-IN.

20 A VERIFY LOCATION AND CONNECTION REQUIREMENTS PRIOR TO ROUGH-IN.

UNIT PLANS. VERIFY LOCATION AND CONNECTION REQUIREMENTS PRIOR TO ROUGH-IN.

ALL FED FROM THEIR OWN LC-D1 LOAD CENTERS SHOWN ON ENLARGED UNIT PLANS. VERIFY LOCATION AND CONNECTI

UNIT PLANS. VERIFY LOCATION AND CONNECTION REQUIREMENTS PRIOR TO ROUGH-IN.

E435 ALL FED FROM THEIR OWN LC-D1 LOAD CENTERS SHOWN ON ENLARGED UNIT PLANS. VERIFY LOCATION AND CONN

20 A THIS EXHAUST FAN IS CIRCUITED TO UNIT TYPE B THIS INFORMATION IS TYPICAL FOR THE EF-1 SERVING DWELLING UNITS #E114, E123, E124, E214, E223, E224, E314, E323.

20 A THIS EXHAUST FAN IS CIRCUITED TO UNIT TYPE C THIS INFORMATION IS TYPICAL FOR THE EF-1 SERVING DWELLING UNITS #E116, E119, E121, E122, E132, E132, E133, E216, E219,

20 A THIS EXHAUST FAN IS CIRCUITED TO UNIT TYPE D1 THIS INFORMATION IS TYPICAL FOR THE EF-1 SERVING DWELLING UNITS #E134, E135, E234, E235, E334, E335, E434 &

20 A THIS EXHAUST FAN IS CIRCUITED TO UNIT TYPE D2 THIS INFORMATION IS TYPICAL FOR THE EF-1 SERVING DWELLING UNITS #E111, E211, E311, E411 ALL FED FROM THEIR

20 A THIS EXHAUST FAN IS CIRCUITED TO UNIT TYPE D3 THIS INFORMATION IS TYPICAL FOR THE EF-1 SERVING DWELLING UNITS #E112, E212, E312, E412 ALL FED FROM THEIR

1107 A VERIFY LOCATION AND CONNECTION REQUIREMENTS PRIOR TO ROUGHIN.

40 A THIS PTAC IS CIRCUITED TO UNIT TYPE B THIS INFORMATION IS TYPICAL FOR THE VPTAC-1 SERVING DWELLING UNITS #E114, E123, E124, E214, E223, E224, E314, E323,

40 A THIS PTAC IS CIRCUITED TO UNIT TYPE C THIS INFORMATION IS TYPICAL FOR THE VPTAC-2 SERVING DWELLING UNITS #E116, E119, E121, E122, E132, E133, E216, E219,

50 A THIS PTAC IS CIRCUITED TO UNIT TYPE D1 THIS INFORMATION IS TYPICAL FOR THE VPTAC-3 SERVING DWELLING UNITS #E134, E135, E234, E235, E334, E335, E434 & E435

50 A THIS PTAC IS CIRCUITED TO UNIT TYPE D2 THIS INFORMATION IS TYPICAL FOR THE VPTAC-3 SERVING DWELLING UNITS #E111, E211, E311 & E411 ALL FED FROM THEIR

50 A THIS PTAC IS CIRCUITED TO UNIT TYPE D3 THIS INFORMATION IS TYPICAL FOR THE VPTAC-3 SERVING DWELLING UNITS #E112, E212, E312, E412 ALL FED FROM THEIR OWN

OWN LC-D2 LOAD CENTERS SHOWN ON ENLARGED UNIT PLANS. VERIFY LOCATION AND CONNECTION REQUIREMENTS PRIOR TO ROUGH-IN.

E324, E414, E423 & E424 ALL FED FROM THEIR OWN LC-B LOAD CENTERS SHOWN ON ENLARGED UNIT PLANS. VERIFY LOCATION AND CONNECTION REQUIREMENTS PRIOR

E221, E222, E232, E233, E316, E319, E321, E322, E332, E333, E416, E419, E421, E422, E432 & E433 ALL FED FROM THEIR OWN LC-C LOAD CENTERS SHOWN ON ENLARGED

E221, E222, E232, E233, E316, E319, E321, E322, E332, E333, E416, E419, E421, E422, E432 & E433 ALL FED FROM THEIR OWN LC-C LOAD CENTERS SHOWN ON ENLARGED

E324, E414, E423 & E424 ALL FED FROM THEIR OWN LC-B LOAD CENTERS SHOWN ON ENLARGED UNIT PLANS. VERIFY LOCATION AND CONNECTION REQUIREMENTS PRIOR

	PERMIT SET  OF  NUMBER E-25237  1/5/2024
PROJECT TITLE	
	Shire

John Knox Village

COURTYARDS - BUILDING E

SFCS Inc. • 1927 South Tryon St. - Suite 207 Charlotte, North Carolina 28203.4633

704.372.7327 • Fax 704.372.7369 www.sfcs.com DESIGNER : DAS CHECKED : MAW

ARCHITECT : DAS APPROVED ; JSK REVISION DESCRIPTION Rev 1 - Permit Comments

MECHANICAL & PLUMBING

EQUIPMENT ELECTRICAL CONNECTION SCHEDULE

Autodesk Docs://23104.00 - John Knox Village - Lindbergh/23104.00-JKV-Courtyards-Building E-Electrical & Low Voltage CENTRAL.rvt

Load Name

EF-1 (UNIT B)

EF-1 (UNIT C)

EF-1 (UNIT D1)

EF-1 (UNIT D2)

EF-1 (UNIT D3)

EF-2 (RES. CLOSET #E302)

EF-2 (RES. CLOSET #E402)

F-2 (ATRIUM ROOF)

VPTAC-1 (UNIT B)

VPTAC-2 (UNIT C)

VPTAC-3 (UNIT D1)

VPTAC-3 (UNIT D2)

VPTAC-3 (UNIT D3)

WTR-HTR-1 (CONTROLS)

WTR-HTR-2 (CONTROLS)

EWH-1 (STAIRWELL #1, 4TH FLOOR)

EWH-1 (STAIRWELL #1, 1ST FLOOR)

EWH-1 (STAIRWELL #2, 4TH FLOOR)

EWH-1 (STAIRWELL #2, 1ST FLOOR)

Munument of the second of the

CIRCULATION PUMP

CIRCULATION PUMP

EXHAUST FAN

ELECTRIC WALL HEATER

ELECTRIC WALL HEATER

ELECTRIC WALL HEATER

ELECTRIC WALL HEATER

ROOF TOP UNIT (DX COOLING & NAT GAS HEAT

ROOF TOP UNIT (DX COOLING & NAT GAS HEAT

VERTICAL PACKAGED TERMINAL AIR CONDITIONER UNITS (THRU WALL)

PRTU-3 ROOF TOP UNIT (DX COOLING & MAT GAS HEAT )

SMOKE EVACUATION EXHAUST FAN

SMOKE EVACUATION EXHAUST FAN

SMOKE EVACUATION EXHAUST FAN

THERMOSTATIC MIXING VALVE

WATER HEATER

WATER HEATER

Description

SUMP PUMP 1176 VA 120 V

Load (VA) Voltage Poles

2 2-#12, 1-#12, 1-#12

1-#12, 1-#12, 1-#12

1-#12, 1-#12, 1-#12

2-#12, 1-#12, 1-#12

2-#10, 1-#10, 1-#10

2-#10, 1-#10, 1-#10

2-#10, 1-#10, 1-#10

1-#10, 1-#10, 1-#10

1-#12, 1-#12, 1-#12

3-#3, 1-#3, 1-#8

3-#8, 1-#8, 1-#8

3-#8, 1-#8, 1-#8

3-#10, 1-#10, 1-#10

1-#8,1-#8,1-#8,

2-#8, 1-#8, 1-#10

2-#6, 1-#6, 1-#10

208 V 2 2-#6, 1-#6, 1-#10

208 V 2 2-#6, 1-#6, 1-#10

7280 VA 208 V 2 2-#8, 1-#8, 1-#10

600 VA 120 V 1 1-#12, 1-#12, 1-#12 600 VA 120 V 1 1-#12, 1-#12, 1-#12

1123 VA

160 VA

528 VA

528 VA

3000 VA

3000 VA

3000 VA

700 VA


25560 VA


6012 VA


6012 VA

240 VA 7280 VA


29880 VA 208 V

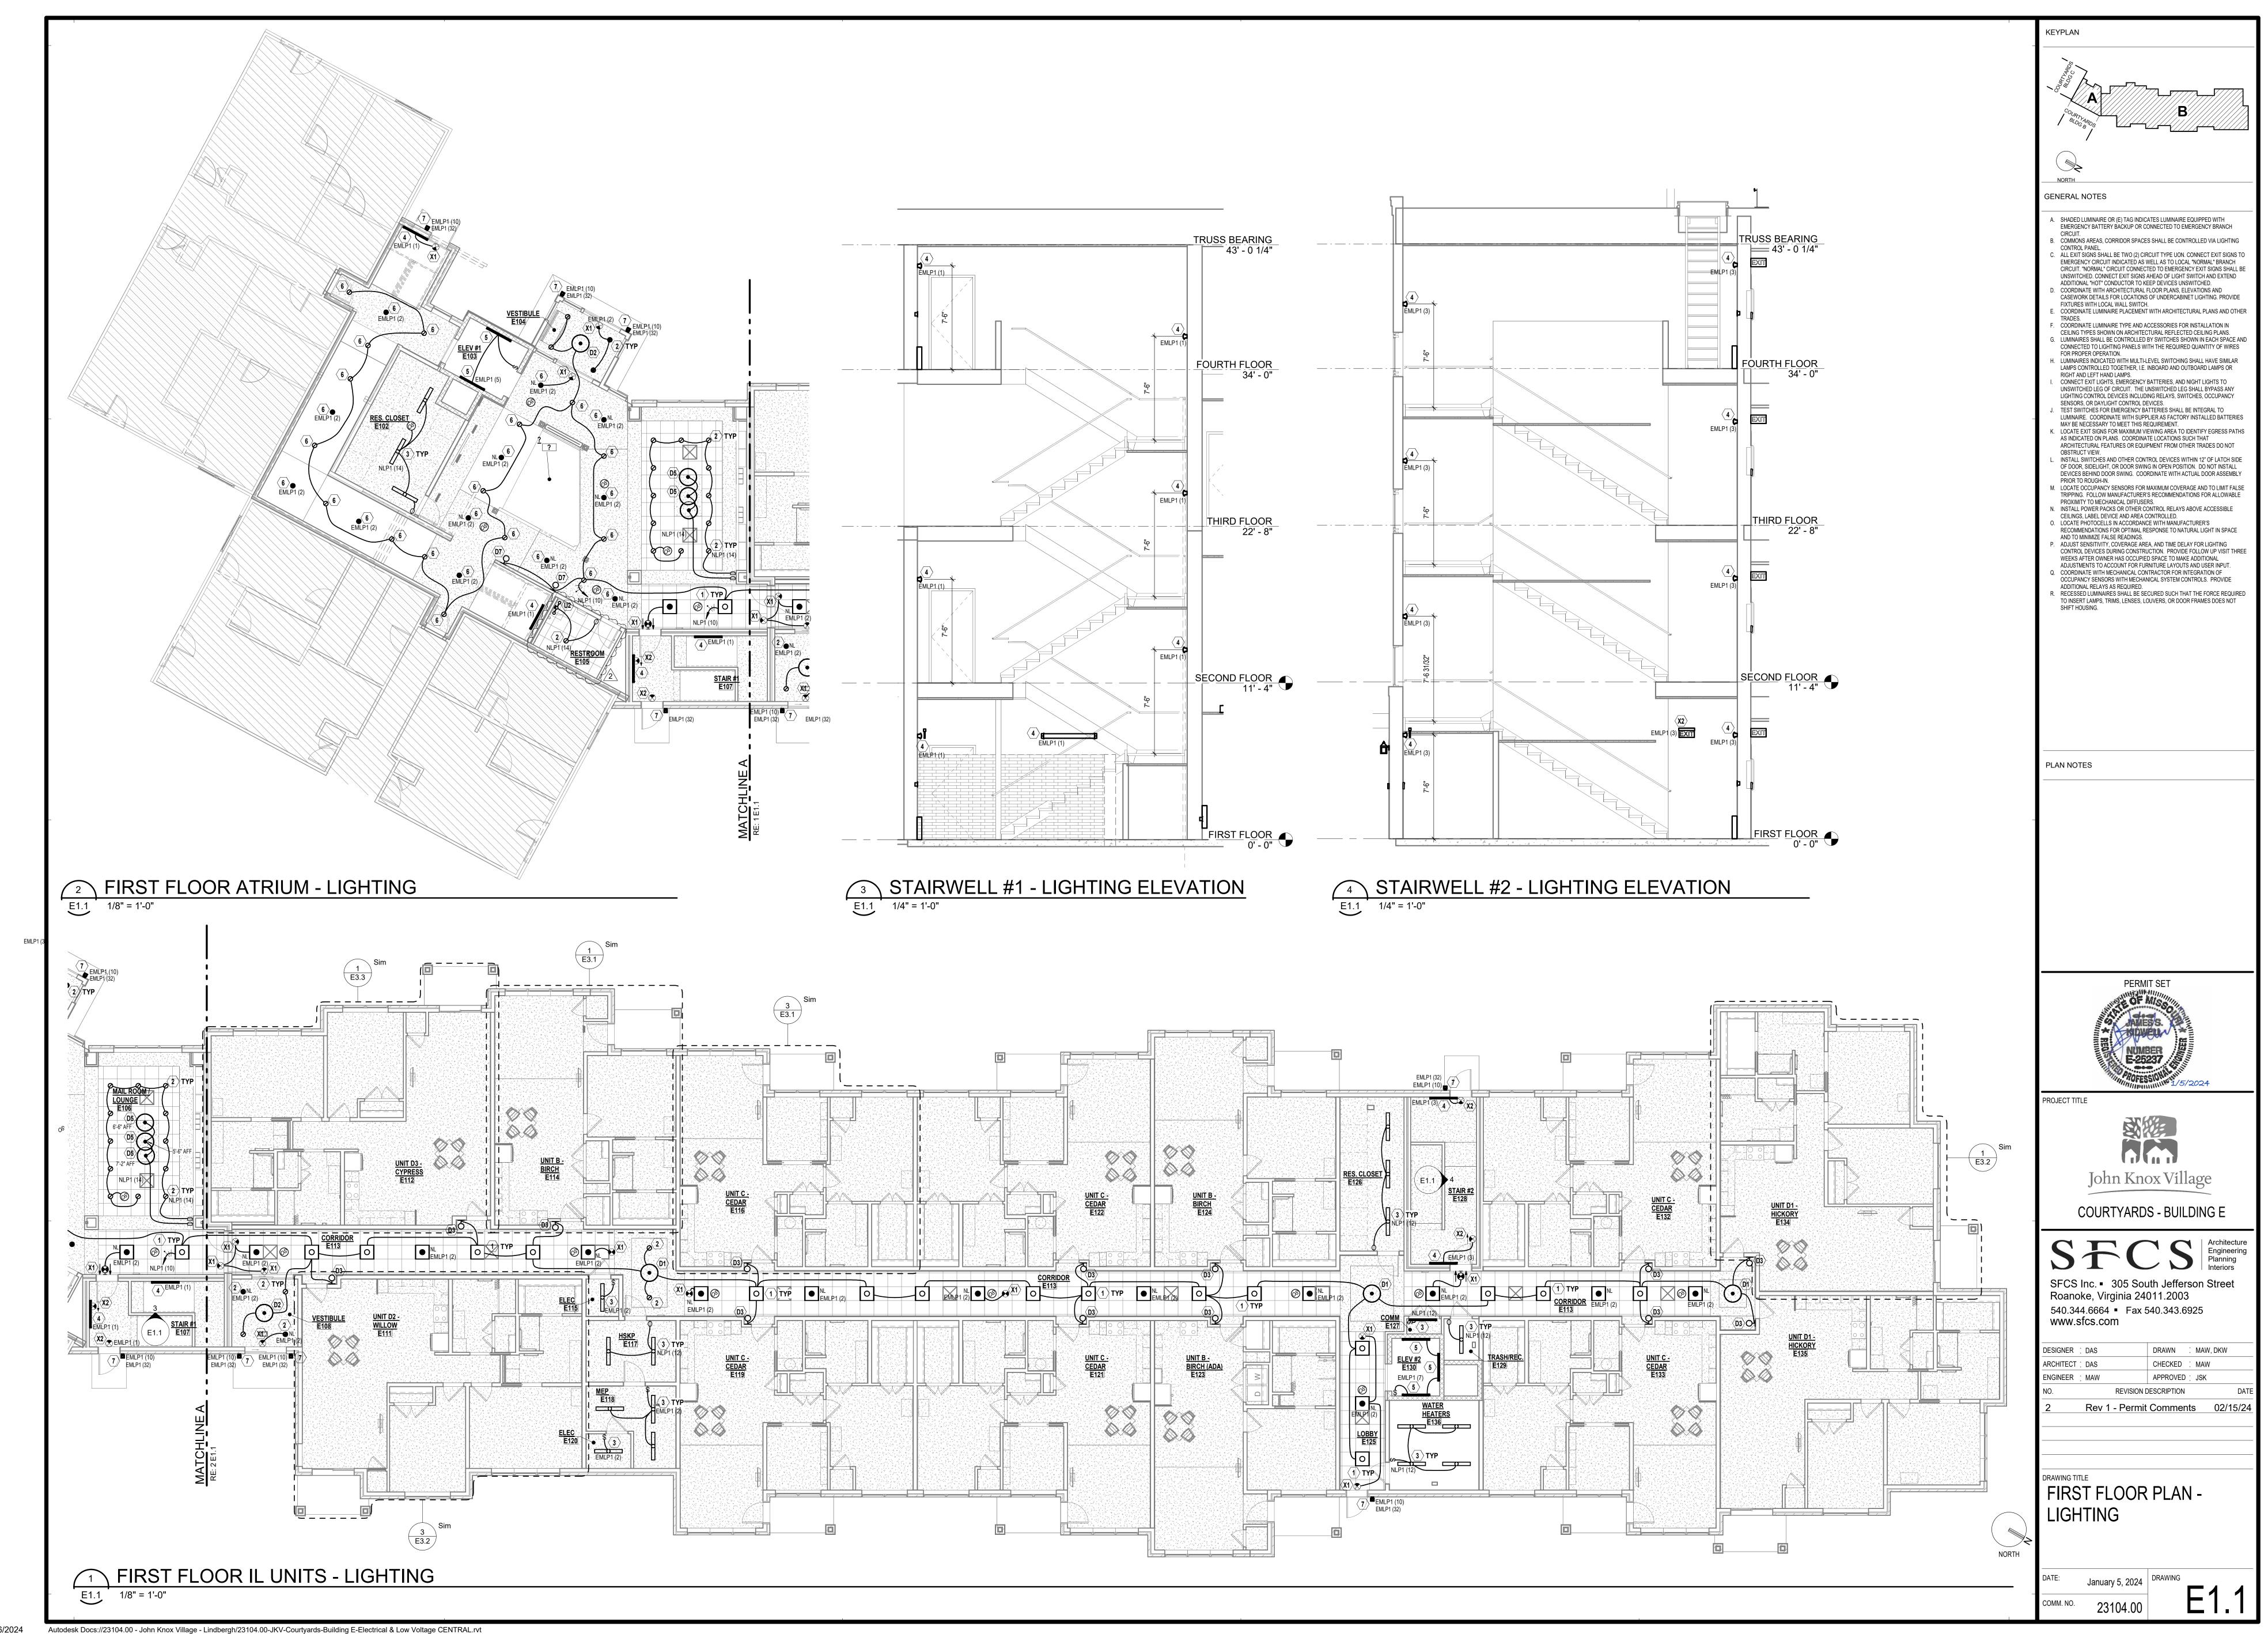


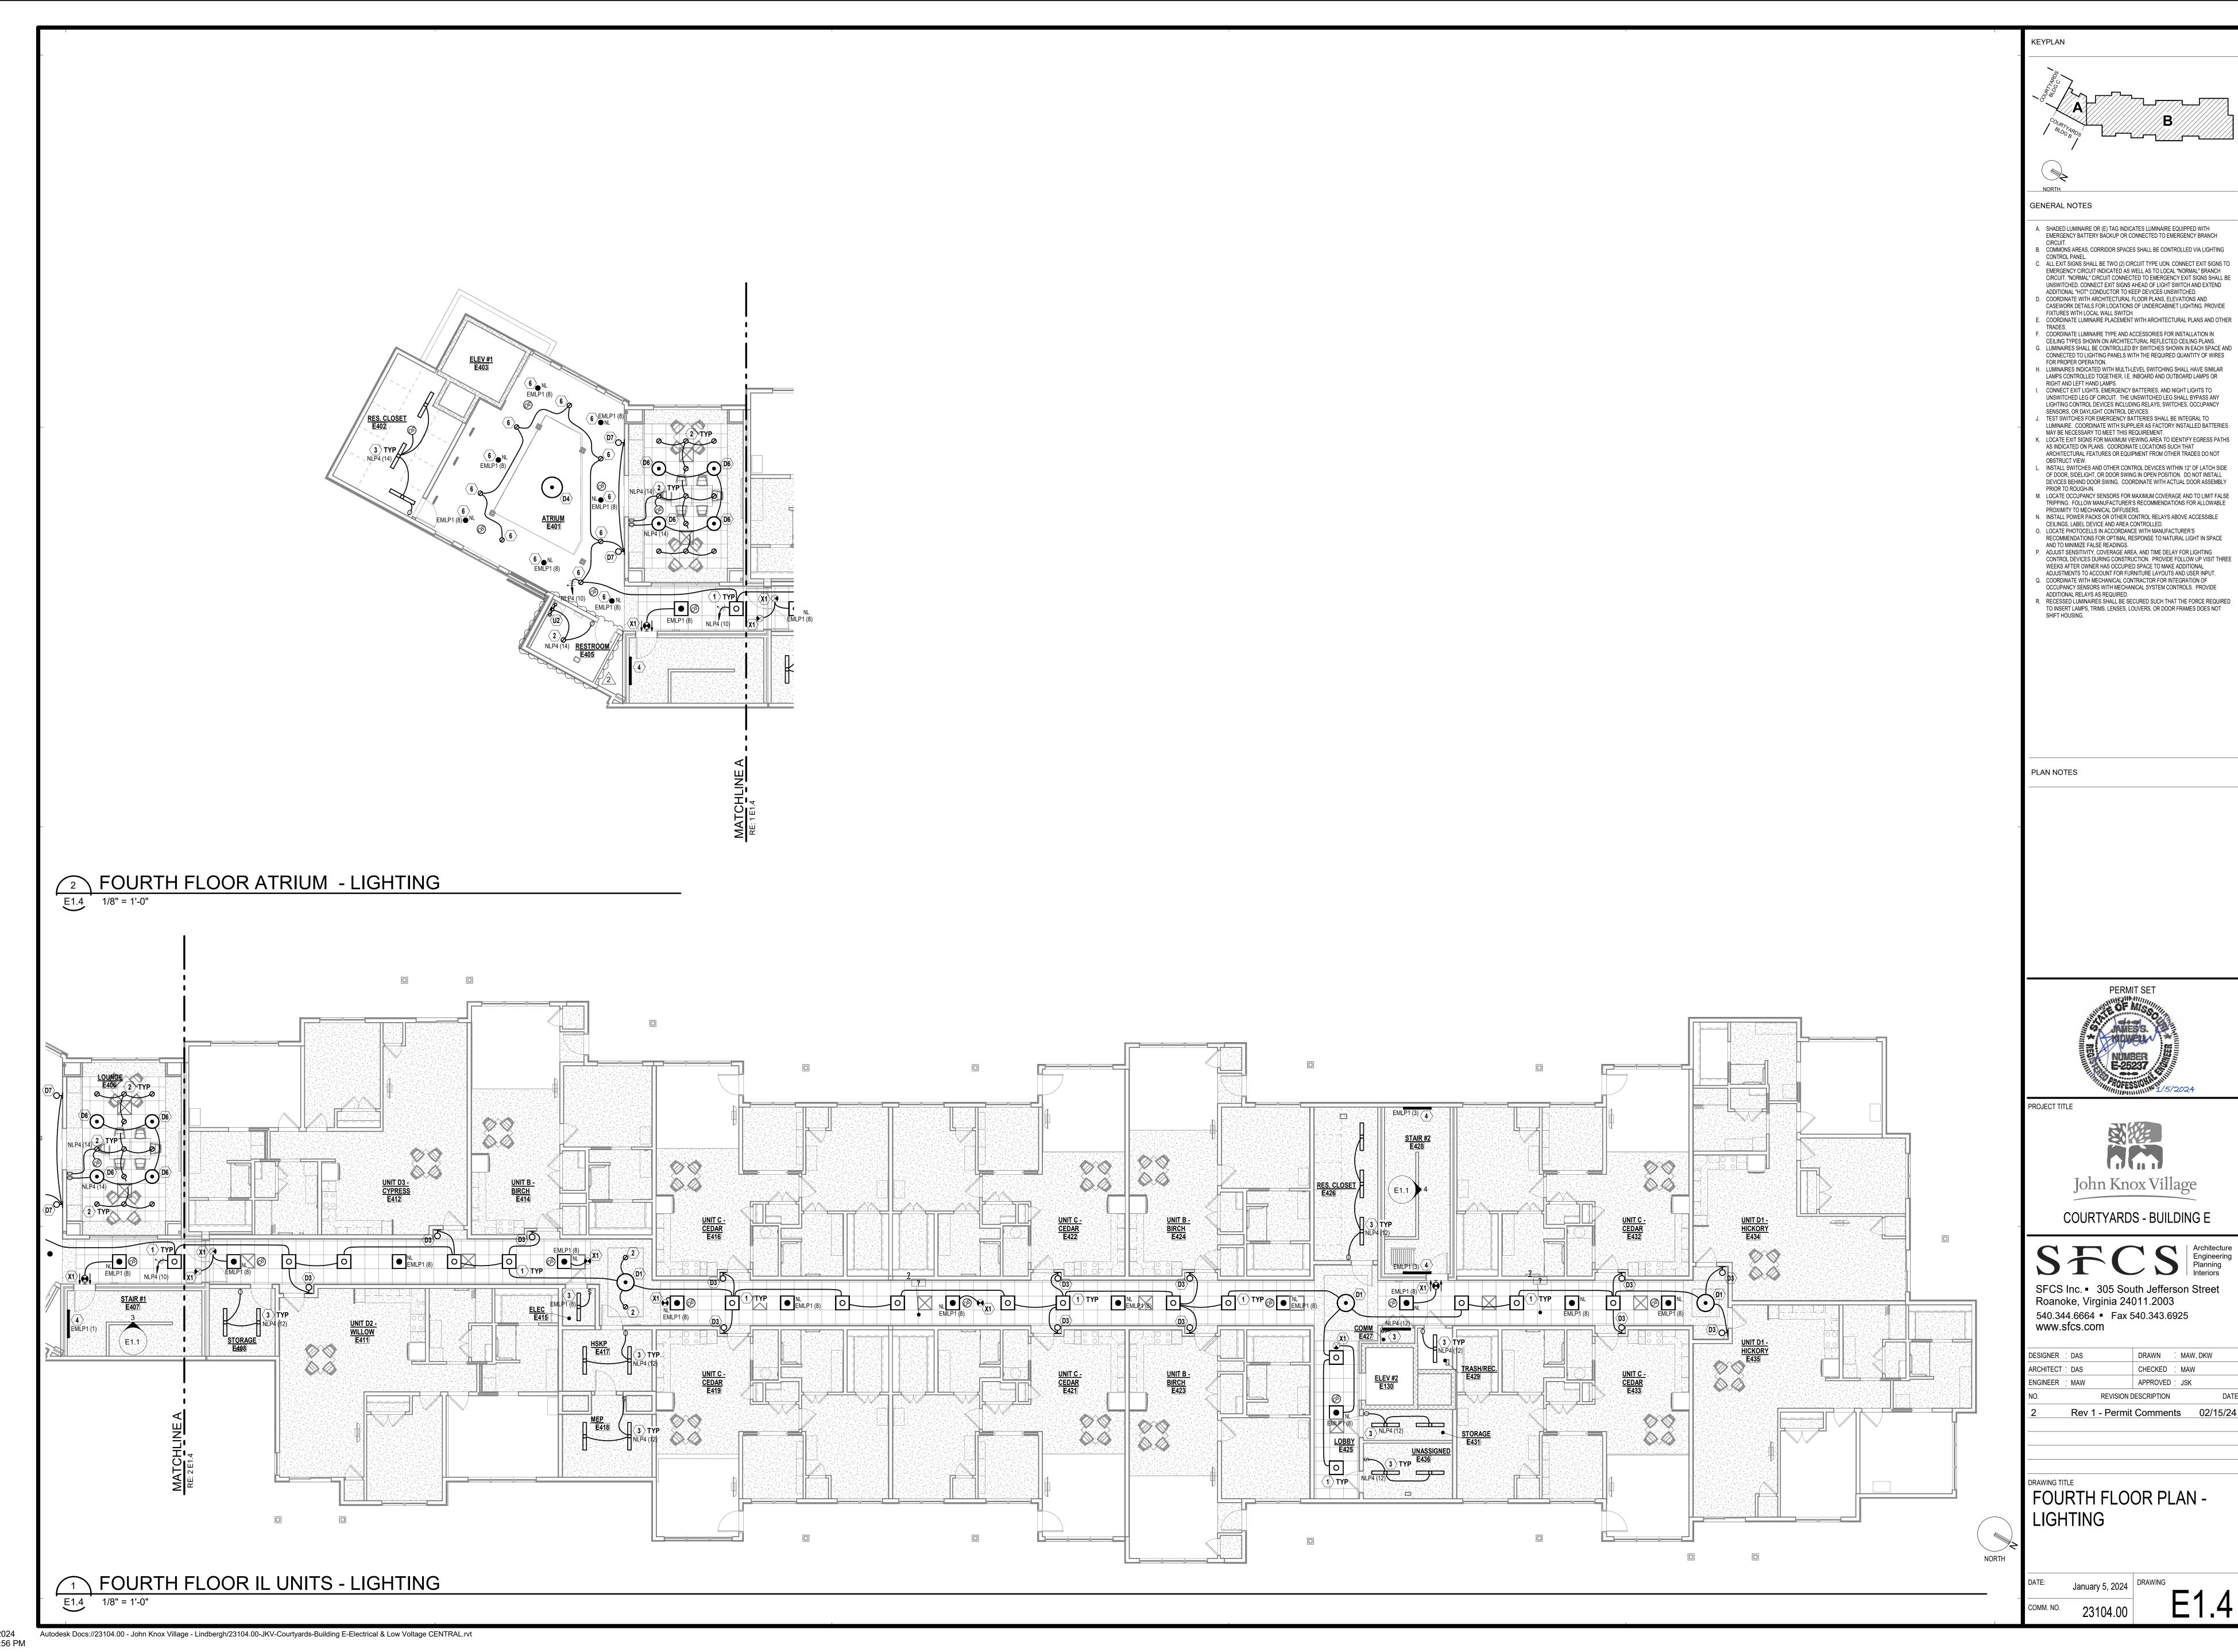


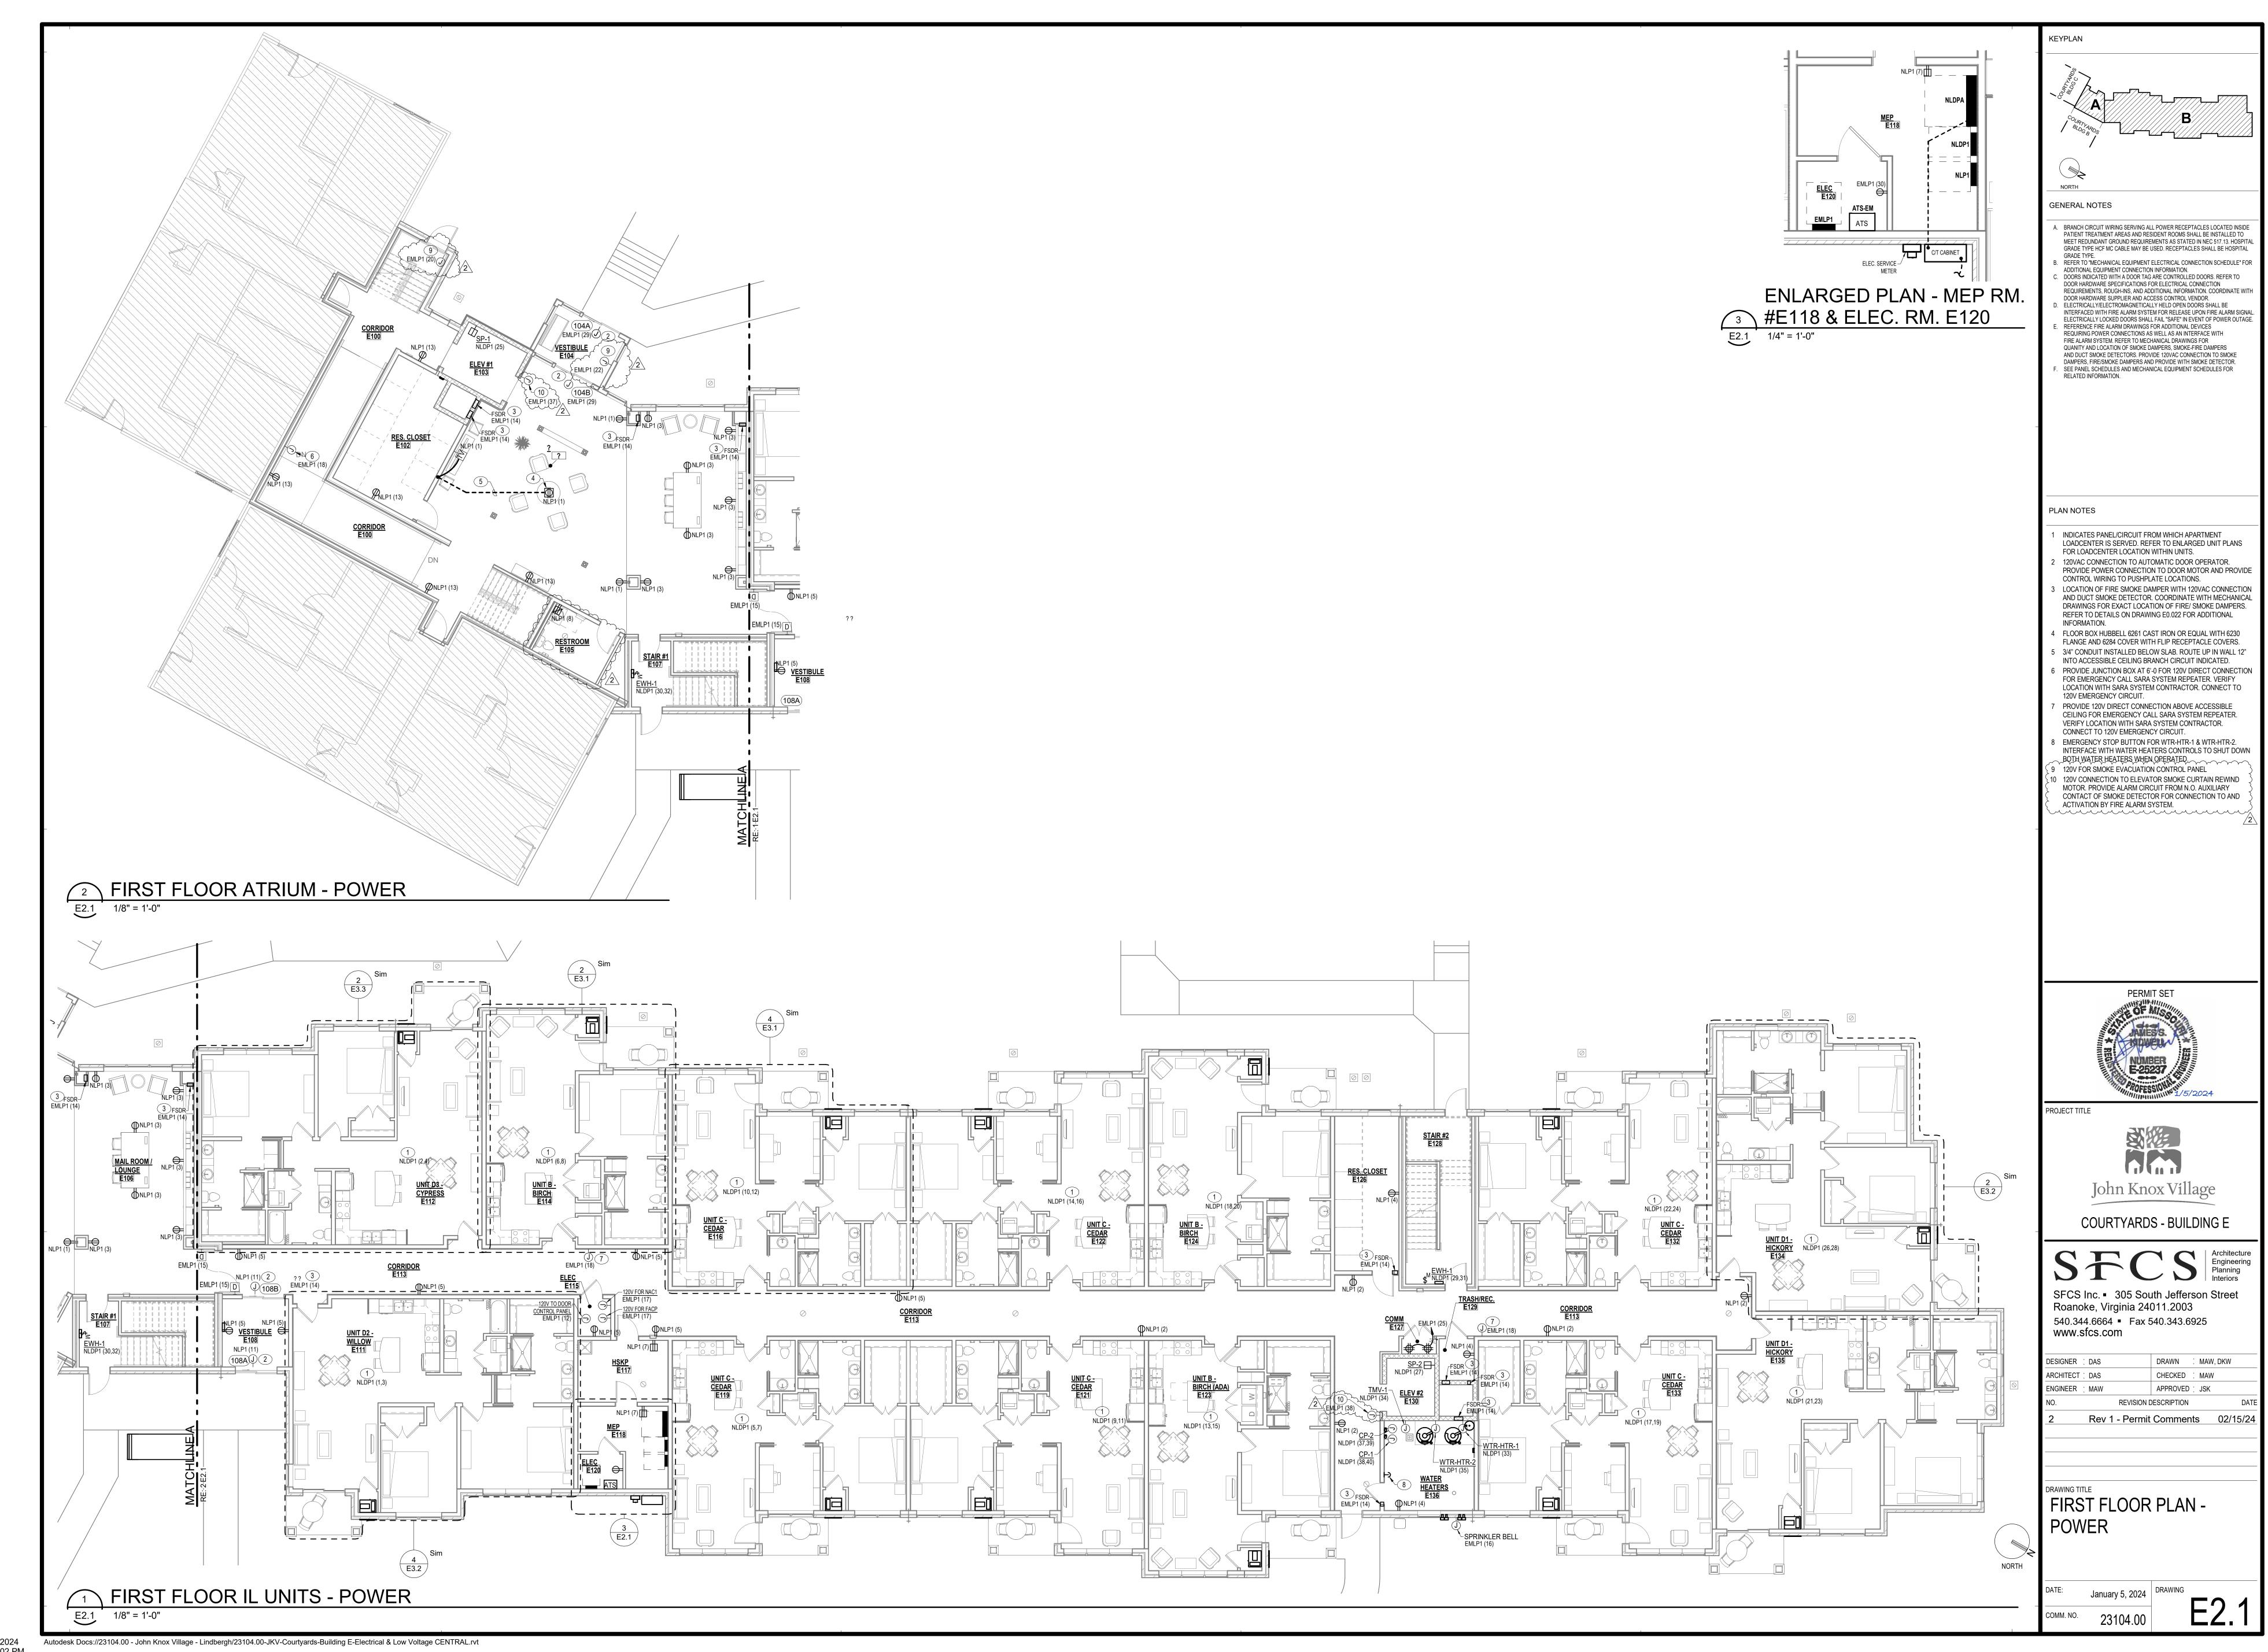

2/16/2024 1:00:02 PM

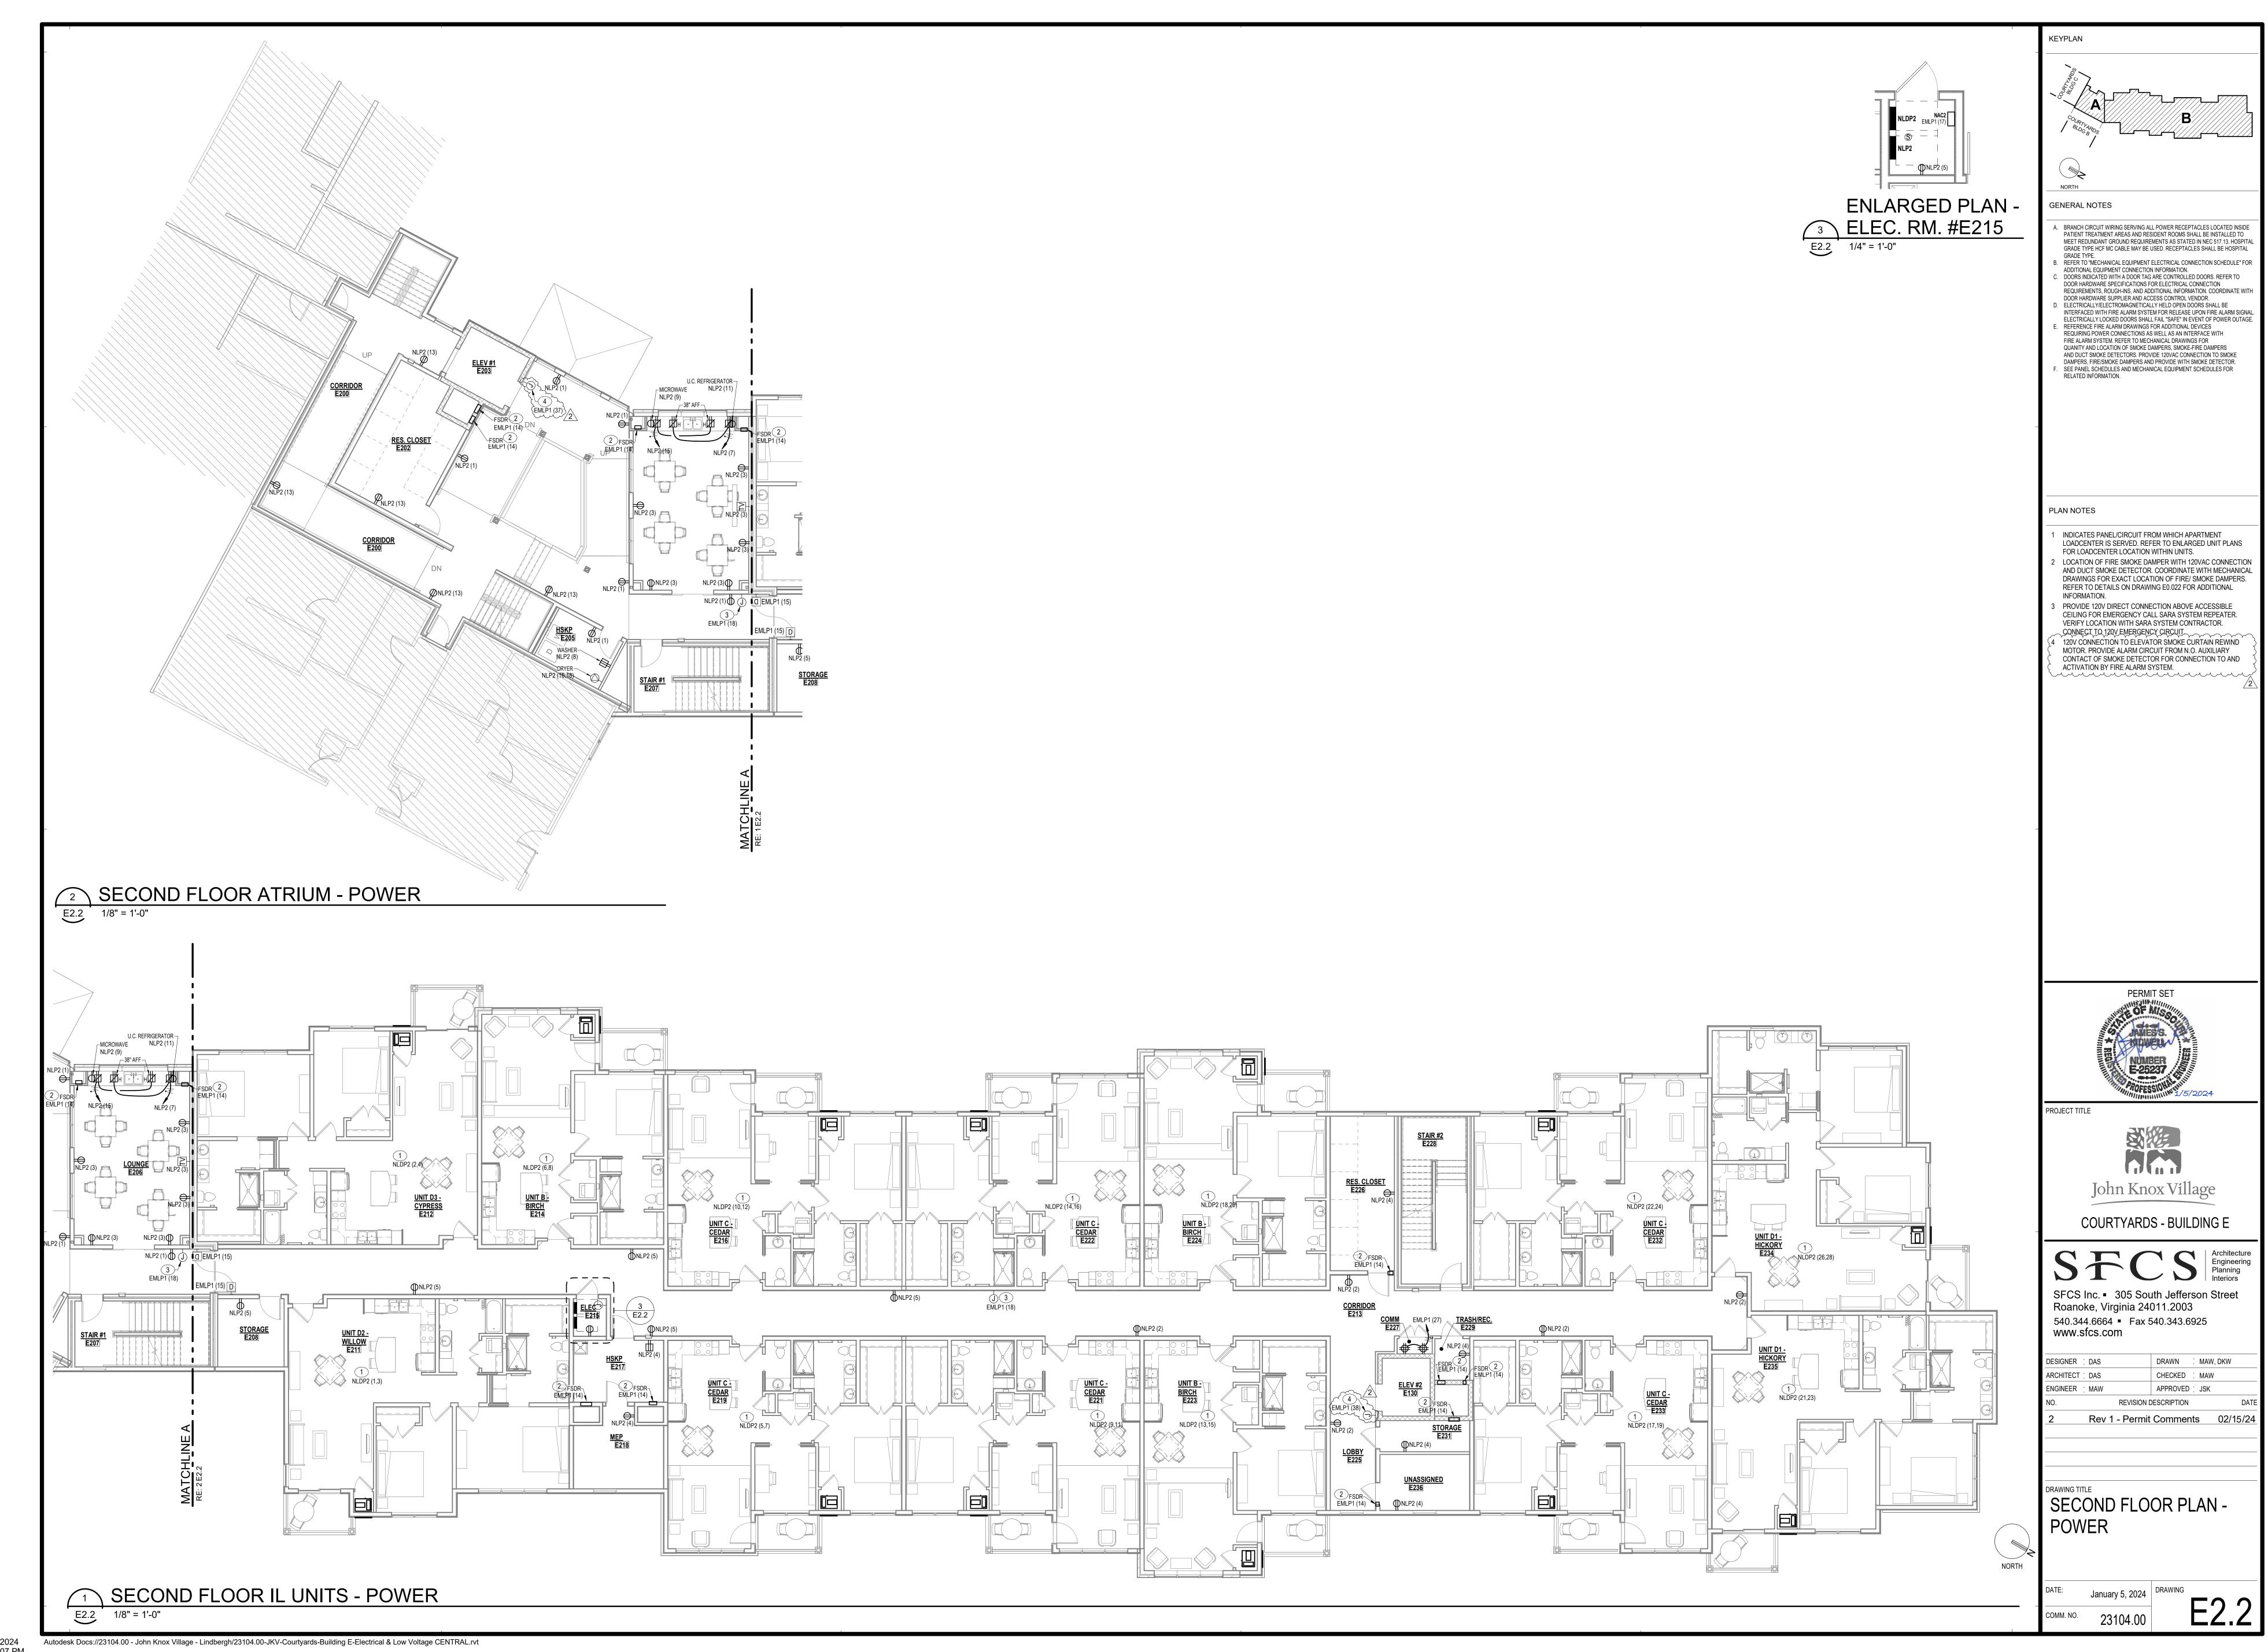

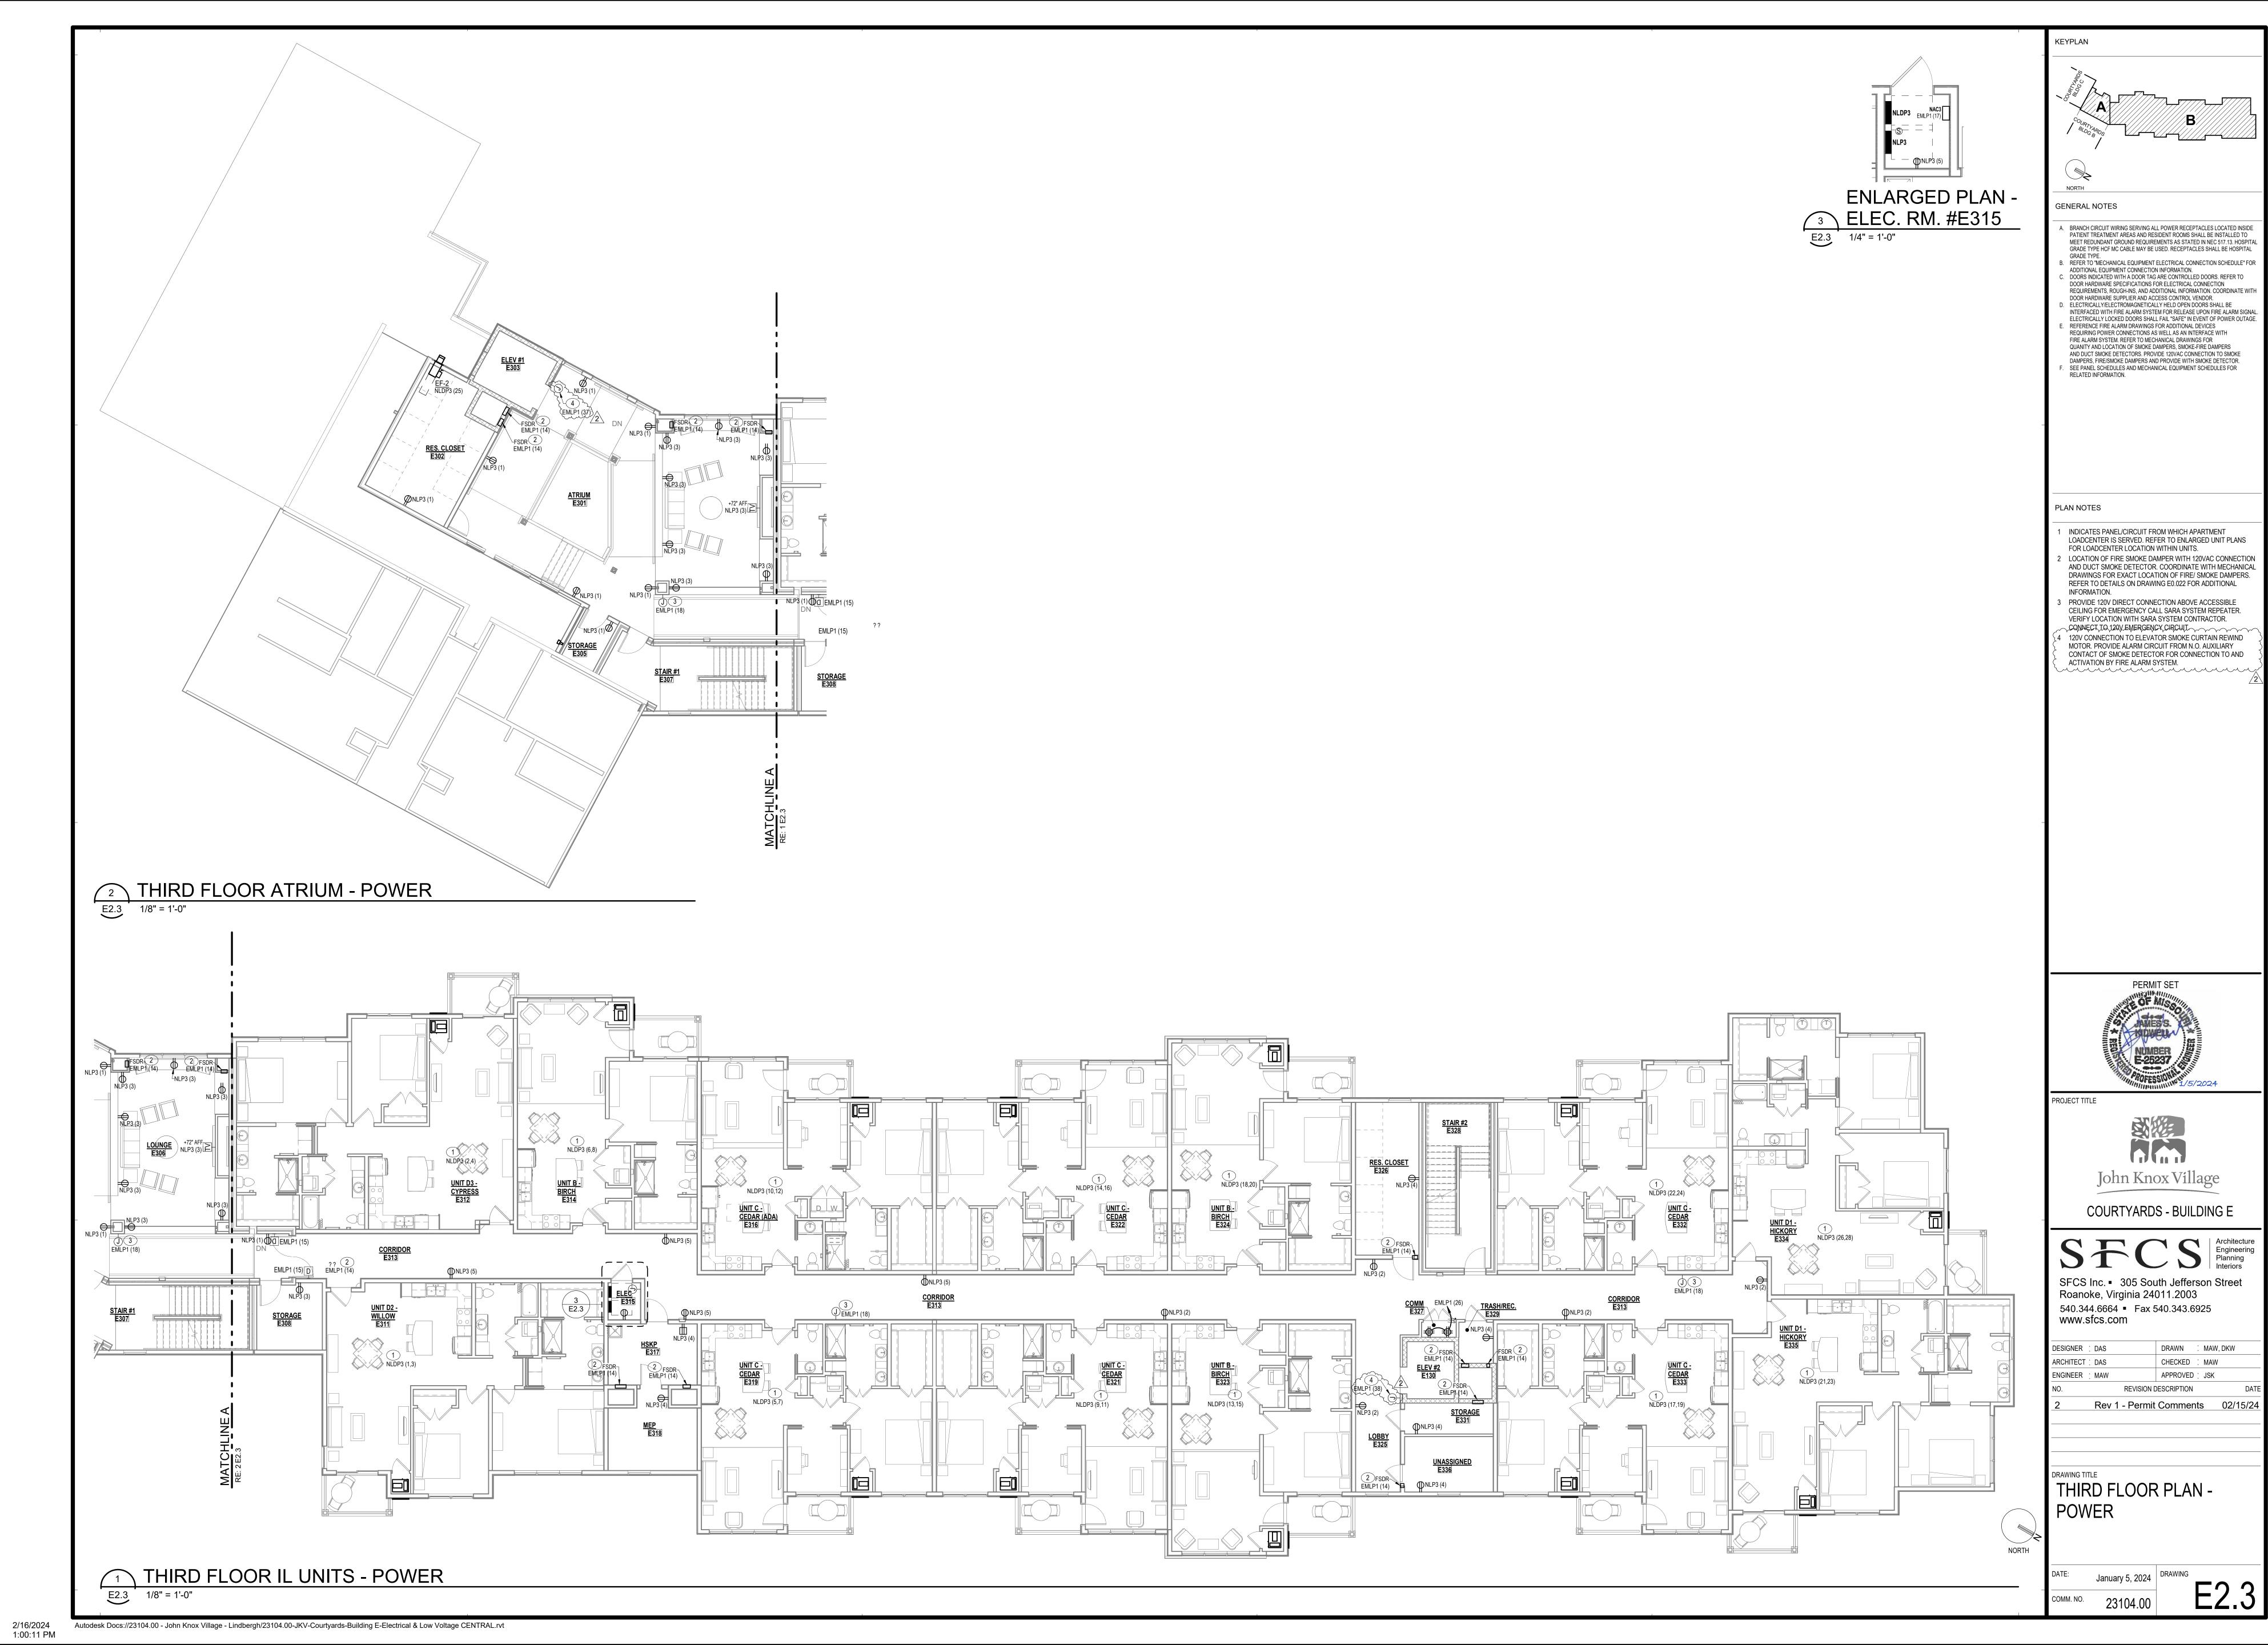

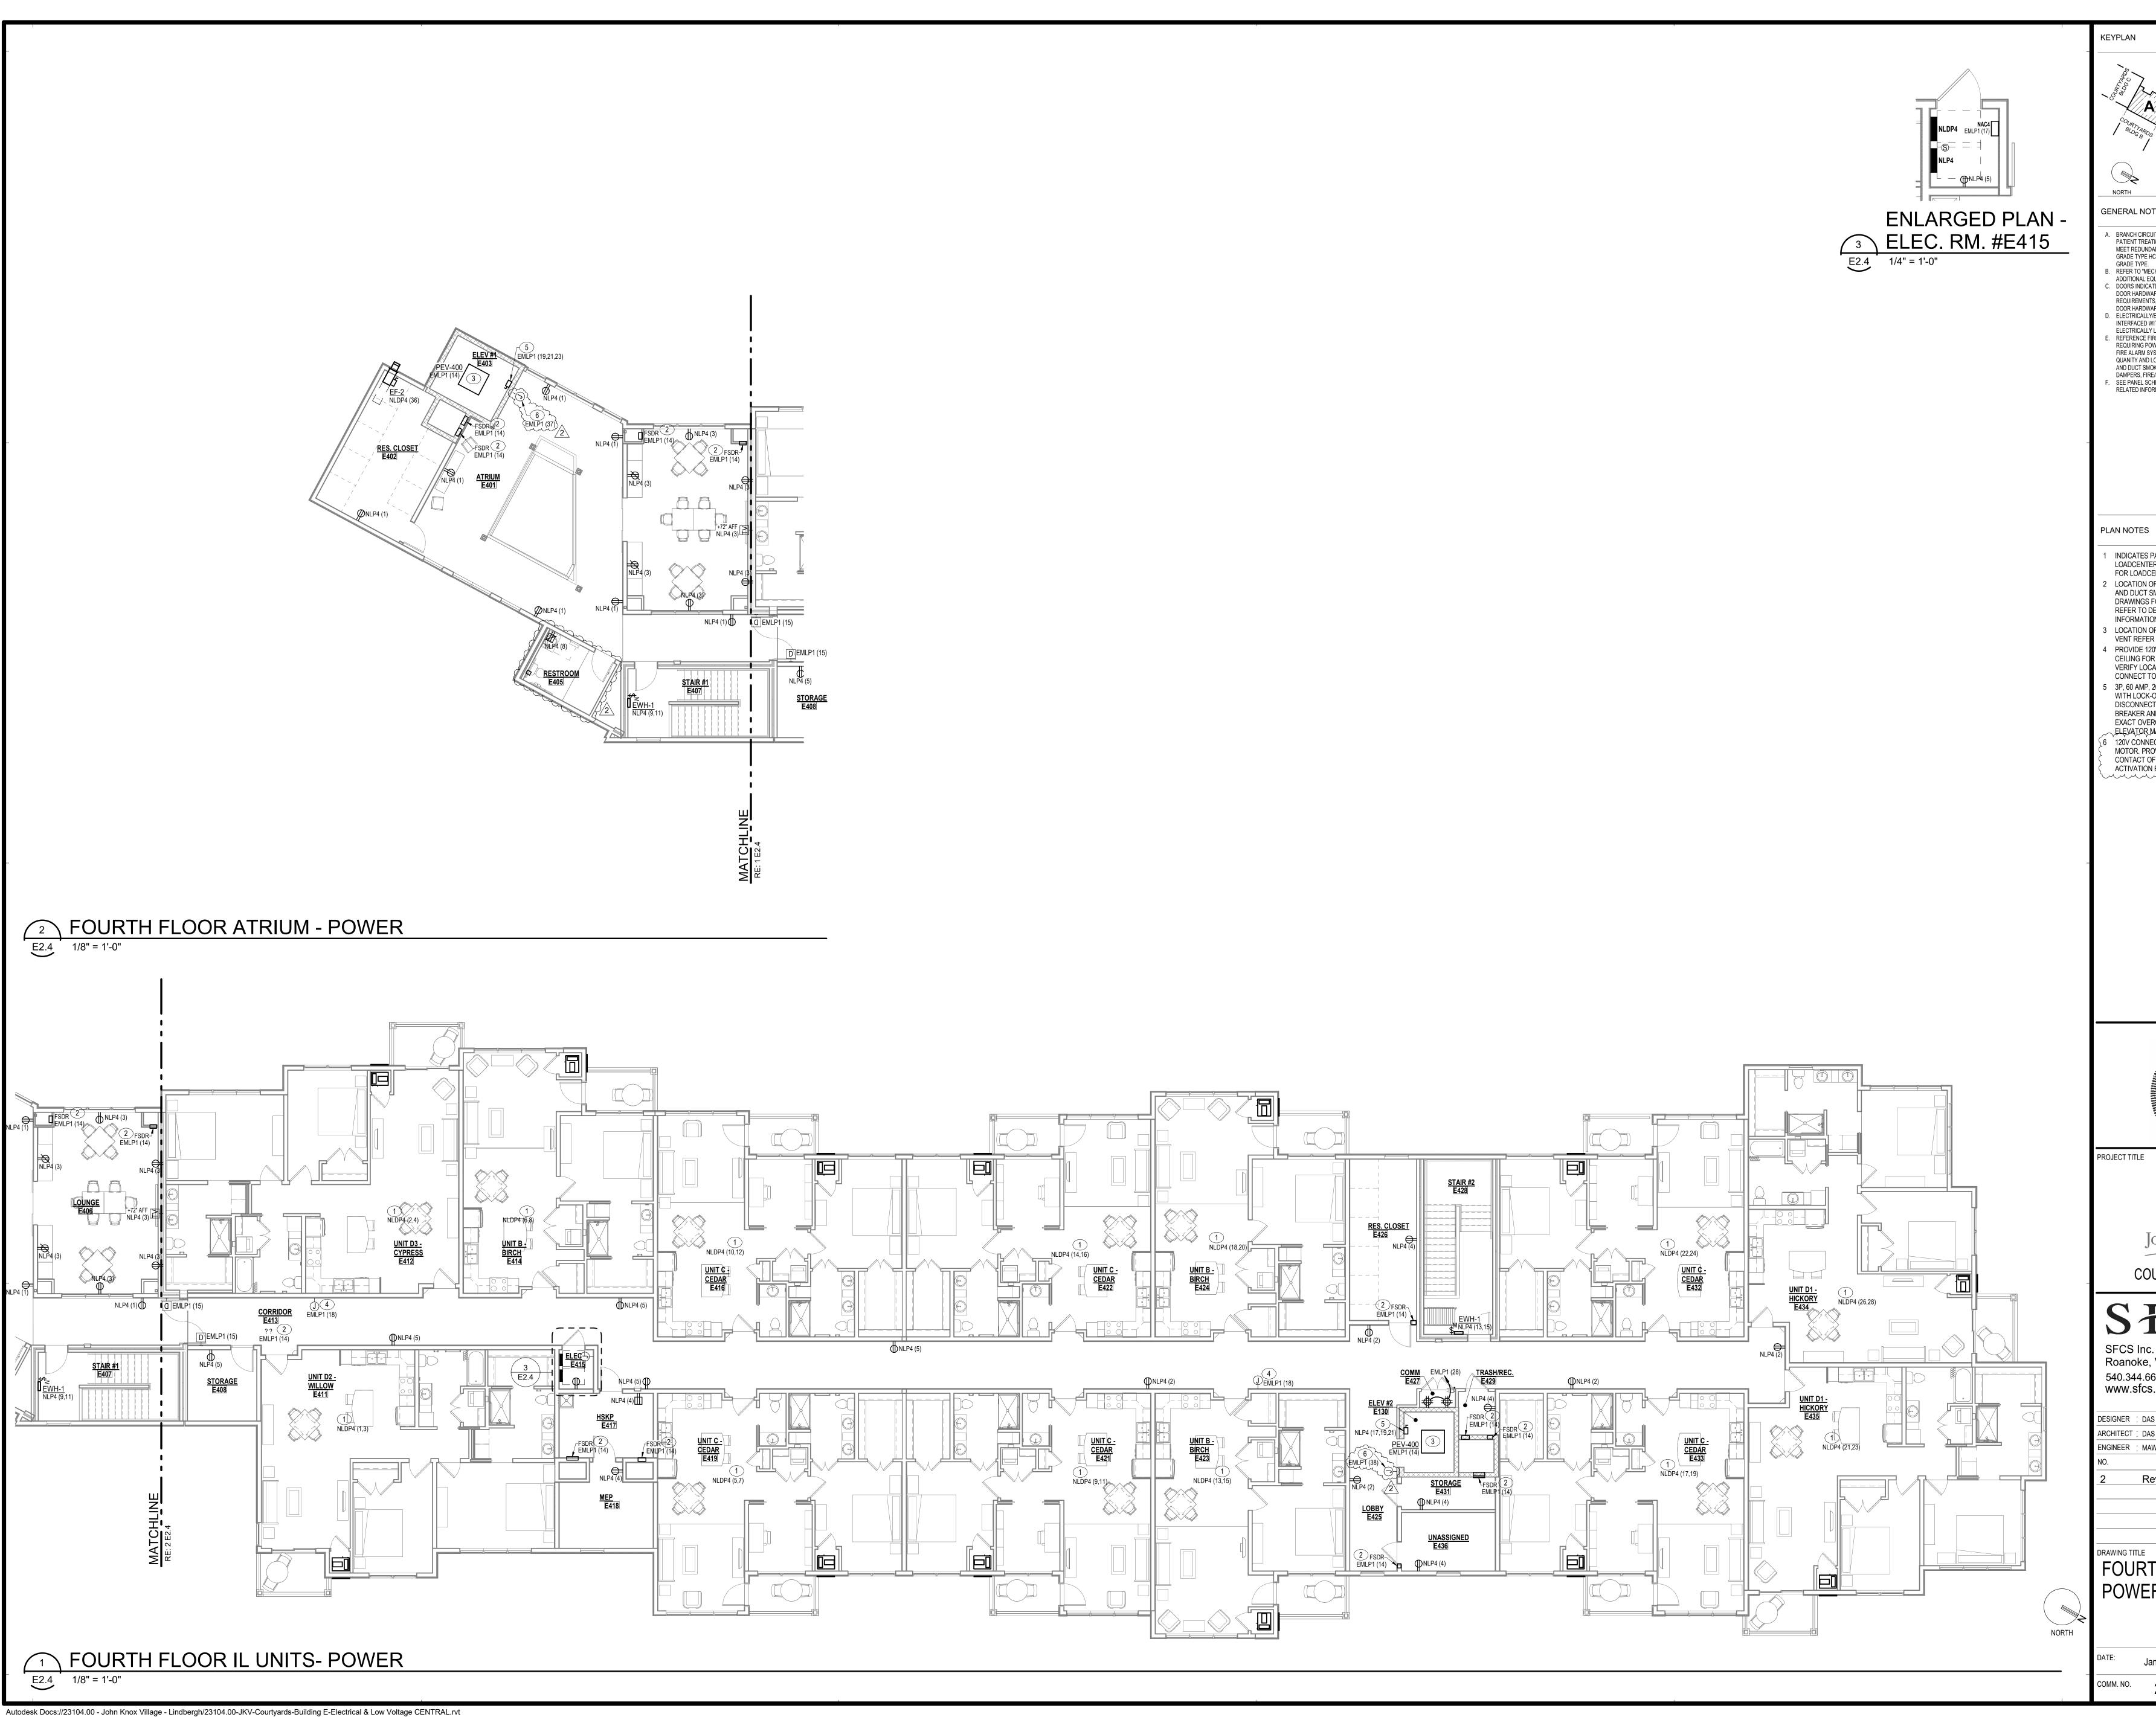

NORTH GENERAL NOTES A. BRANCH CIRCUIT WIRING SERVING ALL POWER RECEPTACLES LOCATED INSIDE PATIENT TREATMENT AREAS AND RESIDENT ROOMS SHALL BE INSTALLED TO MEET REDUNDANT GROUND REQUIREMENTS AS STATED IN NEC 517.13. HOSPITA GRADE TYPE HCF MC CABLE MAY BE USED. RECEPTACLES SHALL BE HOSPITAL REFER TO "MECHANICAL EQUIPMENT ELECTRICAL CONNECTION SCHEDULE" FOR

ADDITIONAL EQUIPMENT CONNECTION INFORMATION.

DOORS INDICATED WITH A DOOR TAG ARE CONTROLLED DOORS. REFER TO DOOR HARDWARE SPECIFICATIONS FOR ELECTRICAL CONNECTION REQUIREMENTS, ROUGH-INS, AND ADDITIONAL INFORMATION. COORDINATE WITH DOOR HARDWARE SUPPLIER AND ACCESS CONTROL VENDOR. D. ELECTRICALLY/ELECTROMAGNETICALLY HELD OPEN DOORS SHALL BE INTERFACED WITH FIRE ALARM SYSTEM FOR RELEASE UPON FIRE ALARM SIGNAL ELECTRICALLY LOCKED DOORS SHALL FAIL "SAFE" IN EVENT OF POWER OUTAGE. REFERENCE FIRE ALARM DRAWINGS FOR ADDITIONAL DEVICES REQUIRING POWER CONNECTIONS AS WELL AS AN INTERFACE WITH

FIRE ALARM SYSTEM. REFER TO MECHANICAL DRAWINGS FOR QUANITY AND LOCATION OF SMOKE DAMPERS, SMOKE-FIRE DAMPERS AND DUCT SMOKE DETECTORS. PROVIDE 120VAC CONNECTION TO SMOKE DAMPERS, FIRE/SMOKE DAMPERS AND PROVIDE WITH SMOKE DETECTOR. SEE PANEL SCHEDULES AND MECHANICAL EQUIPMENT SCHEDULES FOR

INDICATES PANEL/CIRCUIT FROM WHICH APARTMENT LOADCENTER IS SERVED. REFER TO ENLARGED UNIT PLANS FOR LOADCENTER LOCATION WITHIN UNITS. 2 LOCATION OF FIRE SMOKE DAMPER WITH 120VAC CONNECTION

AND DUCT SMOKE DETECTOR. COORDINATE WITH MECHANICAL DRAWINGS FOR EXACT LOCATION OF FIRE/ SMOKE DAMPERS. REFER TO DETAILS ON DRAWING E0.022 FOR ADDITIONAL 3 LOCATION OF GREENHECK PEV-400 PENTHOUSE ELEVATOR VENT REFER TO FOURTH FLOOR PLAN FIRE ALARM DRAWINGS.

4 PROVIDE 120V DIRECT CONNECTION ABOVE ACCESSIBLE CEILING FOR EMERGENCY CALL SARA SYSTEM REPEATER. VERIFY LOCATION WITH SARA SYSTEM CONTRACTOR. CONNECT TO 120V EMERGENCY CIRCUIT. WITH LOCK-OUT DEVICE FOR ELEVATOR CONTROLLER DISCONNECT. EXTEND FEEDER FROM LOAD SIDE OF CIRCUIT BREAKER AND TERMINATE ON ELEVATOR CONTROLLER. VERIFY ELEVATOR MANUFACTURER PRIOR TO ORDERING.


6 120V CONNECTION TO ELEVATOR SMOKE CURTAIN REWIND MOTOR. PROVIDE ALARM CIRCUIT FROM N.O. AUXILIARY CONTACT OF SMOKE DETECTOR FOR CONNECTION TO AND ACTIVATION BY FIRE ALARM SYSTEM.


John Knox Village COURTYARDS - BUILDING E

SFCS Inc. • 305 South Jefferson Street Roanoke, Virginia 24011.2003 540.344.6664 Fax 540.343.6925 www.sfcs.com

DESIGNER : DAS ARCHITECT : DAS CHECKED : MAW APPROVED ; JSK REVISION DESCRIPTION Rev 1 - Permit Comments 02/15/24

FOURTH FLOOR PLAN -POWER

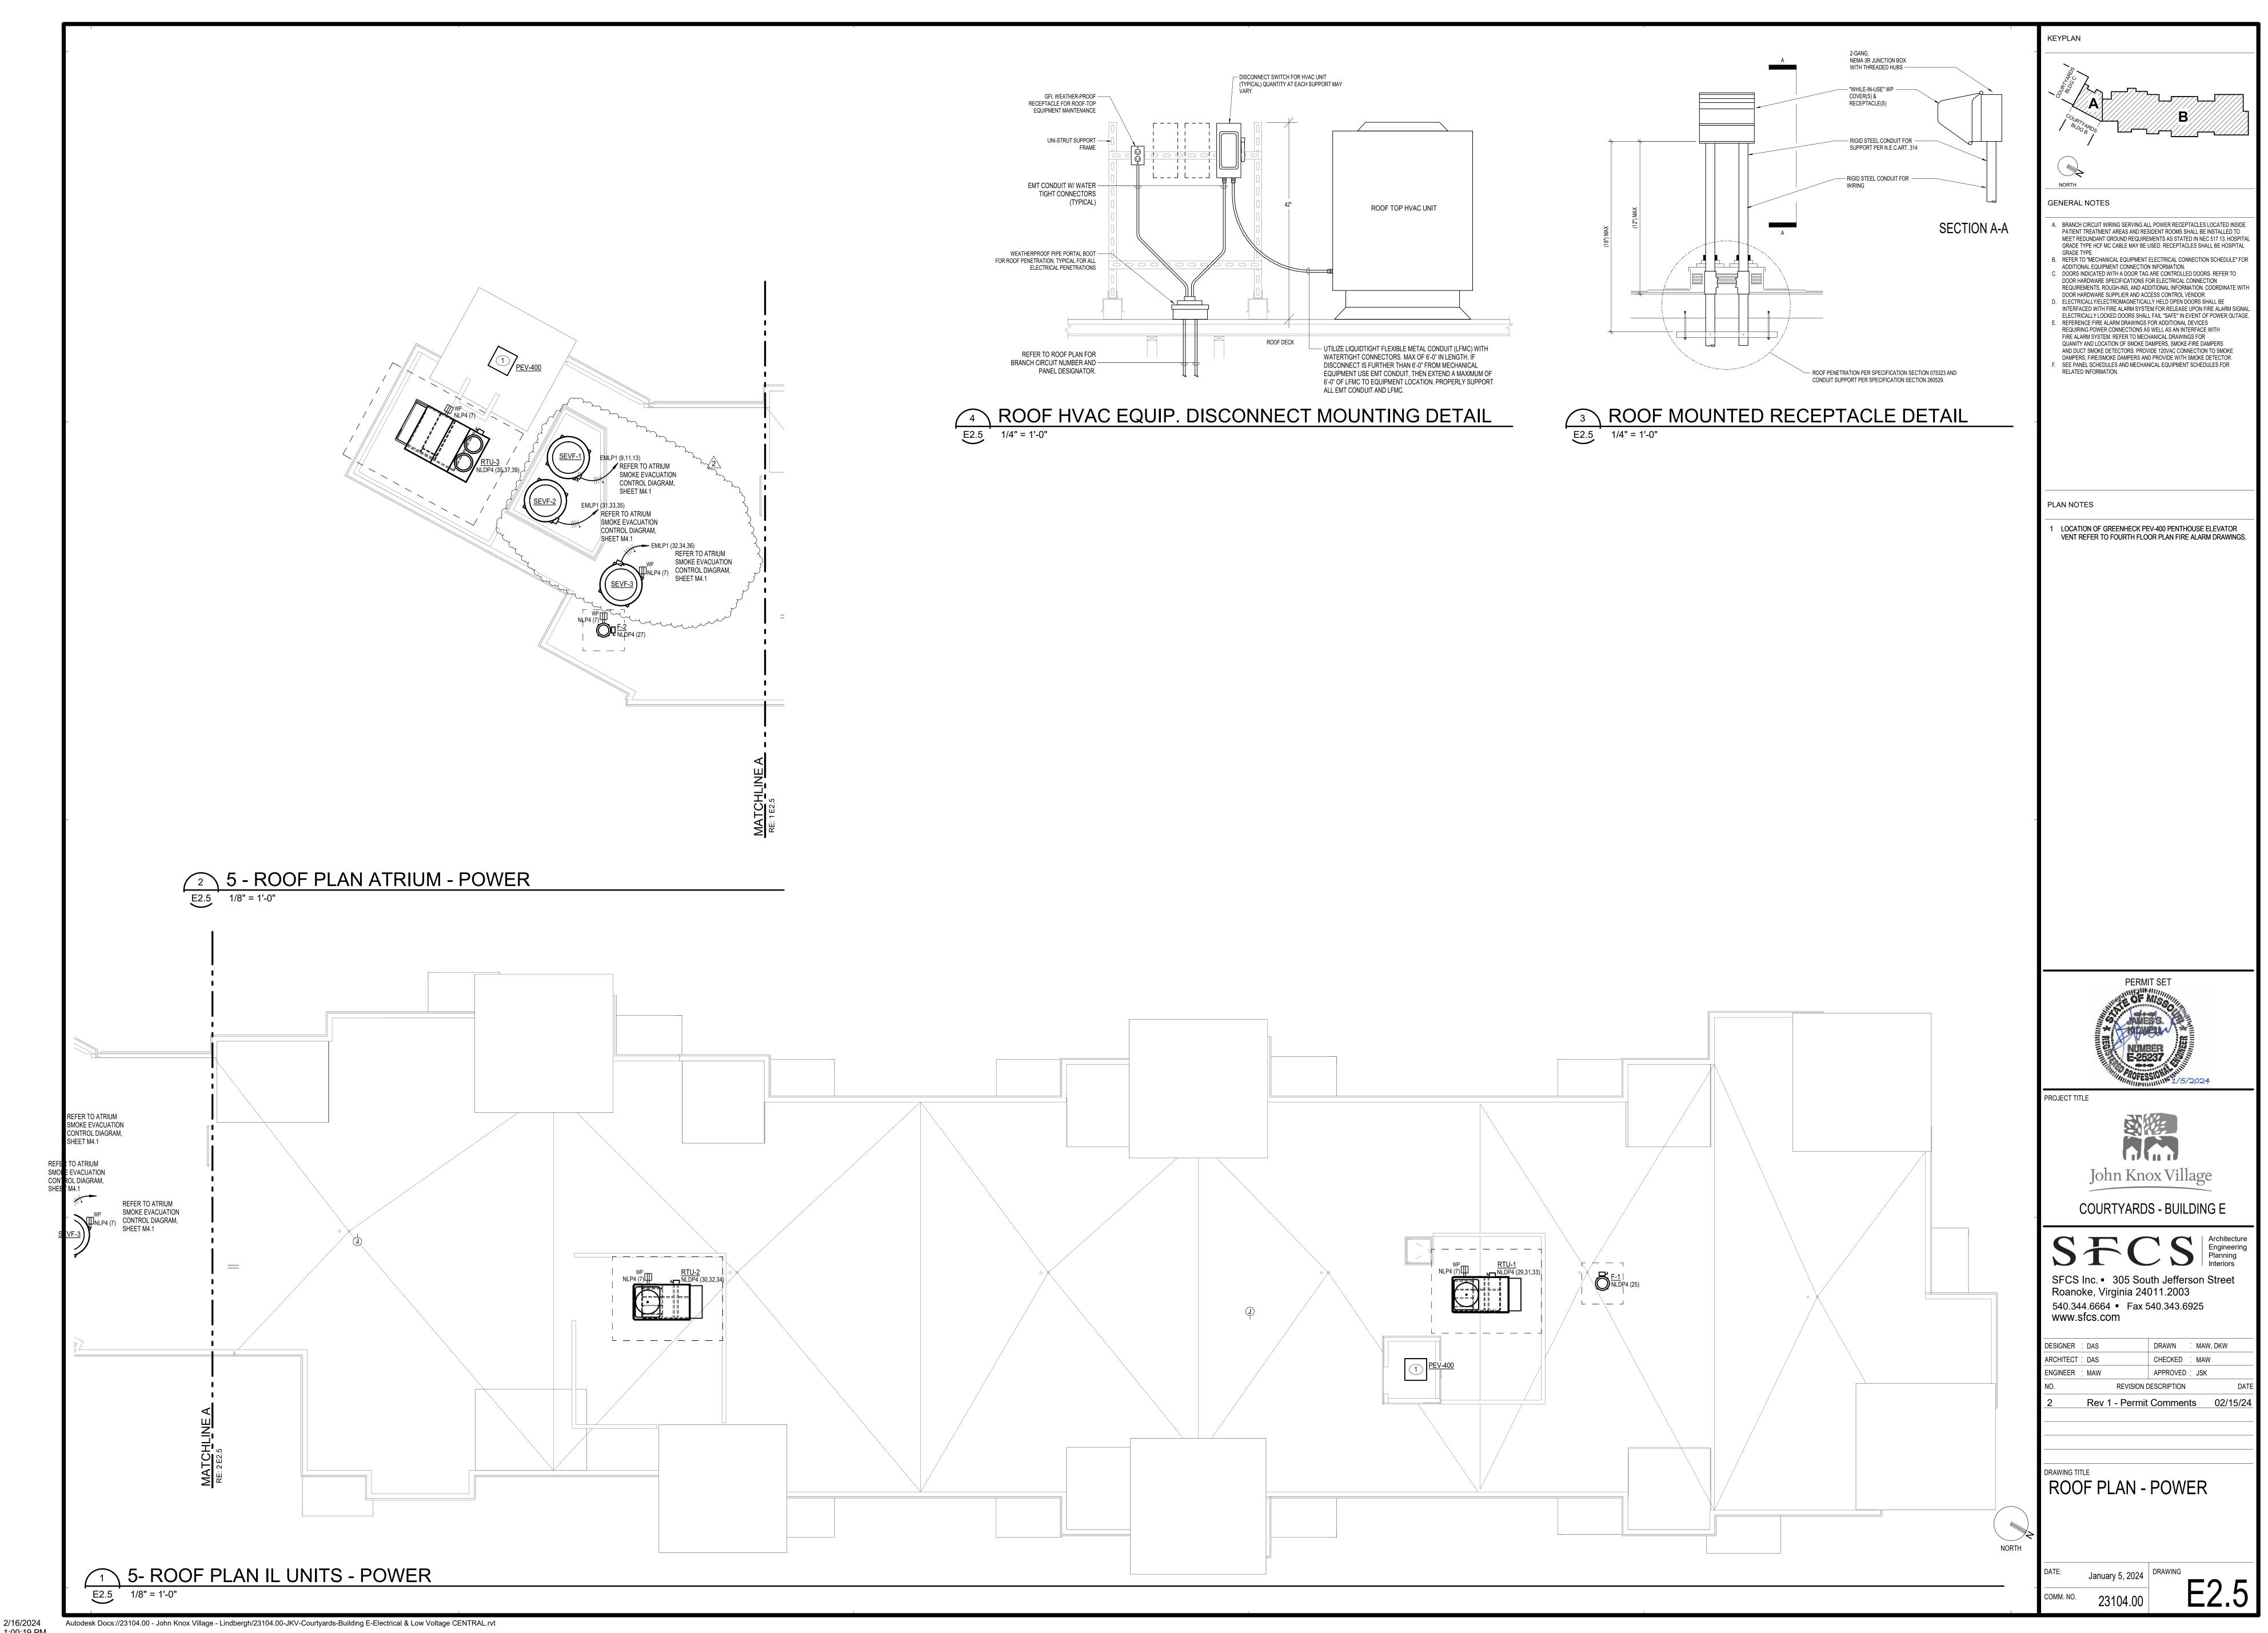

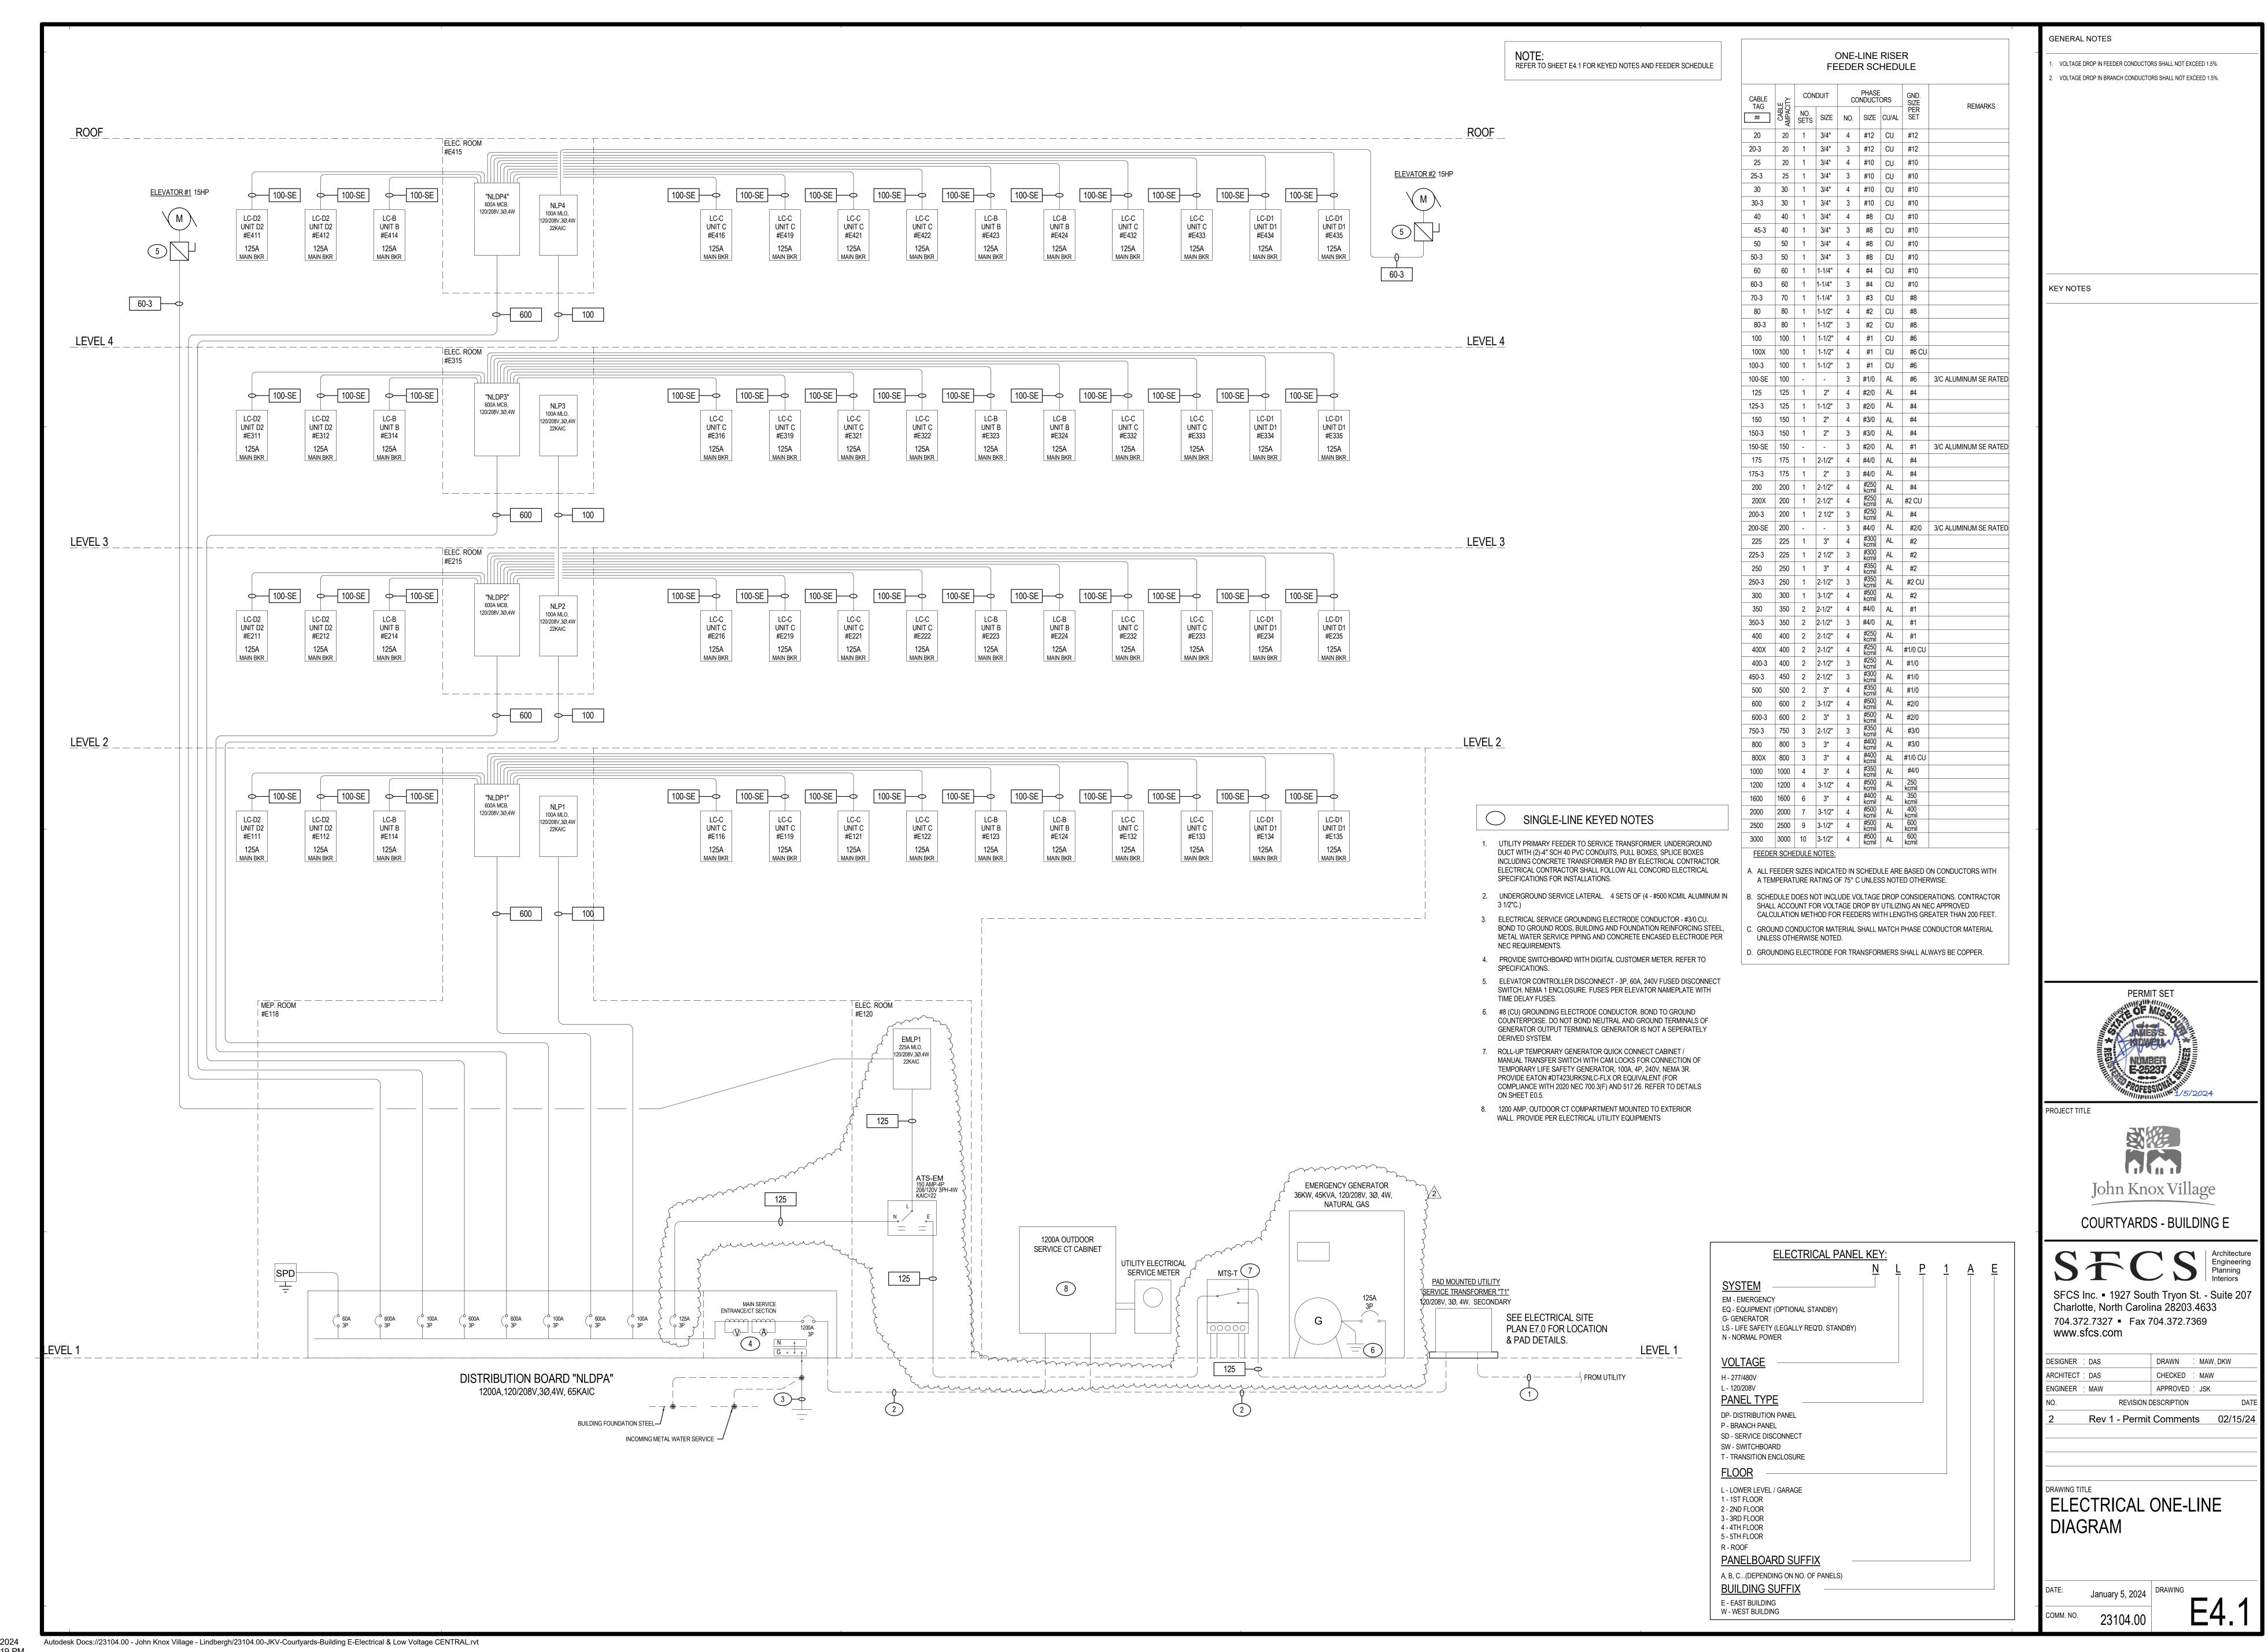

2/16/2024 1:00:19 PM

**Branch Panel: NLDP2** Location: ELEC E215 Volts: 120/208 Wye **A.I.C. Rating:** 10,000 AIC Supply From: NLDPA Phases: 3 Mains Type: MLO Mains Rating: 600 A Mounting: SURFACE Wires: 4 MCB Rating: Enclosure: NEMA 1 | Trip | Poles | A | B | C | Poles | Trip | Circuit December | 100 A | 2 | 11044... | 11044... | 11044... | 2 | 100 A | LC-D2 - UNIT #E212 | --- | --- | 100 A | 2 | 9930 VA | 9857 VA | 2 | 100 A | LC-B - UNIT #E214 | --- | --- | --- | --- | --- | --- | 100 A | 2 | 9930 VA | 9930 VA | 9930 VA | 9930 VA | 2 | 100 A | LC-C - UNIT #E216 | --- | --- | --- | --- | 100 A | 2 | 9857 VA | 9930 VA | 9930 VA | 9930 VA | 2 | 100 A | LC-C - UNIT #E222 |---| Trip Poles A B C Poles Trip Circuit Description Circuit Description 1 LC-D2 - UNIT #E211 5 LC-C - UNIT #E219 9 LC-C - UNIT #E221 13 LC-B - UNIT #E223 17 LC-C - UNIT #E233 21 LC-D1 - UNIT #E235 **Total Load:** 92526 VA 93823 VA 80441 VA **Total Amps:** 787 A 797 A 670 A **Load Classification** Panel Totals

266789 VA 41.00% 109383 VA

Volts: 120/208 Wye

82228 VA

528 VA

109383 VA

Phases: 3 Wires: 4

**Total Amps:** 1018 A 1027 A 900 A

82228 VA

528 VA

266789 VA

Connected Load Demand Factor Estimated Demand

100.00%

100.00%

41.00%

Total Conn. Load: 266789 VA

Total Est. Demand: 109383 VA

Total Conn.: 741 A

Total Est. Demand: 304 A

**A.I.C. Rating:** 10,000 AIC Mains Type: MLO

Panel Totals

Total Conn. Load: 349545 VA

Total Est. Demand: 192139 VA

Total Conn.: 970 A Total Est. Demand: 533 A

Mains Rating: 600 A

MCB Rating:

Residential per NEC 220.84

**Branch Panel: NLDP4** 

Circuit Description

5 LC-C - UNIT #E419

9 LC-C - UNIT #E421

13 LC-B - UNIT #E423

17 LC-C - UNIT #E433

21 LC-D1 - UNIT #E435

25 F-1 (IL - ROOF) 27 F-2 (ATRIUM ROOF)

29 RTU-1

35 RTU-3

**Load Classification** 

Residential per NEC 220.84

Location: ELEC E415

Mounting: SURFACE

Supply From: NLDPA

Enclosure: NEMA 1

	Location: ELEC E315				_			08 Wye				<b>A.I.C. Rating:</b> 10,000	) AIC		
Supply From: NLDPA  Mounting: SURFACE  Enclosure: NEMA 1				Phases: 3 Wires: 4							Mains Type: MLO Mains Rating: 600 A MCB Rating:				
Notes:	:														
СКТ	Circuit Description	Trip	Poles		Α	ı	В		3	Poles	Trip	Circuit De	escription	С	
1	LC-D2 - UNIT #E311	100 A	2	11044	11044					2	100 A	LC-D2 - UNIT #E312			
3			-			11044	11044								
	LC-C - UNIT #E319	100 A	2	0000	00			9930 VA	9857 VA	2		LC-B - UNIT #E314			
7	   LC C	 100 A		9930 VA	9857 VA	0000111	0000111				 100 A	LO C. LINIT #F240			
9	LC-C - UNIT #E321	100 A	2			9930 VA	9930 VA	9930 VA	00307/4	2		LC-C - UNIT #E316			
	LC-B - UNIT #E323	100 A	2	9857 \/^	9930 VA			9930 VA	9930 VA	2	100 A	LC-C - UNIT #E322			
15		100 A		JUJI VA	3330 VA	9857 VA	9930 VA					ONIT #LJZZ		<u> </u>	
	LC-C - UNIT #E333	100 A	2					9930 VA	9857 VA	2		LC-B - UNIT #E324		<u> </u>	
19				9930 VA	9857 VA							-		2	
	LC-D1 - UNIT #E335	100 A	2			11080	9930 VA			2	100 A	LC-C - UNIT #E332		2	
23								11080	9930 VA					2	
	EF-2 (RES. CLOSET #E302)	20 A	1	528 VA	11080					2	100 A	LC-D1 - UNIT #E334		2	
27							11080							2	
29														3	
31														3	
33 35														3	
37														3	
39														4	
41														4	
	I .	Total	Load:	9305	54 VA	9382	23 VA	8044	1 VA			I			
			Amps:		2 A		8 A		0 A	J					
_egen	d:	Total	Amps:	79	2 A	79	8 A	670	A 0						
Load Classification		Connected Load				Demand Factor			Estimated Demand			Panel	Totals		
Power		528 VA 266789 VA				100.00%			528 VA			Total Conn. Load:	267317 \/^		
Kesiae	ential per NEC 220.84				41.00%			109383 VA		/A		Total Est. Demand:			
												Total Est. Demand:			
												Total Est. Demand:			

Volts: 120/208 Wye

6000 VA

2246 VA

3792 VA

109383 VA

Trip Poles A B C Poles Trip Circuit Description

Phases: 3

Wires: 4

**Total Load:** 97825 VA 96962 VA 84041 VA

Connected Load Demand Factor Estimated Demand

100.00%

100.00%

100.00%

41.00%

**Total Amps:** 832 A 825 A 700 A

6000 VA

2246 VA

3792 VA

266789 VA

**A.I.C. Rating:** 10,000 AIC

Panel Totals

Total Conn. Load: 278827 VA

Total Conn.: 774 A

Total Est. Demand: 121421 VA

Total Est. Demand: 337 A

Mains Type: MLO

Mains Rating: 600 A

MCB Rating:

**Branch Panel: NLDP1** 

CKT Circuit Description

1 LC-D2 - UNIT #E111

5 LC-C - UNIT #E119

9 LC-C - UNIT #E121

13 LC-B - UNIT #E123

17 LC-C - UNIT #E133

21 LC-D1 - UNIT #E135

33 WTR-HTR-1 (CONTROLS)

35 WTR-HTR-2 (CONTROLS)

29 EWH-1 (STAIRWELL #2, 1ST FLOOR)

27 SP-2

37 CP-2

Load Classification

Residential per NEC 220.84

Receptacle


Location: MEP E118

Mounting: SURFACE

Enclosure: NEMA 1

Supply From: NLDPA

Notes	Location: ELEC E120 Supply From: ATS-EM Mounting: SURFACE Enclosure: NEMA 1					Volts: hases: Wires:	3	08 Wye			<u>.</u>	A.I.C. Rating: 10,000 Mains Type: MCB Mains Rating: 225 A MCB Rating:	DAIC }	
СКТ	Circuit Description	Trip	Poles		A	E	3			Poles	Trip	Circuit De	escription	С
1	EMERG. LTG STAIRWELL #1	20 A	1	339 VA	758 VA					1	20 A	NL LTG 1ST FLOOR C	ORRIDOR & ATRIUM	
3	EMERG. LTG STAIRWELL #2	20 A	1			227 VA	505 VA			1	20 A	NL LTG 2ND FLOOR C	CORRIDOR & ATRIUM	
5	EMERG. PIT LTG ELEV. #1	20 A	1					80 VA	452 VA	1		NL LTG 3RD FLOOR C		
~~~~~		20A	~~	120 VA	435 VA					1		NL LTG 4TH FLOOR C	ORRIDOR & ATRIUM	
9	SEVF-1	30 A	3			2004 VA	576 VA			1		LTG EXTERIOR		
11								2004 VA	500 VA	1				·
13				2004 VA	1175 VA					1				<u> </u>
	MAGNETIC DOOR HOLDS - ALL FLOORS	20 A	_ `	رر ر		32 VA	250 VA			1				<i>'</i>
17	FACP & NAC'S	20 A	1					500 VA	200 VA	$\sim 1 \sim$		A SARA SYSTEM REPEATERS		\ <u>`</u>
19	ELEVATOR #1 (15 HP)	35 A	3	3360 VA	200 VA				_	1		POWER AUTODOORS #		2
21					-	3360 VA	0 VA		<u> </u>	1				1
23	PORTIO COMMA WEAGT		-					3360 VA	180 VA	M		A GENERATOR RECEPT		\
25	RCPT'S - COMM. #E127	20 A	1	720 VA	720 VA					1				1
27	RCPT'S - COMM. #E227	20 A	1			720 VA	720 VA			1				1
29		20 A	+	<u> </u>		~~	~~	400 VA	180 VA	γ · γ ·		RCPT'S - ELEC. #E120	~~~~~~~~~~~~~~~~~~~~~~~~~~~~~~~~~~~~~~	\\\\\\\\\\\\\\\\\\\\\\\\\\\\\\\\\\\\\\
31	SEVF-2	30 A	3	2004 VA	2004 VA		0004144			3		SEVF-3		
33	<del></del>		-		_	2004 VA	2004 VA		00041/4					;
35	ELEVATOR SMOVE CURTAIN ALL ELOORS	20 A	1	1200 \/A	1200 VA			2004 VA	2004 VA		 20 A	ELEVATOR SMOKE CHE	OTAIN ALL ELOOPS	;
37	ELEVATOR SMOKE CURTAIN - ALL FLOORS	20 A 20 A		1200 VA	. 1200 VA	OVA					20 A	ELEVATOR SMOKE CUI	TIAIN - ALL FLOORS	
			1		-	UVA	U VA		0.1/4	1				+
41	SPARE	20 A		1601	20.1/4	1040	2 \ / ^	0 VA	0 VA	I	20 A	SPARE		
			I Load: Amps:		38 VA 36 A	1240 104			64 VA 9 A					
Leger			•											
	Load Classification		Connected Load 18911 VA			Demand Factor		Estimated Demand 18911 VA			Panel	Totals		
Motor	HVAC Motor		12480 V			100.00% 100.00%						Total Conn. Load:	40504 VA	
Other			32 VA			100.00%		12480 VA 32 VA		Total Est. Demand: 41200 VA				
		<del>                                     </del>				100.00%			1610 V			Total Conn.:		_
	Receptacle Spare		4610 VA 180 VA			100.00%		180 VA			Total Est. Demand:		—	
-	Lighting		3491 VA		125.00%		4364 VA			Total Est. Belliana.	11470			
Power			500 VA			125.00%		500 VA						
	lential per NEC 220.84		300 VA			41.00%		123 VA						
Notes	•			`		11.0070			120 17	•				

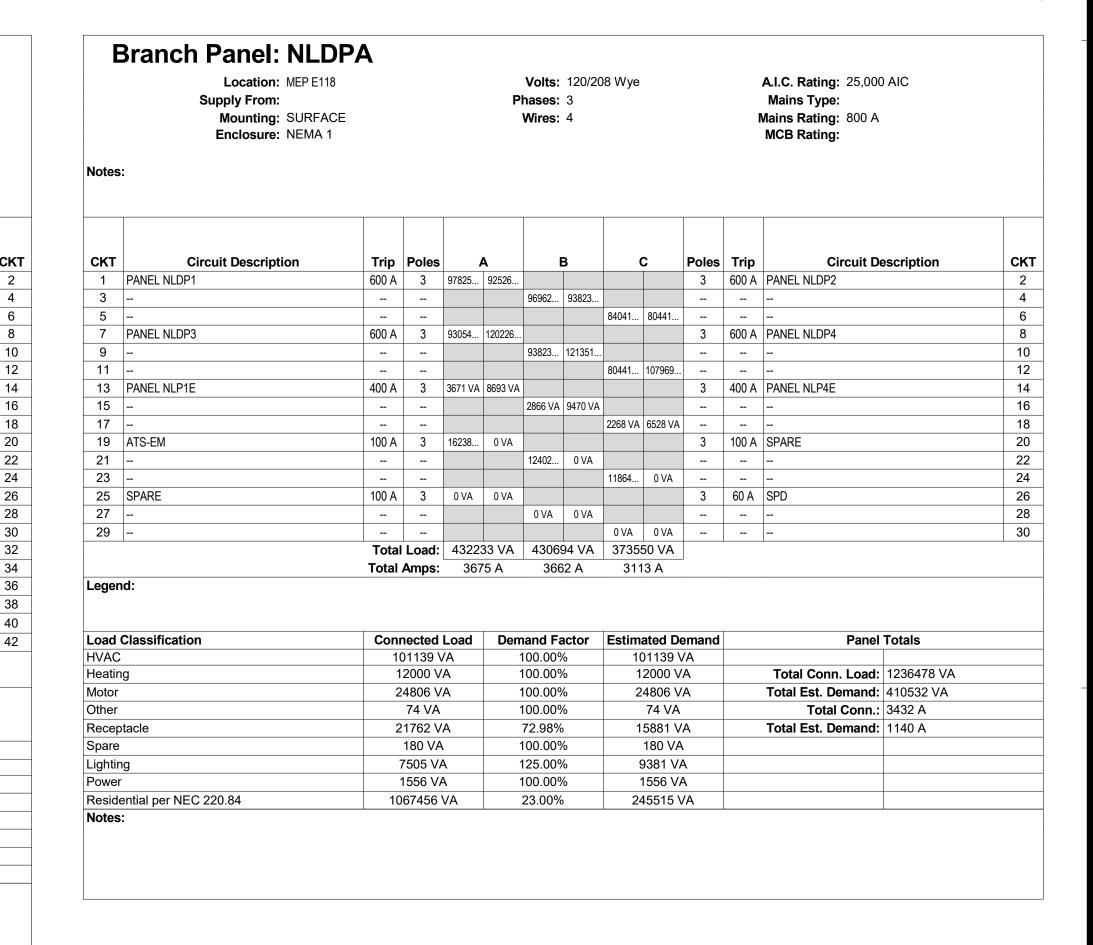

PROJECT TITLE

GENERAL NOTES



SFCS Inc. • 1927 South Tryon St. - Suite 207 Charlotte, North Carolina 28203.4633 704.372.7327 • Fax 704.372.7369 www.sfcs.com


DESIGNER : DAS		DRAWN		MAW, DKW								
ARCHITECT : DAS		CHECKED		MAW								
ENGINEER : MAW		APPROVED		JSK								
NO.	REVISION DESCRIPTION											
		_										

Rev 1 - Permit Comments

PANELBOARD SCHEDULES


Autodesk Docs://23104.00 - John Knox Village - Lindbergh/23104.00-JKV-Courtyards-Building E-Electrical & Low Voltage CENTRAL.rvt


1:00:20 PM

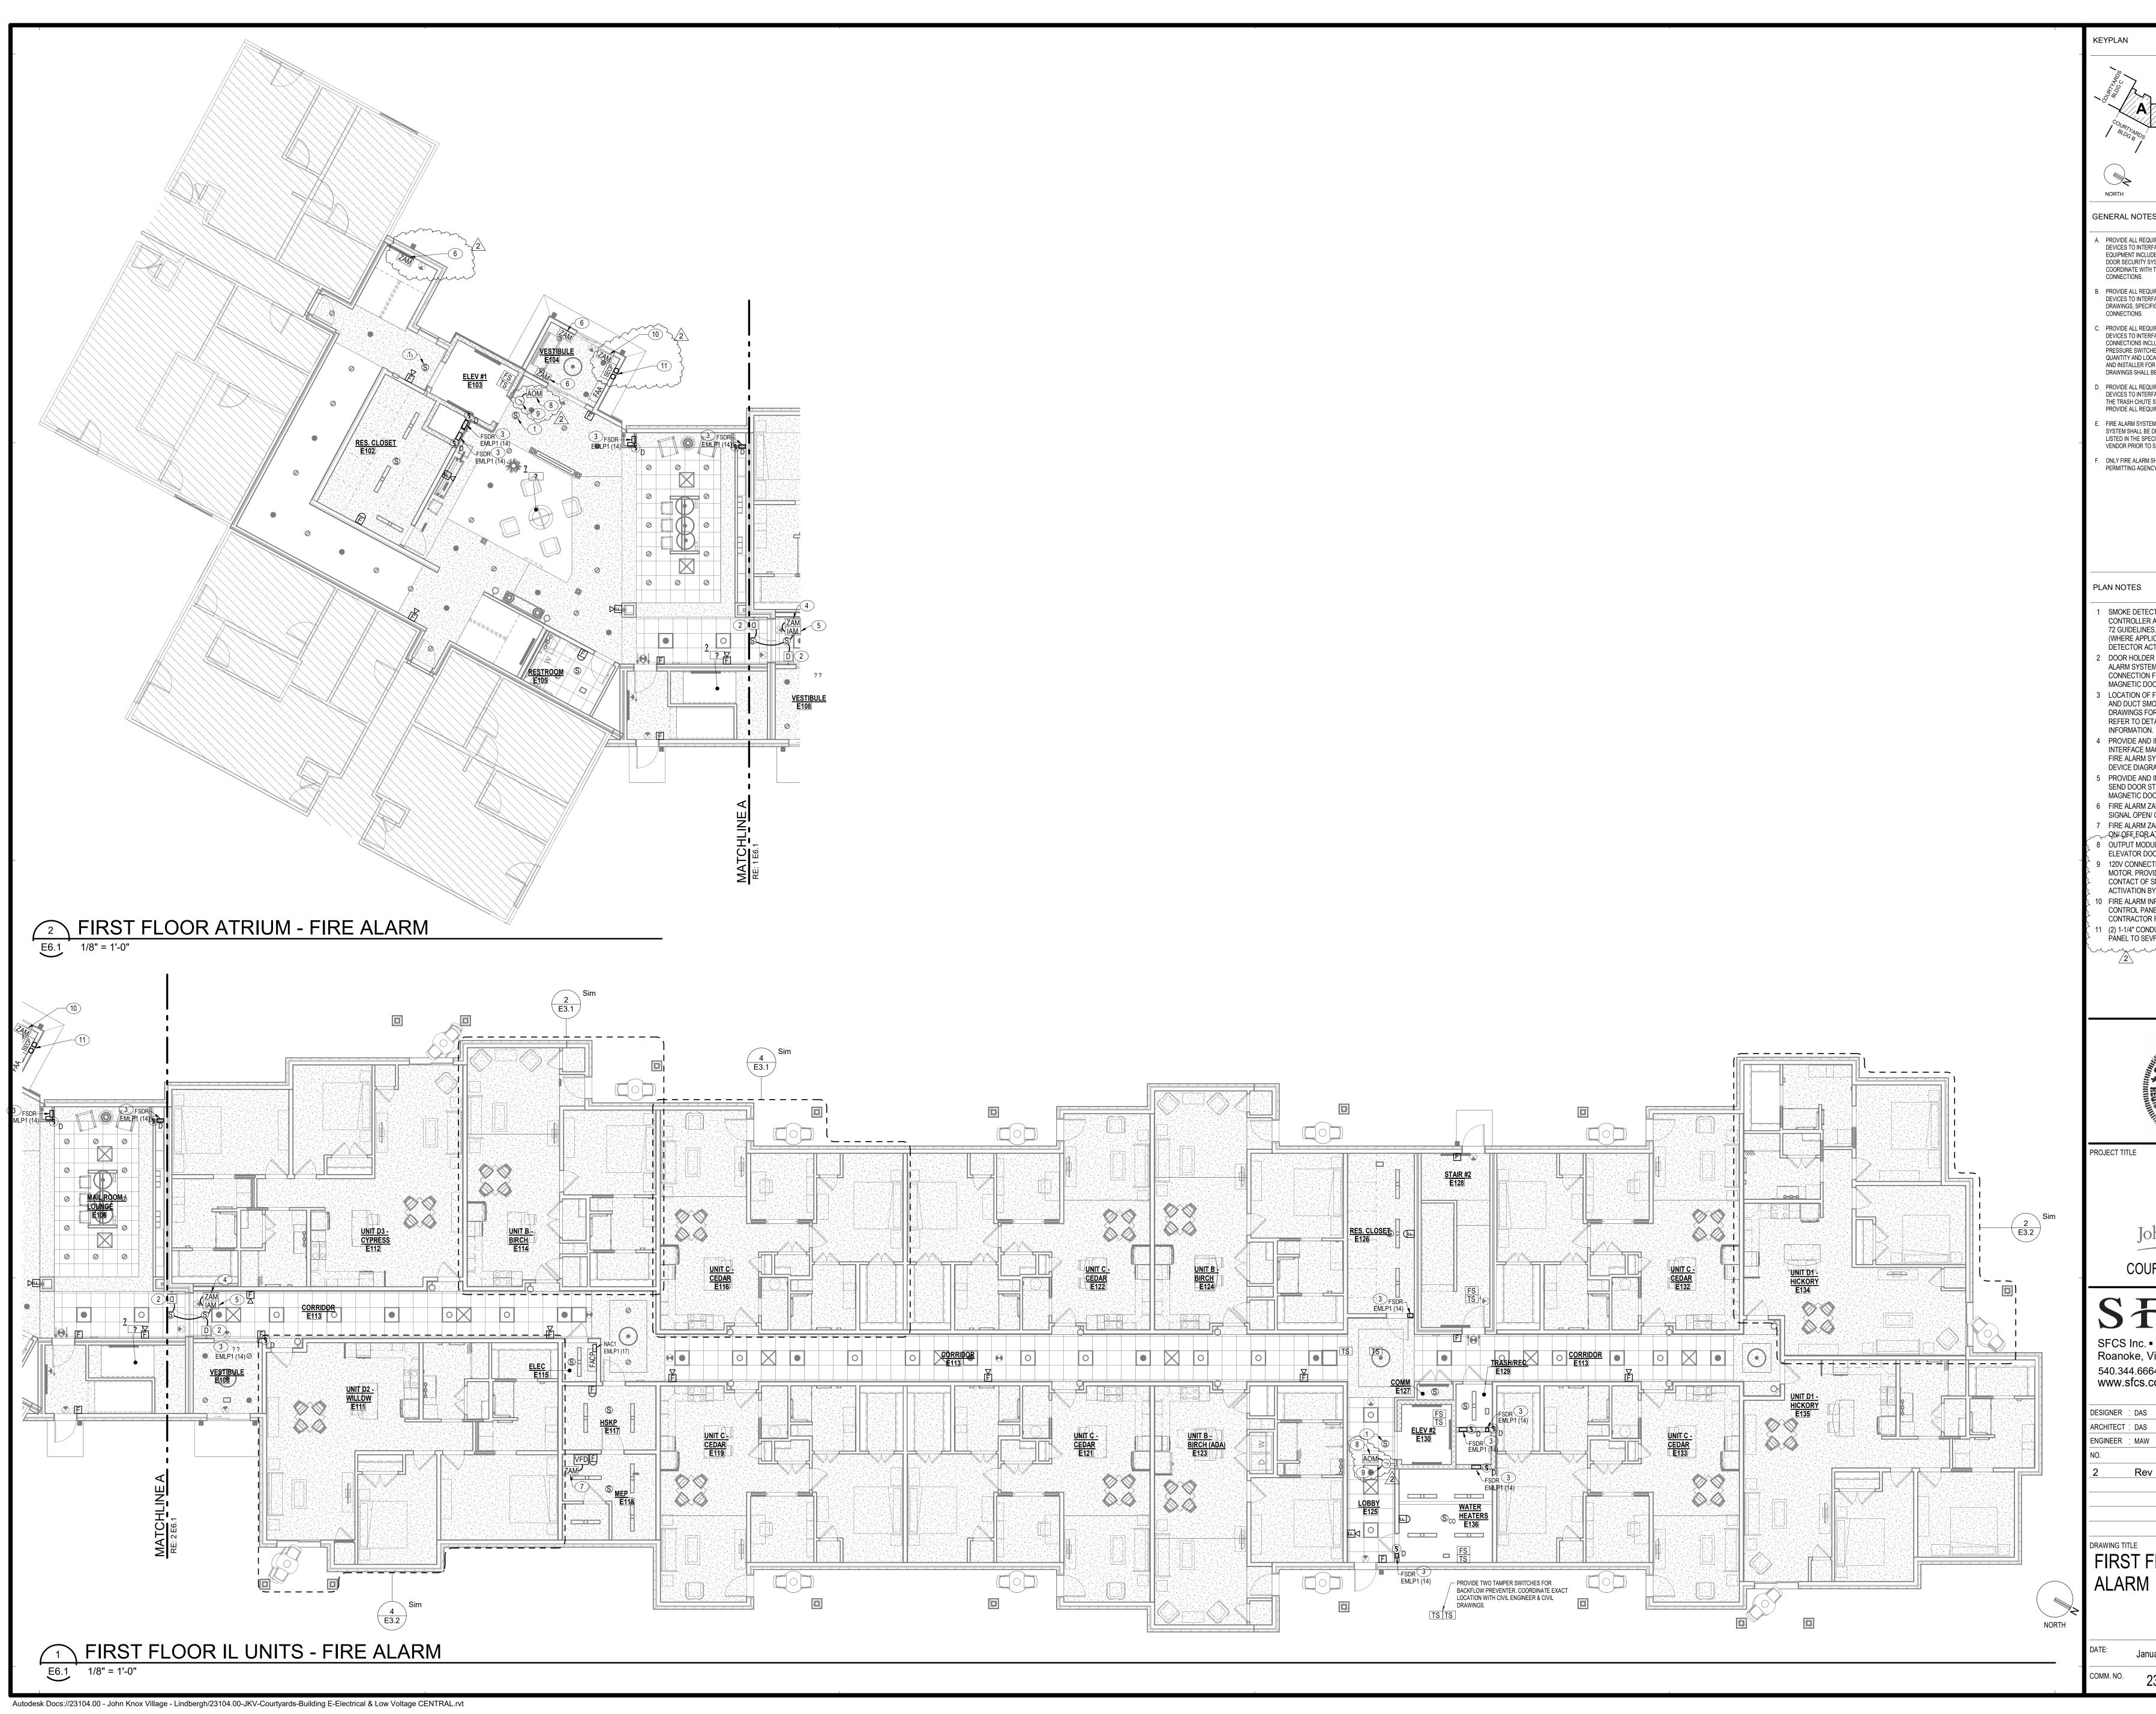


**GENERAL NOTES** A. PROVIDE ALL REQUIRED CONNECTIONS, MATERIALS AND FIRE ALARM DEVICES TO INTERFACE TO ANY LOW VOLTAGE EQUIPMENT. LOW VOLTAGE EQUIPMENT INCLUDES, BUT IS NOT LIMITED TO, EMERGENCY CALL SYSTEM, DOOR SECURITY SYSTEM, ETC. REFER TO LOW VOLTAGE SUBMITTALS AND COORDINATE WITH THE LOW VOLTAGE INSTALLERS FOR REQUIRED . PROVIDE ALL REQUIRED CONNECTIONS, MATERIALS AND FIRE ALARM DEVICES TO INTERFACE TO HVAC EQUIPMENT. REFER TO THE HVAC DRAWINGS, SPECIFICATIONS AND SUBMITTALS FOR REQUIRED PROVIDE ALL REQUIRED CONNECTIONS, MATERIALS AND FIRE ALARM DEVICES TO INTERFACE WITH THE SPRINKLER SYSTEM. SPRINKLER SYSTEM CONNECTIONS INCLUDE, BUT IS NOT LIMITED TO, FLOW SWITCHES, PRESSURE SWITCHES, SUPERVISORY SWITCHES, ETC. COORDINATE QUANTITY AND LOCATION OF SWITCHES WITH THE SPRINKLER DRAWINGS AND INSTALLER FOR REQUIRED CONNECTIONS. NOTE THAT SPRINKLER DRAWINGS SHALL BE PROVIDED BY THE SPRINKLER CONTRACTOR. PROVIDE ALL REQUIRED CONNECTIONS, MATERIALS AND FIRE ALARM DEVICES TO INTERFACE TO THE TRASH CHUTE DOOR INTERLOCKS. REFER TO THE TRASH CHUTE SUBMITTAL AND COORDINATE WITH THE INSTALLER TO PROVIDE ALL REQUIRED CONNECTIONS. . FIRE ALARM SYSTEM DEVICES SHOWN ARE FOR BIDDING PURPOSES ONLY. SYSTEM SHALL BE DESIGNED BY AN ENTITY MEETING THE REQUIREMENTS LISTED IN THE SPECIFICATIONS. COORDINATE WORK WITH FIRE ALARM VENDOR PRIOR TO SUBMITTING BIDS. ONLY FIRE ALARM SHOP DRAWINGS APPROVED BY ENGINEER AND PERMITTING AGENCY SHALL BE USED FOR CONSTRUCTION. SMOKE DETECTOR SHALL BE INTERLOCKED WITH ELEVATOR CONTROLLER AS REQUIRED FOR ELEVATOR RECALL PER NFPA 72 GUIDELINES. CONNECT TO ELEVATOR SMOKE CURTAIN (WHERE APPLICABLE) FOR DEPLOYMENT UPON SMOKE DETECTOR ACTIVATION. 2 DOOR HOLDER SHALL RELEASE UPON ACTIVATION OF FIRE ALARM SYSTEM. PROVIDE LIFE SAFETY BRANCH CIRCUIT CONNECTION FOR MAGNETIC DOOR HOLDER. REFER TO MAGNETIC DOOR HOLD OPEN DEVICE DIAGRAM ON SHEET E6.6. 3 LOCATION OF FIRE SMOKE DAMPER WITH 120VAC CONNECTION AND DUCT SMOKE DETECTOR. COORDINATE WITH MECHANICAL DRAWINGS FOR EXACT LOCATION OF FIRE/ SMOKE DAMPERS. REFER TO DETAILS ON DRAWING E0.022 FOR ADDITIONAL INFORMATION. 4 PROVIDE AND INSTALL AN ADDRESSABLE RELAY MODULE AND INTERFACE MAGNETIC DOOR HOLDER OPERATION WITH THE FIRE ALARM SYSTEM. REFER TO MAGNETIC DOOR HOLD OPEN DEVICE DIAGRAM ON SHEET E6.6. PROVIDE AND INSTALL AN ADDRESSABLE INPUT MODULE TO SEND DOOR STATUS TO THE FIRE ALARM SYSTEM. REFER TO MAGNETIC DOOR HOLD OPEN DEVICE DIAGRAM ON SHEET E6.6. 6 FIRE ALARM ZAM CONNECTED TO DOOR CONTROLLER TO SIGNAL OPEN/ CLOSE FOR ATRIUM SMOKE EVACUATION. 7 FIRE ALARM ZAM MODULE FOR CONTROL OF VFD TO SIGNAL ~QN/QFF, FQR.ATRIUM-SMQKE, EVACUATION-8 OUTPUT MODULE FOR INTERFACE TO SMOKE CURTAIN AT ELEVATOR DOOR. 9 120V CONNECTION TO ELEVATOR SMOKE CURTAIN REWIND MOTOR. PROVIDE ALARM CIRCUIT FROM N.O. AUXILIARY CONTACT OF SMOKE DETECTOR FOR CONNECTION TO AND ACTIVATION BY FIRE ALARM SYSTEM. 10 FIRE ALARM INPUT COTROL MODULE FOR SMOKE EVACUTION CONTROL PANEL. COORDINATE WITH MECHANICAL CONTRACTOR FOR CONNECTIONS 11 (2) 1-1/4" CONDUITS FROM SMOKE EVACUATION CONTROL PANEL TO SEVF FANS ON ATRIUM ROOF. John Knox Village COURTYARDS - BUILDING E SFCS Inc. • 305 South Jefferson Street Roanoke, Virginia 24011.2003 540.344.6664 • Fax 540.343.6925 www.sfcs.com DRAWN : MAW, DKW CHECKED : MAW APPROVED ; JSK REVISION DESCRIPTION Rev 1 - Permit Comments 02/15/24 FIRST FLOOR PLAN - FIRE

2/16/2024 1:00:28 PM

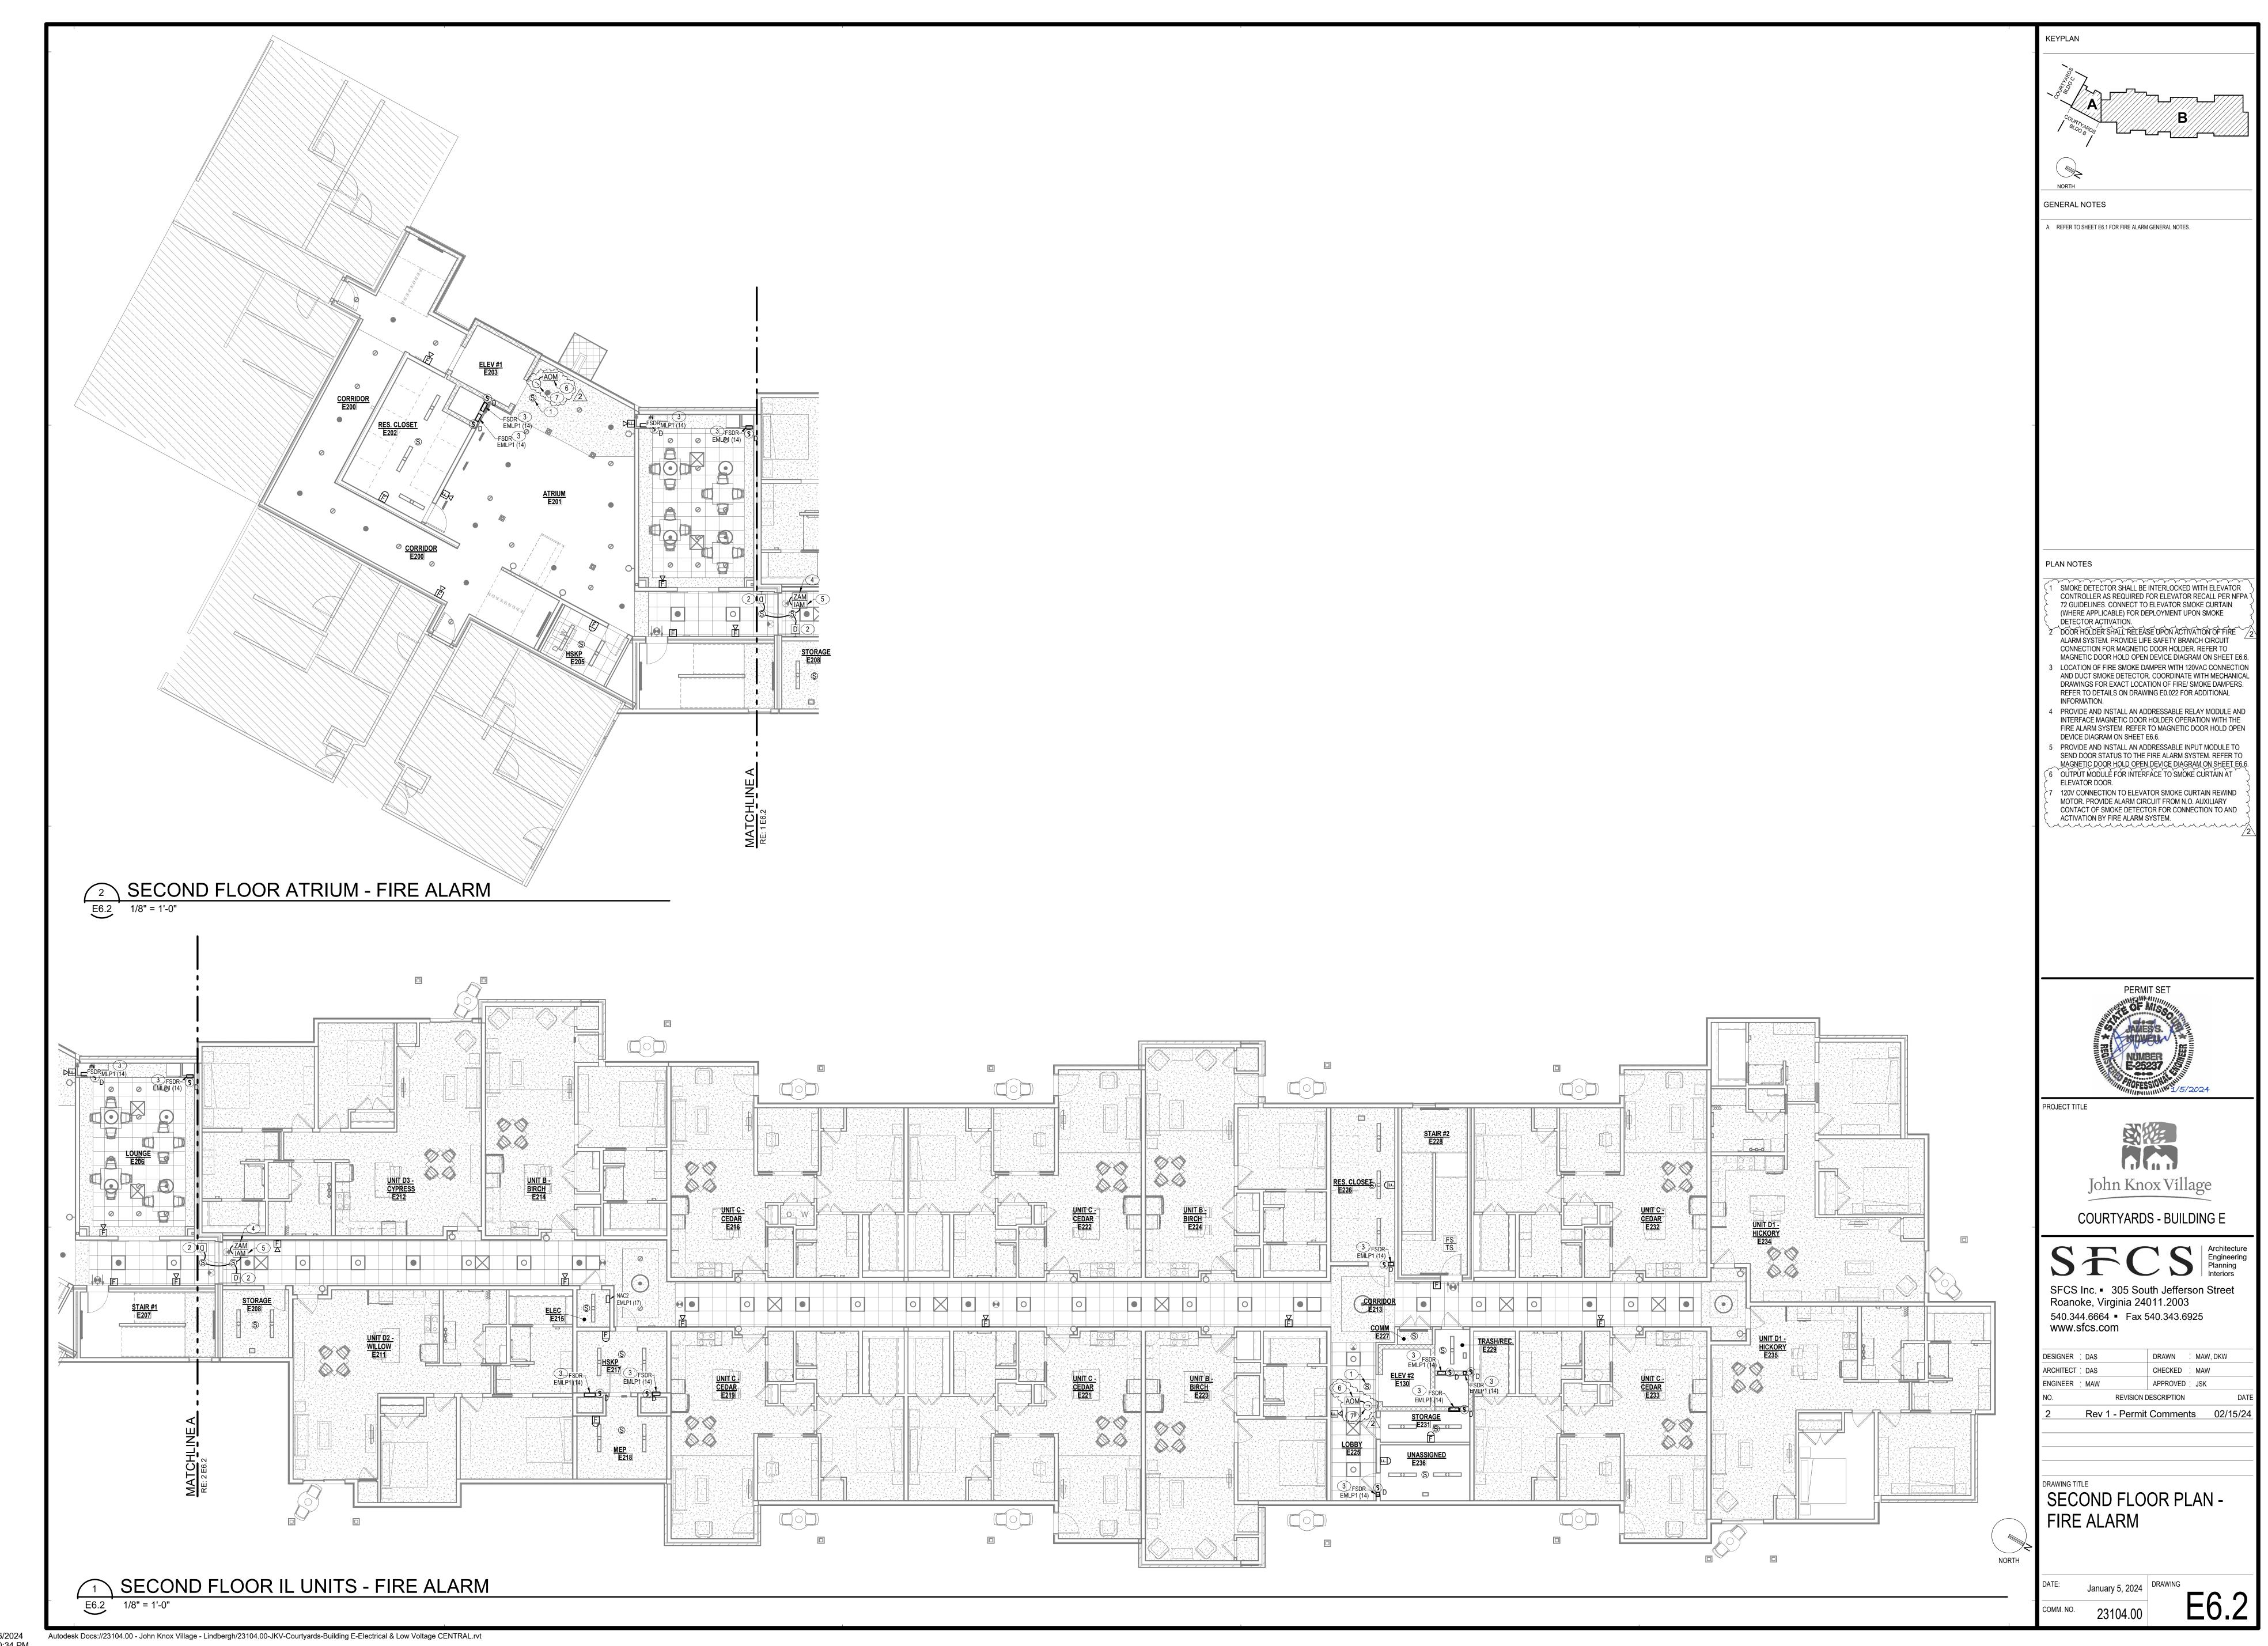

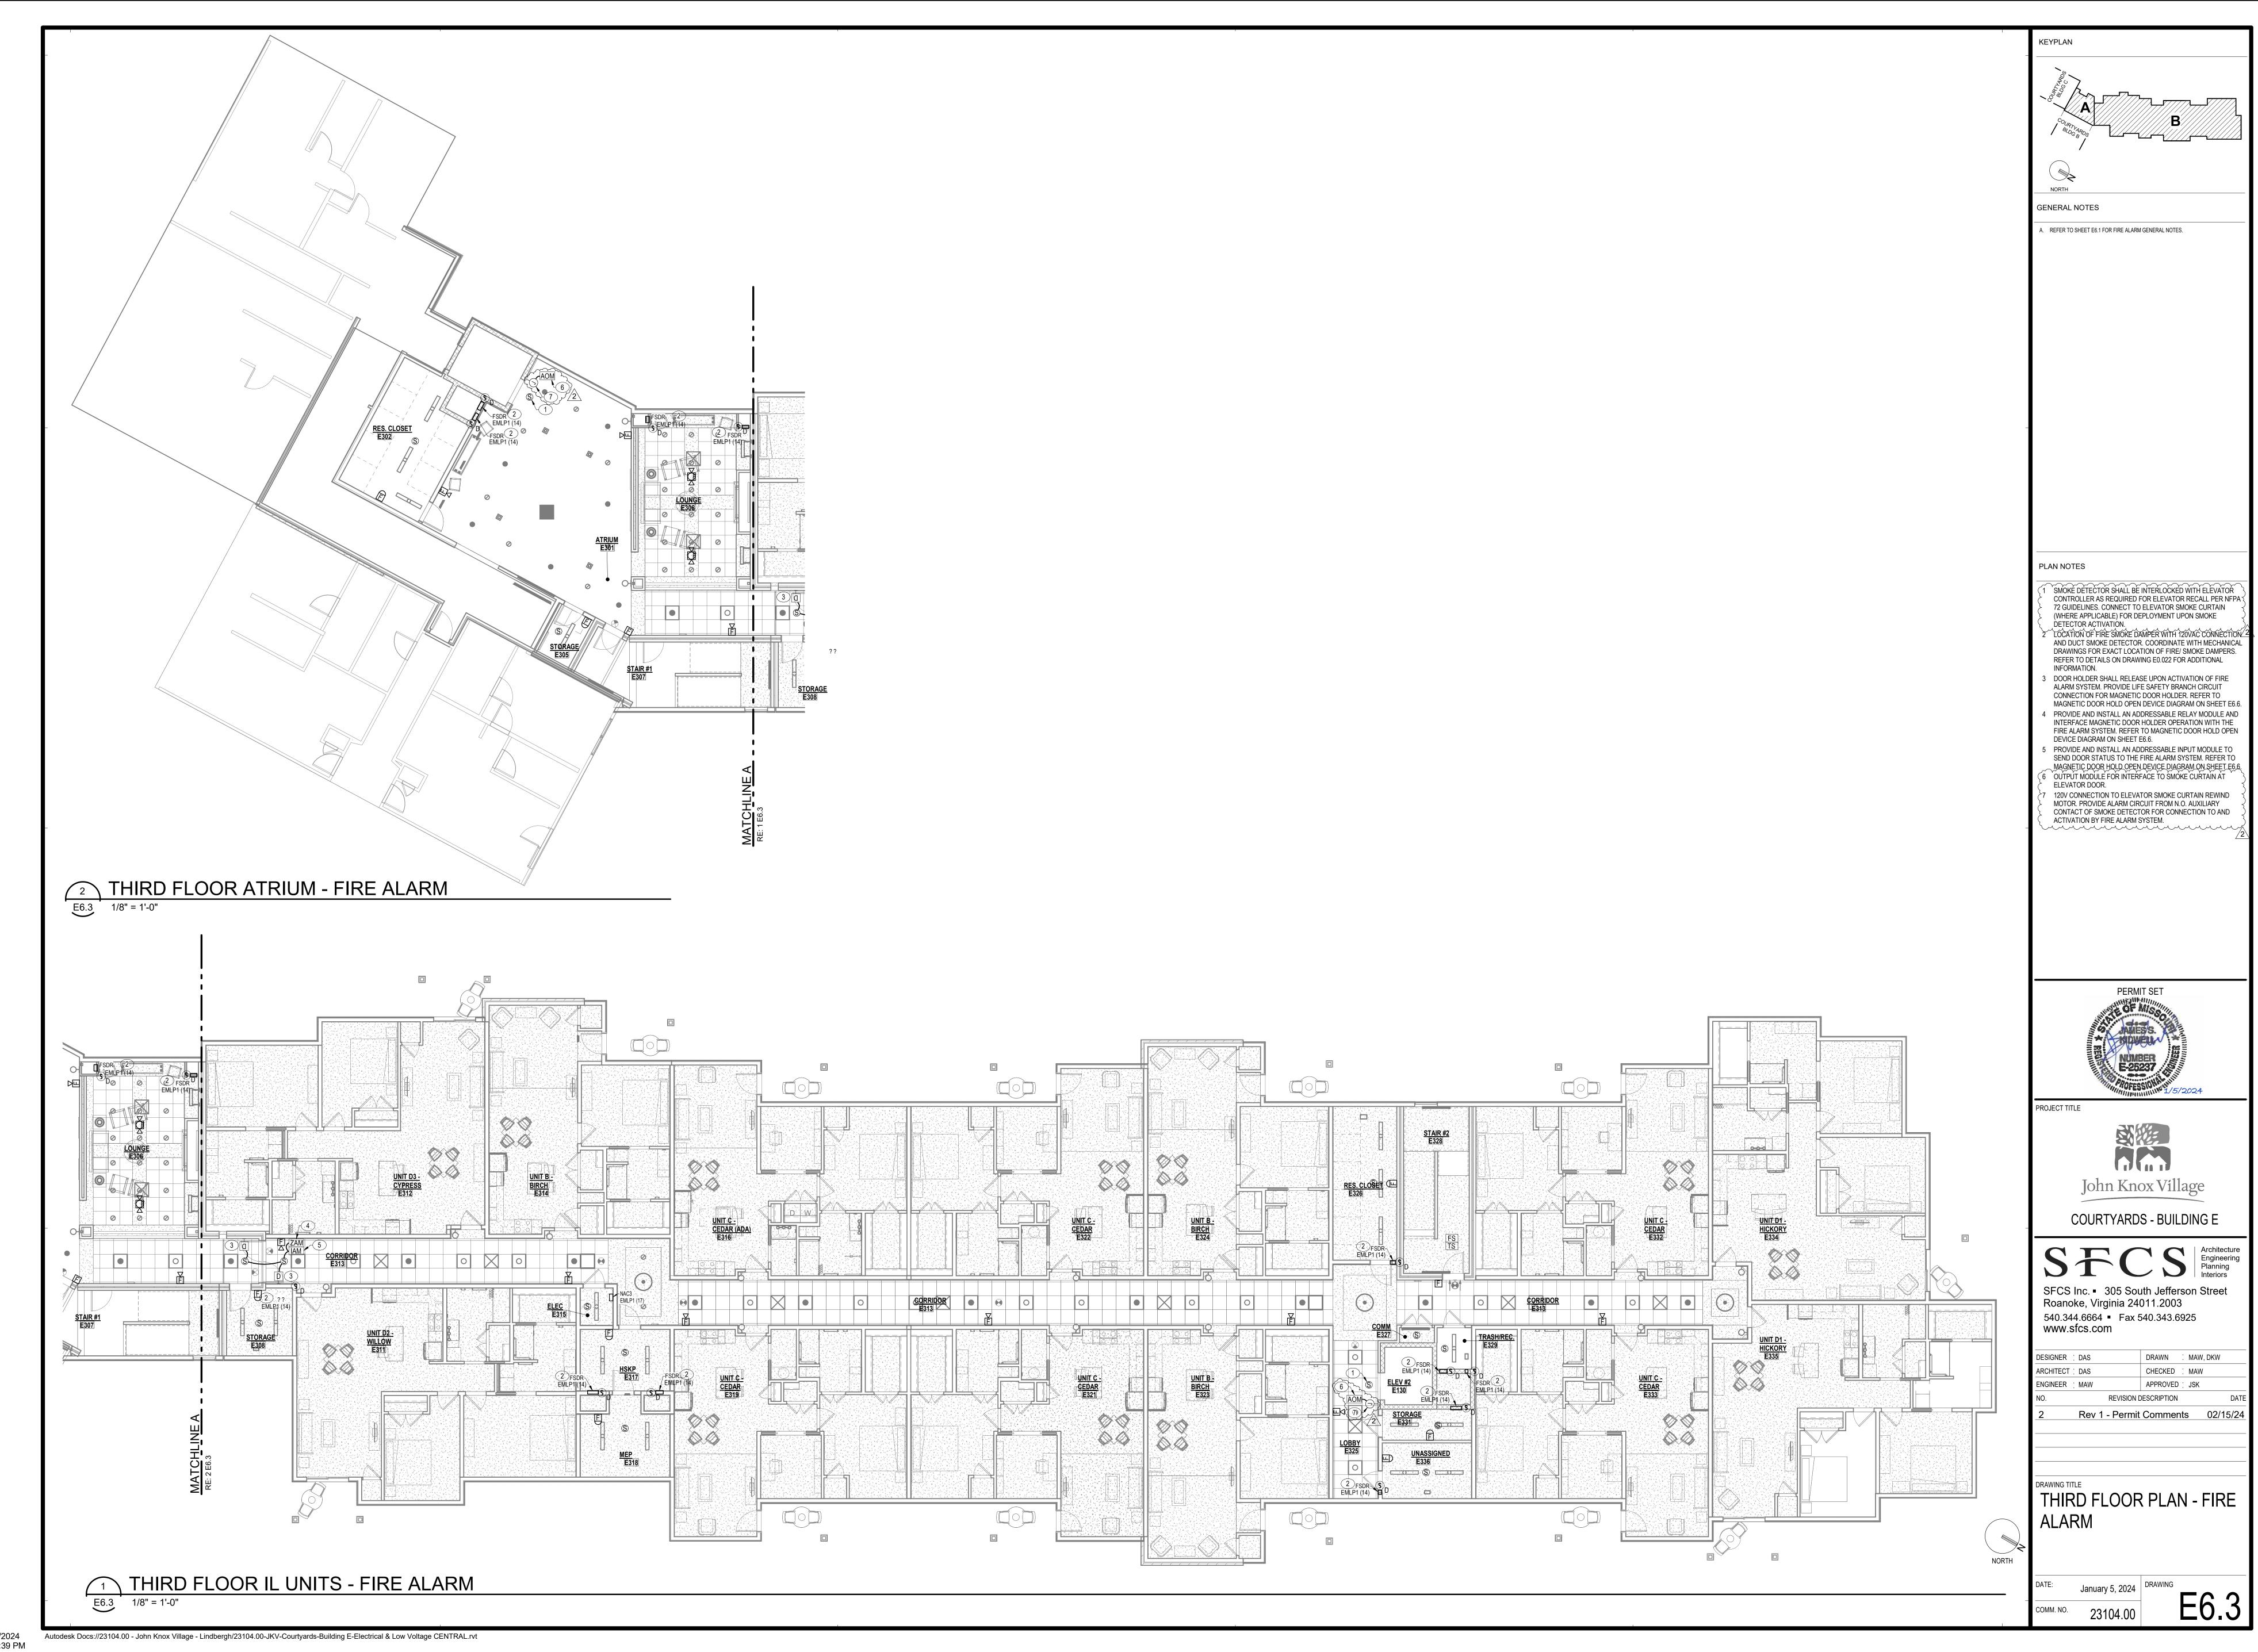

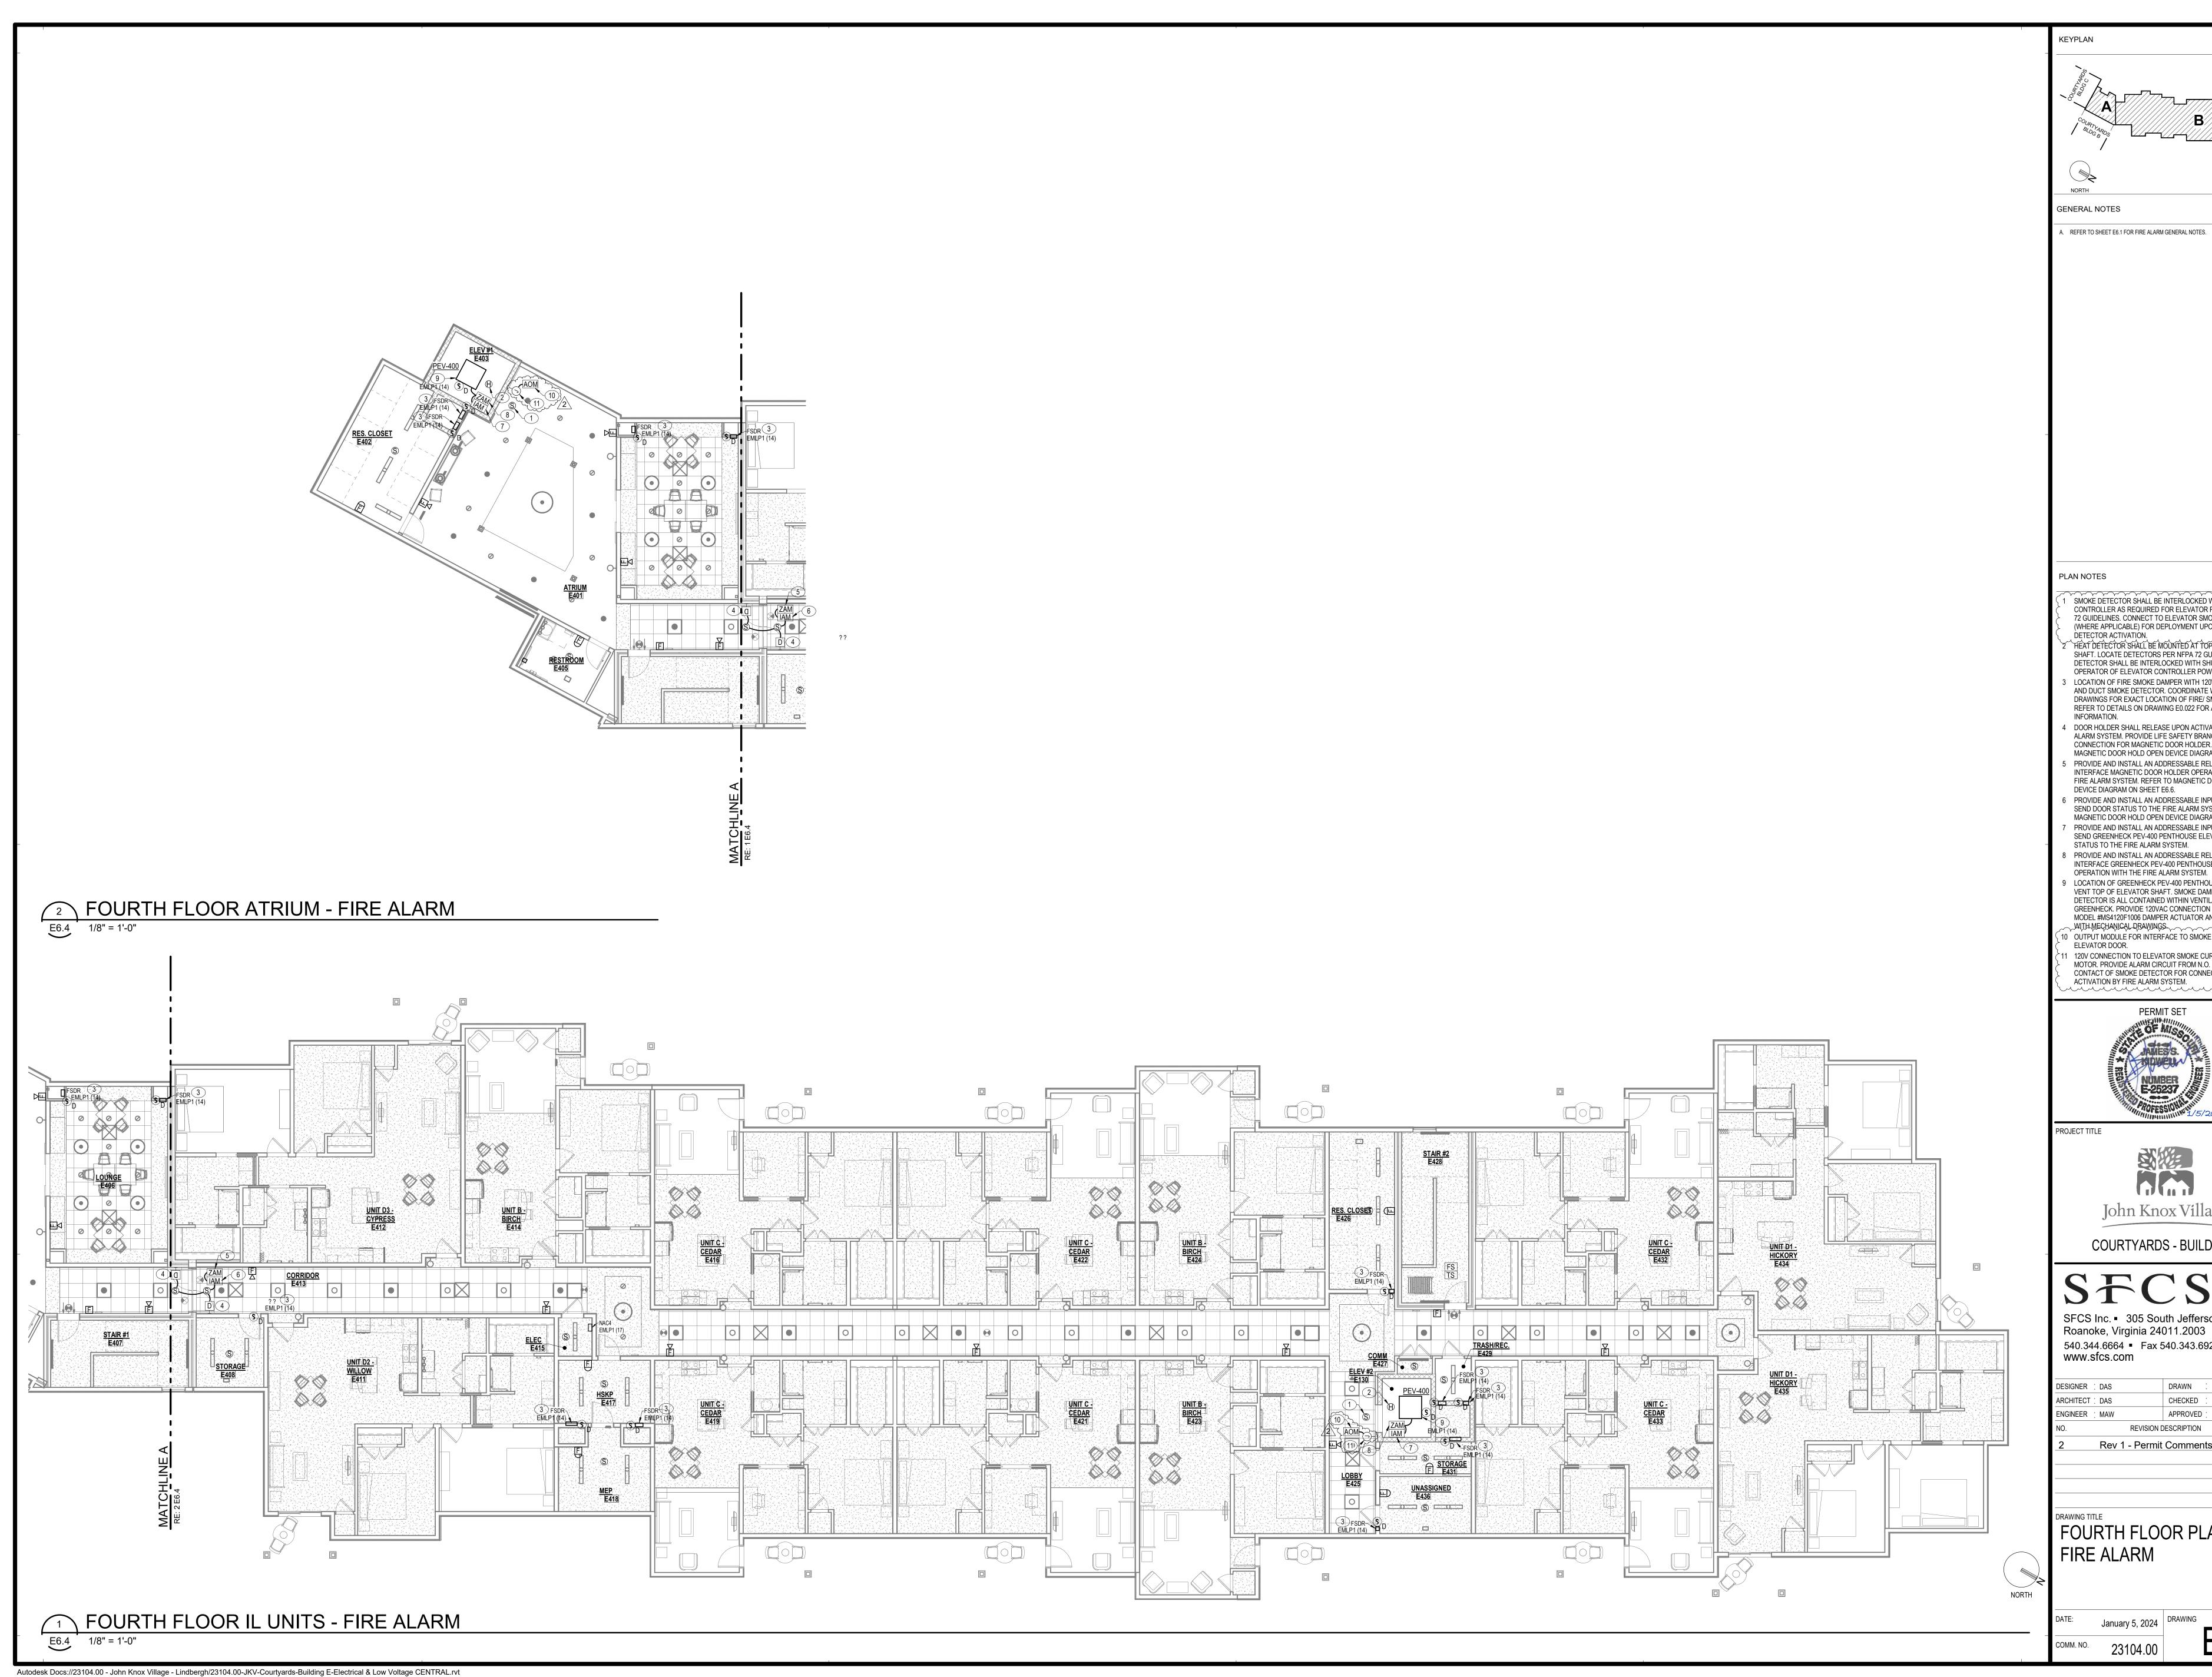

PLAN NOTES SMOKE DETECTOR SHALL BE INTERLOCKED WITH ELEVATOR CONTROLLER AS REQUIRED FOR ELEVATOR RECALL PER NFPA 72 GUIDELINES. CONNECT TO ELEVATOR SMOKE CURTAIN (WHERE APPLICABLE) FOR DEPLOYMENT UPON SMOKE DETECTOR ACTIVATION. 2 HEAT DETECTOR SHALL BE MOUNTED AT TOP OF ELEVATOR SHAFT. LOCATE DETECTORS PER NFPA 72 GUIDELINES. HEAT  $^{\it L}$  DETECTOR SHALL BE INTERLOCKED WITH SHUNT TRIP OPERATOR OF ELEVATOR CONTROLLER POWER DISCONNECT AND DUCT SMOKE DETECTOR. COORDINATE WITH MECHANICAL DRAWINGS FOR EXACT LOCATION OF FIRE/ SMOKE DAMPERS. REFER TO DETAILS ON DRAWING E0.022 FOR ADDITIONAL INFORMATION. 4 DOOR HOLDER SHALL RELEASE UPON ACTIVATION OF FIRE ALARM SYSTEM. PROVIDE LIFE SAFETY BRANCH CIRCUIT CONNECTION FOR MAGNETIC DOOR HOLDER. REFER TO MAGNETIC DOOR HOLD OPEN DEVICE DIAGRAM ON SHEET E6.6. PROVIDE AND INSTALL AN ADDRESSABLE RELAY MODULE AND INTERFACE MAGNETIC DOOR HOLDER OPERATION WITH THE FIRE ALARM SYSTEM. REFER TO MAGNETIC DOOR HOLD OPEN DEVICE DIAGRAM ON SHEET E6.6. 6 PROVIDE AND INSTALL AN ADDRESSABLE INPUT MODULE TO SEND DOOR STATUS TO THE FIRE ALARM SYSTEM. REFER TO MAGNETIC DOOR HOLD OPEN DEVICE DIAGRAM ON SHEET E6.6. PROVIDE AND INSTALL AN ADDRESSABLE INPUT MODULE TO SEND GREENHECK PEV-400 PENTHOUSE ELEVATOR VENT STATUS TO THE FIRE ALARM SYSTEM. PROVIDE AND INSTALL AN ADDRESSABLE RELAY MODULE AND INTERFACE GREENHECK PEV-400 PENTHOUSE ELEVATOR VENT OPERATION WITH THE FIRE ALARM SYSTEM. 9 LOCATION OF GREENHECK PEV-400 PENTHOUSE ELEVATOR VENT TOP OF ELEVATOR SHAFT. SMOKE DAMPER AND SMOKE DETECTOR IS ALL CONTAINED WITHIN VENTILATOR FROM GREENHECK. PROVIDE 120VAC CONNECTION TO HONEYWELL MODEL #MS4120F1006 DAMPER ACTUATOR AND COORDINATE WITH MECHANICAL DRAWINGS.

10 OUTPUT MODULE FOR INTERFACE TO SMOKE CURTAIN AT ELEVATOR DOOR. 11 120V CONNECTION TO ELEVATOR SMOKE CURTAIN REWIND MOTOR. PROVIDE ALARM CIRCUIT FROM N.O. AUXILIARY CONTACT OF SMOKE DETECTOR FOR CONNECTION TO AND ACTIVATION BY FIRE ALARM SYSTEM. PROJECT TITLE John Knox Village COURTYARDS - BUILDING E SFCS Inc. • 305 South Jefferson Street Roanoke, Virginia 24011.2003 540.344.6664 Fax 540.343.6925 www.sfcs.com DESIGNER : DAS DRAWN : MAW, DKW ARCHITECT : DAS CHECKED : MAW APPROVED ; JSK REVISION DESCRIPTION Rev 1 - Permit Comments 02/15/24 FOURTH FLOOR PLAN -FIRE ALARM