## copyright:

The following documents are the sole property of davidson architecture & engineering, Ilc for the specific purpose of construction of said building. These documents are considered confidential and subject to davidson architecture & engineering Ilc's copyright protection. Neither receipt nor possession transfers any rights to reproduce these documents or any part thereof. Any re-use of these documents without the express written permission of davidson architecture & engineering, Ilc is strictly prohibited and shall confer no liability to davidson architecture & engineering, Ilc.

### disclaimer:

These documents are accurate to the best of davidson architecture & engineering, Ilc's professional knowledge. In the event a discrepancy in the documents is encountered, it is the responsibility of that party to notify davidson architecture & engineering in a timely manner, for corrections and/or explanation of the documents.

# project description:

An interior renovation of an existing motor vehicle sales facility

Project Address: 1051 SE Oldham Pkwy
Lee's Summit, Missouri 64081

Responding Fire Service: Lee's Summit Fire Station 6
101 NE Blackwell Road

Lee's Summit, Missouri 64081

Building Inspection Department: Development Services

220 SE Green

Lee's Summit, MO 64063 Phone: (816) 969-1200

# code synopsis

### Adopted Code:

The enclosed documents are reviewed utilizing the currently adopted code for the city of Lee's Summit, Missouri

2018 International Building Code

2018 International Existing Building Code

2018 International Plumbing Code

2018 International Mechanical Code 2018 International Fuel Gas Code

2017 National Electrical Code

2018 International Energy Conservation Code

2018 International Swimming Pool and Spa Code

2018 International Property Maintenance Code

2018 International Fire Code

Occupancy Classification and Use:

2009 Accessible and Usable Buildings and Facilities ICC/ANSI A1117.1

Construction Type:

(III-B (As Reported by Local Jurisdiction)

Automatic Sprinkler System: Yes

Fire-Resistance Rating Requirements for Building Elements per Table 601

S-1 / B

Primary Structural Frame:
Bearing Walls:
 Exterior
 Interior
Nonbearing Walls & Partitions:
 Exterior
 Interior
Floor Construction
Roof Construction

# code synopsis continued:

Building Height: Per Table 504.4

Allowable 4 Stories
Actual 2 Stories
Allowable 3 Stories
Actual 2 Stories

Building Area: Per Table 506

Occupancy Separation Requirements (per table 508.3.3):

S-1 to B No separation requirement between occupancies

Jeep Mountain Rockscape

Integrated sculpted Jeep logo inlay sign.

Size: (approximate) 17'x13'-6"x61"

fixture (supplied by MSI)

Sculpted rock ramp display for showcasing/displaying vehicles.

### sheet index:

### Coversheet

### Architectural

A0.1 Proposed Area Plan
D1.0 Overall First Floor Demo Pla

D1.0 Overall First Floor Demo Plan
D1.1 Reflected Ceiling Demo Plan

A1.0 Overall First Floor PlanA1.1 Interior Elevations and DetailsA2.1 Reflected Ceiling Plan

A2.2 Lighting Schedules

A2.3 Alternate Lighting Schedules

I1.1 Overall First Floor Finish PlanI1.2 Overall First Floor Furniture Plan

I1.3 Finish ScheduleI1.4 Room Finish Sche

Room Finish Schedule & Approved Program Suppliers

### client:

Mr. John C. McCarthy Mr. Jeff Anthony WRL Investments, LP 675 North Rawhide Olathe, Kansas 66061

### owner:


Mr. John C. McCarthy Mr. Jeff Anthony WRL Investments, LP 675 North Rawhide Olathe, Kansas 66061

### architect:

Karen M. Oppliger, RA
Davidson Architecture & Engineering
4301 Indian Creek Parkway
Overland Park, Kansas 66207
p: 913.451.9390 f: 913.451.9391

# MEP Engineer:

TBD - MEP by Contractor

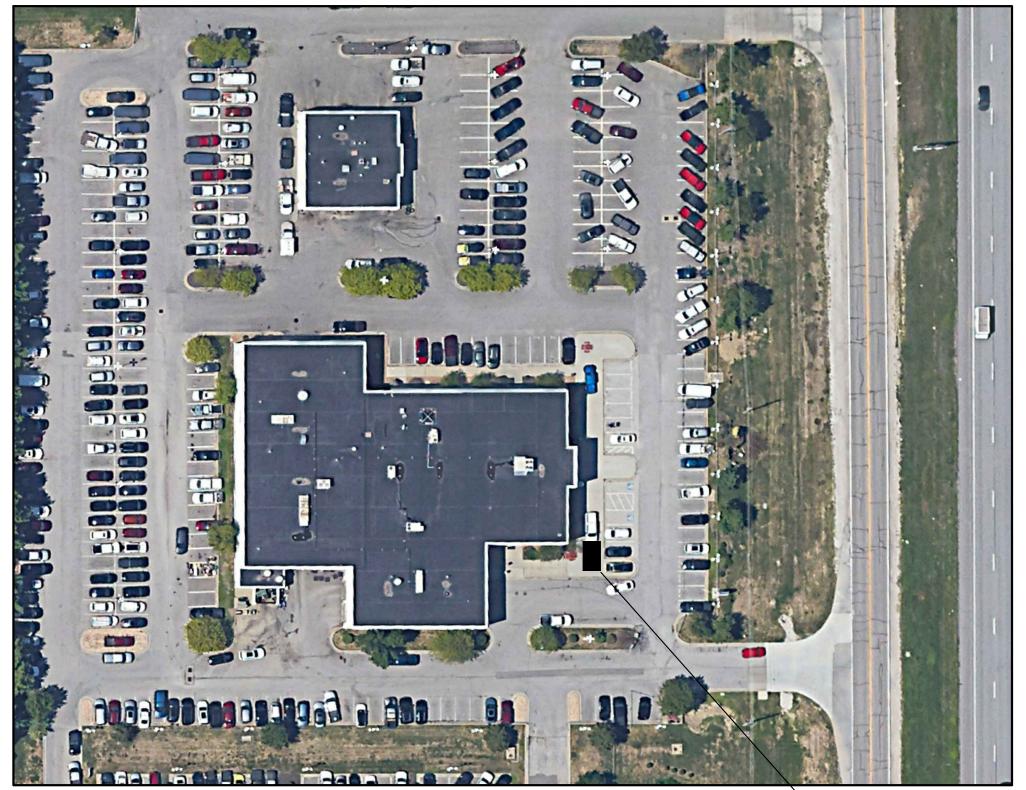

Jeep Mountain
 Rockscape fixture
 location(supplied by MSI)

a remodel for

Starthy CDJR of Lee

RELEASED FOR
CONSTRUCTION
As Noted on Plans Review

architecture&engineering

KAREN M.

**OPPLIGER** 


A-2009010461

Missour

**(**)

**(**)

cover sheet

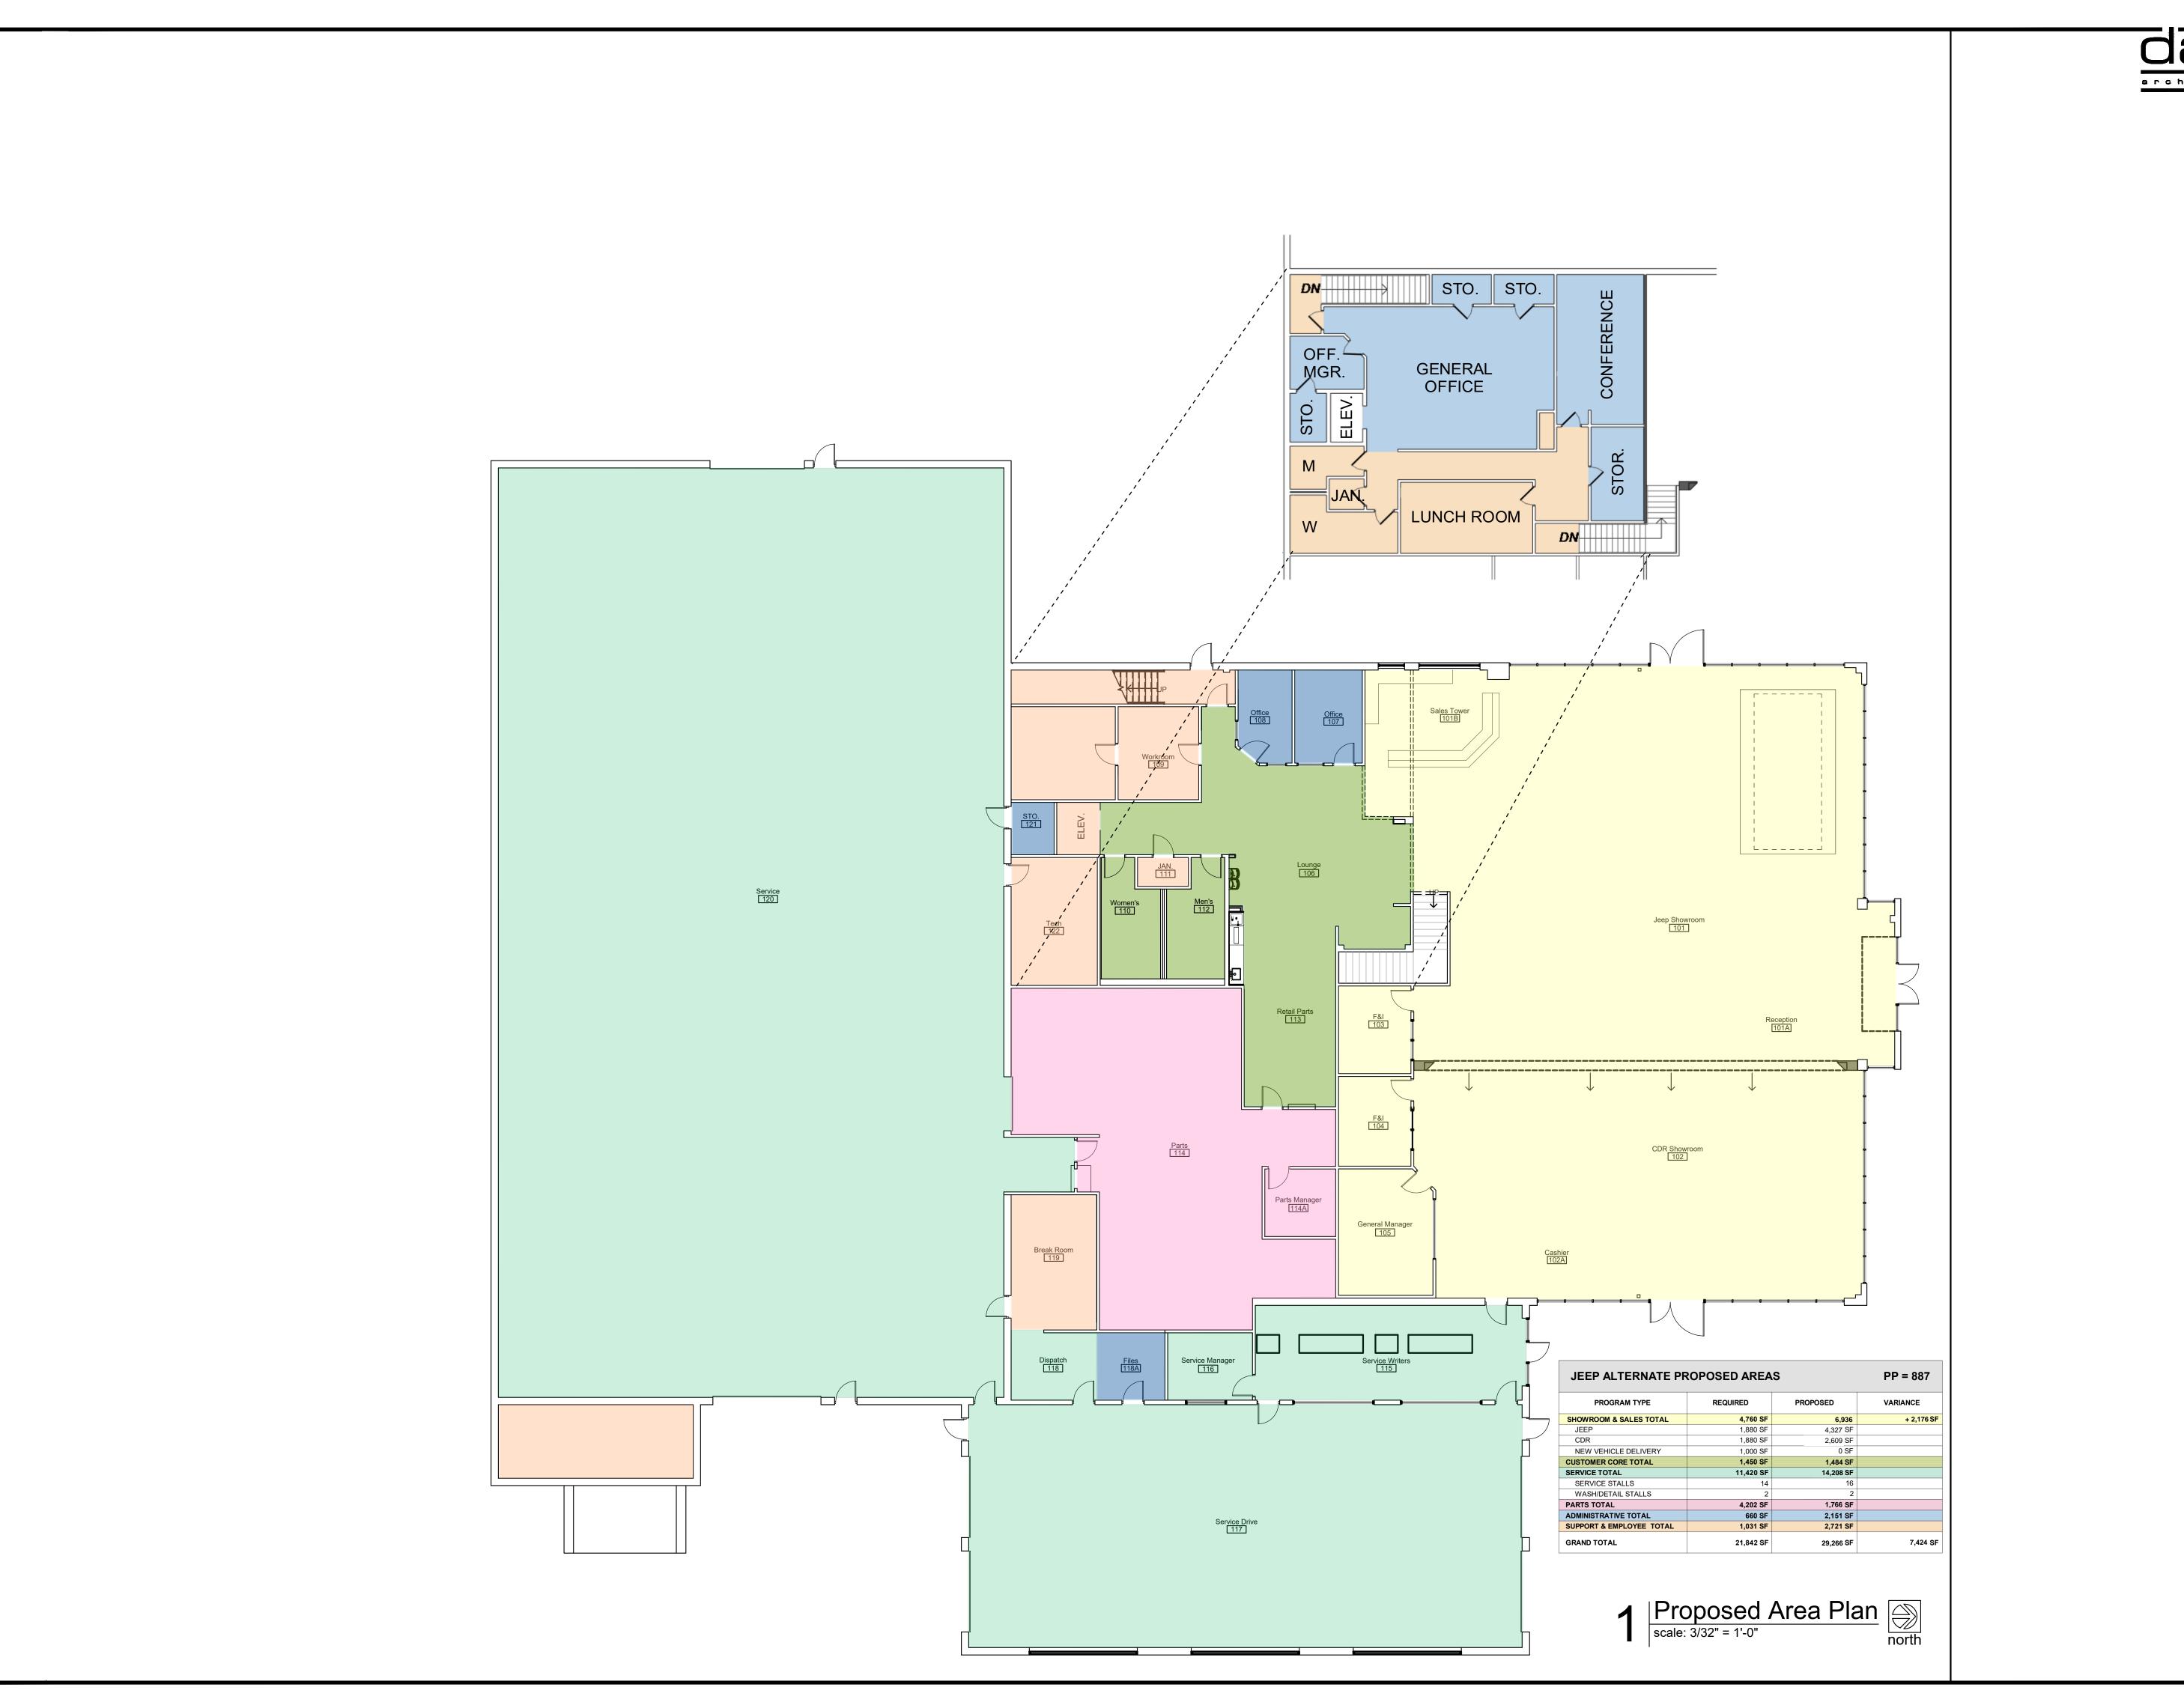



4301 Indian Creek Parkway Overland Park, KS 66207 phone: 91 3.451 .9390 www.davidsonae.com **OPPLIGER** 

**date** 09.28.2023

drewn by
DAE
checked by
DAE
revisions

sheet number **drewing type** 90% Set **project number** 23164



### Demolition Legend - Floors / Walls

Remove existing Tile, mastic & wall base clean to

substrate below as required to provide new finish.



Remove existing Carpet, mastic & wall base clean to substrate below as required to provide new finish.



**----** Remove existing tile wall base; extent demonstrated

### Demolition - General Notes

with dashed line

- These plans are for a specific project as designed by Davidson Architecture and Engineering. They are not to be used in any way, whole, or in part, for any other project or
- Davidson Architecture and Engineering specifically disclaims any existing building conditions or dimensions; new or existing mechanical, electrical, or plumbing
- Dashed lines and areas annotated are to be removed per demolition notes.
- General contractor and all sub-contractors shall familiarize themselves with the project construction documents and the project site and notify the Architect and building Owner of any discrepancies with each.
- General contractor and all related sub-contractors shall be familiar with and understand all local codes, laws, and agencies that govern the work to be performed. The General contractor shall verify the locations of all
- utilities prior to any demolition or construction and verify disconnection with all utility companies as required. General contractor to be responsible for appropriate forms of waste removal and disposal.
- All MEP work to be design-build by contractor; contractor shall engage a qualified engineer to revise systems as required by the local jurisdiction and submit to the city for review and approval where so required.
- Existing mechanical, electrical, and plumbing not affected by this project shall remain in working order and shall remain unaffected.
- Existing plumbing and associated fixtures, where newly exposed and unused, shall be removed, stubbed, and capped as required.
- •• Existing low voltage wiring and associated fixtures, where newly exposed and unused, shall be removed, stubbed, and capped as required. Existing electrical wiring and receptacles, where newly
- exposed and unused, shall be removed, stubbed, and capped as required.
- Existing mechanical system and ductwork, where newly exposed and unused, shall be removed, stubbed, and capped. • All doors and frames in demolished walls shall be removed
- in affected areas. It is the intent of the demolition to remove all existing
- construction which conflicts with the new work. • The general contractor shall be responsible for patching any materials disturbed due to construction/renovation to match existing conditions.
- The general contractor to remove all wall mounted accessories (toilet accessories, mirrors, bulletin boards, etc.) in areas scheduled for demolition and turn over to

### Keyed Demolition Notes #

- Remove existing wall in its entirety to height of adjacent sales tower header, including gypsum board, metal studs, wall finish, wall base, & accessories. Remove / reconfigure existing electrical, remove and cap plumbing, etc. 2. Remove existing carpet and prep to receive new flooring.
- Floor shall be smooth and free from bumps, ready for new flooring installation.
- 3. Remove existing wall base and prepare wall for new specified wall base.
- 4. Remove existing acoustic ceiling tile and grid in its entirety as required for new specific ceiling.
- 5. Remove existing casework, if necessary cap any plumbing and/or electrical. Remove existing sink, cap plumbing as required and patch
- floor and wall as required. Remove existing monitor, mount & backbox; salvage for
- Remove existing fire extinguisher and salvage for installation as required by local inspector.
- 9. Remove ceiling light and move to new location specified in RCP. Modify ceiling as required to accommodate new pre-manufactured "Jeep Gateway"
- 10. Remove existing glazing, door, and wall including gypsum board, metal studs, wall finish, wall base, accessories, electrical, plumbing, etc.and prepare for install of new frameless glass wall and door for office
- 11. Remove all showroom track lighting "truss" assemblies and 12. Remove existing toilets/urinal; salvage for reinstallation.
- 14. Remove existing tile floor and integral cove base clean to slab below; prep to receive new finish. Exercise caution removing tile at separation between existing tile in showroon
- to remain and new area to be carpeted. 15. Remove existing wall tile; patch / repair wall to receive new
- 16. Remove existing television monitor & wall bracket; protect from damage and salvage to owner. 17. Remove existing wall / floor mounted study carols in their
- 18. Remove existing hospitality bar in its entirety. 19. Remove existing wood / laminate and glass display cabinets
- 20. Remove existing wall mounted display fixture & salvage to 21. Remove existing storefront window in its entirety.
- 22. Remove existing alum storefront door and frame; protect and salvage for reinstallation. 23. Verify height of existing soffit in field; demo as required to raise soffit to required opening height.
- 24. Existing acoustical ceiling and grid remain. Remove discolored, stained, warped, sagging, cracked, broken or improperly cut acoustical ceiling tile; prep for replacement. 25. Remove cabinet / drawer faces as required for re-lamination
- or replacement. 26. Remove existing vanity top, backsplash, faucets and sinks; prep to received new millwork & plumbing.
- 27. Remove existing CDR graphic at soffit in its entirety. Patch, repair and / or skim coat wall as required to received new wallcovering or paint as indicated.

4301 Indian Creek Parkway Overland Park, KS 66207 phone: 913.451.9390



date 12.15.2023 drawn by DAE checked by DAE revisions

sheet number



### <u>Demolition Legend - Ceiling</u>

Existing Remain / No Work for ceiling scope of work

Existing Remain gyp header / soffit; u.n.o.

Existing linear diffuser to remain; clean & touch-up as required for "like new" appearance

Existing uplit wall sconce to remain; clean

Remove existing 2 x 2 troffer

Remove existing 2 x 4 troffer

Remove existing can light

### Demolition - General Notes

demolition notes.

- These plans are for a specific project as designed by Davidson Architecture and Engineering. They are not to be used in any way, whole, or in part, for any other project or purpose.
- Davidson Architecture and Engineering specifically disclaims any existing building conditions or dimensions; new or existing mechanical, electrical, or plumbing systems.
   Dashed lines and areas annotated are to be removed per
- General contractor and all sub-contractors shall familiarize themselves with the project construction documents and the project site and notify the Architect and building Owner
- of any discrepancies with each.

  General contractor and all related sub-contractors shall be familiar with and understand all local codes, laws, and
- familiar with and understand all local codes, laws, and agencies that govern the work to be performed.
   The General contractor shall verify the locations of all
- utilities prior to any demolition or construction and verify disconnection with all utility companies as required.
  General contractor to be responsible for appropriate forms of waste removal and disposal.
- All MEP work to be design-build by contractor; contractor shall engage a qualified engineer to revise systems as required by the local jurisdiction and submit to the city for review and approval where so required.
- and shall remain unaffected.
   Existing plumbing and associated fixtures, where newly exposed and unused, shall be removed,

•• Existing mechanical, electrical, and plumbing not

affected by this project shall remain in working order

- stubbed, and capped as required.

  •• Existing low voltage wiring and associated fixtures,
- where newly exposed and unused, shall be removed, stubbed, and capped as required.
   Existing electrical wiring and receptacles, where newly exposed and unused, shall be removed, stubbed, and
- capped as required.
   Existing mechanical system and ductwork, where newly exposed and unused, shall be removed,
- stubbed, and capped.
  All doors and frames in demolished walls shall be removed in affected areas.
- It is the intent of the demolition to remove all existing construction which conflicts with the new work.
   The general contractor shall be responsible for patching
- any materials disturbed due to construction/renovation to match existing conditions.
  The general contractor to remove all wall mounted accessories (toilet accessories, mirrors, bulletin boards, etc.) in areas scheduled for demolition and turn over to

### Keyed Demolition Notes #

- Remove existing wall in its entirety to height of adjacent sales tower header, including gypsum board, metal studs, wall finish, wall base, & accessories. Remove / reconfigure existing electrical, remove and cap plumbing, etc.
   Remove existing carpet and prep to receive new flooring. Floor shall be smooth and free from bumps, ready for new flooring installation.
- Remove existing wall base and prepare wall for new specified wall base.
- specified wall base.

  Remove existing acoustic ceiling tile and grid in its entiret
- Remove existing acoustic ceiling tile and grid in its entirety as required for new specific ceiling.
   Remove existing casework, if necessary cap any plumbing
- and/or electrical.Remove existing sink, cap plumbing as required and patch floor and wall as required.
- 7. Remove existing monitor, mount & backbox; salvage for reinstallation.
- 8. Remove existing fire extinguisher and salvage for installation as required by local inspector.9. Remove ceiling light and move to new location specified in
- RCP. Modify ceiling as required to accommodate new pre-manufactured "Jeep Gateway"

  10. Remove existing glazing, door, and wall including gypsum board, metal studs, wall finish, wall base, accessories,
- electrical, plumbing, etc.and prepare for install of new frameless glass wall and door for office 11. Remove all showroom track lighting "truss" assemblies and
- fixtures

  12. Remove existing toilets/urinal; salvage for reinstallation.

  13. Remove existing toilet partitions.
- 14. Remove existing tile floor and integral cove base clean to slab below; prep to receive new finish. Exercise caution removing tile at separation between existing tile in showroom to remain and new area to be carpeted.
  15. Remove existing wall tile; patch / repair wall to receive new
- 15. Remove existing wall tile; patch / repair wall to receive new finish.
  16. Remove existing television monitor % wall breaket: pretect
- 16. Remove existing television monitor & wall bracket; protect from damage and salvage to owner.17. Remove existing wall / floor mounted study carols in their
- 18. Remove existing hospitality bar in its entirety.
  19. Remove existing wood / laminate and glass display cabinets in their entirety.
- 20. Remove existing wall mounted display fixture & salvage to owner.
- 21. Remove existing storefront window in its entirety.22. Remove existing alum storefront door and frame; protect and salvage for reinstallation.
- salvage for reinstallation.

  23. Verify height of existing soffit in field; demo as required to
- raise soffit to required opening height.

  24. Existing acoustical ceiling and grid remain. Remove discolored, stained, warped, sagging, cracked, broken or
- 25. Remove cabinet / drawer faces as required for re-lamination or replacement.26. Remove existing vanity top, backsplash, faucets and sinks; prep to received new millwork & plumbing.

improperly cut acoustical ceiling tile; prep for replacement.

prep to received new millwork & plumbing.
Remove existing CDR graphic at soffit in its entirety. Patch, repair and / or skim coat wall as required to received new wallcovering or paint as indicated.

4301 Indian Creek Parkway Overland Park, KS 66207 phone: 913.451.9390 www.davidsonae.com

CONSTRUCTION

KAREN M.
OPPLIGER

A-2609010461

12-15-2023

# / Jeep Ram Chrysler Dodg

Carthy


dete
12.15.2023
drewn by
DAE
checked by
DAE
revisions

sheet number

D1.1

drawing type
permit
project number

23164

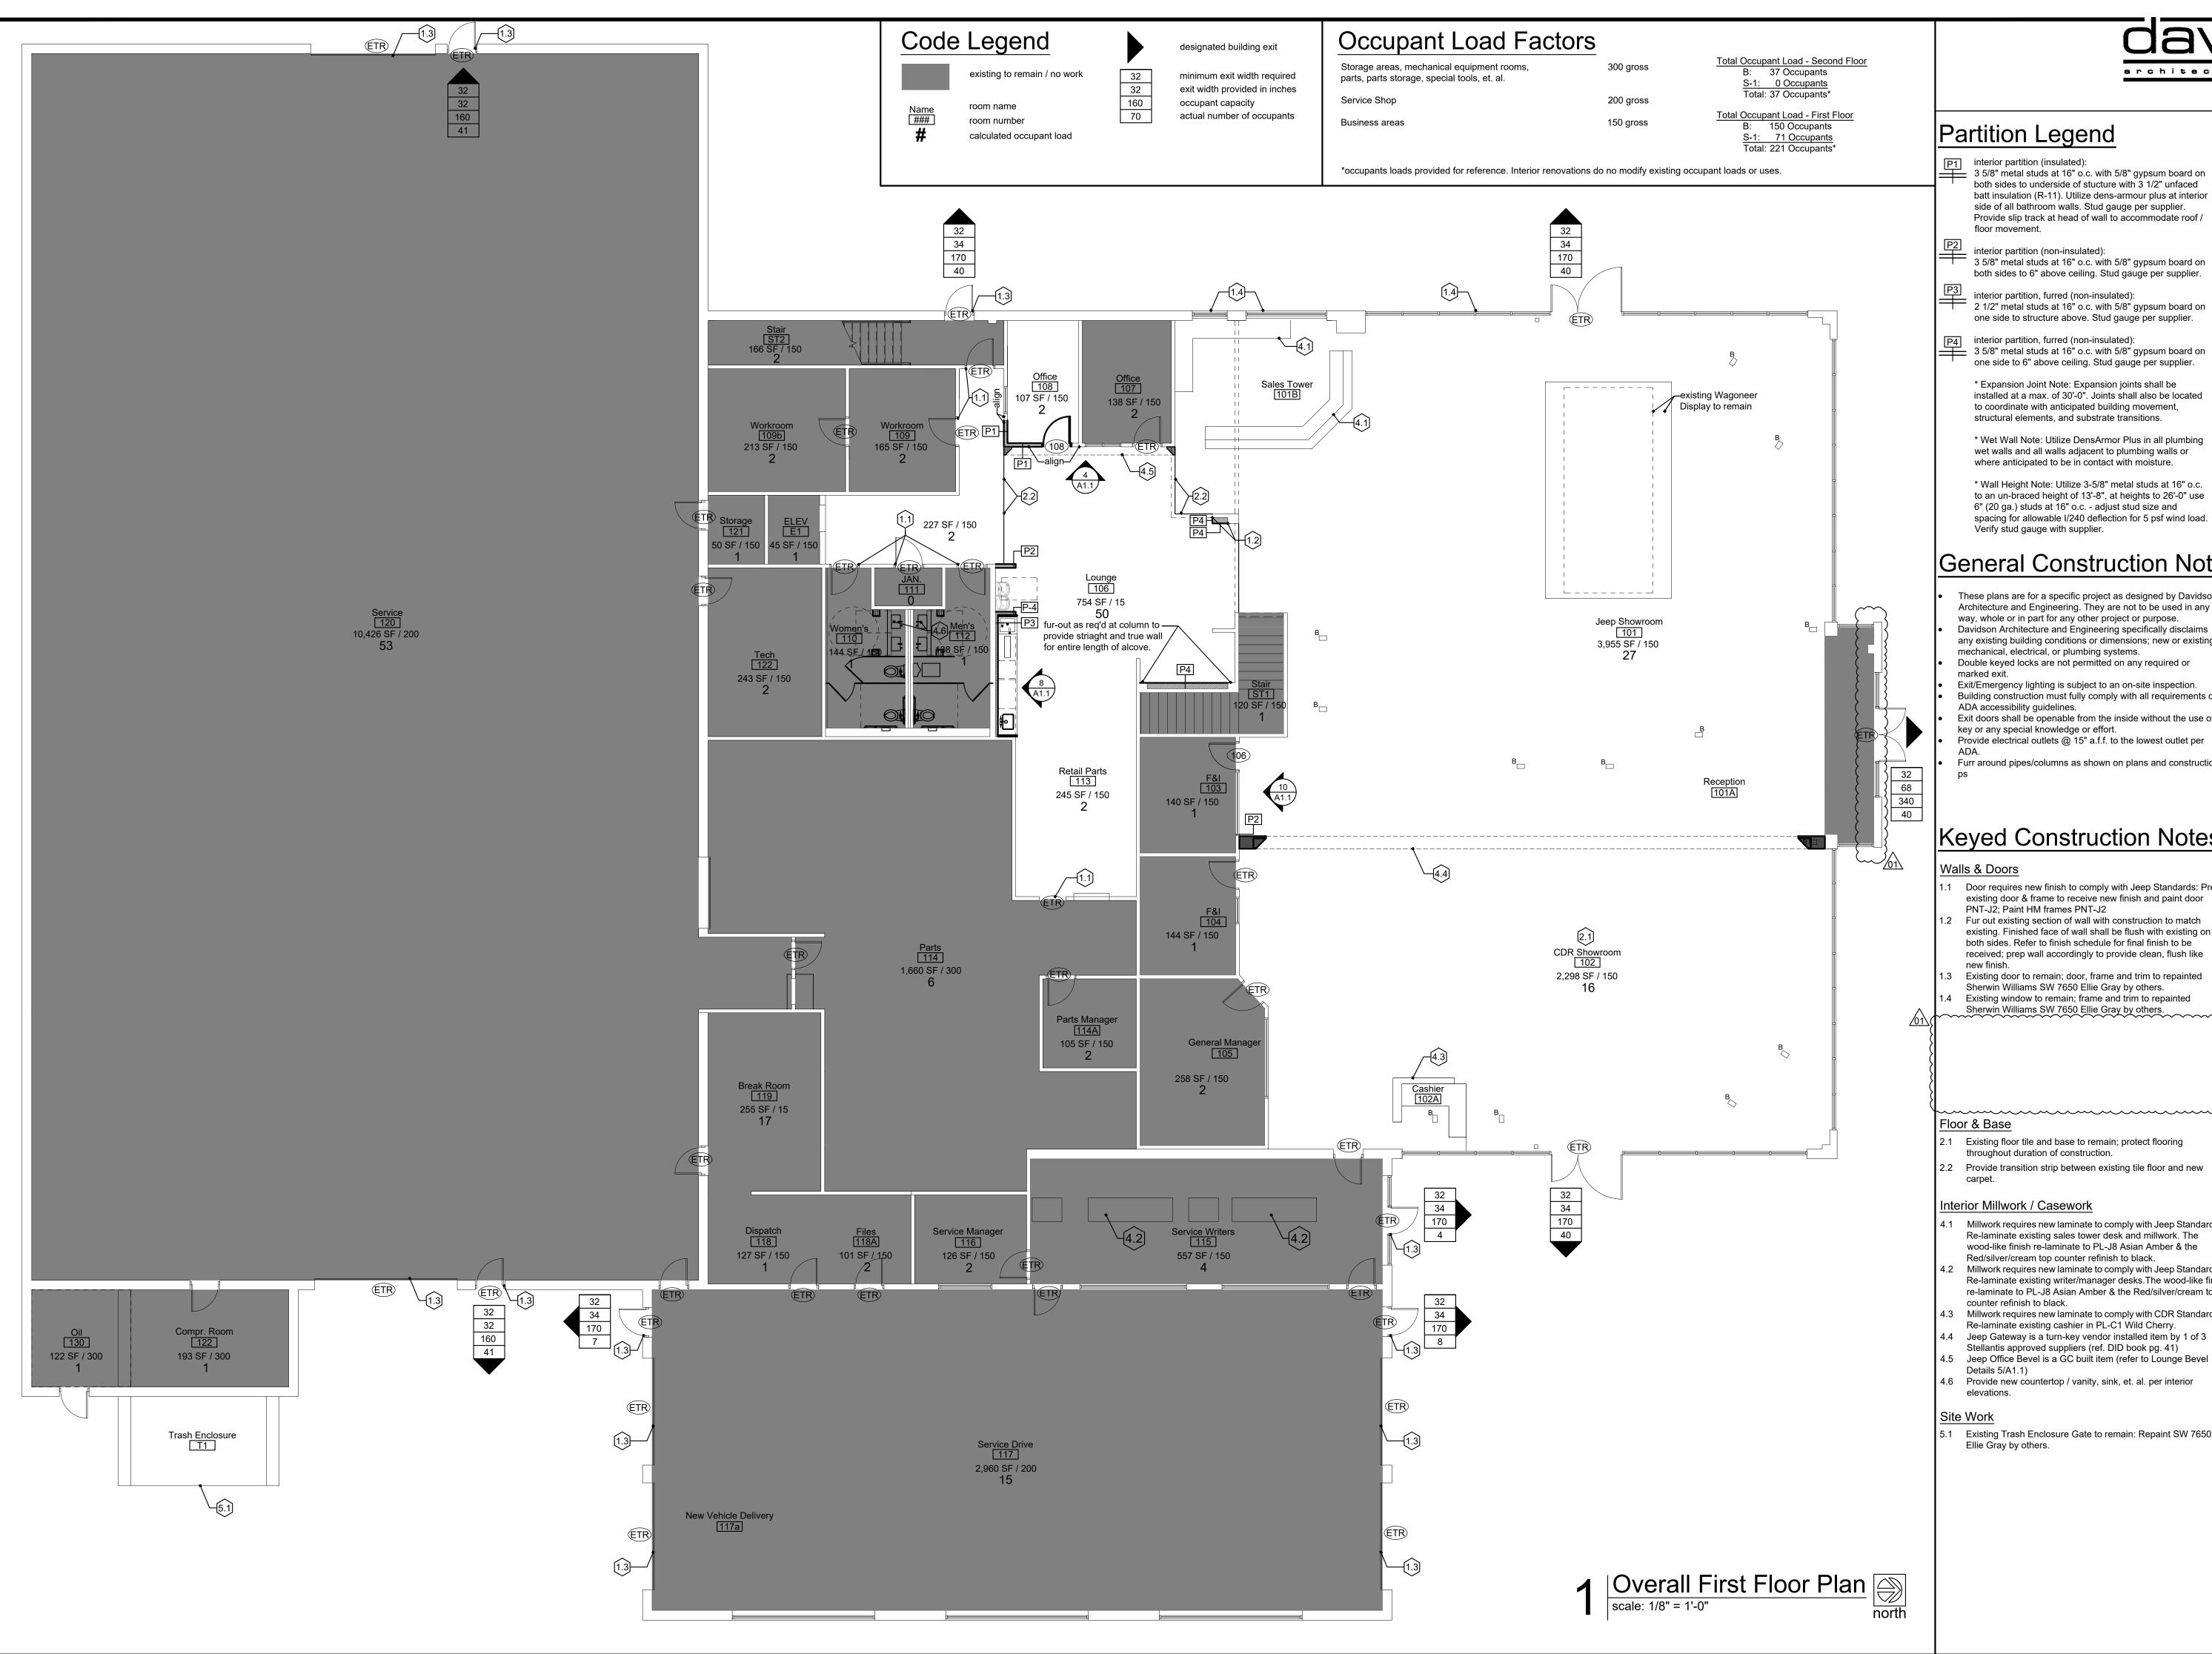

architecture&engineering

Partition Legend

interior partition (insulated):
3 5/8" metal studs at 16" o.c. with 5/8" gypsum board on both sides to underside of stucture with 3 1/2" unfaced batt insulation (R-11). Utilize dens-armour plus at interior side of all bathroom walls. Stud gauge per supplier. Provide slip track at head of wall to accommodate roof / floor movement.

interior partition (non-insulated): 3 5/8" metal studs at 16" o.c. with 5/8" gypsum board on both sides to 6" above ceiling. Stud gauge per supplier.

interior partition, furred (non-insulated): 2 1/2" metal studs at 16" o.c. with 5/8" gypsum board on one side to structure above. Stud gauge per supplier.

interior partition, furred (non-insulated):
3 5/8" metal studs at 16" o.c. with 5/8" gypsum board on one side to 6" above ceiling. Stud gauge per supplier.

> \* Expansion Joint Note: Expansion joints shall be installed at a max. of 30'-0". Joints shall also be located to coordinate with anticipated building movement, structural elements, and substrate transitions.

\* Wet Wall Note: Utilize DensArmor Plus in all plumbing wet walls and all walls adjacent to plumbing walls or where anticipated to be in contact with moisture.

\* Wall Height Note: Utilize 3-5/8" metal studs at 16" o.c. to an un-braced height of 13'-8", at heights to 26'-0" use 6" (20 ga.) studs at 16" o.c. - adjust stud size and spacing for allowable I/240 deflection for 5 psf wind load. Verify stud gauge with supplier.

### **General Construction Notes**

- These plans are for a specific project as designed by Davidson Architecture and Engineering. They are not to be used in any way, whole or in part for any other project or purpose. Davidson Architecture and Engineering specifically disclaims any existing building conditions or dimensions; new or existing mechanical, electrical, or plumbing systems. Double keyed locks are not permitted on any required or
- Exit/Emergency lighting is subject to an on-site inspection. Building construction must fully comply with all requirements of ADA accessibility guidelines.
- Exit doors shall be openable from the inside without the use of a key or any special knowledge or effort. Provide electrical outlets @ 15" a.f.f. to the lowest outlet per
- Furr around pipes/columns as shown on plans and construction

### **Keyed Construction Notes:**

### Walls & Doors

- .1 Door requires new finish to comply with Jeep Standards: Prep existing door & frame to receive new finish and paint door PNT-J2; Paint HM frames PNT-J2
- .2 Fur out existing section of wall with construction to match existing. Finished face of wall shall be flush with existing on both sides. Refer to finish schedule for final finish to be received; prep wall accordingly to provide clean, flush like
- 1.3 Existing door to remain; door, frame and trim to repainted
- Sherwin Williams SW 7650 Ellie Gray by others. 4 Existing window to remain; frame and trim to repainted Sherwin Williams SW 7650 Ellie Gray by others.
- 2.1 Existing floor tile and base to remain; protect flooring throughout duration of construction.
- 2.2 Provide transition strip between existing tile floor and new

### Interior Millwork / Casework

- Millwork requires new laminate to comply with Jeep Standards: Re-laminate existing sales tower desk and millwork. The wood-like finish re-laminate to PL-J8 Asian Amber & the
- Red/silver/cream top counter refinish to black. Millwork requires new laminate to comply with Jeep Standards: Re-laminate existing writer/manager desks. The wood-like finish re-laminate to PL-J8 Asian Amber & the Red/silver/cream top counter refinish to black.
- 4.3 Millwork requires new laminate to comply with CDR Standards:
- Re-laminate existing cashier in PL-C1 Wild Cherry. 4.4 Jeep Gateway is a turn-key vendor installed item by 1 of 3 Stellantis approved suppliers (ref. DID book pg. 41)
- Details 5/A1.1) 4.6 Provide new countertop / vanity, sink, et. al. per interior

### elevations.

5.1 Existing Trash Enclosure Gate to remain: Repaint SW 7650 Ellie Gray by others.

4301 Indian Creek Parkway Overland Park, KS 66207 phone: 913.451.9390

CONSTRUCTION
As Noted on Plans Review




date 12.15.2023 drawn by DAE

checked by DAE revisions

2024-02-21 City Comments

sheet number

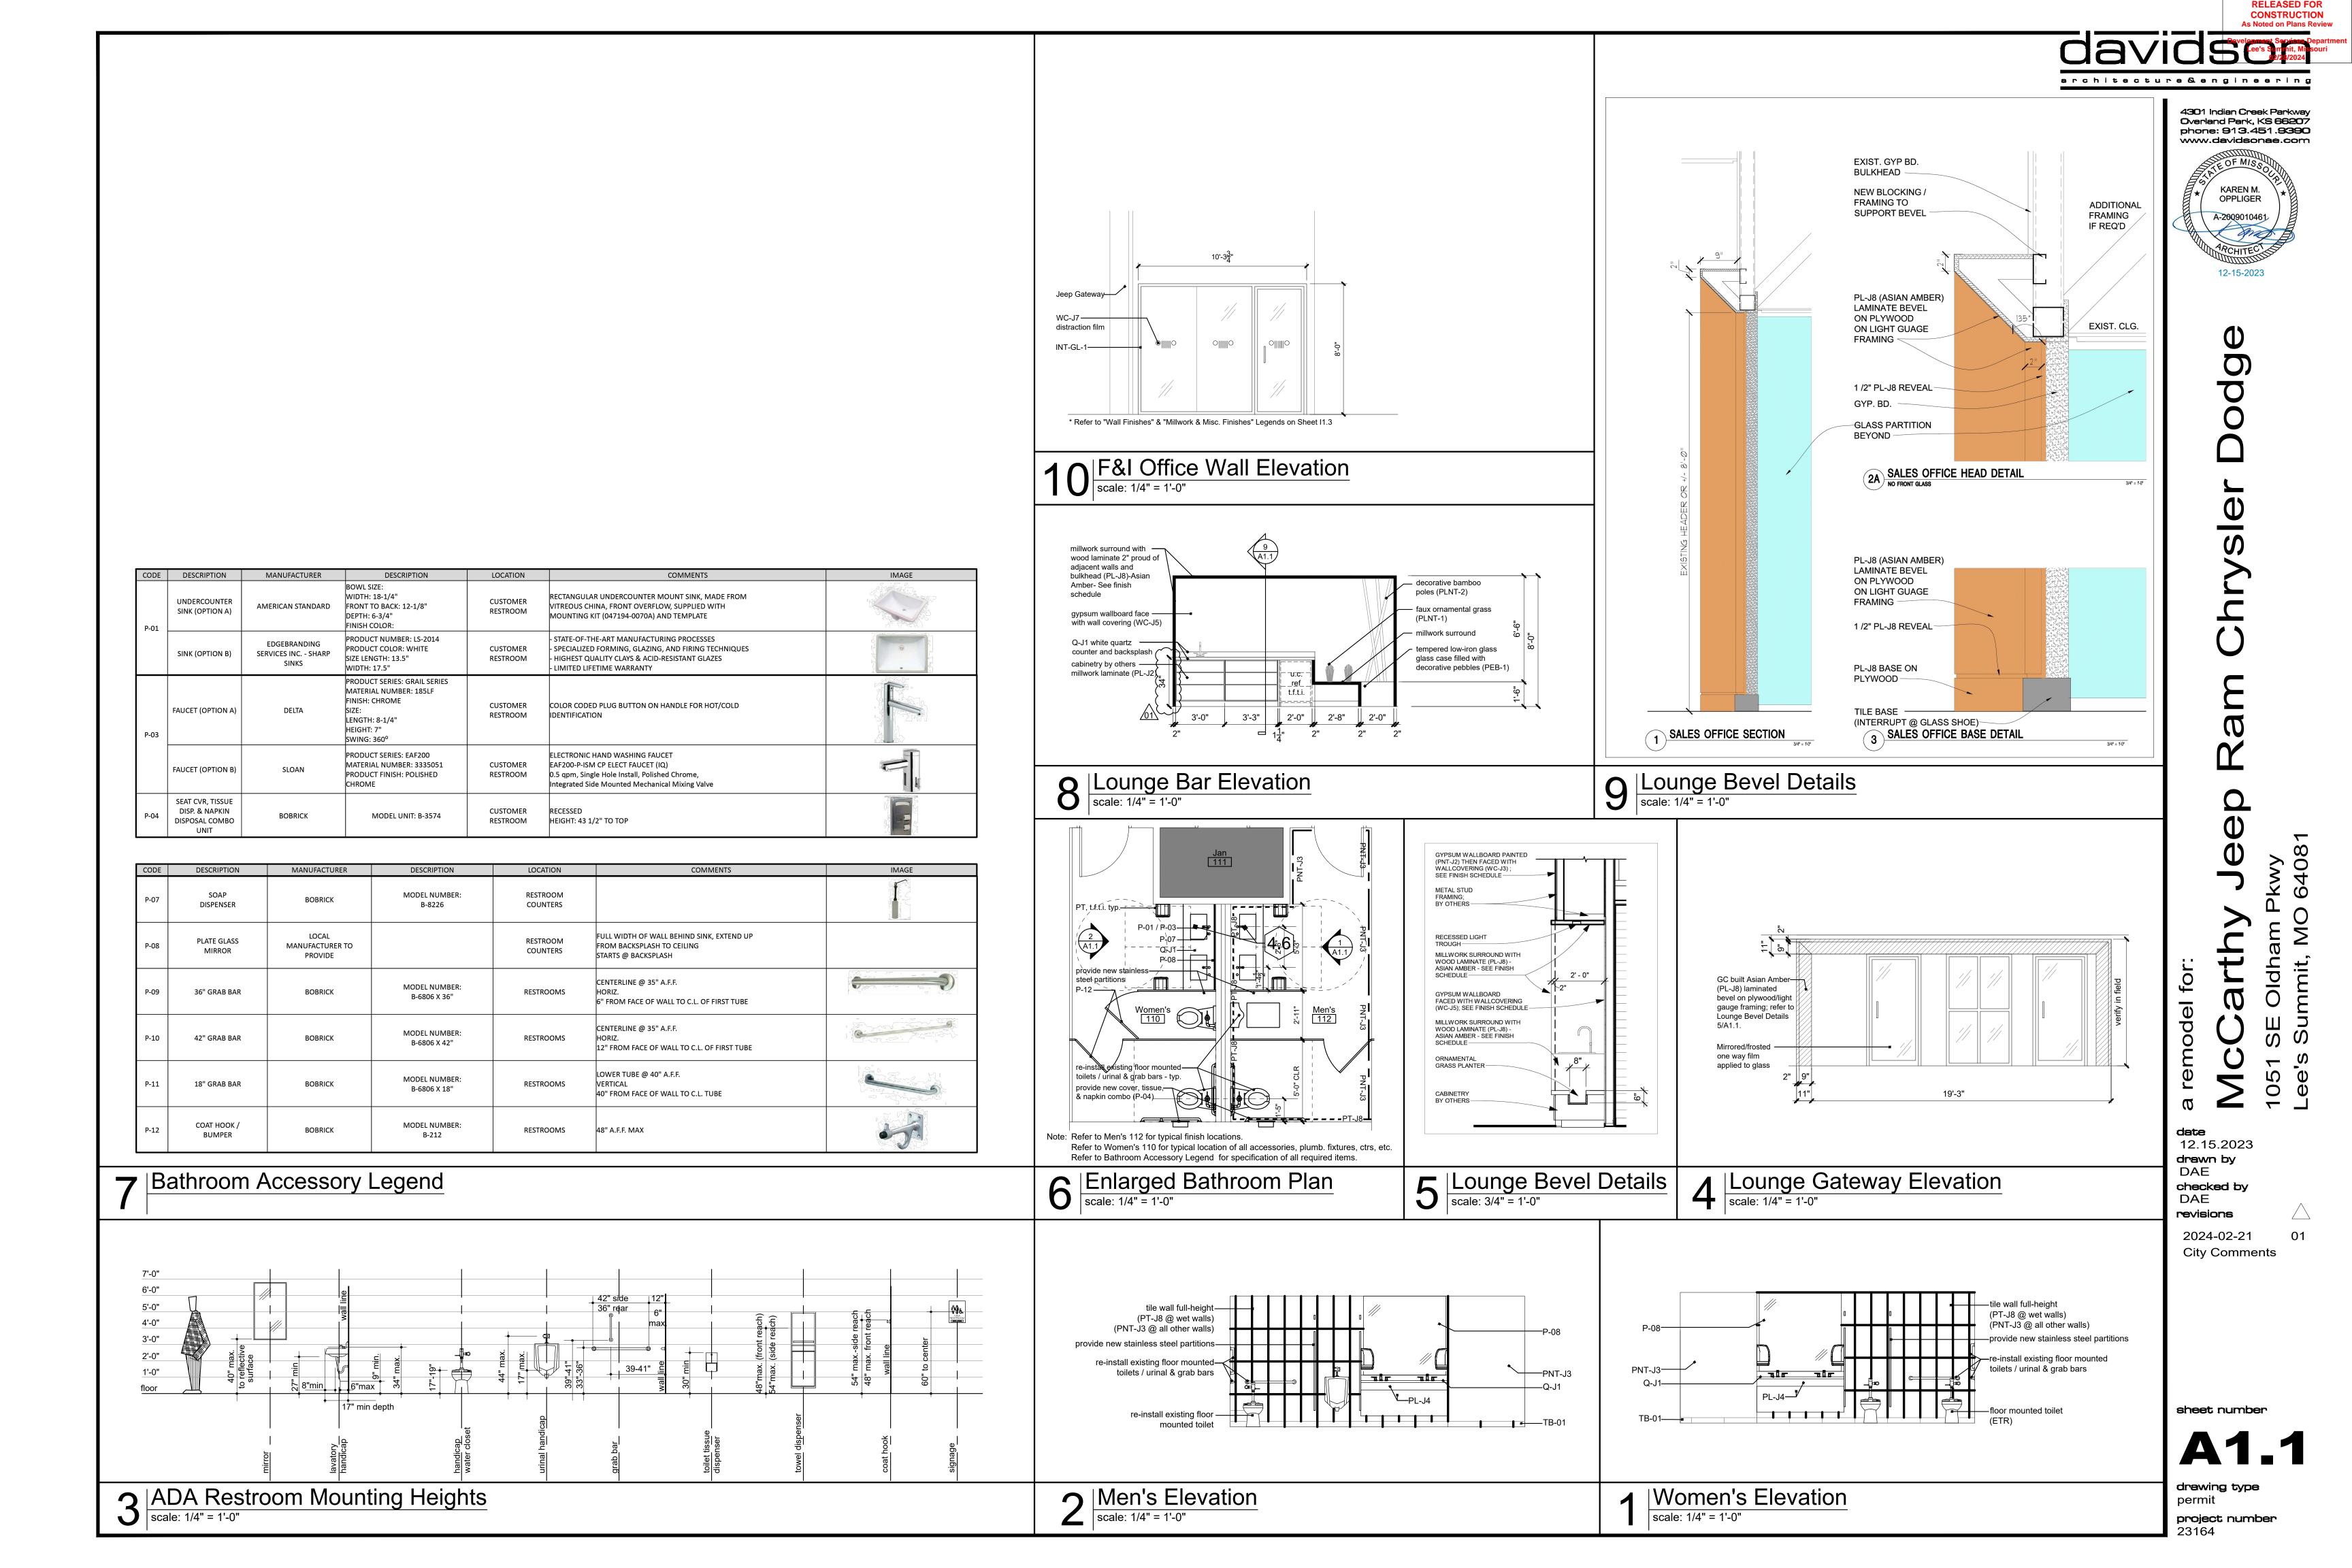



### Reflected Ceiling Notes:

- 1. Refer to general notes and specifications for more
- information. 2. Refer to engineering drawings for electrical fixtures,
- specifications and details. Refer to engineering drawings for emergency fixture location and specification.

### Keyed RCP Notes: (#)

- Existing acoustical ceiling, grid and lighting to remain. Replace discolored, stained, warped, sagging, cracked, broken or improperly cut acoustical ceiling tile. Replace / repair broken, rusted, warped or sagging ceiling grid.
- Existing "Wagoneer Sign" and "Feature Vehicle Cloud" to remain; coordinate installation height of new F1 suspended
- required to deliver specified Fc. Provide new light fixture(s) in existing ceiling grid as indicated.
- "Jeep Gateway".
- and bulkhead Gypsum board, painted PNT-J1
- flush with bottom of existing header; paint PNT-J1 9. Bevel covering PL-J8 (Asian Amber) 10. 3M Ceiling Covering WC-J2

- Provide new ceiling tile to match existing type & style where light fixtures have been removed or reconfigured; re. demo
- light fixtures to clear top of fixture. Exact mounting height as
- Reconfigure diffusers as required to eliminate conflicts and reduce movement of new suspended fixtures. 5. Exiting light fixture; relocate to allow for installation of new
- 6. 2" PL-J8 millwork surround, install 2" proud of adjacent walls
- 8. Modify existing ceiling as required to provide new gyp soffit

4301 Indian Creek Parkway Overland Park, KS 66207 phone: 913.451.939C www.davidaonae.com KAREN M. **OPPLIGER** 

A-2009010461 12-15-2023

RELEASED FOR

**date** 12.15.2023 **drewn by** DAE checked by DAE revisions

sheet number

### Jeep LED Interior Lighting Specifications:

4000K CCT with a minimun CRI of 80 is required for all offices, lounges, and customer areas.
 The showroom display area and service work bays shall have a foot candle level of 50 - 80 Fc.

3. All other customer and office areas shall have a foot candle of 30 - 50 Fc.

All other customer and office areas shall have a foot candle of 30 - 30
 All interior lighting shall meet local code requirments.
 All fixtures (except as noted below) to have an efficacy of 120 LPW.
 F2, F8, & F16 to have a minimum efficacy of 90 LPW.

### Base Lighting

a a Cabaalula - OF Liada	davio		
ng Schedule - GE Ligh	iting:		erchitecture &

TAG NAME	ТҮРЕ	LOCATION	MANFACTURER	MODEL	FIXTURE IMAGE
F1	Suspended LED Luminaire	Showroom	GE Lighting	LALS-28-A-0-BW-04-MM-10-T40-VQ-CM-WHTE	
F2	Recessed LED Downlight	Showroom	GE Lighting	LDX-4S-A-1-30-8-40-VQ / RDI4S-W-SD-WT / BH3	
F3	LED Track Light	Showroom	GE Lighting	LHS-ID-A-1-23-FL-9-40-P-Q-J1-WHTE	
F5	Suspended LED Fixture	Sales Offices	GE Lighting	LALS-24-A-0-BW-06-MM-06-T40-VQ-CM-WHTE-IN	
F6	Linear Recessed LED Luminaire - Continuous Run	Gyp. Bd. Ceiling	GE Lighting	LALR-44-A-0-NA-00-MM-07-T40-VQ-DS-WHTE	
F7	Recessed LED Wall Wash	Sales Offices	GE Lighting	LDX-4S-W-1-15-8-40-VQ / RDI4S-WW-SD-WT / BH3	
F8	Recessed LED Downlight	Offices	GE Lighting	LRX-R6-10-8-40-MD / FRAME6R / BH3	
F9	Recessed LED Troffer	Offices	GE Lighting	LVT22-B-0-33-MM-8-40-VQ-LT-WHTE	
F12	LED Track Light	Retail Merchandise	GE Lighting	LTC-ID-A-1-10-WF-9-40-P-Q-J1-WHTE	
F13	Pendant Luminaire	Service Reception	GE Lighting	ALC6-0-8T-16-T-48-1D-C-Q-V-Q-ST-K-Q-W	
F14	Surface Mount LED Fixture	Utility Rooms	GE Lighting	ALV2-0-4T-05-T-48-1D-S-Q-V-Q-ST-K-Q-W	
F15	LED Strip Light	Storage	GE Lighting	ALV2-0-4T-05-T-48-1D-S-Q-V-Q-ST-K-Q-W	
F16	Recessed Canopy Downlight	Exterior Soffit	GE Lighting	LDX-4S-A-1-15-8-40-VQ / RDI4S-W-SD-WT / BH3	
F17,F18,F19	SEE EXTERIOR SCHEDULE				
F20	LED Suspended Strip	Service Department	GE Lighting	ALV2-0-8T-16-T-48-1D-S-Q-V-Q-ST-K-Q-W	
F21	LED Vapor Tight	Wash Bay	GE Lighting	ALR2-0-4T-06-T-48-1D-S-Q-V-Q-ST-K-Q-W	
PEN-1	Decorative Pendant	Guest Lounge	ET2 Contemporary Lighting	Orb II 9-Light Pendant # E24269-91PC	

### Alternate Lighting Schedule - Hubbell / Litecontrol:

TAG NAME	ТҮРЕ	LOCATION	MANFACTURER	MODEL	FIXTURE IMAGE
F1	Suspended LED Luminaire	Showroom	HUBBELL / LITECONTROL	2L-P-ID-STD-08-SOF-C1-40K-I030-D100-D01-1C-UNV	
F2	Recessed LED Downlight	Showroom	HUBBELL / LITECONTROL	LF4SQML-4SQML30L40K8-WH-B24	
F3	LED Track Light	Showroom	HUBBELL / LITECONTROL	AKTMNLED9L40K9FL35WH	
F5	Suspended LED Fixture	Sales Offices	HUBBELL / LITECONTROL	2L-P-ID-STD-04-SOF-C1-40K-I060-D060-D01-1C-UNV	
F6	Linear Recessed LED Luminaire - Continuous Run	Gyp. Bd. Ceiling	HUBBELL / LITECONTROL	4L-LG-D-04-SOF-C1-40K-D070-D01-1C-UNV	
F7	Recessed LED Wall Wash	Sales Offices	HUBBELL / LITECONTROL	LF4SQSLWW-4SQSL15L40K8WWWT-B24	
F8	Recessed LED Downlight	Offices	HUBBELL / LITECONTROL	LBP6-6LBP11L40KWH-B24	
F9	Recessed LED Troffer	Offices	HUBBELL / LITECONTROL	LCAT22-40MLG-EDU	
F10	Linear LED Wall Wash	Guest Restrooms	J&J ELECTRONICS	LLS-CBLV-XX-40-F-W1	
F11	Suspended Luminaire	Guest Restrooms	HUBBELL / LITECONTROL	2L-P-ID-STD-04-SOF-C1-40K-I060-D060-D01-1C-UNV	
F12	LED Track Light	Retail Merchandise	HUBBELL / LITECONTROL	AKTMNLED9L40K9FL35WH	
F13	Pendant Luminaire	Service Reception	HUBBELL / LITECONTROL	MPS8-40MW-CW-EDU	
F14	Surface Mount LED Fixture	Utility Rooms	HUBBELL / LITECONTROL	<u>CSL4-4040</u>	
F15	LED Strip Light	Stroage	HUBBELL / LITECONTROL	<u>CSL4-4040</u>	
F16	Recessed Canopy Downlight	Exterior Soffit	HUBBELL / LITECONTROL	LF4SQSL-4SQSL15L40K8WT-B24	
F20	LED Suspended Strip	Service Department	HUBBELL / LITECONTROL	MPS8-40VL-CW-EDU	
F21	LED Suspended Strip	Car Wash	HUBBELL / LITECONTROL	LXEM8-40ML-RFA-EDU	
PEN-1	Decorative Pendant	Guest Lounge	ET2 Contemporary Lighting	Orb II 9-Light Pendant # E24269-91PC	

CONSTRUCTION
As Noted on Plans Review

dete
12.15.2023
drawn by
DAE
checked by
DAE
revisions

sheet number **drawing type** permit project number 23164

### Alternate Lighting Schedule - Acuity:



TAG NAME	ТҮРЕ	LOCATION	MANFACTURER	MODEL	FIXTURE IMAGE
F1	Suspended LED Luminaire - Specify Run Length	Showroom	Acuity	IK S4LD LOP 8FT FLP TG 80 CRI 50K 800 LMF MIN1 MVOLT	
F1	Suspended LED Luminaire w/ Uplight - Specify Run Length	Showroom	Acuity	IK S4LID LOP 8FT FLP TG 80CRI 50K 80LMF I80CRI I50K I600LMF MVOLT	
F2	Recessed LED Downlight	Showroom	Acuity	IK LDN4SQ 50_15 LS4AR LS	
F3	LED Track Light	Showroom	Acuity	<u>IK T261L G3 40K 80CRI WFL</u>	
F5	Suspended LED Luminaire - Specify Run Length	Sales Offices	Acuity	IK S4LD LOP 4FT FLP TG 80CRI 40K 80CRI 40K 800LMF MIN1 MVOLT ZT	
F6	Linear Recessed LED Luminaire - Specify Run Length	Gyp. Bd. Ceiling	Acuity	IK SL4L LOP 4 FLP 80CRI 40K 800LMF	
F7	Recessed LED Wall Wash	Sales Offices	Acuity	IK LDN4SQ 40 15 LS4AR LS	
F8	Recessed LED Downlight	Offices	Acuity	IK LDN6 40/20 LO6 WR LSS MVOLT	
F9	Recessed LED Troffer	Offices	Acuity	IK 2BLT2 40 LHE ADP LP850	

TAG NAME	ТҮРЕ	LOCATION	MANFACTURER	MODEL	FIXTURE IMAGE
F10	Linear LED Wall Wash	Guest Restrooms	Acuity	IK WCV212 LSL 8FT 6IN MSL4 40K	
F11	Suspended Luminaire	Guest Restrooms	Acuity	IK CLX L48 6000LM SEF WDL MVOLT 40K	
F12	LED Track Light	Retail Merchandise	Acuity	IK T261L G3 40K 80CRI WFL	
F13	Suspended LED Luminaire	Service Reception	Acuity	IK CLX L96 10000LM SEF FDL MVOLT	
F14	Surface Mount LED Fixture	Utility Rooms	Acuity	IK ZL1D L48 5000LM FST MVOLT 50K	
F15	LED Strip Light	Storage	Acuity	IK ZL1D L48 5000LM FST MVOLT 50K	
F16	Recessed Canopy Downlight	Exterior Soffit	Acuity	IK LDN6 50/20 LO6 WR LSS MVOLT	
F20	LED Suspended Strip	Service Department	Acuity	IK CLX L96 10000LM SEF RDL MVOLT 50K	
F21	LED Suspended Vaportight Strip	Car Wash	Acuity	IK FEM L96 9000LM MAFL WD MVOLT GZ10 50K	
PEN-1	Decorative Pendant	Guest Lounge	ET2 Contemporary Lighting	Orb II 9-Light Pendant # E24269-91PC	
PEN-2	Suspended Cylinder Pendant	Guest Lounge	Intense Lighting or equivalent	SS4G4C-L3-408-SV-HZ-C144	

dete
12.15.2023
drewn by
DAE
checked by
DAE
revisions

sheet number

**drawing type** permit



### General Finish Notes

- Provide thresholds at all exterior man doors.
- Provide floor transitional strips at all changes of flooring material
- Each material specified for application on the entire project shall be from the same dye lot.
- All surfaces shall be cleaned and conditioned to receive new finish as required by finish product manufacturer. Surfaces shall be smooth, free from depressions, protrusions, pits,

Installer/subcontractor shall notify general contractor prior to

- installation if conditions are not satisfactory. Contractor shall be responsible for leveling of floor slabs to receive specified finishes.
- All patterned flooring shall be centered in both directions and generated from center of room outward towards partitions, unless noted otherwise.
- All floor finish changes shall occur under centerline of door in closed position.
- All transition finishing products shall be installed under centerline of door in closed position.

smaller than 4'-0".

- Combustible interior finish products shall be provided per the requirement of the International Building Code section 803.4. Floor seams shall occur at junctions of partitions, thresholds or change of direction in corridors. NO strip patch allowed
- Finishes shall be bid as specified or as approved equal only, pending architect/owner/Goree approval. Utilize Dens-Armour Plus, or approved equal, in all plumbing wet walls, behind refrigerated equipment, and walls
- anticipated to be in contact with moisture. Utilize Dens-Shield for walls receiving ceramic tile. • Furnish and install crack isolation membrane below all
- ceramic floor tile. Furnish and install trim on all exposed ceramic wall tile edges (vertical and horizontal). Refer to interior finish legend for program required transitions.
- Ceramic tile installation should be installed per manufacturer's recommendations including, but not limited to grout joint thickness, tile sealant, back buttering, and subfloor / tile backer recommendations.
- All gypsum walls to scheduled receive paint shall be finished to level 5 finish. All gypsum walls to receive wallcovering shall be finished to
- level 4 finish. All receptacles and outlet covers are to match wall finish

### Floor Finish Legend:

throughout dealership.





EXTENT OF WALL COVERING XX-XX WALL COVERING CODE

---- WALL COVERING OVHD / ON SOFFIT XX-XX WALL COVERING CODE

CPT-C1

4301 Indian Creek Parkway Overland Park, KS 66207 phone: 913.451.9390

RELEASED FOR



remodel for:

**date** 12.15.2023 **drawn by** DAE **checked by** DAE revisions

sheet number



### General FF&E Notes:

- All existing furniture or fixtures with red finish to be replaced with brand compliant finishes.
- Provide all labor, materials and transportation necessary for the complete installation of all furniture, furnishings and equipment (FF&E) specified.

Contractor shall comply with all specification requirements

- outlined in the Conceptual Design Intent Documents (CDID)
  "Hometown Standards Jeep Alternate Lee's Summit"
  Interior Fixtures and Interior Furniture design documents as provided by CDR+J and coordinated with Haworth,
  Autoimage, or I\_E Automotive. These documents are not part of the Architect's instruments of service but shall govern the quality, style and construction of FF&E items the same.
- Shipment of FF&E may be made directly to building site in cases where prior approval of Architect has been obtained and the building is ready for FF&E installation. FF&E contractors are responsible for knowing when their merchandise is to arrive and must have available all labor and equipment needed for delivery, unloading, assembly, handling, setting into place, and inspection. Staging areas must be lockable.
- Delivery schedule must be approved by the owner.
   FF&E Contractor is responsible for temporary storage of all furniture and accessory items until time of delivery and installation.
- All furniture & fixtures shall be held in a climate controlled environment as required by the furniture vendor necessary to maintain all warranties.
   Particular care must be taken by FF&E contractors when
- handling merchandise during installation to prevent damage to existing building, walls, carpet, shelving, and millwork, et. al.

   FF&E contractors are responsible for all damage to items
- provided under this contract up to the time of acceptance by the owner whether damage results during shipment from manufacturer, delivery to site, placement or through carelessness or malicious mischief or other reasons beyond the owner's control, final payment will be made only for undamaged items. Contractor shall replace all damaged items or parts of assembled or manufactured items as soon as discovered, at no cost to the owner.
- Nominal touch-up or repair of painted finishes will be permitted if done in accordance with manufacturer's recommended procedures for such repairs. Repairs shall return items to their original "like new" appearance and function as agreed to and signed off by the Architect and owner's representative.
   Samples: Submit physical samples of all fabrics and finishes
- for verification on all items sourced from vendors other than the approved suppliers.

   Maintenance Instructions: Submit one (1) physical copy in a
- bookmarked binder and one (1) digital copy of manufacturer's recommended maintenance and cleaning instructions provided on a flash-drive.

4301 Indian Creek Parkway Overland Park, KS 66207 phone: 913.451.9390



# y Jeep Ram Chrysler Dodge

c Carthy Je

dete
12.15.2023
drawn by
DAE
checked by
DAE
revisions

sheet number

**11.2** 

## Wall Finishes

	FINISH LEGEND			PATTERN / PRODUCT					
CODE	BRAND IMAGE	MATERIAL	MANUFACTURER / SUPPLIER	LINE	COLOR / FINISH	TYPE / SIZE	REMARKS	CONTACT	
WC-J1	JEEP	Wall Covering	Ideal Image, IMBranded, OR Super Color Digital	Custom Design	Full Wall Graphic	N/A	Sales Offices Full Wall Graphic	See Sheet 5.7 for vendor contact information	
WC-J2	JEEP	Ceiling Covering	3М	Designtex, Custom Dinoc Bamboo	#v1175-001		Lounge Decorative Beams OR Perimeter Soffi Factory trained installer MUST be used. The distributor will provide local qualified installers per location.	t Tanya Romanelli P: 810-444-8797 E: tromanelli@designtex.com	
WC-J3	JEEP	Wall Covering	Shaw PPC Design Or Supercolor Digital	Custom Design	Jeep Script Wallcovering	Satin	Customer Lounge Cafe Accent Wall Covering	Rob Murawski P: 248-348-7755 (ext. 319) C: 248-756-2145 RMurawski@ShawPPCDesign.com	
WC-J4	JEEP	Wall Covering	3M Or Supercolor Digital	Custom Design	Jeep Timeline Graphic	N/A	Showroom Bulkhead above sales offices	Tanya Romanelli P: 810-444-8797 TRomanelli@designtex.com	
WC-J5	JEEP	Wall Covering			Full Wall Graphic	N/A	Customer Lounge Café Wall Graphic		
WC-J6	JEEP & CDR	Wall Covering	Ideal Image, IMBranded, OR Super Color Digital	Custom Design	Full Wall Graphic	N/A	New vehicle Delivery and F&I full wall graphic	See Sheet 5.7 for vendor contact information	
WC-J7	JEEP	Wall Covering			Frosted Vinyl Film	N/A	Sales office frameless glass distraction film		
WC-C1	CDR	Wall Covering	D. L. Couch	Absolute	Noble Grey	SKU: T2-AL-10	Office & Conference Room	Brandi Weiss P: 800-433-0790 ext. 1109 BWeiss@DLCouch.com	
PNT-J1	JEEP	Paint	Sherwin Williams	-	SW7006 Extra White	Satin	Ceilings & Interior office paint	Jacob Allard / P: 734-560-6524 / jacob.d.al-	
PNT-J2	JEEP	Paint	Sherwin Williams	-	SW7069 Iron Ore	Satin	Showroom & Lounge Paint	lard@sherwin.com Dawn Cenowa / P: 248-660-3067 / dawn.m.ce-	
PNT-J3	JEEP	Paint	Sherwin Williams	-	SW7658 Gray Clouds	Satin	Restroom (Not Wet Walls)	-nowa@sherwin.com	
PNT-J4	JEEP	Paint	Sherwin Williams		SW7066 Gray Matters	Satin	Customer Lounge Exposed Structure	Jacob Allard / P: 734-560-6524 / jacob,d.al- lard@sherwin.com Dawn Cenowa / P: 248-660-3067 / dawn.m.ce nowa@sherwin.com	
PNT-C1	CDR	Paint	Benjamin Moore	Classic Color Collection	Smoke Embers 1466	Eggshell	Walls		
PNT-C2	CDR///	/////Paint////	Benjamin Moore	///////	Kendall Charcoal HC 166	Semi-Gløss	Trim (Metal Painted Door Frames)		
PNT-C3	CDR	Paint///	Benjamin Moore	Classic Color Collection	Rock Gray 1615	Semi-Gloss	Interior Service Walls (Floor to 7'-0")	Beth Maguire	
PNT-C4	CDR	Paint	Benjamin Moore	Classic Color Collection	Cheating Heart 1617	Semi-Gloss	Interior Service Walls (7'-0" to 10'-0")	P: 847-372-1854 beth.maguire@BenjaminMoore.com	
PNT-C5	COR///	Paint	Benjamin Moore	Classic Color Collection	Pelican Gray 1612	Semi-Gloss	Interior Service Walls (10'-0" to Ceilings)	2	
PNT-06	CDR	Paint //	Benjamin Moore	////// <del>/</del> //////	Ready Mix White	Flat	Ceilings		

Not used

### Floor Finishes

ERIOR F	NISH LEGEND	T							
CODE	BRAND IMAGE	MATERIAL	MANUFACTURER / SUPPLIER	PATTERN / PRODUCT LINE	COLOR / FINISH	TYPE / SIZE	REMARKS	CONTACT	
PT-01	CDR & JEEP	Porcelain Tile	Alfalux	Straight Grid	Canvas Titanium Finish: Lappato	24" x 24"	Showroom Field and Customer Core (use with 1/8" G-01)		
PT-04	JEEP	Porcelain Tile	Alfalux	Straight Grid	Granite Carbon Finish: Roc	12" x 12"	Service Drive Accent & Janitor Closet (use with 1/8" G-05)		
PT-05	JEEP	Porcelain Tile	Atfalux	Straight Grid	Granite Titanium Finish: Roc	12" x 12"	Service Drive (use with 1/8"/ G-04)	Distributor Dwyer Marble & Stone	
PT-06	JEEP	Porcelain Tile	Alfalux	Straight Grid	Canvas Carbon Finish: Lappato	24"x24"	New Vehicle Delivery	Chad Robar P: 248-476-4944	
PT-J8	JEEP	Porcelain Tile	Alfalux	Floors: 1/3 Offset Walls: Straight Grid	Canvas Titanium Finish: Natural	12" x 24"	Restroom Floor and Walls (use with 1/8" G-01)	Fax: 248-476-5543 E: chad.robar@dwyermarble.com E: jeeptile@dwyermarble.com	
PT-C3/	CDR	Porcelain Tile	Alfalux	Straight Grid	Pebble Gray Finish: Natural	12"×24"	Restroom Floor and Walls (use with 3/16" G-01)	GENERAL NOTE:	
P7- <b>C</b> 4	CDR	Porcelain Tile	Alfalux	Straight Grid	Pebble Crème Finish: Natural	12" × 24"	Restroom Walls (use with 3/16" G-C3)	PORCELAIN TILE WALL BASE TO MATCH ADJACENT FLOOR TILE COLOR AT EITHE 4" OR 6"	
AT-C1 CDR Porcelain Tile		Porcelain/Tile	Alfatux	1/3 Offset	Silver Frost	2" × 12"	3 row accent stripe 36" above floor	2	
TB-01	CDR & JEEP	Porcelain Tile Wall Base	Alfalux			4" x 24"	Match floor Use 3" x 24" @ CDR Restroom ONLY		
CPT-01	JEEP	Carpet	Mohawk	Made to Last #GT350	Charcoal Wash #989	24" x 24"	EcoFlexOne Backing, Pattern: Ashlar parallel to threshold  Use RWB-1 wall base	Specs: Ann_Martin@Mohawkind.com   612-814-2634 Program: Carolyn_Dwyer@MohawkInd.com   313-618-8299 Orders: Vanessa_Crider@Mohawkind.com	
CPT-C1	CDR	Carpet	Mohawk	Smart Casual #GT351	Grey Wash #969	24" x 24"	Use IVVD-1 Wall base		
VCT-C1	CDR & JEEP	Luxury Vinyl Tile	Mannington Commercial	Divergent LVT	13507 Spartina	18" x 18"	Break Room & Janitor Closet		
RT-C1	CDR & JEEP	Rubber Tile	Mannington Commercial	Enforcer	901 Night Black	36" × 36"	Tech Flooring		
RWB-1	CDR & JEEP	Rubber Wall Base	Mohawk	Vinyl Straight CVW01	Night Skies #002	4"	Equivalents are acceptable		
RT-C1 RWB-1 VCT-J1	CDR & JEEP	Static Dissipative Vinyl Tile	Johnsonite	Granit SD	713 Kettle Black	GRTSD-XX	Data / IT Room	John Stoll P: 770-365-0002 / E; john stoll@tarkett.com	

Not used

# Floor/Ceiling/Grout Finishes


NTE	RIOR FIN	NISH LEGEND							
C	ODE	BRAND IMAGE	MATERIAL	MANUFACTURER / SUPPLIER	PATTERN / PRODUCT LINE	COLOR / FINISH	TYPE / SIZE	REMARKS	CONTACT
C	TB-01	JEEP	Carpet Base Moulding	Bentley	Troubadour	400337 Rover	4" or 6" High	Offices	Patti Shammas P: 734-516-5302 E: patti.shammas@bentley mills.com
И	M-01	CDR & JEEP	Interior Floor Mat	Shaw	Welcome II	31500 Ebony	Stepping Out 24" x 24"	Monolithic Installation	Níchole Píkur P: 248-910-5235 E: nichole pikur@shawinc.com
VISHES	ONC	CDR & JEEP	Sealed Concrete	TBD	TBD	TBD	NJA	Shop, Back of House	P:  E:
OK FIN	<del>-</del> C1	CDR	Paint	Benjamin Moore	Classic Color Collection	Pelican Gray 1612	NIA	Service Area Floor Paint	Beth Maguire P: 847-372-1854
5 V	2-02	CDR	Paint	Benjamin Moore	Classic Color Collection	Cheating Heart 1617	MA	2 Part Epoxy Paint with Sharp Grit for Slip Resistance	E. beth maguire@benjaminmoore,com
Ć	B-01	CDR & JEEP	Gypsum Board	Architect's Choice	-	Extra White SW-7006	Satin	\ <del>-</del>	
4	CP-01	CDR & JEEP	Lay-in Acoustical Ceiling Panel	USG or approved equivalent	Halcyon Planks	White	2'×4'	CDR Showroom	Blake Panno
A	3P-02	CDR & JEEP	Lay-in Acoustical USG or approved equivalent		Haleyon Planks	White	2' <b>x 2</b> '	Jeep Showroom and Sales Stations	P: 515-707-9179 E: BPanno@usg.com
V	C-12	JEEP	Ceiling Covering	зм	Designtex, Custom Dinoc Bamboo	#v1175-001	N/A	Factory trained installer MUST be used. The distributor will provide local qualified installers per location.	Tanya Romanelli P: 810-444-8797 E: tromanelli@designtex.com
	XP-01	COR & JEEP	Exposed Structure		<u> </u>			Typically, Service Drive finished PNT-J1 (Jeep) of PNT-C3 (CDR). Service and Parts Departments are painted white.	
CEILING	XP-02	JEEP	Exposed Structure			SW7066 Gray Matters	N/A	Customer lounge exposed structure to be painted PNT-J4	
c	-01	CDR & JEEP	Pre-Mixed Grout		TruColor	Shadow H195	N/A	Use with PT-01 & PT-J8	
6	-02///	JEEP	Pre-Mixed Grout		TruColor	French Gray H142	N/A	Use with PT-02 in CDJR Millenium facility	Manufacturer: Bostick Brian S. Kelley
Ø	-04	JEEP	Sanded Grout	Manufacturer: Bostik	With 1900 Epoxy Admixture	Shadow H195	NJA	Use with PT-05	P. 614-404-1776 brian:kelley@bostik-us.com
9	-05	JEEP	Sanded Grout	Supplier: Dwyer Marble & Stone	With 1900 Epoxy Admixture	French Gray H142	N/A	<del>\\\\\\\\\\\\\\\\\\\\\\\\\\\\\\\\\\\\\</del>	Supplier: Dwyer Marble & Stone Chad Robar P: 248-476-4944 / chad tobar@DwyerMarl
אַססוּ	-C3	CDR	Pre-Mixed Grout		TruColor	Misty Grav H144	NJA	<i>X////////////////////////////////////</i>	com

Not used

### Millwork & Misc. Finishes

				INTERIOR FINISH LEGI	END					
	CODE	BRAND	MATERIAL	MANUFACTURER / SUPPLIER	PATTERN / PRODUCT LINE	COLOR / FINISH	TYPE / SIZE	REMARKS	CONTACT	
	PL-J1	JEEP	Millwork Laminate	Panolam	Nevamar	Chalk White S7024T	-	-	Patricia Buckner P: 404-548-7720	
	PL-J2	JEEP	Millwork Laminate	Panolam	Nevamar	Wrought Iron S6054T	-	-	E: patricia_buckner@panolam.com	
	PL-J4	JEEP	Millwork Laminate	Wilsonart	Decorative Metal	Matte Pewter #6100 (415)	-	Sink vanity in restrooms		
	PL-J6	JEEP	Millwork Laminate	Wilsonart	335 (Vert. Grade); 350 (Horiz. Grade)	Charcoal 10592-38	-	-	Leslie Humphrey, LEED AP	
ZK	PL-J8	JEEP	Millwork Laminate	Wilsonart	335 (Vert. Grade); 350 (Horiz. Grade)	Asian Amber 11152K-18	-	Interior Customer Contact Doors & Millwork	ID+C Wilsonart	
MILLWORK	PL-C1	CDR	Laminate	Wilsonart	335 (Vert. Grade); 350 (Horiz. Grade)	Wild Cherry 7054-60	-	Vertical Surfaces, Interior Doors, and Furniture Work Surfaces	2500 International St. Columbus, OH 43228	
Σ	PL-C2	CDR	Laminate	Wilsonart	335 (Vert. Grade); 350 (Horiz. Grade)	Graphite Nebula 4623-60	-	Breakroom Countertop	P: 614-893-6853 HumphrL@wilsonart.com	
	PL-C3	CDR	Laminate	Wilsonart	335 (Vert. Grade)	Black 1595 Gloss-1	-	Furniture Accent		
	GR-C1	CDR	Granite	-		Black Uba-Tuba Granite	-	Retail Parts, Café, Customer, Restrooms, Recpetion, Cashier Counter	Local Supplier	
	Q-J1	JEEP	Quartz	Wilsonart	-	Lorraine	Q1012	Customer Bathroom Counter Tops & Café Counter	Leslie Humphrey, P: 614-893-6853 HumphrL@wilsonart.com	
	TTS-1	CDR & JEEP	Tile Trasition Strip	Schluter Systems	Decorative Metal	Satin Anodized Aluminum Finish	#AE 100 D	Customer Bathroom	Jennifer Faber P: 800-267-0817	
	TTS-2	JEEP	Tile Trasition Strip	Schluter Systems	RONDEC	Stainless Steel 304	#RO80E	Customer Bathroom	E: jfaber@schluter.com	
	SS-C1	CDR & JEEP	-	-	-	Stainless Steel	-	Parts Counter		
MISC.	INT-GL-1	CDR & JEEP	Office glazing	CR Laurence or equal	Frameless glass system	Clear Anodized Aluminum	Sales, F&I	Jeep and CDR Showroom Offices	800-421-6144 partitions@crlaurence.com	
Σ	PLNT-1	JEEP	Faux Plant		Replica Sansevieria Cylindrica	-				
	PLNT-2	JEEP	Bamboo Poles	Diontorra	Bamboo Poles	Natural Finish	4" dia. x 96"h	Customer Lauraca	Sarah Stalker	
	PLNT-3	JEEP	Planter Box	Planterra	-	-	8"w x 18" h x 48" l	Customer Lounge	P: 248-310-9479 Sstalker@planterra.com	
	PEB-1	JEEP	Pebbles		-	White				

Not used

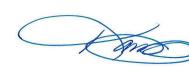

4301 Indian Creek Parkway
Overland Park, KS 66207
phone: 913.451.9390
www.davidsonae.com

4301 Indian Creek Parkw Overland Park, KS 6620 phone: 913.451.935 www.davidsonae.com \* KAREN M. OPPLIGER

A-2009010461

A-2009010461

# Jeen Ram Chrysler Dodge

# 151 SE Oldham Pkwy

date
12.15.2023
drawn by
DAE
checked by
DAE
revisions

sheet number

Approved Program Suppliers

			INTERIOR PROG	RAM SUPPLIERS	
APPLICA	TION	MANUFACTURER / SUPPLIER	REPRESENTATIVE'S NAME	CONTACT INFORMATION	NOTES
	Sales Offices	3M	Tanya Romanelli	200 Varick Street 8th Floor, New York, NY 10014 P: 810-444-8797 / TRomanelli@designtex.com	
Wallcovering	Wall Covering Customer Lounge Accent	Shaw PPC Design	Rob Murawski	44311 Grand River Ave, Novi, MI 48375 P: 248-348-7755 (ext. 319) C: 248-756-2145 RMurawski@ShawPPCDesign.com	
	Wall Covering	D. L. Couch	Brandi Weiss	499 E. County Rd, 300 S, New Castle, IN 47362 P: 800-433-0790 ext. 1109 / BWeiss@DLCouch.com	
Paint		Sherwin Williams	Jacob Allard Dawn Cenowa	P: 734-560-6524 / 248-660-3067 jacob.d.allard@sherwin.com / dawn.m.cenowa@sherwin.com	
, and		Benjamin Moore	Beth Maguire	222 Merchandise Mart - Suite 6-131, Chicago, IL 60654 P: 847-372-1854 / beth.maguire@BenjaminMoore.com	
Tile		AlfaLUX	Distributor: Dwyer Marble & Stone Chad Robar	23177 Commerce, Farmington Hills, MI 48335 P: 248-476-4944 / chad.robar@DwyerMarble.com / JeepTtile@DwyerMarble.com	
Carpet	Floor Mats	Shaw	Nichole Pikur	616 E. Walnut Avenue, Dalton, GA 30722-2128 P: 248-910-5235 / nichole.pikur@shawinc.com	
Сагрес	Carpet	Bentley	Patti Shammas	220 West Street, Ste 200, Chicago, IL 60654 P: 734-516-5302 / patti.shammas@BentleyMill.com	
ıyl Tile & Rubber Wall Base	Vinyl Tile + Wall Base	Mannington Commercial	Chuck Dettloff	7155 19 Mile Rd, Sterling Heights, MI 48314 P: 586-739-6090 CDettloff@ConventionalCarpet.com	
viriyi Tile & Rubbei Wali base		Johnsonite	John Stoll	30000 Aurora Road, Solon, Ohio 44139 P: 770-365-0002 / john.stoll@tarkett.com	
Concrete		Local Supplier			
Ceiling	ACT	USG	Blake Panno	550 W Adams, Chicago, IL 60661 P: 515-707-9179 / BPanno@usg.com	
Celling	Di-Noc	3M	Tayna Romanelli	200 Varick Street 8th Floor, New York, NY 10014 P: 810-444-8797 / TRomanelli@designtex.com	
Grout	Alfalux	AlfaLUX	Distributor: Dwyer Marble & Stone Chad Robar	23177 Commerce, Farmington Hills, MI 48335 P: 248-476-4944 / chad.robar@DwyerMarble.com / JeepTtile@DwyerMarble.com	
		Bostik	Brian S. Kelley	11320 West Watertown Plank Road, Wauwatosa, WI 53226 P: 614-404-1776 / brian.kelley@bostik-us.com	See supplier pages
Laminate		Panolam	Patricia Buckner	20 Progress Drive, Shelton, CT 06484 P: 404-548-7720 / patricia_buckner@panolam.com	
Lammate		Wilsonart	Brynn Bishop	2501 Wilsonart Drive, Temple, TX 76504 P: 720-346-4538 / BishopB@wilsonart.com	
Countertops		Hanwha	David McWilliams	2839 Paces Ferry Road, Suite 200, Atlanta, GA 30339 P: 770-431-6113 / DavidMcWilliams@HanwhaSurfaces.com	
Transition Strip		Schluter Systems	Jennifer Faber	194 Pleasant Ridge Road, Plattsburgh, NY 12901 P: 800-267-0817 / JFaber@schluter.com	
Lounge Planters & Plants		Planterra	Sarah Stalker	7315 Drake Rd., West Bloomfield, MI 48322 P: 248-310-9479 / Sstalker@planterra.com	

			INTERIOR PROGRAM SUPPLIERS	
APPLICATION	MANUFACTURER / SUPPLIER	REPRESENTATIVE'S NAME	CONTACT INFORMATION	NOTES
	GE Lighting	John Koster	P: 216-577-9673 / john.koster@gecurrent.com	
Lighting	Hubbell Lighting	Dan Rodriguez	P: 562-964-5995 / DRodriguez@hubbell.com	
	Ikon	Nate Kimes Kevin Tomczak	P: 616-717-5351 / NKimes@ikonefs.com P: 616-328-8520 / KTomczak@ikonefs.com	
	Airea	Katie Gans Burlager	P: 248-426-3720 / kburlager@aireainc.com	
Furniture & Fixtures	American Interiors	Melissa Caples	P: 216-912-1207 / mcaples@aminteriors.com	
	EWI Worldwide	Lori Kasten	P: 877-585-3696 / FCA-showroom@ewiworldwide.com	
	Interior Environments	Marc Cygan	P: 248-996-6232 / mcygan@ieoffices.com	
	Ideal Image	Aaron Paugh	P: 937-832-1660 x 2106 / aaron.paugh@idealimageinc.com	
Graphics	IM Branded	Kristie Shepard	P: 248-537-8557 / 248-819-2353 / ksherpard@imbranded.com	
	Supercolor Digital	Curtis Slater	p: 949-398-7850 / CurtisS@SuperColor.com	
Potail Displays	EWI	Lori Kasten	P: 414-277-6312 / lkasten@ewiworldwide.com	Jeep Retail Fixtures
Retail Displays	HELM	Jen Minott Donna Newton	P: 734-679-3679 / jminott@helm.com P: 734-664-1432 / dnewton@helm.com	CDR Retail Fixtures
Retail Merchandise	HELM	Ryan Mulligan Jen Goodwin	rmulligan@helm.com / jgoodwin@helm.com	Jeep Merchandise
Media	Bizco: iShowroomPRO	Marci Sieting	P: 248-512-6237 / marci.sieting@fcagroup.com	
High Speed Roll Up Doors	Rytec	Brady Bell	P: 214-334-4866 / BBell@rytecdoors.com	
Site Elements (Jeep Mountain)	MSI	Tom Maglio	P: 781-389-9284 / tmaglio@msi-design.com	
specialty Equipment	Snap-On	Terry Goll	P: 248-293-8299 / P: 248-296-9600	



room no.	room name	floor	grout	base	,	wall	C	eiling	remarks
					primary	accent	ETR	clg. ht.	
101	Jeep Showroom	ETR	ETR	ETR	PNT-J2	WC-J1, WC-J4	•	-	-
101A	Reception	ETR	ETR	ETR	PNT-J2	-	•	-	-
101B	Sales Tower	ETR	ETR	ETR	PNT-J2	-	•	-	-
102	CDR Showroom	ETR	ETR	ETR	PNT-C1	-	•	-	-
102A	Cashier	ETR	ETR	ETR	PNT-C1	-	•	-	-
103	F&I	CPT-01	-	CTB-J1	PNT-J1	WC-J6	•	-	WC-J7 Frosted Film: Jeep grill distraction bar
104	F&I	CPT-C1	-	RB-C1	PNT-C1	WC-J6	•	-	-
105	General Manager	CPT-C1	-	RB-C1	PNT-C1	-	•	-	-
106	Lounge	CPT-01	-	CTB-J1	PNT-J2	WC-J3/WC-J5	•	-	WC-J5 Cafe Wall,PL-J8 Cafe wall Surround
107	Office	CPT-01	-	CTB-J1	PNT-J1	-	•	-	-
108	Office	CPT-01	-	CTB-J1	PNT-J1	-	•	-	-
109	Workroom	ETR	ETR	ETR	PNT-J1	-	•	-	-
110	Women's RR	PT-J8	G-01	TB-01	PT-08(G-01)	PNT-J3	•	-	-
111	Janitor	ETR	ETR	ETR	PNT-J1	-	•	-	-
112	Men's RR	PT-J8	G-01	TB-01	PT-08(G-01)	PNT-J3	•	-	-
113	Retail Parts	CPT-01	-	CTB-J1	PNT-J2	WC-J3/PL-J8	•	-	-
114	Parts	ETR	ETR	ETR	PNT-J1	-	•	-	-
114A	Parts Manager	ETR	ETR	ETR	PNT-J1	-	•	-	-
115	Service Writers	ETR	ETR	ETR	PNT-C1	-	•	-	-
116	Service Manager	ETR	ETR	ETR	PNT-C1	-	•	-	-
117	Service Drive	ETR	ETR	ETR	PNT-C1	-		-	-
118	Dispatch	ETR	ETR	ETR	PNT-C1	-		-	-
118A	Files	ETR	ETR	ETR	PNT-C1	-		-	-
119	Break Room	ETR	ETR	ETR	PNT-C1	-		-	-
120	Service	ETR	ETR	ETR	PNT-C1	-		-	_

4301 Indian Creek Parkway Overland Park, KS 66207 phone: 913.451.9390 www.davidsonae.com

date
12.15.2023
drawn by
DAE
checked by
DAE
revisions