- SDWC 15600 NECESARIO EN TODO LOS PUNTOS DE APOYO (u.n.o.)

TODAS LAS CONEXIONES DE TRUSS A TRUSS = 'CLAVADAS " (u.n.o.)

RELEASE FOR CONSTRUCTION AS NOTED FOR PLAN REVIEW DEVELOPMENT SERVICES LEE'S SUMMIT, MISSOURI 03/04/2024

EVERSTEAD SHOP DRAWING / SUBMITTAL REVIEW SUBMITTAL WAS REVIEWED FOR DESIGN
CONFORMITY AND GENERAL CONFORMACE TO
ONTRACT DOCUMENTS ONLY. THE CONTRACTOR
IS RESPONSIBLE FOR CONFIRMING AND
CORRELATING DIMENSIONS AT JOBSITE FOR
TOLERANCE, CLEARANCE, QUANTITIES,
FABRICATION, COORDINATION OF HIS OR HER
WORK WITH OTHER TRADES, AND FULL COMPLIANCE WITH CONTRACT DOCUMENTS. STATUS: **APPROVED** 03/01/2024 REVIEWED BY:

CPD ENGINEER, EVERSTEAD ENGINEERING & DESIGN

20300 W 207TH St Spring Hill, KS 66083

75

964

155

5,817

PREMIER

Since 1923
Customer

Kyle Clifford

Angela Justus

TRUSS QUANTITY

HORIZONTAL OVERHANG LINES

SQUARE FOOTAGE IS ESTIMATED. CONTRACTOR/FRAMER VERIFICATION

RAKED OVERHANG LINES

GABLE AREA

RIDGE LINES **ROOF AREA**

VALLEY LINES

REQUIRED.

HIP LINES

Clayton Properties

Emerald Townhome

3710/3712/3716/3718 SW Clayton

2/28/2024 | P240089 | 1/4" = 1'


ROOF TRUSS PLACEMENT DIAGRAM

BUILDING SUPPLY OF KANSAS CITY

Phone: 913.686.1812

www.premierbuildingsupply.com

25-10-0 25-11-0 25-10-0 25-11-0

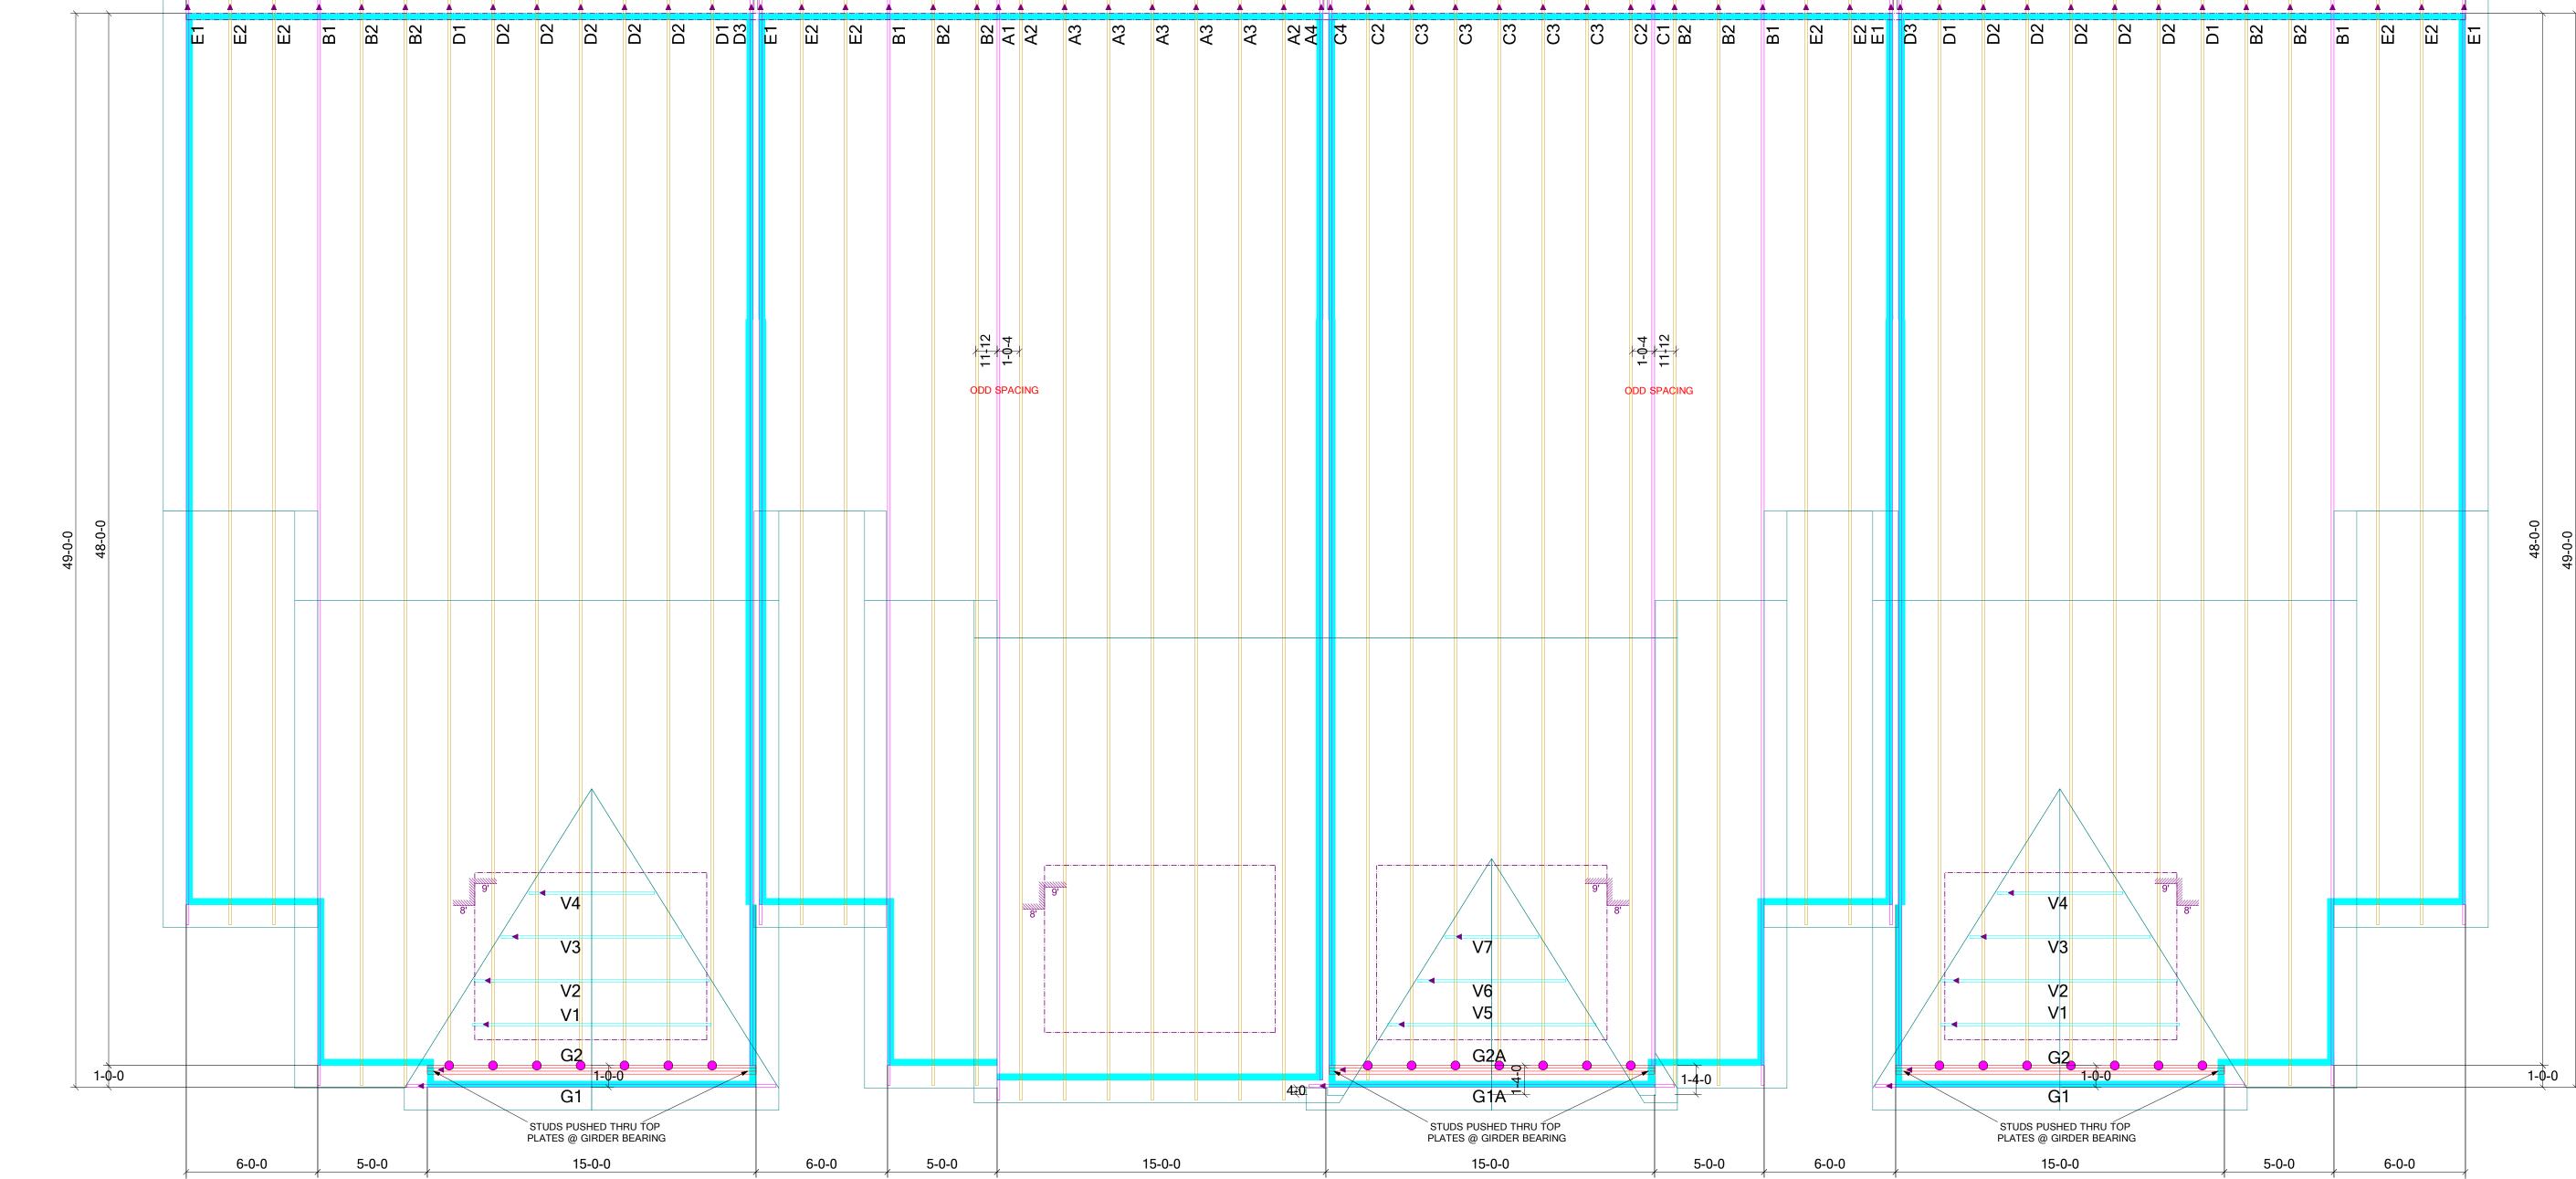

- EL EXTREMO IZQUIERDO DE LOS TRUSSES (VEA LOS PERFILES)

TODAS LAS DIMENSIONES PARA LAS TRUSSES SON DE FUERA DE LA MADERA ESTABLECER LOS TRUSSES NIVELADAS CON LA ESTRUCTURA (u.n.o.)

- LEFT END OF TRUSS (SEE TRUSS PROFILES)

ALL ROOF TRUSS DIMENSIONS ARE FROM OUTSIDE EDGE OF STUD (u.n.o.) SET ROOF TRUSSES FLUSH WITH FRAMING (u.n.o.)

WARNING: Trusses must be handled with care to prevent damage and injury. This truss placement diagram is to be used only as an installation aid; it is not a structural diagram. These trusses are designed as individual building components to be incorporated into the building design at the the specification of the building designer. See individual design sheets for each truss design identified on the placement drawing.

Professional advice should be sought regarding handling, installation, temporary and permanent bracing before erecting trusses. Temporary and permanent bracing is required during installation of trusses to prevent possible collapse. For general guidance regarding bracing, consult "BCSI-06" available jointly from WTCA & TPI.


Premier Building Supply must be notified of any issues requiring a back charge prior to any work being done. Premier Building Supply reserves the right to use it's service staff in lieu of being back charged.

ROOF PITCH FRONT TO BACK: 4/12 & 5/12 SOFFIT DESIGNED FOR 12" O.H HEEL HEIGHT: 8 1/4" - 7 3/16"

104-0-0

ROOF PITCH LEFT TO RIGHT: 8/12 SOFFIT DESIGNED FOR 12" O.H HEEL HEIGHT: 11 3/8"

TYPICAL WALL HEIGHT: 8-1-2

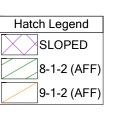

HANGER SCHEDULE		QUANTITY
	HUS28	21
	SDWC 15600	250