



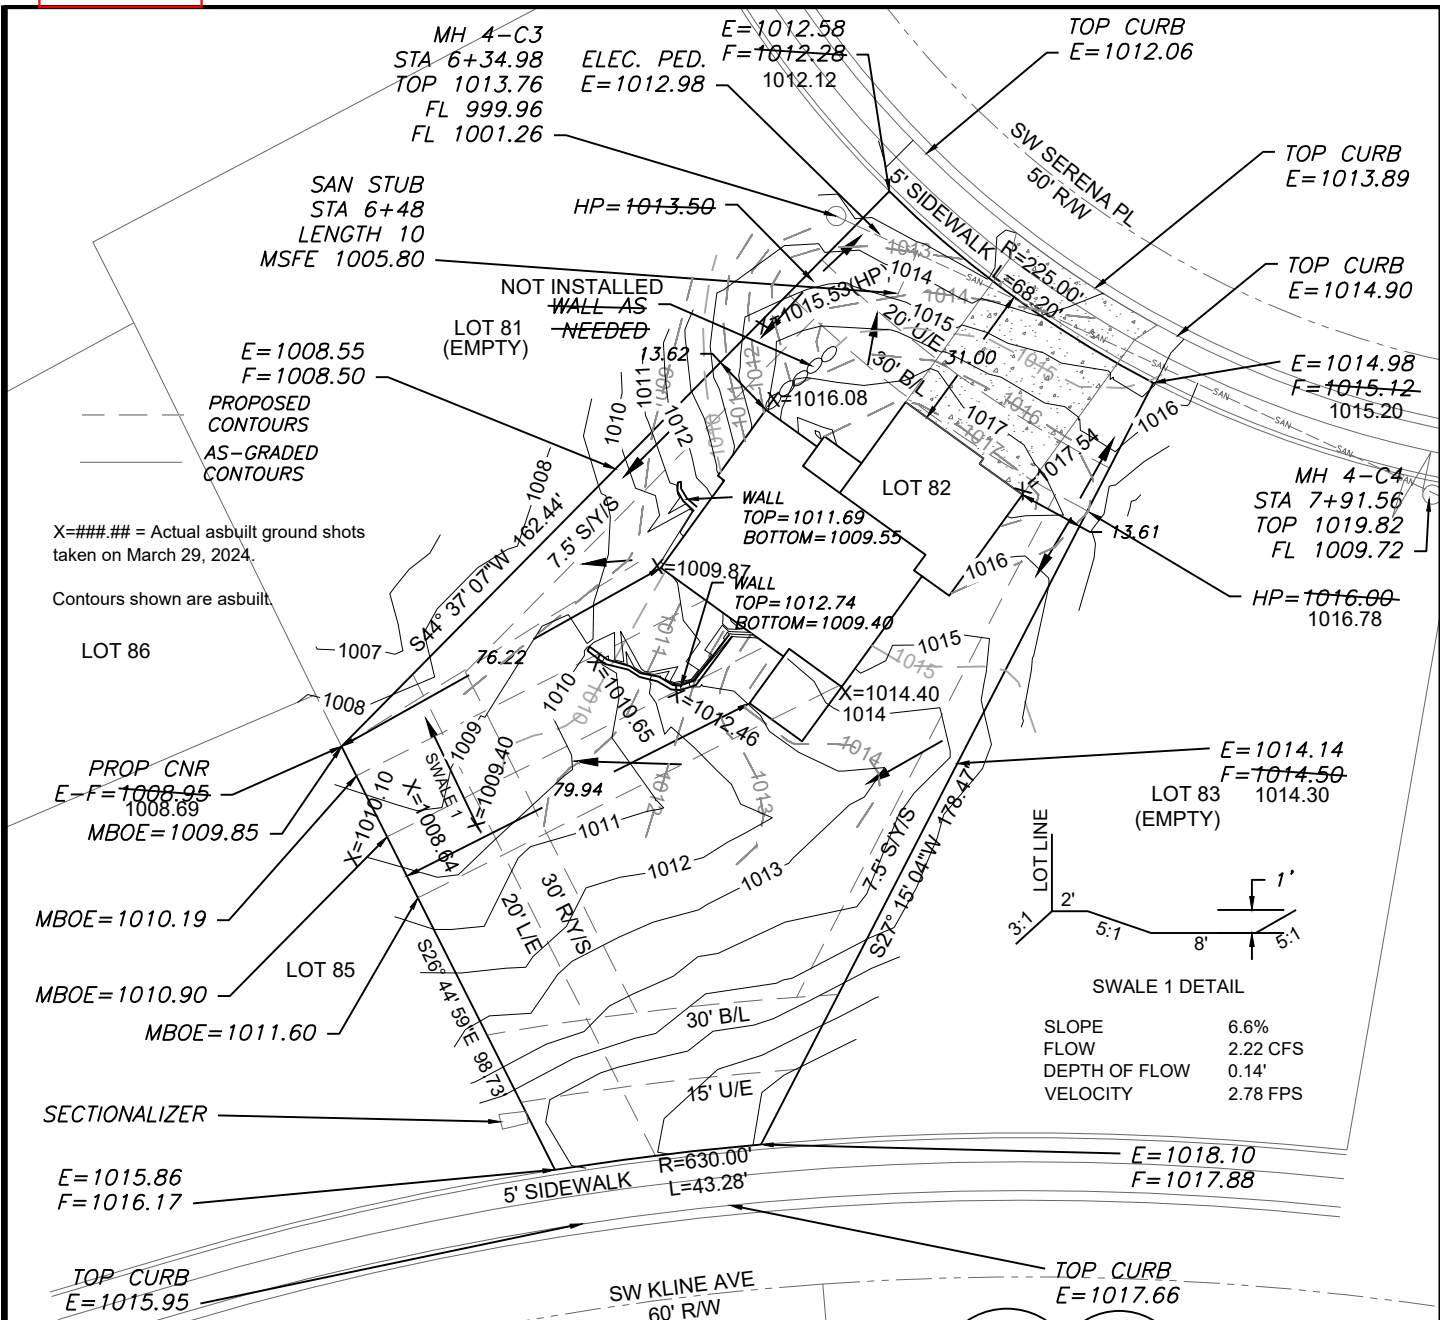

X=###.## = Actual asbuilt ground shots taken on March 29, 2024.

Contours shown are asbuilt.

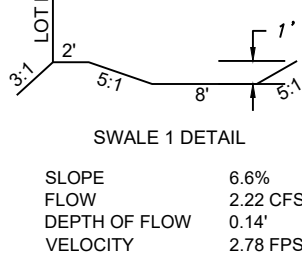

LEGEND

- Gas Meter
- Telephone or Fiber-Optic Pedestal
- Cable TV Pedestal
- Electric Pedestal
- Light Pole
- Mailbox
- Fire Hydrant
- Water Valve

PROPOSED HOUSE



TOP FOUNDATION = 1019.07
GARAGE FLOOR = 1017.07
TOP FOOTING = 1010.07
BASEMENT FLOOR = 1010.40
DRIVE SLOPE = 9.5%

E = EXISTING ELEVATION
F = PROPOSED FINAL ELEVATION
G = ADJACENT GRADE AT EGRESS
U/E = UTILITY EASEMENT
B/L = BUILDING LINE
S/Y/S = SIDE YARD SETBACK
R/Y/S = REAR YARD SETBACK

NOTES

- BUILDER TO VERIFY ALL BUILDING ELEVATIONS AND DIMENSIONS.
- THIS PLOT PLAN DOES NOT CONSTITUTE A BOUNDARY SURVEY.
- THE EASEMENTS SHOWN ON THIS PLOT PLAN ARE TAKEN FROM THE FINAL PLAT. EASEMENTS MAY EXIST.

AS-GRADED PLOT PLAN IS REQUIRED PRIOR TO SODDING

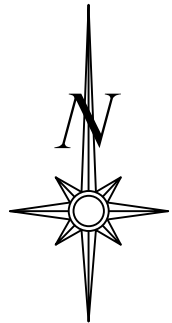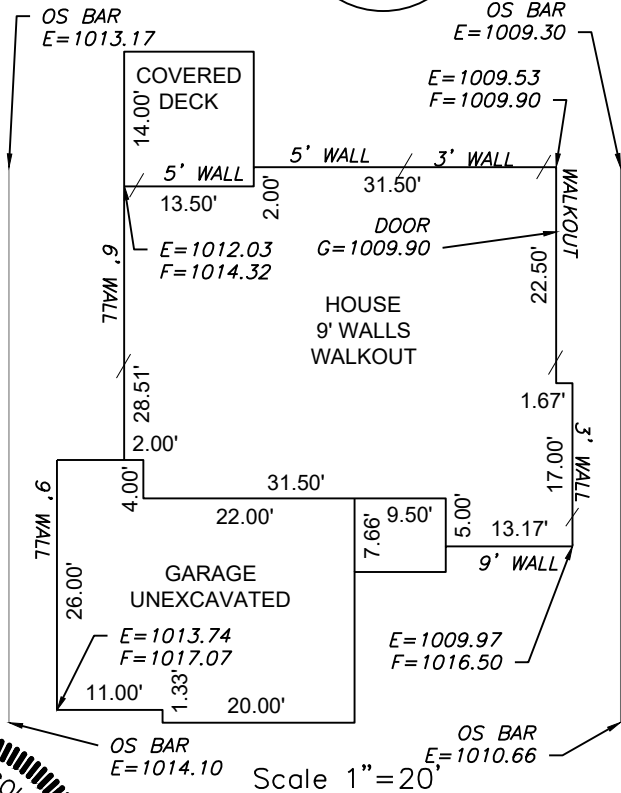

Scale 1"=40'


LOT INFORMATION

17,657 SQ. FT.
MBOE(NW)=1009.85
MBOE(W)=1014.75
MSFE =1005.80
ADDRESS
2311 SW SERENA PL

LEGAL DESCRIPTION

LOT 82, SUMMIT VIEW FARMS 4TH PLAT, A SUBDIVISION AS RECORDED IN LEE'S SUMMIT, JACKSON COUNTY, MISSOURI.

ENGINEERING SOLUTIONS
ENGINEERING & SURVEYING
50 SE 30TH STREET
LEE'S SUMMIT, MO 64082
P:(816) 623-9888 F:(816) 623-9849
WWW.ENGINEERINGSOLUTIONSKC.COM

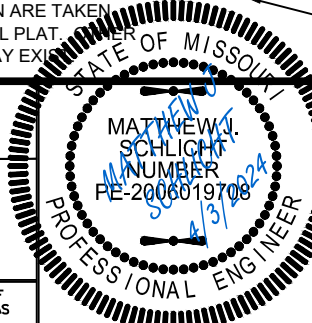

AS-GRADED PLOT PLAN - LOT 82
SUMMIT VIEW FARMS 4TH PLAT
LEE'S SUMMIT, JACKSON COUNTY, MISSOURI
WALKER CUSTOM HOMES LLC
PO BOX 247
LEE'S SUMMIT, MO 64063
PROJECT NO. 1 FILE NAME LOT 82, SUMMIT VIEW FARMS DATE 4/19/23 SHEET 1 OF 1
Rev:

THIS DRAWING IS NOT VALID UNLESS THE SIGNATURE, DATE AND SEAL OF THE ENGINEER WHO SUPERVISED THE PREPARATION OF THIS DRAWING HAS BEEN AFFIXED HERETO.