



RELEASE FOR CONSTRUCTION
AS NOTED ON PLANS REVIEW
DEVELOPMENT SERVICES
LEE'S SUMMIT, MISSOURI
04/08/2024 8:24:49

DN01 DO NOT cut, notch or drill flanges

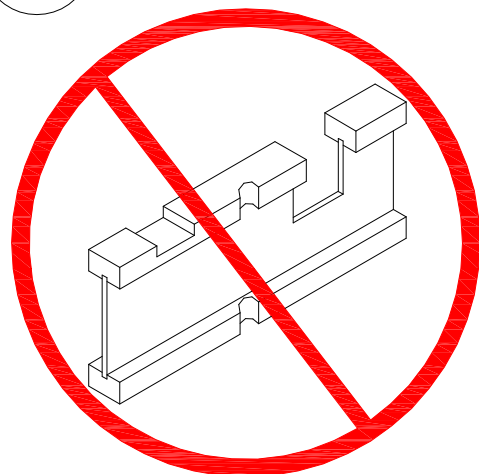

Start Framing Here
11-7/8" BCI 5000s 16" O.C.


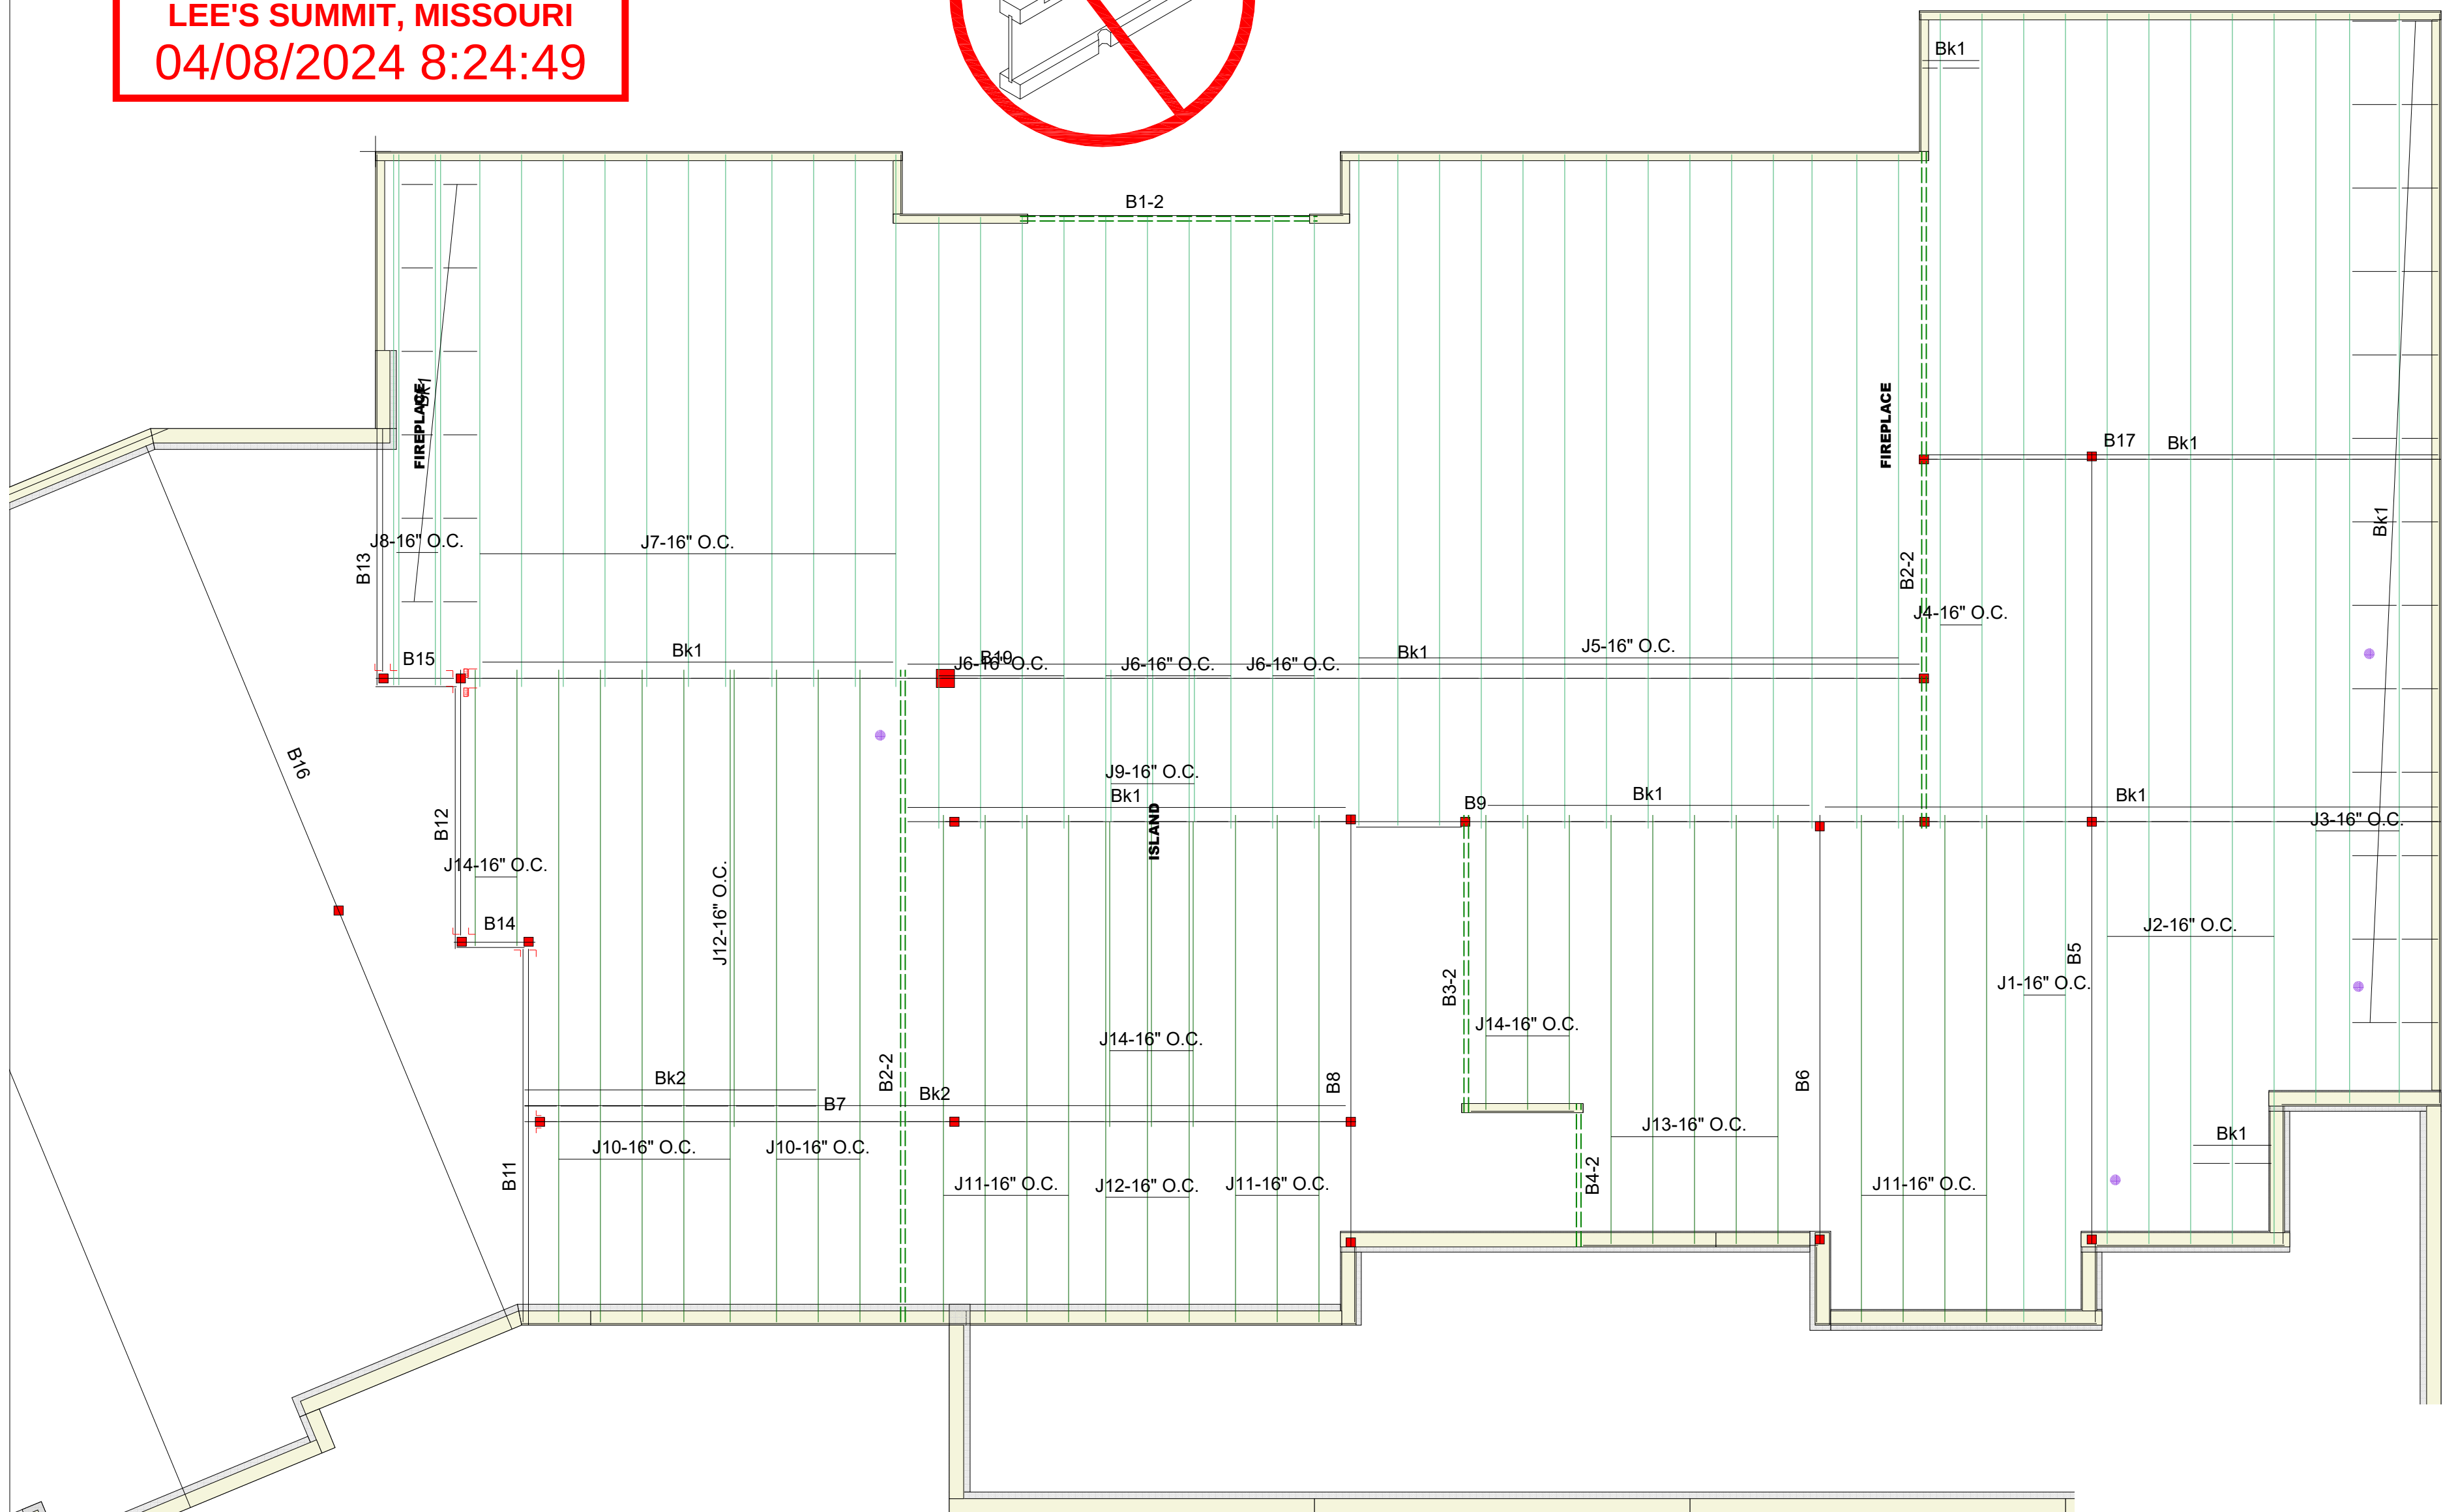


Products				
PlotID	Net Qty	Product	Length	Plies
J1-16" O.C.	2	11-7/8" BCI@ 5000s-1.8	42' 0"	1
J2-16" O.C.	5	11-7/8" BCI@ 5000s-1.8	40' 0"	1
J3-16" O.C.	3	11-7/8" BCI@ 5000s-1.8	36' 0"	1
J4-16" O.C.	2	11-7/8" BCI@ 5000s-1.8	28' 0"	1
J5-16" O.C.	14	11-7/8" BCI@ 5000s-1.8	22' 0"	1
J6-16" O.C.	10	11-7/8" BCI@ 5000s-1.8	20' 0"	1
J7-16" O.C.	11	11-7/8" BCI@ 5000s-1.8	18' 0"	1
J8-16" O.C.	4	11-7/8" BCI@ 5000s-1.8	18' 0"	2
J9-16" O.C.	3	11-7/8" BCI@ 5000s-1.8	6' 0"	1
J10-16" O.C.	8	1 1/2" 11 7/8 T-Tec LSL 1.35E	22' 0"	1
J11-16" O.C.	11	1 1/2" 11 7/8 T-Tec LSL 1.35E	18' 0"	1
J12-16" O.C.	4	1 1/2" 11 7/8 T-Tec LSL 1.35E	16' 0"	1
J13-16" O.C.	5	1 1/2" 11 7/8 T-Tec LSL 1.35E	14' 0"	1
J14-16" O.C.	8	1 1/2" 11 7/8 T-Tec LSL 1.35E	10' 0"	1
B1-2	2	1-3/4" x 9-1/2" VERSA-LAM@ 2.0 3100 SP	10' 0"	2
B2-2	4	1-3/4" x 11-7/8" VERSA-LAM@ 2.0 3100 SP	22' 0"	2
B3-2	2	1-3/4" x 11-7/8" VERSA-LAM@ 2.0 3100 SP	10' 0"	2
B4-2	2	1-3/4" x 11-7/8" VERSA-LAM@ 2.0 3100 SP	6' 0"	2
Ca1	19	1-1/8" x 11-7/8" BC RIM BOARD OSB	12' 0"	1
Bk1	127	11-7/8" BCI@ 5000s-1.8	2' 0"	1
Bk2	27	1 1/2" 11 7/8 T-Tec LSL 1.35E	2' 0"	1

SHOP DRAWING SUBMITTAL REVIEW
This review is for general conformance with plans and specifications only.
Approvals are subject to contractor's performance within the confines of the contract documents. Review of dimensions will not serve to relieve the contractor of contractual responsibility for any deviation from the contract requirements.

Approved as noted Note markings
Field measurements or templates required prior to fabrication Not approved - revise and resubmit

VISTA STRUCTURAL ENGINEERING, LLC
www.vistastructural.com
By: Dennis Heier Date: 03/06/2024

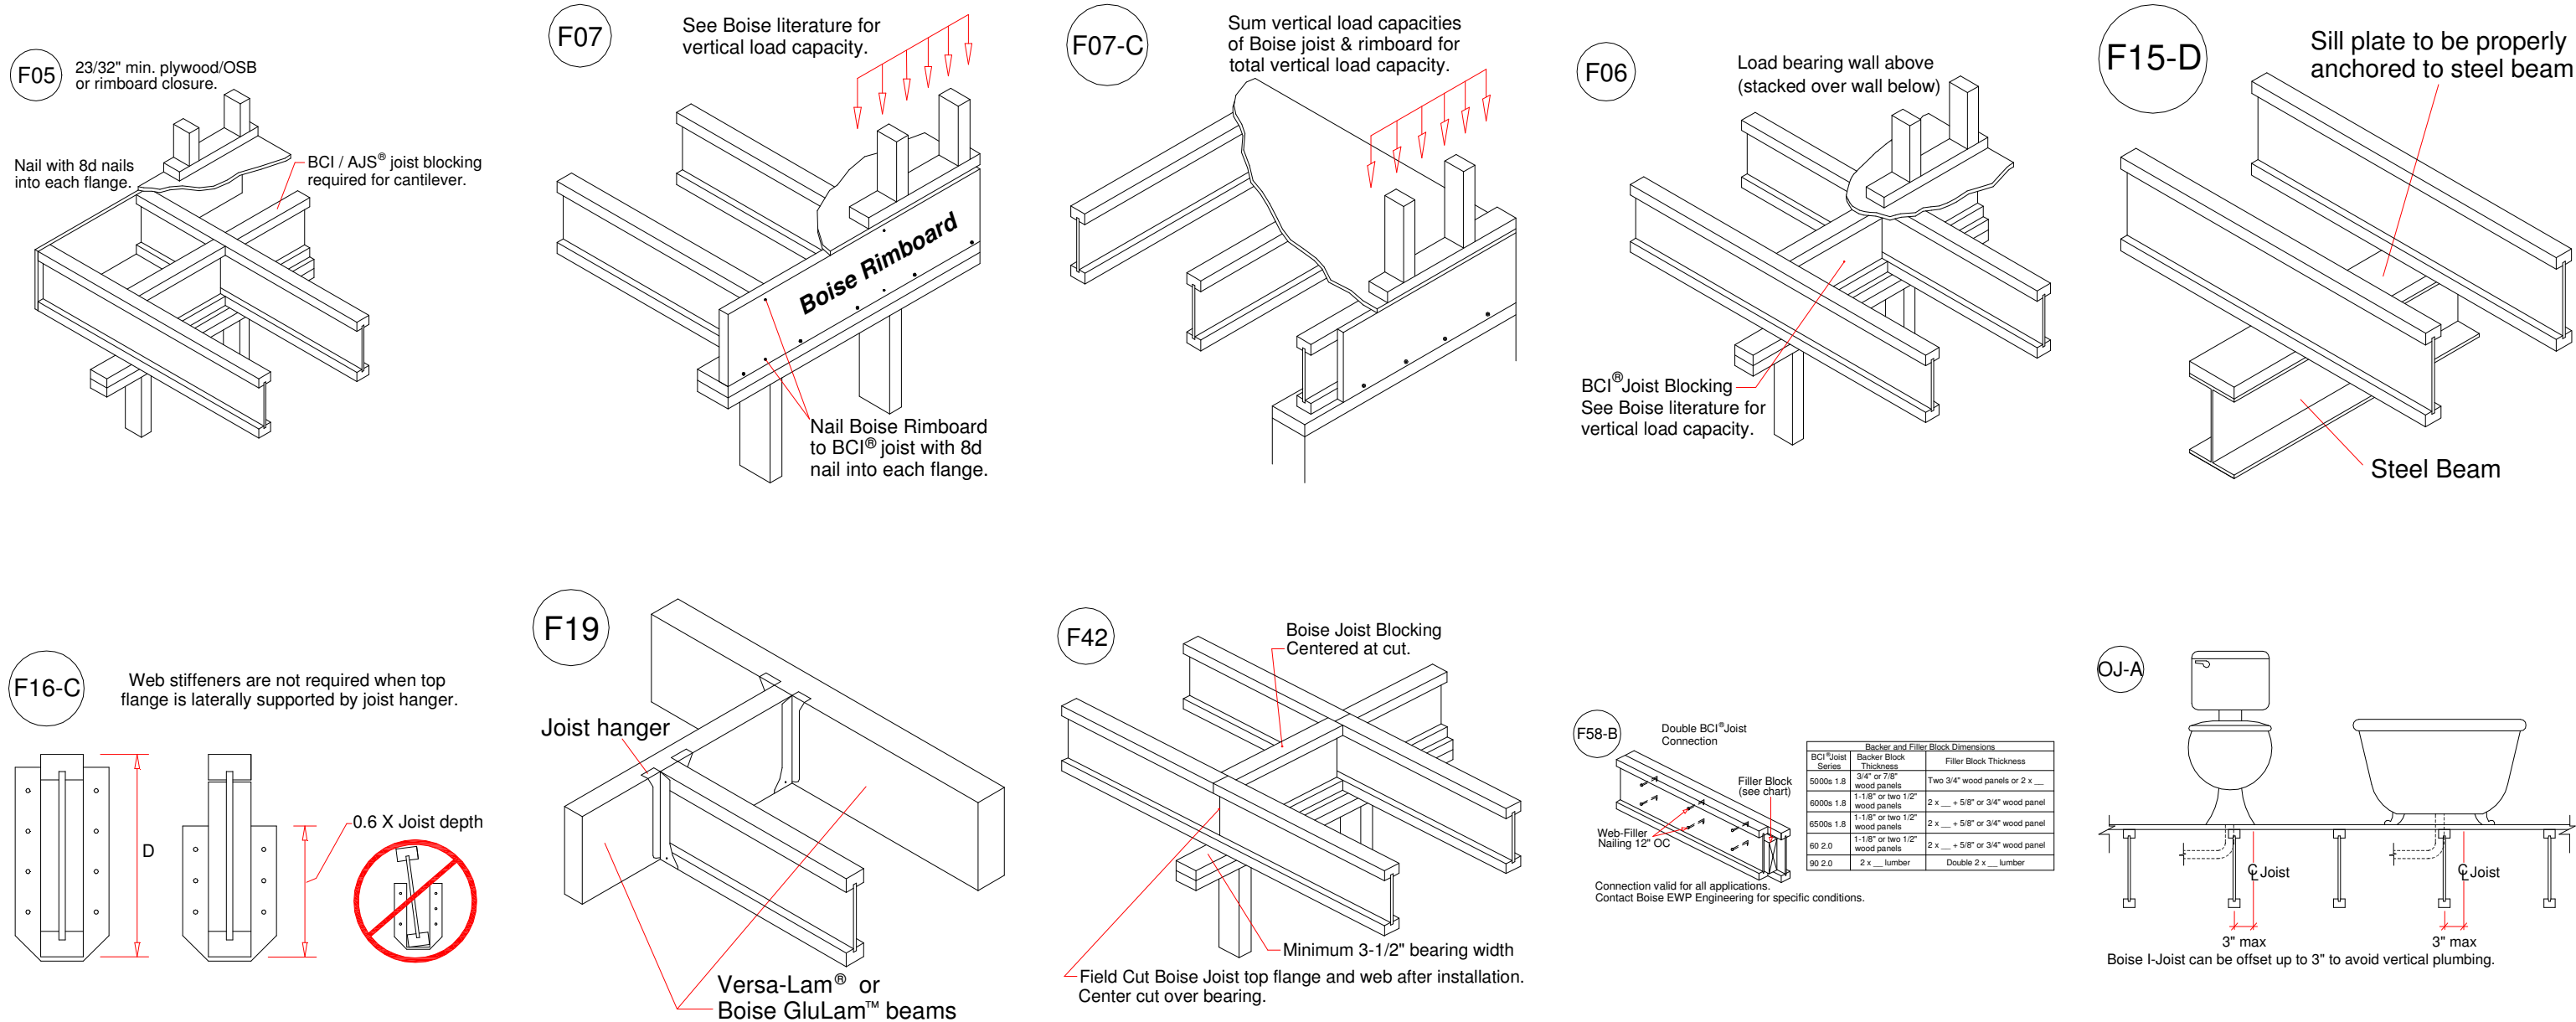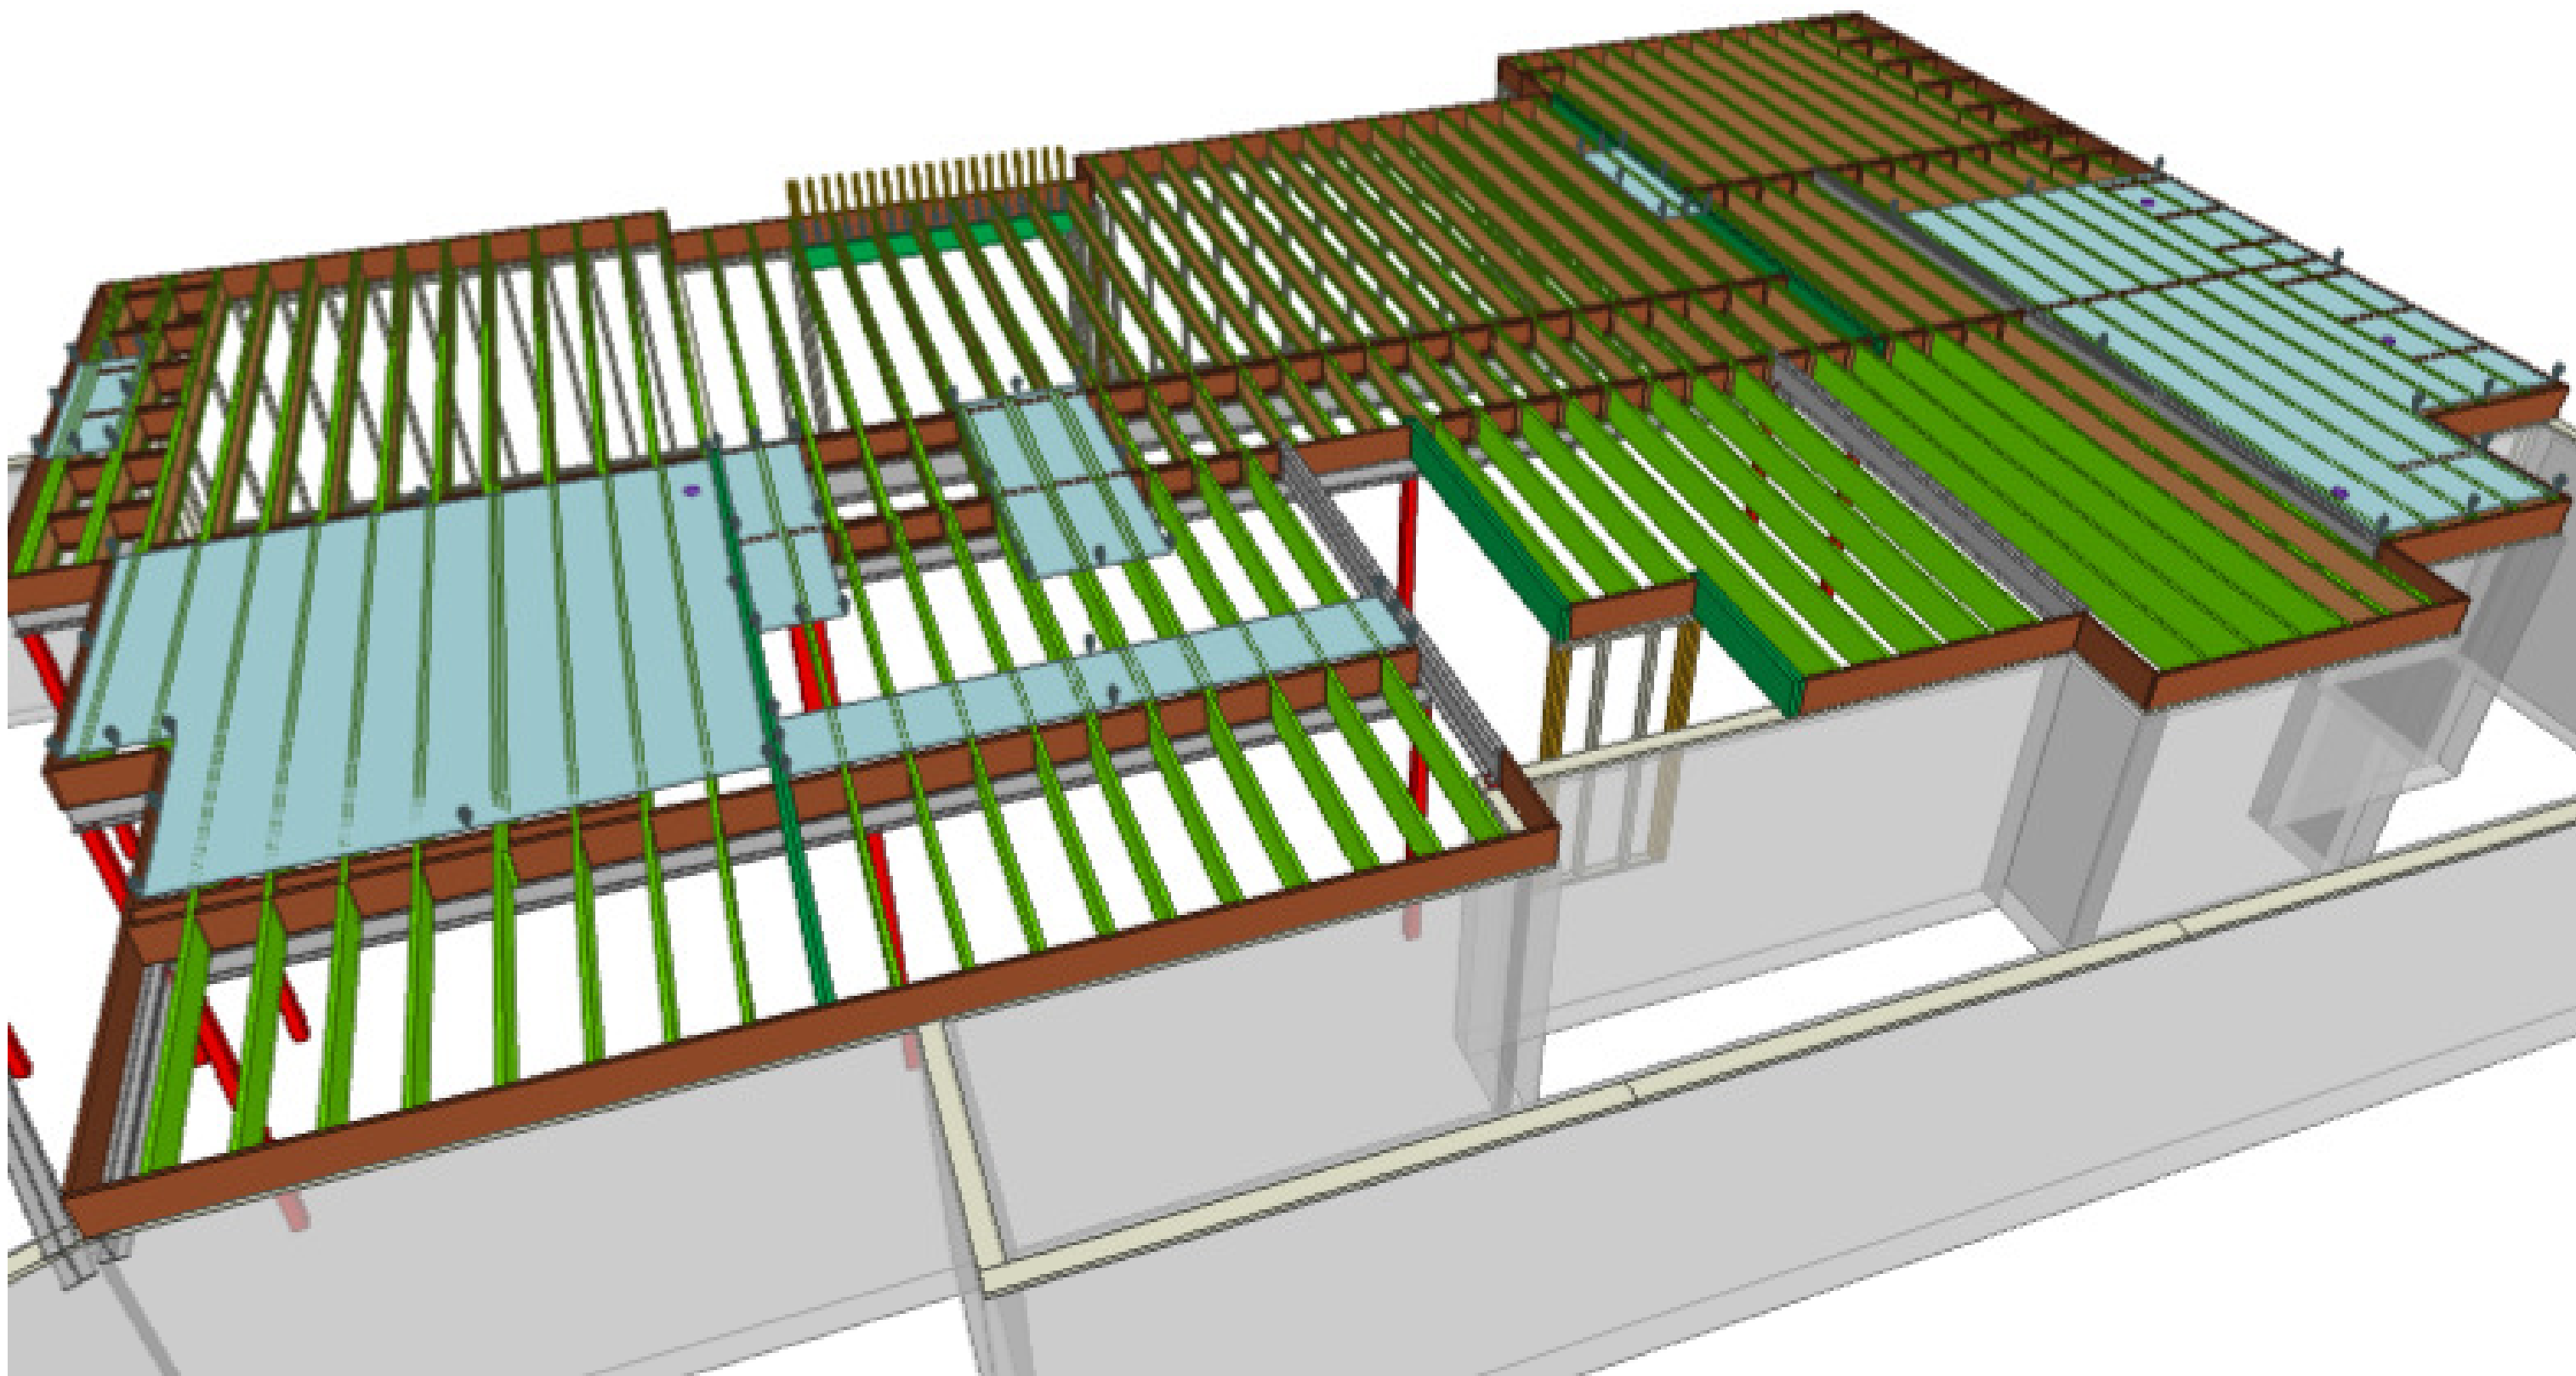

Revisions:BY:

Boise Cascade

84 LUMBER

SALES PRESENTATION DRAWING
No structural or dimensional check has been made of this design drawings of the building, therefore purchaser is to check and approve all dimensions, quantities, loads, and details carefully.
This drawing has not been check by Boise Engineering.
NOTE:
ALL MEASUREMENTS
TO BE VERIFIED
IN THE FIELD.

84 LUMBER
RWR165A Fulson
Boise Cascade
N/A

BC FRAMER

Scale: 1/4"=1'-0"

Date: 02/29/2024

By: Mitek

File: RWR165A Fulson

DWG:

Sheet: 1/1