

HANGER

SCHEDULE

LUS24

Quantity

2

MO

Job Site A
City,

Designer
3/20/2024


HIS LAYOUT IS THE SOLE SOURCE FOR FABRICATION OF TRUSSES AND VOIDS ALL PREVIOUS ARCHITECTURAL OR OTHER TRUSS LAYOUTS. REVIEW AND APPROVAL OF THIS LAYOUT MUST BE RECEIVED BEFORE ANY TRUSSES WILL BE BUILT. VERIFY ALL CONDITIONS TO INSURE AGAINST CHANGES THAT WILL RESULT IN EXTRA CHARGES TO YOU.

**EVERSTEAD** 

SHOP DRAWING / SUBMITTAL

RELEASE FOR CONSTRUCTION AS NOTED FOR PLAN REVIEW DEVELOPMENT SERVICES LEE'S SUMMIT, MISSOURI 04/11/2024

Roof Truss Layout Scale: 3/16" = 1'

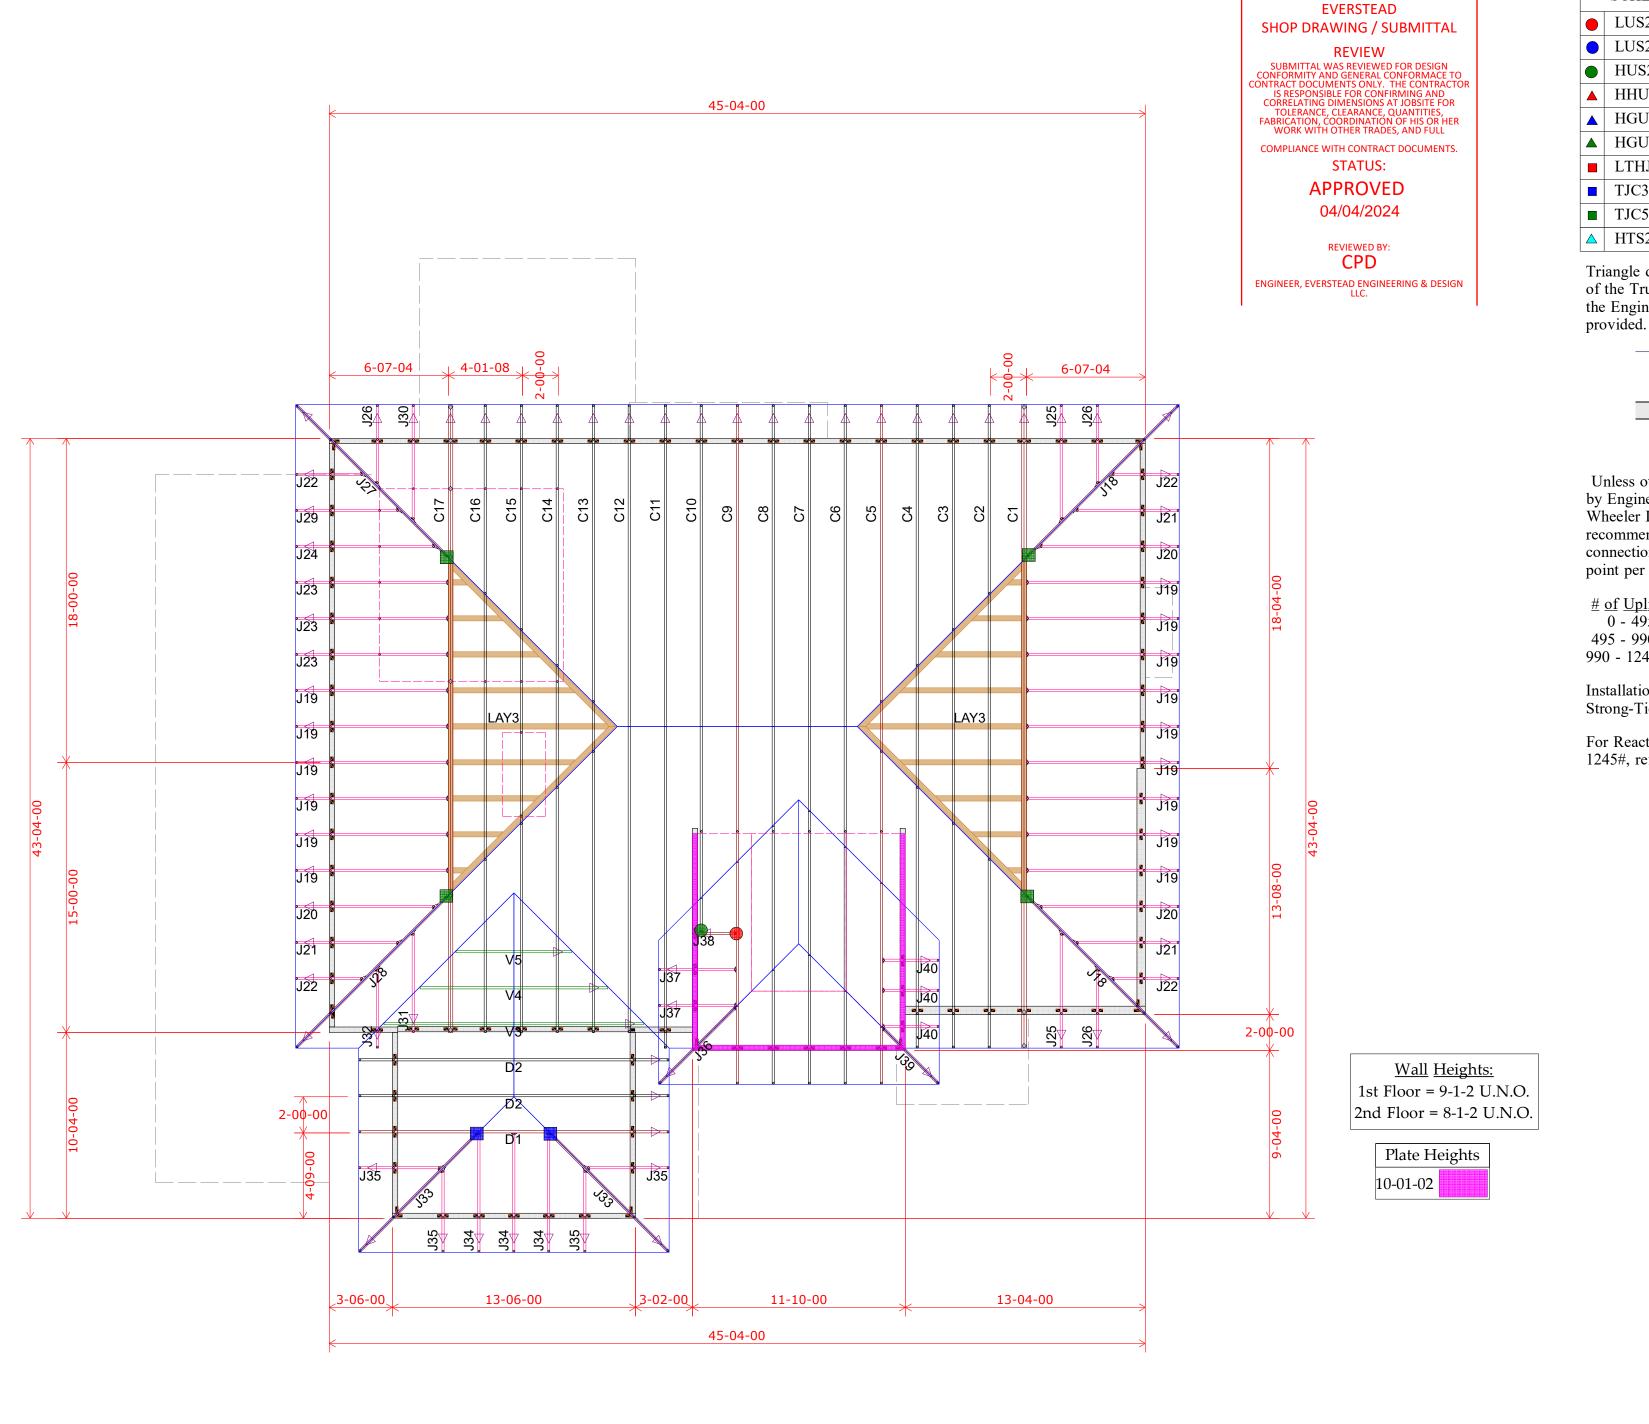

HANGER Quantity **SCHEDULE** LUS24 2 LUS26 0 MO HUS26 Lot 146 Woodside Ridge ▲ HHUS26-2 0 ▲ HGUS26-2 0 ▲ HGUS28-3 0 LTHJA26 0 TJC37 5 TJC57 4 △ HTS20 0 Triangle denotes the left end State of the Truss as it appears on the Engineered Drawings Job Name

Customer

Job Site / City,

Designer
3/20/2024

HIS LAYOUT IS THE SOLE SOURCE FOR FABRICATION OF TRUSSES AND VOIDS ALL PREVIOUS ARCHITECTURAL OR OTHER TRUSS LAYOUTS. REVIEW AND APPROVAL OF THIS LAYOUT MUST BE RECEIVED BEFORE ANY TRUSSES WILL BE BUILT. VERIFY ALL CONDITIONS TO INSURE AGAINST CHANGES THAT WILL RESULT IN EXTRA CHARGES TO YOU.

Unless otherwise specified by Engineer Of Record, Wheeler Lumber, LLC recommends an uplift connection at each bearing point per the following:

# of Uplift Connector 0 - 495: (1) H2.5A 495 - 990: (2) H2.5A 990 - 1245: (1) HTS20

Installation per Simpson Strong-Tie guidelines.

For Reactions greater than 1245#, refer to EOR.

Wheeler Lumber 1959 Old Hwy 50 NE Waverly, KS 66871



Roof Truss Layout
Scale: 3/16" = 1'