


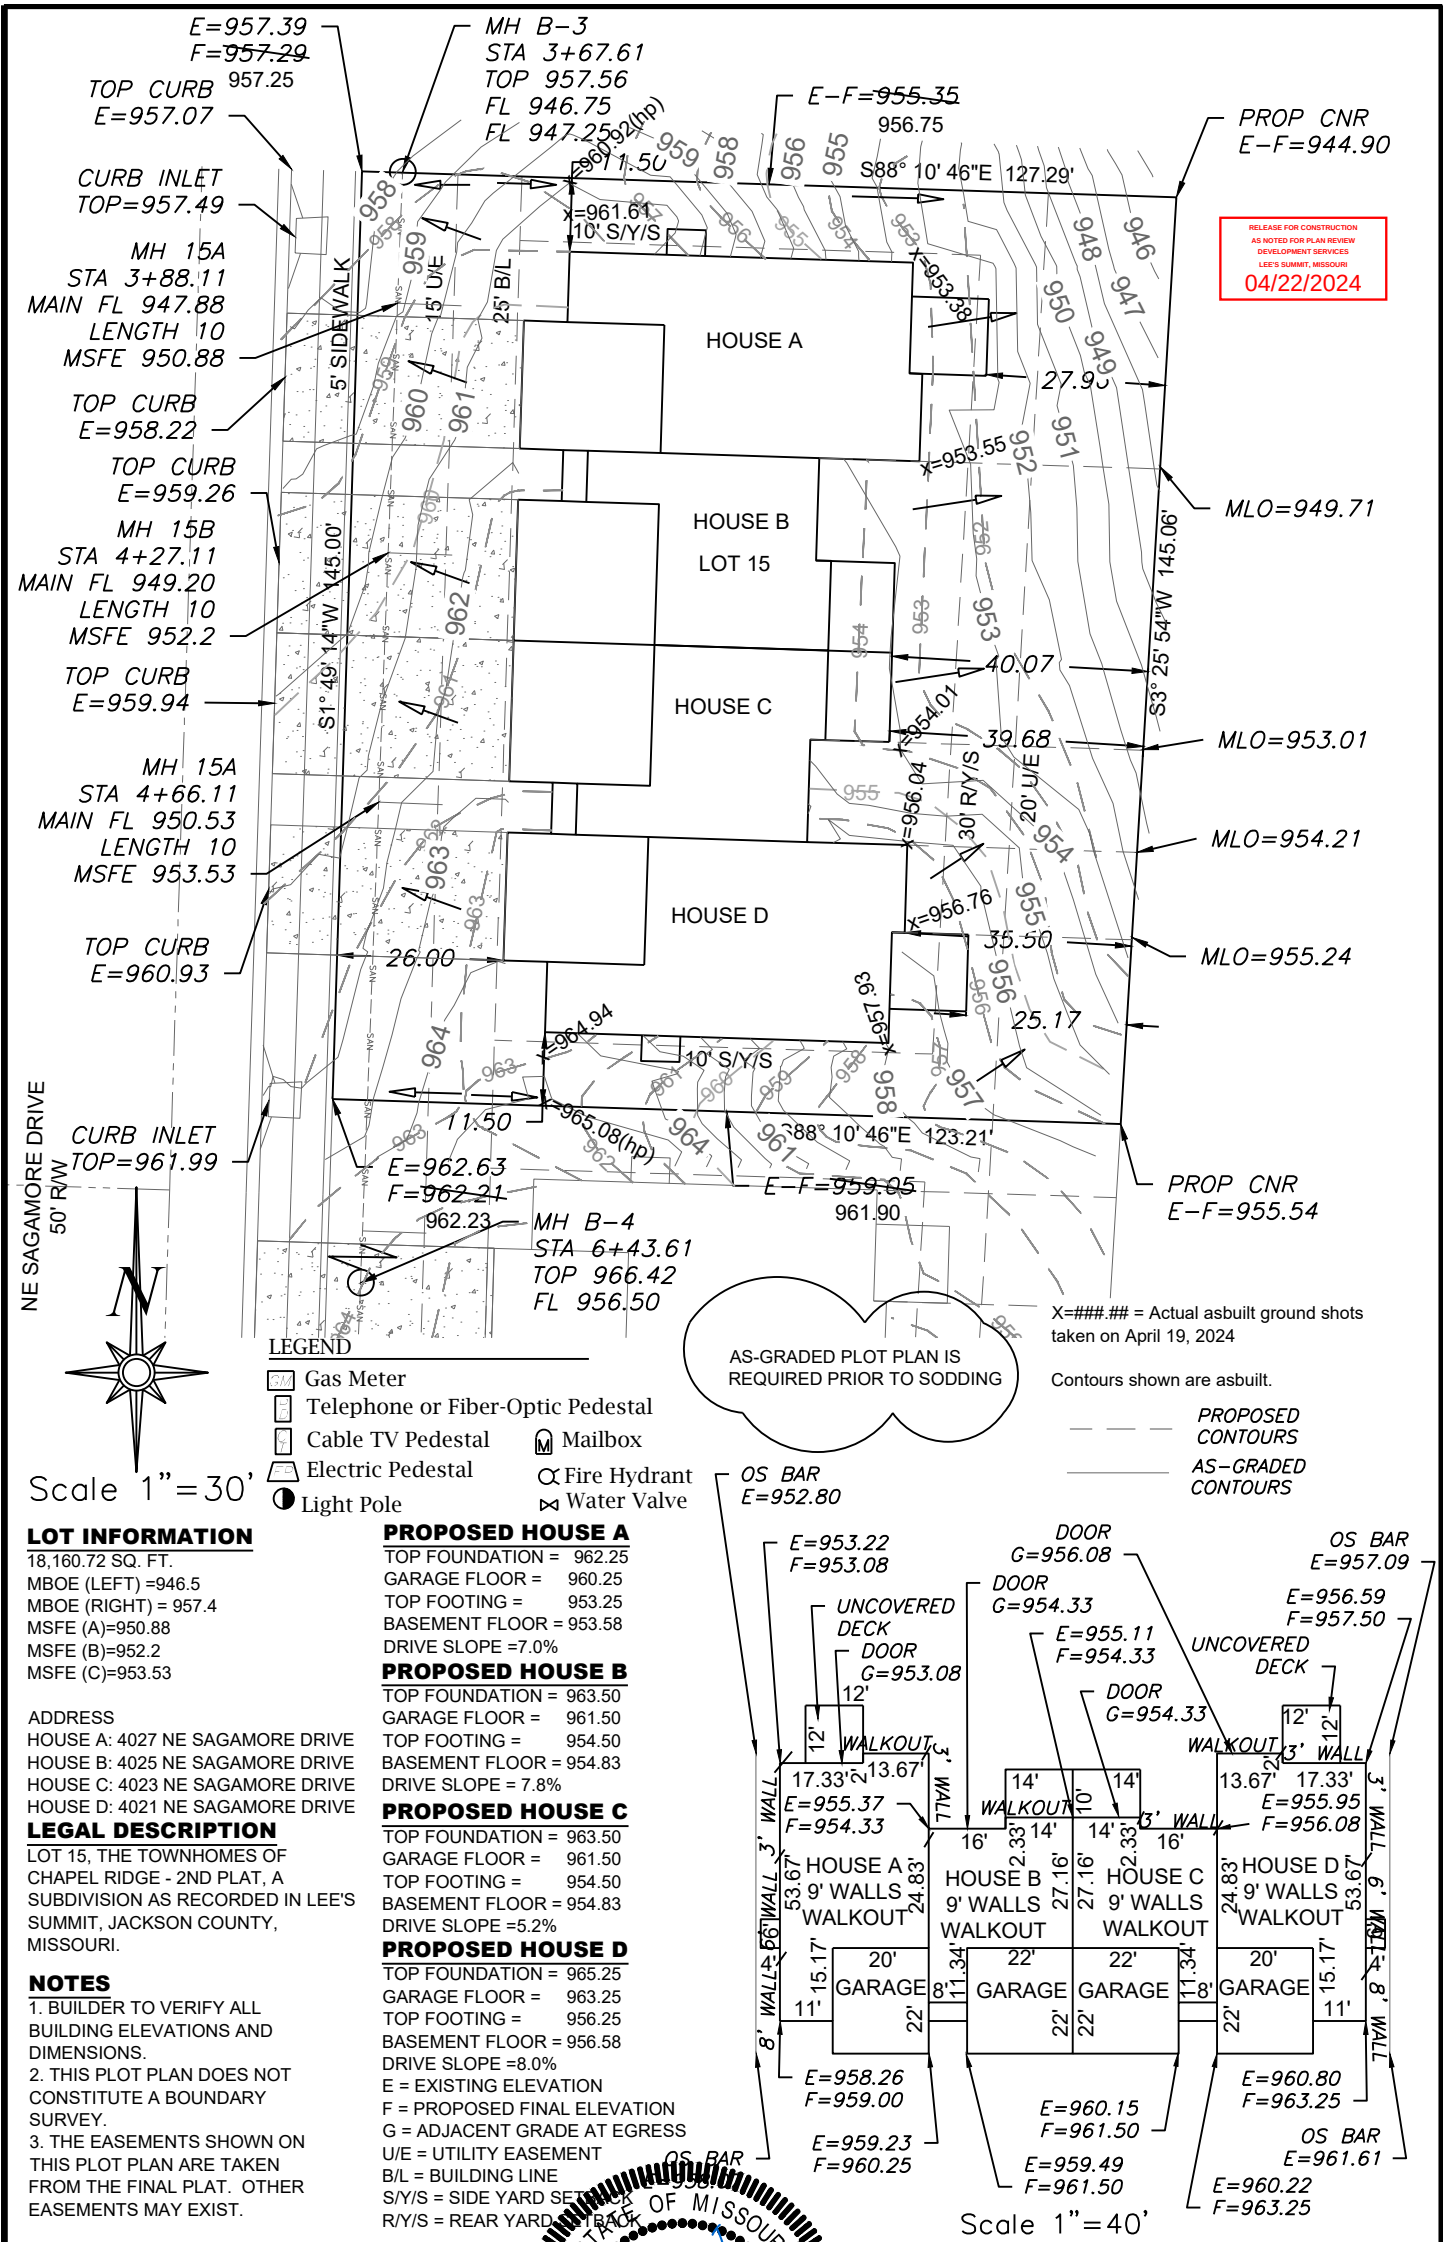

RELEASE FOR CONSTRUCTION
AS NOTED FOR PLAN REVIEW
DEVELOPMENT SERVICES
LEE'S SUMMIT, MISSOURI
04/22/2024


X=###.## = Actual asbuilt ground shots taken on April 19, 2024

Contours shown are asbuilt.

--- PROPOSED CONTOURS
--- AS-GRADED CONTOURS

Scale 1"=40'

ENGINEERING SOLUTIONS
ENGINEERING & SURVEYING
50 SE 30TH STREET
LEE'S SUMMIT, MO 64082
P:(816) 623-9888 F:(816) 623-9849
WWW.ENGINEERINGSOLUTIONSKC.COM

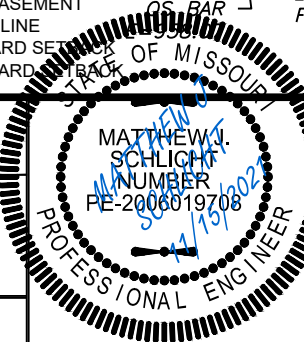

AS-GRADED PLOT PLAN - LOT 15				
THE TOWNHOMES OF CHAPEL RIDGE - 2ND PLAT				
LEE'S SUMMIT, JACKSON COUNTY, MISSOURI				
KEVIN HIGDON CONSTRUCTION				
P.O. BOX 847				
LEE'S SUMMIT, MO 64063				
PROJECT NO.	FILE NAME	DATE	SHEET	OF
1	LOT 14, 15, TOWNHOMES OF CHAPEL RIDGE	5/14/21	1	1
Rev:				