


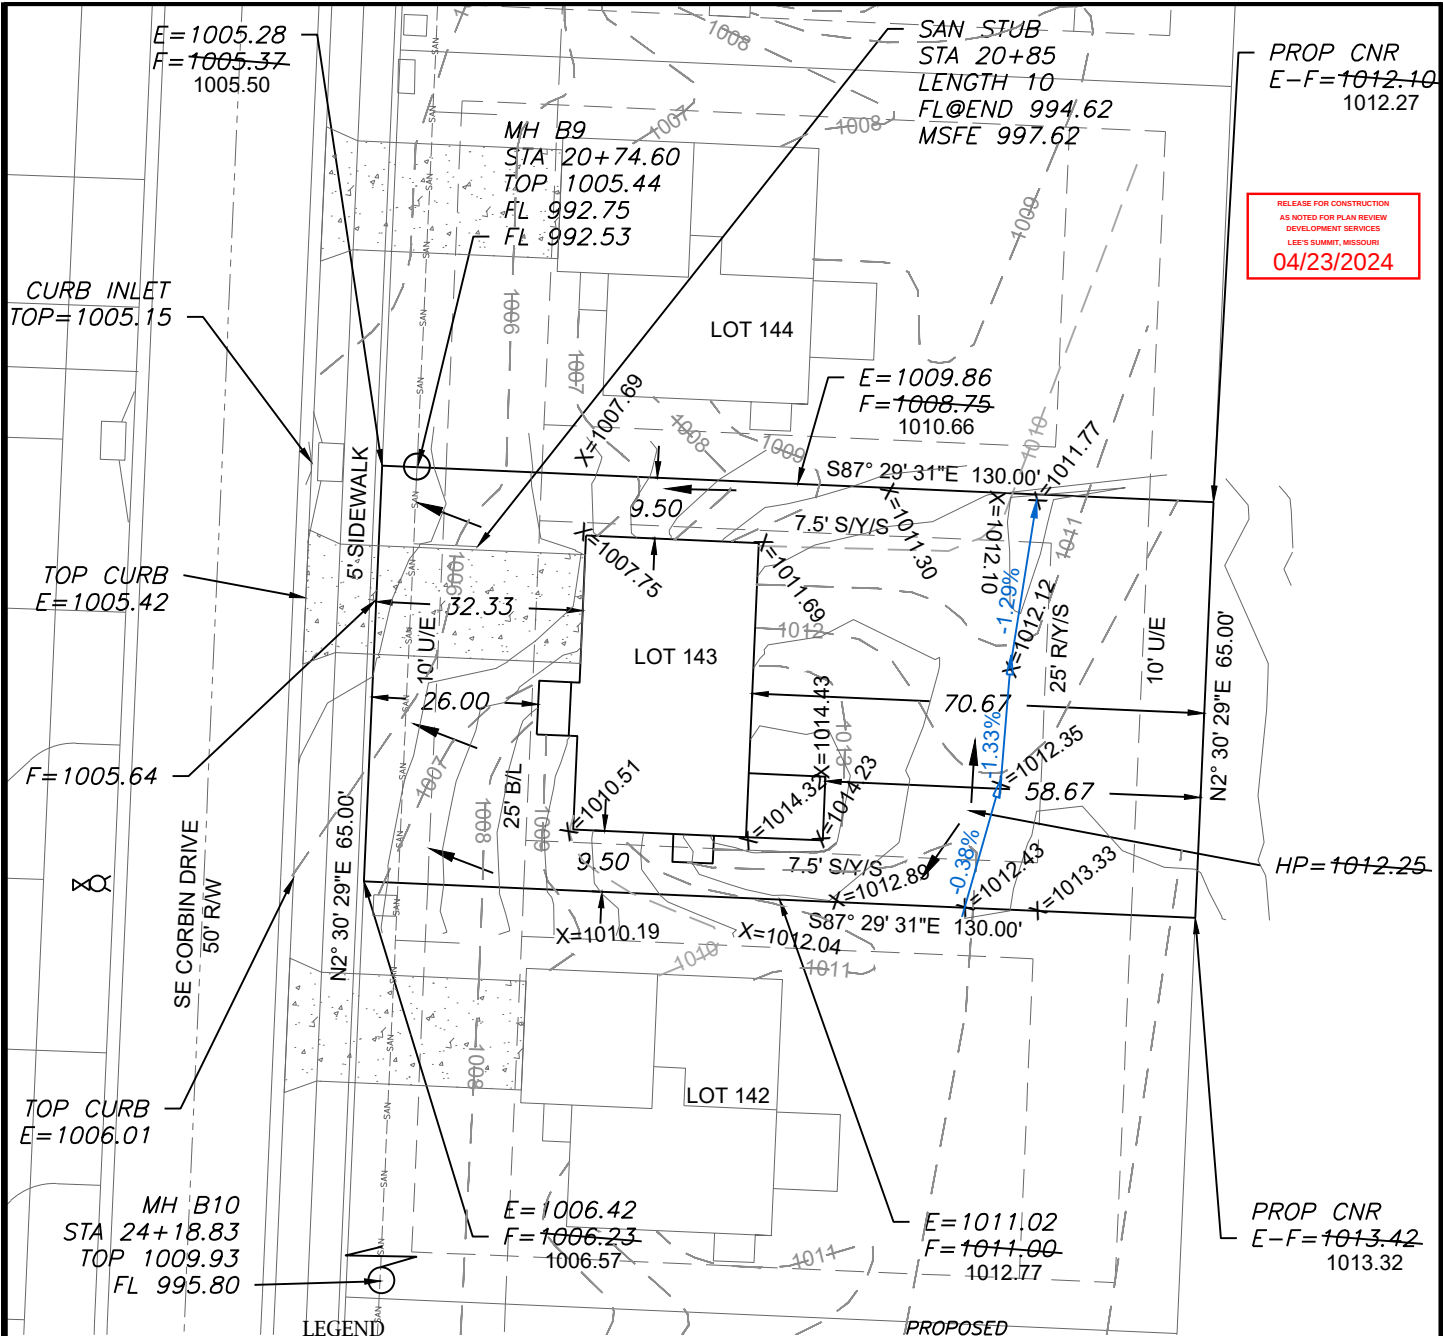

RELEASE FOR CONSTRUCTION
AS NOTED FOR PLAN REVIEW
DEVELOPMENT SERVICES
LEE'S SUMMIT, MISSOURI
04/23/2024

LEGEND

- Gas Meter
- Telephone or Fiber-Optic Pedestal
- Cable TV Pedestal
- Electric Pedestal
- Light Pole
- Mailbox
- Fire Hydrant
- Water Valve

PROPOSED HOUSE

TOP FOUNDATION = 1015.67
GARAGE FLOOR = 1007.00
TOP FOOTING = 1006.67
BASEMENT FLOOR = 1007.00
DRIVE SLOPE = 4.2%

E = EXISTING ELEVATION
F = PROPOSED FINAL ELEVATION
G = ADJACENT GRADE AT EGRESS
U/E = UTILITY EASEMENT
B/L = BUILDING LINE
S/Y/S = SIDE YARD SETBACK
R/Y/S = REAR YARD SETBACK

NOTES

- BUILDER TO VERIFY ALL BUILDING ELEVATIONS AND DIMENSIONS.
- THIS PLOT PLAN DOES NOT CONSTITUTE A BOUNDARY SURVEY.
- THE EASEMENTS SHOWN ON THIS PLOT PLAN ARE TAKEN FROM THE FINAL PLAT. OTHER EASEMENTS MAY EXIST.


PROPOSED
CONTOURS
AS-GRADED
CONTOURS

X=#### = Actual asbuilt ground shots taken on February 14, 2024

Contours shown are asbuilt.

NOTE : DECK APPROVAL WILL BE REQUIRED PRIOR TO (FUTURE) DECK CONSTRUCTION

EXTENDED LOT AREA = 9,165.0 SF
DRIVE AREA = 549.6 SF
APPROACH AREA = 197.0 SF
SIDEWALK AREA = 240.0 SF

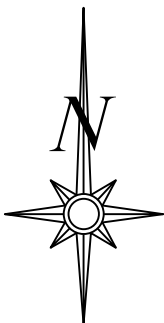


Scale 1"=30'

LOT INFORMATION

8450 SQ. FT.
MSFE=997.62
ADDRESS

3537 SE CORBIN DR.

LEGAL DESCRIPTION
LOT 143, COBEY CREEK - 1ST
PLAT, A SUBDIVISION AS
RECORDED IN LEE'S SUMMIT,
JACKSON COUNTY, MISSOURI.

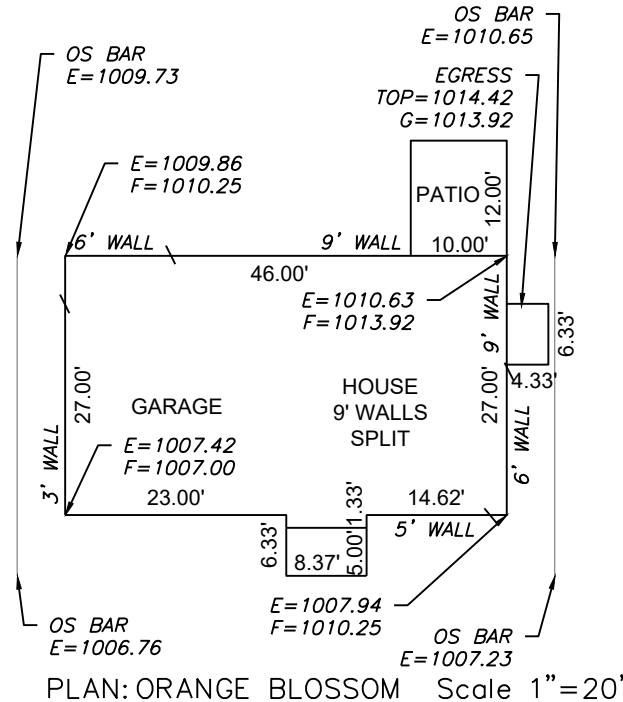

PLAN: ORANGE BLOSSOM Scale 1"=20'

ENGINEERING
ENGINEERING & SURVEYING
SOLUTIONS

50 SE 30TH STREET
LEE'S SUMMIT, MO 64082
P: (816) 623-9888 F: (816) 623-9849
WWW.ENGINEERINGSOLUTIONKCC.COM

THIS DRAWING IS NOT VALID UNLESS THE SIGNATURE, DATE AND SEAL OF THE ENGINEER WHO SUPERVISED THE PREPARATION OF THIS DRAWING HAS BEEN AFFIXED HERETO.

AS-GRADED PLOT PLAN - LOT 143

COBEY CREEK - 1ST PLAT
LEE'S SUMMIT, JACKSON COUNTY, MISSOURI

CLOVER AND HIVE
120 SE 30TH STREET
LEE'S SUMMIT, MO 64082

PROJECT NO.	FILE NAME	DATE	SHEET	OF
1	LOT 140-159, COBEY CREEK	10/4/21	1	1