


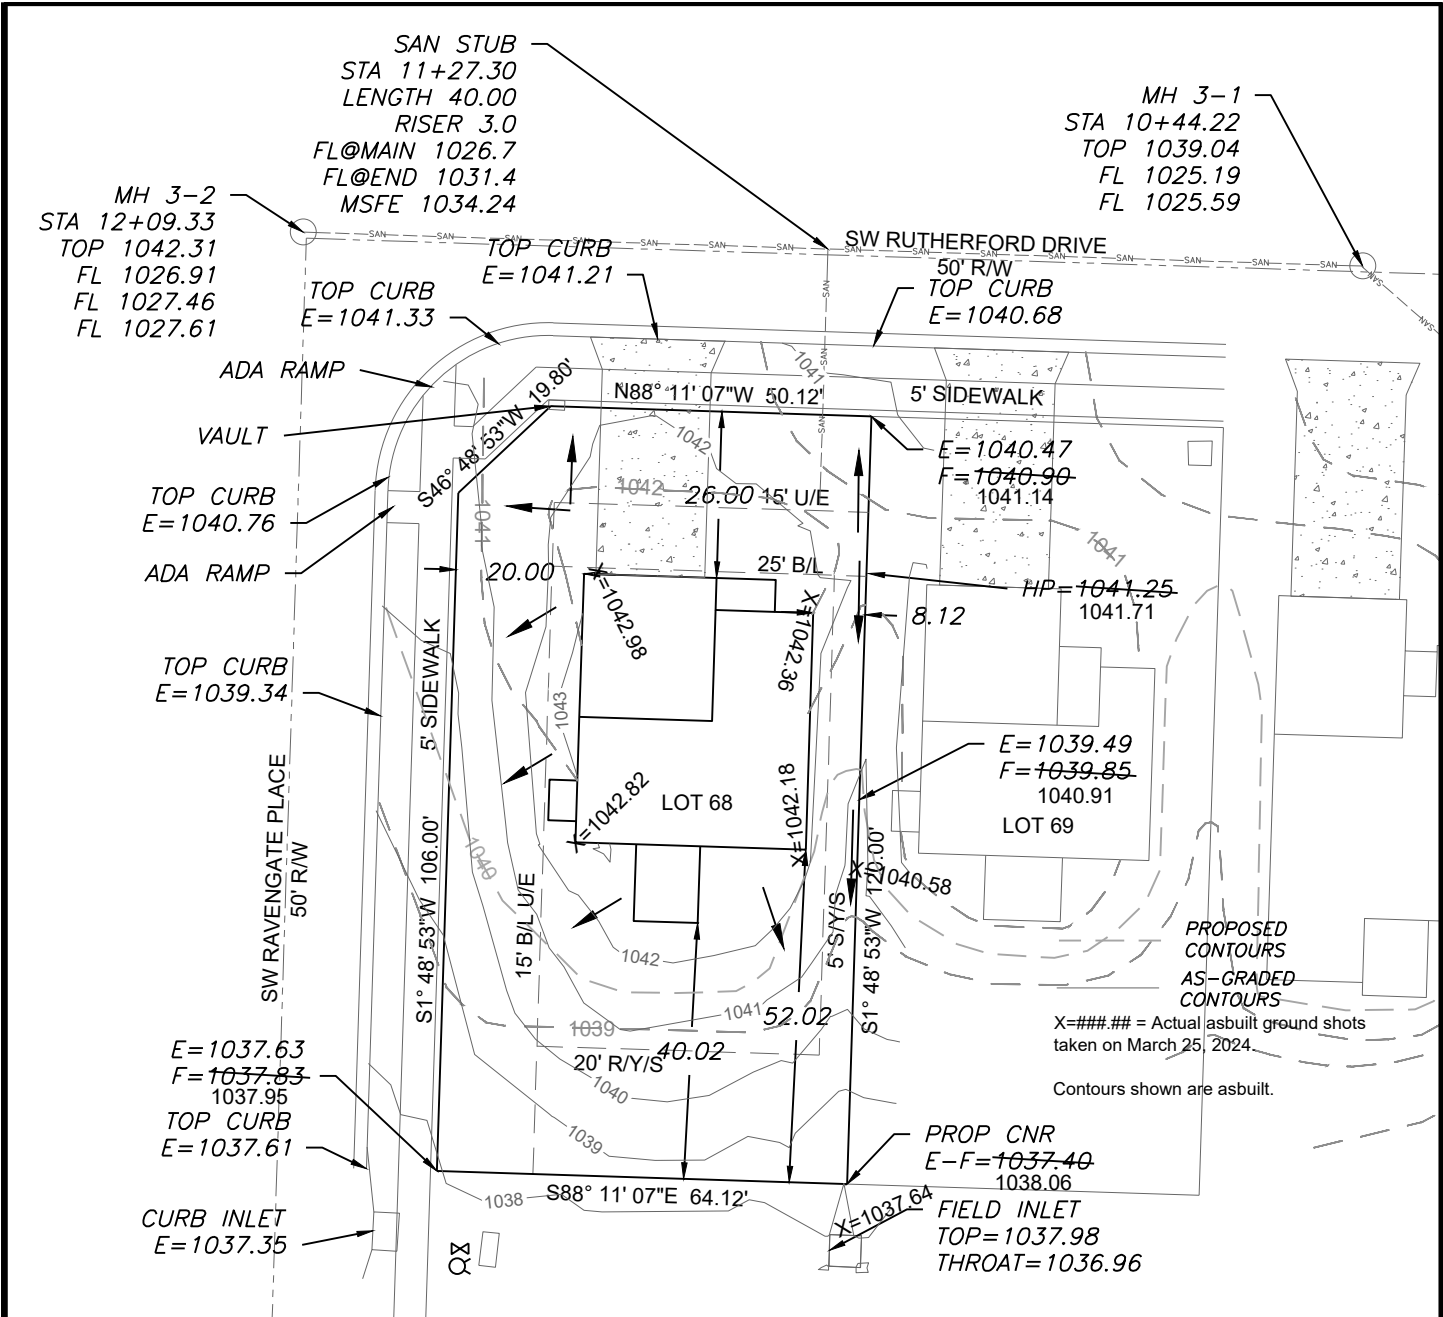

LEGEND

- Gas Meter
- Telephone or Fiber-Optic Pedestal
- Cable TV Pedestal
- Electric Pedestal
- Light Pole
- Mailbox
- Fire Hydrant
- Water Valve

PROPOSED HOUSE

TOP FOUNDATION = 1043.75
GARAGE FLOOR = 1042.75
TOP FOOTING = 1035.75
BASEMENT FLOOR = 1036.08
DRIVE SLOPE = 5.1%

E = EXISTING ELEVATION
F = PROPOSED FINAL ELEVATION
G = ADJACENT GRADE AT EGRESS
U/E = UTILITY EASEMENT
B/L = BUILDING LINE
S/Y/S = SIDE YARD SETBACK
R/Y/S = REAR YARD SETBACK

NOTES


1. BUILDER TO VERIFY ALL BUILDING ELEVATIONS AND DIMENSIONS.
2. THIS PLOT PLAN DOES NOT CONSTITUTE A BOUNDARY SURVEY.
3. THE EASEMENTS SHOWN ON THIS PLOT PLAN ARE TAKEN FROM THE FINAL PLAT. EASEMENTS MAY EXIST.

EXTENDED LOT AREA = 9,706.8 SF
DRIVE AREA = 442.0 SF
APPROACH AREA = 197.0 SF
SIDEWALK AREA = 903.0 SF

AS-GRADED PLOT PLAN IS REQUIRED PRIOR TO SODDING

X=###.## = Actual asbuilt ground shots taken on March 25, 2024.
Contours shown are asbuilt.

PROP CNR
E-F=1037.40
1038.06
FIELD INLET
TOP=1037.98
THROAT=1036.96

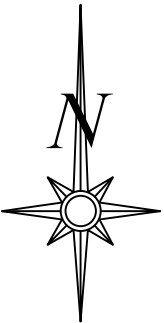

Scale 1"=30'

LOT INFORMATION

7,596 SQ. FT.
REAR LEFT MBOE = 1038.02
REAR RIGHT MBOE = 1038.19
MSFE = 1034.24
ADDRESS
2133 SW RUTHERFORD DRIVE

LEGAL DESCRIPTION

LOT 68, OSAGE SECOND PLAT, A SUBDIVISION AS RECORDED IN LEE'S SUMMIT, JACKSON COUNTY, MISSOURI.


OS BAR
E=1039.68

OS BAR
E=1041.36

E=1039.69
F=1041.00

OS BAR
E=1040.08


OS BAR
E=1041.53

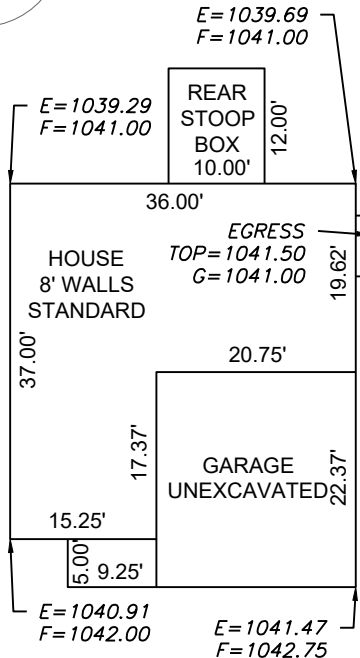

PLAN: BASSWOOD

Scale 1"=20'

ENGINEERING SOLUTIONS
ENGINEERING & SURVEYING
50 SE 30TH STREET
LEE'S SUMMIT, MO 64082
P:(816) 623-9888 F:(816) 623-9849
WWW.ENGINEERINGSOLUTIONSKC.COM

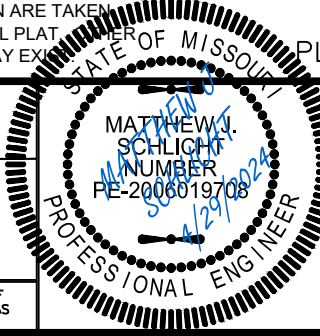

AS-GRADED PLOT PLAN - LOT 68				
OSAGE SECOND PLAT LEE'S SUMMIT, JACKSON COUNTY, MISSOURI				
CLOVER & HIVE 120 SE 30TH STREET LEE'S SUMMIT, MO 64082				
PROJECT NO.	FILE NAME	DATE	SHEET	OF
1	LOT 68, OSAGE	4/19/23	1	1
Rev:				

THIS DRAWING IS NOT VALID UNLESS THE SIGNATURE, DATE AND SEAL OF THE ENGINEER WHO SUPERVISED THE PREPARATION OF THIS DRAWING HAS BEEN AFFIXED HERETO.