


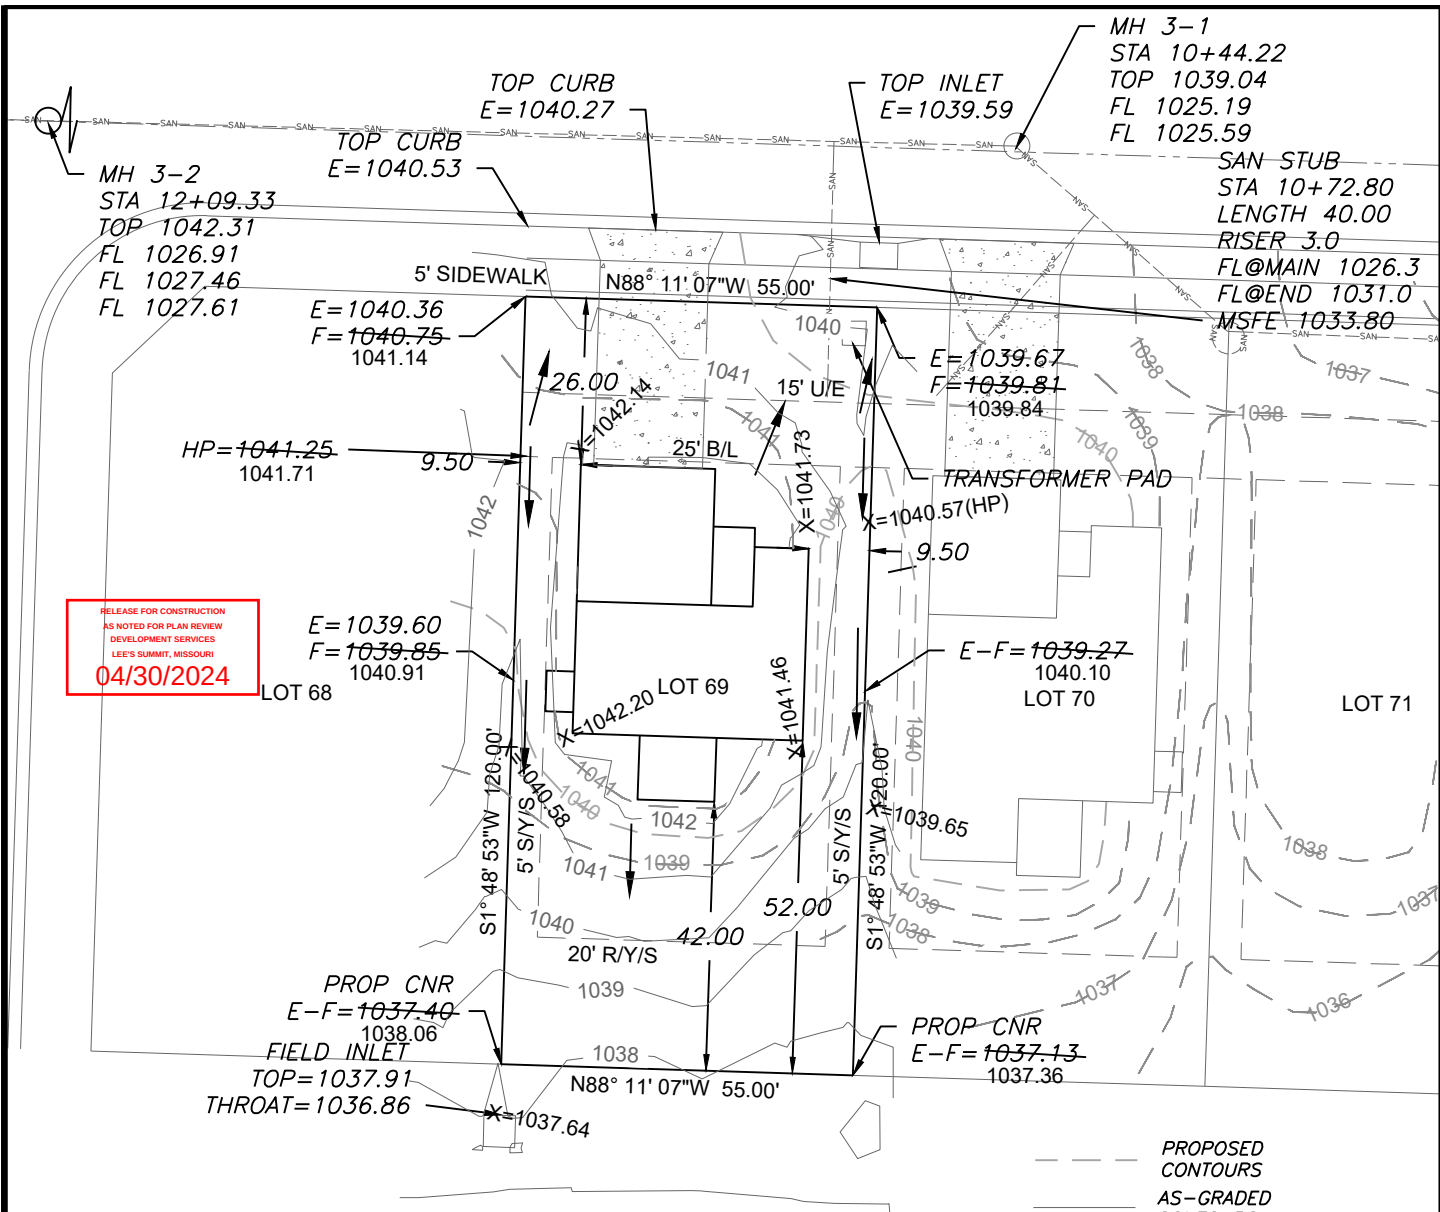

RELEASE FOR CONSTRUCTION
AS NOTED FOR PLAN REVIEW
DEVELOPMENT SERVICES
LEE'S SUMMIT, MISSOURI
04/30/2024

--- PROPOSED
CONTOURS
--- AS-GRADED
CONTOURS
X=###.## = Actual asbuilt ground shots
taken on March 25, 2024.
Contours shown are asbuilt.

LEGEND

- Gas Meter
- Telephone or Fiber-Optic Pedestal
- Cable TV Pedestal
- Electric Pedestal
- Light Pole
- Mailbox
- Fire Hydrant
- Water Valve

PROPOSED HOUSE


TOP FOUNDATION = 1042.75
GARAGE FLOOR = 1041.75
TOP FOOTING = 1034.75
BASEMENT FLOOR = 1035.08
DRIVE SLOPE = 4.8%

E = EXISTING ELEVATION
F = PROPOSED FINAL ELEVATION
G = ADJACENT GRADE AT EGRESS
U/E = UTILITY EASEMENT
B/L = BUILDING LINE
S/Y/S = SIDE YARD SETBACK
R/Y/S = REAR YARD SETBACK

NOTES

- BUILDER TO VERIFY ALL BUILDING ELEVATIONS AND DIMENSIONS.
- THIS PLOT PLAN DOES NOT CONSTITUTE A BOUNDARY SURVEY.
- THE EASEMENTS SHOWN ON THIS PLOT PLAN ARE TAKEN FROM THE FINAL PLAT. EASEMENTS MAY EXIST.

EXTENDED LOT AREA = 7205.0 SF
DRIVE AREA = 442.0 SF
APPROACH AREA = 197.0 SF
SIDEWALK AREA = 190.0 SF

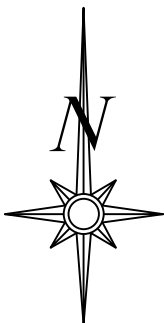


Scale 1"=30'

LOT INFORMATION

6,600 SQ. FT.
REAR LEFT MBOE = 1037.77
REAR RIGHT MBOE = 1038.02
MSFE = 1033.80
ADDRESS
2129 SW RUTHERFORD DR

LEGAL DESCRIPTION


LOT 69, OSAGE SECOND PLAT, A
SUBDIVISION AS RECORDED IN
LEE'S SUMMIT, JACKSON
COUNTY, MISSOURI.

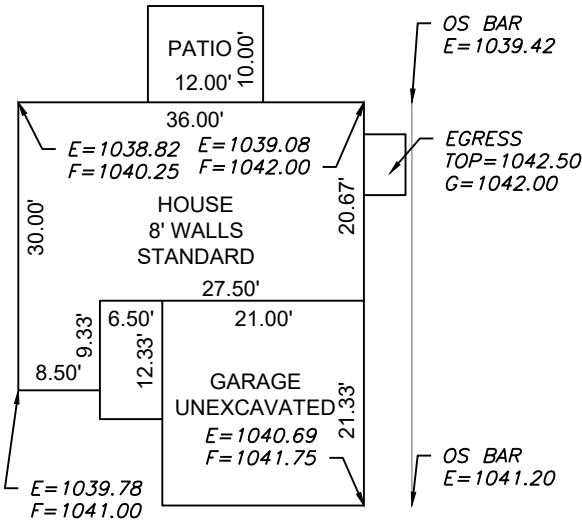

Scale 1"=20'
PLAN: MARMALADE

ENGINEERING
ENGINEERING & SURVEYING
SOLUTIONS

50 SE 30TH STREET
LEE'S SUMMIT, MO 64082
P: (816) 623-9888 F: (816) 623-9849
WWW.ENGINEERINGSOLUTIONSKC.COM

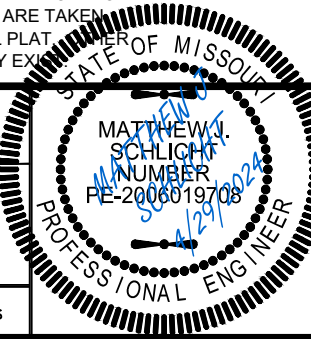

AS-GRADED PLOT PLAN - LOT 69

OSAGE SECOND PLAT
LEE'S SUMMIT, JACKSON COUNTY, MISSOURI

CLOVER & HIVE
120 SE 30TH STREET
LEE'S SUMMIT, MO 64082

PROJECT NO.	FILE NAME	DATE	SHEET	OF
1	LOT 69, 70, OSAGE	4/4/23	1	1

THIS DRAWING IS NOT VALID UNLESS THE SIGNATURE, DATE AND SEAL OF THE ENGINEER WHO SUPERVISED THE PREPARATION OF THIS DRAWING HAS BEEN AFFIXED HERETO.