


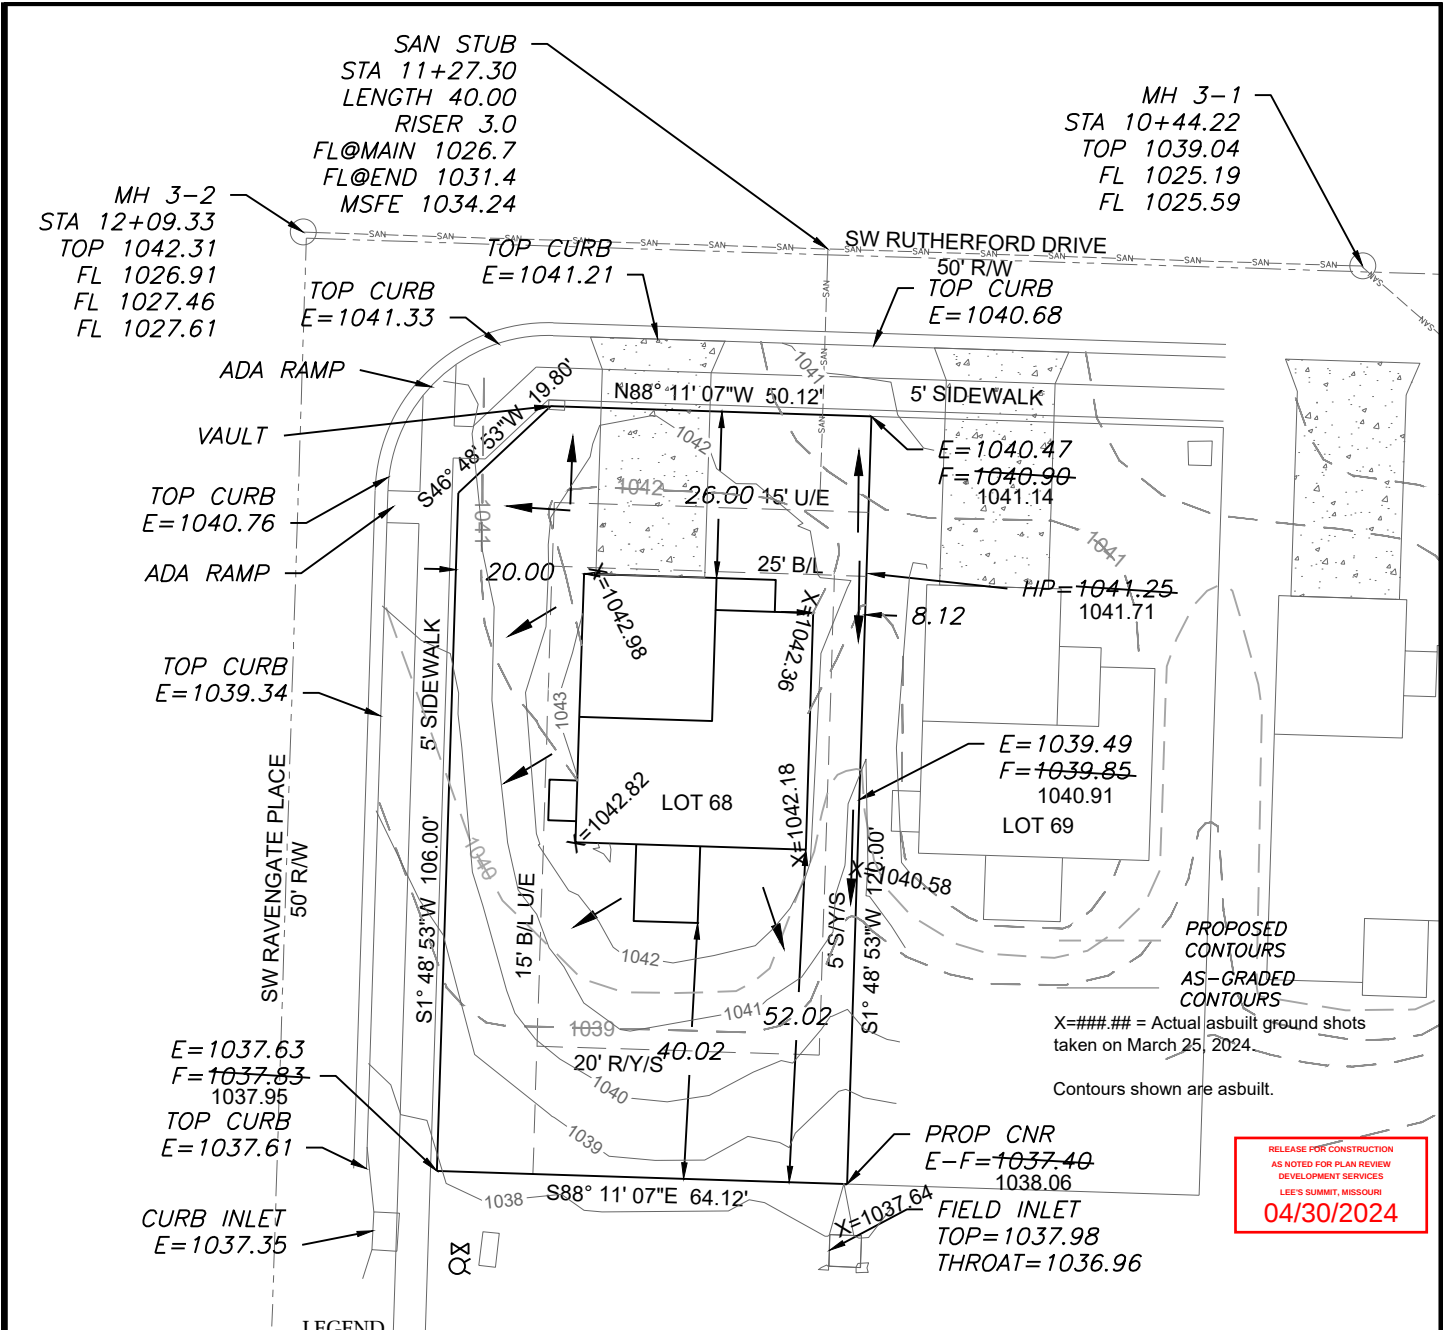

RELEASE FOR CONSTRUCTION
AS NOTED FOR PLAN REVIEW
DEVELOPMENT SERVICES
LEE'S SUMMIT, MISSOURI
04/30/2024

LEGEND

- Gas Meter
- Telephone or Fiber-Optic Pedestal
- Cable TV Pedestal
- Electric Pedestal
- Light Pole
- Mailbox
- Fire Hydrant
- Water Valve

PROPOSED HOUSE

TOP FOUNDATION = 1043.75
GARAGE FLOOR = 1042.75
TOP FOOTING = 1035.75
BASEMENT FLOOR = 1036.08
DRIVE SLOPE = 5.1%


E = EXISTING ELEVATION
F = PROPOSED FINAL ELEVATION
G = ADJACENT GRADE AT EGRESS
U/E = UTILITY EASEMENT
B/L = BUILDING LINE
S/Y/S = SIDE YARD SETBACK
R/Y/S = REAR YARD SETBACK

NOTES

- BUILDER TO VERIFY ALL BUILDING ELEVATIONS AND DIMENSIONS.
- THIS PLOT PLAN DOES NOT CONSTITUTE A BOUNDARY SURVEY.
- THE EASEMENTS SHOWN ON THIS PLOT PLAN ARE TAKEN FROM THE FINAL PLAT. EASEMENTS MAY EXIST.

EXTENDED LOT AREA = 9,706.8 SF
DRIVE AREA = 442.0 SF
APPROACH AREA = 197.0 SF
SIDEWALK AREA = 903.0 SF

AS-GRADED PLOT PLAN IS
REQUIRED PRIOR TO SODDING

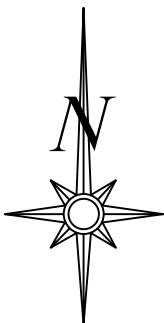

Scale 1"=30'

LOT INFORMATION

7,596 SQ. FT.
REAR LEFT MBOE = 1038.02
REAR RIGHT MBOE = 1038.19
MSFE = 1034.24
ADDRESS
2133 SW RUTHERFORD DRIVE

LEGAL DESCRIPTION

LOT 68, OSAGE SECOND PLAT, A
SUBDIVISION AS RECORDED IN
LEE'S SUMMIT, JACKSON
COUNTY, MISSOURI.

PLAN: BASSWOOD

Scale 1"=20'


AS-GRADED PLOT PLAN - LOT 68

OSAGE SECOND PLAT
LEE'S SUMMIT, JACKSON COUNTY, MISSOURI

CLOVER & HIVE
120 SE 30TH STREET
LEE'S SUMMIT, MO 64082

PROJECT NO.	FILE NAME	DATE	SHEET	OF
1	LOT 68, OSAGE	4/19/23	1	1

ENGINEERING SOLUTIONS
ENGINEERING & SURVEYING
50 SE 30TH STREET
LEE'S SUMMIT, MO 64082
P:(816) 623-9888 F:(816) 623-9849
WWW.ENGINEERINGSOLUTIONSKC.COM

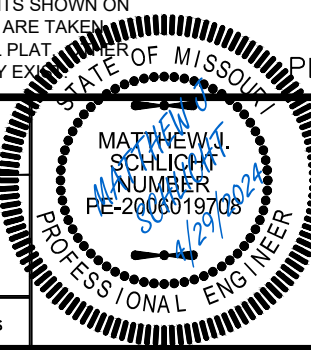

THIS DRAWING IS NOT VALID UNLESS THE SIGNATURE, DATE AND SEAL OF THE ENGINEER WHO SUPERVISED THE PREPARATION OF THIS DRAWING HAS BEEN AFFIXED HERETO.