



RELEASE FOR CONSTRUCTION  
 AS NOTED FOR PLAN REVIEW  
 DEVELOPMENT SERVICES  
 LEE'S SUMMIT, MISSOURI  
**05/02/2024**

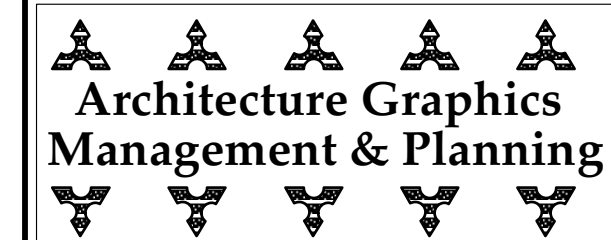

**Independence Office**  
 Roy Browne 816-228-1111  
 Internet - Roy@AGMPARCH.com  
**Lee's Summit Office**  
 Bruce Best 816-525-8918  
 Internet - Bruce@AGMPARCH.com

Roy Browne Architect of Record

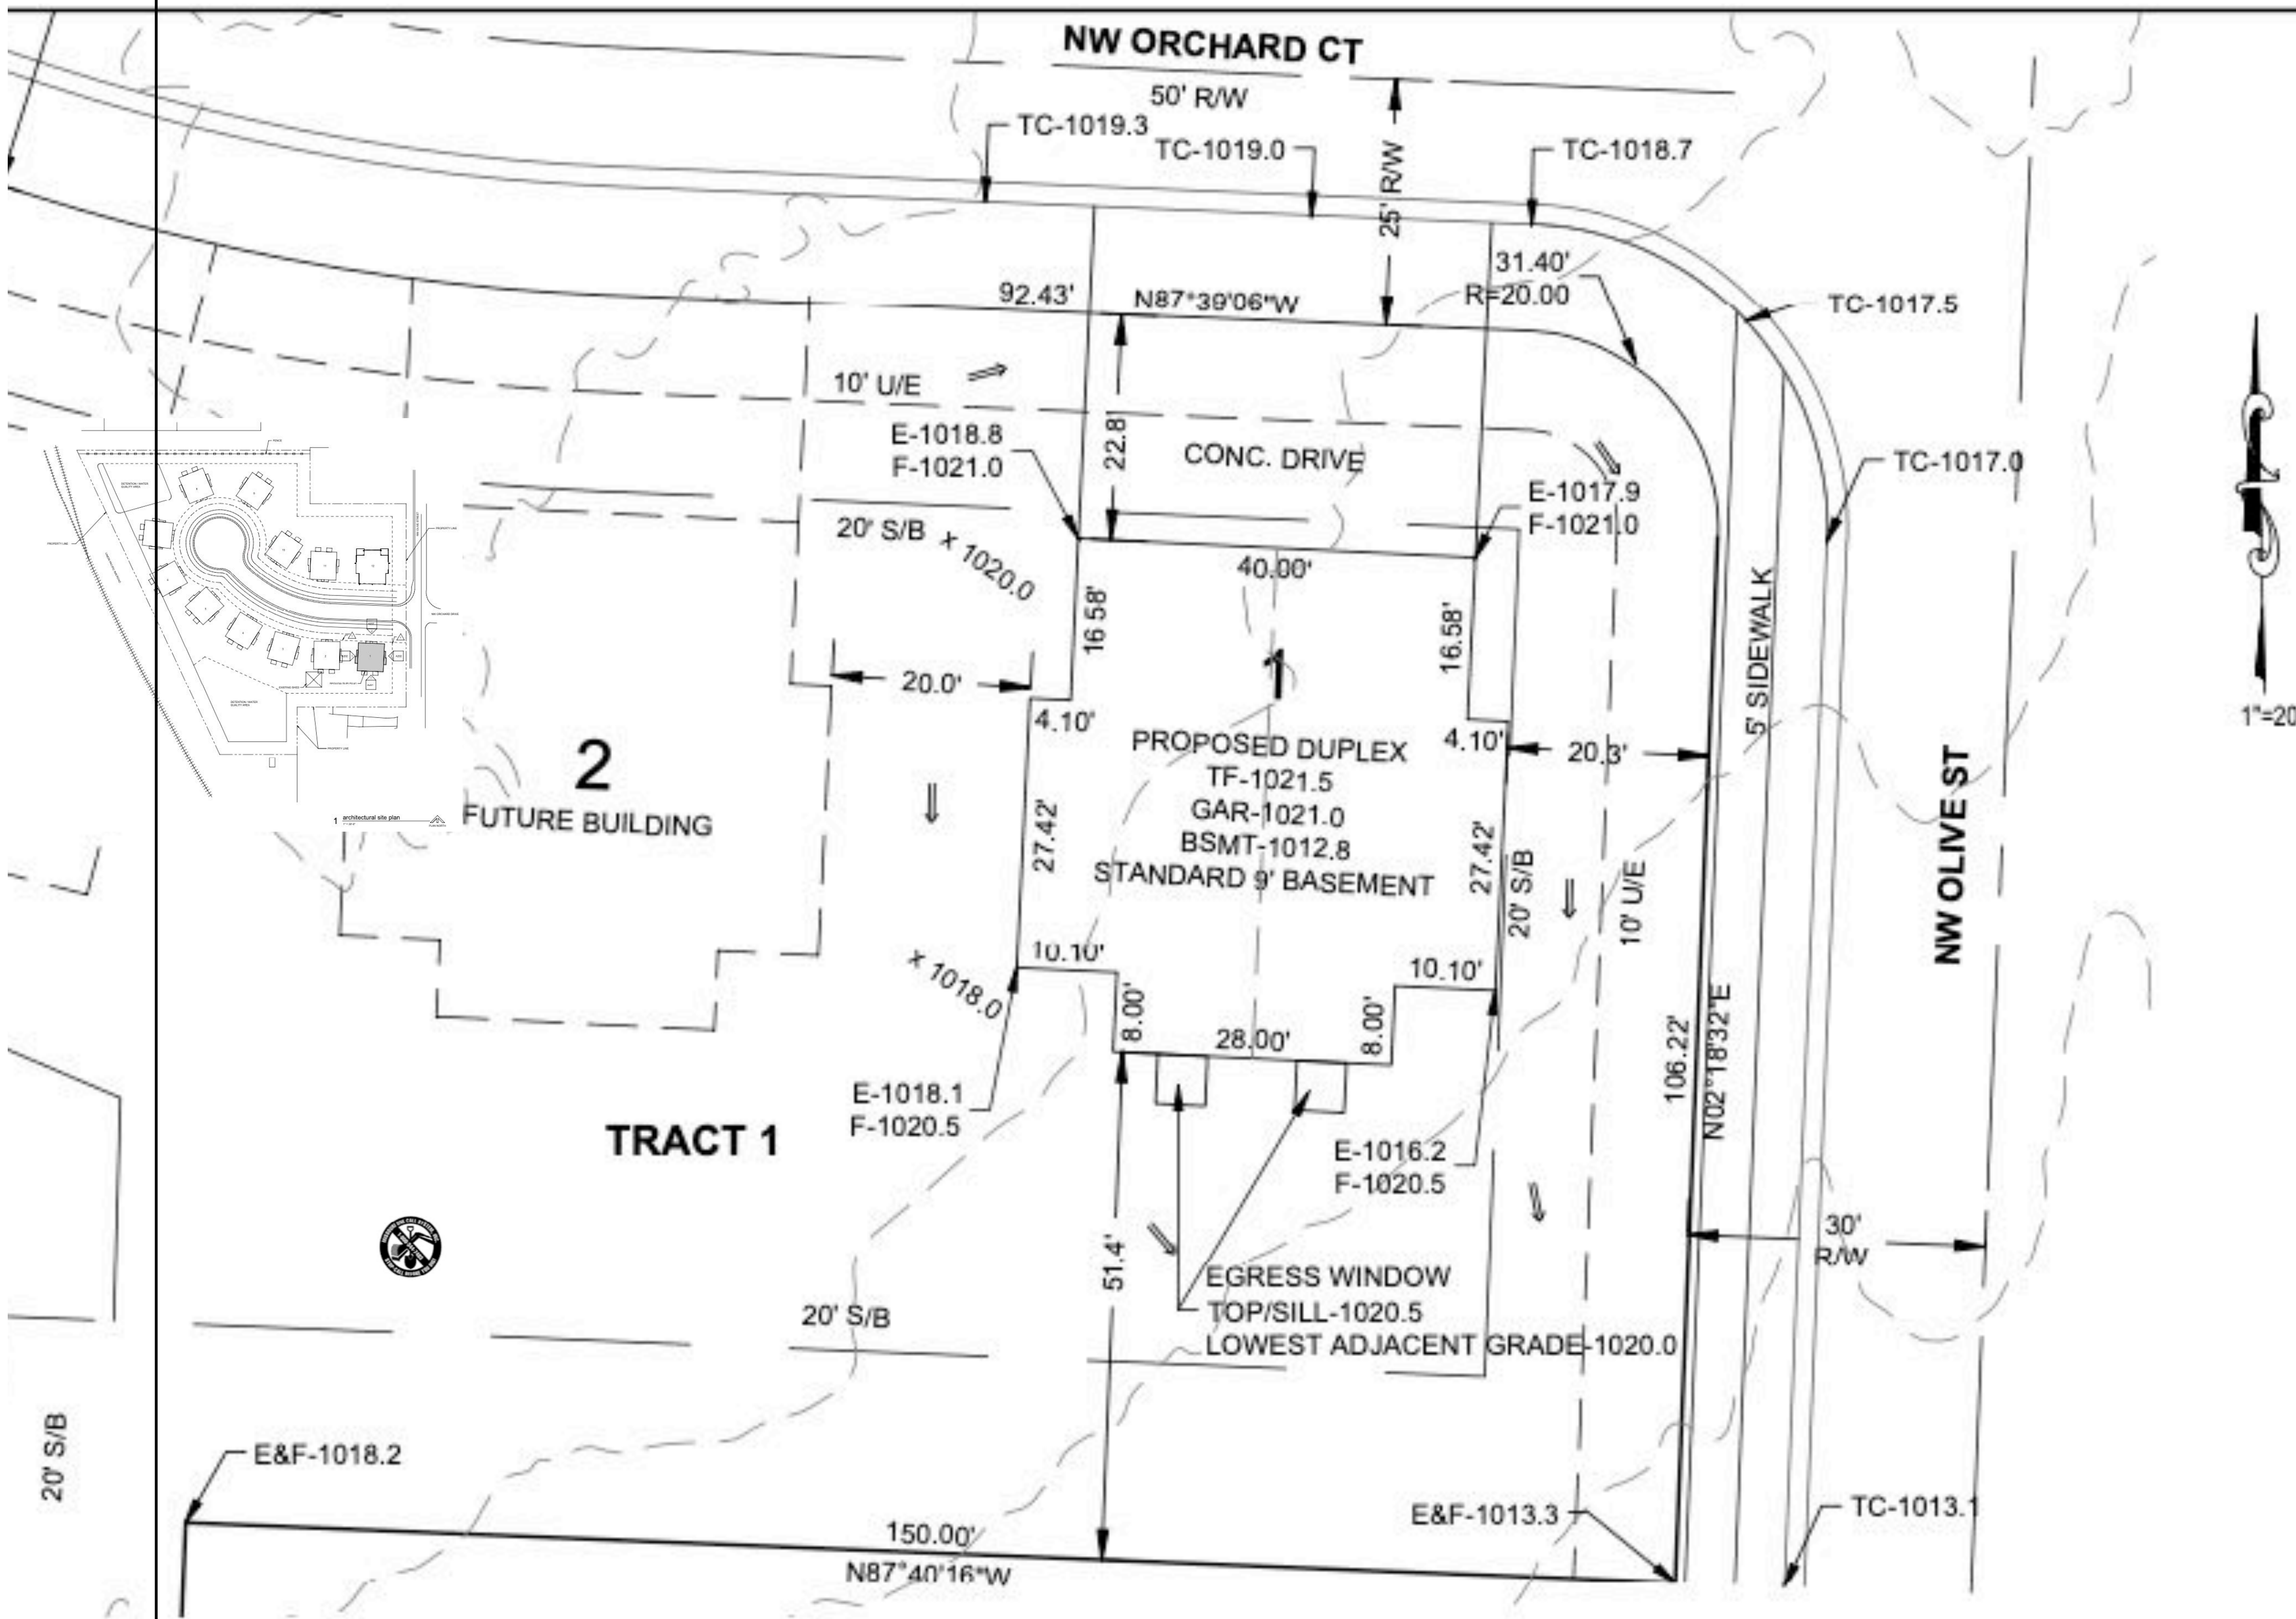

**NOTES:**

1. THE CONTRACTOR OR CONTRACTORS SHALL VERIFY THAT THE FOUNDATION DIMENSIONS SHOWN AND THE CONSTRUCTION STAKING ARE IN COMPLIANCE WITH THE OWNERS OR BUILDERS FOUNDATION PLAN. CUTS OR FILLS SHOWN ON CONSTRUCTION STAKING ARE FOR ASSISTANCE IN EXCAVATION ONLY. FINAL BASEMENT OR TOP OF FOUNDATION ELEVATIONS SHALL BE MADE BY THE OWNER OR CONTRACTOR.
2. IT IS THE RESPONSIBILITY OF THE CONTRACTOR TO VERIFY THE DEPTH OF THE SANITARY SEWER IN RELATION TO THE FOUNDATION PRIOR TO POURING THE FOUNDATION.
3. NO TITLE REPORT WAS PROVIDED BY THE CLIENT. BOUNDARY & CONSTRUCTION SURVEYING, INC. ASSUMES NO RESPONSIBILITY FOR BOUNDARY OR EASEMENTS NOT SHOWN. THE CLIENT HAS MADE AN AGREEMENT THAT THIS IS NOT A BOUNDARY SURVEY.
5. DECK NOTE: DECK APPROVAL REQUIRED PRIOR TO CONSTRUCTION.
6. AS-GRADED PLOT PLAN NEEDED (PER SECTION 7-160, CODE OF ORDINANCES)

**LEGEND**


- S/B - BUILDING SETBACK LINE
- U/E - UTILITY EASEMENT
- R/W - RIGHT-OF-WAY
- M - MEASURE
- R - RADIUS
- L - ARC LENGTH
- MBFE - MINIMUM BASEMENT FLOOR ELEVATION
- TF - TOP OF FOUNDATION
- BSMT - BASEMENT
- GAR - GARAGE
- TC - TOP OF CURB
- E - EXISTING ELEVATION
- F - FINISHED ELEVATION
- ⇒ - DRAINAGE ARROW



**SEQUOIA DUPLEX ALT # 1**  
**205 & 207 Orchard Court**  
**LEE'S SUMMIT, MO**



This Drawing And Information Contained Within Is Provided As An Instrument Of Service By The Architect, And Is Intended For Use On This Project Only. This Drawing Remains The Property Of The Architect And Shall Be Returned To Him Upon Completion Of The Construction Work. All Drawings, Specifications, Ideas, Designs And Arrangements Appearing Herein Constitute The Original And Unpublished Work Of The Architect. Any Reproduction, Use Or Disclosure Of The Proprietary Information Contained Herein Without The Prior Written Consent Of The Architect Is Strictly Prohibited.  
 © AGMP 2023

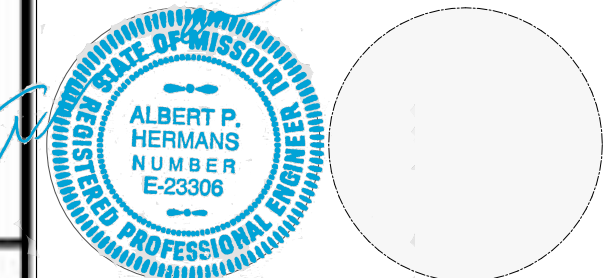

**PLOT PLAN**  
**BOUNDARY & CONSTRUCTION SURVEYING, INC.**  
 821 NE COLUMBUS STREET SUITE 100, LEE'S SUMMIT, MO. 64063  
 PH.# 816/554-9798, FAX # 816/554-0337

PROJECT NO. 23-183 SHEET 1 OF 1  
 200 NW ORCHARD CT, LEE'S SUMMIT, MISSOURI

DATE: 12.21.23 DEVELOPER  
 ORCHARD PARK DEVELOPMENT, LLC  
 8 SW AA HIGHWAY  
 KINGSVILLE, MO. 64061

Scale In Feet  
 1" = 20'

**DESCRIPTION:**  
 ALL OF BUILDING 1, A PART OF TRACT 1, SEQUOIA RESIDENTIAL, A SUBDIVISION IN LEE'S SUMMIT, JACKSON COUNTY, MISSOURI

SP-1

1	Date	APRIL	26, 2024
2	REVISION	April	30, 2024
3	REVISION		
4	REVISION		
5	REVISION		