


PROP CNR
E-F=1053.30

MH 3-3
STA 14+00.24
TOP 1048.97
FL 1034.42

SW RAVENGATE PLACE
50' RW

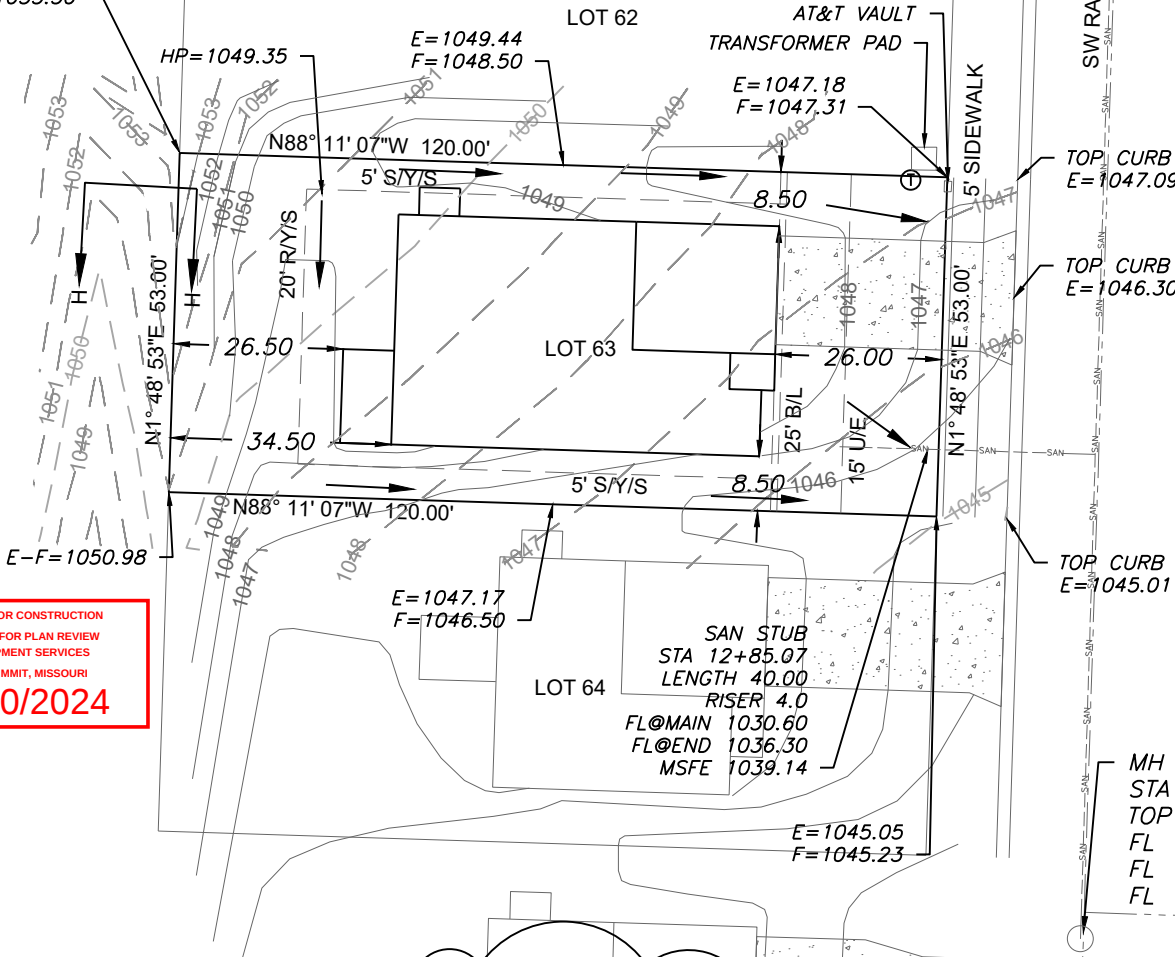

TOP CURB
E=1047.09

TOP CURB
E=1046.30

TOP CURB
E=1045.01

MH 3-2
STA 12+09.33
TOP 1042.31
FL 1026.91
FL 1027.46
FL 1027.61

RELEASE FOR CONSTRUCTION
AS NOTED FOR PLAN REVIEW
DEVELOPMENT SERVICES
LEE'S SUMMIT, MISSOURI

05/10/2024

EXTENDED LOT AREA = 6,943 SF
DRIVE AREA = 441.9 SF
APPROACH AREA = 197.0 SF
SIDEWALK AREA = 180.0 SF


AS-GRADED PLOT PLAN IS
REQUIRED PRIOR TO SODDING.

LEGEND

- Gas Meter
- Telephone or Fiber-Optic Pedestal
- Cable TV Pedestal
- Electric Pedestal
- Light Pole
- Mailbox
- Fire Hydrant
- Water Valve

SWALE H-H
MANNINGS COEFF 0.03
CHANNEL SLOPE 4.91%
SWALE DEPTH 1.5'
SIDE SLOPE 3:1
BOTTOM WIDTH 5.00'
TOP WIDTH 5.30'

PG VARIES*
6.50' L
PG VARIES*
2.50' L
PG VARIES*
2.50' R
PG VARIES*
6.50' R

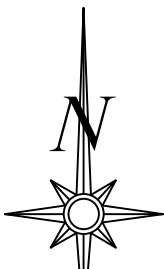

Scale 1"=30'

PROPOSED HOUSE

TOP FOUNDATION = 1050.60
GARAGE FLOOR = 1048.60
TOP FOOTING = 1042.60
BASEMENT FLOOR = 1042.93
DRIVE SLOPE = 8.0%

E = EXISTING ELEVATION
F = PROPOSED FINAL ELEVATION
G = ADJACENT GRADE AT EGRESS
U/E = UTILITY EASEMENT
B/L = BUILDING LINE
S/Y/S = SIDE YARD SETBACK
R/Y/S = REAR YARD SETBACK

NOTES

- BUILDER TO VERIFY ALL BUILDING ELEVATIONS AND DIMENSIONS.
- THIS PLOT PLAN DOES NOT CONSTITUTE A BOUNDARY SURVEY.
- THE EASEMENTS SHOWN ON THIS PLOT PLAN ARE TAKEN FROM THE FINAL PLAT. OTHER EASEMENTS MAY EXIST.

E=1048.60
F=1049.85
OS BAR
E=1048.36

UNCOVERED
PATIO
14.67' 8.00'

E=1050.32
F=1049.85

OS BAR
E=1050.52

HOUSE
8' WALLS
STANDARD

EGRESS
TOP=1050.35
G=1049.85

OS BAR
E=1047.72

LOT INFORMATION

6,360 SQ. FT.
MSFE = 1039.14
ADDRESS
3816 SW RAVENGATE PLACE

LEGAL DESCRIPTION


LOT 63, OSAGE SECOND PLAT, A
SUBDIVISION AS RECORDED IN
LEE'S SUMMIT, JACKSON
COUNTY, MISSOURI.

Scale 1"=20'
PLAN: WILDFLOWER

ENGINEERING
ENGINEERING & SURVEYING
SOLUTIONS

50 SE 30TH STREET
LEE'S SUMMIT, MO 64082
P:(816) 623-9888 F:(816) 623-9849
WWW.ENGINEERINGSOLUTIONKCC.COM

THIS DRAWING IS NOT VALID UNLESS THE SIGNATURE, DATE AND SEAL OF
THE ENGINEER WHO SUPERVISED THE PREPARATION OF THIS DRAWING HAS
BEEN AFFIXED HERETO.

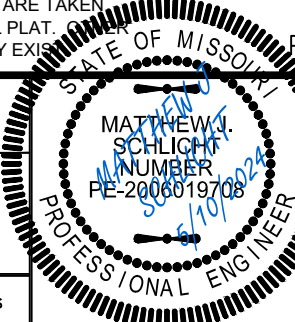

PLOT PLAN - LOT 63

OSAGE SECOND PLAT
LEE'S SUMMIT, JACKSON COUNTY, MISSOURI

SUMMIT HOMES
120 SE 30TH STREET
LEE'S SUMMIT, MO 64082

PROJECT NO.	FILE NAME	DATE	SHEET	OF
1	LOT 63, OSAGE	3/28/24	1	1