

- ☒ **Conforms to Design Concept**
- ☐ **Conforms to Design Concept with Revisions Noted**
- ☐ **Non-Conforming; Revise and Resubmit**



THIS SHOP DRAWING HAS BEEN REVIEWED FOR GENERAL CONFORMANCE WITH DESIGN CONCEPT ONLY AND DOES NOT RELIEVE THE FABRICATOR, VENDOR, OR ORIGINAL DESIGN ENGINEER OF RESPONSIBILITY FOR CONFORMANCE WITH DESIGN DRAWINGS, SPECIFICATIONS, AND APPLICABLE CODES, ALL OF WHICH HAVE PRIORITY OVER THIS SHOP DRAWING.

By: [Signature] Date: 7/11/24  
R.E.O. ENGINEERING, P.C.

Products				
PlotID	Net Qty	Product	Length	Plies
J1-16" O.C.	5	9-1/2" BCI@ 5000s-1.8	48' 0"	1
J2-16" O.C.	6	9-1/2" BCI@ 5000s-1.8	34' 0"	1
J3-16" O.C.	2	9-1/2" BCI@ 5000s-1.8	34' 0"	2
J4-16" O.C.	6	9-1/2" BCI@ 5000s-1.8	32' 0"	1
J5-16" O.C.	5	9-1/2" BCI@ 5000s-1.8	26' 0"	1
J6-16" O.C.	20	9-1/2" BCI@ 5000s-1.8	18' 0"	1
J7-16" O.C.	6	9-1/2" BCI@ 5000s-1.8	18' 0"	2
J8-16" O.C.	6	9-1/2" BCI@ 5000s-1.8	16' 0"	1
J9-16" O.C.	15	9-1/2" BCI@ 5000s-1.8	14' 0"	1
J10-16" O.C.	11	9-1/2" BCI@ 5000s-1.8	8' 0"	1
J11-16" O.C.	5	9-1/2" BCI@ 5000s-1.8	6' 0"	1
B1-2	4	1-3/4" x 9-1/2" VERSA-LAM@ 2.0 3100 SP	16' 0"	2
B2-2	2	1-3/4" x 9-1/2" VERSA-LAM@ LVL 2.1E 3100 SP	18' 0"	2
B3-2	2	1-3/4" x 9-1/2" VERSA-LAM@ LVL 2.1E 3100 SP	14' 0"	2
B4	2	1-3/4" x 9-1/2" VERSA-LAM@ LVL 2.1E 3100 SP	8' 0"	1
B5-2	2	1-3/4" x 9-1/2" VERSA-LAM@ LVL 2.1E 3100 SP	6' 0"	2
Ca1	21	1-1/8" x 9-1/2" BC RIM BOARD OSB	12' 0"	1
Bk1	70	9-1/2" BCI@ 5000s-1.8	2' 0"	1

Connector Summary				
PlotID	Qty	Manuf	Product	Flange
H1	12	Simpson	ITS2.06/9.5	None
H2	2		HU9	None

RELEASE FOR CONSTRUCTION  
AS NOTED FOR PLAN REVIEW  
DEVELOPMENT SERVICES  
LEE'S SUMMIT, MISSOURI  
07/11/2024

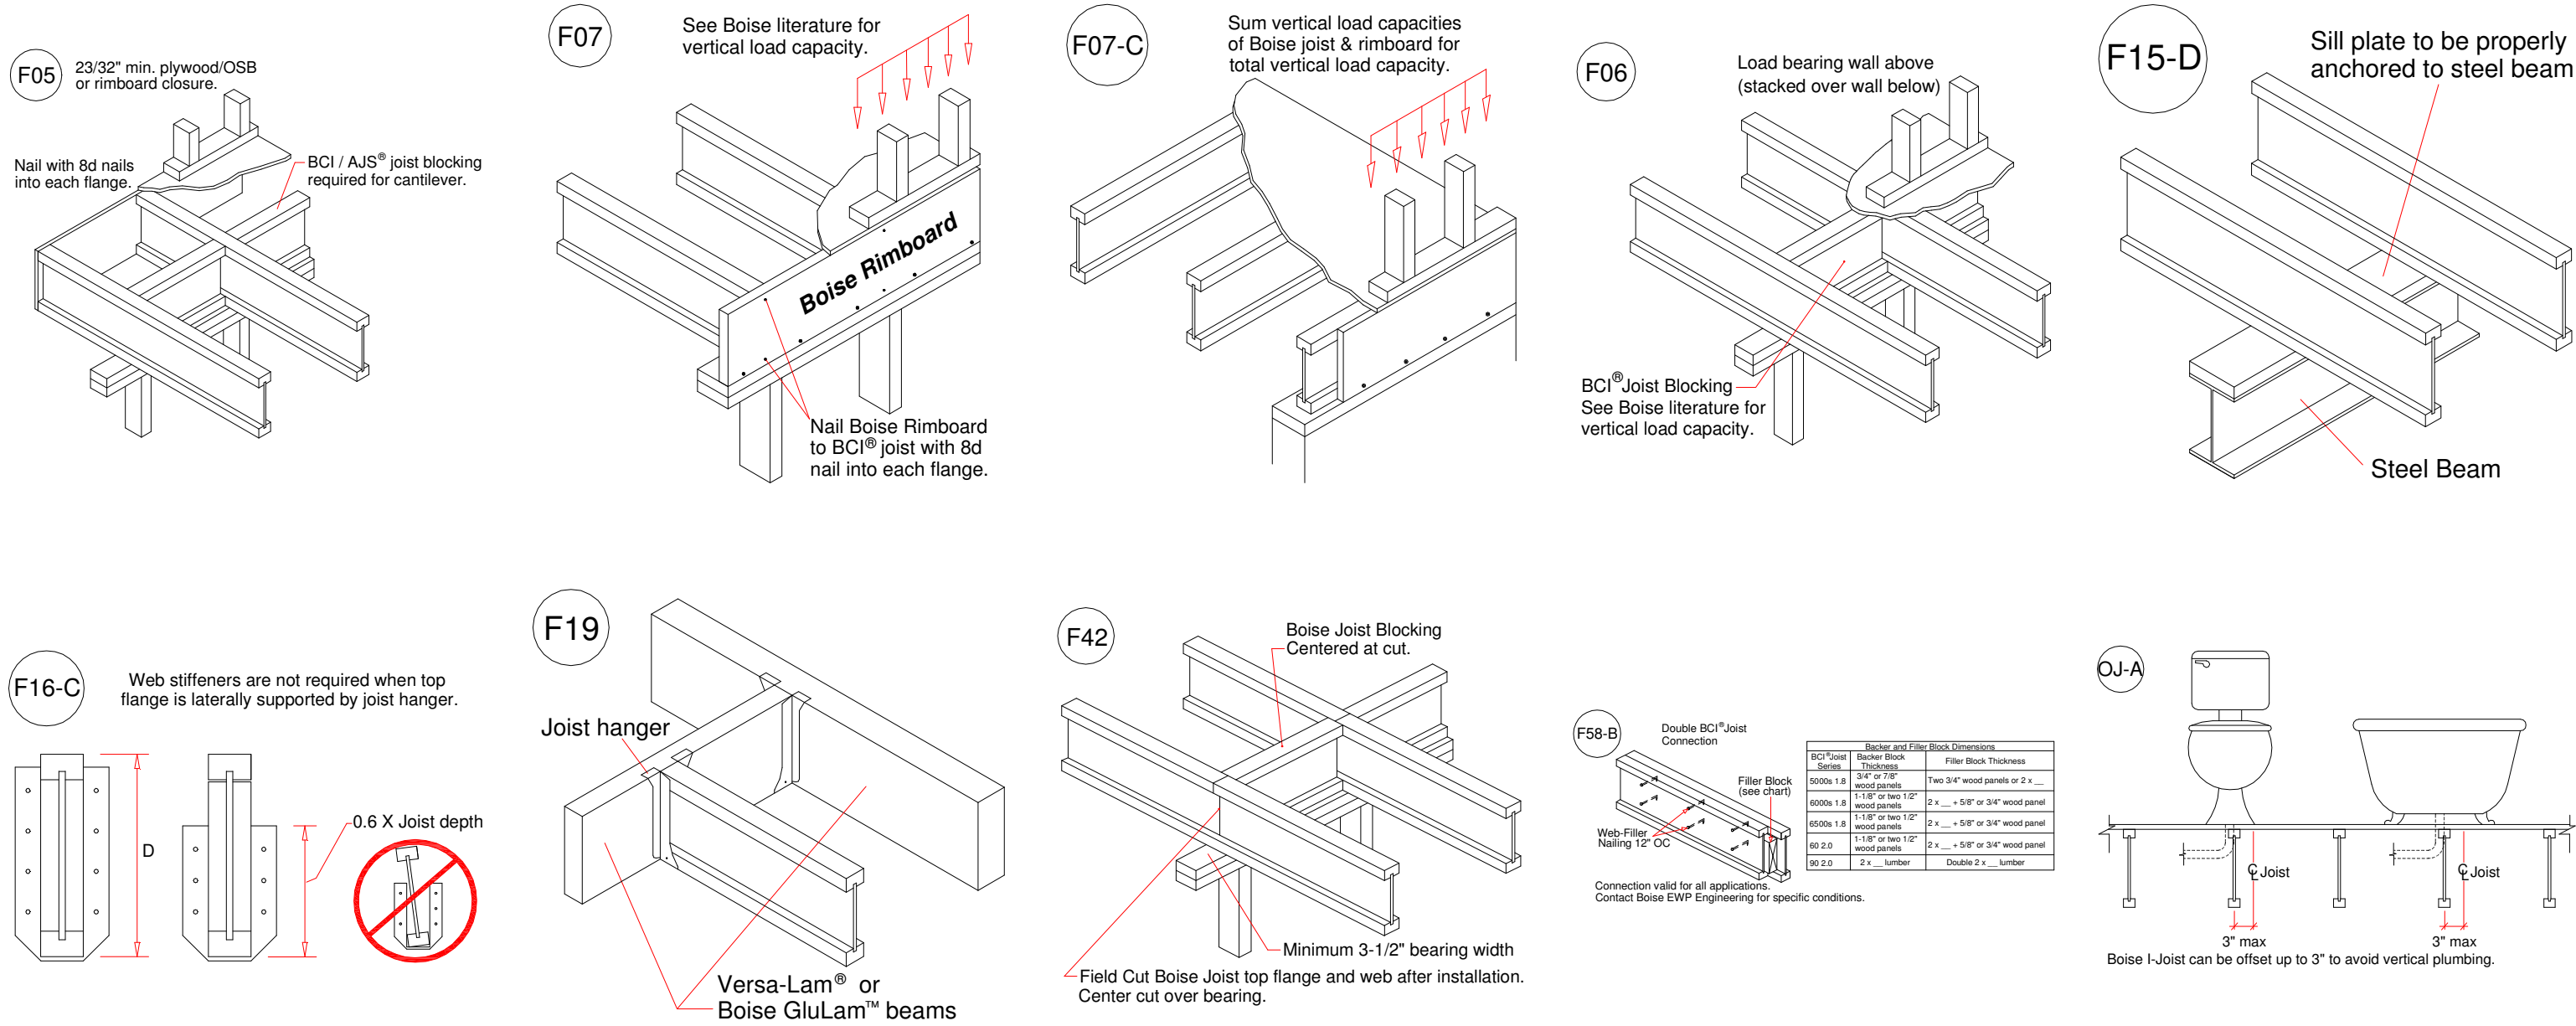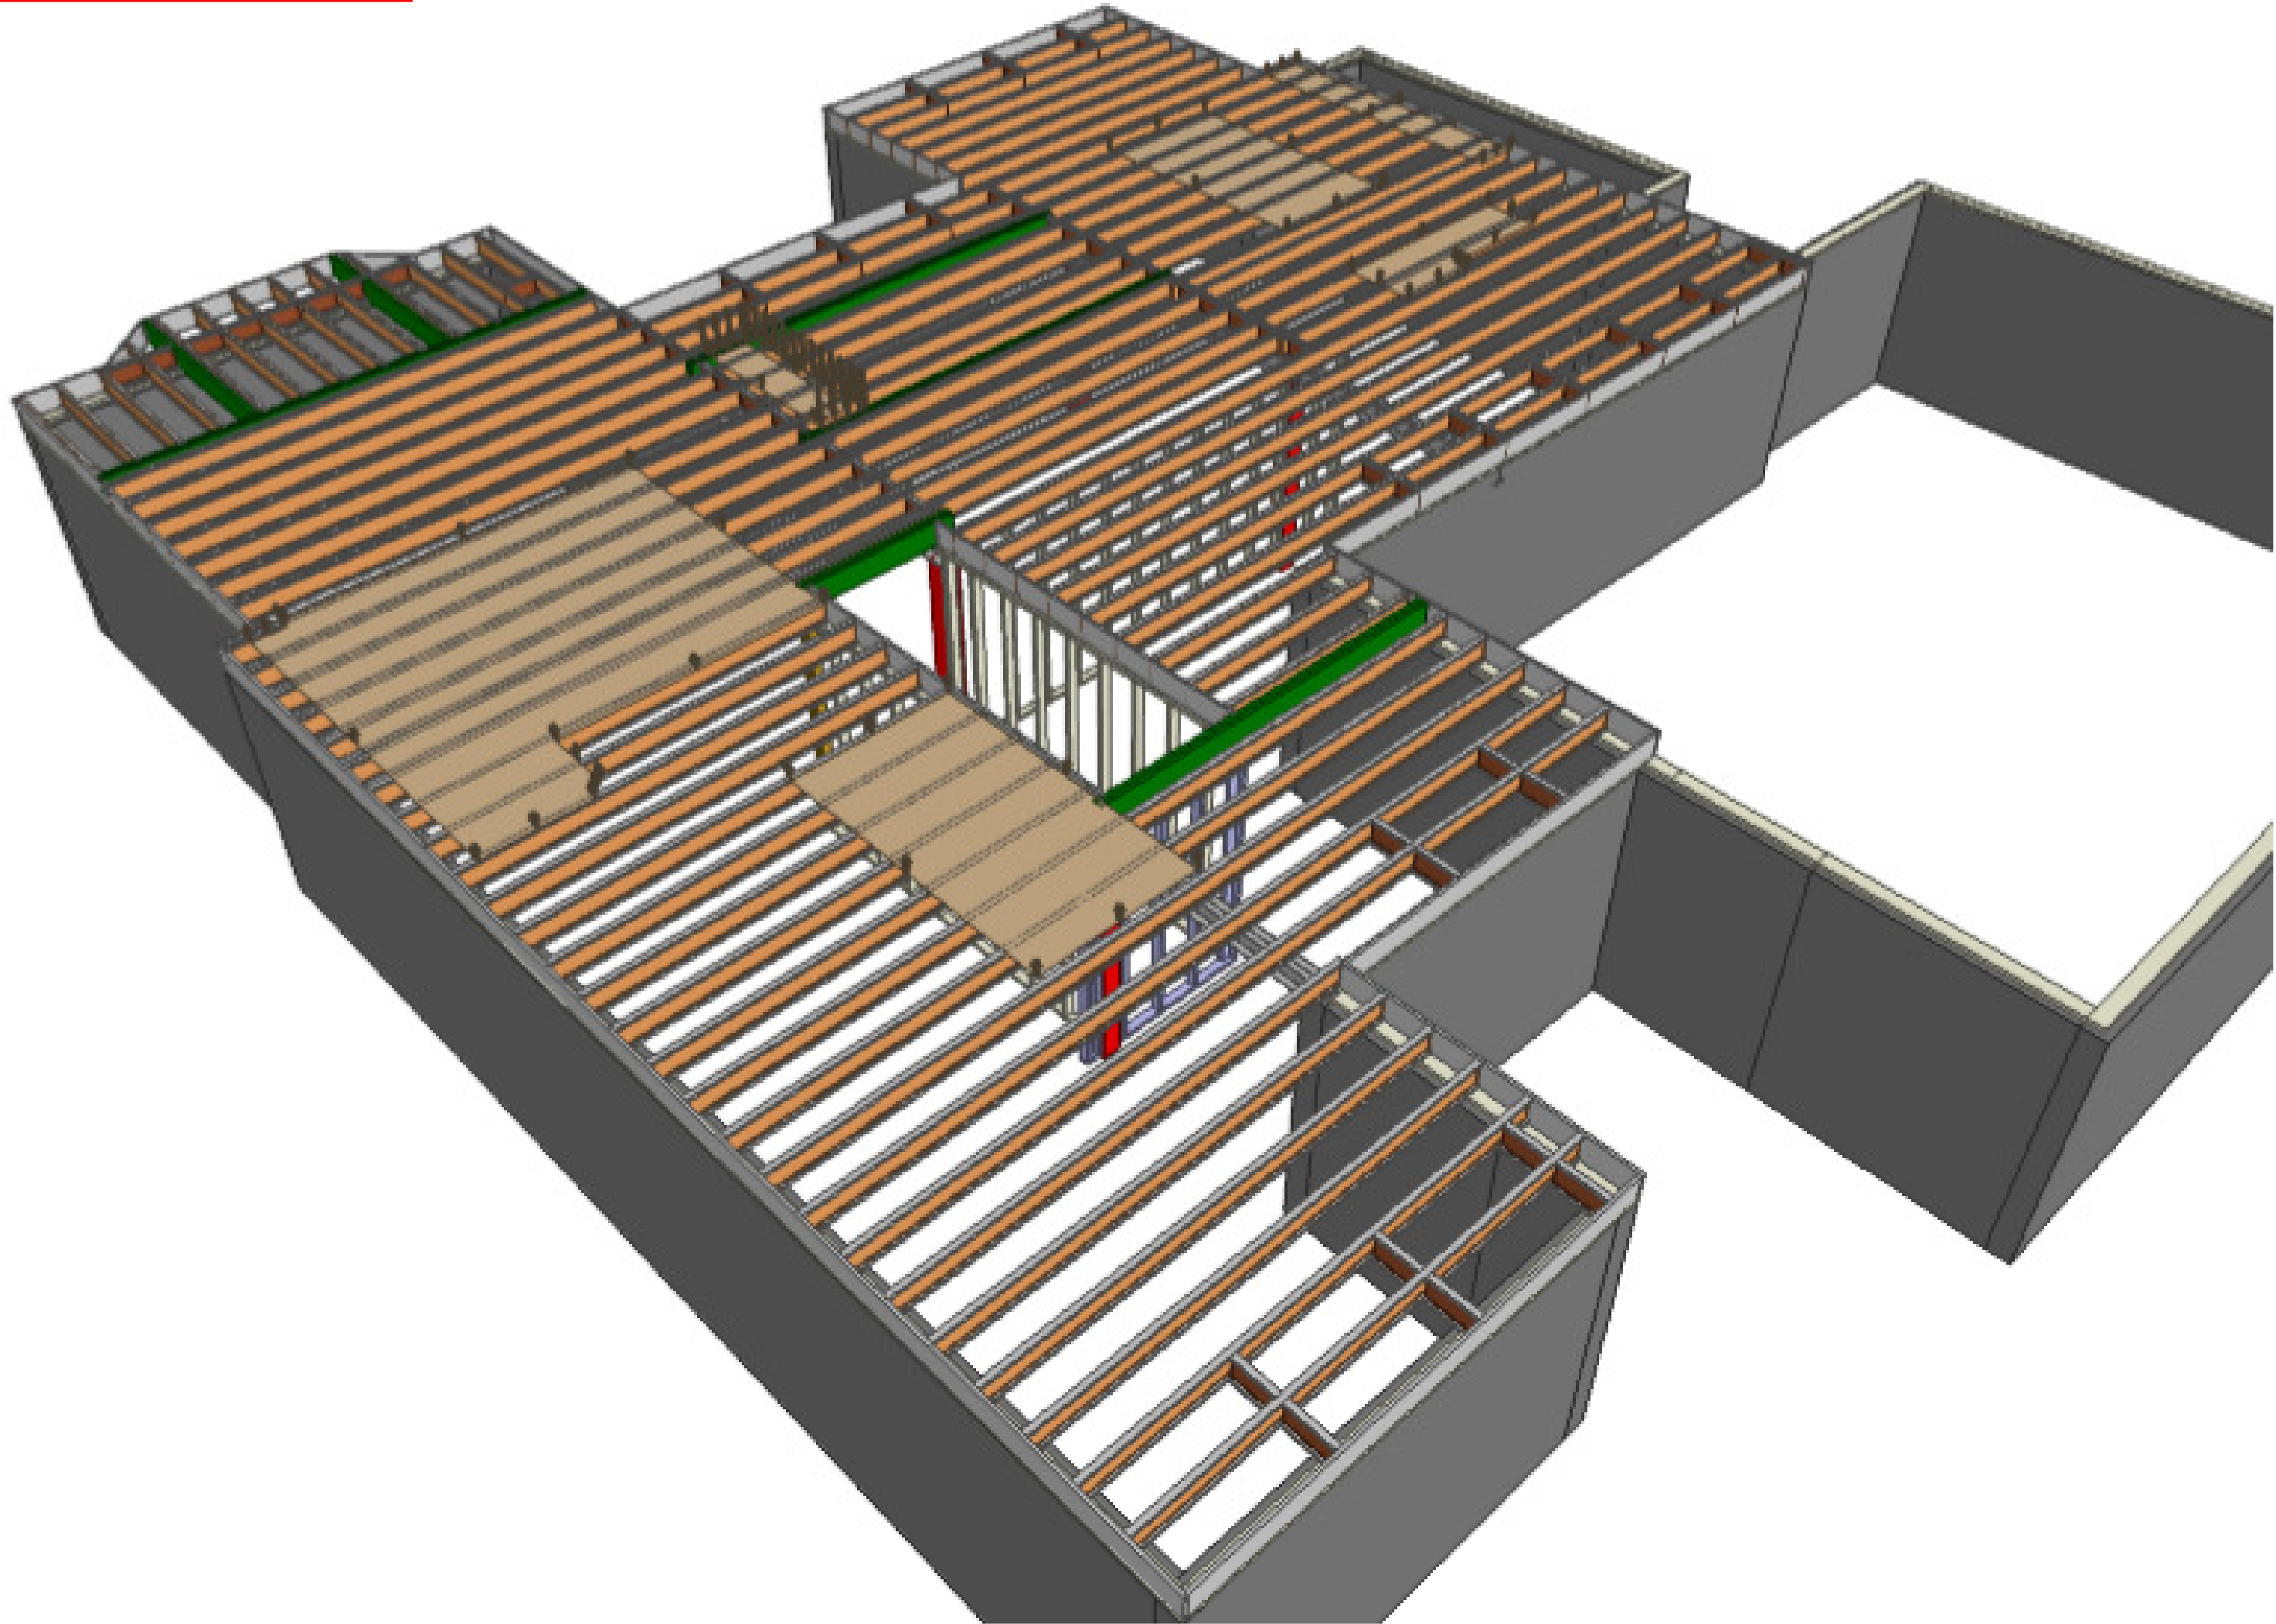

Revisions:

BY:

Boise Cascade

Teague Lumber Company Inc.

SALES PRESENTATION DRAWING  
No structural or dimensional check has been made of this design drawings of the building, therefore purchaser is to check and approve all dimensions, quantities, loads, and details carefully. This drawing has not been check by Boise Engineering.  
NOTE:  
ALL MEASUREMENTS TO BE VERIFIED IN THE FIELD.

Teague Lumber  
Lot 45 Whispering Woods  
Boise Cascade  
Lee's Summit, MO

BC FRAMER

Scale: 1/4"=1'-0"

Date: 3/11/2023

By: Dustin Pratt

File: Lot 45 Whispering Woods

DWG:

Sheet: 1/1