04 <u>NO</u>TES

ARCHITECTURAL GENERAL NOTES: 1. ALL WORK SHALL COMPLY WITH THE CITY AND STATE'S BUILDING HEALTH RULES AND REGULATION. LOCAL ORDINANCES AND SUCH STATUTORY PROVISIONS WILL BE CONSIDERED AS MUCH AS A PART OF THESE SPECIFICATIONS. 2. CG SHALL FIELD VERIFIED ALL EXISTING DIMENSIONS AND PARTITIONS LOCATION, AND INFORM ARCHITECT. 3. THE DRAWINGS ARE COMPLIMENTARY AND WHAT IS REQUIRED BY ONE SHALL BE AS BINDING AS IF REQUIRED BY ALL. SHOULD A CONFLICT OCCUR, THE OWNER'S REPRESENTATIVE WILL DETERMINE THE INTENT OF THE DRAWINGS TO PROVIDE A COMPLETED AND FUNCTIONAL FACILITY. PERFORMANCE BY THE CONTRACTOR SHALL BE REQUIRED ONLY TO THE EXTENT CONSISTENT WITH THESE DRAWINGS AND REASONABLY INFERABLE FROM THEM AS BEING NECESSARY TO PRODUCE THE INTENDED "FINISHED" RESULTS. 4. BEFORE ORDERING ANY MATERIALS OR DOING ANY WORK EACH CONTRACTOR AND SUBCONTRACTOR SHALL VERIFY ALL MEASUREMENTS AT THE SITE AND IN THE BUILDING AND SHALL BE RESPONSIBLE FOR THE ACTUAL DIMENSIONS AND THE DIMENSIONS INDICATED ON THE DRAWINGS. ALL WORK SHALL BE LAID OUT SUFFICIENTLY IN ADVANCE OF WORKMEN TO GIVE OPPORTUNITY FOR THE ARCHITECT TO ADJUST DISCREPANCIES OR RENDER DECISIONS WITHOUT CAUSING DELAY TO THE PROJECT BUT WORK SHOULD BE STOPPED WHEN NECESSARY AND IN NO CASE ALLOWED TO PROCEED IN UNCERTAINTY.

5. THESE DRAWINGS ARE FOR THIS SPECIFIC PROJECT AND NO OTHER USE IS AUTHORIZED.

6. ALL MATERIALS ARE NOT NOTED BY WORDS. IT IS INTENDED THAT THEY ARE UNDERSTOOD BY THE MATERIAL SYMBOL DRAWN.

7. WHERE A CONDITION IS NOTED "TYPICAL", IT IS UNDERSTOOD THAT ALL SIMILAR CONDITIONS ARE TO BE CONSTRUCTED OF THE SAME MATERIALS, FINISH AND/OR DIMENSIONS.

8. ALL DIMENSIONS ARE TO THE FACE OF STUDS, THE FACE OF FINISHED WALL, OR CENTERLINE OF STRUCTURAL COLUMN AND THE AFOREMENTIONED MATERIALS. CEILING ELEVATIONS, BEAM ELEVATION, SOFFIT ELEVATIONS ARE CLEAR "FINISHED" DIMENSIONS.

9. FURNISH AND INSTALL SOLID WOOD BLOCKING IN ALL INTERIOR STUD PARTITIONS WHERE STRUCTURAL SUPPORTS ARE REQUIRED FOR VANITIES, SHELVES, GRAB BARS, BENCHES. ETC.

10. WHERE DISSIMILAR MATERIALS MEET USE CAULKED JOINTS. USE METAL EDGES CORNERS AND STOPS AS REQUIRED ON ALL GYPSUM BOARD UNITS FOR FIRST CLASS FINISHED APPEARANCE.

11. ALL GYPSUM BOARD SHALL BE 5/8" "X" TYPE THROUGHOUT EXCEPT WHERE NOTED, AND SHALL INSTALL ACCORDING TO THE SPECIFICATION OF GYPSUM ASSOCIATION. 12. NO PLUMBING SUPPLIES, WASTES, ETC. TO BE LOCATED IN EXTERIOR WALLS EXCEPT FROST PROOF HOSE BIBS. ALL EXPOSED PIPES, DUCTS, CONDUIT SHALL BE ENCLOSED WITH GYPSUM BOARD ON FURRING INCLUDING THOSE NOT SHOWN ON THE DRAWINGS.

13. SLOPE 1" IN 4' RADIUS AROUND ALL FLOOR DRAINS. 14. ALL PLUMBING CHASES TO HAVE FULL BATT INSULATION. 15. EVERY CONTRACTOR SUBCONTRACTOR AND SUPPLIER SHALL PROVIDE A NOTARIZED STATEMENT OF ASSURANCE THAT NO PRODUCTS OR MATERIALS CONTAINING ASBESTOS WERE SUPPLIED OR INSTALLED ON THIS PROJECT. 16. COMBUSTIBLE MATERIALS OF ANY NATURE ARE NOT

PERMITTED ABOVE THE CEILING 17. ALL CONTRACTORS MUST BE LICENSED TO WORK IN THE CITY

18. ANY AND ALL MATERIALS AND SUBSTANCE UTILIZED WITHIN THE PREMISES MUST BE ENVIRONMENTALLY SAFE AND NON-HAZARDOUS

19. INSTALL A SIGN THAT STATE THE OCCUPANT LOAD. 20. ALL BARRIER FREE FIXTURES AND ACCESSORIES ARE TO CONFORM TO THE AMERICANS WITH DISABILITIES ACT, THE STATE BARRIER FREE CODE AND ANY LOCAL ORDINANCES 21. INSTALL HANDICAP SIGN ON RESTROOM DOOR AND PARKING LOT SPACE. ALL SIGNS SHALL BE ADA APPROVED.

FOOD PROTECTION NOTES:

GC SHALL FIELD VERIFY EXISTING CONDITION OF THE FOLLOWINGS. REPAIR / REPLACE OR PROVIDE AS REQUIRED:

1. UTENSIL WASHING SINK (3-COMPARTMENT SINK) MUST BE NSF APPROVED ALL METAL AND FREESTANDING. BOWL SIZE 21"X21"X21"

2. PROVIDE METAL BACKSPLASH @ 8" MIN, EXTENDING UP THE WALL SHALL BE FORMED AS AN INTEGRAL PART OF THE UNIT AND SEALED TO THE WALL. THE SINK COMPARTMENTS AND DRAIN BOARDS SHALL BE LARGE ENOUGH TO ACCOMMODATE THE LARGEST UTENSIL USED. 3. THIS FACILITY DOES NOT SERVE BEER AND/OR ALCOHOL DRINKS.

4. HOT WATER HEATER: A.O.SMITH, #BTH-150, GAS FIRED CONDENSING TYPE, 50 GAL. STORAGE, 150 MBTUH INPUT, 190 GPH RECOVERY @ 90 DEGREE F RISE, OR SIM. 6. HAND WASHING FACILITIES PER PLAN SHALL BE EQUIPPED WITH AN ADEQUATE SUPPLY OF HOT AND COLD RUNNING WATER DELIVERED UNDER PRESSURE THROUGH A MIXING VALVE. TEMPERED WATER MUST SUPPLY TO ALL THE HAND-WASHING SINKS. FAUCETS SHOULD BE W/WRIST BLADES. PROVIDE HAND WASHING CLEANSER AND SINGLE-USE SANITARY TOWELS SHALL BE PROVIDED IN WALL MOUNTED DISPENSERS.

7. MOP SINK SHALL BE SEPARATED FROM ANY FOOD PREPARATION OR STORAGE AREA AND SHALL BE A SLAB, BASIN CURBED AND SLOPED TO A DRAIN FINALIZED WITH OWNER, AND CONNECTED TO APPROVED SEWERAGE AND PROVIDED WITH HOT AND COLD RUNNING WATER, THROUGH A MIXING VALVE, AND PROTECTED WITH A BACKFLOW DEVICE.

8. ALL EQUIPMENT SHALL MEET NSF STANDARS AND INSTALLED IN ACCORDANCE WITH SUCH REQUIREMENTS. 9. ALL REFRIGERATION UNITS SHALL BE MAINTAINING FOODS AT OR BELOW 41 DEGREE F AT ALL TIME. 10.APPLIANCES AND EQUIPMENT WHICH ARE EQUIPPED WITH PUMPS, DRIPS OR DRAINAGE OUTLETS SHALL BE DRAINED BY INDIRECT WASTE PIPES DISCHARGING INTO AN APPROVED FLOOR DRAIN AS REQUIRED BY CODE. 11.FOOD SHELVING SHALL BE EASILY CLEANABLE AND DURABLE. THE LOWEST SHELF OF ANY SHELVING UNIT SHALL BE AT LEAST SIX INCHES ABOVE THE FLOOR. 12. VENTILATION SHALL BE PROVIDED TO REMOVE TOXIC GASES, HEAT, GREASE, VAPORS AND SMOKE FROM THE FOOD ESTABLISHMENT. ALL AREAS SHALL HAVE SUFFICIENT VENTILATION TO FACILITATE PROPER FOOD STORAGE AND TO PROVIDE A REASONABLE ENVIRONMENT OF COMFORT. TOILET ROOM SHALL BE VENTED TO THE OUTSIDE AIR BY MEANS OF A LIGHT-SWITCH ACTIVATED EXHAUST FAN, CONSISTENT WITH THE REQUIREMENTS OF LOCAL BUILDING CODES.

13.LIGHTING: 50 FOOT-CANDLES MIN. @ 30" AFF SHALL BE PROVIDED IN ALL AREAS WHERE FOOD IS PREPARED, PROCESSED OR PACKAGED OR IN AREAS WHERE UTENSILS ARE CLEANED OR STORED. LIGHT FIXTURES SHALL BE PROTECTED WITH SHATTERPROOF SHIELDS AND SHALL BE EASILY CLEANABLE.

14.DELIVERY AND ENTRANCE DOORS SHALL BE SELF-CLOSING.

15.PROVIDE SUFFICIENT HOT WATER SUPPLY TO SATISFY THE CONTINUOUS AND PEAK HOT WATER DEMANDS OF THE ESTABLISHMENTS. HAND WASHING SHALL BE AT 110 DEGREES. ALL TEMPERED WATER SHALL BE SUPPLIED THROUGH A WATER TEMPERATURE LIMITING DEVICE THAT CONFORMS TO ASSE 1070 AND SHALL LIMIT THE TEMPERED WATER TO A MAX OF 110 DEGREES.

NEW AUTOMATIC FIRE-EXTINGUISHING SYSTEM:

A NEW SYSTEM SHALL BE PROVIDED FOR THE KITCHEN EXHAUST HOOD AND DUCT SYSTEM AS REQUIRED BY THE IFC OR THE IMC. THE AUTOMATIC FIRE EXTINGUISHING SYSTEMS SHALL BE AUTOMATICALLY ACTUATED AND INTERLOCKS WITH FUEL SHUTOFFS. VENTILATION CONTROLS, SMOKE AND HEAT VENTS AND OTHER FEATURES NECESSARY FOR PROPER OPERATION OF THE FIRE-EXTINGUISHING SYSTEM.

MANUAL PULL-STATION SHALL BE NOT LESS THAN FORTY-TWO (42) INCHES ABOVE FLOOR AND NOT MORE THAN FORTY-EIGHT (48) INCHES ABOVE FINISHED FLOOR. B. NOT LESS THAN TEN (10) FEET FROM NOR MORE THAN TWENTY (20) FEET FROM THE EXHAUST SYSTEM; AND MUST BE IN OR NEAR THE PATH OF EGRESS. THE OPERATION OF THE EXTINGUISHING SYSTEM SHALL AUTOMATICALLY SHUT DOWN THE FUEL OR ELECTRICAL SUPPLY TO THE COOKING EQUIPMENT UNDER THE HOOD.

AN AUDIBLE ALARM SHALL BE MOUNTED ON THE FRONT FACE OF THE HOOD, INTERLOCKED WITH THE FIRE SYSTEM. MAKE UP AIR UNITS SHALL BE ELECTRICALLY INTERLOCKED WITH THE AUTOMATIC FIRE SUPPRESSION SYSTEM AND SHALL SHUT DOWN UPON ACTIVATION. THE EXHAUST FANS SHALL REMAIN IN OPERATION DURING FIRE CONDITIONS. EXHAUST FANS SHALL BE TESTED FOR USE WITH GREASE LADEN VAPORS AND COMPLY WITH UL762-1991.

FIRE SUPPRESSION SYSTEM OVER DEEP FRYERS SHALL MEET UL300 COMPLIANCE.

ALL ELECTRIC OUTLETS AND CONNECTIONS UNDER THE HOOD, SHALL BE TURNED OFF UPON ACTIVATION OF THE FIRE SYSTEM.

FIRE SUPPRESSION SYSTEM IS NOT PART OF THIS PERMIT. CONTRACTOR SUBMIT SHOP DRAWINGS FOR CITY/COUNTY APPROVAL PRIOR TO INSTALLATION-DEFERRED

FIRE PROTECTION NOTES: 1.POSTING OF OCCUPANT LOAD. EVERY ROOM OR SPACE THAT IS AN ASSEMBLY OCCUPANCY SHALL HAVE THE OCCUPANT LOAD OF THE ROOM OR SPACE POSTED IN A CONSPICUOUS PLACE, NEAR THE MAIN EXIT OR EXIT ACCESS DOORWAY FROM THE ROOM OR SPACE. POSTED SIGNS SHALL BE OF AN APPROVED LEGIBLE PERMANENT DESIGN AND SHALL BE MAINTAINED BY THE OWNER OR AUTHORIZED AGENT. 2. MAINTENANCE OF FIRE-RESISTIVE ASSEMBLY FOR THE EXISTING DEMISING WALL: GC SHALL FIELD VERIFY AND MAINTAIN THE REQUIRED ONE HOUR FIRE-RESISTANT RATING OF FIRE-RESISTANCE-RATED CONSTRUCTION. SUCH ELEMENTS SHALL BE PROPERLY REPAIRED, RESTORED OR REPLACED WHEN DAMAGED, ALTERED, BREACHED OR PENETRATED. OPENINGS MADE THEREIN FOR THE PASSAGE OF PIPES, ELECTRICAL CONDUIT, WIRES DUCTS, AIR TRANSFER OPENINGS AND HOLES MADE FOR ANY REASON SHALL BE PROTECTED WITH APPROVED METHODS CAPABLE OF RESISTING THE PASSAGE OF SMOKE AND FIRE. OPENINGS THROUGH FIRE-RESISTANCE-RATED ASSEMBLIES SHALL BE PROTECTED BY SELF- OR AUTOMATIC- CLOSING DOORS OF APPROVED CONSTRUCTION MEETING THE FIRE PROTECTION REQUIREMENTS FOR THE ASSEMBLY 3. INSTALLATION ACCEPTANCE TESTING: FIRE DETECTION AND ALARM SYSTEMS, FIRE EXTINGUISHING SYSTEM. FIRE HYDRANT SYSTEMS. AND ALL OTHER FIRE PROTECTION SYSTEMS AND APPURTENANCES THERETO SHALL BE SUBJECT TO ACCEPTANCE TESTS AS CONTAINED IN THE INSTALLATION STANDARD AND AS APPROVED BY THE FIRE CODE OFFICIAL. THE FIRE CODE OFFICIAL SHALL BE NOTIFIED BEFORE ANY REQUIRED ACCEPTANCE TESTING. 4. PORTABLE FIRE EXTINGUISHERS FOR COMMERCIAL COOKING EQUIPMENT. PORTABLE FIRE EXTINGUISHER SHALL BE PROVIDED WITH A 30 FOOT TRAVEL DISTANCE OF COMMERCIAL TYPE COOKING EQUIPMENT. COOKING EQUIPMENT INVOLVING VEGETABLE OR ANIMAL OILS AND FATS SHALL BE PROTECTED BY A CLASS K RATED PORTABLE EXTINGUISHER. A K-CLASS EXTINGUISHER SHALL BE PROVIDED AND LOCATED UNDER THE MANUAL PULL FOR THE HOOD.

5. PORTABLE FIRE EXTINGUISHERS SHALL BE SELECTED, INSTALLED AND MAINTAINED IN ACCORDANCE WITH THE NFPA

6. OWNER SHALL BE MAINTAIN ABC TYPE EXTINGUISHERS 7. MAINTENANCE OF EXTERIOR DOORS AND OPENINGS: EXTERIOR DOORS AND THEIR FUNCTION SHALL NOT BE ELIMINATED WITHOUT PRIOR APPROVAL. 8. SPRINKLER NOTES: N/A


9. THE FINAL DETERMINATION FOR THE REQUIREMENTS OF EXIT SIGNAGE AND EMERGENCY LIGHTING SHALL BE MADE IN THE FIELD. 10. N/A

11. THE ADDRESS SHALL BE POSTED ON FRONT AND REAR: FRONT IS MINIMUM 6" LETTERS OF CONTRASTING COLOR TO BACKGROUND AND BACK MAY BE 1" LETTERS.

10. N/A

11. A KNOX BOX SHALL BE PROVIDED NEAR THE MAIN ENTRANCE TO THE BUILDING (IFC-2018 § 506.1). TO ENSURE PROPER KEYING TO KANSAS CITY, MISSOURI; KNOX BOXES MAY BE ORDERED ONLINE AT WWW.KNOXBOX.COM OR ON AN OFFICIAL ORDER FORM OBTAINED THROUGH THIS OFFICE. 12. PORTABLE FIRE EXTINGUISHERS SHALL BE PROVIDED PER (IFC-2018 § 906.1;906.2). ABC AND CLASS K

02 SITE CONTEXT

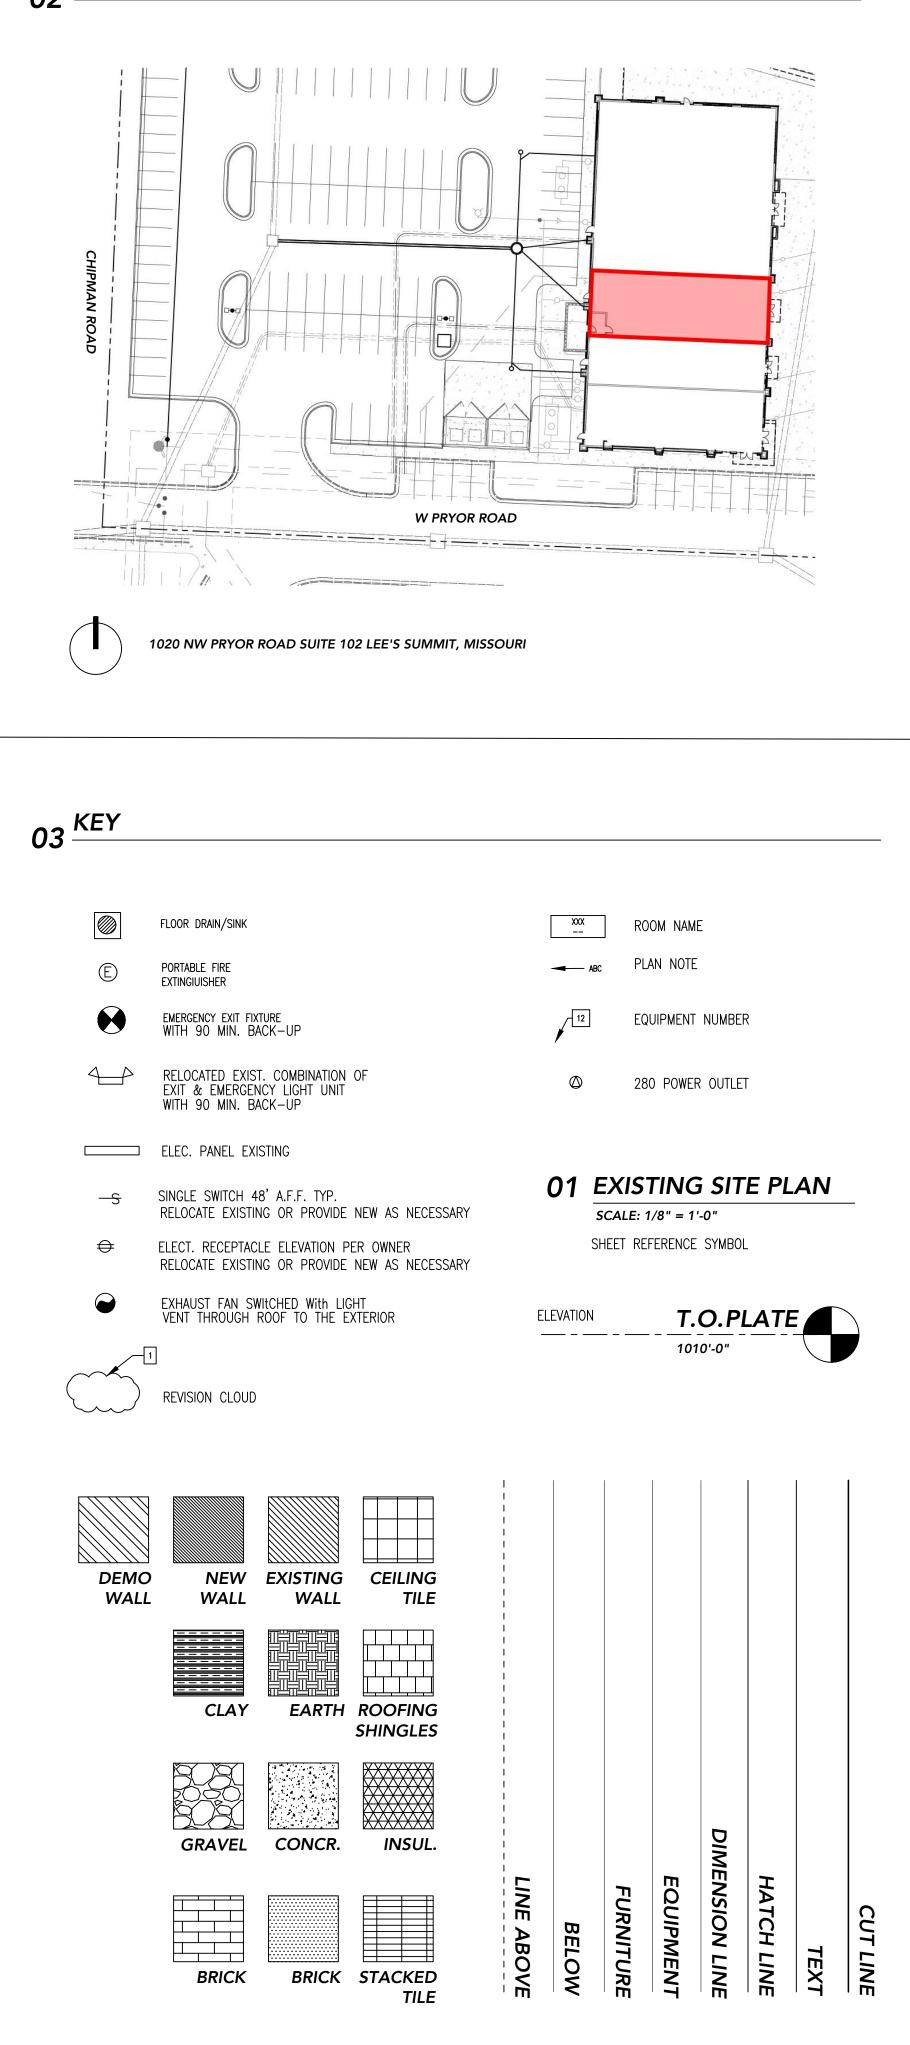

BUILDING INFORMATION

THE 2018 INTERNATIONAL BUILDING CODES PACKAGE:

INTERNATIONAL BUILDING CODE INTERNATIONAL FIRE CODE INTERNATIONAL PLUMBING CODE INTERNATIONAL ENERGY CODE INTERNATIONAL MECHANICAL CODE INTERNATIONAL FUEL GAS CODE INTERNATIONAL EXISTING BUILDING CODE 2017 NATIONAL ELECTRIC CODE 2010 ADA ACCESSIBILITY REQUIREMENTS

SCOPE OF WORK

THE REMODELING OF AN TENANT SPACE FOR THE NEW CAFE WHERE ORDER AND SERVED AT TABLE

CODE AND OCCUPANT LOAD DATA

CODE DATA

OCCUPANCY TYPE	A2
CONSTRUCTION TYPE	2B
FLOOR AREA	2,700 SF

OCCUPANCY LOAD

ROOM NAME	AREA	AREA PE OCCUPA		OCCUPANCY LOAD
DINING	FLEX SEAT BOOTH	392SF/15 2'/PPL	SF/PPL	37 28
KITCHEN	1121 SF	200 SF GR0	DSS	6
WAITING HOST	BENCH	2'/PERSON	1	3
		TOTAL OCC	UPANCY	LOAD: 75
	REQUIR	RED	Р	ROVIDED
NO. OF EXIT REQUIRED	1			2
NO. OF RESTROOMS REQUIRED	1			1
NO. OF STORIES	1 STORY			
SPRINKLERS	THIS IS A SP EXISTING FIRE			

PLUMBING FIXTURES

EXISTING TO REMAIN. NO CHANGE


FIXTURES DATA		
	REQUIRED	PROVIDED
WATER CLOSET(S) LAVATORY(S)	2 2	2 2

PLANNING AND DEVELOPMENT PARKING DATA


PARKING PROVIDED BY DEVELOPER HAS COMPLY WITH THE CITY'S STANDARDS FOR OFF-STREET PARKING. ACCESSIBLE PARKING SPACES AND RAMPS ARE LOCATED IN FRONT OF THIS FACILITY.


NO RTU CAN BE SIGHTED FROM GROUND LEVEL. GC SHALL PROVIDE RTU SCREEN MATCHING BUILDING MATERIALS AS REQUIRED.


	RELEASED FOR CONSTRUCTION As Noted on Plans Review
COPYRIGHT 2024	Development Services Depart Lee's Summit, Missouri
Щ	08/09/2024
T, T,	Wa
2 F,	8117 NW ROBERTS ROAD KANSAS CITY, MISSOURI 64152 816.838.3472 CORNERSTONEARCHITECTLLC@GMAIL.COM
RNERS1 CHITEC	2 ©@GM
К Ш	D 6415. CTLLC
	5 ROA SOUR CHITE
N N N	BERT9 Y, MIS 2 NEAR
<u>0</u> 2 2 0	UW RC 4S CIT 88.347, ERSTO
L AO	8117 NW ROBERTS ROAD KANSAS CITY, MISSOURI 64152 816.838.3472 CORNERSTONEARCHITECTLLC©
PROJECT:	
MAGIC	
NOODLE	S
1020 NW PRYOR ROAD LEE'S SUMMIT, MISSOU	
OF ML	Sho - a
S STATE SASSASSASSASSASSASSASSASSASSASSASSASSAS	SSOUR .
SUN KA	
AUMBE	R
STANDA	All's and
07/12/20	024
SHEET INDEX	•
T TITLE PAG	
A102 PROPOSEI	FLOOR PLAN D FLOOR PLAN
A104 PROP. ME	SCHEDULES CH. ROOF PLAN
	CAL FLOOR PLAN
LIGHTING	.OOR PLAN FLOOR PLAN VER PLAN
E300 ELECTRICA	
PLUMBING	
PLUMBING MP300 MECH. DE	G PLAN
MP301 MECH. SC MP302 MECH. SC	HEDULE
MPE400 SPECIFICA	
CONSULTAN	TS:
M/E/P:	
GLADFELTER ENGIN 10233 MILLSTONE D	
LENEXA, KANSAS 66220	
TEL: 816-916-4675 EMAIL: GPG@AECOI	NSORT.COM
ISSUE PACKA	GE:
NO: DATE	
1 CITY COMM	ENTS 06/28/2024
OWNER:	
CONTACT:	
DRAWN BY: JRK CHECKED BY: YJK	
PROJECT: DINE-IN	
DATE	05/19/2024
DRAWING	
TITLE P	AGE
SCALE $\frac{1}{4}$ " = 1	'0"
SHEET NUMBER	

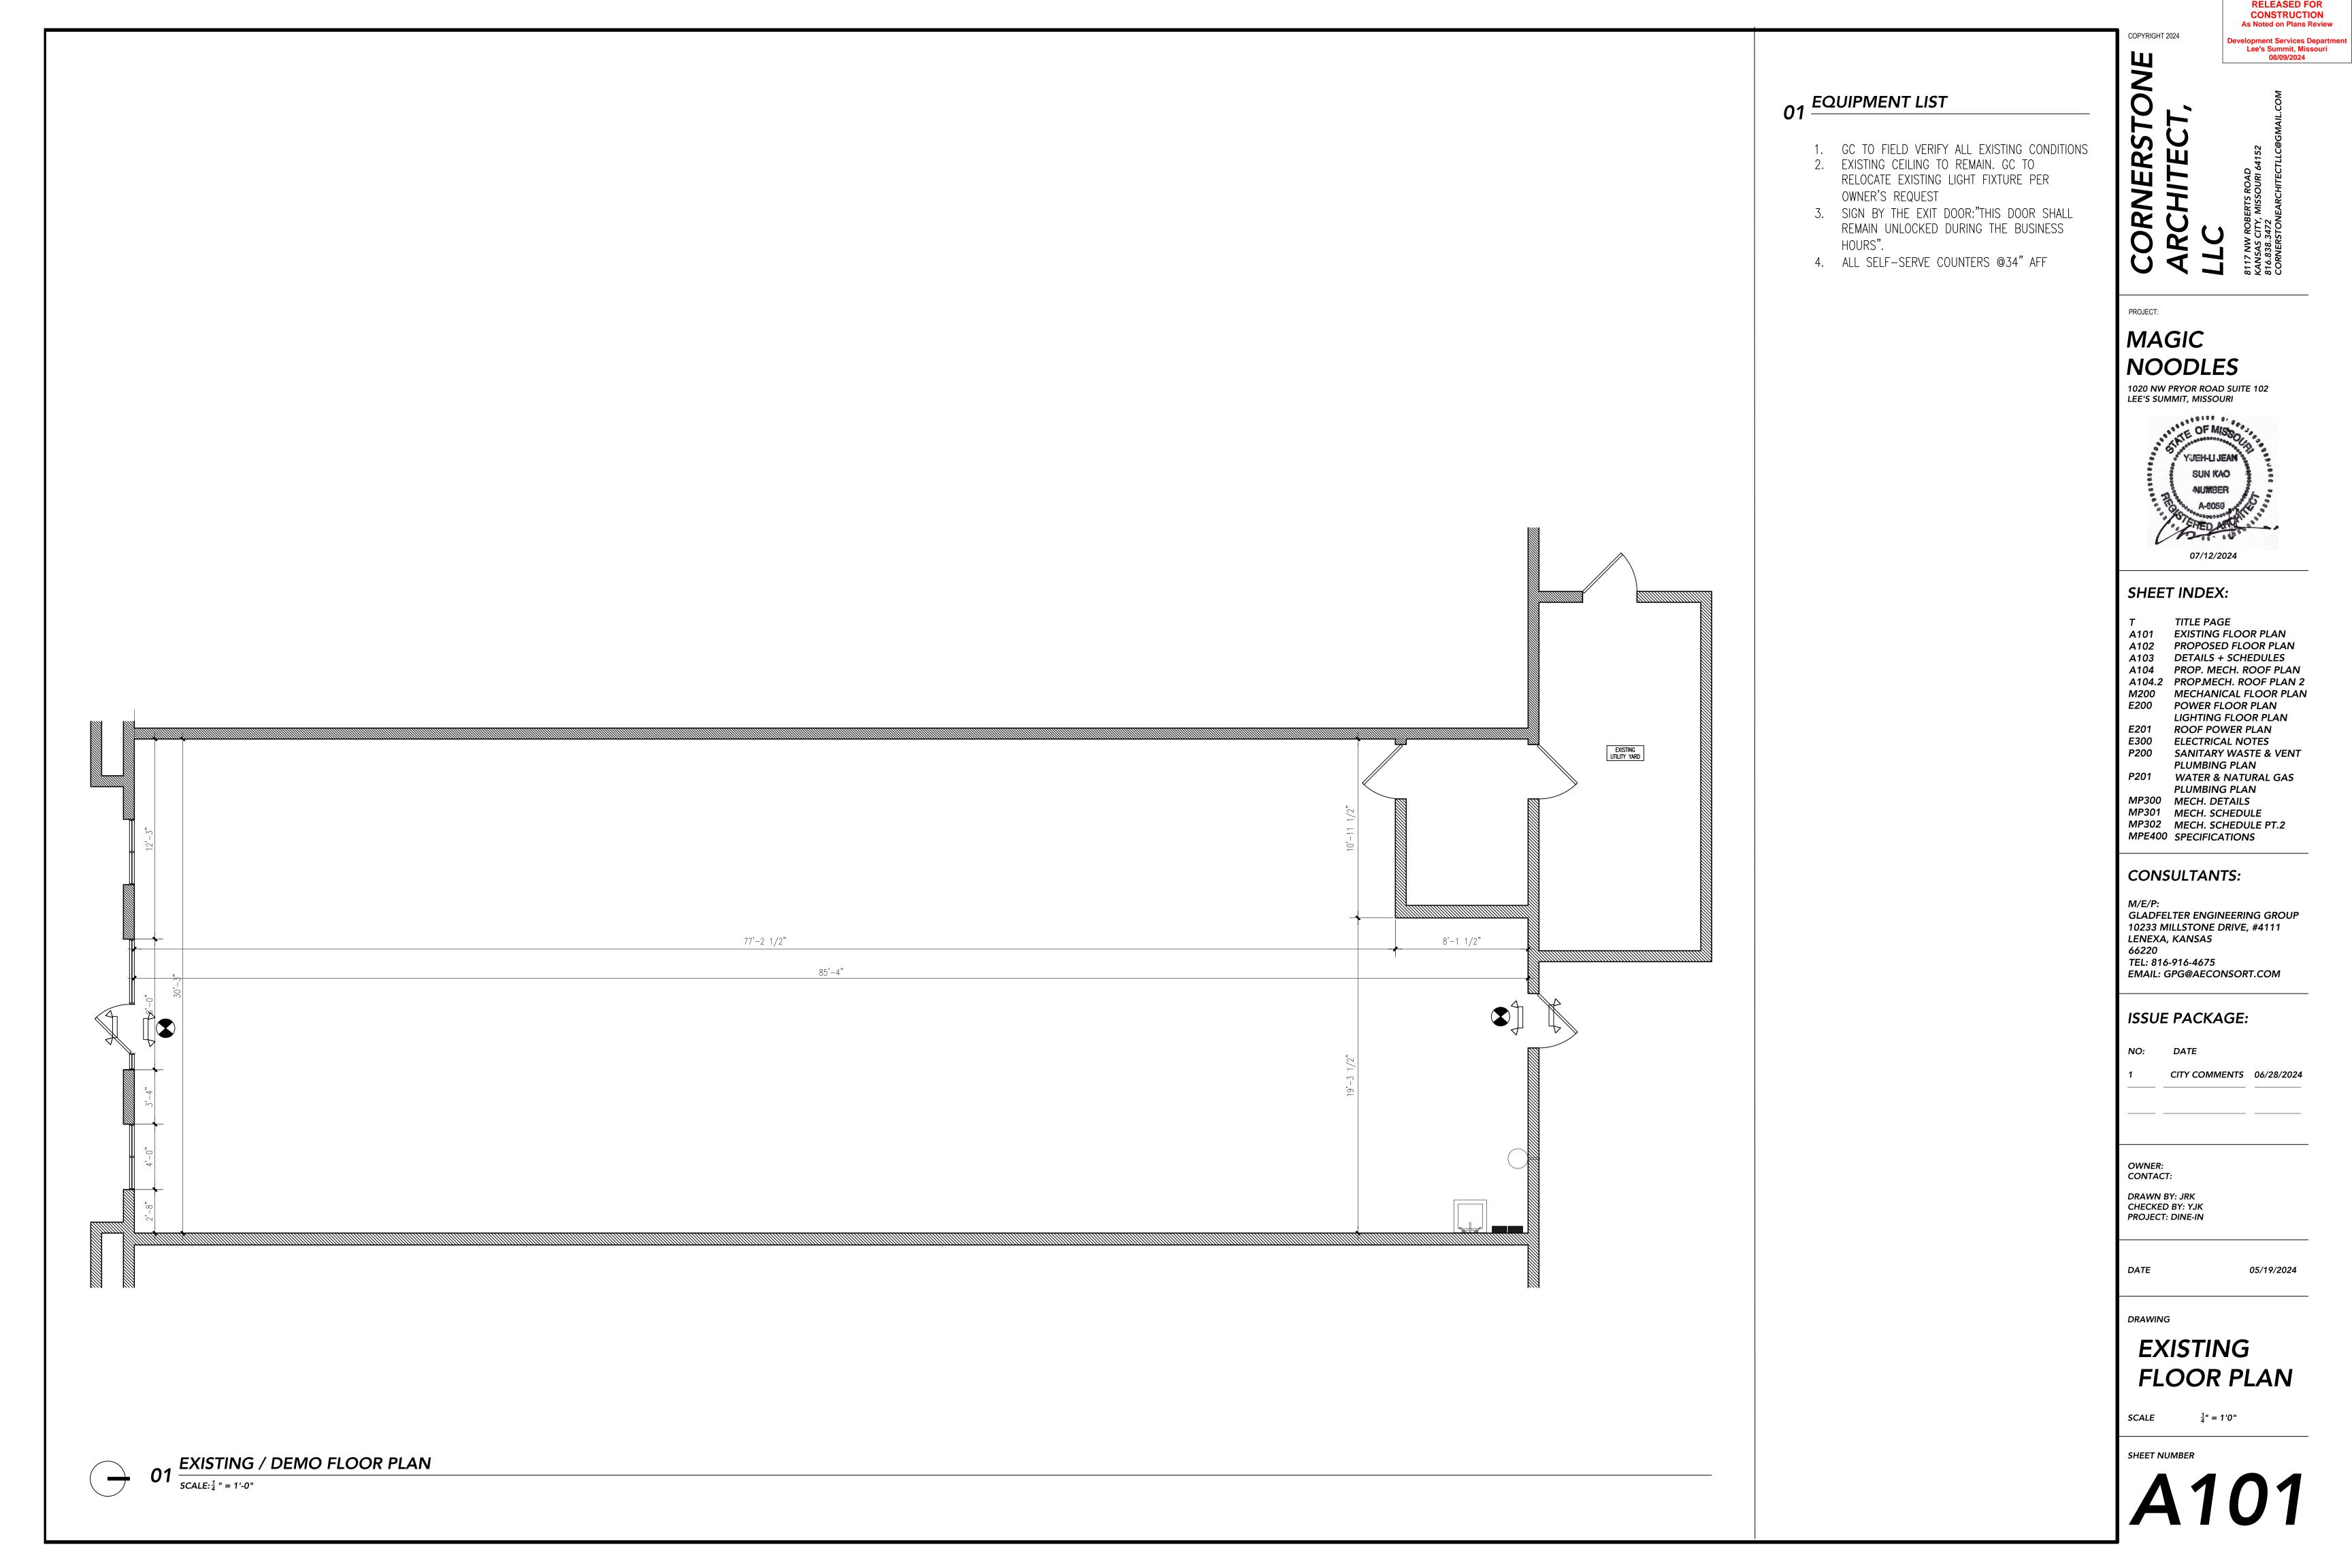



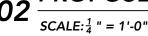

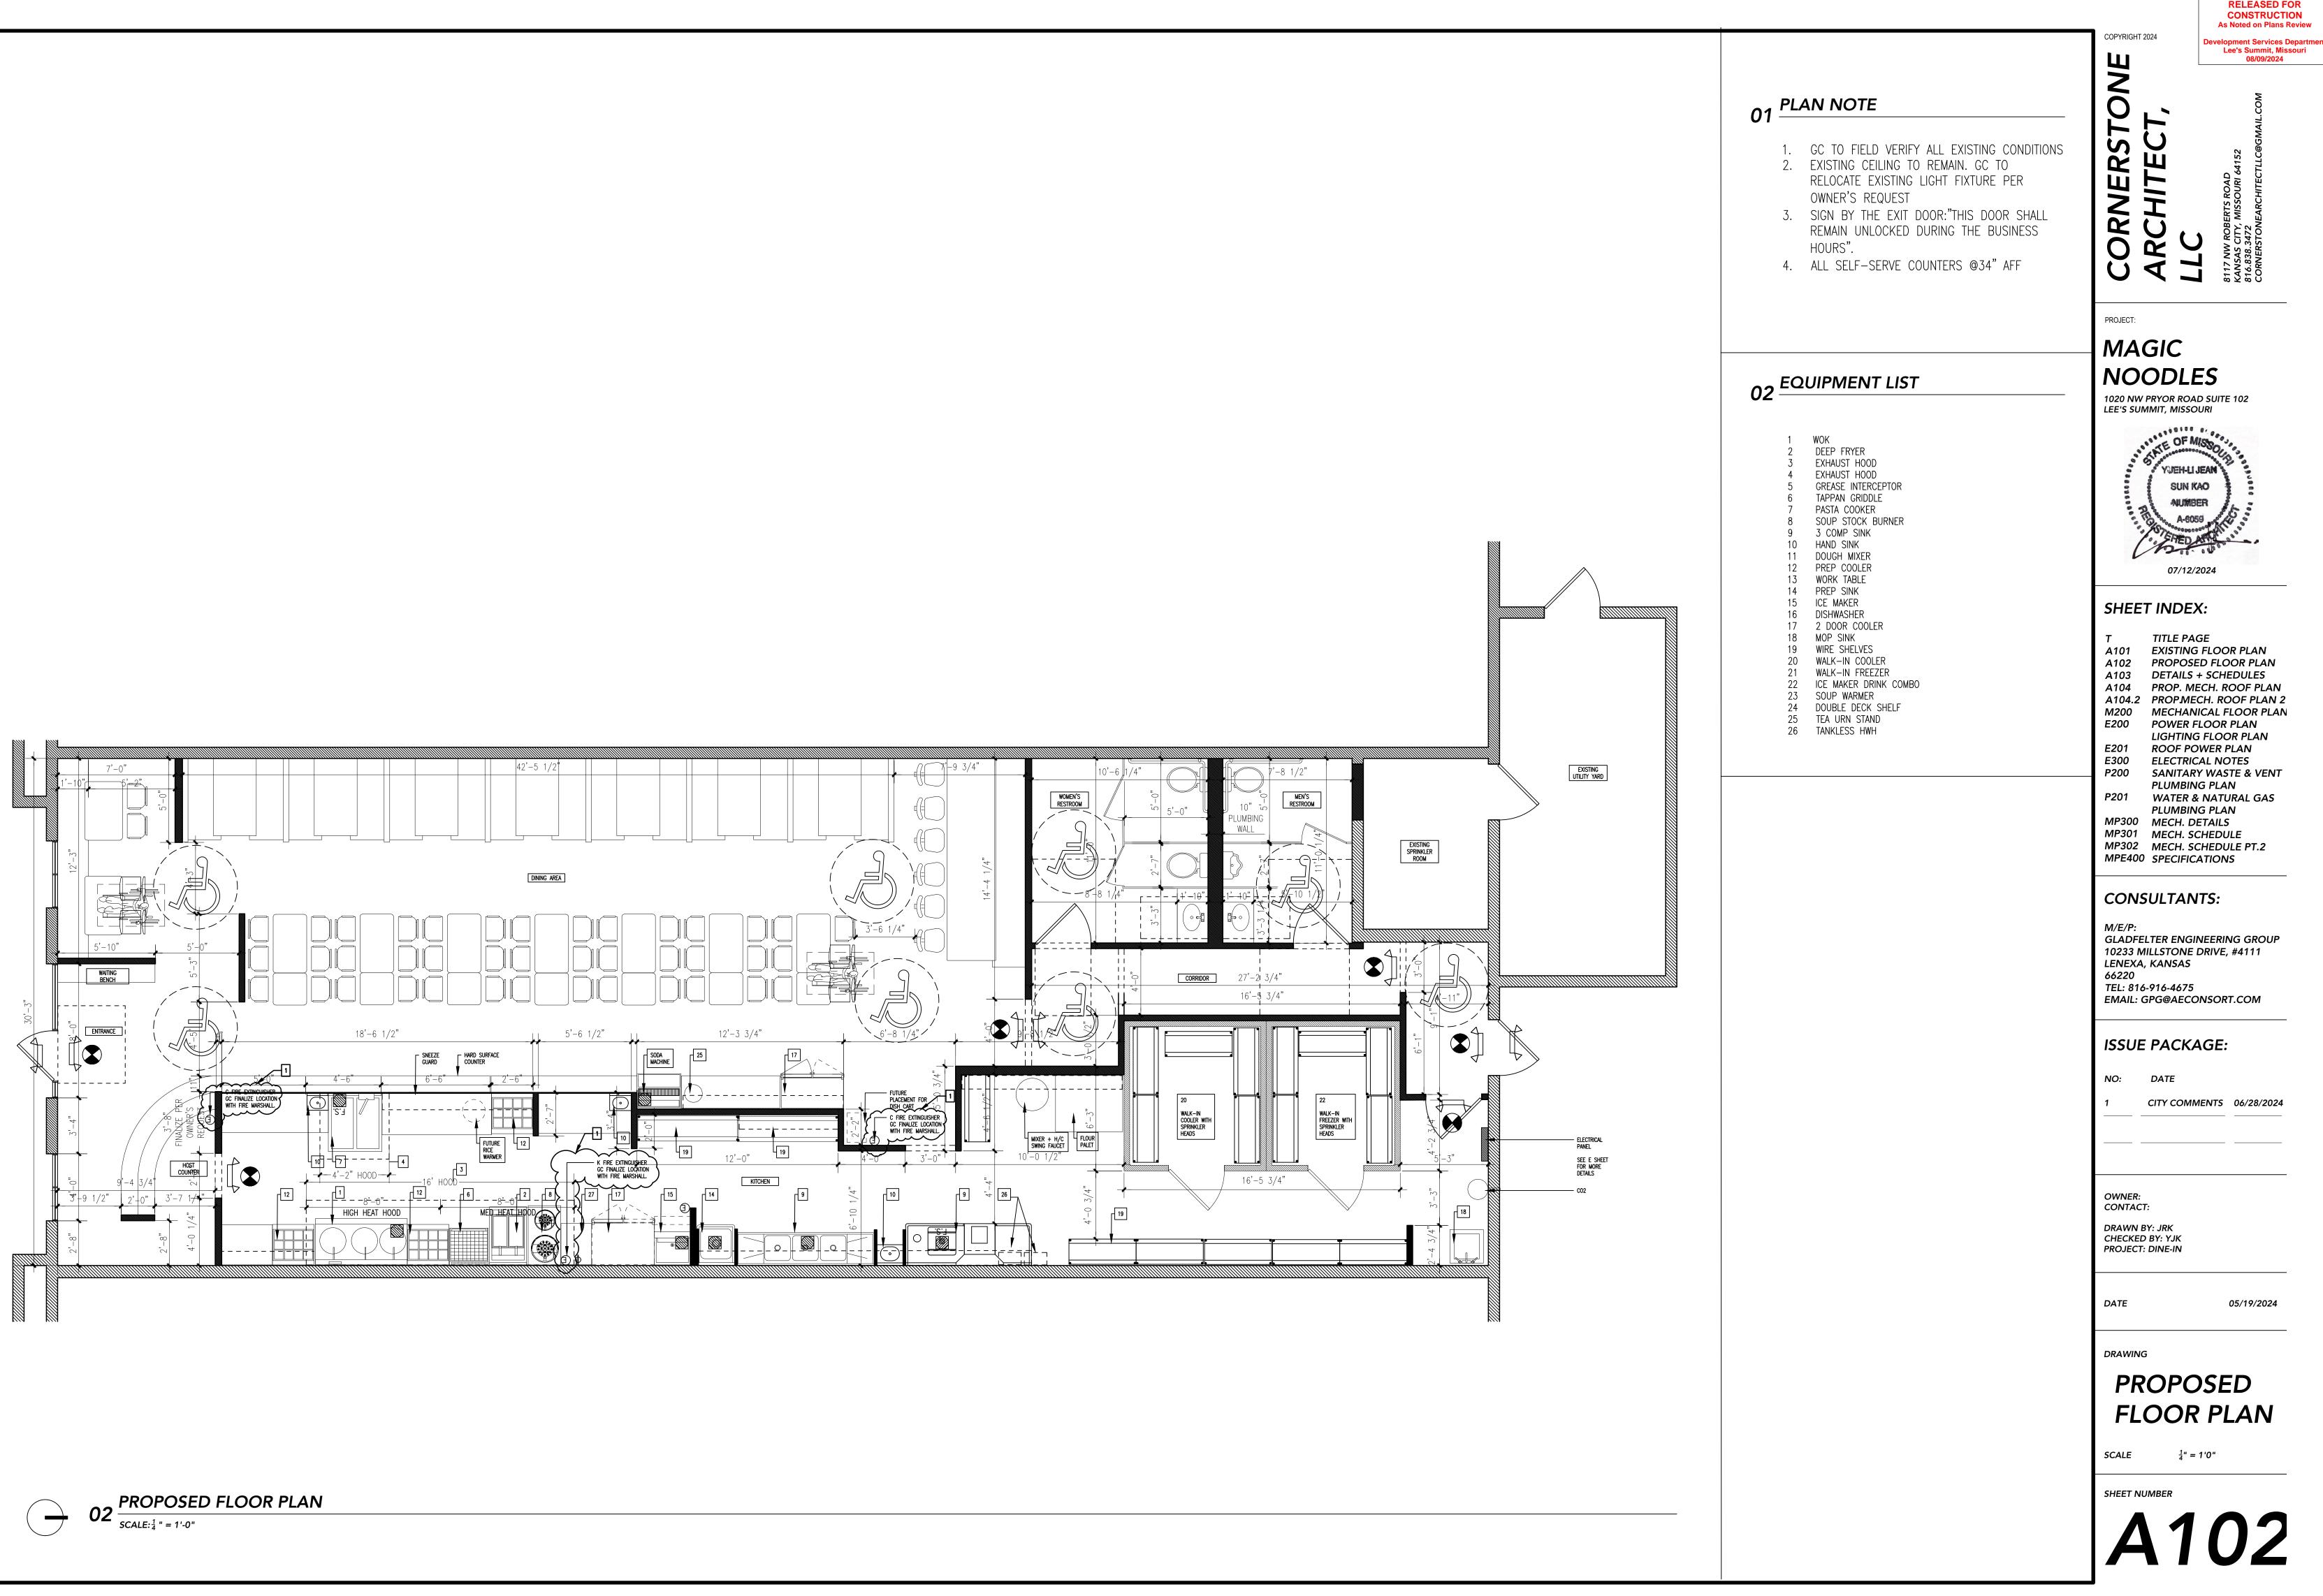

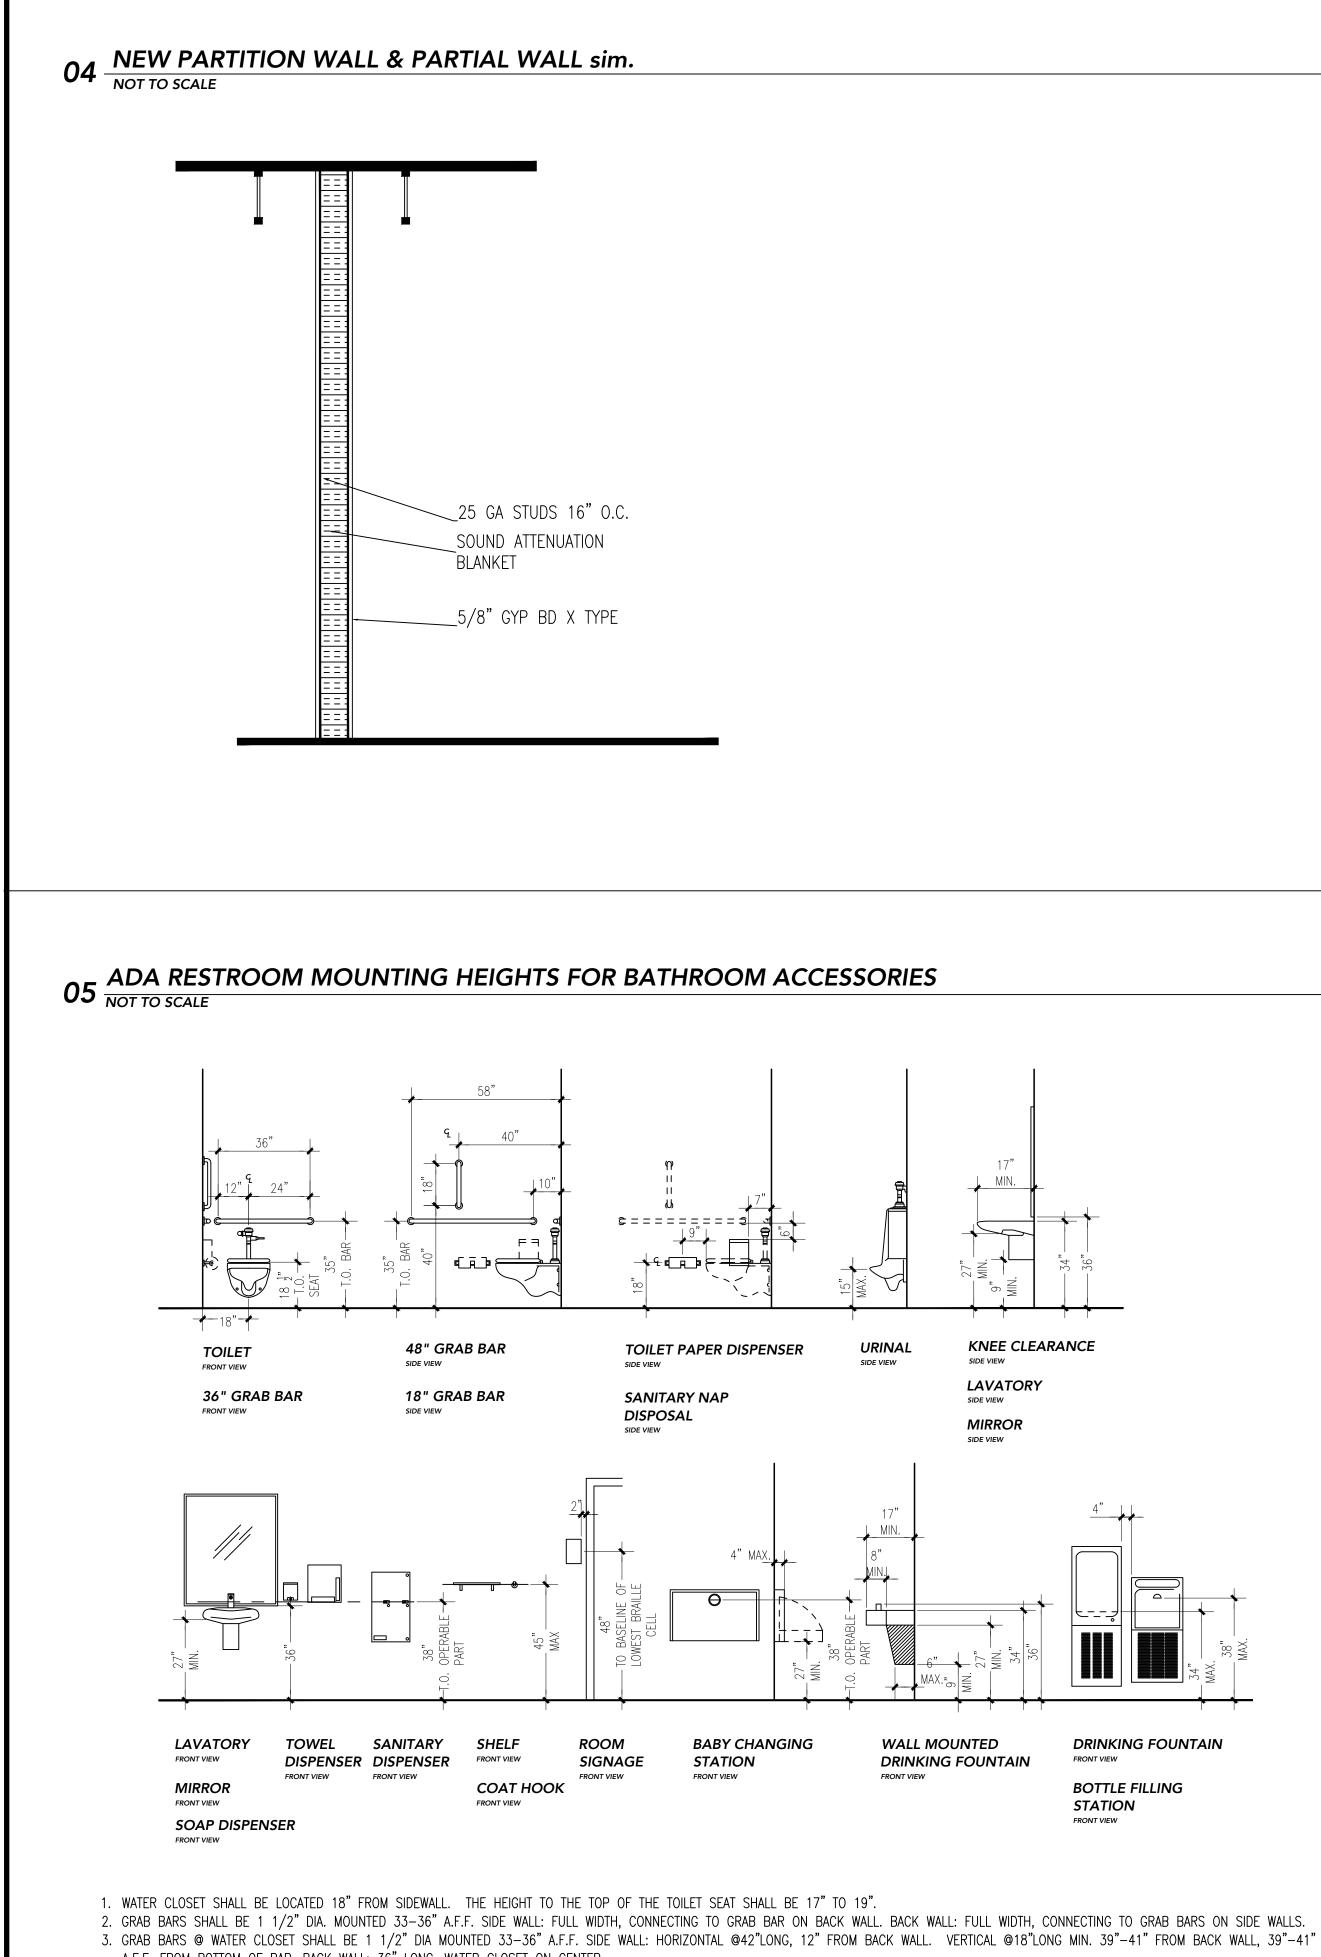

- A.F.F. FROM BOTTOM OF BAR. BACK WALL: 36" LONG, WATER CLOSET ON CENTER. 4. TOILET PAPER DISPENSERS SHALL BE INSTALLED ON THE SIDEWALL, BELOW THE GRAB BAR, AT MIN. 19" ABOVE THE FLOOR, AND A MAX. 36" FROM THE REARWALL. DISPENSERS THAT DO NOT PERMIT CONTINUOUS PAPER FLOW SHALL NOT BE USED.
- 5. LAVATORIES SHALL BE MOUNTED WITH THE RIM NO HIGHER THAN 34" ABOVE THE FINISH FLOOR. IT SHALL EXTEND 17" MIN. FROM THE WALL. CLEARANCE OF 29" MIN SHALL BE PROVIDED FROM FINISH FLOOR TO BOTTOM OF APRON. KNEE CLEARANCE OF 27" MIN. BY 8" MIN. UNDER THE EDGE OF THE LAVATORY. HOT WATER AND DRAINPIPES UNDER LAVATORIES SHALL BE INSULATED TO PROTECT AGAINST CONTACT AND SHALL BE NO ABRASIVE SURFACES. 6. FAUCET SHALL BE LEVER-OPERATED DESIGN.
- 7. MIRROR SHALL BE MOUNTED WITH THE BOTTOM EDGE OF THE REFLECTING SURFACE 40" MAX. A.F.F.
- 8. HANDICAPPED ACCESSIBLE RESTROOM SIGN SHALL MEET ALL THE STANDARDS OF ADA SIGN.
- 9. RESTROOM SHALL BE 3'-0"X 7'-0" HOLLOW CORD DOOR W/ SELF-CLOSER AND U SHAPED HARDWARE.
- 10. EXHAUST FAN SHALL BE SWITCHED WITH LIGHT. 11. ACCESSIBLE ROUTE SHALL HAVE A RUNNING SLOPE OF 1:20 MAX. AND A CROSS SLOPE OF 1:50 MAX.

01 EQUIPMENT LIST

NO.	DESCRIPTION	MODEL	NSF	AGA	UL	G	AS	VOLT
1	WOK	Q3 BURNERS	v	V	V	3"	300,000	
2	DEEP FRYER		v v	v	v	<u>3</u> " 4 <u>3</u> " 4	150,000	
3	EXHAUST HOOD	16 FOOT TYPE 1	l v	•	v I	4	100,000	120
4	EXHAUST HOOD	4 FOOT TYPE 2	V V		·			
5	GREASE INTERCEPTOR	1500 GPM	V					
6	TAPPAN GRIDDLE	24" WIDE	l v	V	v	<u>3</u> "	60,000	
7	PASTA COOKER	AX-GPC-2	V	V	v	<u>1</u> "	100,000	
8	SOUP STOCK BURNER	TASP-180	l v	·		3" 4 1" 2 3"	158,000	115
9	3 COMP SINK	22X22X20	l v			4	100,000	
10	HAND SINK	PER OWNER	l v					
11	DOUGH MIXER	30 QUART	V		v			115/60/1
12	PREP COOLER	30"	l v		V			115
13	WORK TABLE	SIZE VARY	V V		v I			
14	PREP SINK	PER OWNER	V					115
15	ICE MAKER	REMOTE AIRCHILL	l v		v			115
16	DISHWASHER	CONSERVER XL:CHEM. SAN.	V		V			115
17	2 DOOR COOLER	PER OWNER	l v		v I			115/60/1
18	MOP SINK	PER OWNER	V					
19	WIRE SHELVES	PER OWNER	V					
20	WALK-IN COOLER	SIZE PER PLAN	V		V			230
21	WALK-IN FREEZER	SIZE PER PLAN	V		V			230
22	ICE MAKER DRINK COMBO	AIR COOL	V		V			115/120/6
23	SOUP WARMER	INDUCTION 7 QT	V		V			115/120/6
24	DOUBLE DECK SHELF	PER OWNER	V					
25	TEA URN STAND	PER PLAN	V			7		
26	TANKLESS HWH	CU199IN	V	V	V	<u>3</u> " 4	199,000	

1. "BY OWNER": EQUIPMENT PROVIDE BY OWNER AND INSTALL BY GC PER MANUFACTURE'S INSTRUCTION WITH SUFFICIENT POWER IN ACCORDANCE WITH THE LATEST ADOPTED CODE. GC TO FINALIZE ALL EQUIPMENT WITH OWNER PRIOR TO CONSTRUCTION, AND INSTALLATION PER MANUFACTURE'S INSTRUCTION AND THE LATEST ADOPTED CODE. 3. PER NFPA 17A AND 96, ALL CASTER-MOUNTED EQUIPMENT UNDER FIRE SUPPRESSION SYSTEM SHALL BE LOCKED IN PLACE WITH DORMONT SAFETY-SET CASTER PLACEMENT SAFETY SET SYSTEM, OR EQUAL.

02 INTERIOR FINISH SCHEDULE

INTERIOR FINISH SCHEDULE

FLOOR	CEILING	WALL
CERAMIC TILE WITH MATCHING COVE BASE	OPEN CEILING	2 COATS OF WASHABLE PAINT
CERAMIC TILE WITH MATCHING COVE BASE	OPEN CEILING	2 COATS OF WASHABLE PAINT
CERAMIC TILE WITH MATCHING COVE BASE	EXISTING 2X4 LAY-IN CLIMAPLUS CEILING TILE OR EQUAL	TILE TO 6'-0" A.F.F. & WASHABLE PAINT
CERAMIC TILE WITH MATCHING COVE BASE	2X4 LAY—IN CEILING TILE, GENESIS: SMOOTH PRO OR EQUAL	SS UNDER HOOD / FRP
	CERAMICTILEWITHMATCHINGCOVEBASECERAMICTILEWITHMATCHINGCOVEBASECERAMICTILEWITHMATCHINGCOVEBASE	CERAMIC TILE WITH MATCHING COVE BASE OPEN CEILING CERAMIC TILE WITH MATCHING COVE BASE OPEN CEILING CERAMIC TILE WITH MATCHING COVE BASE EXISTING 2X4 LAY-IN CLIMAPLUS CEILING TILE OR EQUAL

INTERIOR WALL AND CEILING FINISH MATERIALS SHALL COMPLY WITH IBC 2018 CHAPTER 803.1 AND TESTED IN ACCORDANCE WITH NFPA 286.

03 DOOR SCHEDULE

DOOR SCHEDULE

		1	1
DOOR	MATERIAL	SIZE	REN
EXISTING EXTERIOR FRONT	STORE FRONT ALUMINUM	6'-0" x 7'-0"	TIGH
NEW RESTROOM	WOOD-SC, MTL FRAME, PREHUNG	3'-0" x 6'-8"	TIGH
EXISTING EXTERIOR REAR	HOLLOW MTL FRAME, PREHUNG	3'-0" x 7'-0"	TIGHT

DOOR NOTES:

- 1. LATCH SIDE CLEARANCES AT ALL DOORWAYS SHALL BE IN ACCORDANCE W/ A 117.1 AND IN COMPLIANCE WITH IBC 2018 1008 AND 1010.1.99 2. ALL EXITS TO BE LABELED.
- 3. INTERIOR TO BE LABELED AS TO INTENDED USE.
- 4. PANIC HARDWARE ON ALL EXTERIOR DOORS
- WRIST TO OPERATE.

5. THE OPERATING DEVICE ON ALL DOORS SHALL BE CAPABLE OF OPERATION WITH ONE HAND AND SHALL NOT REQUIRE TIGHT GRASPING, TIGHT PINCHING OR TWISTING OF THE 6. LANDING SHALL BE PROVIDED AT EVERY REQUIRED EXIT AND THEY SHALL BE A MINIMUM OF 36 INCHES IN WIDTH AND 44 INCHES LONG IN THE DIRECTION OF TRAVEL.

AM	P HI	P PHMAI	UFACTURER
6 6 3.2 7.7 10 9.8 8.5	13" 1 15" 13" 13" 1	1 1 1 1 1 1 1 1 1	WIN AVANTCO LARKEN PER JCW VOLLRATH AXIS OR SIM WIN EAGLE EAGLE WIN TURBO WIN EAGLE MANITOWOC EAGLE MANITOWAC EAGLE EAGLE AMERIKOOLER AMERIKOOLER HOSHIZIKI VOLLRATH WIN WIN RINNAJ


EMARKS-HEAVY DUTY COMMERCIAL, ANSI, ADA

GHT FITTING, CLOSER, PUSH PANIC BAR

GHT FITTING, CLOSER, PRIVACY LOCK SET

GHT FITTING, CLOSER, PUSH PANIC BAR

COPYRIGHT 2024	RELEASED FOR CONSTRUCTION As Noted on Plans Review Development Services Department Lee's Summit, Missouri
CORNERSTONE ARCHITECT, ILC	8117 NW ROBERTS ROAD KANSAS CITY, MISSOURI 64152 816.838.3472 CORNERSTONEARCHITECTLLC@GMAIL.COM
PROJECT: MAGIC NOODLEE 1020 NW PRYOR ROAD LEE'S SUMMIT, MISSON SUN KA A-605 COT/12/2	D SUITE 102 URI
A103 DETAILS A104 PROP. ME A104.2 PROP.ME M200 MECHAN E200 POWER F LIGHTING E201 ROOF PO E300 ELECTRIC P200 SANITAR PLUMBIN	GE FLOOR PLAN D FLOOR PLAN SCHEDULES CH. ROOF PLAN CH. ROOF PLAN 2 ICAL FLOOR PLAN LOOR PLAN FLOOR PLAN WER PLAN AL NOTES Y WASTE & VENT G PLAN NATURAL GAS G PLAN TAILS CHEDULE CHEDULE PT.2
CONSULTAN M/E/P: GLADFELTER ENGIN 10233 MILLSTONE I LENEXA, KANSAS 66220 TEL: 816-916-4675 EMAIL: GPG@AECO ISSUE PACKA NO: DATE 1 CITY COMM	NEERING GROUP DRIVE, #4111 NSORT.COM
OWNER: CONTACT: DRAWN BY: JRK CHECKED BY: YJK PROJECT: DINE-IN DATE	05/19/2024
DRAWING DETAIL SCALE SHEET NUMBER	ULES 1'0"
	03

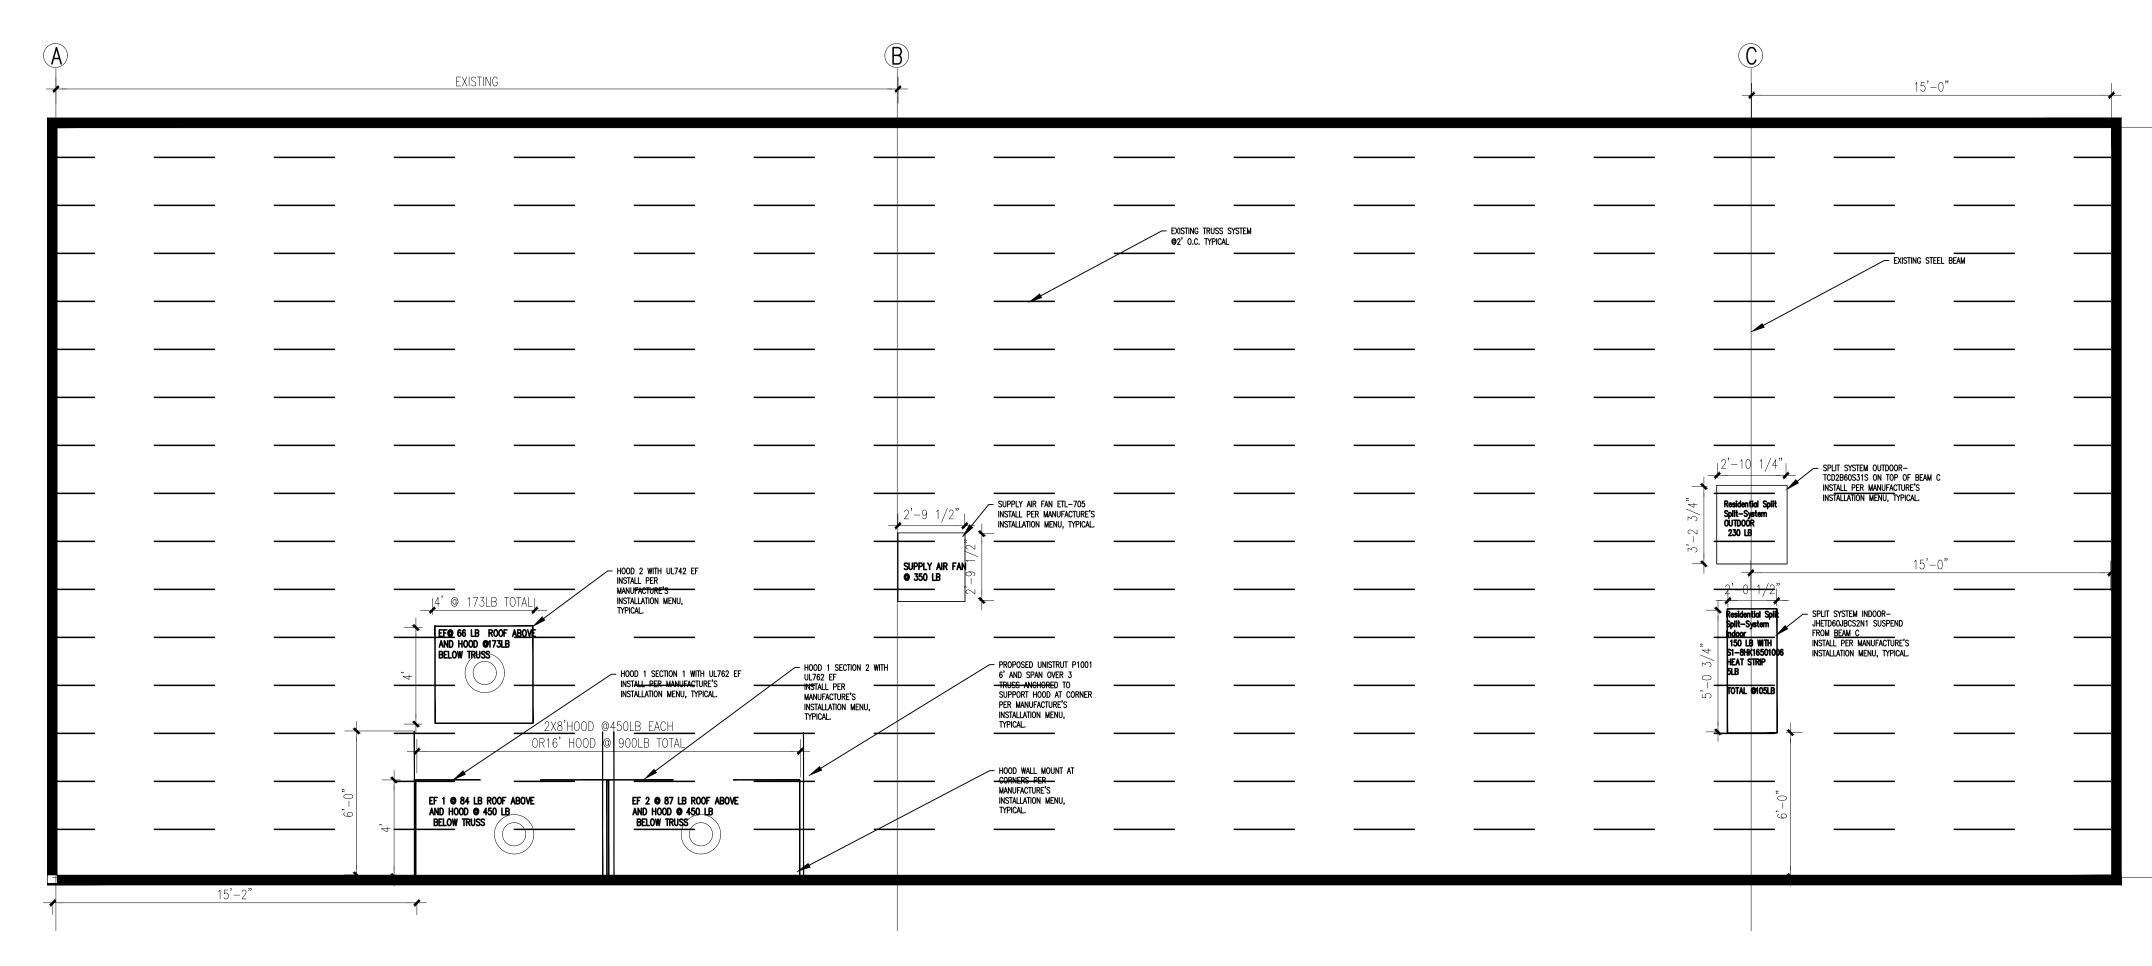



01 MAGIC NOODLE 2-THE NEW EXHAUST HOOD SYSTEM ROOF PLAN SCALE: 1/4"=1'-0" GC FIELD VERIFY ALL EXISTING CONDITION

04 LARKIN INDUSTRIES, INC

Page 2 of 3 QUOTATION Larkin Page 1 of 3 Date....: 06/12/2024 Quote #: L-442186 JOB NAME: MAGIC NOODLE 2 QUOTATION QUANTITY DESCRIPTION LARKIN INDUSTRIES, INC. 114 David Green Road Toll: 800-322-4036 Birmingham, AL 35244 Fax: 205-987-0583 Quote Date: 06/12/2024 Quote #....: L-442186 UL-762 EXHAUST FAN - For HOOD: 1 - SECTION: 1 Model: XCUBE-140-7 3/4 HP 208 V 1 PH 7.60 AMPS Exhaust Air Volume: 2064 CFM @ 1.000SP Weight: 84lbs Grease Trough for Exhaust Fan Hinged Base Kit for Exhaust Fan 21X21 Flat Roof Curb 1
 TO:
 ATLAS MECHANICAL SERVICES, INC.

 ATTN:
 SCOTT

 PH:
 913-708-4695

 FAX:
 816-637-2010
 MECH CONTRACTORS JOB NAME: MAGIC NOODLE 2 FROM: NATHAN SANDLIN UL-762 EXHAUST FAN - For HOOD: 1 - SECTION: 2 Model: XCUBE-160-10 1 HP 208 V 1 PH 8.80 AMPS Exhaust Air Volume: 2832 CFM @ 1.000SP Weight: 87lbs Grease Trough for Exhaust Fan Hinged Base Kit for Exhaust Fan 21X21 Flat Roof Curb 1 QUANTITY DESCRIPTION (Hood Size LxWxH) HOOD 1 16' 0" x 48" x 24" Model: SC 1 (SHORT CIRCUIT) WALL STYLE - 430 STAINLESS STEEL - WHERE EXPOSED HOOD IS 2 SECTIONS, END TO END HOOD 2 4' 0" x 48" x 24" Model: CH1 1 4' 0" x 48" x 24" Model: CH1 (STANDARD CONDENSATE HOOD) WALL STYLE - 100% STAINLESS STEEL WEIGHT: 173lbs No ETL Label 12X12 Exhaust Collar(s) For Top Loose Aluminum Mesh Filter (Shipped Loose) With Rack (Shipped Loose) CFM REQUIREMENT: EXHAUST: 800 CFMS @ .250 S.P. NOTE.....: S.P. Calculations Include Hood, Filters, and up to 8' of Straight Exhaust Duct. SUPPLY: 800 CFMS @ .125 S.P. NOTE.....: S.P. Calculations Include Hood and up to 20' of Straight Supply Duct. 'AIR INTO ROOM SECTION 1 OF HOOD 1 8' 0" x 48" x 24" WEIGHT: 450lbs 450 Degree ETL Label 1 WEIGHT: 450lbs 450 Degree ETL Label Prewired Incandescent Light(s) 13X13 Exhaust Collar(s) For Top Loose 30X10 Supply Collar(s) With Damper(s) For Top Loose Front Panel Insulation 3" Back Stand-Off Mounted (Stand-Off Adds to Width of Hood) Zero Clearance Back Zero Clearance Top Stainless Steel Baffle Filters CFM REQUIREMENT: EXHAUST: 2064 CFMS @ .500 S.P. NOTE.....: S.P. Calculations Include Hood, Filters, and up to 8' of Straight Exhaust Duct. SUPPLY: 2064 CFMS @ .125 S.P. NOTE.....: S.P. Calculations Include Hood and up to 20' of Straight Supply Duct. NOTE: For proper system balance 412 CFMS of Supply Air to be introduced into space via Ceiling Grills, etc. 1 * SUPPLY AIR INTO ROOM UL-762 EXHAUST FAN - For HOOD: 2 Model: XCUBE-100-4 1/4 HP 115 V 1 PH 5.80 AMPS 1 Exhaust Air Volume: 800 CFM @ 0.625SP Weight: 66lbs 18X18 Flat Roof Curb SECTION 2 OF HOOD 1 8' 0" x 48" x 24" WEIGHT: 450lbs 600 Degree ETL Label Prewired Incandescent Light(s) 16X16 Exhaust Collar(s) For Top Loose 40X10 Supply Collar(s) With Damper(s) For Top Loose Front Panel Insulation ETL-705 SUPPLY FAN Model: ARS-15 2 HP 208 V 3 PH 7.50 AMPS 1 Supply Air Volume: 4896 CFM @ 0.625SP Weight: 350lbs 33X33 Flat Roof Curb 1 Tront Panel Insulation 3" Back Stand-Off Mounted (Stand-Off Adds to Width of Hood) Zero Clearance Back Zero Clearance Top Stainless Steel Baffle Filters CFM REQUIREMENT: EXHAUST: 2832 CFMS @ .625 S.P. NOTE.....: S.P. Calculations include Hood, Filters, and up to 8' of Straight Exhaust Duct. SUPPLY: 2832 CFMS @ .250 S.P. NOTE.....: S.P. Calculations include Hood and up to 20' of Straight Supply Duct. NOTE: For proper system balance 1132 CFMS of Supply Air to be introduced into space via Ceiling Grills, etc. Auto Fan Control System Thermostatically controlled ON/OFF, lights off in fire mode, 10amp light control relay, 2 aux dry contacts, 120v power for shunt trip. 12X22X6 Stainless Steel enclosure Controlling HOOD 1 Section 1,2 Distribution for the section 1.2 1 Display/Switches mounted on enclosure door Hood Sensors 2

		COPYRIGHT 2024 RELEASED FOR CONSTRUCTION As Noted on Plans Review Development Services Department
		Lee's Summit, Missouri 08/09/2024
	DUCTATION Page 3 of 3 JOB NAME: MAGIC NOODLE 2 Date: 06/12/2024 Quote #: Date: 06/12/2024 Quote #: <td< th=""><th>CORNERSTO CORNERSTO ARCHITECT, ARCHITECT, LLC LLC B17 NW ROBERTS ROAD KANSAS CITY, MISSOURI 64152 KANSAS CITY, MISSOURI 64152 KANSAS CITY, MISSOURI 64152 CORNERSTONEARCHITECTLLC@GMAIL.COM</th></td<>	CORNERSTO CORNERSTO ARCHITECT, ARCHITECT, LLC LLC B17 NW ROBERTS ROAD KANSAS CITY, MISSOURI 64152 KANSAS CITY, MISSOURI 64152 KANSAS CITY, MISSOURI 64152 CORNERSTONEARCHITECTLLC@GMAIL.COM
-	QUOTATION FOR ADDITIONAL OPTIONS (Add to above total if required) Adder for Sloped Curb (per Curb)	PROJECT:
-	 **NOTICE*** THE PURCHASER MAY BE LIABLE FOR ALL REPORTING AND REMITTANCE OF SALES AND/OR USE TAX DIRECTLY TO THEIR APPROPRIATE TAXING AUTHORITY FOR ALL APPLICABLE TAXABLE PURCHASES. **SPECIAL NOTES** THIS QUOTE IS SUBJECT TO THE TERMS & CONDITIONS OF LARKIN INDUSTRIES, INC. COPIES OF DISCLAIMERS AND RECOMMENDATIONS MAY BE OBTAINED UPON REQUEST. THIS QUOTE IS VALID FOR 30 DAYS FROM ABOVE DATE. THANK YOU FOR THE OPPORTUNITY TO QUOTE YOU ON THE ABOVE KITCHEN VENTILATION PRODUCTS. IF YOU HAVE ANY QUESTIONS CONCERNING THE PRODUCTS OR PRICES QUOTED PLEASE CALL NATHAN SANDLIN AT (800) 322-4036. 	<section-header><text></text></section-header>
		SHEET INDEX: T TITLE PAGE A101 EXISTING FLOOR PLAN A102 PROPOSED FLOOR PLAN
	5	A103 DETAILS + SCHEDULES A104 PROP. MECH. ROOF PLAN A104.2 PROPJMECH. ROOF PLAN 200 MECHANICAL FLOOR PLAN E200 POWER FLOOR PLAN E201 ROOF POWER PLAN E300 ELECTRICAL NOTES P200 SANITARY WASTE & VENT PLUMBING PLAN P201 WATER & NATURAL GAS PLUMBING PLAN MP300 MECH. DETAILS MP301 MECH. SCHEDULE MP302 MECH. SCHEDULE PT.2 MPE400 SPECIFICATIONS CONSULTANTS: M/E/P: GLADFELTER ENGINEERING GROUP 10233 MILLSTONE DRIVE, #4111 LENEXA, KANSAS 66220 TEL: 816-916-4675 EMAIL: GPG@AECONSORT.COM
		NO: DATE 1 CITY COMMENTS 06/28/2024
	(<u>4</u>)	PROJECT: DINE-INDATE05/19/2024DRAWINGDRAWINGPROPOSED DLANSCALE $\frac{1}{4}" = 1'0"$ SHEET NUMBER
		A104





Unit Model # JHETD60JBC52N System: JHETD60JBC52N alled Options
alled Options
00002111
Option(s) Selected
J York Branded
H Single Piece
E Standard ECM
T Two Stage Capable
D 24.5 inch width
i0 5 ton
J 4R-28-12
C BC Factory TXV
S Standard (Conventional)
2 208/230-1-60
N
1

Information is subject to change eithout notice. Check local codes.


YC	DRK [®]	F	Split-Syste				Page
Name: Ma nical	gic Noodle 2 - Atlas					Unit Model #;	JHETD60JBCS2
y: 1			JHET Physical a	and Electrical			
Table 4: Pr	rysical and electrical data		JHET Physical a	ing Electrical			
Models		B18B	B24C	B30D	B36D	C36D	C42F
Blower - di	ameter x width (in.)	11 x 8	11 x 8	11 x 8	11 x 8	11 x 10	11 x 10
1100	HP	1/3 HP	1/3 HP	1/2 HP	1/2 HP	1/2 HP	1/2 HP
Motor	Nominal RPM	1050	1050	1050	1050	10:50	1050
Voltage (V))	208/230	208/230	208/230	208/230	208/230	208/230
Full load an	mps at 230 V (A.)	2.6	2.6	3.8	3.8	3.8	3.8
	Туре			Disposable	or cleanable		
Filter ¹	Size	16 x 20 x 1	16 x 20 x 1	16 x 20 x 1	20 x 20 x 1	20 x 20 x 1	20 x 20 x 1
Shipping/o	perating weight (1b)	101/98	107/99	106/100	108/100	124/114	135/125
Models		C48G	D48G	C60H	D60H	DE0J	
Blower - di	ameter x width (in.)	11 x 10	11 x 11	11 x 10	11 x 11	11 x 11	
	HP	3/4 HP	3/4 HP	3/4 HP	3/4 HP	3/4 HP	
Motor	Nominal RPM	1050	1050	1050	1050	10/50	
Voltage (V))	208/230	208/230	208/230	208/230	208/230	
Full load at	mps at 230 V (A)	5.4	5.4	5.4	5.4	5.4	
-	Тура		Di	posable or cleana	ible		
Filter ¹	Size	20 x 20 x 1	23 x 20 x 1	20 x 20 x 1	23 x 20 x 1	23 x 20 x 1	
Oblighters	perating weight (lb)	140/129	152/140	153/141	158/146	162/150	


Printed 07/11/202

Models	Motor FLA ¹	Minimum Circuit Ampacity (A)	MOP ²
B18B/B24C	2.6	3.3	15
830D/836D/C36D/C42F	3.8	4.8	15
C48G/D48G/C60H/D60H/D60J	5.4	6.8	15

Information is subject to change without notice. Check local codes

FLA = Full Load Amps
 MOP = Maximum Overcurrent Protection device; must be HACR type circuit breaker or time delay fuse. Refer to the latest edition of the National Electric Code or in Canada the Canadan electrical Code and local codes to determine correct wire sizing.

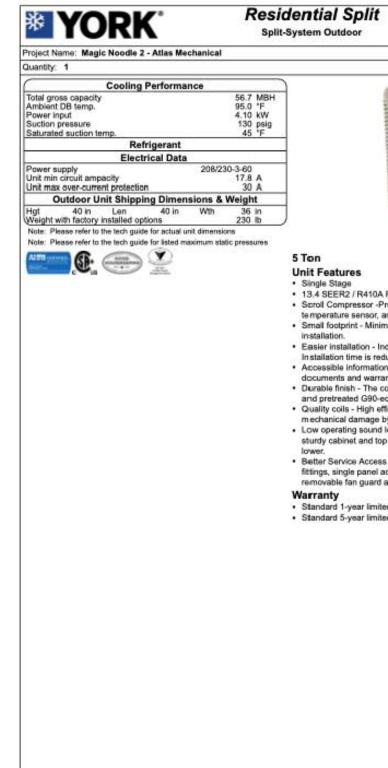

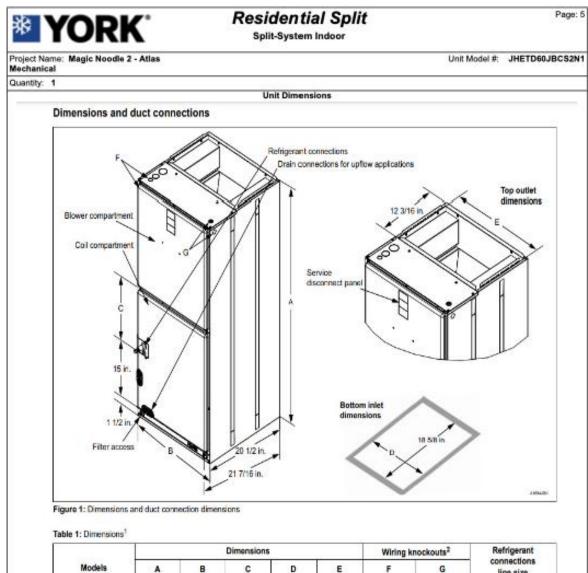

Models	A	В	C	D	E	F	G		size
	Height (in.)	Width (in.)	Ope	ning widths	(in.)	Power (in.)	Control (in.)	Liquid (in.)	Vapor (in.)
JHETB18B	47	17 1/2	7 1/2	16 1/2	16 1/2			1	
JHETB24C	49 5/8	17 1/2	10	16 1/2	16 1/2	1			
JHETB30D	49 5/8	17 1/2	10	16 1/2	16 1/2				3/4
JHETB36D	49 5/8	17 1/2	10	16 1/2	16 1/2				
JHETC36D	51	21	11 1/2	20	20	7/8 (1/2)			
JHETC42F	57	21	17 1/2	20	20	1 3/8 (1)	7/8 (1/2)	3/8	
JHETC48G	61 1/4	.21	21 3/4	20	20	4)		0.00	
JHETD48G	61 1/4	24 1/2	21 3/4	23 1/2	23 1/2	7 ~ .			
JHETC60H	63	21	23 1/2	20	20	7			7/8
JHETD60H	63	24 1/2	23 1/2	23 1/2	23 1/2				
JHETD60J	61 1/4	24 1/2	21 3/4	23 1/2	23 1/2	-			

Information is subject to change without notice. Check local codes.

Printed 07/11/2024

Printed 07/11/2024

Projec Mecha Quanti		Mag	gic No	odle 3
Ту	pical a	appl	icati	ons
	ι	Jpflo	**	
	Ť		1	<u> </u>
		1	Heat	kit ,
				Ţ
		E	۲	- State
		1		And a state of
		0	1	
	2	2		

	Unit Model #	TCD2B605315
	System:	TCD2B60S31S
and the second s	our other designs of the	
TORK	and the state of the	
162538		
12 22 22 2	a second second	
2		
eatures		
Stage		
EER2 / R410A Refrigerant		
Compressor -Protected internally by a		
rature sensor, and externally by the s		
footprint - Minimum footprint for easie	r handling, transp	portation, and
ation. r installation - Independent panels pro	uida quick accase	for unit set in
ation time is reduced by easy power a		
while information of an or an other	and does not all and a	and the Read advantage

Printed 07/11/2024

Page: 8

 Accessible information - QR code on unit provides quick access to technical documents and warranty information. • Durable finish - The coated steel wire fan guard, coated external fasteners, and pretreated G90-equivalent galvanized steel chassis • Quality coils - High efficiency microchannel aluminum coil, protected from mechanical damage by a proven stamped steel coil guard design. Low operating sound levels - Developed using CFD and FEA tools, the sturdy cabinet and top design provides sound performance of 76 dBA or

 Iower.
 Better Service Access - Diagonal base valves with open access for low-loss fittings, single panel access to the electrical controls, full corner access, and removable fan guard allow easy access for unit maintenance.


Printed 07/11/2024

Standard 1-year limited parts warranty
 Standard 5-year limited compressor warranty

Information is subject to change without notice. Check local codes.

		al Split ^{Outdoor}	Page:
Project Name: Magic Noodle 2 - Atlas Mechanical	800000		TCD2B60531
Quantity: 1			TCD2B60531
Factory In	nstalle	d Options	
TCD	2B60	<u>S31S</u>	
Equipment Options		Option(s) Selected	
Brand:	Т	York Brand	
Unit Type:	С	Air Conditioner	
Efficiency:	D2	13.4 SEER2 Series	
Refrigerant:	В	R410a Refrigerant	
Nominal Cooling Capacity:	60	5 Ton	
Stage:	S	Single Stage	
Voltage:	3	208/230-3-60	
Product Generation:	1		
Controls:	S	Standard Controls	

formation is subject to change without notice. Check local codes.

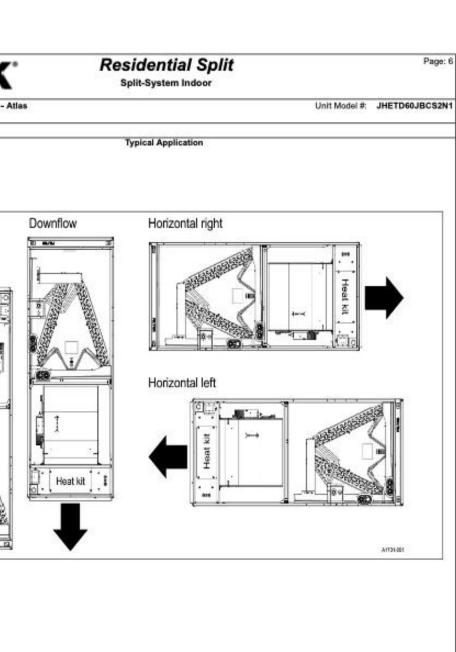

Information is subject to change without notice. Check local codes.


Printed 07/11/2024


COPYRIGHT 2024	CONSTRUCTION As Noted on Plans Review Development Services Department Lee's Summit, Missouri
CORNERSTONE ARCHITECT, LLC	8117 NW ROBERTS ROAD KANSAS CITY, MISSOURI 64152 816.838.3472 CORNERSTONEARCHITECTLLC@GMAIL.COM
PROJECT: MAGIC NOODLEE 1020 NW PRYOR ROAD LEE'S SUMMIT, MISSOU SUN KA A-8055 A-	SUITE 102 JRI
A102 PROPOSE A103 DETAILS + A104 PROP. ME A104.2 PROP.ME M200 MECHANI E200 POWER FL LIGHTING E201 ROOF POW E300 ELECTRICA P200 SANITARY PLUMBINO P201 WATER & PLUMBINO MP300 MECH. DE MP301 MECH. SC	GE FLOOR PLAN D FLOOR PLAN SCHEDULES CH. ROOF PLAN CH. ROOF PLAN CH. ROOF PLAN CAL PLOOR PLAN CAL PLOOR PLAN CAL PLOOR PLAN CAL PLOOR PLAN SCHEDULE VASTE & VENT G PLAN NATURAL GAS G PLAN TAILS HEDULE HEDULE HEDULE PT.2 ATIONS
M/E/P: GLADFELTER ENGIN 10233 MILLSTONE D LENEXA, KANSAS 66220 TEL: 816-916-4675 EMAIL: GPG@AECOI ISSUE PACKA NO: DATE	DRIVE, #4111 NSORT.COM
1 CITY COMMI	ENTS 06/28/2024
date drawing PROPO ROOF F	
SCALE $\frac{1}{4}$ " = 1	1'0"

RELEASED FOR

HEET	NUMBER



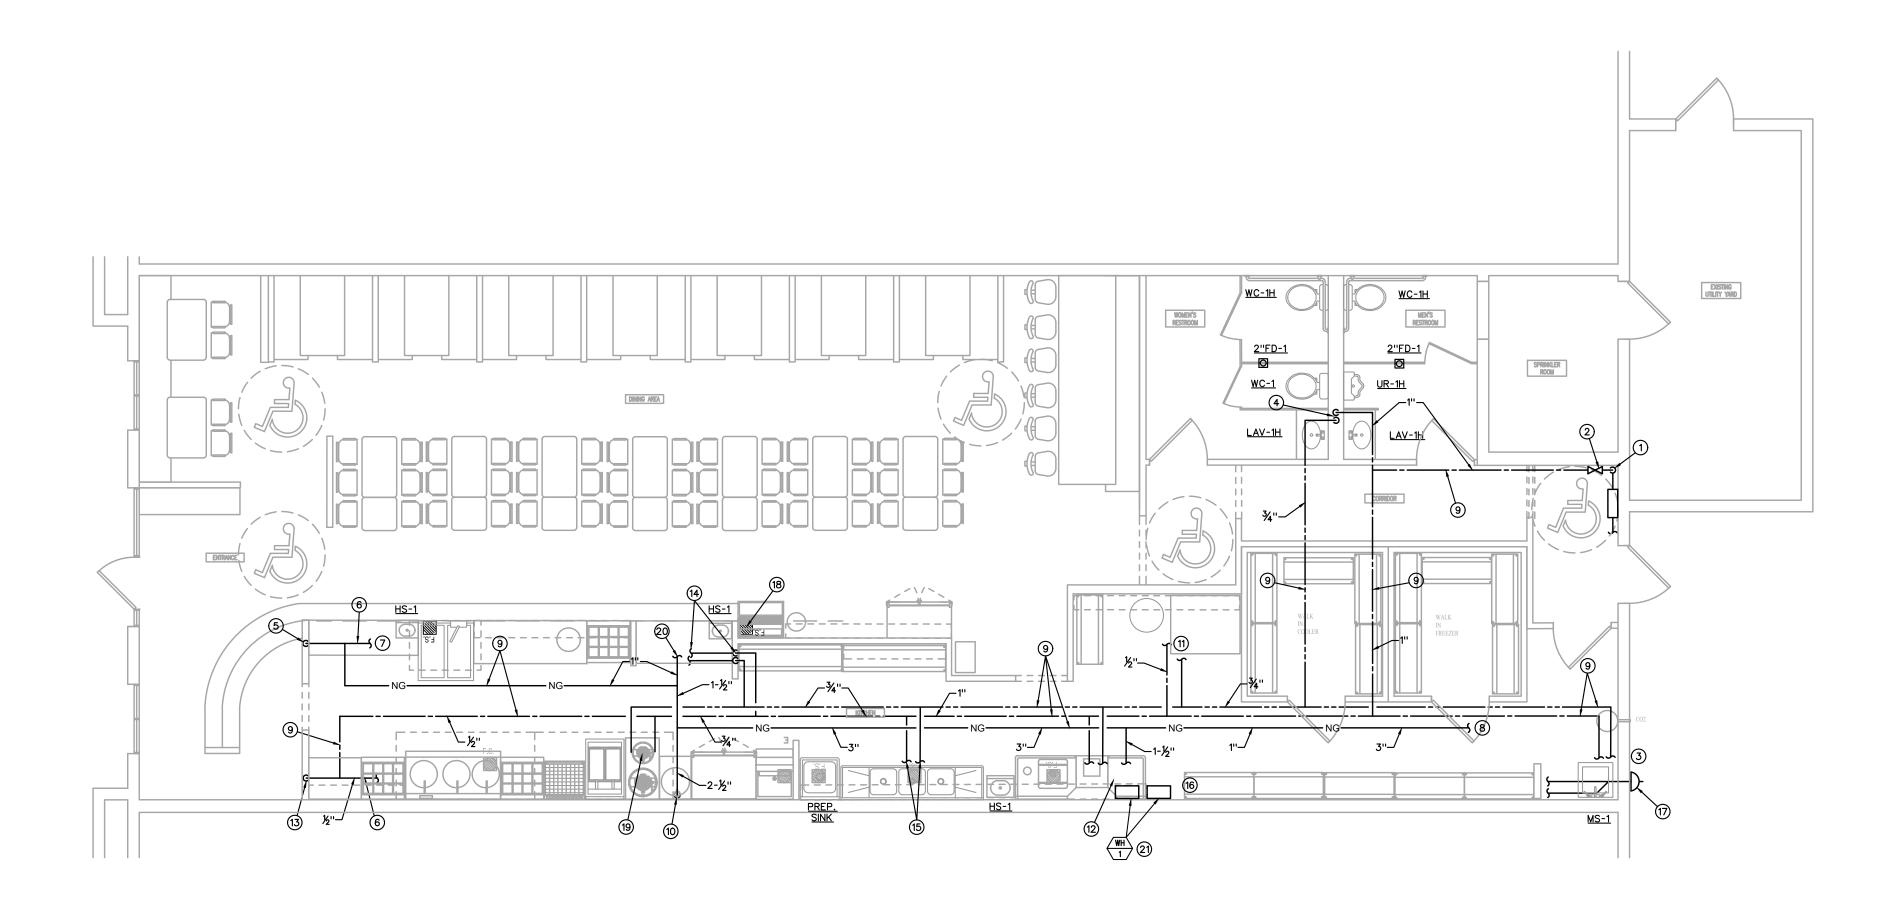

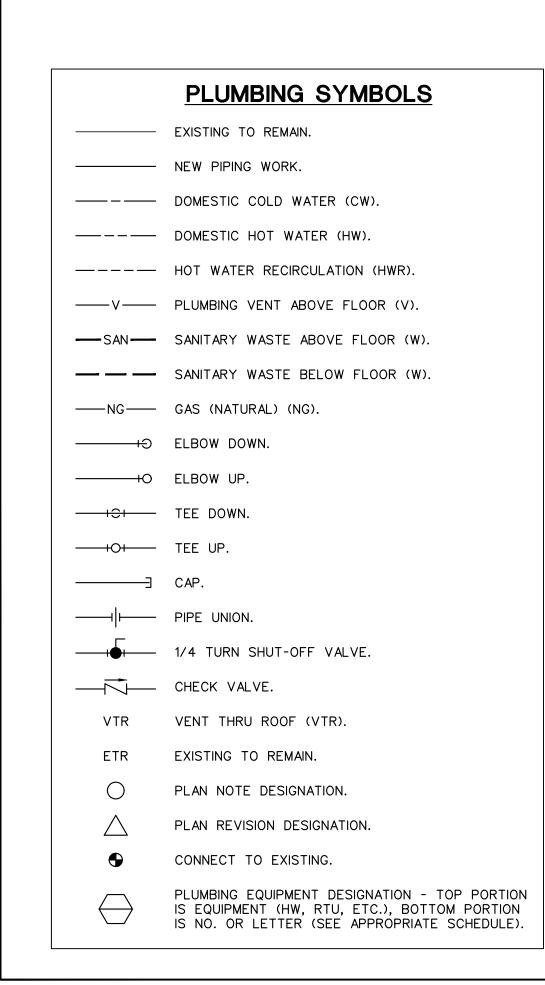




PLUMBING PLAN NOTES (#):

- 1. EXISTING 1" CW.
- 2. CONNECT NEW 1" CW TO EXISTING 1" CW.
- 3. EXTEND 1/2" CW AND HW TO MS-1.
- 4. 1" CW AND 3/4" HW DOWN IN WALL. EXTEND 1/2" CW TO EACH LAVATORY AND WATER CLOSET, 1/2" HW TO EACH LAVATORY, 3/4" CW TO URINAL.
- 5. 1" NG DOWN IN WALL TO BELOW COUNTER.
- 6. NG PIPING BELOW COUNTER OR BEHIND APPLIANCES.
- 7. EXTEND 1" NG TO PASTA COOKER. SEE "GAS RISER DIAGRAM #2", SHEET MP300, FOR CONTINUATION OF PIPING.
- 8. EXTEND 3" NG TO EXISTING NG METER.
- 9. PIPING ABOVE CEILING.
- 10. 2-1/2" NG DOWN TO KITCHEN APPLIANCES. SEE "GAS RISER DIAGRAM #1", SHEET MP300, FOR CONTINUATION PIPING.
- 11. EXTEND 1/2" CW AND HW TO FAUCET AT MIXER.
- 12. 1" CW TO WATER HEATERS AND 1" HW FROM WATER HEATERS. SEE "DOMESTIC WATER HEATER PIPING DIAGRAM", SHEET MP 300, FOR PIPING ARRANGEMENT.
- 13. 1/2" CW DOWN IN WALL. EXTEND 1/2" CW TO WOK.
- 14. 3/4" CW AND HW DOWN IN WALL TO BELOW COUNTER. EXTEND 1/2" CW TO PASTA COOKER, 1/2" CW AND HW TO HS-1 (2 PLACES).
- 15. 3/4" CW AND HW EXTEND 1/2" CW AND HW TO FAUCETS AT 3-COMPARTMENT SINK, PREP. SINK AND HAND SINK, 1/2" CW TO ICE MACHINE (ON OTHER SIDE OF WALL). INSTALL BACK FLOW PREVENTER ON WATER SUPPLY TO ICE MACHINE.
- 16. 1-1/2" NG TO WH-1A AND 1B. EXTEND 1-1/4" NG TO EACH.
- 17. CONCENTRIC VENT/COMBUSTION AIR INTAKE/VENT FOR WH-1A AND WH-1B (SEPARATE FOR EACH WATER HEATER). VENT SIZES PER WATER HEATER MANUFACTURER.
- 18. 1/2" CW TO BEVERAGE EQUIPMENT. INSTALL BACKFLOW PREVENTERS AS REQUIRED BY THE CODE. SEE "BACKFLOW PREVENTER SCHEDULE" ON SHEET MP302.
- 19. 1/2" CW AND HW TO SOUP STOCK FAUCET.
- 20. EXTEND 1" NG TO MAU-1.
- 21. EXTEND 3/4" HW TO DISHWASHER.

PLUMBING GENERAL NOTES

- A) ALL FIXTURES USED SPECIFICALLY FOR HANDWASHING PURPOSES (LAVATORIES, HAND SINKS, ETC.) SHALL BE PROVIDED WITH A TEMPERING VALVE TO TEMPER THE HOT WATER TO THE FIXTURE (MAXIMUM OF 105-DEGREES F).
- B) SEE "PLUMBING RISER DIAGRAMS", SHEET MP300, FOR PIPING NOT SHOWN ON THE PLANS.
- C) REFER TO FOOD SERVICE DRAWINGS FOR SINKS, EQUIPMENT AND APPLIANCES PROVIDED BY THE KEC.
- D) PC SHALL ROUGH-IN AND MAKE FINAL CONNECTION FOR ALL SINKS, EQUIPMENT APPLIANCES AND ACCESSORIES PROVIDED BY THE KEC. 3-COMPARTMENT SINK AND HAND SINK, AND ASSOCIATED FAUCETS, ARE PROVIDED BY THE KEC. WHERE REQUIRED, PC TO PROVIDE BASKET STRAINER DRAIN, TAILPIECE, 3/8-INCH FLEXIBLE RISERS W/ANGLE SUPPLIES WITH LOOSE KEY STOPS, 1-1/2-INCH INLET/2-INCH OUTLET CHROME PLATED CAST BRASS "P" TRAP W/CLEANOUT PLUG AND ESCUTCHEON W/SET SCREW.
- E) CONTRACTOR SHALL CONSULT WITH KANSAS GAS TO DETERMINE IF EXISTING GAS METER HAS SUFFICIENT CAPACITY TO SUPPORT 1,889 CFH.

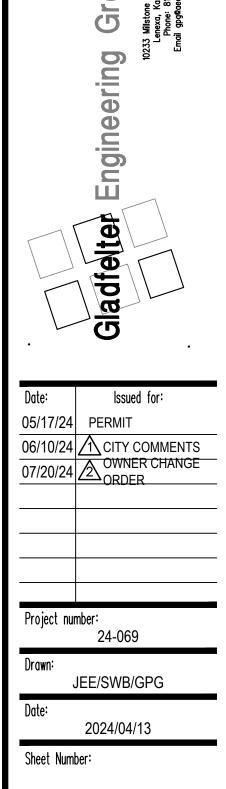

P201


dno



RELEASED FOR CONSTRUCTION As Noted on Plans Review pment Services De Lee's Summit, Missouri 08/09/2024

Μ \square MIT 00 00 М М z≿ O d o $\overline{\Omega} \ge 0$ A ̈́ο ̈́Ш Žo^Ľ Ñ 9

Gladfelter Engineering Group assumes design responsibility for this project for only the mechanical, plumbing and electrical disciplines with drawing sheet number beginning with M, P and E. All other drawings should be considered the work of others. Further, drawings in this project set may contain drawing information, including but not limited to: architectural plans, sections and elevations, site plans and surveys and other information pertinent to showing th mechanical, plumbing and electrical work which is furnished by others, generally indicated by screened or light type. Gladfelter Engineering Group assumes no responsibility or liability for the accuracy or regulatory compliance for work prepared by others even though shown on MPE drawings. Gladfelter Engineering Group assumes responsibility only for the design of mechanical, plumbing and electrical disciplines contained herein, generally indicated in bold type

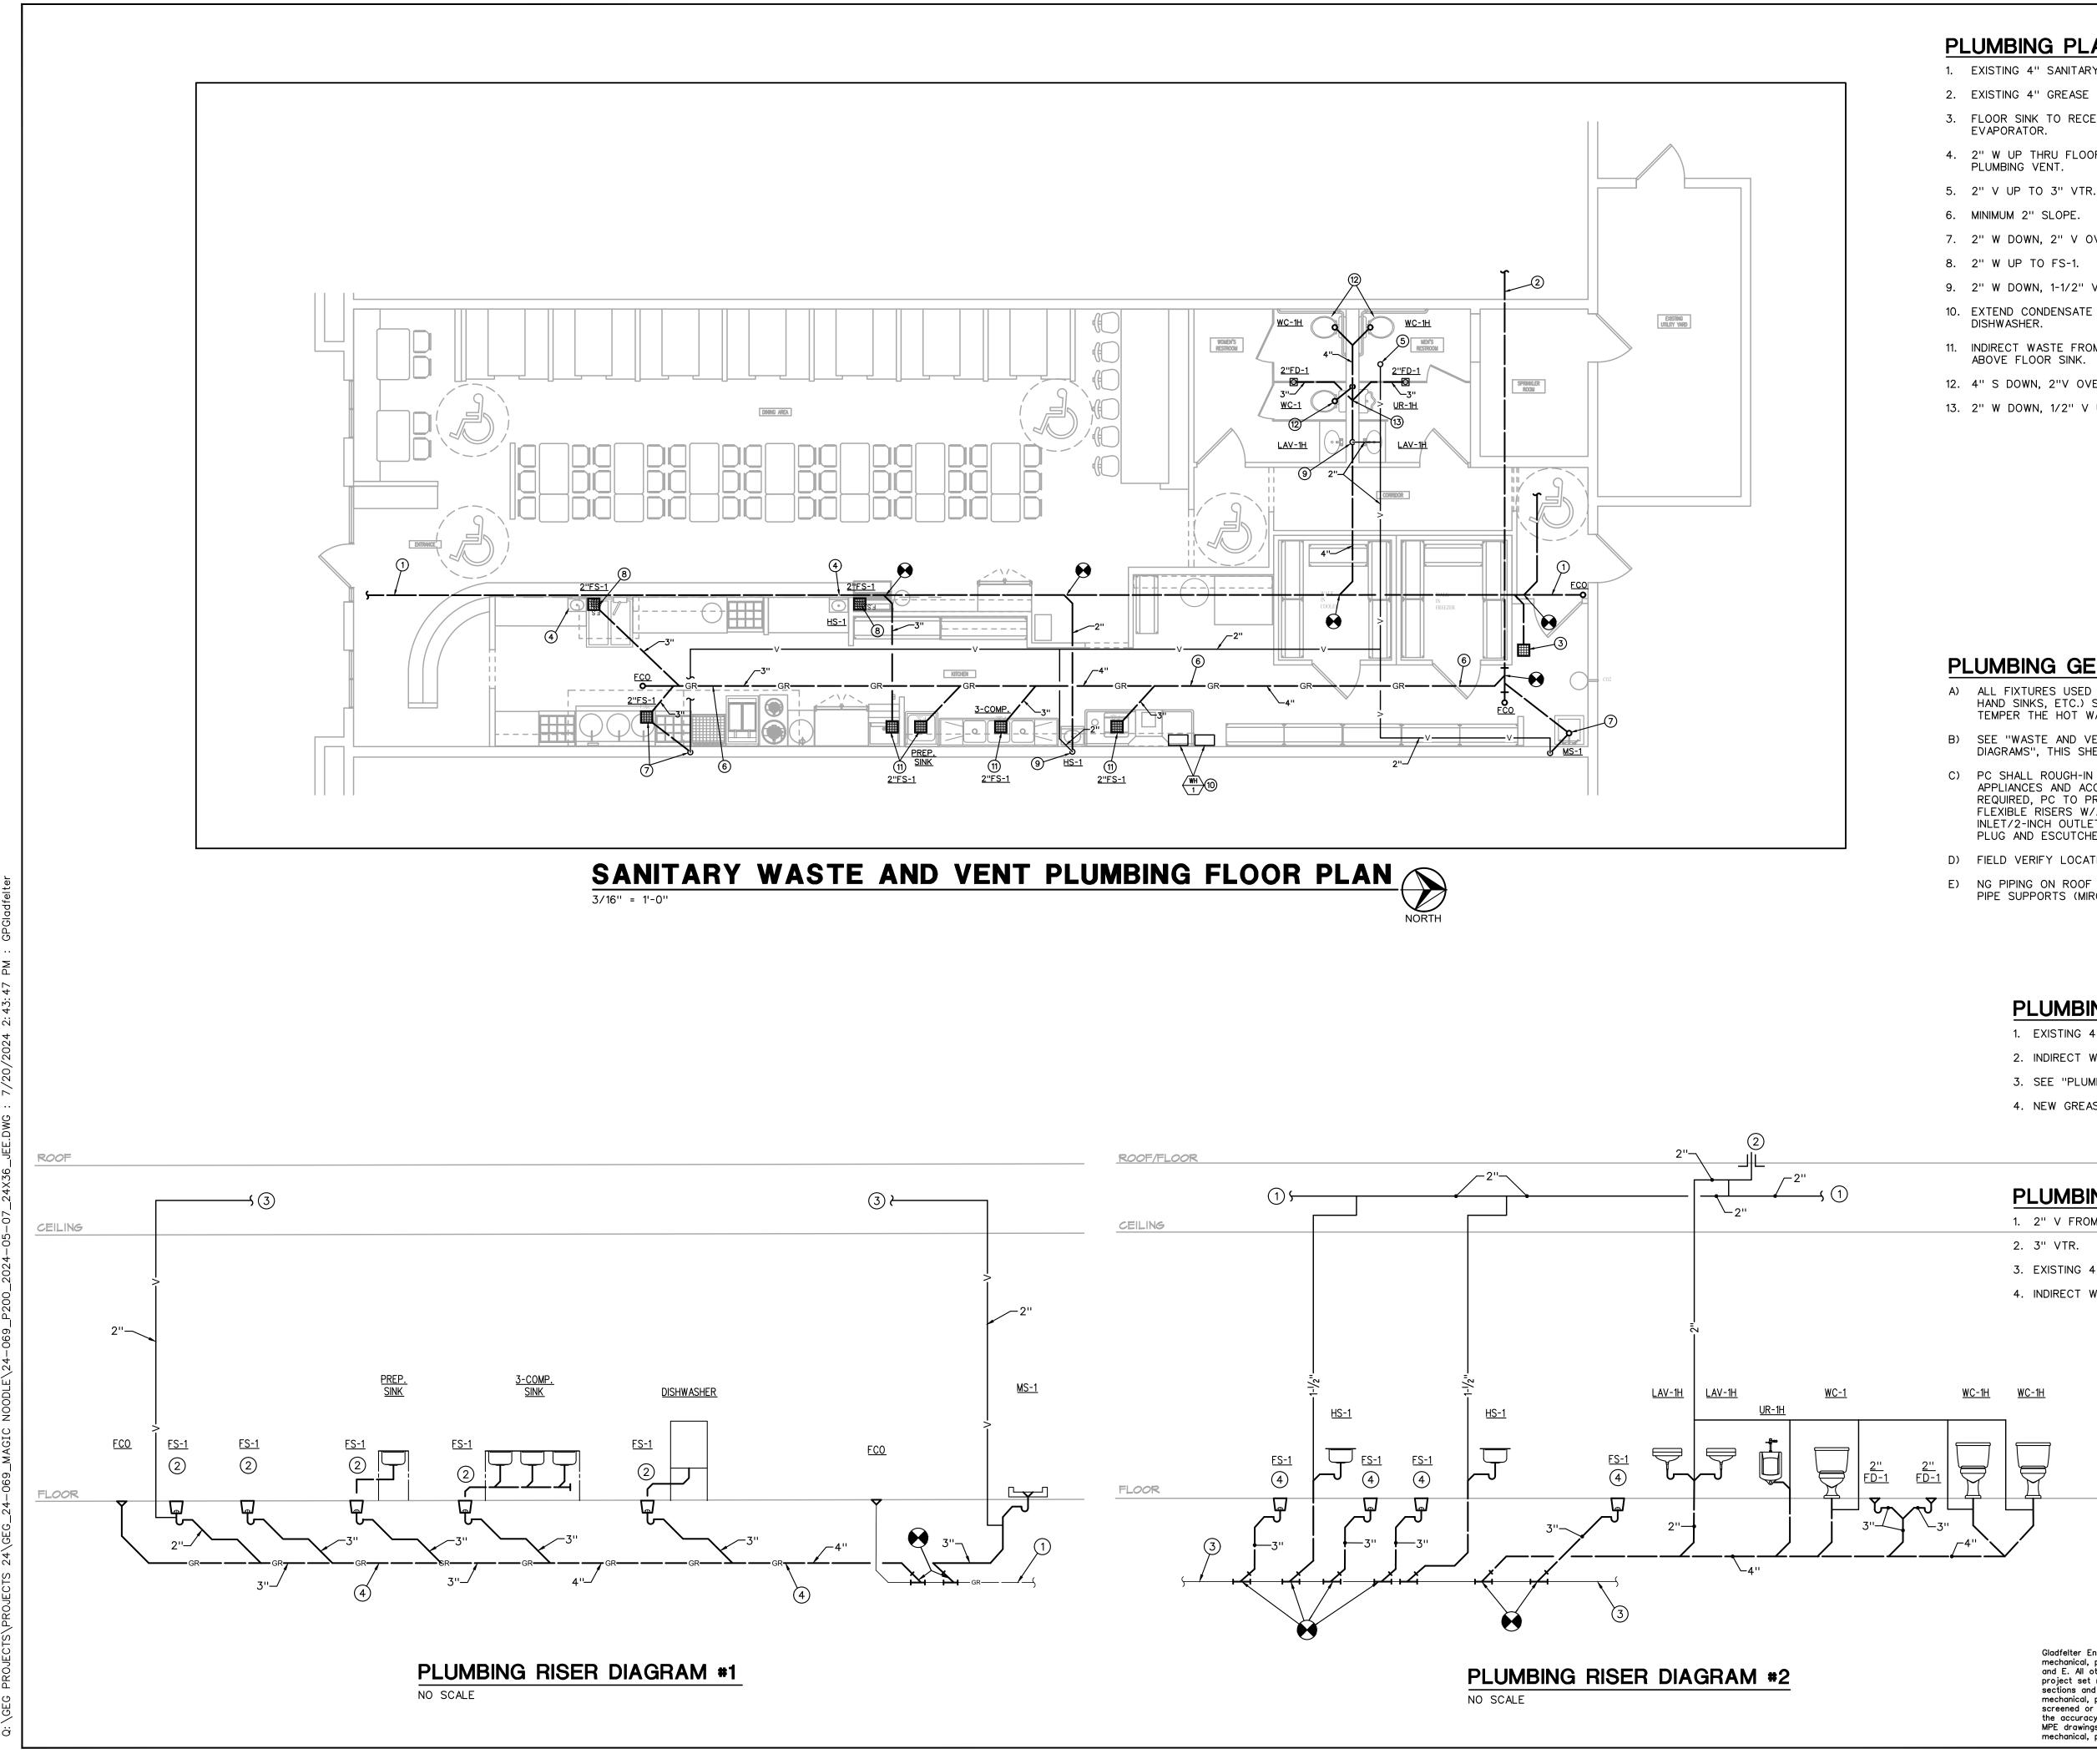

RELEASED FOR CONSTRUCTION As Noted on Plans Review opment Services De Lee's Summit, Missouri 08/09/2024

PLUMBING PLAN NOTES :

- 1. EXISTING 4" SANITARY PIPING.
- 2. EXISTING 4" GREASE WASTE PIPING.
- 3. FLOOR SINK TO RECEIVE CONDENSATE FROM WALK-IN COOLER/FREEZER
- 4. 2" W UP THRU FLOOR TO HS-1. INSTALL AIR ADMITTANCE VALVE IN LIEU OF

- 7. 2" W DOWN, 2" V OVER TO WALL AND ABOVE CEILING.
- 9. 2" W DOWN, 1-1/2" V UP TO ABOVE CEILING.
- 10. EXTEND CONDENSATE FROM WATER HEATERS TO FLOOR SINK BELOW
- 11. INDIRECT WASTE FROM 3-COMP. SINK, PREP. SINKS, DISHWASHER OR ICE MAKER
- 12. 4" S DOWN, 2"V OVER TO WALL AND UP IN WALL.
- 13. 2" W DOWN, 1/2" V UP IN WALL.

PLUMBING GENERAL NOTES


- A) ALL FIXTURES USED SPECIFICALLY FOR HANDWASHING PURPOSES (LAVATORIES, HAND SINKS, ETC.) SHALL BE PROVIDED WITH A TEMPERING VALVE TO TEMPER THE HOT WATER TO THE FIXTURE (MAXIMUM OF 105-DEGREES F).
- B) SEE "WASTE AND VENT RISER DIAGRAMS" AND "DOMESTIC WATER RISER DIAGRAMS", THIS SHEET, FOR PIPING NOT SHOWN ON THE PLANS.
- C) PC SHALL ROUGH-IN AND MAKE FINAL CONNECTION FOR ALL SINKS, EQUIPMENT APPLIANCES AND ACCESSORIES PROVIDED BY THE THE OWNER/KEC. WHERE REQUIRED, PC TO PROVIDE BASKET STRAINER DRAIN, TAILPIECE, 3/8-INCH FLEXIBLE RISERS W/ANGLE SUPPLIES WITH LOOSE KEY STOPS, 1-1/2-INCH INLET/2-INCH OUTLET CHROME PLATED CAST BRASS "P" TRAP W/CLEANOUT PLUG AND ESCUTCHEON W/SET SCREW.
- D) FIELD VERIFY LOCATION AND SIZE OF EXISTING UTILITIES.
- E) NG PIPING ON ROOF SHALL BE SUPPORTED BY MANUFACTURED PILLOW BLOCK PIPE SUPPORTS (MIRO INDUSTRIES MODEL #1.5 OR APPROVED EQUAL).

PLUMBING RISER #1 NOTES


- 1. EXISTING 4" GREASE WASTE PIPING.
- 2. INDIRECT WASTE FOR EQUIPMENT OR SINK ABOVE FLOOR SINK.
- 3. SEE "PLUMBING RISER DIAGRAM #2", THIS SHEET FOR CONTINUATION.
- 4. NEW GREASE WASTE PIPING. SLOPE AT A MINIMUM OF 2%.

PLUMBING RISER #2 NOTES # 1. 2" V FROM GREASE WASTE SYTEM. 3. EXISTING 4" SAN. 4. INDIRECT WASTE FROM EQUIPMENT ABOVE FLOOR SINK.

Gladfelter Engineering Group assumes design responsibility for this project for only the mechanical, plumbing and electrical disciplines with drawing sheet number beginning with M, P and E. All other drawings should be considered the work of others. Further, drawings in this project set may contain drawing information, including but not limited to: architectural plans, sections and elevations, site plans and surveys and other information pertinent to showing mechanical, plumbing and electrical work which is furnished by others, generally indicated by screened or light type. Gladfelter Engineering Group assumes no responsibility or liability for the accuracy or regulatory compliance for work prepared by others even though shown on MPE drawings. Gladfelter Engineering Group assumes responsibility only for the design of mechanical, plumbing and electrical disciplines contained herein, generally indicated in bold type

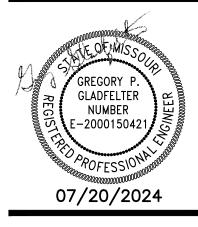

Μ **H Z S** \square NIT,00 Z≿ מה ב MAGIC 20 SW PF LEE'S SI 9

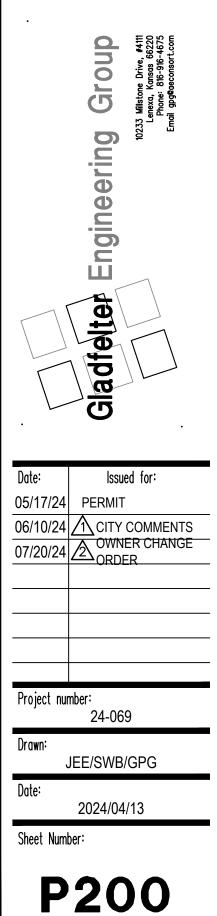

A.	INSTALLATION SHALL BE IN ACCORDANCE WITH THE LATEST EDITION OF N.E.C., NFPA 90A AND 101 AND ALL STATE AND LOCAL CODES, ORDINANCES AND RECULATIONS	Ν	NSTALLATION IECHANICAL A
	REGULATIONS. PLANS AND SPECIFICATIONS SHALL TAKE PRECEDENCE OVER THE CODE WHERE CODE REQUIREMENTS ARE EXCEEDED.	B. F	OCAL CODES, LANS AND SF ODE REQUIRE
C.		С. С	RAWINGS ARE ESIGN CONCE ITTING OR FE OR AN INSTA
D.	FURNISH MATERIALS AND LABOR FOR A COMPLETE AND OPERATIONAL ELECTRICAL INSTALLATION.	D. F	
E.	MATERIAL AND EQUIPMENT SHALL BE NEW AND SHALL BEAR THE 'UL' LABELS AS REQUIRED.	S	QUIPMENT AN
F.	REFER TO ARCHITECTURAL AND STRUCTURAL DRAWINGS FOR DIMENSIONS. DO NOT SCALE MECHANICAL DRAWINGS. CONFORM TO ARCHITECTURAL AND STRUCTURAL REQUIREMENTS FOR EXACT PLACEMENT AND LOCATION OF EQUIPMENT AND FOR REQUIRED STRUCTURAL SUPPORT, BRACING AND	5	EFER TO STE TRUCTURAL S UPPLEMENTAL
G.	REINFORCEMENT. E.C. SHALL VERIFY ALL CONDITIONS PRIOR TO ANY ROUGH-IN.	N	ANUFACTURE
н.	E.C. SHALL COORDINATE LOCATIONS OF ALL DEVICES, SUCH AS LIGHT SWITCHES, CONVENIENCE RECEPTACLES, TELEVISION OUTLETS, AND TELEPHONE OUTLETS WITH ARCHITECTURAL DRAWINGS PRIOR TO ANY ROUGH-IN.	G. V	ELEARANCE RE ERIFY ALL E
Ι.	VERIFY ALL EQUIPMENT TO BE INSTALLED (WHETHER FURNISHED BY THIS CONTRACTOR OR BY OTHERS). CONFIRM WITH VENDOR CONNECTION SIZES, TYPES AND LOCATION AND PROVIDE MATCHING CONDUIT CONNECTIONS, SIZES AND TYPES AFTER EQUIPMENT PROCUREMENT. PROVIDE ALL FITTINGS AND	т А Н. С	YPES AND LO YPES AFTER CCESSORIES COORDINATE E RCHITECTURA
J.	ACCESSORIES FOR A COMPLETE CODE COMPLIANT WORKING INSTALLATION. ALL EQUIPMENT SHALL BE INSTALLED PER MANUFACTURER'S REQUIREMENTS AND		AULK AND SE
К.	PER LISTINGS. ALL ELECTRICAL EQUIPMENT SHALL BE INSTALLED TO PROVIDE MANUFACTURER'S RECOMMENDED OPERATING AND SERVICE CLEARANCES FOR ALL EQUIPMENT.	J. A S	BOVE GROUN OLVENT CEM IR PLENUMS.
	EC SHALL VERIFY RATINGS, LOCATIONS, AND CONNECTIONS OF ALL EQUIPMENT PROVIDED BY OTHERS AND INSTALLED AND/OR CONNECTED BY THE ELECTRICAL	к. А	CREWED JOIN
м.	CONTRACTOR. COORDINATE EXACT LOCATIONS AND ORIENTATION OF EQUIPMENT WITH ARCHITECTURAL AND STRUCTURAL REQUIREMENTS.	L. S	REE SOLDER ERVICE VALV 50 LB. LEAD
N.		^	ND TEE SEAT
	PROVIDING FOR ACCESS INTO SPACES WHERE WORK IS TO OCCUR. CONTRACTOR IS RESPONSIBLE FOR ALL DAMAGES ASSOCIATED WITH CONSTRUCTION ACTIVITY. HE SHALL RESTORE REPAIRED OR REMODELED AREAS		HERE CHILLE
	CONSTRUCTION ACTIVITY. HE SHALL RESTORE REPAIRED OR REMODELED AREAS TO EXISTING CONDITIONS AND NEW CONSTRUCTION AREAS TO NEW CONDITION. ALL REPAIRS SHALL BE IN ACCORDANCE WITH THE APPLICABLE ARCHITECTURAL AND STRUCTURAL PROVISIONS. TO THE GREATEST EXTENT POSIBLE, EXISTING BUILDING MATERIALS SHALL NOT BE DISTURBED.	0. N V N	RAINED, PRO' IATURAL GAS /ITH THREADE IATURAL GAS
P.	THE COMPONENTS OF THE ELECTRICAL SYSTEM SHALL BE WARRANTED FOR A PERIOD OF ONE YEAR FROM THE DATE OF ACCEPTANCE THEREOF EITHER FOR BENEFICIAL USE OR FINAL ACCEPTANCE, WHICHEVER IS EARLIER, AGAINST DEFECTIVE MATERIALS, DESIGN AND WORKMANSHIP.	P. 0	E PROTECTED LUMBING COE AS SERVICE
Q.	ALL WIRING SHALL BE INSTALLED IN CONDUIT. EMT CONDUIT WITH SET SCREW FITTINGS MAY BE UTILIZED WHERE PERMITTED BY CODE. MINIMUM CONDUIT SIZE SHALL BE 1/2".	C	EG AND UNIO ONNECTORS
R.	CONTRACTOR SHALL FIELD VERIFY EXACT ROUTING OF ALL CONDUITS TO NEW EQUIPMENT.	V S	/ITH ALL SER MOKE/FLAME
	ALL NEW BRANCH CIRCUIT CONDUITS SHALL BE INSTALLED CONCEALED ABOVE LAY-IN CEILING OR IN WALLS WHERE POSSIBLE. CAULK AND SEAL ALL RACEWAY PENETRATIONS OF EXTERIOR OR DEMISING	R C A E	LUMBING FIXT EQUIRED TRIN OMPLIANT INS RRESTORS, S ACH GROUP
U.	WALLS. ALL WIRING SHALL BE COPPER WITH 600 VOLT INSULATION AND COLOR CODED.	S. N	OCATION OF
V.	EXPOSED LOCATIONS. CONDUCTORS SHALL BE MINIMUM #12 GAUGE AND COPPER.	F	IANDICAP ACC IANDI-LAV-GAI
W.	MC CABLE SHALL NOT BE USED FOR HOMERUNS. ALL WIRING DEVICES SHALL BE RATED 20 AMP, OR AS NOTED.	F	LL FIXTURES
	INSTALL BLANK COVER PLATE ON ALL PULL BOXES AND JUNCTION BOXES. NEW CIRCUIT BREAKERS INSTALLED IN EXISTING PANELBOARD SHALL MATE/MATCH	F	N GENERAL A PARALLEL TO BOVE CEILING
	PANEL CONSTRUCTION AND AIC RATING.		UPPORT ALL
Ζ.	DUCT SMOKE DETECTOR SHALL BE 120 VOLT, PHOTO-ELECTRIC, REMOTE ALARM LAMP, WITH SAMPLING TUBES - INSTALLED IN RETURN AIR DUCT. PROVIDE WITH MIN-ALERT SOUNDER. STROBE AND REMOTE TEST/RESET STATION. WIRE DETECTORS SO THAT UPON SENSING SMOKE UNIT AUTOMATICALLY SHUTS DOWN	<u>۷</u>	LL WATER BI ALVES AT LO ITH OWNER'S
	AND SOUNDER/STROBE IS ACTIVATED. PROVIDE ALL RELAYS AND ACCESSORIES REQUIRED FOR COMPLETE INSTALLATION. EQUIPMENT SHALL BE BY EDWARDS, SIMPLEX, PYROTRONICS, OR NOTIFER.	X. F	
AA.	TYPEWRITTEN PANELBOARD DIRECTORY SHALL BE PROVIDED FOR PANELBOARD AND CORRECTLY FILLED OUT.	Т	HAN 1/8" PE
	DISCONNECT SWITCHES SHALL BE HEAVY DUTY TYPE, NEMA 1 FOR INDOOR AND NEMA 3R FOR OUTDOOR INSTALLATIONS. MANUFACTURED BY SQUARE D, ITE/SIEMENS, GE, OR CUTLER-HAMMER.	C 7. F	-1/2" AND S OORDINATED ROVIDE DIELE
cc.	PROVIDE LIGHT FIXTURES AS SCHEDULED OR SELECTED BY OWNER WITH ALL REQUIRED TRIM AND ACCESSORIES FOR A COMPLETE WORKING AND CODE COMPLIANT INSTALLATION. REFER TO THE ARCHITECTURAL PLANS FOR EXACT LOCATION OF THE FIXTURES.	BB. C	UPPORT ALL IEMBERS, NOT UCTWORK FA
DD.	ALL LIGHT FIXTURES AND DEVICES MOUNTED IN CEILING SHALL BE BRACED TO RESIST SEISMIC FORCES IN ACCORDANCE WITH IBC, NEC, AND LOCAL AUTHORITY HAVING JURISDICTION.	CC. A N	MACNA STAN
EE.	EMERGENCY AND EXIT LIGHT FIXTURES SHALL BE PROVIDED WITH BATTERY BACK-UP FOR MINIMUM OF (90) MINUTES. EMERGENCY AND EXIT LIGHT FIXTURES SHALL BE CONNECTED TO HOT LEG OF CIRCUIT, NOT SWITCHED.	L N C	ONGITUDINAL OTED. ROUNE OLLARS WITH
FF.	VOICE/DATA AND THERMOSTAT OUTLET BOXES SHALL BE PROVIDED AND INSTALLED WITH 3/4" CONDUIT STUBBED UP OUT TOP OF BOX TO ABOVE ACCESSIBLE CEILING. PROVIDE BUSHING ON END OF CONDUIT.		
GG.	VOICE/DATA SYSTEMS, ASSOCIATED WIRING, AND DEVICES TO BE PROVIDED BY OWNER.		
HH.	AT COMPLETION OF THE INSTALLATION, TEST ELECTRICAL SYSTEMS PER INDUSTRY STANDARDS.		

AL/PLUMBING SPECIFICATION

HALL BE IN ACCORDANCE WITH THE 2018 INTERNATIONAL D PLUMBING CODES, NFPA 90A AND 101 AND ALL STATE AND ORDINANCES AND REGULATIONS.

CIFICATIONS SHALL TAKE PRECEDENCE OVER THE CODE WHERE ENTS ARE EXCEEDED.

DIAGRAMATIC AND ARE INTENDED TO INDICATE THE GENERAL T. THEY DO NOT NECESSARILY INDICATE EACH AND EVERY TURE. THE CONTRACTOR SHALL PROVIDE ALL ITEMS NECESSARY _ATION THAT IS COMPLETE IN EVERY RESPECT.

HITECTURAL AND STRUCTURAL DRAWINGS FOR DIMENSIONS. DO CHANICAL DRAWINGS. CONFORM TO ARCHITECTURAL AND EQUIREMENTS FOR EXACT PLACEMENT AND LOCATION OF FOR REQUIRED STRUCTURAL SUPPORT, BRACING AND

CTURAL DRAWINGS FOR SPECIFIC REQUIREMENTS CONCERNING PPORTS AND MOUNTINGS FOR MECHANICAL EQUIPMENT AND

AND PLUMBING EQUIPMENT SHALL BE INSTALLED TO PROVIDE S RECOMMENDED OPERATING AND SERVICE CLEARANCES FOR ALL CONTRACTOR IS RESPONSIBLE FOR DIMENSIONS AND DIFFERING UIREMENTS OF ACTUAL EQUPIMENT FURNISHED.

UIPMENT TO BE INSTALLED (WHETHER FURNISHED BY THIS R BY OTHERS). CONFIRM WITH VENDOR CONNECTION SIZES, CATION AND PROVIDE MATCHING PIPING CONNECTIONS, SIZES AND EQUIPMENT PROCUREMENT. PROVIDE ALL FITTINGS AND OR A COMPLETE CODE COMPLIANT WORKING INSTALLATION.

ACT LOCATIONS AND ORIENTATION OF EQUIPMENT WITH AND STRUCTURAL REQUIREMENTS.

ALL PIPING PENETRATIONS OF EXTERIOR WALLS.

WASTE AND VENT PIPING SHALL BE SCHEDULE 40 PVC WITH NT JOINTS, EXCEPT USE STANDARD WEIGHT NO-HUB CAST IRON IN (ENT PIPING MAY BE SCHEDULE 40 GALVANIZED STEEL WITH S. PAINT ALL EXTERIOR PIPING WITH UV RESISTANT PAINT.

WATER PIPING SHALL BE TYPE 'L' HARD COPPER WITH LEAD IOINTS OR CROSS-LINKED POLYETHYLENE (PEX) PLASTIC TUBING.

S FOR WATER PIPING SYSTEMS UP THRU 2" SHALL BE 1/4 TURN, REE BRASS BALL VALVES WITH BRONZE CHROME PLATED BALL 5, NIBCO S-585-70 (SOLDER) OR PXCP400-LF (PEX) CONNECTION.

ATE PIPING AND TRAPS SHALL BE PVC. TRAP CONDENSATE FULL DISCHARGE AND TERMINATE AS SHOWN.

CONDENSATE FROM INDOOR UNITS CANNOT BE POSITIVELY DE CONDENSATE PUMP ACCESSORY WITH THE EQUIPMENT.

PIPING (ABOVE GROUND) SHALL BE SCHEDULE 40 BLACK STEEL JOINTS. CONNECT USING JOINT COMPOUND SUITABLE FOR PIPING. ALL EXPOSED BLACK STEEL NATURAL GAS PIPING SHALL WITH A RUST INHIBITING COATING IN ACCORDANCE WITH THE

ALVES TO BE LUBRICATED PLUG COCKS, ROCKWELL 142 OR 143. O EQUIPMENT SHALL HAVE SERVICE VALVES, 6'' MINIMUM DIRT OR AT CONTRACTOR OPTION, UL LISTED APPLIANCE FLEXIBLE AY BE USED.

TIC WATER PIPING SHALL BE INSULATED WITH 1" FIBERGLASS CE JACKET OR COMPARABLE UNICELLULAR INSULATION WITH ATING OF 25/50. INSULATION IS NOT REQUIRED FOR PEX PIPING

IRES AND EQUIPMENT PROVIDED BY OTHERS. PROVIDE ALL AND ACCESSORIES FOR A COMPLETE WORKING AND CODE FALLATION. PROVIDE STOP VALVES AND WATER HAMMER ZED AS INDICATED OR PER MANUFACTURER FOR EACH FIXTURE OR F FIXTURES. REFER TO THE ARCHITECTURAL PLANS FOR EXACT HE FIXTURES.

JIREMENTS OF THE ADA FOR ALL FIXTURES REQUIRED TO BE SSIBLE. INSULATE PIPING BENEATH HANDICAP FIXTURES PER ADA, SYSTEM OR EQUIVALENT.

AND EQUIPMENT SHALL BE INSTALLED PER MANUFACTURER'S AND PER LISTINGS.

D EXCEPT AS OTHERWISE NOTED, PIPING SHALL BE INSTALLED COLUMN AND BUILDING WALL LINES. THEY SHALL BE CONCEALED G, IN CHASES OR WALL CONSTRUCTION WHERE POSSIBLE.

PIPING SYSTEMS IN ACCORDANCE WITH MANUFACTURER AND INDUSTRY STANDARDS TO PREVENT SAGS AND DIPS.

ARING PIPING SHALL BE SLOPED FOR DRAINAGE WITH BALL DRAIN W POINTS. COORDINATE SYSTEM DRAINAGE FOR WINTERIZATION UTILITIES CONTRACTOR.

S PANELS TO PROVIDE ACCESS TO INACCESSIBLE VALVES THAT THENT OR REPLACEMENT.

S SHALL BE SLOPED IN ACCORDANCE WITH CODE, BUT NOT LESS FOOT FOR 3'' AND LARGER PIPING AND 1/4'' PER FOOT FOR ALLER PIPING. CONNECTION TO UTILITIES PROVIDED SHALL BE (ITH OWNER'S UTILITY CONTRACTOR..

TRIC UNIONS AT ALL CONNECTIONS BETWEEN DISSIMILAR METALS.

METAL DECK.

RICATION AND INSTALLATION SHALL BE IN ACCORDANCE WITH

SHALL BE SHEET METAL, CONSTRUCTED TO SMACNA STANDARDS, WG PRESSURE CLASS AND SEAL CLASS 'C' MINIMUM. ALL ND TRANSVERSE JOINTS TO BE SEALED, EXCEPT AS OTHERWISE AND FLEX DUCT CONNECTIONS SHALL BE MADE WITH SPIN EXTRACTORS AND VOLUME DAMPERS.

- DD. DUCT SIZES SHOWN ARE CLEAR INSIDE DIMENSIONS.
- EE. ALL DUCTWORK EXPOSED ON THE ROOF SHALL BE INSULATED AND ENCLOSED IN A WATERPROOF COVERING MATERIAL. GREASE DUCT INSULATION SHALL BE SUITABLE FOR HIGH TEMPERATURE USE.
- FF. PROVIDE FLEXIBLE CONNECTORS AT ALL DUCTWORK CONNECTIONS TO ROTATING EQUIPMENT. CONNECTORS EXPOSED TO SUNLIGHT SHALL BE MADE OF UV RESISTANT MATERIAL.
- GG. DUCT SMOKE DETECTOR AT RTU-1 IS EXISTING TO REMAIN. SEE ELECTRICAL FOR INTEGRATION OF ALL SMOKE DETECTION AND SHUTDOWN OF EQUIPMENT WITH FIRE ALARM SYSTEM IF PROVIDED. ALL EQUIPMENT IN EXCESS OF 2000 CFM SHALL BE EQUIPPED WITH SMOKE DETECTORS IN THE RETURN AIR STREAM. IF A FIRE ALARM SYSTEM IS NOT PROVIDED, PROVIDE AND INSTALL A STROBE/HORN TO NOTIFY OCCUPANTS OF THE SENSING OF SMOKE AT A SMOKE DETECTOR.
- HH. ALL POWER WIRING SHALL BE THE RESPONSIBILITY OF THE ELECTRICAL CONTRACTOR. DISCONNECT SWITCHES SHALL BE FURNISHED BY THE ELECTRICAL CONTRACTOR, EXCEPT WHERE SPECIFICALLY INDICATED TO BE FURNISHED BY THE MECHANICAL CONTRACTOR. COORDINATE REQUIRED POWER FOR EQUIPMENT WITH THE ELECTRICAL CONTRACTOR.
- II. ALL CONTROL DEVICES AND INTERLOCK WIRING SHALL THE RESPONSIBILITY OF THE MECHANICAL CONTRACTOR. CONTRACTOR SHALL FURNISH LOCKING GUARDS FOR DEVICES WHERE INDICATED AND WHERE REQUIRED TO PROTECT THEM FROM PHYSICAL DAMAGE. PROVIDE INSULATED SUBBASES WHERE SENSORS ARE INSTALLED ON 'COLD' OR EXTERIOR WALLS. MOUNT CONTROL DEVICES SUCH AS THERMOSTATS AND SENSORS AT 46" AFF.
- JJ. CONTRACTOR SHALL BE RESPONSIBLE FOR EQUIPMENT HANDLING AND TRANSPORT FOR ITEMS HE FURNISHES AND/OR INSTALLS. HE SHALL BE RESPONSIBLE FOR PROVIDING FOR ACCESS INTO SPACES WHERE WORK IS TO OCCUR.
- KK. CONTRACTOR IS RESPONSIBLE FOR ALL DAMAGES ASSOCIATED WITH CONSTRUCTION ACTIVITY. HE SHALL RESTORE REPAIRED OR REMODELED AREAS TO EXISTING CONDITIONS AND NEW CONSTRUCTION AREAS TO NEW CONDITION. ALL REPAIRS SHALL BE IN ACCORDANCE WITH THE APPLICABLE ARCHITECTURAL AND STRUCTURAL PROVISIONS. TO THE GREATEST EXTENT POSIBLE, EXISTING BUILDING MATERIALS SHALL NOT BE DISTURBED.
- LL. TEST AND CLEAN PIPING SYSTEMS PER INDUSTRY STANDARDS. PRESSURE TEST OF PRESSURE PIPING SHALL BE AT 1-1/2 TIMES THE ANTICIPATED OPERATING PRESSURE, BUT NOT LESS THAN 50 PSIG FOR 2 HOURS. NON-PRESSURIZED SYSTEMS SHALL BE TESTED WITH 10' WATER COLUMN ABOVE NORMAL OPERATING CONDITIONS OR 5 PSI FOR 2 HOURS. THERE SHALL BE NO MEASURABLE DROP DURING THE TEST PERIOD.
- MM. TEST AND BALANCE ALL SYSTEMS PER NEBB STANDARDS. SUBMIT BALANCE REPORTS TO ARCHITECT FOR APPROVAL.

PLUMBING FIXTURE SCHEDULE


- A. INSTALL PLUMBING FIXTURES AND EQUIPMENT IN ACCORDANCE WITH MANUFACTURER'S INSTRUCTIONS. VERIFY ROUGH-IN REQUIREMENTS WITH MANUFACTURER'S DRAWINGS AND INSTALL PER MANUFACTURER'S RECOMMENDATIONS. PROVIDE WATER-CONSERVING FIXTURES AND APPURTENANCES IF/AS REQUIRED BY LOCAL AUTHORITIES. CONFIRM ALL LOCATIONS AND MOUNTING HEIGHTS WITH ARCHITECTURAL DRAWINGS AND/OR SPECIFICATIONS. CAULK FIXTURES TO WALLS/FLOORS. SET COUNTER MOUNTED SINKS AND LAVATORIES IN A BED OF CAULK. THE SPECIFIED PLUMBING FIXTURES, OR APPROVED EQUALS, SHALL BE USED UNLESS OTHERWISE NOTED OR INDICATED.
- B. WATER CLOSET (WC-1H), TOTO #CSC744SL.01, FLOOR-MOUNTED, CONSTRUCTED OF VITREOUS CHINA, MEETING ANSI A-117.1 AND ADA BARRIER-FREE REQUIREMENTS, 17" HIGH, 1.6-GALLON FLUSH, CLOSE-COUPLED TANK DESIGN WITH ELONGATED BOWL AND SIPHON JET ACTION. TANK SHALL BE VITREOUS CHINA WITH COVER, 3/8" FLEXIBLE RISER WITH LOOSE KEY ANGLE STOP VALVE, CHROME-PLATED BRASS TRIP LEVER AND MANUFACTURER'S BOLT CAPS. PROVIDE BENKE #527 WHITE ELONGATED OPEN FRONT SEAT LESS COVER, PERMA BUMPER.
- C. LAVATORY (LAV-1H), TOTO #LT307.4 (20"X18"), WALL-HUNG TYPE, CONSTRUCTED OF VITREOUS CHINA, MEETING ANSI A-117.1 AND ADA BARRIER-FREE REQUIREMENTS. LAVATORY SHALL HAVE 4-INCH FAUCET CENTERS AND DRILLED FOR CONCEALED ARM CARRIER. PROVIDE 3/8-INCH FLEXIBLE RISER W/ANGLE SUPPLIES WITH LOOSE KEY STOPS, 1-1/4-INCH INLET 1-1/2-INCH OUTLET CHROME PLATED CAST BRASS "P" TRAP W/CLEANOUT PLUG AND ESCUTCHEON W/SET SCREW. PROVIDE DELTA #523-WFOGHDF HEAVY DUTY SINGLE LEVER FAUCET, 4-INCH CENTERS, VANDAL-RESISTANT 2.2 GPM AERATOR, PERFORATED OFFSET GRID DRAIN (W/ 1-1/4" TAILPIECE) AND VANDAL-RESISTANT SINGLE LEVER HANDLE. PROVIDE WITH J.R. SMITH CARRIER (TO MATCH WALL TYPE). MOUNT AT ADA HEIGHT AND MAINTAIN CLEARANCES UNDER LAVATORY AS REQUIRED BY ADA REGULATIONS. INSULATE WASTE AND HOT WATER SUPPLY UNDER LAVATORY WITH UNDERSINK PROTECTIVE PIPE COVER, MOLDED, ANTIMICROBIAL, WITH FLUSH REUSABLE FASTENERS, TRUEBRO LAV GUARD.
- D. MOP SINK (MS-1), STERN WILLIAMS #SB-900, CONSTRUCTED OF TERRAZZO, 32" SQUARE BY 12" HIGH (COORDINATE SIZE WITH ARCHITECTURAL PLANS), CHROME-PLATED CAST BRASS DRAIN (CAST INTEGRAL) WITH STAINLESS STEEL CAP. PROVIDE WITH DELTA #28T2383 FAUCET WITH VACUUM BREAKER, LEVER HANDLES, 3/4" HOSE THREAD SPOUT WITH 48" LONG HOSE, WALL SUPPORT, INTEGRAL STOPS AND ROUGH CHROME-PLATED FINISH..
- E. FLOOR DRAINS (FD-1), WADE #1100-G5-1-27. RATED FOR GENERAL LIGHT DUTY USE WITH CAST IRON BODY WITH FLANGE, SEEPAGE OPENINGS,INTEGRAL REVERSING CLAMPING COLLAR, TRAP PRIMER CONNECTION, 5" SQUARE NICKEL BRONZE ADJUSTIBLE STRAINER, SEDIMENT BUCKET AND HEEL PROOF GRATE, PROVIDE WITH SEPARATE DEEP SEAL "P" TRAP (SEE PLANS FOR SIZE).
- F. EQUIPMENT DRAINS (ED-1) WADE #1100-94 ADJUSTABLE CAST IRON FLOOR DRAIN WITH FLANGE, SEEPAGE OPENINGS, INTEGRAL CLAMPING COLLAR, EXTENSION ADAPTER INSTALLED ABOVE THE FLOOR ELEVATION APPROXIMATELY 3/4" TO PREVENT WATER ON THE FLOOR FROM ENTERING DRAIN AND 1/2" PLUGGED TRAP PRIMER CONNECTION. PROVIDE WITH SEPARATE DEEP SEAL "P" TRAP (SEE PLANS FOR SIZE).
- G. SANITARY FLOOR SINKS: <u>FS-1</u> WADE #9130-1-24-27-6 SQUARE PATTERN FLOOR SINK WITH CAST IRON BODY (12" X 12" X 6" DEEP), ACID RESISTING ENAMELED INTERIOR, SEDIMENT BUCKET, TRAP PRIMER CONNECTION AND 12" SQUARE NICKEL BRONZE FRAME AND GRATE. PROVIDE WITH SEPARATE DEEP SEAL "P" TRAP (SEE PLANS FOR SIZE).
- H. FINISHED FLOOR CLEANOUTS; (FFCO) WADE #6000-1-2-S CAST IRON FLOOR CLEANOUT WITH FLANGE, PLASTIC TAPERED PLUG AND SQUARE NICKEL BRONZE ADJUSTABLE TOP. PROVIDE WITH CARPET CLEANOUT MARKER WHEN CLEANOUT IS LOCATED BELOW CARPET. COORDINATE WITH ARCHITECTURAL PLANS.
- I. FINISHED WALL CLEANOUTS: (FWCO) WADE #8560, W/ 8304-85-6 CAST IRON CLEANOUT TEE WITH BRASS PLUG AND 6" ROUND STAINLESS STEEL ACCESS COVER. J.R. SMITH FIGURE 4530. PROVIDE DUCO CAST IRON WALL CLEANOUT TEE WITH COUNTERSUNK PLUG. DELETE COVER PLATE IF CLEANOUT IS IN EXPOSED LOCATION.
- J. ALL FIXTURES USED SPECIFICALLY FOR HANDWASHING PURPOSES (LAVATORIES, HAND SINKS, ETC.) SHALL BE PROVIDED WITH A TEMPERING VALVE TO TEMPER THE HOT WATER TO THE FIXTURE (MAXIMUM OF 105-DEGREES F).
- K. 3-COMPARTMENT SINK, HAND SINKS AND KITCHEN SINKS AND ASSOCIATED FAUCETS ARE PROVIDED BY THE KEC. PC TO PROVIDE BASKET STRAINER DRAIN, TAILPIECE, 3/8-INCH FLEXIBLE RISERS W/ANGLE SUPPLIES WITH LOOSE KEY STOPS, 1-1/2-INCH INLET/2-INCH OUTLET CHROME PLATED CAST BRASS "P" TRAP W/CLEANOUT PLUG AND ESCUTCHEON W/SET SCREW. PC TO PROVIDE OWNER FAUCETS (DELTA OR EQUAL) TO GO ALONG WITH FIXTURES PROVIDED BY THE KEC UNLESS OTHERWISE NOTED. SEE KITCHEN EQUIPMENT PLANS.



RELEASED FOR CONSTRUCTION As Noted on Plans Review

elopment Services Departme Lee's Summit, Missouri 08/09/2024

MAGIC NOODLE 020 SW PRYOR, UNIT B LEE'S SUMMIT, MO

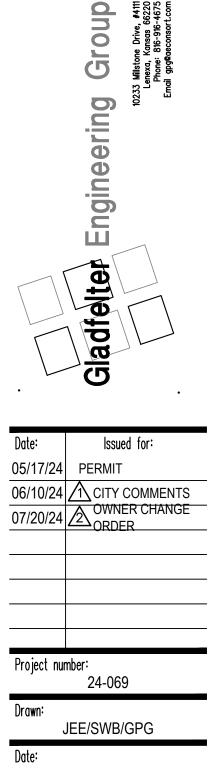


2024/04/13

Sheet Number:

MPE400

Gladfelter Engineering Group assumes design responsibility for this project for only the mechanical, plumbing and electrical disciplines with drawing sheet number beginning with M, P and E. All other drawings should be considered the work of others. Further, drawings in this project set may contain drawing information, including but not limited to: architectural plans, sections and elevations, site plans and surveys and other information pertinent to showing the mechanical, plumbing and electrical work which is furnished by others, generally indicated by screened or light type. Gladfelter Engineering Group assumes no responsibility or liability for the accuracy or regulatory compliance for work prepared by others even though shown on MPE drawings. Gladfelter Engineering Group assumes responsibility only for the design of mechanical, plumbing and electrical disciplines contained herein, generally indicated in bold type.

	HEAT PUMP CONDENSING UNIT SCHEDULE														
	MARK NO. MODEL NO. COOLING HEATING ELECTRICAL REMARKS MARK NO. MODEL NO. TOTAL MBH AMBIENT °F COP VOLT Ø HZ MCA MOCP REMARKS \$ 1 LENNOX MLI4XPI-060-233 56.4 95 12.2 53.5 17 - 208 3 60 18 30 1-4	OUTSID	E AIR SUMMARY (S		AREA	CALCULATED	RATE	AIRFLOW IN	AIRFLOW IN BREATHING ZONE	DISTRIBUTION EFFECTIVENESS (Ez)	OUTDOOR AIRFLOW	OUTDOOR AIRFLOW	OUTDOOR		
	I. PROVIDE WITH 5 YEAR COMPRESSOR WARRANTY, COIL HAIL GUARDS, HEAT PUMP REVERSING VALVE, DEFROST	RTU-6	6 CORR	RIDOR	159	(Pz)	(Rp) 5	0.06	9.54	1.0/0.8	9.54	11.93	12	(CFM)	REMARK
	\langle		WOMEN RI	ESTROOM	112	0		0.12	17.40	1.0/0.8	17.40	21.75			
	4. PROVIDE WITH 0°F LOW AMBIENT HEAD PRESSURE CONTROLS FOR ALL AIR UNITS WITHOUT ECONOMIZER.		1	/		1 1	5	0.06	14.90	1.0/0.8	14.90	18.63			6
			DN) DINING	ROOM	1,102	- 78	- 7.5	0.18	783.36		783.36		980	258	6
						0 91	5	0.06	10.14	1.0/0.8	10.14	12.68		258	
	1A/1B RINNAI CU199IN TANKLESS 15 199 0.5 10 70 5.4 199 189 95% 1-3 NOTES: 1. SE PIPING SCHEMATIC FOR OTHER ACCESSORIES NEEDED. 2. SAFETY FEATURES INCLUDE AIR-FUEL RATIO SENSOR, EXHAUST/WATER TEMPERATURE SAFETY CONTROL	1. ZONE A 2. CALCUL 3. VENTIL 4. BATHRO 5. SPACE 6. MINIMU	LATION DONE IN ACCO ATION AIR PROVIDED E OOM MINIMUM EXHAUS EXHAUST REQUIRED A M KITCHEN EXHAUST	ORDANCE WITH 2 BY DIRECT CONN ST AIR PROVIDED AT THE INDICATE AIR PROVIDED A	018 IMC, CH/ NECTION TO D AT MINIMU ED RATE. T 0.7 CFM/SO	APTER 4. THE OUTDO M 70 CFM PE QUARE FOOT	ORS IN ACCOR ER FIXTURE IN / T IN ACCORDAN	DANCE WITH SECT ACCORDANCE WITH	ON 401, 2018 IMC. CHAPTER 4, 2018 IN 4, 2018 IMC.	MC.	~~~~~	~~~~~	~~ .		
		>													
				SUPPL	.Y	REFF	RIGERANT COIL	SUMMER°, WINTE	R° ELEC. HEAT				-		
	YCUBE-160 YCUBE-160	MANUF ACTURER		VI 0.A. RPI	M S.P.		NO.	NG COOLING MBH		BH TPUT VOLT Ø HZ	Z MCA MOCP	, REMARKS			
	$\begin{array}{c c c c c c c c c c c c c c c c c c c $	NOTES:							- 15		0 49 50	1-4			
	DRAWINGS. MC SHALL INSTALL SYSTEMS PER MANUFACTURER'S INSTRUCTIONS. 2. INTERLOCK TO OPERATE WHENEVER KITCHEN APPLIANCES ARE IN OPERATION. SEE LARKIN DRAWINGS FOR CONTROL DIAGRAMS. 3. PROVIDE CEILING FANS WITH CEILING GRILLE, DISCONNECT SWITCH, HANGER HARDWARE, BACKDRAFT DAMPER, UNIT	4. PROVIDE CONDENS.	ATE SENSOR SHUTDOWN	N AND ALARM ANI	D CONTAINME										
			WATER HA		FSTOR	SCHEDU	IF					BUTION WATER O	QUALITY DEPT.	REQUIREMENTS	
	AIR BALANCE SCHEDULE	H REMARKS										DISHWAS	HER -	RPZ BFF	
	PLAN MARK AREA SERVED AIR CFM AIR CFM NOTES A TITUS S300FL - NOTE 1 DUCT NOTE			SERIES	4 (SINGLI	E FIXT) X						TEA MAK	KERS -	DCVA	
	RTU-5 ALL 750 Second and a second a	4 -	B SIOUX CHIEF	653 B											
	EF-1 KITCHEN HOOD -2064	4 2									[
	EF-3 KITCHEN HOOD -800 X NOTES 1. SEE THE PLANS FOR NECK SIZE.	[X NOTES:	X X	X	×					ON PLANS	\land	- DUCTWORK		$\overline{\}$
	2. PROVIDE DAMPER AT DUCT TAKE-OFF EXCEPT PROVIDE GRILLE MOUNTI DAMPER ABOVE INACCESSIBLE CEILINGS.	ED 1			N IN ACCORI	DANCE									
	OTES: OUTSIDE AIR CFM INDICATED FOR OPERATION IN CONJUNCTION WITH													INING	
	TO MINIMUM OA AS CALCULATED IN "OA CALCULATION" WHEN THESE SYSTEMS ARE OFF.							Water Closet	(fv) 4" 2" 2" 1 ½"	$\frac{1^{2}}{1^{2}}$		DUCT			
		~~~~~~~~~~~~~~~~~~~~~~~~~~~~~~~~~~~~~~~	······	~~~~~~	~~~~~			Sink Triple Sinl	2" 1 ½"	$\frac{\frac{1}{2}''}{\frac{1}{2}''} \frac{\frac{1}{2}''}{\frac{1}{2}''} \frac{\frac{1}{2}''}{\frac{1}{2}'''} \frac{\frac{1}{2}''}{\frac{1}{2}'''} \frac{\frac{1}{2}'''}{\frac{1}{2}'''} \frac{\frac{1}{2}'''}{\frac{1}{2}'''} \frac{\frac{1}{2}'''}{\frac{1}{2}''''} \frac{\frac{1}{2}''''}{\frac{1}{2}''''''''} \frac{\frac{1}{2}'''''}{\frac{1}{2}''''''''''''''''''''''''''''''''''$	LOW VELOCITY	DUCTS:			L INSULATION 2" OTH
								Water Fount Janitor Sink	(flr) <u>3</u> " <u>2</u> "	$\frac{1}{12}$ $\frac{1}{12}$ $\frac{1}{12}$ $\frac{1}{12}$ $\frac{1}{12}$ $\frac{1}{12}$ $\frac{1}{12}$ $\frac{1}{12}$	SUPPLY DU	UCTS (RECT.)	0 0		0
	UNIT LOCATION MODEL CFM (IN. CAP CAP. EDB EWB INPUT OUTPUT GAS NO. (MBH) (MBH) (MBH) (MC) (MC) (MC) (MC) (MC) PRESSUR		SUPPLY	FAN (LE	T. REMAR			Floor Drai Floor Sink	n <u>2" 1 ½"</u> 3" 2"		OUTSIDE A	IR DUCTS	0 0		
	1         ROOF         AR-15         4896         0.625         -         -         50 1	$\equiv \langle$		Hub Drain Dishwashe	2" <u>1 ½</u> " 2" <u>1 ½</u> "		ROUND SU	IPPLY			
	MAKE-UP AIR UNIT, KITCHEN HOOD AND HOOD EF PROVIDED BY THE KEC AS A PACKAGED SYSTEM.				-	Ş		Ice Maker FPWH, HE		3/4"	1. INSULATIO	N SHALL BE INSTA	ALLED WHEN INDIC	ATED OTHERWISE I	IN THE QUIRED.
	DRAWINGS FOR CONTROL DIAGRAMS.		~~~~~~~~~~~~~~~~~~~~~~~~~~~~~~~~~~~~~~~					grade sho 2. Size as s	III be 2''. hown on drawings ar		RECTANGU	ULAR DUCTS SHALL	BE LINED, ROUNI	D DUCTS SHALL B	E WRAPPED
											UNCONDIT VAPOR BA SURFACES	IONED SPACES SHA ARRIER TO PREVEN S. NO INSULATION	ALL BE INSULATED IT CONDENSATION IS REQUIRED FOR	AS INDICATED AN FROM FORMING ON ROUND SUPPLY AI	ID SHALL IN N COLD MET
Clock wide belock in wide be	RK MODEL MODEL EXT	JST	COOLIN	NG							4. AT CONTE USED WH	RACTORS OPTION, ERE ROUND SUPPL	GALVANIZED STEEL Y AIR DUCTS ARE	ROUND DOUBLE	INSULATED.
	NO. ARRANGEMENT DISCHARGE CFM MIN. O.A. S.P. TYPE SIZE RPM HP TYPE CFM S.P. IN. W.G.	HP °F °		OTAL SENS. MA MBH MBH FF	AX STAGES	UNIT INF EER MI	PUT DUTPUT BH MBH STA		Z MCA MOCP		THE SPEC 5. AT CONTE	CIFICATIONS FOR A	DDITIONAL REQUIRE	MENTS. R MAY BE USED '	WHERE ROUN
NOMINAL 5.0 TON CAPACITY. NOMINAL 7.5 TON CAPACITY. SET MINIMUM OA PER OUTSIDE AIR CALC AND/OR AIR BALANCE SCHEDULE. VERIFY THAT A SMOKE DETECTOR IS INSTALLED IN THE RA DUCT AND INSTALL ONE IF MISSING. POWER WIRING & SMOKE DETECTOR INTERFACE BY ELECTRICAL CONTRACTOR. SEE THE SPECIFICATIONS FOR ADDITIONAL REQUIREMENTS. SMOKE DETECTOR NOT REQUIRED SINCE FAN CFM DOES NOT EXCEED 2000 CFM.					-						MANVILLE	SPIRACOUSTIC PL	JS, OR APPROVED	EQUAL, 1.5" THIC	ver shall E K (R6.4). SI
NOMINAL 5.0 TON CAPACITY. NOMINAL 7.5 TON CAPACITY. SET MINIMUM OA PER OUTSIDE AIR CALC AND/OR AIR BALANCE SCHEDULE. VERIFY THAT A SMOKE DETECTOR IS INSTALLED IN THE RA DUCT AND INSTALL ONE IF MISSING. POWER WIRING & SMOKE DETECTOR INTERFACE BY ELECTRICAL CONTRACTOR. SEE THE SPECIFICATIONS FOR ADDITIONAL REQUIREMENTS. SMOKE DETECTOR NOT REQUIRED SINCE FAN CFM DOES NOT EXCEED 2000 CFM.	ES:											1 MP301 NO SCALE	ATED OR LIN	ED DUCT DE	TAIL
SET MINIMUM OA PER OUTSIDE AIR CALC AND/OR AIR BALANCE SCHEDULE. VERIFY THAT A SMOKE DETECTOR IS INSTALLED IN THE RA DUCT AND INSTALL ONE IF MISSING. POWER WIRING & SMOKE DETECTOR INTERFACE BY ELECTRICAL CONTRACTOR. SEE THE SPECIFICATIONS FOR ADDITIONAL REQUIREMENTS. SMOKE DETECTOR NOT REQUIRED SINCE FAN CFM DOES NOT EXCEED 2000 CFM.	NOMINAL 5.0 TON CAPACITY.														
VERIFY THAT A SMOKE DETECTOR IS INSTALLED IN THE RA DUCT AND INSTALL ONE IF MISSING. POWER WIRING & SMOKE DETECTOR INTERFACE BY ELECTRICAL CONTRACTOR. SEE THE SPECIFICATIONS FOR ADDITIONAL REQUIREMENTS. mechanical, plumbing and electrical work which is furnished by others, generall smoke detector NOT REQUIRED SINCE FAN CFM DOES NOT EXCEED 2000 CFM.	SET MINIMUM OA PER OUTSIDE AIR CALC AND/OR AIR BALANCE SCHEDULE.										mechar and E. project	nical, plumbing and e All other drawings s t set may contain d	lectrical disciplines v should be considered rawing information, i	vith drawing sheet n I the work of other ncluding but not limi	umber beginni s. Further, dr ited to: archit
		CAL CONTRACTOR. SEE THE	SPECIFICATIONS FOR A	ADDITIONAL REQUIF	REMENTS.						section mechar screen the ac	ns and elevations, sit nical, plumbing and e led or light type. Gla souracy or regulatory	e plans and surveys lectrical work which dfelter Engineering ( compliance for wo	s and other informa is furnished by oth Group assumes no r rk prepared by othe	ition pertinent ers, generally responsibility o ers even thou

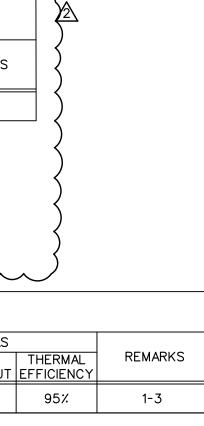


	R SUMMARY (SINGLE ZONE	STSTLIVIS	5) (NOTE 2)									
						SPACE OUTDOOR	ZONE AIR	ZONE	ZONE			
			CALCULATED	VENTILATION	AREA OUTDOOR	AIRFLOW IN	DISTRIBUTION	OUTDOOR	OUTDOOR	ZONE		
		AREA	OCCUPANT	RATE	<b>AIRFLOW IN</b>	BREATHING ZONE	EFFECTIVENESS (Ez)	AIRFLOW	AIRFLOW	OUTDOOR	EXHAUST	
		(SQUARE	TOTAL	(CFM/PERS)	<b>BREATHING ZONE</b>	Vbz=RpPz+RaAz	COOLING/HEATING	(Voz=Vbz/Ez)	(Voz=Vbz/Ez)	AIR SETPOINT	REQUIRED	
SYSTEM	SPACE	FEET)	(Pz)	(Rp)	(Ra) CFM/SF	CFM	(NOTE 1)	COOLING	HEATING	(CFM)	(CFM)	REMARKS
RTU-6	CORRIDOR	159	0	5	0.06	9.54	1.0/0.8	9.54	11.93	12		
(5-TON)	STORAGE	145	0	0	0.12	17.40	1.0/0.8	17.40	21.75	22		
	WOMEN RESTROOM	112									70	
	MEN RESTROOM	82									70	
	WORK ROOM (DISHWASHING)	165	1	5	0.06	14.90	1.0/0.8	14.90	18.63	19	83	6
	TOTAL RTU-6	663	1							53	223	
RTU-5	KITCHEN (COOKING)	368	_		-		_	_		-	258	6
(7.5-TON)	DINING ROOM	1,102	78	7.5	0.18	783.36	1.0/0.8	783.36	979.20	980		
· · · · · · · · · · · · · · · · · · ·	CORRIDOR	169	0	5	0.06	10.14	1.0/0.8	10.14	12.68	13		
	TOTAL RTU-5	1,710	91							993	258	


			HP -	HEA	T PUN	MP FA	NCC	DIL SCHED	ULE (V	N/ELE	CTRIC	HEA	<b>(T)</b>							
				S	SUPPLY			REFRIGERANT	COIL SUN	MER°	, WINTER	°	ELEC.	HEATING	ELEC	CTRIC	AL			
MARK NO.	MANUFACTURER	MODEL NO.	CFM	MIN O.A. CFM	RPM	EXT. S.P. IN W.G.	HP	MODEL NO.	TOTAL COOLING MBH	SENS. COOLING MBH	HEATING MBH	COP	ĸw	MBH OUTPUT	VOLT	ø	ΗZ	мса	моср	REMARKS
1	LENNOX	CBA27UHE-060	2000	-	-	0.6	1.0	-	56.4	43.3	53.5	-	15	-	208	3	60	49	50	1-4


WATER HAMMER ARRESTOR SCHEDULE								
MARK NO.	MANUFACTURER	MODEL NO.	PDI UNIT RATING	FIXTURE UNIT CAPACITY	REMARKS			
AA I	SIOUX CHIEF	660 SERIES	AA	4 (SINGLE FIXT)	Х			
Ą	SIOUX CHIEF	652	A	1 - 11	X			
B	SIOUX CHIEF	653	В	12 - 32	×			
Ç	SIOUX CHIEF	654	С	33 - 60	×			
P	SIOUX CHIEF	655	D	61 - 113	Х			
X	Х	Х	х	х	Х			
JOTES:								

FIXTURE B	RANG	CH S		
FIXTURE	WASTE	VENT		
Water Closet (ft)	4"	2"		
Water Closet (fv)	4"	2"		
Urinal	2"	1 ½"		
Lavatory	2" 1 ½" 2"	1 ½" 1 ½" 1 ½" 1 ½" 1 ½" 1 ½" 1 ½"		
Sink	2"	1 ½"		
Triple Sink	2"	1 ½"		
Shower, Tub	2"	1 ½"		
Water Fountain	2" 2" 1 ½" 3"	1 ½"		
Janitor Sink (flr)	3"	2"		
Janitor Sink (wall)	2" 2" 3"	1 1/3"		
Floor Drain	2"	1 1/2"		
Floor Sink	3"	2" 2"		
Eqpt Floor Drain	3"	2"		
Hub Drain	2"	1 ½"		
Dishwasher	2" 2" 2"	1 ½" 1 ½"		
Washer Box	2"	1 ½"		
lce Maker				
FPWH, HB			ĺ	
1. Minimum waste or vent size grade shall be 2".				




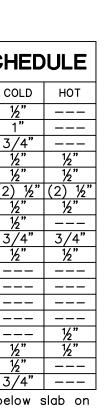

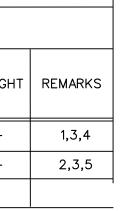


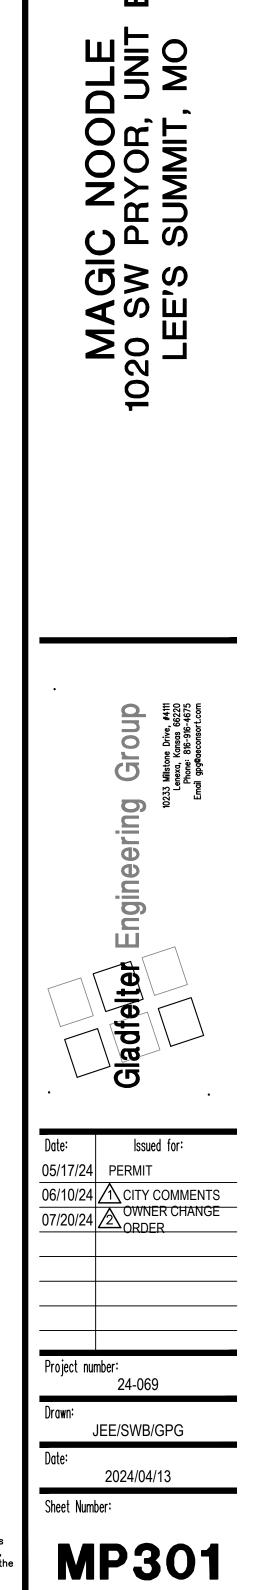



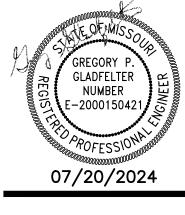



Ш

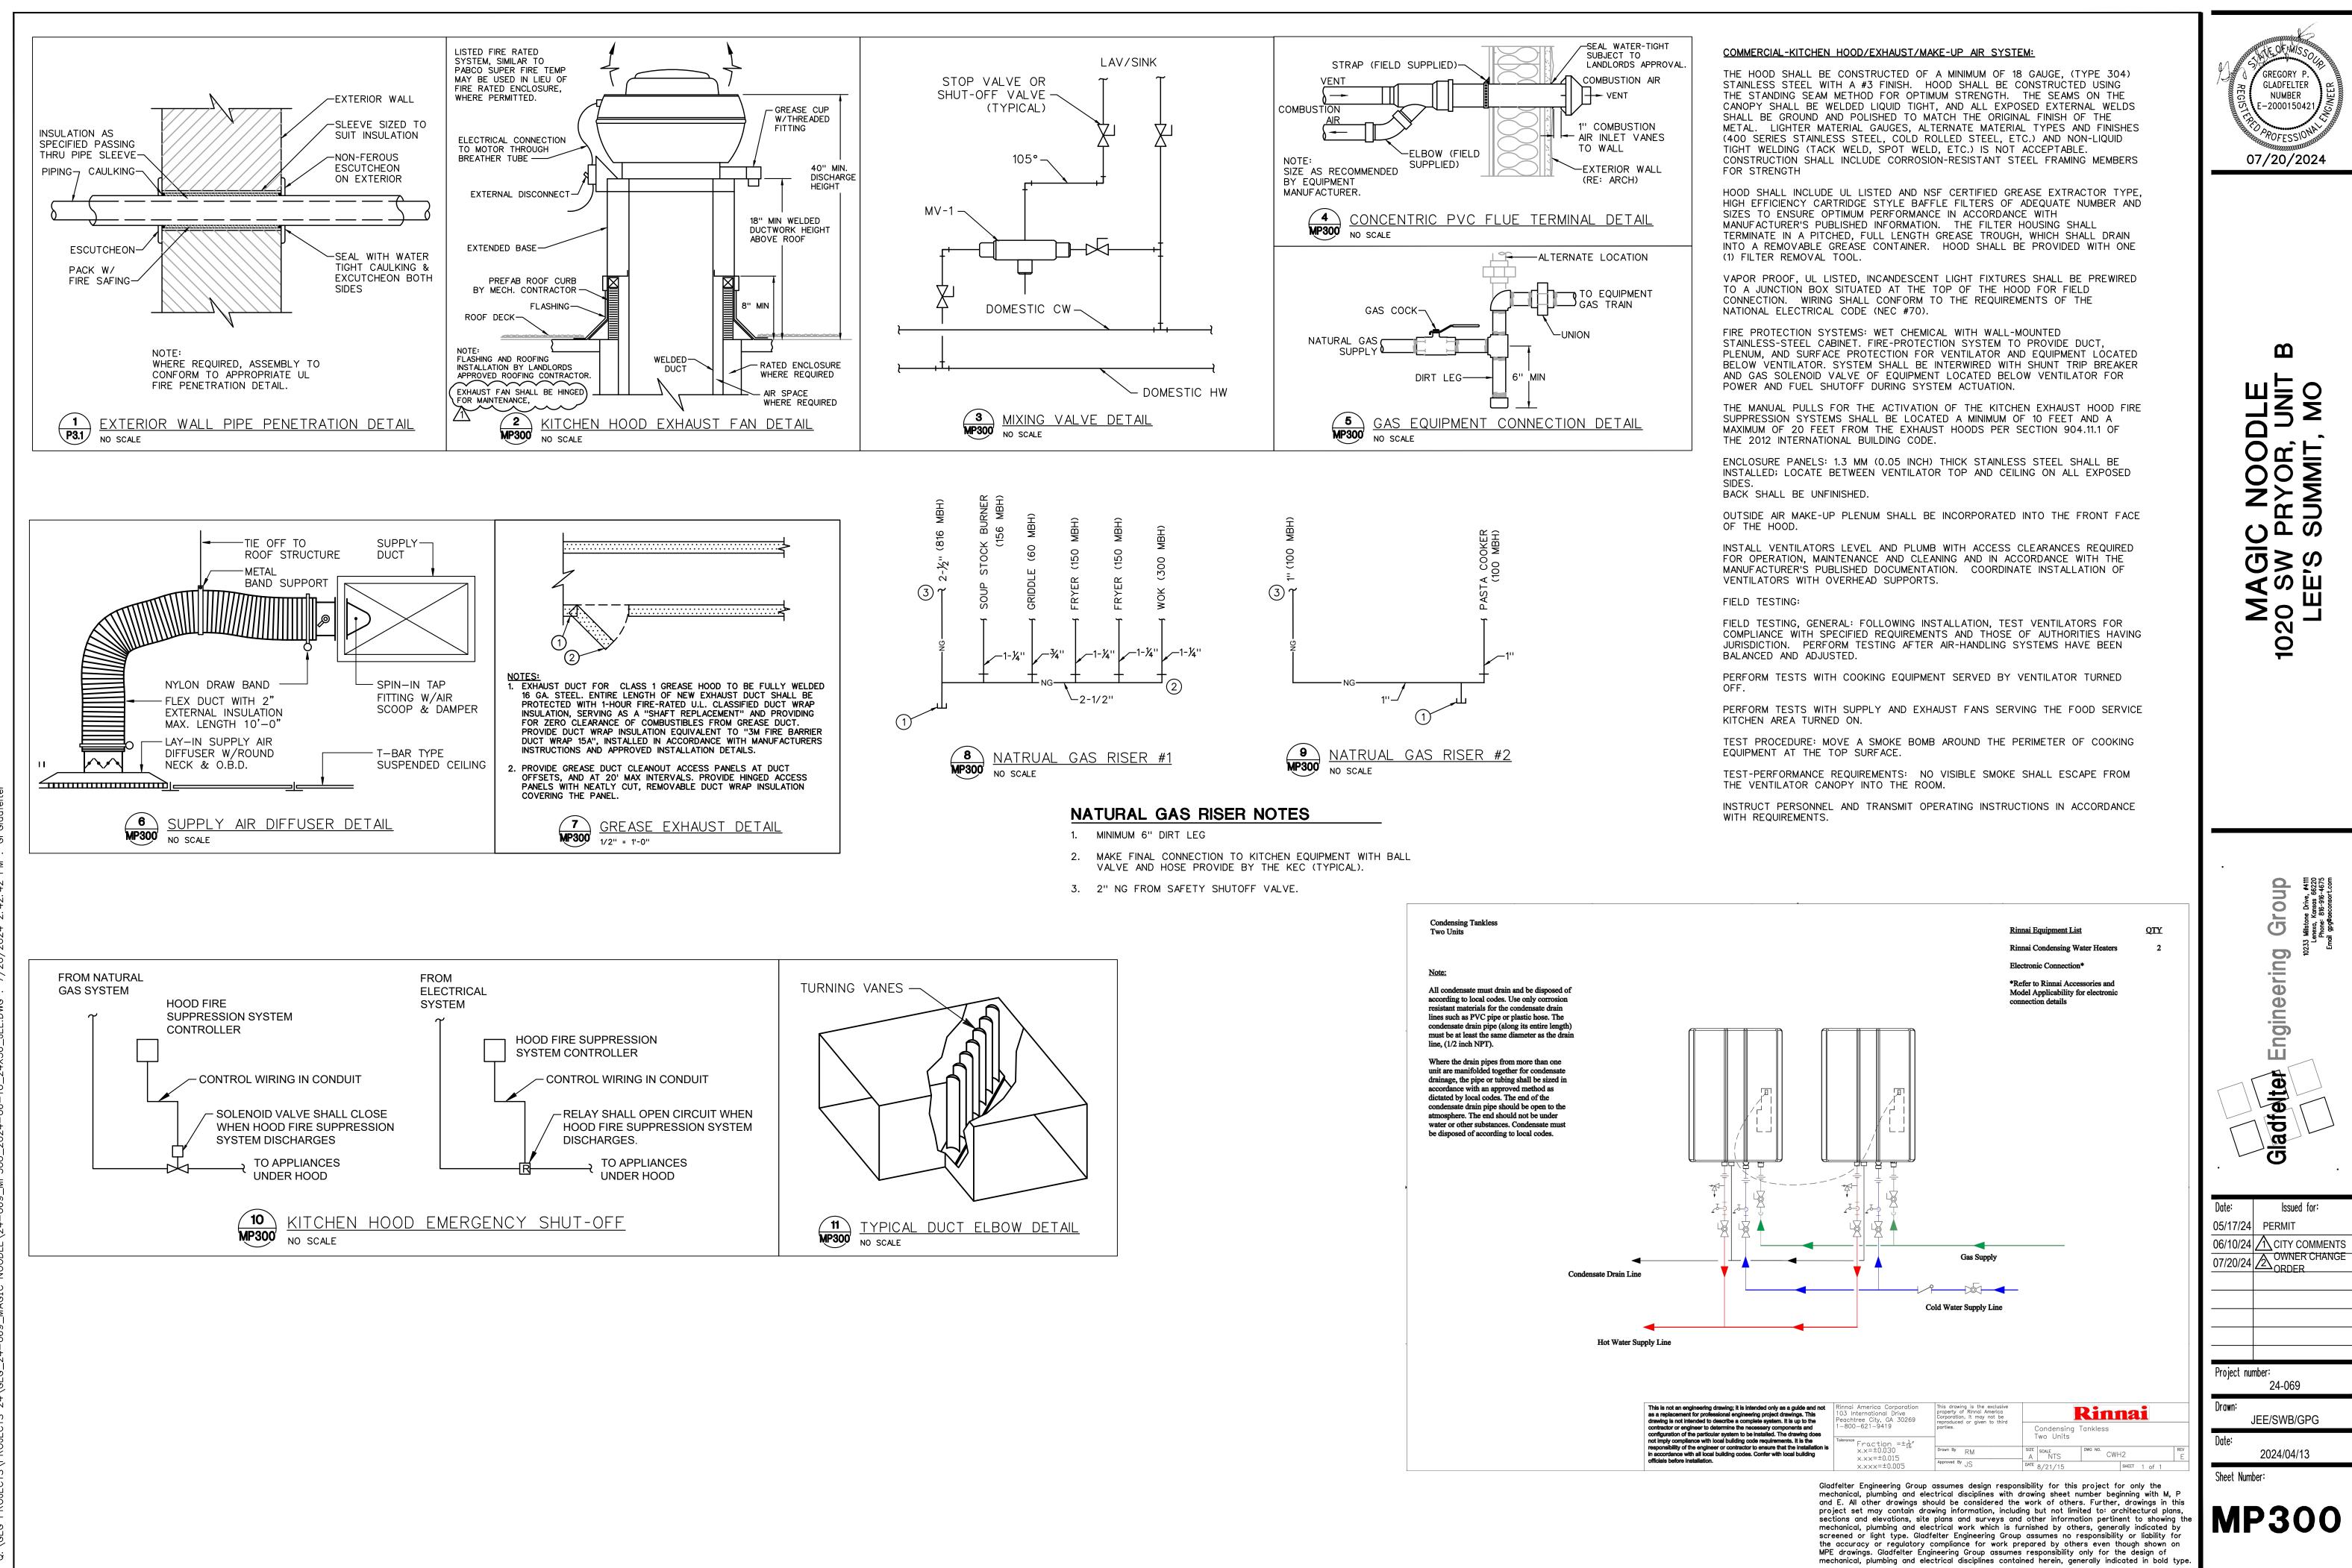

RELEASED FOR CONSTRUCTION As Noted on Plans Review ment Services De Lee's Summit, Missouri 08/09/2024



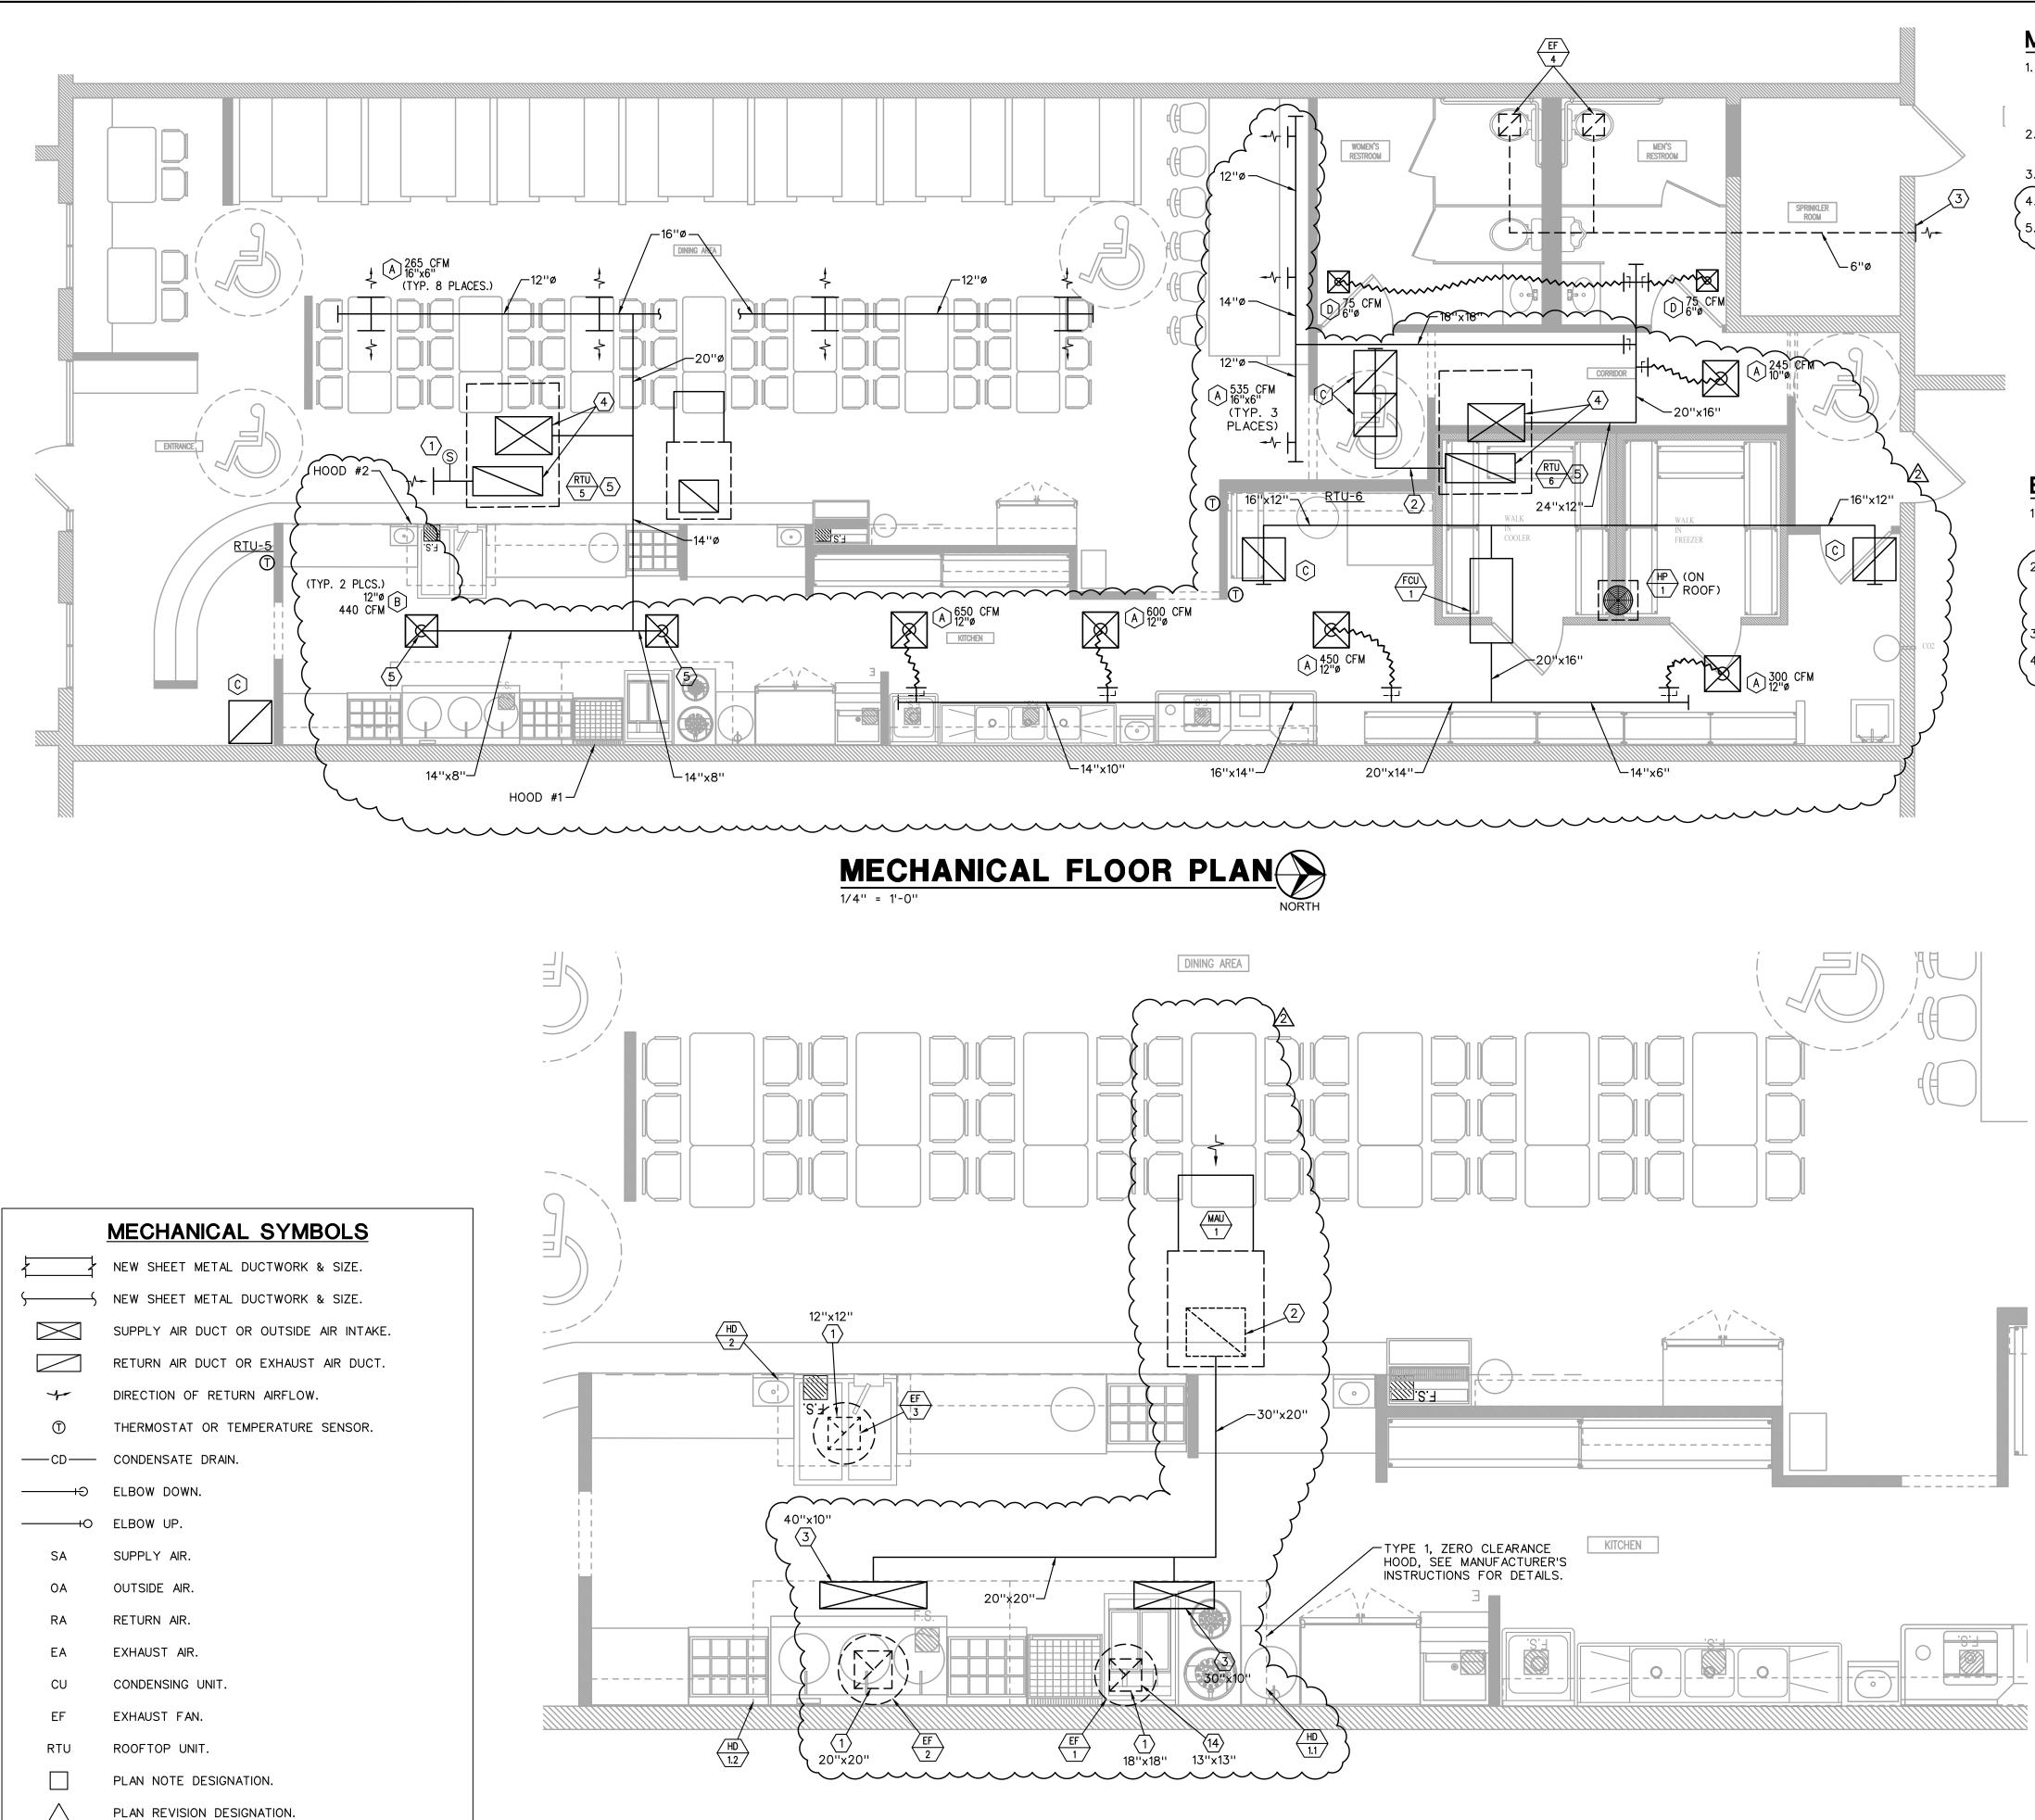

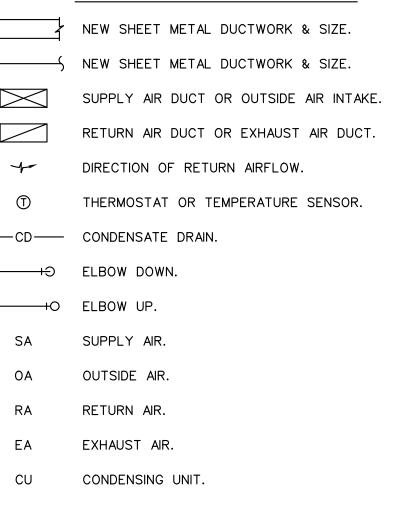


CONNECT TO EXISTING.

MECHANICAL EQUIPMENT DESIGNATION - TOP PORTION

IS EQUIPMENT (RTU, EF, HP, ETC.), BOTTOM PORTION

IS NO. OR LETTER (SEE APPROPRIATE SCHEDULE).

 $\longleftrightarrow$ 

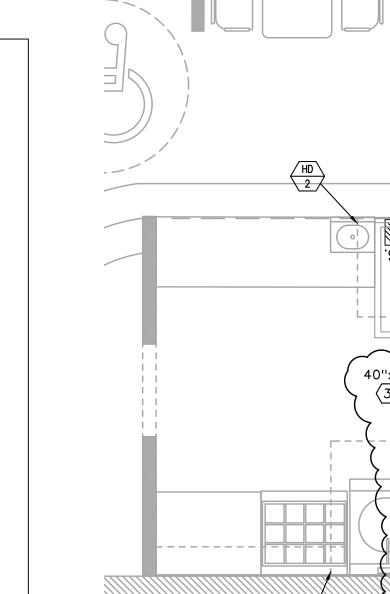

## MECHANICAL ENLARGED KITCHEN PLAN NORTH

3/8" = 1'-0"

#### MECHANICAL PLAN NOTES (#) 1. EXISTING SMOKE DETECTOR IN RA DUCT IS ALREADY IN PLACE. SMOKE DETECTOR SHALL BE WIRED BY ELECTRICAL CONTRACTOR TO SHUT DOWN SUPPLY AIR FANS AT BOTH ROOFTOP UNITS UPON DETECTION OF SMOKE. SEE THE MECHANICAL SPECIFICATION FOR ADDITIONAL INFORMATION.

- 2. NO SMOKE DETECTOR REQUIRED SINCE SUPPLY AIR FAN CAPACITY DOES NOT EXCEED 2000 CFM.
- 3. 6" EXHAUST DUCT THRU WALL TO WEATHERPROOF OUTLET. 4. EXISTING SA & RA DUCTS DOWN THRU ROOF.
- 5. 12" SPIN COLLAR WITH VD AND 12" FLEX DUCT DOWN TO CEILING DIFFUSER (TYP. 2 PLACES)

## ENLARGED KITCHEN MECHANICAL PLAN NOTES

- 1. EXHAUST AIR DUCT THRU ROOF (SIZE AS INDICATED). COORDINATE LOCATION WITH STRUCTURAL ELEMENTS. OFFSET DUCT IF REQUIRED. MAINTAIN 10'-0" SEPARATION BETWEEN OUTLET OF EF AND ANY HVAC EQUIPMENT OA INTAKES. 18x16" MAKE-UP AIR DOWN THRU ROOF FROM MAKE-UP AIR UNIT. ROOF PENETRATION
- (FLASHING AND ROOFING) BY LANDLORD'S APPROVED ROOFING CONTRACTOR. COORDINATE LOCATION OF MAKE-UP AIR UNIT WITH STRUCTURAL ELEMENTS AND MAINTAIN 10'-0" SEPARATION BETWEEN OA INTAKE AND EXHAUST OUTLETS OR PLUMBING VENTS.
- MAKE-UP AIR DOWN TO HOOD CONNECTION (SIZE AS INDICATED).
- EXHAUST DUCT CONNECTION AT HOOD (SIZE AS INDICATED). EXTEND EXHAUST DUCT UP TO EXHAUST FAN.
- _____

#### MECHANICAL GENERAL NOTES

- A) COORDINATE LOCATION OF CEILING DIFFUSERS AND RETURN GRILLES WITH ARCHITECTURAL REFLECTED CEILING PLAN.
- B) CONFIRM THAT NO COMBUSTIBLE MATERIALS ARE LOCATED IN CEILING RETURN AIR PLENUMS.
- C) TEMPERATURE CONTROL INCLUDES ALL CONTROL WIRING FOR COMPLETE OPERATION OF ROOFTOP UNITS BY MECHANICAL CONTRACTOR ACCORDING TO THE FOLLOWING SEQUENCE OF OPERATION
  - RTU SEQUENCE OF CONTROL:

PROVIDE A WALL MOUNTED 7-DAY HEATING/COOLING THERMOSTAT FOR EACH ROOFTOP UNIT INSTALLED IN A LOCATION APPROVED BY THE OWNER. INSTALL TAMPERPROOF COVER.

DAY OPERATION - THE TIMECLOCK OR MANUAL OVERIDE FUNCTION SHALL AUTOMATICALLY ACTIVATE THE SYSTEM TO THE "OCCUPIED" OR "DAY" MODE. THE SYSTEM SHALL HEAT OR COOL THE SPACE TO THE DESIRED SET POINTS (COOLING: 74°F AND HEATING: 70°F) THROUGH THE THERMOSTATS BUILT-IN DEADBAND. THE OUTSIDE AIR DAMPERS SHALL BE AT THEIR MINIMUM POSITION AND THE FAN SHALL MAINTAIN CONTINUOUS OPERATION.

NIGHT OPERATION - THE TIMECLOCK SHALL AUTOMATICALLY ACTIVATE THE SYSTEM TO THE "NIGHT/UNOCCUPIED" MODE. THE SYSTEM SHALL HEAT OR COOL THE SPACE TO THE DESIRED NIGHT SET POINTS (COOLING: 85°F AND HEATING: 60°F) THROUGH THE THERMOSTATS NIGHT/UNOCCUPIED SETPOINTS. THE OUTSIDE AIR DAMPERS SHALL BE CLOSED AND THE FAN SHALL CYCLE AS NEEDED TO MAINTAIN THE THERMOSTAT SETPOINTS.

ECONOMIZER OPERATION TO ENABLE FREE COOLING SHALL BE A FUNCTION OF THE RTU MANUFACTURER'S STANDARD CONTROLS. DEHUMIDIFICATION OPERATION, IF PROVIDED, SHALL BE A FUNCTION OF THE RTU MANUFACTURER'S STANDARD CONTROLS. INSTALL HUMIDISTAT WHERE RECOMMENDED BY MANUFACTURER

SAFETY OPERATION - THE SYSTEM SHALL SHUTDOWN OPERATION OF RTU FAN UPON DETECTION OF SMOKE AT ANY SMOKE DETECTOR INSTALLED AT THIS FACILITY.

RTU FAN SHALL OPERATE WHENEVER THE HOOD EXHAUST AND MAKE-UP AIR SYSTEMS ARE OPERATING. CONSULT "AIR BALANCE" SCHEDULE FOR MINIMUM OA SETTING WHEN THESE SYSTEMS ARE OPERATING.


- E) TYPE I HOODS, ASSOCIATED EXHAUST FANS AND MAKE-UP AIR UNIT PROVIDED BY KEC, INSTALLED BY MECHANICAL CONTRACTOR. COORDINATE EXHAUST DUCT CONNECTIONS TO HOOD WITH MANUFACTURER OF THE HOOD INSTALLED.
- F) CONTRACTOR SHALL ASSURE A FREE AIR PATH EXISTS IN RA CEILING PLENUM SPACES. PROVIDE OPENINGS IN SOLID BARRIERS AND RA SOUND BOOTS WHERE SOUND CONTROL IS DESIRED.

Gladfelter Engineering Group assumes design responsibility for this project for only the mechanical, plumbing and electrical disciplines with drawing sheet number beginning with M, P and E. All other drawings should be considered the work of others. Further, drawings in this project set may contain drawing information, including but not limited to: architectural plans, sections and elevations, site plans and surveys and other information pertinent to showing mechanical, plumbing and electrical work which is furnished by others, generally indicated by screened or light type. Gladfelter Engineering Group assumes no responsibility or liability for the accuracy or regulatory compliance for work prepared by others even though shown on MPE drawings. Gladfelter Engineering Group assumes responsibility only for the design of mechanical, plumbing and electrical disciplines contained herein, generally indicated in bold type



RELEASED FOR CONSTRUCTION As Noted on Plans Review opment Services De Lee's Summit, Missouri 08/09/2024

## Ω NOOD X OR, U JMMIT, N N N N N O d o AGI SW EE'S 9

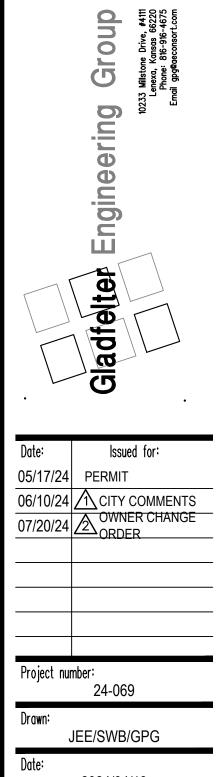

2024/04/13 Sheet Number:



			208	VOLTS		200	_ A. BI	JS	SERVI	CE ENT	RANCE			LIGHT FIXTU
	(EXIST		3	PHASE					FEED	THRU I	LUGS		TYPE	MANUFACTURER
-		ON <u>1</u> OF <u>1</u>		WIRE BRKR.		MAI				EED LUG BRKR.	GS	-	A	2x4 TROFFER SELECTED BY ARCHITECT
	CIRC. NO.	CIRCUIT DESCRIPTION		POLES	VA	Ø	CIRC. NO.	CIRCUIT DESCRIPTION		POLES	VA		в	LED TRACK LIGHT FIXTURE AND TRAC
	1	LIGHTS	20	1	920	A	2	INDUCTION	20	1	1800			RAIL SYSTEM SELECTED NY ARCHITEC
	3	RECEPTACLES	20	1	1080	в	4	INDUCTION	20	1	1800		C	CAN LIGHT SELECTED BY ARCHITECT
	5	SHOW-WINDOW REC	20	1	1000	С	6	INDUCTION	20	1	1800		EM	EXITRONIX #LED90
	7	LOGO REC	20	1	1000	A	8	INDUCTION	20	1	1800		EEM	EXITRONIX #MLED
	9	HOST REC	20	1	1200	в	10	PREP COOLER	20	1	500		ХЕМ	EXITRONIX #VLED-1-WH-EL90-R
	11	SODA/ICE	20	1	1000	С	12	ICE/COOLER	20	1	1500			
	13	P.O.S.	20	1	500	A	14	STOCK BURNER	20	1	720		X	EXITRONIX #VEX-U-BP-WB-WH-120
	15	GF REC	20	1	360	в	16	PREP COOLER	20	1	500		X2	EXITRONIX #VEX-U/2-BP-WB-WH-120
	17	HOOD S	20	1	1500	С	18	DISHWASHER	20	1	1500		NOTES:	-
2	19			2	1000	A	20	MIXER	20	1	1500			YPE 'X' AND/OR 'XEM' FIXTURES SHALI YOWER TYPE 'EEM'.
	21	WALK-IN SYSTEMS	20	2	1000	в	22	RECEPTACLES	20	1	720			
	23	WALK-IN LTS/CONTRLS	20	1	500	С	24	SPARE	20	1	-			
Γ	25	SPARE	20	1	-	A	26	SPARE	20	1	-			
	27	SPARE	20	1	-	в	28				385			
	29	WH-1	20	1	500	С	30	EF-1	15	2	385	$\left\{ \begin{array}{c} 2 \\ \end{array} \right\}$		
	31				3480	A	32				500	᠈ᢅ᠋᠆ᠺ		
F	33	EXISTING RTU-5	60	3	3480	в	34	EF-2	15	2	500		7	
F	35				3480	С	36	EF-3	15	1	696	2		
	37				6720	A	38				2040	$\mathbf{b}$		
Ē	39	EXISTING RTU-6	50	3	6720	в	40	MAU-1	25	3	2040	2		
	41				6720	С	42				2040			
$( \ \ )$	43				5878	A	44		Ŷ	$\sim$	2159	$\square$		
7	45	FCU-1	50	3	5878	в	46	HP-1	30	3	2159			
7	47				5878	С	48				2159			
<b>}</b>	49	SPACE	-	1	-	A	50	SPACE	-		-	12		
	51	SPACE	-	1	-	в	52	SPACE	-	1	-	1)		
	53	SPACE	-	1	-	с	54	SPACE	_	1	-	1)		
-		L CONNECTED LOAD 57270 VA URFACE MOUNTED LUSH MOUNTED	- F F C	lights ( Recepts Recepts Other (	FACTORS:	_ % : _ % : _ % : _ % :	=	1150         VA           10000         VA           2332         VA           41686         VA           55168         VA	F	POWER I 100 EMAND (	% FACTOR	-		

<u>NOTES:</u>

1. POWER FROM PANEL P FROM 400-AMP FUSED DISCONNECT SWITCH. REPLACE FUSES WITH 200-AMP RATED FUSES.

2. COORDINATE POWER REQUIREMENTS WITH EQUIPMENT PROVIDED.

#### TURE SCHEDULE

		—
	LAMP	<u>VOLTS</u> WATTS
	LED	<u>120</u> 32
ACK ECT	LED	<u>120</u> 10
т	LED	<u>120</u> 10
	(2) LED HEADS WITH UNIT	<u>120</u> 10
	WEATHERPROOF LED REMOTE	<u>6</u> 8
	RED LED AND (2) LED HEADS WITH UNIT	<u>120</u> 15
	RED LED WITH UNIT	<u>120</u> 5
)	RED LED WITH UNIT	<u>120</u> 5

SHALL HAVE 12 WATTS OF REMOTE CAPACITY AND


## ELECTRICAL SYMBOLS

	BRANCH CIRCUIT CONCEALED IN CEILING OR WALL. ARROWS INDICATE HOMERUNS TO PANEL. ALL CONDUCTORS ARE #12 EXCEPT AS NOTED.
— <del> III-</del> —	CONDUIT RUN UNDERGROUND OR BENEATH FLOOR SLAB.
	GROUNDING CONDUCTOR #12 EXCEPT AS NOTED.
нŴ	WALL MOUNTED JUNCTION BOX.
$\bigcirc$	CEILING MOUNTED JUNCTION BOX.
	PANELBOARD (SURFACE MOUNTED).
	DISCONNECT SWITCH. SIZED AS NOTED.
<b>E</b> h	DISCONNECT SWITCH FURNISHED WITH EQUIPMENT.
🛇 OR 🔕	EXIT LIGHT - SINGLE FACE - ARROWS AS SHOWN.
<b>†</b> €†	EXIT LIGHT - DOUBLE FACE - ARROWS AS SHOWN.
$\bigotimes$	COMBINATION EXIT/EMERGENCY LIGHT FIXTURE WITH (2) HEADS
44	CEILING OR WALL MOUNTED EMERGENCY LIGHTING UNIT WITH (2) HEADS.
0	FLUORESCENT LIGHT FIXTURE.
Alla	FLUORESCENT NIGHT LIGHT FIXTURE. FIXTURE SHALL BE ON 24/7.
	FLUORESCENT STRIP FIXTURE.
0	CEILING LIGHT FIXTURE.
Ю	WALL MOUNTED LIGHT FIXTURE.
н <b>Ф</b>	REMOTE WEATHERPROOF EMERGENCY LIGHT FIXTURE.
\$	SINGLE POLE SWITCH. +3'-10" AFF.
\$P	SWITCH AND PILOT LIGHT. +3'-10" AFF.
$\Theta$	SINGLE RECEPTACLE. +1'-6" AFF OR AS NOTED.
<b>⊖</b>	DUPLEX RECEPTACLE. +1'-6" AFF OR AS NOTED.
	DUPLEX RECEPTACLE INSTALLED ABOVE COUNTERTOP.
€ ^{WP}	DUPLEX RECEPTACLE WITH WEATHERPROOF PLATE. HEIGHT AS NOTED.
€ ^{GF}	DUPLEX RECEPTACLE W/GROUND FAULT PROTECTION. +1'-6" AFF OR AS NOTED.
Ē	FOURLEX RECEPTACLE. +1'-6" AFF OR AS NOTED.
₽	FOURPLEX RECEPTACLE INSTALLED ABOVE COUNTERTOP.
4	COMBINATION VOICE/DATA OUTLET WITH 3/4" CONDUIT STUBBED UP OUT OF BOX TO ABOVE ACCESSIBLE CEILING. +1'-6" AFF OR AS NOTED.
4	COMBINATION VOICE/DATA OUTLET WITH 3/4" CONDUIT STUBBED UP OUT OF BOX TO ABOVE ACCESSIBLE CEILING. INSTALLED ABOVE COUNTERTOP.
+3'-10''	HEIGHT TO CENTERLINE OF OUTLET BOX ABOVE FINISHED FLOOR.
RTU-1	ROOF TOP UNIT AND NUMBER.
WH-1	ELECTRIC WATER HEATER AND NUMBER.
EF-1	EXHAUST FAN AND NUMBER.
AFF	ABOVE FINISH FLOOR.
ETR	EXISTING TO REMAIN.
ER	EXISTING RELOCATED.
EC	ELECTRICAL CONTRACTOR.
NL	NIGHT LIGHT. FIXTURE SHALL BE ON 24/7

## ELECTRICAL GENERAL NOTES


- CONTRACTOR SHALL COORDINATE INSTALLATION REQUIREMENTS AND SCHEDULING OF ALL WORK WITH BUILDING REPRESENTATIVE AND GENERAL CONTRACTOR.
- 2. INSTALLATION SHALL COMPLY WITH LATEST EDITION OF N.E.C. AND LOCAL AUTHORITY HAVING JURISDICTION.
- 3. CONTRACTOR SHALL BE LICENSED TO PERFORM WORK IN MUNICIPALITY WHERE PROJECT IS LOCATED.
- 4. ALL WIRING SHALL BE INSTALLED IN CONDUIT. EMT CONDUIT WITH SET SCREW FITTINGS MAY BE UTILIZED WHERE PERMITTED BY CODE. MINIMUM CONDUIT SIZE SHALL BE 1/2".
- 5. CONDUIT INSTALLED IN AREAS OF BUILDINGS OR PORTIONS OF BUILDINGS WHERE MEDICAL CARE IS PROVIDED SHALL BE MEDICAL GRADE CONDUIT AND THE INSTALLATION SHALL CONFORM WITH CHAPTER 517 OF THE NEC (HEALTH CARE FACILITIES).
- 6. ALL WIRING SHALL BE COPPER WITH 600 VOLT INSULATION AND COLOR CODED.
- 7. CONTRACTOR SHALL OBTAIN AND PAY FOR ALL PERMIT AND INSPECTION FEES.
- 8. MC CABLE MAY BE INSTALLED WHERE PERMITTED BY CODE CONCEALED IN WALLS AND FOR CONNECTIONS TO LIGHT FIXTURES (MAXIMUM LENGTH 6'-O''). CONDUCTORS SHALL BE MINIMUM #12 GAUGE AND COPPER. MC CABLE SHALL NOT BE USED FOR HOMERUNS.
- 9. INSTALL BLANK COVER PLATE ON ALL PULL BOXES AND JUNCTION BOXES.
- 10. TYPEWRITTEN PANELBOARD DIRECTORY SHALL BE PROVIDED FOR PANELBOARD AND CORRECTLY FILLED OUT.
- 11. CONTRACTOR SHALL COORDINATE INSTALLATION OF ELECTRICAL WORK WITH ALL OTHER TRADES INVOLVED WITH CONSTRUCTION OF PROJECT.
- 12. ALL WIRING DEVICES SHALL BE RATED 20 AMP, OR AS NOTED.
- 13. ALL NEW BRANCH CIRCUIT CONDUITS SHALL BE INSTALLED CONCEALED ABOVE LAY-IN CEILING OR IN WALLS.
- 14. CONTRACTOR SHALL FIELD VERIFY EXACT ROUTING OF ALL CONDUITS TO NEW EQUIPMENT.
- 15. VOICE/DATA AND THERMOSTAT OUTLET BOXES SHALL BE PROVIDED AND INSTALLED WITH 3/4" CONDUIT STUBBED UP OUT TOP OF BOX TO ABOVE ACCESSIBLE CEILING. PROVIDE BUSHING ON END OF CONDUIT.
- 16. VOICE/DATA SYSTEMS, ASSOCIATED WIRING, AND DEVICES TO BE PROVIDED BY OWNER.
- 17. DISCONNECT SWITCHES SHALL BE HEAVY DUTY TYPE, NEMA 1 FOR INDOOR AND NEMA 3R FOR OUTDOOR INSTALLATIONS. MANUFACTURED BY SQUARE D, ITE/SIEMENS, GE, OR CUTLER-HAMMER.
- 18. FURNISH MATERIALS AND LABOR FOR A COMPLETE AND OPERATIONAL ELECTRICAL INSTALLATION.
- 19. MATERIAL AND EQUIPMENT SHALL BE NEW AND SHALL BEAR THE 'UL' LABELS AS REQUIRED.
- 20. PROVIDE LIGHT FIXTURES AS SCHEDULED OR SELECTED BY OWNER WITH ALL REQUIRED TRIM AND ACCESSORIES FOR A COMPLETE WORKING AND CODE COMPLIANT INSTALLATION. REFER TO THE ARCHITECTURAL PLANS FOR EXACT LOCATION OF THE FIXTURES.
- 21. ALL LIGHT FIXTURES AND DEVICES MOUNTED IN CEILING SHALL BE BRACED TO RESIST SEISMIC FORCES IN ACCORDANCE WITH IBC, NEC, AND LOCAL AUTHORITY HAVING JURISDICTION.
- 22. PROVIDE A FACTORY INSTALLED MAXIMUM WATTAGE LABEL ON ALL MEDIUM SCREW BASE LIGHT FIXTURES THAT CORRESPONDS TO THE MAXIMUM WATTAGE OF THE LIGHT FIXTURE LISTED IN THE LIGHT FIXTURE SCHEDULE.
- 23. EMERGENCY AND EXIT LIGHT FIXTURES SHALL BE PROVIDED WITH BATTERY BACK-UP FOR MINIMUM OF (90) MINUTES. EMERGENCY AND EXIT LIGHT FIXTURES SHALL BE CONNECTED TO HOT LEG OF CIRCUIT, NOT SWITCHED.
- 24. E.C. SHALL VERIFY RATINGS, LOCATIONS, AND CONNECTIONS OF ALL EQUIPMENT PROVIDED BY OTHERS AND INSTALLED AND/OR CONNECTED BY THE ELECTRICAL CONTRACTOR.
- 25. E.C. SHALL VERIFY ALL CONDITIONS PRIOR TO ANY ROUGH-IN.
- 26. ALL CHANGES BY E.C. TO ITEMS SPECIFIED ON DRAWINGS MUST BE APPROVED IN WRITING BY ENGINEER/ARCHITECT OR OWNER AT LEAST (10) TEN DAYS PRIOR TO PROJECT BID DATE.
- 27. E.C. SHALL PROVIDE AND INSTALL SMOKE AND FIRE STOPS AT ALL CONDUIT PENETRATIONS OF SMOKE AND FIRE-RATED WALLS AND CEILINGS.
- 28. CAULK AND SEAL ALL RACEWAY PENETRATIONS OF EXTERIOR OR DEMISING WALLS.
- 29. THE CONTRACTOR SHALL TAKE CARE TO MAINTAIN THE INTEGRITY OF ALL FIRE RATED AND SOUND RATED ASSEMBLIES.
- 30. E.C. SHALL COORDINATE LOCATIONS OF ALL DEVICES, SUCH AS LIGHT SWITCHES, CONVENIENCE RECEPTACLES, TELEVISION OUTLETS, AND TELEPHONE OUTLETS WITH ARCHITECTURAL DRAWINGS PRIOR TO ANY ROUGH-IN.
- 31. DUCT SMOKE DETECTOR SHALL BE 120 VOLT, PHOTO-ELECTRIC WITH SAMPLING TUBES - INSTALLED IN RETURN AIR DUCT OF HVAC UNIT(S). PROVIDE WITH MIN-ALERT SOUNDER, STROBE AND REMOTE TEST/RESET STATION. WIRE DETECTORS SO THAT UPON SENSING SMOKE HVAC UNIT FANS(S) AUTOMATICALLY SHUTS DOWN AND SOUNDER/STROBE IS ACTIVATED. WHERE MULTIPLE HVAC UNIT FANS SHARE A COMMON RETURN AIR PLENUM (IN EXCESS OF 2,000 CFM COMBINED), ALL FANS SHALL AUTOMATICALLY SHUT DOWN UPON DETECTION OF SMOKE AT ANY SINGLE SMOKE DETECTOR (INCLUDING VAV BOX FANS OR OTHER FANS ASSOCIATED WITH THE PLENUM). PROVIDE ALL RELAYS AND ACCESSORIES REQUIRED FOR COMPLETE INSTALLATION. EQUIPMENT SHALL BE BY EDWARDS, SIMPLEX, PYROTRONICS, OR NOTIFER.
- 32. NEW CIRCUIT BREAKERS INSTALLED IN EXISTING PANELBOARD SHALL MATE/MATCH PANEL CONSTRUCTION AND AIC RATING.
- 33. THE COMPONENTS OF THE ELECTRICAL SYSTEM SHALL BE WARRANTED FOR A PERIOD OF ONE YEAR FROM THE DATE OF ACCEPTANCE THEREOF EITHER FOR BENEFICIAL USE OR FINAL ACCEPTANCE, WHICHEVER IS EARLIER, AGAINST DEFECTIVE MATERIALS, DESIGN AND WORKMANSHIP.
- 34. FIRE ALARM SYSTEM ADDITIONS TO THE TENANT SPACE FOR THIS FACILITY SHALL BE DESIGN/BUILD. SUCCESSFUL FIRE ALARM CONTRACTOR SHALL PROVIDE COMPLETE FIRE ALARM SYSTEM DOCUMENTS INCLUDING DRAWINGS, DETAILS AND SPECIFICATION DATA SHEETS SEALED BY A LICENSED ENGINEER FOR REVIEW AND SUBMISSION TO THE CITY FOR PERMIT. INSTALLATION SHALL COMPLY WITH NFPA 72, ALL LOCAL BUILDING CODES AND AUTHORITY HAVING JURISDICTION. ALL COMPONENTS SHALL MATE/MATCH THE EXISTING SYSTEM. WIRING SHALL BE PER MANUFACTURERS REQUIREMENTS.

Gladfelter Engineering Group assumes design responsibility for this project for only the mechanical, plumbing and electrical disciplines with drawing sheet number beginning with M, P and E. All other drawings should be considered the work of others. Further, drawings in this project set may contain drawing information, including but not limited to: architectural plans. sections and elevations, site plans and surveys and other information pertinent to showing t mechanical, plumbing and electrical work which is furnished by others, generally indicated by screened or light type. Gladfelter Engineering Group assumes no responsibility or liability for the accuracy or regulatory compliance for work prepared by others even though shown on MPE drawings. Gladfelter Engineering Group assumes responsibility only for the design of mechanical, plumbing and electrical disciplines contained herein, generally indicated in bold type

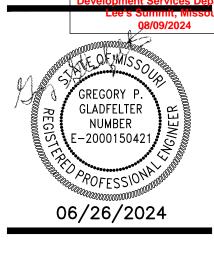

**RELEASED FOR** CONSTRUCTION As Noted on Plans Review

 $\mathbf{m}$ NUT NO O'n⊑ ΟΟΣ Z≻Ž  $\square$ O L O  $\overline{\Omega} \ge \tilde{0}$ ЧS Ш Σou N Ο

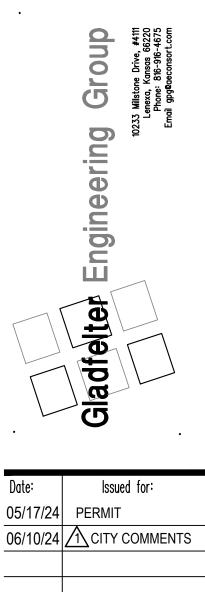

Project number:

Sheet Number:


Drawn:

Date

24-069

JEE/SWB/GPG

2024/04/13

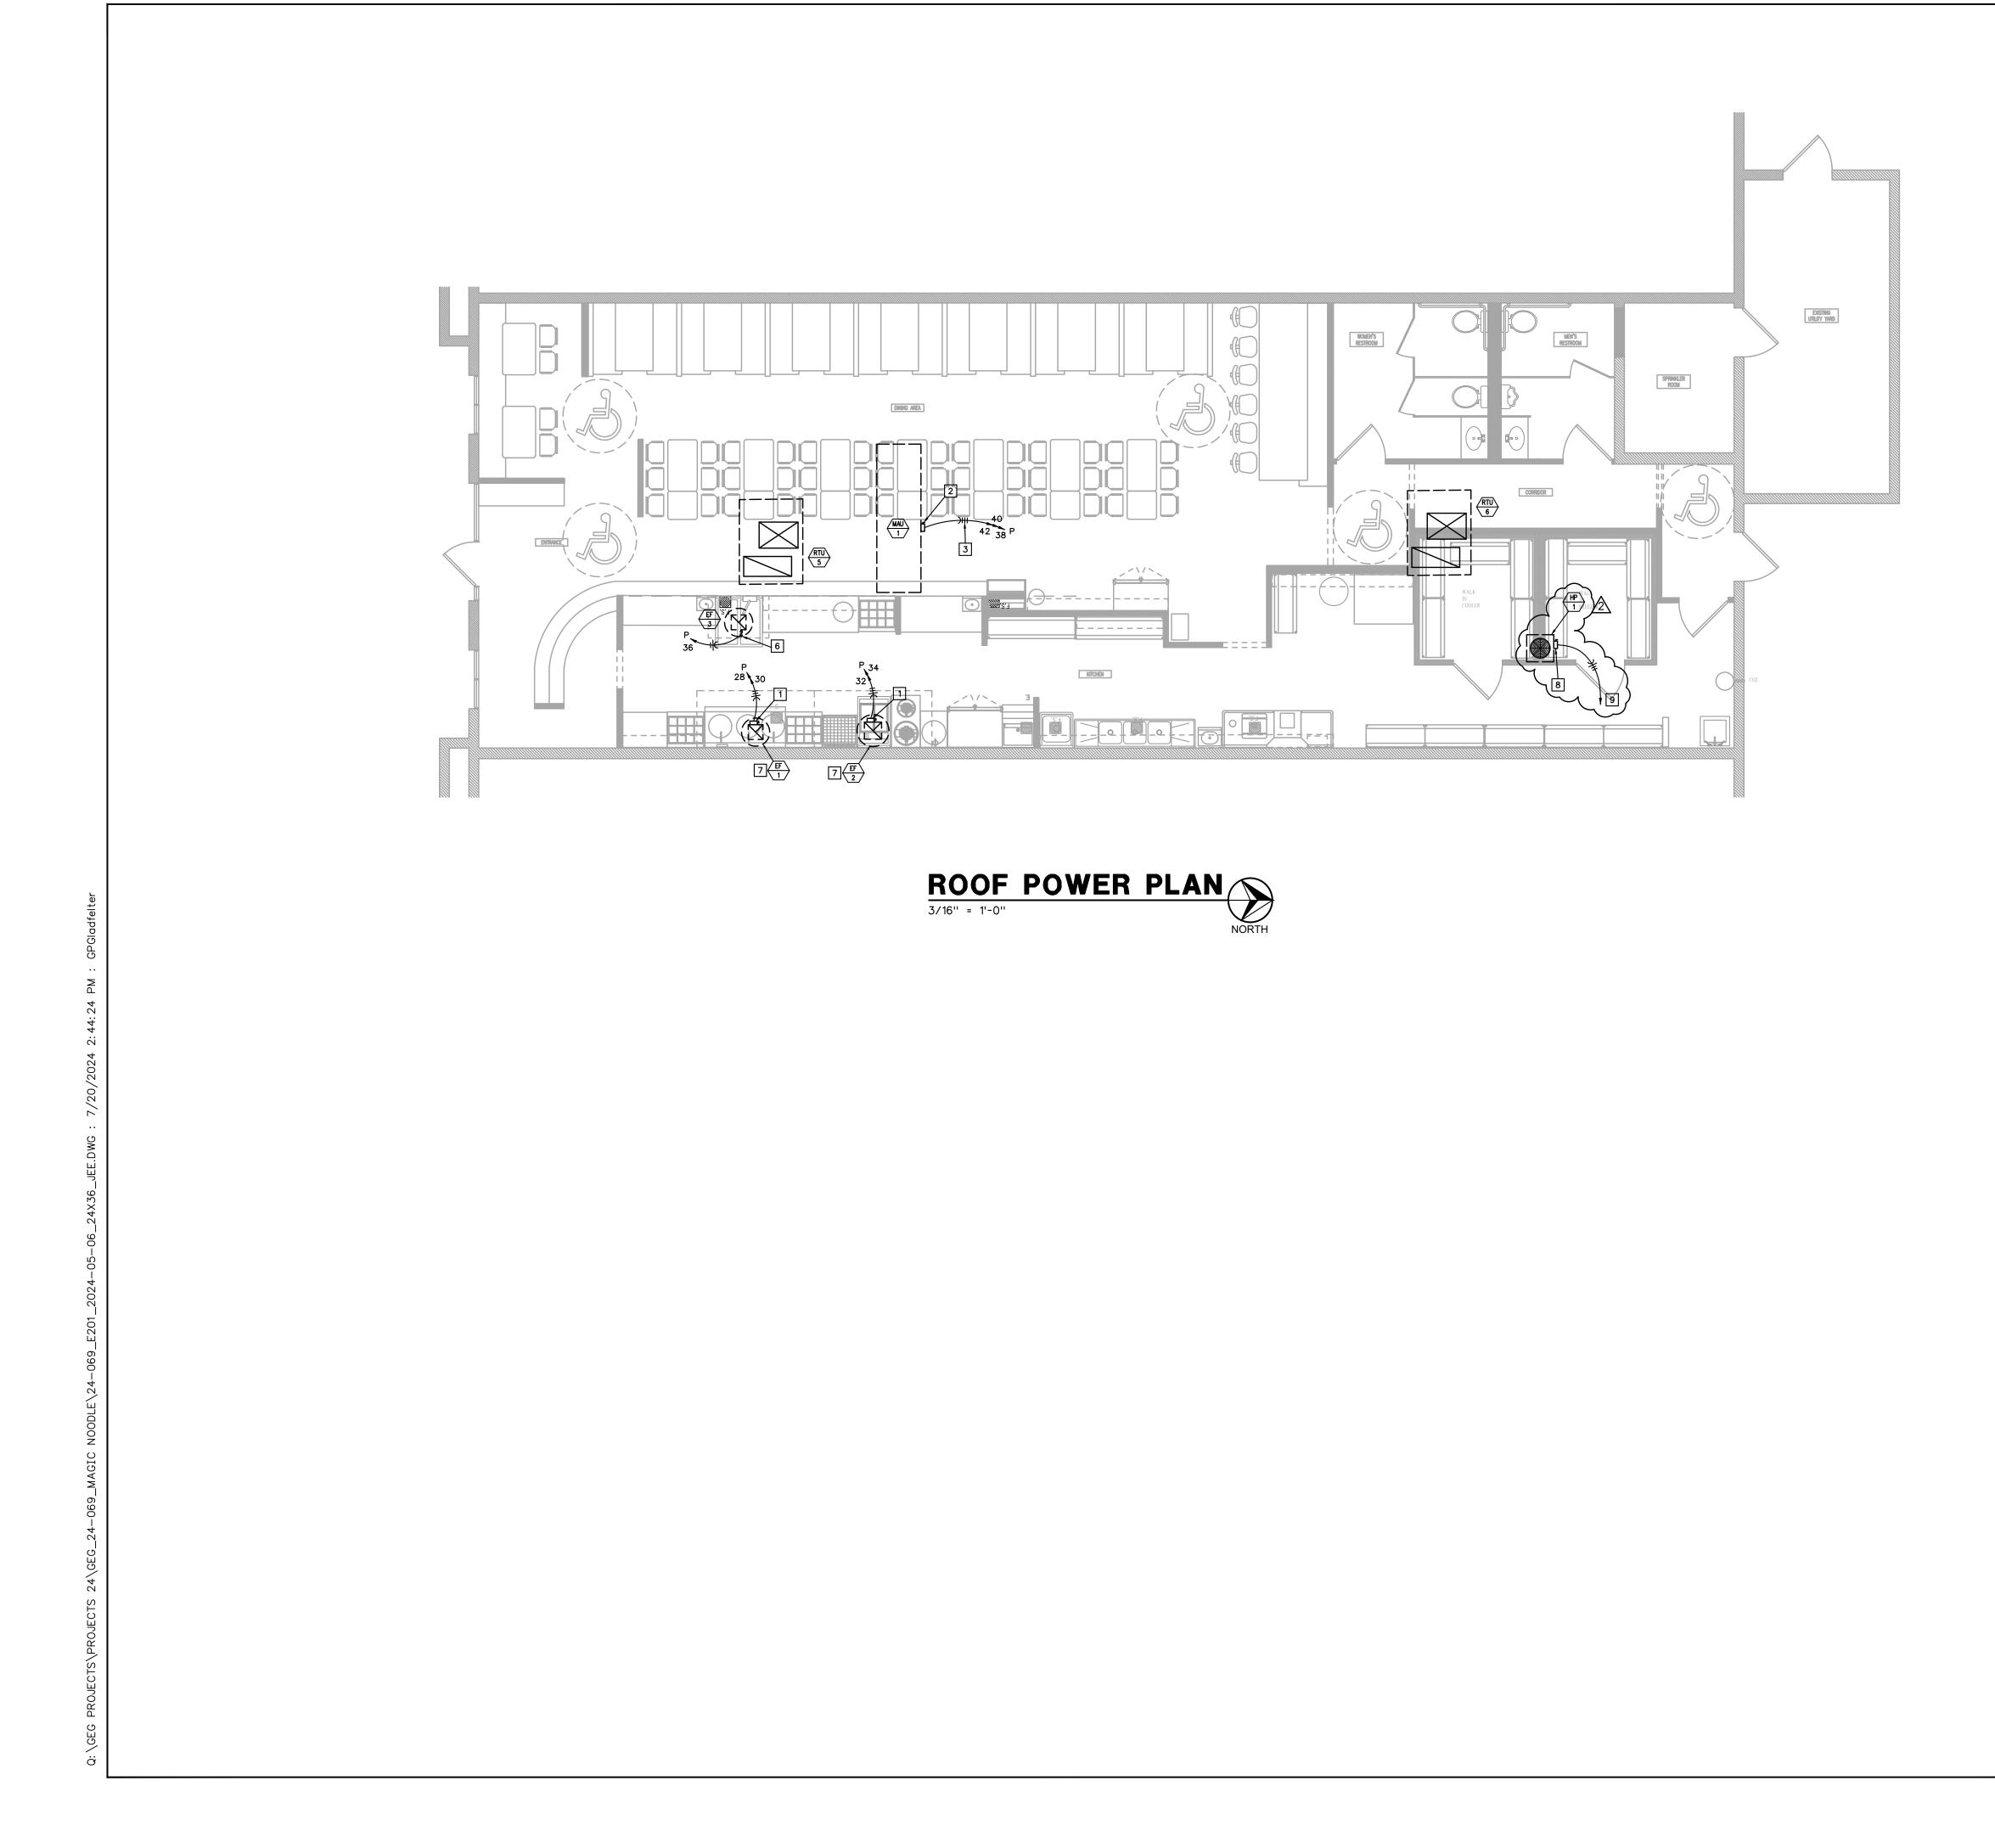

RELE	ASED FOR
CONS	STRUCTION
As Noted	on Plans Review
Development	Services Departme
	ımmit, Missouri
0	3/09/2024

POWER	PLAN	NOTES #

- 1. 30A/2P, NON-FUSED, NEMA 3R DISCONNECT SWITCH INSTALLED ON SIDE OF UNIT. DO NOT INSTALL ON ACCESS PANEL.
- 30A/3P, NON-FUSED, NEMA 3R DISCONNECT SWITCH INSTALLED ON SIDE OF UNIT. DO NOT INSTALL ON ACCESS PANEL.
- 3. 3/4" CONDUIT WITH 3-#10 (CU) AND 1-#10 (CU) GROUND WIRE.
- 60A/3P, NON-FUSED, NEMA 3R DISCONNECT SWITCH INSTALLED ON SIDE OF UNIT. DO NOT INSTALL ON ACCESS PANEL.
- 5. 3/4" CONDUIT WITH 3-#8 (CU) AND 1-#10 (CU) GROUND WIRE.
- 20A/1P, HORSEPOWER RATED TOGGLE SWITCH INSTALLED ON WALL FOR DISCONNECTING MEANS.

7. POWER FROM LIGHTING CIRCUIT. 8. 30-AMP, 3-POLE NEMA 3R DISCONNECT SWITCH.


9. 3/4" C WITH FOUR #10 CU. 





·	Gladfeter Engineering Group 10233 Miltone Dive. #411 10233 Miltone Dive. #411 Leneva, Karass 6622 Phone: 818-916-4675 Enail gp@deeconsort.com
Date: 05/17/24 06/10/24 07/20/24	Issued for: PERMIT CITY COMMENTS OWNER CHANGE ORDER
Project nu	mber: 24-069
Drawn:	JEE/SWB/GPG
Date:	2024/04/13
Sheet Num	

# Gladfelter Engineering Group assumes design responsibility for this project for only the mechanical, plumbing and electrical disciplines with drawing sheet number beginning with M, P and E. All other drawings should be considered the work of others. Further, drawings in this project set may contain drawing information, including but not limited to: architectural plans, sections and elevations, site plans and surveys and other information pertinent to showing the mechanical, plumbing and electrical work which is furnished by others, generally indicated by screened or light type. Gladfelter Engineering Group assumes no responsibility or liability for the accuracy or regulatory compliance for work prepared by others even though shown on MPE drawings. Gladfelter Engineering Group assumes responsibility only for the design of mechanical, plumbing and electrical disciplines contained herein, generally indicated in bold type.

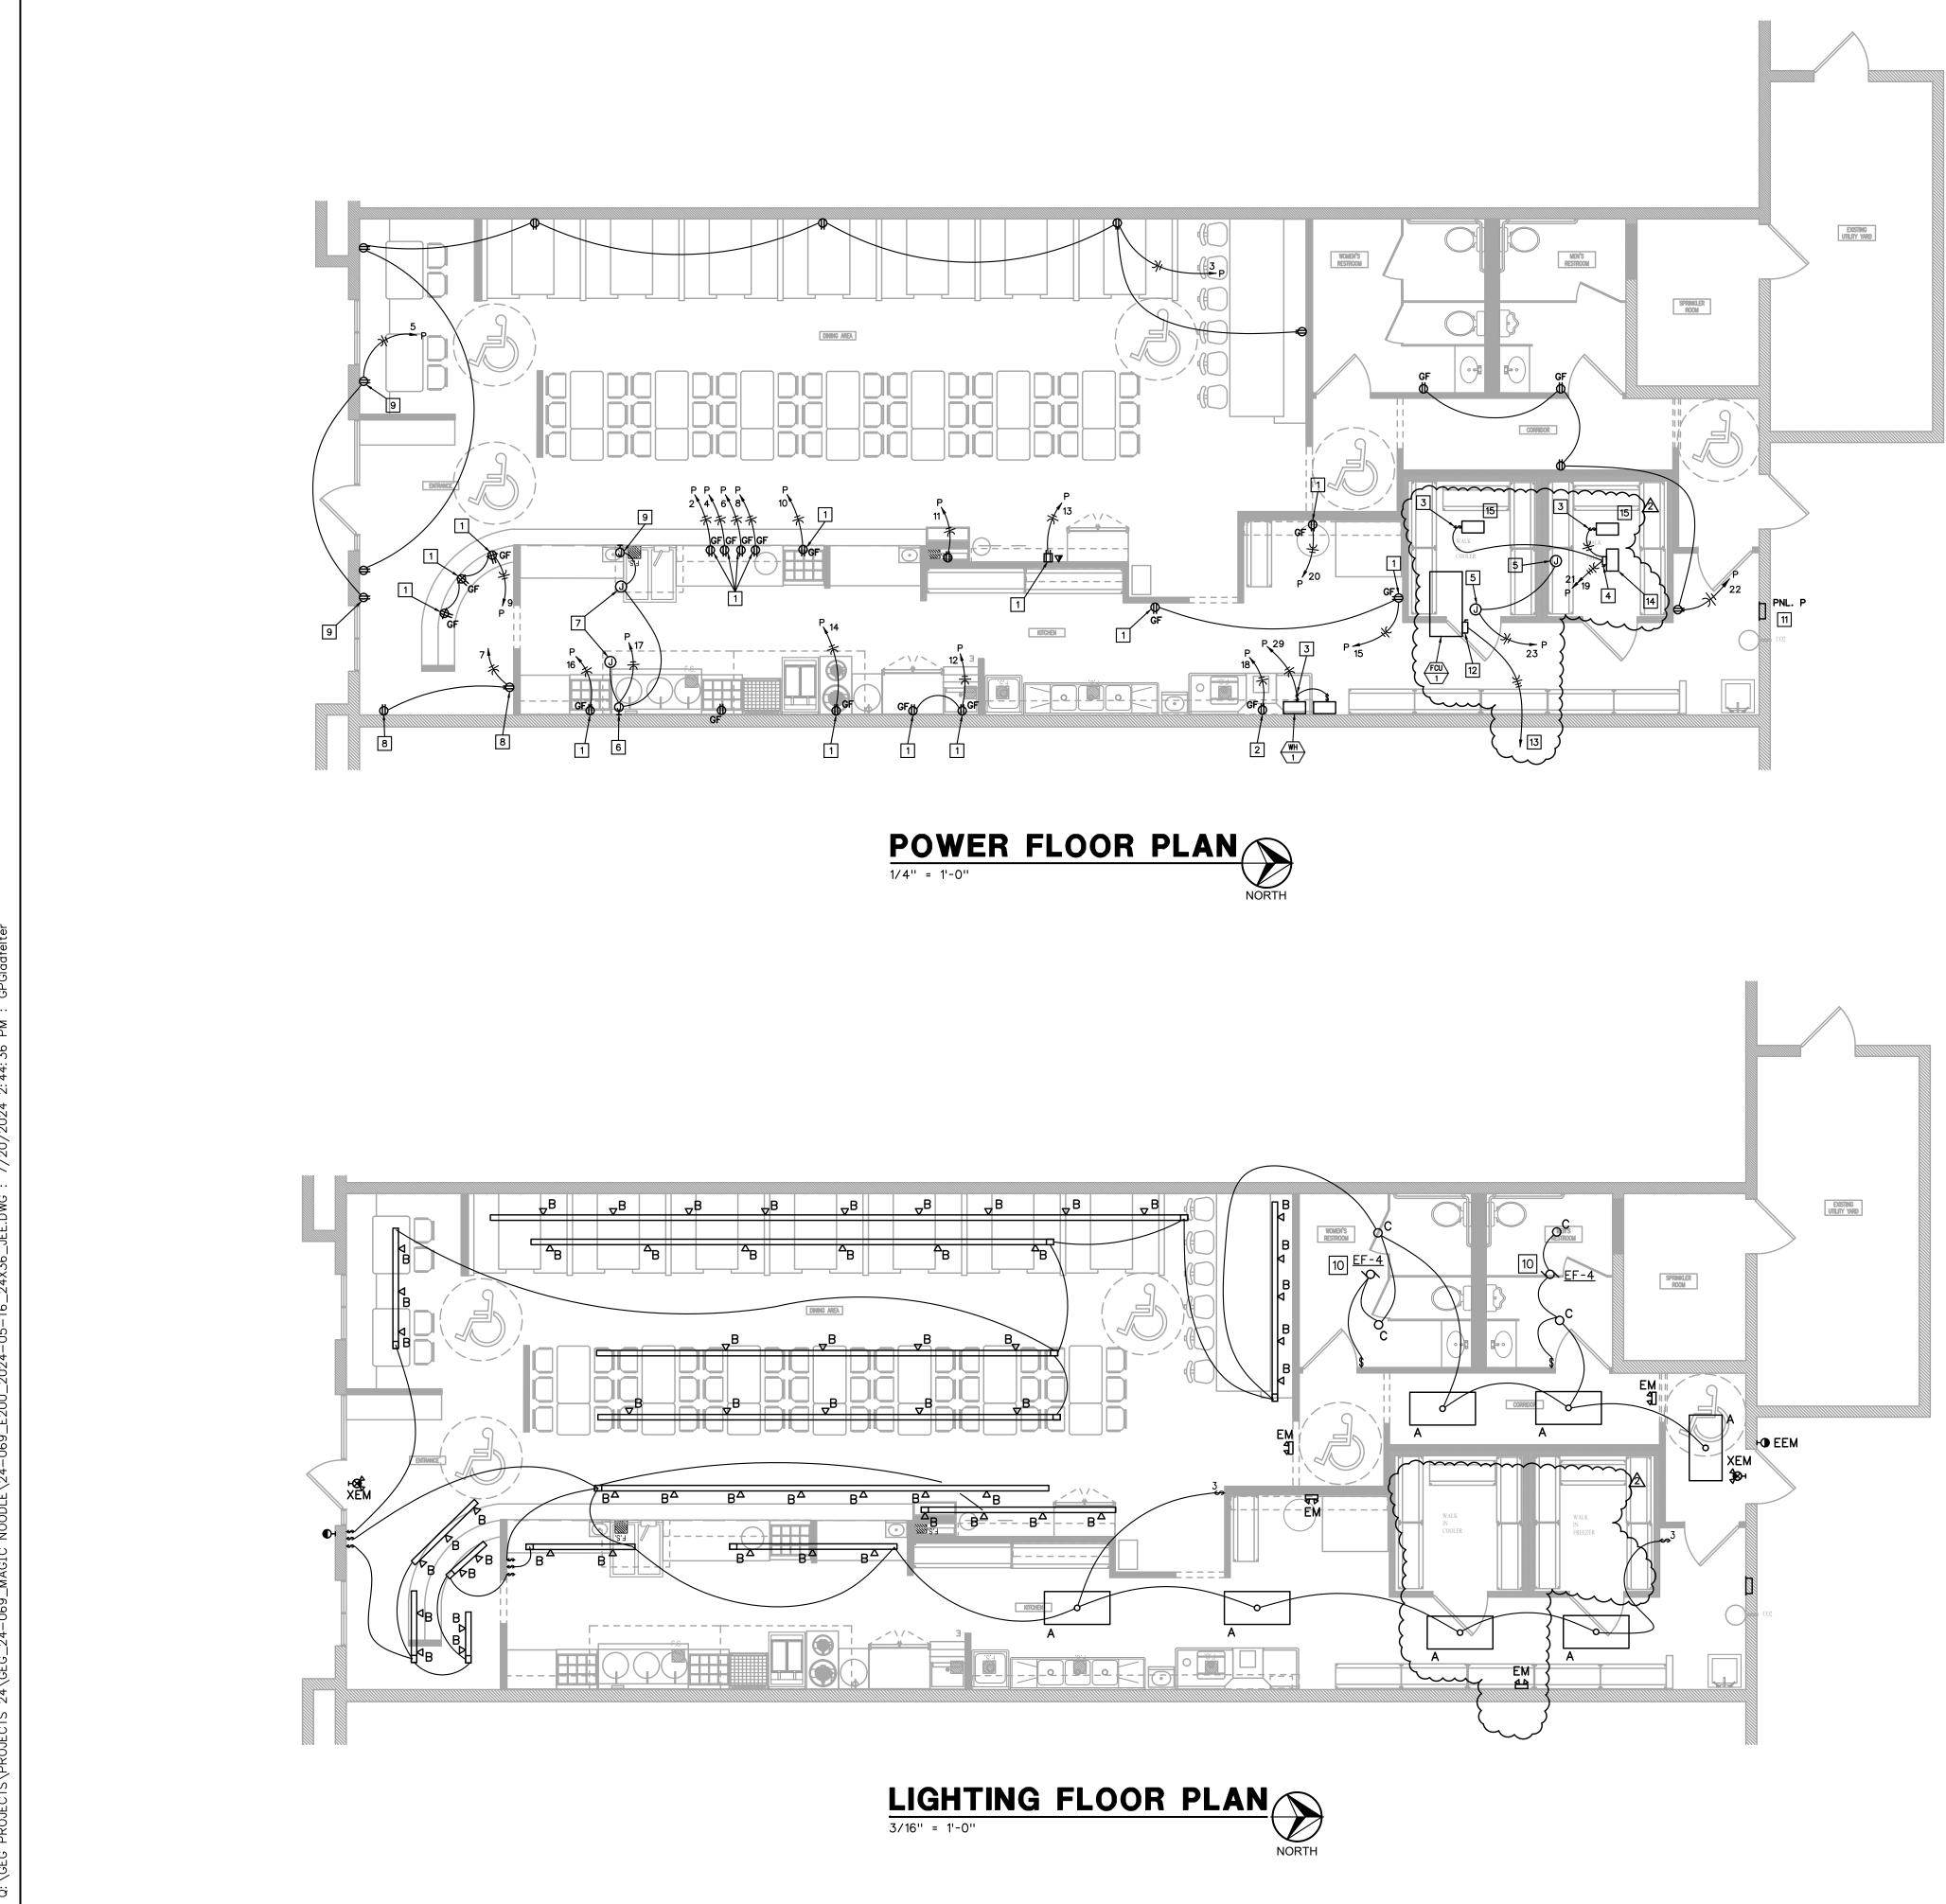


#### RELEASED FOR CONSTRUCTION As Noted on Plans Review lopment Services Departme Lee's Summit, Missouri 08/09/2024

## ELECTRICAL PLAN NOTES

- 1. INSTALL OUTLET BOX FOR WIRING DEVICE AT 48" AFF.
- 2. RECEPTACLE FOR DISHWASHER INSTALLED BELOW COUNTERTOP. INSTALL IN AN ACCESSIBLE MANNER.
- 3. 20A/1P, HORSEPOWER RATED TOGGLE SWITCH FOR DISCONNECTING MEANS INSTALLED ON SIDE OF UNIT. DO NOT INSTALL ON ACCESS PANEL.
- 30A/2P, NON-FUSED, NEMA 3R DISCONNECT SWITCH INSTALLED ON SIDE OF UNIT. DO NOT INSTALL ON ACCESS PANEL.
- 5. J-BOX FOR CONNECTION OF WALK-IN LIGHTS AND CONTROLS. VERIFY EXACT LOCATION AND MOUNTING HEIGHT WITH OWNER/ARCHITECT PRIOR TO ROUGH-IN.
- 6. J-BOX FOR CONNECTION OF HOOD/ANSUL. VERIFY EXACT LOCATION AND MOUNTING HEIGHT WITH OWNER/ARCHITECT PRIOR TO ROUGH-IN.
- 7. J-BOX FOR CONNECTION OF HOOD LIGHTS AND CONTROLS. VERIFY EXACT LOCATION AND MOUNTING HEIGHT WITH OWNER/ARCHITECT PRIOR TO ROUGH-IN.
- 8. OUTLET BOX FOR WIRING DEVICE INSTALLED AT 6'-0" AFF.
- 9. SHOW-WINDOW RECEPTACLE INSTALLED IN CEILING. INSTALL WITHIN 12" OF WINDOW.
- 10. POWER FROM LIGHTING CIRCUIT.
- 11. COORDINATE LOCATION OF PANEL P WITH THE OWNER. EXTEND MIN. 2" CONDUIT FROM EXISTING 2-1/2" CONDUIT, PULL 3 #3/0 CU AND 1 #6 CU G FROM EXISTING 400-AMP DISCONNECT SWITCH PANEL P. REPLACE EXISTING 400-AMP FUSES WITH 200-AMP FUSES AT DISCONNECT SWITCH (3-POLE).
- 12. 50-AMP, 3-POLE DISCONNECT SWITCH.
- 13. 3/4" C WITH FOUR #8 CU.
- 14. ROOF MOUNTED CONDENSER.
- 15. EVAPORATOR.

### ELECTRICAL GENERAL NOTES

- A) SEE ARCHITECTURAL REFLECTED CEILING PLANS FOR EXACT LOCATION OF LIGHT FIXTURES.
- B) COORDINATE NEMA RATING OF APPLIANCE PLUGS WITH THE EQUIPMENT SPECIFICATIONS.
- C) ALL RECEPTACLES WITHIN 6' OF WATER BEARING FIXTURES, EXTERIOR OUTLETS AND ALL OUTLETS IN KITCHEN AREAS SHALL BE GFI STYLE OR THE CIRCUIT SERVING THOSE DEVICES SHALL BE PROTECTED BY MEANS OF A GFI CIRCUIT BREAKER.
- D) OUTLET AND SWITCH BOXES INSTALLED IN RATED WALLS SHALL BE PROVIDED WITH UL LISTED PUTTY PADS TO PROTECT THE RATING OF THE WALL.
- E) CONNECT ALL NIGHT LIGHT, EXIT LIGHT AND EMERGENCY LIGHT FIXTURES TO UNSWITCHED HOT-LEG OF NEAREST 120V LIGHTING CIRCUIT IN SAME AREA.
- F) VERIFY EXISTING CONDITIONS BEFORE COMMENCING WORK.

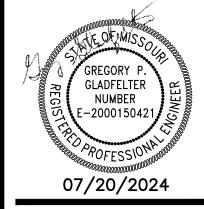

Ш NUT NO MIT 00 00 N M N Ż≿ O d o MAGI 20 SW LEE'S 9

·	Gladfelter Engineering Group Phone: 86-96-465 Phone: 86-96-465 Email gogeoconsort.com
Date: 05/17/24	Issued for: PERMIT
06/10/24 07/20/24	CITY COMMENTS
Project nur	nber: 24-069
Drawn:	JEE/SWB/GPG
Date:	2024/04/13
Sheet Numb	

