

2x4 minimum squash blocks

INSTALLATION GUIDE FOR

SCAN WITH YOUR SMAKIFRO DAMAGE REPORTING

DAMAGE REPO MOBILE TOOL

FLOOR AND ROOF FRAMING

Use 2x4 minimum squash blocks to

Trus Joist

required on both

sides at E1W ONLY

| E1 | E1W

8" diameter maximum hole for 11\%" -

16" deep blocking panels; 6" diameter

maximum for blocking panels 9½"

deep or shorter than 12" long.

11/8" TJ® Rim Board or

Nail with 10d (0.131" x 3")

nails, one each at top and

Do not cut flanges

1¹/₄" or 1¹/₂" TimberStrand® LSL.

Adjust joist up to 3" to allow for


Max clear span at L/480 and max

24" o.c. spacing. 9 1/2" 210 16" o.c. 15'9"

11 7/8" 210 16" o.c. 18'8"

Plumbing and Mechanical installation

transfer load around TJI® joist

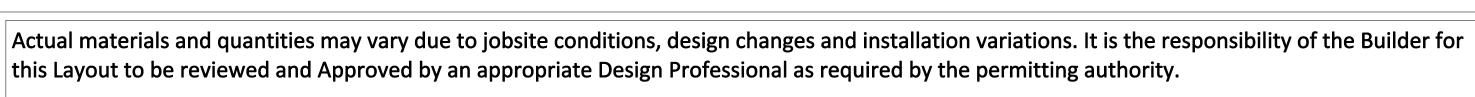

RELEASE FOR CONSTRUCTION

AS NOTED FOR PLAN REVIEW

DEVELOPMENT SERVICES


LEE'S SUMMIT, MISSOURI


08/19/2024

ALL ROOF LOADS ASSUMED TO BE SUPPORTED AT EXTERIOR WALLS AND BEAMS BY OTHERS, IF APPLICABLE, UNLESS OTHERWISE NOTED.


NO ROOF LOADS APPLIED TO


210'S 16" O.C. **UNLESS OTHERWISE NOTED**

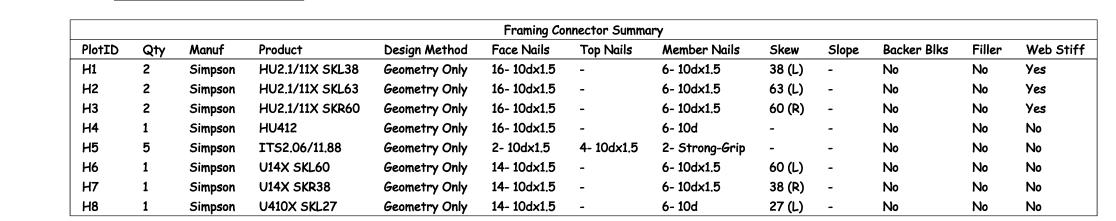

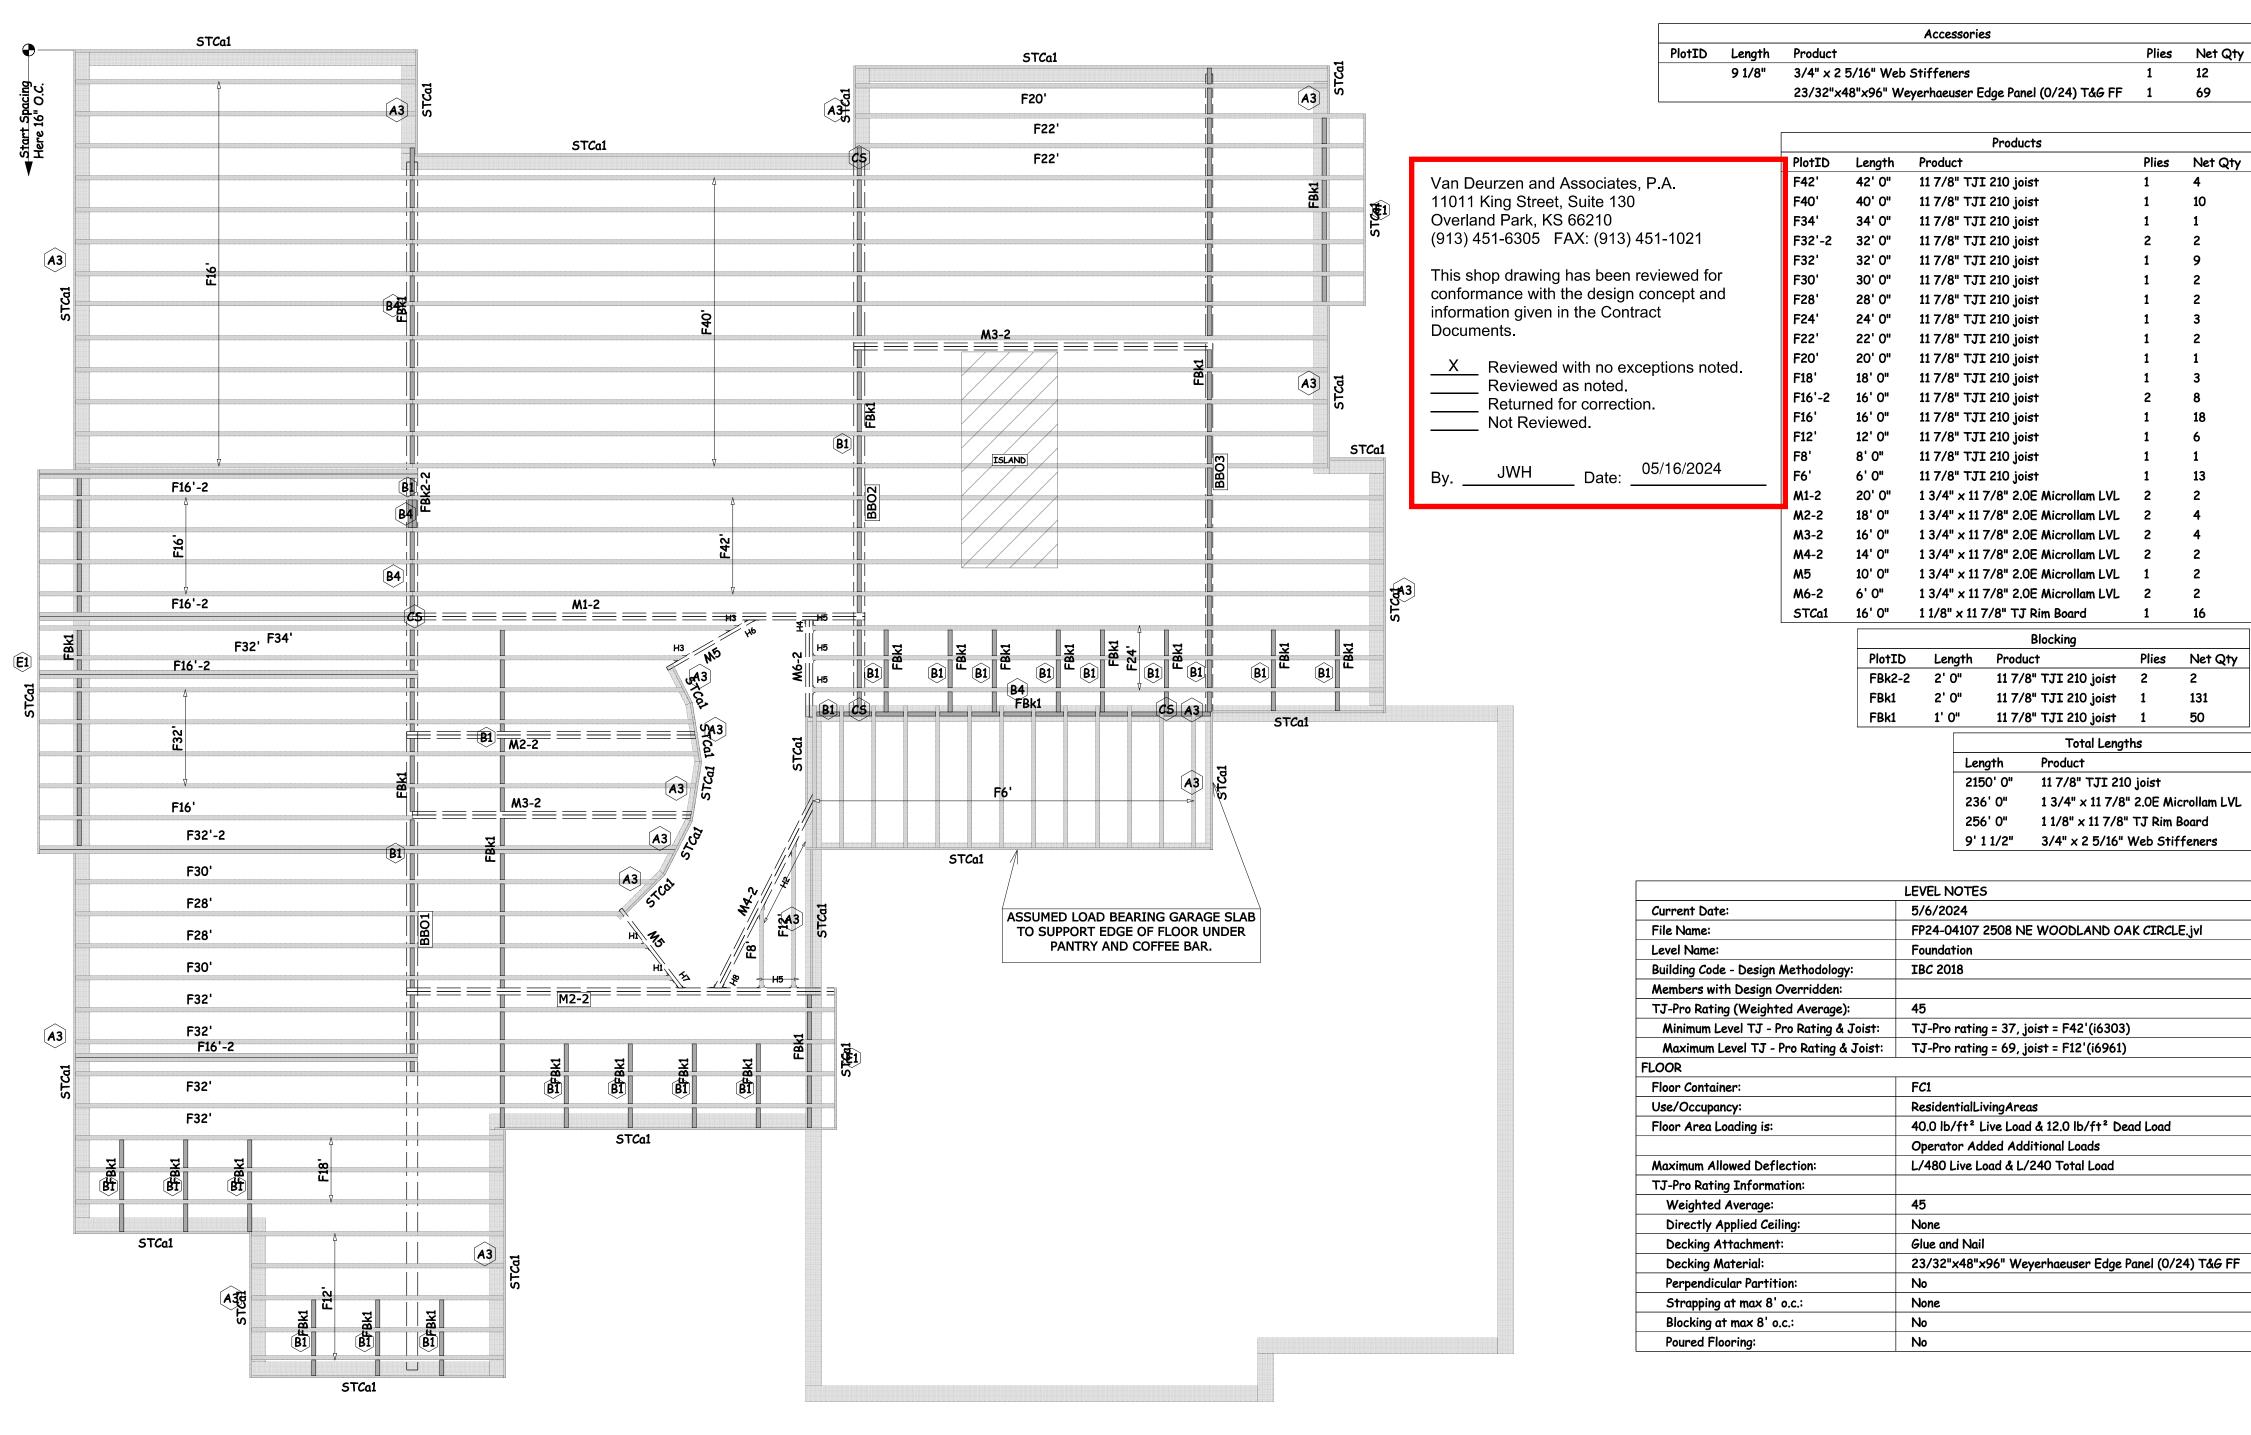



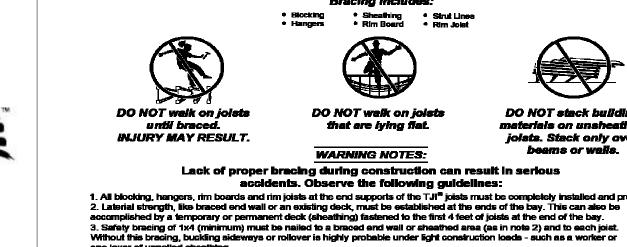

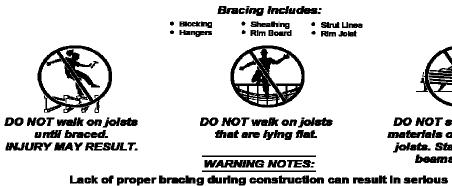

WARNING

accidents. Observe the following guidelines:


one layer of unnalled sheathing.


4. Sheathing must be completely attached to each TJI[®] joist before additional loads can be placed on the system of cantilevers require safety bracing on both the top and bottom flanges.

6. The flanges must remain straight within 1/2" from true alignment.

★ Weyerhaeuser, Microllam, Parallam, TimberStrand, TJI, TJ, and Trus Joist are registered trademarks of Weyerhaeuser NR. © 2014 Weyerhaeuser NR Company. All rights reserved.



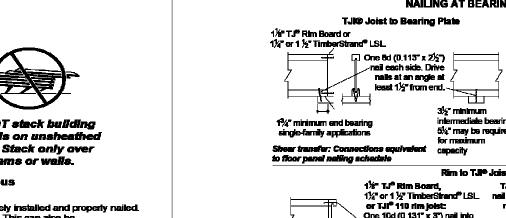

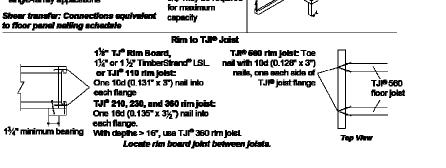

One 10d (0.128" x 3")

nail into each flange

This layout is intended for product application assurance and is not intended to circumvent the need for a design professional as determined by the Building Codes. The designer of record and/ or builder/ framer is responsible to assure these drawings are compatible with the overall project.

Weyerhaeuser

Construction Detail Callout (See Framer's Pocket Guide Excessive Point Load er 12K | AWARNING: Member design did no clude this load. Special conside is required by the designer of record.) Required Bearing Length (Only placed at insufficient bearing

Y PREPARED BY JOHN KLOZIK FOREST PRODUCTS SUPPLY

Mead Lumber


Woodland 뮐

08

SCALE

1/4"=1'-0" PROJECT #: FP 24-04107

5/6/2024

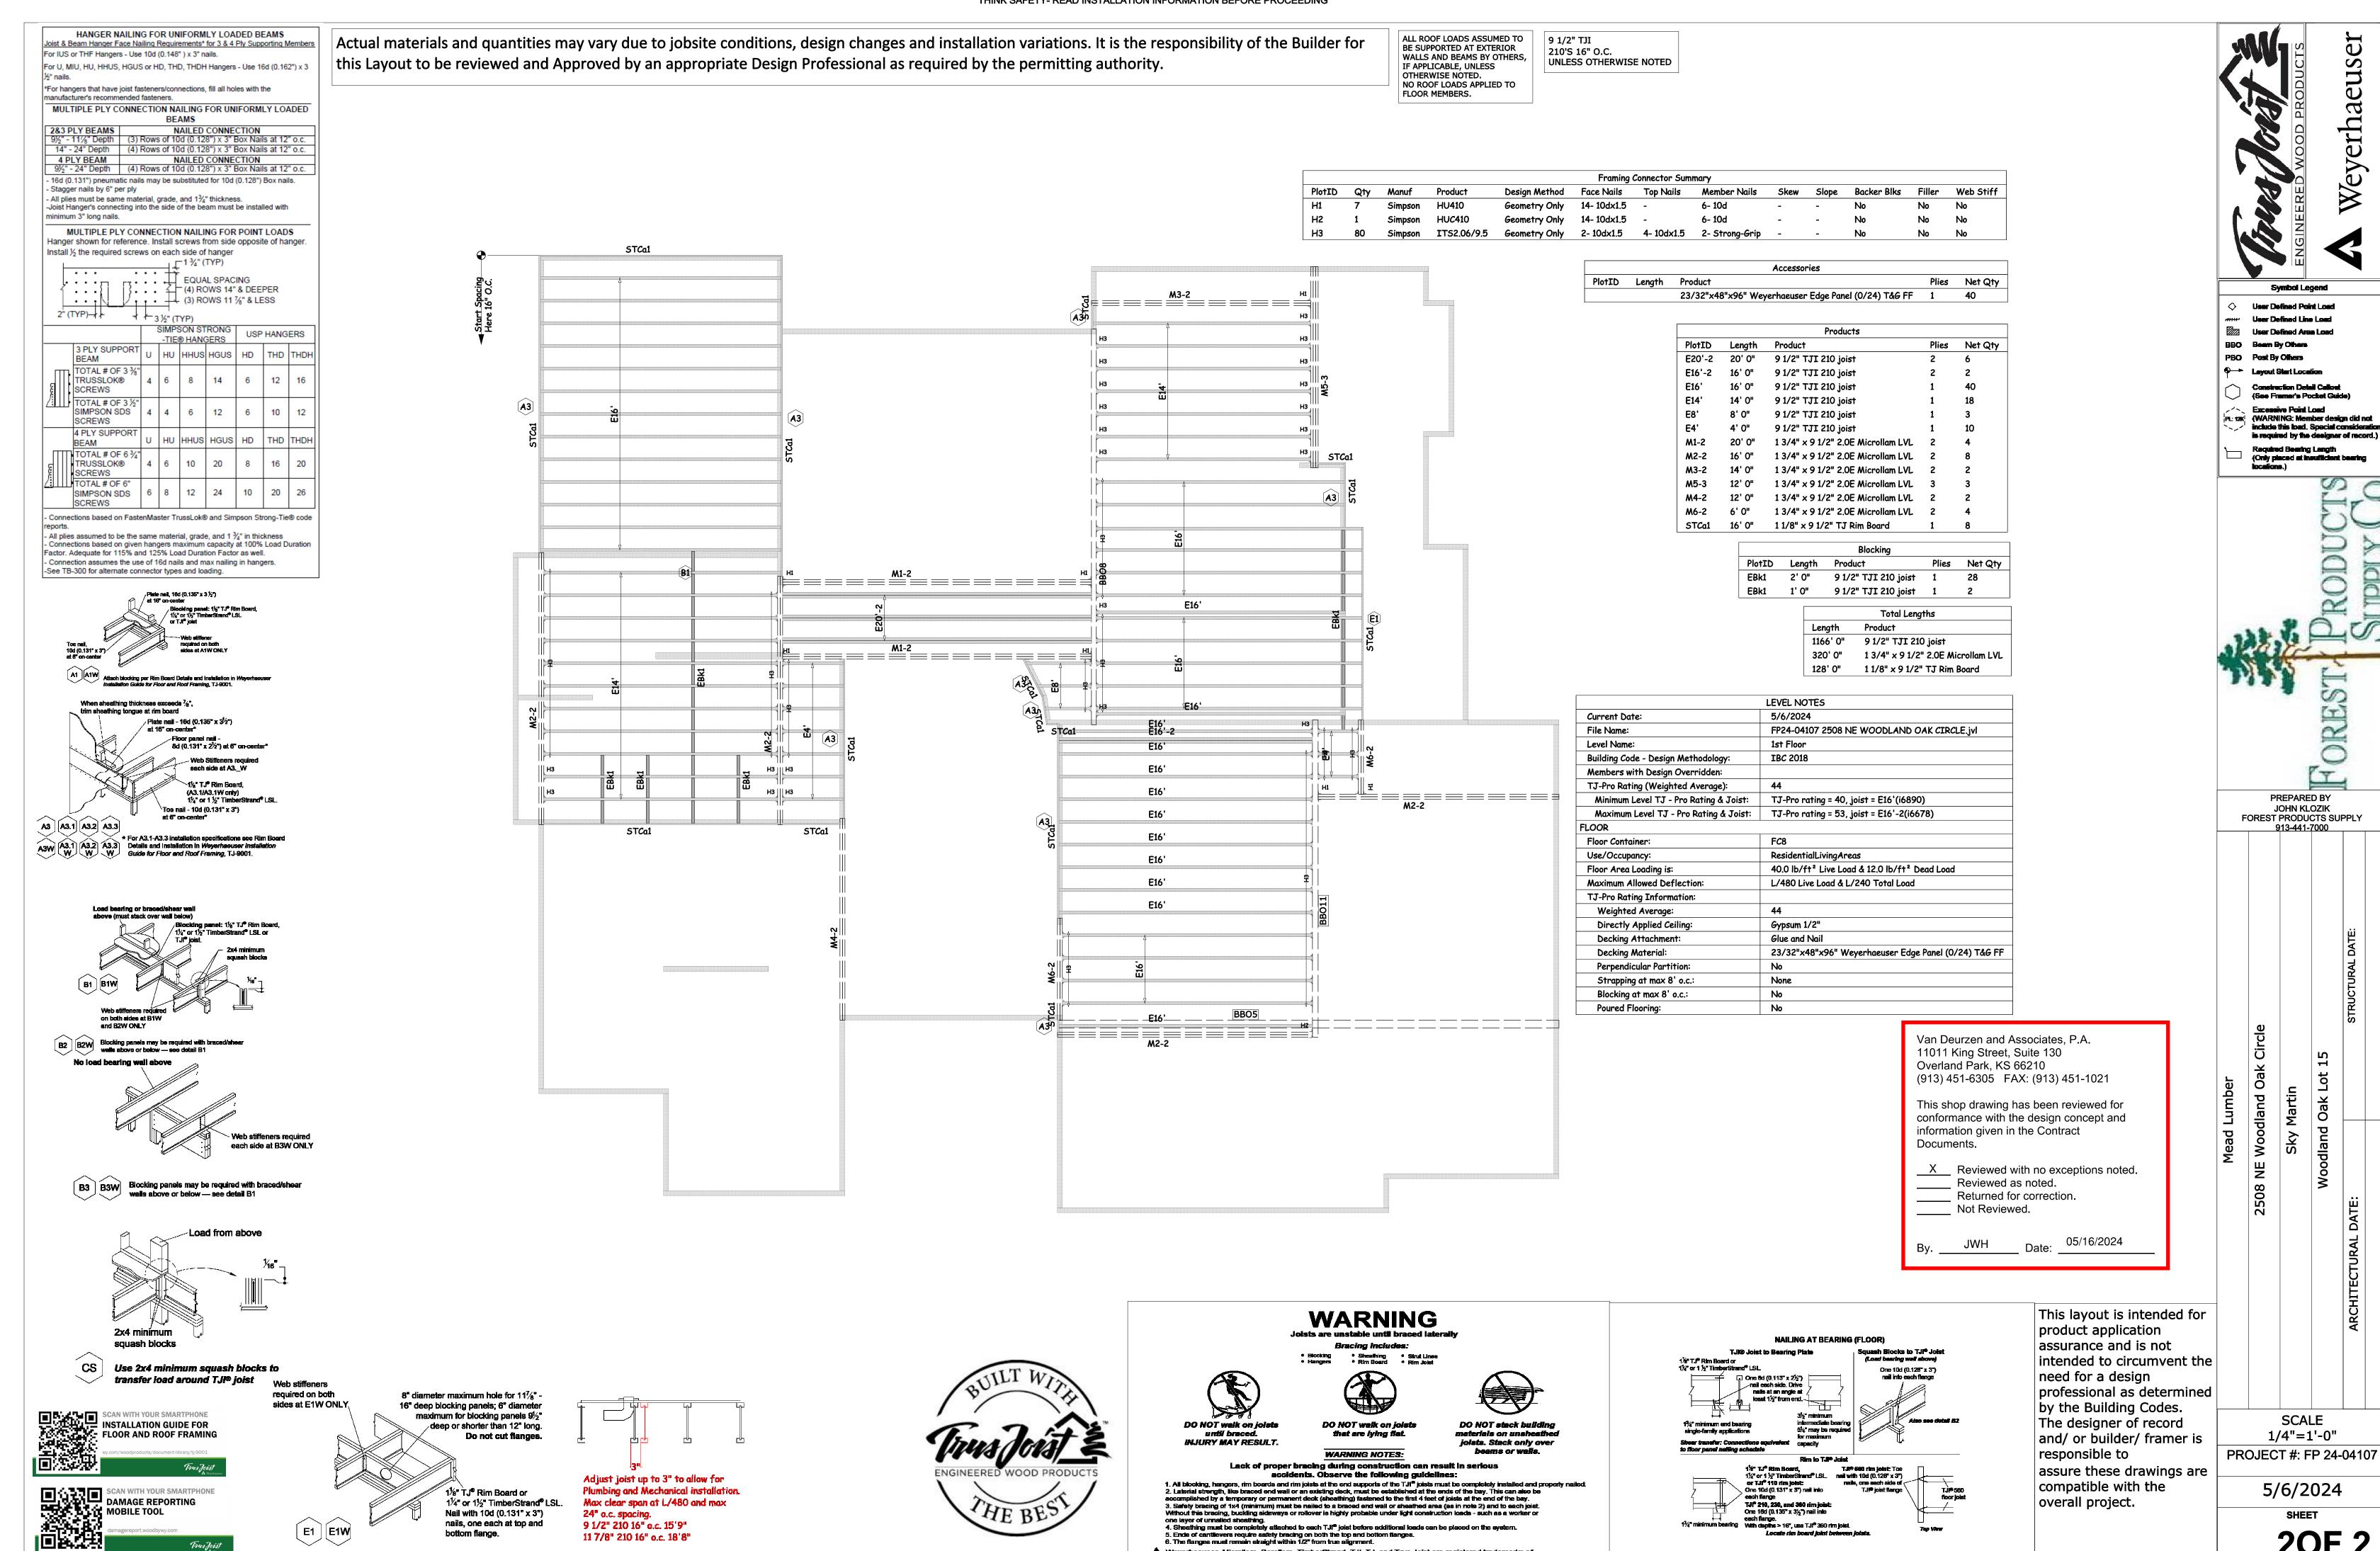

A Weyerhaeuser, Microllam, Parallam, TimberStrand, TJI, TJ, and Trus Joist are registered trademarks of

Weyerhaeuser NR. © 2014 Weyerhaeuser NR Company. All rights reserved.