



1. Hold finish grade min 6" below bottom of siding or wood framing

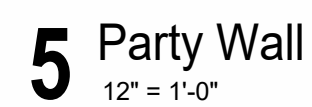

RELEASE FOR CONSTRUCTION  
AS NOTED FOR PLAN REVIEW  
DEVELOPMENT SERVICES  
LEE'S SUMMIT, MISSOURI

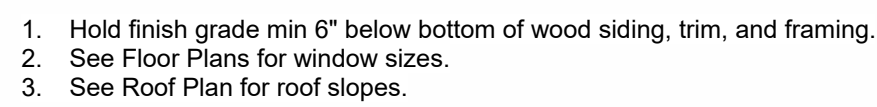

Area Summary per Unit

Covered Patio	
64 SF	1-Floor
64 SF	
Covered Porch	
37 SF	1-Floor
37 SF	
Finished	
976 SF	0-Floor
1,311 SF	1-Floor
2,287 SF	
Garage	
452 SF	1-Floor
452 SF	
Storage	
788 SF	0-Floor
788 SF	
3,627 SF	

Floor Plan Notes

- Unless noted otherwise, exterior wall dimensions are to face of stud or concrete. Interior wall dimensions are to face of finish. Wall thickness dimensions are nominal. Coordinate precision with abutting elements.
- Window and door tags indicate sash or leaf sizes. Example: 3068 = 3'-0" x 6'-8". Tag suffix as follows: C = Casement, F = Fixed, DH = Double-hung, SH = Single-hung, T = Transom, E = Egress, S = Slider. See Elevations for window and door types.
- Field verify all existing conditions relevant to the work.
- Loose furnishings, if shown, are by Owner.
- Mechanical and electrical designs are by design-build contractors who are responsible for coordinating with Owner's requirements and code conformance.
- All sleeping rooms shall have at least one egress window per IRC R310. See Project Notes and Window Schedule.
- Fire resistant construction, if required, shall comply with IRC R302. See Project Notes.
- Safety glazing, where required, shall comply with IRC R308.
- Garage floor slab shall comply with IRC R309.
- Emergency egress paths such as floors and landings at exterior doors, stairs, and hallways shall comply with IRC R311.
- Where window sills are 24" or lower, provide window fall protection per IRC R312.
- Refer to IRC R317 for preservative treated wood requirements.
- Refer to IRC R318 for termite protection requirements.
- Provide smoke detector, hard-wired and interconnected, in each sleeping room per IRC 314.
- Provide combination smoke/carbon monoxide detector, hard-wired and interconnected, outside each group of sleeping rooms and inside the interior garage door per IRC 315.

Jurisdiction Approval Stamp:

BILL FOWLER ARCHITECT

3601 W 122nd Terrace  
Lee's Summit, MO 64029  
913.908.5393  
BFWFOWLER@ME.COM

N C A R B  
National Council of  
Architectural Registration Boards  
Project:



6/4/24

Twin Villa

Woodland Glen Lot 53

Location:  
1442-1444 SW Winthrop Ter, Lee's Summit, MO

Client Contact:  
John Duggan  
(913) 498-3536 / jduggan@kc-dslaw.com

Revisions

NO. DATE DESCRIPTION

Sheet Name:

Basement Plan

Sheet No:

A21

PERMIT SET

Date:

6/4/24

BFA No:

TWIN-WG53

RELEASE FOR CONSTRUCTION

AS NOTED FOR PLAN REVIEW

DATE: 09/26/2024


LEE'S SUMMIT, MISSOURI

Plan North




1 Basement Floor Plan


1/4" = 1'-0"

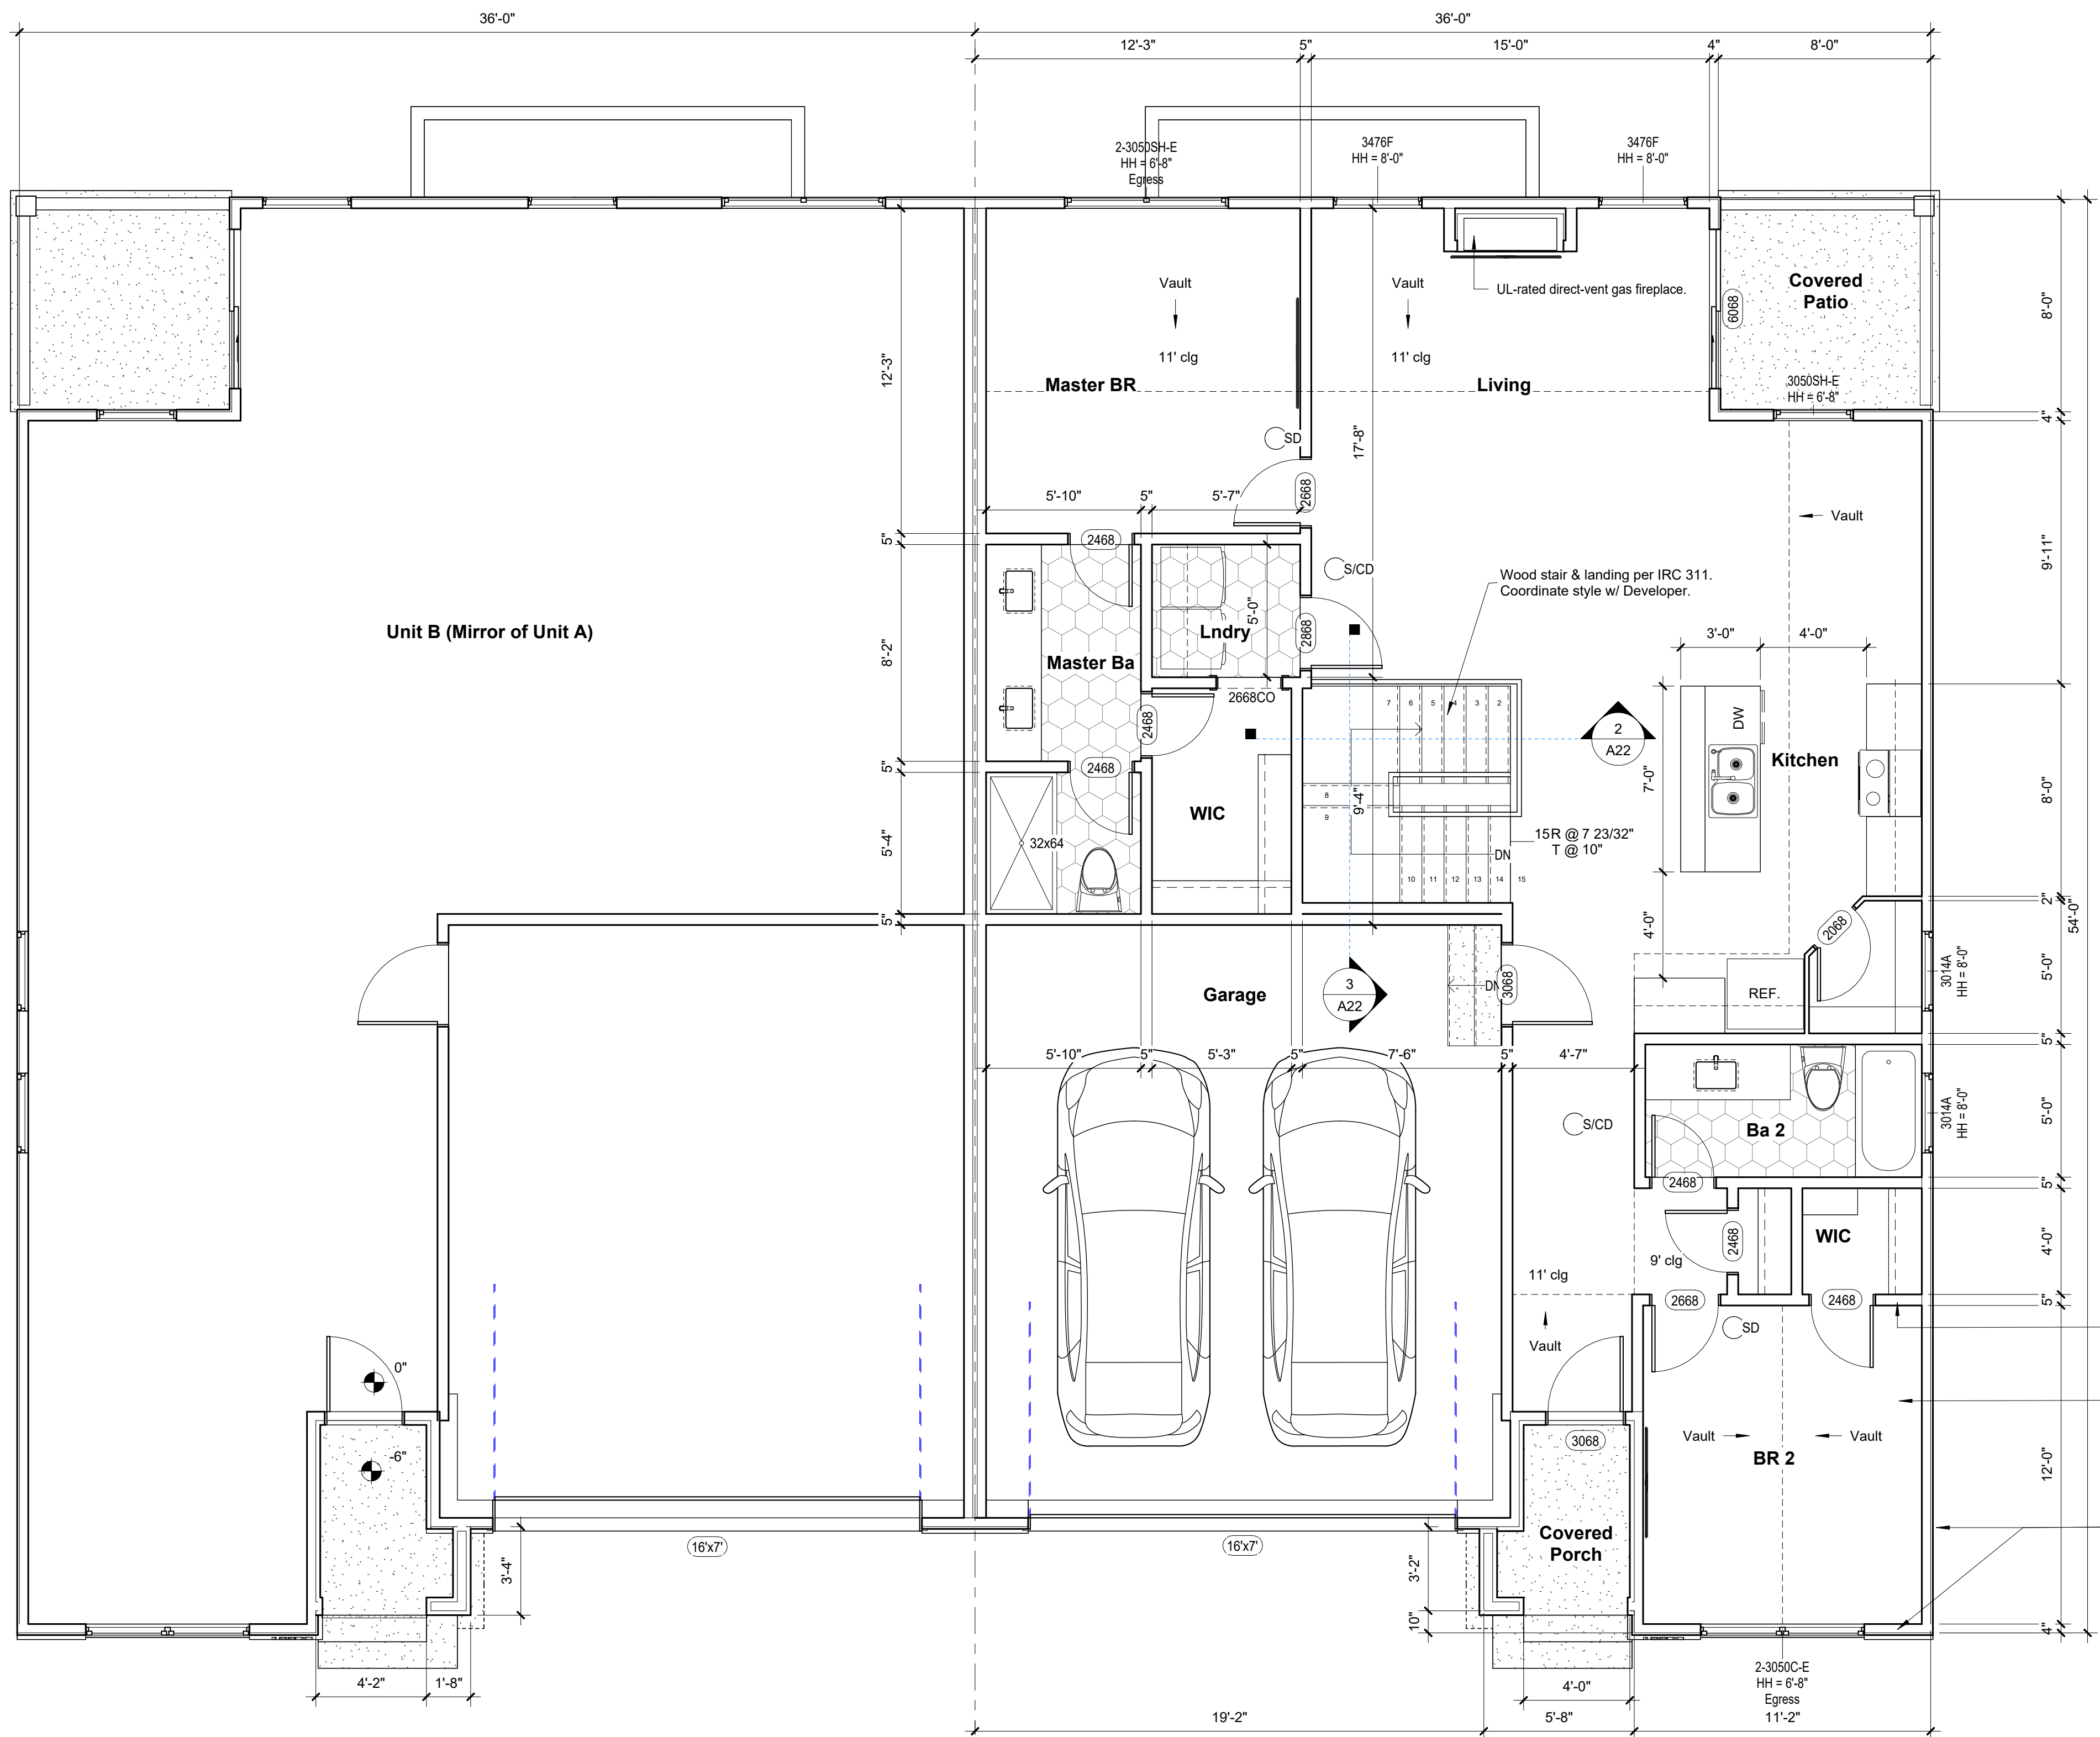

Plan North  
**1** First Floor Plan  
1/4" = 1'-0"

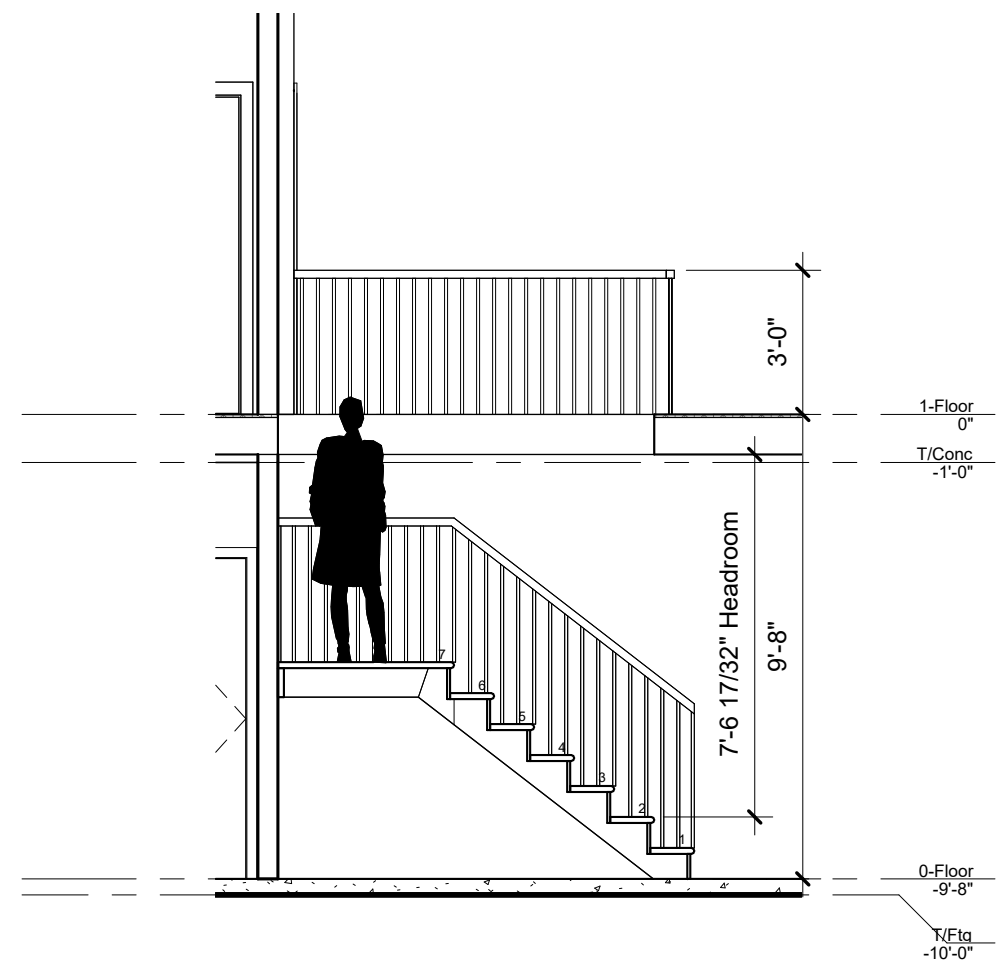

**2** Stair Headroom  
1/4" = 1'-0"

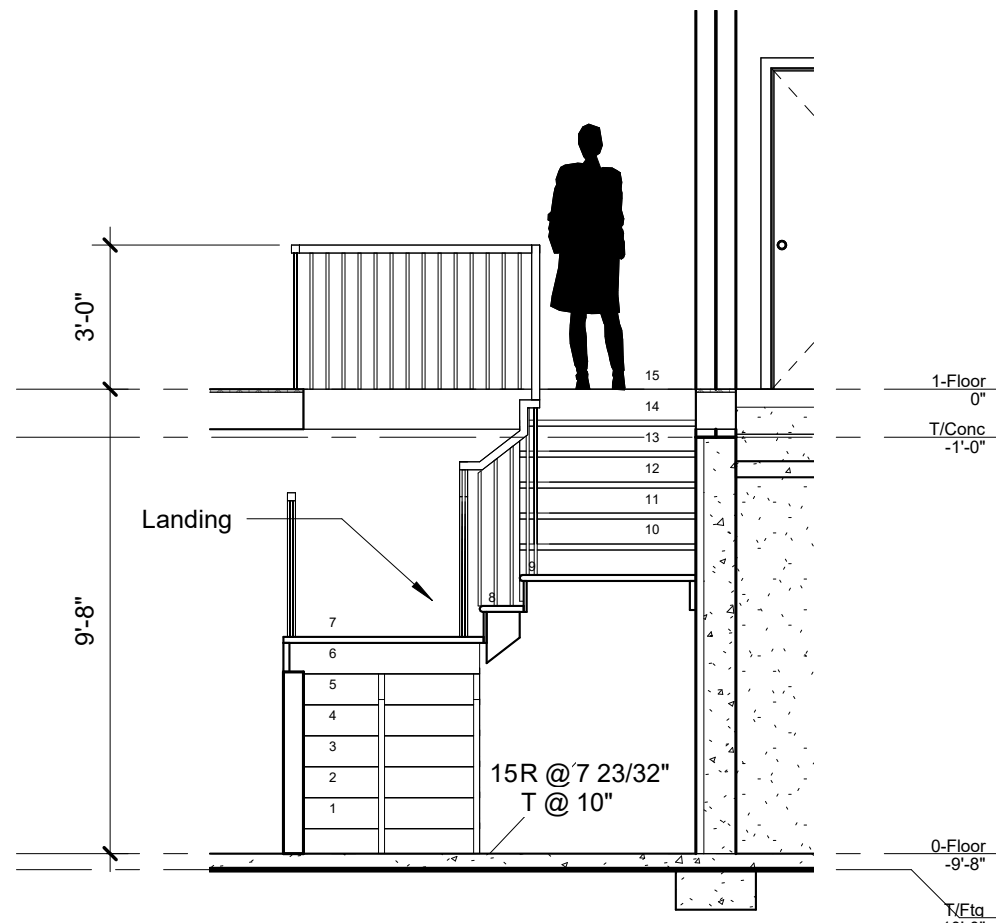

**3** Stair Landing  
1/4" = 1'-0"

## Area Summary per Unit

Covered Patio	
64 SF	1-Floor
64 SF	
Covered Porch	
37 SF	1-Floor
37 SF	
Finished	
976 SF	0-Floor
1,311 SF	1-Floor
2,287 SF	
Garage	
452 SF	1-Floor
452 SF	
Storage	
788 SF	0-Floor
788 SF	
3,627 SF	

## Floor Plan Notes

- Unless noted otherwise, exterior wall dimensions are to face of stud or concrete. Interior wall dimensions are to face of finish. Wall thickness dimensions are nominal. Coordinate precision with abutting elements.
- Window and door tags indicate sash or leaf sizes. Example: 3068 = 3'-0" x 6'-8". Tag suffix as follows: C = Casement, F = Fixed, DH = Double-hung, SH = Single-hung, T = Transom, E = Egress, S = Slider. See Elevations for window and door types.
- Field verify all existing conditions relevant to the work.
- Loose furnishings, if shown, are by Owner.
- Mechanical and electrical designs are by design-build contractors who are responsible for coordinating with Owner's requirements and code conformance.
- All sleeping rooms shall have at least one egress window per IRC R310. See Project Notes and Window Schedule.
- Fire resistant construction, if required, shall comply with IRC R302. See Project Notes.
- Safety glazing, where required, shall comply with IRC R308.
- Garage floor slab shall comply with IRC R309.
- Emergency egress paths such as floors and landings at exterior doors, stairs, and hallways shall comply with IRC R311.
- Where window sills are 24" or lower, provide window fall protection per IRC R312.
- Refer to IRC R317 for preservative treated wood requirements.
- Refer to IRC R318 for termite protection requirements.
- Provide smoke detector, hard-wired and interconnected, in each sleeping room per IRC 314.
- Provide combination smoke/carbon monoxide detector, hard-wired and interconnected, outside each group of sleeping rooms and inside the interior garage door per IRC 315.

Jurisdiction Approval Stamp:

## BILL FOWLER ARCHITECT

3601 W 122nd Terrace  
Lee's Summit, MO 64089  
913.908.5393  
BFWFOWLER@A22.COM



N C A R B B  
National Council of  
Architectural Registration Boards  
Project:

6/4/24

Twin Villa

Woodland Glen Lot 53

Location:  
1442-1444 SW Winthrop Ter, Lee's Summit, MO

Client Contact:  
John Duggan  
(913) 498-3536 / jduggan@kc-dslaw.com

## Revisions

NO.	DATE	DESCRIPTION
-----	------	-------------

Sheet Name:

First Floor Plan


Sheet No: 6/4/24

**A22**  
BFA No: TWIN-WG53

PERMIT SET

RELEASE FOR CONSTRUCTION  
AS NOTED FOR PLAN REVIEW  
DATE: 09/26/2024



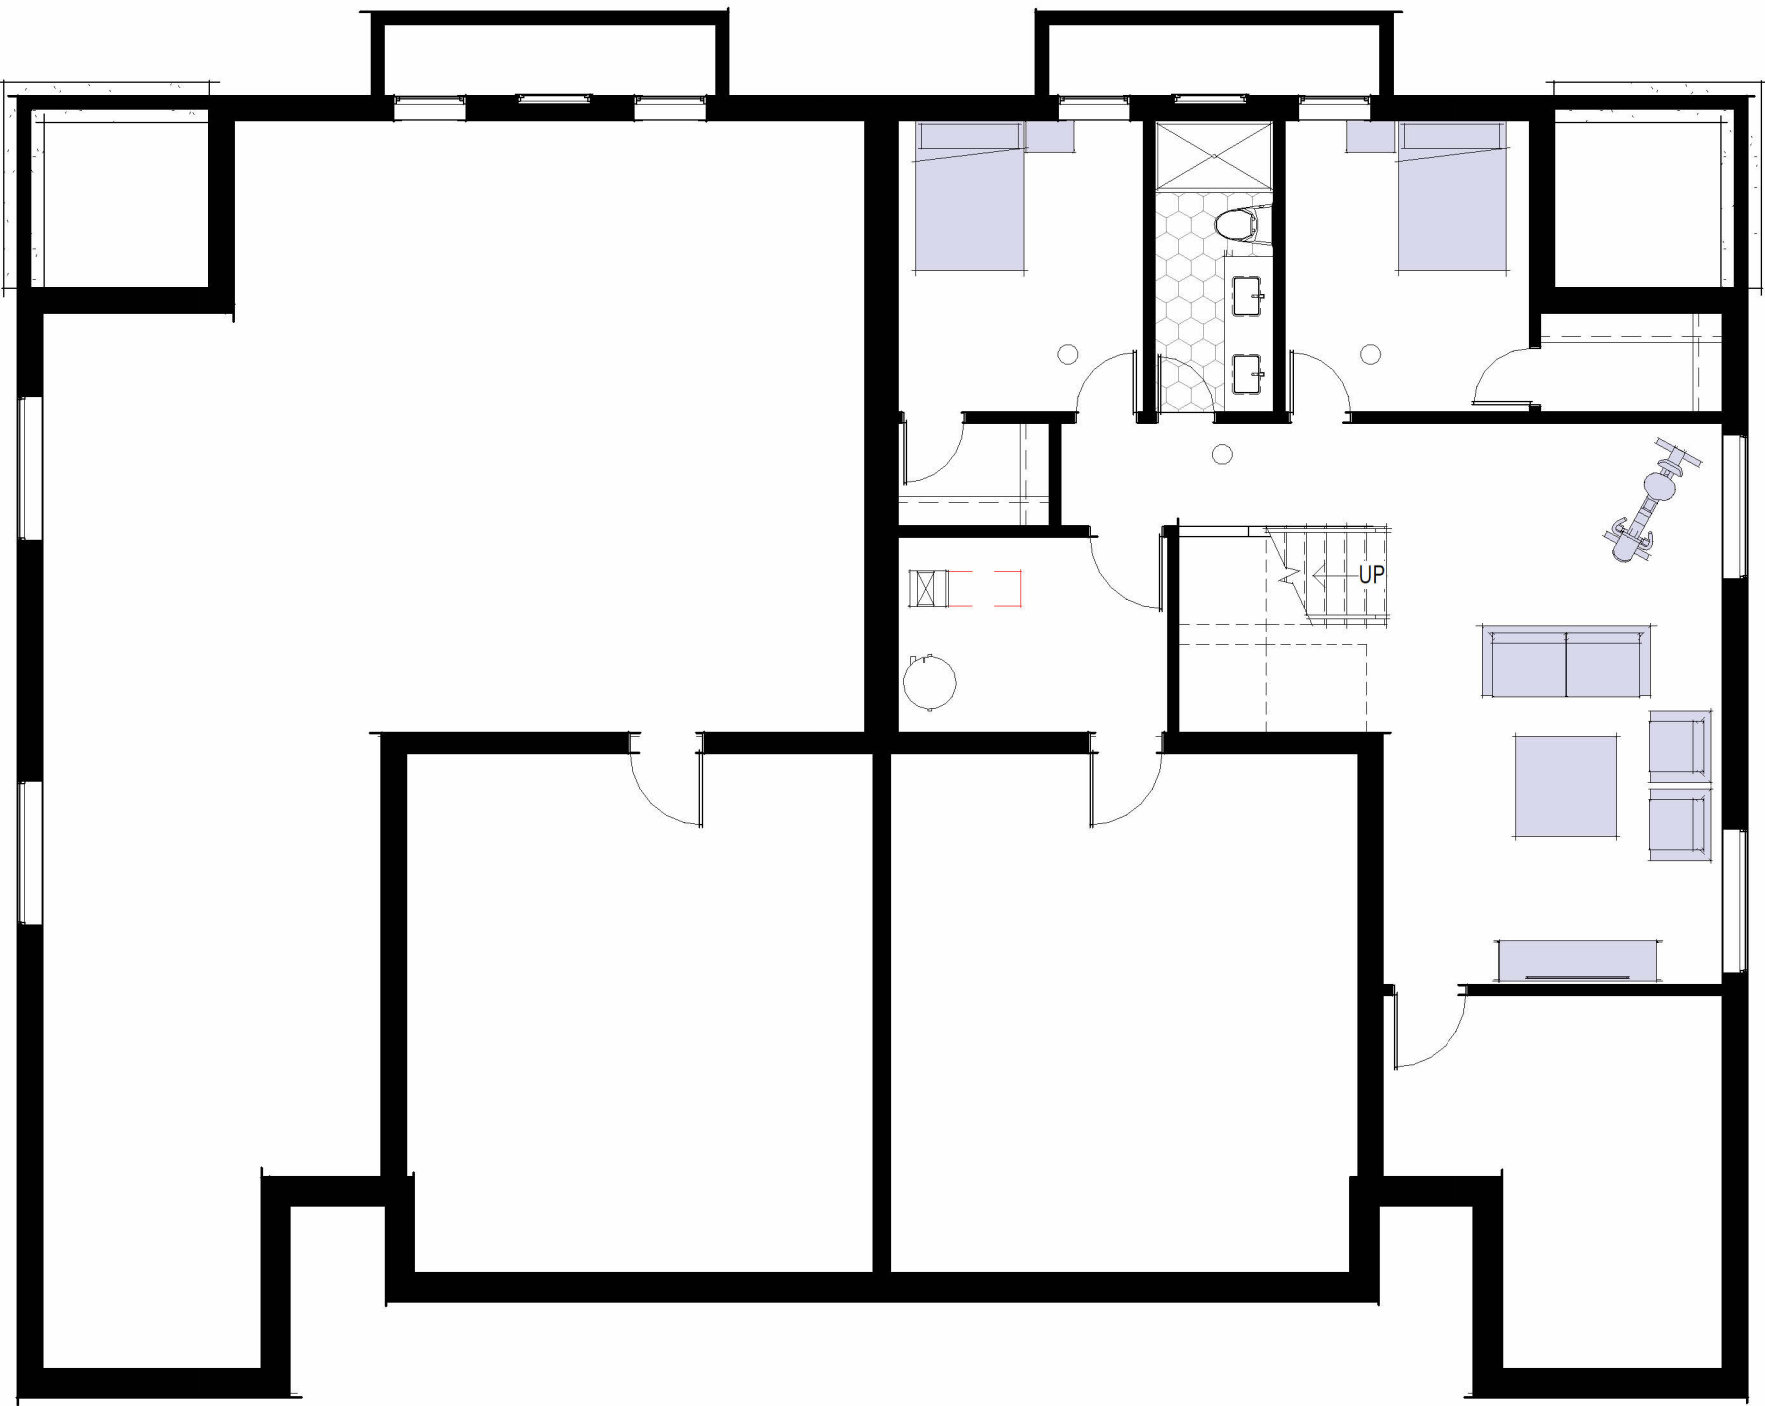


Plan North  
1 Basement Floor Plan  
1/8" = 1'-0"

Furnishing Plan Notes

1. Loose furnishings are by others - not in contract.
2. Furnishing layout is preliminary and must be coordinated with Developer.
3. Furnishing layout is provided as a suggestion to aid in locating electrical and media outlets.

Jurisdiction Approval Stamp:

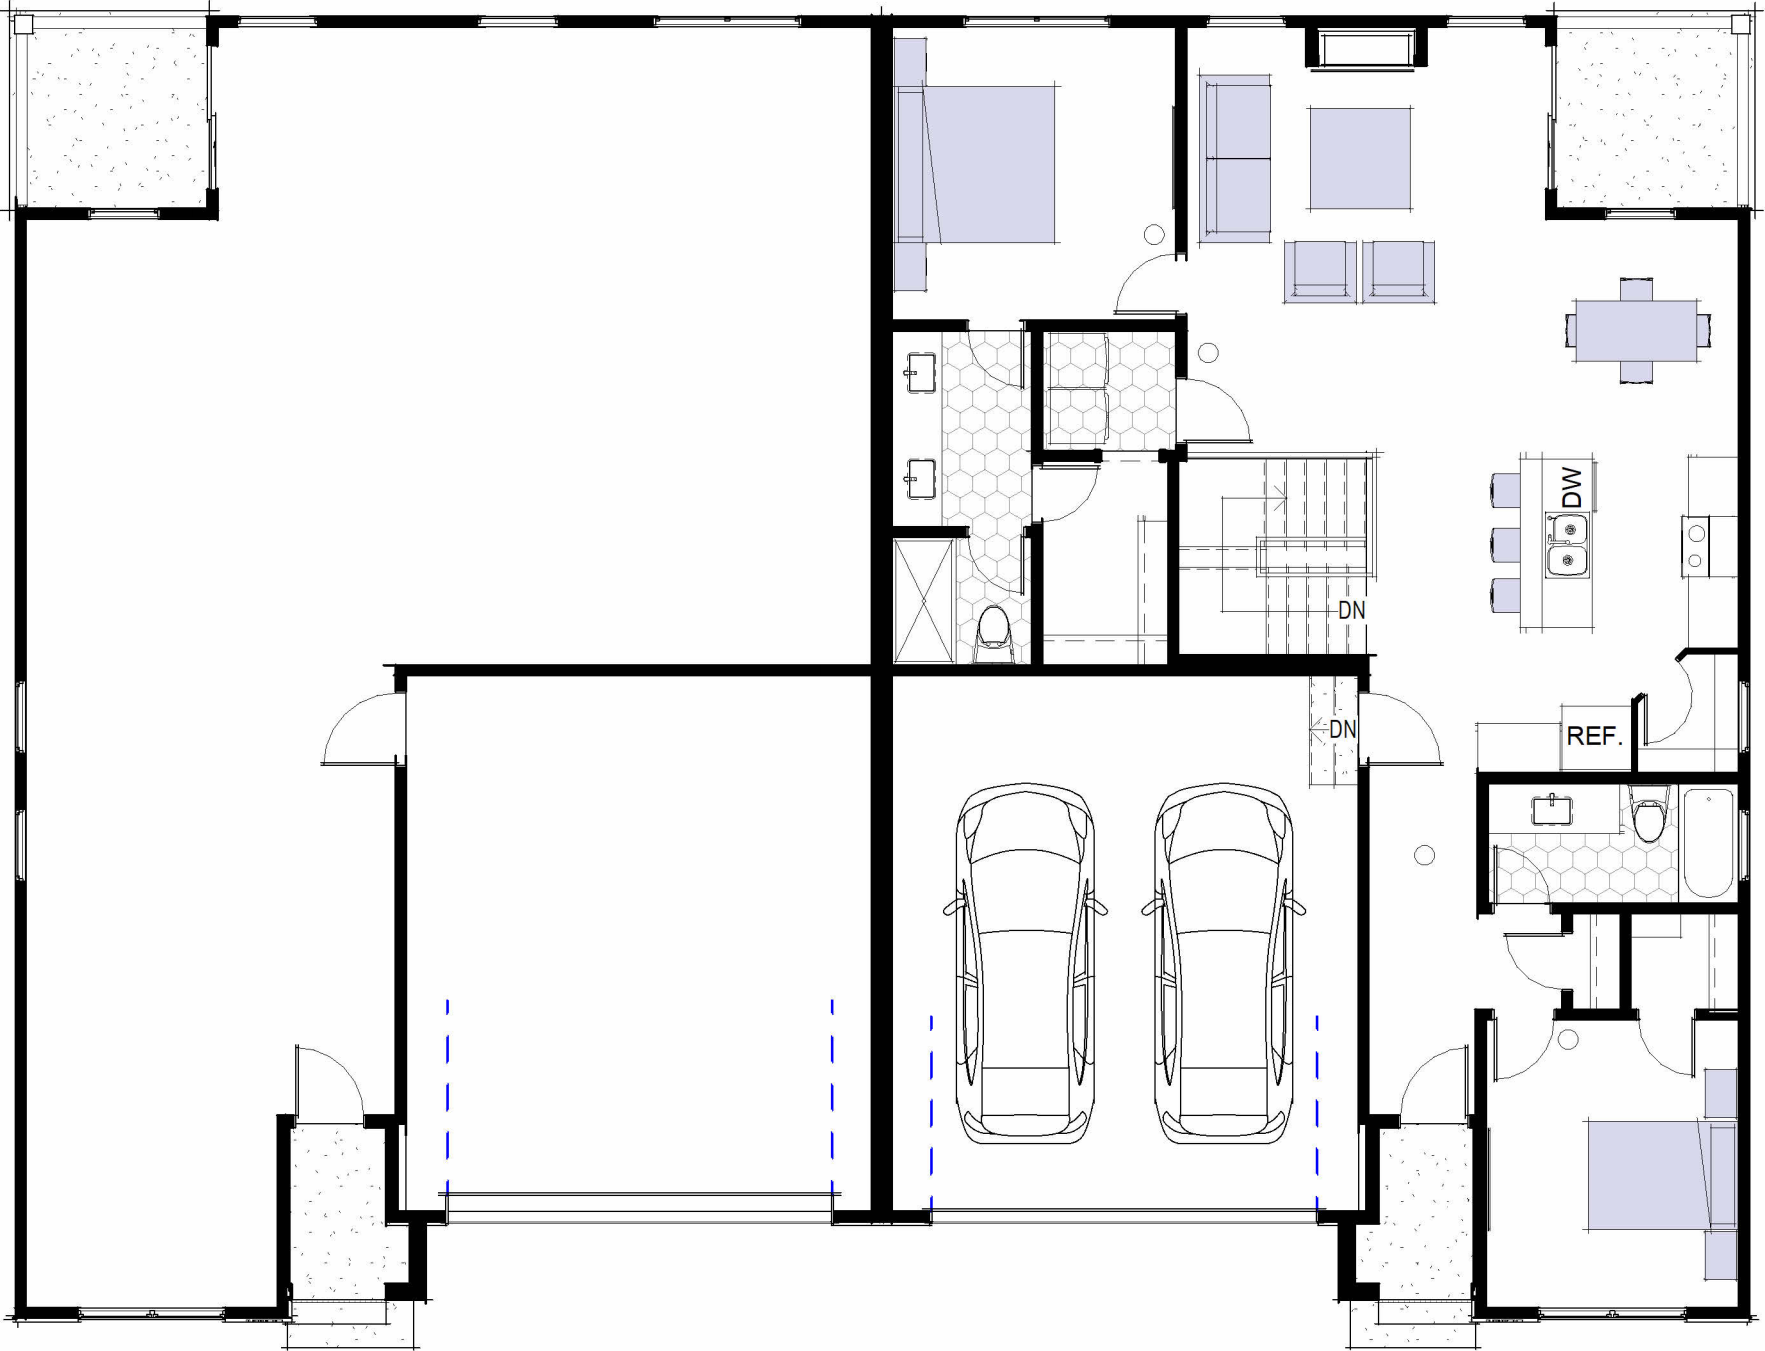

Plan North  
2 First Floor Plan  
1/8" = 1'-0"

BILL FOWLER ARCHITECT

3601 W 122nd Terrace  
Lee's Summit, MO 64029  
913.908.5383  
BFWFOWLER@AECOM

N C A R B  
National Council of  
Architectural Registration Boards  
Project:

Twin Villa

Woodland Glen Lot 53

Location:  
1442-1444 SW Winthrop Ter, Lee's Summit, MO

Client Contact:  
John Duggan  
(913) 498-3536 / jduggan@kc-dsdlaw.com

Revisions

NO.	DATE	DESCRIPTION
-----	------	-------------


Sheet Name:

Furnishing Plans

Sheet No:

A23

PERMIT SET

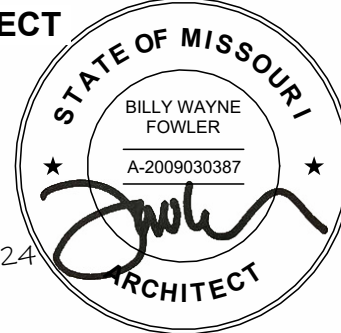

6/4/24

Date:

6/4/24

BFA No:

TWIN-WG53

RELEASE FOR CONSTRUCTION  
AS NOTED FOR PLAN REVIEW  
LEE'S SUMMIT, MISSOURI

09/26/2024







NOTES ARE TYPICAL. LUSKED NOTE NUMBER IS INSIDE OF CIRCLE, THEN THE NOTE REFERS TO A SPECIFIC LOCATION(S) MARKED ON THE PLAN.

1. PROVIDE 3/4" TONGUE AND GROOVE WOOD STRUCTURAL PANEL SHEATHING FOR SUBFLOOR GLUED AND NAILED TO WOOD JOISTS WITH 8d NAILS AT 6"oc AT PANEL EDGES AND 12"oc AT NON-PANEL EDGES.
2. ALL EXTERIOR WALL FRAMING SHALL BE 2x4 OR 2x6 DOUG-FIR STUD GRADE AT 16"oc.
3. PROVIDE 1/2" EXTERIOR GRADE PLYWOOD SHEATHING NAILED TO WOOD STUDS WITH 8d NAILS AT 6"oc AT PANEL EDGES AND 12"oc AT NON-PANEL EDGES.
4. ALL INTERIOR BEARING WALL FRAMING SHALL BE 2x4 OR 2x6 DOUG-FIR STUD GRADE AT 16"oc.
5. DOUBLE FLOOR JOISTS UNDER ALL PARTITION WALLS RUNNING PARALLEL WITH JOISTS.
6. PROVIDE PROPER WALL INSULATION AS REQUIRED BY GOVERNING BUILDING CODE.
7. STAIRS SHALL HAVE A MAXIMUM RISE OF 7-3/4" AND MINIMUM TREAD OF 10". ALL RISERS AND TREADS TO BE EQUAL BETWEEN FLOORS.
8. PROVIDE WALL BRACING AS SHOWN ON PLAN.
9. PROVIDE HEADERS AS SHOWN ON PLAN, FOR HEADERS NOT MARKED REFERENCE TYPICAL BEARING WALL HEADER SCHEDULE.
10. FLOOR JOISTS: SEE IRC TABLE R502.3.1(1) AND R502.3.1(2) FOR SPAN, SIZE, SPACING, AND GRADE OF FLOOR JOISTS.
11. PROVIDE MIN (2) STUDS FULL WIDTH BEARING UNDER ALL WOOD BEAMS, LVL'S, AND STEEL BEAMS UNLESS NOTED OTHERWISE.
12. INTERIOR FOOTINGS OF LOAD BEARING WALLS AND COLUMNS SHALL BE ISOLATED FROM THE BASEMENT FLOOR SLAB.

**Unit B (Mirror of Unit A)**

FLOOR FRAMING & FOUNDATIONS FROM AREA A SHALL BE MIRRORED TO THIS SIDE OF THE DUPLEX

2'-0" WIDE x 12" THICK FOOTING REINFORCED WITH (3) #4 CONT. BENEATH 12" WALL

12" THICK CONCRETE WALL, RE: SECTION 11/S30

RE: SECTIONS 8/S30, 9/S30 & 10/S30 FOR ADDITIONAL SUPPORTED SLAB INFORMATION

Rooms and Dimensions:


- BR 3: 12'-5 1/2" x 12'-5 1/2"
- Ba 3: 7'-1" x 7'-1"
- BR 4: 12'-5 1/2" x 12'-5 1/2"
- WIC: 4'-8 1/2" x 4'-8 1/2"
- Storage: 12'-4 1/2" x 12'-4 1/2"
- Game Room: 14'-2" x 14'-4"
- Storage / Storm (Under Garage): 21'-4" x 21'-4"
- Storage: 11'-5" x 9'-2"

Structural Notes:

- (2) DF#2 2x10, UPSET
- (2) 1 3/4" x 9 1/4" LVL
- DF#2 2x10 FLOOR JOISTS @ 16" O.C.
- W8x15
- (2) 2x4s
- 8'-4 1/2"
- 34'-4"
- (2) DF#2 2x10
- (2) 1 3/4" x 9 1/4" LVL
- 15' @ 7' 23/32" T @ 10"
- BEAM POCKET
- W10x15 or W8x21
- DF#2 2x10 FLOOR JOISTS @ 16" O.C.
- BEAM POCKET
- W10x22
- 7'-1 3/8"
- 6'-6 3/8"
- 7'-8 3/8"
- 18'-10"
- 22'-10"
- 4'-0"
- 4'-0"
- 4'-0"
- 4'-4"
- 11'-2"
- 11'-5"
- 46'-0"
- 54'-0"
- 8'-0"
- 36'-0"
- 28'-0"
- 13'-10"
- 3'-0"
- 27'-4"
- 54'-2"

SCALE: 1/4" = 1'-0"

09/26/2024

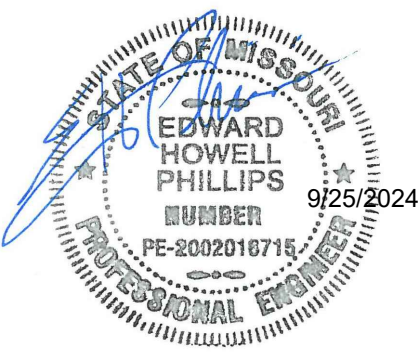

## TYPICAL BRACED WALL METHOD

WSP - WOOD STRUCTURAL PANEL; WOOD STRUCTURAL PANEL SHEATHING WITH A THICKNESS NOT LESS THAN 3/8" FOR 16" STUD SPACINGS. FASTEN WITH 6d COMMON NAILS (1 1/2"x2" LONG) AT 6"oc ALONG EDGES AND 12"oc AT INTERMEDIATE SUPPORTS, WHERE SHOWN ON PLANS. UNLESS OTHERWISE NOTED, PANEL WIDTH = 4'-0".

CS-WSP - CONTINUOUSLY SHEATHED WOOD STRUCTURAL PANEL; WOOD STRUCTURAL PANEL SHEATHING WITH A THICKNESS NOT LESS THAN 3/8" FOR 16" STUD SPACING. FASTEN WITH 6d COMMON NAILS (1 1/2"x2" LONG) AT 6"oc ALONG EDGES AND 12"oc AT INTERMEDIATE SUPPORTS, PLACED ON ALL SHEATHABLE SURFACES ON ONE SIDE OF THE BRACED WALL LINE INCLUDING AREAS ABOVE AND BELOW OPENINGS AND GABLE END WALLS.

GB - GYPSUM BOARD; 1/2" GYPSUM BOARD WITH 13 GAGE, 1 3/8" LONG, 19/64" HEAD; 0.098" DIA, 1 3/8" LONG, ANNULAR-RINGED; 6d COOLER NAIL, 0.092" DIA, 1 7/8" LONG, 1/4" HEAD; OR GYPSUM BOARD NAIL, 0.0915" DIA, 1 7/8" LONG, 19/64" HEAD; TYPE W OR TYPE S SCREWS; AT 7"oc EDGES & 7"oc FIELD

PFH - PORTAL FRAME WITH HOLD-DOWNS; REF PORTAL FRAME WITH HOLD-DOWNS DETAIL

ABW - ALTERNATE BRACED WALL; REF ALTERNATE BRACED WALL DETAIL

PFG - PORTAL FRAME AT GARAGE; REF PORTAL FRAME AT GARAGE DETAIL

LIB - LET-IN BRACE; REF LET-IN BRACE DETAIL.

HPS - HARDBOARD PANEL SIDING; HARDBOARD PANEL SIDING WITH A 7/16" THICKNESS. FASTEN WITH 0.092" DIA, 0.225" DIA HEAD NAILS WITH LENGTH TO ACCOMMODATE 1 1/2" PENETRATION INTO STUDS AT 4"oc ALONG EDGES AND 8" AT INTERMEDIATE SUPPORTS.

## CEILING FRAMING PLAN NOTES

- NOTES ARE TYPICAL UNLESS NOTE NUMBER IS INSIDE OF CIRCLE, THEN THE NOTE REFERS TO A SPECIFIC LOCATION(S) MARKED ON THE PLAN.
- PROVIDE PROPER CEILING INSULATION AS REQUIRED BY GOVERNING BUILDING CODE.
  - PROVIDE MIN (2) STUDS FULL WIDTH BEARING UNDER ALL WOOD BEAMS, LVL'S, AND STEEL BEAMS UNLESS NOTED OTHERWISE.
  - LOAD BEARING WALL STUDS SHALL BE CONTINUOUS FROM THE FLOOR TO THE ROOF/CEILING DIAPHRAGM PER IRC 602.3.
  - WALL SHEATHING SHALL BE CONTINUOUS TO UNDERSIDE OF ROOF SHEATHING PER FIRE WALL REQUIREMENTS. ATTACH CEILING JOIST ADJACENT TO WALL, THROUGH WALL SHEATHING, WITH (1) SIMPSON SDWS22600DB SCREW AT EACH STUD.
  - REFERENCE ROOF FRAMING PLAN FOR FRAMING IN VAULTED AREAS.

## JOIST HANGER TABLE

(BASED ON SIMPSON STRONG-TIE WOOD CONSTRUCTION CONNECTORS 2021 CATALOG)

JOIST SIZE	MODEL NO.	FASTENERS		DF/SP ALLOWABLE LOADS (lb.)	
		HEADER	JOIST	FLOOR (100)	SNOW (115)
2x4	LU24	(4) 0.162 x 3-1/2	(2) 0.148 x 1-1/2	555	630
DBL 2x4	LUS24-2	(4) 0.162 x 3-1/2	(2) 0.162 x 3-1/2	800	905
2x6	LUS26	(4) 0.148 x 3	(4) 0.148 x 3	865	990
DBL 2x6	LUS26-2	(4) 0.162 x 3-1/2	(4) 0.162 x 3-1/2	1,030	1,170
2x8	LUS28	(6) 0.148 x 3	(4) 0.148 x 3	1,100	1,260
DBL 2x8	LUS28-2	(6) 0.162 x 3-1/2	(4) 0.162 x 3-1/2	1,315	1,490
2x10	LUS210	(8) 0.148 x 3	(4) 0.148 x 3	1,335	1,530
DBL 2x10	LUS210-2	(8) 0.162 x 3-1/2	(6) 0.162 x 3-1/2	1,830	2,075
2x12	LUS212	(8) 0.148 x 3	(4) 0.148 x 3	1,335	1,530
DBL 2x12	LUS210-2	(8) 0.162 x 3-1/2	(6) 0.162 x 3-1/2	1,830	2,075
(2) 1 3/4 x 9 1/2	HUS410	(8) 0.162 x 3-1/2	(8) 0.162 x 3-1/2	2,125	2,420
1 3/4 x 11 1/4	HU11	(22) 0.162 x 3-1/2	(6) 0.148 x 1-1/2	3,275	3,695
(2) 1 3/4 x 11 1/4	HHUS410	(30) 0.162 x 3-1/2	(10) 0.162 x 3-1/2	5,635	6,380
(2) 1 3/4 x 11 7/8	HHUS410	(30) 0.162 x 3-1/2	(10) 0.162 x 3-1/2	5,635	6,380
(1) 1 3/4 x 14	HU14	(28) 0.162 x 3-1/2	(8) 0.148 x 1-1/2	4,165	4,420

- a. FOR MINIMUM NAILING QUANTITY AND LOAD VALUES, FILL ALL ROUND HOLES; FOR MAXIMUM NAILING QUANTITY AND LOAD VALUES, FILL ALL ROUND AND TRIANGULAR HOLES.  
b. FASTENERS: NAIL DIMENSIONS ARE LISTED DIAMETER BY LENGTH.

### BILL FOWLER ARCHITECT

3601 W 122nd Terrace  
Leawood, KS 66209  
913 908 5263  
BFWFOWLER@ME.COM

NCARB  
National Council of  
Architectural Registration Boards  
Project:

**Twin  
Villa**

Woodland Glen Lot 53

Location:  
1442-1444 SW Winthrop Ter, Lee's Summit, MO

Client Contact:  
John Duggan  
(913) 498-3536 /jduggan@kc-dsdlaw.com

### Revisions

NO.	DATE	DESCRIPTION
1	9/25/2024	CONTRACTOR QUESTIONS

Sheet Name:  
**Ceiling/Braced Wall Plan**

Sheet No:  
**S20**

Date:  
6/03/24


BFA No:  
TWIN-WG53

PERMIT SET

RELEASE FOR CONSTRUCTION  
AS NOTED FOR PLAN REVIEW

LEE'S SUMMIT, MISSOURI

09/26/2024

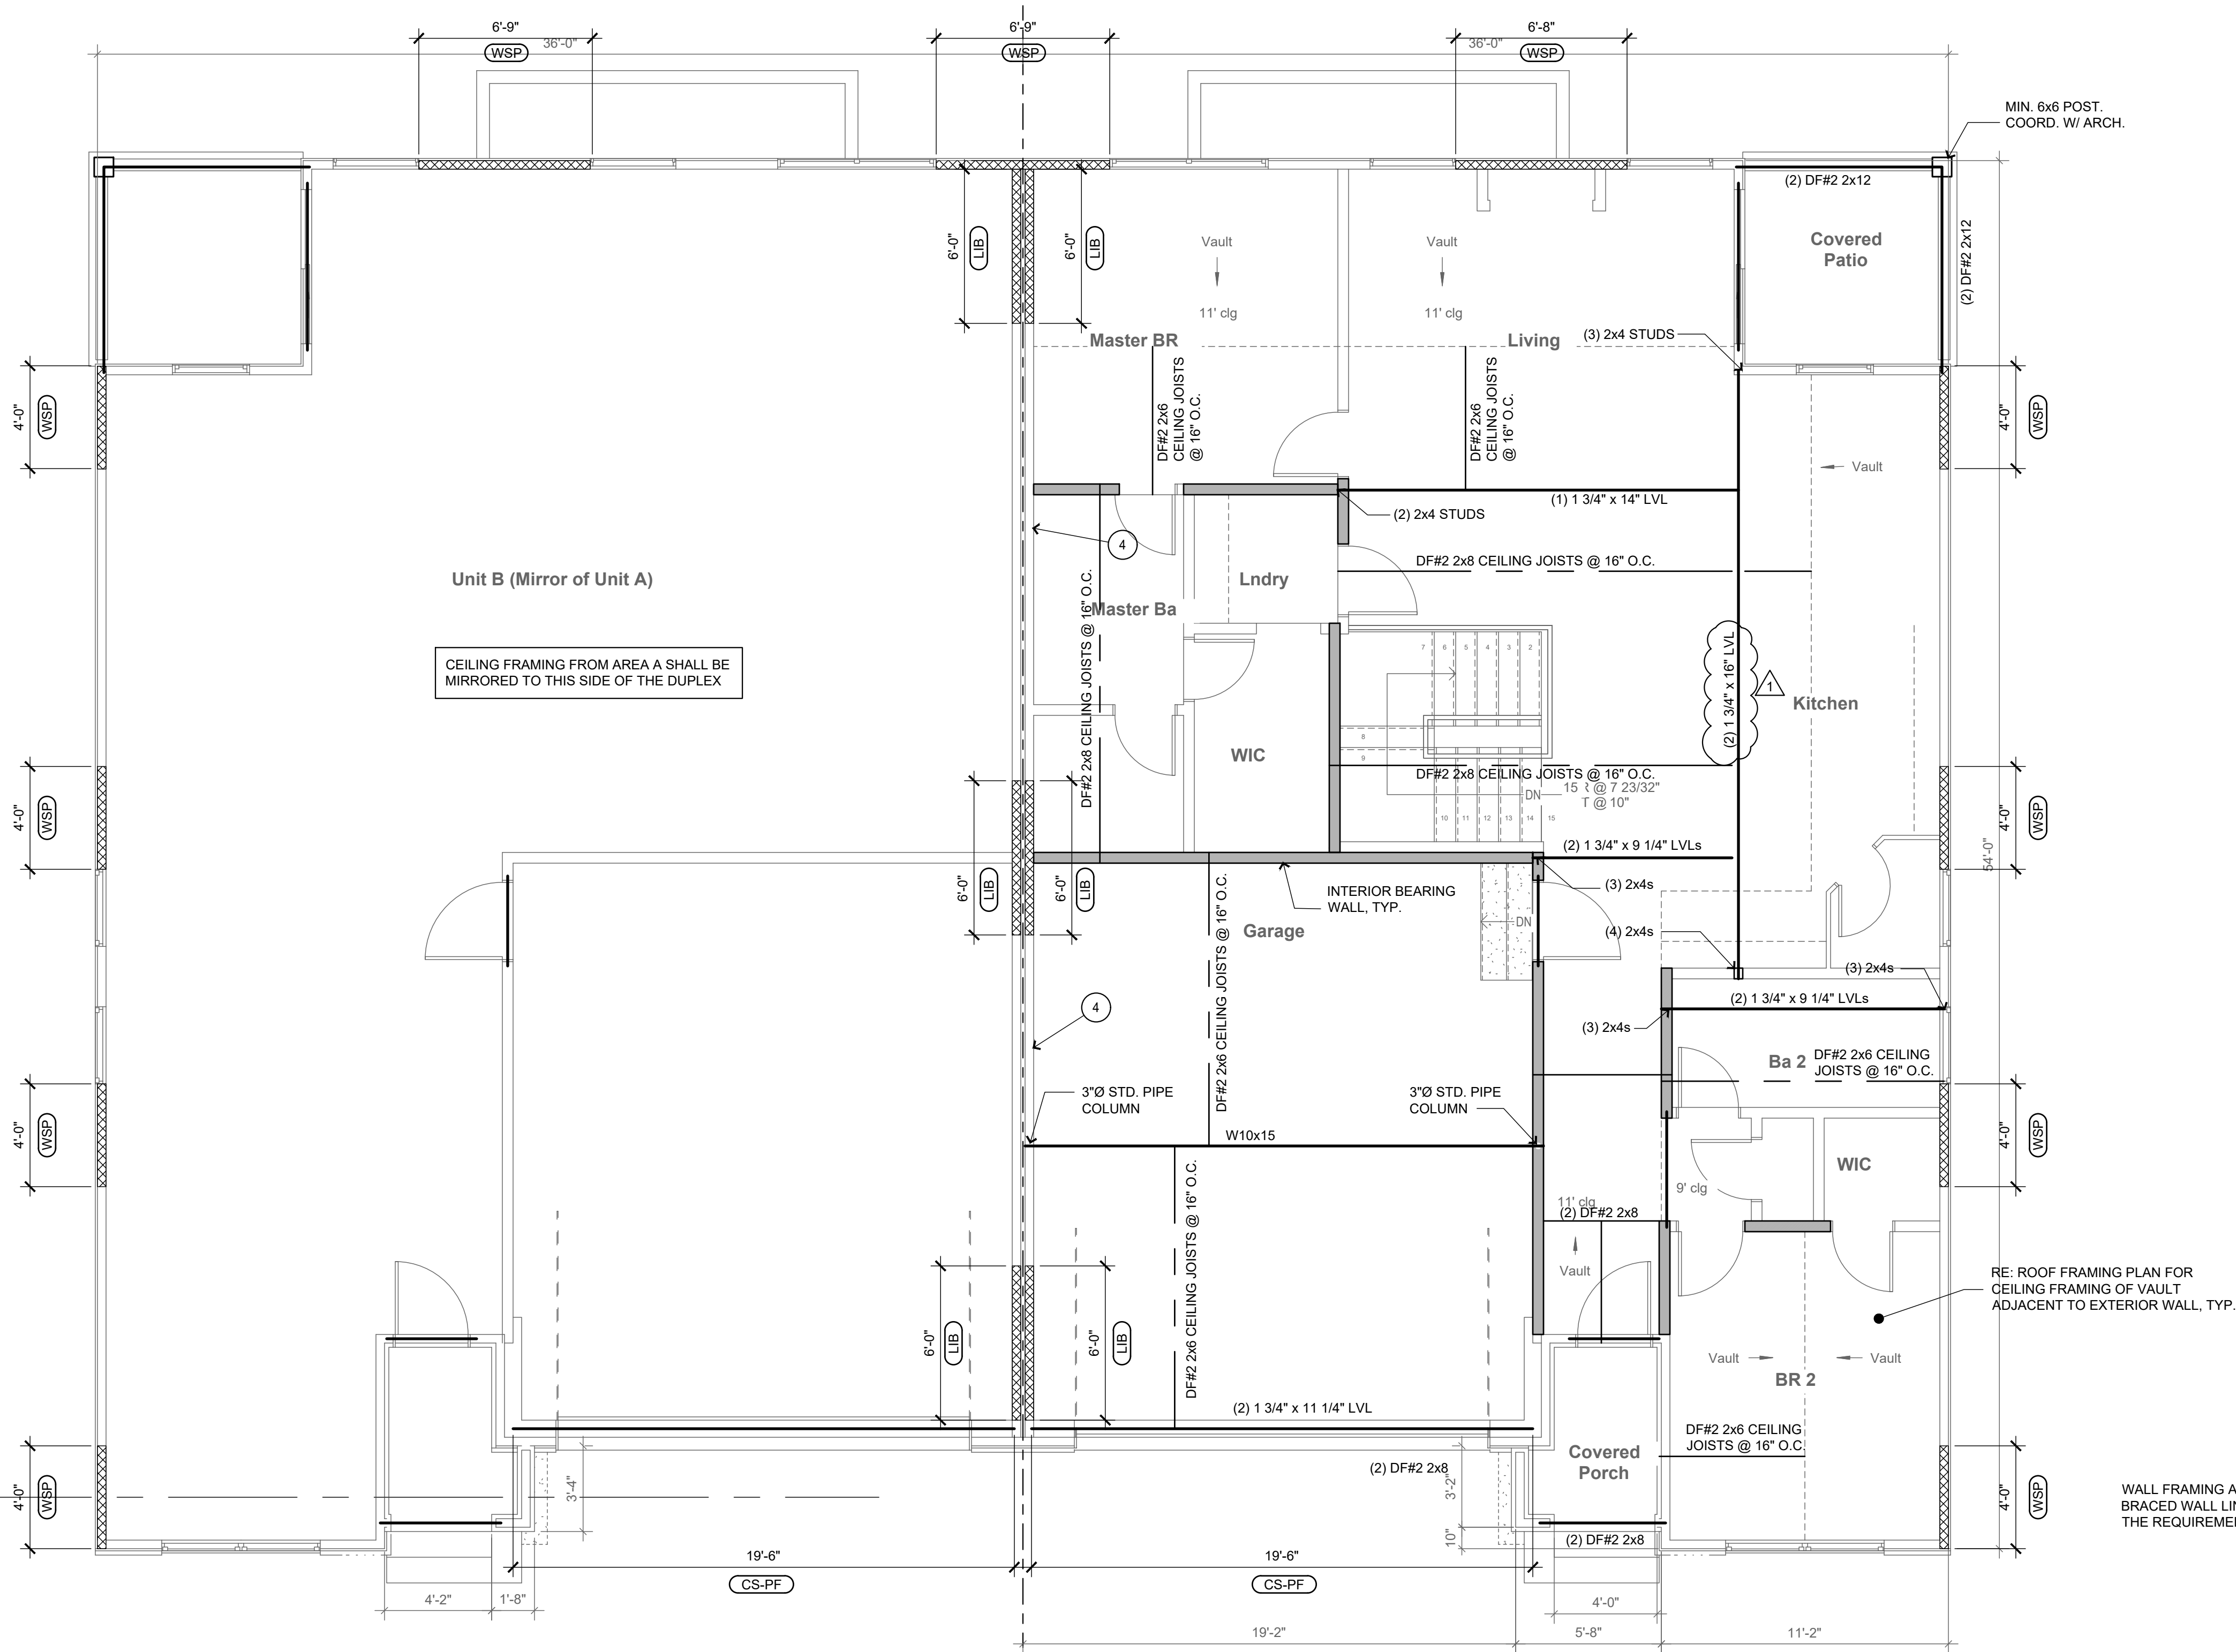


WALL FRAMING ALONG THIS  
BRACED WALL LINE SHALL MEET  
THE REQUIREMENTS OF CS-WSP

1

## CEILING/BRACED WALL PLAN

SCALE: 1/4" = 1'-0"



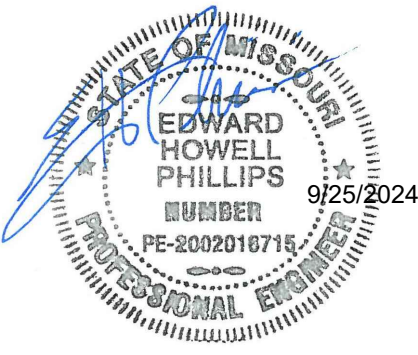

## ROOF FRAMING PLAN NOTES

- NOTES ARE TYPICAL UNLESS NOTE NUMBER IS INSIDE OF CIRCLE, THEN THE NOTE REFERS TO A SPECIFIC LOCATION(S) MARKED ON THE PLAN.
- PROVIDE 1/2" EXTERIOR GRADE PLYWOOD SHEATHING NAILED TO ROOF RAFTERS WITH 8d NAILS AT 6"oc AT PANEL EDGES AND 12"oc AT NON-PANEL EDGES.
  - PROVIDE ADDITIONAL DEPTH TO JOISTS AS REQUIRED TO PROVIDE 1" AIR GAP TO PREVENT CONDENSATION PLUS 12" INSULATION TO PROVIDE R-38 INSULATION VALUE TO VAULTED CEILING AREA WHERE SHOWN ON PLAN WITH CROSS HATCH.
  - ALL RIDGE, VALLEY, AND HIP MEMBERS SHALL BE 2" NOMINAL THICKNESS AND NOT LESS IN DEPTH THAN THE CUT END OF THE RAFTER.
  - HIP AND VALLEY MEMBERS SHALL BE SUPPORTED AT THE RIDGE WITH A 2x6 T-BRACE TO A BEARING WALL BELOW.
  - PROVIDE SOFFIT, RIDGE, AND GABLE END VENTS AS REQUIRED TO PROVIDE ADEQUATE VENTILATION FOR ROOF.
  - PROVIDE PROPER FLASHING AND BUILDING PAPER UNDER SHINGLES AS REQUIRED TO PROVIDE WATER TIGHT SEAL AT ALL ROOF PENETRATIONS, RIDGES, VALLEYS, HIPS AND/OR OTHER SLOPE CHANGES.
  - GUTTERS, DOWNSPOUTS, AND SPLASH BLOCKS SHALL BE PROVIDED TO INSURE ALL ROOF DRAINAGE IS DIRECTED 5 FEET MINIMUM FROM HOUSE BEFORE TOUCHING SOIL.
  - ALL GABLE END WALL FRAMING SHALL BE 2x4 DOUG-FIR STUD GRADE AT 16"oc.
  - PROVIDE PROPER CEILING INSULATION AS REQUIRED BY GOVERNING BUILDING CODE.
  - PROVIDE MIN (2) STUDS FULL WIDTH BEARING UNDER ALL WOOD BEAMS, LVL'S, AND STEEL BEAMS UNLESS NOTED OTHERWISE.
  - PROVIDE OVER-BUILD FRAMING AS REQUIRED TO ACHIEVE THE DESIRED ROOF SLOPES/PROFILES.
  - LOAD BEARING WALL STUDS SHALL BE CONTINUOUS FROM THE FLOOR TO THE ROOF/CEILING DIAPHRAGM PER IRC 602.3.
  - ROOF RAFTERS DO NOT EXCEED 200 PLF OF UPLIFT. ATTACH ALL MEMBERS PER FASTENING SCHEDULE ON S33.
  - BRACE HIP/RIDGE/VALLEY DOWN TO BEARING WALL OR BEAM BELOW.
  - U.N.O. ALL HIPS/VALLEYS/RIDGES SHALL BE A MIN. OF DF#2 2x10 MEMBERS.
  - CEILING BEAM, REFERENCE CEILING FRAMING PLAN.
  - ALL ROOF RAFTER FRAMING SHALL BE DF#2 2x6 RAFTERS @ 16" O.C., UNLESS NOTED OTHERWISE. INCREASE DEPTH OF RAFTER AS REQUIRED AT VAULTED CEILING AREAS AS REQUIRED TO MEET INSULATION REQUIREMENTS.
  - SUPPORT RAFTER FRAMING/PURLIN BRACING ON CEILING BEAM.
  - WALL SHEATHING SHALL BE CONTINUOUS TO UNDERSIDE OF ROOF SHEATHING PER FIRE WALL REQUIREMENTS. ATTACH RAFTER ADJACENT TO WALL, THROUGH WALL SHEATHING, WITH (1) SIMPSON SDWS22600DB SCREW AT EACH STUD.
  - SUPPORT PURLIN BRACING OFF CEILING BEAMS AND BEARING WALLS BELOW. REFERENCE SHEET S33 FOR ADDITIONAL REQUIREMENTS.

NOTE: ROOF HAS BEEN DESIGNED WITH STRUCTURAL HIPS & VALLEYS. ALL HIPS & VALLEYS TO BE BRACED PER HIP/VALLEY RAFTER TABLE. ALL HIPS & VALLEYS TO BE 2x10 MIN UNO.

NOTE: ALL HIPS, VALLEYS, RIDGES, AND ROOF BEAMS SHALL COMPLY WITH IRC R802.3 & R802.4.3 & HAVE (1) SIMPSON H2.5A AT EACH END TO RESIST UPLIFT. WHERE THE ROOF MEMBER IS SUPPORTED BY A STRUT, IN ADDITION TO THE ROOF MEMBER TO STRUT UPLIFT CONNECTION, THE STRUT SHALL ALSO BE CONNECTED TO A BEARING WALL OR BEAM BELOW WITH A SIMPSON H2.5A.

### PURLIN SPAN TABLE

PURLIN (DF #2) *	MAX SPAN			
	2x6	2x8	2x10	2x12
2x6 RAFTERS AT 24"oc	4'-3"	5'-4"	6'-4"	7'-1"
2x6 RAFTERS AT 16"oc	3'-11"	4'-10"	5'-10"	6'-6"


\* BRACE PURLINS WITH 2x6 "T" BRACES.

FOR BRACE LENGTHS LESS THAN 6'-0", 2x4 "T" BRACES MAY BE USED.

FOR BRACE LENGTHS OVER 20', USE 2x8 "T" BRACES.

### HIP/VALLEY RAFTER TABLE

TYPE	MAX UNBRACED SPAN					
	2x6	2x8	2x10	2x12	1 3/8"x9 1/2" LVL	1 3/8"x11 1/2" LVL
HIP RAFTERS	9'-6"	11'-2"	12'-9"	14'-1"	15'-8"	18'-2"
VALLEY RAFTERS	7'-7"	8'-10"	10'-1"	11'-2"	13'-2"	15'-3"

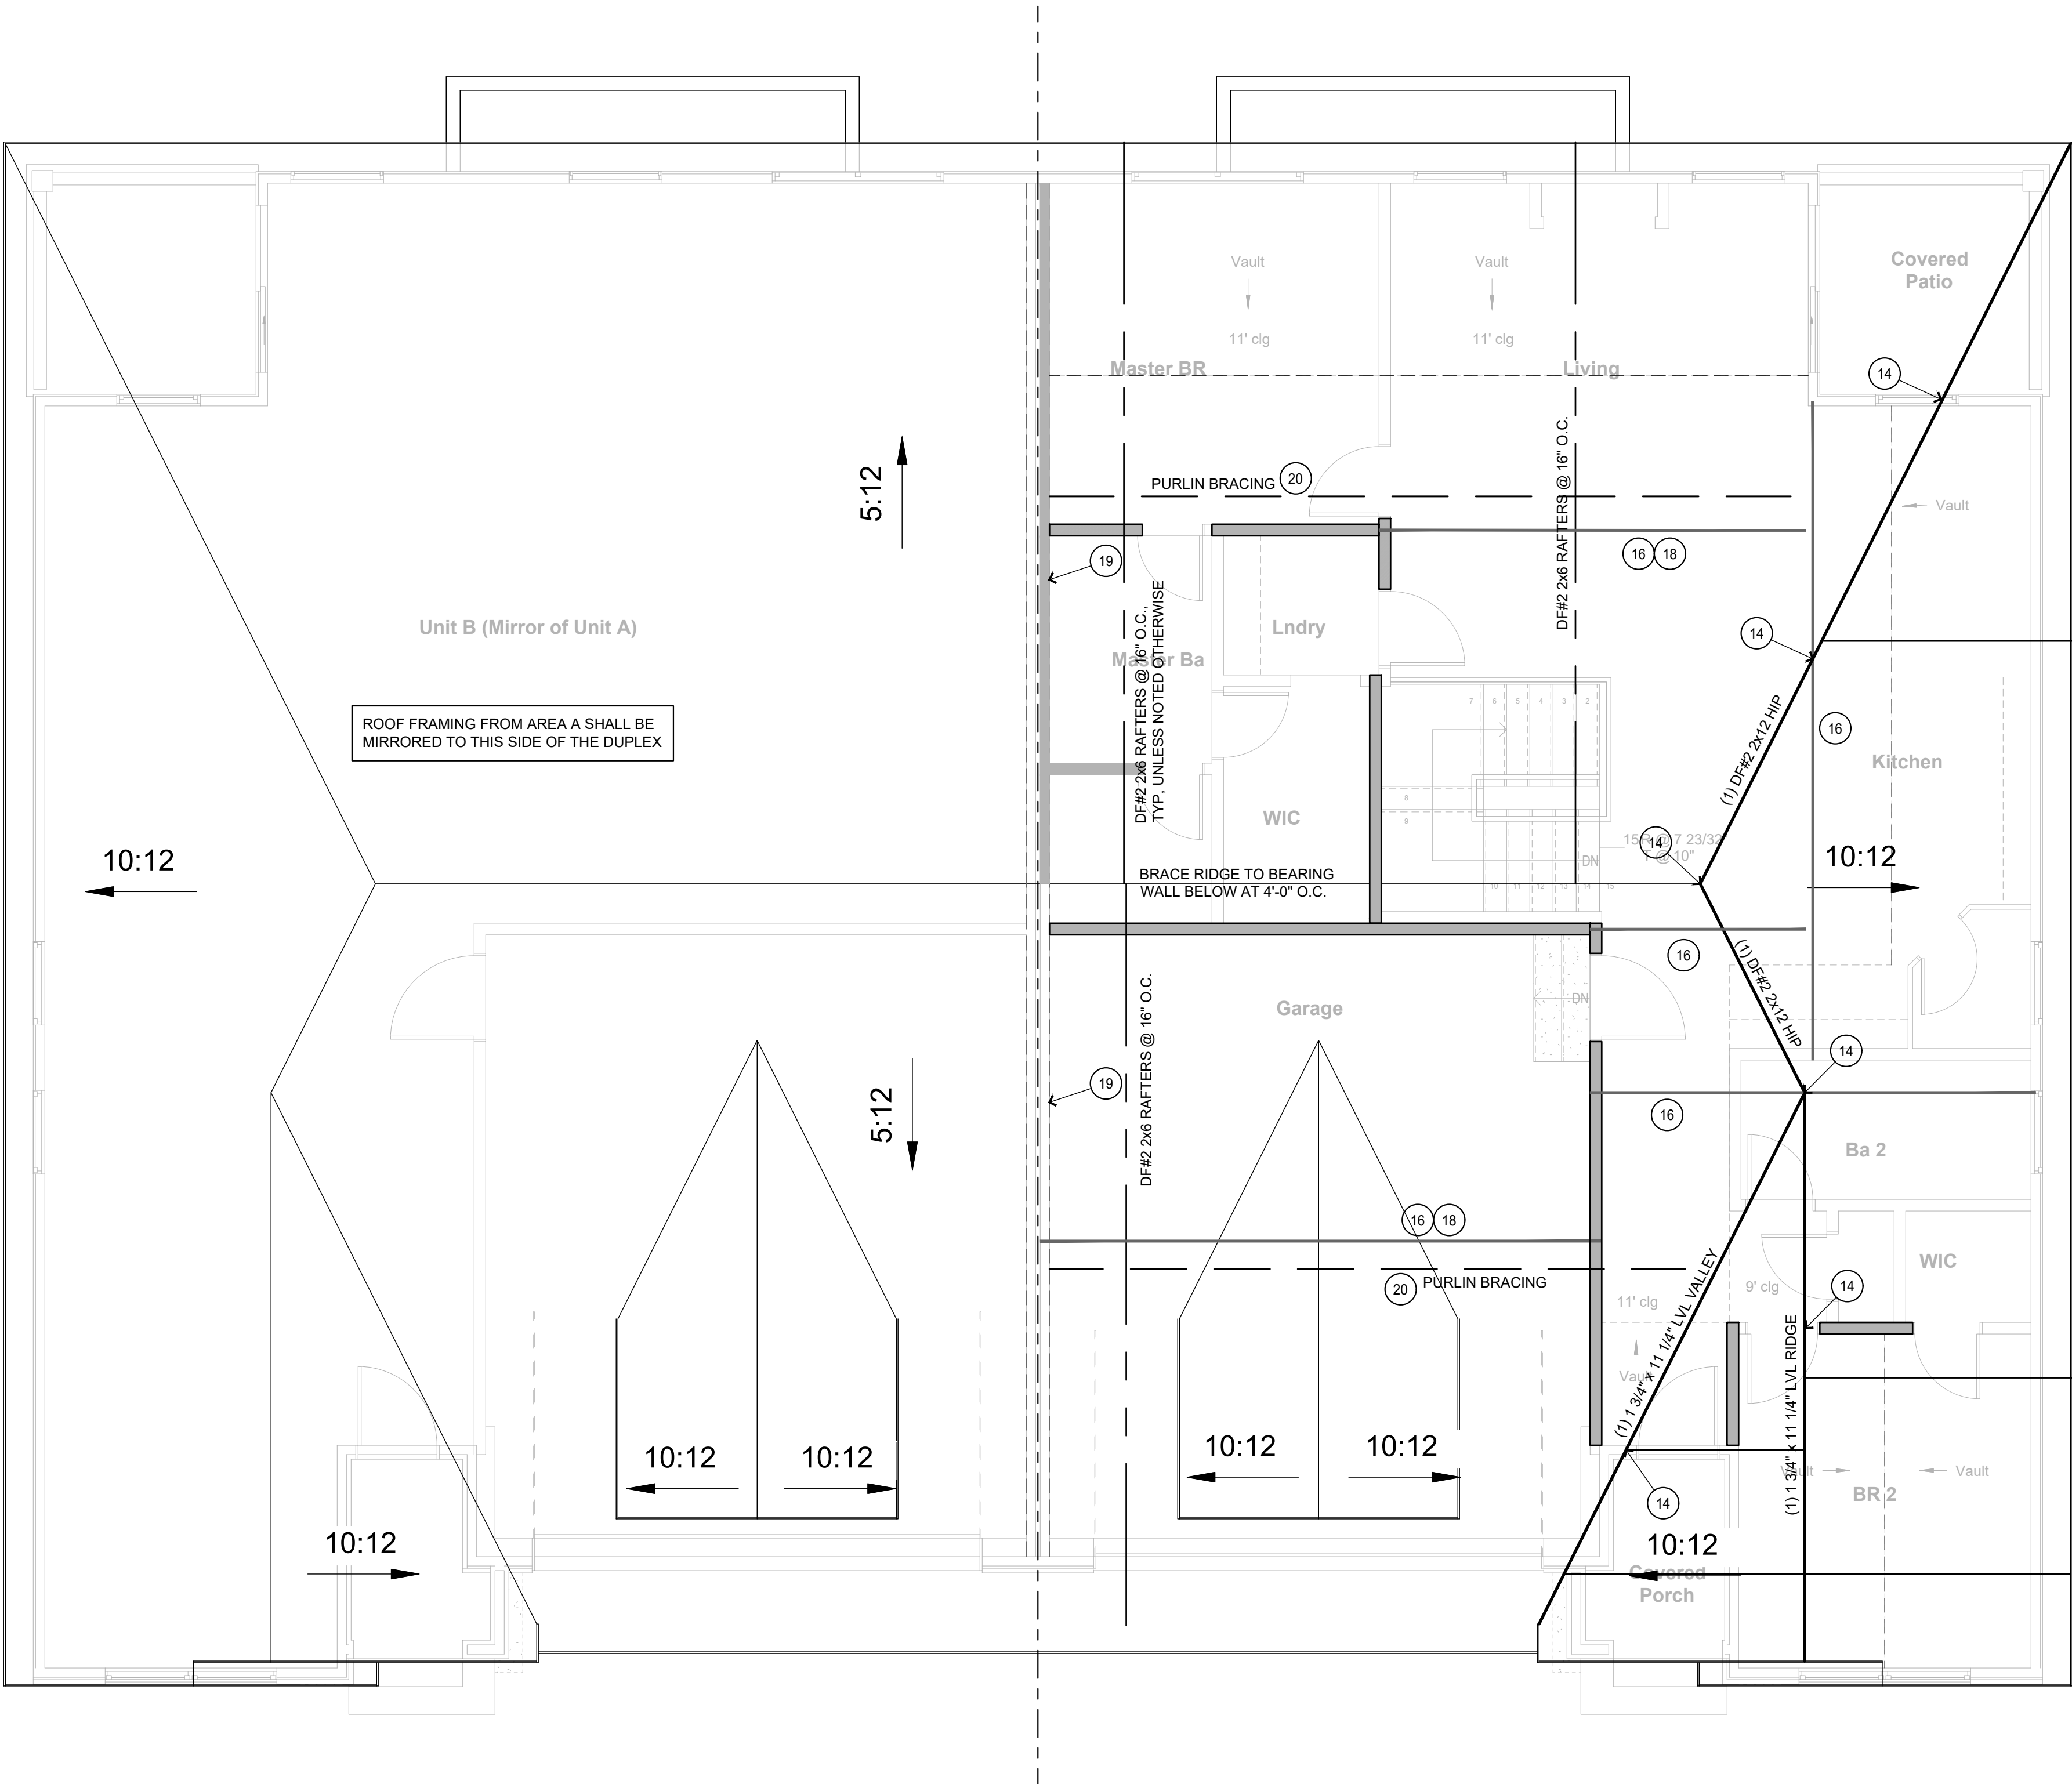

1

## ROOF FRAMING PLAN

SCALE: 1/4" = 1'-0"

### BILL FOWLER ARCHITECT

3601 W 122nd Terrace  
Leawood, KS 66209  
913 908 5263  
BFWFOWLER@ME.COM

N.C.A.R.B.  
National Council of  
Architectural Registration Boards  
Project:

## Twin Villa

Woodland Glen Lot 53

Location:  
1442-1444 SW Winthrop Ter, Lee's Summit, MO

Client Contact:  
John Duggan  
(913) 498-3536 /jduggan@co-dsdlaw.com

### Revisions

NO.	DATE	DESCRIPTION
1	9/25/2024	CONTRACTOR QUESTIONS

Sheet Name:

### Roof Framing Plan

Sheet No: **S21**  
Date: 6/03/24  
BFA No: **TWIN-WG53**


PERMIT SET

RELEASE FOR CONSTRUCTION  
AS NOTED FOR PLAN REVIEW


LEE'S SUMMIT, MISSOURI

09/26/2024




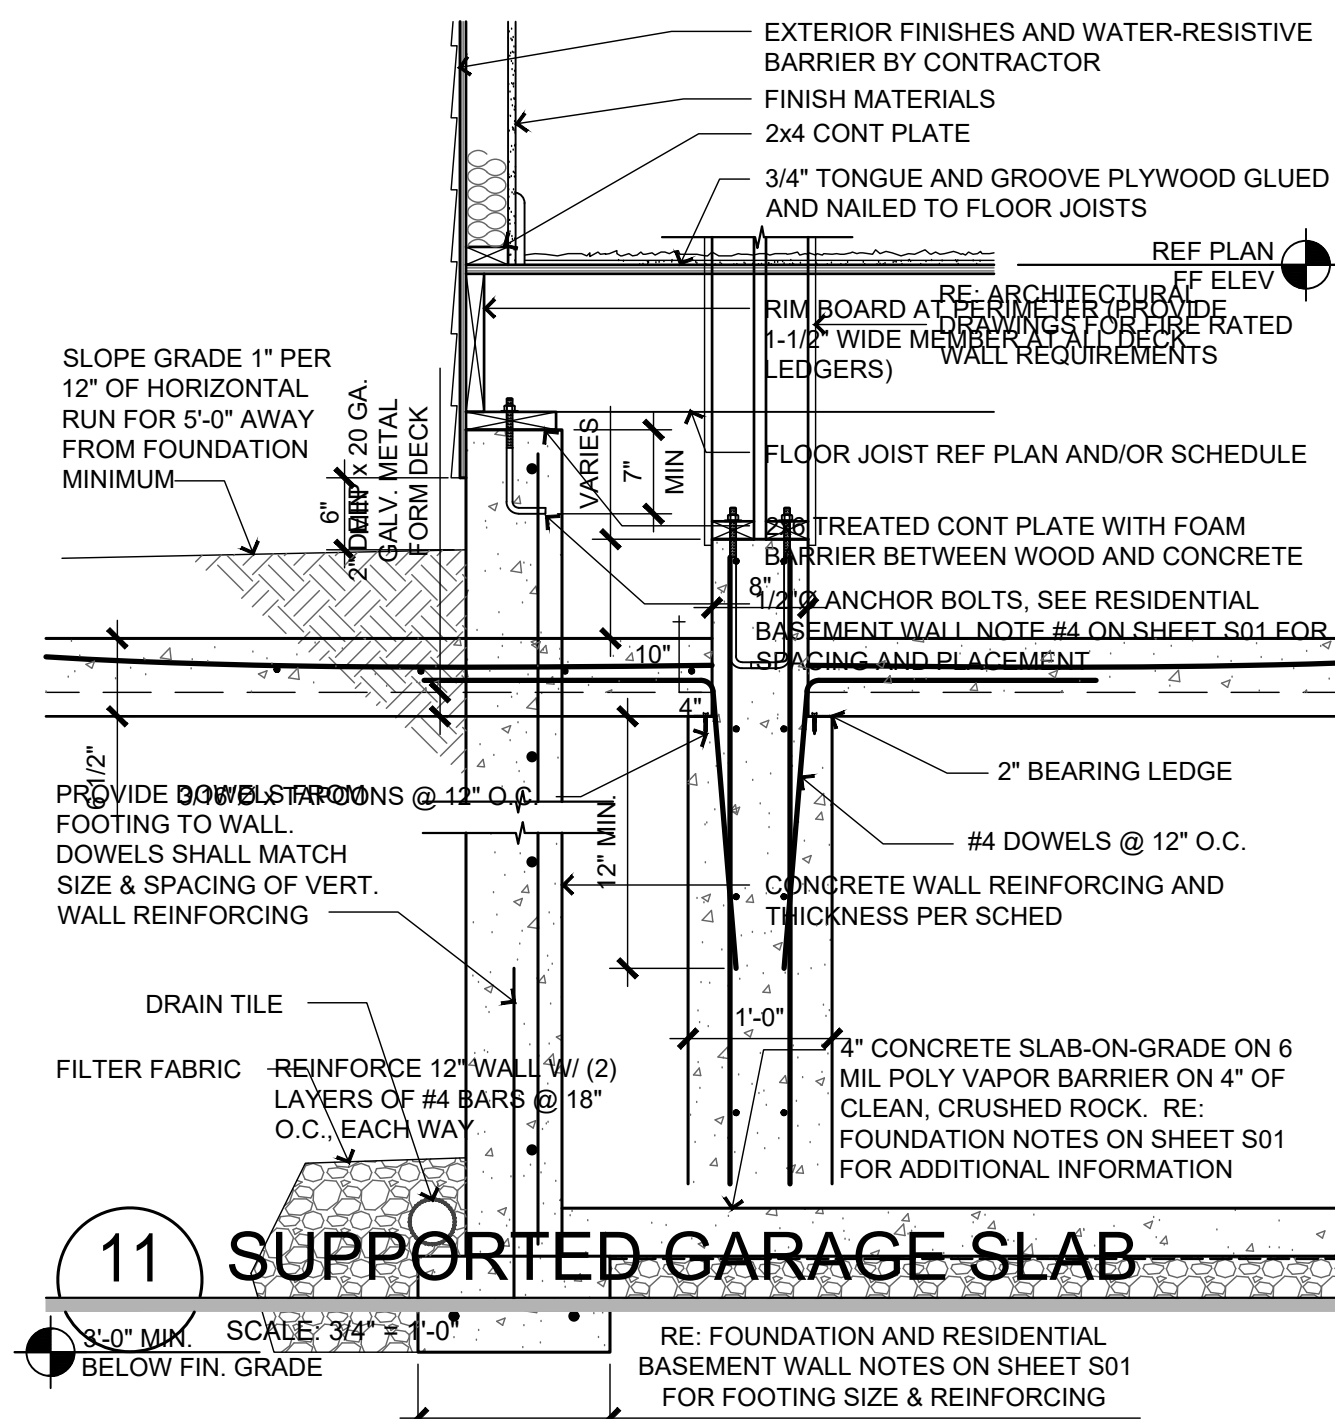


11 FOUNDATION BEARING WALL  
SCALE: 3/4" = 1'-0"

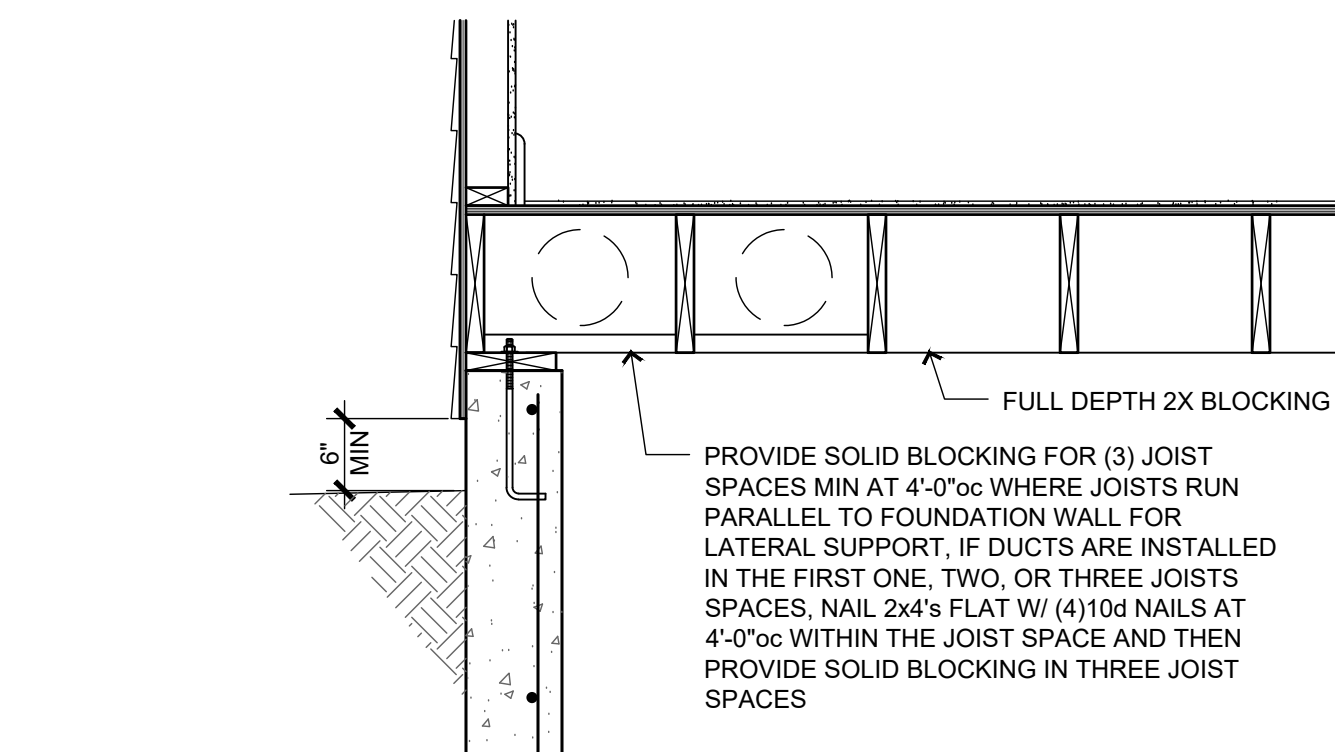


12 JOISTS PARALLEL TO WALL  
SCALE: 3/4" = 1'-0"

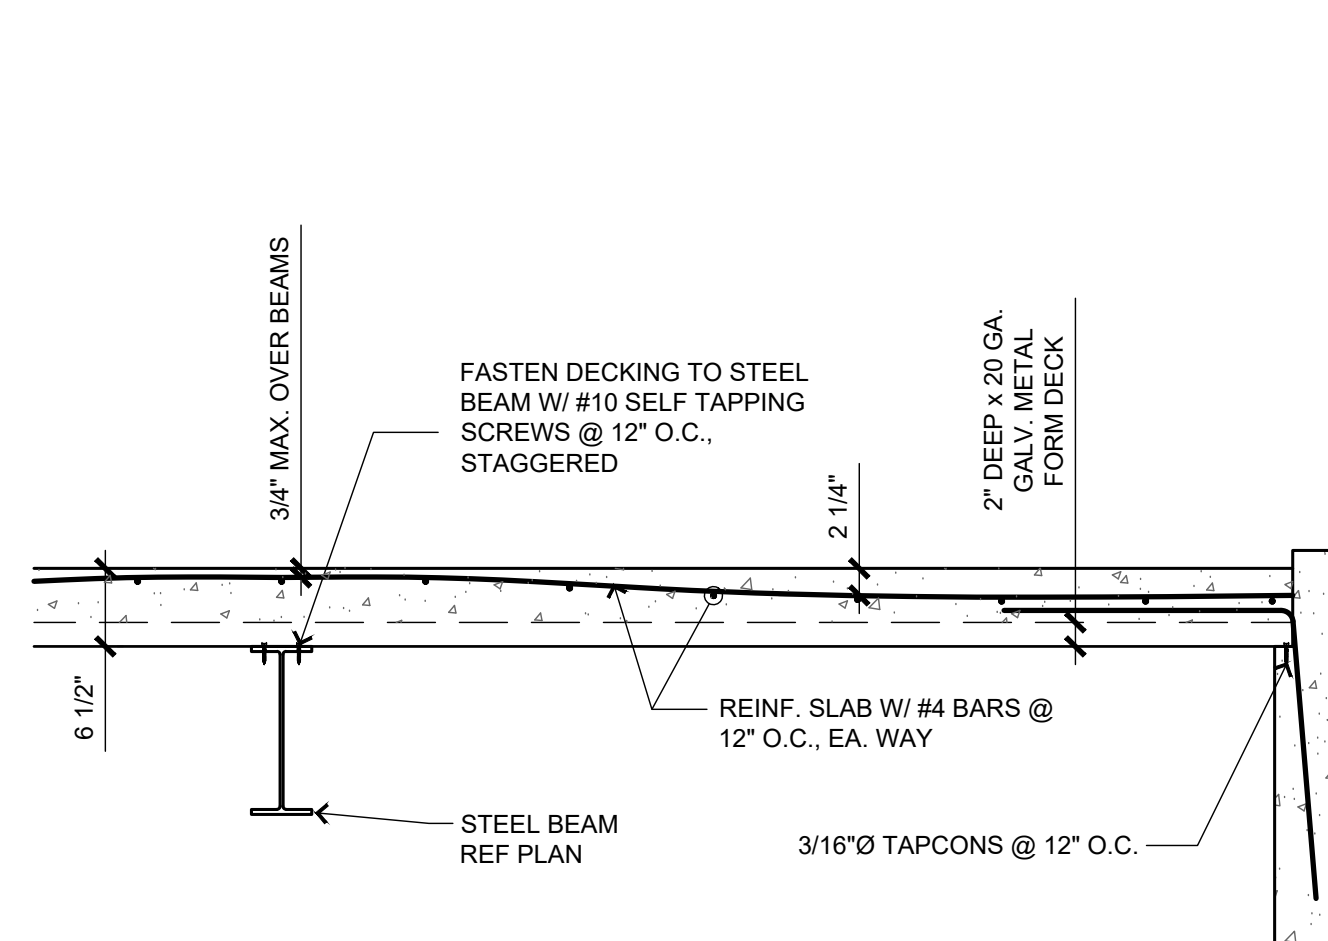


8 SLAB OVER BEAM  
SCALE: 3/4" = 1'-0"

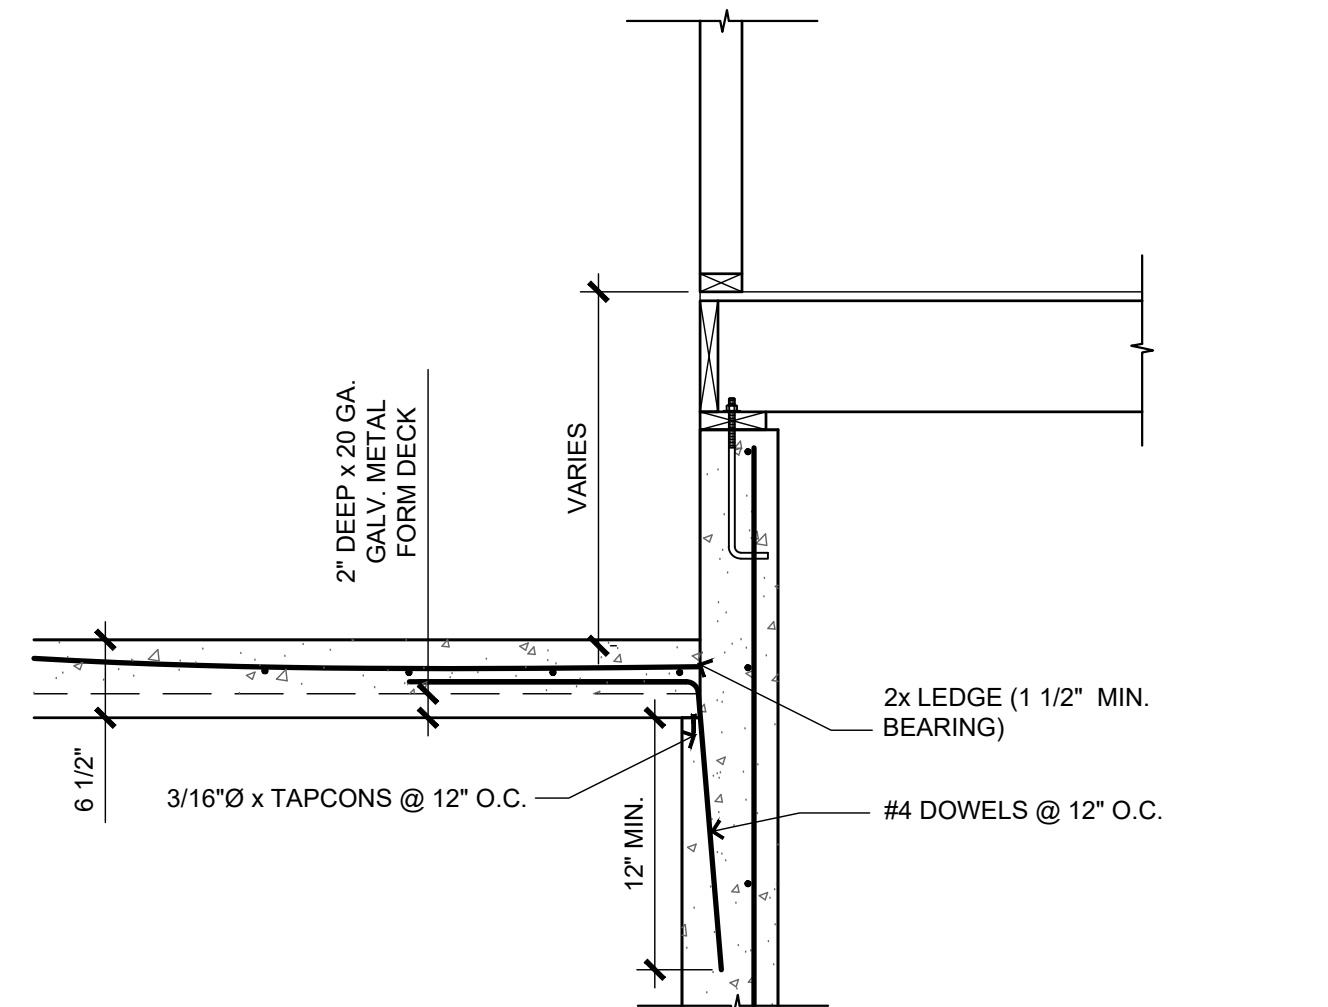


9 GARAGE SLAB ON FILL @ WALL  
SCALE: 3/4" = 1'-0"

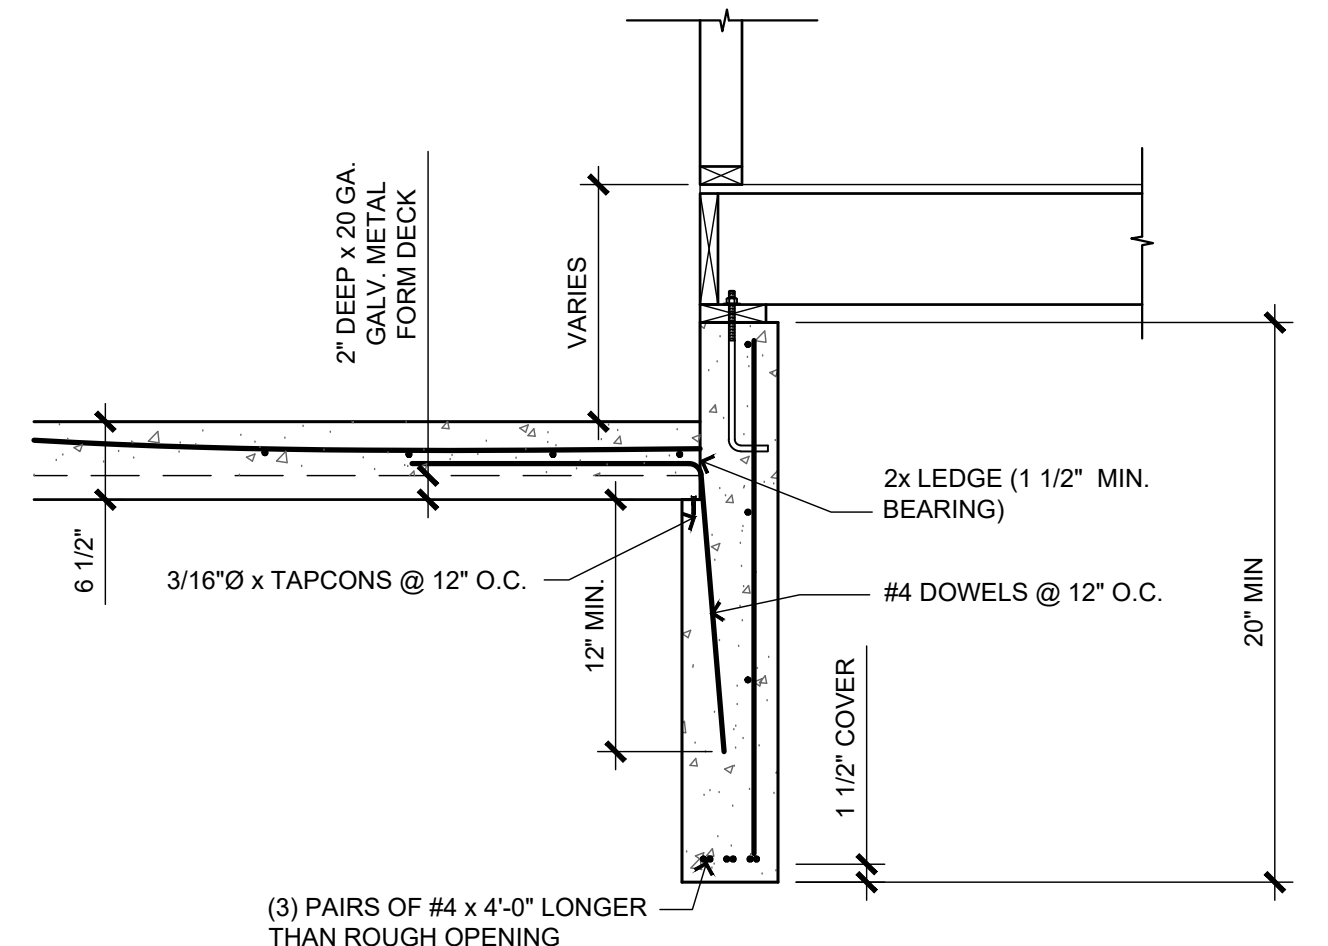


10 SUPPORTED GARAGE SLAB  
SCALE: 3/4" = 1'-0"

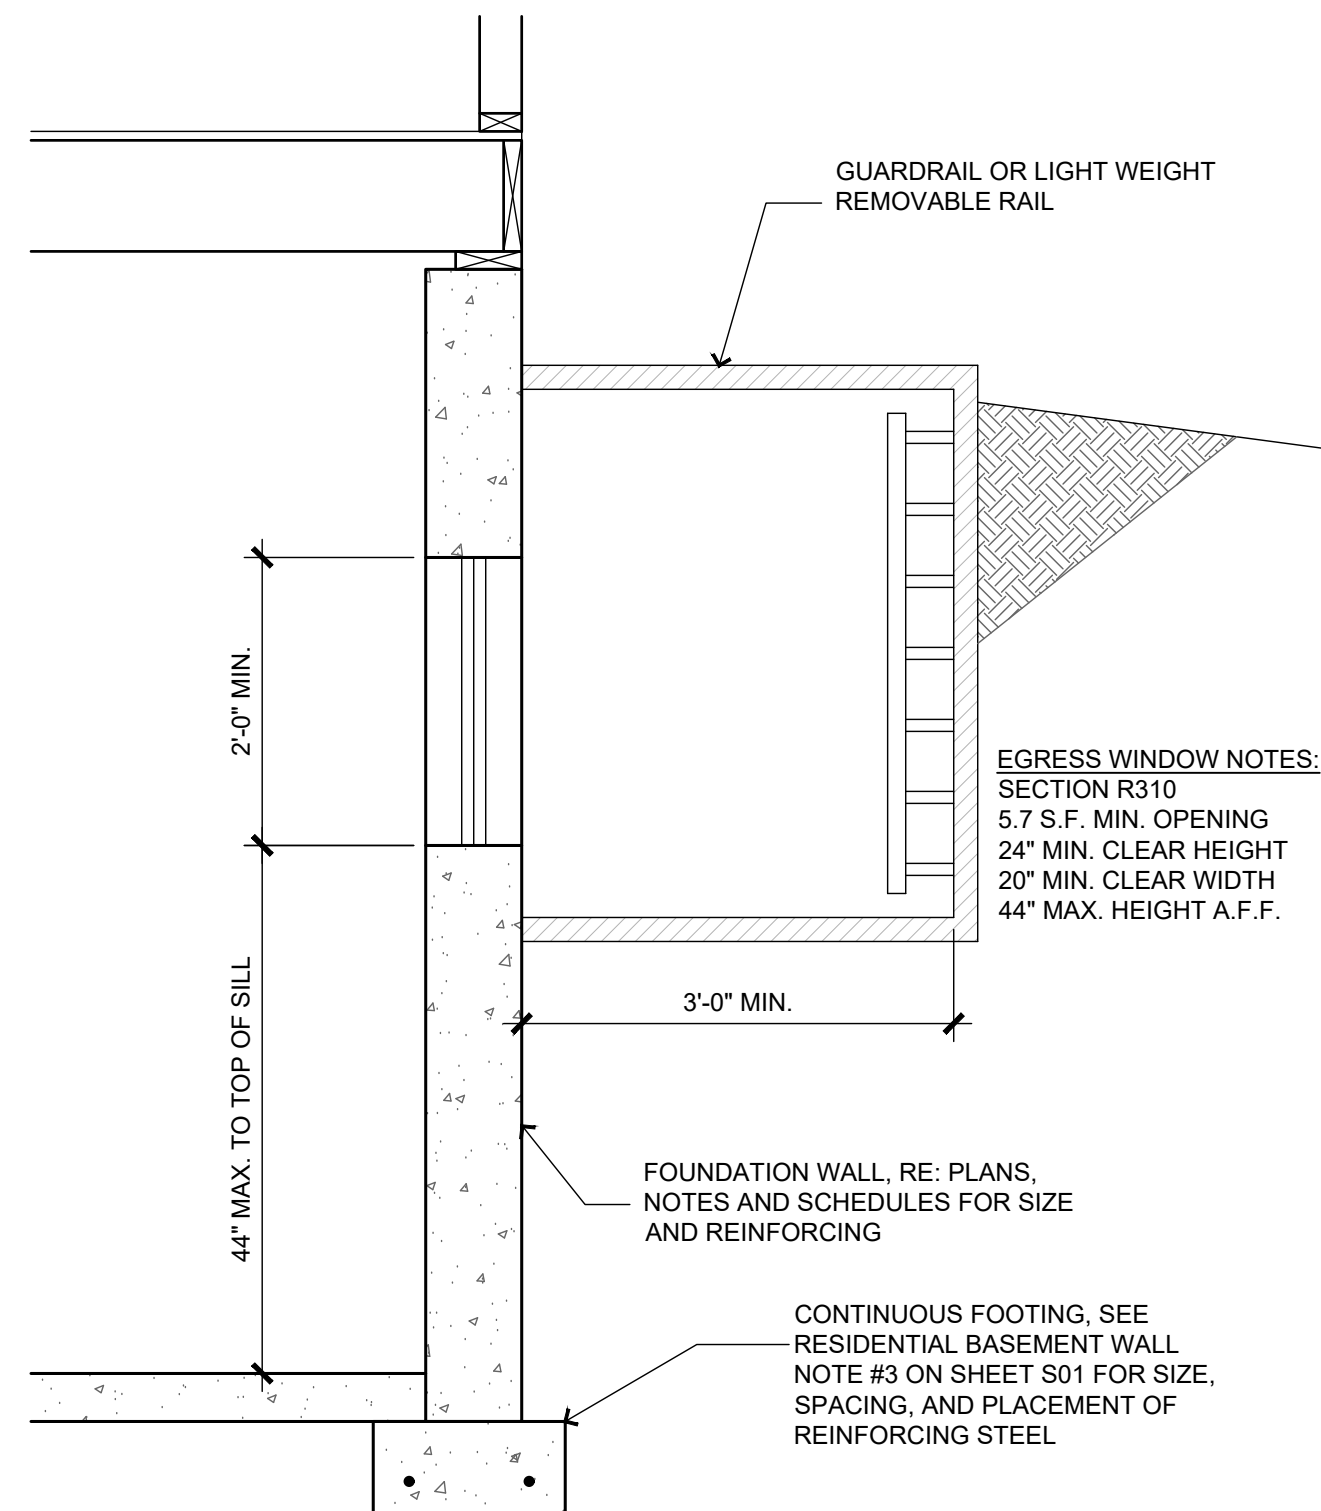


5 TYP EGRESS WINDOW SECTION  
SCALE: 3/4" = 1'-0"

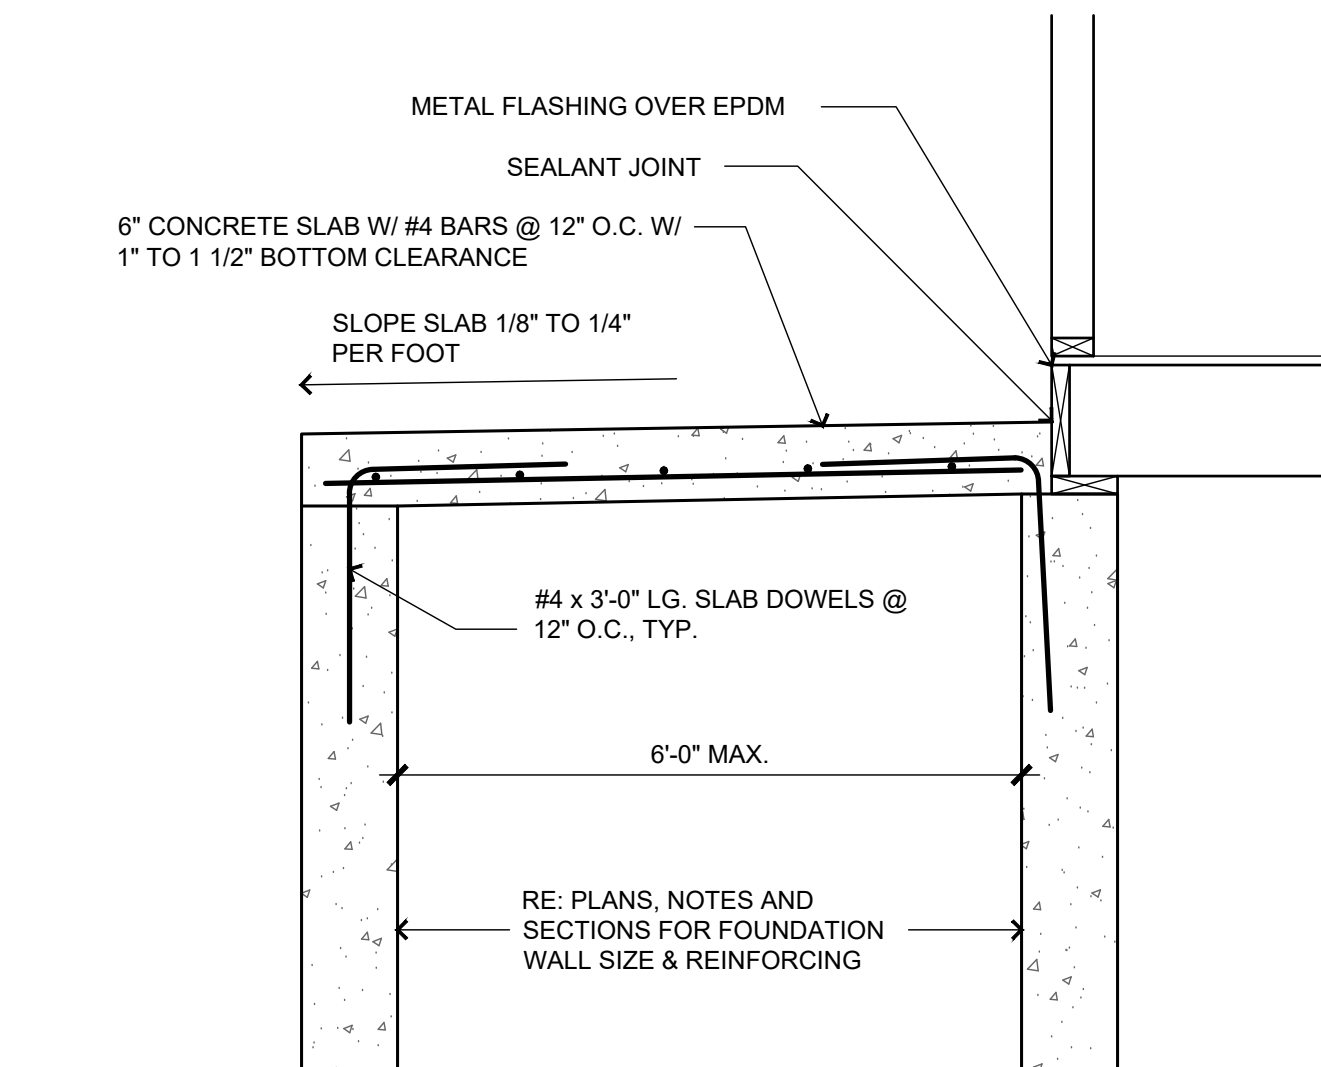


6 SUSPENDED PORCH STOOP  
SCALE: 3/4" = 1'-0"

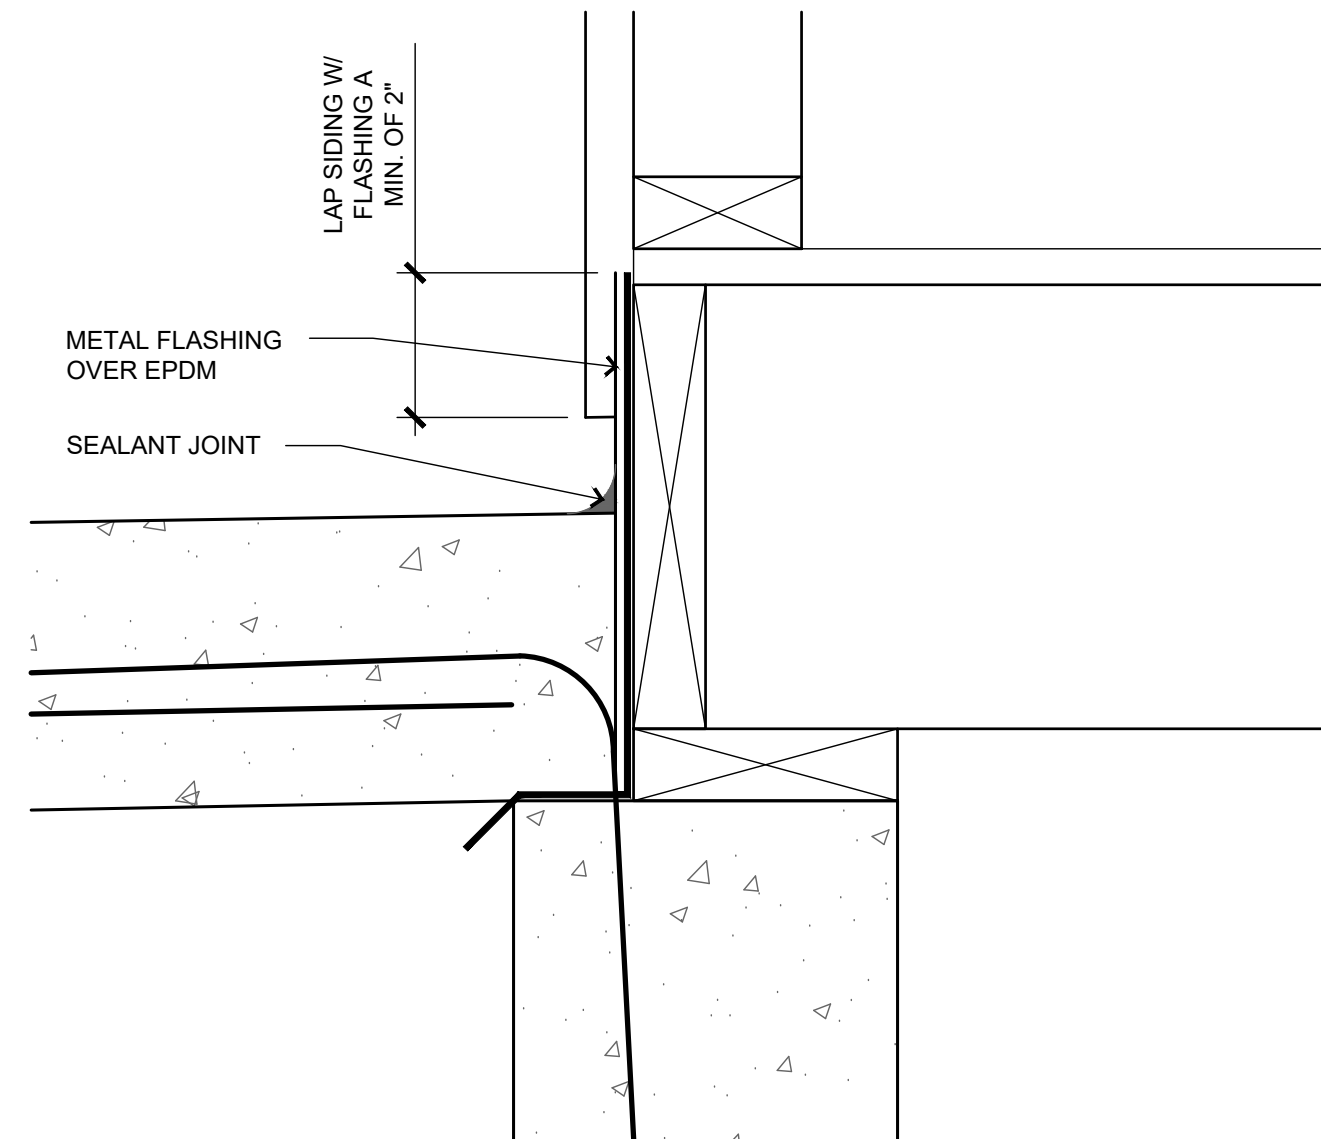


7 STOOP SECTION  
SCALE: 3\"/>

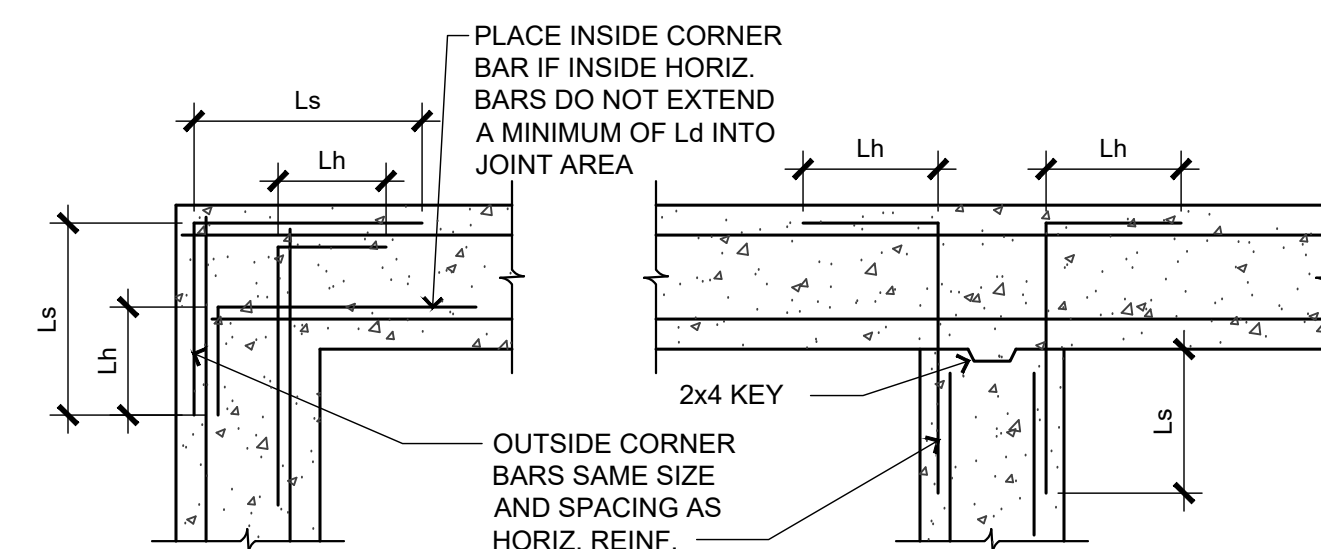


CORNER PLAN INTERSECTION PLAN

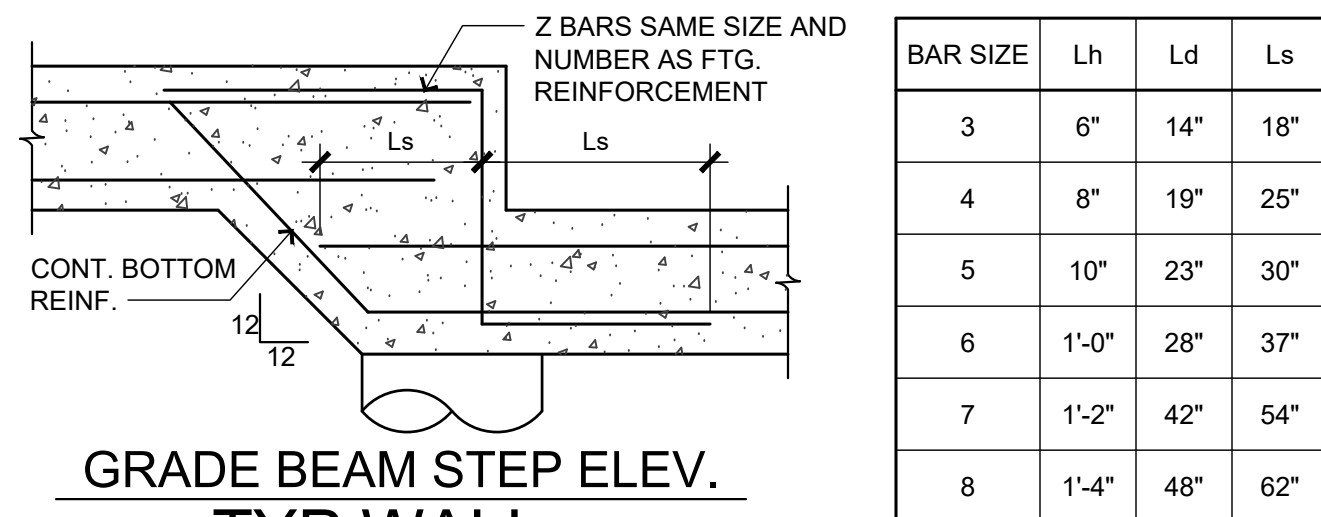


1 GRADE BEAM STEP ELEV. AND GRADE BEAM DTL'S  
SCALE: 3/4" = 1'-0"

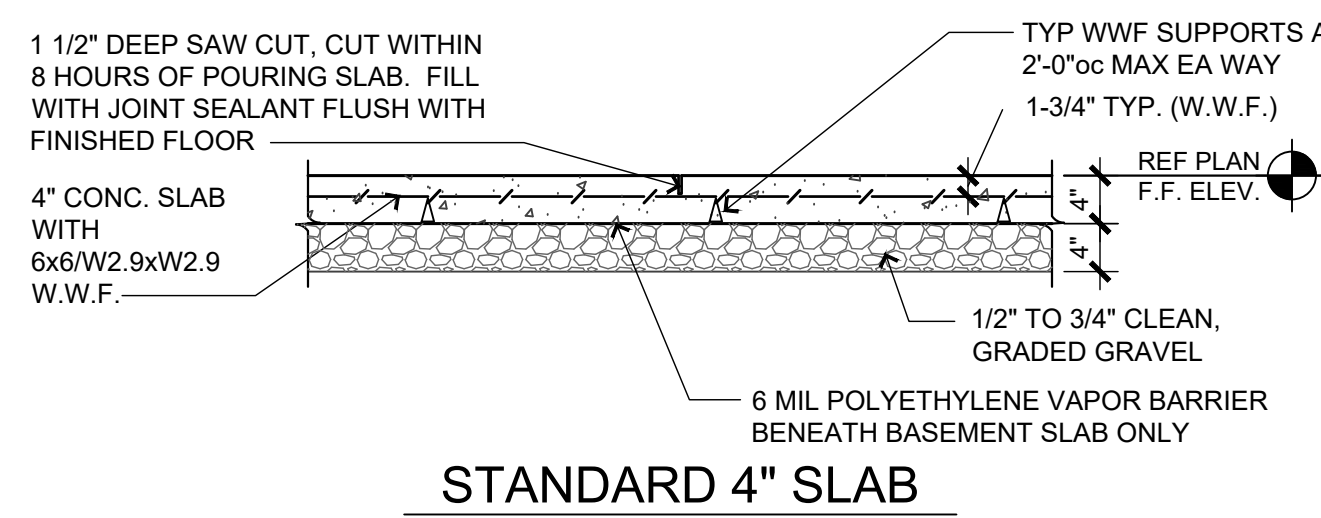

2 STANDARD SLAB DETAILS  
SCALE: 3/4" = 1'-0"

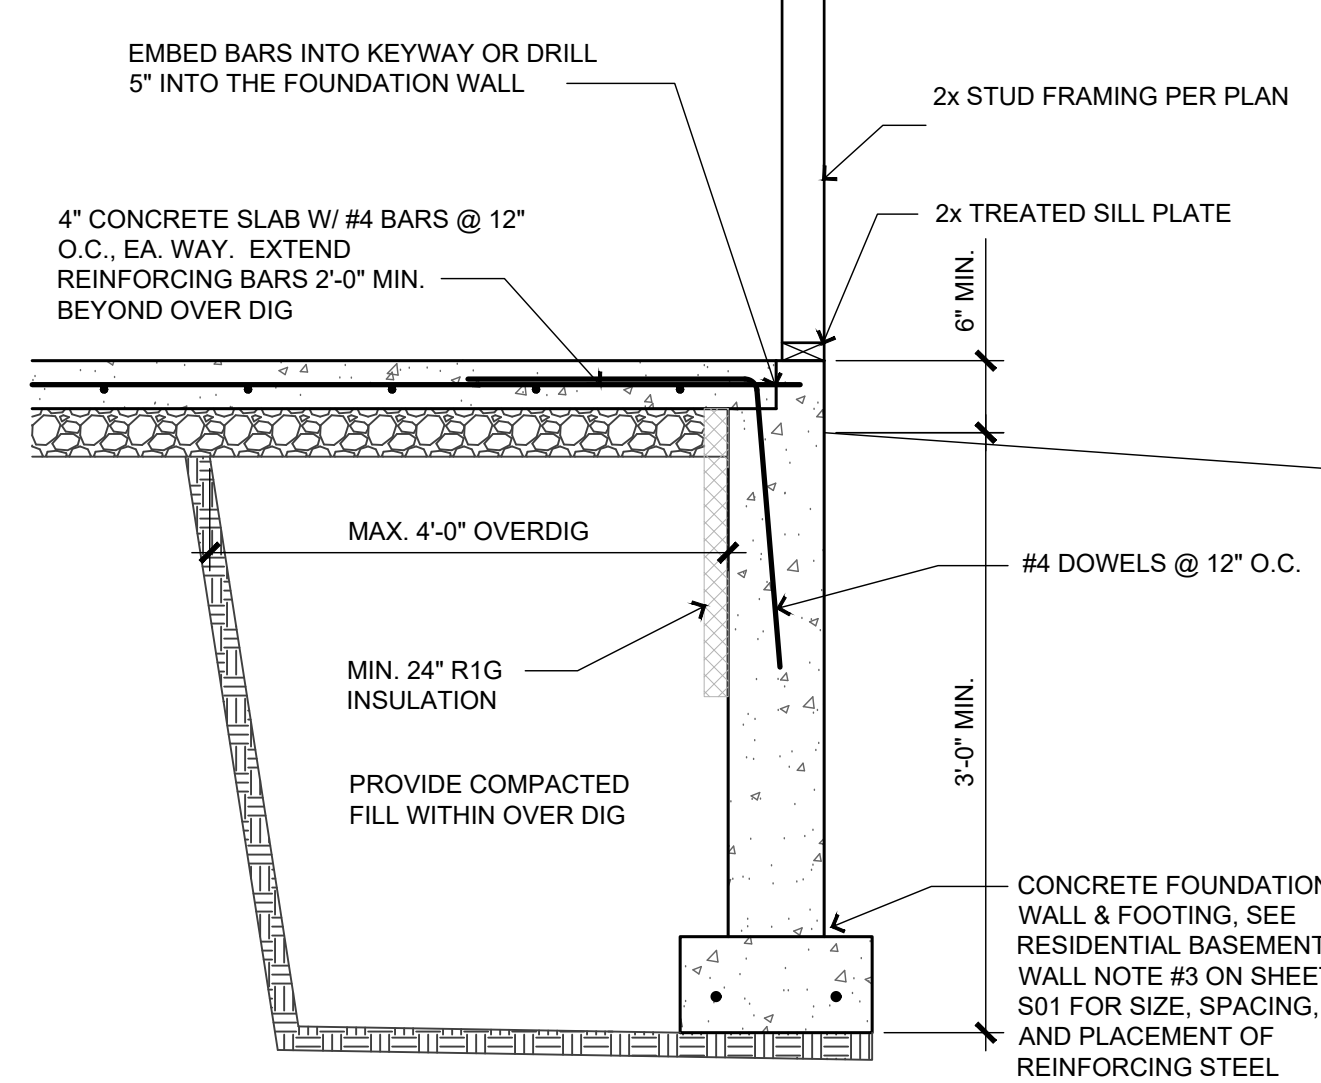

3 OVERDIG SECTION BSMT SLAB  
SCALE: 3/4" = 1'-0"

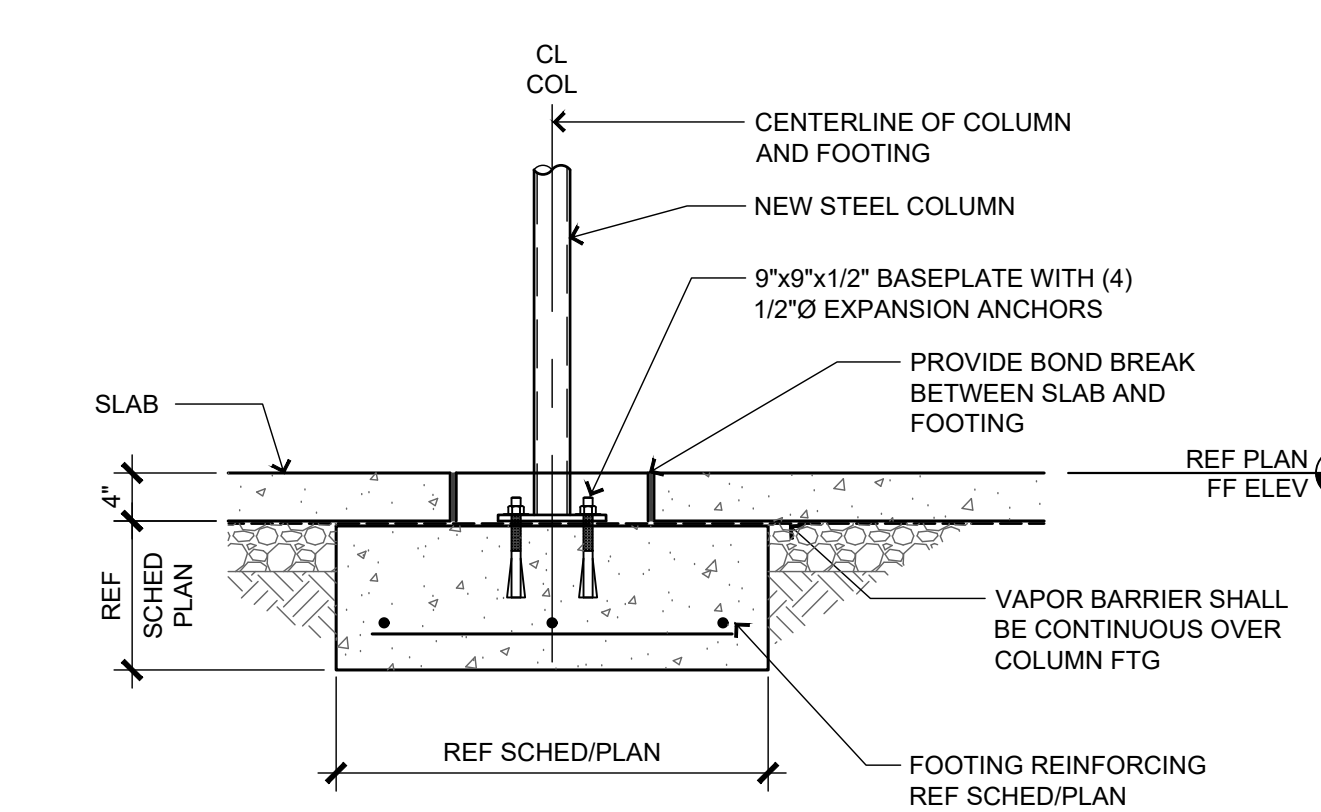

4 TYP. COLUMN FOOTING  
SCALE: 3/4" = 1'-0"

**BILL FOWLER ARCHITECT**

3601 W 122nd Terrace  
Leawood, KS 66209  
913 908 5263  
BFWFOWLER@ME.COM

**N.C.A.R.B.**  
National Council of  
Architectural Registration Boards  
Project:

**Twin  
Villa**

Woodland Glen Lot 53

Location:  
1442-1444 SW Winthrop Ter, Lee's Summit, MO

Client Contact:  
John Duggan  
(913) 498-3536 / jduggan@kc-dsdlaw.com

**Revisions**

NO.	DATE	DESCRIPTION
1	9/25/2024	CONTRACTOR QUESTIONS

Sheet Name:

**Std. Details, Schedules, & Notes**

Sheet No: 6/03/24

**S30**  
BFA No: TWIN-WG53


PERMIT SET

RELEASE FOR CONSTRUCTION  
AS NOTED FOR PLAN REVIEW

LEE'S SUMMIT, MISSOURI


09/26/2024



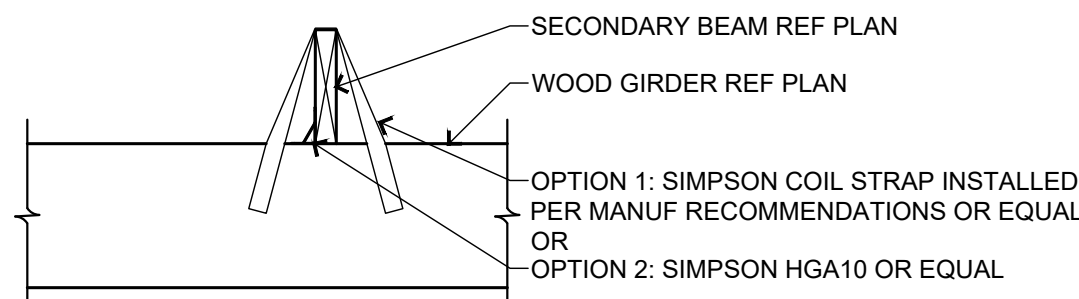


## 12 WD BM BEARING ON WD BM

SCALE: 3/4" = 1'-0"

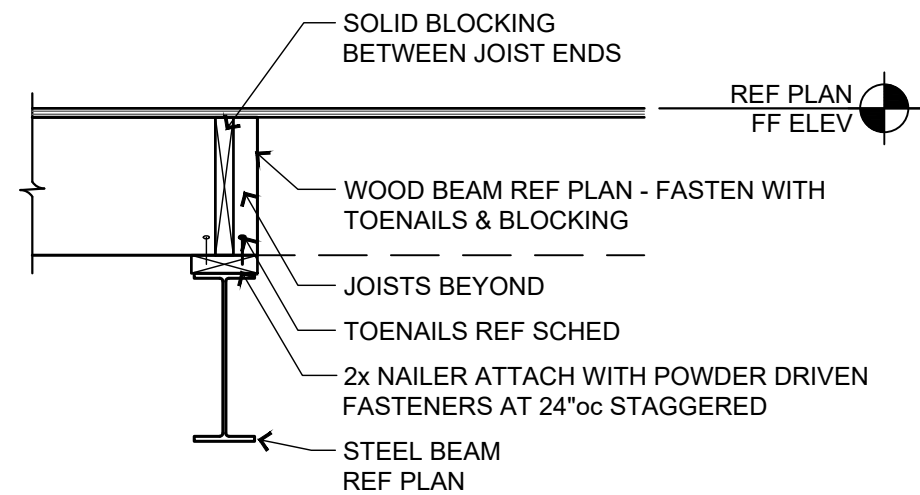


## 13 WD BEAM ON STEEL BEAM

SCALE: 3/4" = 1'-0"

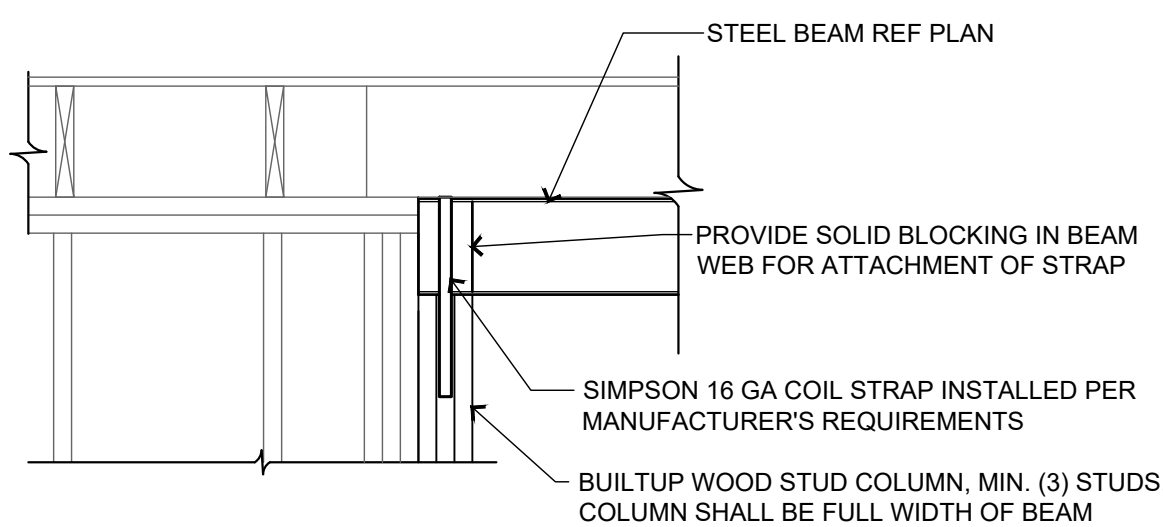


## 14 STL BM PARALLEL TO WALL

SCALE: 3/4" = 1'-0"

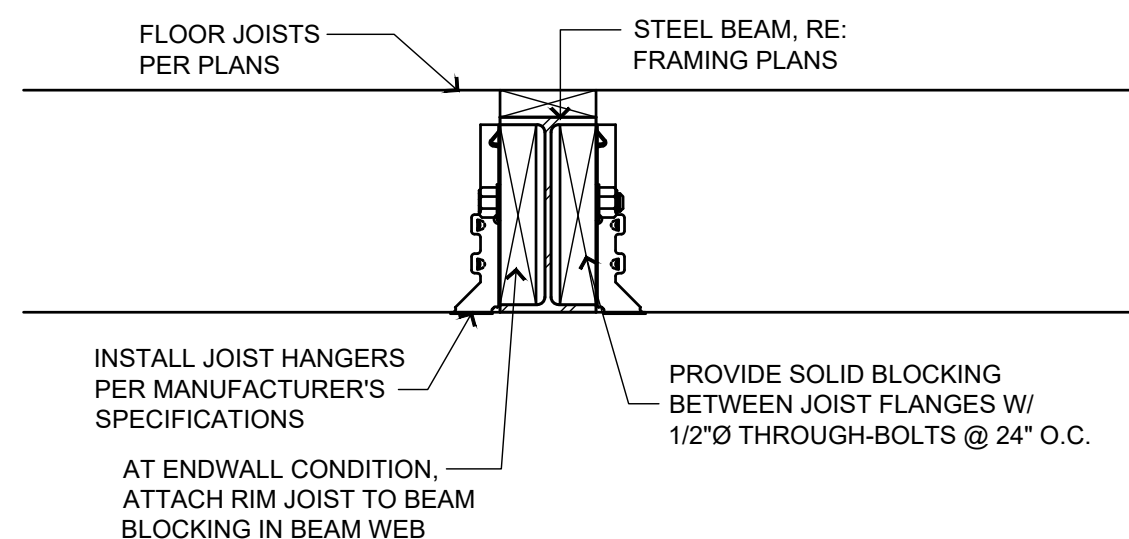


## 15 UPSET STEEL BEAM

SCALE: 1 1/2" = 1'-0"

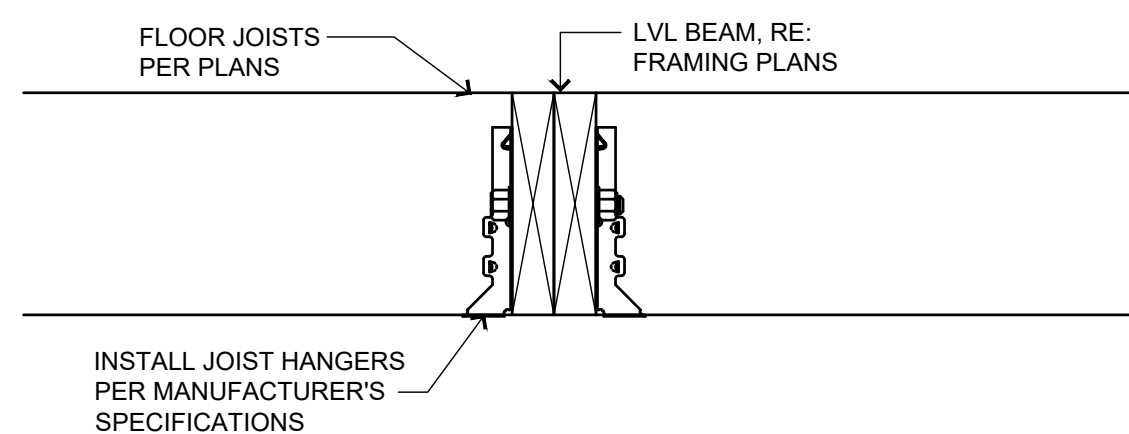

## 16 UPSET LVL BEAM


SCALE: 1 1/2" = 1'-0"

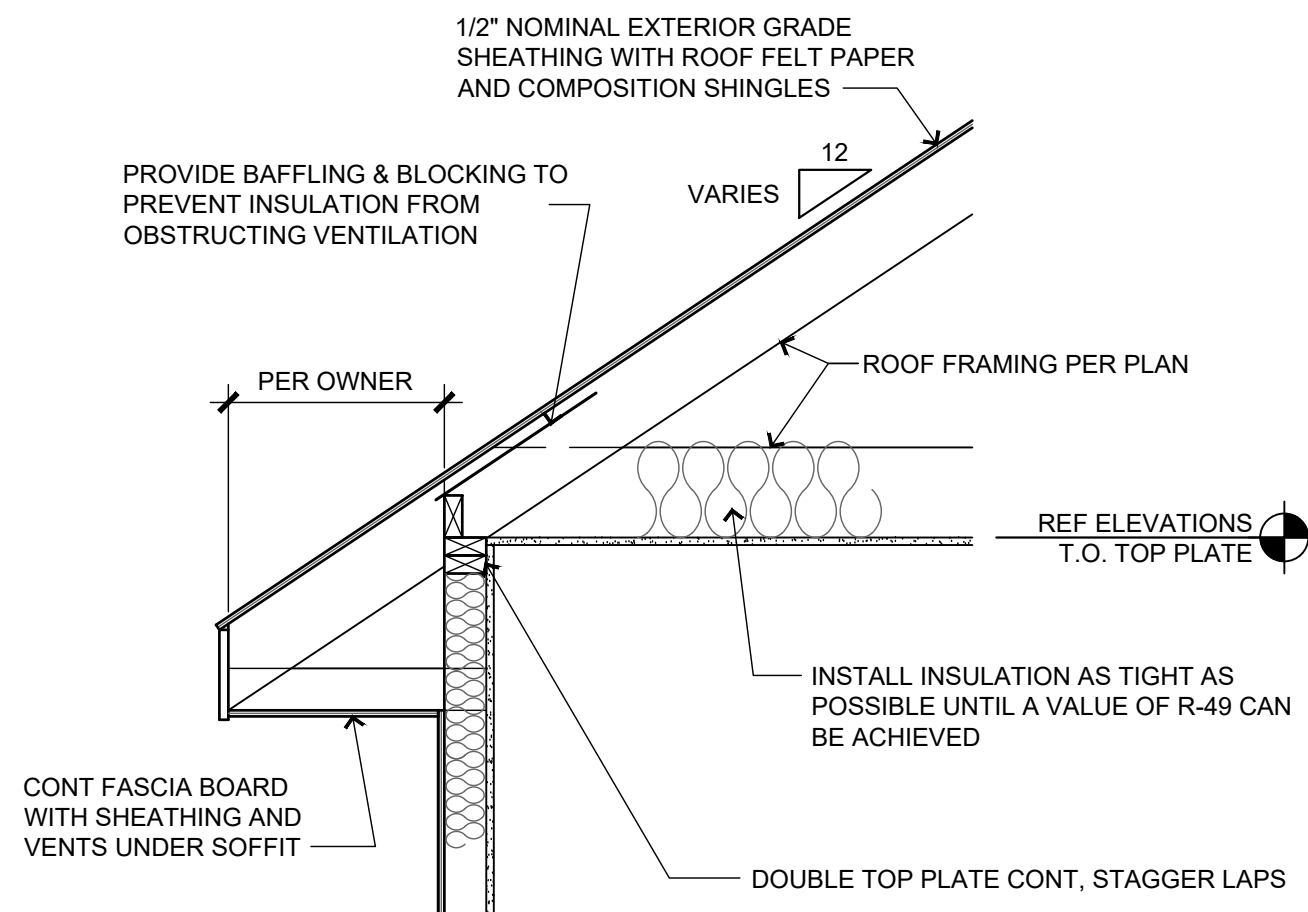

## 8 ROOF RAFTER BEARING


SCALE: 3/4" = 1'-0"

X-WALSEC02

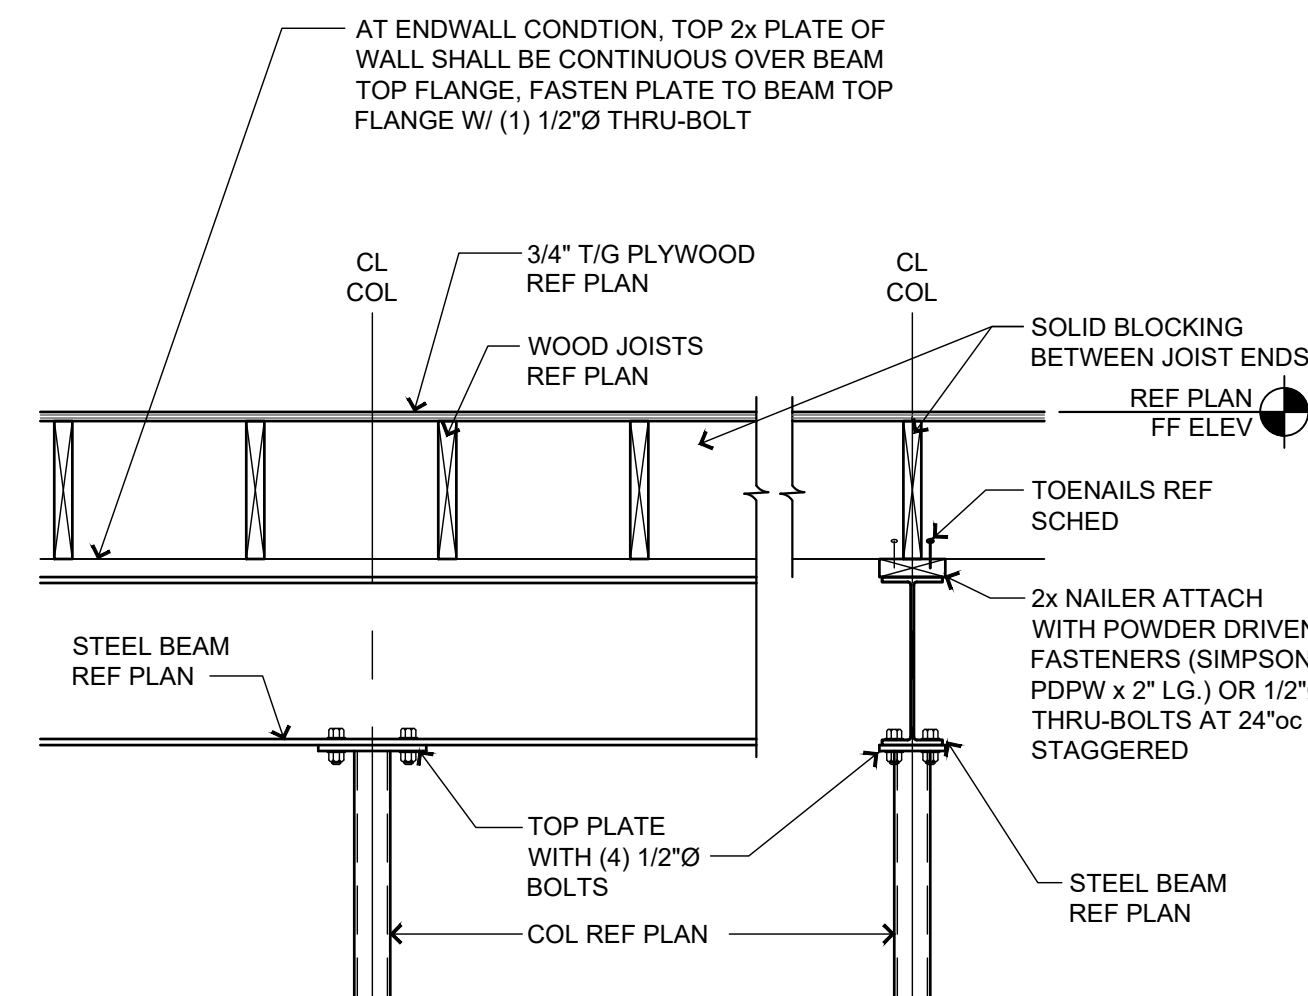


## 9 TYP. BEAM AT COLUMN

SCALE: 3/4" = 1'-0"

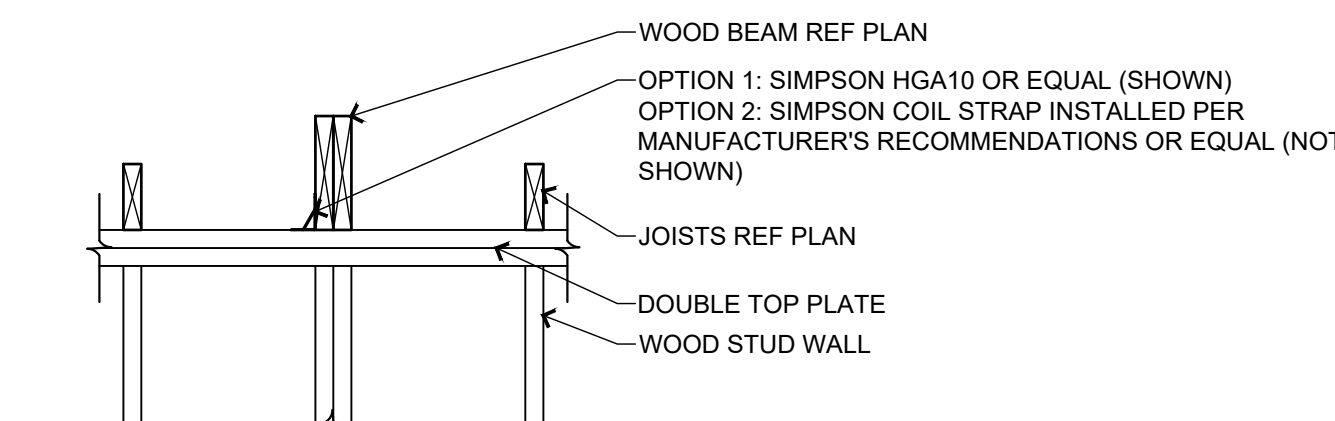


## 10 TYP WOOD BM PERP TO WALL

SCALE: 3/4" = 1'-0"

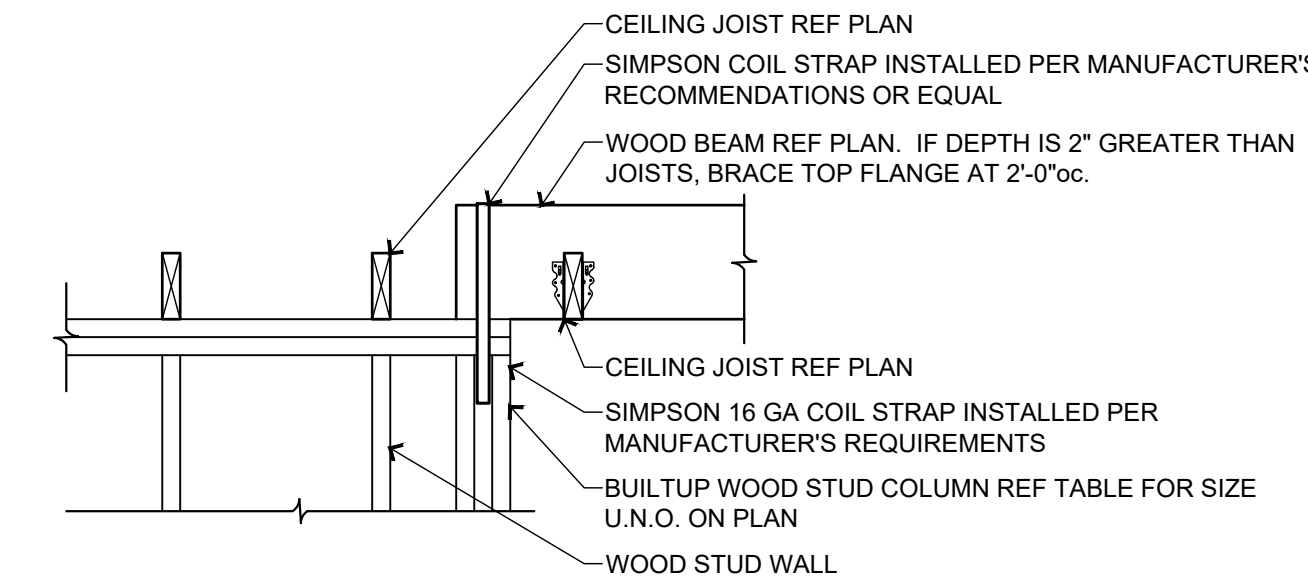

## 11 TYP WD BM PARALLEL TO WALL


SCALE: 3/4" = 1'-0"

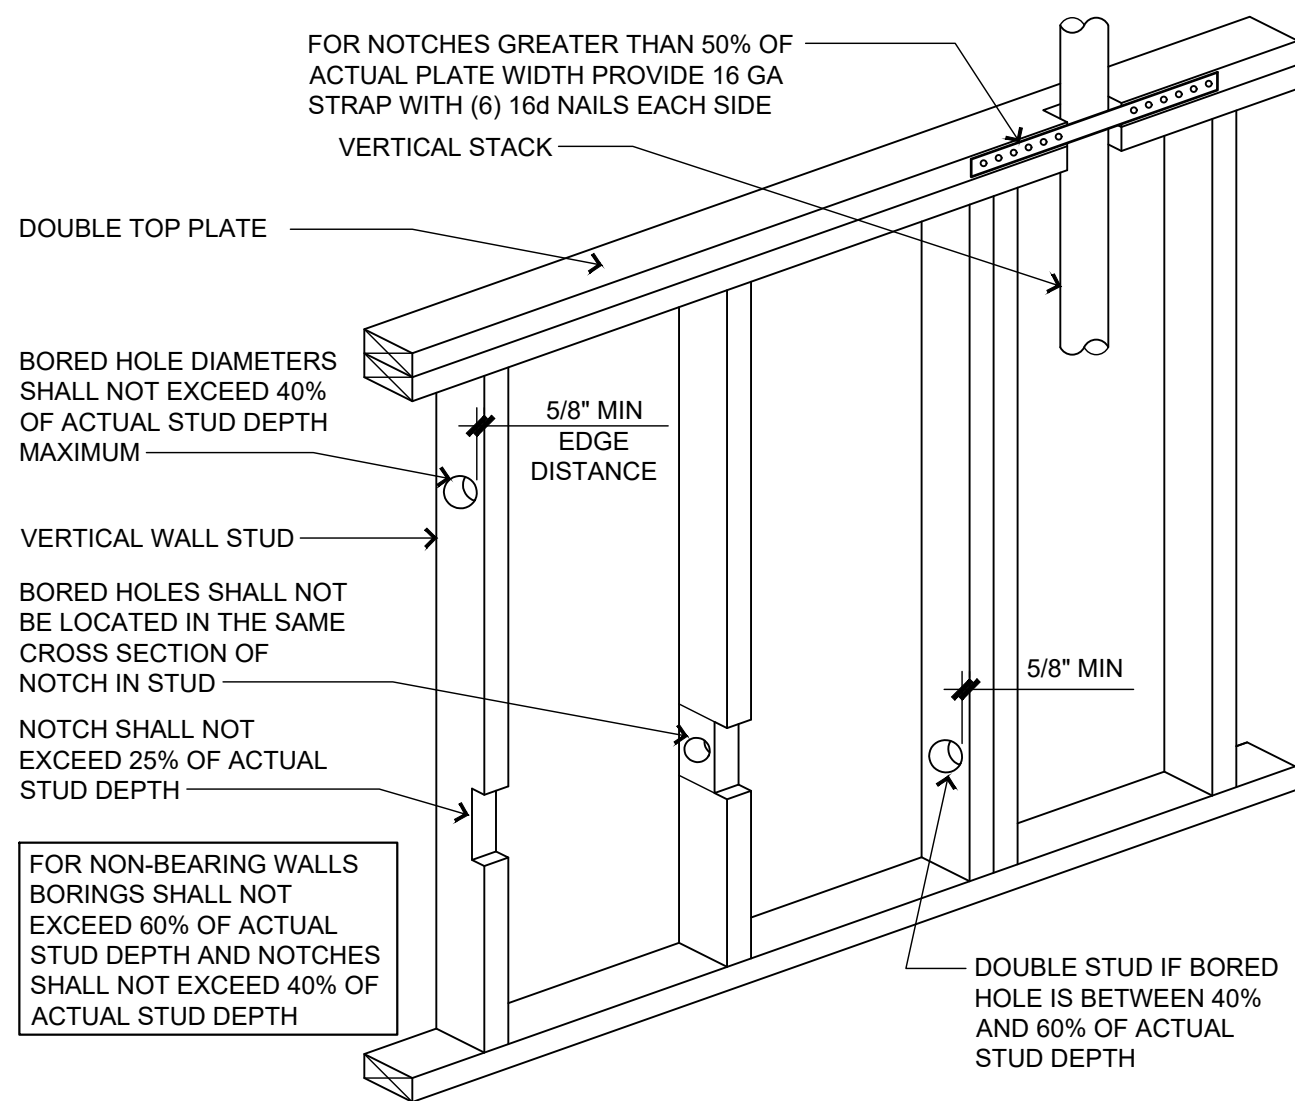

## 5 NOTCHING AND BORING WALLS


SCALE: 3/4" = 1'-0"

BUILT UP COLUMN NAILING SCHEDULE							
BUILT UP COLUMN	BUILT UP SECTION	PATTERN	END DISTANCE	EDGE DISTANCE	ROW SPACING	NAIL SPACING	NAIL SIZE
BC1	(2) 2x6	2	2 1/2"	1 1/2"	2 1/2"	9"	10d
BC2	(3) 2x6	2	3 1/2"	1 1/2"	2 1/2"	9"	30d
BC3	(4) 2x6	2	4"	1 1/2"	2 1/2"	9"	50d
BC4	(2) 2x4	1	2 1/2"	1"	---	6"	10d
BC5	(3) 2x4	1	3 1/2"	1 1/2"	---	8"	30d

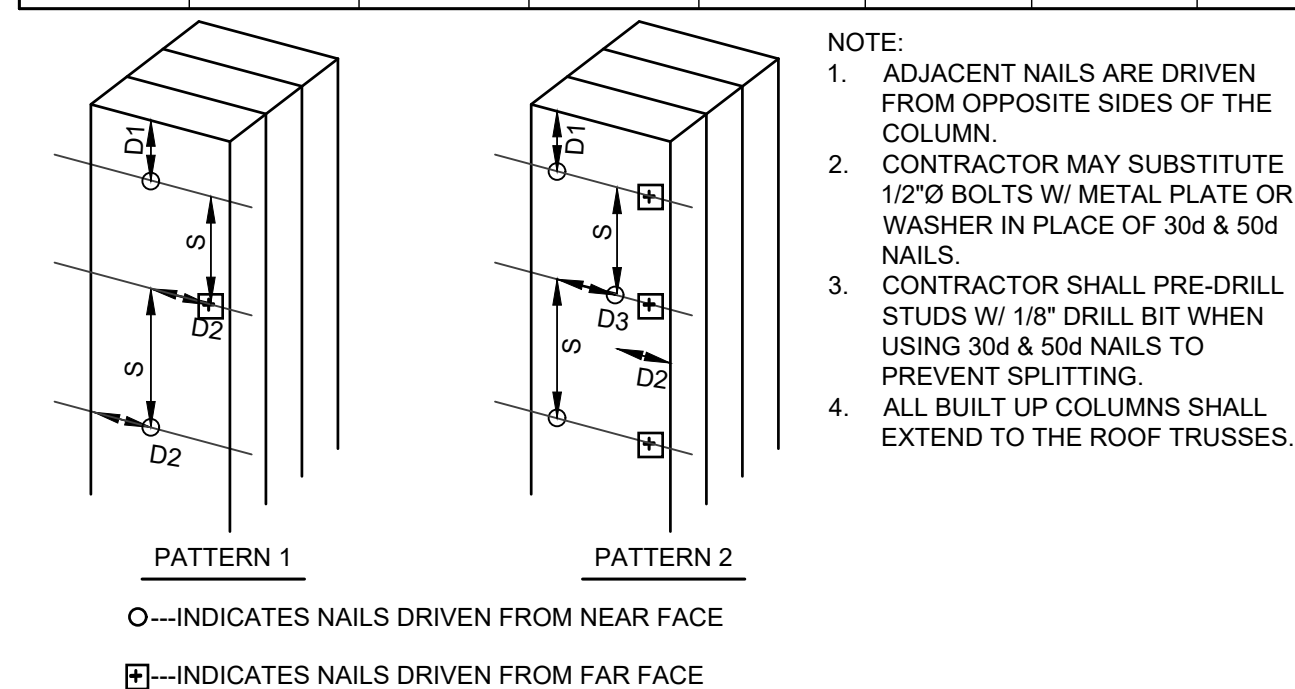

## 6 BUILT UP COLUMN SCHEDULE

SCALE: 3/4" = 1'-0"

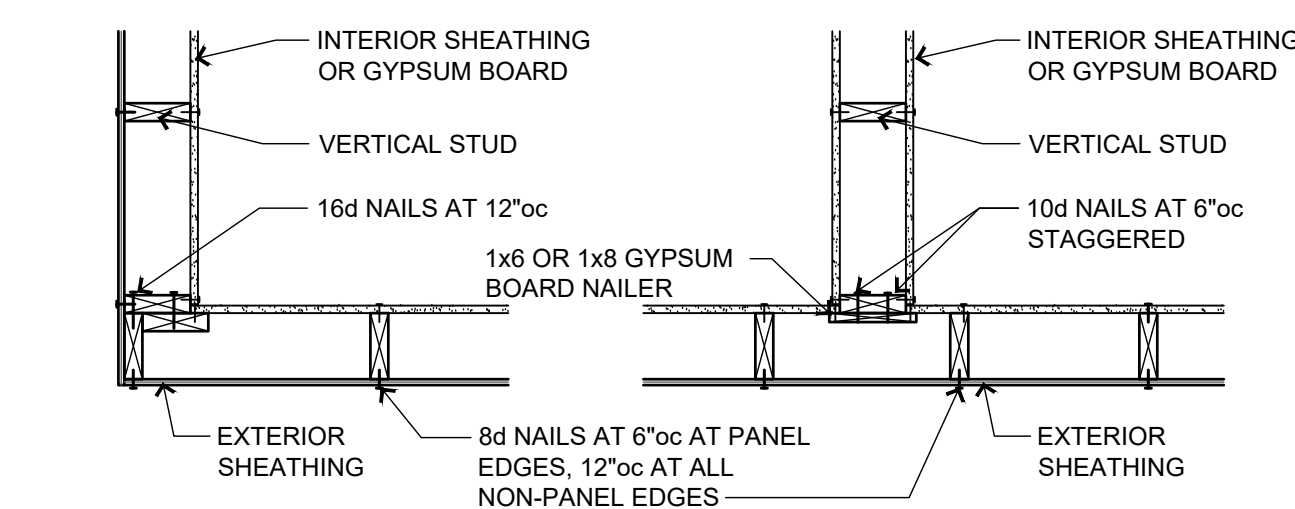


BEARING WALL HEADERS (CENTER BEARING FLOOR)							
INTERIOR WALL (1 FLOOR)				EXTERIOR WALL (ROOF ONLY)			
SPAN	SIZE	NO. J.S.		SPAN	SIZE	NO. J.S.	
0'-0" - 4'-5"	(2) 2x8	2		0'-0" - 5'-4"	(2) 2x8	2	
4'-6" - 5'-5"	(2) 2x10	2		5'-5" - 6'-6"	(2) 2x10	2	
5'-6" - 6'-3"	(2) 2x12	2		6'-7" - 7'-6"	(2) 2x12	2	
INTERIOR WALL (2 FLOORS)				EXT WALL (ROOF + FLOOR)			
0'-0" - 3'-2"	(2) 2x8	2		0'-0" - 4'-6"	(2) 2x8	2	
3'-3" - 3'-10"	(2) 2x10	3		4'-7" - 5'-6"	(2) 2x10	2	
3'-11" - 4'-5"	(2) 2x12	3		5'-7" - 6'-5"	(2) 2x12	2	
EXT WALL (ROOF + 2 FLOORS)							
0'-0" - 3'-9"	(2) 2x8	2		0'-0" - 3'-9"	(2) 2x8	2	
3'-10" - 4'-7"	(2) 2x10	2		3'-10" - 4'-7"	(2) 2x10	2	
4'-8" - 5'-3"	(2) 2x12	2		4'-8" - 5'-3"	(2) 2x12	2	

NOTE:  
1. NOT FOR OPEN WEB TRUSS SYSTEMS  
2. MAXIMUM JOIST SPAN OF 18FT  
3. HEADERS SUPPORT FLOOR LOADS ONLY, NO ROOF LOADS


## 7 TYP WALL FRAMING DETAILS

SCALE: 3/4" = 1'-0"

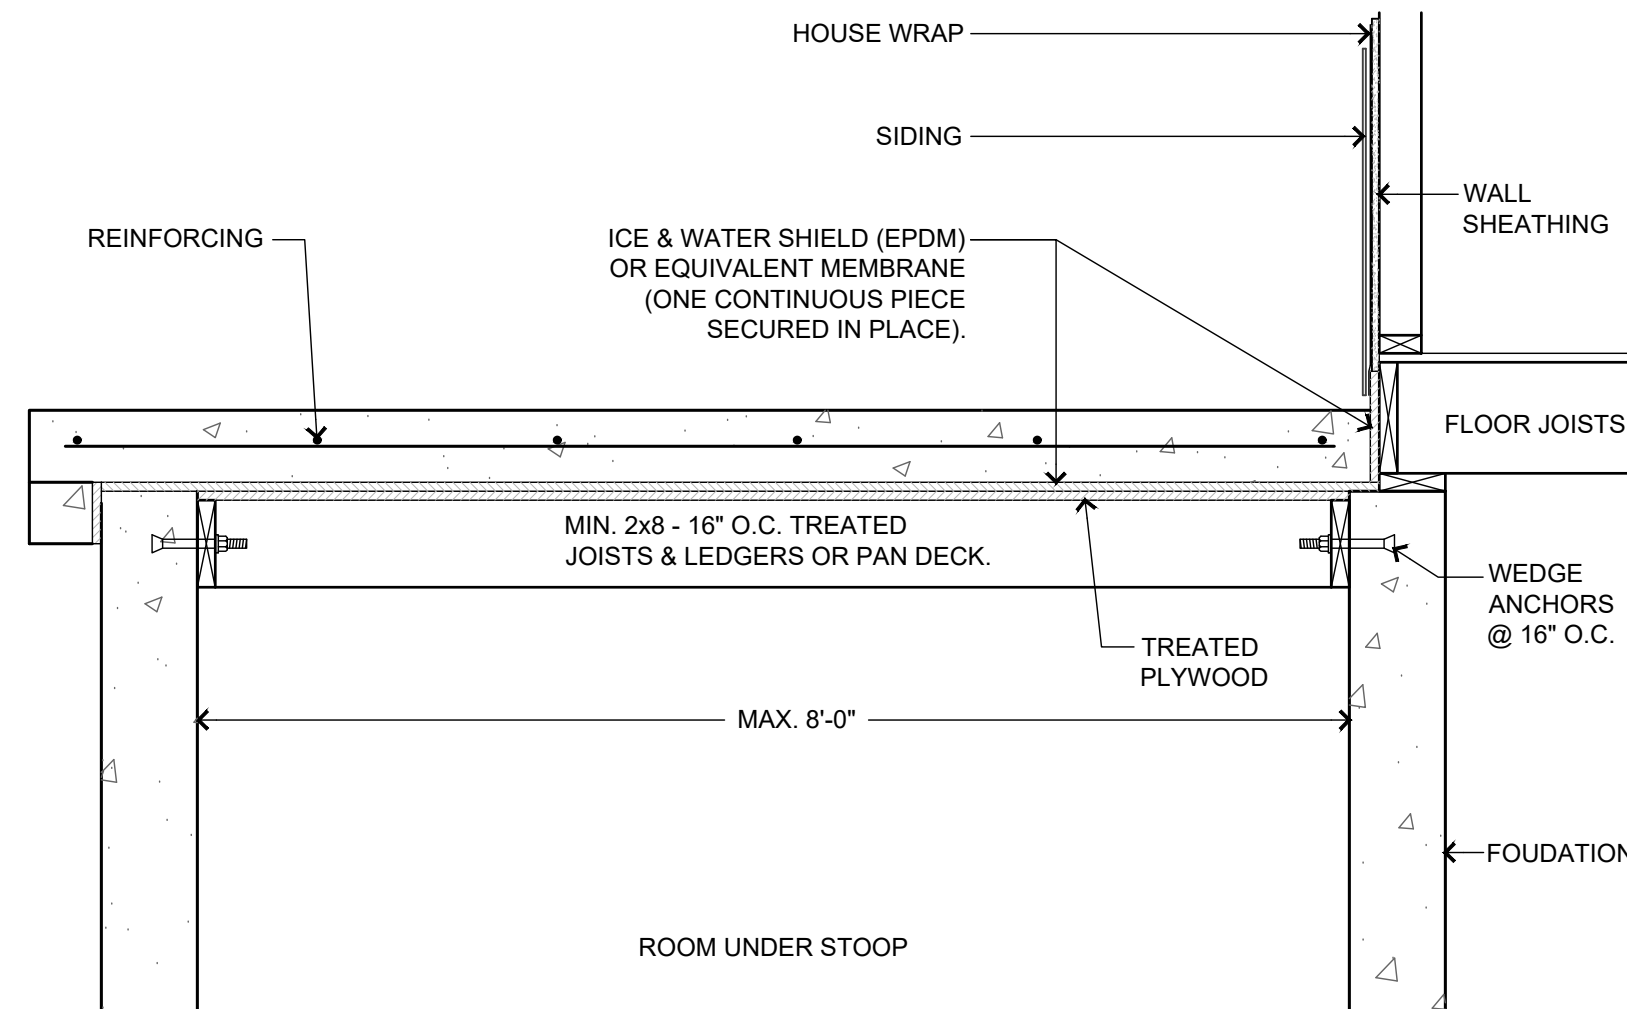


## 1 FLASHING DETAIL - ROOM UNDER STOOP

SCALE: 3/4" = 1'-0"

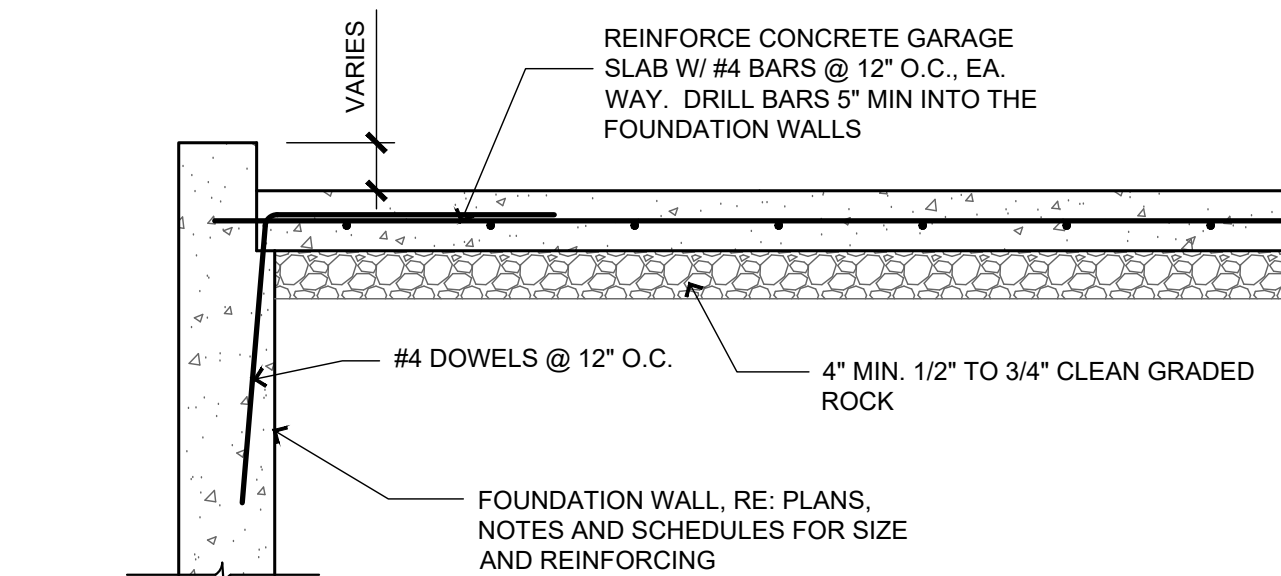


## 2 GARAGE SLAB/WALL SECTION

SCALE: 3/4" = 1'-0"

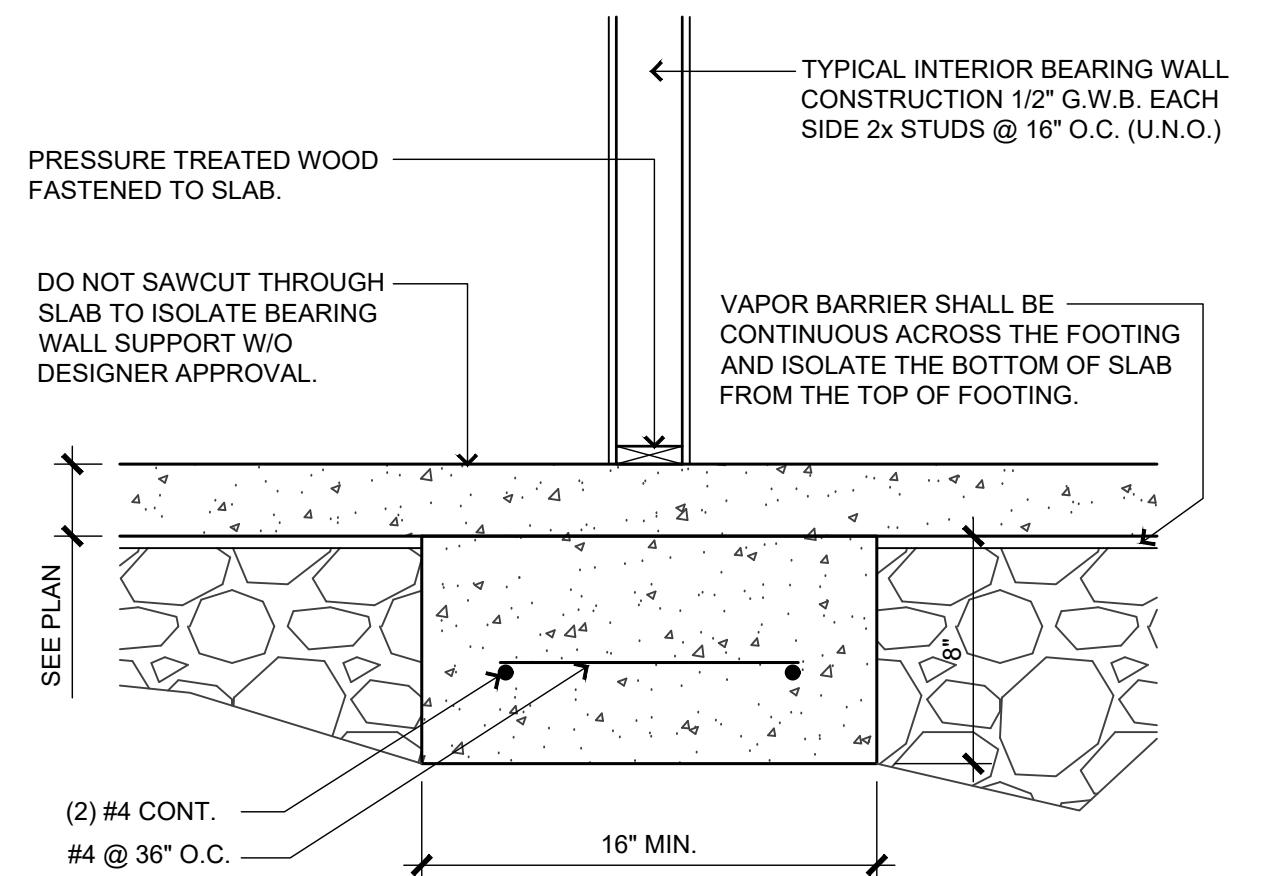


## 3 INTERIOR BEARING WALL

SCALE: 3/4" = 1'-0"

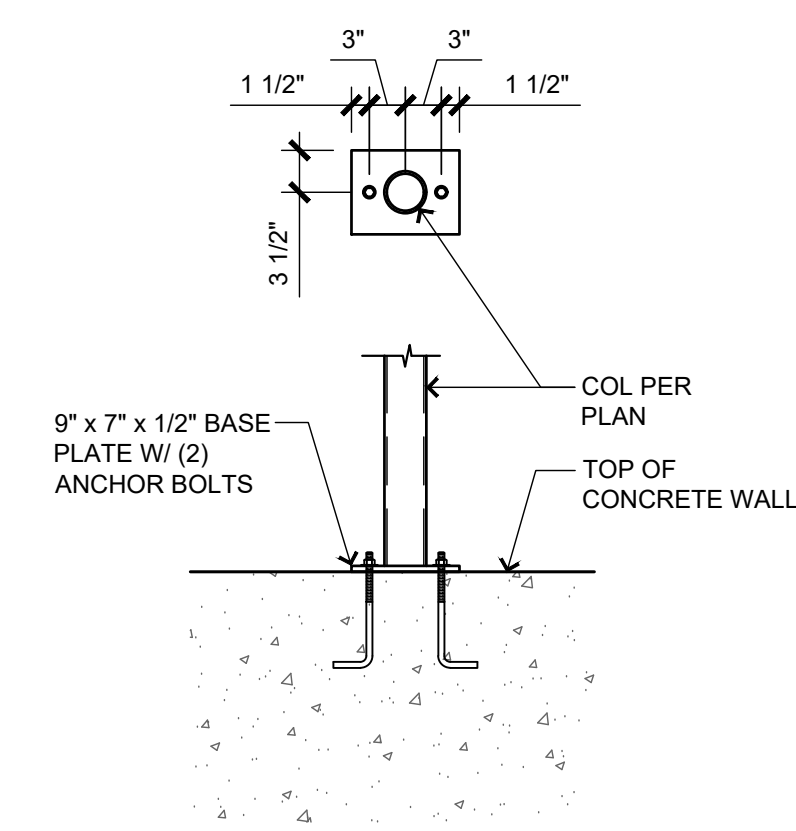

## 4 STL COL ON CONC WALL

SCALE: 3/4" = 1'-0"

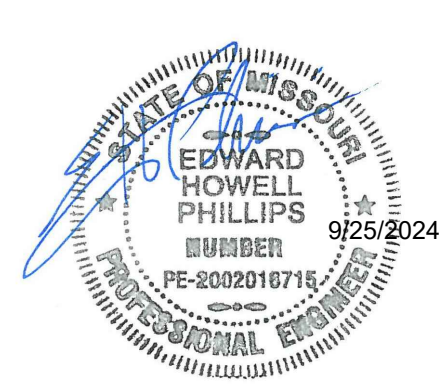

### BILL FOWLER ARCHITECT

3601 W 122nd Terrace  
Leawood, KS 66209  
913 908 5263  
BFWFOWLER@ME.COM

NCARB  
National Council of  
Architectural Registration Boards  
Project:

Twin

Villa

Woodland Glen Lot 53

Location:  
1442-1444 SW Winthrop Ter, Lee's Summit, MO

Client Contact:  
John Duggan  
(913) 498-3536 / jduggan@kc-dsdlaw.com

### Revisions

NO.	DATE	DESCRIPTION
1	9/25/2024	CONTRACTOR QUESTIONS

Sheet Name:

Std. Details, Schedules, & Notes

Sheet No. Date: 6/03/24

BFA No.: **S31**  
TWIN-WG53



PERMIT SET

RELEASE FOR CONSTRUCTION  
AS NOTED FOR PLAN REVIEW

LEE'S SUMMIT, MISSOURI


09/26/2024



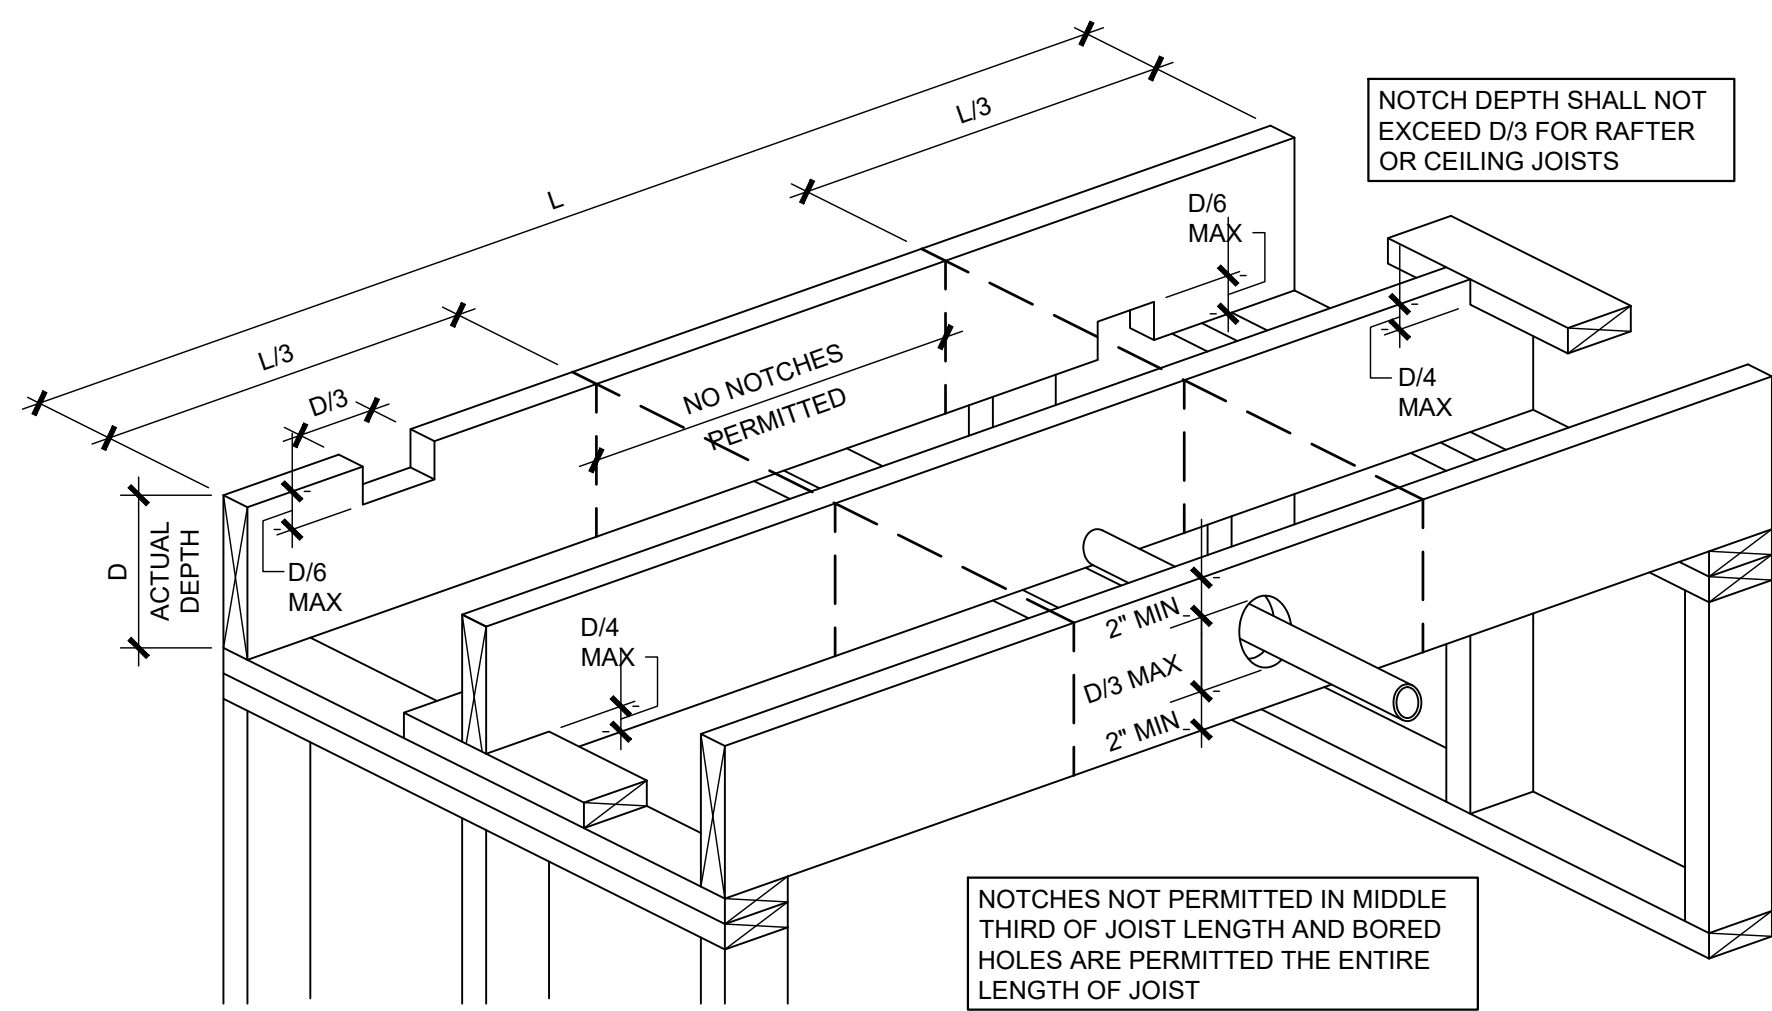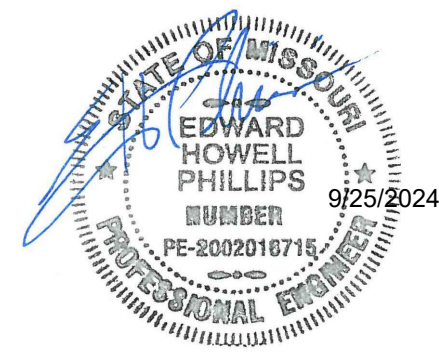


### 3 NOTCHING AND BORING CEILING OR FLOOR JOISTS

SCALE: 3/4" = 1'-0"

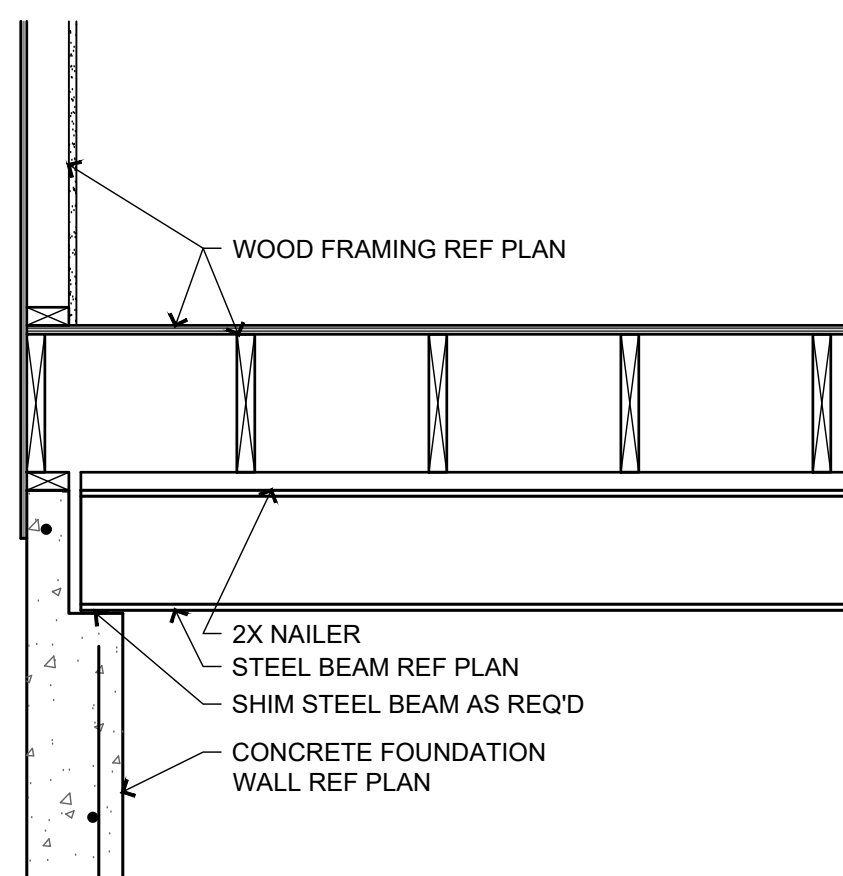


### 6 STL. BM. ON CONC. FNDN. WALL

SCALE: 3/4" = 1'-0"

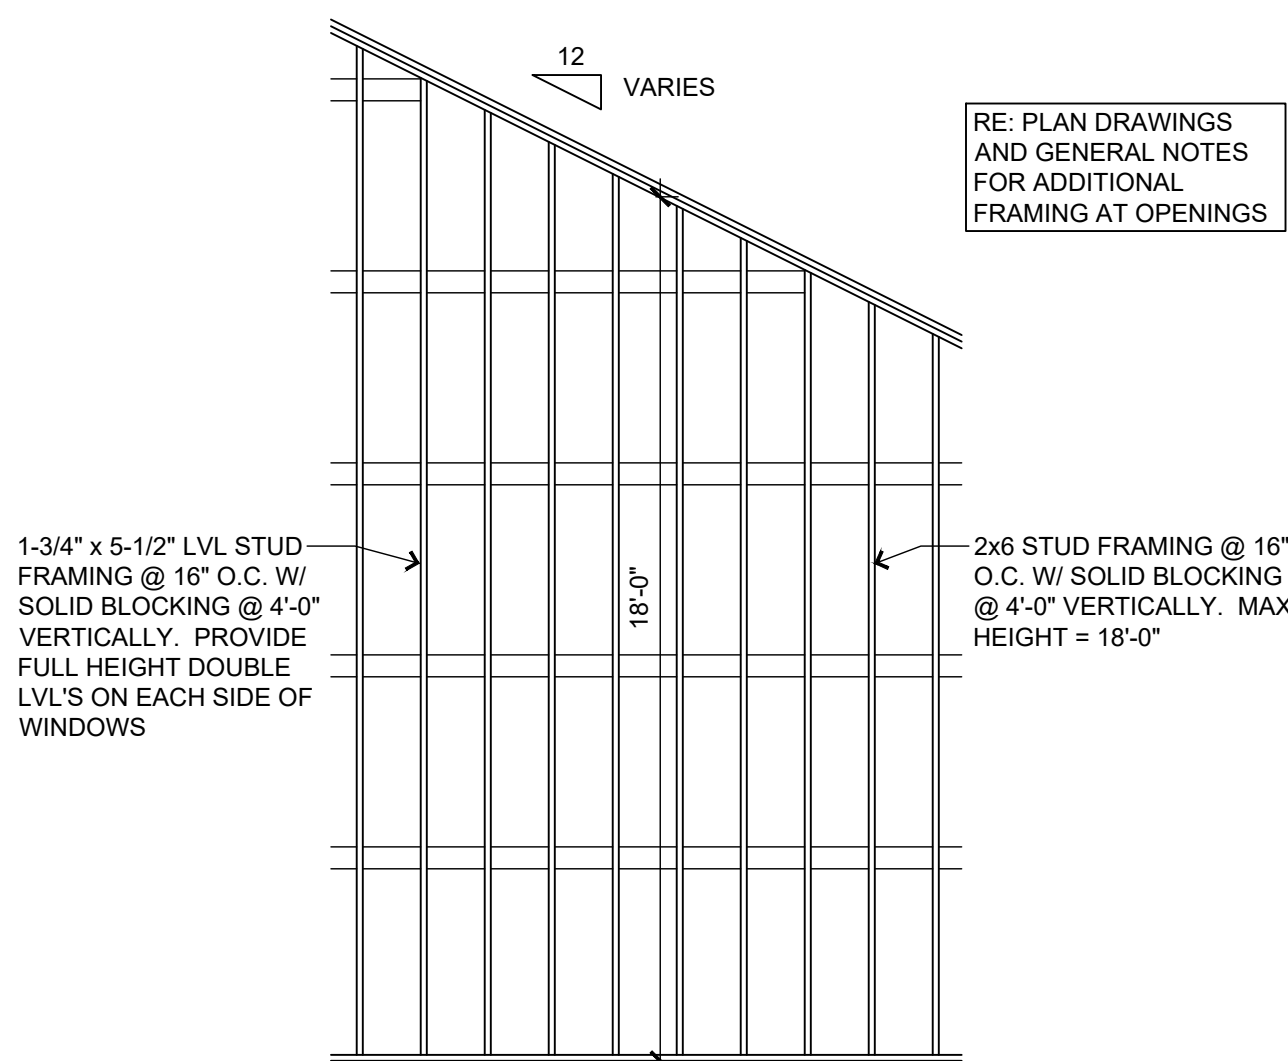


### 4 GENERIC GABLE END WALL FRAMING @ VAULTED CEILINGS

SCALE: 1/4" = 1'-0"

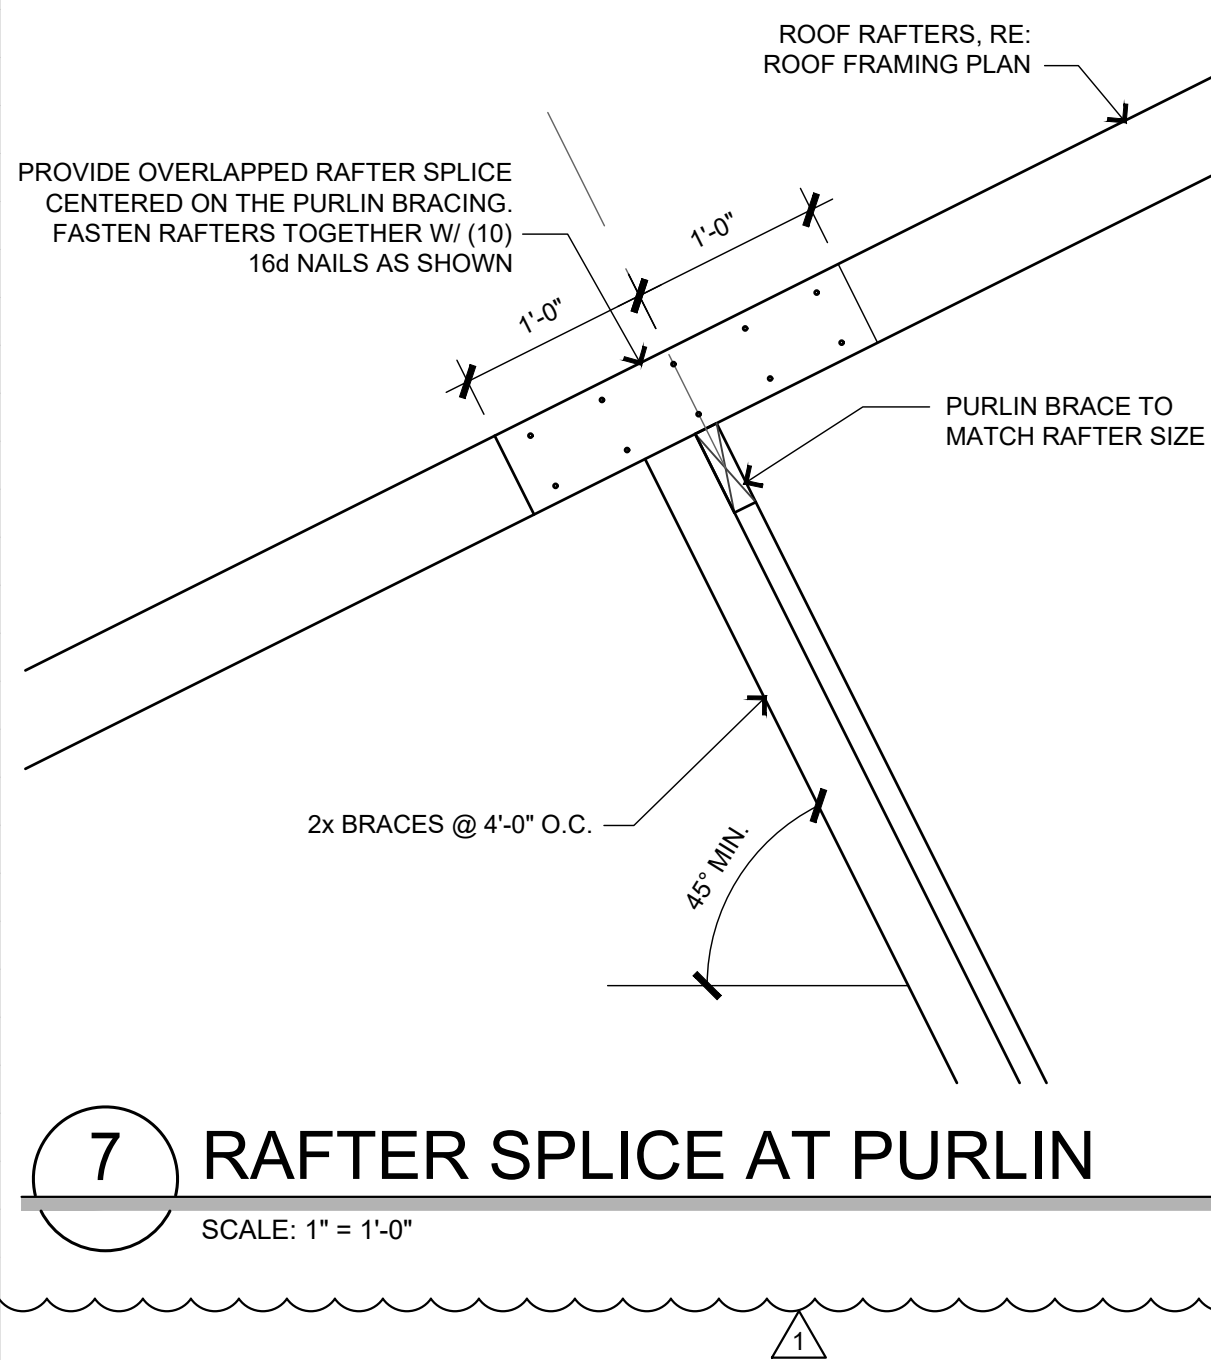


### 7 RAFTER SPLICE AT PURLIN

SCALE: 1" = 1'-0"

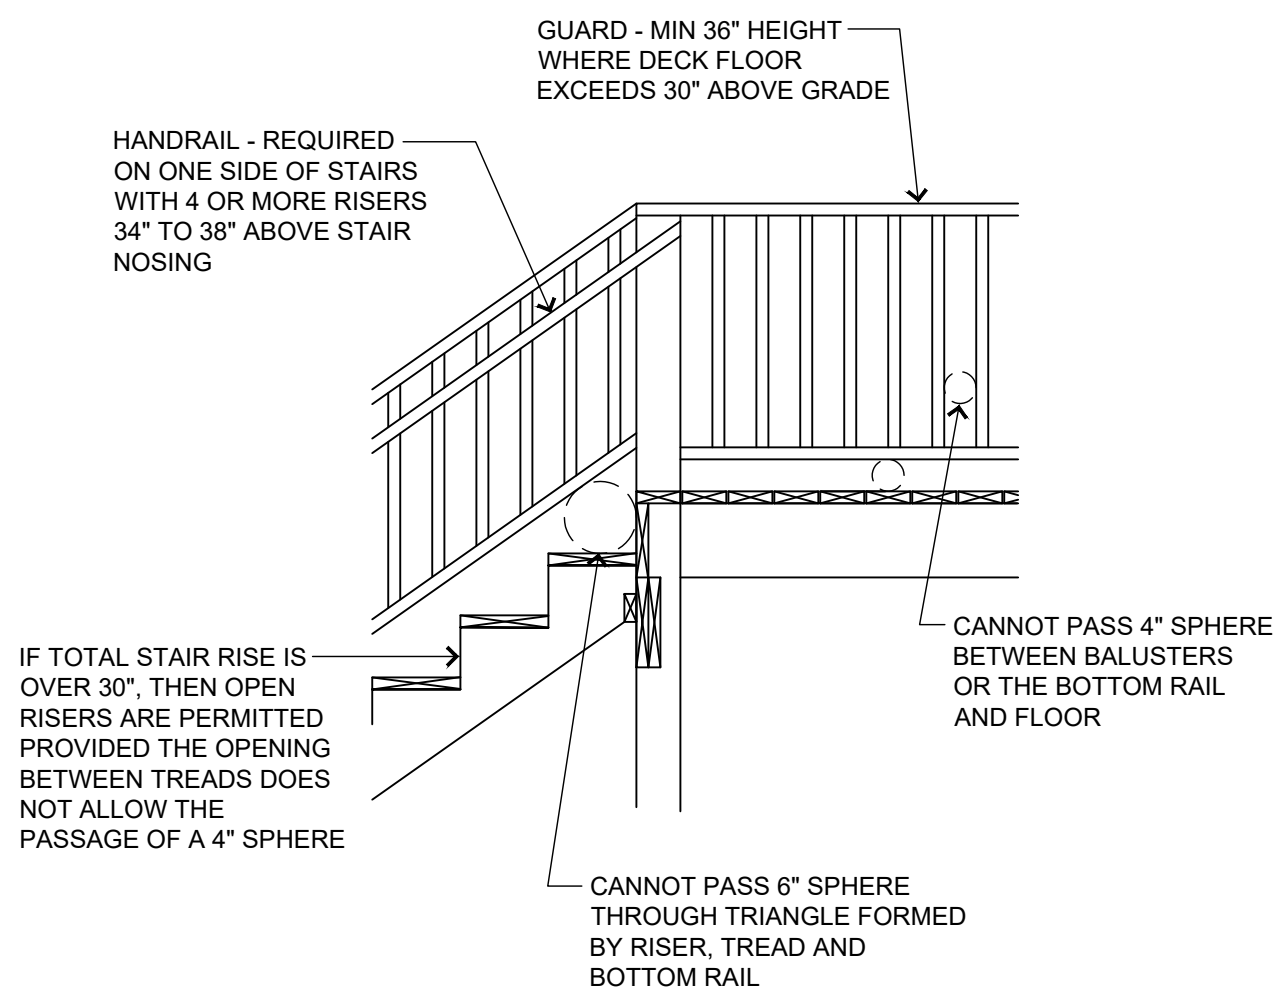


### 5 GUARD DETAIL

SCALE: 3/4" = 1'-0"

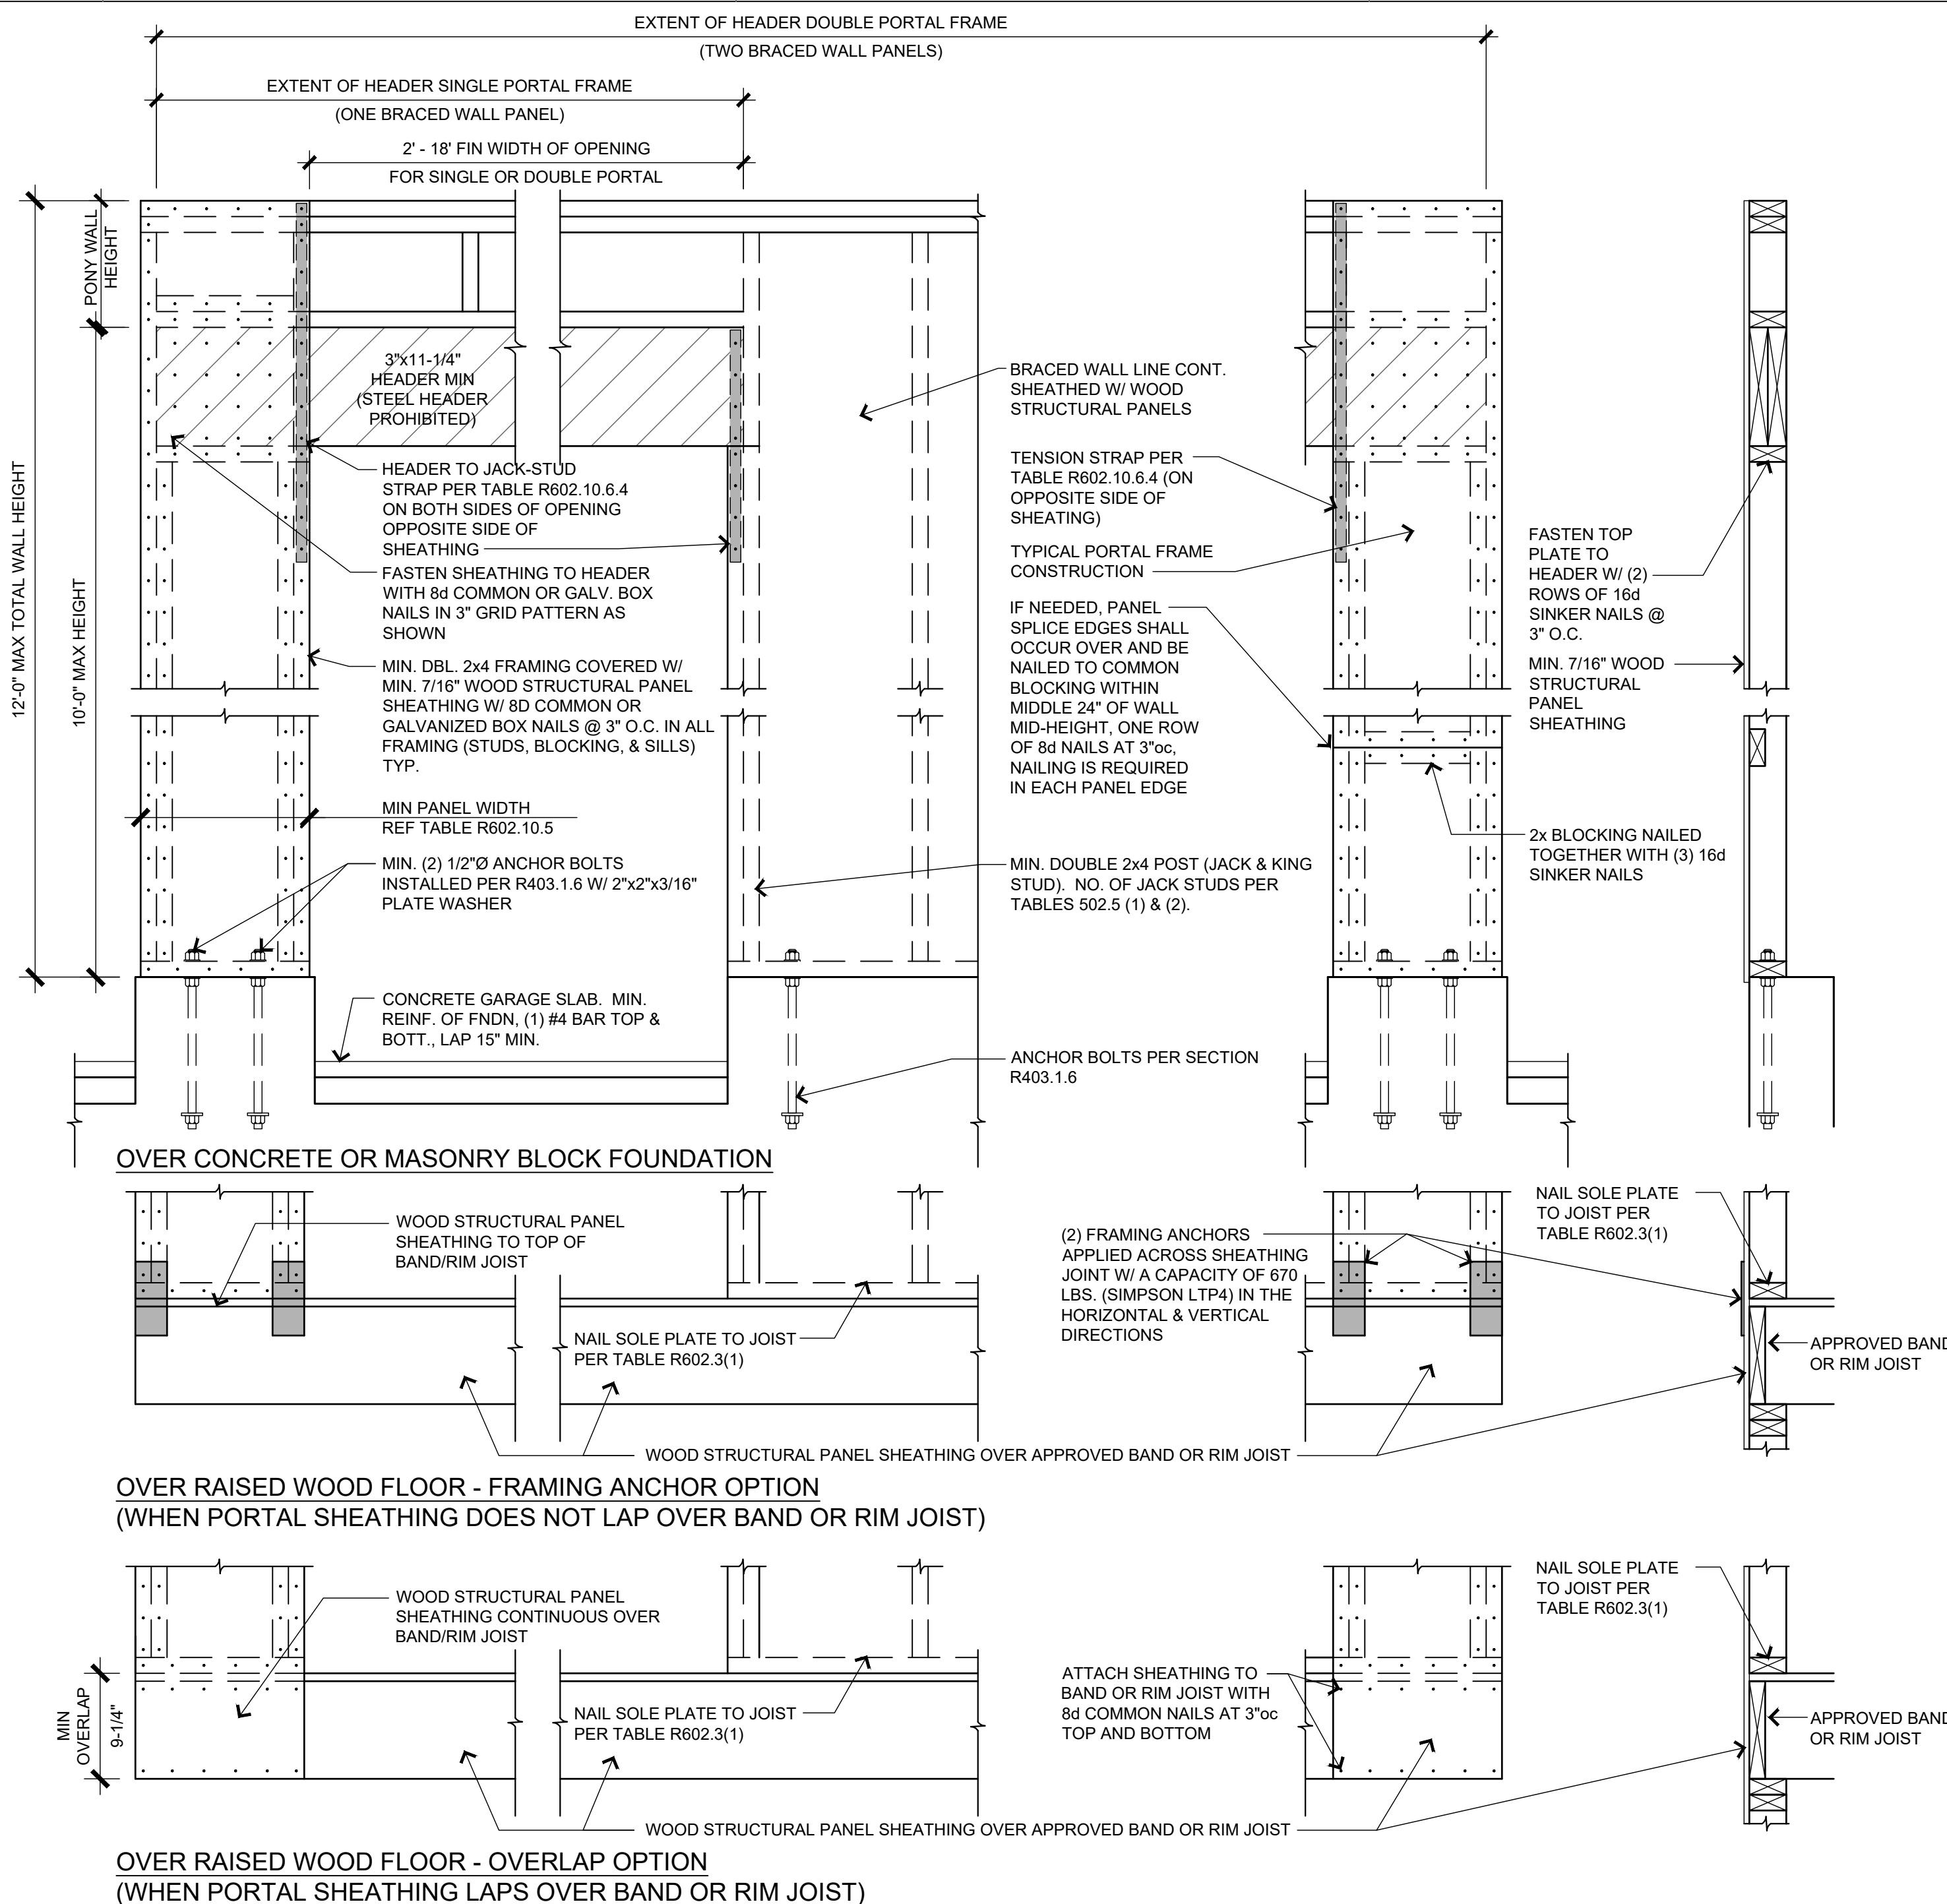

### 1 METHOD CS-PF CONT SHEATHED PORTAL FRAME PANEL (R602.10.6.4)

SCALE: 1" = 1'-0"

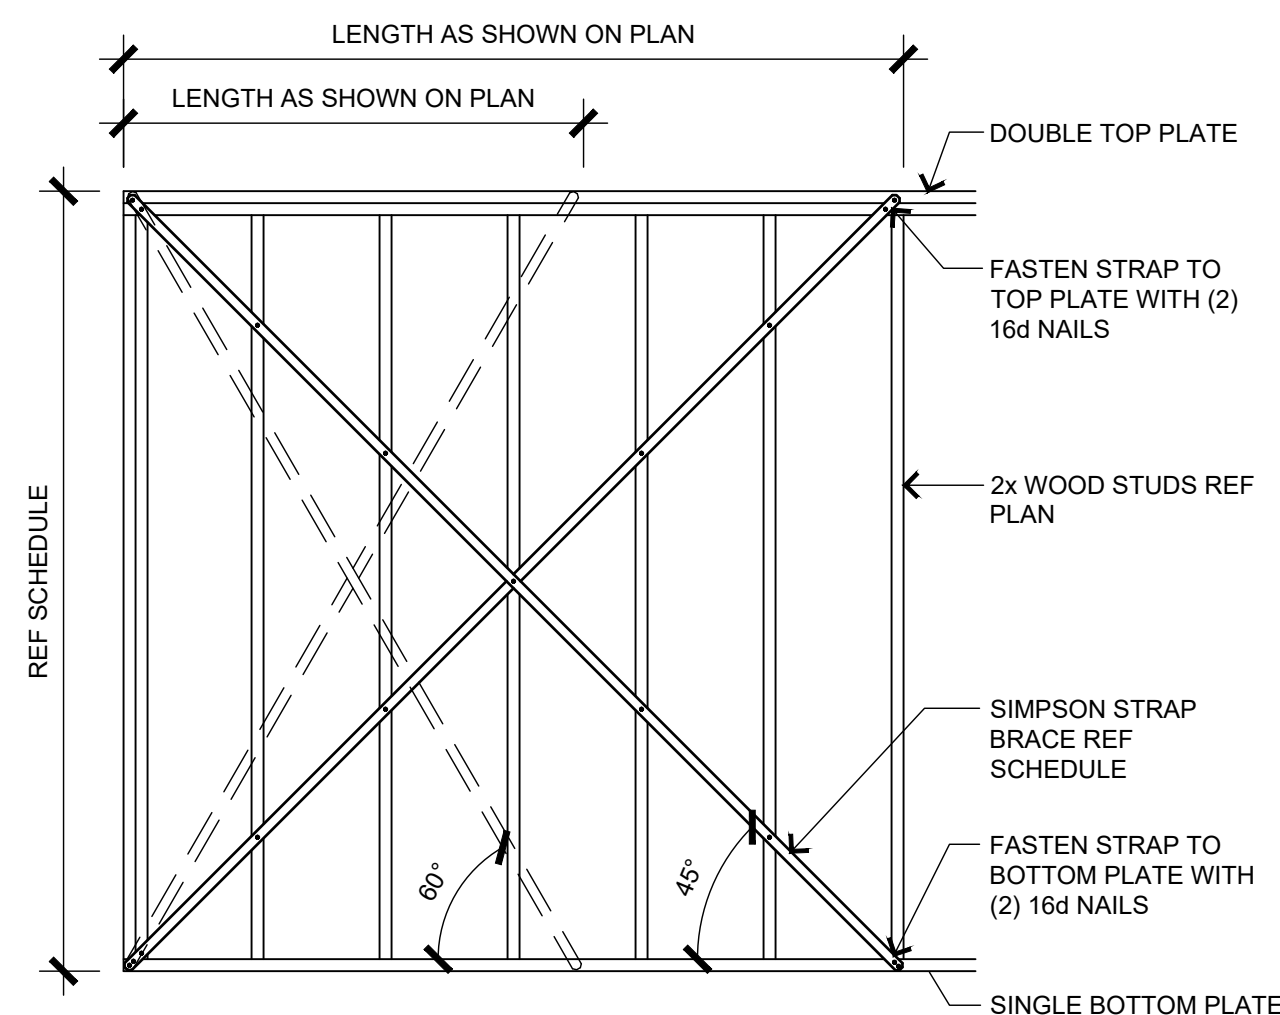

### 2 INTERIOR BRACED WALL (LIB)

SCALE: N.T.S.

TABLE R602.10.5 - MINIMUM LENGTH OF BRACED WALL PANELS						
METHOD		WALL LENGTH PER PORTAL HEADER HEIGHT				
		8 FEET	9 FEET	10 FEET	11 FEET	12 FEET
PFH	SUPPORTING ROOF ONLY	16"	16"	16"	(c)	(c)
	SUPPORTING ONE STORY AND ROOF	24"	24"	24"	(c)	(c)
PFG		24"	27"	30"	(d)	(d)
CS-PF	SEISMIC DESIGN CATEGORY A, B, C	16"	18"	20"	(e)	(e)
	SEISMIC DESIGN CATEGORY D <sub>0</sub> , D <sub>1</sub> , D <sub>2</sub>	16"	18"	20"	(e)	(e)

(c) MAXIMUM HEADER HEIGHT FOR PFH IS 10 FEET IN ACCORDANCE WITH FIGURE R602.10.6.2, BUT WALL HEIGHT MAY BE INCREASED TO 12 FEET WITH PONY WALL.  
(d) MAXIMUM HEADER HEIGHT FOR PFG IS 10 FEET IN ACCORDANCE WITH FIGURE R602.10.6.3, BUT WALL HEIGHT MAY BE INCREASED TO 12 FEET WITH PONY WALL.  
(e) MAXIMUM HEADER HEIGHT FOR CS-PF IS 10 FEET IN ACCORDANCE WITH FIGURE R602.10.4, BUT WALL HEIGHT MAY BE INCREASED TO 12 FEET WITH PONY WALL.

### INTERIOR BRACED WALL SCHEDULE

SIMPSON MODEL NO.	STRAP LENGTH	WALL DIM'S HEIGHT x WIDTH	ANGLE FROM HORIZONTAL	FASTENERS	
				PLATES	EA STUD
WB106	9'-5 5/8"	8'-0" x 5'-0"	60°	(2) 16d	(1) 8d
WB126	11'-4 3/8"	8'-0" x 8'-0"	45°	(2) 16d	(1) 8d
WB106C	9'-6"	8'-0" x 5'-0"	60°	(2) 16d	(1) 8d
WB126C	11'-4 13/16"	8'-0" x 8'-0"	45°	(2) 16d	(1) 8d
WB143C	14'-3"	10'-0" x 10'-0"	45°	(2) 16d	(1) 8d

### BILL FOWLER ARCHITECT

3601 W 122nd Terrace  
Leawood, KS 66209  
913 908 5263  
BFWFOWLER@ME.COM

NCARB  
National Council of  
Architectural Registration Boards  
Project:

### Twin Villa

Woodland Glen Lot 53

Location:  
1442-1444 SW Winthrop Ter, Lee's Summit, MO

Client Contact:  
John Duggan  
(913) 498-3536 / jduggan@ko-dslaw.com

### Revisions

NO.	DATE	DESCRIPTION
1	9/25/2024	CONTRACTOR QUESTIONS

Sheet Name:  
Std. Details, Schedules, & Notes

Sheet No:  
Date:  
6/03/24

BFA No:  
TWIN-WG53

PERMIT SET



RELEASE FOR CONSTRUCTION  
AS NOTED FOR PLAN REVIEW  
LEE'S SUMMIT, MISSOURI  
09/26/2024



ROOF RAFTER SCHEDULE						
GRADE	MEMBER SIZE / SPACING	MAX SPAN CEILING JSTs AT TOP PLATE	MAX SPAN H <sub>c</sub> /H <sub>r</sub> =0.16	MAX SPAN H <sub>c</sub> /H <sub>r</sub> =0.20	MAX SPAN H <sub>c</sub> /H <sub>r</sub> =0.25	MAX SPAN H <sub>c</sub> /H <sub>r</sub> =0.33
#2 DF/L	2x6 / 24"oc	11'-9"	10'-6"	9'-9"	8'-11"	7'-10"
#2 DF/L	2x6 / 16"oc	14'-1"	12'-8"	11'-8"	10'-8"	9'-5"
#2 DF/L	2x8 / 16"oc	18'-2"	16'-4"	15'-1"	13'-9"	12'-2"
#2 DF/L	2x10 / 16"oc	22'-3"	20'-0"	18'-5"	16'-10"	14'-10"
#2 DF/L	2x12 / 16"oc	25'-9"	23'-2"	21'-4"	19'-7"	17'-3"

SPANS ABOVE ARE FOR ROOF LIVE LOAD OF 20 PSF AND DEAD LOAD OF 10 PSF WITH CEILINGS ATTACHED TO RAFTERS. RE: TABLES R802.4.1(1) THROUGH R802.4.1(8) FOR ADDITIONAL RAFTER SPAN INFORMATION.

THE ROOF FRAMING ON THIS HOME UTILIZES RAFTERS SPACED AT 16" ON CENTER IN EXPOSURE B WITH A ROOF SPAN LESS THAN 42' ON IN 90 MPH WIND ZONE. THEREFORE THE UPLIFT FORCE ON THE RAFTER IS LESS THAN 200 LBS. AND CAN BE CONNECTED PER TO THE WALL FRAMING PER TABLE R602.3(1).

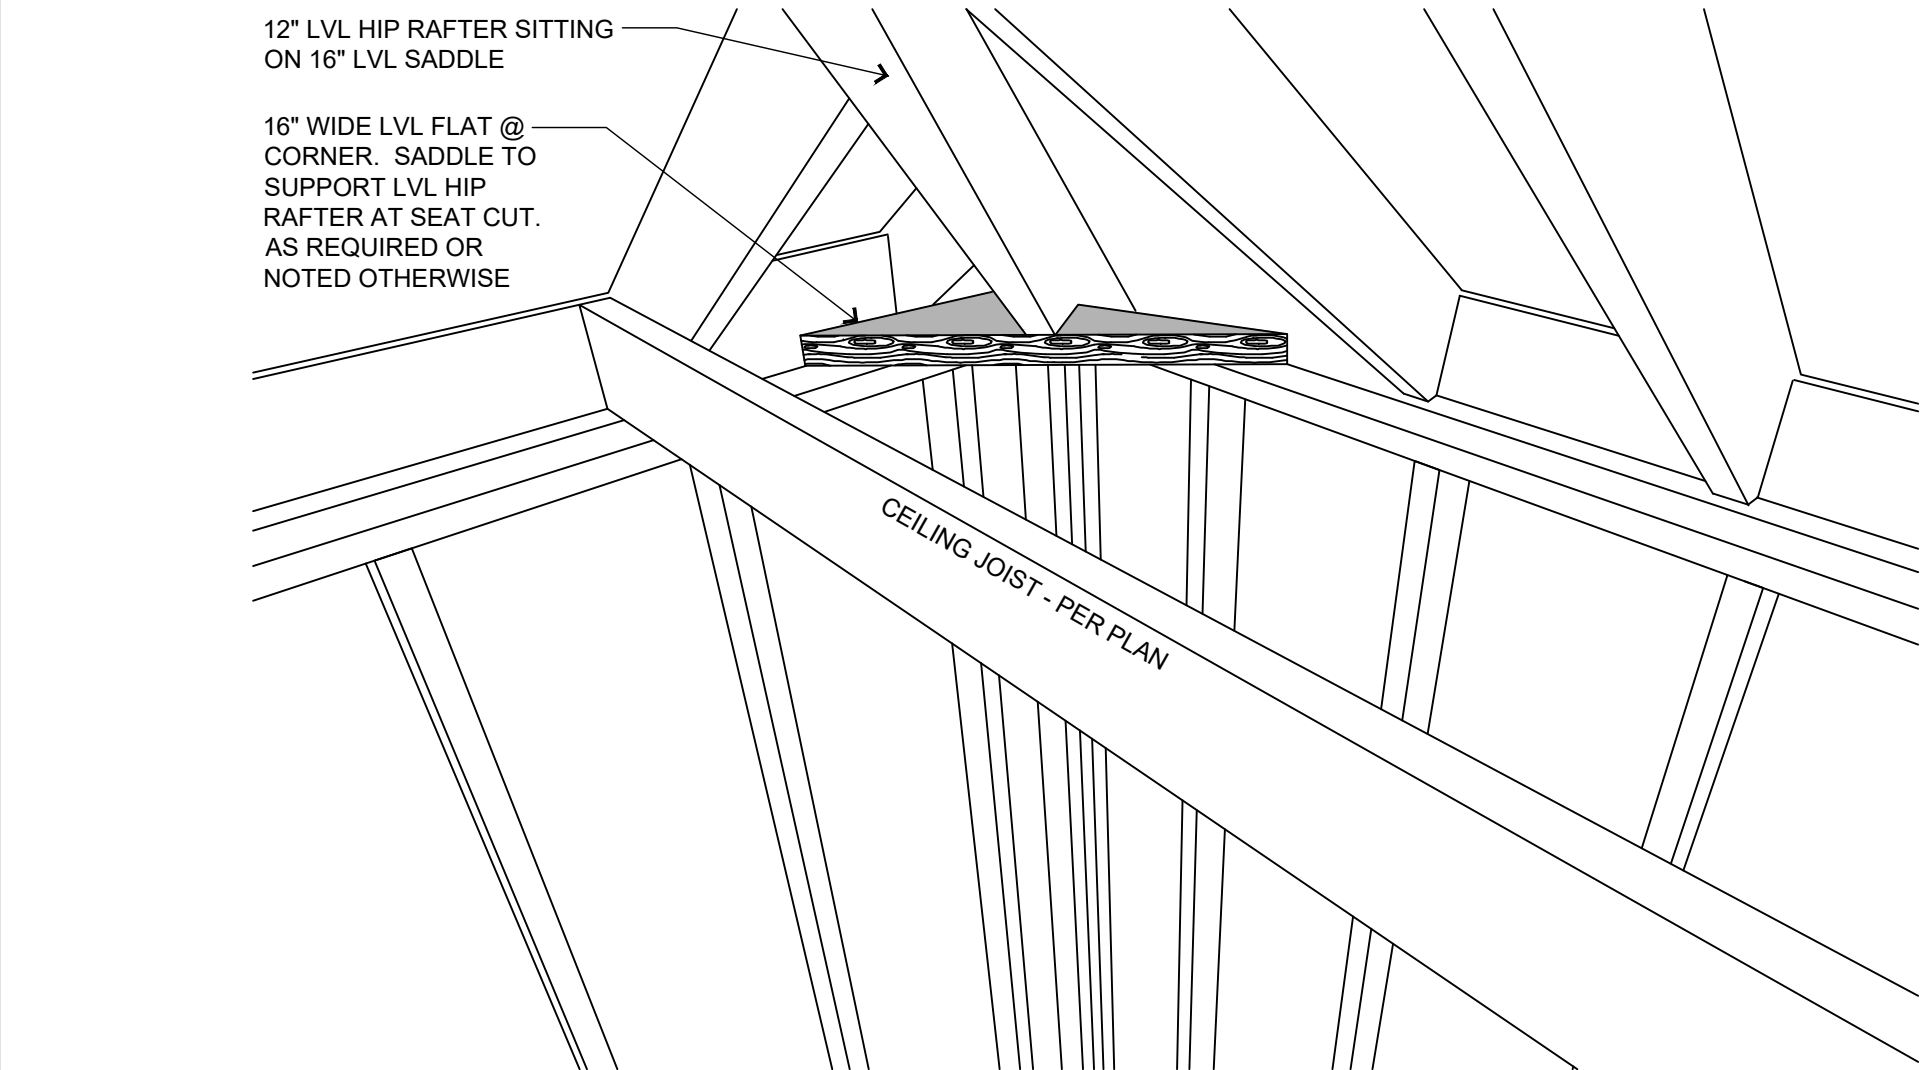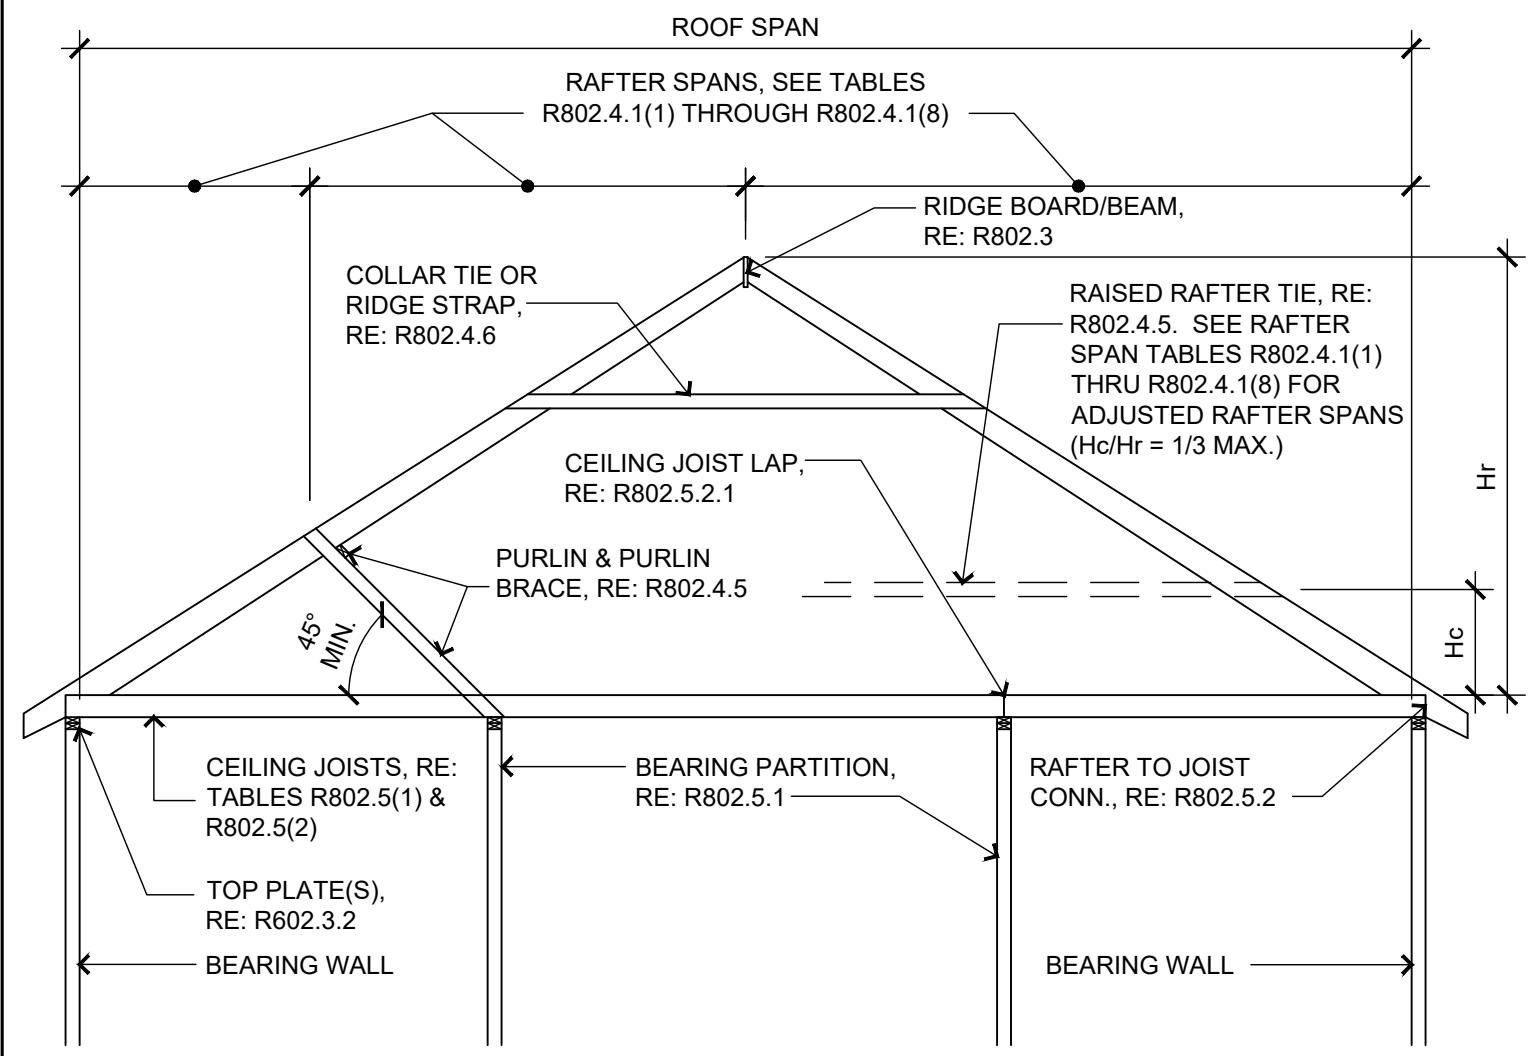

## LVL HIP RAFTER BEARING ON 16" LVL FLAT AT CORNERS

2

SCALE: 1/2" = 1'-0"

TABLE R802.5.2 RAFTER/CEILING JOIST HEEL JOINT CONNECTIONS (a,b,c,d,e,g)																			
RAFTER SLOPE	RAFTER SPACING (inches)	GROUND SNOW LOAD (PSF)																	
		20(f)				30				50				70					
		ROOF SPAN (FEET)																	
		12	20	28	36	12	20	28	36	12	20	28	36	12	20	28	36		
		REQUIRED NUMBER OF 16d COMMON NAILS(a,b) PER HEEL JOINT SPLICES (c,d,e)																	
3:12	12	4	5	6	8	10	4	6	8	11	5	8	12	15	6	11	15	20	26
	16	5	7	11	15	19	7	11	16	21	9	14	19	25	10	15	20	26	33
	24	7	11	15	19	25	10	15	20	26	12	18	25	33	13	20	26	33	42
4:12	12	3	5	6	8	10	4	6	8	11	5	8	12	15	6	11	15	20	26
	16	4	6	8	10	14	5	8	11	16	7	12	17	22	9	16	21	28	36
	24	5	8	12	15	19	7	11	16	21	9	14	19	25	10	15	20	26	33
5:12	12	3	4	5	6	8	3	4	5	7	3	5	7	9	4	7	9	12	16
	16	3	5	6	8	10	4	6	8	11	5	8	12	15	6	11	15	20	26
	24	4	7	9	12	14	5	9	12	16	7	12	17	22	9	16	21	28	36
7:12	12	3	4	4	5	3	3	4	5	3	4	5	7	3	5	7	9	11	17
	16	3	4	5	6	3	4	5	6	3	5	7	9	4	6	9	11	17	23
	24	3	5	7	9	3	5	7	9	4	7	10	13	5	9	13	17	23	30
9:12	12	3	3	4	4	3	3	3	4	3	3	4	5	3	4	5	7	9	13
	16	3	4	4	5	3	3	4	5	3	4	5	7	3	5	7	9	13	17
	24	3	4	6	7	3	4	6	7	3	6	8	10	4	7	10	13	17	23
12:12	12	3	3	3	3	3	3	3	3	3	3	3	4	3	3	4	5	7	10
	16	3	3	4	4	3	3	3	4	3	3	4	5	3	4	5	7	10	13
	24	3	4	4	5	3	3	4	6	3	4	6	8	3	6	8	10	13	17

- a. 40d BOX NAILS SHALL BE PERMITTED TO BE SUBSTITUTED FOR 16D COMMON NAILS.  
b. NAILING REQUIREMENTS SHALL BE PERMITTED TO BE REDUCED 25% IF NAILS ARE CLINCHED.  
c. HEEL JOINT CONNECTIONS ARE NOT REQUIRED WHEN THE RIDGE IS SUPPORTED BY A LOAD-BEARING WALL, HEADER, OR RIDGE BEAM.  
d. WHEN INTERMEDIATE SUPPORT OF THE RAFTER IS PROVIDED BY VERTICAL STRUTS OR PURLINS TO A LOAD-BEARING WALL, THE TABULATED HEEL JOINT CONNECTION REQUIREMENTS SHALL BE PERMITTED TO BE REDUCED PROPORTIONALLY TO THE REDUCTION IN SPAN.  
e. EQUIVALENT NAILING PATTERNS ARE REQUIRED FOR CEILING JOIST TO CEILING JOIST LAP SPLICES.  
f. APPLIES TO ROOF LIVE LOAD OF 20 psf OR LESS.  
g. TABULATED HEEL JOINT CONNECTION REQUIREMENTS ASSUME THAT CEILING JOISTS OR RAFTER TIES ARE LOCATED AT THE BOTTOM OF THE ATTIC SPACE. WHEN CEILING JOISTS OR RAFTER TIES ARE LOCATED HIGHER IN THE ATTIC, HEEL JOINT CONNECTION REQUIREMENTS SHALL BE INCREASED BY THE FOLLOWING FACTORS:

H <sub>c</sub> /H <sub>r</sub>	HEEL JOINT CONNECTION ADJUSTMENT FACTOR
1/3	1.5
1/4	1.33
1/5	1.25
1/6	1.2
1/10 OR LESS	1.11

WHERE:

H<sub>c</sub>= HEIGHT OF CEILING JOISTS OR RAFTER TIES MEASURED VERTICALLY ABOVE THE TOP OF THE RAFTER SUPPORT WALLS.






H<sub>r</sub>=HEIGHT OF ROOF RIDGE MEASURED VERTICALLY ABOVE THE TOP OF THE RAFTER SUPPORT WALLS.

### REQUIREMENTS

RETURN PANEL:  
24" FOR BRACED WALL LINES SHEATHED WITH WOOD STRUCTURAL PANELS  
32" FOR BRACED WALL LINES SHEATHED WITH STRUCTURAL FIBERBOARD

DISTANCE D:  
24" FOR BRACED WALL LINES SHEATHED WITH WOOD STRUCTURAL PANELS  
32" FOR BRACED WALL LINES SHEATHED WITH STRUCTURAL FIBERBOARD

HOLD-DOWN DEVICE:  
800 lbs CAPACITY FASTENED TO THE EDGE OF THE BRACED WALL PANEL CLOSEST TO THE CORNER AND TO THE FOUNDATION OR FLOOR FRAMING BELOW

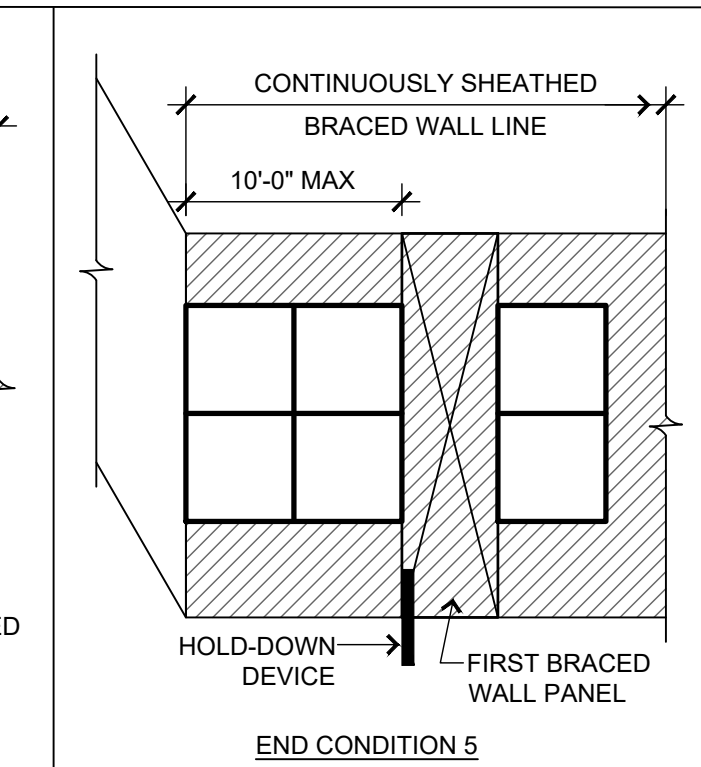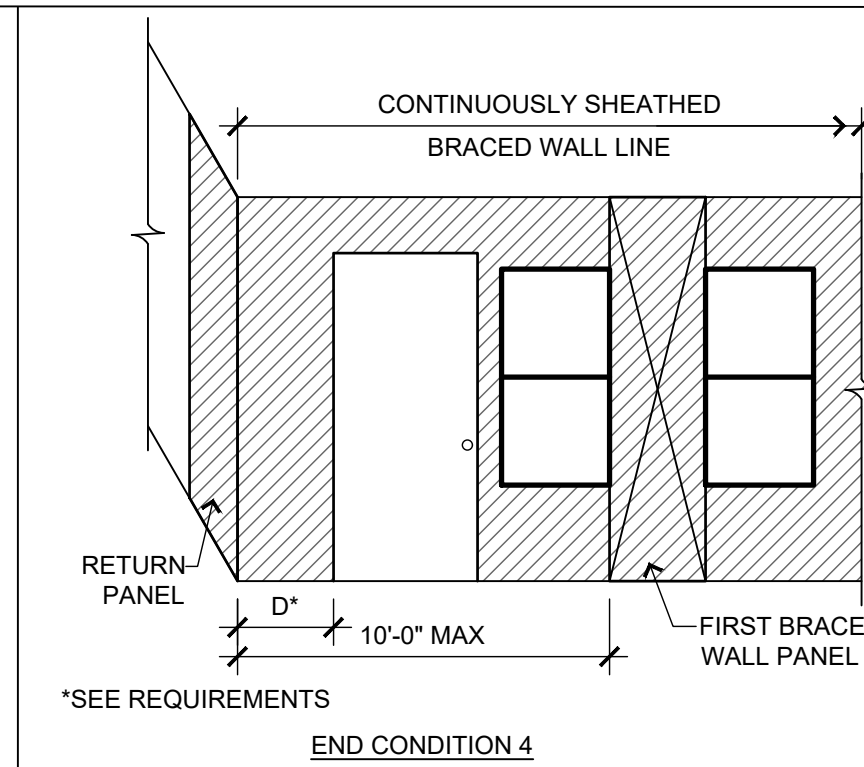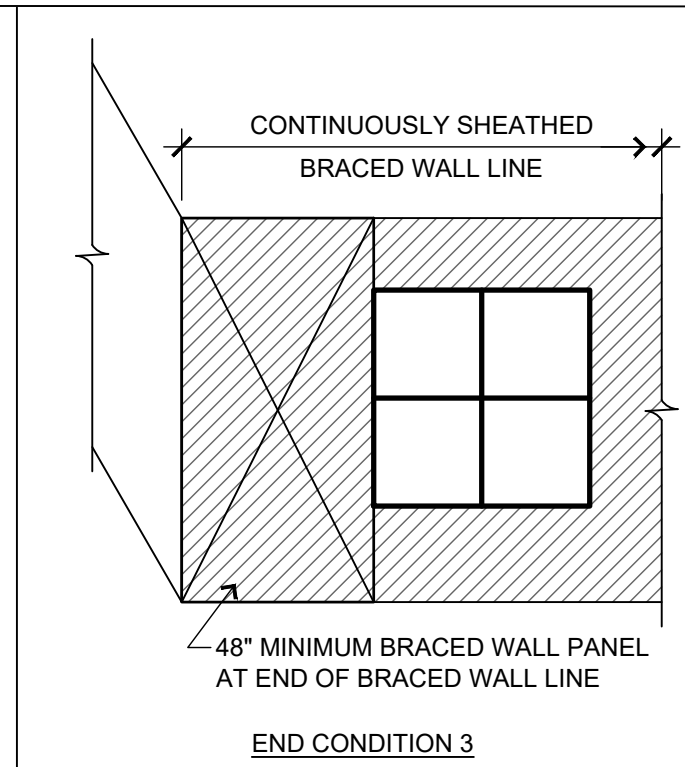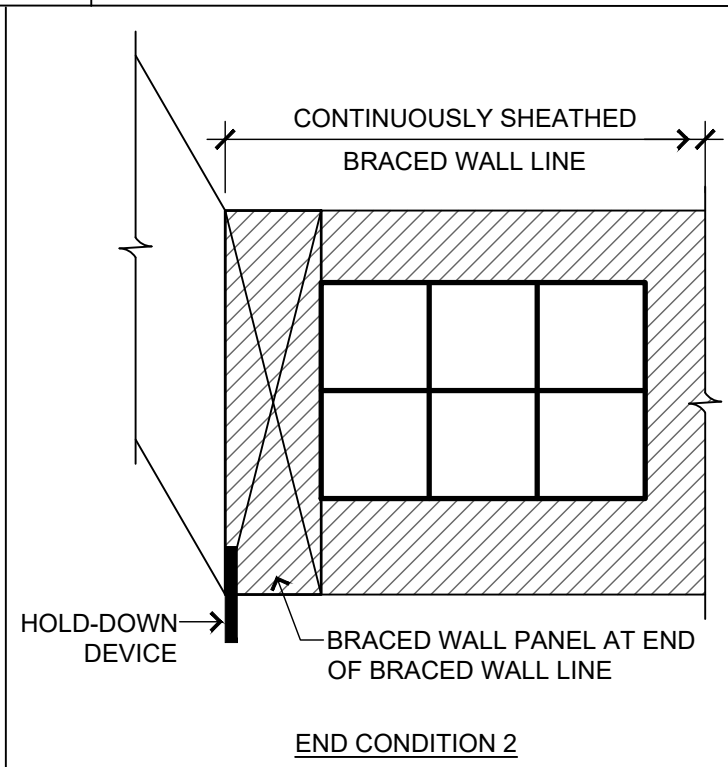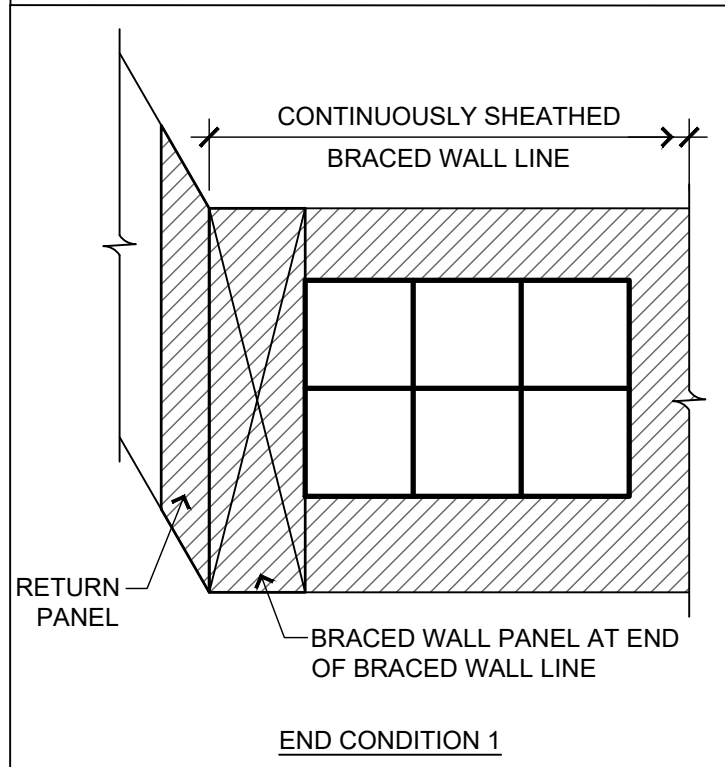

1

## END CONDITIONS FOR BRACED WALL LINES WITH CONTINUOUS SHEATHING R602.10.7

SCALE: NTS

FASTENING SCHEDULE IRC 2018 TABLE R602.3(1)			ITEM	DESCRIPTION OF BUILDING ELEMENTS	NUMBER AND TYPE OF FASTENER (a)(b)(c)	SPACING AND LOCATION
Roof						
1	Blocking between ceiling joists or rafters to top plate	4-8d box (2-1/2" × 0.113"); or 3-8d common (2-1/2" × 0.131"); or 3-10d box (3" × 0.128"); or 3-3" × 0.131" nails		Toe nail		
2	Ceiling joists to top plate	4-8d box (2-1/2" × 0.113"); or 3-8d common (2-1/2" × 0.131"); or 3-10d box (3" × 0.128"); or 3-3" × 0.131" nails		Per joist, toe nail		
3	Ceiling joist not attached to parallel rafter, laps over partitions (see Section R802.5.2 and Table R802.5.2)	4-10d box (3" × 0.128"); or 3-16d common (3-1/2" × 0.162"); or 4-3" × 0.131" nails		Face nail		
4	Ceiling joist attached to parallel rafter (heel joint) (see Section R802.5.2 and Table R802.5.2)	Table R802.5.2		Face nail		
5	Collar tie to rafter, face nail or 11/4" × 20 ga. ridge strap to rafter	4-10d box (3" × 0.128"); or 3-10d common (3" × 0.148"); or 4-3" × 0.131" nails		Face nail each rafter		
6	Rafter or roof truss to plate	3-16d box nails (3-1/2" × 0.135"); or 3-10d common nails (3" × 0.148"); or 4-10d box (3" × 0.128"); or 4-3" × 0.131" nails	2 toe nails on one side and 1 toe nail on opposite side of each rafter or truss()			
7	Roof rafters to ridge, valley or hip rafters or roof rafter to minimum 2" ridge beam	4-16d (3-1/2" × 0.135"); or 3-10d common (3" × 0.148"); or 4-10d box (3" × 0.128"); or 4-3" × 0.131" nails		Toe nail		
		3-16d box (3-1/2" × 0.135"); or 2-16d common (3-1/2" × 0.162"); or 3-10d box (3" × 0.128"); or 3-3" × 0.131" nails		End nail		
Wall						
8	Stud to stud (not at braced wall panels)	16d common (3-1/2" × 0.162")		24" o.c. face nail		
		10d box (3" × 0.128"); or 3" × 0.131" nails		16" o.c. face nail		
9	Stud to stud and abutting studs at intersecting wall corners (at braced wall panels)	16d box (3-1/2" × 0.135"); or 3" × 0.131" nails		12" o.c. face nail		
		16d common (3-1/2" × 0.162")		16" o.c. face nail		
10	Built-up header (2" to 2" header with 1/2" spacer)	16d common (3-1/2" × 0.162")		16" o.c. each edge face nail		
		16d box (3-1/2" × 0.135")		12" o.c. each edge face nail		
11	Continuous header to stud	5-8d box (2-1/2" × 0.113"); or 4-8d common (2-1/2" × 0.131"); or 4-10d box (3" × 0.128")		Toe nail		
		16d common (3-1/2" × 0.162")		16" o.c. face nail		
12	Top plate to top plate	10d box (3" × 0.128"); or 3" × 0.131" nails		12" o.c. face nail		
13	Double top plate splice	8-16d common (3-1/2" × 0.162"); or 12-16d box (3-1/2" × 0.135"); or 12-10d box (3" × 0.128"); or 12-3" × 0.131" nails		Face nail on each side of end joint (minimum 24" lap splice length each side of end joint)		
14	Bottom plate to joist, rim joist, band joist or blocking (not at braced wall panels)	16d common (3-1/2" × 0.162")		16" o.c. face nail		
		16d box (3-1/2" × 0.135"); or 3" × 0.131" nails		12" o.c. face nail		
15	Bottom plate to joist, rim joist, band joist or blocking (at braced wall panel)	3-16d box (3-1/2" × 0.135"); or 2-16d common (3-1/2" × 0.162"); or 4-3" × 0.131" nails		3 each 16" o.c. face nail 2 each 16" o.c. face nail 4 each 16" o.c. face nail		
16	Top or bottom plate to stud	4-8d box (2-1/2" × 0.113"); or 3-16d box (3-1/2" × 0.135"); or 4-8d common (2-1/2" × 0.131"); or 4-10d box (3" × 0.128"); or 4-3" × 0.131" nails		Toe nail		
		3-16d box (3-1/2" × 0.135"); or 2-16d common (3-1/2" × 0.162"); or 3-10d box (3" × 0.128"); or 3-3" × 0.131" nails		End nail		
17	Top plates, laps at corners and intersections	3-10d box (3" × 0.128"); or 2-16d common (3-1/2" × 0.162"); or 3-3" × 0.131" nails		Face nail		
18	1" brace to each stud and plate	3-8d box (2-1/2" × 0.113"); or 2-8d common (2-1/2" × 0.131"); or 2-10d box (3" × 0.128"); or 2 staples 1-3/4"		Face nail		
19	1" × 6" sheathing to each bearing	3-8d box (2-1/2" × 0.113"); or 2-8d common (2-1/2" × 0.131"); or 2-10d box (3" × 0.128"); or 2 staples, 1" crown, 16 ga., 1-3/4" long		Face nail		
20	1" × 8" and wider sheathing to each bearing	3-8d box (2-1/2" × 0.113"); or 3-8d common (2-1/2" × 0.131"); or 3-10d box (3" × 0.128"); or 3 staples, 1" crown, 16 ga., 1-3/4" long		Face nail		
		Wider than 1" × 8" 4-8d box (2-1/2" × 0.113"); or 3-8d common (2-1/2" × 0.131"); or 3-10d box (3" × 0.128"); or 4 staples, 1" crown, 16 ga., 1-3/4" long				
		(continued)				

ITEM	DESCRIPTION OF BUILDING ELEMENTS	NUMBER AND TYPE OF FASTENER (a)(b)(c)	SPACING AND LOCATION
21	Joist to sill, top plate or girder	4-8d box (2-1/2" × 0.113"); or 3-8d common (2-1/2" × 0.131"); or 3-10d box (3" × 0.128"); or 3-3" × 0.131" nails	Toe nail
22	Rim joist, band joist or blocking to sill or top plate (roof applications also)	8d box (2-1/2" × 0.113")	4" o.c. toe nail
23	1" × 6" subfloor or less to each joist	8d common (2-1/2" × 0.131"); or 10d box (3" × 0.128"); or 3" × 0.131" nails	6" o.c. toe nail
24	2" subfloor to joist or girder	3-8d box (2-1/2" × 0.113"); or 2-8d common (2-1/2" × 0.131"); or 3-10d box (3" × 0.128"); or 2 staples, 1" crown, 16 ga., 1-3/4" long	Face nail
25	2" planks (plank & beam—floor & roof)	3-16d box (3-1/2" × 0.135"); or 2-16d common (3-1/2" × 0.162")	Blind and face nail
26	Band or rim joist to joist	3-16d box (3-1/2" × 0.135"); or 2-16d common (3-1/2" × 0.162")	At each bearing, face nail
27	Built-up girders and beams, 2-inch lumber layers	3-16d common (3-1/2" × 0.162") 4-10 box (3" × 0.128"); or 4-3" × 0.131" nails; or 4-3" × 14 ga. staples, 7/16" crown	End nail
28	Ledger strip supporting joists or rafters	20d common (4" × 0.192"); or	Nail each layer as follows: 32" o.c. at top and bottom and staggered.
29	Bridging or blocking to joist	10d box (3" × 0.128"); or 3" × 0.131" nails	24" o.c. face nail at top and bottom staggered on opposite sides
ITEM	DESCRIPTION OF BUILDING ELEMENTS	NUMBER AND TYPE OF FASTENER (a)(b)(c)	SPACING OF FASTENERS Edges (inches)(h) Intermediate supports(c)(e) (inches)
	Wood structural panels, subfloor, roof and interior wall sheathing to framing and particleboard wall sheathing to framing [see Table R602.3(3) for wood structural panel exterior wall sheathing to wall framing]		
30	3/8" – 1/2"	6d common (2" × 0.113") nail (subfloor, wall)(i) 8d common (2-1/2" × 0.131") nail (roof); or RSRs-01 (2-3/8" × 0.113") nail (roof)(j)	6 12(f)
31	19/32" – 1"	8d common nail (21/2" × 0.131"); or RSRs-01; (2-3/8" × 0.113") nail (roof)(j)	6 12(f)
32	1-1/8" – 1-1/4"	10d common (3" × 0.148") nail; or 8d (21/2" × 0.131") deformed nail	6 12
33	1/2" structural cellulosic fiberboard sheathing	1-1/2" galvanized roofing nail, 7/16" head diameter, or 1-1/4" long 16 ga. staple with 7/16" or 1" crown	3 6
34	25/32" structural cellulosic fiberboard sheathing	1-3/4" galvanized roofing nail, 7/16" head diameter, or 1-1/2" long 16 ga. staple with 7/16" or 1" crown	3 6
35	1/2" gypsum sheathing(d)	1-1/2" galvanized roofing nail: staple galvanized, 1-1/2" long; 1-1/4" screws, Type W or S	7 7
36	5/8" gypsum sheathing(d)	1-3/4" galvanized roofing nail: staple galvanized, 1-5/8" long; 1-5/8" screws, Type W or S	7 7
37	3/4" and less	6d deformed (2" × 0.120") nail; or 8d common (2-1/2" × 0.131") nail	6 12
38	7/8" – 1"	8d common (2-1/2" × 0.131") nail; or 8d deformed (2-1/2" × 0.120") nail	6 12
39	1-1/8" – 1-1/4"	10d common (3" × 0.148") nail; or 8d deformed (2-1/2" × 0.120") nail	6 12
a.	Nails are smooth-common, box or deformed shanks except where otherwise stated. Nails used for framing and sheathing connections shall have minimum average bending yield strengths as shown: 80 ksi for shank diameter of 0.192 inch (20d common nail), 90 ksi for shank diameters larger than 0.142 inch but not larger than 0.177 inch, and 100 ksi for shank diameters of 0.142 inch or less.		
b.	Staples are 16 gage wire and have a minimum 7/16-inch on diameter crown width.		
c.	Nails shall be spaced at not more than 6 inches on center at all supports where spans are 48 inches or greater.		
d.	Four-foot by 8-foot or 4-foot by 9-foot panels shall be applied vertically.		
e.	Spacing of fasteners not included in this table shall be based on Table R602.3(2).		
f.	For wood structural panel roof sheathing attached to gable end roof framing and to intermediate supports within 48 inches of roof edges and ridges, nails shall be spaced at 6 inches on center where the ultimate design wind speed is less than 130 mph and shall be spaced 4 inches on center where the ultimate design wind speed is 130 mph or greater but less than 140 mph.		
g.	Gypsum sheathing shall conform to ASTM C1396 and shall be installed in accordance with GA 253. Fiberboard sheathing shall conform to ASTM C208.		
h.	Spacing of fasteners on floor sheathing panel edges applies to panel edges supported by framing members and required blocking and at floor perimeters only. Spacing of fasteners on roof sheathing panel edges applies to panel edges supported by framing members and required blocking. Blocking of roof or floor sheathing panel edges perpendicular to the framing members need not be provided except as required by other provisions of this code. Floor perimeter shall be supported by framing members or solid blocking.		
i.	Where a rafter is fastened to an adjacent parallel ceiling joist in accordance with this schedule, provide two toe nails on one side of the rafter and toe nails from the ceiling joist to top plate in accordance with this schedule. The toe nail on the opposite side of the rafter shall not be required.		
j.	RSRS-01 is a Roof Sheathing Ring Shank nail meeting the specifications in ASTM F1667.		

**N.S. NORTON SCHMIDT**  
Consulting Engineers  
311 East 11th Avenue  
North Kansas City, MO 64116  
Phone: (816) 421-4232  
www.nortonschmidt.com  
N&S JOB NUMBER: 2024-1167  
© 2024 Norton & Schmidt Consulting Engineers

**BILL FOWLER ARCHITECT**  
3601 W 122nd Terrace  
Leawood, KS 66209  
913 908 5263  
BFWFOWLER@ME.COM

**NCARB**  
National Council of Architectural Registration Boards  
Project:

**Twin Villa**  
Woodland Glen Lot 53

Location:  
**1442-1444 SW Winthrop Ter, Lee's Summit, MO**

Client Contact:  
John Duggan  
(913) 498-3536 / jduggan@ko-dsdlaw.com

**Revisions**  
NO. DATE DESCRIPTION  
1 9/25/2024 CONTRACTOR QUESTIONS

Sheet Name:  
**Std. Details, Scheds., & Notes**

Sheet No.:  
**S33**

Date:  
6/03/24

BFA No.:  
TWIN-WG53

**PERMIT SET**

RELEASE FOR CONSTRUCTION  
AS NOT