



AS GRADED PLOT PLAN

Ordered by: Elevate Design and Build
Description: Lot 171, Hook Farms 2nd Plat in Lee's Summit, MO.
Address: 2614 SW Barley Field Drive

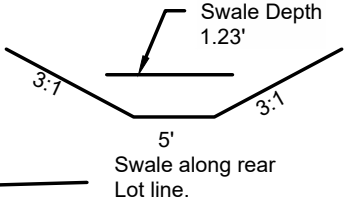


RELEASE FOR CONSTRUCTION
AS NOTED FOR PLAN REVIEW
DEVELOPMENT SERVICES
LEE'S SUMMIT, MISSOURI
10/10/2024

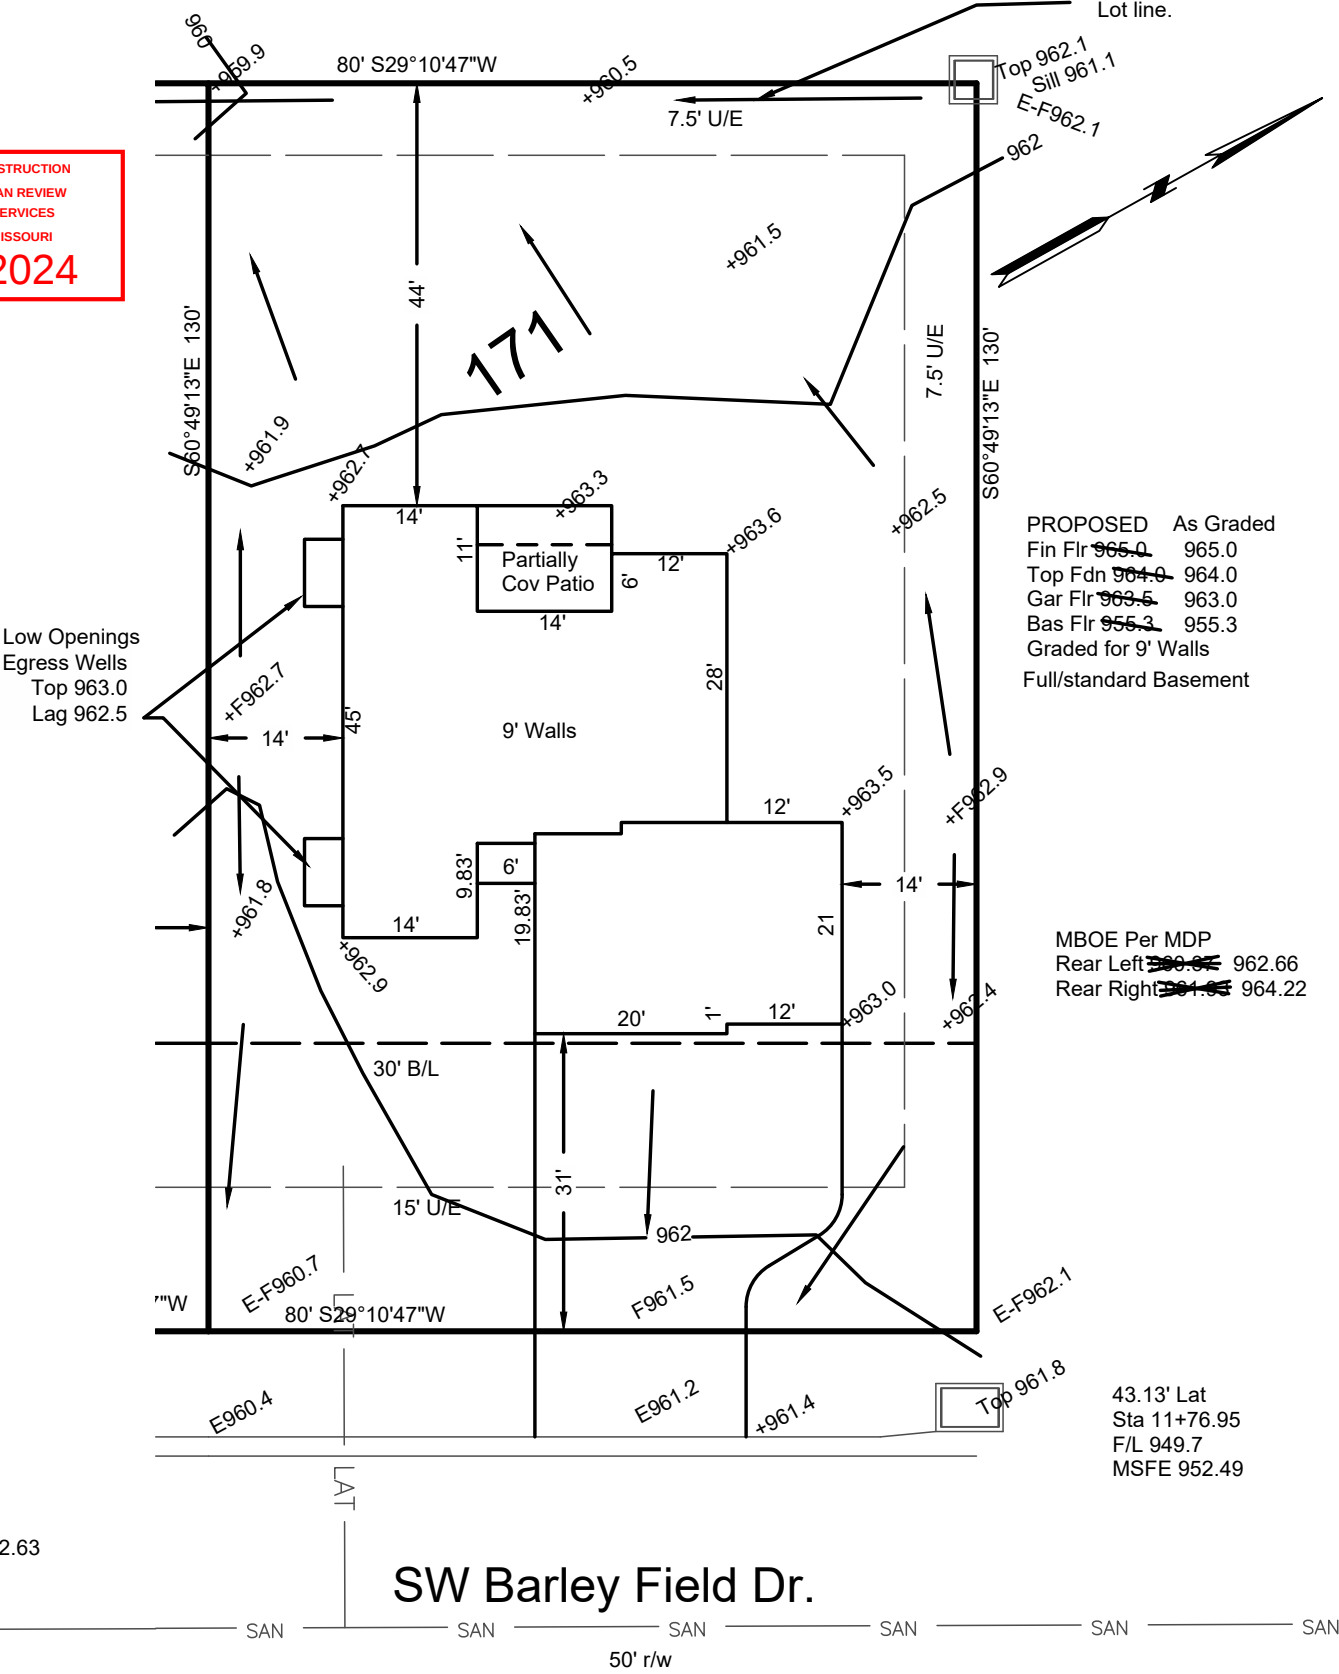

Grades Shown are as of 10-09-2024

→ = DRAINAGE PATTERN

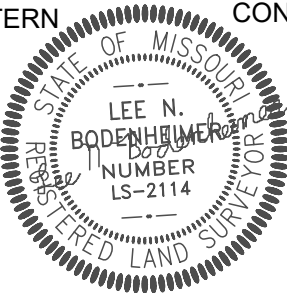

CONSTRUCTION ENGINEERING SERVICES, INC.
16810-C East 40 Highway
Independence, MO 64055
(816)478-2323
lee@engineeringkc.com
SCALE: 1" = 20'
DATE: 04-15-2024 & 10-08-2024
JOB NO: 19037 & 19229

LEE BODENHEIMER, L.S.
Land Surveyor