## ION PET

## HAMBLEN U

## П S T SUMMI MISSOUR!

## GENERAL NOTES

- CONTRACTOR 15 RESPONSIBLE FOR OBTAINING ALL PERMITS & INSPECTIONS REQUIRED FOR CERTIFICATE OF OCCUPANCY.
- ALL WORK SHALL CONFORM TO THE REQUIREMENTS OF FEDERAL, STATE, AND LOCAL CODES, LAWS, RULES, & REGULATIONS OF ALL LEGALLY CONSTITUTED PUBLIC AUTHORITIES JURISDICTION. IN CASE OF CONFLICT BETWEEN REQUIREMENTS, THE MOST RESTRICTIVE SHALL APPLY.
- THE CONTRACTOR IS RESPONSIBLE TO PROVIDE TEMPORARY SHORING AND BRACING FOR ALL STRUCTURAL ELEMENTS AS REQUIRED UNTIL NEW STRUCTURAL MEMBERS INSTALLED, WHETHER INDICATED ON THE DRAWINGS OR NOT. IF THE CONTRACTOR IS UNSURE WHETHER OR NOT TO PROVIDE TEMPORARY SHORING AND BRACING HE SHAARCHITECT OR STRUCTURAL ENGINEER, IN WRITING, PRIOR TO COMMENCEMENT OF WORK. AFE PER
- CONTRACTOR SHALL FIELD VERIFY ALL EXISTING CONDITIONS AND CRITICAL DIMENSIONS PRIOR TO COMMENCEMENT OF WORK, AND SHALL NOTIFY QUNER & ARCHITECT OF ANY DISCREPANCIES PRIOR TO PROCEEDING WITH WORK, THIS VERIFICATION SHALL INCLUDE BUT NOT LIMITED TO LOCATION OF NEW FRAMING MEMBERS, LINES OF SUPPORT, LOCATIONS, ANCHOR BOLTS, HOLD DOWNS, EXISTING SITE CONDITIONS, AND UTILITIES PRIOR TO ORDERING MATERIALS. Å

CONTRACTOR TO VERIFY FIT & FINISH REQUIREMENTS FOR ALL PROJECT COMPONENTS, WITH OWNER, PRIOR TO ORDERING MATERIALS. REPORT CONFLICTING INFORMATION TO OWN PROCEEDING WITH WORK

FER PRIOR TO

- CONTRACTOR SHALL DISPOSE OF ALL DEMOLITION & CONSTRUCTION DEBRIS AS REQUIRED BY FEDERAL, STATE, AND LOCAL ORDINANCES.
- THE GENERAL CONTRACTOR SHALL ENSURE THAT ALL MATERIALS, A REQUIRED BY CODE, ARE TESTED BY INDEPENDENT LABORATORIES AND THAT RESULTS ARE FURNISHED TO LOCAL BUILDING AUTHORITIES, OWNER, AND THE PROJECT CONSULTANTS IF REQUESTED.
- BY THE USE OF THE DRAWINGS FOR CONSTRUCTION OF THE PROJECT, THE OWNER REPRESENTS THAT HE HAS REVIEWED AND APPROVED THE DRAWINGS, AND THAT THE CONSTRUCTION PHASE OF THE PROJECT IS COMPLETE. CONTRACTOR SHALL STENCIL/LABEL ON ALL RATED WALLS IN CONCEALED AREAS THE FOLLOWING: "FIRE AND SMOKE BARRIER - PROTECT ALL OPENINGS"

各

- CONTRACTOR SHALL COORDINATE HIS WORK WITH ALL OTHER CONTRACTORS FURNISHING THE LABOR, MATERIALS, AND ALL WORK, SO THAT THE WORK AS A WHOLE. SHALL BE EXECUTED AND COMPLETED WITHOUT CONFLICT OR DELAY, THE OWNER AND HIS CONSULTANTS SHALL NOT BE RESPONSIBLE FOR HOW THE WORK IS PERFORMED, SAFETY AND NEGLIGENT ACTS OR OMISSIONS BY THE GENERAL CONTRACTOR OR THE SUBCONTRACTORS ON THE JOB.
- CONTRACTOR SHALL COORDINATE THE REQUIREMENTS OF ANY AND ALL DRAWINGS INCLUDING ARCHITECTURAL, CIVI, MECHANICAL, PLUMBING AND ELECTRICAL. BROUGHT TO THE ATTENTION OF THE OWNER & ARCHITECT PRIOR TO ANY WORK. ANY CONFLICTS
- IT SHALL BE THE RESPONSIBILITY OF THE CONTRACTOR TO ACQUAINT HIMSELF WITH THE DIMENSIONS OF ALL EQUIPMENT INCLUDED IN THIS PROJECT SO THAT PREPARATIONS CAN BE MADE TO PROVIDE ENTRY INTO THE FACILITY WITH SUFFICIENT CLEARANCE, AND TO ENSURE THAT ADEQUATE FLOOR SPACE IS AVAILABLE.
- CONTRACTOR SHALL NEVER SCALE DRAWINGS. LOCATIONS FOR ALL PARTITIONS, WALLS, CEILINGS, ETC. WILL BE DETERMINED BY DIMENSIONS ON THE DRAWINGS. ANY SUCH DIMENSIONS MISSING FROM THE PLANS MUST BE BROUGHT TO THE ATTENTION OF THE OWNER & ARCHITECT IMMEDIATELY, ALL DIMENSIONS TO FACE OF STUD UNLESS OTHERWISE NOTED, "CLEAR" DENOTES FINISH TO FINISH DIMENSIONS.
- <del>4</del>, THE CONTRACTOR SHALL ADHERE TO THE DRAWINGS AND SPECIFICATIONS. SHOULD ANY ERROR OR INCONSISTENCY APPEAR REGARDING THE TRUE MEANING AND/OR INTENT OF DRAWINGS OR SPECIFICATIONS, THE CONTRACTOR SHALL IMMEDIATELY REPORT SAME TO THE ARCHITECT WHO WILL MAKE ANY NECESSARY CLARIFICATION, INTERPRETATION, OR REQUIRED. REVISION AS
- IF THE CONTRACTOR DISCOVERS AN ERROR OR INCONSISTENCY AND PROCEEDS WITH WORK WITHOUT NOTIFYING THE OWNER & ARCHITECT OF ANY SUCH DISCREPANCIES, HE SHA ALL CHARGES AND MAKE ANY CHANGES TO HIS WORK MADE NECESSARY BY HIS FAILURE TO OBSERVE AND/OR REPORT THE CONDITION. FORM OF A

ASSUME

 $\overline{v}$ 

- IF THE INTENT OF THE DRAWINGS & SPECIFICATIONS ARE UNCLEAR, THE CONTRACTOR SHALL ASK THE ARCHITECT FOR CLARIFICATION, PRIOR TO PROCEEDING WITH WORK, IN THE WRITTEN REJ. (REQUEST FOR INFORMATION). THE ARCHITECT SHALL THEN RESPOND IN WRITING TO ALL APPROPRIATE PARTIES.
- $\overline{\varphi}$ CONTRACTOR SHALL PROVIDE ADEQUATE PROTECTION OF WORK, MATERIALS, FIXTURES, ETC. IN LEASED SPACE FROM LOSS, DAMAGE, FIRE, THEFT, ETC.
- WHEREVER THE TERM "OR EQUAL" IS USED, IT SHALL MEAN EQUAL PRODUCT AS APPROVED IN WRITING BY ARCHITECT.
- IF THE CONTRACTOR PROPOSES A MATERIAL OR EQUIPMENT SUBSTITUTION HE SHALL PROVIDE ALL APPROPRIATE DOCUMENTATION AND INFORMATION REQUIRED FOR THE ARCHITECT TO DETERMINE WHETHER OR NOT THE SUBSTITUTION IS EQUAL TO THE SPECIFICATION. ANY CHANGES TO THE DESIGN, AFTER ISSUANCE OF A BUILDING PERMIT, SHALL BE SUBMITTED TO THE PRESIDING BUILDING AGENCY FOR APPROVAL BY THE GENERAL CONTRACTOR.
- CONTRACTOR SHALL PROVIDE AND INSTALL ALL NECESSARY INWALL FRAMING REQUIRED TO CARRY SHELF, HANGING, AND VALANCE LOADS, RAILINGS, ETC. AS PER PLANS AND

CODES,

- PROVIDE SILICONE SEALANT AT ALL JOINTS AND INTERFACES OF ALL COUNTERTOPS, EQUIPMENT, WALLS, WINDOWS AND DOOR OPENINGS
- PROJECT SHALL BE LEFT CLEANED AND POLISHED AFTER COMPLETION OF WORK

21,


Ŗ


- 22. 23. THE CONTRACTOR SHALL VERIFY LOCATIONS OF ALL FOOD SERVICE EQUIPMENT AND COORDINATE LOCATION OF FLOOR SINKS, FLOOR DRAINS, SLOPES/SLAB DEPRESSIONS AND CURBS, ELECTRICAL AND PLUMBING STUB OUTS, AND ALL OTHER WORK UNDER THIS SCOPE OF RESPONSIBILITY RELATED TO THIS EQUIPMENT. REFER TO QUNERS FOOD SERVICE SUPPLIER FOR SPECIFIC REQUIREMENTS & REFERENCES, EQUIPMENT DRAWINGS ARE INCLUDED FOR REFERENCE ONLY, ACTUAL SHOP DRAWINGS FOR THE SPECIFIC PROJECT MAY THE CONTRACTORS RESPONSIBILITY TO COORDINATE ALL WORK WITH THE REQUIREMENTS OF THE SUPPLIERS FOR THE MATERIALS REPRESENTED BY SHOP DRAWINGS.
- CONTRACTOR SHALL REFER TO THESE DOCUMENTS, AS WELL AS SPECIFICATIONS, FOR IDENTIFICATION OF ALL OWNER SUPPLIED ITEMS, CONTRACTOR SHALL VERIFY WITH OWNER, ORDERING, WHICH ITEMS THE OWNER SHALL SUPPLY, ALL ITEMS NOT MARKED AS 'OWNER SUPPLIED' ARE TO BE SUPPLIED BY THE CONTRACTOR. UNLESS NOTED OTHERWISE ALL TO BE INSTALLED BY GENERAL CONTRACTOR. CONTRACTOR IS RESPONSIBLE FOR RECEIVING, UNLOADING, UNCRATING, INSTALLATION AND HOOK-UP OF ALL FOOD SERVICE EQUIPMENT AND OTHER OWNER FURNISHED ITEMS AND OF ALL CARTONS PRIOR TO
- MINIMUM FLAME SPREAD CLASSIFICATION OF INTERIOR FINISHES SHALL CONFORM TO THE BUILDING CODE AND LOCAL GOVERNING BUILDING CODES/ORDINANCES
- 27, CONTRACTOR SHALL CONTACT THE LOCAL FIRE MARSHALL, AND PROVIDE AND INSTALL FIRE EXTINGUISHERS PER THE FIRE MARSHAL'S DIRECTION, INCLUDING: TYPE, QUANTITY, AND LOCATIONS. AS A MINIMUM, CONTRACTOR SHALL PROVIDE FIRE EXTINGUISHERS HAVING A RATING OF 2-AIØ-BC FOR EVERY 3,000 S.F. OF FLOOR AREA AND TRAVEL DISTANCE TO AN EXTINGUISHER SHALL NOT EXCEED 15 FEET.

CIFICATIONS


- FOR CONSTRUCTION DETAILS NOT SHOWN, USE THE MANUFACTURER'S STANDARD DETAILS OR APPROVED SHOP DRAWINGS/DATA SHEETS IN ACCORDANCE WITH THE PROJECT SPE DOCUMENTS MARKED "BID DOCUMENTS" SHALL NOT BE USED FOR CONSTRUCTION
- POST OCCUPANT LOAD SIGN LISTED IN SPECIFICATIONS PER LOCAL GOVERNING AGENCY REQUIREMENTS.
- SUBMITTAL DOCUMENTS FOR DEFERRED SUBMITTAL ITEMS SHALL BE SUBMITTED TO THE ARCHITECT WHO SHALL REVIEW THEM AND PROVIDE A NOTATION INDICATING THAT DEFERRED SUBMITTAL DOCUMENTS HAVE BEEN REVIEWED AND FOUND TO BE IN GENERAL CONFORMANCE WITHE DESIGN OF THE BUILDING, THESE SUBMITTAL ITEMS MUST THEN BE SUBMITTED TO THE BUILDING OFFICIAL.


  DEFERRED SUBMITTALS ARE AS FOLLOWS:

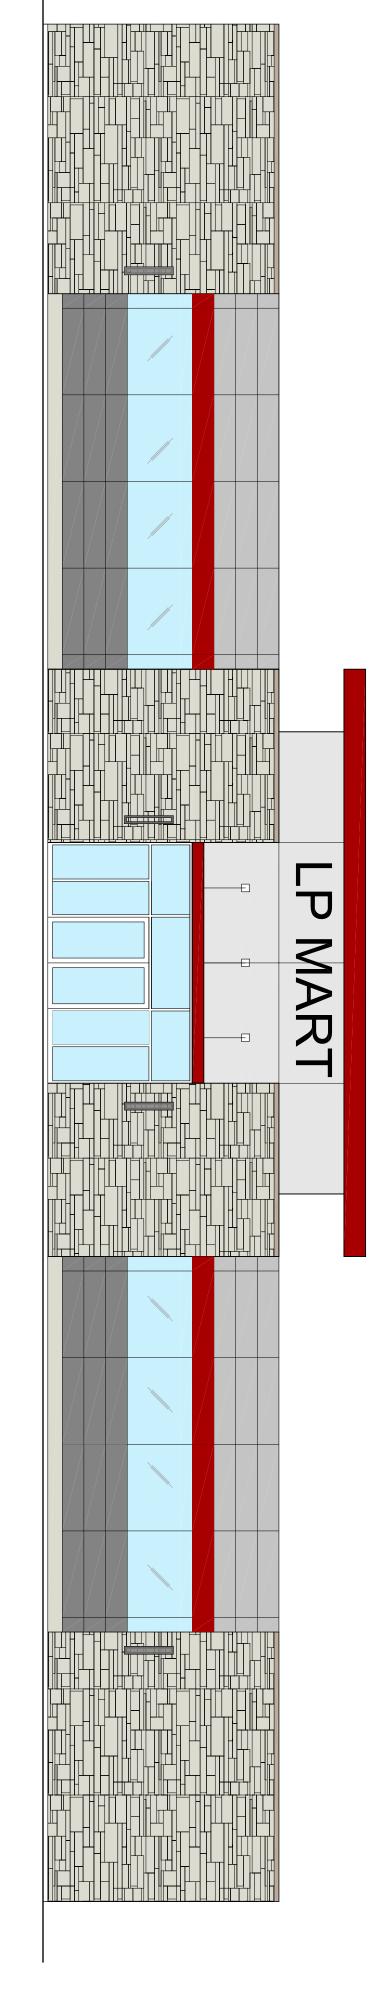


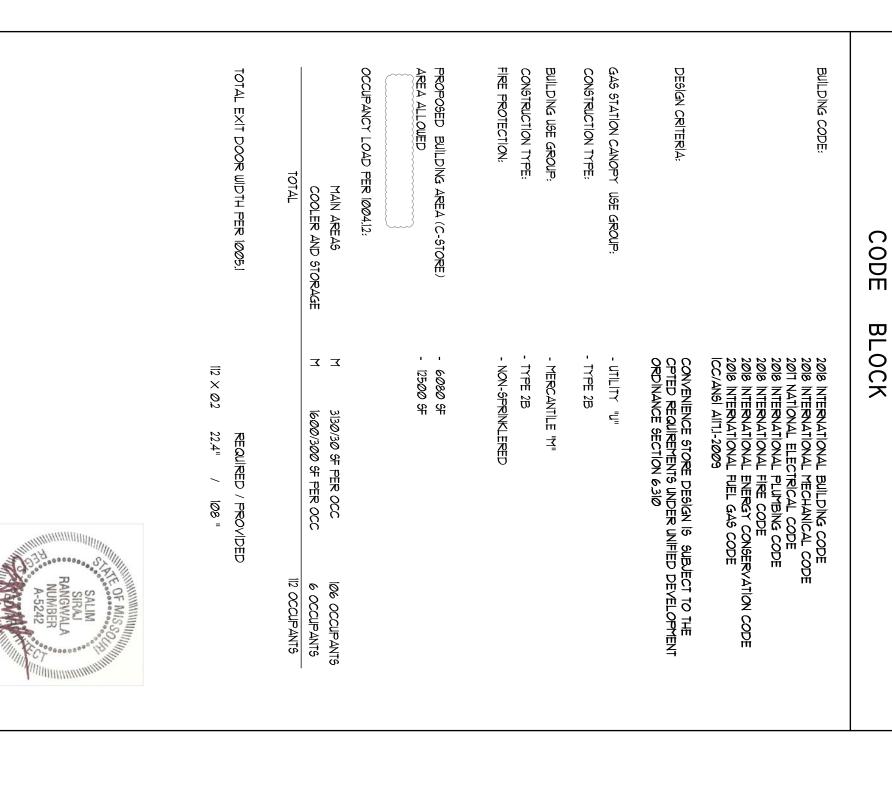



DISPOSING

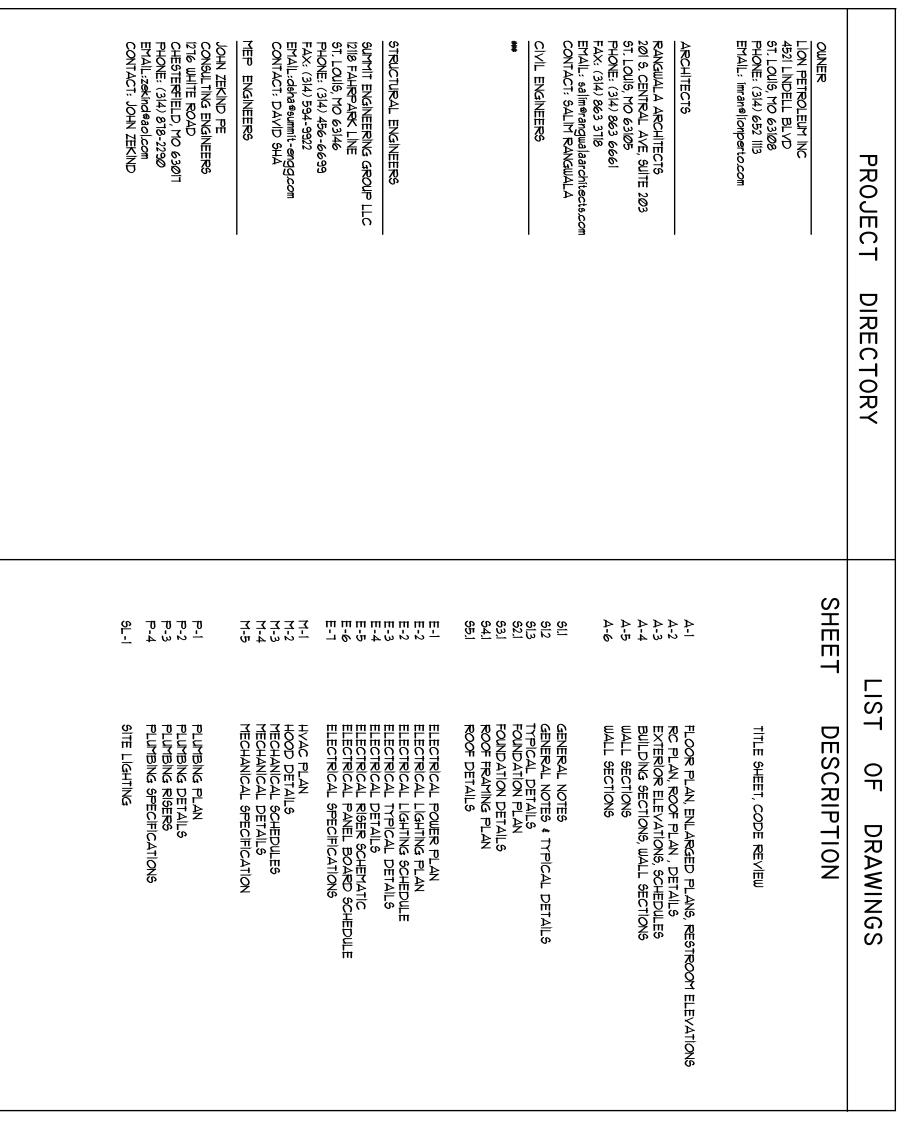


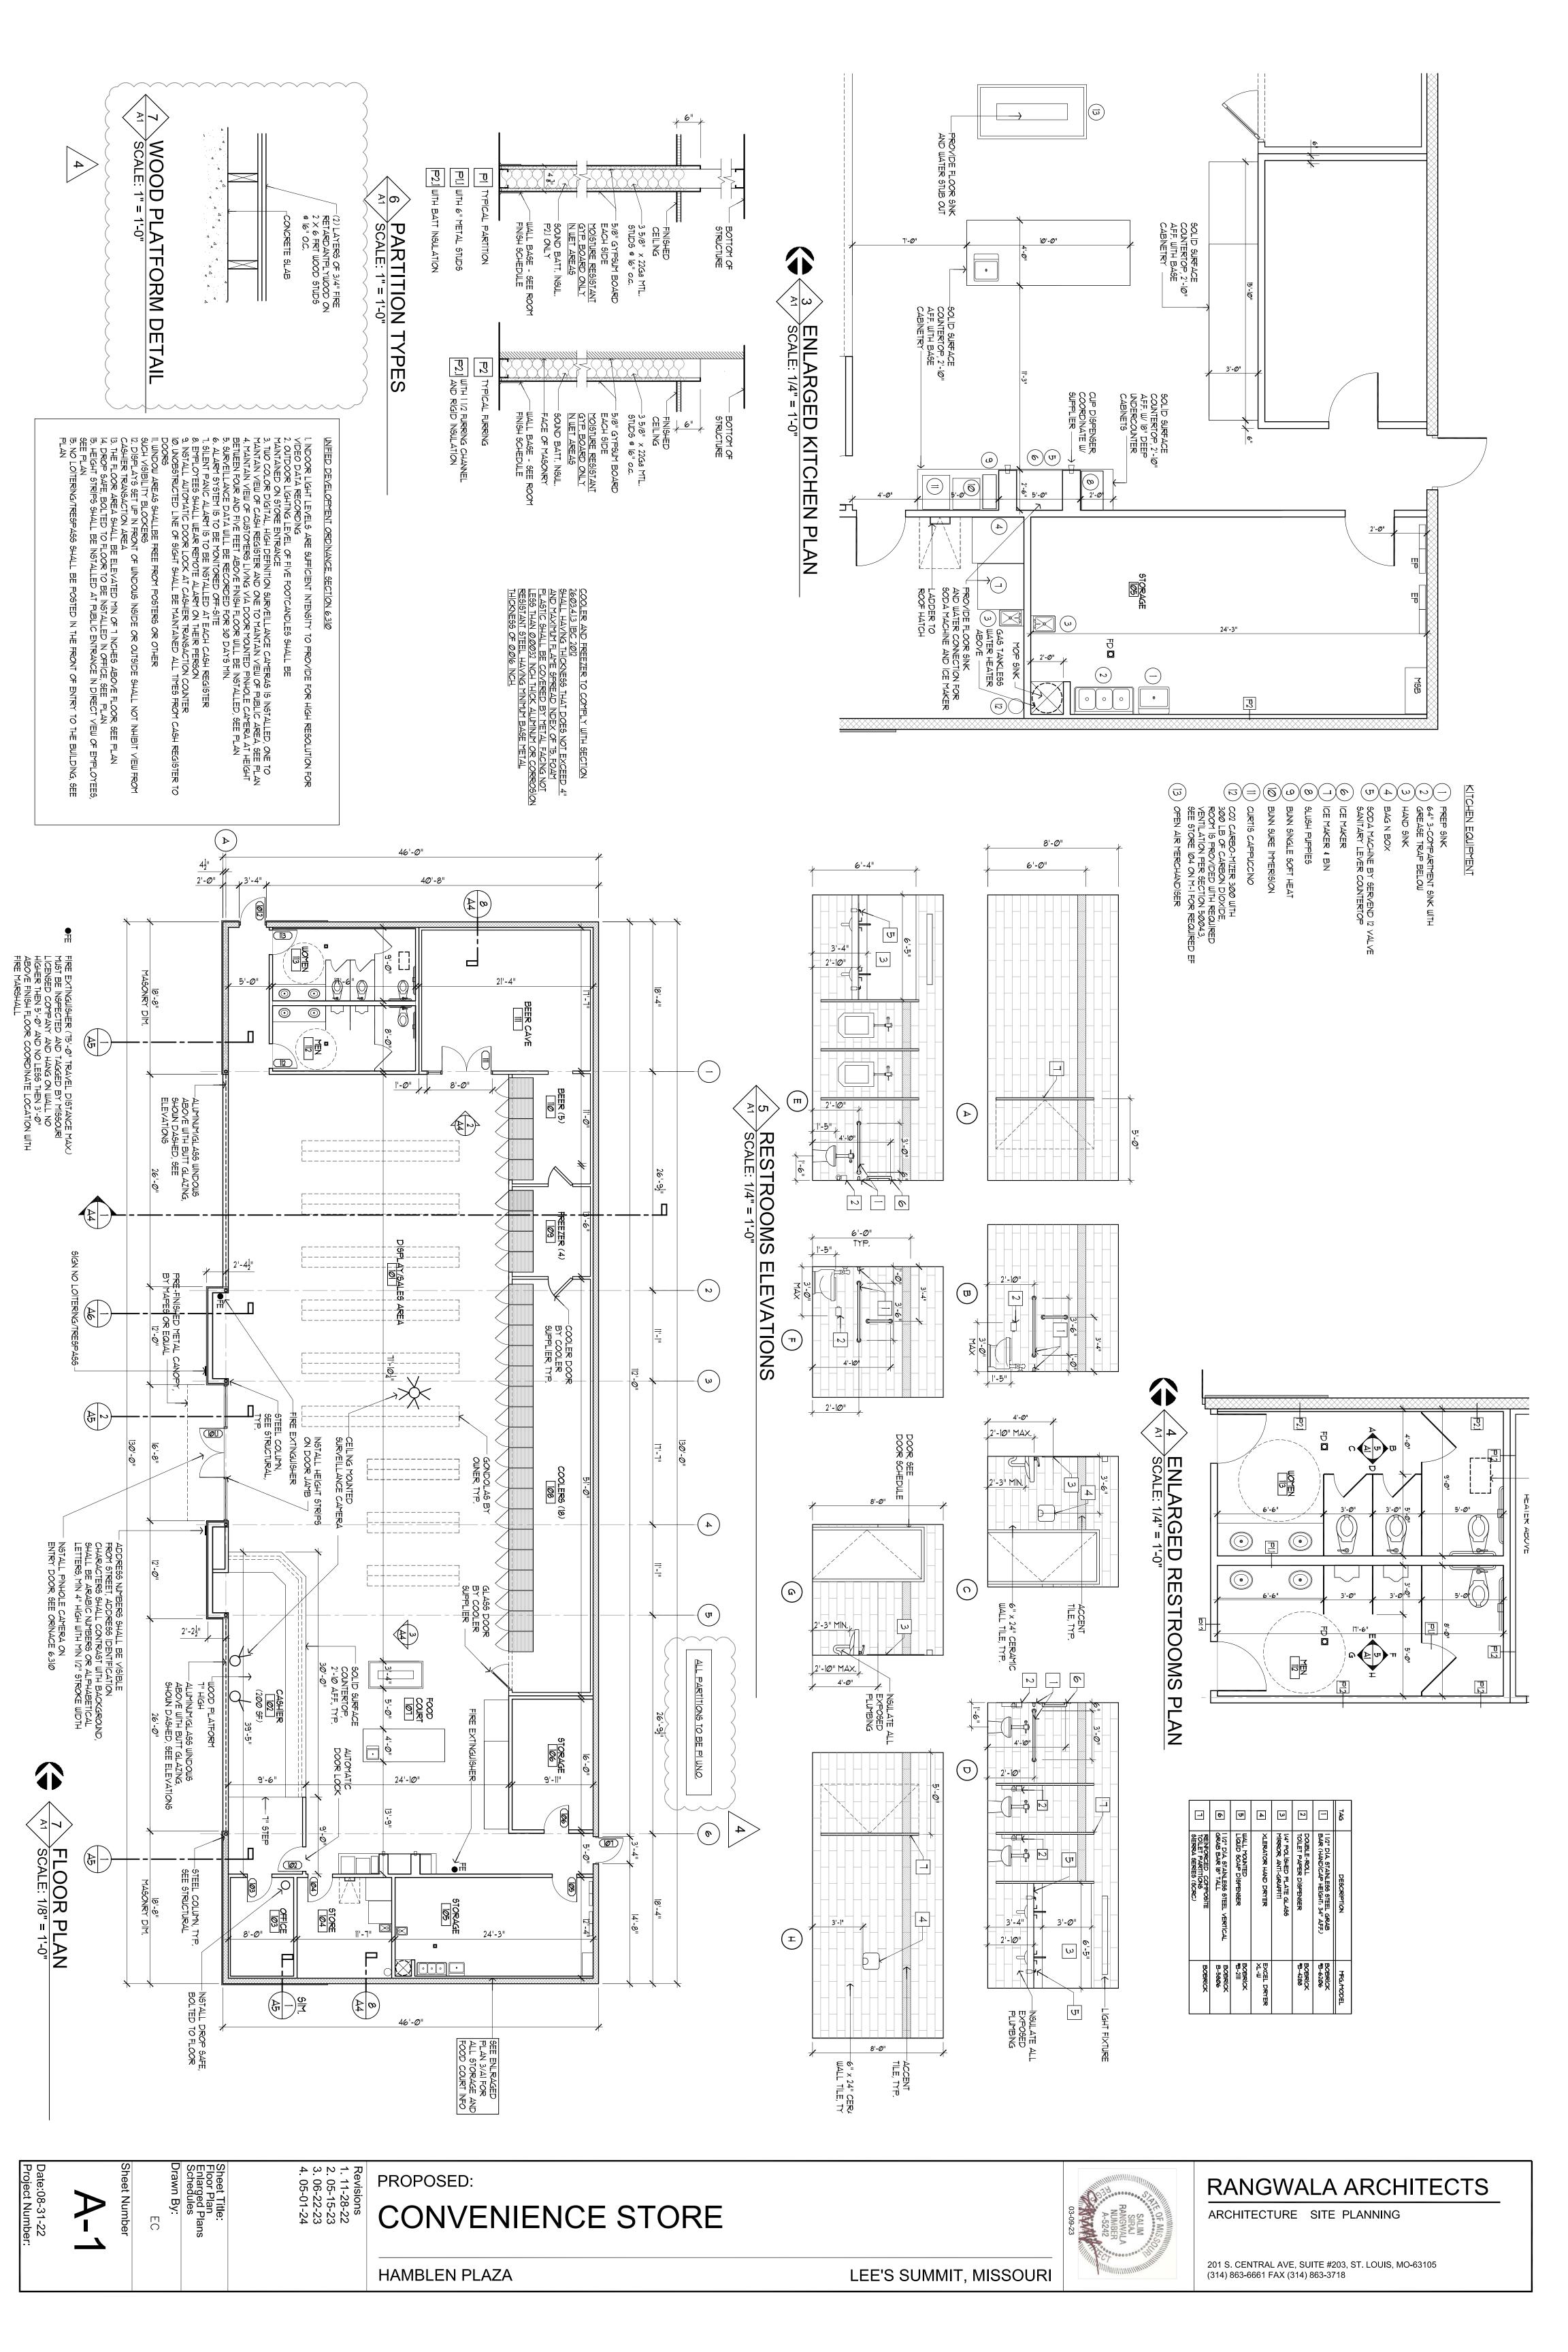

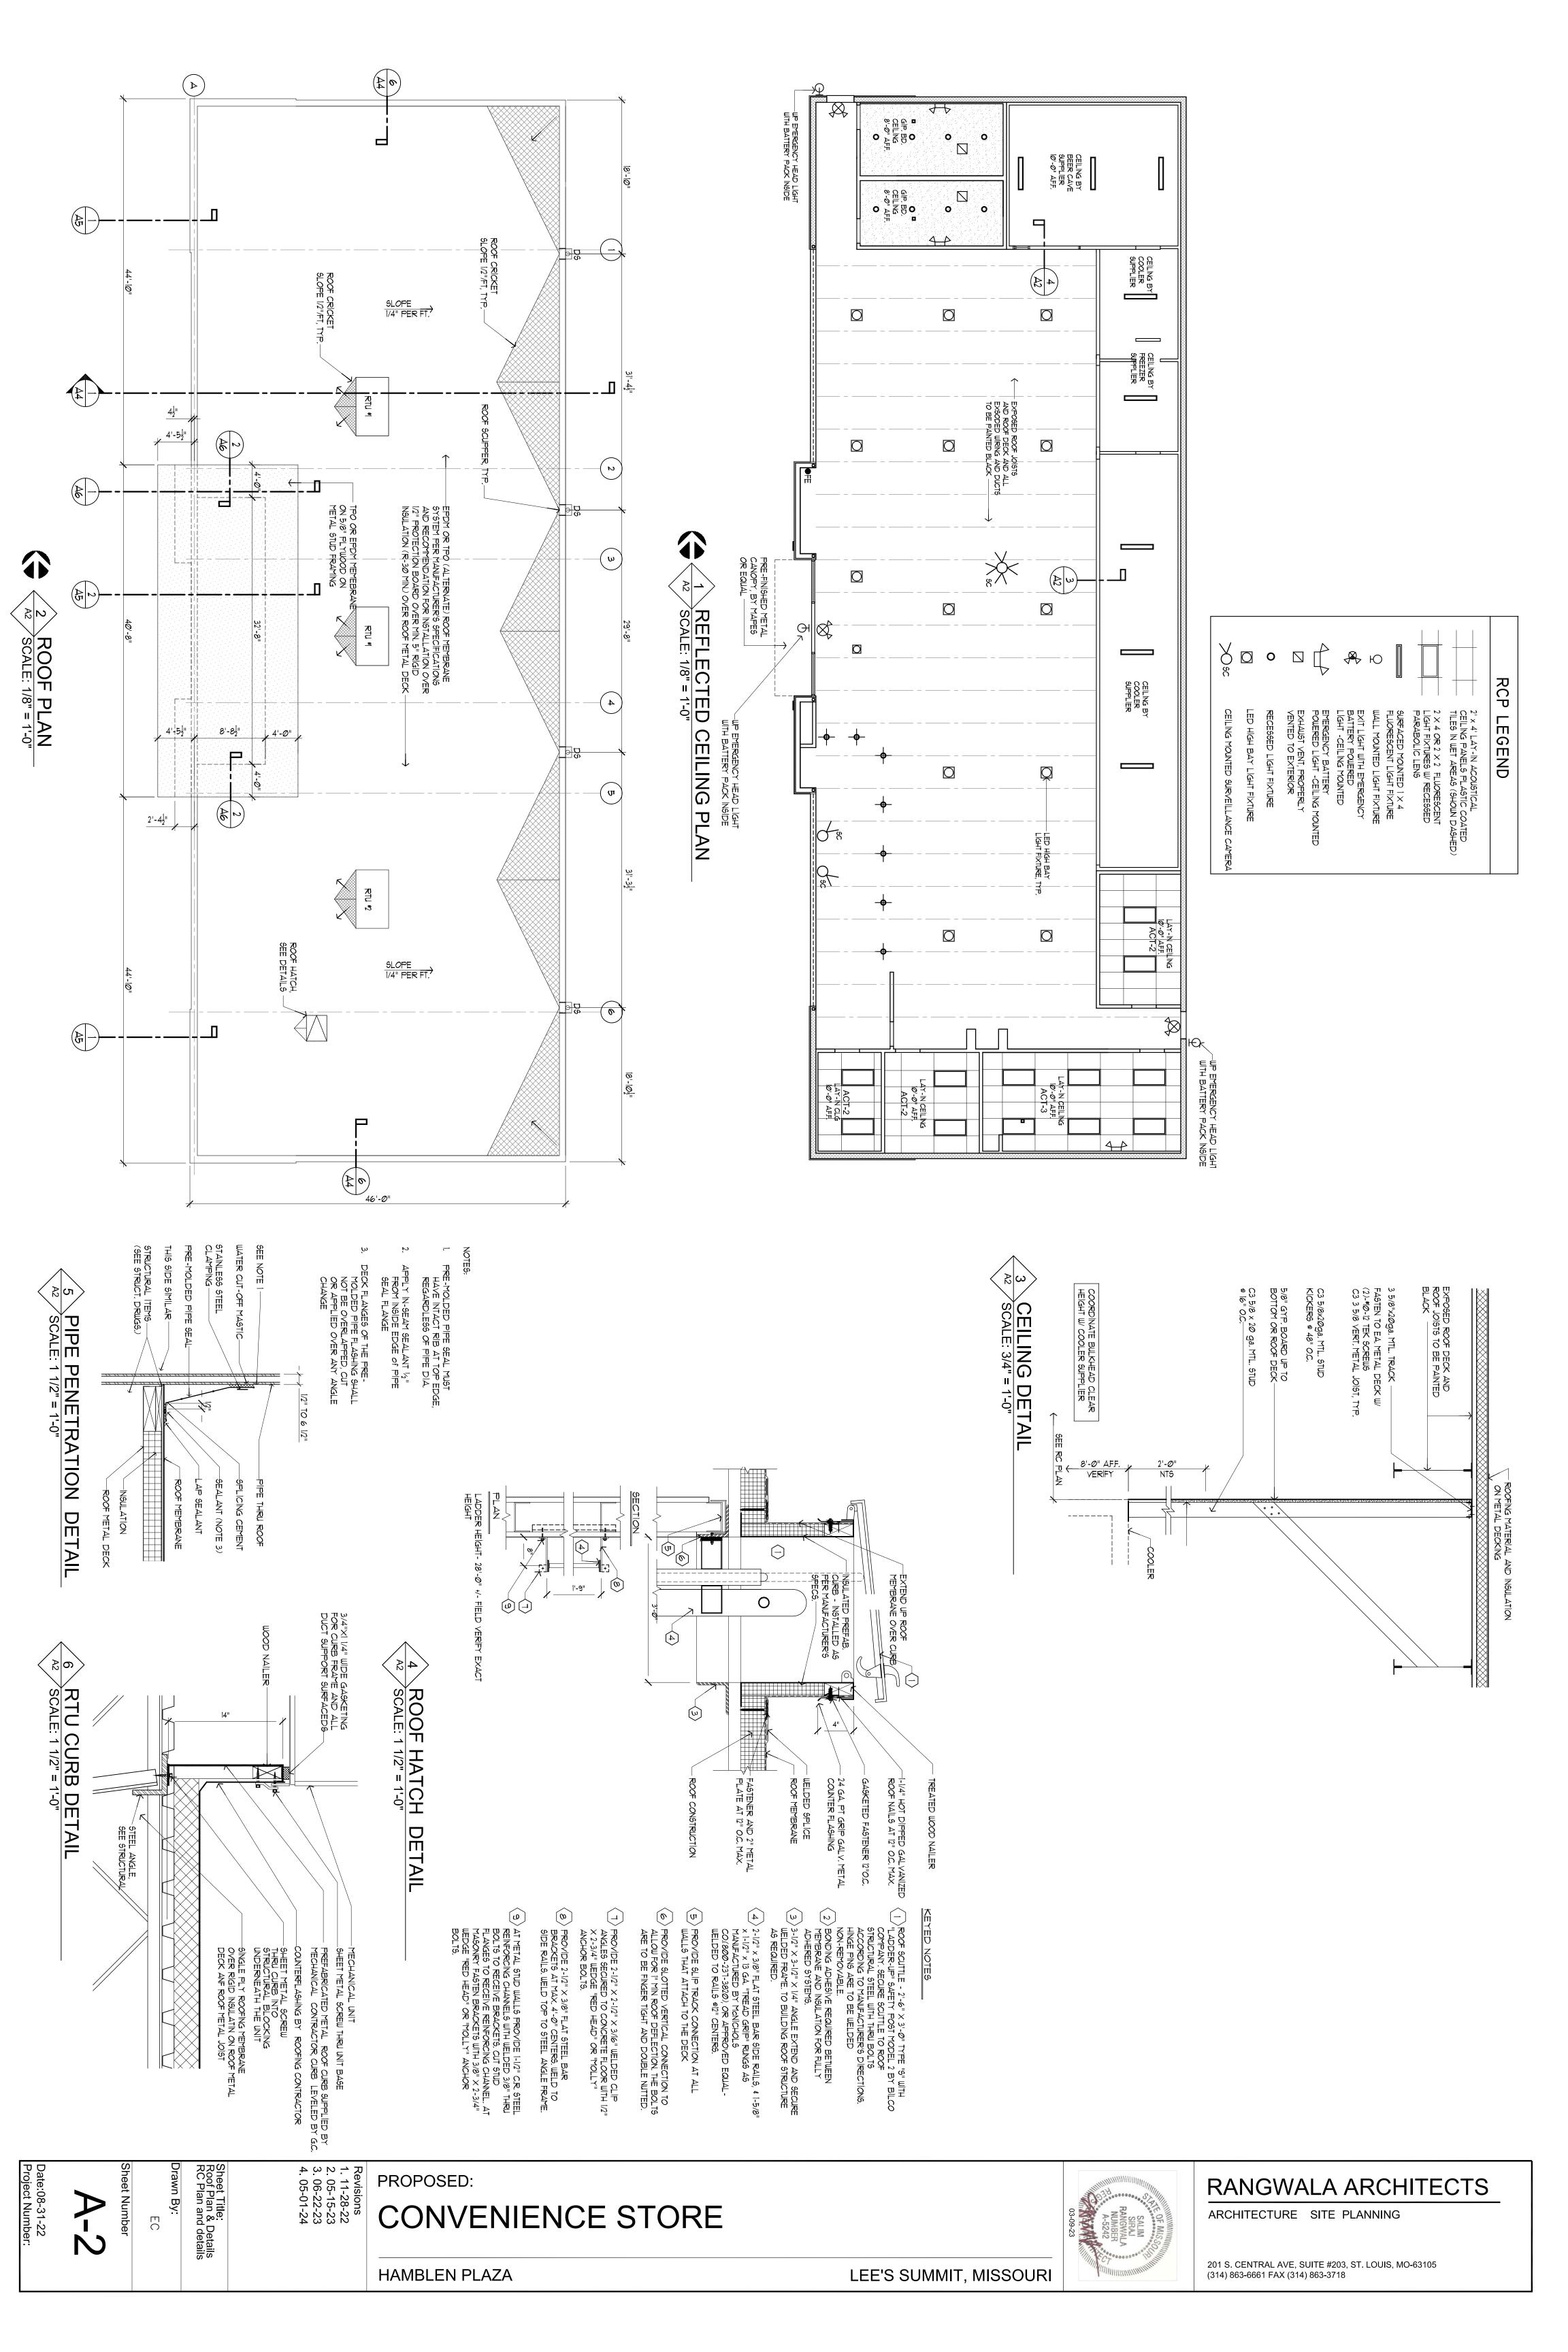

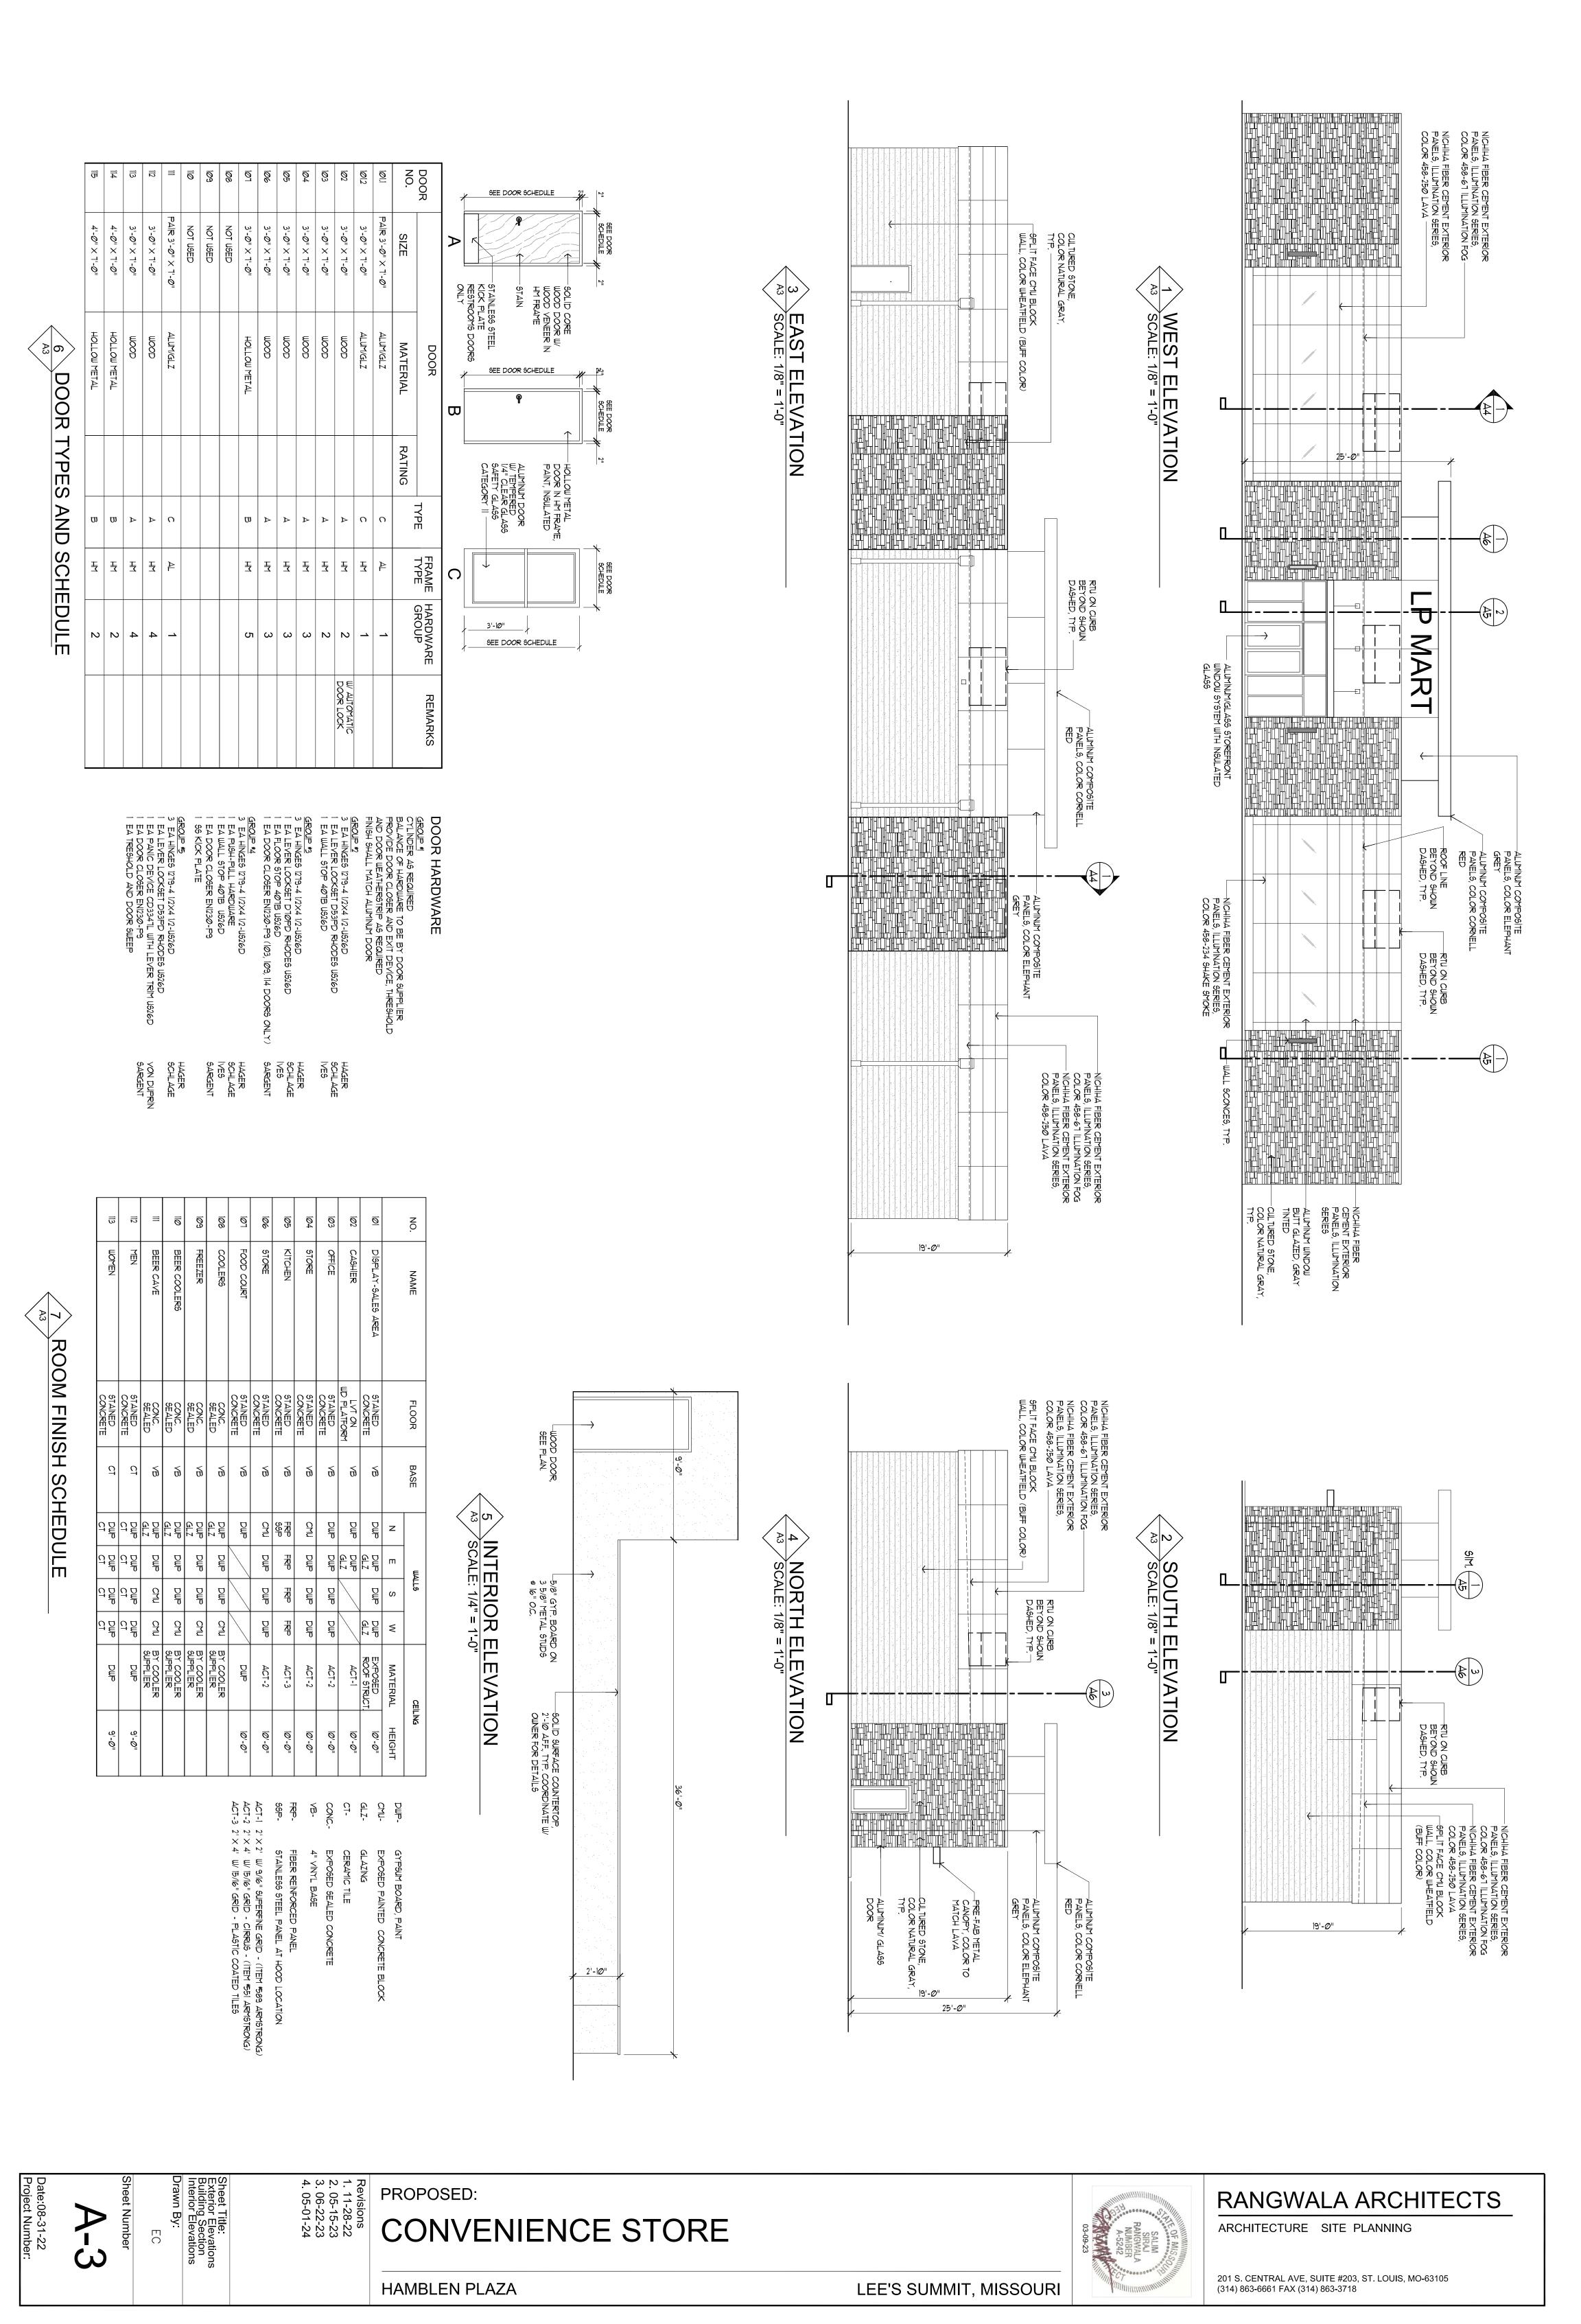

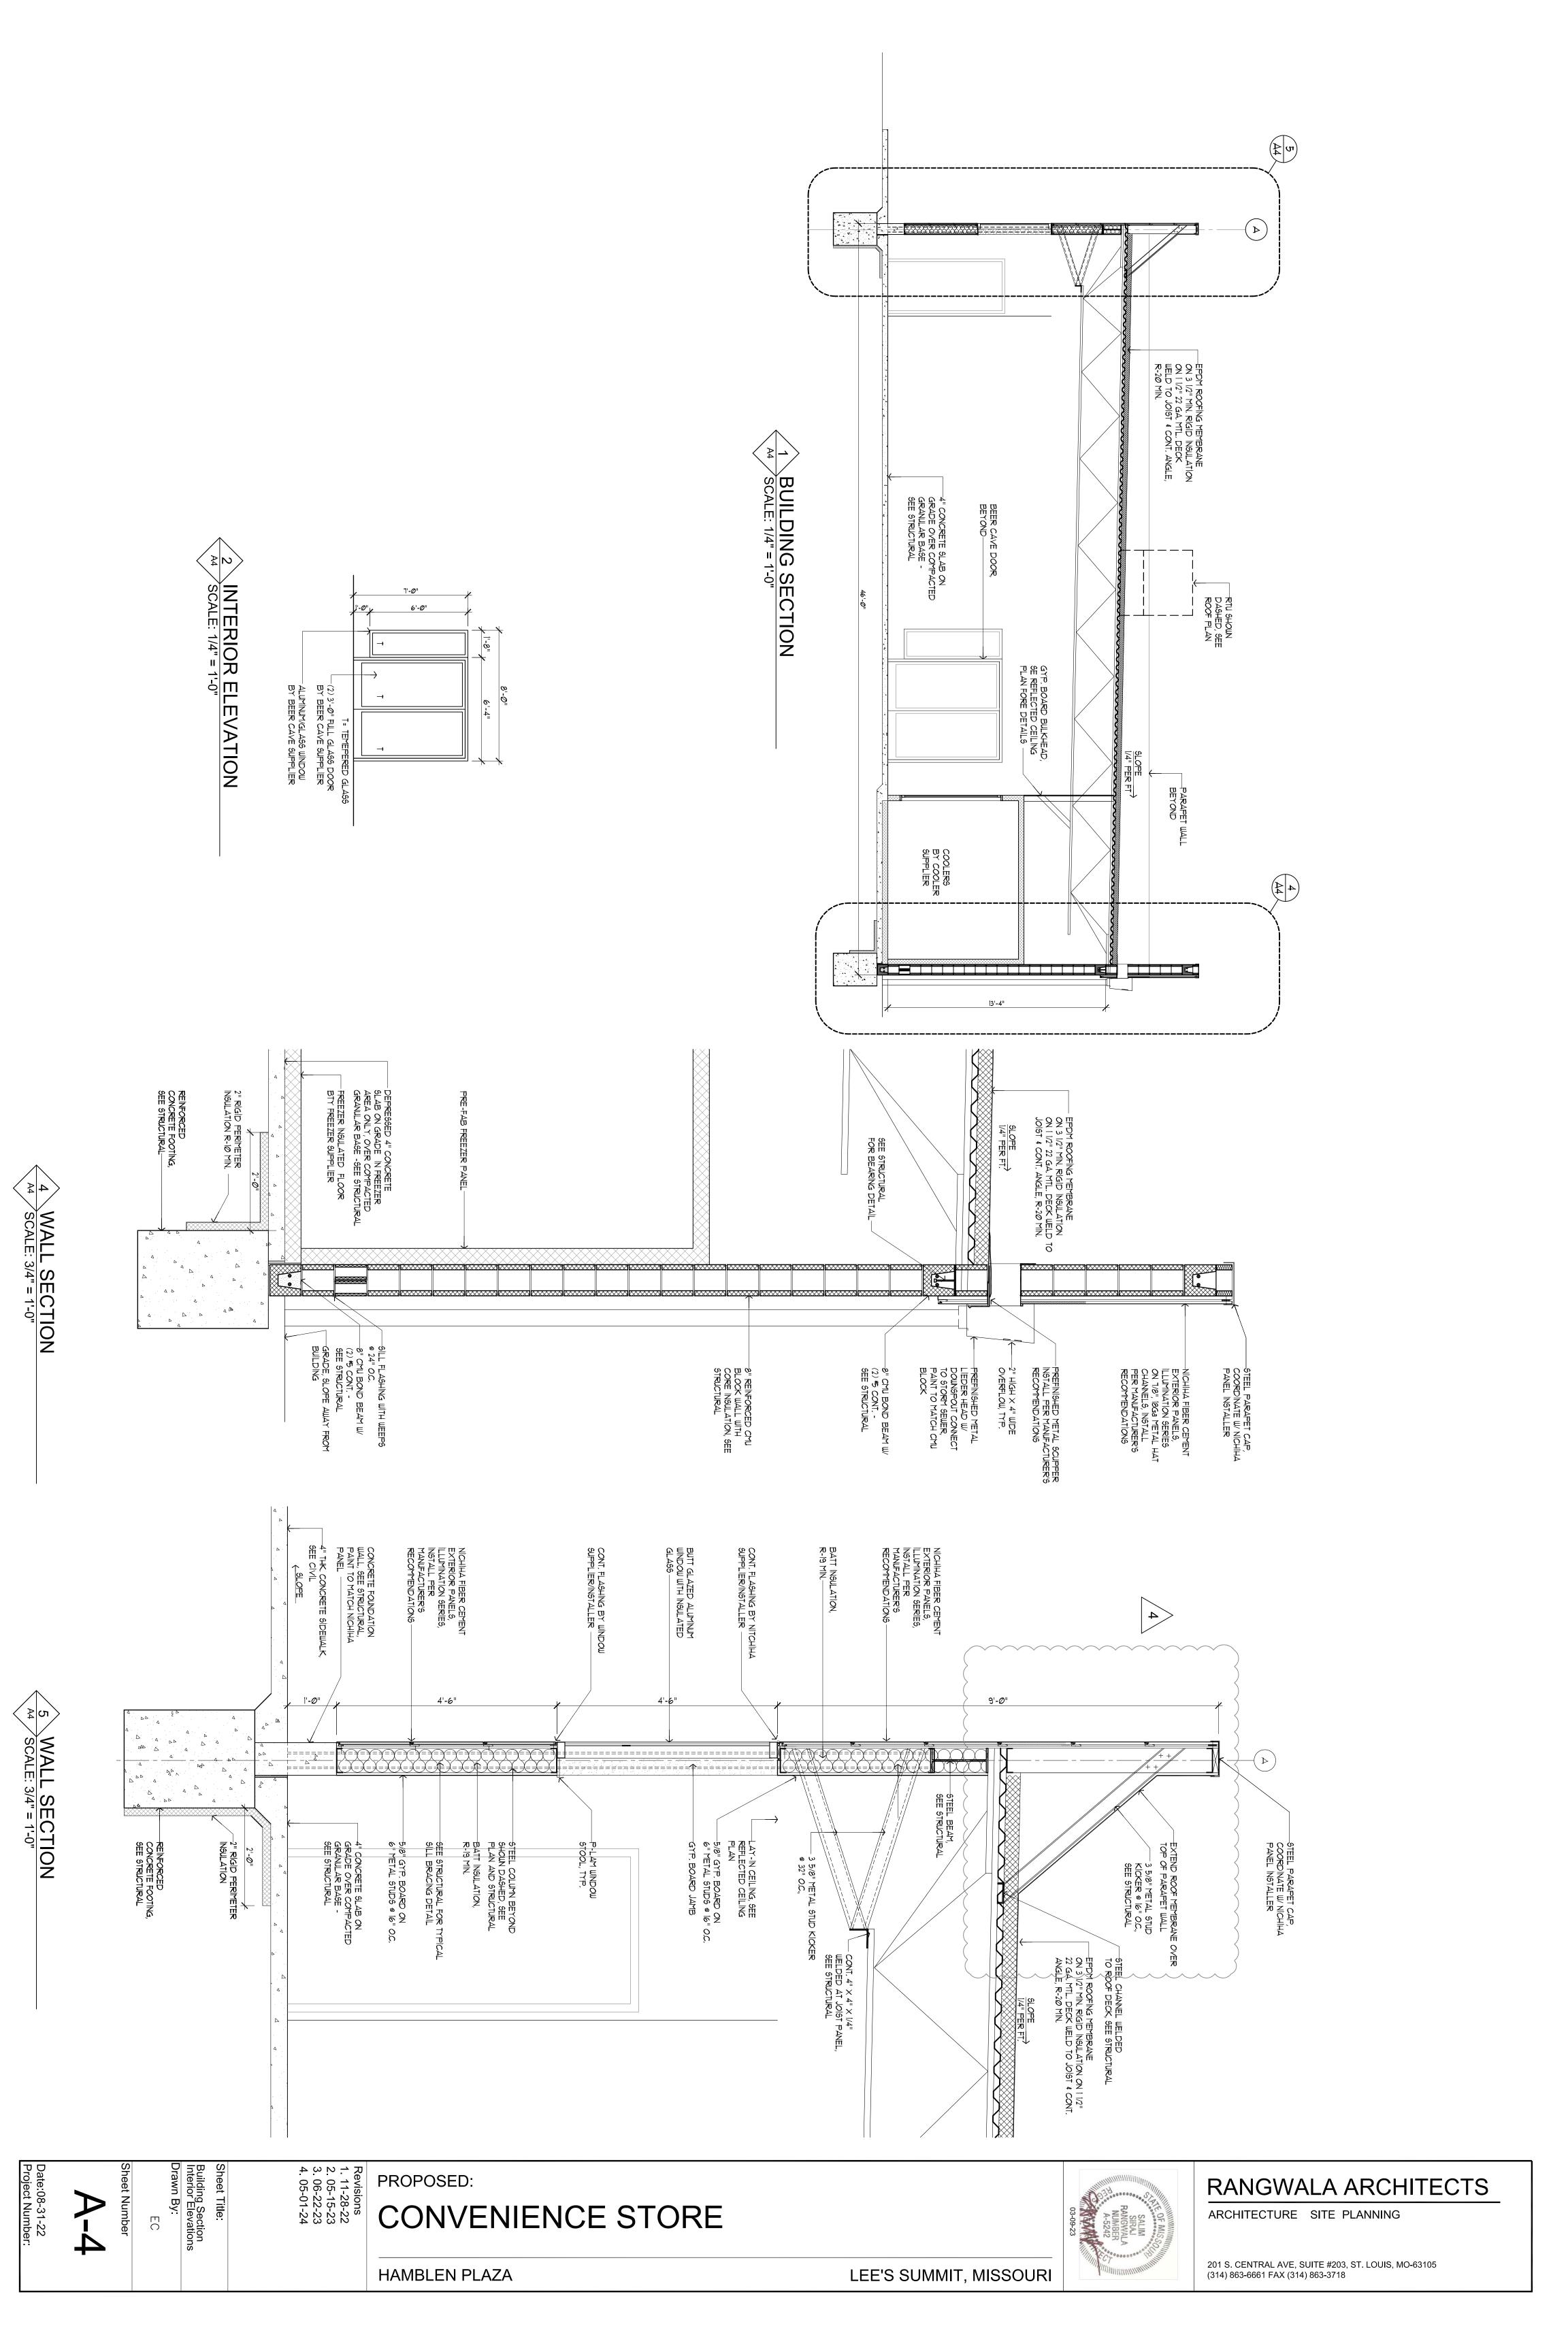


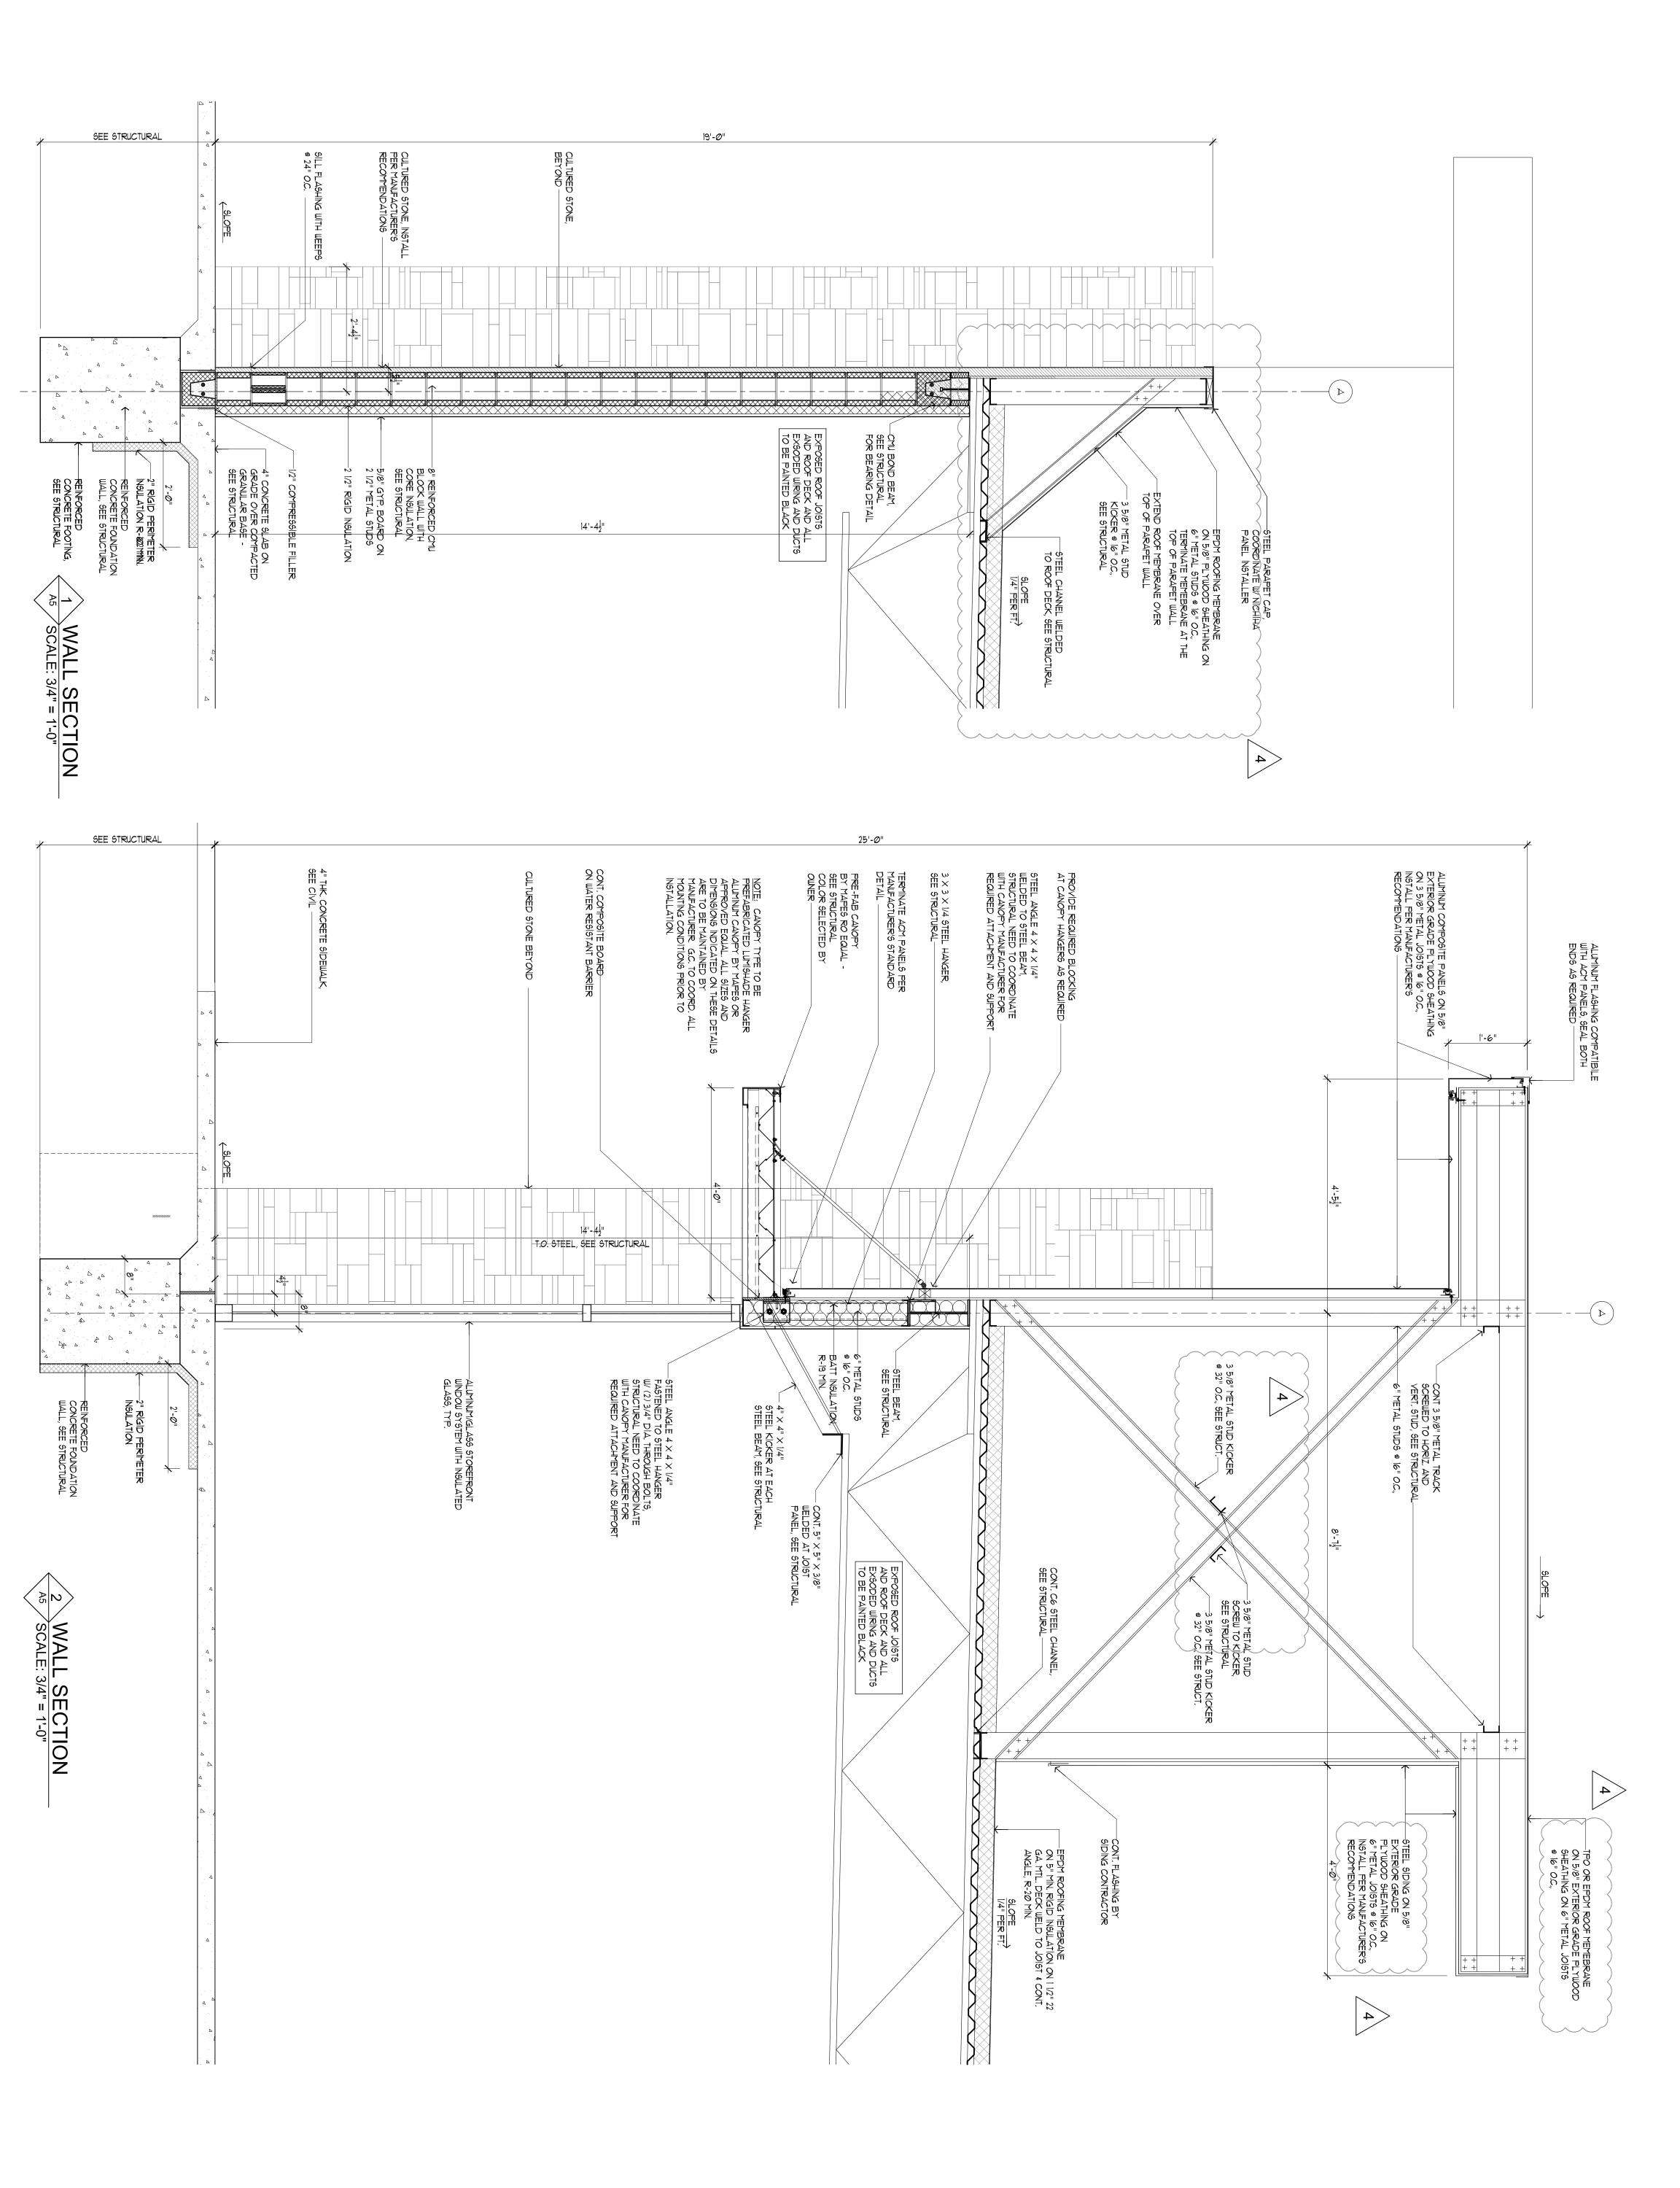

PROPOSED: **A-5 CONVENIENCE STORE** 201 S. CENTRAL AVE, SUITE #203, ST. LOUIS, MO-63105 (314) 863-6661 FAX (314) 863-3718 LEE'S SUMMIT, MISSOURI HAMBLEN PLAZA



RANGWALA ARCHITECTS ARCHITECTURE SITE PLANNING

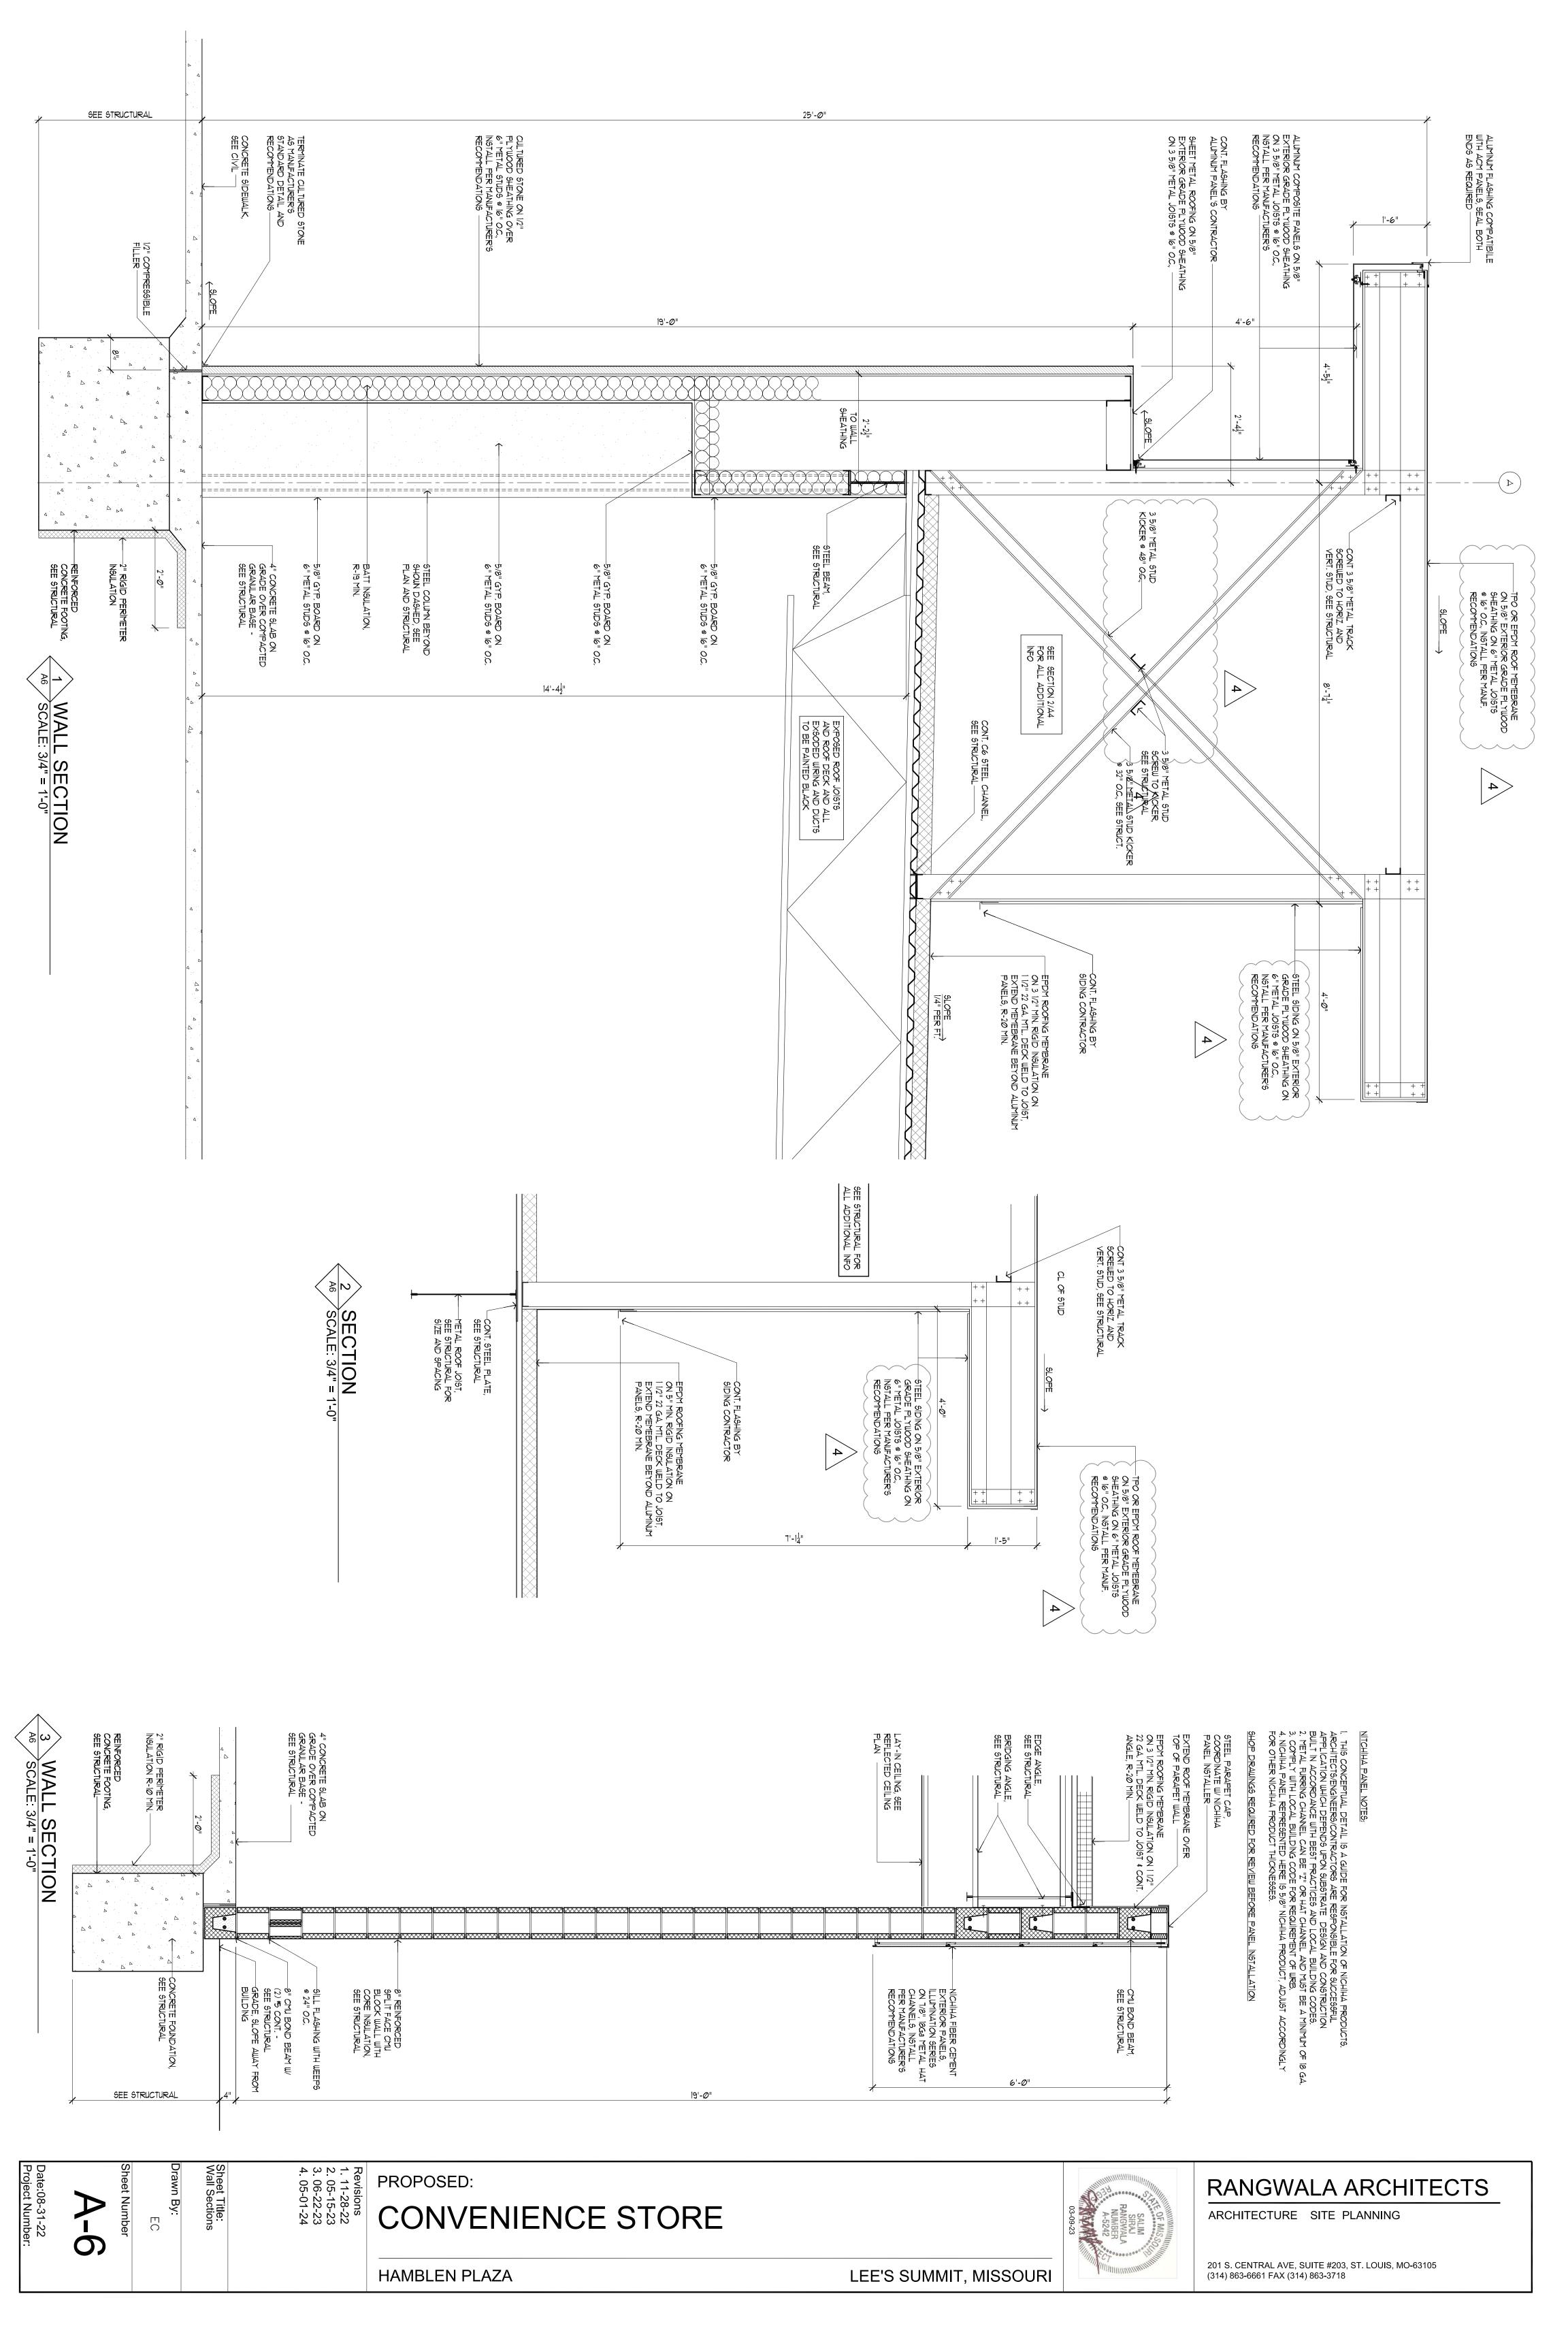

DOCUMENTS.

2. SUBMIT TWO SETS OF HARD COPIES AND ONE SET OF REPRODUCIBLES. ONE SET OF REDLINED HARD COPY WILL BE RETURNED TO THE ARCHITECT AND ONLY THE REPRODUCIBLE WILL BE RETURNED TO THE CONTRACTOR. IF NO REPRODUCIBLE IS SUBMITTED ONLY TWO SETS OF REDLINED DRAWINGS MILL BE RETURNED.

3. ALLOW AMPLE TIME FOR SHOP DRAWINGS REVIEW PROCESS. DEPENDING ON THE AMOUNT OF SHOP DRAWINGS NOT INCLUDE SATURDAYS, WILL BE RETURNED.

3. ALLOW AMPLE TIME FOR SHOP DRAWINGS REVIEW PROCESS. DEPENDING ON THE AMOUNT OF SHOP DRAWINGS AND THE COMPLEXITY OF THE PROJECT, THE NORMAL REVIEW TIME IS TEN WORKING DAYS FROM THE DAY AFTER THE STRUCTURAL ENGINEER RECEIVES THE DRAWINGS. THIS DOES NOT INCLUDE SATURDAYS, SUNDAYS, HOLIDAYS AND THE DAY DRAWINGS ARE RECEIVED.

4. THE REVIEW OF SHOP DRAWINGS IS ONLY FOR GENERAL CONFORMANCE WITH THE DESIGN CONCEPT OF THE PROJECT AND GENERAL COMPLIANCE WITH THE INFORMATION GIVEN IN THE CONTRACT DOCUMENTS

5. FIELD LAYOUT, SHOP DETAILS, CONTRACT DOCUMENTS

6. FIELD LAYOUT, SHOP DETAILS, VERIFYING AND COORDINATING DIMENSIONS AND DETAILS SHOWN ON ARCHITECTURAL, MECHANICAL, ELECTRICAL, PLUMBING, FIRE PROTECTION, CIVIL, AND STRUCTURAL DRAWINGS AND REPORT ANY DISCREPANCIES TO THE ARCHITECT

6. DIMENSIONS TO BE CONFIRMED AND CORRELATED AT THE JOB SITE AND BETWEEN INDIVIDUAL DRAWINGS OR SETS OF DRAWINGS

7. FABRICATION, PROCESSES, MEANS, METHODS, TECHNIQUES, SEQUENCES AND PROCEDURES OF CONSTRUCTION, INCLUDING EXCAVATION, SHORING, SCAFFOLDS, TEMPORARY BRACING, TEMPORARY CLIPS AND LUGS, ERECTION, TEMPORARY STRUCTURAL MEMBERS REQUIRED FOR SAFE ERECTION PROCEDURES, FORMWORK, AND ETC. DETAILS AND SECTIONS LABELED "TYPICAL" ON THE STRUCTURAL DRAWINGS APPLY TO ALL SITUATIONS OCCURING ON THE PROJECT THAT ARE THE SAME OR SIMILAR TO THOSE LOCATIONS SPECIFICALLY INDICATED, WHERE DETAILS OR SECTIONS ARE NOT INDICATED, THEY SHALL BE THE SAME AS OTHER SIMILAR CONDITIONS. OWNER IS RESPONSIBLE FOR THE COSTS OF HAVING SPECIAL INSPECTIONS COMPLETED BY AN APPROVED AND QUALIFIED INSPECTION OR TESTING AGENCY, OWNER HAS OPTION TO DESIGNATE THE GENERAL CONTRACTOR AS COORDINATOR AND SCHEDULER OF ALL SPECIAL INSPECTIONS. ETC.
COORDINATION OF THE WORK OF ALL TRADES, SAFE WORKING CONDITIONS ON THE JOB SITE, AND COMPLIANCE WITH ALL FEDERAL, STATE, AND LOCAL CODE REQUIREMENTS INCLUDING OSHA REQUIREMENTS. NS.

IS SHALL BE PERFORMED PER CHAPTER 17 OF THE 2018 IBC.

ALL BE APPROVED QUALIFIED INSPECTION AND TESTING AGENCY D. STEEL FABRICATOR SHOP INSPECTION

1. ALL STRUCTURAL STEEL FOR MATERIAL IDENTIFICATION, AND CONFORMANCE TO ASTM SPECIFICATION.

2. SHOP INSTALLED BOLTS PER LATEST RCSC'S "SPECIFICATION FOR STRUCTURAL BOLTS AND JOINTS USING A325 OR A490 BOLTS", AND CONFORMANCE TO PLANS.

3. WELD IN CONFORMANCE WITH AWS SPECIFICATIONS. FOR BUILDING IN SEISMIC PERFORMANCE CATEGORY C OR HIGHER, ALL COMPLETE PENETRATION GROOVE WELDS SHALL BE ULTRASONICALLY TESTED OR INSPECTED BY OTHER APPROVED METHODS. COLUMN SPLICE WELDS SHALL BE ULTRASONICALLY TESTED OR INSPECTED BY OTHER APPROVED METHODS.

4. FABRICATION AND QUALITY CONTROL PROCEDURES ALONG WITH IMPLEMENTATION PROCEDURES. SPECIAL INSPECTIONS OF STRUCTURAL SHOP IS NOT REQUIRED IF FABRICATOR MAINTAINS AN AGREEMENT WITH AN APPROVED INDEPENDENT INSPECTION OR QUALITY CONTROL AGENCY.

E. FIELD INSPECTION FOR STRUCTURAL STEEL

1. ALL BOLTED CONNECTIONS PER RCSC'S "SPECIFICATION FOR STRUCTURAL JOINTS USING A325 OR A490 BOLTS".

2. ALL WELDED CONNECTIONS INCLUDING BUT NOT LIMITED TO STEEL BEAMS, COLUMNS, JOIST BEARING SEATS, STEEL ANGLES, BRACES, BRIDGING, MISSELL ANEOUS STEEL CONNECTIONS.

3. STEEL FRAME FOR COMPLIANCE VERIFICATION WITH DETAILS SHOWN ON APPROVED CONSTRUCTION DOCUMENTS. 2. CONTRACTOR AND MANUFACTURER SHALL PRO ALL LIGHT GAGE METAL FRAMING USED ON INCLUDE THE FOLLOWING:


A. MATERIAL MILL CERTIFICATES
B. SECTION PROPERTIES AND STRENGTHS
C. WELDER QUALIFICATION CERTIFICATES
D. ANCHORAGE DETAILS
E. MANUFACTURER'S STANDARD DETAILS AN OR FIRE RATED ASSEMBLIES SHOWN ON ARCHITECTURAL DRAWINGS PROVIDE COLD—TORMED METAL FRAMING IDENTICAL TO THAT TESTED AS PART OF THE ASSEMBLY FOR THE TIRE RESISTANCE PER ASTM E119 BY INDEPENDENT TESTING.


IRE—RESISTANCE RATINGS ARE INDICATED ON ARCHITECTURAL DRAWINGS BY UL "FIRE RESISTANCE DIRECTORY NUMBER" OR BY WARNOCK HERSEY OR OTHER TESTING AN UNSPECTING AGENCIES ACCEPTABLE TO AUTHORITIES HAVING JURISDICTION. HALL PROTECT COLD-FORMED METAL FRAMING FROM NO OTHER DAMAGE DURING DELIVERY, STORAGE AND HANDLY ALL STORE COLD-FORMED METAL FRAMING WITH A VENTILATE TO AVOID CORROSION.


HALL FOLLOW ALL MANUFACTURER'S RECOMMENDATIONS FOR STORAGE. STANDARD DETAILS AND INSTALLATION REQUIREMENTS
PLY WITH APPLICABLE PROVISIONS OF AWS D1.1 "STRUCTURAL
TEL" AND AWS D1.3 "STRUCTURAL WELDING CODE FOR SHEET CONTRACT SIDE LAP INTERLOCKS.


SQUARE AND FASTEN TO SUPPORTING DID CORROSION.


MANUFACTURER'S RECOMMENDATIONS FOR HANDLING, PROVIDE SHOP DRAWINGS AND PRODUCT ON THIS PROJECT. THE SUBMITTAL OF 2000 PSI AT 13/8" DIAMETER STRENGTH OF 15 28 DAYS. GROUT SHALL AGGREGATE. TYPE 'S' 500 PSI @ 28 DAYS BASED ON GALVANIZED-STEEL SPECIFICATIONS AND RECOMMENDATIONS, AND THE STRUCTURAL DRAWINGS ARE NOT A SET OF STAND-ALONE CONSTRUCTION DOCUMENTS. THESE STRUCTURAL DRAWINGS MUST ONLY BE USED IN CONJUNCTION WITH ARCHITECTURAL AND OTHER RELATED DISCIPLINES DRAWINGS. CONTRACTOR TO VERIFY EXISTING CONDITIONS AND CO-ORDINATE BETWEEN THE STRUCTURAL, ARCHITECTURAL, AND OTHER DISCIPLINES DRAWINGS. ANY DISCREPANCY BETWEEN THE DRAWINGS MUST BE BROUGHT TO THE ARCHITECT AND ENGINEERS ATTENTION FOR RESOLUTION PRIOR TO FABRICATION OR CONSTRUCTING THAT PORTION OF THE STRUCTURE. CONTRACTORS TO COMPLY WITH ALL GOVERNING REGULATIONS AND REQUIREMENTS INCLUDING OSHA REGULATIONS 29 CFR PART 1926 FOR CONSTRUCTION INDUSTRY. SUMMIT ENGINEERING GROUP LLC
STRUCTURAL ENGINEERS
12118 Fairpark Lane St. Louis, MO 63146 Ph: 314-325-4899 Fax: 314-594-9922 Email: eng@summit-engg.com **GENERAL** PROPOSED: RANGWALA ARCHITECTS **CONVENIENCE STORE** ARCHITECTURE SITE PLANNING 201 S. CENTRAL AVE, SUITE #203, ST. LOUIS, MO-63105 LEE'S SUMMIT, MISSOURI HAMBLEN PLAZA (314) 863-6661 FAX (314) 863-3718

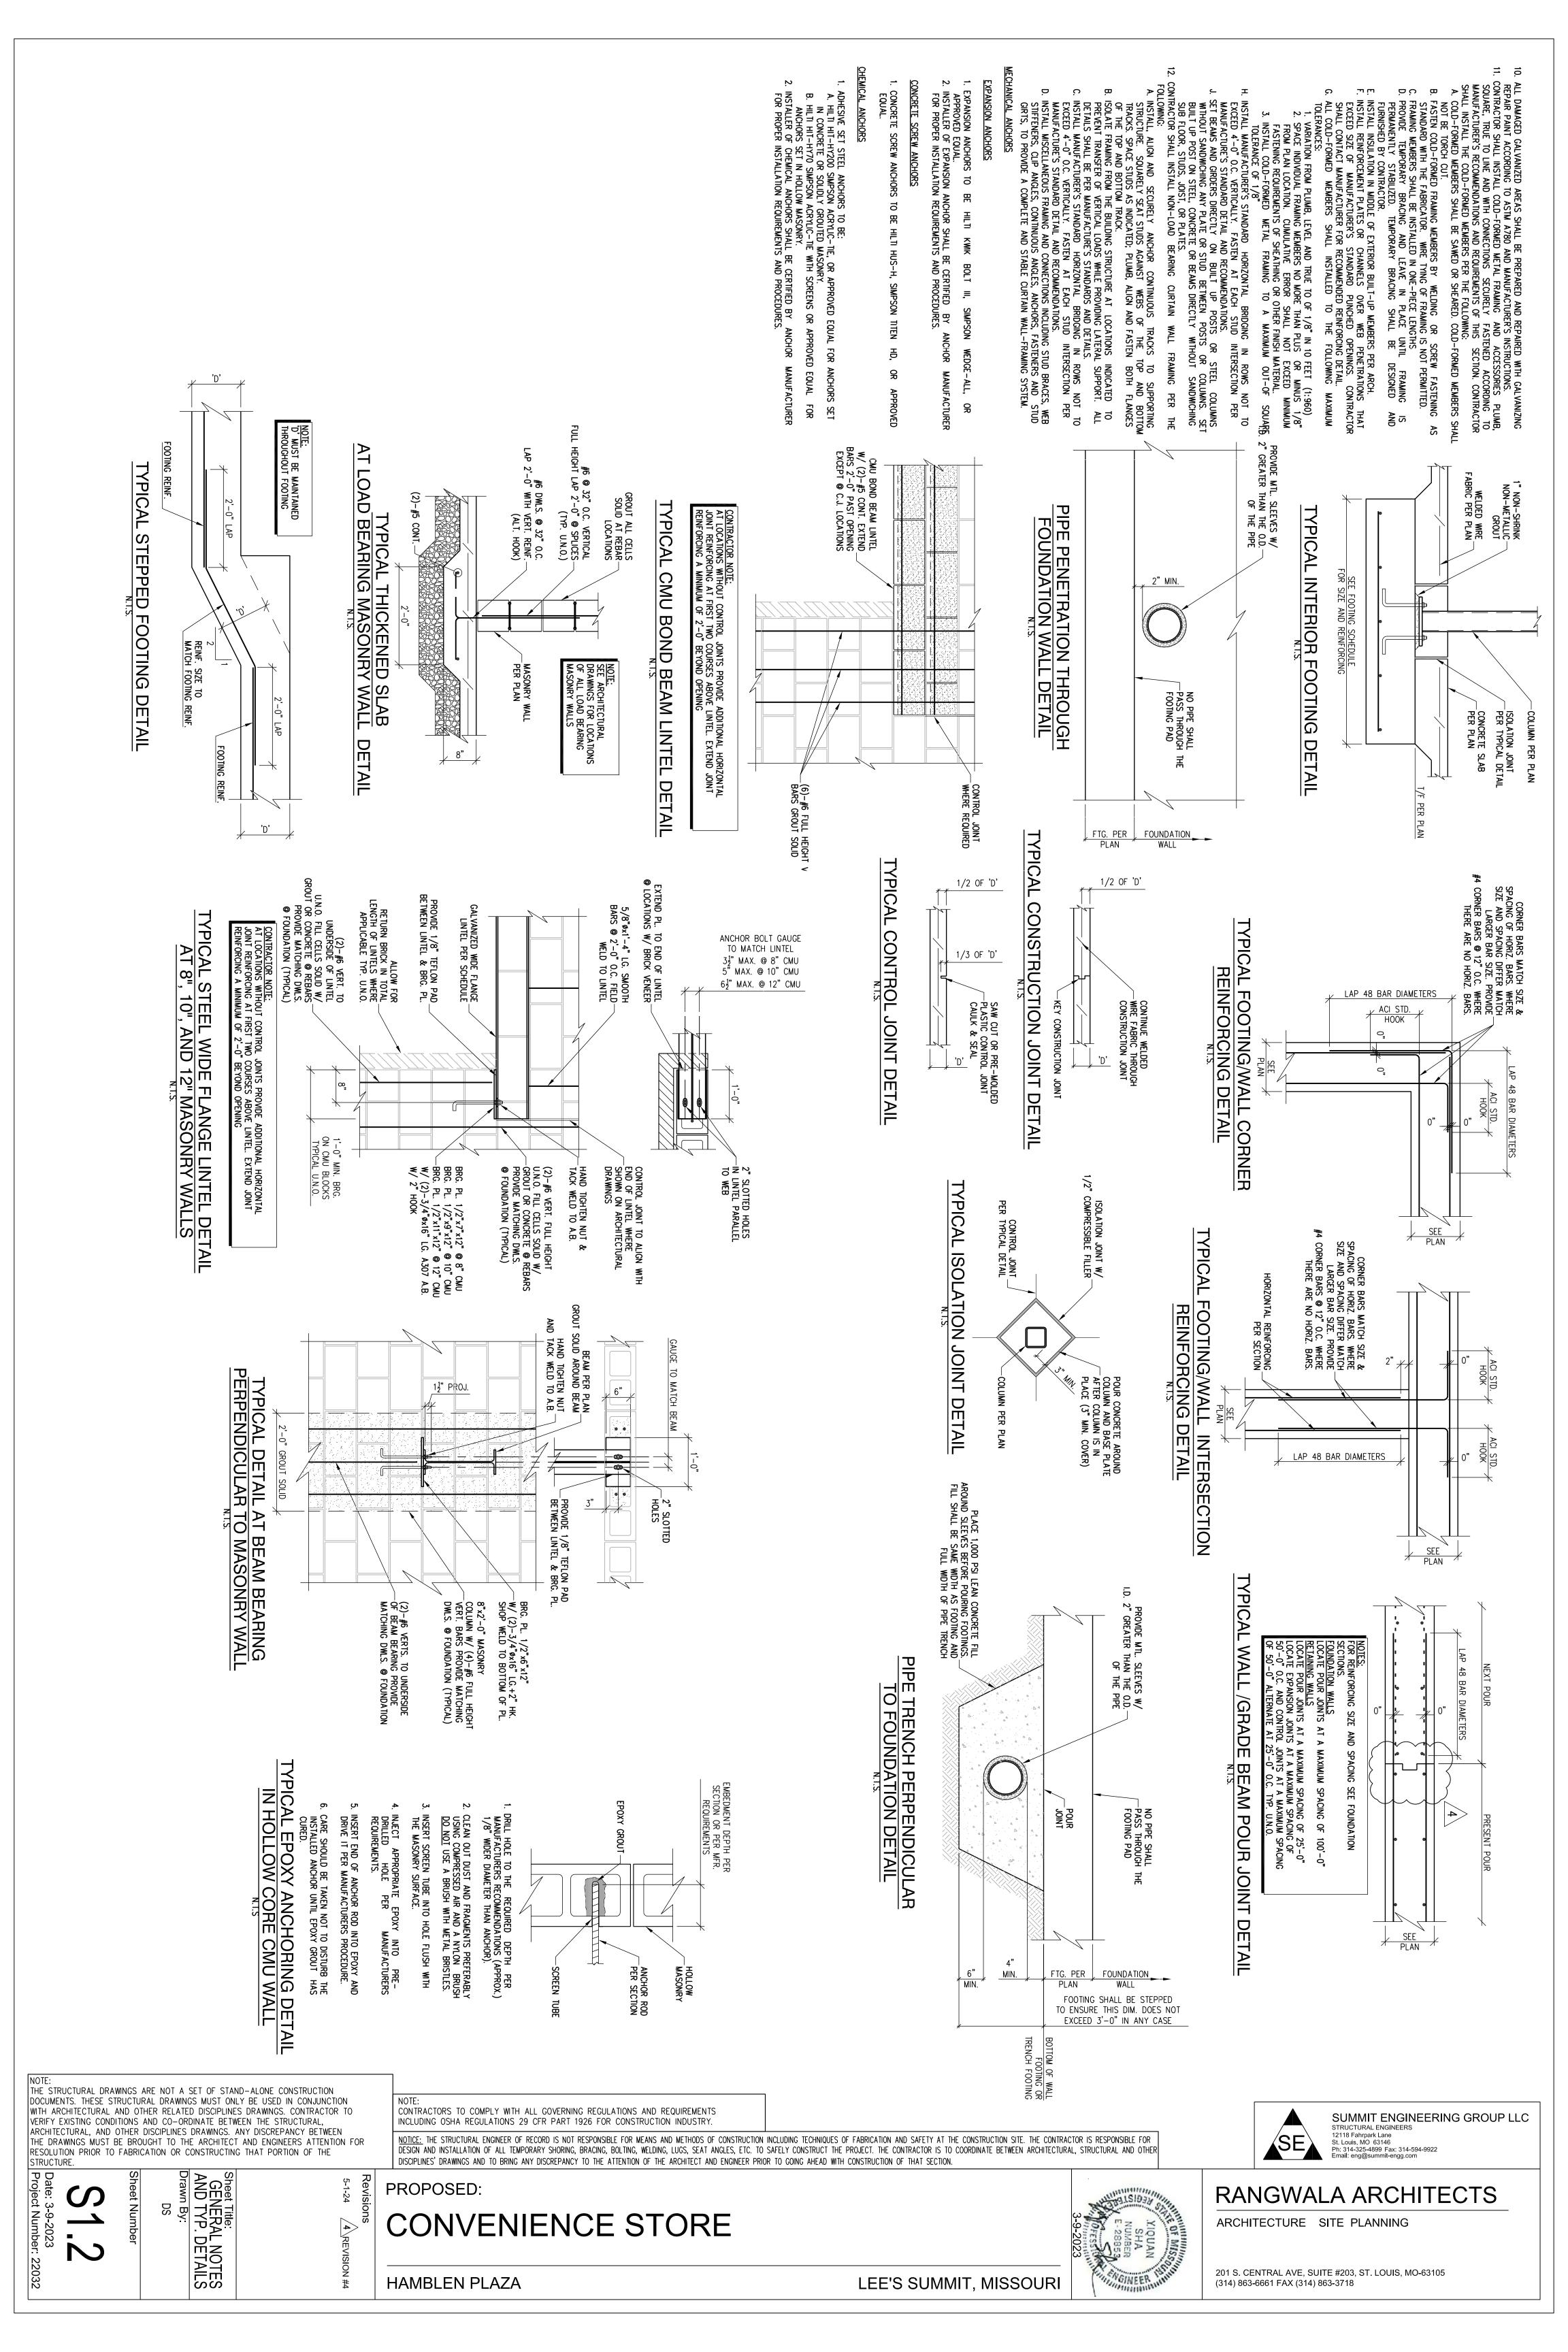


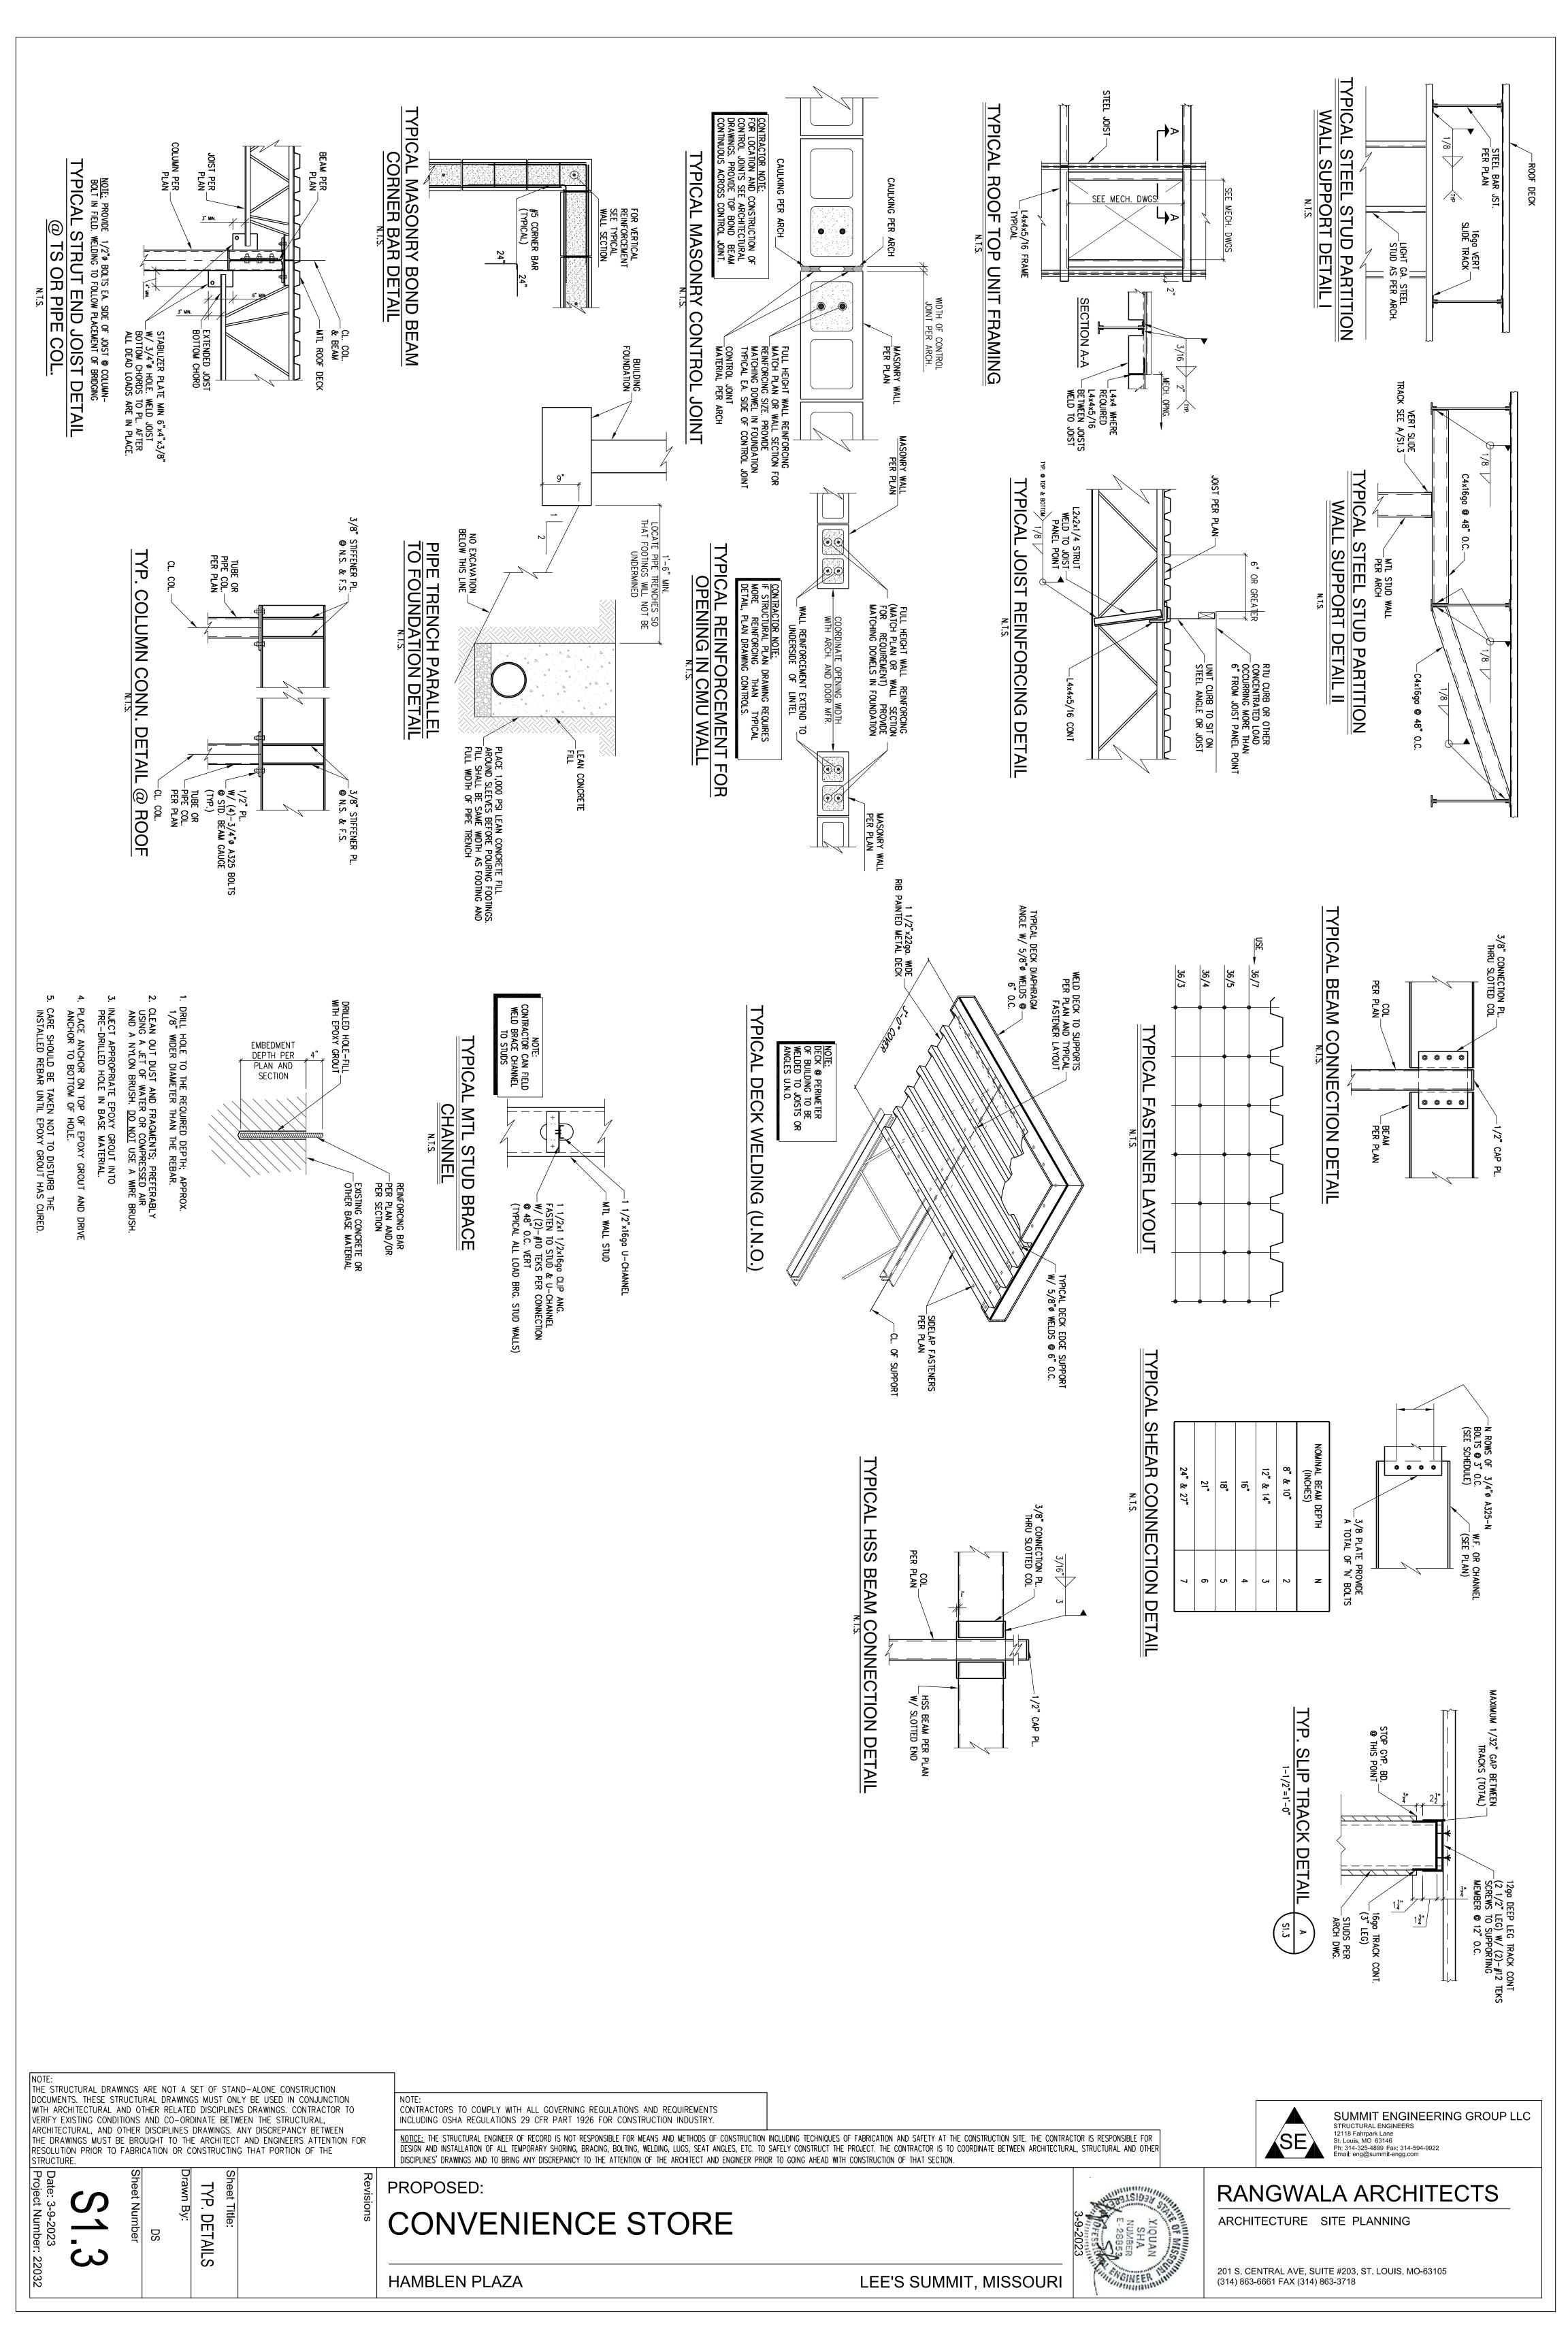

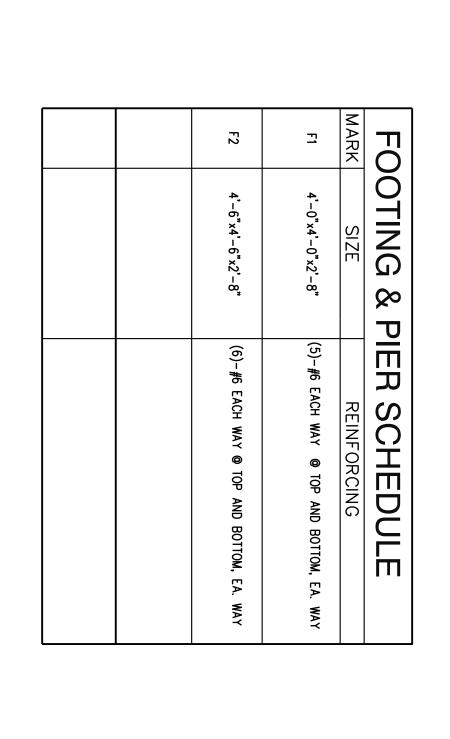

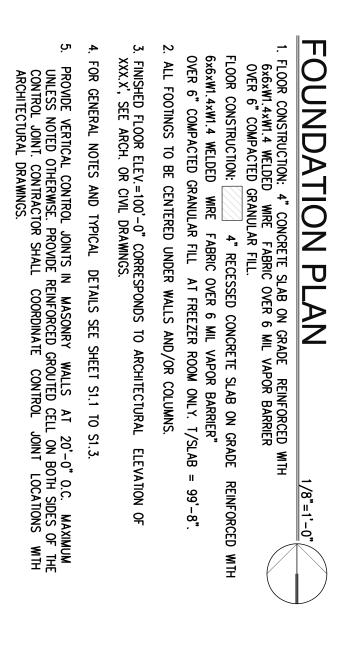

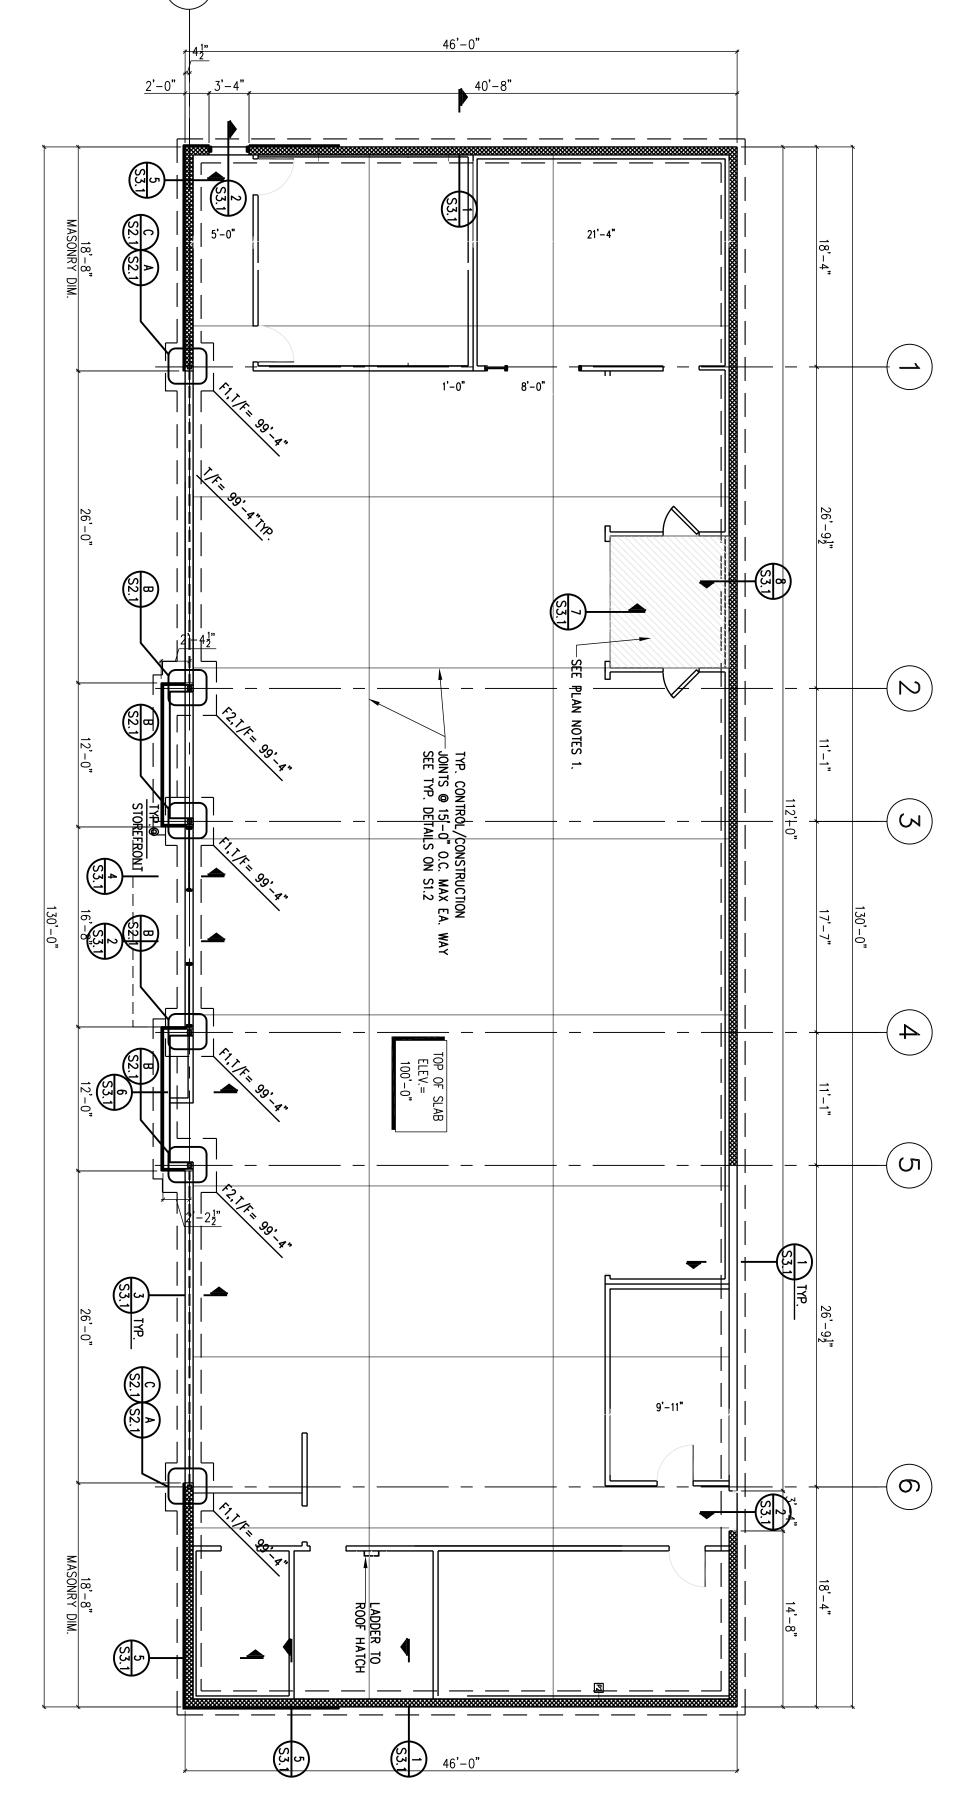

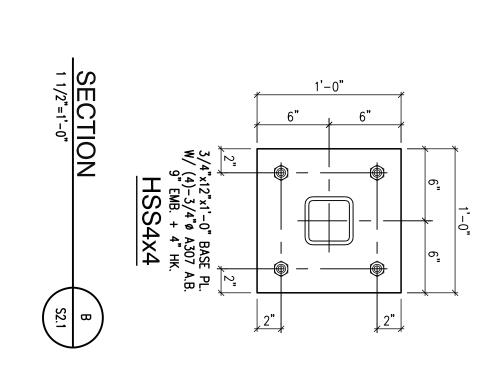


HSS COLUMN SEE DETAIL D/S2.1 FOR BASE PL INFO.

2)#6 VERT. FULL HEIGHT WITH

SAME SIZE DOWELS IN FOUNDATION

SECTION
3/4"=1'-0"

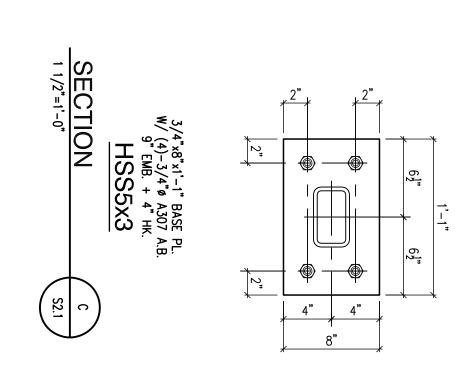

THE STRUCTURAL DRAWINGS ARE NOT A SET OF STAND-ALONE CONSTRUCTION DOCUMENTS. THESE STRUCTURAL DRAWINGS MUST ONLY BE USED IN CONJUNCTION WITH ARCHITECTURAL AND OTHER RELATED DISCIPLINES DRAWINGS. CONTRACTOR TO VERIFY EXISTING CONDITIONS AND CO-ORDINATE BETWEEN THE STRUCTURAL, ARCHITECTURAL, AND OTHER DISCIPLINES DRAWINGS. ANY DISCREPANCY BETWEEN THE DRAWINGS MUST BE BROUGHT TO THE ARCHITECT AND ENGINEERS ATTENTION FOR RESOLUTION PRIOR TO FABRICATION OR CONSTRUCTING THAT PORTION OF THE STRUCTURE.

CONTRACTORS TO COMPLY WITH ALL GOVERNING REGULATIONS AND REQUIREMENTS INCLUDING OSHA REGULATIONS 29 CFR PART 1926 FOR CONSTRUCTION INDUSTRY.

NOTICE: THE STRUCTURAL ENGINEER OF RECORD IS NOT RESPONSIBLE FOR MEANS AND METHODS OF CONSTRUCTION INCLUDING TECHNIQUES OF FABRICATION AND SAFETY AT THE CONSTRUCTION SITE. THE CONTRACTOR IS RESPONSIBLE FOR DESIGN AND INSTALLATION OF ALL TEMPORARY SHORING, BOLTING, WELDING, LUGS, SEAT ANGLES, ETC. TO SAFELY CONSTRUCT THE PROJECT. THE CONTRACTOR IS TO COORDINATE BETWEEN ARCHITECTURAL, STRUCTURAL AND OTHER DISCIPLINES' DRAWINGS AND TO BRING ANY DISCREPANCY TO THE ATTENTION OF THE ARCHITECT AND ENGINEER PRIOR TO GOING AHEAD WITH CONSTRUCTION OF THAT SECTION.

SUMMIT ENGINEERING GROUP LLC
STRUCTURAL ENGINEERS
12118 Fahrpark Lane
St. Louis, MO 63146
Ph: 314-325-4899 Fax: 314-594-9922
Email: eng@summit-engg.com

S2-9-2023

Sheet Title:
FOUNDATION PLAN
Drawn By:


PROPOSED:

CONVENIENCE STORE

HAMBLEN PLAZA

LEE'S SUMMIT, MISSOURI



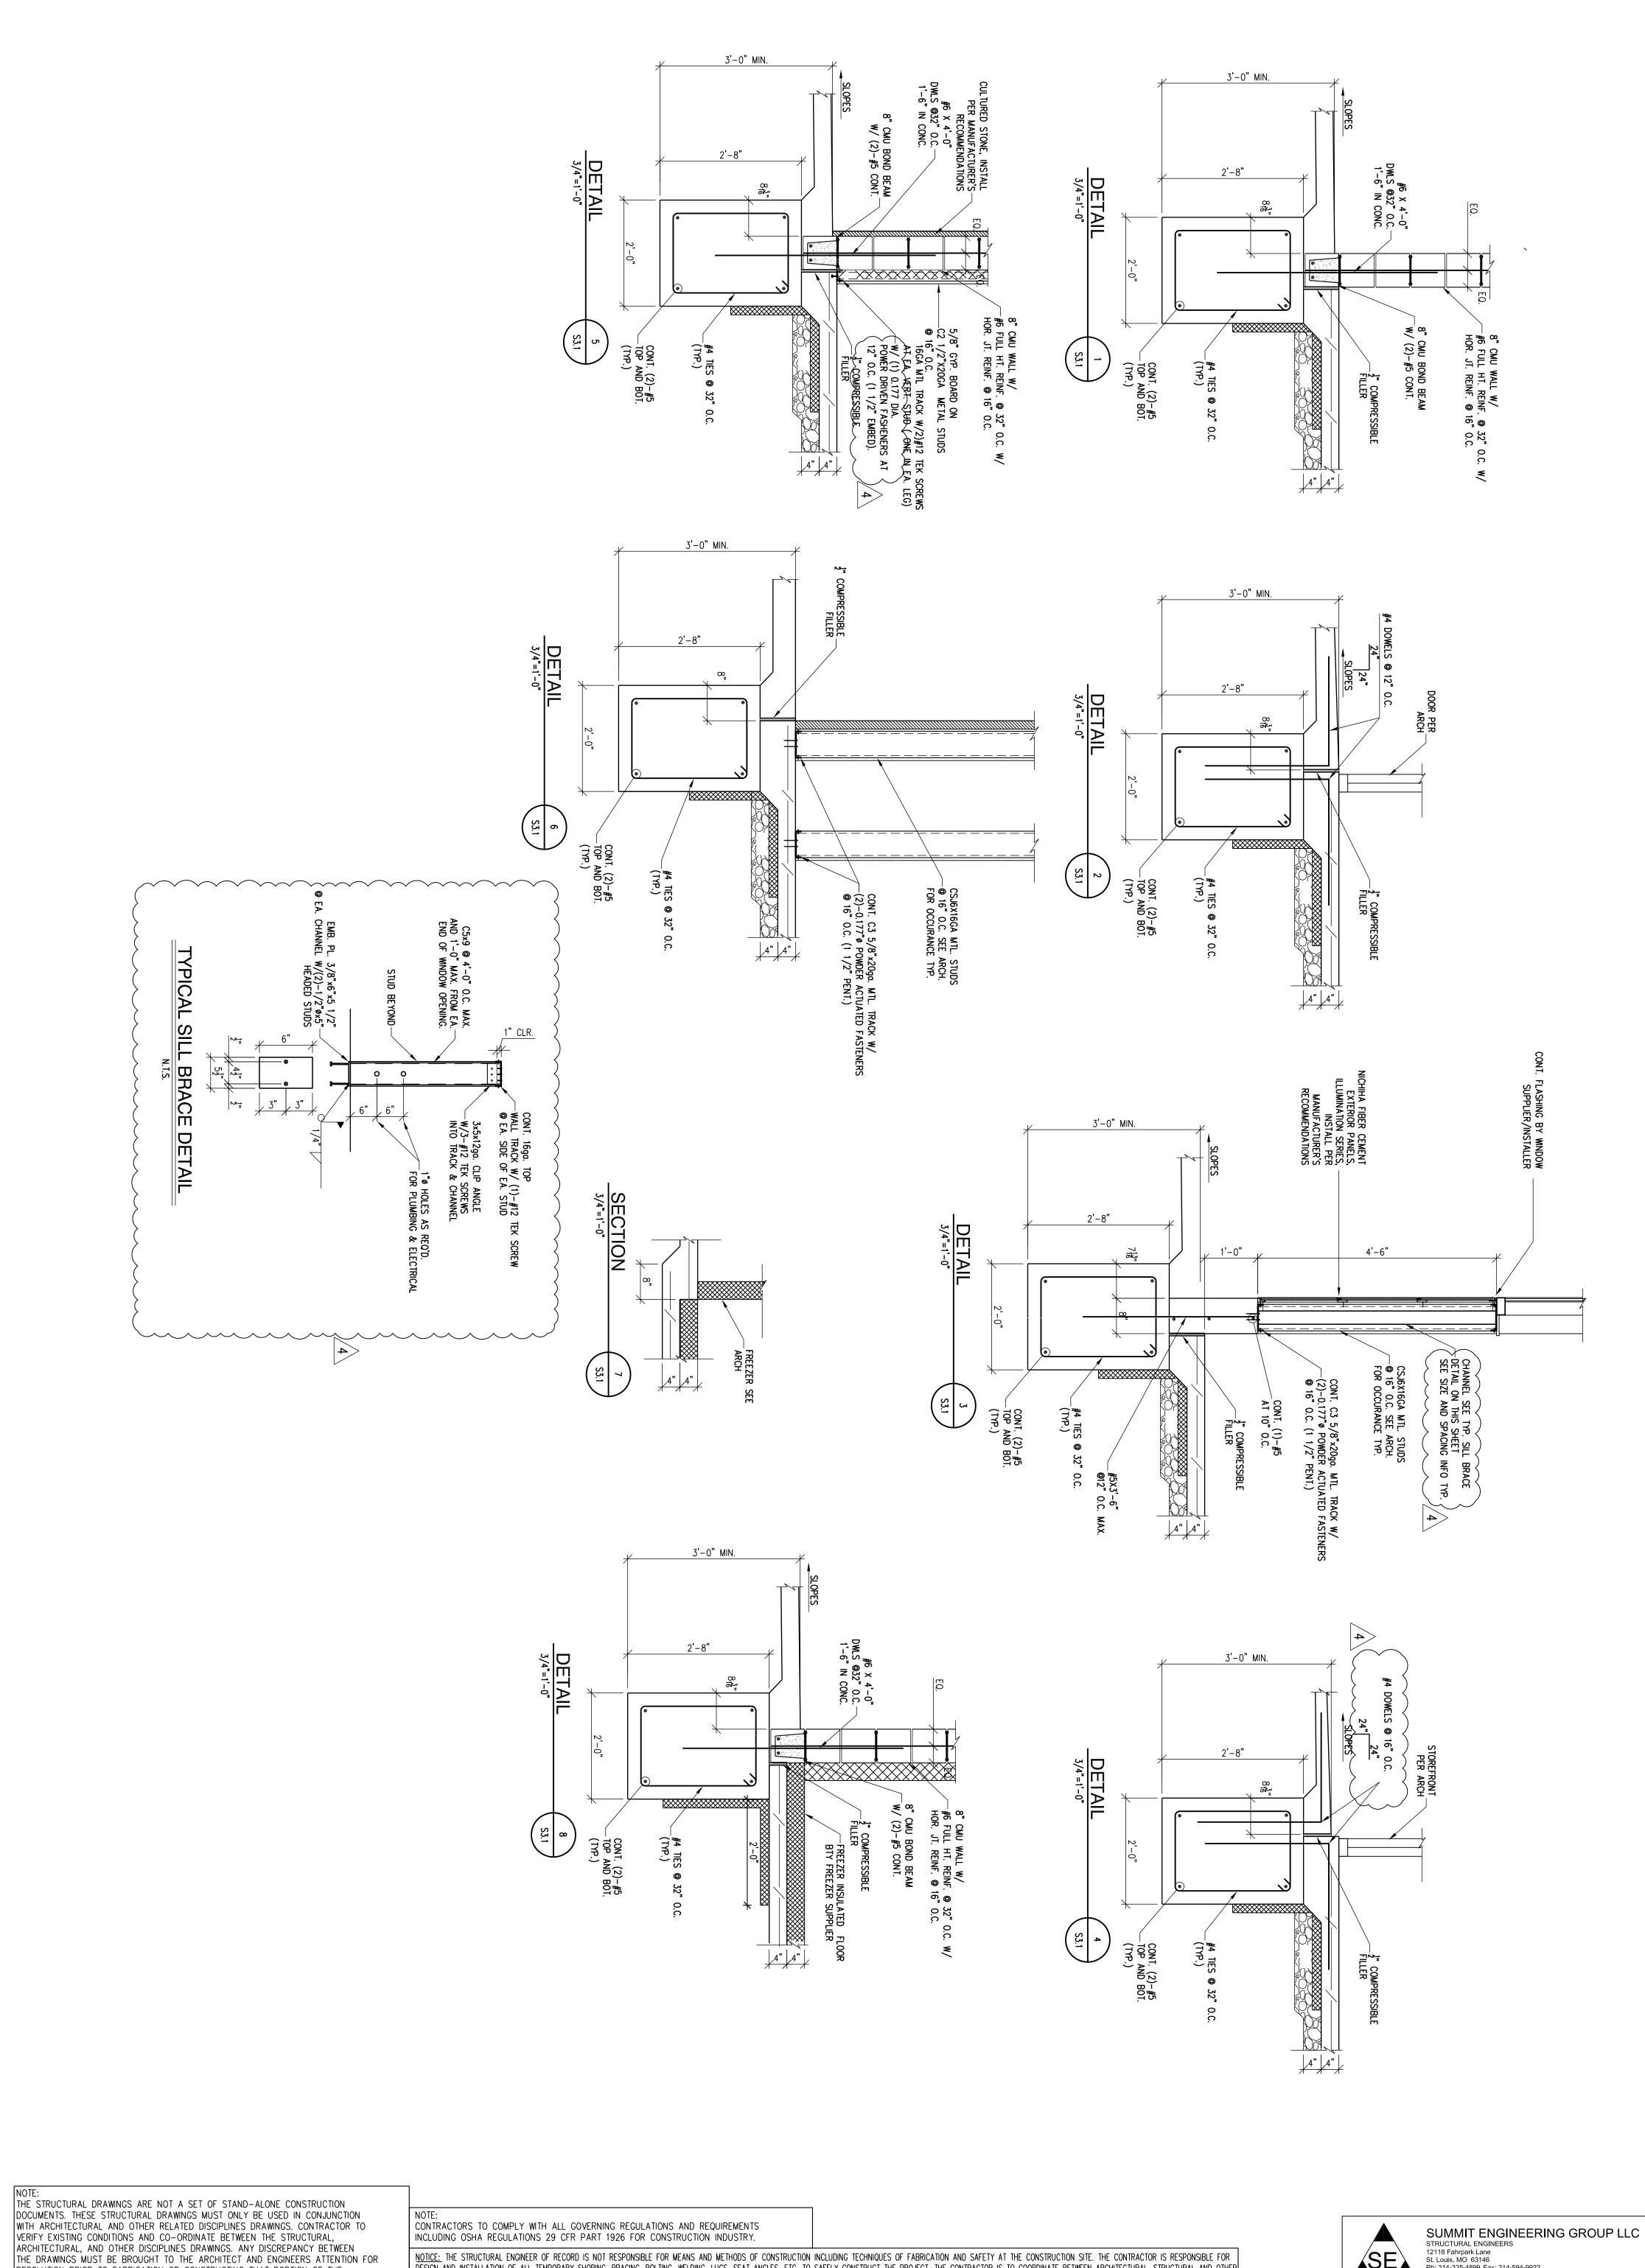

RESOLUTION PRIOR TO FABRICATION OR CONSTRUCTING THAT PORTION OF THE STRUCTURE. Sheet Title:
FOUNDATION
DETAILS
Drawn By:

NOTICE: THE STRUCTURAL ENGINEER OF RECORD IS NOT RESPONSIBLE FOR MEANS AND METHODS OF CONSTRUCTION INCLUDING TECHNIQUES OF FABRICATION AND SAFETY AT THE CONSTRUCTION SITE. THE CONTRACTOR IS RESPONSIBLE FOR DESIGN AND INSTALLATION OF ALL TEMPORARY SHORING, BRACING, BOLTING, WELDING, LUGS, SEAT ANGLES, ETC. TO SAFELY CONSTRUCT THE PROJECT. THE CONTRACTOR IS TO COORDINATE BETWEEN ARCHITECTURAL, STRUCTURAL AND OTHER

DISCIPLINES' DRAWINGS AND TO BRING ANY DISCREPANCY TO THE ATTENTION OF THE ARCHITECT AND ENGINEER PRIOR TO GOING AHEAD WITH CONSTRUCTION OF THAT SECTION

St. Louis, MO 63146 Ph: 314-325-4899 Fax: 314-594-9922 Email: eng@summit-engg.com

PROPOSED:

**CONVENIENCE STORE** 


HAMBLEN PLAZA


LEE'S SUMMIT, MISSOURI

RANGWALA ARCHITECTS

ARCHITECTURE SITE PLANNING

201 S. CENTRAL AVE, SUITE #203, ST. LOUIS, MO-63105 (314) 863-6661 FAX (314) 863-3718

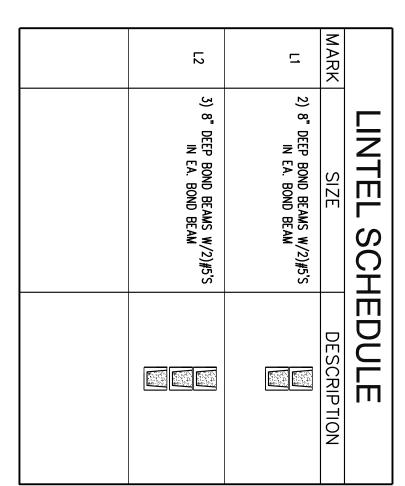

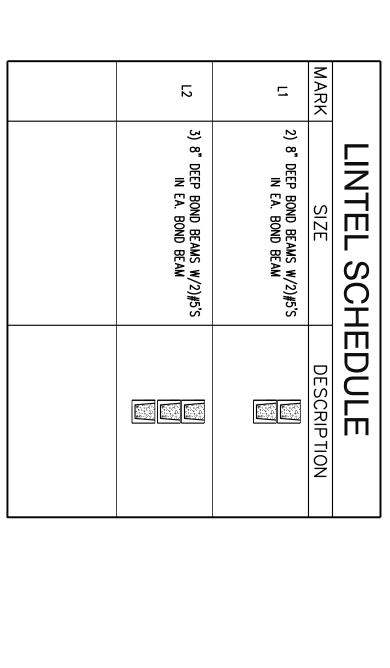

1. ROOF CONSTRUCTION: 1 1/2"x22 go. WIDE RIB PAINTED METAL ROOF DECK. FASTEN TO SUPPORTING STEEL WITH 5/8" & PUDDLE WELDS IN A 36/7 PATTERN WITH (4)-#10 TEK SCREW SIDE LAP CONNECTIONS BETWEEN EACH SUPPORT UNLESS OTHERWISE NOTED. PROVIDE 5/8" & PUDDLE WELDS @ 6" O.C. @ CONTINUOUS ANGLES, STEEL MEMBERS, JOSTS, ETC. @ DIAPHRAGM BOUNDARY CONDITIONS AND ALONG ALL PERIMETER WALLS.

2. TOP OF STRUCTURAL STEEL ELEVATION IS REFERENCED FROM FINISHED FLOOR ELEVATION = 100"-0" AND NOTED THUS (1/S = xxx'-x") ON PLAN.


3. FOR GENERAL NOTES AND TYPICAL DETAILS SEE DRAWINGS \$1.1 TO \$1.3.

4. PROVIDE VERTICAL CONTROL JOINTS IN MASONRY WALLS AT 20"-0" O.C. MAXIMUM UNLESS NOTED OTHERWISE. PROVIDE REINFORCED GROUTED CELL ON BOTH SIDES OF THE CONTROL JOINT. CONTRACTOR SHALL COORDINATE CONTROL JOINT LOCATIONS WITH ARCHITECTURAL DRAWINGS.

5. THE CONCENTRATED LOADS FROM MECHANICAL UNITS AND ROOF SCREENS ARE NOT INCLUDED IN THE SIZE CALLOUT FOR THE JOISTS, THE JOIST MANUFACTURER SHALL DESIGN THE JOISTS AND ROOF SCREENS ARE NOT INCLUDED MICHANICAL UNITS AND ROOF SCREENS ARE NOT INCLUDED MECHANICAL UNITS WITH THE MECHANICAL CONTRACTOR. PROVIDE STEEL ANGLE FRAME UNDER ALL ROOF TOP UNITS AND DECHANICAL CONTRACTOR. PROVIDE STEEL ANGLE FRAME UNDER ALL ROOF TOP UNITS AND OPENING REQUIRED SHAR REQUIRED TEMPORARY BRACING DETAIL AS APPLICABLE. TYPICAL DETAIL. PROVIDE STRUT END JOIST AT EACH COLUMN WHERE JOIST OCCUR SEE TYPICAL DETAIL. PROVIDE STRUT END JOIST AT EACH COLUMN WHERE JOIST OCCUR SEE TYPICAL DETAIL. PROVIDE STRUT END JOIST AT EACH COLUMN WHERE JOIST OCCUR SEE TYPICAL DETAIL. PROVIDE STRUT END JOIST AT EACH COLUMN WHERE JOIST OCCUR SEE TYPICAL DETAIL. PROVIDE STRUT END JOIST AT EACH COLUMN WHERE JOIST OCCUR SEE TYPICAL DETAIL. ROOF FRAMING PLAN 18'-8" MASONRY DIM.

RTU #2 800# 4'-0" SLOPE 1/4" PER FT.  $\left(\begin{array}{c} 2\\ \overline{\text{S5.J}} \end{array}\right)$  TYP. RTU #3 800# 18'-8"
MASONRY DIM.

46'-0"

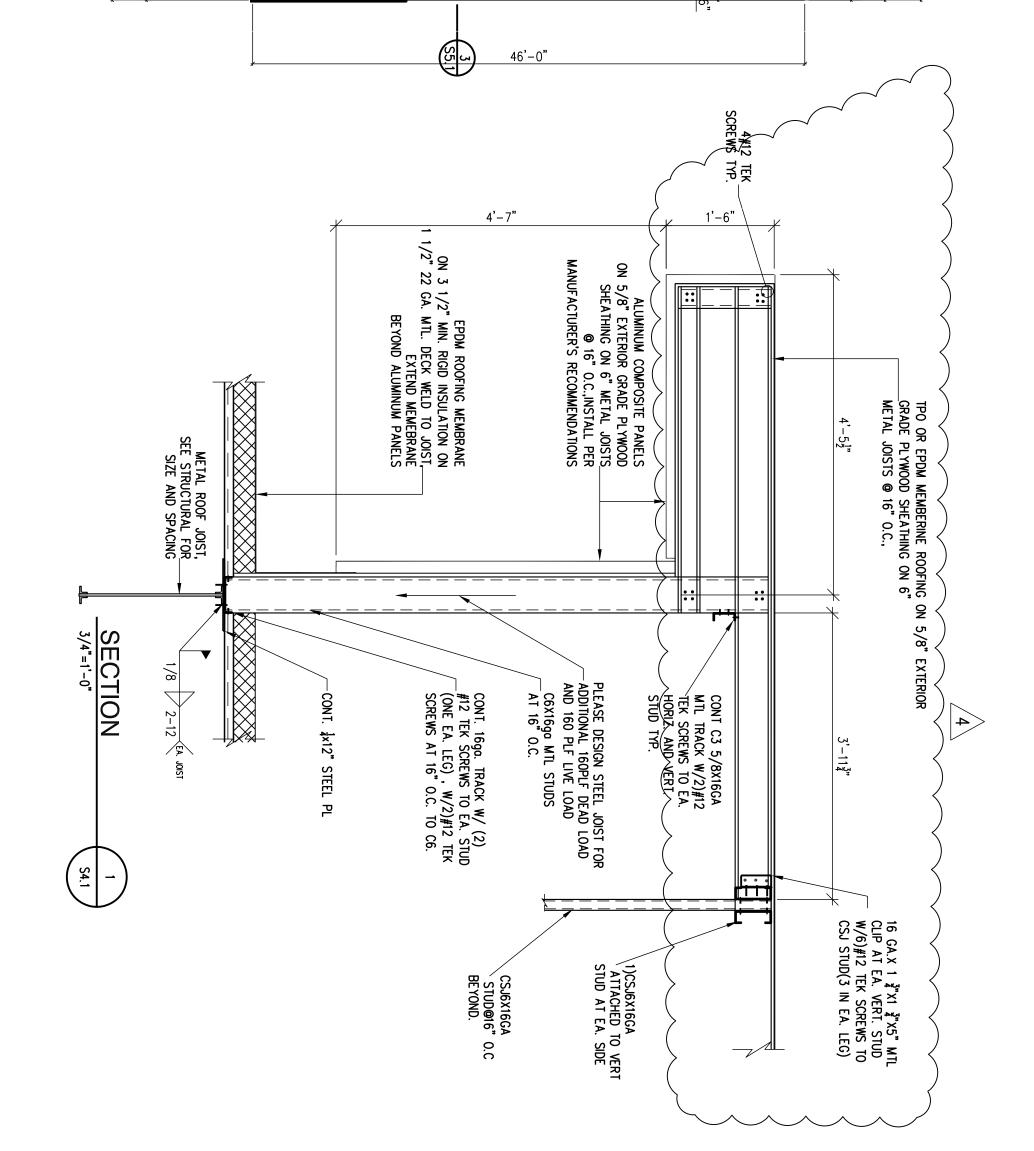

THE STRUCTURAL DRAWINGS ARE NOT A SET OF STAND-ALONE CONSTRUCTION DOCUMENTS. THESE STRUCTURAL DRAWINGS MUST ONLY BE USED IN CONJUNCTION WITH ARCHITECTURAL AND OTHER RELATED DISCIPLINES DRAWINGS. CONTRACTOR TO VERIFY EXISTING CONDITIONS AND CO-ORDINATE BETWEEN THE STRUCTURAL, ARCHITECTURAL, AND OTHER DISCIPLINES DRAWINGS. ANY DISCREPANCY BETWEEN THE DRAWINGS MUST BE BROUGHT TO THE ARCHITECT AND ENGINEERS ATTENTION FOR RESOLUTION PRIOR TO FABRICATION OR CONSTRUCTING THAT PORTION OF THE STRUCTURE.

CONTRACTORS TO COMPLY WITH ALL GOVERNING REGULATIONS AND REQUIREMENTS INCLUDING OSHA REGULATIONS 29 CFR PART 1926 FOR CONSTRUCTION INDUSTRY.

NOTICE: THE STRUCTURAL ENGINEER OF RECORD IS NOT RESPONSIBLE FOR MEANS AND METHODS OF CONSTRUCTION INCLUDING TECHNIQUES OF FABRICATION AND SAFETY AT THE CONSTRUCTION SITE. THE CONTRACTOR IS RESPONSIBLE FOR DESIGN AND INSTALLATION OF ALL TEMPORARY SHORING, BRACING, BOLTING, WELDING, LUGS, SEAT ANGLES, ETC. TO SAFELY CONSTRUCT THE PROJECT. THE CONTRACTOR IS TO COORDINATE BETWEEN ARCHITECTURAL, STRUCTURAL AND OTHER

DISCIPLINES' DRAWINGS AND TO BRING ANY DISCREPANCY TO THE ATTENTION OF THE ARCHITECT AND ENGINEER PRIOR TO GOING AHEAD WITH CONSTRUCTION OF THAT SECTION

SUMMIT ENGINEERING GROUP LLC STRUCTURAL ENGINEERS 12118 Fahrpark Lane St. Louis, MO 63146 Ph: 314-325-4899 Fax: 314-594-9922 Email: eng@summit-engg.com

 $\aleph$ 

 $\mathcal{O}$ 

 $\circ$ 

STAC

1/3

ROOF PLAN

PROPOSED:

**CONVENIENCE STORE** 

HAMBLEN PLAZA

LEE'S SUMMIT, MISSOURI



RANGWALA ARCHITECTS

201 S. CENTRAL AVE, SUITE #203, ST. LOUIS, MO-63105

ARCHITECTURE SITE PLANNING

(314) 863-6661 FAX (314) 863-3718

