

CONSTRUCTION STAKE PLOT PLAN

Ordered by: KC Custom Homes

Description: Lot 133, WOODSIDE RIDGE 1ST PLAT, in Lee's Summit, MO.

Address: 2147 NW Killarney Lane

Lot Area= 14861 sf

RELEASE FOR CONSTRUCTION
AS NOTED FOR PLAN REVIEW
DEVELOPMENT SERVICES
LEE'S SUMMIT, MISSOURI
10/02/2023

Digitally signed by
Brandon Kalwei
DN: CN=Brandon
Kalwei,
OU=Development,
OU=LS Users,
DC=COLS, DC=LOC
Date: 2023.10.02
14:28:13-0500

Brandon Kalwei

Sprinkler heads
noted in orange

TOP FDN
LOT 132
958.5

LAT STA 12+64.08
75.93' LAT
MBFE 951.55


TOP FDN
LOT 134
963.3

Walkout Basement
PROPOSED
TOP FDN 962.7
GAR FLR 962.2
BAS FLR 953.0
LOWER BAS FLR 947.0
GRINDER PUMP
REQUIRED

MH STA 12+81.1
TOP 960.82
INV 947.12

MBOE
REAR LEFT 935.28
REAR RIGHT 938.53
FRONT LEFT 960.36
FRONT RIGHT 961.28

NW Killarney Lane

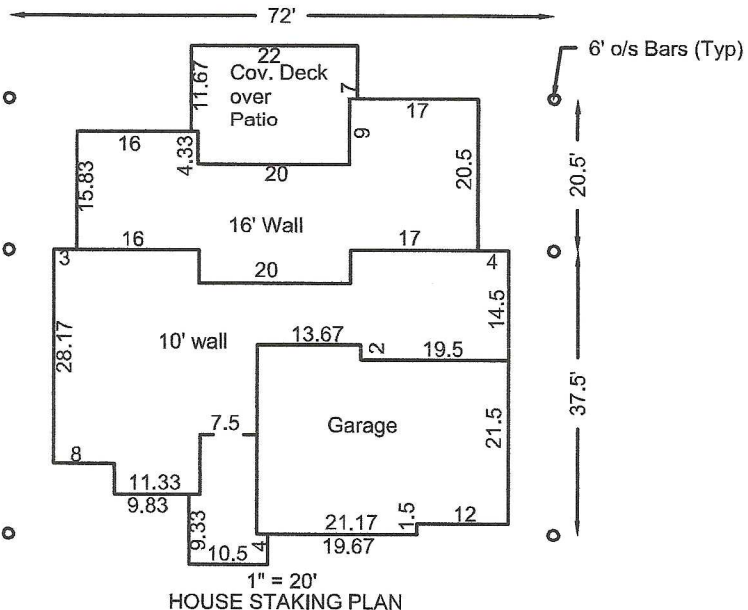

HOUSE STAKING PLAN

→ = DRAINAGE PATTERN

CONSTRUCTION ENGINEERING SERVICES, INC.

16810-C East 40 Highway
Independence, MO 64055
(816)478-2323

lee@engineeringkc.com
SCALE: 1"=30'

DATE: 07-07-2023
JOB NO: 17899

LEE BODENHEIMER, L.S.
Land Surveyor

