

April 30, 2024

Mr. Brandon Kalwel

Planning & Building Inspections

Lee's Summit, Missouri



Architecture, Graphics
Management & Planning
1119 NE Clubhouse Circle
Lee's Summit, MO 64086
Phone (816) - 525-8918
E-Mail Bruce@AGMPARCH.com

Plan Review Discrepancy Report Reply Letter

Sequoia Orchard Park, Lee's Summit, MO Permit # PRES20240700

BUILDING Responses will be in order of the Comments Provided for In the Report Dated April 25

ITEM #1 The square footages are placed on the top of sheet A102 and are in both Gross and Net areas and I am sending an updated Application Form that will match the areas together from what the final plans show.

ITEM #5 I have found eight locations of places where I changed the 2012 date to the correct 2018 code on Sheet S100. All have been Clouded.

PLOT PLAN REVIEW

ITEM #1 I have added the proper plot plan that you send me on a SP-1 Sheet. With additional information on that sheet.

If you have any additional problems or need additional information please contact me directly as soon as possible so I can resolve your issues as fast as possible.

Respectfully

Bruce Best

RELEASE FOR CONSTRUCTION
AS NOTED FOR PLAN REVIEW
DEVELOPMENT SERVICES
LEE'S SUMMIT, MISSOURI

05/02/2024

general notes structural

general

- the contractor shall verify dimensions and conditions of the job and site and notify the architect of any discrepancies or difficulties that might effect the cost, coordination or safety of the project prior to proceeding.
- the general contractor shall coordinate all disciplines, and shall verify size and locations of all openings shown on architectural drawings with dimensions call for on, electrical, mechanical structural and plumbing drawings. all errors, discrepancies, or other difficulties shall be called to the attention of the architect for resolution prior to proceeding.
- all designs and construction techniques shall meet the requirement of the international building code as amended by local building code officials
- these drawing are for use on a single specific building project only. any other use is not authorized without written permission signed and sealed by a principal of agmp.

foundation

- spread footing, grade beams and retaining walls are designed to bear on engineered fill or undisturbed soil capable of sustaining a minimum 2,000 psf.
- retaining structures shall be designed for a lateral load of 40 pcf or the equivalent fluid pressure.
- the general contractor shall provide for the deflection of surface water or ground water seepage from all foundation excavations until forms have been striped or exterior foundation wall water proofing has been applied.
- no concrete footing or foundations shall be placed on standing water, ground softened from excess water or frozen ground.
- all foundation excavations shall be inspected for suitable bearing capacity prior to placement of steel and or concrete. any indications of organic material, trash or other debris shall call for immediate inspection by a soils engineer qualified and approved by the architect or structural engineer.

structural steel

- all structural and misc. steel shall be astm a36 grade steel fabrication and erection shall be in accordance with the latest edition of the aisc manual of steel construction.
- in case of discrepancies between structural steel plans and plans of other trades, such discrepancies shall be call the attention of the architect or structural engineer for resolution immediately, prior to fabrication if possible.
- all steel connections shall be welded or bolted. all beam connection shall be designed for the indicated reactions or at least 1/2 of the beam shear capacity, whichever is greater
- all bolts not otherwise called out shall be 3/4" round ab25n.
- all welding shall conform to american welding society recommendations.
- all anchor bolts shall be 1/2" diameter astm a307, unless otherwise noted.


concrete

- all concrete except exterior flatwork shall develop a minimum compressive strength of 3,000 psi at 28 days, with not less than 500 pounds of cement per cubic yard of concrete regardless of strengths obtained, not over 6-1/2 gallons of water per 100 pounds of cement and not more than a 4" slump.
- concrete for exterior flatwork shall have a minimum compressive strength of 4,000 psi at 28 days, with not less than 600 pounds of cement per cubic yard of concrete regardless of strengths obtained, not over 5 gallons of water per 100 pounds of cement and not more than a 4" slump. provide all exterior flatwork cement with ± 1% air entrainment and additional fibermesh reinforcing.
- all concrete is reinforced concrete unless specifically called out as unreinforced. reinforce all concrete not otherwise shown with the same steel as in similar sections or areas. any details not shown shall be detailed per aci 315 and meet the requirements of aci 318, current edition.
- all reinforcing steel shall conform to the requirements of astm a615 grade 60 steel except stirrups and ties, which shall be grade 60 bendable steel.
- clear minimum coverage of concrete over reinforcing


concrete placed against earth	3"
formed concrete against earth	2"
slabs or joists	1"
beams or columns	1-1/2"
other	2"

 all coverage shall be nominal (2) bar diameter minimum.
- all reinforcing dowels shall be the same size and spacing as main reinforcing bars of adjoining members and shall be lap spliced 40 bar diameters or 24" minimum unless noted otherwise.
- at corners of all walls, beams and grade beams supply corner bars extending 40 bar diameters or 24" minimum each direction. in outside face of wall, match size and spacing of horizontal bars, where there are no vertical bar in outside face of wall supply (3)- #4 vertical support bars for corner bars.
- bars marked continuous and all vertical steel shall be lapped 40 bar diameters or 2'-0" minimum as splices and construction joints, unless shown otherwise. splice top bars near mid span and bottom bars over supports, unless otherwise noted.
- at all holes in concrete walls and slabs, add (2)-#5 bars of length equal to opening dimension plus 60 bar diameters at each of four sides. also add (2) -#5 x 5'-0" long diagonally at each corner of the hole.
- openings in 8" thick walls and slabs shall be similarly reinforced but with (1)-#5 or for installation of this misc. reinf.)
- accessories shall be as specified in the latest edition of the aci detailing handbook. maximum accessory spacing shall be 4'-0" o.c. all accessories shall be plastic coated or shall have plastic coated feet.
- all slabs and stairs nor shown otherwise shall be reinforced with 6 x 6 - 10/10 wwf. all exterior porches and stoops not otherwise detailed may be constructed in any standard manner, solid or hollow, but must be reinforced with 6 x 6 - 10/10 wwf. porches shall be doweled to adjacent walls or grade beams with #4 bars at 12" o.c., hooked or embedded 40 bar diameters in to these members. slope porches 1/8" per foot for drainage unless noted otherwise.


RELEASE FOR CONSTRUCTION
AS NOTED FOR PLAN REVIEW
DEVELOPMENT SERVICES
LEE'S SUMMIT, MISSOURI
05/02/2024

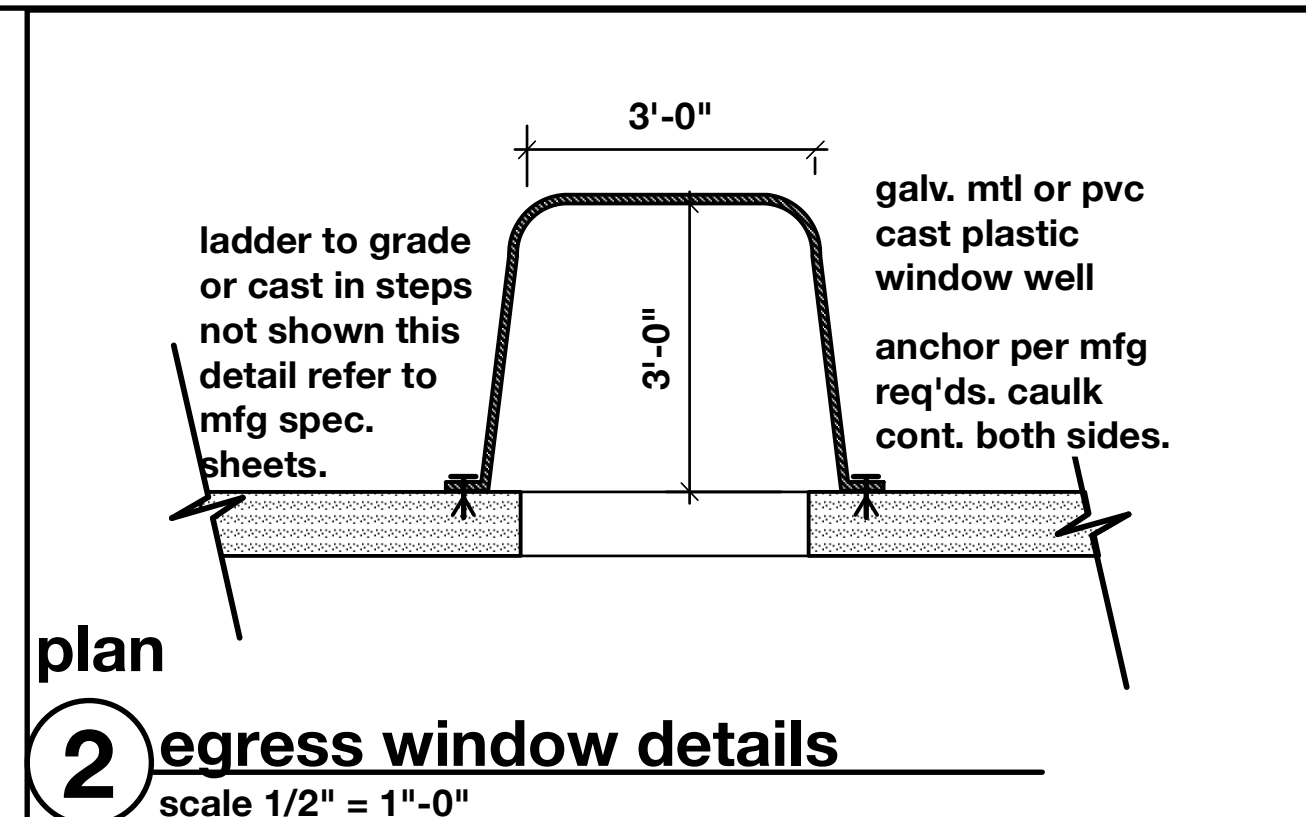

2 egress window details
scale 1/2" = 1'-0"

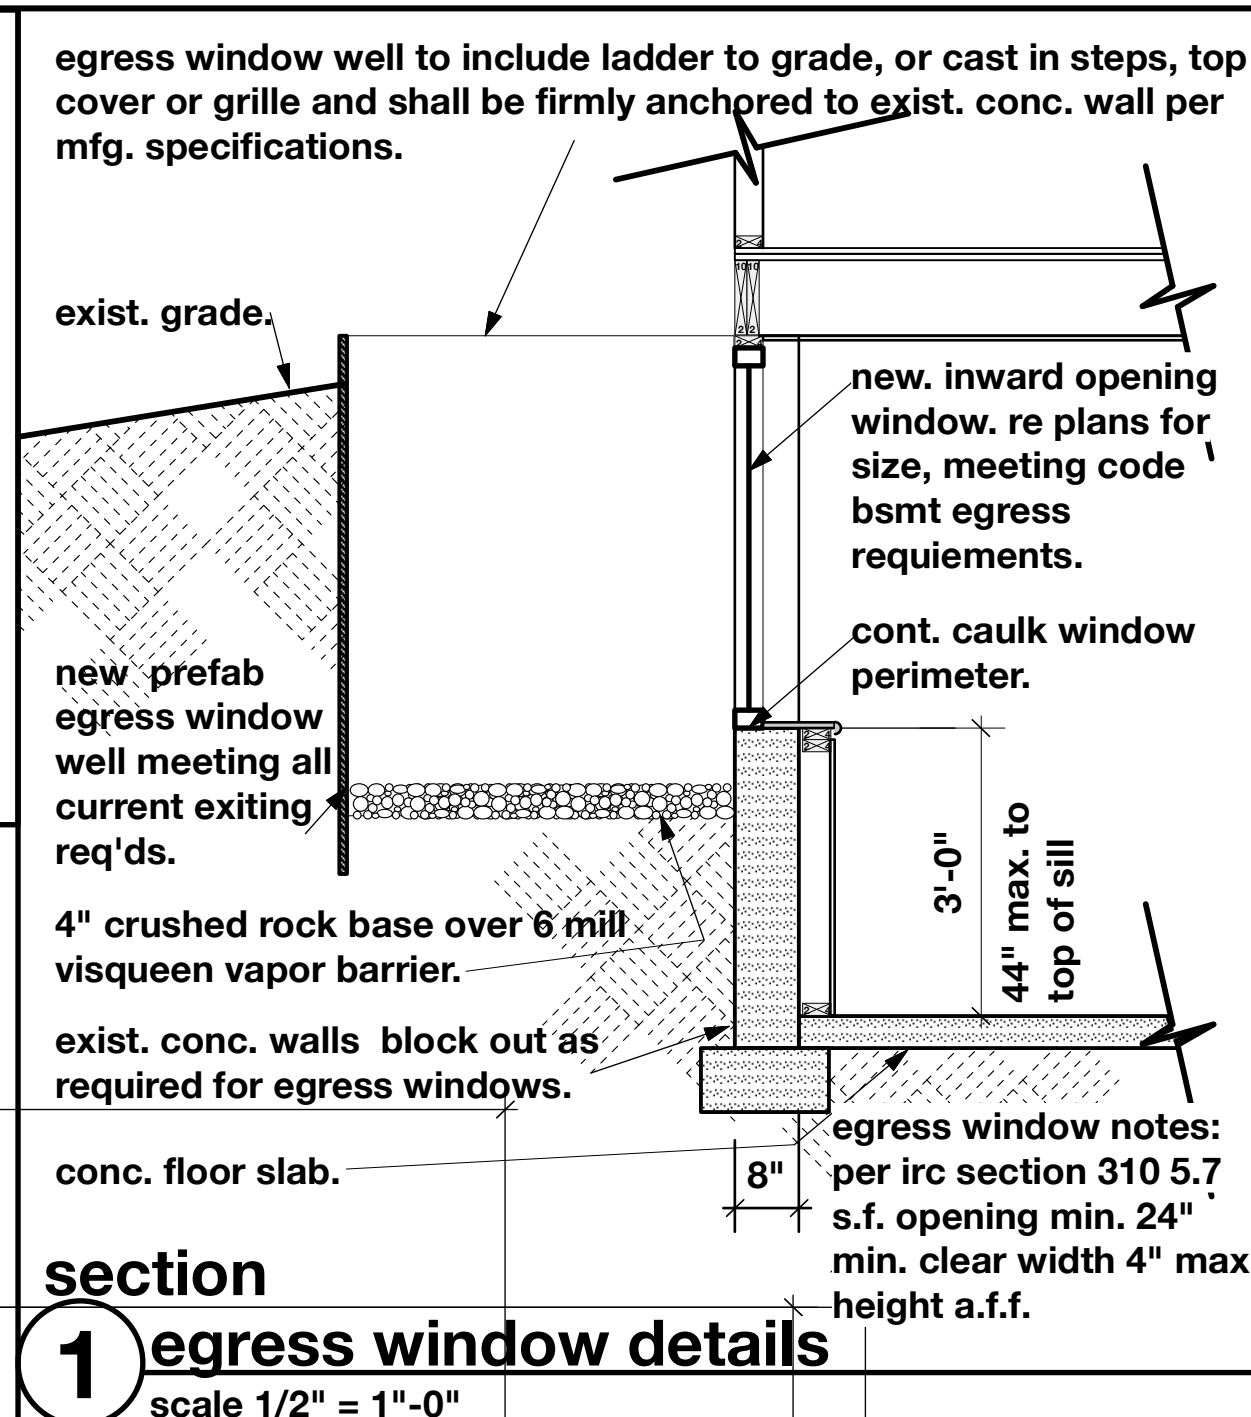

1 egress window details
scale 1/2" = 1'-0"

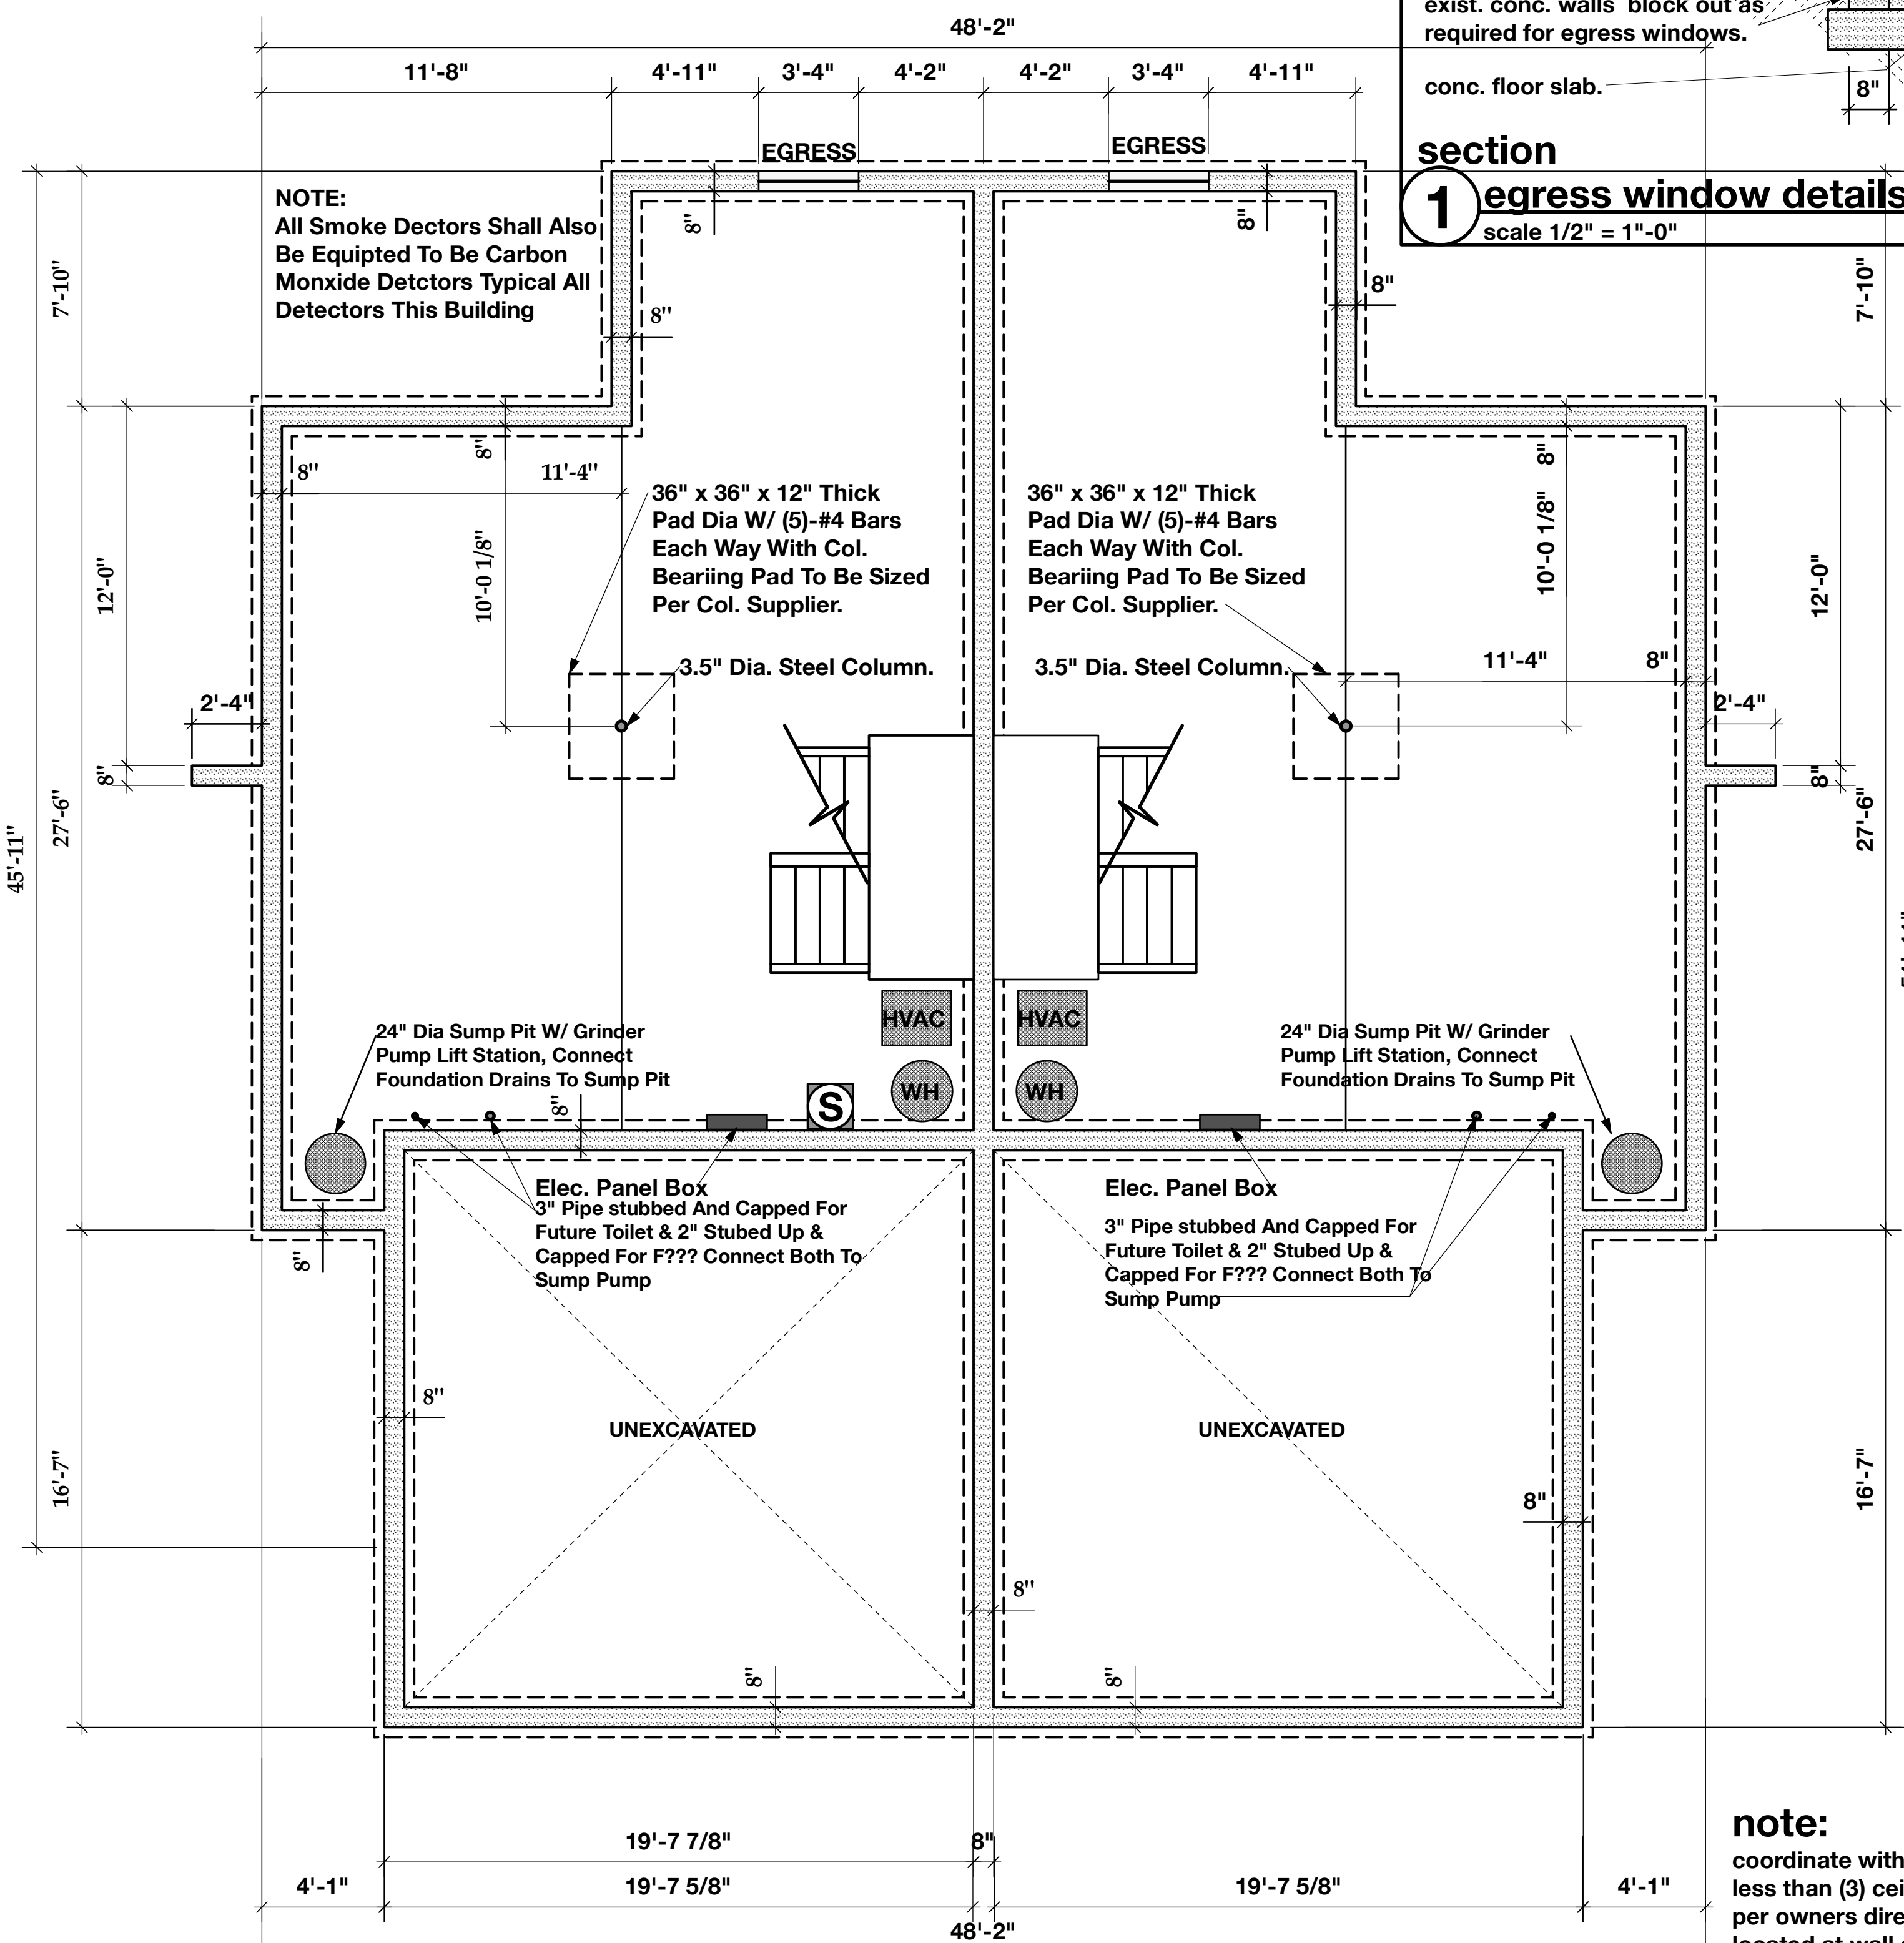

BASEMENT FLOOR PLAN
Scale 1/4" = 1'-0"

note:
this drawing is for general layout information only. refer to the S-1 structural sheet for reinforcing, thicknesses and pad sizes

note:
coordinate with owner & provide not less than (3) ceiling light fixtures located per owners direction, provide switch located at wall at bottom of stairs.

Architecture Graphics Management & Planning

Independence Office
Roy Browne 816-228-1111
Internet - Roy@AGMPARCH.com

Lee's Summit Office
Bruce Best 816-525-8918
Internet - Bruce@AGMPARCH.com

Roy Browne Architect of Record

SEQUOIA DUPLEX ALT #1
205 & 207 Orchard Court
LEE'S SUMMIT, MO


This Drawing And Information Contained Within Is Provided As An Instrument Of Service By The Architect. And Is Intended For Use On This Project Only. This Drawing Remains The Property Of The Architect And Shall Be Returned To Him Upon Completion Of The Construction Work. All Drawings, Specifications, Ideas, Designs And Arrangements Appearing Herein Constitute The Original And Unpublished Work Of The Architect. Any Reproduction, Use Or Disclosure Of The Proprietary Information Contained Herein Without The Prior Written Consent Of The Architect Is Strictly Prohibited.
© AGMP 2023



A100

1	Date	APRIL 26, 2024
2	REVISION	
3	REVISION	
4	REVISION	
5	REVISION	

BUILDING AREAS GROSS - per unit.	BUILDING AREAS NET - per unit.	COMBINED AREAS NET - per unit.
First Floor Garage 346.0 Sq. Ft.	First Floor Garage 346.0 Sq. Ft.	First Floor Garage 692.0 Sq. Ft.
Basement 704.0 Sq. Ft.	Basement 600.0 Sq. Ft.	Basement 1200.0 Sq. Ft.
First Floor Living 641.0 Sq. Ft.	First Floor Living 546.0 Sq. Ft.	First Floor Living 1092.0 Sq. Ft.
Second Floor 953.0 Sq. Ft.	Second Floor 864.0 Sq. Ft.	Second Floor 1728.0 Sq. Ft.
Total Living Area = 2644.0 Sq. Ft.	Total Living Area = 1678.0 Sq. Ft.	Total Living Area = 4712.0 Sq. Ft.

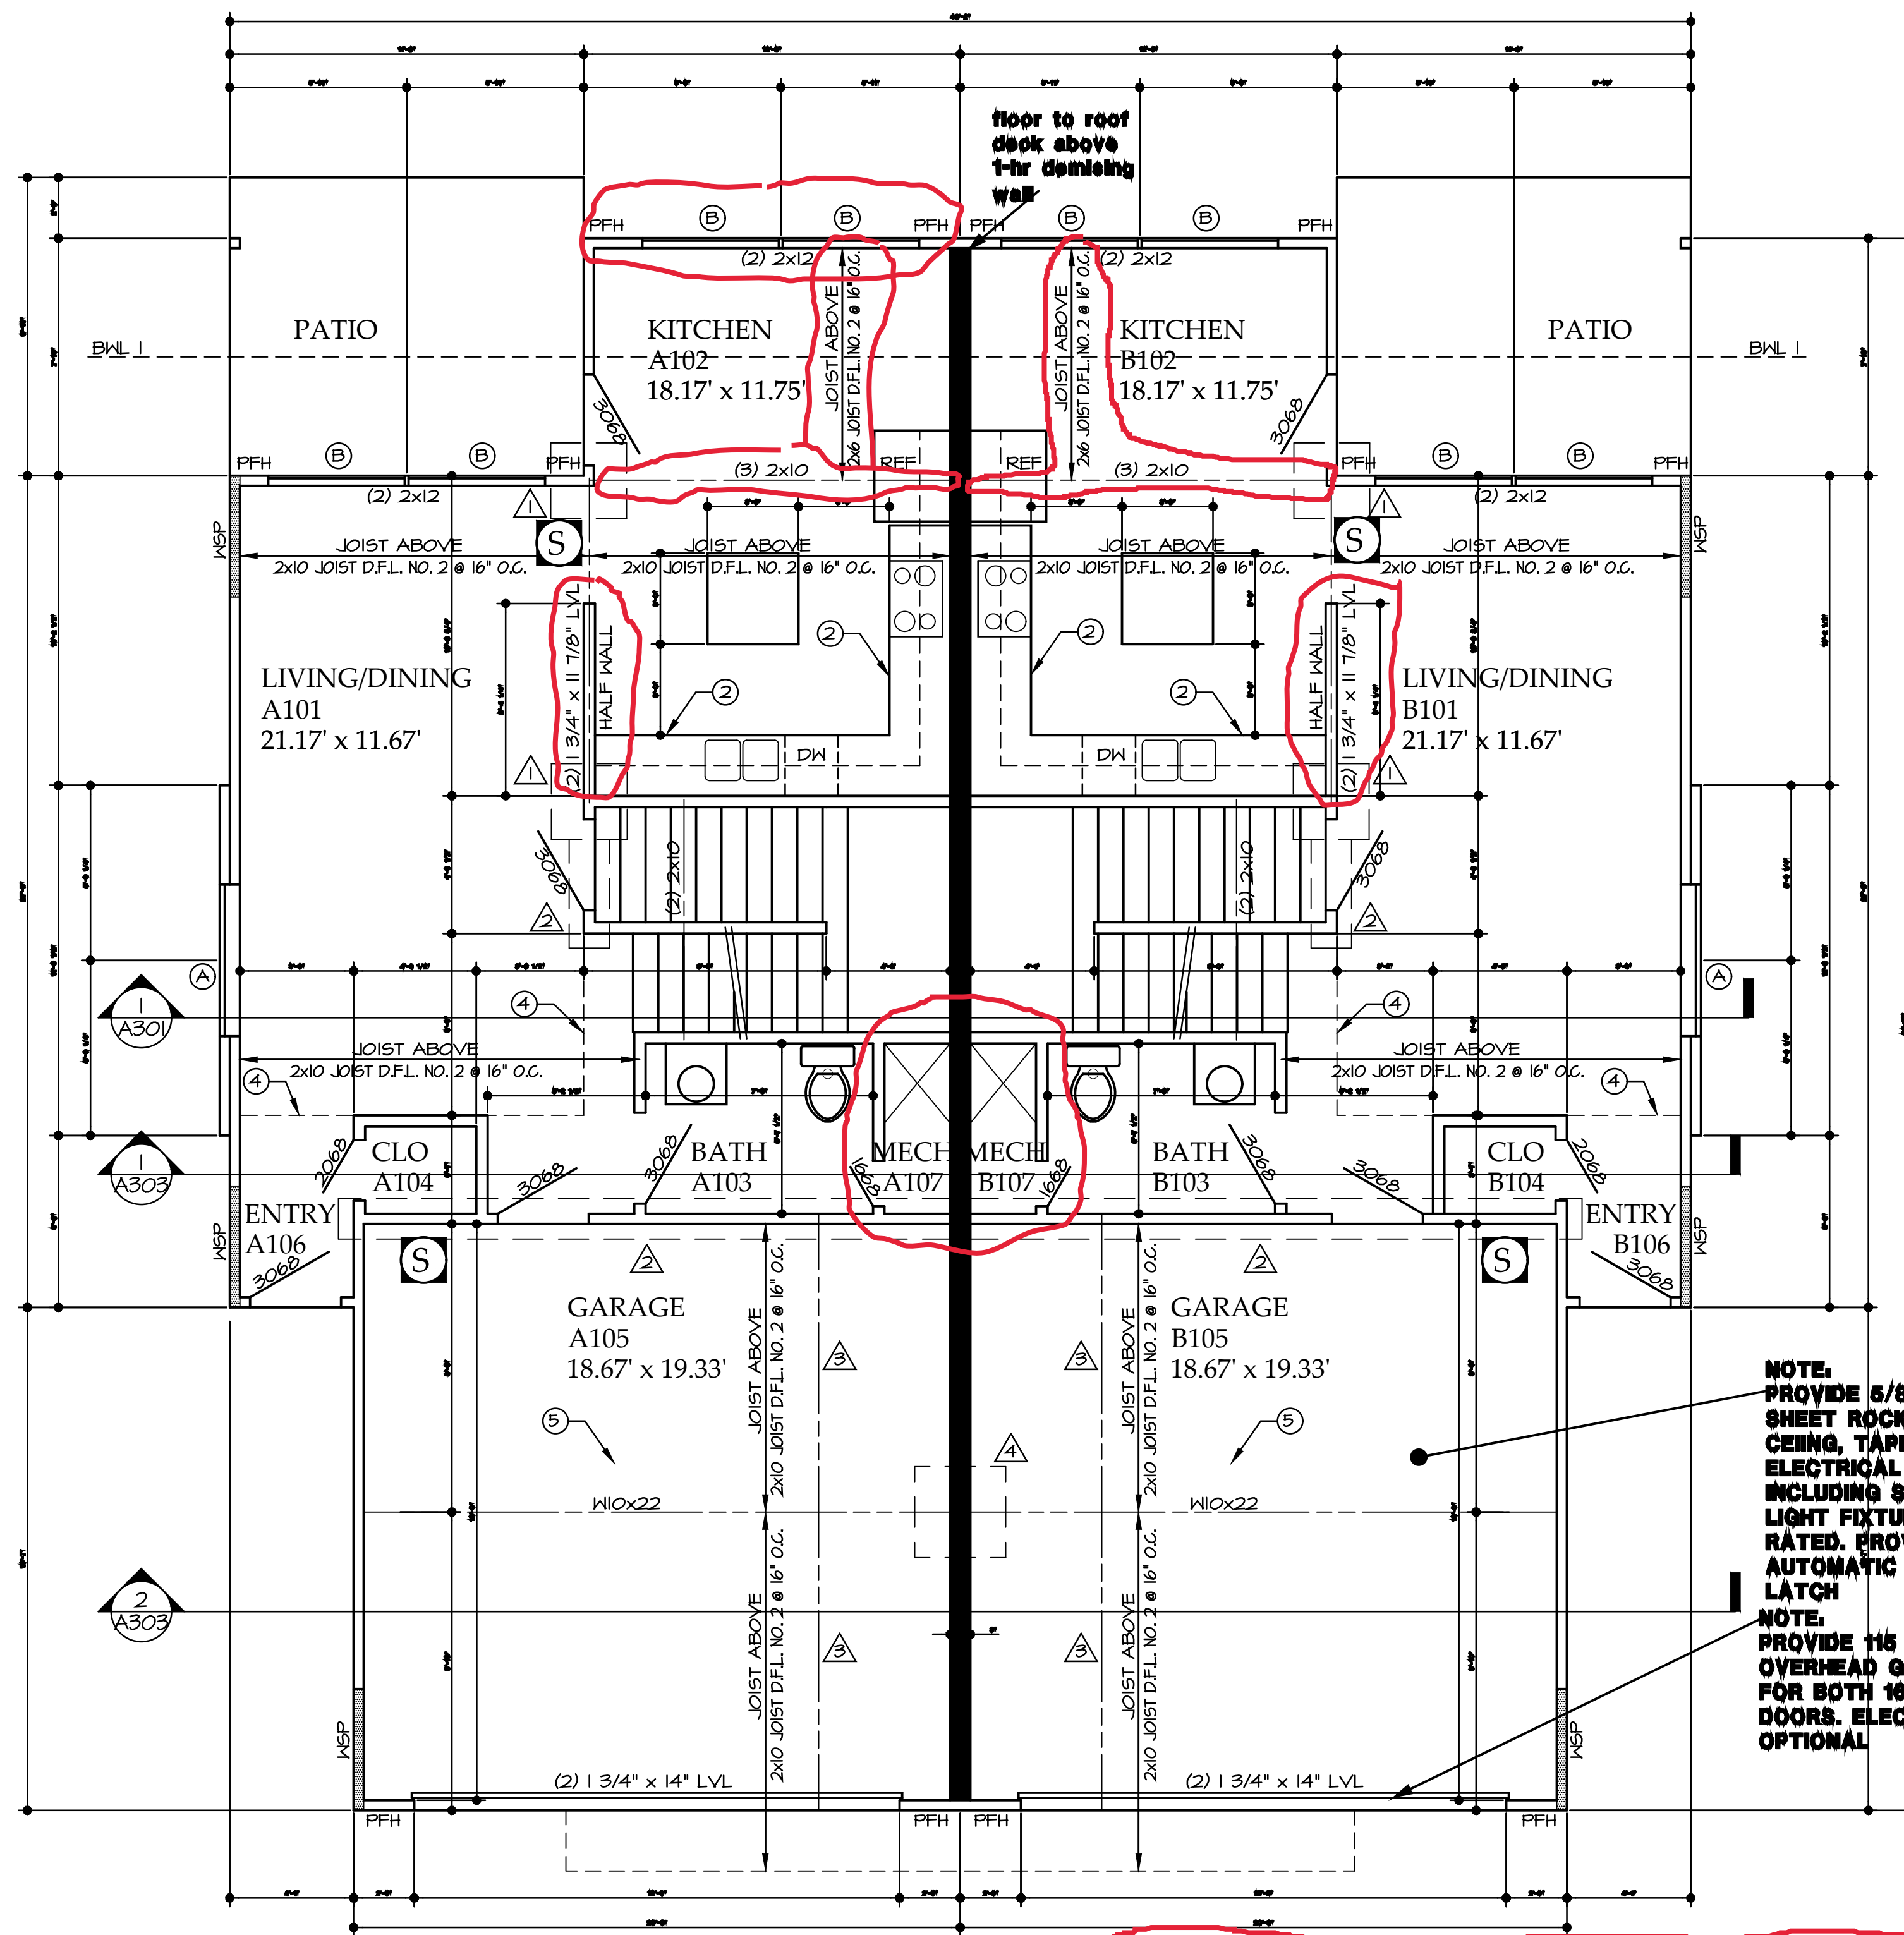

NOTE: PROVIDE 5/8" TYPE 1X FIRE CODE SHEET ROCK ON ALL WALLS & CEILING, TAPE, SAND & PAINT. ALL ELECTRICAL PENETRATIONS INCLUDING SWITCHES, OUTLETS AND LIGHT FIXTURES SHALL BE 1HR. RATED. PROVIDE 20 MIN. DOOR W/ AUTOMATIC CLOSER LOCK AND LATCH.

NOTE: PROVIDE 116 MPH SEGMENTED OVERHEAD GARAGE DOORS TYPICAL FOR BOTH 16' WIDE OR 7' WIDE DOORS. ELECTRONIC CLOSER OPTIONAL.

S This symbol denotes smoke detector locations on all sheets. NOTE All smoke detectors shall be a combination carbon monoxide and smoke detectors, typical all locations noted on these plans.


WINDOW THERMAL PROPERTIES

MANUFACTURER: BUILDER'S VINYL W/ LOW-E
 PRODUCT LINE: U-FACTOR: 0.32
 SHGC: 0.35


PLAN MARK	CONFIGURATION	WIDTH	HEIGHT	COMMENTS
A	SINGLE - SLIDER WINDOW	5'-0"	3'-2"	
B	SINGLE - SLIDER WINDOW	4'-5"	5'-0"	
C	SINGLE - CASEMENT WINDOW	3'-0"	5'-0"	
E	SINGLE - SLIDER WINDOW	2'-0"	2'-0"	EGRESS

WINDOW GENERAL NOTES


- EGRESS WINDOWS SHALL COMPLY WITH SECTION 310 OF THE IRC.
- WINDOWS SHALL HAVE FALL PROTECTION PER IRC 312.2 WHERE NEEDED.
- WINDOWS, DOORS, AND OTHER GLAZING WILL COMPLY WITH THE REQUIREMENTS OF SECTION 308 OF THE IRC FOR SAFETY GLAZING.

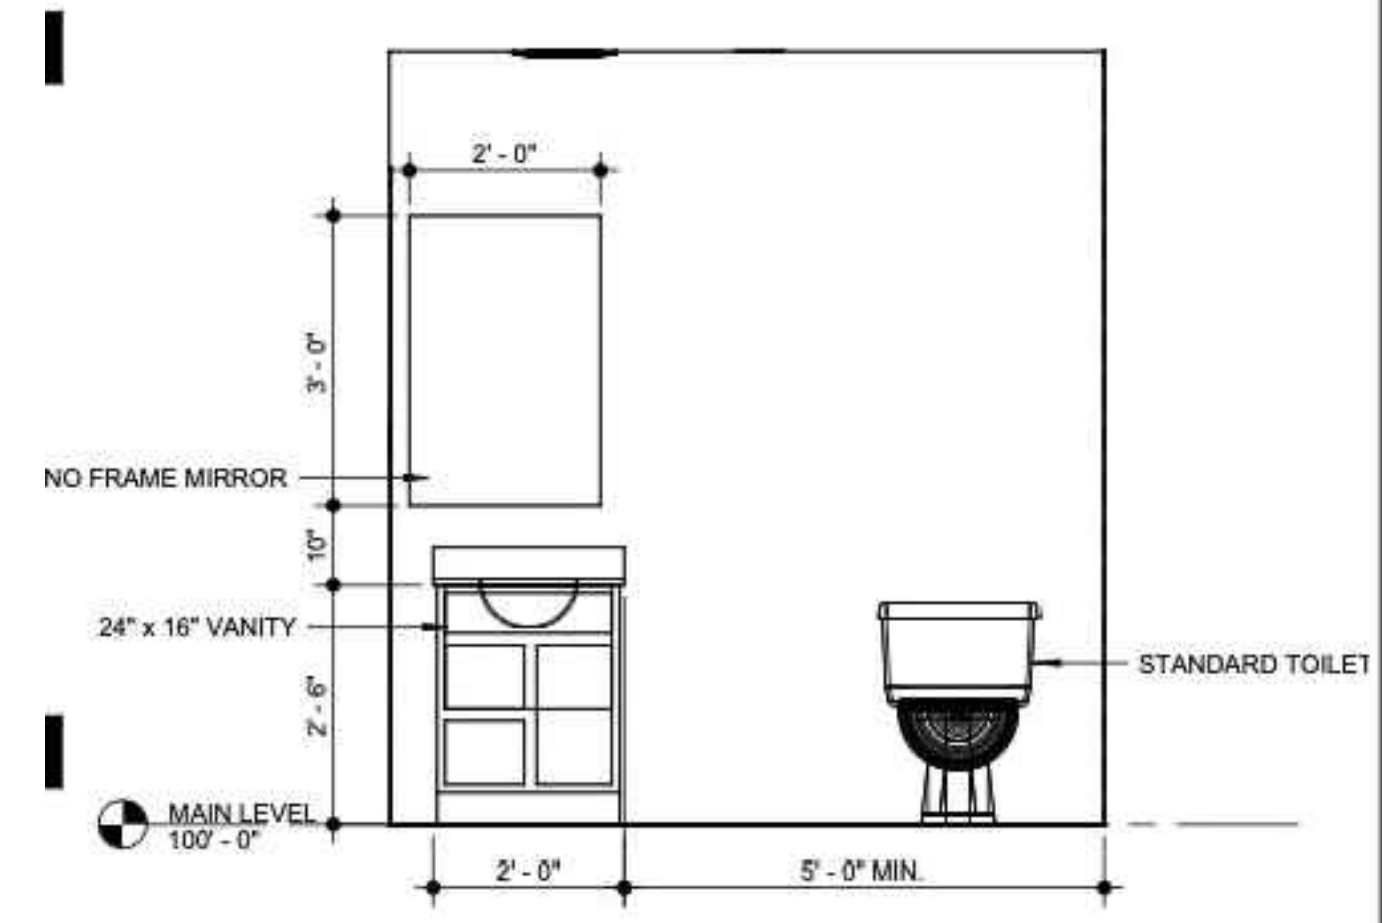


2 interior north main bath elevation
1/2" = 1'-0"

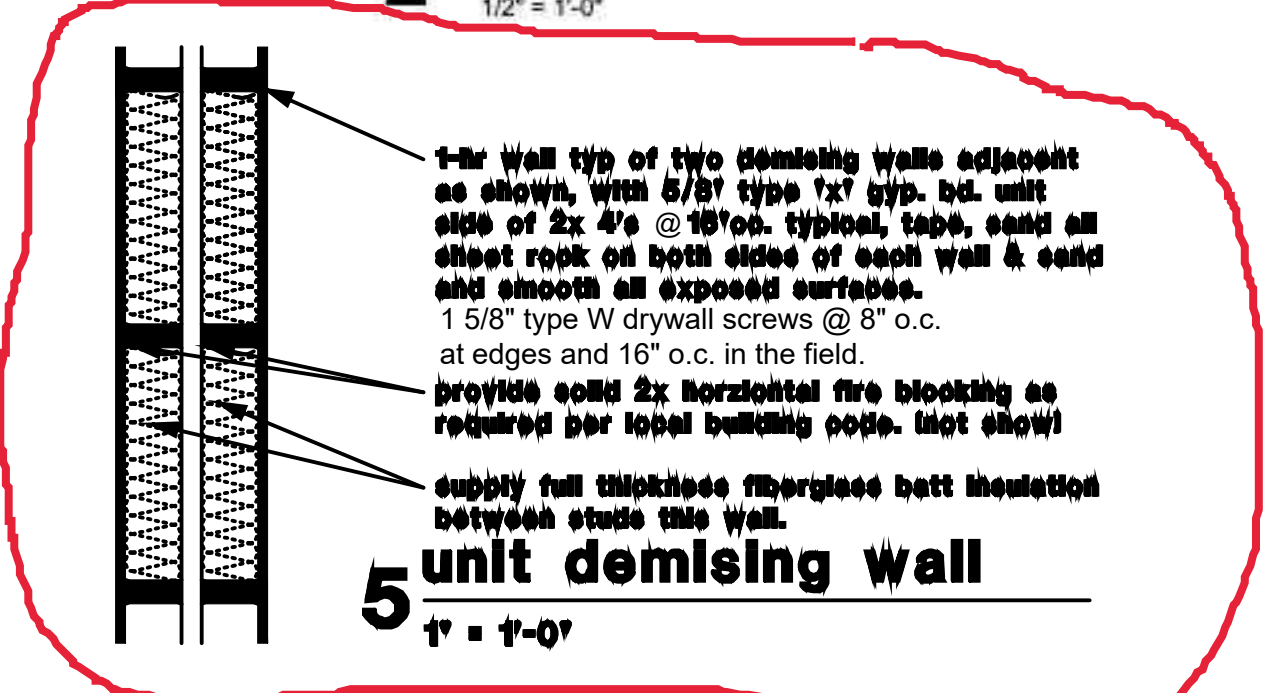

5 unit demising wall
1" = 1'-0"

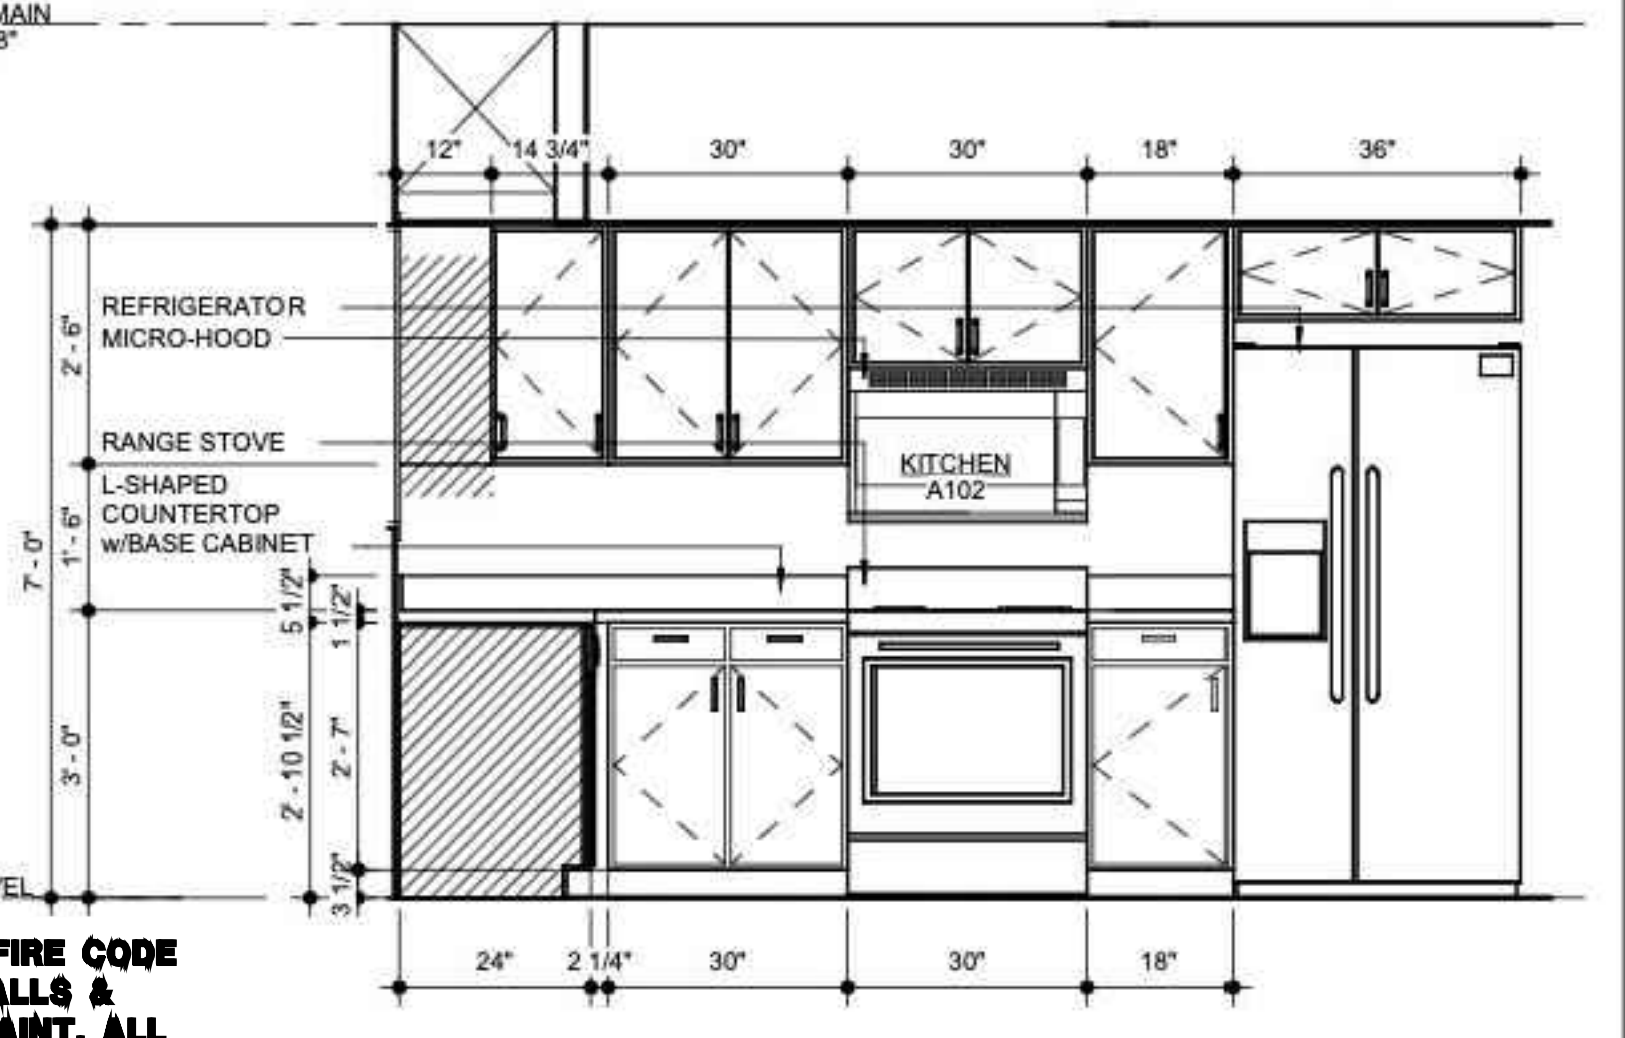

3 interior east main kitchen elevation
1/2" = 1'-0"

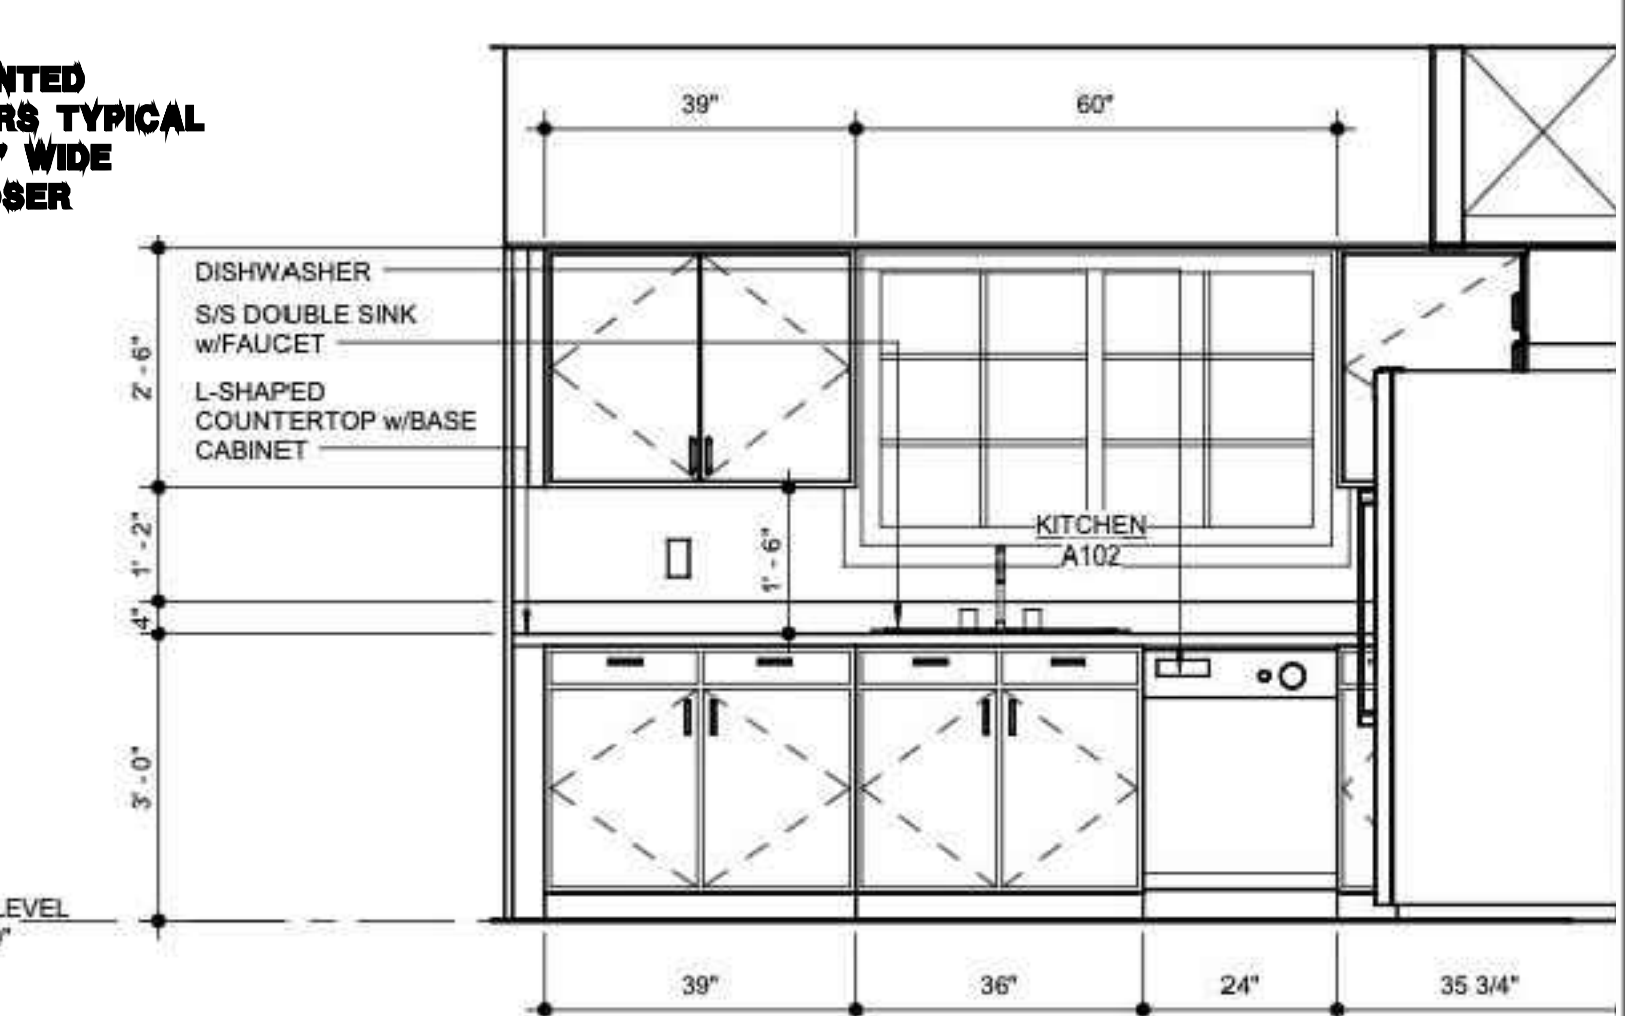


4 interior north main kitchen elevation
1/2" = 1'-0"

general notes

- GENERAL CONTRACTOR SHALL NOTIFY THE ARCHITECT OF ANY DISCREPANCIES BETWEEN SPECIFICATIONS AND DRAWINGS. BETWEEN MULTIPLE SPECIFICATION SECTIONS AND/OR BETWEEN MULTIPLE DRAWINGS. THE ARCHITECT WILL DETERMINE WHICH SHALL GOVERN.
- GENERAL CONTRACTOR SHALL VERIFY ALL DIMENSIONS AND CONDITIONS OF THE JOB SITE INCLUDING UTILITIES AND EXISTING STRUCTURES PRIOR TO BEGINNING WORK AND REPORT ANY DISCREPANCIES TO THE ARCHITECT.
- GENERAL CONTRACTOR SHALL BE RESPONSIBLE FOR STABILITY OF THE STRUCTURE DURING CONSTRUCTION INCLUDING ALL SHORING AND BRACING REQUIRED TO RESIST REQUIRED VERTICAL AND LATERAL FORCES.
- ALL ARCHITECTURAL FLOOR PLAN DIMENSIONS ARE FROM FACE OF CONCRETE OR FACE OF STUD.
- INTERIOR WALLS ARE TO BE COMPRISED OF 2x4 STUDS AT 16" O.C. MAX WITH 1/2" DRYWALL EACH SIDE UNLESS NOTED OTHERWISE.
- MECHANICAL/PLUMBING CONTRACTOR TO COORDINATE EACH OTHERS' WORK WITH ARCHITECTURAL PLANS AND TO NOTIFY ARCHITECT OF NEED FOR SOFFITS OR CHASES FOR INSTALLATION OF DUCTWORK OR PLUMBING.
- ELECTRICAL CONTRACTOR TO INSTALL OUTLETS AS REQUIRED PER CODE. VERIFY ALL LOCATIONS WITH OWNER PRIOR TO BEGINNING DRYWALL.
- ALL EXTERIOR WALLS TO RECEIVE R-19 BATT INSULATION, U.N.O.

partition types

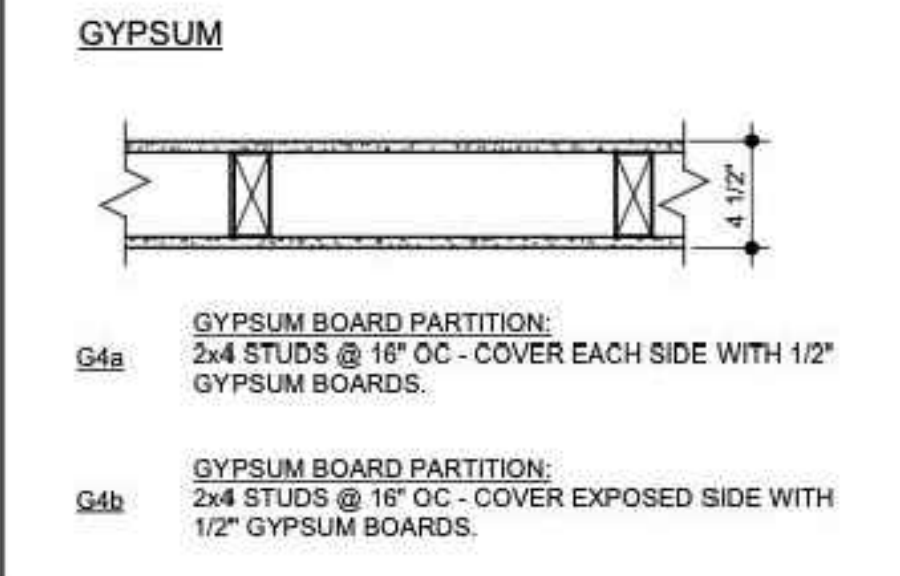

architectural plan keynotes

- STAIR MAIN TO SECOND LEVEL - (15) RISERS AT APPROX. 7 1/2" AND (14) TREADS AT 10"
- SOFFIT FOR HVAC ROUTING. SOFFIT TO BE 2'-0" WIDE AND 7'-0" AFF
- ATTIC ACCESS. ROUGH FRAMED OPENING TO NOT BE LESS THAN 22" X 30". ACCESS TO MEET THE REQUIREMENTS OF R807.1 OF THE IRC.
- SOFFIT FOR HVAC ROUTING. SOFFIT TO BE 8'-0" AFF
- 4" CONCRETE SLAB - REFER TO STRUCTURAL.
- PROVIDE 1/2" FIRE GUARD X GYP BD ON ENTIRE WALL BETWEEN GARAGE AND HOUSE

structural plan keynotes

- 2'-6"x2'-6"x1'-0" FOOTING W/ (5) #4 BARS EACH WAY, EACH SIDE OF BEAM
- 8"x16" WALL FOOTING W/ (3) #4, TYP WHERE SHOWN
- (2) 1/4"x9/16" LVL UNDER BEARING WALL ABOVE
- 3'-0"x3'-0"x1'-0" FOOTING W/ (6) #4 BARS EACH WAY

typical braced wall method

WSP - WOOD STRUCTURAL PANEL; WOOD STRUCTURAL PANEL SHEATHING WITH A THICKNESS NOT LESS THAN 3/8" FOR 16" STUD SPACING. FASTEN WITH 6d COMMON NAILS (131"x2"x2" LONG) AT 6"oc ALONG EDGES AND 12"oc AT INTERMEDIATE SUPPORTS, WHERE SHOWN ON PLANS. UNLESS OTHERWISE NOTED, PANEL WIDTH = 4'-0".

CS-WSP - CONTINUOUSLY SHEATHED WOOD STRUCTURAL PANEL; WOOD STRUCTURAL PANEL SHEATHING WITH A THICKNESS NOT LESS THAN 3/8" FOR 16" STUD SPACING. FASTEN WITH 6d COMMON NAILS (131"x2"x2" LONG) AT 6"oc ALONG EDGES AND 12"oc AT INTERMEDIATE SUPPORTS. PLACED ON ALL SHEATHABLE SURFACES ON ONE SIDE OF THE BRACED WALL LINE INCLUDING AREAS ABOVE AND BELOW OPENINGS AND GABLE END WALLS.

GB - GYPSUM BOARD; 1/2" GYPSUM BOARD WITH 13 GAGE, 1 3/8" LONG, 19/64" HEAD, 0.098" DIA, 1 3/8" LONG, ANNULAR-RINGED, 6d COOLER NAIL, 0.092" DIA, 1 7/8" LONG, 1/4" HEAD, OR GYPSUM BOARD NAIL, 0.0915" DIA, 1 7/8" LONG, 19/64" HEAD, TYPE W OR TYPE S SCREWS, AT 7"oc EDGES & 7"oc FIELD

PFH - PORTAL FRAME WITH HOLD-DOWNS; REF PORTAL FRAME WITH HOLD-DOWNS DETAIL

PFG - PORTAL FRAME AT GARAGE; REF PORTAL FRAME AT GARAGE DETAIL

Architecture Graphics Management & Planning

Independence Office
 Roy Browne 816-228-1111
 Internet - Roy@AGMPARCH.com


Lee's Summit Office
 Bruce Best 816-525-8918
 Internet - Bruce@AGMPARCH.com

Roy Browne Architect of Record

SEQUOIA DUPLEX ALT #1
205 & 207 Orchard Court
LEE'S SUMMIT, MO

This Drawing And Information Contained Within Is Provided As An Instrument Of Service By The Architect, And Is Intended For Use On This Project Only. This Drawing Remains The Property Of The Architect And Shall Be Returned To Him Upon Completion Of The Construction Work. All Drawings, Specifications, Ideas, Designs And Arrangements Appearing Herein Constitute The Original And Unpublished Work Of The Architect. Any Reproduction, Use Or Disclosure Of The Proprietary Information Contained Herein Without The Prior Written Consent Of The Architect Is Strictly Prohibited.

© AGMP 2023

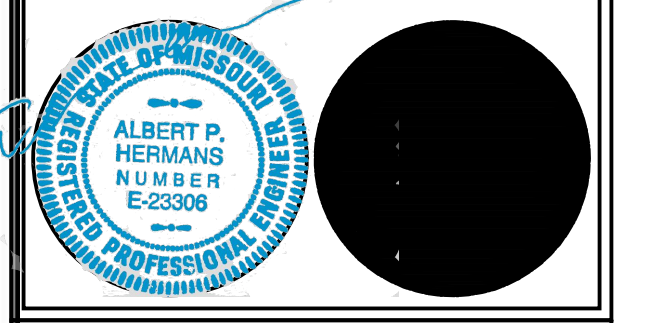

A102

- Date APRIL 26, 2024
- REVISION NOVEMBER 3, 2024
- REVISION
- REVISION
- REVISION


SEQUOIA DUPLEX ALT #1

205 & 207 Orchard Court

LEE'S SUMMIT, MO

This Drawing And Information Contained Within Is Provided As An Instrument Of Service By The Architect, And Is Intended For Use On This Project Only. This Drawing Remains The Property Of The Architect And Shall Be Returned To Him Upon Completion Of The Construction Work. All Drawings, Specifications, Ideas, Designs And Arrangements Appearing Herein Constitute The Original And Unpublished Work Of The Architect. Any Reproduction, Use Or Disclosure Of The Proprietary Information Contained Herein Without The Prior Written Consent Of The Architect Is Strictly Prohibited.

©AGMP 2023

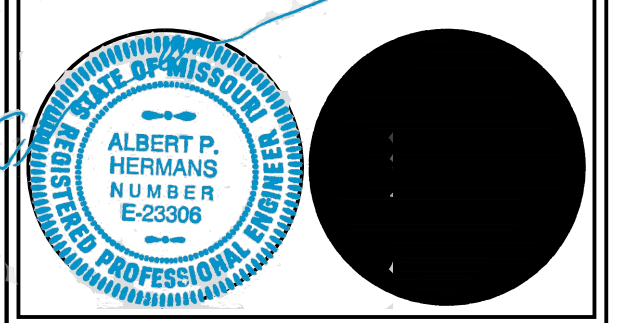


A103

1	Date	APRIL	26, 2024
2	REVISION	NOVEMBER	3, 2024
3	REVISION		
4	REVISION		
5	REVISION		

general notes

- 1) GENERAL CONTRACTOR SHALL NOTIFY THE ARCHITECT OF ANY DISCREPANCIES BETWEEN SPECIFICATIONS AND DRAWINGS, BETWEEN MULTIPLE SPECIFICATION SECTIONS AND/OR BETWEEN MULTIPLE DRAWINGS. THE ARCHITECT WILL DETERMINE WHICH SHALL GOVERN.
- 2) GENERAL CONTRACTOR SHALL VERIFY ALL DIMENSIONS AND CONDITIONS OF THE JOB SITE INCLUDING UTILITIES AND EXISTING STRUCTURES PRIOR TO BEGINNING WORK AND REPORT ANY DISCREPANCIES TO THE ARCHITECT.
- 3) GENERAL CONTRACTOR SHALL BE RESPONSIBLE FOR STABILITY OF THE STRUCTURE DURING CONSTRUCTION INCLUDING ALL SHORING AND BRACING REQUIRED TO RESIST REQUIRED VERTICAL AND LATERAL FORCES.
- 4) ALL ARCHITECTURAL FLOOR PLAN DIMENSIONS ARE FROM FACE OF CONCRETE OR FACE OF STUD.
- 5) INTERIOR WALLS ARE TO BE COMPRISED OF 2x4 STUDS AT 16" O.C. MAX WITH 1/2" DRYWALL EACH SIDE UNLESS NOTED OTHERWISE.
- 6) MECHANICAL/PLUMBING CONTRACTOR TO COORDINATE EACH OTHERS' WORK WITH ARCHITECTURAL PLANS AND TO NOTIFY ARCHITECT OF NEED FOR SOFFITS OR CHASES FOR INSTALLATION OF DUCTWORK OR PLUMBING.
- 7) ELECTRICAL CONTRACTOR TO INSTALL OUTLETS AS REQUIRED PER CODE. VERIFY ALL LOCATIONS WITH OWNER PRIOR TO BEGINNING DRYWALL.
- 8) ALL EXTERIOR WALLS TO RECEIVE R-19 BATT INSULATION, U.N.O.

partition types

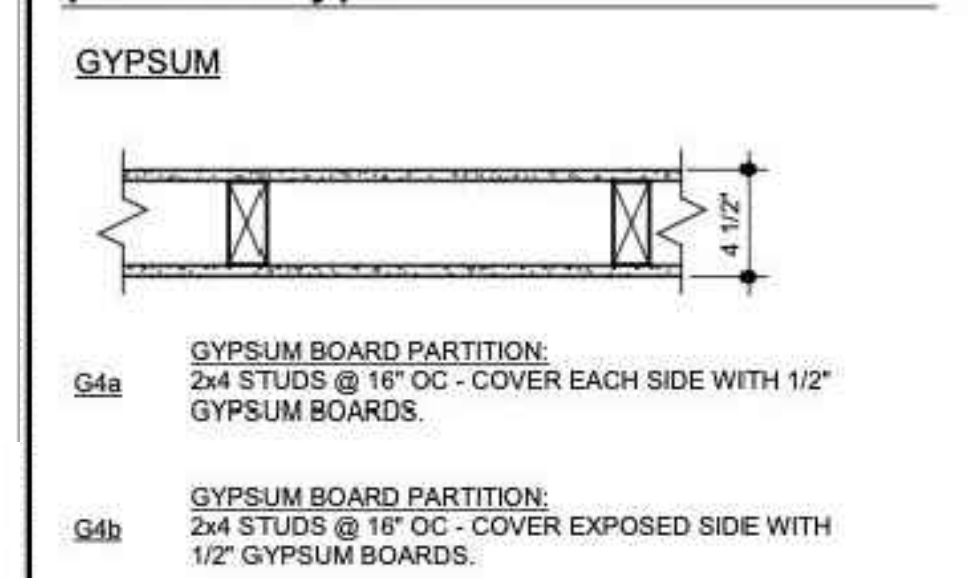


architectural plan keynotes

- 1 STAIR MAIN TO SECOND LEVEL- (15) RISERS AT APPROX. 7 1/2" AND (14) TREADS AT 10"
- 2 SOFFIT FOR HVAC ROUTING. SOFFIT TO BE 2'-0" WIDE AND 7'-0" AFF
- 3 ATTIC ACCESS. ROUGH FRAMED OPENING TO NOT BE LESS THAN 22" X 30". ACCESS TO MEET THE REQUIREMENTS OF R907.1 OF THE IRC.
- 4 SOFFIT FOR HVAC ROUTING. SOFFIT TO BE 8'-0" AFF
- 5 4" CONCRETE SLAB - REFER TO STRUCTURAL
- 6 PROVIDE 1/2" FIRE GUARD X GYP BD ON ENTIRE WALL BETWEEN GARAGE AND HOUSE

PLAN MARK	Width	DOOR OPENING SIZE		Door Type (A)Door Type (A)	Door Material (B)Door Material (B)		NOTES
		H					
2068	2'-0"	6'-8"		F			
2668	2'-6"	6'-8"		F			
2669	1'-6"	6'-8"		F			
2671	1'-6"	6'-8"		F			
3068	3'-0"	6'-8"		F			
3068A	3'-0"	6'-8"		F			SEE GENERAL NOTE 3
3068B	3'-0"	6'-8"		F	WD		SLIDING BARN DOOR
3068C	3'-0"	6'-8"		HG			
5068	5'-0"	6'-8"		FG			
70160	16'-0"	7'-0"		OHD			
Grand total: 36							

door schedule notes

- DOOR GENERAL NOTES**
1. DOORS SHALL COMPLY WITH THE REQUIREMENTS OF SECTION 308 OF THE IRC FOR SAFETY GLAZING
 2. THE GARAGE DOOR(S) SHALL MEET DASHA 90 MPH REQUIREMENTS
 3. CONTRACTOR OPTION FOR DOOR 3068A
OPTION A: 1 3/8" IN THICKNESS SOLID WOOD DOOR
OPTION B: SOLID OR HONEYCOMB STEEL DOOR NOT LESS THAN 1 3/8" THICK
OPTION C: 20-MINUTE FIRE-RATE DOOR WITH SELF-CLOSING OR AUTOMATIC-CLOSING DEVICE

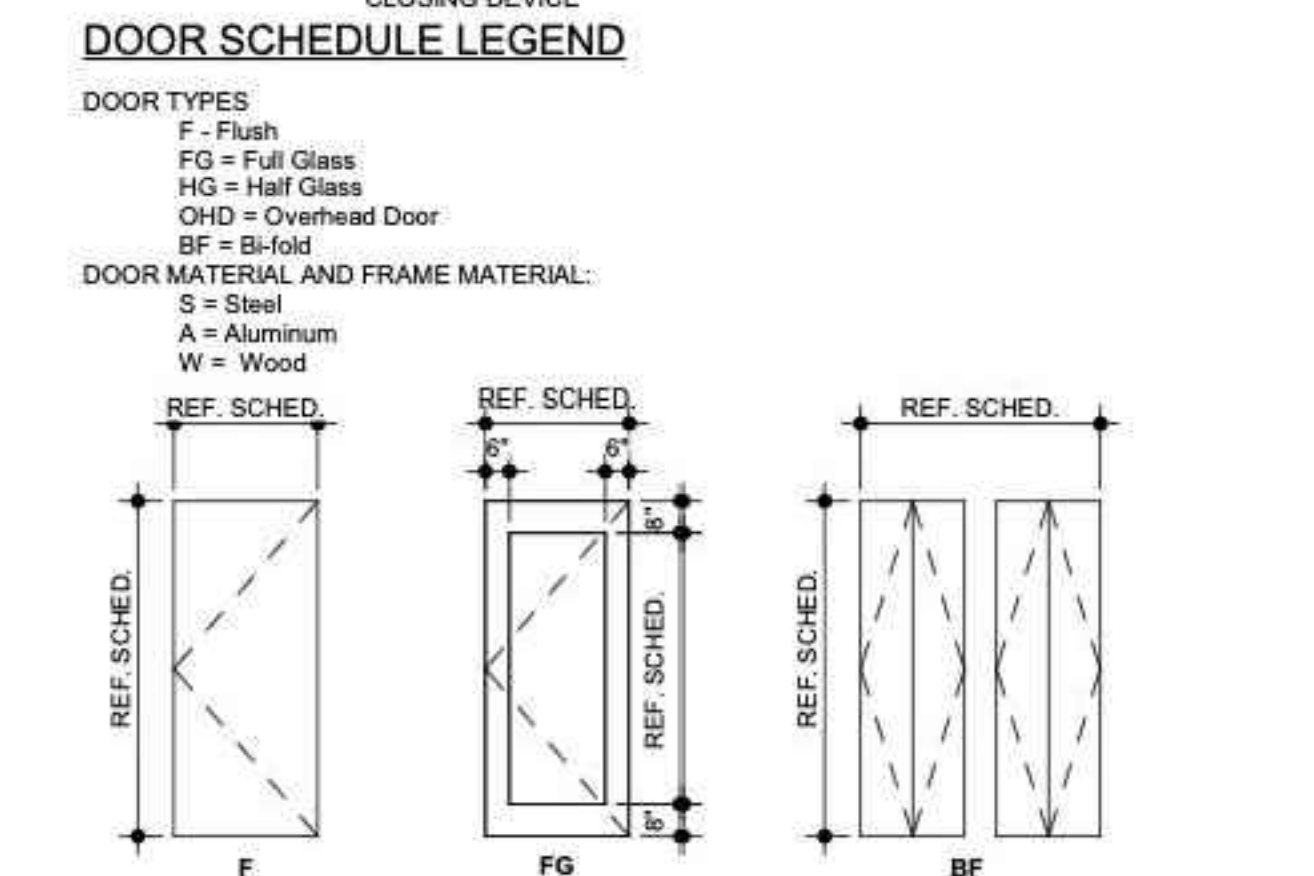

finish legends


- CARPET
- PORCELAIN FLOOR TILE
- LVP

room finish schedule

NO.	ROOM NAME	FLOOR
A101	LIVING/DINING	LVP
A102	KITCHEN	LVP
A103	BATH	PORCELAIN FLOOR TILE
A104	CL	CARPET
A105	GARAGE	CONCRETE
A106	ENTRY	LVP
A107	CL	LVP
A201	BEDROOM 2	LVP
A202	BEDROOM 3	LVP
A204	BATH	PORCELAIN FLOOR TILE
A205	M BEDROOM	LVP
A206	M. BATH	PORCELAIN FLOOR TILE
A207	LAUNDRY	LVP
A208	CL	CARPET
A209	CL	CARPET
A210	CL	CARPET
A211	DUCT SHAFT	PORCELAIN FLOOR TILE
A301	ATTIC	- NO FINISH-
B101	LIVING/DINING	LVP
B102	KITCHEN	LVP
B103	BATH	PORCELAIN FLOOR TILE
B104	CL	CARPET
B105	GARAGE	CONCRETE
B106	ENTRY	LVP
B107	CL	LVP
B201	BEDROOM 2	LVP
B202	BEDROOM 3	LVP
B204	BATH	PORCELAIN FLOOR TILE
B205	M. BEDROOM	LVP
B206	M. BATH	PORCELAIN FLOOR TILE
B207	LAUNDRY	LVP
B208	CL	CARPET
B209	CL	CARPET
B210	CL	CARPET
B211	FRM	PORCELAIN FLOOR TILE
B301	ATTIC	- NO FINISH-


PLAN MARK	CONFIGURATION	WIDTH	HEIGHT	COMMENTS
A	SINGLE - SLIDER WINDOW	5'-0"	3'-2"	
B	SINGLE - SLIDER WINDOW	4'-5"	5'-0"	
C	SINGLE - CASEMENT WINDOW	3'-0"	5'-0"	
E	SINGLE - SLIDER WINDOW	2'-0"	2'-0"	EGRESS

- WINDOW GENERAL NOTES**
1. EGRESS WINDOWS SHALL COMPLY WITH SECTION 510 OF THE IRC.
 2. WINDOWS SHALL HAVE FALL PROTECTION PER IRC 312.2 WHERE NEEDED.
 3. WINDOWS, DOORS, AND OTHER GLAZING WILL COMPLY WITH THE REQUIREMENTS OF SECTION 308 OF THE IRC FOR SAFETY GLAZING.
- WINDOW THERMAL PROPERTIES**
- MANUFACTURER: PRODUCT LINE: U-FACTOR: SHGC: MANUFACTURER: BUILDER'S VINYL W/ LOW-E 0.32 0.35

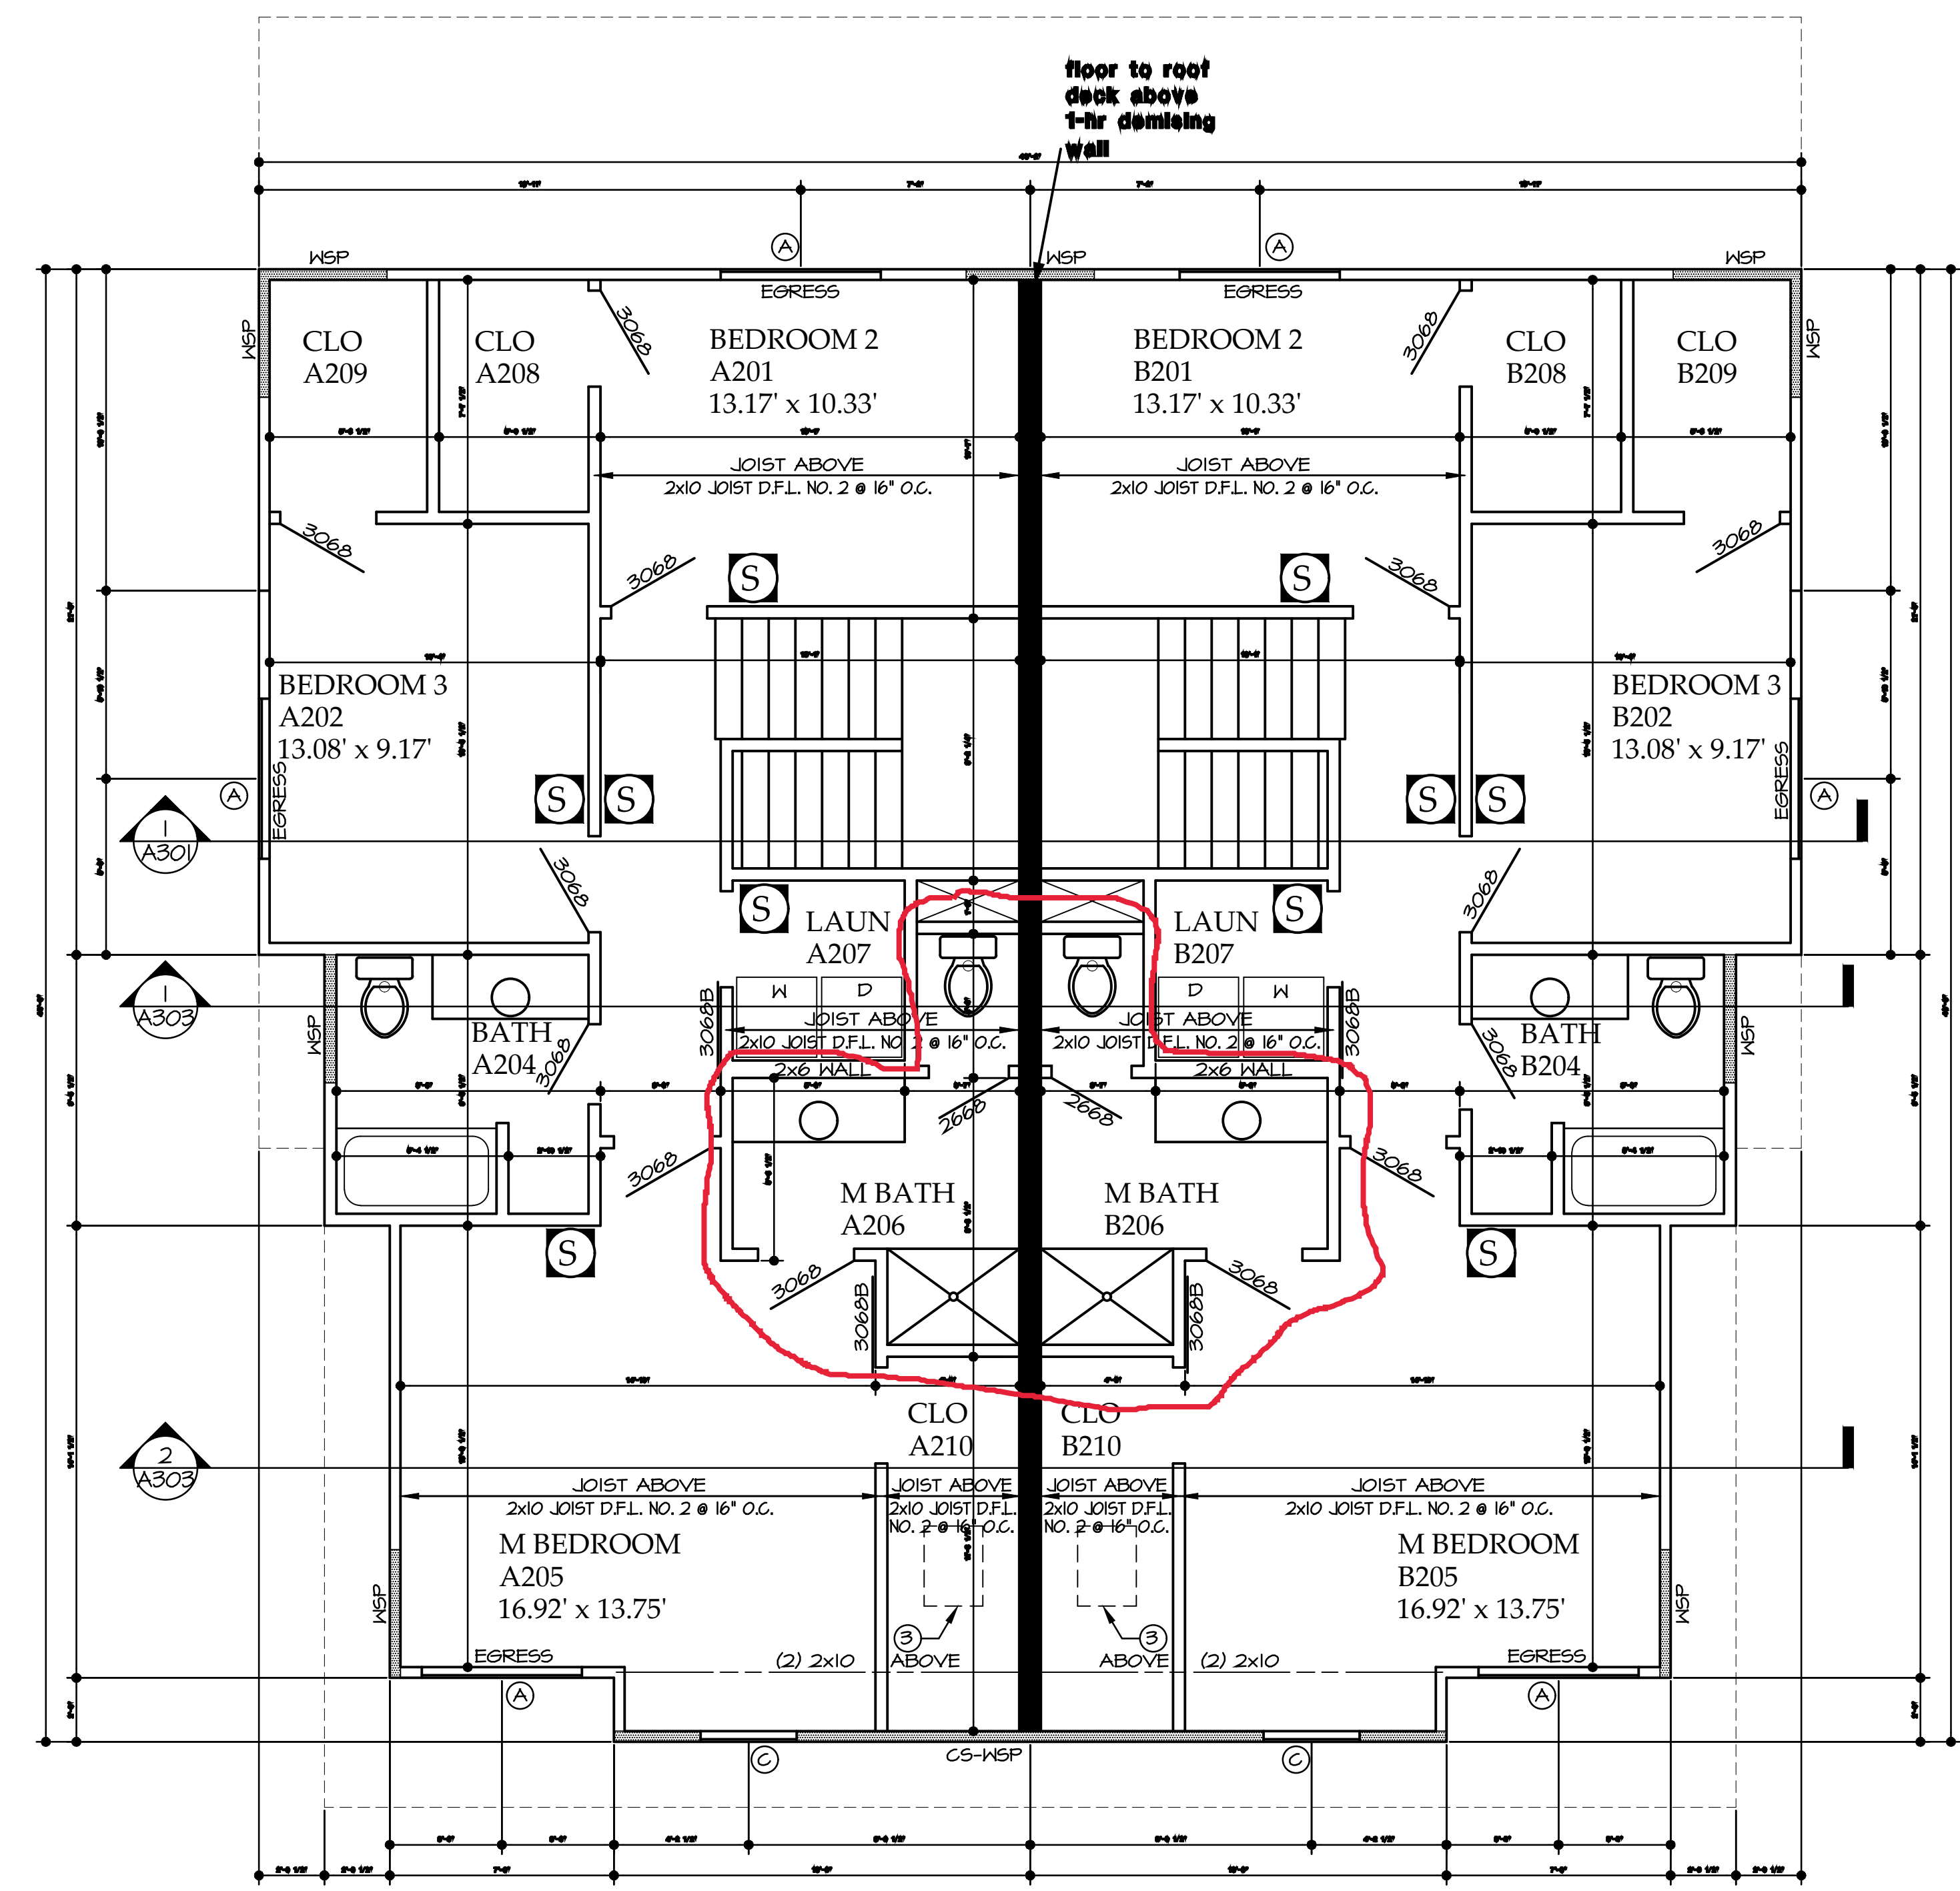

S This symbol denotes smoke detector locations on all sheets. NOTE All smoke detectors shall be a combination carbon monoxide and smoke detectors, typical all locations noted on these plans.


NOTE:
All internal sheetrock on the face of all walls, and ceilings of all garage spaces shall be type 'X' 5/8" fire code sheet rock, taped, sanded and painted.

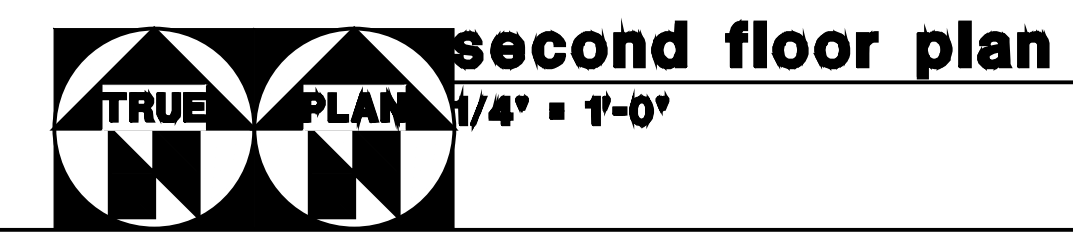

second floor plan

SEQUOIA DUPLEX ALT # 1
205 & 207 Orchard Court
LEE'S SUMMIT, MO

This Drawing And Information Contained Within Is Provided As An Instrument Of Service By The Architect, And Is Intended For Use On This Project Only. This Drawing Remains The Property Of The Architect And Shall Be Returned To Him Upon Completion Of The Construction Work. All Drawings, Specifications, Ideas, Designs And Arrangements Appearing Herein Constitute The Original And Unpublished Work Of The Architect. Any Reproduction, Use Or Disclosure Of The Proprietary Information Contained Herein Without The Prior Written Consent Of The Architect Is Strictly Prohibited.
© AGMP 2023

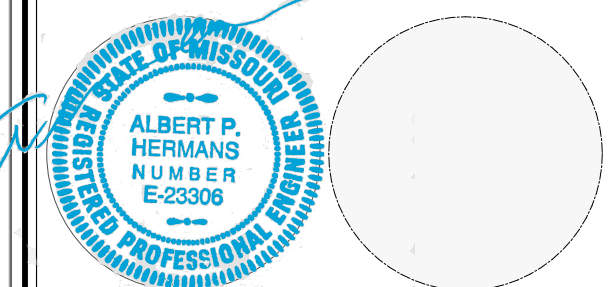

A201

1	Date	APRIL 26, 2024
2	REVISION	
3	REVISION	
4	REVISION	
5	REVISION	

RELEASE FOR CONSTRUCTION
AS NOTED FOR PLAN REVIEW
DEVELOPMENT SERVICES
LEE'S SUMMIT, MISSOURI
05/02/2024

exterior elevation general notes

1. SLOPE GRADE A MINIMUM OF 5% AWAY FROM THE HOUSE FOR A MINIMUM DISTANCE OF 10'-0"
2. MAINTAIN MIN. 8" CLEARANCE BETWEEN FINAL GRADE AND EXPOSED WOOD
3. EXTERIOR SIDING INDICATED ON DRAWINGS SHALL BE INSTALLED OVER BUILDING WRAP, RESULTING IN A WATER-RESISTIVE EXTERIOR WALL SYSTEM COMPLIANT WITH IRC SECTION 703.2.
4. WHERE DIFFERENTIAL BETWEEN PORCH/PATIO AND SURROUNDING GRADE IS GREATER THAN 18" GUARDRAIL SHALL BE PROVIDED. THE GUARDRAIL SHALL BE 42" TALL AND SHALL BE CONSTRUCTED SUCH THAT A 4" SPHERE CANNOT PASS THROUGH IT.
5. REFER TO SHEET A601 FOR EXTERIOR LIGHTING. ALL EXTERIOR LIGHTING SHALL HAVE A CONCEALED LIGHT SOURCE.
6. ALL EXTERIOR METAL SHALL BE CORROSION RESISTANT.
7. ALL EXTERIOR MECHANICAL AND PLUMBING VENT LOCATIONS SHALL BE APPROVED WITH ARCHITECT, PRIOR TO INSTALLATION. ALL PIPING SHALL PAINTED TO MATCH SURROUNDING CONTEXT.

exterior material legend building 2

MATERIAL TYPE

- A. LAP SIDING
- B. EIFS
- C. ASPHALT SHINGLES
- D. METAL TRIM
- E. BRICK

MATERIAL FINISH

1. PAINT, COLOR 1, TBD
2. EIFS FINISH COAT - 3, COLOR TBD
3. PER MANUFACTURER, TBD
4. PAINT, ACCENT COLOR 2, TBD
5. PER MANUFACTURER, TBD
6. EIFS FINISH COAT - 2, COLOR TBD
7. EIFS FINISH COAT - 4, COLOR TBD

exterior material legend building 3

MATERIAL TYPE

- A. T-1-11
- B. EIFS
- C. ASPHALT SHINGLES
- D. METAL TRIM
- E. MANUFACTURED STONE

MATERIAL FINISH

1. PAINT, COLOR 1, TBD
2. EIFS FINISH COAT - 3, COLOR TBD
3. PER MANUFACTURER, TBD
4. PAINT, ACCENT COLOR 2, TBD
5. PER MANUFACTURER, TBD
6. EIFS FINISH COAT - 2, COLOR TBD
7. EIFS FINISH COAT - 4, COLOR TBD

exterior material legend building 4

MATERIAL TYPE


- A. BATTEN BOARD
- B. EIFS
- C. ASPHALT SHINGLES
- D. METAL TRIM
- E. BRICK

MATERIAL FINISH


1. PAINT, COLOR 1, TBD
2. EIFS FINISH COAT - 3, COLOR TBD
3. PER MANUFACTURER, TBD
4. PAINT, ACCENT COLOR 2, TBD
5. PER MANUFACTURER, TBD
6. EIFS FINISH COAT - 2, COLOR TBD
7. EIFS FINISH COAT - 4, COLOR TBD



2 north elevation
1/4" = 1'-0"

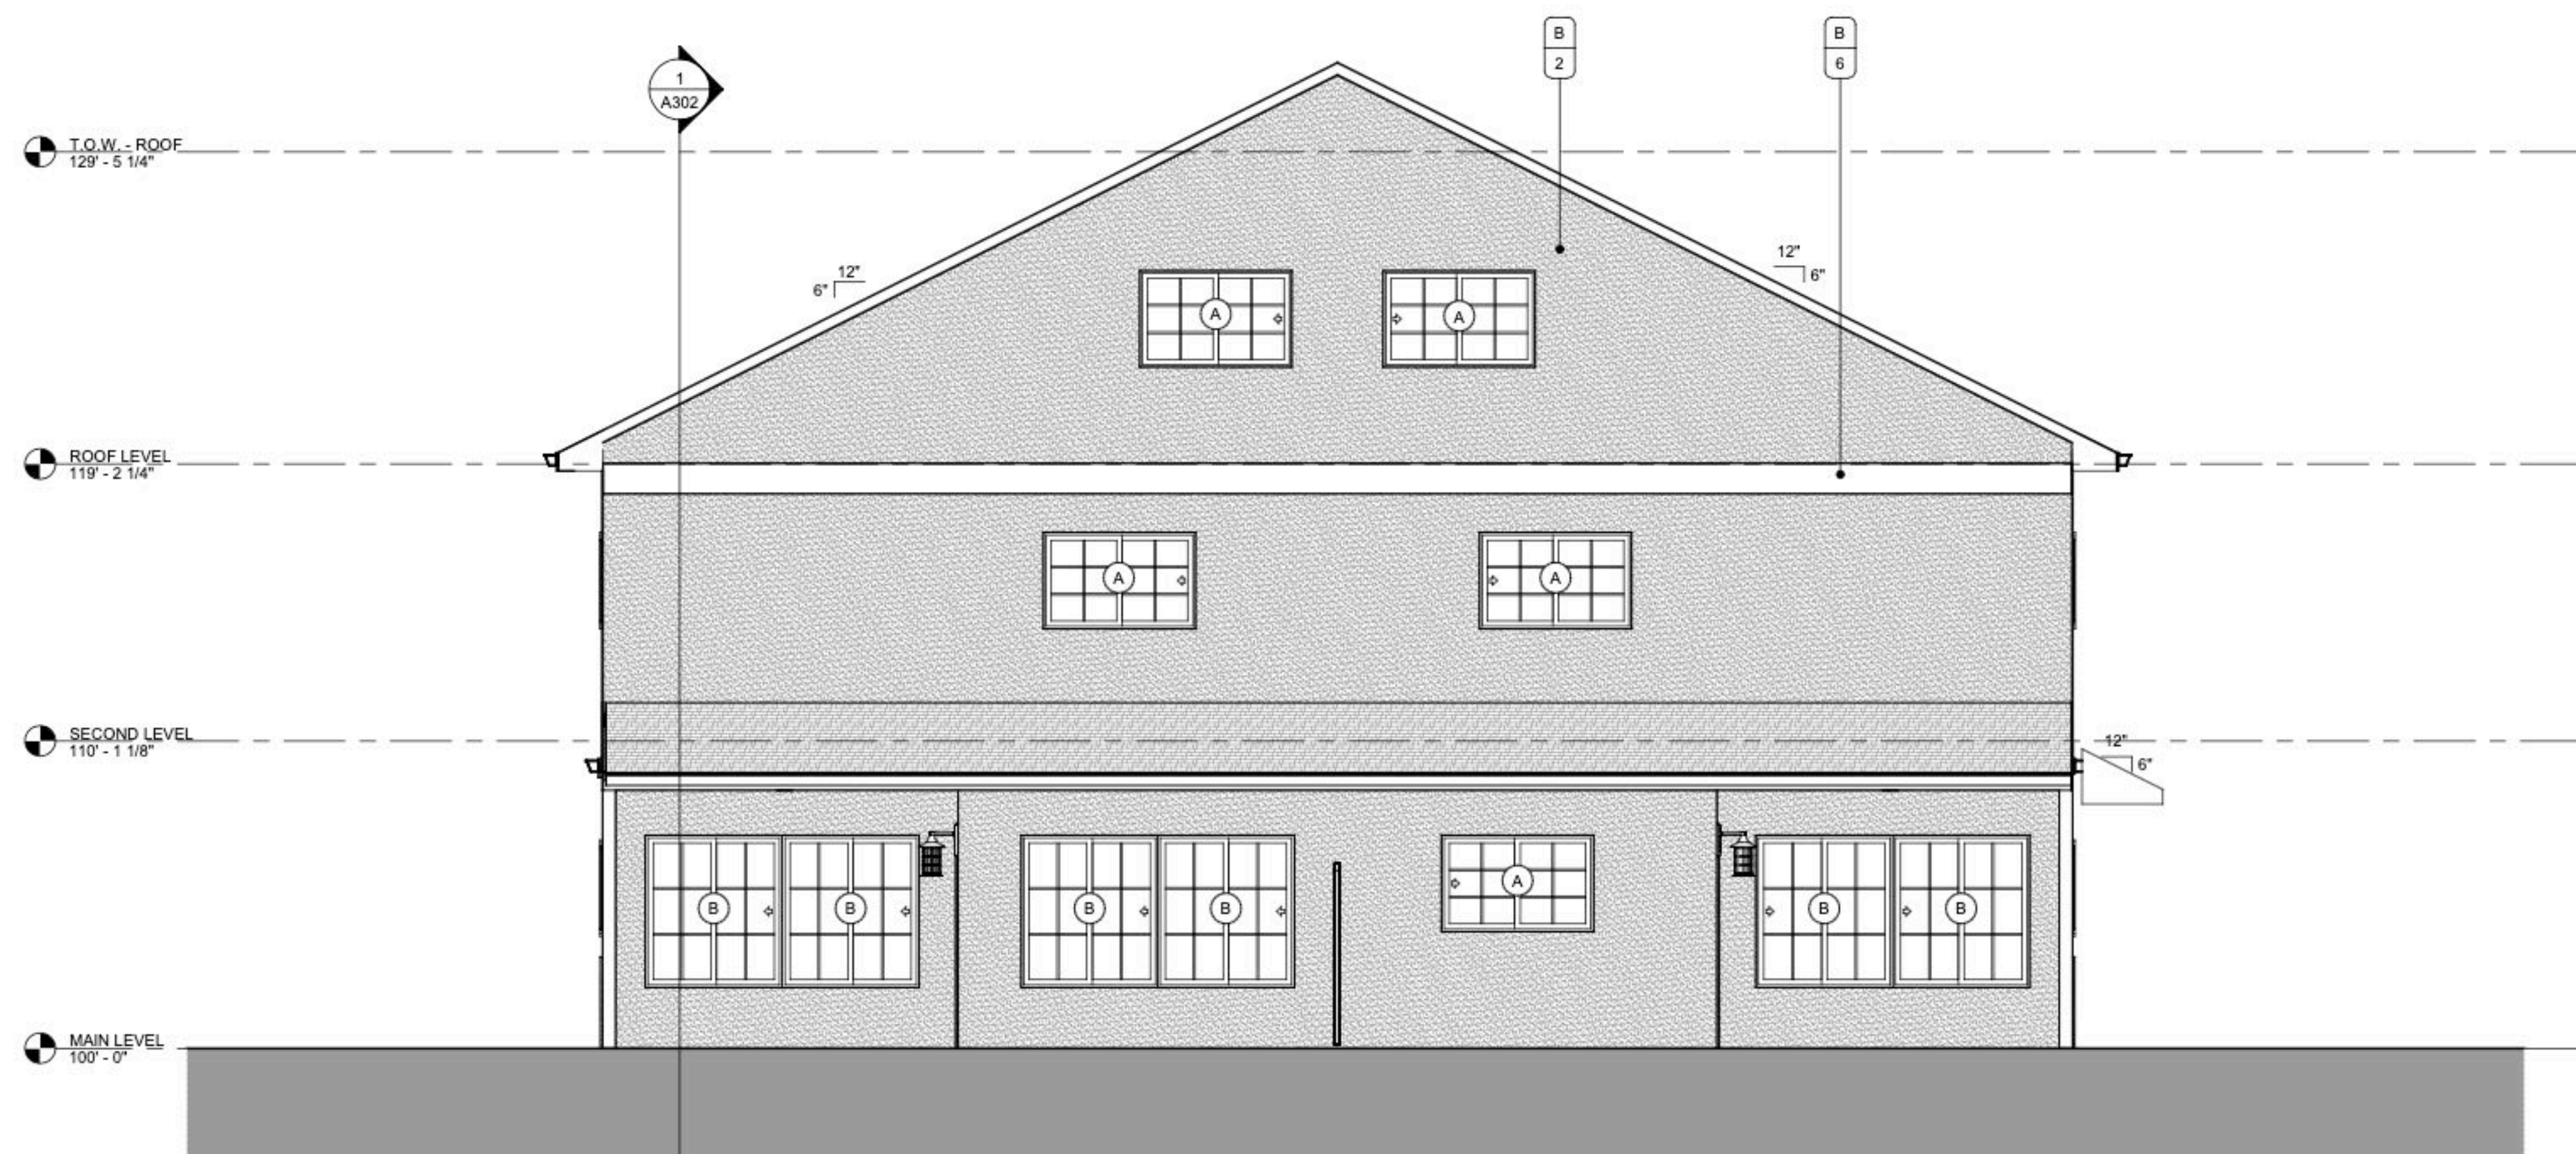


1 south elevation
1/4" = 1'-0"

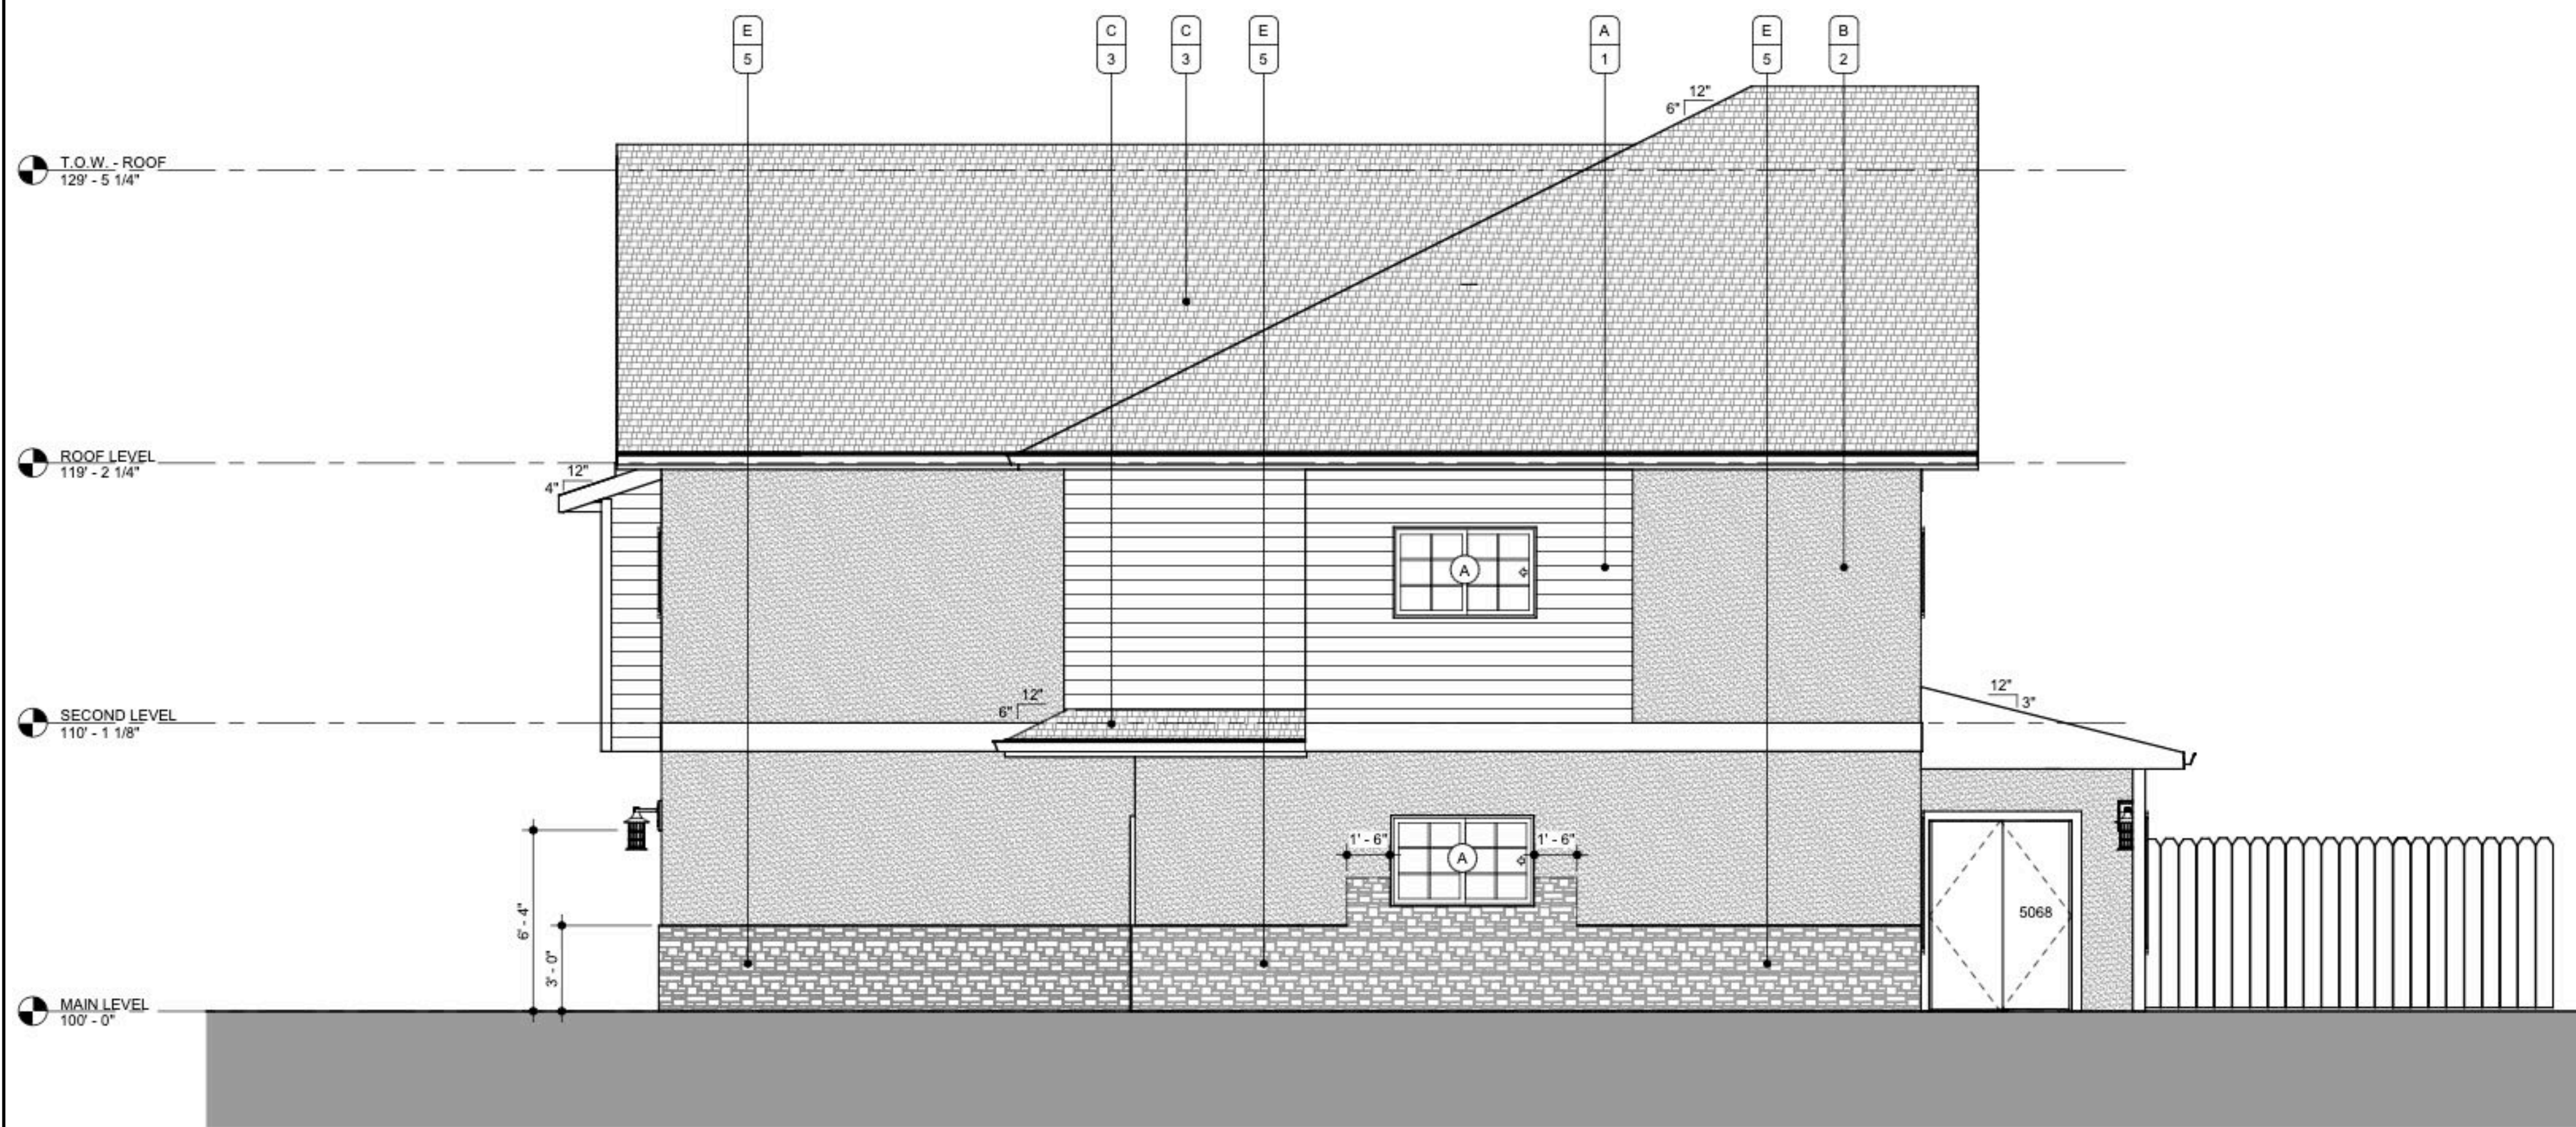

west elevation

1/4" = 1'-0"

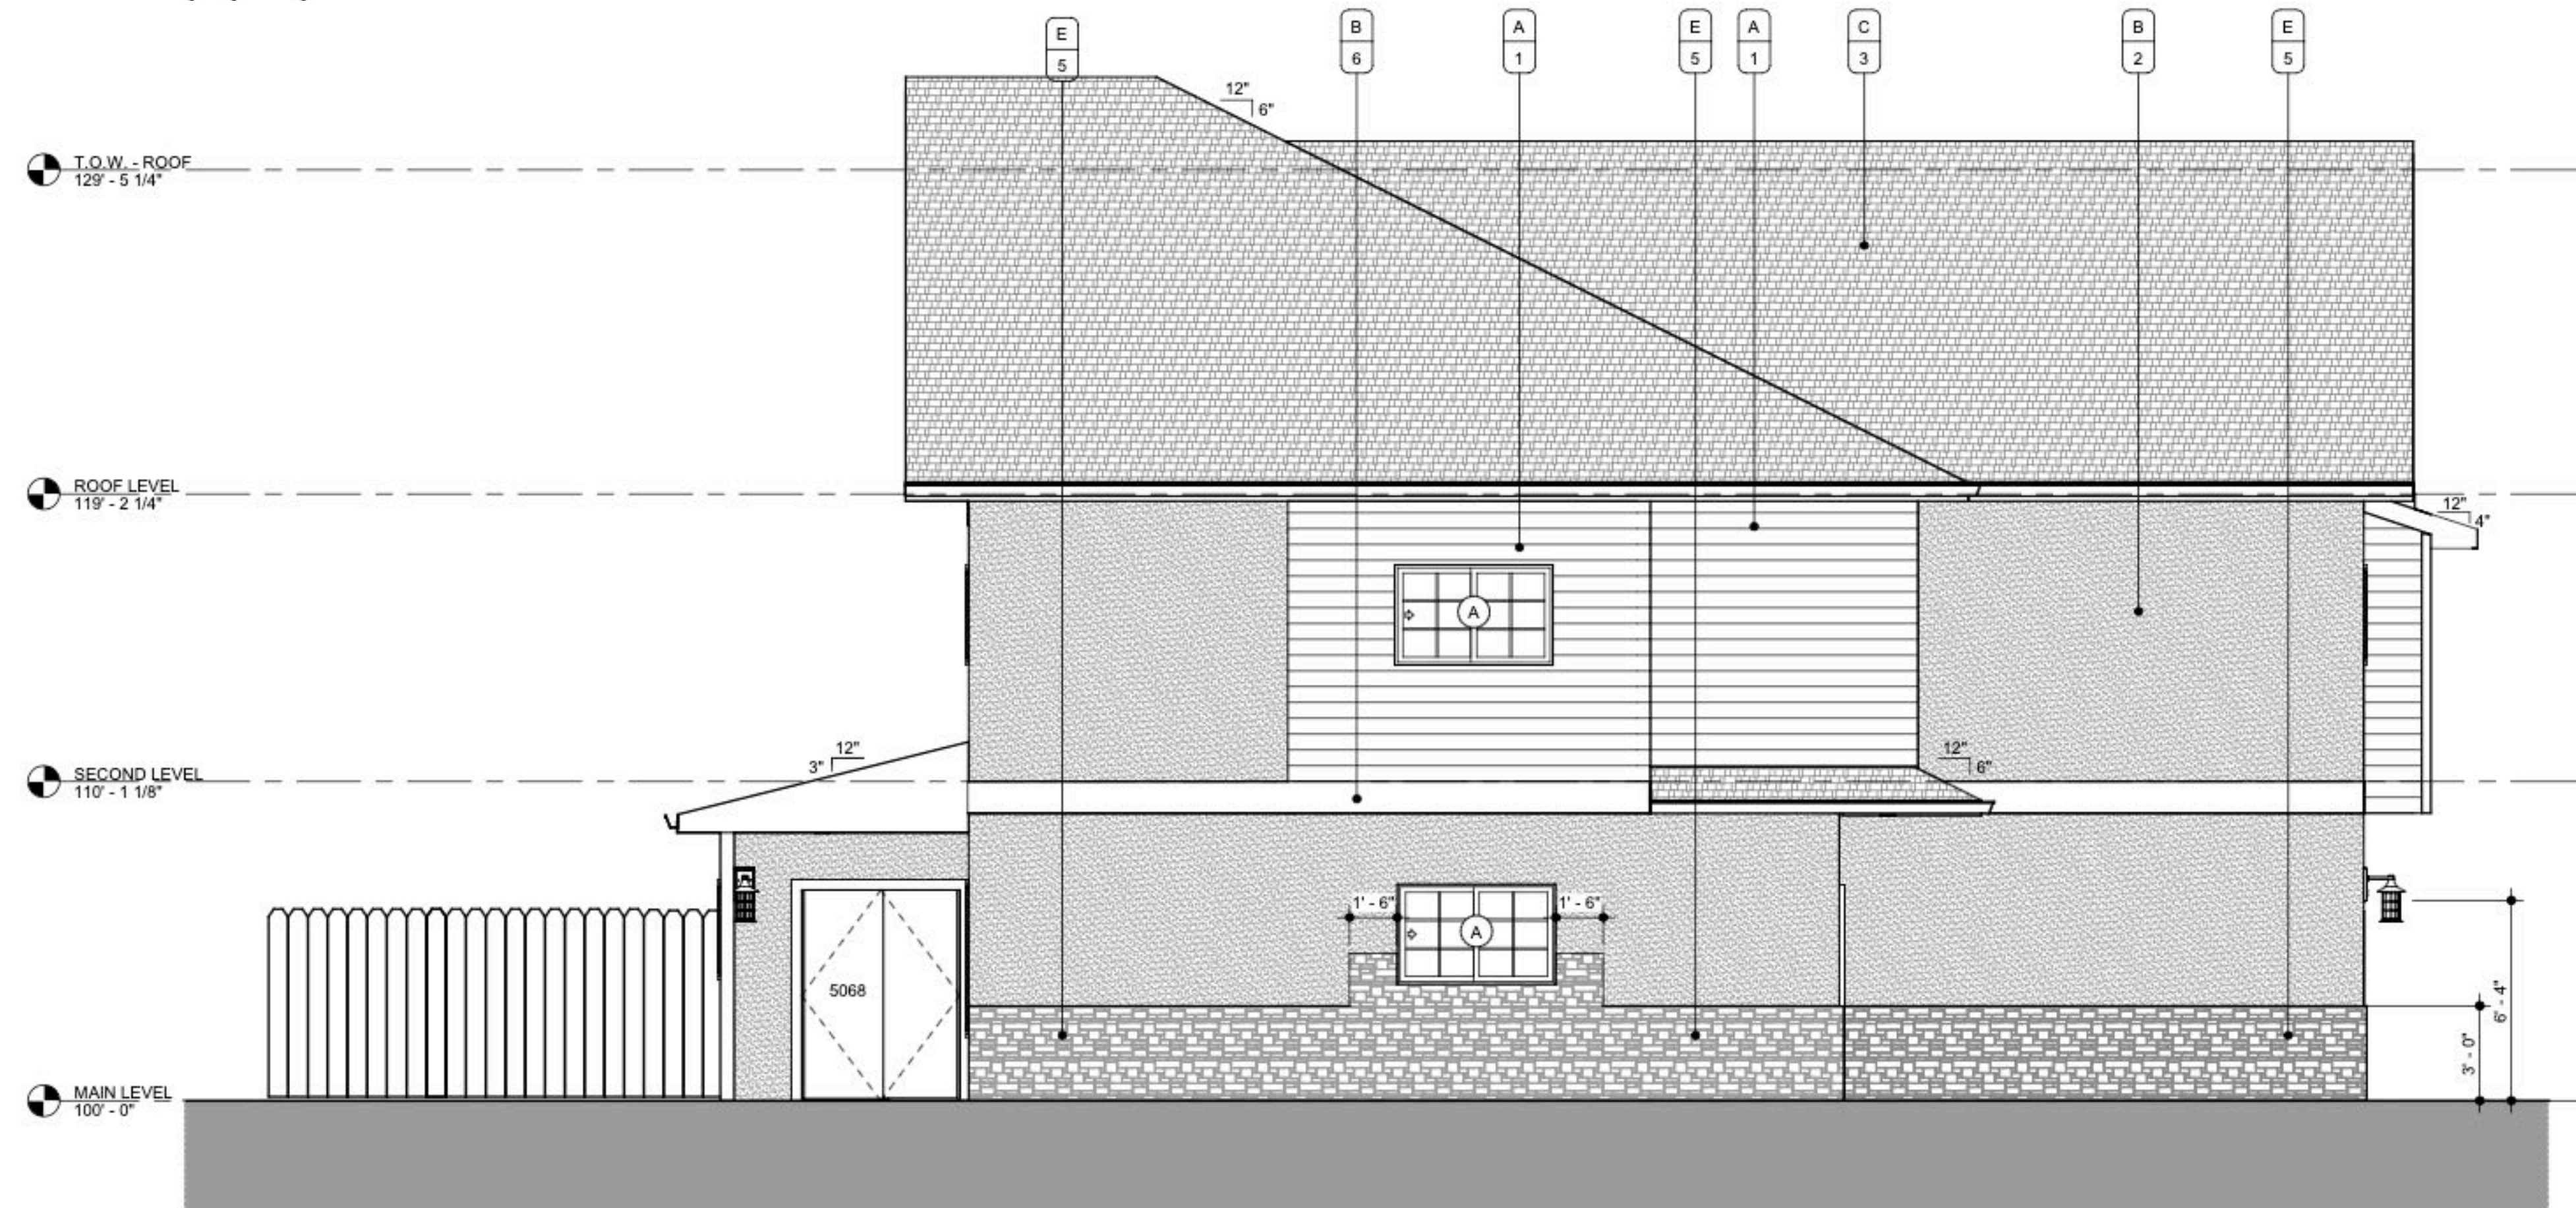

east elevation

1/4" = 1'-0"

exterior elevation general notes

1. SLOPE GRADE A MINIMUM OF 5% AWAY FROM THE HOUSE FOR A MINIMUM DISTANCE OF 10'-0"
2. MAINTAIN MIN. 8" CLEARANCE BETWEEN FINAL GRADE AND EXPOSED WOOD
3. EXTERIOR SIDING INDICATED ON DRAWINGS SHALL BE INSTALLED OVER BUILDING WRAP, RESULTING IN A WATER-RESISTIVE EXTERIOR WALL SYSTEM COMPLIANT WITH IRC SECTION 703.2
4. WHERE DIFFERENTIAL BETWEEN PORCH/PATIO AND SURROUNDING GRADE IS GREATER THAN 18" GUARDRAIL SHALL BE PROVIDED. THE GUARDRAIL SHALL BE 42" TALL AND SHALL BE CONSTRUCTED SUCH THAT A 4" SPHERE CANNOT PASS THROUGH IT.
5. REFER TO SHEET A601 FOR EXTERIOR LIGHTING. ALL EXTERIOR LIGHTING SHALL HAVE A CONCEALED LIGHT SOURCE.
6. ALL EXTERIOR METAL SHALL BE CORROSION RESISTANT.
7. ALL EXTERIOR MECHANICAL AND PLUMBING VENT LOCATIONS SHALL BE APPROVED WITH ARCHITECT. PRIOR TO INSTALLATION. ALL PIPING SHALL PAINTED TO MATCH SURROUNDING CONTEXT.

exterior material legend building 2


- MATERIAL TYPE
- A. LAP SIDING
 - B. EIFS
 - C. ASPHALT SHINGLES
 - D. METAL TRIM
 - E. BRICK

- MATERIAL FINISH
1. PAINT, COLOR 1, TBD
 2. EIFS FINISH COAT - 3, COLOR TBD
 3. PER MANUFACTURER, TBD
 4. PAINT, ACCENT COLOR 2, TBD
 5. PER MANUFACTURER, TBD
 6. EIFS FINISH COAT - 2, COLOR TBD
 7. EIFS FINISH COAT - 4, COLOR TBD

exterior material legend building 3

- MATERIAL TYPE
- A. T-1-11
 - B. EIFS
 - C. ASPHALT SHINGLES
 - D. METAL TRIM
 - E. MANUFACTURED STONE

- MATERIAL FINISH
1. PAINT, COLOR 1, TBD
 2. EIFS FINISH COAT - 3, COLOR TBD
 3. PER MANUFACTURER, TBD
 4. PAINT, ACCENT COLOR 2, TBD
 5. PER MANUFACTURER, TBD
 6. EIFS FINISH COAT - 2, COLOR TBD
 7. EIFS FINISH COAT - 4, COLOR TBD

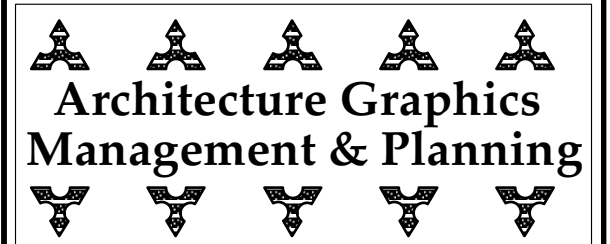

Independence Office
 Roy Browne 816-228-1111
 Internet - Roy@AGMPARCH.com

Lee's Summit Office
 Bruce Best 816-525-8918
 Internet - Bruce@AGMPARCH.com

Roy Browne Architect of Record

SEQUOIA DUPLEX ALT # 1
205 & 207 Orchard Court
LEE'S SUMMIT, MO

This Drawing And Information Contained Within Is Provided As An Instrument Of Service By The Architect, And Is Intended For Use On This Project Only. This Drawing Remains The Property Of The Architect And Shall Be Returned To Him Upon Completion Of The Construction Work. All Drawings, Specifications, Ideas, Designs And Arrangements Appearing Herein Constitute The Original And Unpublished Work Of The Architect. Any Reproduction, Use Or Disclosure Of The Proprietary Information Contained Herein Without The Prior Written Consent Of The Architect Is Strictly Prohibited.
 © AGMP 2023



A202

1	Date	APRIL	26, 2024
2	REVISION		
3	REVISION		
4	REVISION		
5	REVISION		

RELEASE FOR CONSTRUCTION
 AS NOTED FOR PLAN REVIEW
 DEVELOPMENT SERVICES
 LEE'S SUMMIT, MISSOURI
 05/02/2024


SEQUOIA DUPLEX ALT # 1
205 & 207 Orchard Court
LEE'S SUMMIT, MO

This Drawing And Information Contained Within Is Provided As An Instrument Of Service By The Architect, And Is Intended For Use On This Project Only. This Drawing Remains The Property Of The Architect And Shall Be Returned To Him Upon Completion Of The Construction Work. All Drawings, Specifications, Ideas, Designs And Arrangements Appearing Herein Constitute The Original And Unpublished Work Of The Architect. Any Reproduction, Use Or Disclosure Of The Proprietary Information Contained Herein Without The Prior Written Consent Of The Architect Is Strictly Prohibited.
© AGMP 2023




A301

1	Date	APRIL 26, 2024
2	REVISION	
3	REVISION	
4	REVISION	
5	REVISION	

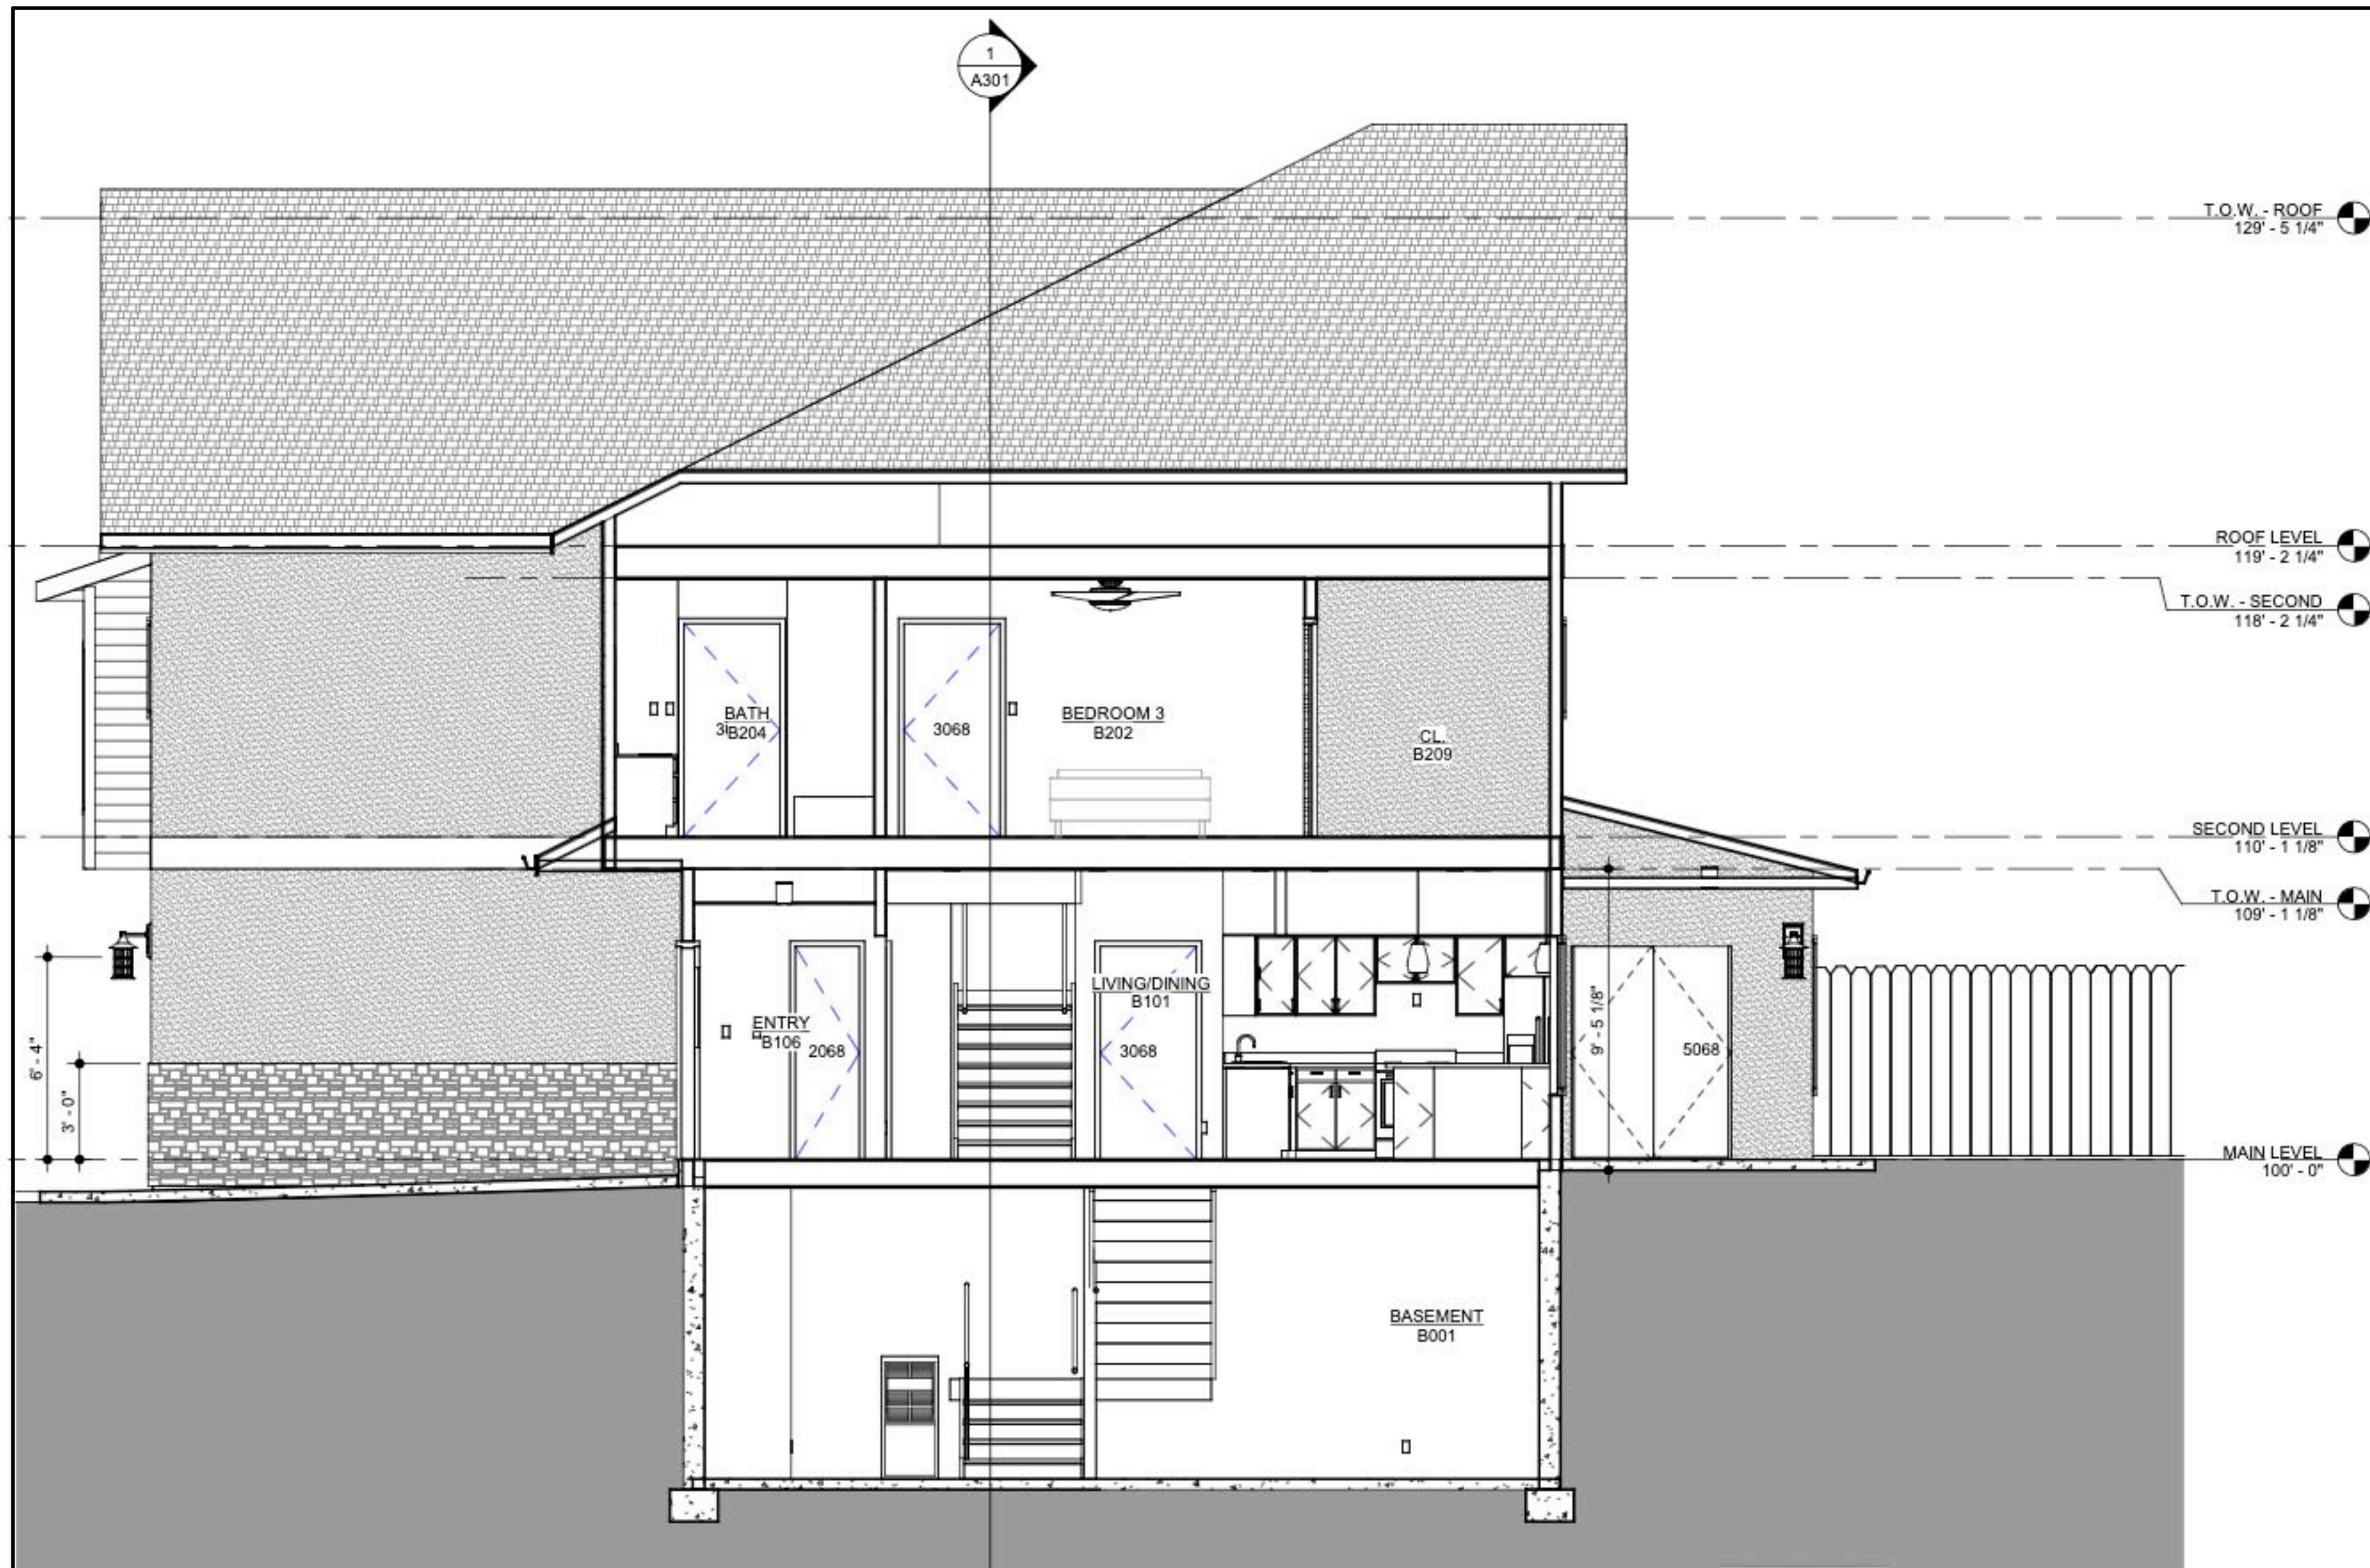

building section looking north

1/4" = 1'-0"

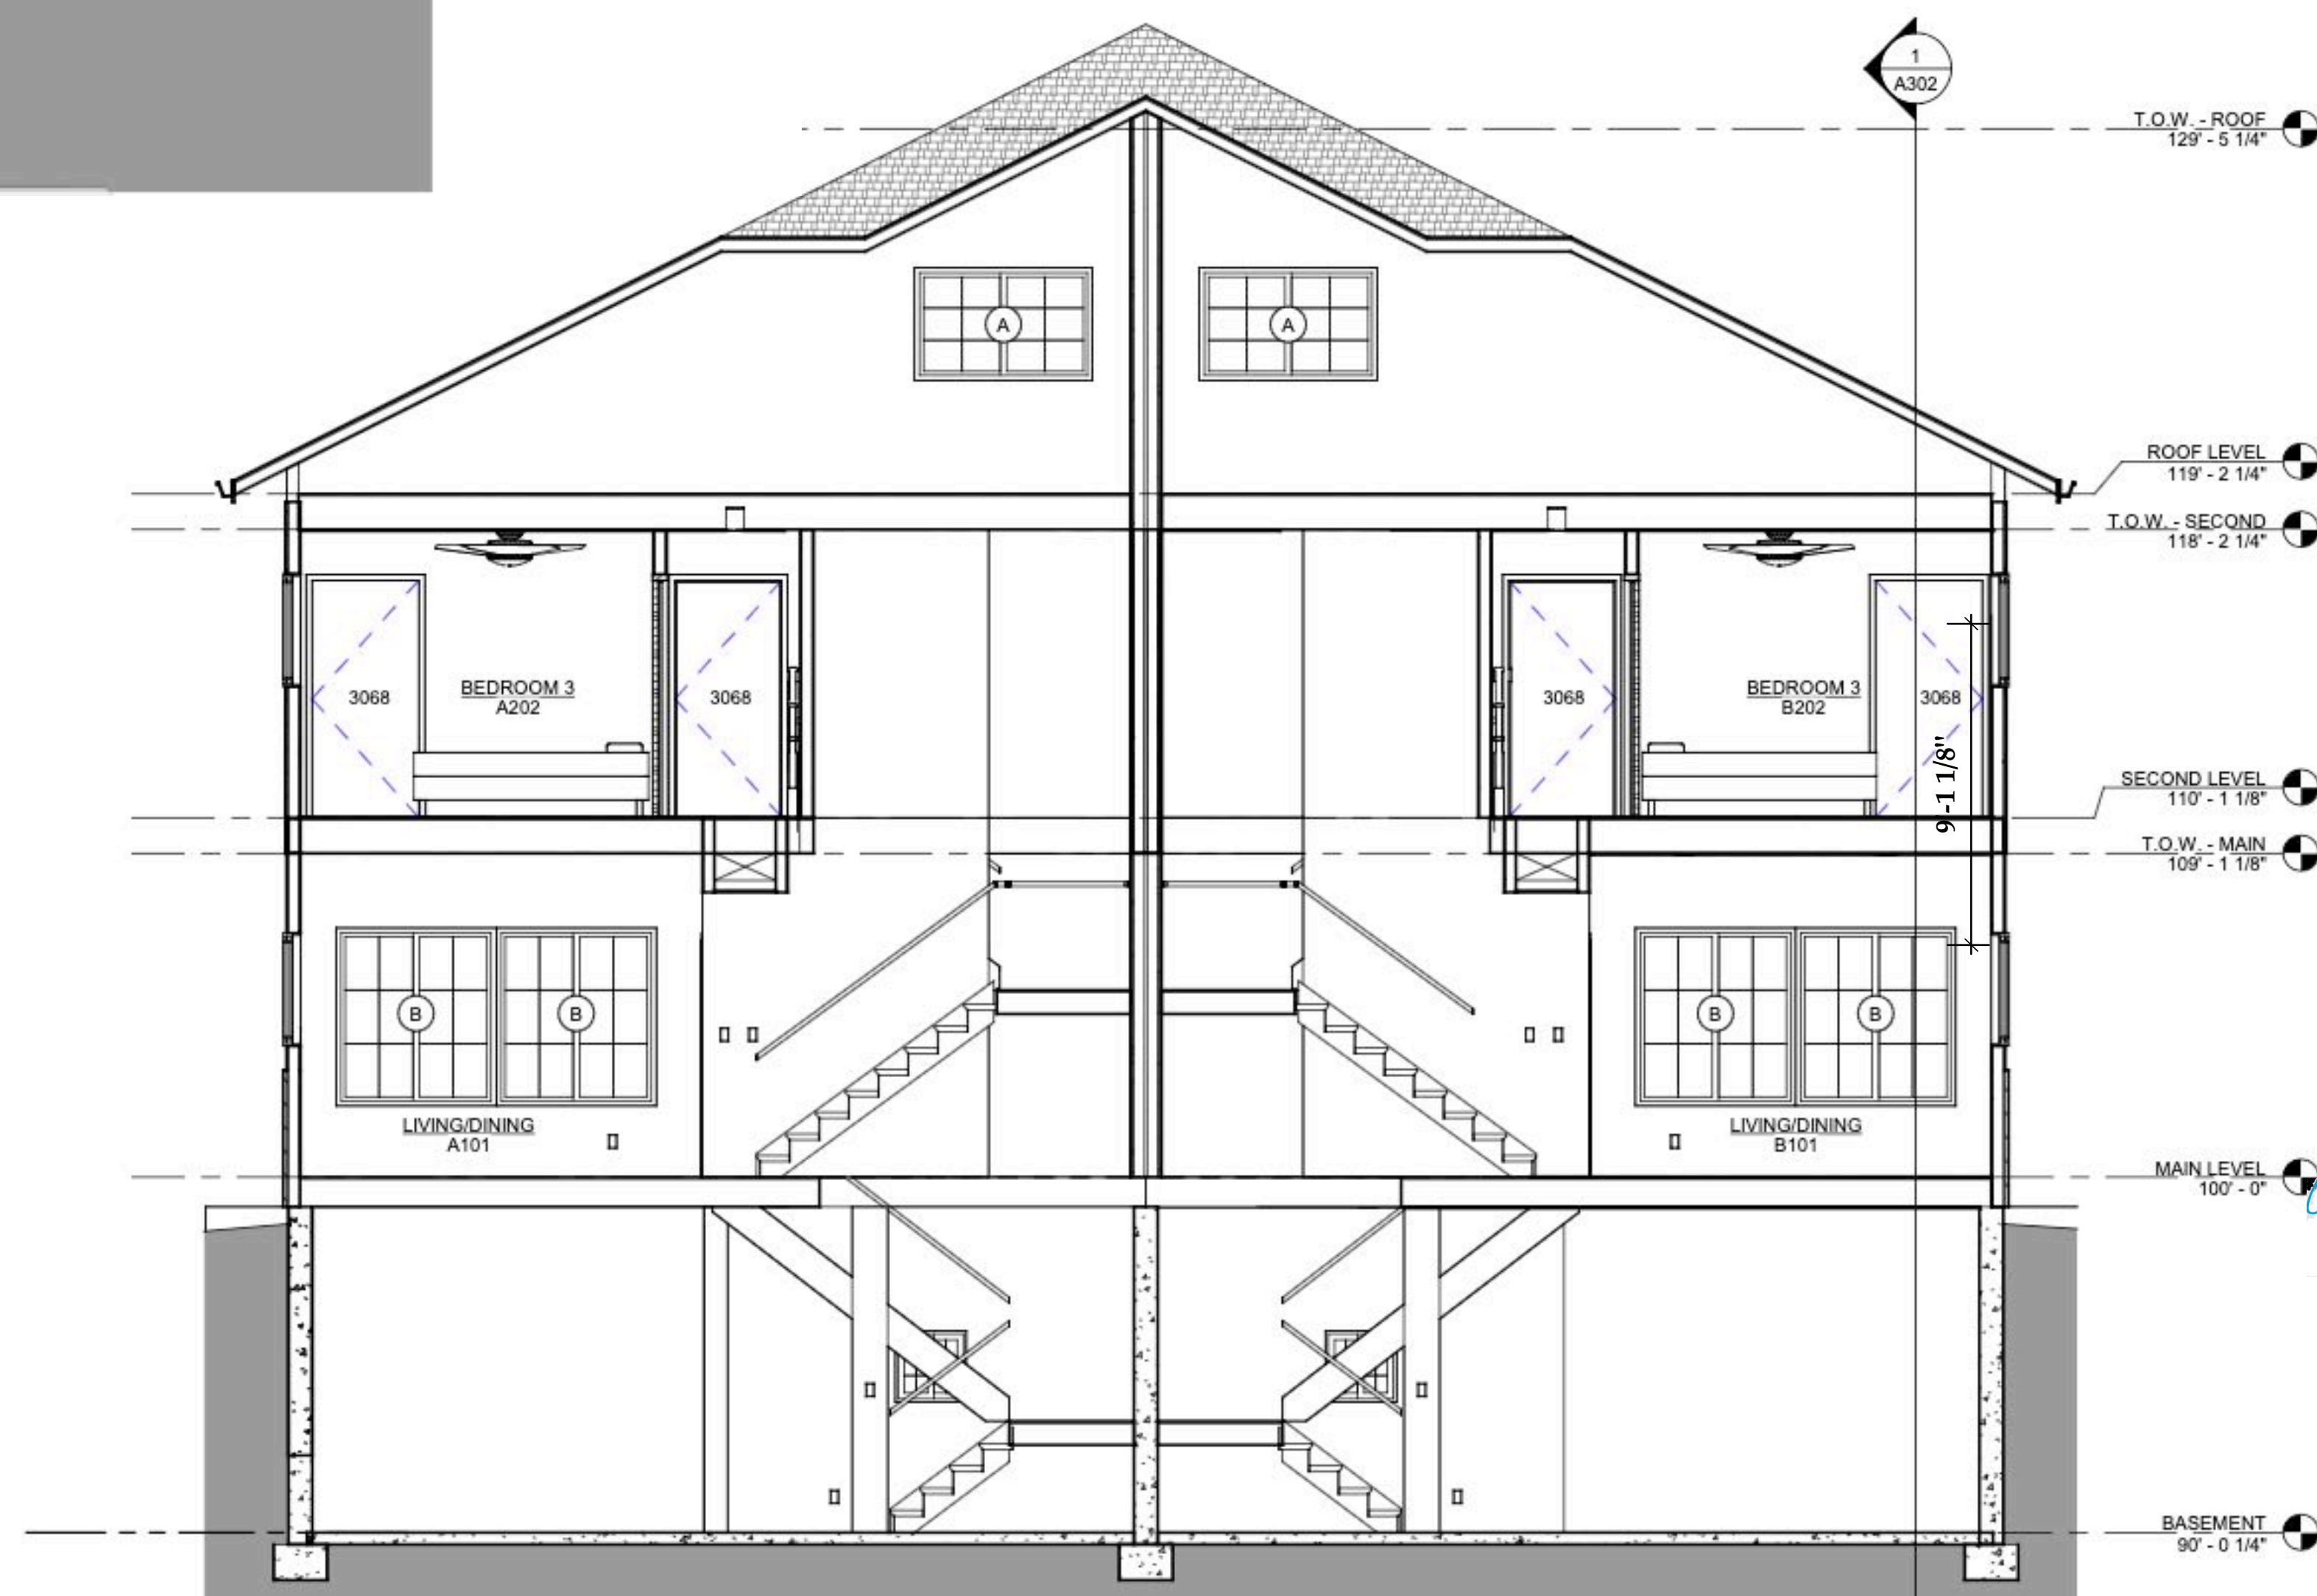

building section stairs looking south

1/4" = 1'-0"

RELEASE FOR CONSTRUCTION
AS NOTED FOR PLAN REVIEW
DEVELOPMENT SERVICES
LEE'S SUMMIT, MISSOURI
05/02/2024

electrical/ceiling keynotes

- 1 GARAGE OPENER OUTLET IN CEILING
- 2 SOFFIT FOR HVAC ROUTING. SOFFIT TO BE 2'-0" WIDE AND 7'-0" AFF
- 3 SOFFIT FOR HVAC ROUTING. SOFFIT TO BE 8'-0" AFF
- 4 RESTROOM CEILING HEIGHT TO BE 8'-0"
- 5 PROVIDE 5/8" FIRE GUARD X GYP BD ON ENTIRE CEILING OF GARAGE

electrical/ceiling general notes

- 1. CARBON MONOXIDE DETECTORS SHALL BE INSTALLED PER R315.
- 2. SMOKE DETECTORS SHALL BE INSTALLED PER R314.
- 3. COORDINATE REQUIREMENTS FOR ALL ELECTRICAL FIXTURES WITH SPECIFIC SELECTED FIXTURE REQUIREMENTS PRIOR TO ROUGH-IN.
- 4. THIS HOUSE SHALL BE PROVIDED WITH A "UFER" GROUND PER IRC SECTION 3608.1

electrical/ceiling legend

CEILING TYPES

- EXTERIOR, PRE-FINISHED ALUMINUM SOFFIT PANELS
- PAINTED GYP. BD. CEILING

LIGHT FIXTURE TYPES

- RECESSED CAN LIGHT- REF. SCHEDULE FOR DETAILS
- OVER-VANITY LIGHT- REF. SCHEDULE FOR DETAILS
- CEILING FAN W/ LIGHT KIT- REF. SCHEDULE FOR DETAILS
- WALL SCONCE- REF. SCHEDULE FOR DETAILS
- LARGE PENDANT LIGHT- REF. SCHEDULE FOR DETAILS
- BATHROOM EXHAUST FAN- SWITCH AS INDICATED AND COORDINATE EXHAUST VENT WITH MECHANICAL CONTR

SWITCH TYPES

- GARAGE DOOR OPENER SWITCH
- CEILING FAN SWITCH- WIRE FOR INDEPENDENT FAN/SWITCH CONTROLS
- DIMMER SWITCH
- 3-WAY SWITCH
- 4-WAY SWITCH

OUTLET TYPES


- TELEPHONE/DATA OUTLET. COORDINATE WITH LOCAL PROVIDER AND OWNER
- CABLE-TV OUTLET. COORDINATE EXTERIOR LOCATION WITH LOCAL PROVIDER AND OWNER
- GFCI OUTLET PER CODE
- STANDARD DUPLEX OUTLET
- DUPLEX OUTLET W/ USB OUTLETS
- DUPLEX OUTLET AT MICROHOOD LOCATION OVER RANGE- MOUNT AT 60" A.F.F.
- GARBAGE DISPOSAL OUTLET UNDER SINK- WIRE TO SWITCH LOCATION AS INDICATED
- TELEVISION OUTLET- UTILIZE RECESSED OUTLET- MOUNT AT 60" A.F.F.
- 240V 4-SLOT DRYER OUTLET- MOUNT AT 36" A.F.F.

lighting fixture schedule

TYPE MARK	DESCRIPTION	COMMENTS
A	6" LED RECESSED CAN LIGHT	
B	6" LED RECESSED CAN LIGHT FOR EXTERIOR	
C	BEDROOM CEILING FAN W/ LIGHT KIT	
D	EXTERIOR WALL SCONCE	
E	OVER-VANITY FIXTURE- MASTER BATH	
F	OVER-VANITY FIXTURE- HALF BATH	
G	6" LED RECESSED CAN LIGHT FOR WET LOCATION	
H	ISLAND PENDANT	
J	LIGHT SOCKET WITH PULL STRING	
Grand total: 104		


SEQUOIA DUPLEX ALT #1
205 & 207 Orchard Court
LEE'S SUMMIT, MO

This Drawing And Information Contained Within Is Provided As An Instrument Of Service By The Architect, And Is Intended For Use On This Project Only. This Drawing Remains The Property Of The Architect And Shall Be Returned To Him Upon Completion Of The Construction Work. All Drawings, Specifications, Ideas, Designs And Arrangements Appearing Herein Constitute The Original And Unpublished Work Of The Architect. Any Reproduction, Use Or Disclosure Of The Proprietary Information Contained Herein Without The Prior Written Consent Of The Architect Is Strictly Prohibited.
 © AGMP 2023

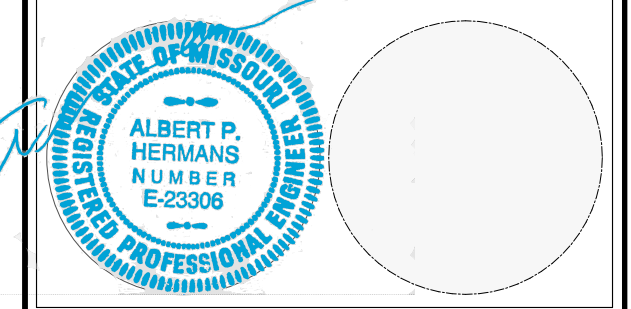


E101

1	Date	APRIL 26, 2024
2	REVISION	
3	REVISION	
4	REVISION	
5	REVISION	

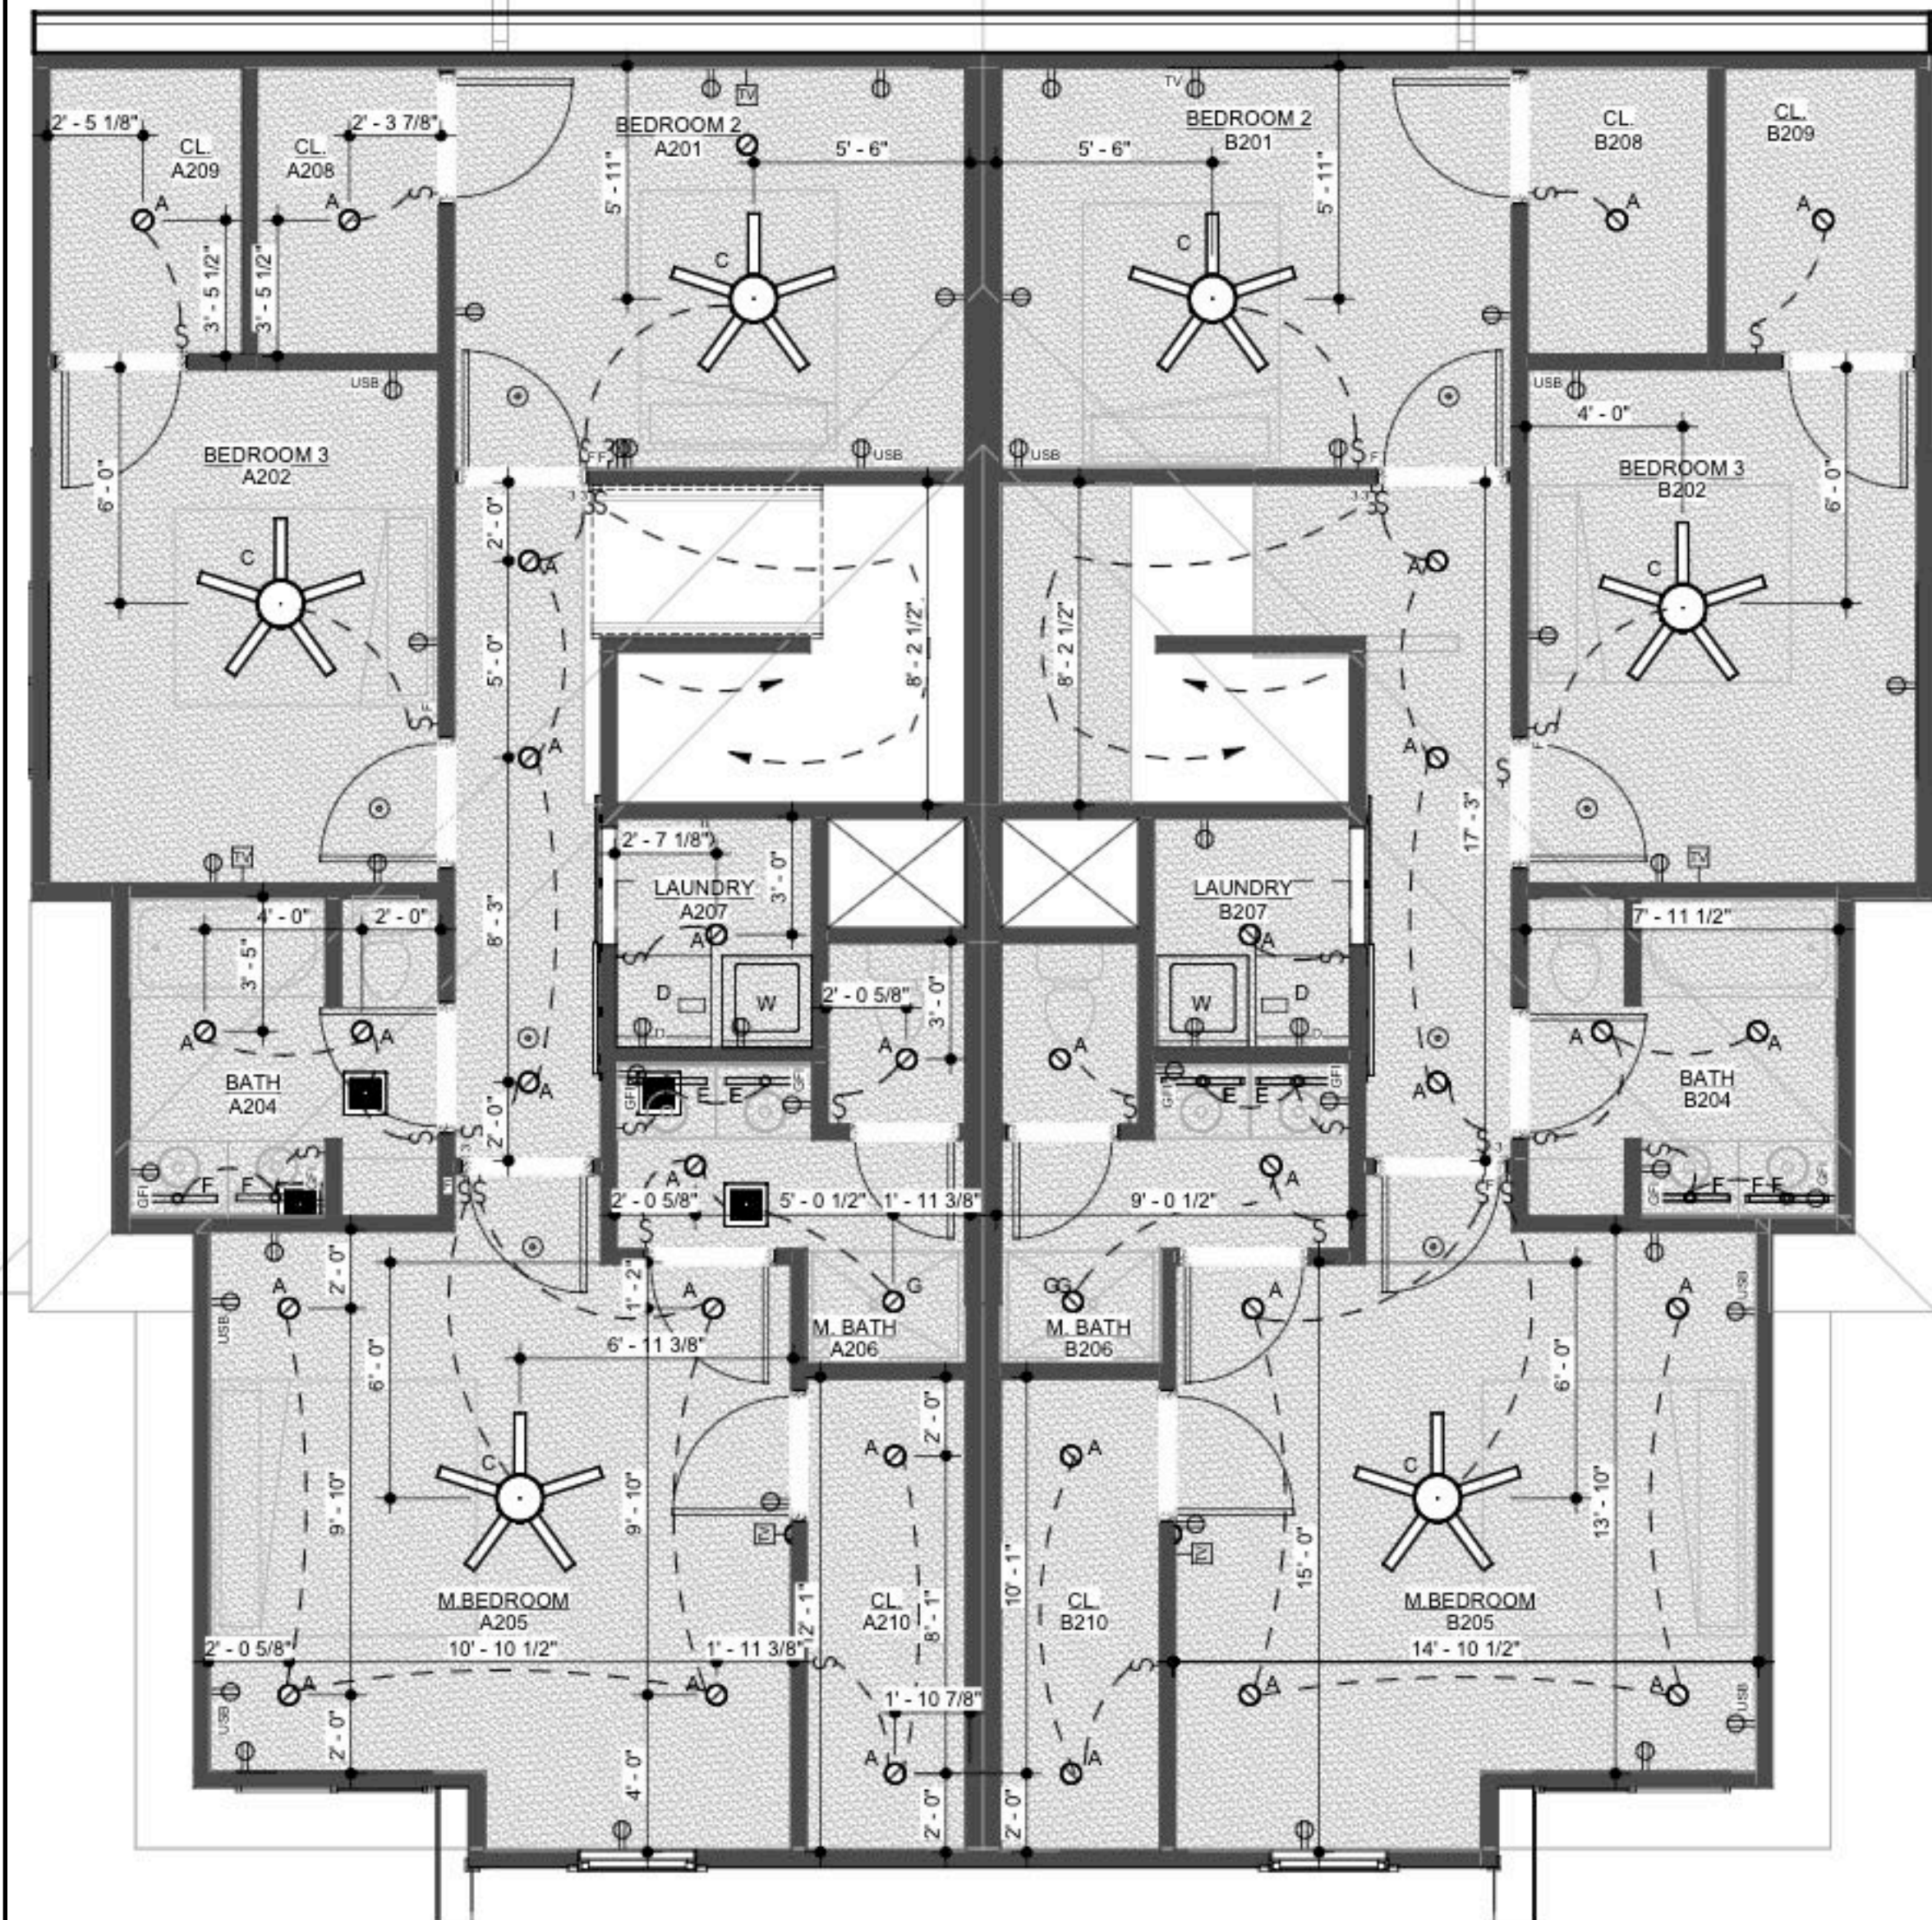

second floor electrical plan

1/4" = 1'-0"

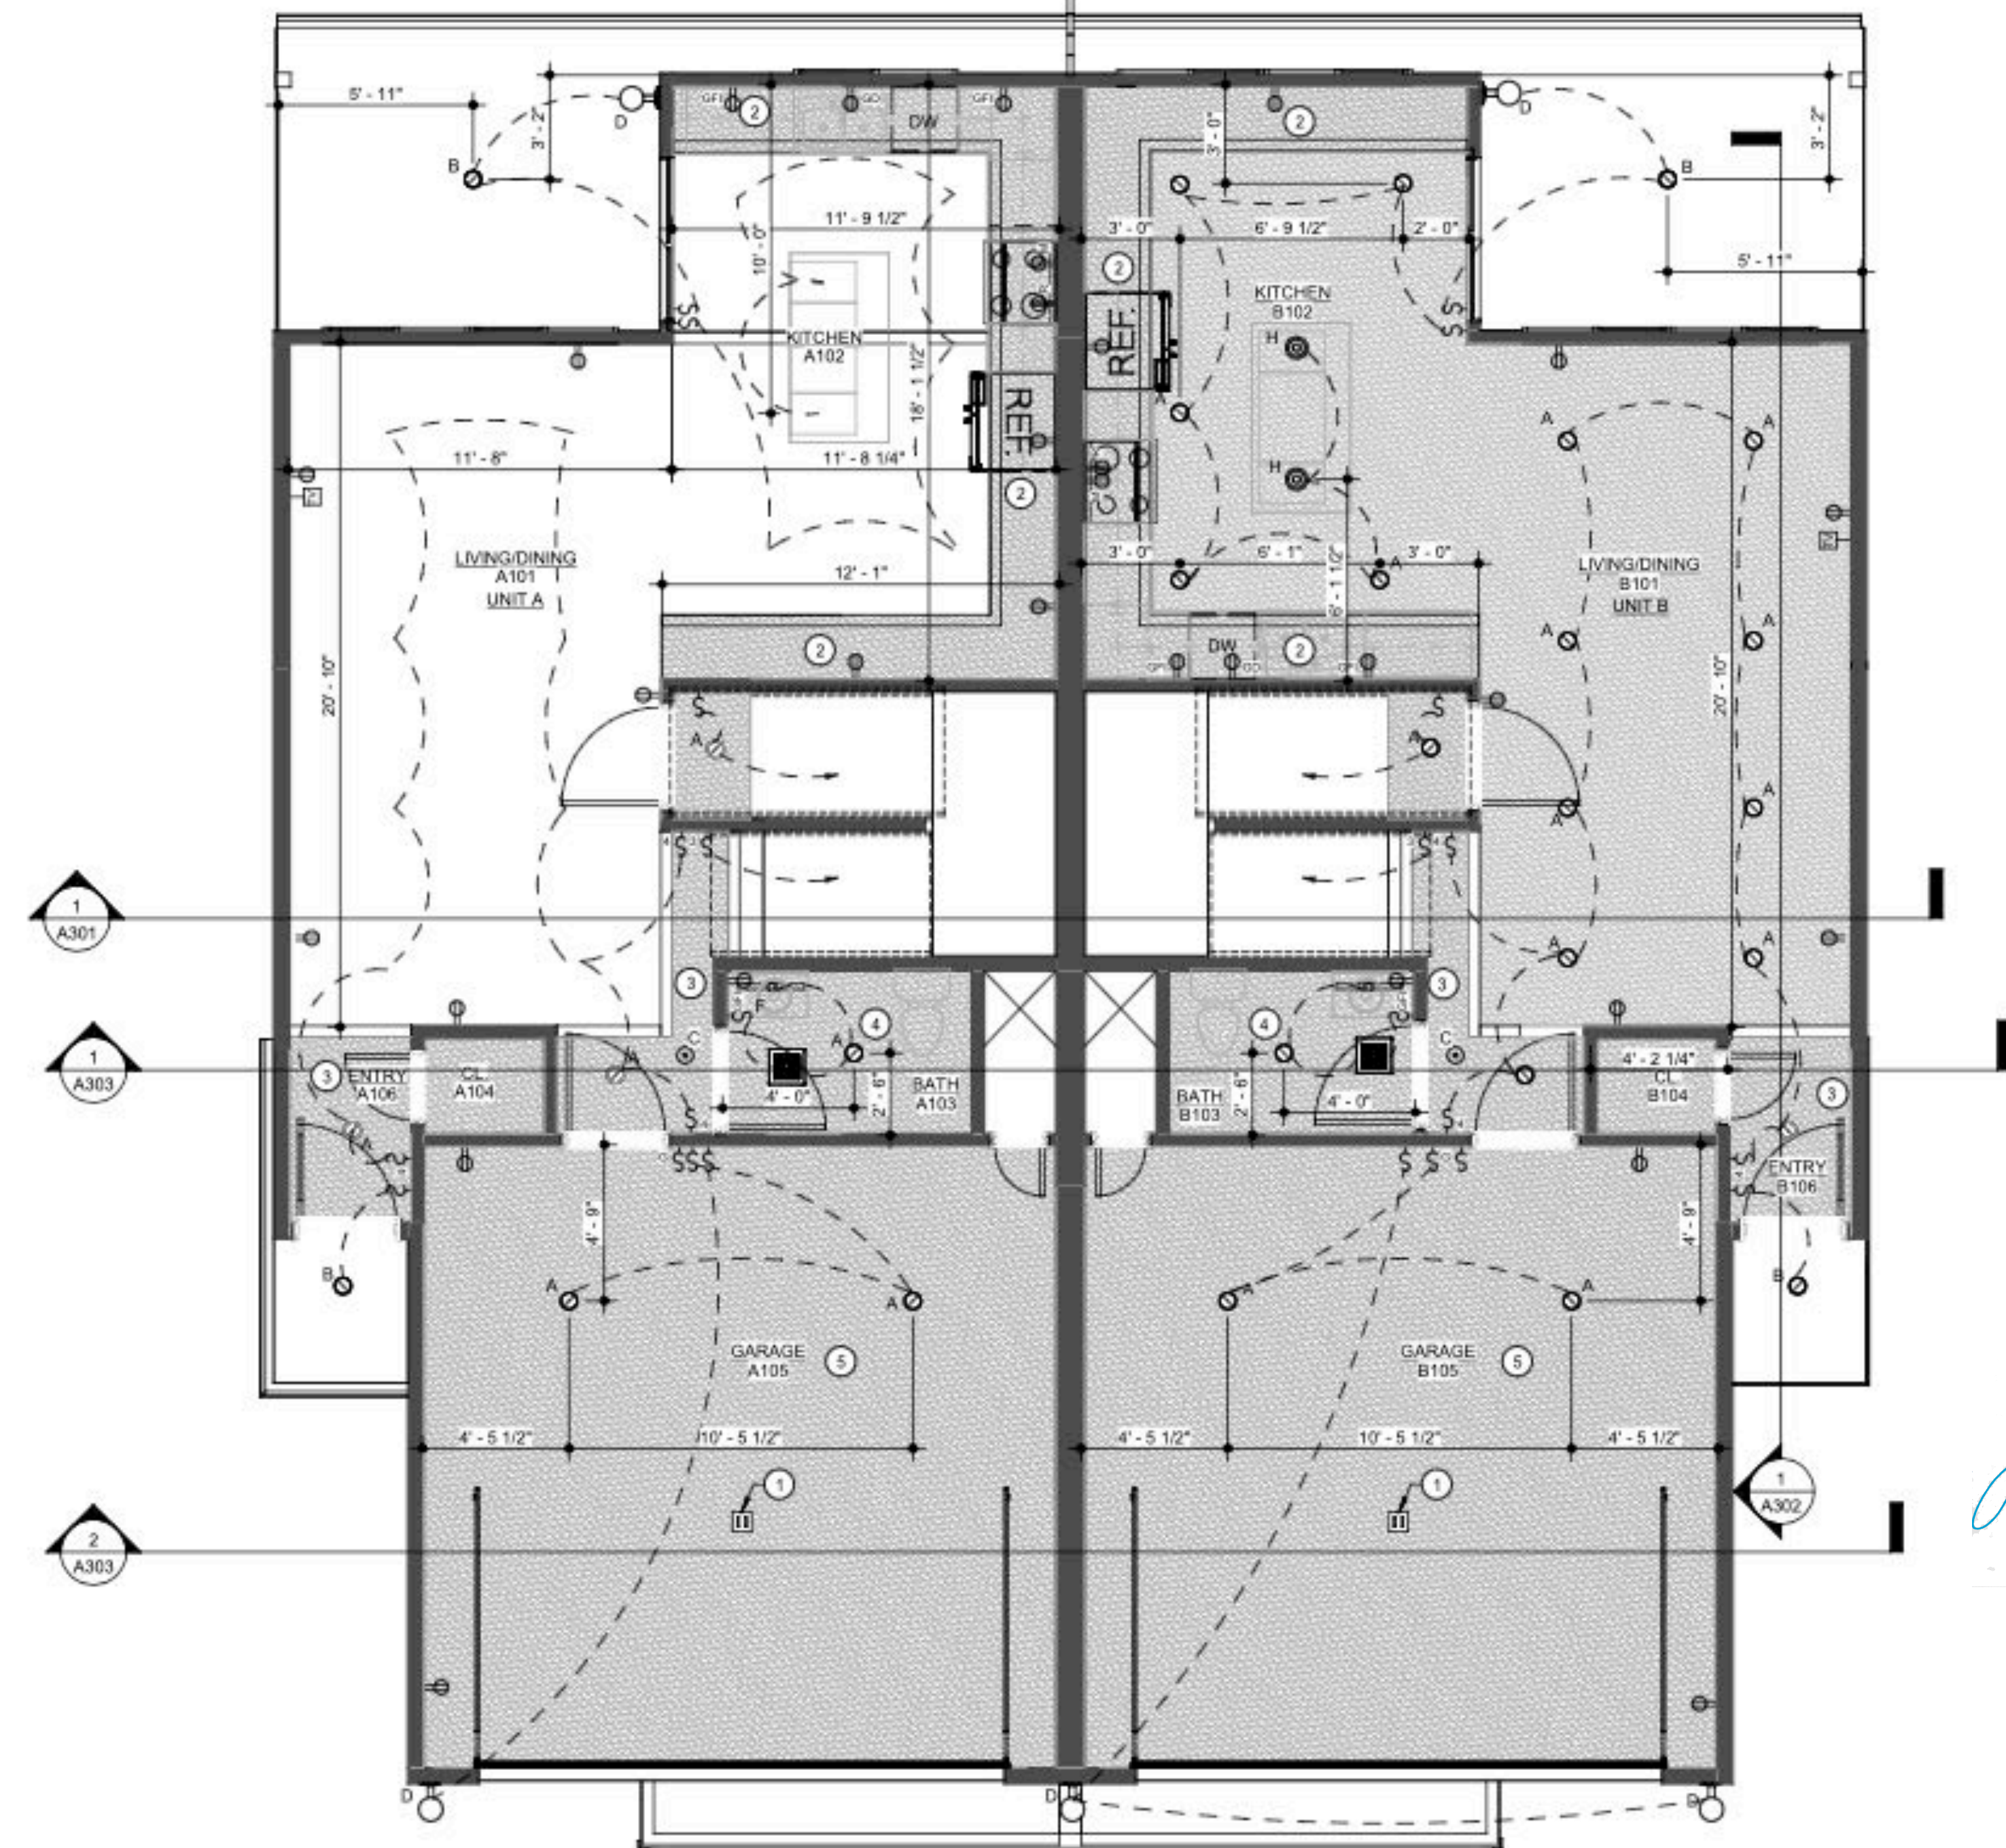

first floor electrical plan

1/4" = 1'-0"

FLOOR JOIST SCHEDULE

MARK	TYPE	SUB-TYPE	SIZE	SPACING	MAX. SPAN
FJ-1	1" Joist	TJI PRO 130	9 1/2"	12" O.C.	17'
FJ-2	1" Joist	TJI PRO 130	9 1/2"	16" O.C.	16'
FJ-3	1" Joist	TJI PRO 130	9 1/2"	19.2" O.C.	15'
FJ-4	1" Joist	TJI PRO 130	11 7/8"	12" O.C.	21'
FJ-5	1" Joist	TJI PRO 130	11 7/8"	16" O.C.	19'
FJ-6	1" Joist	TJI PRO 130	11 7/8"	19.2" O.C.	18'
FJ-7	1" Joist	TJI PRO 250	11 7/8"	12" O.C.	22'
FJ-8	1" Joist	TJI PRO 250	11 7/8"	16" O.C.	20'
FJ-9	1" Joist	TJI PRO 250	11 7/8"	19.2" O.C.	19'
FJ-20	Lumber	Treated#2 or BTR	2x6	12" O.C.	10'-9"
FJ-21	Lumber	Treated#2 or BTR	2x6	16" O.C.	9'-9"
FJ-22	Lumber	Treated#2 or BTR	2x8	12" O.C.	14'-2"
FJ-23	Lumber	Treated#2 or BTR	2x8	16" O.C.	12'-7"
FJ-24	Lumber	Treated#2 or BTR	2x10	12" O.C.	17'-9"
FJ-25	Lumber	Treated#2 or BTR	2x10	16" O.C.	15'-5"
FJ-26	Lumber		2-2x10	19.2" O.C.	
FJ-27	Lumber		2x12		
FJ-28	Lumber		2x12		

Note: "I" Joists Listed Above Are Manufactured By Trus Joist Macmillan And Spans Are Based On L / 480 Live Load Deflection

HEADER SCHEDULE

MARK	SIZE	NO. OF STUDS AT EACH END
Ⓐ	2-2x10's	2
Ⓑ	2-2x10's	2
Ⓒ	2-1 3/4" x 7 1/4" L.V.L.'S	2
Ⓓ	2-1 3/4" x 9 1/2" L.V.L.'S	3
Ⓔ	2-1 3/4" x 11 7/8" L.V.L.'S	3
Ⓕ	2-1 3/4" x 14" L.V.L.'S	4
Ⓖ	2-1 3/4" x 16" L.V.L.'S	4
Ⓗ	2-1 3/4" x 18" L.V.L.'S	4
Ⓙ	3-1 3/4" x 9 1/2" L.V.L.'S	4
Ⓚ	3-1 3/4" x 11 7/8" L.V.L.'S	4
Ⓛ	3-1 3/4" x 14" L.V.L.'S	5
Ⓜ	3-1 3/4" x 16" L.V.L.'S	5
Ⓝ	3-1 3/4" x 18" L.V.L.'S	5
Ⓟ	1-1 3/4" x 9 1/2" L.V.L.'S	2
Ⓠ	1-1 3/4" x 11 7/8" L.V.L.'S	2

Note: "U" Indicates Header Is Upset

CEILING JOISTS SCHEDULE

MARK	SIZE	SPACING	MAXIMUM SPAN
CI-1	2X6	12"	14'-10"
CI-2	2X6	16"	12'-10"
CI-3	2X8	12"	18'-9"
CI-4	2X8	16"	16'-3"
CI-5	2X10	12"	22'-11"
CI-6	2X10	16"	19'-10"

CONCRETE WALL SCHEDULE

MARK	CONCRETE WALL THICKNESS	HEIGHT	REINFORCING VERTICAL	HORIZONTAL
Ⓐ	8"	4' OR LESS	#4s AT 2' O.C.	2-#4s
Ⓑ	8"	4' TO 6'	#4s AT 2' O.C.	3-#4s
Ⓒ	8"	4' TO 8'	#4s AT 2' O.C.	4-#4s
Ⓓ	8"	8'	#4s AT 2' O.C.	4-#4s
Ⓔ	10"	9'	#4s AT 2' O.C.	5-#4s
Ⓕ	10"	4'	#4s AT 2' O.C.	2-#4s
Ⓖ	10"	8'	#4s AT 2' O.C.	4-#4s
Ⓗ	10"	9'	#4s AT 2' O.C.	5-#4s
Ⓛ	10"	10'	#4s AT 2' O.C.	6-#4s


COLUMN SCHEDULE

MARK	COLUMN SIZE	PAD SIZE	REINFORCING	MAX. LOAD
Ⓐ	3" II Gauge	30"x30"x12"	4-#4S Each Way	12K
Ⓑ	3.5" II Gauge	36"x36"x12"	4-#4S Each Way	18K
Ⓒ	3" Schedule 40	42"x42"x12"	5-#4S Each Way	24K
Ⓓ	3.5" Schedule 40	48"x48"x12"	5-#4S Each Way	32K
Ⓔ	6"x6" C.C.A.	18" x 18" x 3"		
Ⓕ	8"x8" Cedar	24" x 3"		


ROOF RAFTER SCHEDULE

MARK	SIZE	SPACING	MAXIMUM SPAN	
			FLAT CEILING	VAULTED CEILING
RJ-1	2 X 6	12"	16'-7"	16'-6"
RJ-2	2 X 6	16"	14'-4"	11'-11"
RJ-3	2 X 6	24"	11'-9"	9'-9"
RJ-4	2 X 8	12"	21'-0"	17'-5"
RJ-5	2 X 8	16"	18'-2"	15'-1"
RJ-6	2 X 8	24"	14'-10"	12'-4"
RJ-7	2 X 10	12"	25'-8"	21'-4"
RJ-8	2 X 10	16"	22'-3"	18'-5"
RJ-9	2 X 10	24"	18'-2"	15'-1"
RJ-10	2 X 12	16"	25'-9"	21'-5"
RJ-11	2 X 12	24"	18'-2"	17'-6"


Note: All Spans Figured Using #2 Douglas Fir And Tables 2308.10.3(1) And 2308.10.3(5) Respectively Of The 2000 IBC, Where Dead Load = 10 PSF

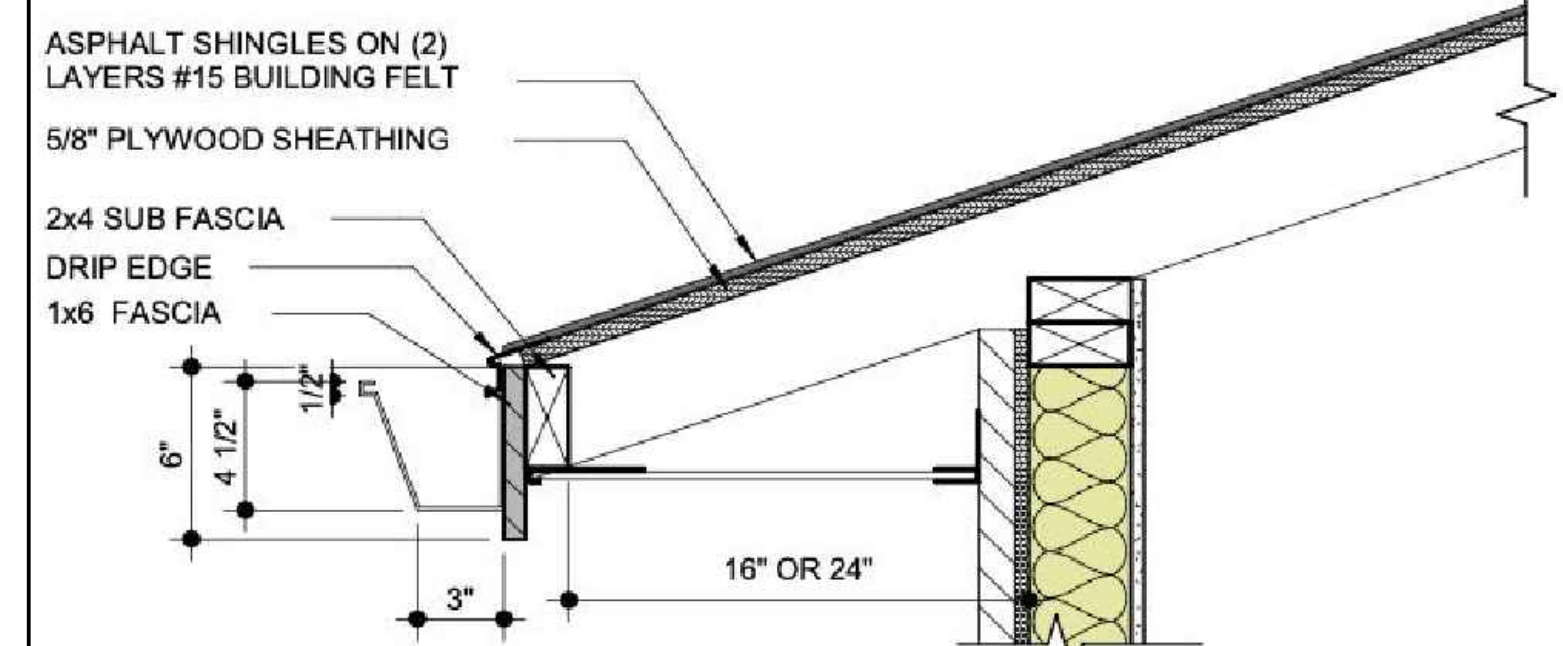

typical gutter detail
1 1/2" = 1'-0"

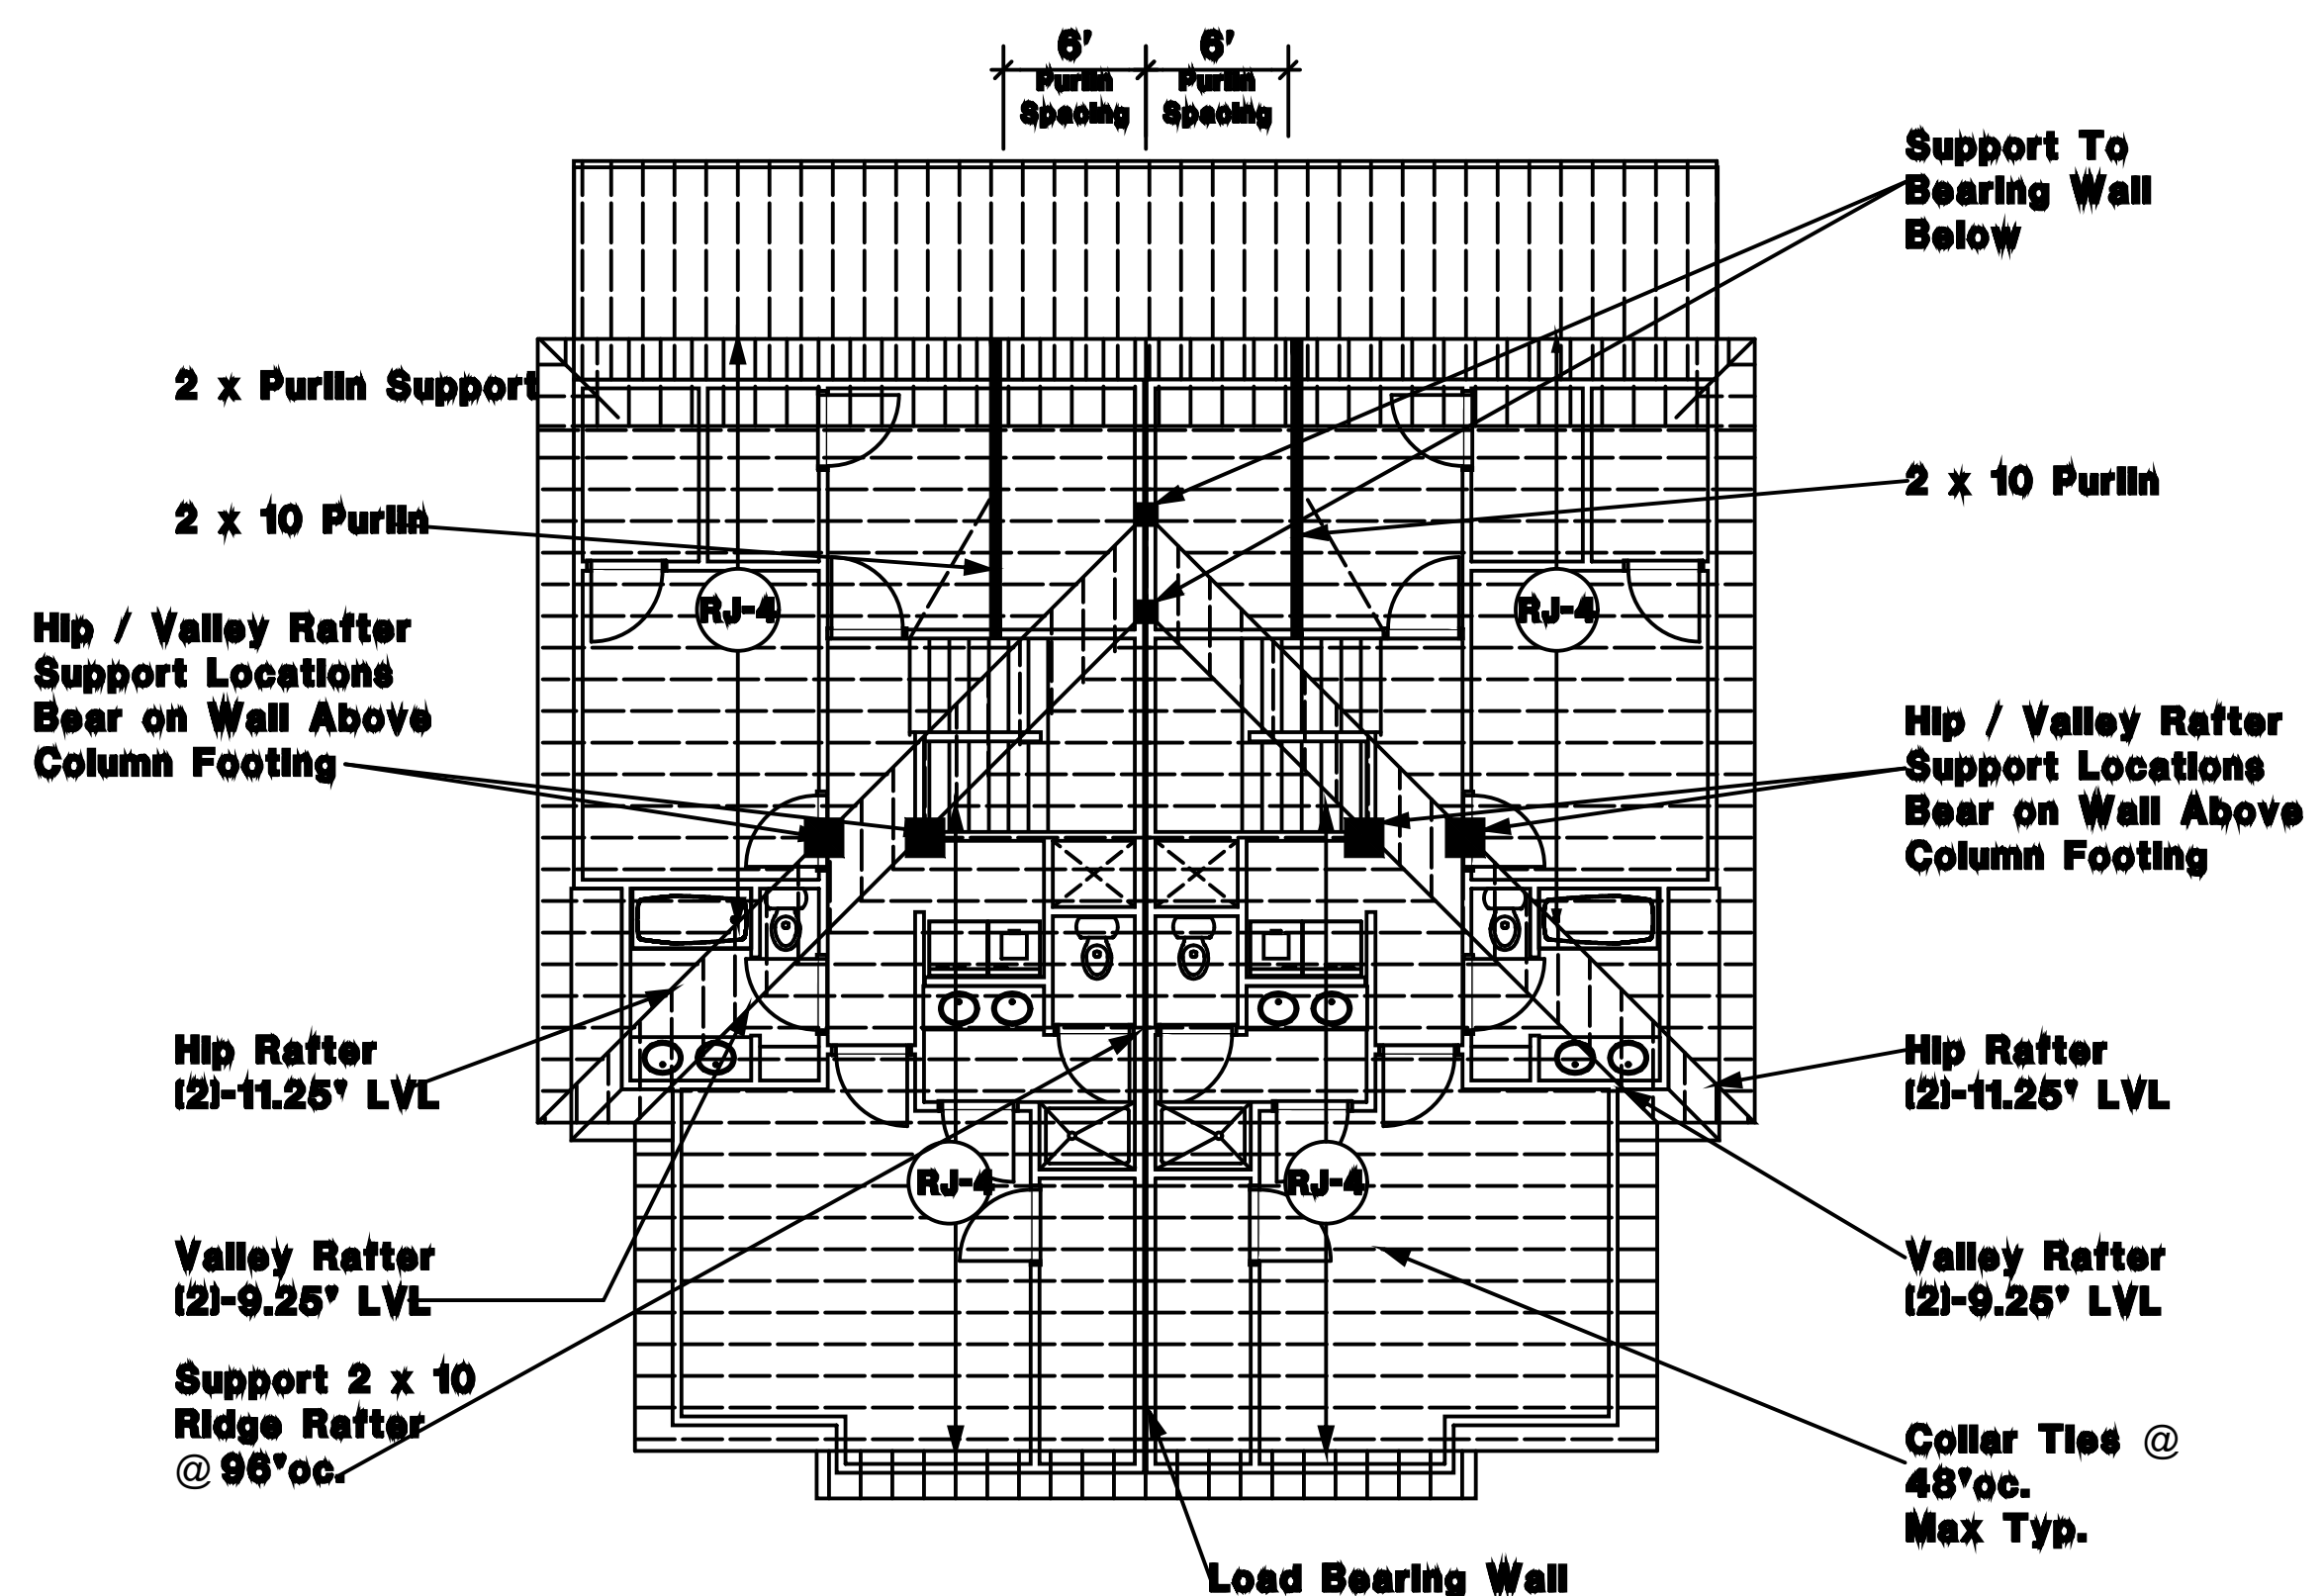

roof and framing plan
1/8" = 1'-0"

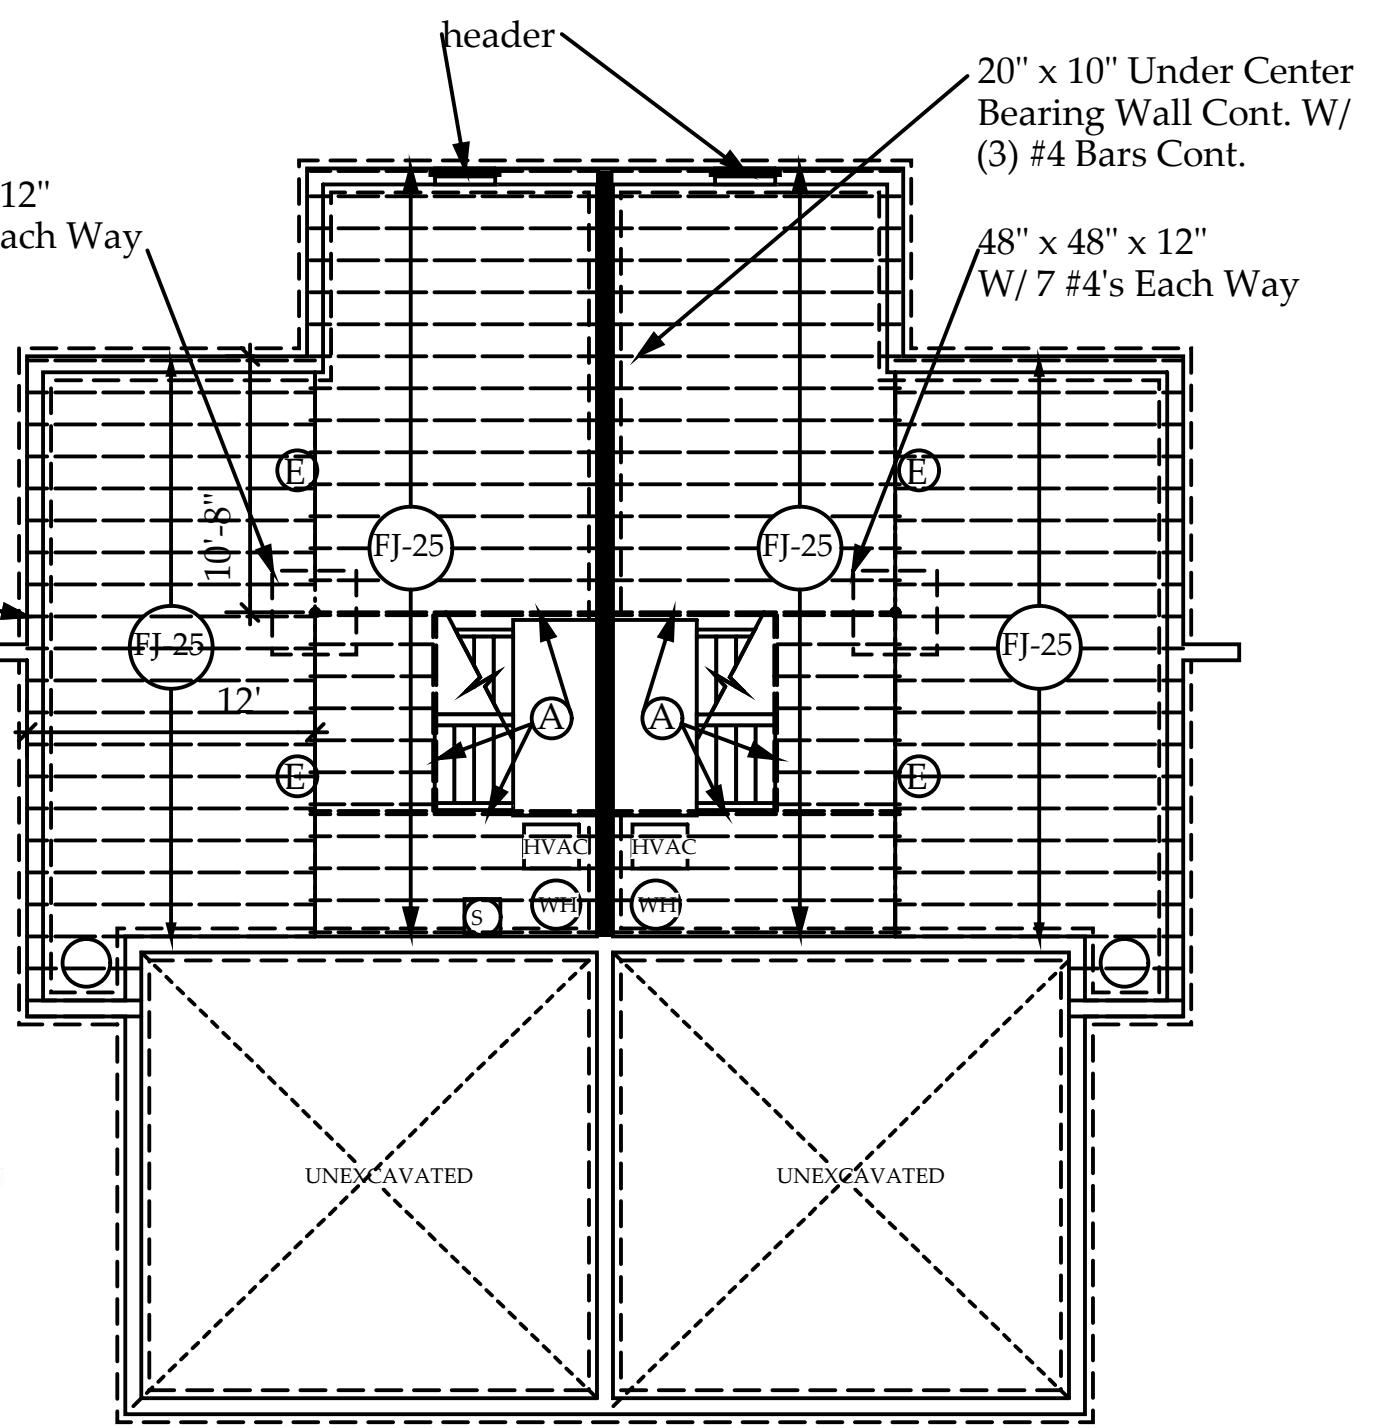


first floor framing plan
1/8" = 1'-0"

NOTE:
Provide Solid Blocking Between Joists Above Load Bearing Walls

NOTE:
All Door & Window Headers This Floor Shall Be "B" Type From Adjacent Schedule This Sheet Unless Otherwise Noted

Load Bearing Wall Typical All

Areas Of Braced Wall Typical All Floors

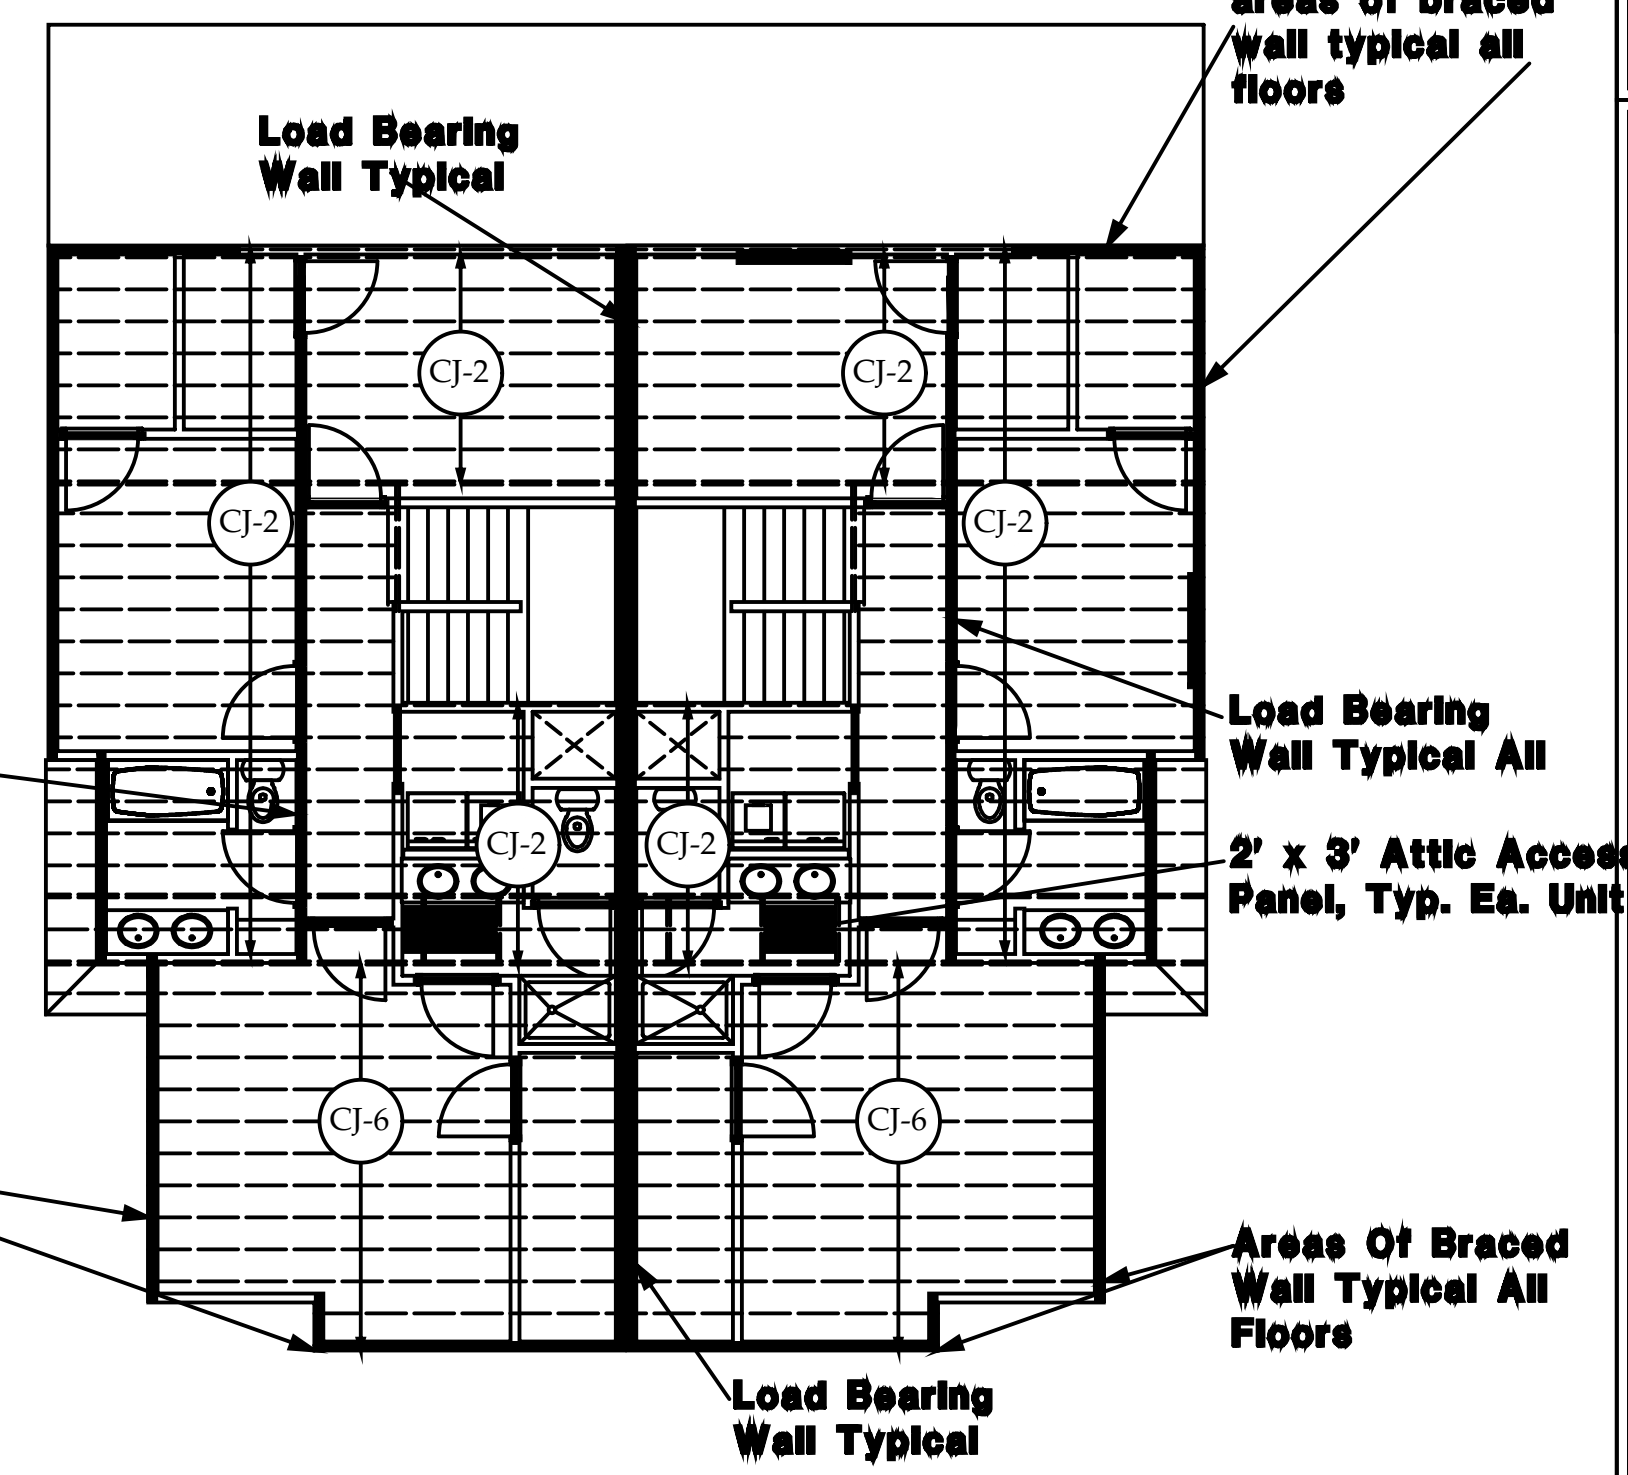

second floor ceiling framing plan
1/8" = 1'-0"

NOTE:
All Door & Window Headers This Floor Shall Be "B" Type From Adjacent Schedule This Sheet Unless Otherwise Noted

LOADS & ROOF DESIGN
Wind Load =15 MPH
Snow Load=20 LBS
Floor Loads
Dead Load = 15 LBS
Live Load = 40 LBS
Soil Bearing Capacity Assumed To Be 2000 P&F
Snow Load Importance Factor Category "I" 1.0
Snow Exposure Factor Terrain "B" 1.0
Thermal Factor 1.0
Wind Importance Factor Exposure "B"
Seismic Use Importance Category "I" 1.0

NOTE:
Provide Solid Blocking Between Joists Above Load Bearing Walls

second floor framing plan
1/8" = 1'-0"

Architecture Graphics Management & Planning

Independence Office
Roy Browne 816-228-1111
Internet - Roy@AGMPARCH.com


Lee's Summit Office
Bruce Best 816-525-8918
Internet - Bruce@AGMPARCH.com

Roy Browne Architect of Record

SEQUOIA DUPLEX ALT #1
205 & 207 Orchard Court
LEE'S SUMMIT, MO

This Drawing And Information Contained Within Is Provided As An Instrument Of Service By The Architect, And Is Intended For Use On This Project Only. This Drawing Remains The Property Of The Architect And Shall Be Returned To Him Upon Completion Of The Construction Work. All Drawings, Specifications, Ideas, Designs And Arrangements Appearing Herein Constitute The Original And Unpublished Work Of The Architect. Any Reproduction, Use Or Disclosure Of The Proprietary Information Contained Herein Without The Prior Written Consent Of The Architect Is Strictly Prohibited.

© AGMP 2023

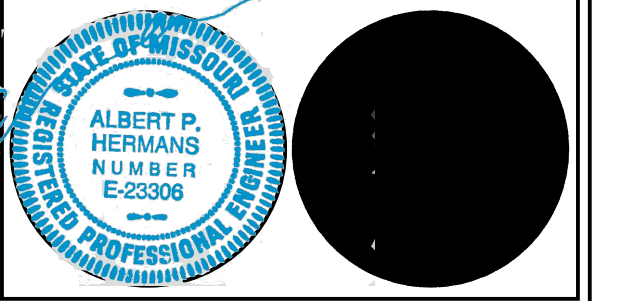

S-1

1	Date	APRIL 26, 2024
2	REVISION	
3	REVISION	
4	REVISION	
5	REVISION	

GENERAL NOTES

Table with 2 columns: Designation (e.g., GOVERNING BUILDING CODE, DESIGN LOADS, ROOF DEAD LOAD, ROOF LIVE LOAD, FLOOR DEAD LOAD, FLOOR LIVE LOAD, WIND LOADS, SEISMIC LOADS, ASSUMED ALLOWABLE SOIL BEARING PRESSURE) and Value (e.g., 2018 INTERNATIONAL RESIDENTIAL CODE (IRC) AND ITS APPROPRIATE SUPPLEMENTS, 10 psf, 20 psf, 10 psf, 30 psf, 40 psf, Vas=90 MPH, EXPOSURE B, SITE CLASS "B", 1500 PSF)

GENERAL:

- 1. FURNISH ALL LABOR, MATERIAL AND EQUIPMENT NECESSARY TO COMPLETE THE WORK SHOWN OR INFERRED BY THESE DRAWINGS.
2. THE GENERAL CONTRACTOR SHALL BE RESPONSIBLE FOR VERIFYING ALL DIMENSIONS AND ELEVATIONS SHOWN ON THE PLANS AND FOR COORDINATING ALL DIMENSIONS AND ELEVATIONS SHOWN WITH THE EXISTING CONDITIONS.
3. THE CONTRACTOR SHALL PROVIDE ALL TEMPORARY BRACING AND SHORING AS REQUIRED DURING CONSTRUCTION TO ENSURE THE SAFETY OF ALL INDIVIDUALS INVOLVED.
4. ALL MECHANICAL, ELECTRICAL, AND PLUMBING ELEMENTS SHALL BE INSTALLED PER THE REQUIREMENTS OF THE GOVERNING BUILDING CODE AND THE LOCAL MUNICIPALITY.
5. NORTON & SCHMIDT CONSULTING ENGINEERS, L.L.C. HAS DESIGNED THE STRUCTURAL FLOOR FRAMING AND WALL BRACING SYSTEM OF THESE PLANS FOR THE CONSTRUCTION OF A RESIDENCE AT THE ADDRESS REFERENCED IN THE PLANS.

STRUCTURAL STEEL:

- 1. ALL STRUCTURAL STEEL SHALL CONFORM TO THE FOLLOWING:
STRUCTURAL STEEL ASTM A992, Fy = 50 KSI
MISCELLANEOUS STEEL ASTM A36
HOLLOW STRUCTURAL STEEL (HSS) ASTM A500, GRADE B
STEEL PIPE ASTM A53, GRADE B (SCHED 40 MIN)
2. ALL BEAM CONNECTIONS SHALL BE DESIGNED BY THE STEEL FABRICATOR UNDER THE DIRECTION OF A REGISTERED PROFESSIONAL ENGINEER UNLESS SPECIFIC CONNECTIONS ARE SHOWN ON THE DRAWINGS.
3. ALL COLUMN ANCHOR BOLTS SHALL BE ASTM F1554 GRADE 36.
4. WELDING SHALL CONFORM TO THE LATEST PUBLICATION OF APPLICABLE CODES SET FORTH BY THE AMERICAN WELDING SOCIETY.
5. PROVIDE 30# WELD BOND BREAK AROUND ALL STEEL COLUMNS WHERE IN CONTACT WITH SLAB-ON-GRADE.
6. ALL EXTERIOR STEEL EXPOSED TO THE ELEMENTS SHALL BE HOT DIPPED GALVANIZED UNLESS NOTED OTHERWISE.
7. ALL STRUCTURAL STEEL SHALL HAVE ONE COAT OF RUST INHIBITIVE PRIMER CONFORMING TO SPECIFICATIONS. FIELD TOUCHUP ALL UNPAINTED AREAS AND WELD AREAS.

WOOD FRAMING NOTES:

- 1. ALL STRUCTURAL LUMBER (RAFTERS, CEILING JOISTS, PURLINS AND HEADERS) SHALL BE DOUGLAS FIR LARCH #2 OR BETTER UNLESS OTHERWISE NOTED ON THE DRAWINGS.
2. GLUE LAMINATED MEMBERS MARKED "LVL" (LAMINATED VENEER LUMBER) SHALL HAVE A MINIMUM ALLOWABLE BENDING STRESS (FB) OF 2600 PSI, A MINIMUM ALLOWABLE SHEAR STRESS (FV) OF 285 PSI, AND A MINIMUM MODULUS OF ELASTICITY (E) OF 2,000 KSI.
3. FLOOR JOISTS: SEE IRC TABLE R502.3.1(1) AND R502.3.1(2) FOR SPAN, SIZE, SPACING, AND GRADE OF FLOOR JOISTS.
4. FLOOR JOISTS BELOW PARTITION WALLS RUNNING PARALLEL TO THE JOIST SPAN SHALL BE DOUBLED.
5. SOLID BLOCKING BETWEEN FLOOR JOISTS SHALL BE INSTALLED WHERE JOISTS BEAR ON TOP OF BEAMS OR HEADERS AND BELOW POINT LOADS.
6. ALL FLOOR AND CEILING JOISTS THAT BUTT INTO THE SIDE OF A HEADER OR STEEL BEAM SHALL BE ANCHORED TO THE HEADER OR STEEL BEAM WITH STANDARD JOIST HANGERS.
7. ALL SUPPORTS FOR WOOD TRUSSES, RAFTERS AND PURLINS, UNLESS SHOWN OTHERWISE ON THE DRAWINGS, SHALL BEAR ON LOAD BEARING WALLS (WALLS LOCATED DIRECTLY ABOVE A BEAM LINE OR CONTINUOUS FOOTING).
8. ALL NAILING NOT INDICATED ON THE DRAWINGS SHALL CONFORM TO THE NAILING SCHEDULE OF THE GOVERNING BUILDING CODE.
9. ALL NON-LOADBEARING STUD WALLS IN THE BASEMENT SHALL BE PROVIDED WITH A 1" MINIMUM VERTICAL EXPANSION JOINT TO ALLOW FOR HEAVE IN THE FLOOR SLAB.
10. SHEATHING FOR HORIZONTAL DIAPHRAGMS SHALL BE EXTERIOR GRADE, CD, STRUCTURAL GROUP II OR BETTER.
11. ALL WOOD STRUCTURAL PANELS SHALL BE IDENTIFIED WITH THE APPROPRIATE GRADE TRADEMARK OF THE AMERICAN PLYWOOD ASSOCIATION (APA) AND SHALL MEET THE REQUIREMENTS OF PRODUCT STANDARD PS-1.
12. WOOD STRUCTURAL PANELS SHALL BE SET WITH FACE GRAIN PERPENDICULAR TO SUPPORTING MEMBERS AND STAGGER END JOINTS 4'-0".
13. STANDARD WASHERS SHALL BE USED WITH ALL BOLTS FASTENING WOOD MEMBERS.
14. ALL SAWN LUMBER EXPOSED TO WEATHER OR IN CONTACT WITH CONCRETE OR MASONRY SHALL BE PRESSURE TREATED.
15. ROOF FRAMING - RIDGE BEAMS, VALLEY AND HIP RAFTERS SHALL HAVE A MINIMUM NOMINAL THICKNESS OF 2" AND MINIMUM DEPTH NOT LESS THAN THE END CUT OF THE RAFTERS.
16. CEILING JOISTS: SEE IRC TABLE R802.4(2) FOR SPAN, SIZE, SPACING, AND GRADE OF CEILING JOISTS.
17. ROOF RAFTERS: SEE IRC TABLE R802.5.1(1) THRU R802.5.1(9) FOR SPAN, SIZE, SPACING, AND GRADE OF ROOF RAFTERS.
18. BRACE THE COMPRESSION FLANGE OF ALL BEAMS UNLESS NOTED OTHERWISE.
19. ALL BEAMS OR HEADERS THAT BEAR ON WOOD FRAMING SHALL BE SUPPORTED BY ANOTHER BEAM OR HEADER OR A BUILT-UP STUD COLUMN.
20. ALL LIGHT GAGE METAL FRAMING ACCESSORIES NOTED SHALL BE AS MANUFACTURED BY "SIMPSON STRONG TIE" OR APPROVED EQUAL.
21. PROVIDE HEADERS AS SHOWN ON PLAN, FOR HEADERS NOT MARKED REFERENCE TYPICAL BEARING WALL HEADER SCHEDULE.
22. FLOOR SHEATHING SHALL BE 3/4" TONGUE & GROOVE WOOD STRUCTURAL PANEL.
23. ALL EXTERIOR WOOD WALL FRAMING SHALL BE 2x6 DOUG-FIR STUD GRADE AT 16" OC, UNO.
24. ALL INTERIOR BEARING WALL FRAMING SHALL BE 2x4 DOUG-FIR STUD GRADE AT 16" OC, UNO.
25. WOOD TRUSSES AND THEIR CONNECTIONS SHALL BE DESIGNED BY THE TRUSS MANUFACTURER FOR THE LOADS STIPULATED ON THE DRAWINGS.
26. TEMPORARY STABILITY OF WOOD TRUSSES DURING ERECTION SHALL BE THE RESPONSIBILITY OF THE CONTRACTOR IN CONJUNCTION WITH ALL RECOMMENDATIONS OF THE MANUFACTURER.
27. WOOD TRUSSES SHALL NOT BE FIELD CUT.
28. MULTIPLE STUD MEMBERS CALLED OUT FOR SUPPORT OF LVL BEAMS AND HEADERS SHALL BE CARRIED DOWN TO TOP OF FOUNDATIONS OR SUPPORT BEAMS(S).

FOUNDATION NOTES:

- 1. ALL FOUNDATIONS SHALL BEAR ON NATIVE, UNDISTURBED SOIL CAPABLE OF SUPPORTING 1,500 PSF UNLESS NOTED OTHERWISE.
2. ALL EXTERIOR FOOTINGS SHALL BEAR A MIN. OF 36" BELOW FINISHED GRADE.
3. IF THE EXISTING SITE TOPOGRAPHY OR SOIL CONDITIONS VARY FROM THE CONDITIONS SHOWN ON THE DRAWINGS, IT SHALL BE THE RESPONSIBILITY OF THE CONTRACTOR TO NOTIFY THE ARCHITECT/ENGINEER SO THAT A DESIGN THAT IS APPROPRIATE FOR THE SITE CAN BE GENERATED.
4. FOOTINGS SHALL BE POURED CONTINUOUS AT FOOTING STEPS (SOLID JUMPS).
5. ANY FILL THAT IS INSTALLED UNDER THE BASEMENT OR GARAGE FLOOR SLABS SHALL BE PROPERLY COMPACTED TO PREVENT SETTLEMENT OF THE FILL MATERIAL.
6. CONTROL JOINTS IN THE FLOOR SLABS SHALL BE INSTALLED AS TO MINIMIZE THE AMOUNT OF RANDOM CRACKING.
7. THE BUILDER SHALL BE RESPONSIBLE FOR TAKING THE APPROPRIATE STEPS TO MINIMIZE THE EFFECTS OF EXPANSIVE SOILS.
8. INSTALL CONTINUOUS DRAIN TILE (4" DIAMETER MINIMUM) AROUND THE PERIMETER OF THE ENTIRE LOWER LEVEL AND COVER THE TILE WITH FILTER FABRIC AND COURSE CLEAN ROCK.
9. CONCRETE BASEMENT SLABS SHALL BE A MIN. OF 4" THICK OVER A MIN. OF 4" OF 12" X 12" CLEAN, GRADED ROCK.
10. PROVIDE A MIN. 6-MIL POLYETHYLENE MOISTURE BARRIER OVER GRAVEL BASE UNDER BASEMENT FLOOR SLABS.
11. ALL FOOTING AND SLAB REINFORCEMENT SHALL BE BLOCKED OFF SUBGRADE WITH CHAIRS OR CONCRETE BRICKS.

RESIDENTIAL BASEMENT WALL NOTES:

- 1. VERTICAL REBAR SPACING FOR CONCRETE FOUNDATION WALLS SHALL BE PER THE TABLE BELOW:

Table with 4 columns: WALL THICKNESS (6" OR LESS, 8", 10", 12"), WALL HEIGHT (6", 7", 8", 9", 10'), REINFORCING (60 KSI, 40 KSI) and REBAR SPECIFICATIONS.

- a. MINIMUM REQUIREMENT FOR VERTICAL REBAR IN PLAN CONCRETE WALLS IS #4 BARS @ 36" O.C. (ACI 332).
b. VERTICAL BARS SHALL BE CONTINUED TO WITHIN 4" OF THE TOP OF THE WALL.
c. REBAR SHALL BE POSITIONED AT THE TENSION FACE OF THE WALL, 1/2" FROM THE INSIDE FACE.
d. REINFORCEMENT SHALL LAP A MINIMUM OF 24" AT ENDS, SPLICES, AND AROUND CORNERS.
e. DESIGN BY A PROFESSIONAL ENGINEER IS REQUIRED FOR WALLS OVER 10' IN HEIGHT.
f. HORIZONTAL REINFORCING SHALL MATCH THE SIZE OF THE VERTICAL REINFORCING.
1. BARS SHALL LAP A MINIMUM OF 48 BAR DIAMETERS AT ENDS, SPLICES AND AROUND CORNERS.
2. CONTINUOUS WALL FOOTINGS SHALL BE A MINIMUM OF 16" WIDE AND 8" DEEP WITH (2) #4 BARS CONTINUOUS FOR 8" THICK WALLS, UNO.
3. FOUNDATION WALLS THAT RETAIN EARTH AND ENCLOSE INTERIOR SPACES AND FLOORS BELOW GRADE SHALL BE DAMP PROOFED FROM THE TOP OF THE FOOTING TO THE FINISHED GRADE WITH A BITUMINOUS COATING IN ACCORDANCE WITH SECTION R406.1.
4. INSULATION SHALL BE INSTALLED FOR ALL BASEMENT WALLS AS REQUIRED PER SECTION N1102.1.
5. ALL SITE RETAINING WALLS GREATER THAN 4'-0" IN HEIGHT SHALL REQUIRE A DESIGN BY A PROFESSIONAL ENGINEER.
6. A CONCRETE ENCASED GROUNDING ELECTRODE CONNECTION SHALL BE PROVIDED TO THE ELECTRICAL SERVICE PER SECTION E3008.1.

WOOD DECK FRAMING NOTES:

- 1. ALL WOOD DECK FRAMING SHALL COMPLY WITH THE LATEST EDITION OF THE "RESIDENTIAL DECKS - PERMIT AND CONSTRUCTION GUIDELINES" AS PUBLISHED BY THE JOHNSON COUNTY CONTRACTOR LICENSING PROGRAM.
2. WOOD FRAMING FOR EXTERIOR DECKS SHALL BE TREATED SOUTHERN PINE #2 OR BETTER.

ENERGY REQUIREMENTS

- 1. THE BUILDING THERMAL ENVELOPE SHALL BE SEALED WITH AN AIR BARRIER PER 2018 IRC SEC N1102.
2. LIGHTING FIXTURES PENETRATING THE THERMAL ENVELOPE SHALL BE RATED, LEAKAGE RATED AND SEALED TO THE GYPSUM WALLBOARD AS REQUIRED PER N1102.4.7.
3. PROGRAMMABLE THERMOSTATS SHALL BE INSTALLED AS REQUIRED PER N1103.1.1.
4. AIR HANDLERS SHALL BE RATED FOR MAXIMUM 2% AIR LEAKAGE RATE PER N1103.2.2.1.
5. BUILDING CAVITIES USED AS RETURN AIR PLenums SHALL BE SEALED TO PREVENT LEAKAGE ACROSS THE THERMAL ENVELOPE AS REQUIRED PER N1103.2.3.
6. BUILDING CAVITIES IN A THERMAL ENVELOPE WALL SHALL NOT BE USED AS RETURN AIR PLenums UNLESS THE REQUIRED INSULATION BARRIER IS MAINTAINED PER M1601.1.1.
7. HOT WATER PIPES SHALL BE INSULATED AS REQUIRED PER N1103.4.
8. ALL EXHAUST FANS SHALL TERMINATE TO THE BUILDING EXTERIOR AS REQUIRED PER M1507.2.
9. MAKEUP AIR SYSTEMS SHALL BE INSTALLED FOR KITCHEN EXHAUST HOODS THAT EXCEED 400 CFM AS REQUIRED PER M1503.4.
10. EXHAUST HANDLING SYSTEM SHALL NOT SERVE BOTH THE LIVING SPACE AND THE GARAGE PER M1601.1.
11. MINIMUM MECHANICAL EFFICIENCY RATING FOR AC EQUIPMENT IS 13 SEER AS REQUIRED PER 2012 IRC.
12. MINIMUM MECHANICAL EFFICIENCY RATING FOR FORCED AIR FURNACE IS 78% AS REQUIRED PER 2018 IRC.

ABBREVIATIONS LEGEND

Table with 3 columns: Abbreviation (e.g., AB, ACI, AFF, ASC, AISI, ARCH, ASTM, AWS, BFF, BFS, BO, BOS, BRG, BWP, CIP, CJ, CL, CLR, COL, CONC, CONST, CONJ, DAM, EIFS, ELEV, ELEC, EQ, EW, FDN, FF, FS, FTG, GA, GYP, HD, HORIZ, HSA, INFO, JST, JT, KSI, LBS, LONG, MAX), Full Name, and Description.


SYMBOLS LEGEND

Table with 3 columns: Symbol (e.g., Elevation designation, Section cut, Elevation detail, Wood structural panel, Alternate braced wall panel, Portal frame with hold-downs, Portal frame at garage), Description, and Revision Designation.

INSULATION AND FENESTRATION REQUIREMENTS - IRC TABLE N1102.1.1

Table with 2 columns: COMPONENT (e.g., FENESTRATION, SKYLIGHT, CEILING - FLAT, CEILING - VAULTED, WOOD FRAME WALL, MASS WALL, FLOOR OVER UNHEATED SPACE, FLOOR OVER OUTSIDE AIR, DUCTS OUTSIDE OF THE CONDITIONED SPACE, BASEMENT WALL, SLAB (R VALUE/DEPTH), CRAWLSPACE WALL W/ FLOOR INSULATION, CRAWLSPACE WALL W/O FLOOR INSULATION) and VALUE.

- a. R VALUES ARE MINIMUMS. U - FACTORS ARE MAXIMUMS.
b. THE FENESTRATION U - FACTOR EXCLUDES SKYLIGHTS.
c. THE FIRST R VALUE APPLIES TO CONTINUOUS INSULATION, THE SECOND TO FRAMING CAVITY INSULATION.
d. R - 5 SHALL BE ADDED TO THE REQUIRED SLAB EDGE R - VALUES FOR HEATED SLABS.
e. THERE ARE NO SHGC REQUIREMENTS IN THE MARINE ZONE.
f. BASEMENT WALL INSULATION IS NOT REQUIRED IN WARM-HUMID LOCATIONS AS DEFINED BY FIGURE N1101.10 AND TABLE N1101.10.
g. OR INSULATION SUFFICIENT TO FILL THE CAVITY, R - 19 MINIMUM.
h. FIRST VALUE IS CAVITY INSULATION, SECOND IS CONTINUOUS INSULATION OR INSULATED SIDING.
i. THE SECOND R VALUE APPLIES WHEN MORE THAN HALF OF THE INSULATION IS ON THE INTERIOR OF THE MASS WALL.

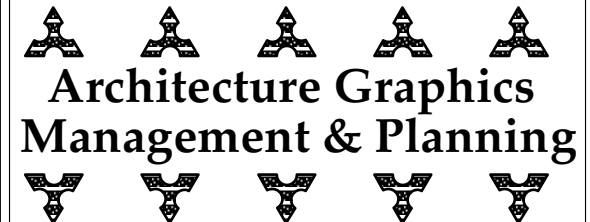


Independence Office
Roy Browne 816-228-1111
Internet - Roy@AGMPARCH.com

Lee's Summit Office
Bruce Best 816-525-8918
Internet - Bruce@AGMPARCH.com

Roy Browne Architect of Record

SEQUOIA DUPLEX ALT # 1
205 & 207 Orchard Court
LEE'S SUMMIT, MO

This Drawing And Information Contained Within Is Provided As An Instrument Of Service By The Architect. And Is Intended For Use On This Project Only. This Drawing Remains The Property Of The Architect And Shall Be Returned To Him Upon Completion Of The Construction Work.

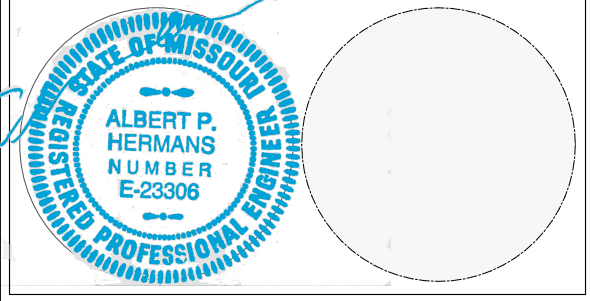

S100

Table with 3 columns: Revision Number, Date, and Revision Description (e.g., 1 Date APRIL 26, 2024, 2 REVISION APRIL 30, 2024, 3 REVISION, 4 REVISION, 5 REVISION)

SEQUOIA DUPLEX ALT #1
205 & 207 Orchard Court
LEE'S SUMMIT, MO


This Drawing And Information Contained Within Is Provided As An Instrument Of Service By The Architect, And Is Intended For Use On This Project Only. This Drawing Remains The Property Of The Architect And Shall Be Returned To Him Upon Completion Of The Construction Work. All Drawings, Specifications, Ideas, Designs And Arrangements Appearing Herein Constitute The Original And Unpublished Work Of The Architect. Any Reproduction, Use Or Disclosure Of The Proprietary Information Contained Herein Without The Prior Written Consent Of The Architect Is Strictly Prohibited.
© AGMP 2023




S500

1	Date	APRIL	26, 2024
2	REVISION		
3	REVISION		
4	REVISION		
5	REVISION		

RELEASE FOR CONSTRUCTION
AS NOTED FOR PLAN REVIEW
DEVELOPMENT SERVICES
LEE'S SUMMIT, MISSOURI
05/02/2024


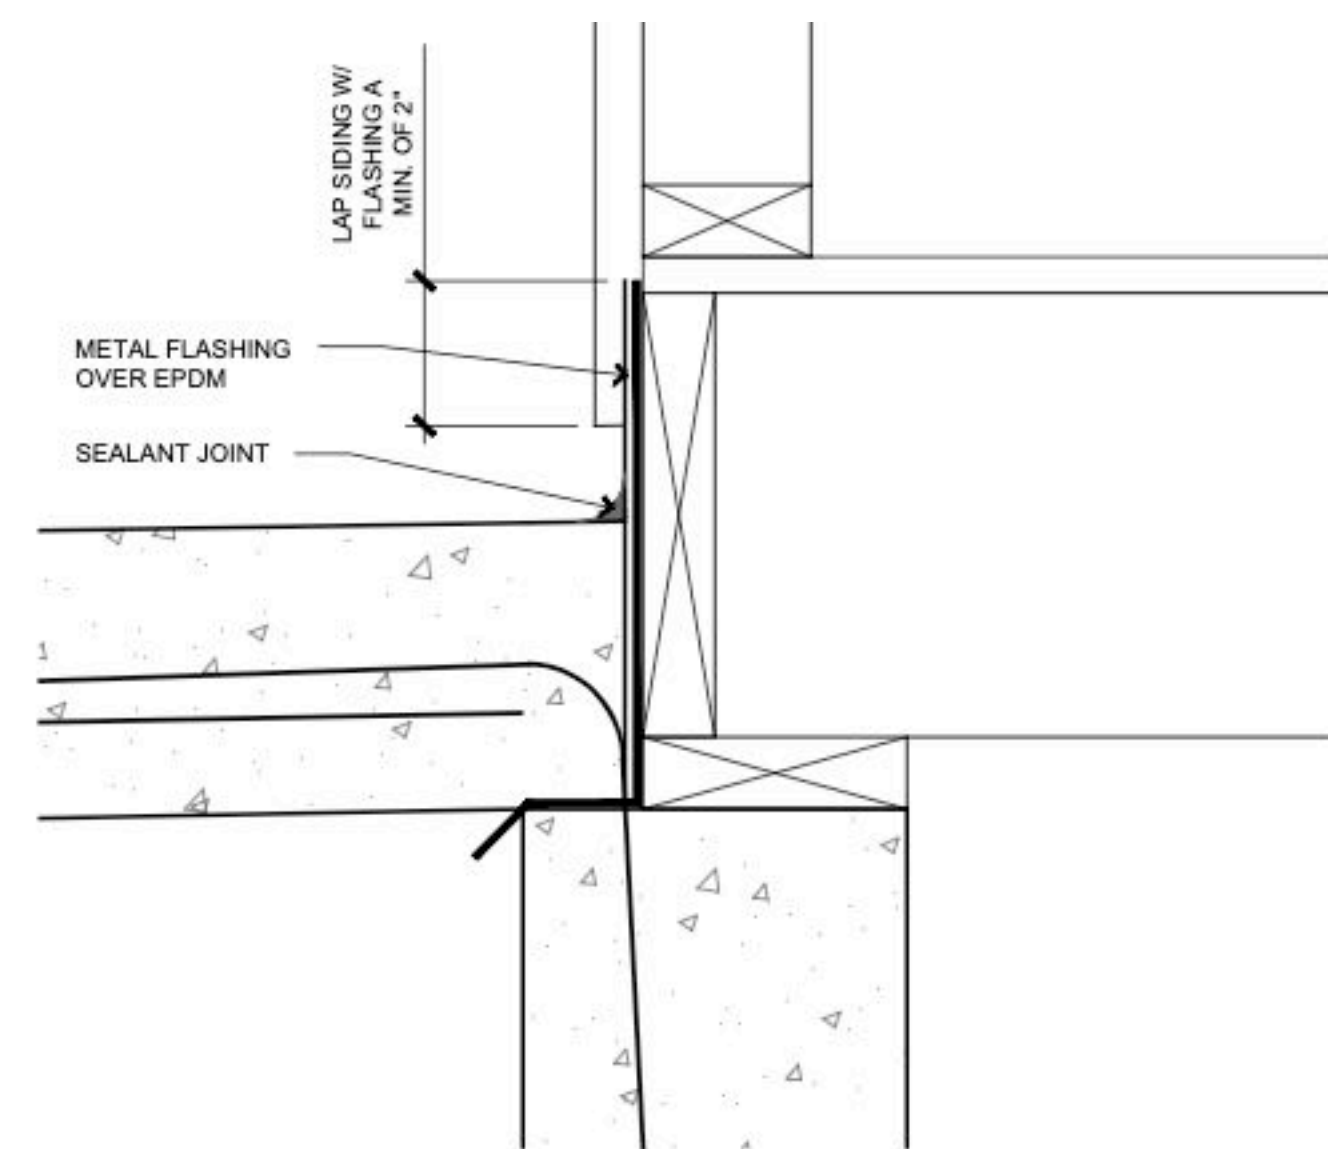


10 STOOP SECTION
SCALE: 3" = 1'-0"

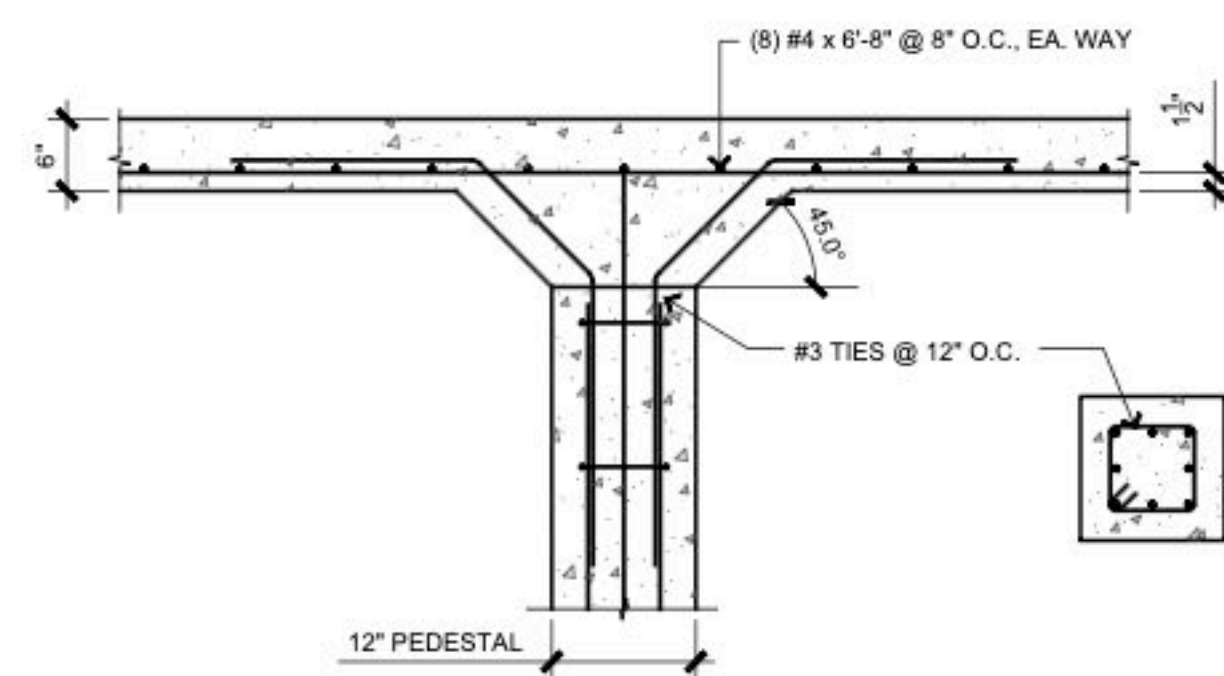


7 GARAGE SLAB AT PEDESTAL
SCALE: 3/4" = 1'-0"

4 GARAGE SLAB/WALL SECTION
SCALE: 3/4" = 1'-0"

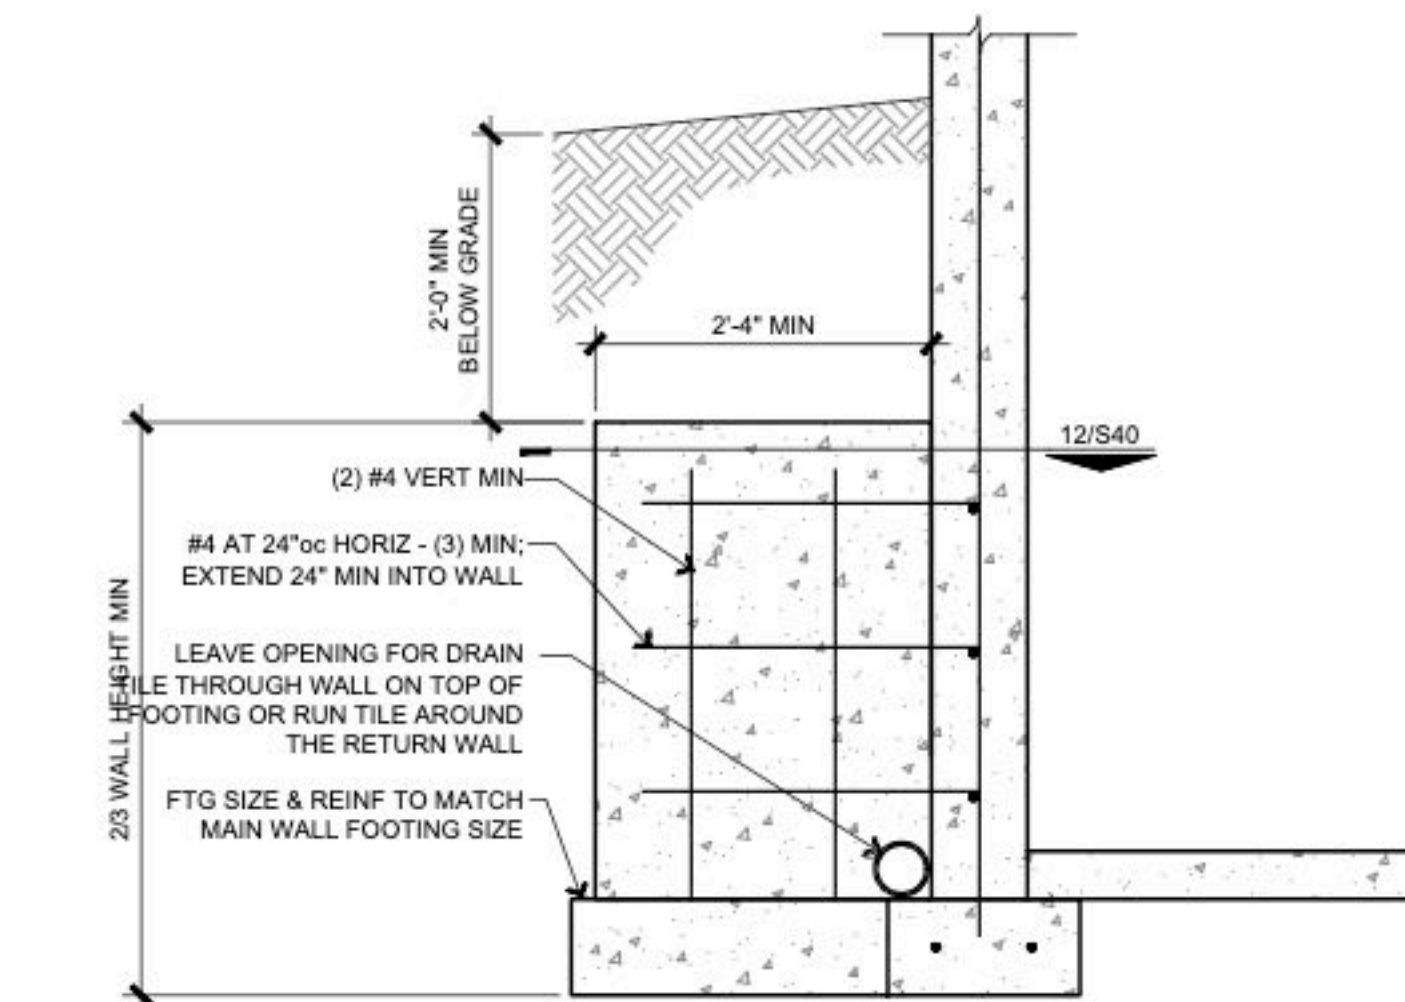
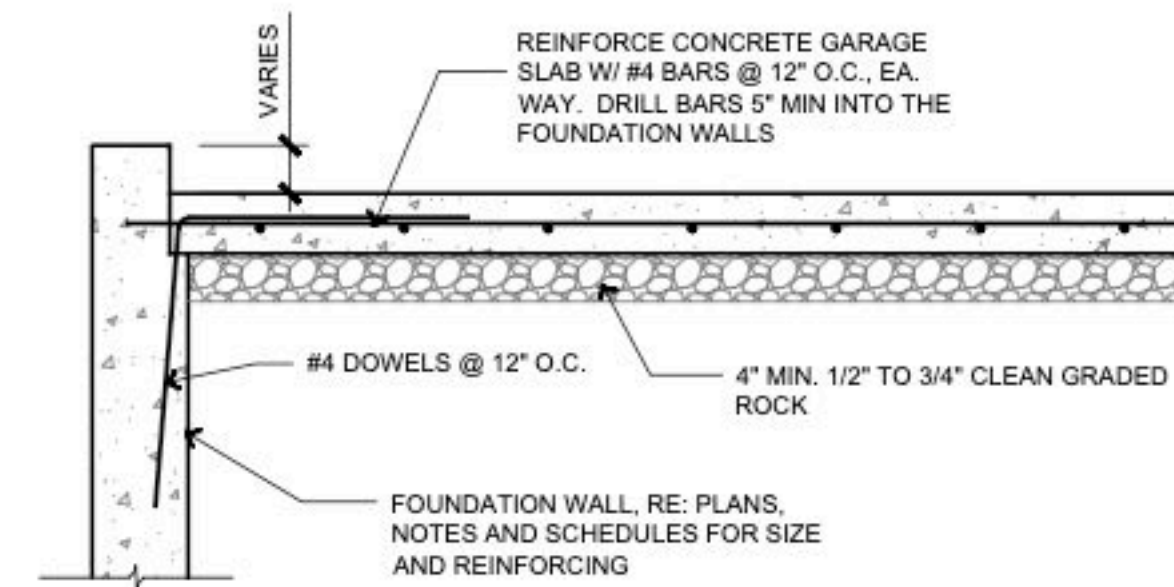


11 TYP RETURN WALL DETAIL
SCALE: 3/4" = 1'-0"

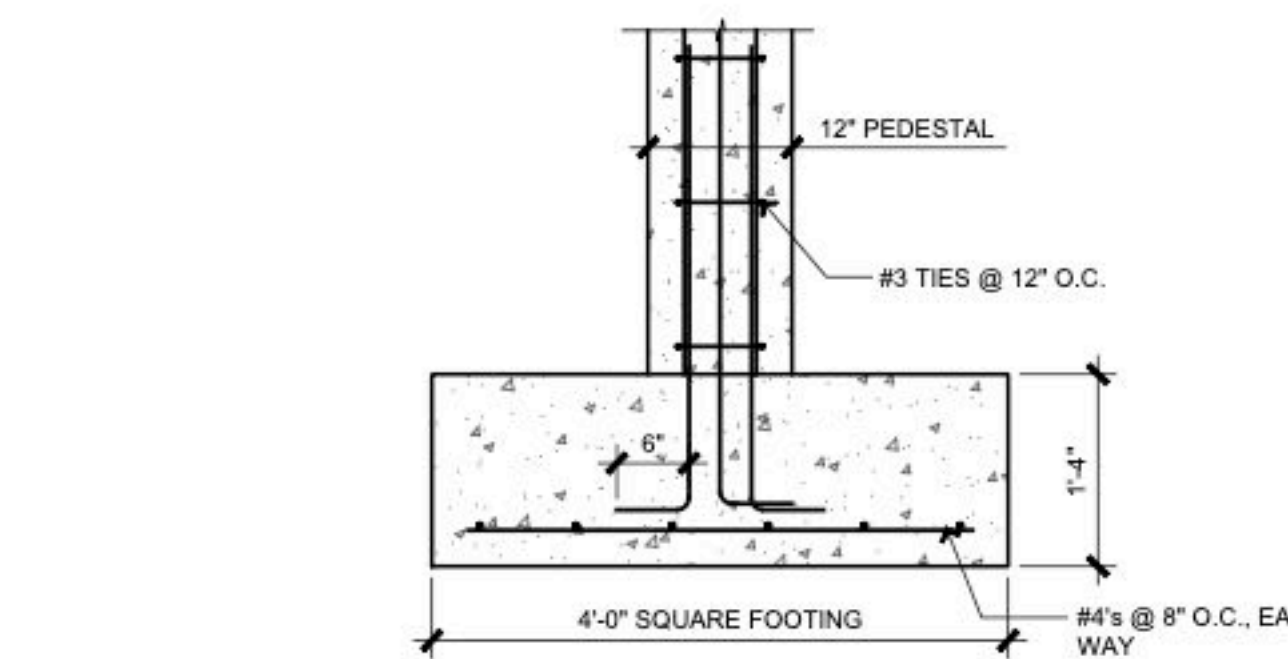


8 PEDESTAL FOOTING
SCALE: 3/4" = 1'-0"

5 TYP EGRESS WINDOW SECTION
SCALE: 3/4" = 1'-0"

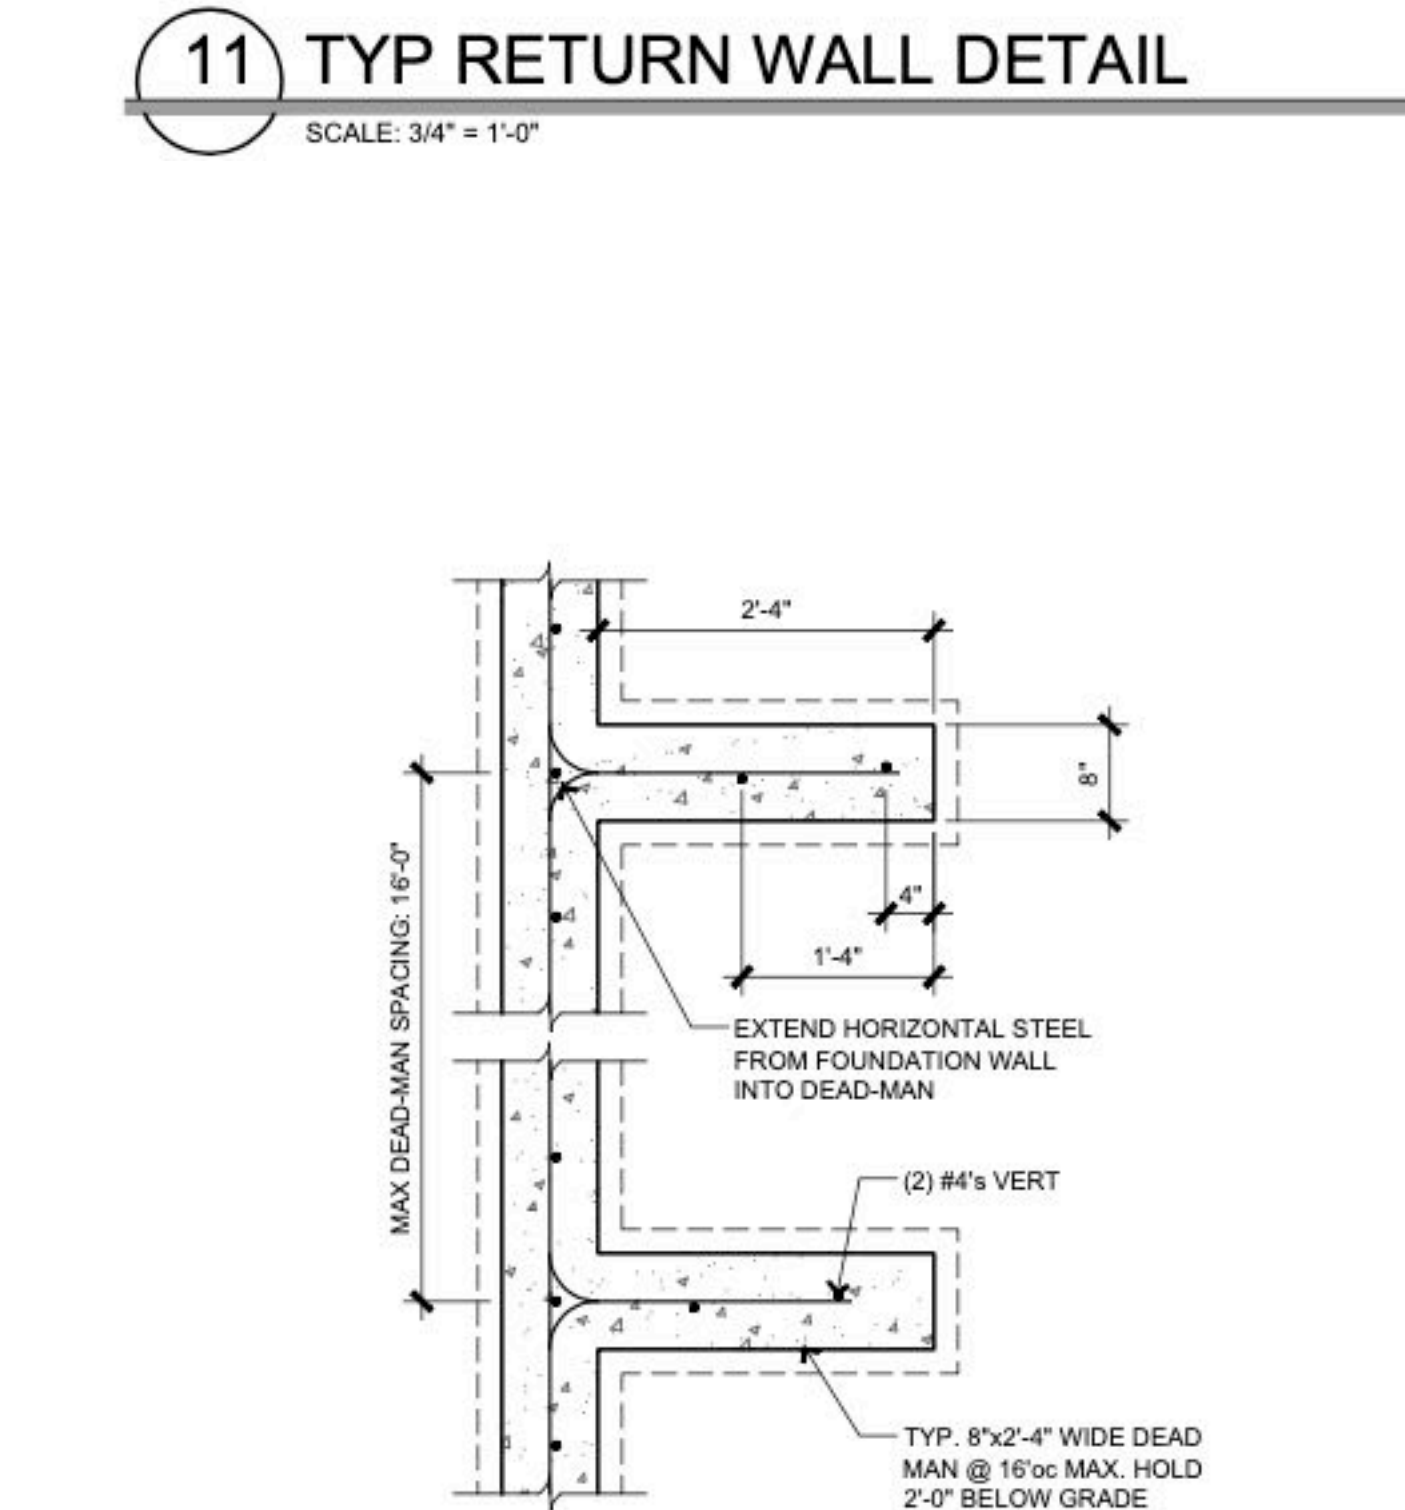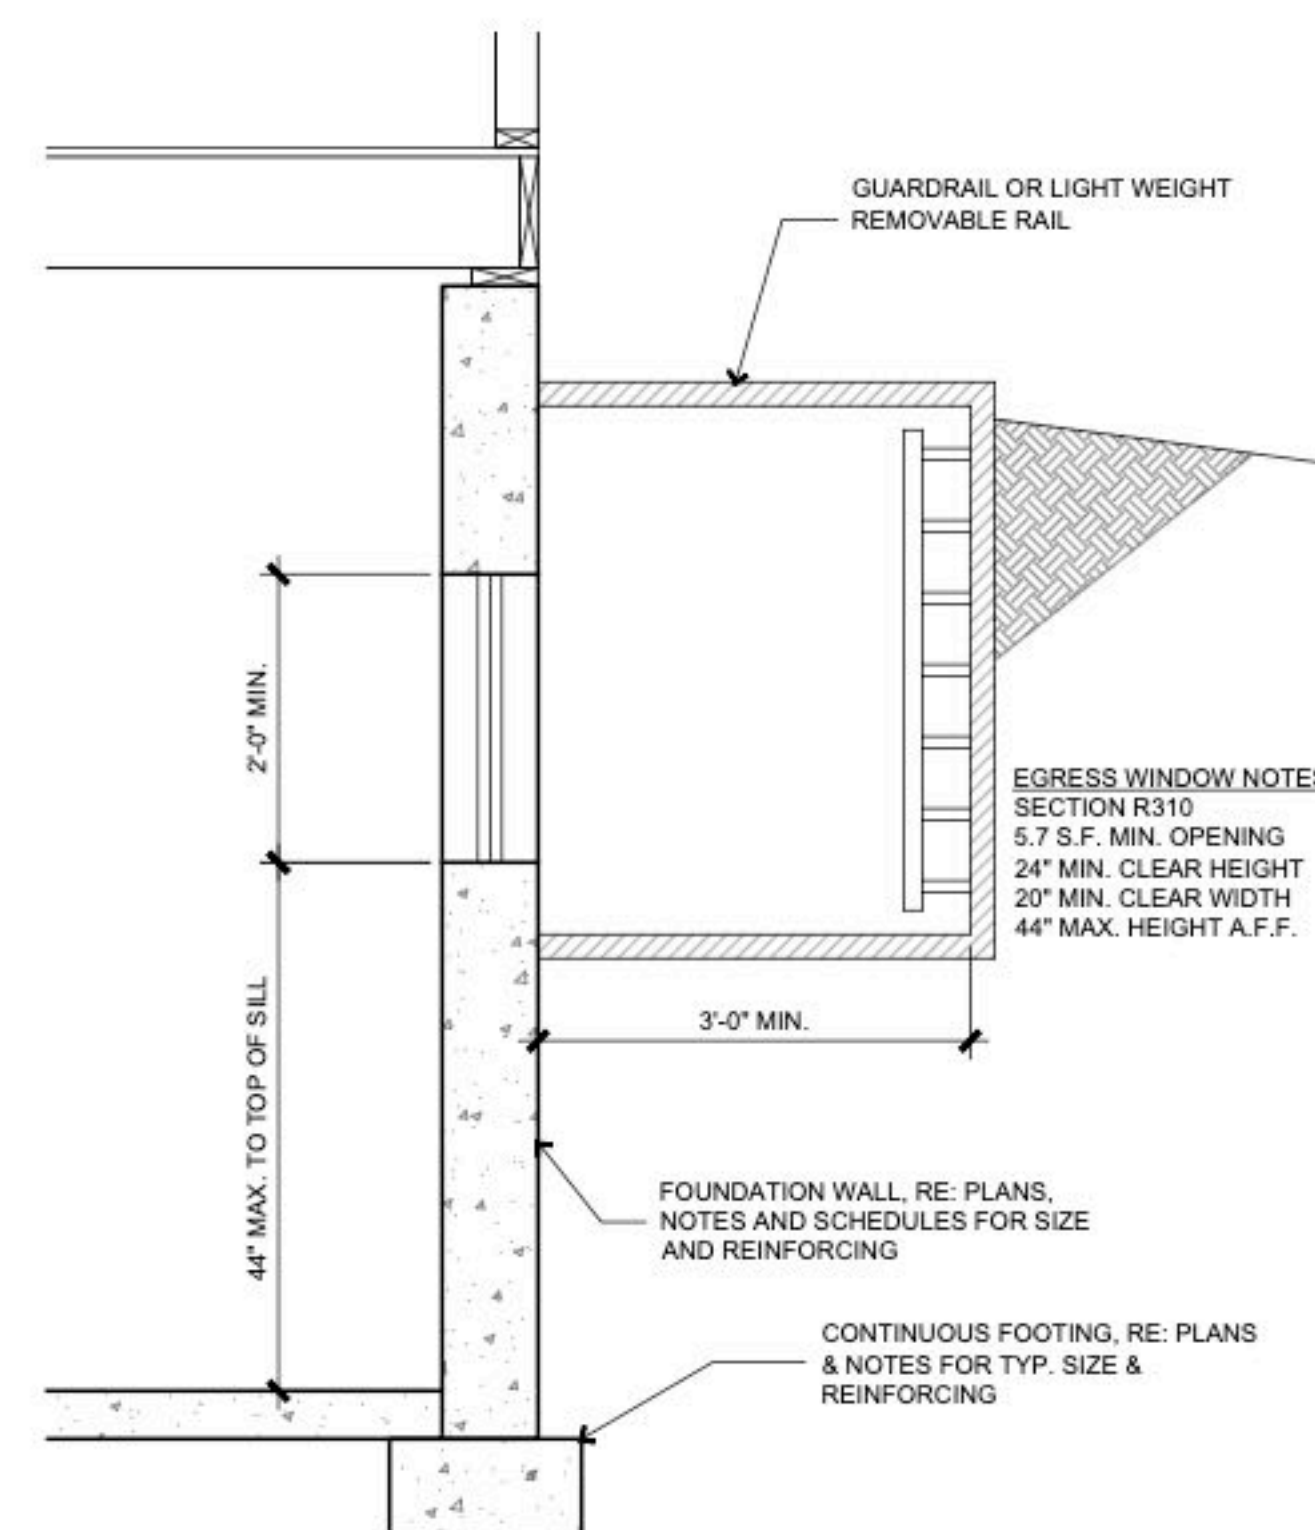


12 TYP DEAD-MAN SECTION
SCALE: 3/4" = 1'-0"

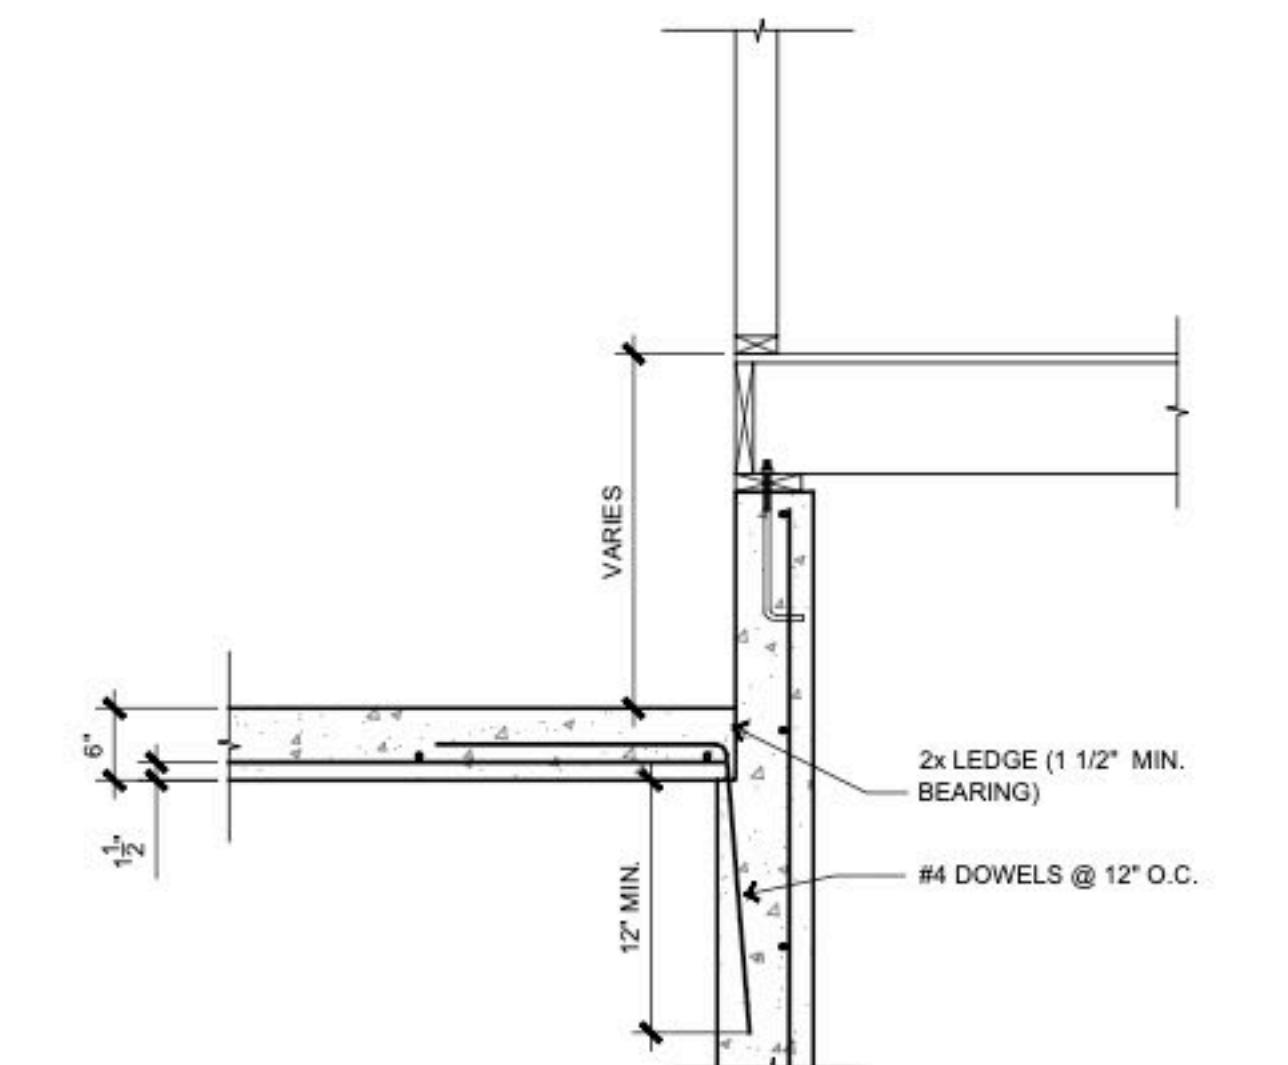


9 GARAGE SLAB ON FILL @ WALL
SCALE: 3/4" = 1'-0"


6 SUSPENDED PORCH STOOP
SCALE: 3/4" = 1'-0"

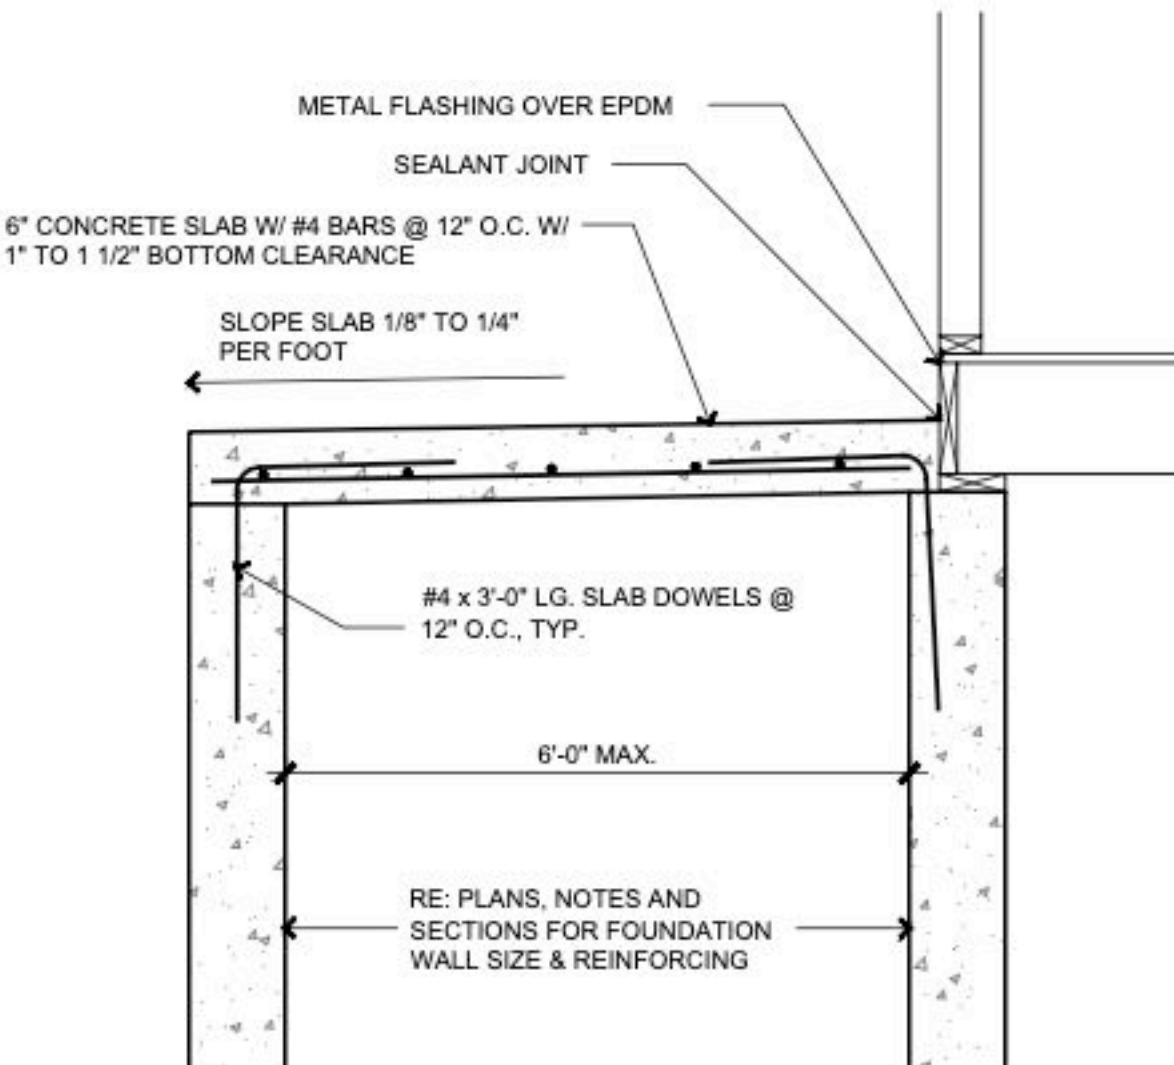

3 OVERDIG SECTION BSMT SLAB
SCALE: 3/4" = 1'-0"

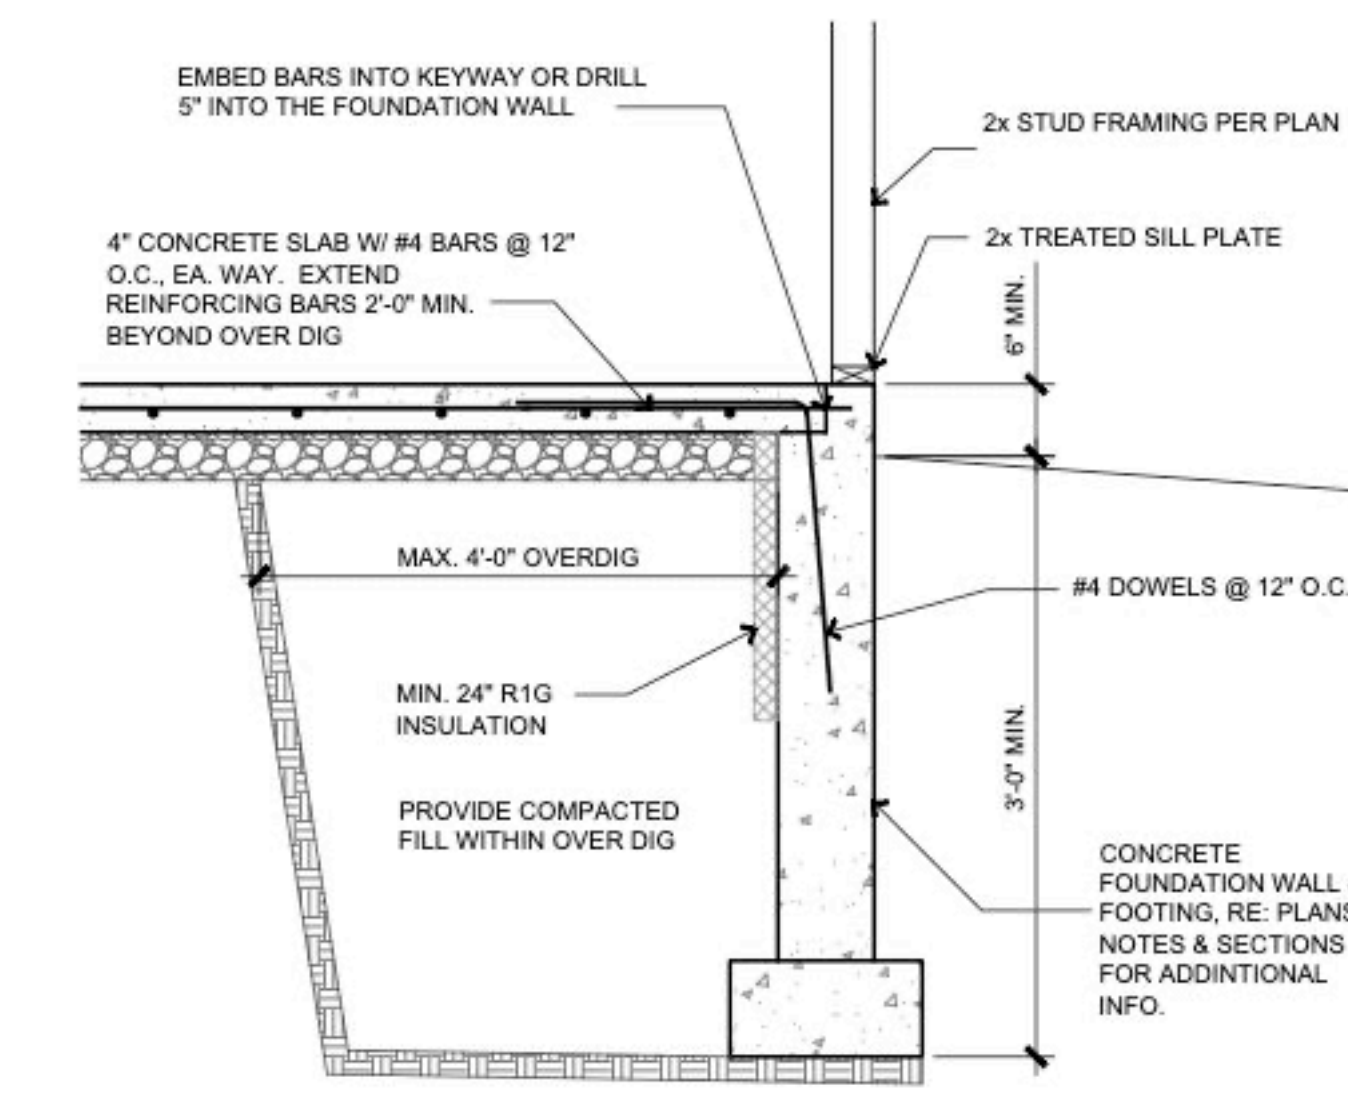



3 OVERDIG SECTION BSMT SLAB
SCALE: 3/4" = 1'-0"

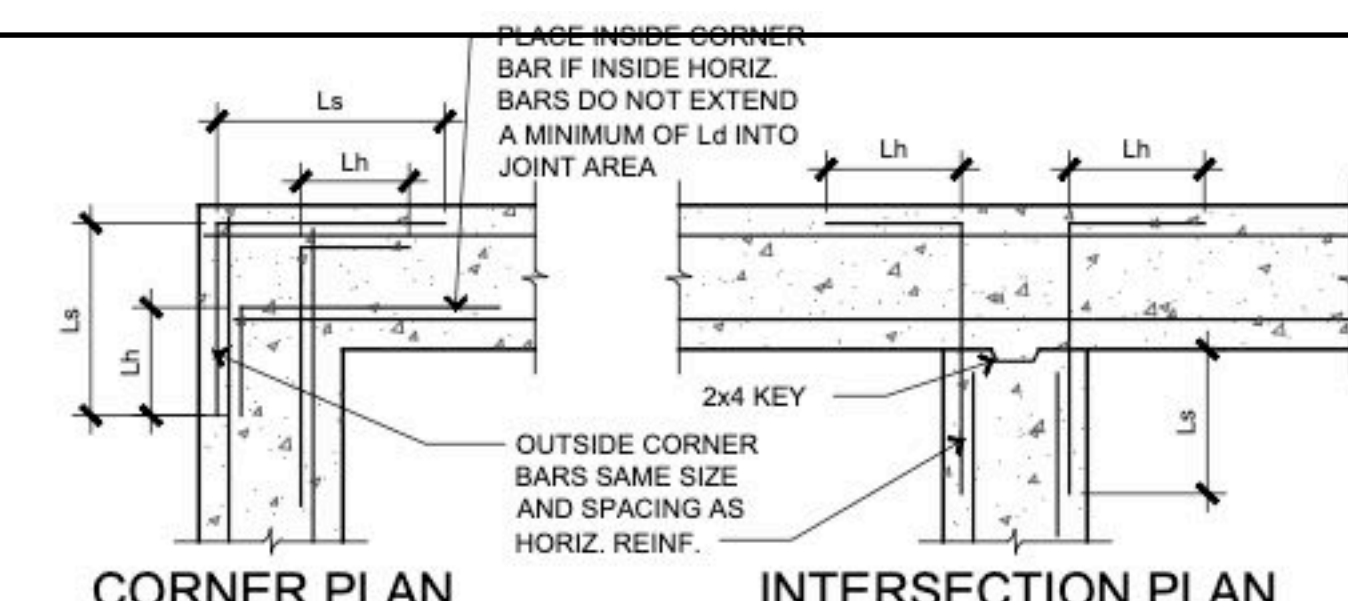

CORNER PLAN INTERSECTION PLAN

BAR SIZE	Lh	Ld	Ls
3	6"	14"	18"
4	8"	19"	25"
5	10"	23"	30"
6	1'-0"	28"	37"
7	1'-2"	42"	54"
8	1'-4"	48"	62"

1 TYP WALL AND GRADE BEAM DTL'S
SCALE: 3/4" = 1'-0"

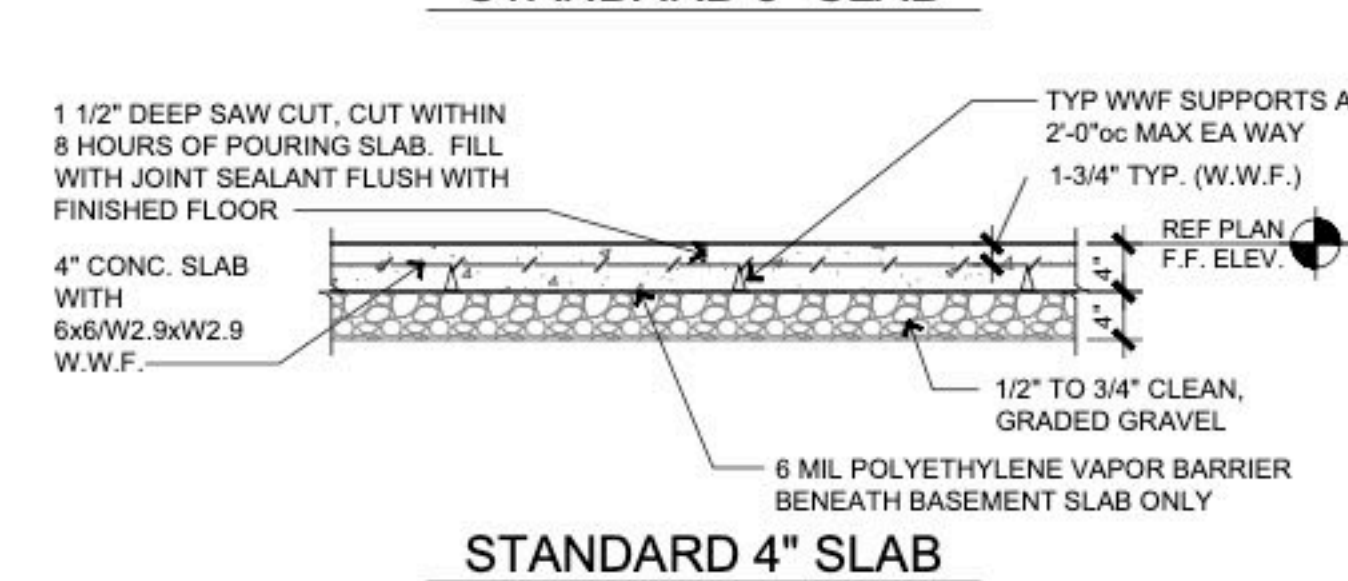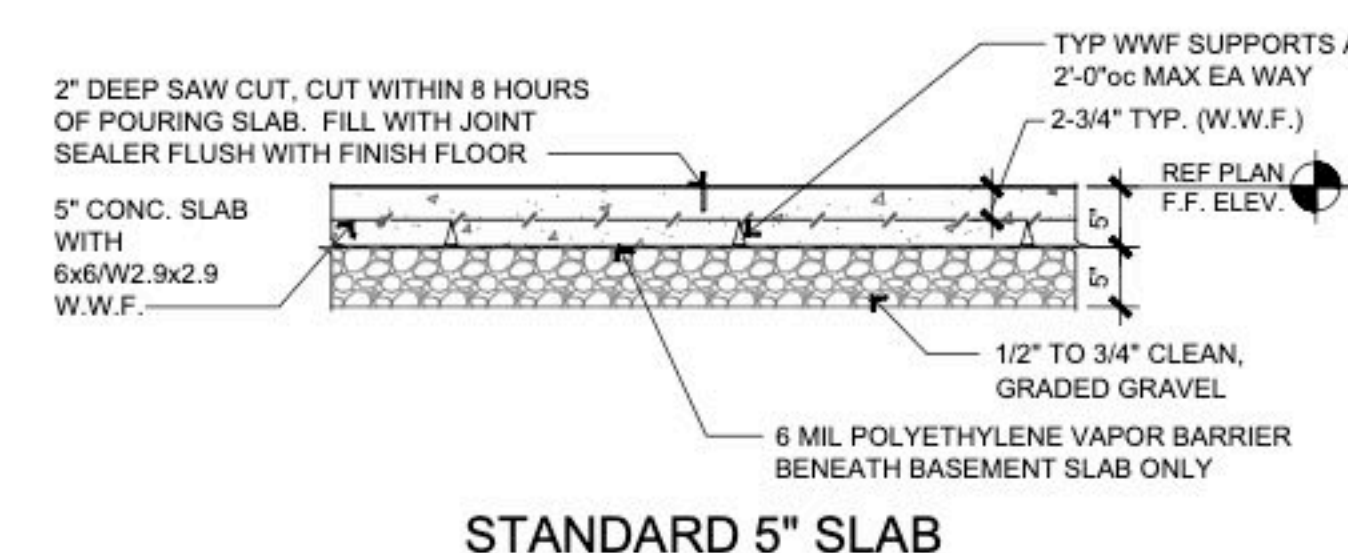

2 STANDARD SLAB DETAILS
SCALE: 3/4" = 1'-0"

1 TYP WALL AND GRADE BEAM DTL'S
SCALE: 3/4" = 1'-0"

SEQUOIA DUPLEX ALT # 1
205 & 207 Orchard Court
LEE'S SUMMIT, MO






This Drawing And Information Contained Within Is Provided As An Instrument Of Service By The Architect, And Is Intended For Use On This Project Only. This Drawing Remains The Property Of The Architect And Shall Be Returned To Him Upon Completion Of The Construction Work. All Drawings, Specifications, Ideas, Designs And Arrangements Appearing Herein Constitute The Original And Unpublished Work Of The Architect. Any Reproduction, Use Or Disclosure Of The Proprietary Information Contained Herein Without The Prior Written Consent Of The Architect Is Strictly Prohibited.
© AGMP 2023




S501

1	Date	APRIL	26, 2024
2	REVISION		
3	REVISION		
4	REVISION		
5	REVISION		


RELEASE FOR CONSTRUCTION
AS NOTED FOR PLAN REVIEW
DEVELOPMENT SERVICES
LEE'S SUMMIT, MISSOURI
05/02/2024

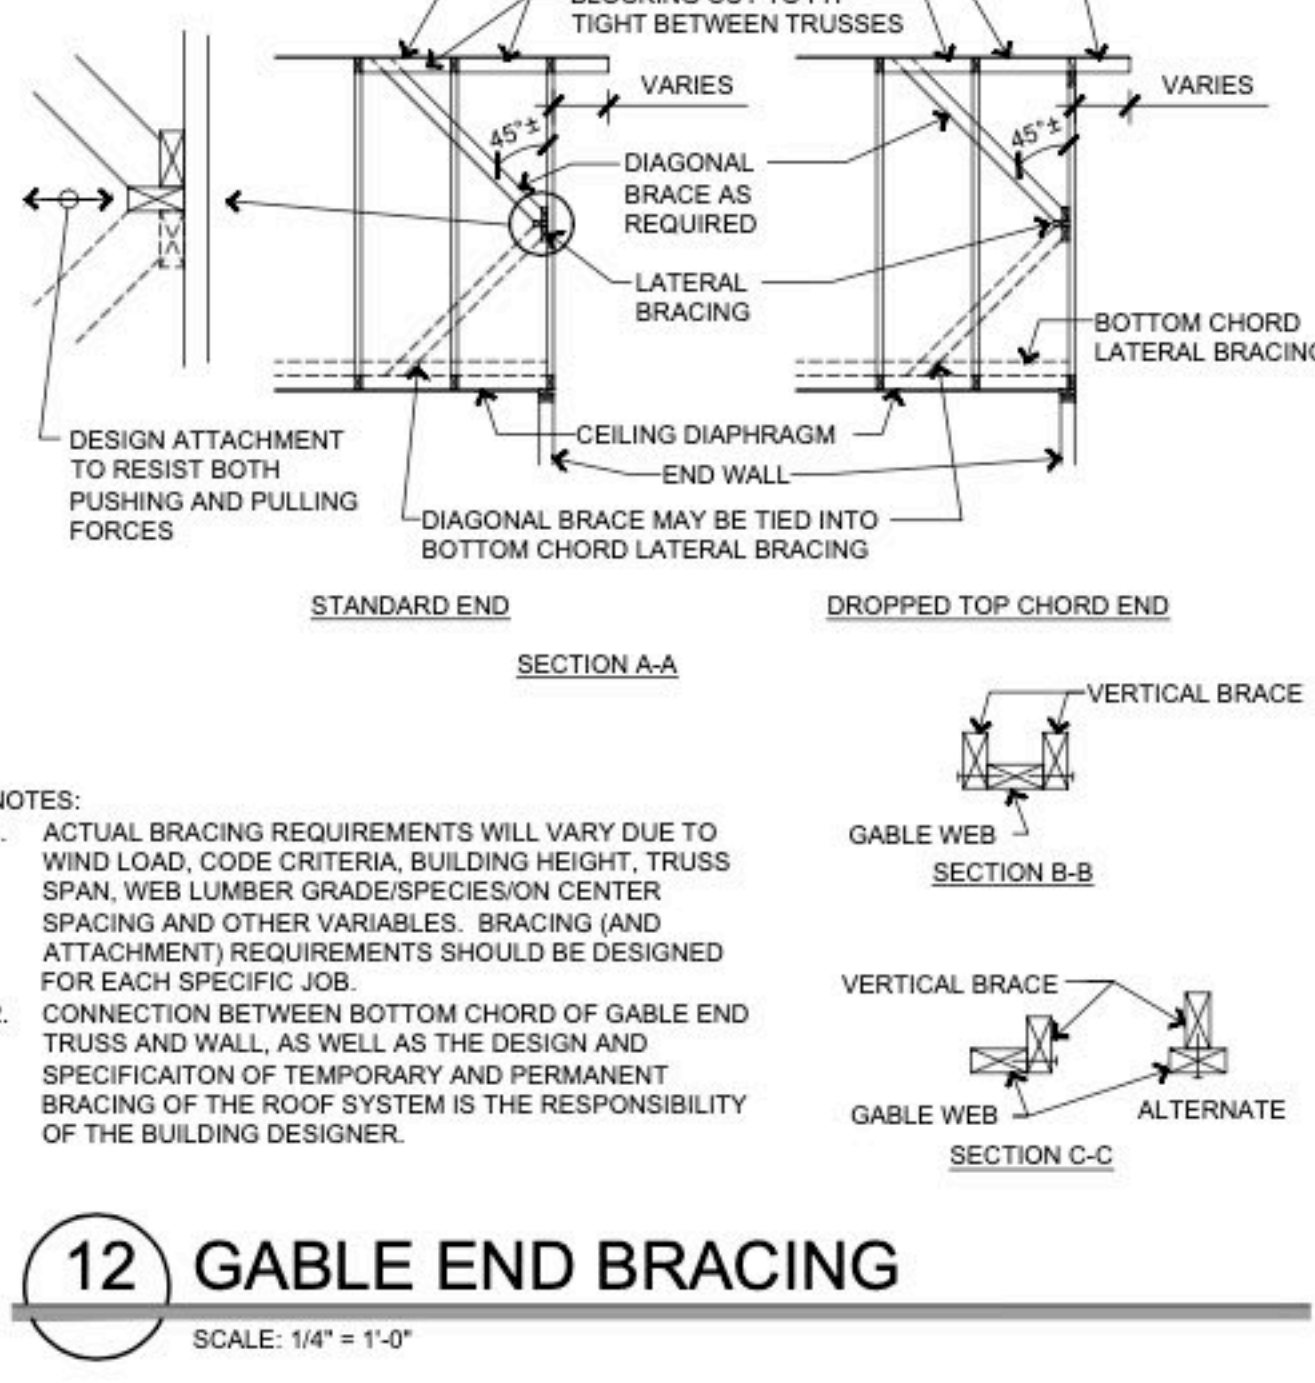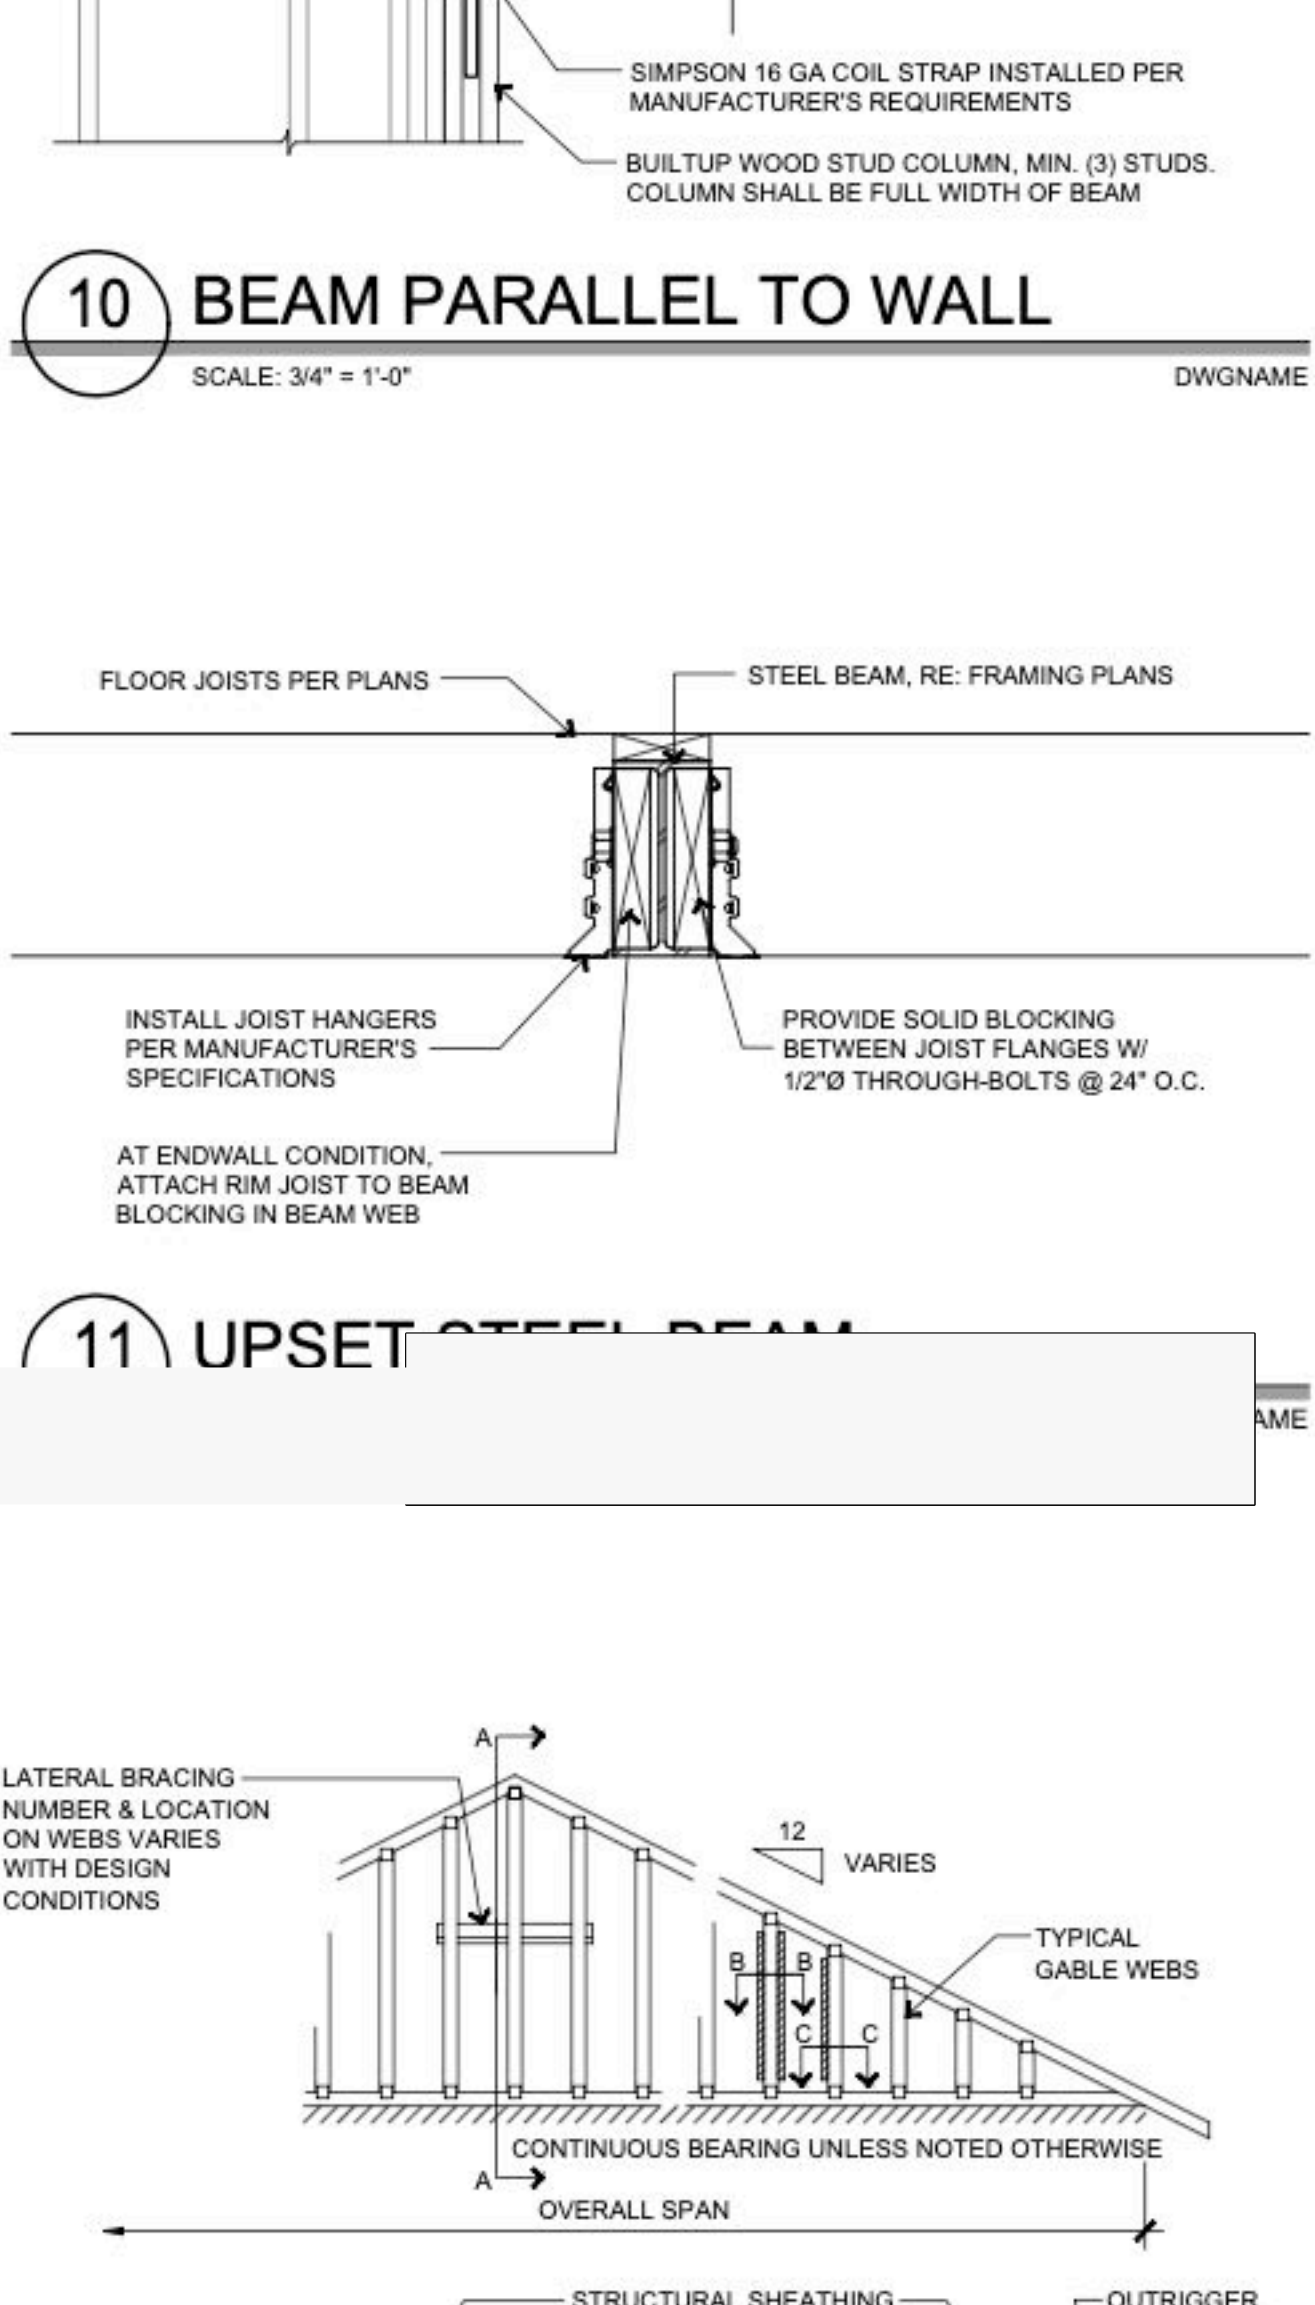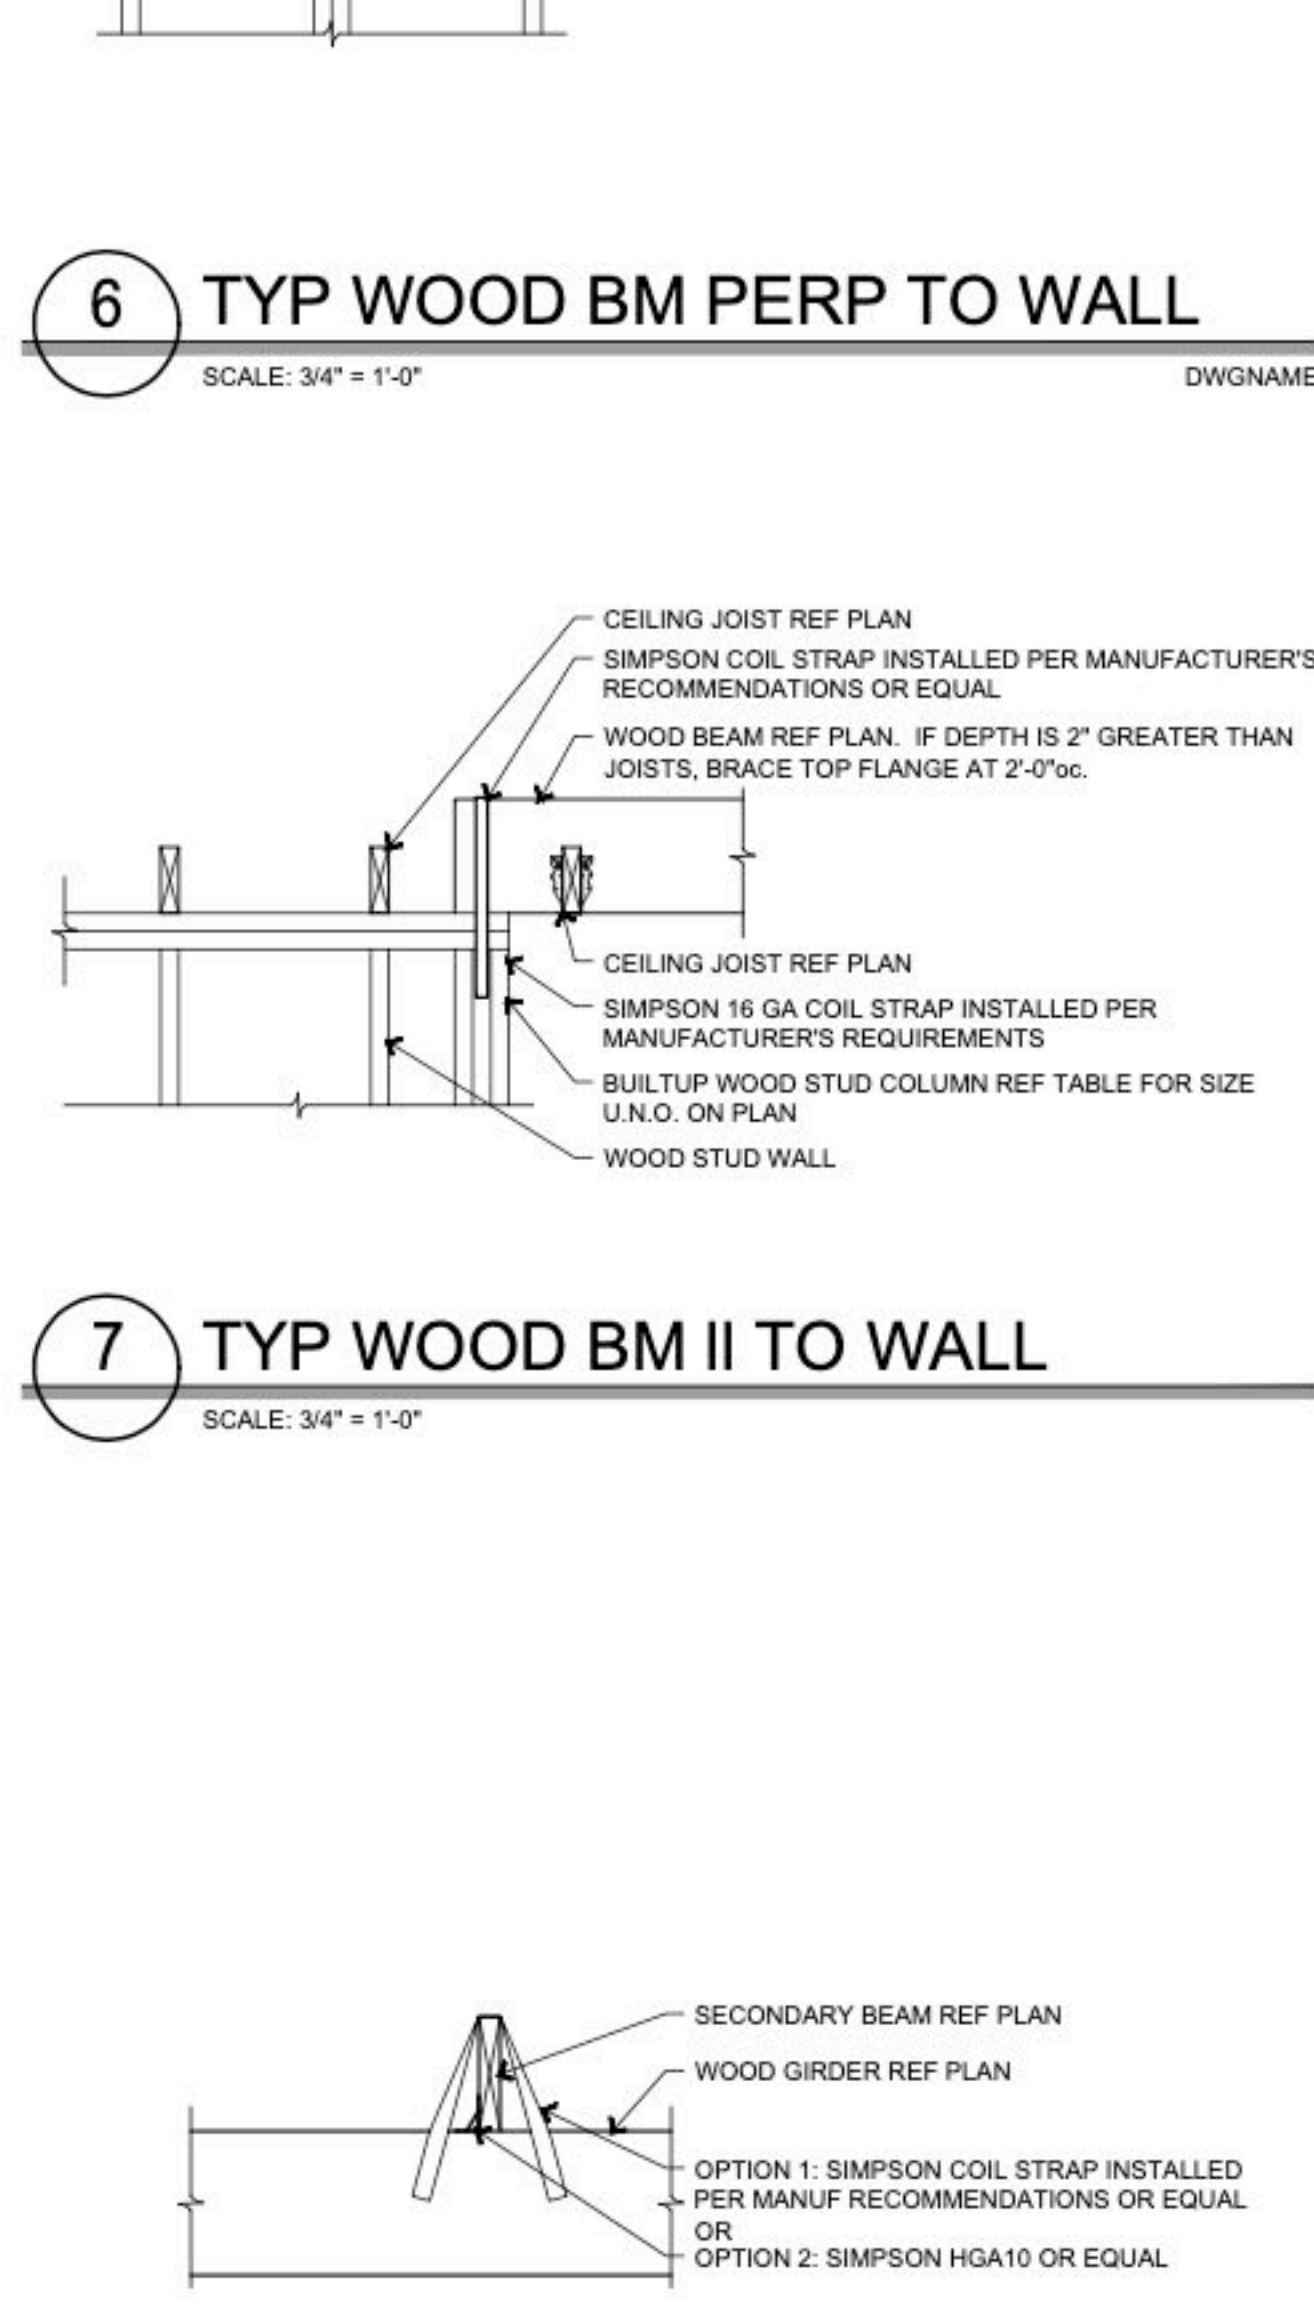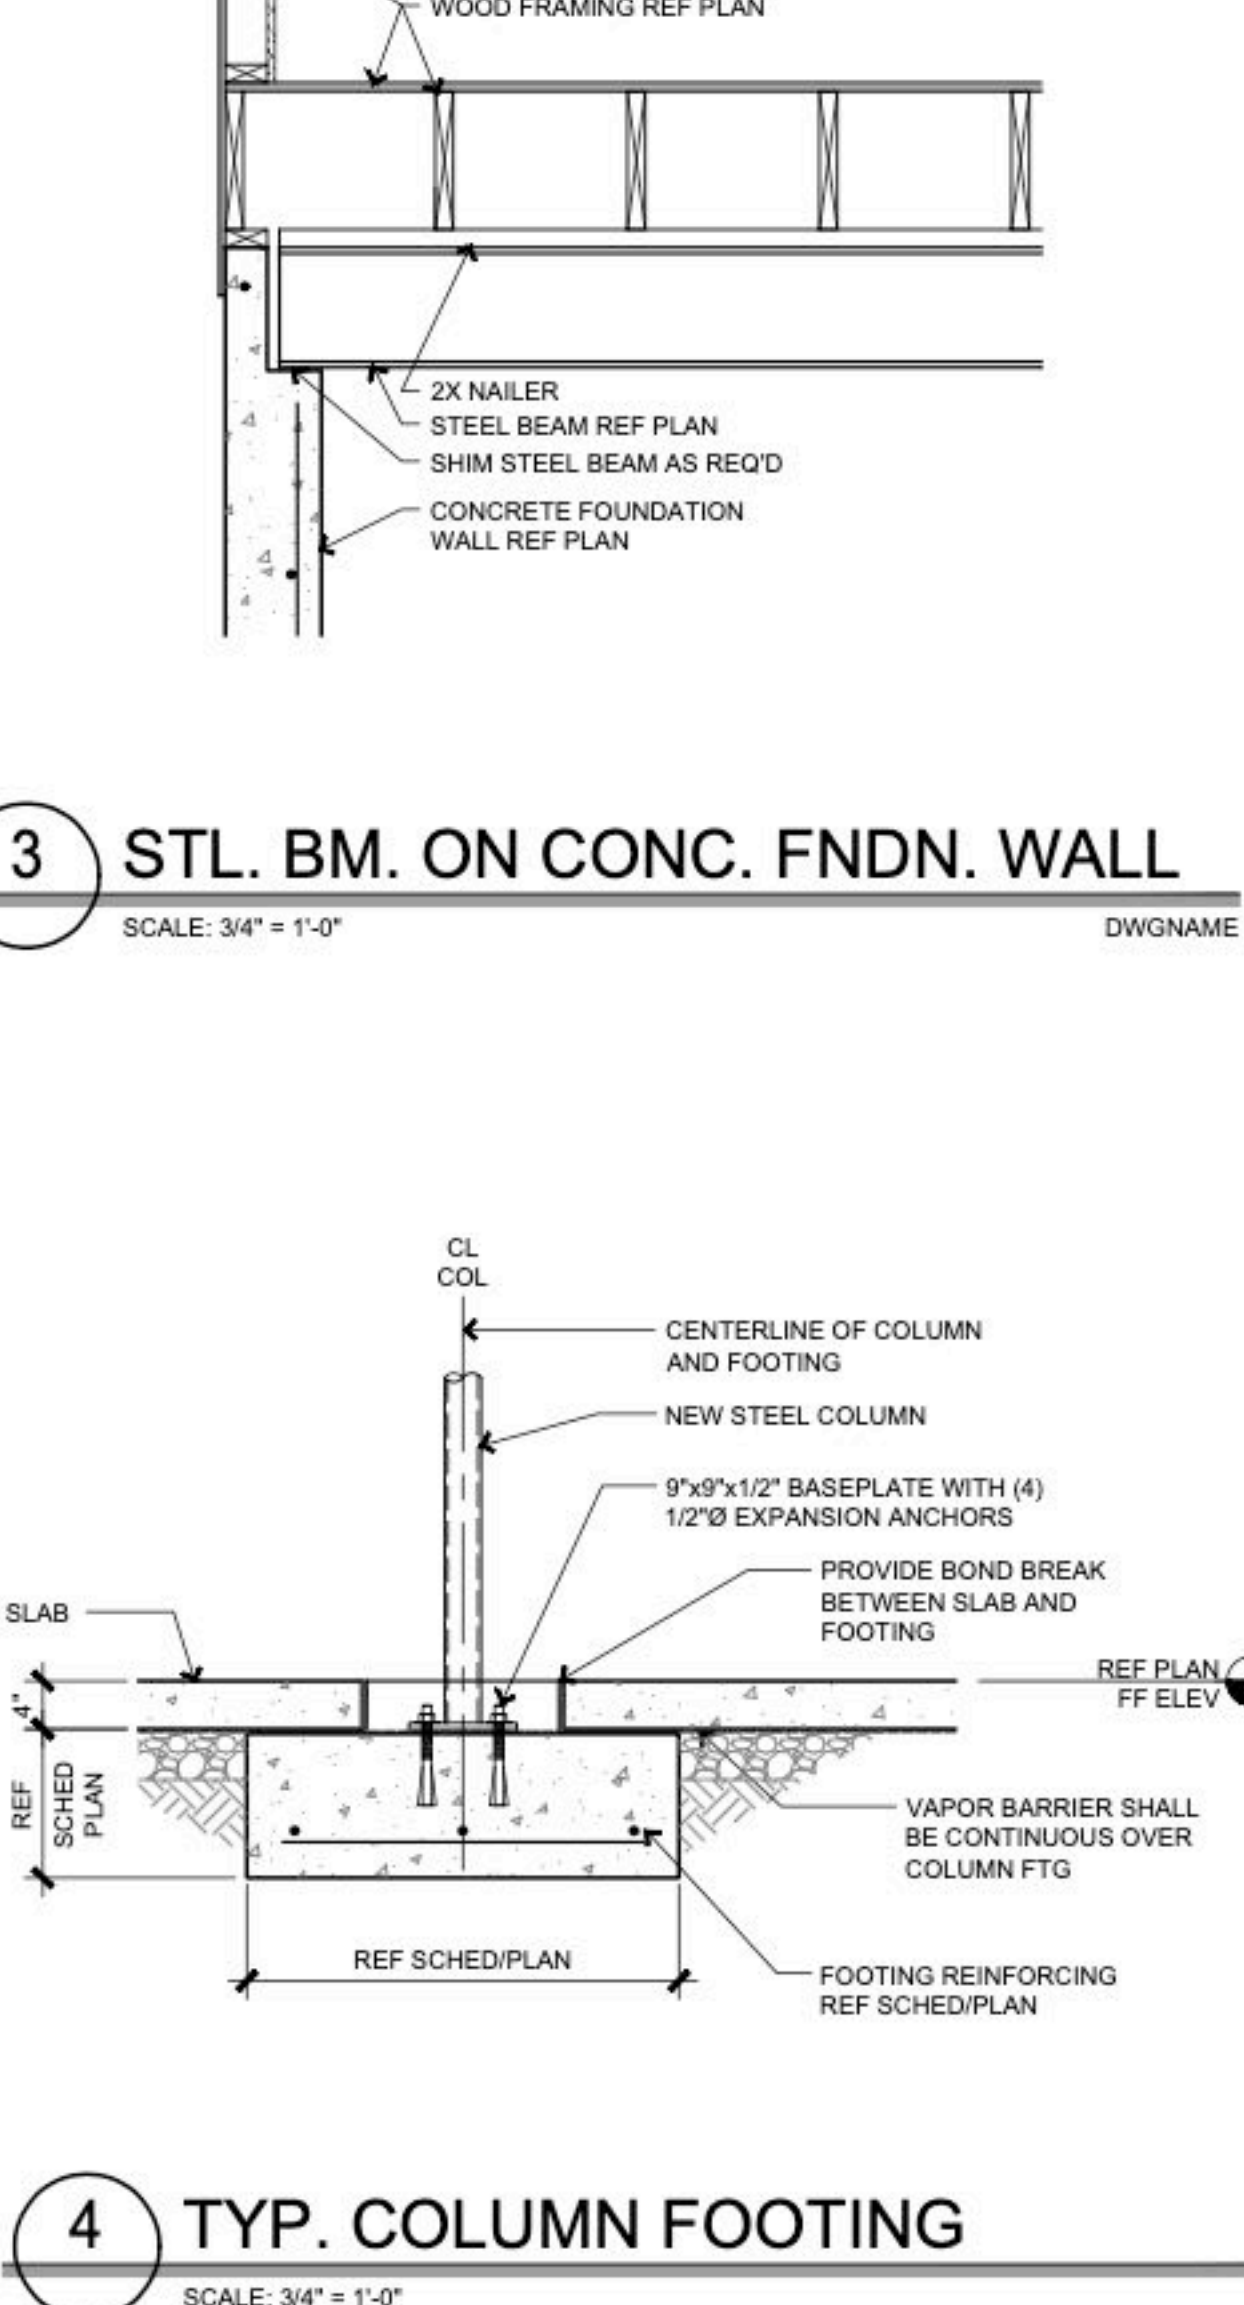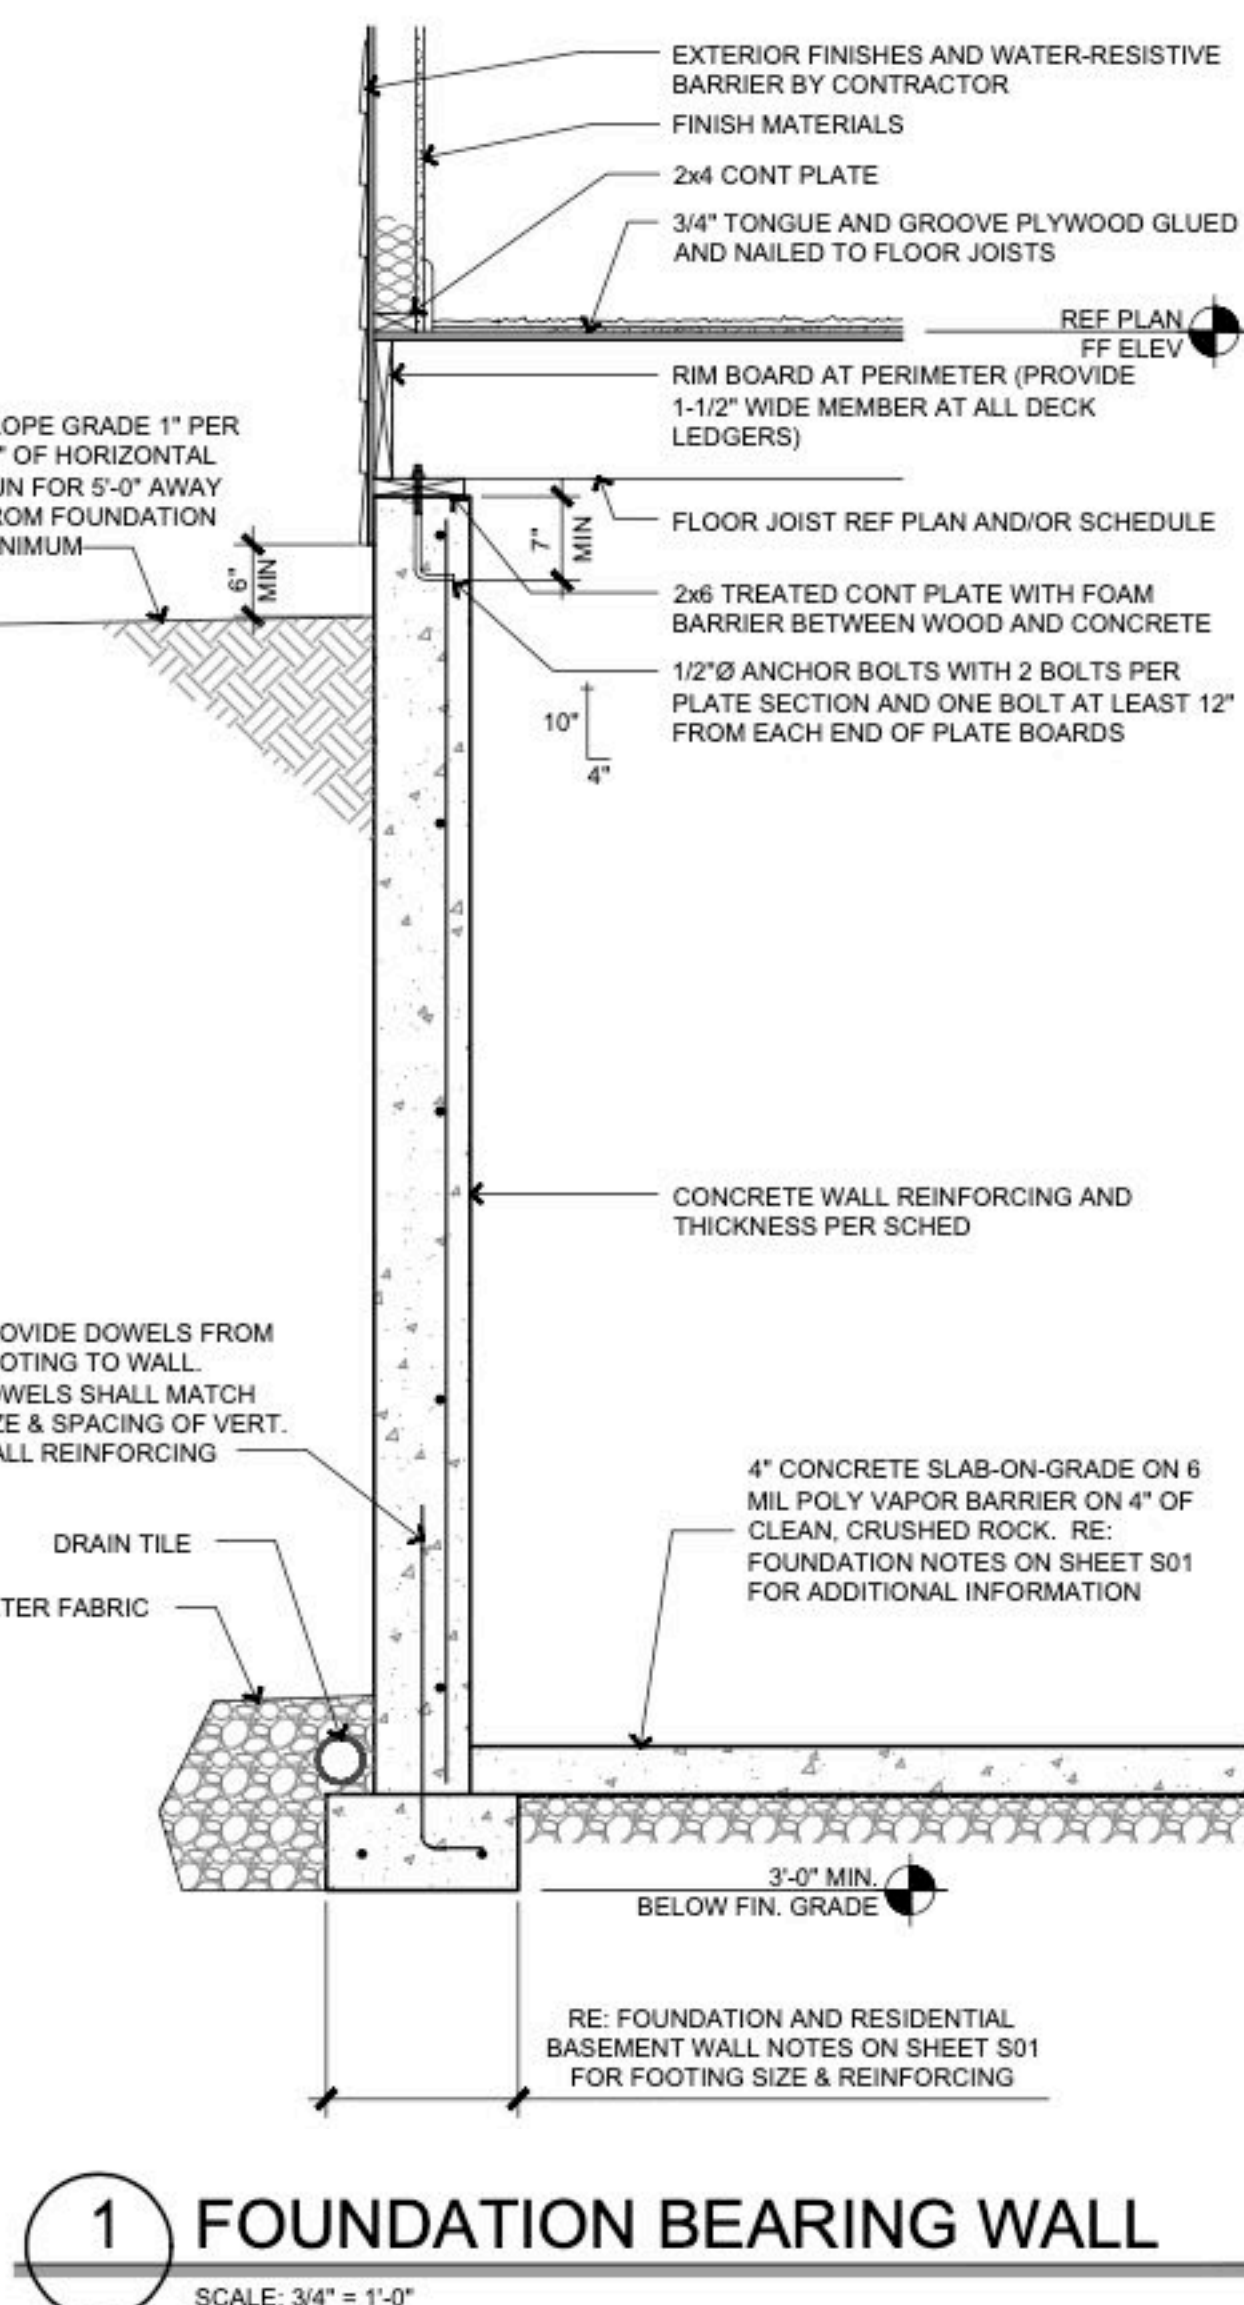

- NOTES:
- ACTUAL BRACING REQUIREMENTS WILL VARY DUE TO WIND LOAD, CODE CRITERIA, BUILDING HEIGHT, TRUSS SPAN, WEB LUMBER GRADE/SPECIES/ON CENTER SPACING AND OTHER VARIABLES. BRACING (AND ATTACHMENT) REQUIREMENTS SHOULD BE DESIGNED FOR EACH SPECIFIC JOB.
 - CONNECTION BETWEEN BOTTOM CHORD OF GABLE END TRUSS AND WALL, AS WELL AS THE DESIGN AND SPECIFICATION OF TEMPORARY AND PERMANENT BRACING OF THE ROOF SYSTEM IS THE RESPONSIBILITY OF THE BUILDING DESIGNER.

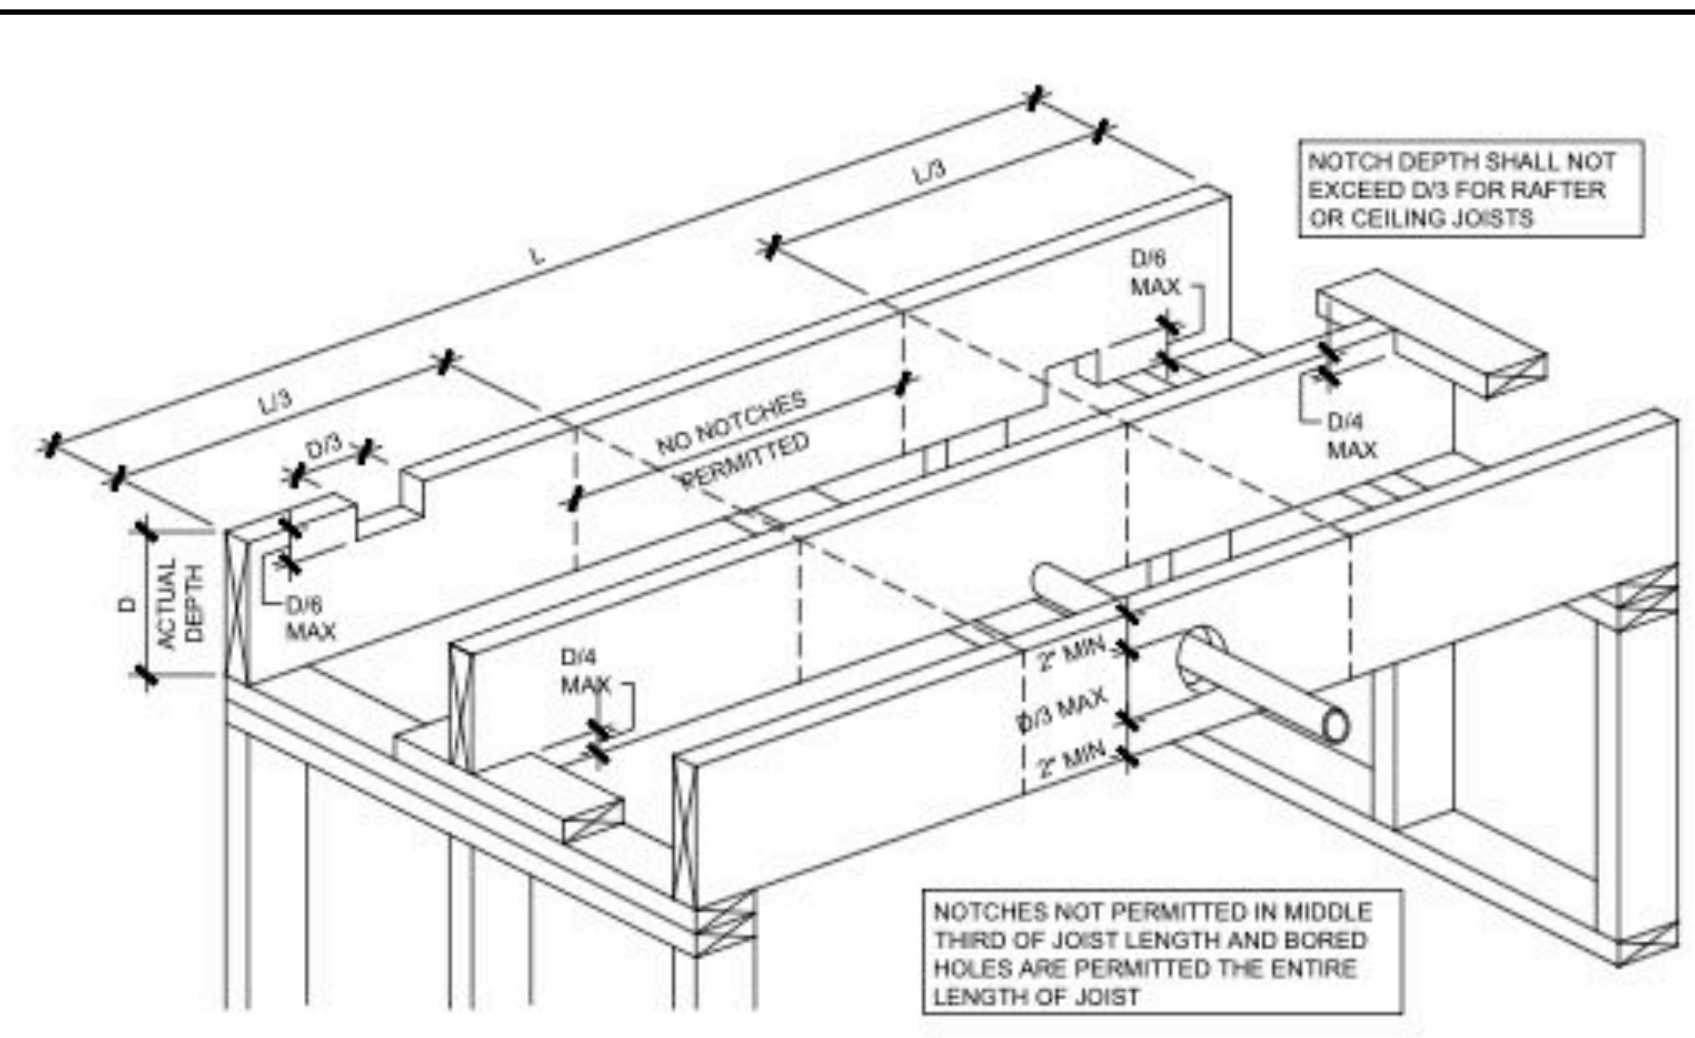


7 NOTCHING AND BORING CEILING OR FLOOR JOISTS
SCALE: 3/4" = 1'-0"

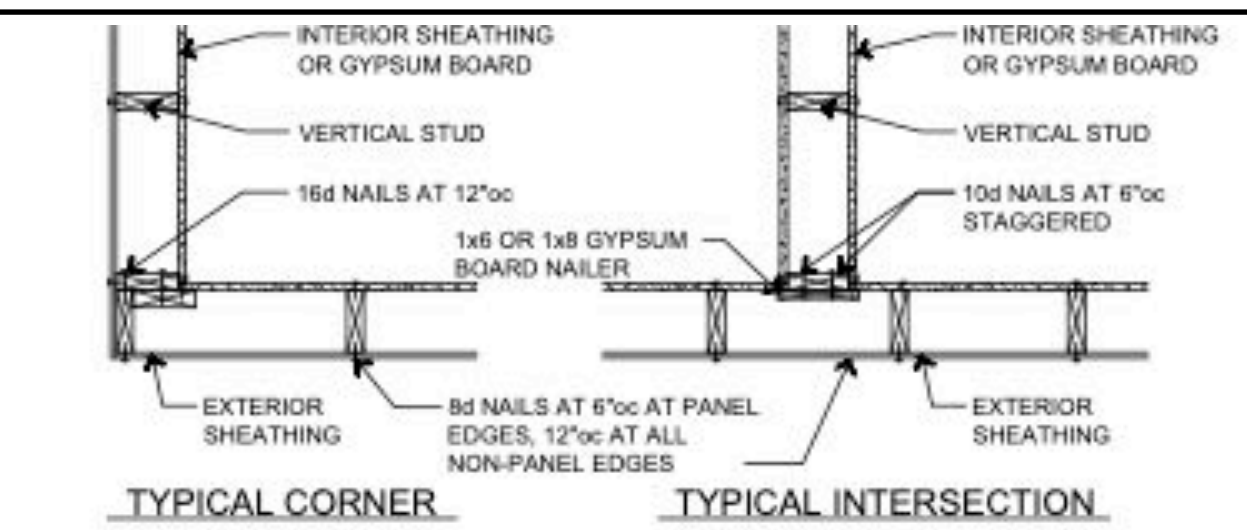


BEARING WALL HEADERS (CENTER BEARING FLOOR)

INTERIOR WALL (1 FLOOR)			EXTERIOR WALL (ROOF ONLY)		
SPAN	SIZE	NO. J.S.	SPAN	SIZE	NO. J.S.
0'-0" - 4'-5"	(2) 2x8	2	0'-0" - 5'-4"	(2) 2x8	2
4'-6" - 5'-5"	(2) 2x10	2	5'-5" - 6'-6"	(2) 2x10	2
5'-6" - 6'-3"	(2) 2x12	2	6'-7" - 7'-6"	(2) 2x12	2
INTERIOR WALL (2 FLOORS)			EXT WALL (ROOF + FLOOR)		
0'-0" - 3'-2"	(2) 2x8	2	0'-0" - 4'-6"	(2) 2x8	2
3'-3" - 3'-10"	(2) 2x10	3	4'-7" - 5'-4"	(2) 2x10	2
3'-11" - 4'-5"	(2) 2x12	3	5'-7" - 6'-5"	(2) 2x12	2
NOTE:			EXT WALL (ROOF + 2 FLOORS)		
1. NOT FOR OPEN WEB TRUSS SYSTEMS			0'-0" - 3'-9"	(2) 2x8	2
2. MAXIMUM JOIST SPAN OF 18FT			3'-10" - 4'-7"	(2) 2x10	2
3. HEADERS SUPPORT FLOOR LOADS ONLY, NO ROOF LOADS			4'-8" - 5'-3"	(2) 2x12	2


4 TYP WALL FRAMING DETAILS
SCALE: 3/4" = 1'-0"

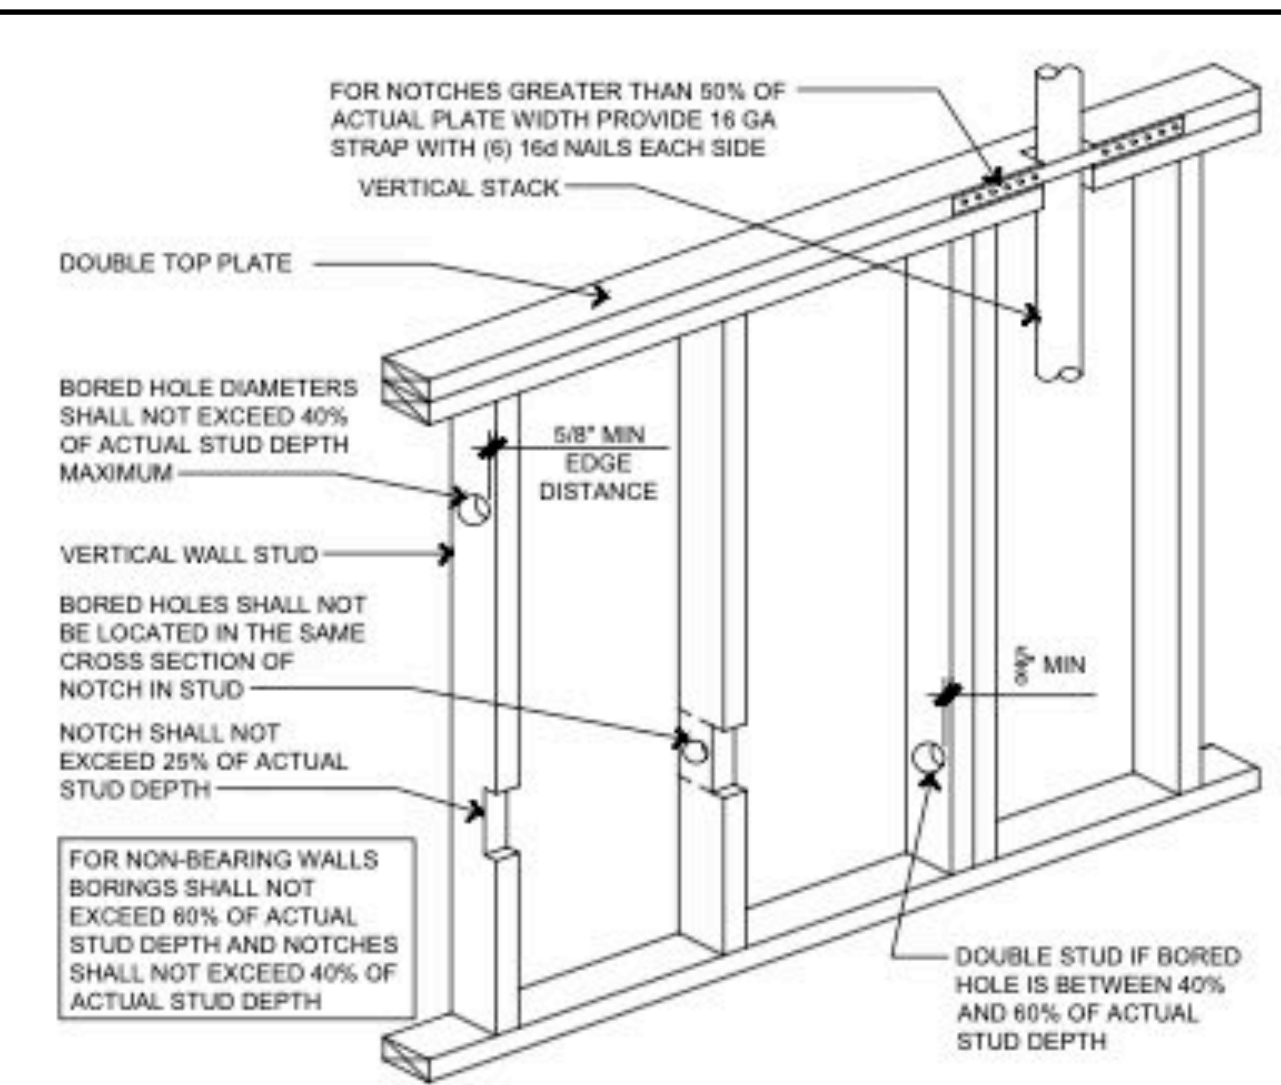


1 NOTCHING AND BORING WALLS
SCALE: 3/4" = 1'-0"

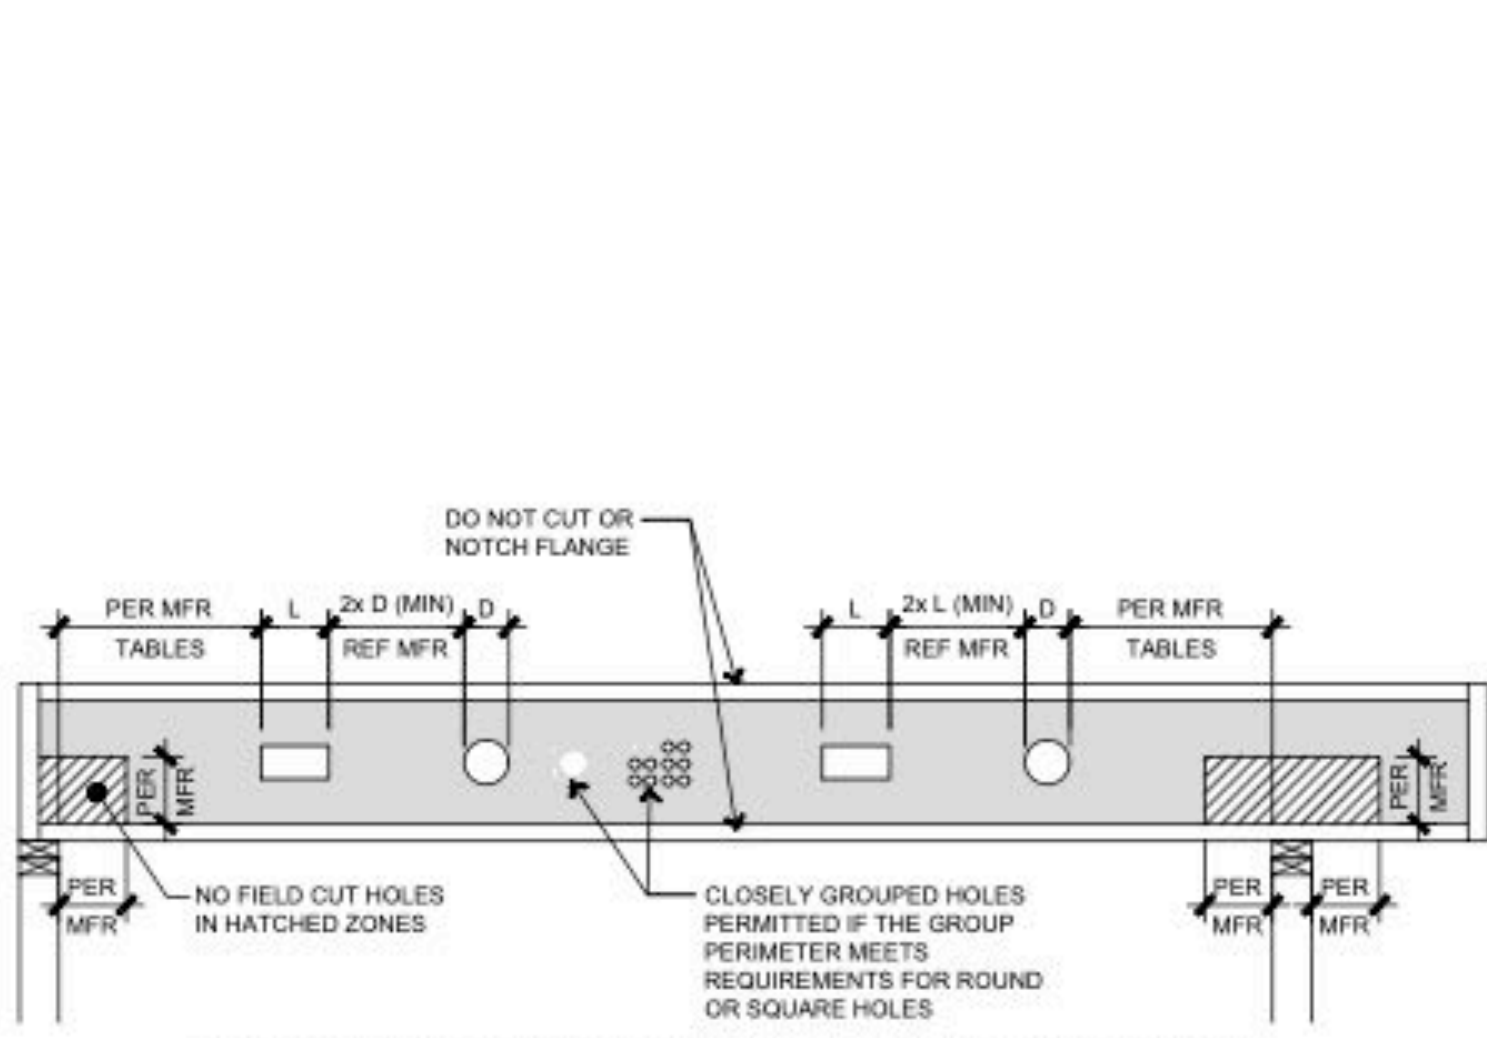

10 ALLOWABLE HOLE LOCATIONS FOR PRE-FABRICATED JOISTS
SCALE: 3/4" = 1'-0"

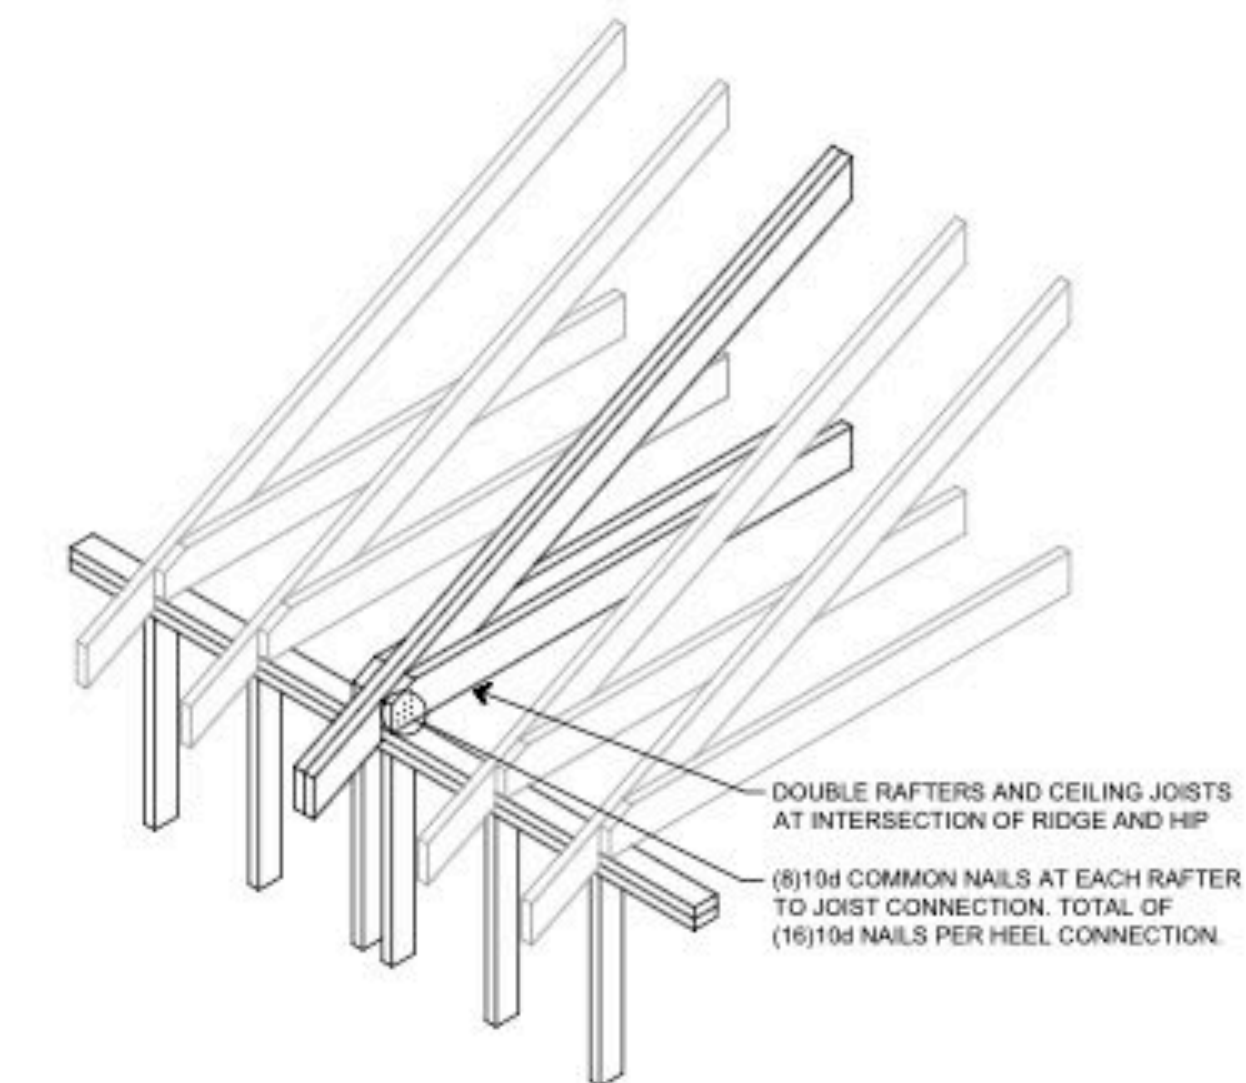


8 JOIST RIDGE SUPPORT
SCALE: NTS

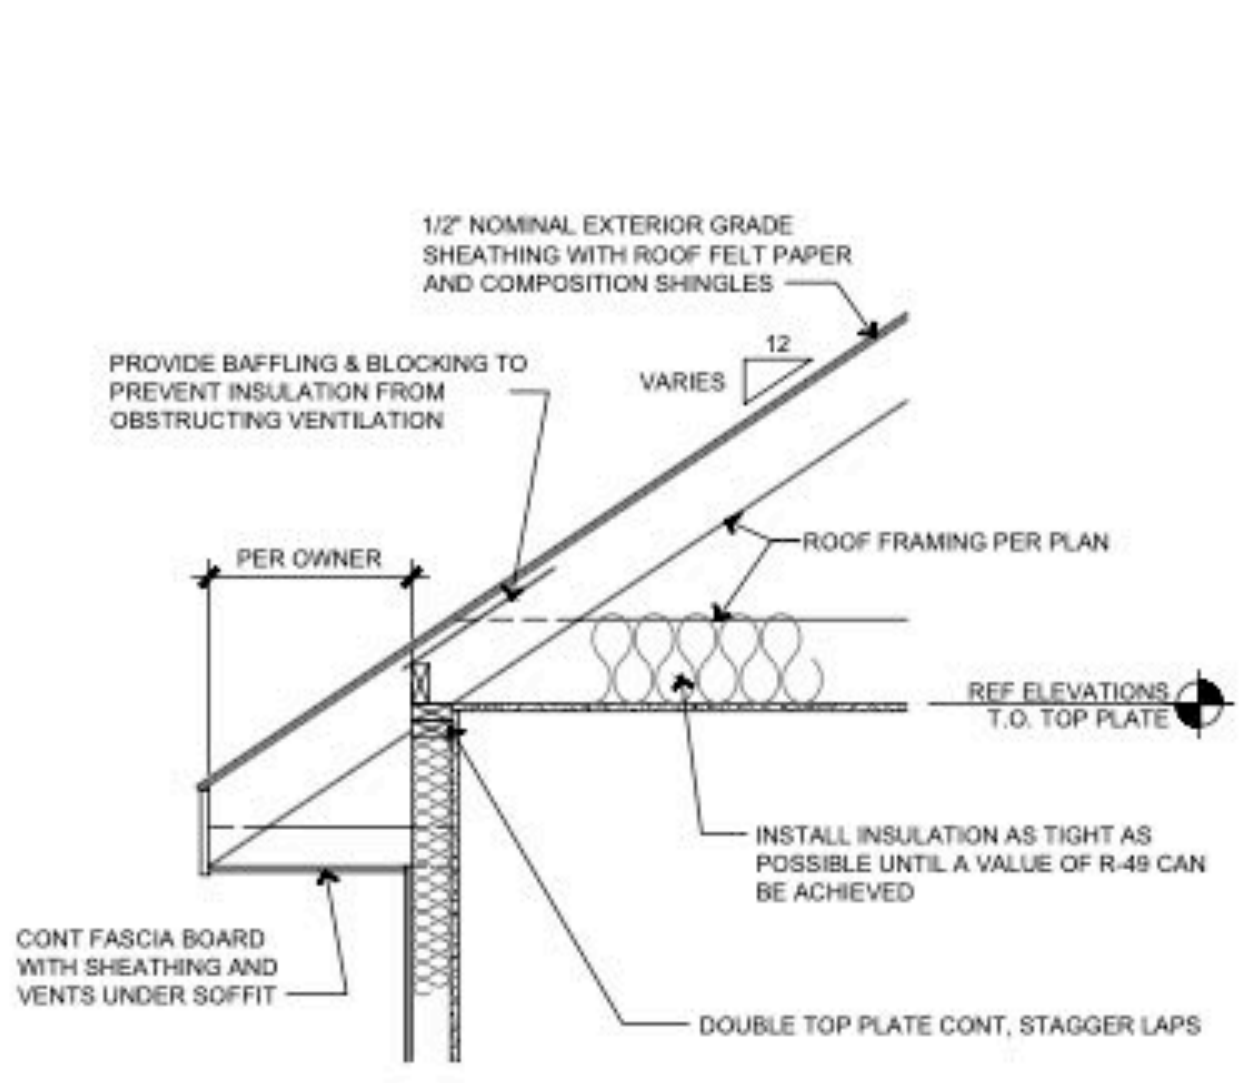


5 ROOF RAFTER BEARING
SCALE: 3/4" = 1'-0" X-WALSEC02

BUILT UP COLUMN NAILING SCHEDULE

BUILT UP COLUMN	BUILT UP SECTION	PATTERN	END DISTANCE	EDGE DISTANCE	ROW SPACING	NAIL SPACING	NAIL SIZE
BC1	(2) 2x6	2	2 1/2"	1 1/2"	2 1/2"	9"	10d
BC2	(3) 2x6	2	3 1/2"	1 1/2"	2 1/2"	9"	30d
BC3	(4) 2x6	2	4"	1 1/2"	2 1/2"	9"	50d
BC4	(2) 2x4	1	2 1/2"	1"	---	6"	10d
BC5	(3) 2x4	1	3 1/2"	1 1/2"	---	8"	30d

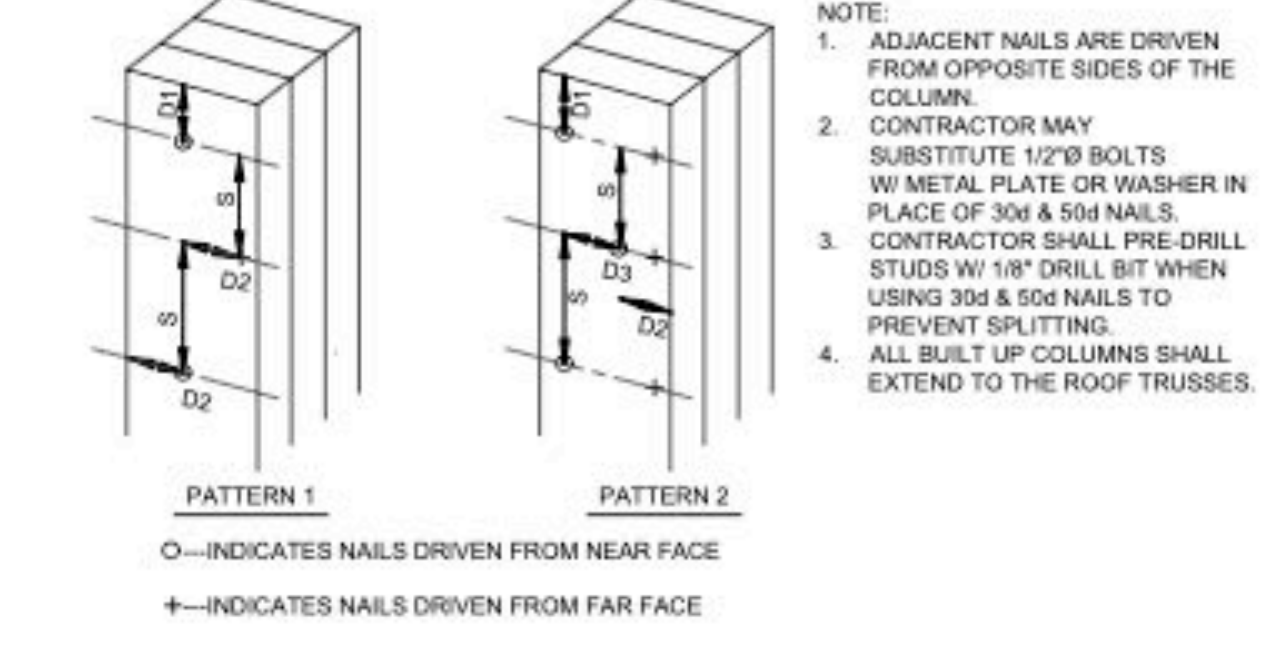

2 BUILT UP COLUMN SCHEDULE
SCALE: 3/4" = 1'-0"

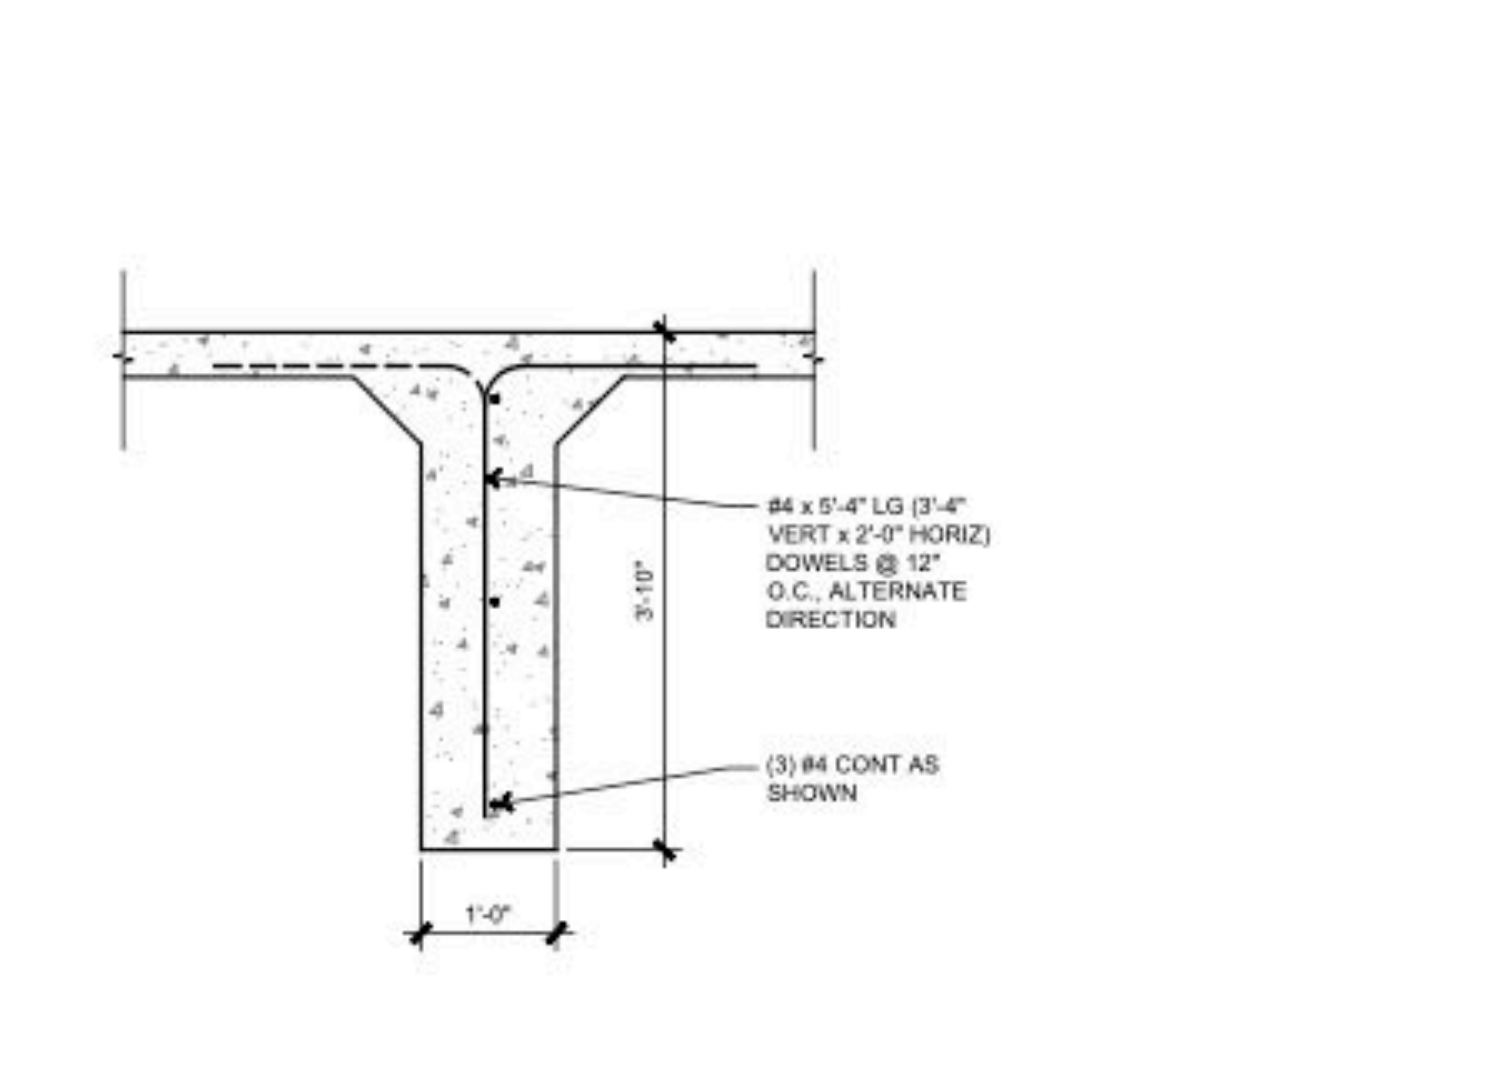


11 SLAB KEY
SCALE: 3/4" = 1'-0"


DECK PIER

PIER SIZE	AREA S.F.	CAPACITY LBS.	
		1500 PSF	2000 PSF
12"Ø	0.79	1,177	1,570
14"Ø	1.07	1,602	2,137
16"Ø	1.40	2,094	2,792
18"Ø	1.77	2,650	3,534
20"Ø	2.18	3,272	4,363
22"Ø	2.64	3,959	5,279
24"Ø	3.14	4,712	6,283
26"Ø	3.68	5,530	7,374
28"Ø	4.27	6,414	8,552

9 DECK PIER
SCALE: 3/4" = 1'-0"

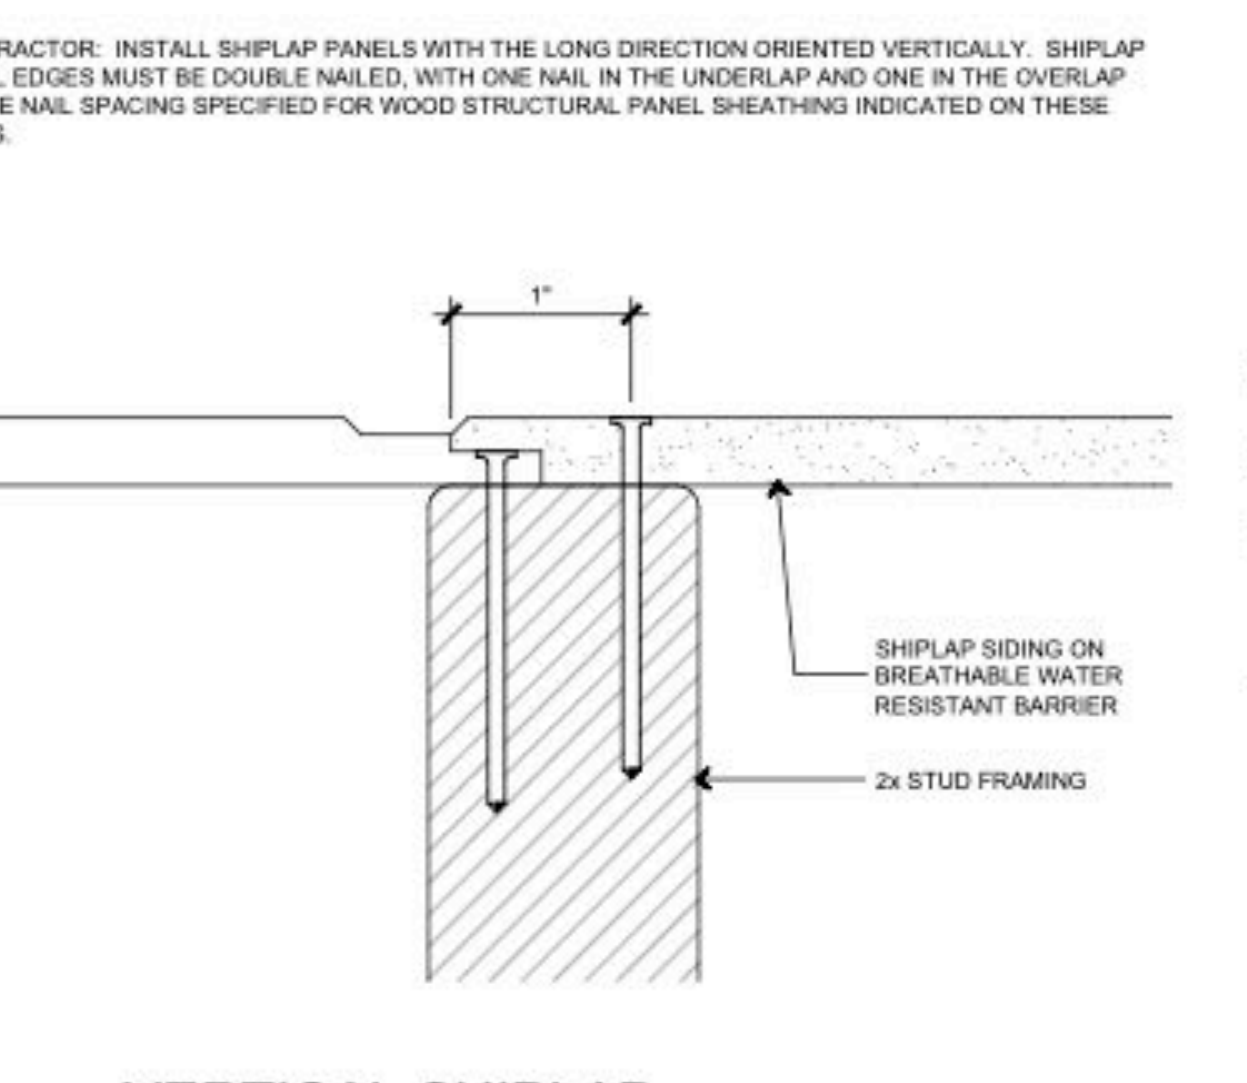

6 VERTICAL SHIPLAP SIDING PANEL JOINT
SCALE: FULL DWGNAME

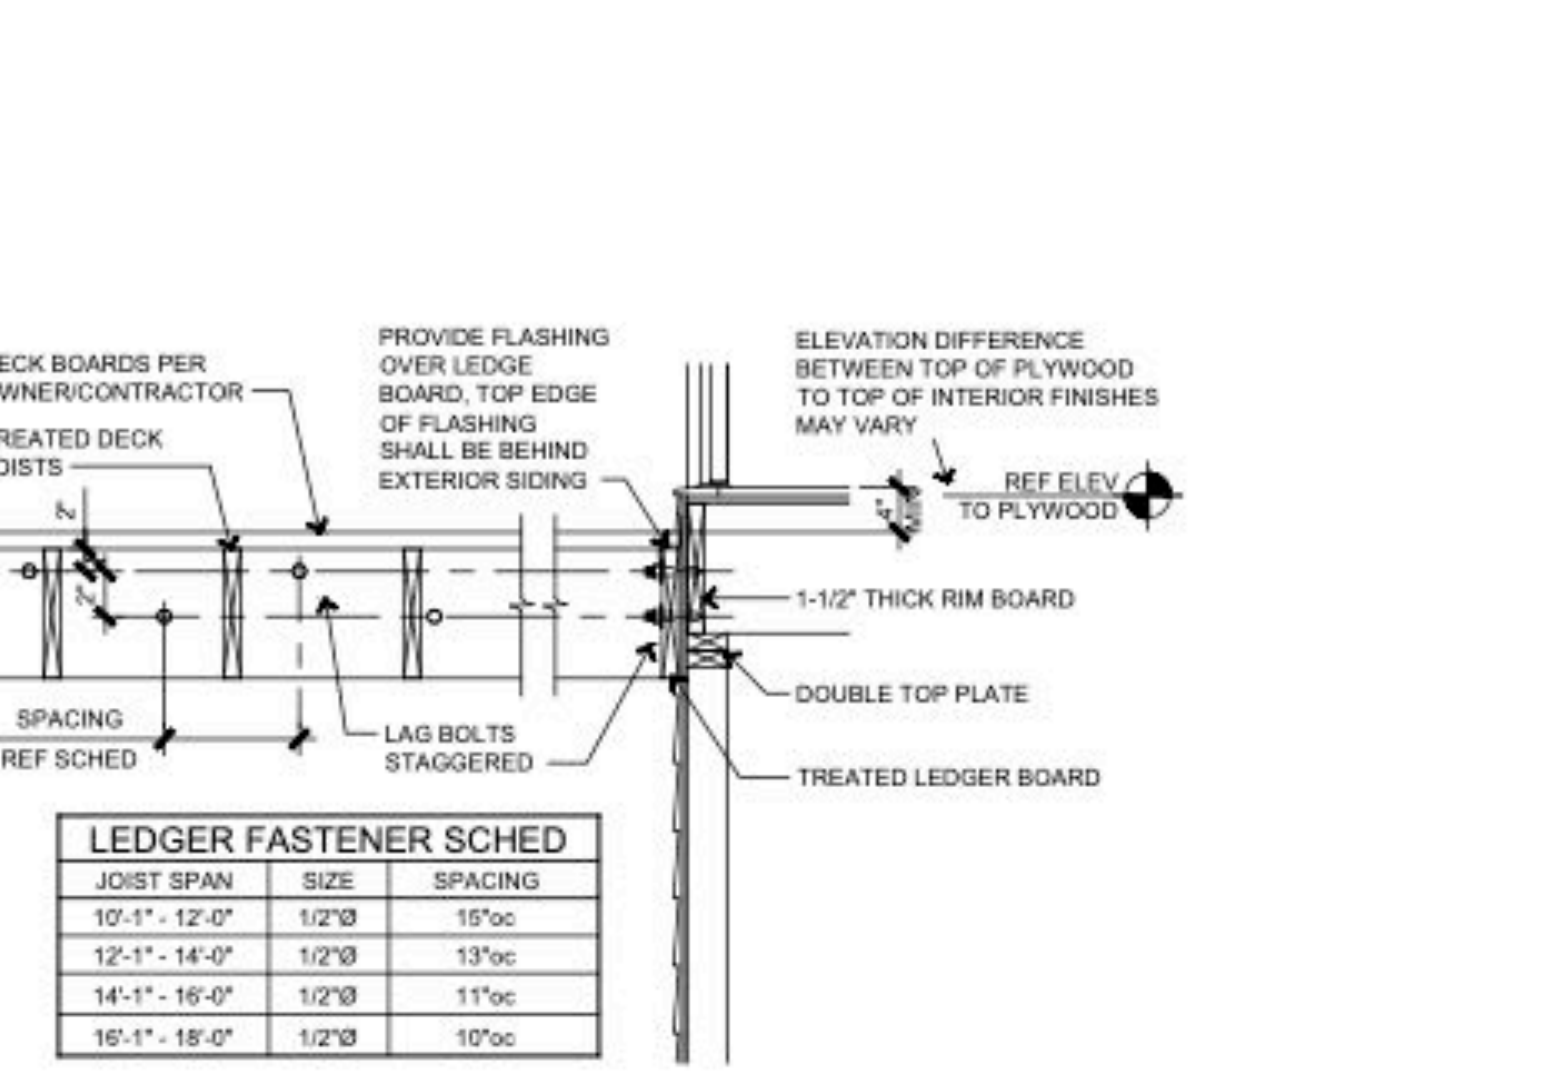


3 DECK LEDGER ATTACHMENT
SCALE: 3/4" = 1'-0"

LEDGER FASTENER SCHED

JOIST SPAN	SIZE	SPACING
10'-1" - 12'-0"	1/2"Ø	15"OC
12'-1" - 14'-0"	1/2"Ø	13"OC
14'-1" - 16'-0"	1/2"Ø	11"OC
16'-1" - 18'-0"	1/2"Ø	10"OC

SEQUOIA DUPLEX ALT #1
205 & 207 Orchard Court
LEE'S SUMMIT, MO

This Drawing And Information Contained Within Is Provided As An Instrument Of Service By The Architect, And Is Intended For Use On This Project Only. This Drawing Remains The Property Of The Architect And Shall Be Returned To Him Upon Completion Of The Construction Work. All Drawings, Specifications, Ideas, Designs And Arrangements Appearing Herein Constitute The Original And Unpublished Work Of The Architect. Any Reproduction, Use Or Disclosure Of The Proprietary Information Contained Herein Without The Prior Written Consent Of The Architect Is Strictly Prohibited.
© AGMP 2023

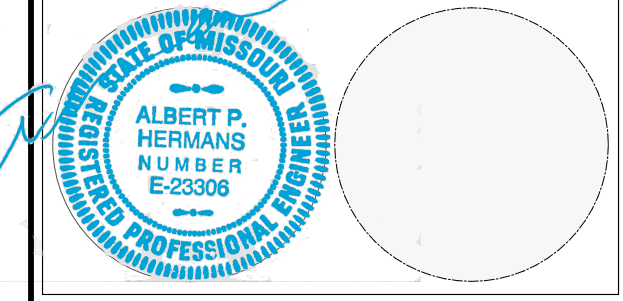


S502

REVISION	DATE	BY
1	APRIL 26, 2024	
2		
3		
4		
5		


SEQUOIA DUPLEX ALT #1
205 & 207 Orchard Court
LEE'S SUMMIT, MO

This Drawing And Information Contained Within Is Provided As An Instrument Of Service By The Architect, And Is Intended For Use On This Project Only. This Drawing Remains The Property Of The Architect And Shall Be Returned To Him Upon Completion Of The Construction Work. All Drawings, Specifications, Ideas, Designs And Arrangements Appearing Herein Constitute The Original And Unpublished Work Of The Architect. Any Reproduction, Use Or Disclosure Of The Proprietary Information Contained Herein Without The Prior Written Consent Of The Architect Is Strictly Prohibited.
© AGMP 2023

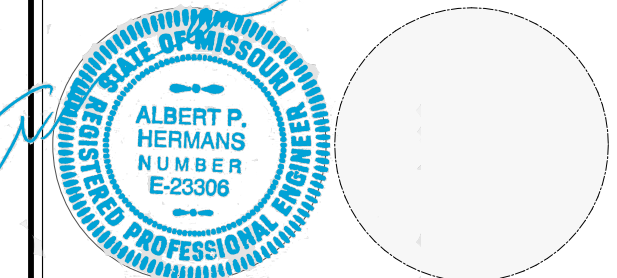


S503


1	Date	APRIL	26, 2024
2	REVISION		
3	REVISION		
4	REVISION		
5	REVISION		

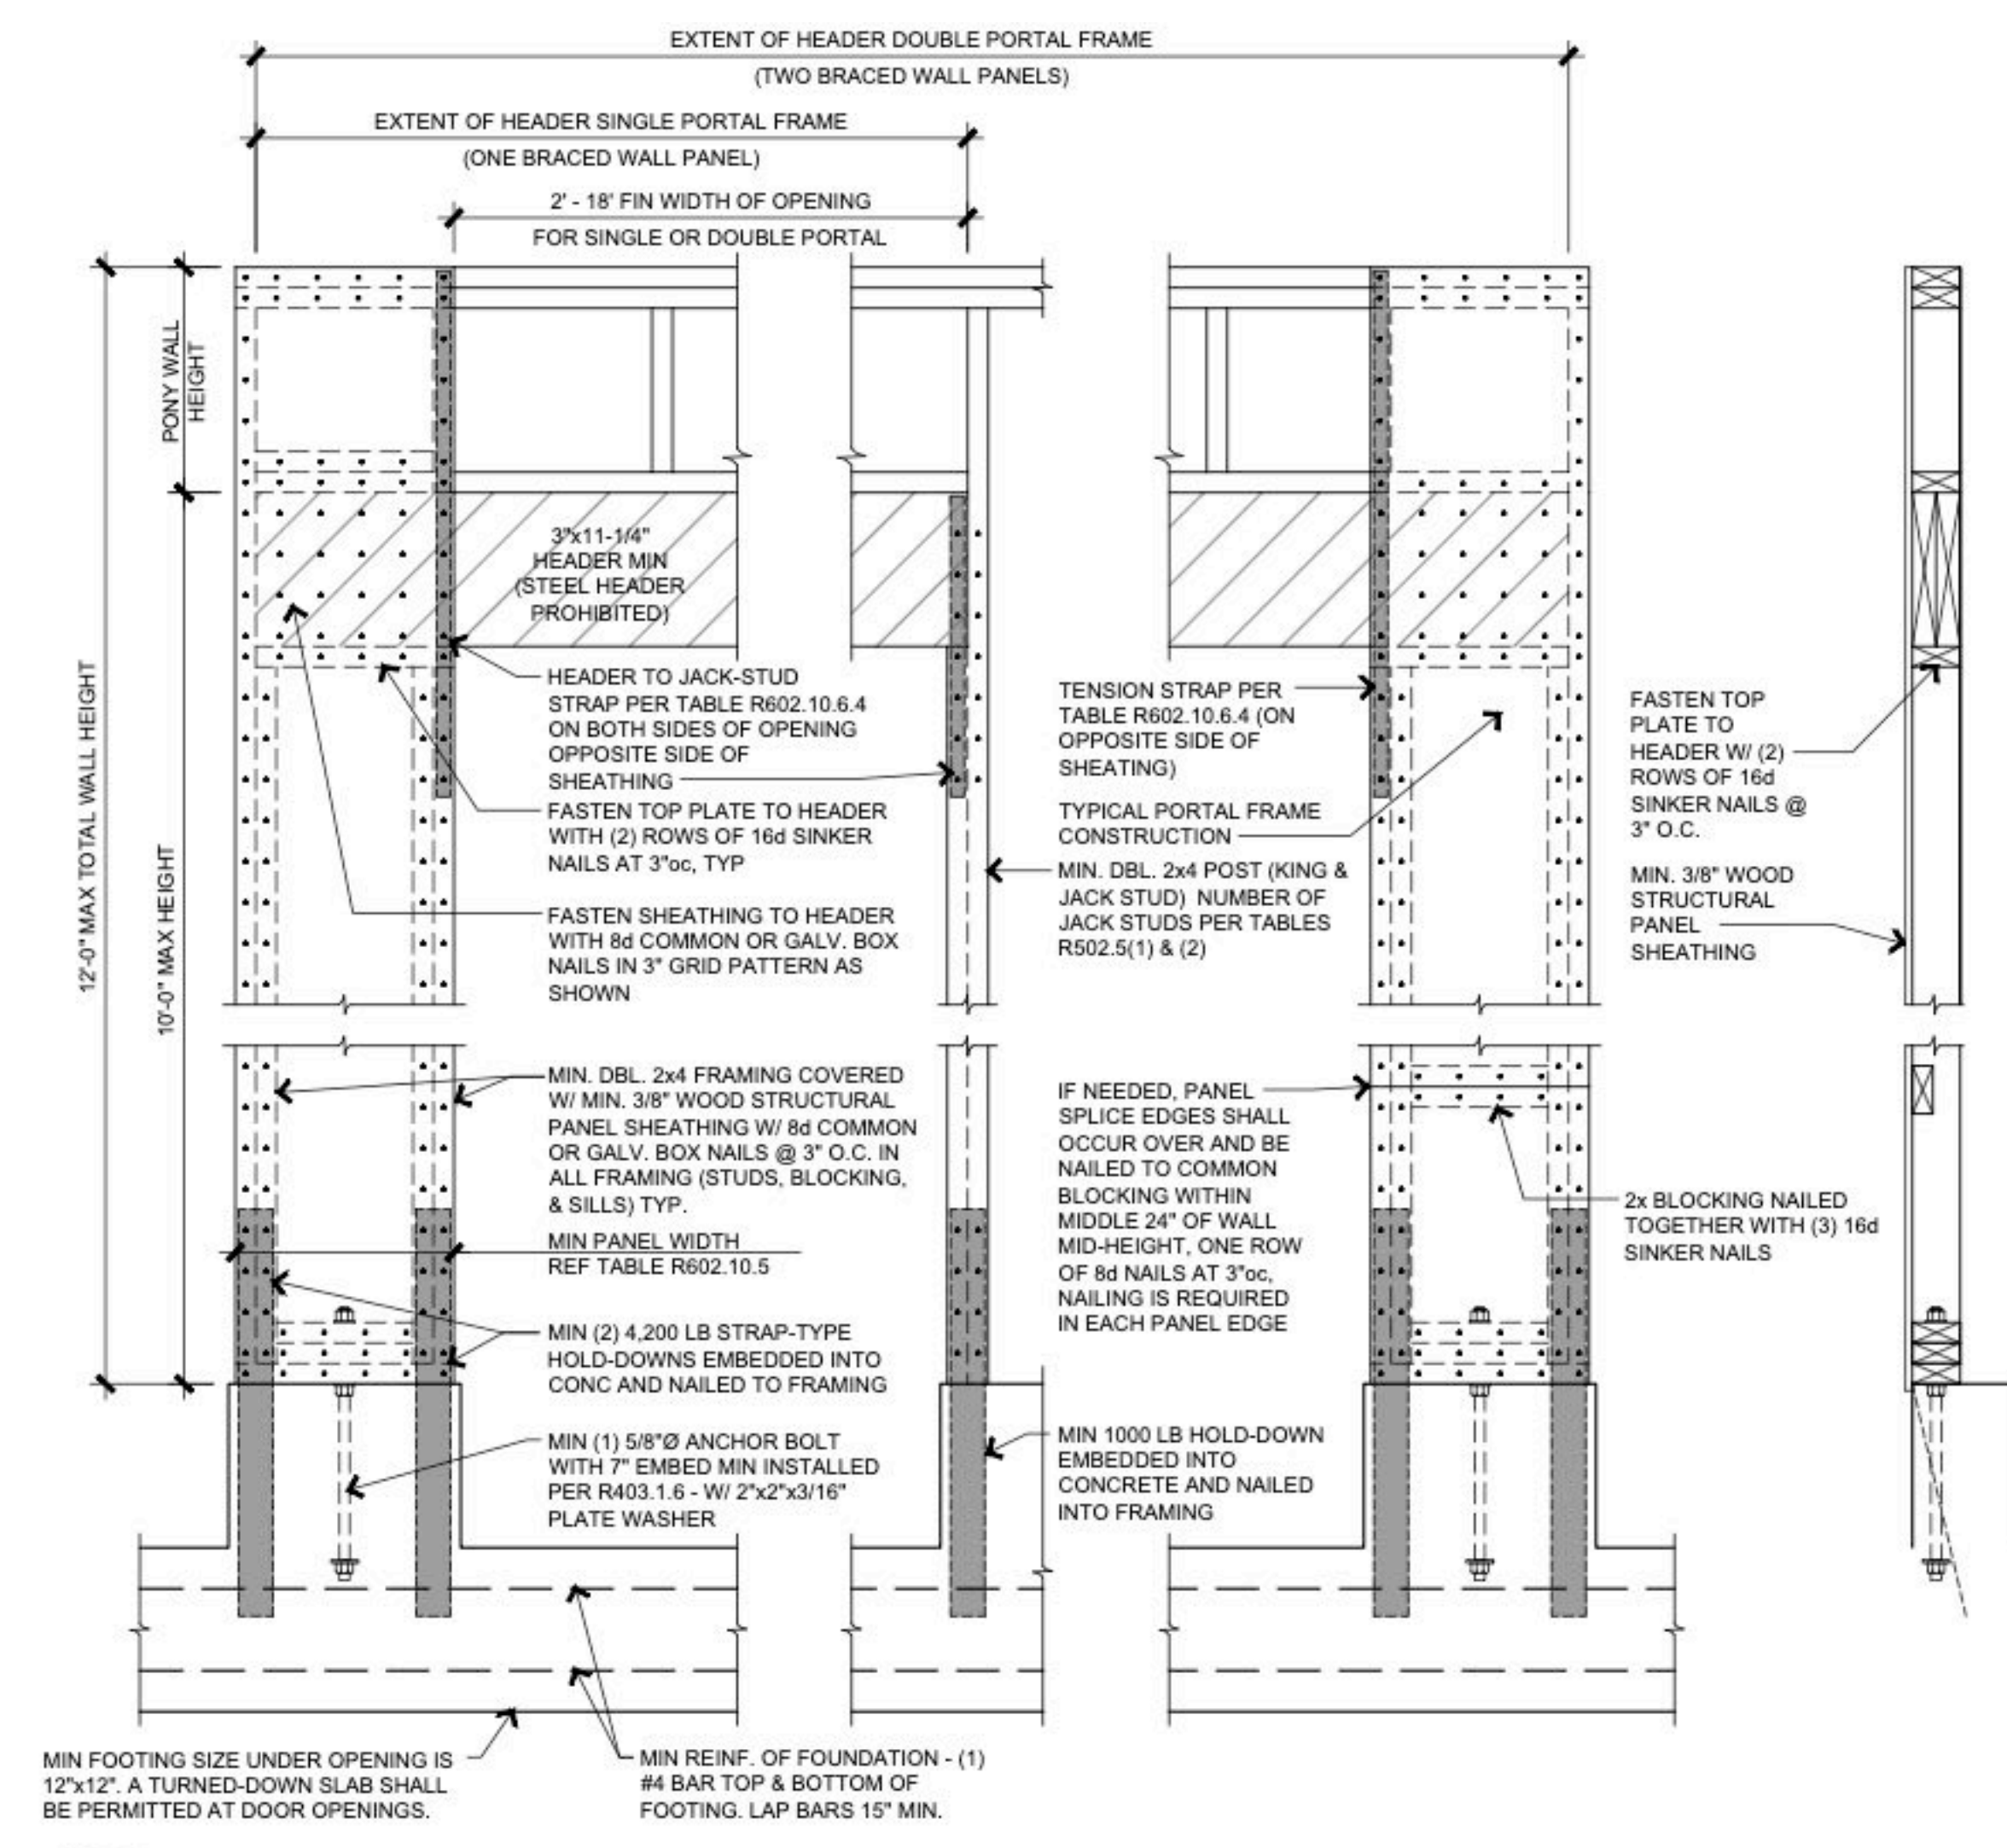


1 PFH-PORTAL FRAME WITH HOLD-DOWNS (R602.10.6.2)
SCALE: 1" = 1'-0"

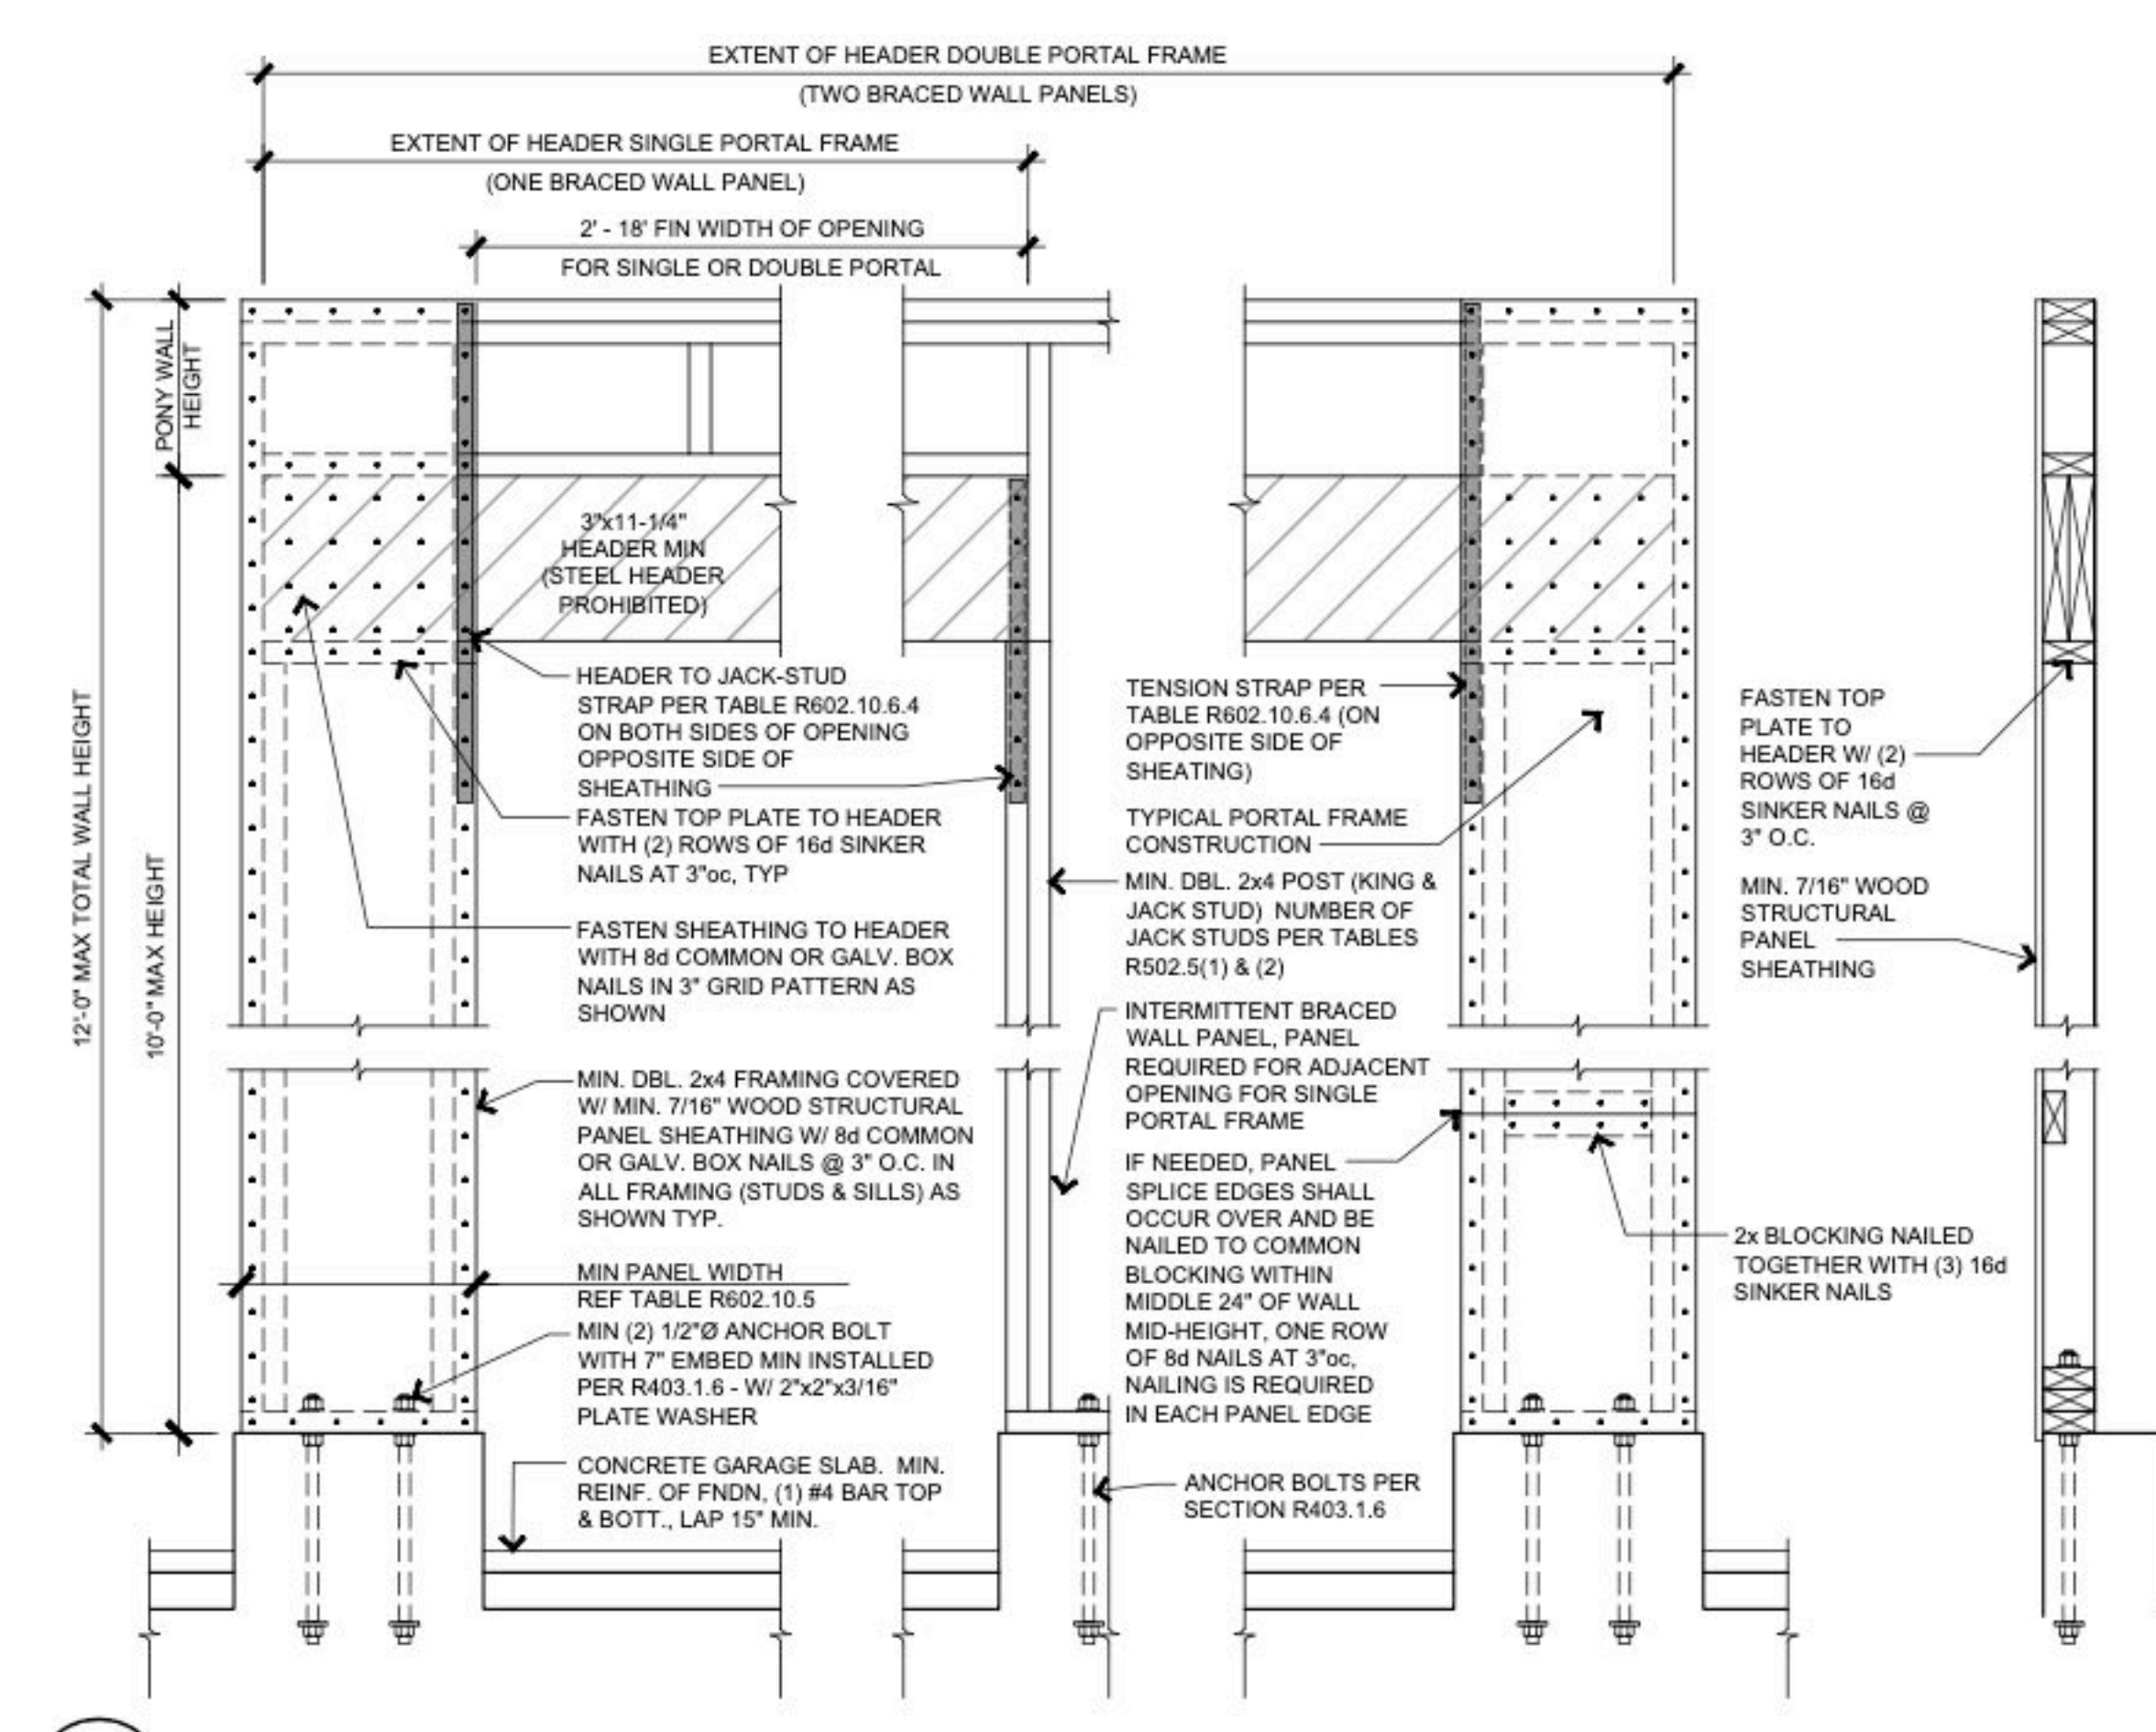

2 PORTAL FRAME AT GARAGE (PFG - R602.10.6.3)
SCALE: 1" = 1'-0"

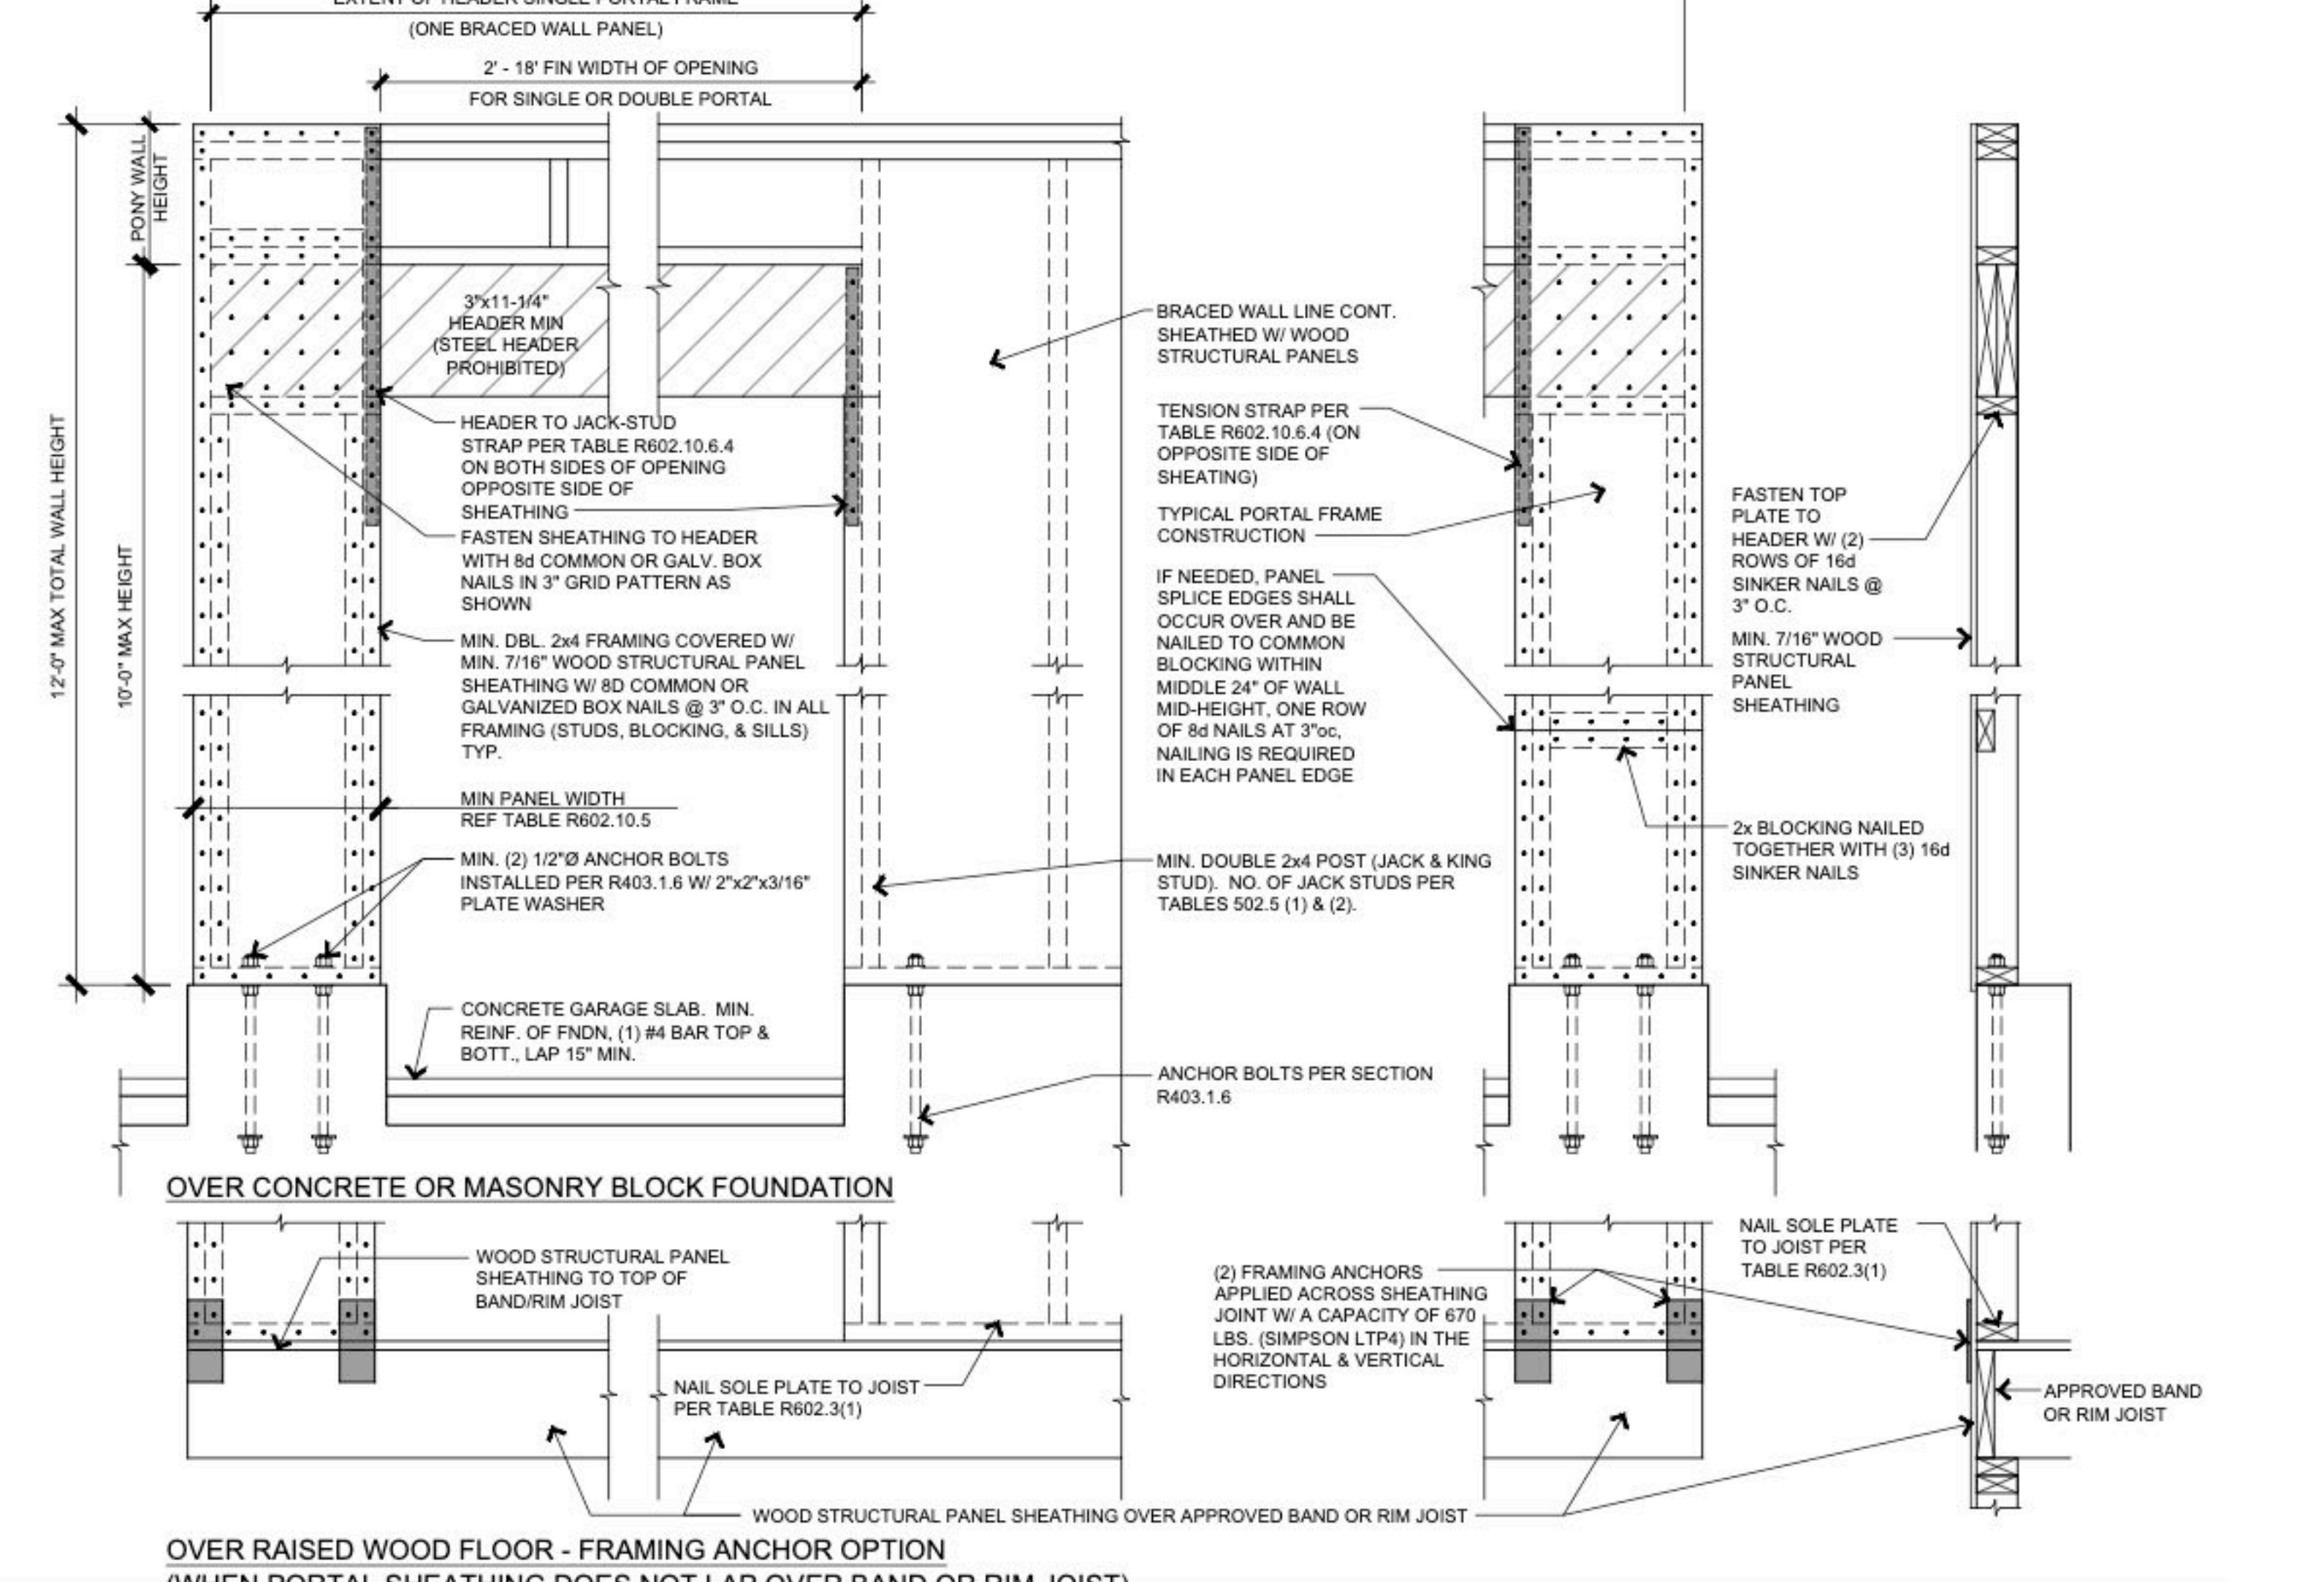

3 METHOD CS-PF CONT SHEATHED PORTAL FRAME (R602.10.6.4)
SCALE: 1" = 1'-0"

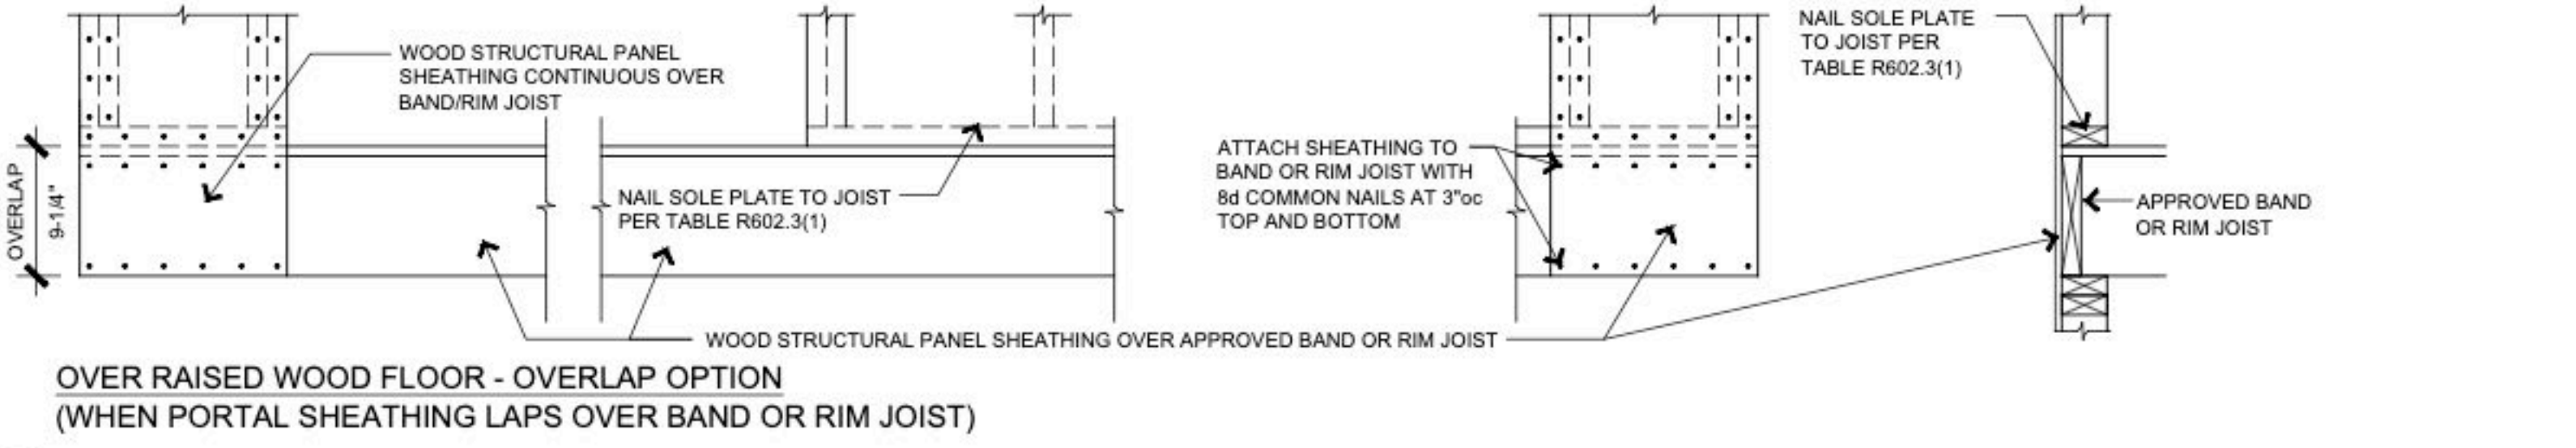

4 INTERIOR BRACED WALL (LIB)
SCALE: N.T.S.

TYPE	WALL HEIGHT			
	8 FEET	9 FEET	10 FEET	11 FEET
SUPPORTING ROOF ONLY	16"	16"	16"	18" (c)
SUPPORTING ONE STORY AND ROOF	24"	24"	24"	27" (c)

(c) MAXIMUM HEADER HEIGHT FOR PFH IS 10 FEET IN ACCORDANCE WITH FIGURE R602.10.6.2, BUT WALL HEIGHT MAY BE INCREASED TO 12 FEET WITH PONY WALL.

SIMPSON MODEL NO.	STRAP LENGTH	WALL DIM'S HEIGHT x WIDTH	ANGLE FROM HORIZONTAL	FASTENERS	
				PLATES	EA STUD
WB106	9'-5 5/8"	8'-0" x 5'-0"	60°	(2) 16d	(1) 8d
WB126	11'-4 3/8"	8'-0" x 8'-0"	45°	(2) 16d	(1) 8d
WB106C	9'-6"	8'-0" x 5'-0"	60°	(2) 16d	(1) 8d
WB126C	11'-4 13/16"	8'-0" x 8'-0"	45°	(2) 16d	(1) 8d
WB143C	14'-3"	10'-0" x 10'-0"	45°	(2) 16d	(1) 8d

TABLE R802.5.1(9) RAFTER/CEILING JOIST HEEL JOINT CONNECTIONS (a,b,c,d,e,f,g)

RAFTER SLOPE	RAFTER SPACING	GROUND SNOW LOAD (PSF)											
		30				50				70			
		12	20	28	36	12	20	28	36	12	20	28	36
3:12	12	4	6	8	11	5	8	12	15	6	11	15	20
4:12	12	3	5	6	8	4	6	9	11	5	8	12	15
5:12	12	3	4	5	7	3	5	7	9	4	7	9	12
7:12	12	3	3	4	5	3	4	5	7	3	5	7	9
9:12	12	3	3	3	4	3	3	4	5	3	4	5	7
12:12	12	3	3	3	3	3	3	3	4	3	3	4	5

- a. 40d BOX NAILS SHALL BE PERMITTED TO BE SUBSTITUTED FOR 16d COMMON NAILS.
- b. NAILING REQUIREMENTS SHALL BE PERMITTED TO BE REDUCED 25% IF NAILS ARE CLINCHED.
- c. HEEL JOINT CONNECTIONS ARE NOT REQUIRED WHEN THE RIDGE IS SUPPORTED BY A LOAD-BEARING WALL, HEADER, OR RIDGE BEAM.
- d. WHEN INTERMEDIATE SUPPORT OF THE RAFTER IS PROVIDED BY VERTICAL STRUTS OR PURLINS TO A LOAD-BEARING WALL, THE TABULATED HEEL JOINT CONNECTION REQUIREMENTS SHALL BE PERMITTED TO BE REDUCED PROPORTIONALLY TO THE REDUCTION IN SPAN.
- e. EQUIVALENT NAILING PATTERNS ARE REQUIRED FOR CEILING JOIST TO CEILING JOIST LAP SPLICES.
- f. WHEN RAFTER TIES ARE SUBSTITUTED FOR CEILING JOISTS, THE HEEL JOINT CONNECTION REQUIREMENT SHALL BE TAKEN AS THE TABULATED HEEL JOINT CONNECTION REQUIREMENT FOR TWO-THIRDS OF THE ACTUAL RAFTER SLOPE.
- g. TABULATED HEEL JOINT CONNECTION REQUIREMENTS ASSUME THAT CEILING JOISTS OR RAFTER TIES ARE LOCATED AT THE BOTTOM OF THE ATTIC SPACE. WHEN CEILING JOISTS OR RAFTER TIES ARE LOCATED HIGHER IN THE ATTIC, HEEL JOINT CONNECTION REQUIREMENTS SHALL BE INCREASED BY THE FOLLOWING FACTORS:


Hc/Hr	HEEL JOINT CONNECTION ADJUSTMENT FACTOR
1/3	1.5
1/4	1.33
1/5	1.25
1/6	1.2
1/10 OR LESS	1.11

WHERE:
 Hc= HEIGHT OF CEILING JOISTS OR RAFTER TIES MEASURED VERTICALLY ABOVE THE TOP OF THE RAFTER SUPPORT WALLS.
 Hr=HEIGHT OF ROOF RIDGE MEASURED VERTICALLY ABOVE THE TOP OF THE RAFTER SUPPORT WALLS.

ROOF RAFTER SCHEDULE

GRADE	MEMBER SIZE / SPACING	MAX SPAN CEILING JST'S AT TOP PLATE	MAX SPAN H _c /H _r =0.16	MAX SPAN H _c /H _r =0.20	MAX SPAN H _c /H _r =0.25	MAX SPAN H _c /H _r =0.33
#2 DF/L	2x6 / 24"oc	11'-9"	10'-6"	9'-9"	8'-11"	7'-10"
#2 DF/L	2x6 / 16"oc	14'-1"	12'-6"	11'-8"	10'-8"	9'-5"
#2 DF/L	2x8 / 16"oc	18'-2"	16'-4"	15'-1"	13'-9"	12'-2"
#2 DF/L	2x10 / 16"oc	22'-3"	20'-0"	18'-5"	16'-10"	14'-10"
#2 DF/L	2x12 / 16"oc	25'-9"	23'-2"	21'-4"	19'-7"	17'-3"

SPANS ABOVE ARE FOR ROOF LIVE LOAD OF 20 PSF AND DEAD LOAD OF 10 PSF WITH CEILINGS ATTACHED TO RAFTERS. RE: TABLES R802.5.1(1) THROUGH R802.5.1(8) FOR ADDITIONAL RAFTER SPAN INFORMATION.
 THE ROOF FRAMING ON THIS HOME UTILIZES RAFTERS SPACED AT 16" ON CENTER IN EXPOSURE B WITH A ROOF SPAN LESS THAN 42' ON IN 90 MPH WIND ZONE. THEREFORE THE UPLIFT FORCE ON THE RAFTER IS LESS THAN 200 LBS. AND CAN BE CONNECTED PER TO THE WALL FRAMING PER TABLE 602.3(1).

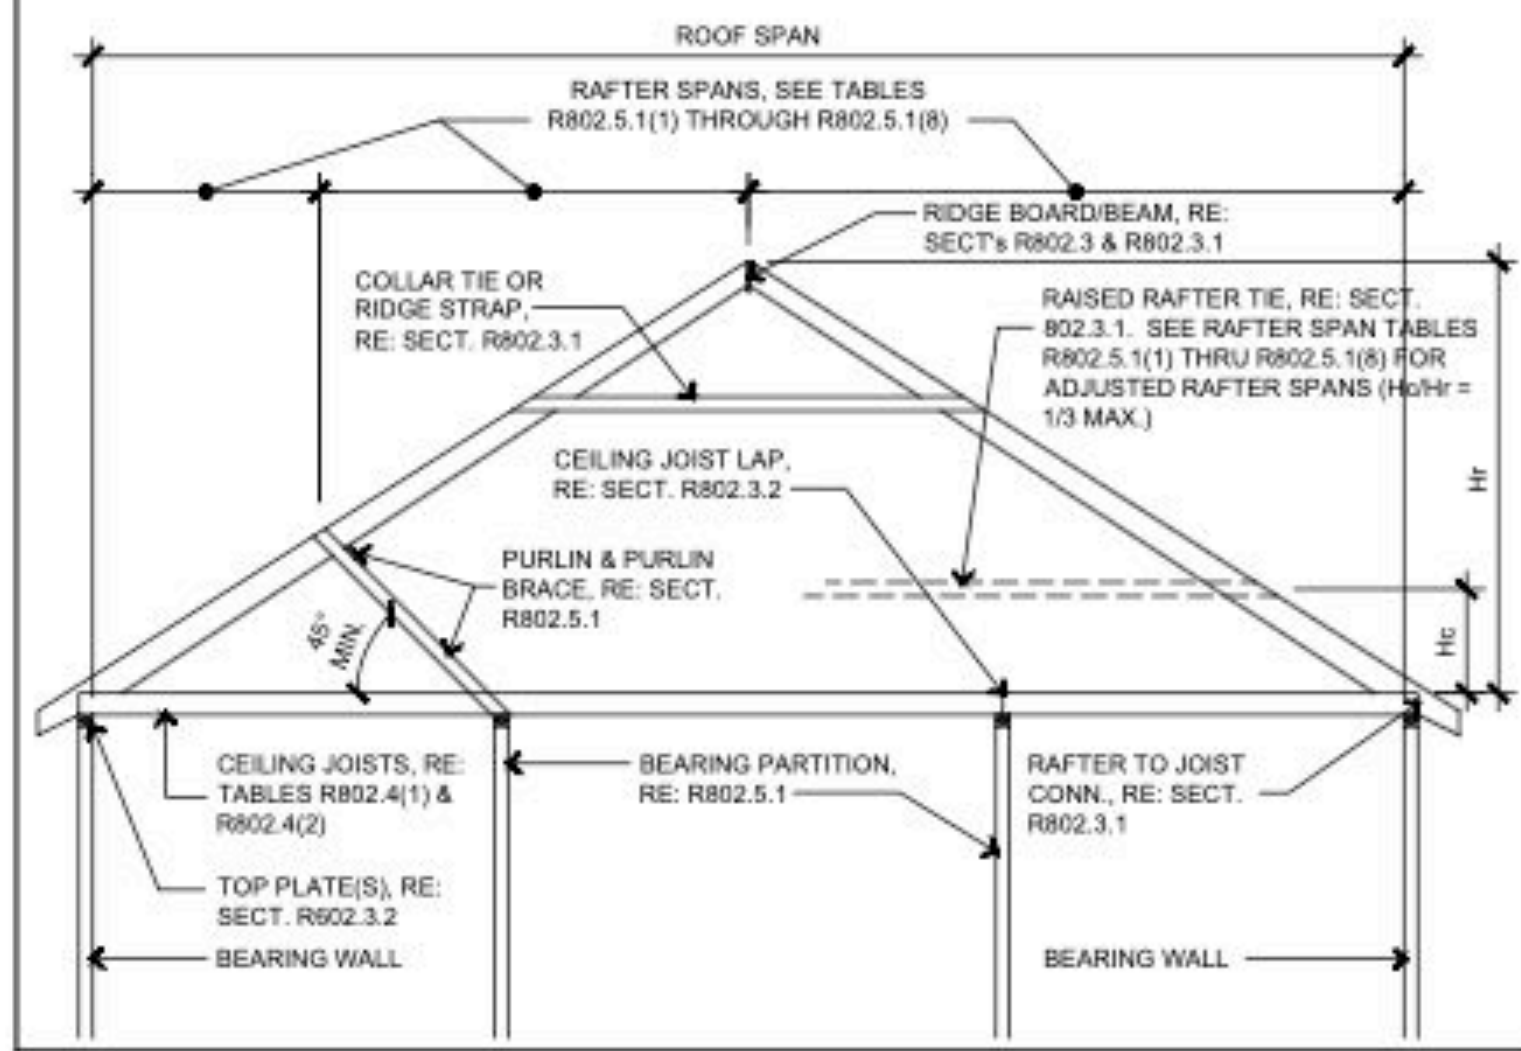


NAILING SCHEDULE IRC 2012 TABLE R602.3(1)

Description of Building Elements	Number & Type of Fastener (a,b,c)	Spacing of Fasteners
Roof		
Blocking between joists or rafters to top plate, toe nail	3 - 8d (2 1/2" x 0.113")	
Ceiling joists to plate, toe nail	3 - 8d (2 1/2" x 0.113")	
Ceiling joist not attached to parallel rafter, laps over partitions, face nail	3 - 10d (3" x 0.128")	
Collar tie to rafter, face nail, or 1 1/4" x 20 gage ridge strap	3 - 10d (3" x 0.128")	
Rafter or roof truss to plate, toe nail	3 - 16d box nails (3 1/2" x 0.135") or 3 - 10d common nails (3" x 0.148")	2 toe nails on one side and 1 toe nail on opposite side of each rafter or truss (j)
Roof rafters to ridge, valley or hip rafters: toe nail	4 - 16d (3 1/2" x 0.135")	
Roof rafters to ridge, valley or hip rafters: face nail	3 - 16d (3 1/2" x 0.135")	
Wall		
Built-up studs	10d (3" x 0.128")	24" o.c.
Abutting studs at intersecting wall corners, face nail	16d (3 1/2" x 0.135")	12" o.c.
Built up header, two pieces with 1/2" spacer	16d (3 1/2" x 0.135")	16" o.c. along ea. edge
Continued header, two pieces	16d (3 1/2" x 0.135")	16" o.c. along ea. edge
Continuous header to stud, toe nail	4 - 8d (2 1/2" x 0.113")	
Double studs, face nail	10d (3" x 0.128")	24" o.c.
Double top plates, face nail	10d (3" x 0.128")	24" o.c.
Double top plates, minimum 24" offset of end joints, face nail in lapped area	8 - 16d (3 1/2" x 0.135")	
Sole plate to joist or blocking, face nail	16d (3 1/2" x 0.135")	16" o.c.
Sole plate to joist or blocking at braced wall panels	3 - 16d (3 1/2" x 0.135")	16" o.c.
Stud to sole plate, toe nail	3 - 8d (2 1/2" x 0.113") or 2 - 16d (3 1/2" x 0.135")	
Top or sole plate to stud, end nail	2 - 16d (3 1/2" x 0.135")	
Top plates, laps at corners and intersections, face nail	2 - 10d (3" x 0.128")	
1" brace to each stud and plate, face nail	2 - 8d (2 1/2" x 0.113") 2 staples, 1 3/4"	
1" x 6" sheathing to each bearing, face nail	2 - 8d (2 1/2" x 0.113") 3 staples, 1 3/4"	
Wider than 1" x 6" sheathing to each bearing, face nail	3 - 8d (2 1/2" x 0.113") 4 staples, 1 3/4"	
Floor		
Joist to sill or girder, toe nail	3 - 8d (2 1/2" x 0.113")	
Rim joist to top plate, toe nail (roof applications also)	8d (2 1/2" x 0.113")	6" o.c.
Rim joist or blocking to sill plate, toe nail	8d (2 1/2" x 0.113")	6" o.c.
1" x 6" subfloor or less to each joist, face nail	2 - 8d (2 1/2" x 0.113") 2 staples, 1 3/4"	
2" subfloor to joist or girder, blind & face nail	2 - 16d (3 1/2" x 0.135")	
2" planks (plan & beam - floor & roof)	2 - 16d (3 1/2" x 0.135")	At each bearing

NAILING SCHEDULE IRC 2012 TABLE R602.3(1)

Description of Building Elements	Number & Type of Fastener (a,b,c)	Spacing of Fasteners
Floor (Continued)		
Built-up girders and beams, 2-inch lumber layers	10d (3" x 0.128")	Nail ea. layer as follows: 32" o.c. at top & bott. & staggered. Two nails at ends and at ea. splice
Ledger strip supporting joists or rafters	3 - 16d (3 1/2" x 0.135")	At each joist or rafter
Wood Structural Panels, subfloor, roof and wall sheathing to framing, and particulate wall sheathing to framing		
3/8" - 1/2"	6d common (2" x 0.113") nail (subfloor, wall(j)) 8d common (2 1/2" x 0.131") nail (roof)(j)	6" 12" (g)
19/32" - 1"	8d common (2 1/2" x 0.131") nail (f)	6" 12" (g)
1 1/8" - 1 1/4"	10d common (3" x 0.148") nail or 8d (2 1/2" x 0.131") deformed nail	6" 12"
Other wall sheathing (h)		
1/2" structural cellulose fiberboard sheathing	1 1/2" galvanized roofing nail 8d common (2 1/2" x 0.131") nail, staple 16 ga., 1 1/2" long	3" 6"
25/32" structural cellulose fiberboard sheathing	1 3/4" galvanized roofing nail 8d common (2 1/2" x 0.131") nail, staple 16 ga., 1 1/2" long	3" 6"
1/2" gypsum sheathing (d)	1 1/2" galvanized roofing nail; staple galvanized, 1 1/2" long; 1 1/4" screws, Type W or S	7" 7"
5/8" gypsum sheathing (d)	1 3/4" galvanized roofing nail; staple galvanized, 1 5/8" long; 1 5/8" screws, Type W or S	7" 7"
Wood structural panels, combination subfloor underlayment to framing		
3/4" or less	6d deformed (2" x 0.120") nail or 8d common (2 1/2" x 0.131") nail	6" 12"
7/8" - 1"	8d common (2 1/2" x 0.131") nail or 8d deformed (2 1/2" x 0.120") nail	6" 12"
1 1/8" - 1 1/4"	10d common (3" x 0.148") nail or 8d deformed (2 1/2" x 0.120") nail	6" 12"


- a. All nails are smooth-common, box or deformed shanks except where otherwise stated. Nails used for framing and sheathing connections shall have minimum average bending yield strengths as shown: 80 ksi for shank diameter of 0.192 inch (20d common nail), 90 ksi for shank diameters larger than 0.142 inch but not larger than 0.177 inch, and 100 ksi for shank diameters of 0.142 inch or less.
- b. Staples are 16 gage wire and have a minimum 7/16-inch on diameter crown width.
- c. Nails shall be spaced at not more than 6" on center at all supports where spans are 48 inches or greater.
- d. Four-foot-by-8-foot or 4-foot-by-9-foot panels shall be applied vertically.
- e. Spacing of fasteners not included in this table shall be based on Table R602.3(2).
- f. For regions having basic wind speed of 110 mph or greater, 8d deformed (2 1/2" x 0.120) nails shall be used for attaching plywood and wood structural panel roof sheathing to framing within minimum 48-inch distance from gable end walls, if mean roof height is more than 25 feet, up to 35 feet maximum.
- g. For regions having a basic wind speed of 100 mph or less, nails for attaching wood structural panel roof sheathing to gable end wall framing shall be spaced 6 inches on center. When basic wind speed is greater than 100 mph, nails for attaching panel roof sheathing to intermediate supports shall be spaced 6 inches on center for minimum 48-inch distance from ridges, eaves and gable end walls; and 4 inches on center to gable end wall framing.
- h. Gypsum sheathing shall conform to ASTM C 1396 and shall be installed in accordance with GA 253. Fiberboard sheathing shall conform to ASTM C 208.
- i. Spacing of fasteners on floor sheathing panel edges applies to panel edges supported by framing members and required blocking and at all floor perimeters only. Spacing of fasteners on roof sheathing panel edges applies to panel edges supported by framing members and required blocking. Blocking of roof or floor sheathing panel edges perpendicular to the framing members need not be provided except as required by other provisions of this code. Floor perimeter shall be supported by framing members or solid blocking.
- j. Where a rafter is fastened to an adjacent parallel ceiling joist in accordance with this schedule, provide two toe nails on one side of the rafter and toe nails from the ceiling joist to top plate in accordance with this schedule. The toe nail on the opposite side of the rafter shall not be required.

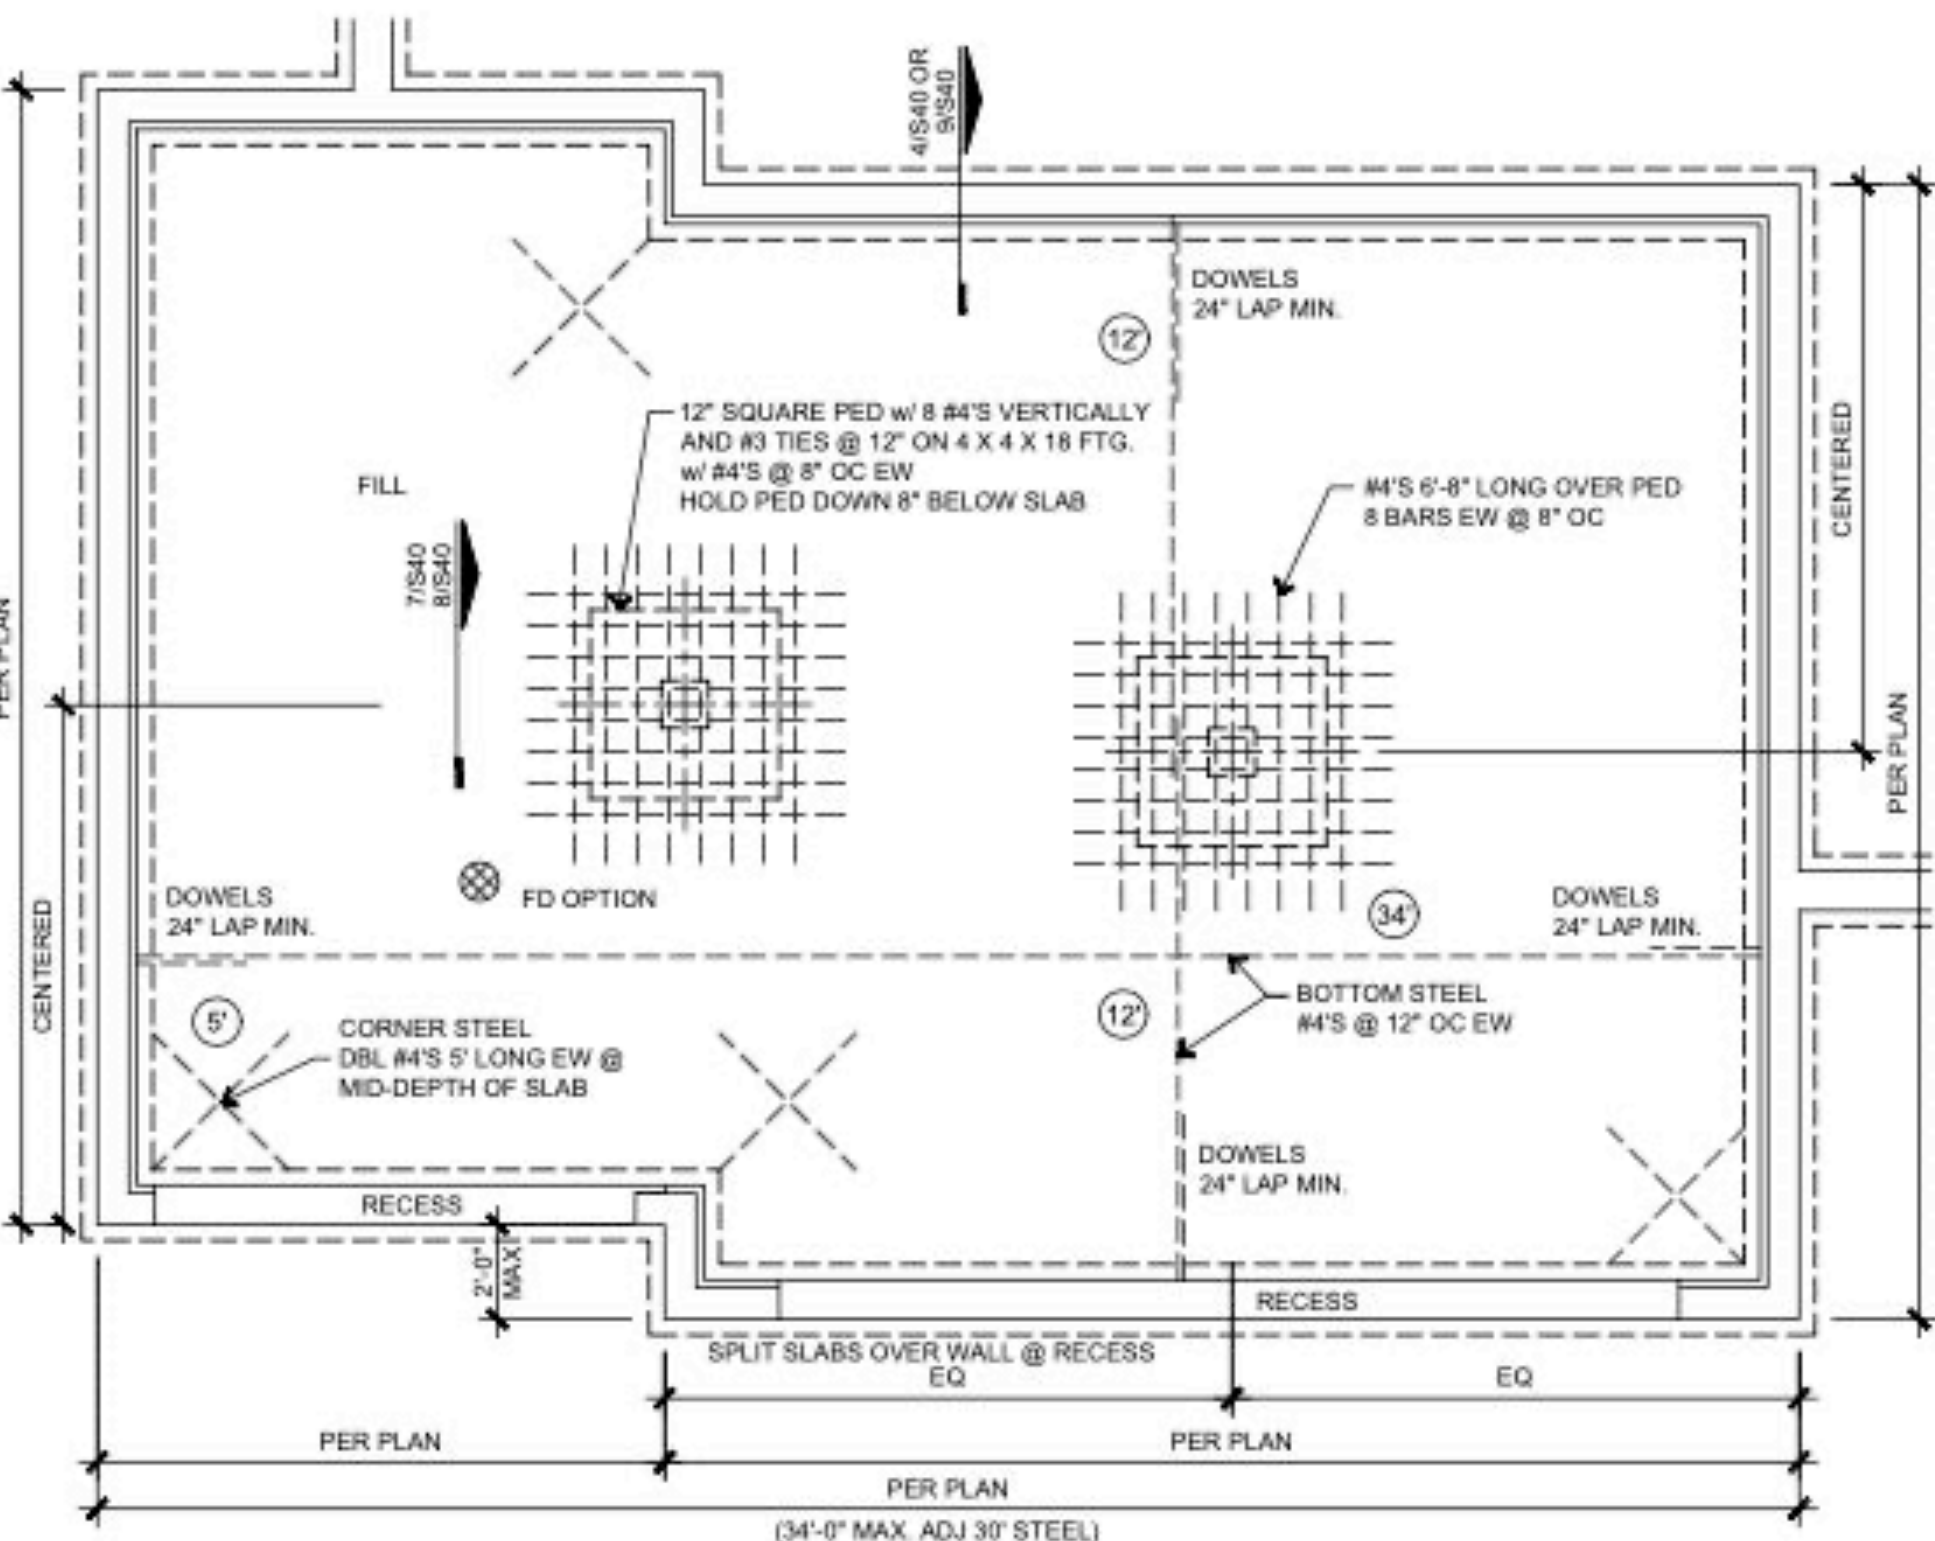

2 GARAGE SLAB ON FILL

SCALE: NTS

REQUIREMENTS
 RETURN PANEL:
 24" FOR BRACED WALL LINES SHEATHED WITH WOOD STRUCTURAL PANELS
 32" FOR BRACED WALL LINES SHEATHED WITH STRUCTURAL FIBERBOARD
 DISTANCE D:
 24" FOR BRACED WALL LINES SHEATHED WITH WOOD STRUCTURAL PANELS
 32" FOR BRACED WALL LINES SHEATHED WITH STRUCTURAL FIBERBOARD
 HOLD-DOWN DEVICE:
 800 lbs CAPACITY FASTENED TO THE EDGE OF THE BRACED WALL PANEL CLOSEST TO THE CORNER AND TO THE FOUNDATION OR FLOOR FRAMING BELOW

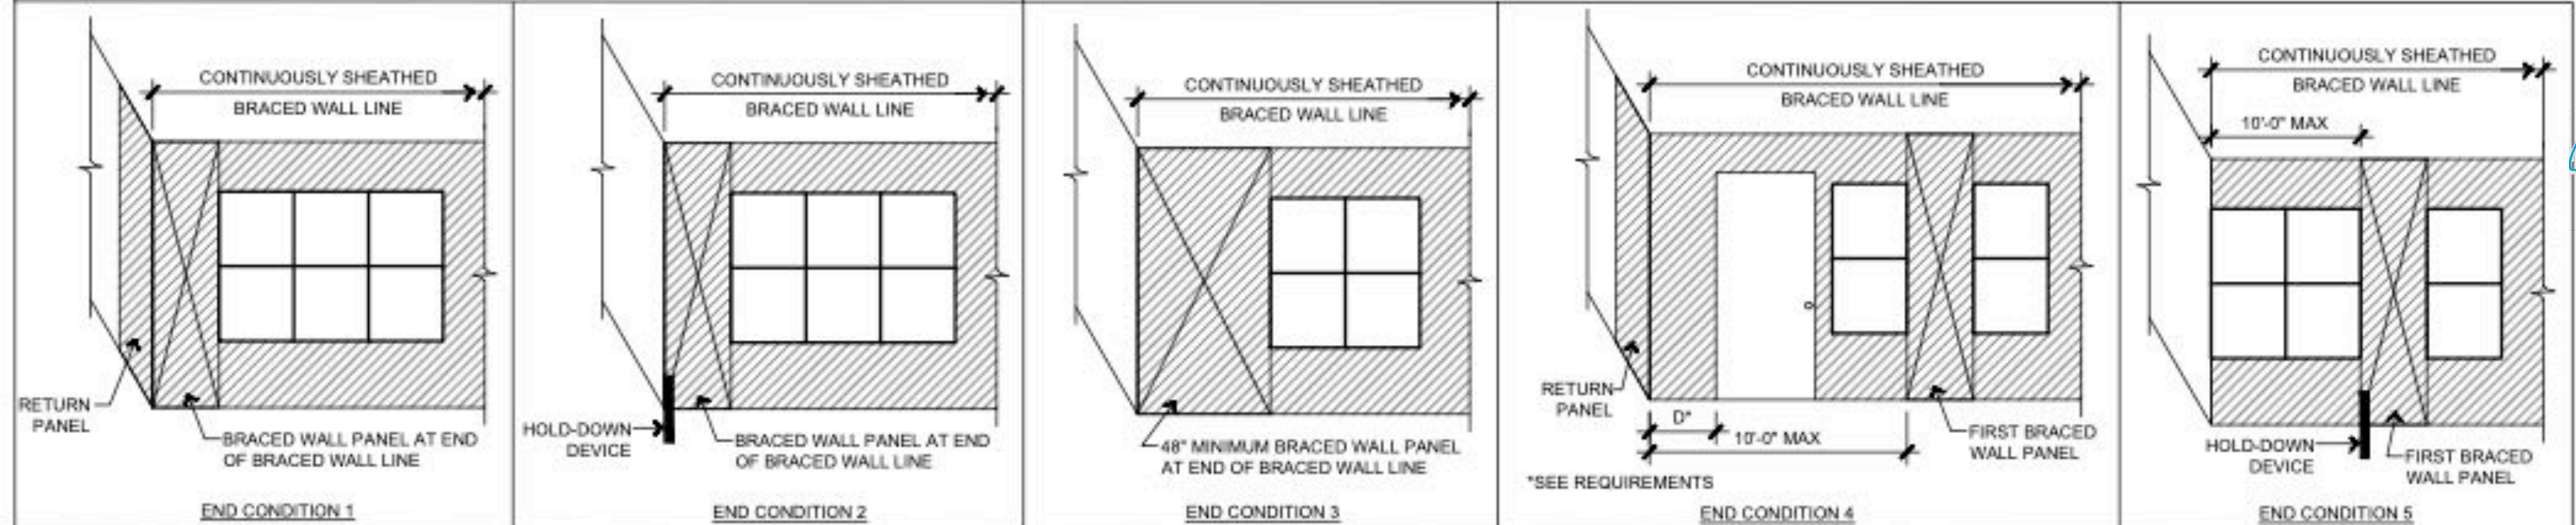

1 END CONDITIONS FOR BRACED WALL LINES WITH CONTINUOUS SHEATHING R602.10.7

SCALE: NTS

SEQUOIA DUPLEX ALT #1
205 & 207 Orchard Court
LEE'S SUMMIT, MO

This Drawing And Information Contained Within Is Provided As An Instrument Of Service By The Architect, And Is Intended For Use On This Project Only. This Drawing Remains The Property Of The Architect And Shall Be Returned To Him Upon Completion Of The Construction Work. All Drawings, Specifications, Ideas, Designs And Arrangements Appearing Herein Constitute The Original And Unpublished Work Of The Architect. Any Reproduction, Use Or Disclosure Of The Proprietary Information Contained Herein Without The Prior Written Consent Of The Architect Is Strictly Prohibited.
 © AGMP 2023



S504

1	Date	APRIL	26, 2024
2	REVISION		
3	REVISION		
4	REVISION		
5	REVISION		