




3/16" = 1'-0"

NORTH

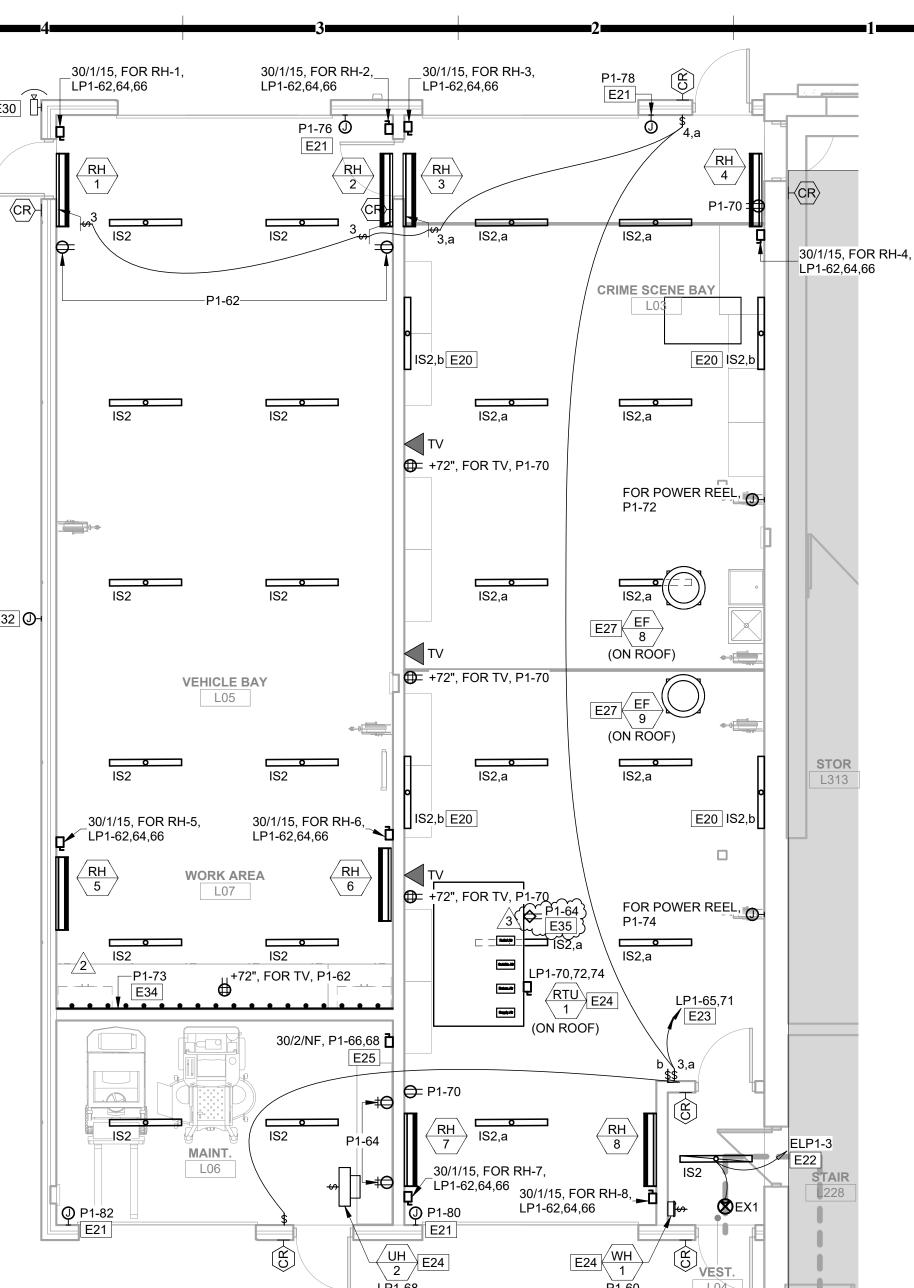

GENERAL NOTES: ELECTRICAL NOTES. CONNECT TO EXISTING LIGHTING E8 WITH NEW LIGHTING. E10 OF RESULTS. E12 REINSTALL LIGHT FIXTURE CONTROLS. E14 EXISTING LIGHTING CIRCUIT E16 REINSTALL LIGHTING CONTROLS MAINTAIN EXISTING CIRCUIT. E19 PROVIDE 4" FIRE-RATED POKE-THRU PROVIDE BLACK COVER. E20 WALL MOUNT LIGHT FIXTURE AT +72" E21 EXACT LOCATION AND POWER VENDOR'S INSTALLATION E22 PROVIDE POWER FROM EXISTING LIFE SAFETY LIGHTING CIRCUIT IN SHOWN IS BASED ON AS-BUILT RESULTS. E23 PROVIDE POWER FROM EXISTING NORMAL LIGHTING CIRCUIT IN SHOWN IS BASED ON AS-BUILT RESULTS. E24 PROVIDE POWER TO DIVISION 23 DIVISION 23. G E25 PROVIDE POWER TO AIR PRIOR TO ROUGH-IN. E27 CONNECT NEW ROOF-MOUNTED DEMOLITION. E30 OWNER. E32 LOCATION. E34

4 E35

UNIT.

