
THE VILLAGE AT DISCOVERY PARK

LOCATION MAP

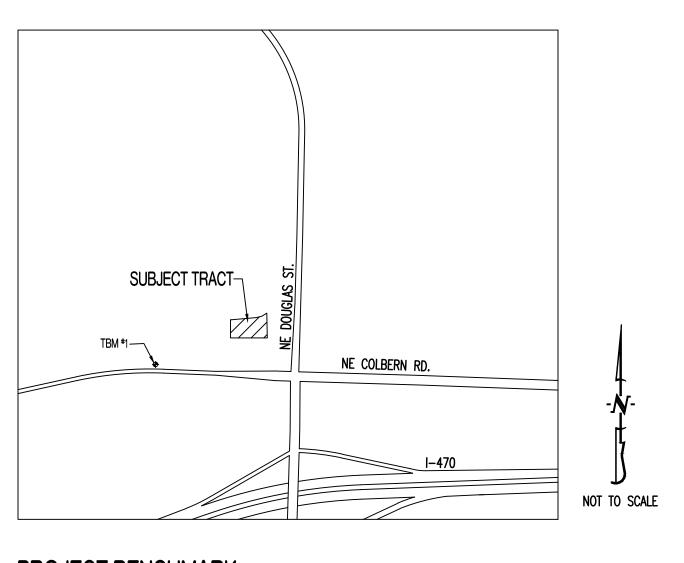

TBM #1 - CONTROL POINT #50 SET BY OLSSON. 1/2" IMBEDDED CAP ON NORTH SIDE OF NW COLBERN RD. LOCATED AT 1ST FIELD ENTRANCE.

EASTING = 2822108.784

REFER TO "PRIVATE SITE DEVELOPMENT PLANS FOR THE VILLAGE AT DISCOVERY PARK ZONE 1" PLANS BY OLSSON DATED 10/18/2023 FOR MORE INFORMATION.

FLOOD PLAIN STATEMENT:

THIS LOT IS LOCATED IN ZONE X UNSHADED - AREAS DETERMINED TO BE OUTSIDE THE 1% ANNUAL CHANCE FLOOD AS SHOWN ON THE FEMA F.I.R.M. PANEL #29095C0409G, DATED JANUARY 20, 2017.

LEGAL DESCRIPTION:

VILLAGE AT DISCOVERY PARK, LOT 4. A SUBDIVISION IN JACKSON COUNTY, LEE'S SUMMIT, MISSOURI.

UTILITY COMPANIES:

LOCATES: MISSOURI ONE CALL INC.





TELEPHONE:

800-286-8313

NATURAL GAS:

314-342-0500

FIBER: **GOOGLE FIBER** 877-454-6959

ELECTRIC:

816-524-3223

CITY OF LEE'S SUMMIT

1200 S HAMBLEN RD LEE'S SUMMIT, MO 64081

816-969-1900

WATER UTILITIES DEPARTMENT

WATER/SANITARY SEWER:

CABLE TELEVISION: 877-772-2253

GENERAL NOTES:

ALL STREET, STORM DRAIN, AND SANITARY SEWER CONSTRUCTION TO BE IN ACCORDANCE WITH THE CITY OF LEE'S SUMMIT "DESIGN AND CONSTRUCTION MANUAL" (CURRENT EDITION).

ANY CITY DETAILS SHOWN ON THIS SET OF PLANS ARE FOR REFERENCE ONLY. CONTRACTOR TO HAVE A COPY OF THE CITY'S LATEST EDITION OF SPECIFICATIONS AND STANDARDS FOR ALL STREET, STORM, AND SANITARY CONSTRUCTION ON SITE AT ALL TIMES DURING CONSTRUCTION. REFER TO https://cityofls.net/development-services/design/design-criteria/design-construction-manual-infrastructure

CONTRACTOR WILL BE RESPONSIBLE FOR PLACEMENT AND MAINTENANCE OF TRAFFIC CONTROL DEVICES NECESSARY TO COMPLETE THEIR PORTION OF WORK. THE DEVICES AND METHODS EMPLOYED WILL COMPLY WITH THE CURRENT VERSION OF THE MANUAL ON UNIFORM TRAFFIC CONTROL DEVICES.

ALL CONCRETE MATERIALS SHALL CONFORM TO KCMMB STANDARDS AND SPECIFICATIONS.

THIS PLAT CONTAINS APPROXIMATELY 1.49 ACRES.

THIS TRACT IS ZONED PMIX.

THE STORM SEWER NETWORK DESIGN FOR THIS PROJECT IS BASED ON OPEN CHANNEL FLOW; THEREFORE THE HYDRAULIC GRADE LINE IS AT OR LESS THAN THE CROWN OF THE PIPE.

EXISTING UTILITIES SHOWN FOR REFERENCE ONLY. CONTRACTOR SHALL COORDINATE LOCATES (HORIZONTAL AND VERTICAL) PRIOR TO

ALL EXCAVATION TO BE IN ACCORDANCE WITH SECTIONS 319.010-319.050, REVISED STATUTES OF THE STATE OF MISSOURI. SUCH COMPLIANCE SHALL NOT, HOWEVER, EXCUSE ANY PERSON MAKING ANY EXCAVATION FROM DOING SO IN A CAREFUL AND PRUDENT MANNER, NOR SHALL IT EXCUSE SUCH PERSON FROM LIABILITY FOR ANY DAMAGE OR INJURY TO UNDERGROUND UTILITIES RESULTING FROM THE EXCAVATION.

A GEOTECHNICAL EVALUATION OF THE SUBSURFACE SOIL, GROUNDWATER CONDITIONS, AND A SLOPE STABILITY ANALYSIS HAS NOT BEEN PERFORMED BY THIS ENGINEER. THE OWNER SHALL SATISFY THEMSELVES OF ALL GEOTECHNICAL CONDITIONS PRIOR TO ANY CONSTRUCTION.

ALL LAND DISTURBANCE ACTIVITIES SHALL BE IN ACCORDANCE WITH THE CITY OF LEE'S SUMMIT CODE OF ORDINANCES. REFER TO STORMWATER POLLUTION PREVENTION PLAN (SWPPP) FOR NARRATIVE REPORT AND BMP DESCRIPTIONS AND DETAILS.

ALL SLOPES ARE 3:1 OR FLATTER UNLESS OTHERWISE NOTED.

IT IS THE INTENT OF THESE PLANS TO COMPLY WITH THE REQUIREMENTS OF THE MoDNR CLEAN WATER COMMISSION.

ALL DISTURBED AREAS WITHIN THE "LIMITS OF DISTURBANCE" SHALL BE FINE GRADED, SEEDED, AND MULCHED.

THE CONTRACTOR IS RESPONSIBLE FOR MAINTAINING ALL EROSION CONTROL DEVICES AND REMOVING THEM ONCE THE SITE IS

ALL HDPE PIPE SHALL BE INSTALLED PER MANUFACTURER'S RECOMMENDATIONS. REFER TO DETAIL FOR PIPE BEDDING REQUIREMENTS.

IN ORDER TO TERMINATE A STATE OPERATING PERMIT THE MISSOURI DEPARTMENT OF NATURAL RESOURCES (MDNR) REQUIRES THAT THE PERMITTEE SUBMIT A COMPLETED FORM H (INCLUDED WITH THE APPROVAL PERMIT) TO THE MDNR. A PERMIT IS ELIGIBLE FOR FERMINATION WHEN EITHER PERENNIAL VEGETATION, PAVEMENT, BUILDINGS, OR STRUCTURES USING PERMANENT MATERIALS COVER ALL AREAS THAT HAVE BEEN DISTURBED. VEGETATIVE COVER SHALL BE AT LEAST 70% OF FULLY ESTABLISHED PLANT DENSITY OVER 100% OF THE DISTURBED AREA. A COPY OF FORM H SHOULD BE SUBMITTED TO THE CITY AT WHICH TIME THE CITY WILL REMOVE THE PROJECT FROM ITS INSPECTION SCHEDULE.

LAND DISTURBANCE SITES SHOULD BE INSPECTED AT LEAST ONCE EVERY SEVEN (7) CALENDAR DAYS AND WITHIN 48 HOURS AFTER ANY STORM EVENT EQUAL TO OR GREATER THAN A 2-YEAR, 24-HOUR STORM HAS CEASED DURING A NORMAL WORK DAY OR WITHIN 72 HOURS IF THE RAIN EVENT CEASES DURING A NON-WORK DAY SUCH AS A WEEKEND OR HOLIDY. ANY DEFICIENCIES SHALL BE NOTED IN A WEEKLY REPORT OF THE INSPECTION AND CORRECTED WITHIN SEVEN CALENDAR DAYS OF THE REPORT. CONTRACTORS ARE REQUIRED TO SUBMIT TO CITY INSPECTION STAFF COPIES OF THEIR INSPECTION REPORTS REQUIRED BY THE STORMWATER POLLUTION PREVENTION PLAN (SWPPP) ON A MONTHLY BASIS IF REQUESTED.

NO OIL AND GAS WELLS EXIST ON THIS TRACT ACCORDING TO THE MISSOURI DEPARTMENT OF NATURAL RESOURCES OIL AND GAS

THE CONTRACTOR SHALL CONTACT THE CITY'S DEVELOPMENT SERVICES ENGINEERING INSPECTION TO SCHEDULE A PRE-CONSTRUCTION MEETING WITH A FIELD ENGINEERING INSPECTOR PRIOR TO ANY LAND DISTURBANCE WORK AT (816) 969-1200.

TOTAL DISTURBED AREA ON SITE = 1.82 AC.

MISSOURI DNR LAND DISTURBANCE PERMIT NUMBER MORA23630.

DEVELOPER:

DISCOVERY PARK LEE'S SUMMIT, LLC. 4220 PHILLIPS FARM RD. COLUMBIA, MO 65201 573-615-2252

	CLICET TITLE	ORIGINAL	REVISION 1	REVISION 2	ESI #1	ADD 004
SHEET NUMBER	SHEET TITLE	06/14/24	07/26/24	08/30/24	10/15/24	01/23/25
CE 1.0	COVER SHEET	X	X			
CE 1.1	CIVIL SPECIFICATIONS	X				
CE 2.1	EROSION CONTROL PLAN	X				
CE 2.2	EROSION CONTROL DETAILS	X				
CE 3.0	OVERALL GRADING PLAN	X				
CE 3.1	GRADING PLAN SHEET 1	X				X
CE 3.2	GRADING PLAN SHEET 2	X				
CE 3.3	GRADING PLAN SHEET 3	X				
CE 3.4	GRADING PLAN SHEET 4	X				
CE 4.1	UTILITY PLAN	X	X	X		
CE 5.1	STORM PROFILE & DETAILS	X	X		X	
CE 5.2	STORM DETAILS CONT'D	X	X			
CE 5.3	25-YR STORM CALCULATIONS	X	X			
CE 5.4	100-YR STORM CALCULATIONS	X	X			
CE 6.1	SITE PLAN	X	X			X
CE 7.1	DETAILS SHEET 1	X				
CE 7.2	DETAILS SHEET 2	X	X			
CE 7.3	DETAILS SHEET 3	X	X			
CE 7.4	LEE'S SUMMIT DETAILS SHEET 1	X				
CE 7.5	LEE'S SUMMIT DETAILS SHEET 2	X				
CE 8.1	LANDSCAPING PLAN		Χ			

LEGEND OF SYMBOLS:

	EXISTING CURB	FF=XXX.X
	PROPOSED CURB	(XXX.XX TC)
	RIP RAP	(XXX.XX TP)
	EXISTING STRUCTURE	(XXX.XX FG)
	EXISTING TREELINE	(XXX.XX TW)
~~~	PROPOSED TREELINE	$(\chi\chi)$
000	EDGE OF WATERWAY	
— — W — —	EXISTING WATERLINE	$\langle X \rangle$
	PROPOSED WATERLINE	V
—— G ——	EXISTING GAS LINE	X
G	PROPOSED GAS LINE	H.P.
T	EXISTING TELEPHONE	L.P.
— — — F0 — — —	EXISTING FIBER OPTIC	<del>-</del> o-
—— OE ——	EXISTING OVERHEAD ELECTRIC	Ø
— — — UE — — —	EXISTING UNDERGROUND ELECTRIC	GV
UE	PROPOSED UNDERGROUND ELECTRIC	$\bowtie$
— — OETV — —	EXISTING OVERHEAD ELEC. & TV	©
— — OETVT — —	EXISTING OVERHEAD ELEC., TV & TELE.	W
—— s ——	EXISTING SANITARY SEWER	A
s	PROPOSED SANITARY SEWER	·
·····XXX······	EXISTING MINOR CONTOUR	
XXX	EXISTING MAJOR CONTOUR	
XXX	PROPOSED MINOR CONTOUR	®
XXX	PROPOSED MAJOR CONTOUR	AC
	100 YEAR FLOOD PLAIN	
		Ē
··	ORDINARY HIGH WATER MARK	<u> </u>
··	STREAM SIDE BUFFER	¤
	OUTER STREAM BUFFER	$\rightarrow$

PROPOSED CONCRETE PAVEMENT

PROPOSED CONCRETE PAVEMENT

IN PARKING GARAGE

(XXX.XX TC)	PROPOSED TOP OF CURB ELEVATION
(XXX.XX TP)	PROPOSED TOP OF PAVEMENT ELEVATION
(XXX.XX FG)	PROPOSED FINISHED GRADE ELEVATION
(XXX.XX TW)	PROPOSED TOP OF WALL
XX	LOT NUMBER
$\langle \chi \rangle$	STORM SEWER STRUCTURE LABEL
X	SANITARY SEWER STRUCTURE LABEL
H.P.	HIGH POINT
L.P.	LOW POINT
<del></del> 0	EXISTING SIGNS
Ø	EXISTING POWER POLE
GV	EXISTING GAS VALVE
$\bowtie$	EXISTING WATER VALVE
©	EXISTING GAS METER
W	EXISTING WATER METER
Å	EXISTING FIRE HYDRANT
©	MANHOLE
<b>- →</b>	EXISTING SANITARY SEWER LATERAL
	PROPOSED SANITARY SEWER LATERAL
TB)	PROPOSED TRACER WIRE TEST STATION BOX
AC	EXISTING AIR CONDITIONER
T	EXISTING TELEPHONE PEDESTAL
E	EXISTING ELECTRICAL TRANSFORMER
E	EXISTING ELECTRIC METER
¤	EXISTING LIGHT POLE
$\rightarrow$	EXISTING GUY WIRE
	PROPOSED BUILDING FOOTPRINT
Δ. · · · · · · · · · · · · · · · · · · ·	PROPOSED HEAVY DUTY PAVEMENT


FINISHED FLOOR OF STRUCTURE


||REVISIONS: THIS SHEET HAS BEEN SIGNED, SEALED AND DATED ELECTRONICALLY NATHAN THOMAS ECKHOFF MO LICENSE-2003014960 DRAWING INCLUDES: **COVER SHEET** 


DESIGNED: DRAWN: NMD

PROJECT NO.: 230286


CE 1.0

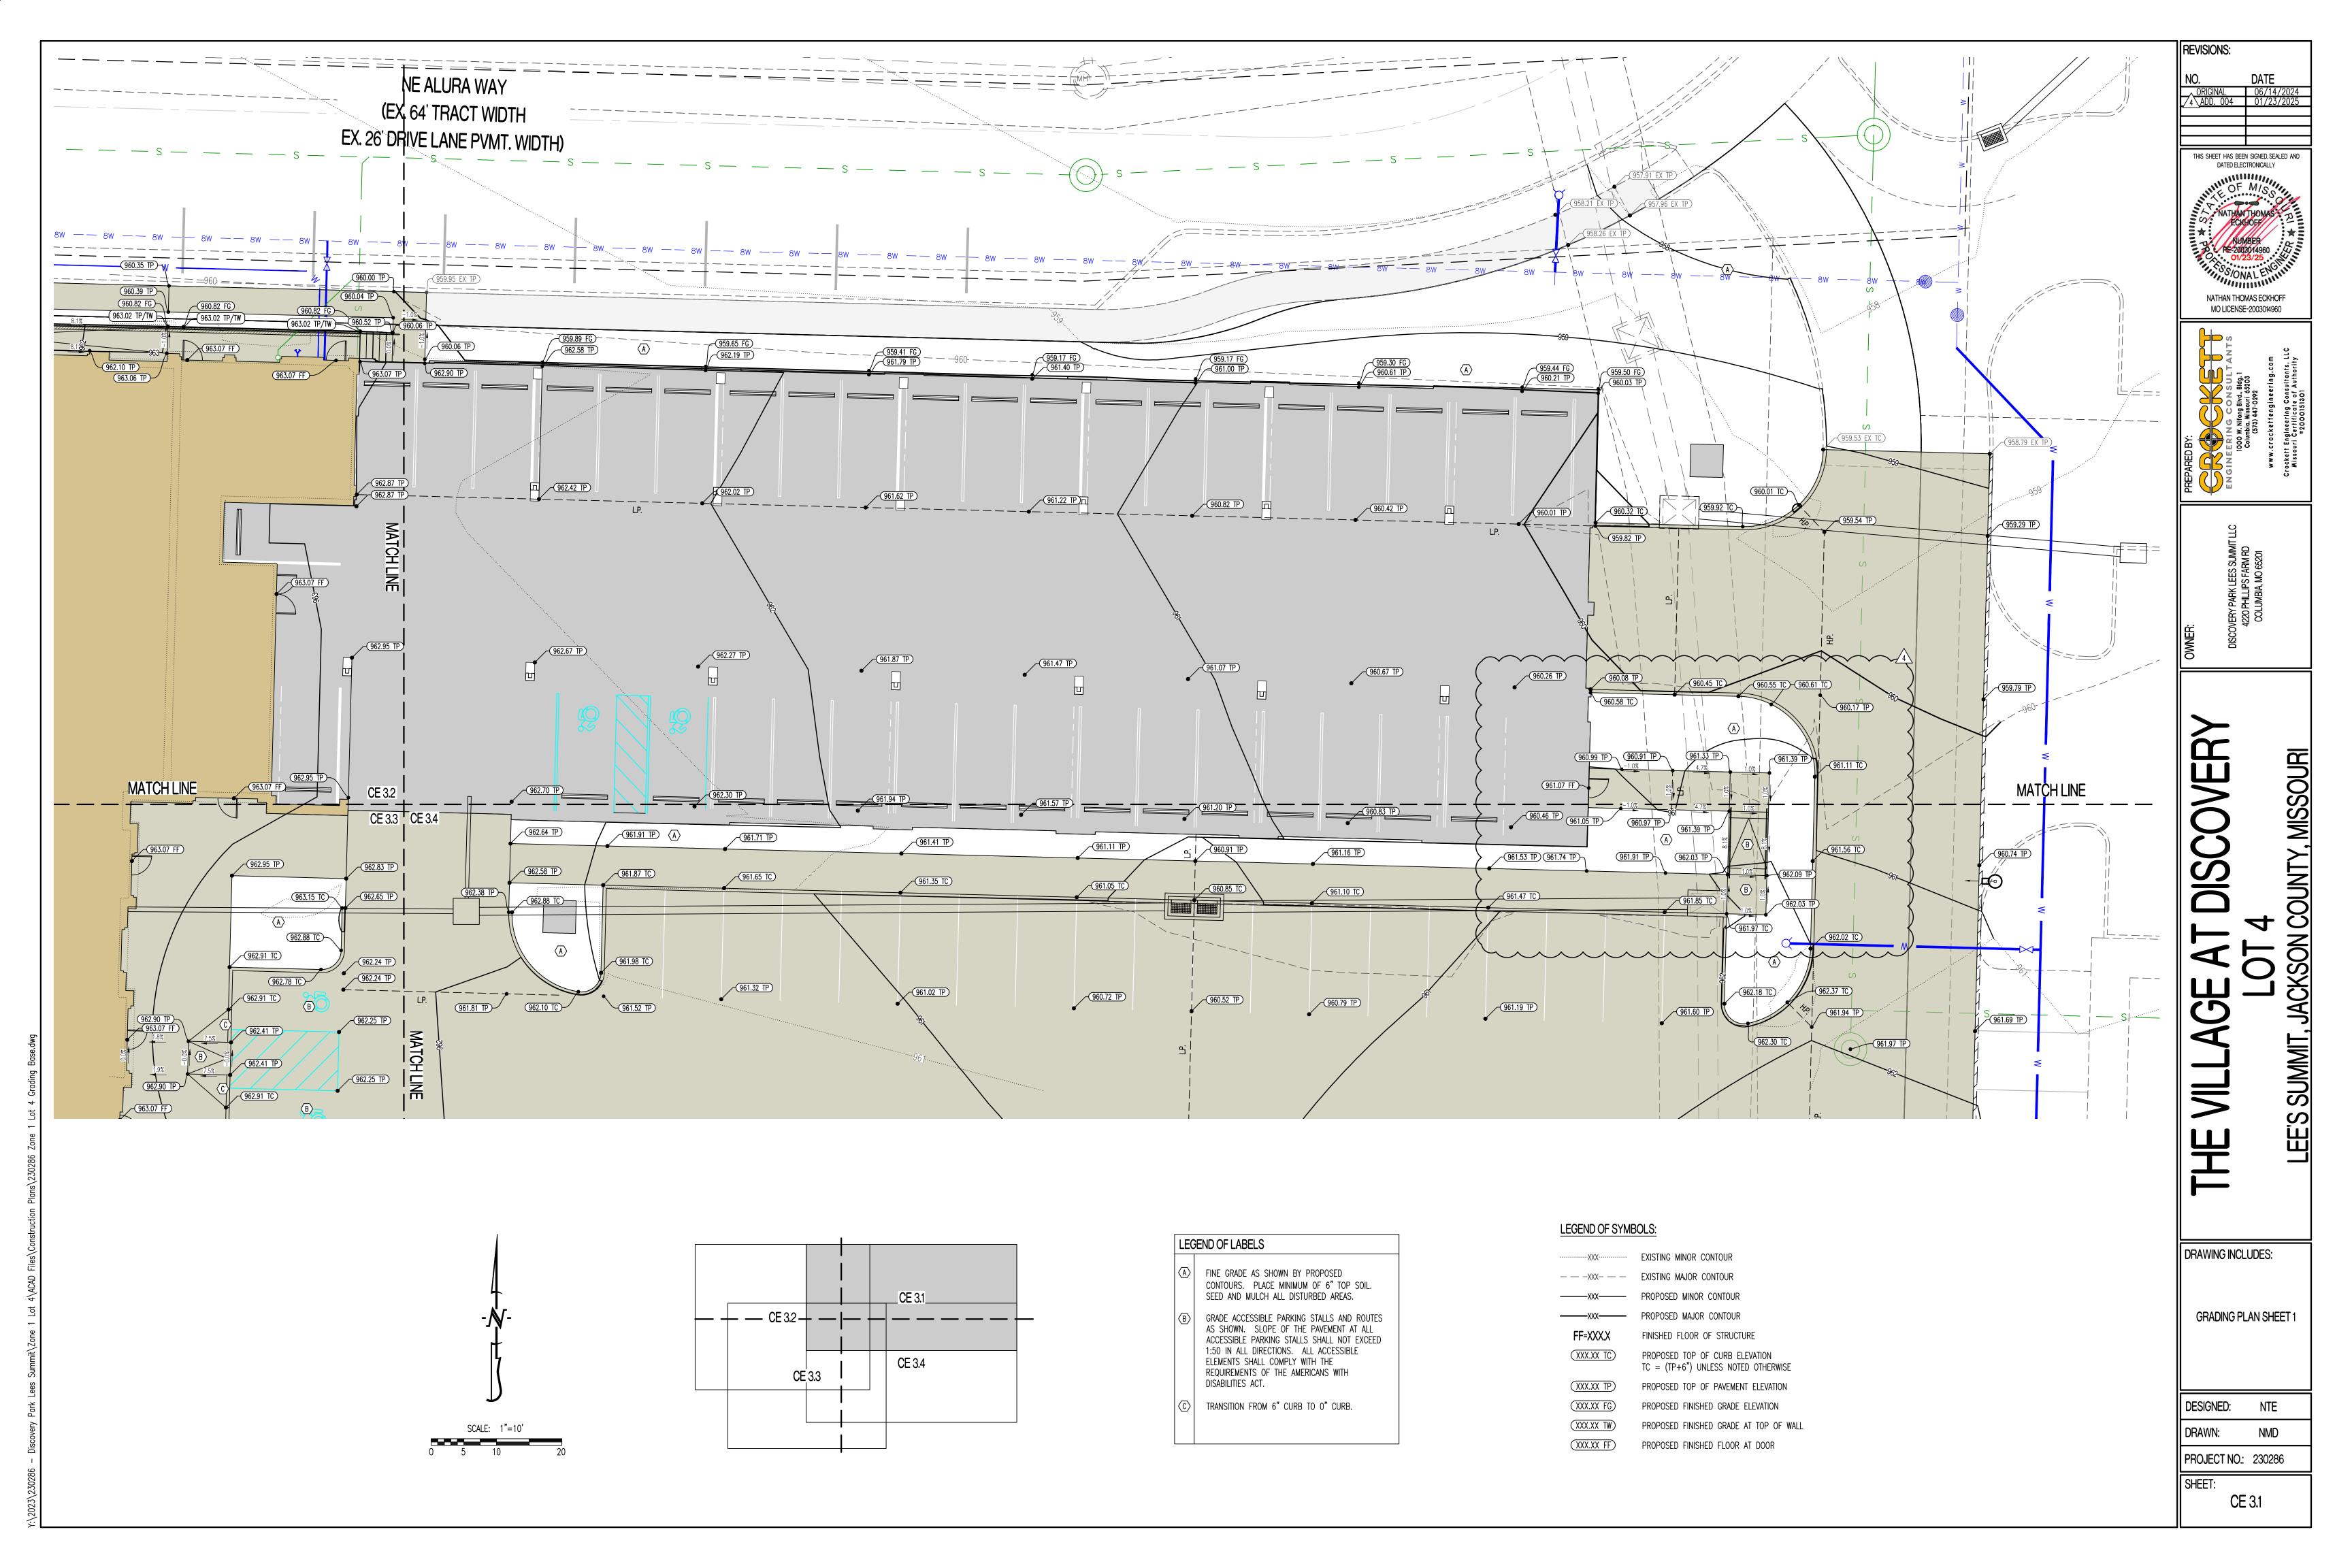

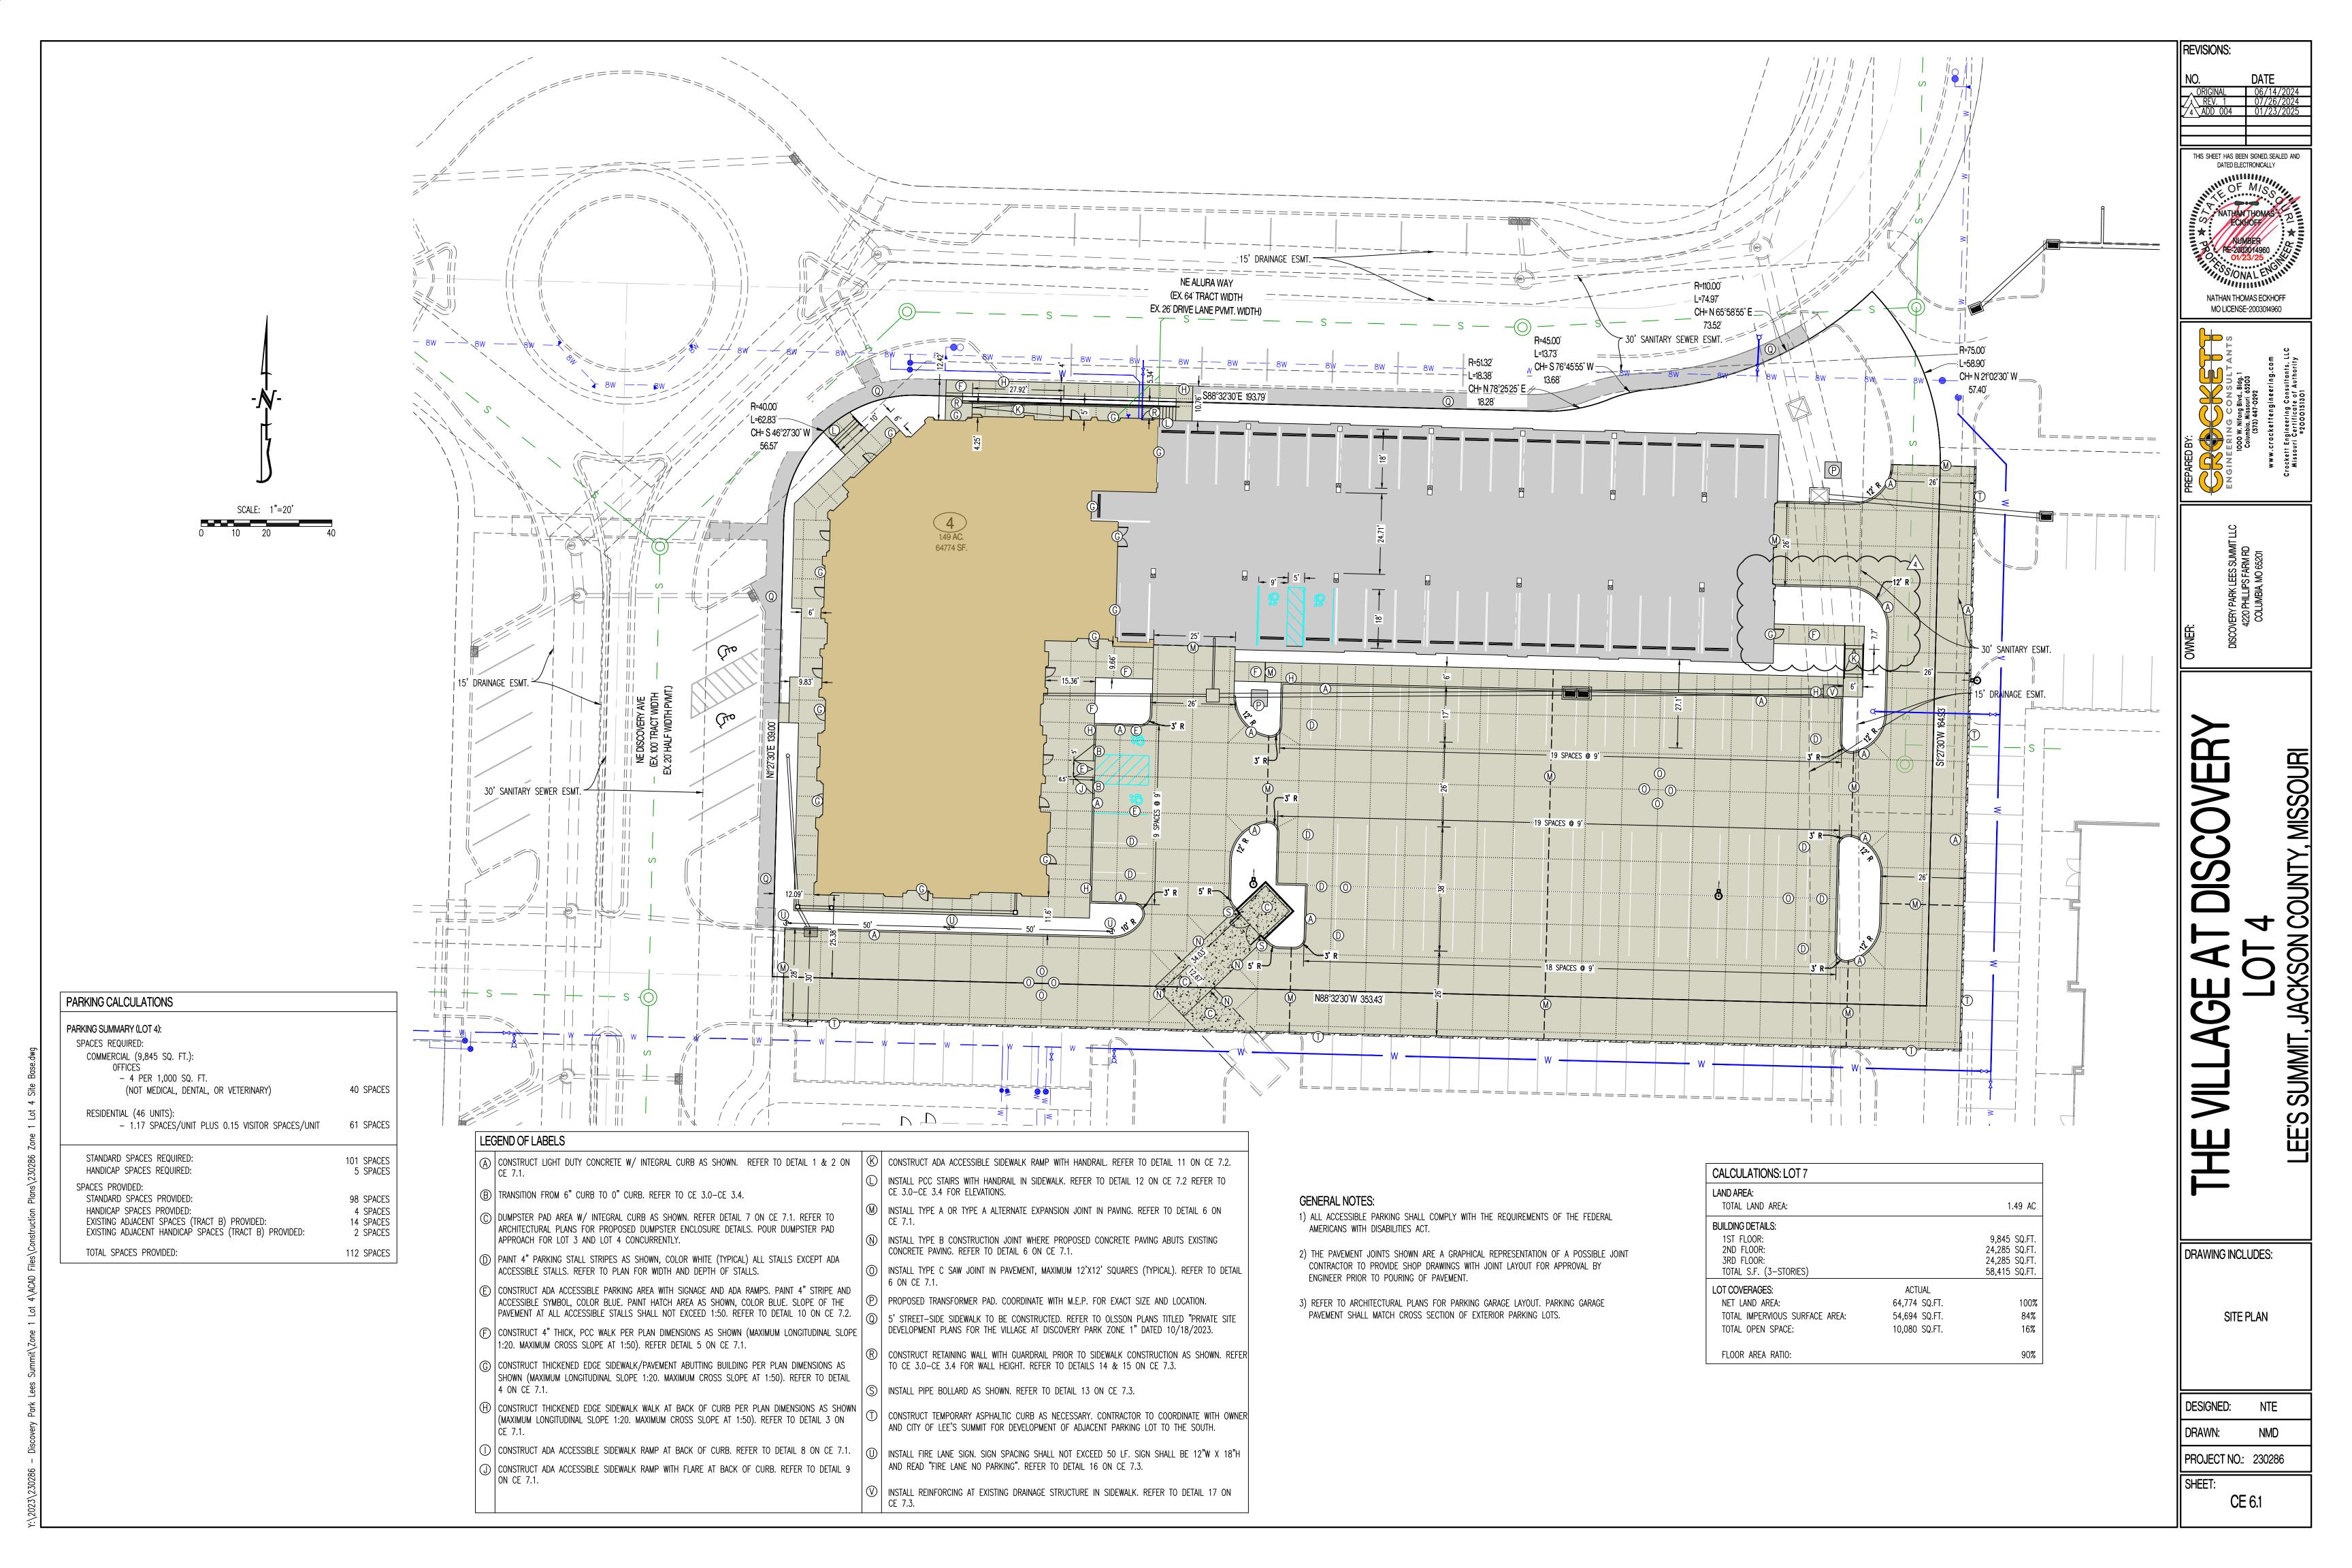

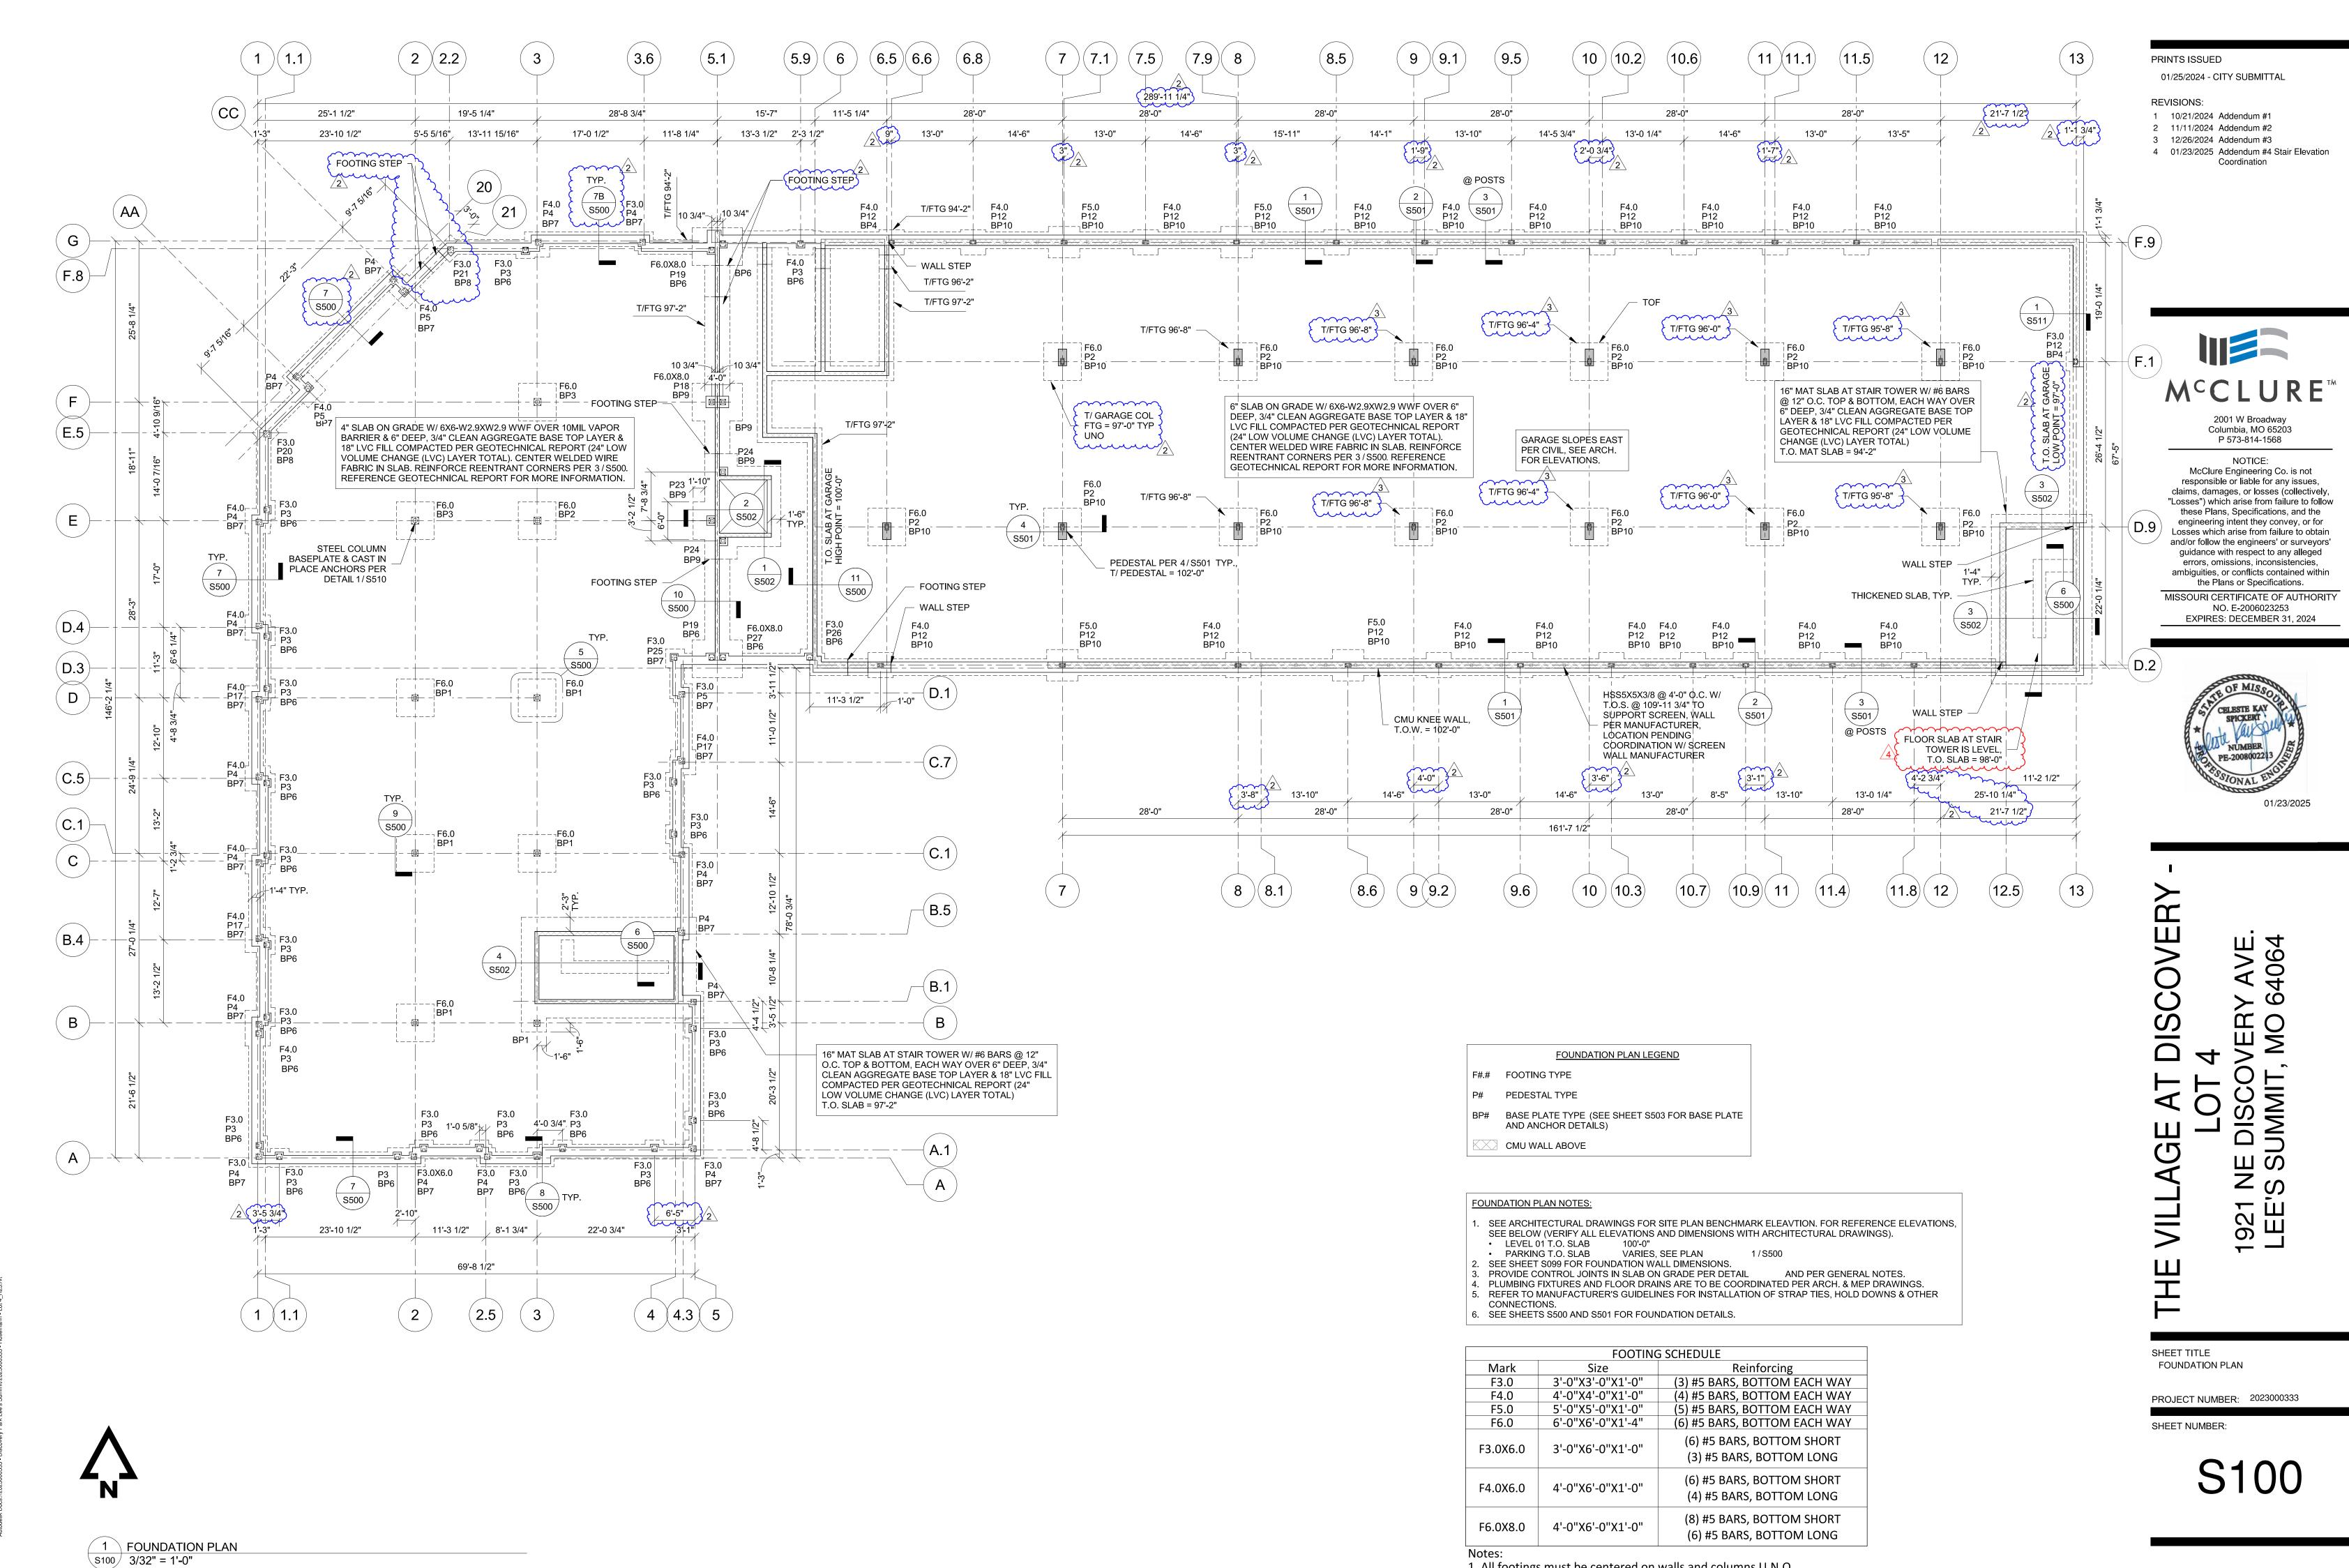

1. All footings must be centered on walls and columns U.N.O.

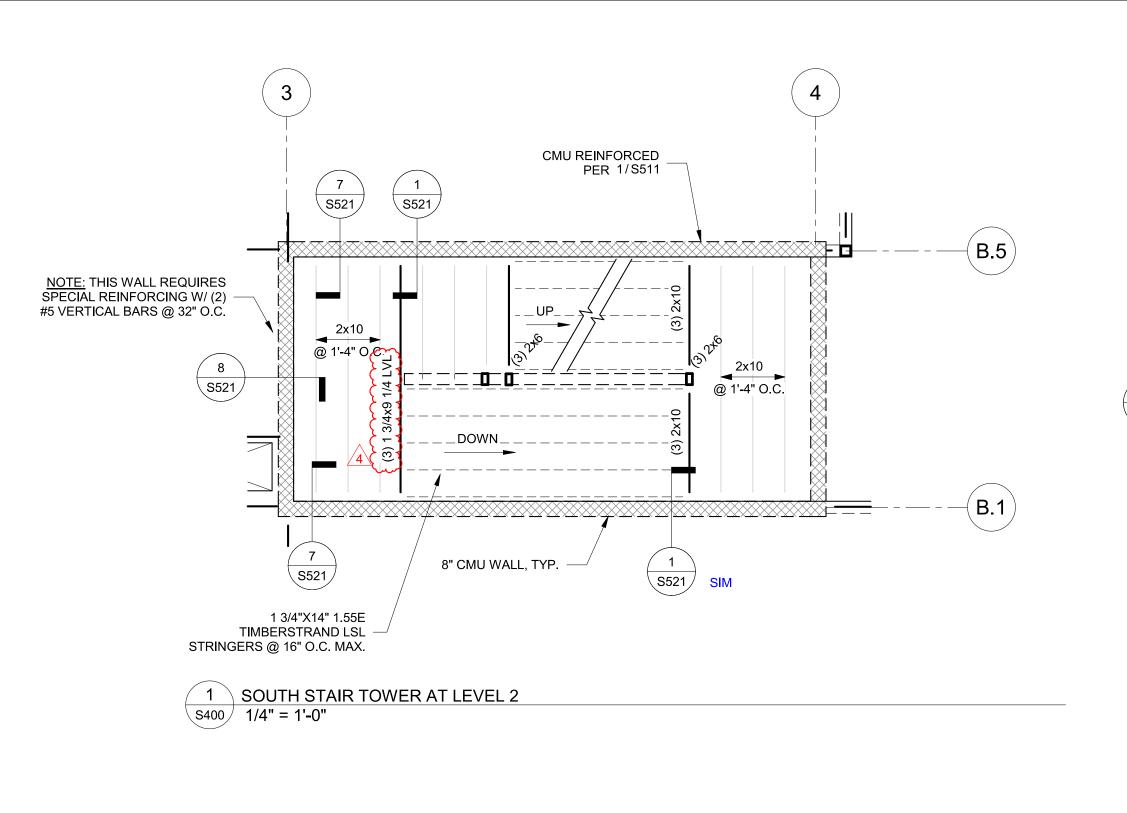


13


(D.9)

1 3/4"X14" 1.55E - TIMBERSTRAND LSL STRINGERS @ 16" O.C. MAX.


12" CMU WALL, TYP.

S521

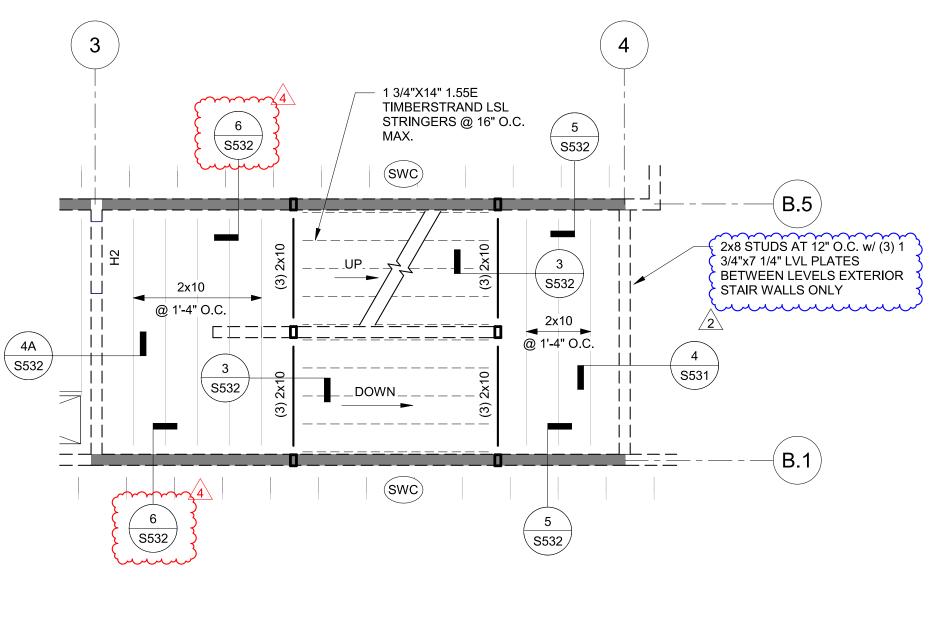

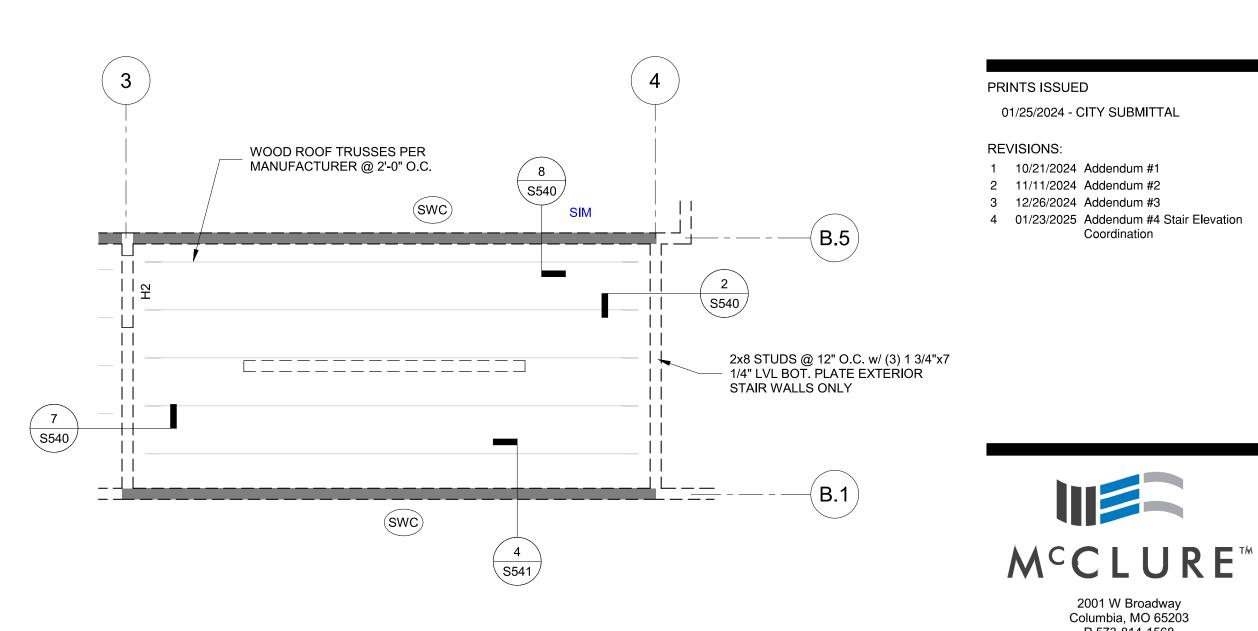


3 SOUTH STAIR TOWER AT ROOF 1/4" = 1'-0"

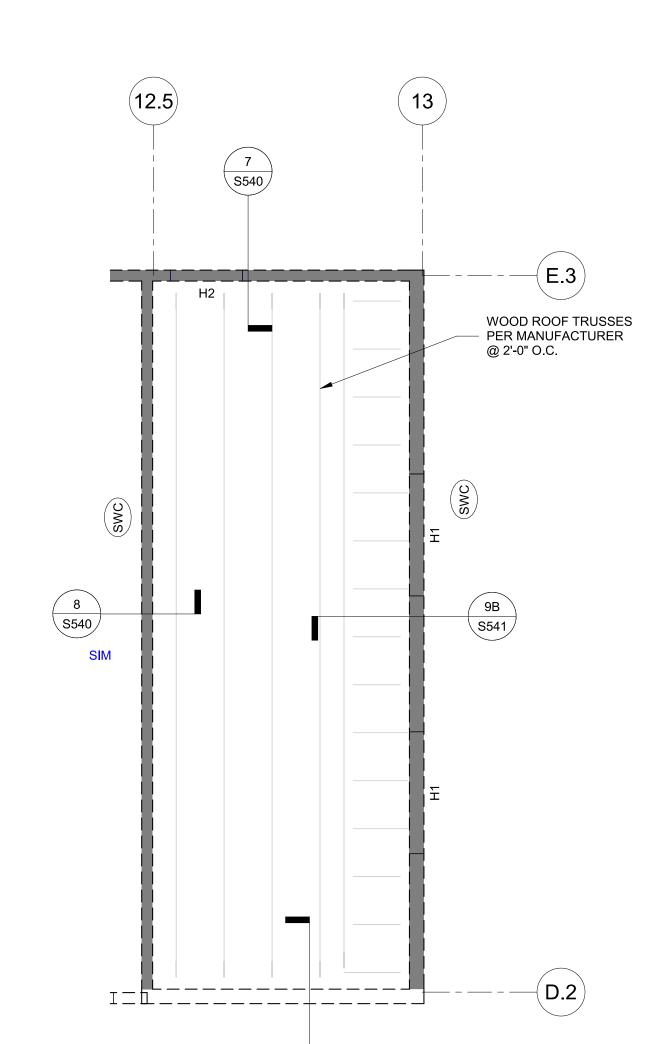


9A S541

6 EAST STAIR TOWER AT ROOF

S400 1/4" = 1'-0"

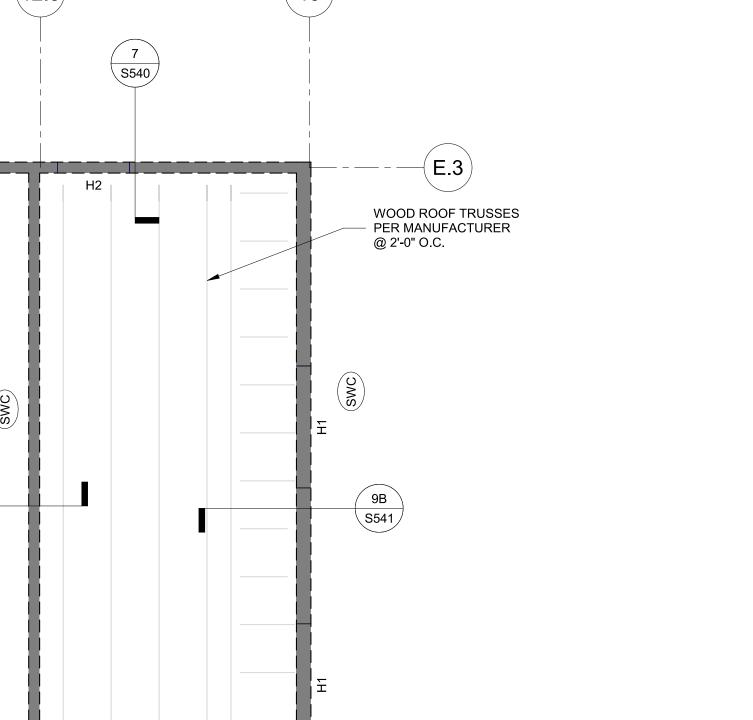

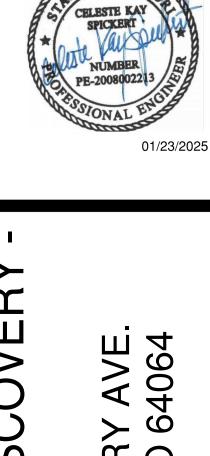

2001 W Broadway Columbia, MO 65203

P 573-814-1568

McClure Engineering Co. is not

responsible or liable for any issues,

claims, damages, or losses (collectively, "Losses") which arise from failure to follow these Plans, Specifications, and the engineering intent they convey, or for Losses which arise from failure to obtain and/or follow the engineers' or surveyors' guidance with respect to any alleged errors, omissions, inconsistencies, ambiguities, or conflicts contained within

the Plans or Specifications. MISSOURI CERTIFICATE OF AUTHORITY NO. E-2006023253 EXPIRES: DECEMBER 31, 2024

92 EE

DISCOVERY

SHEET TITLE **ENLARGED VIEWS** 

SHEET NUMBER:

 $\cdots$ 


OF SECTIONS UPDATED STAIR 2 MIRRORED AND FRAMING ADJUSTED


STAIR FRAMING MODIFIED SHEET S401 REMOVED

SECTIONS 7 AND 8 MOVED TO SHEET S532 SEE SECTION SHEETS S521 AND S532, MAJORITY

BALCONY PLANS MOVED TO NEW S560 SERIES SHEETS ENLARGED STAIR PLANS MOVED TO THIS SHEET (S400)

PROJECT NUMBER: 2023000333

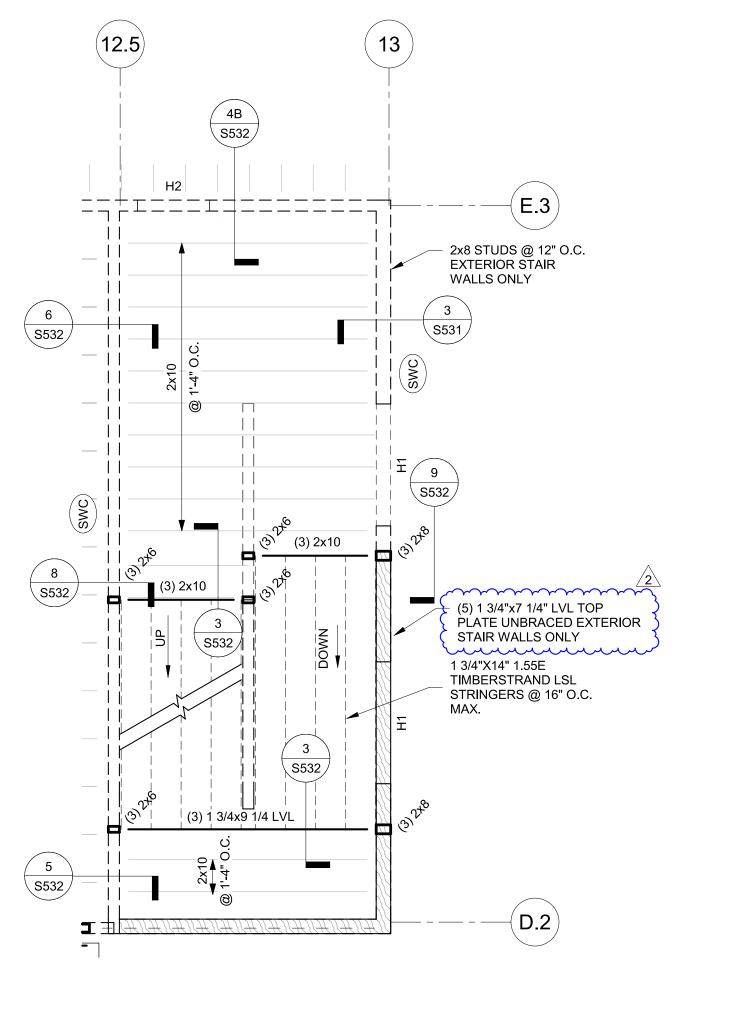

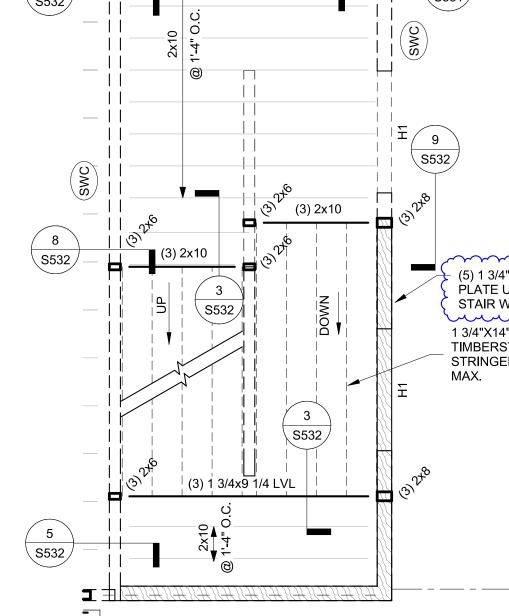

SOUTH STAIR TOWER AT LEVEL 3

S400 1/4" = 1'-0"

5 EAST STAIR TOWER AT LEVEL 3 S400 1/4" = 1'-0"

4 EAST STAIR TOWER AT LEVEL 2 S400 1/4" = 1'-0"

(3) 1 3/4x9 1/4 LVL


6 S521

(12.5)

7 S521

\S521

5 S521

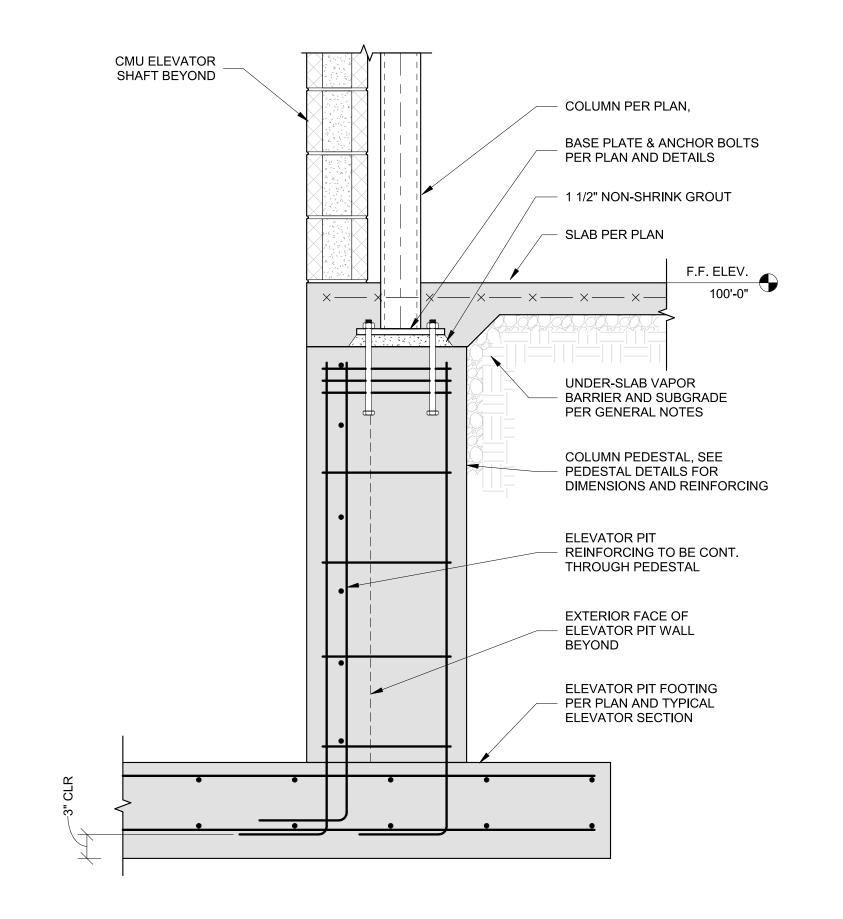

2 COLUMN PEDESTAL AT ELEVATOR 5502 1" = 1'-0"

#5 DOWELS AT SAME SPACING AND LOCATIONS AS CMU REINF. EMBED 24" INTO CONCRETE WALL AND 30" FOUNDATION WALL #5 VERT. BARS @ 12 O.C. W/ STANDARD ACI HOOK, #5 HOR. BARS @ 12 O.C., 7.O. FTG
94'-2"

12" CMU WALL WITH #5 VERTICAL

BARS @ 32" O.C. EXCEPT WHERE

INTO CMU WALL

GARAGE SLAB SLOPES

**BOTH FACES** 

**BOTH FACES** 

TYP.


SLAB PER PLAN

UNDER-SLAB VAPOR

#6 BARS @ 12" O.C. EW TOP & BOTTOM

BARRIER AND SUBGRADE PER GENERAL NOTES

NOTED OTHERWISE ON PLAN, GROUT ALL REINFORCED CELLS SOLID

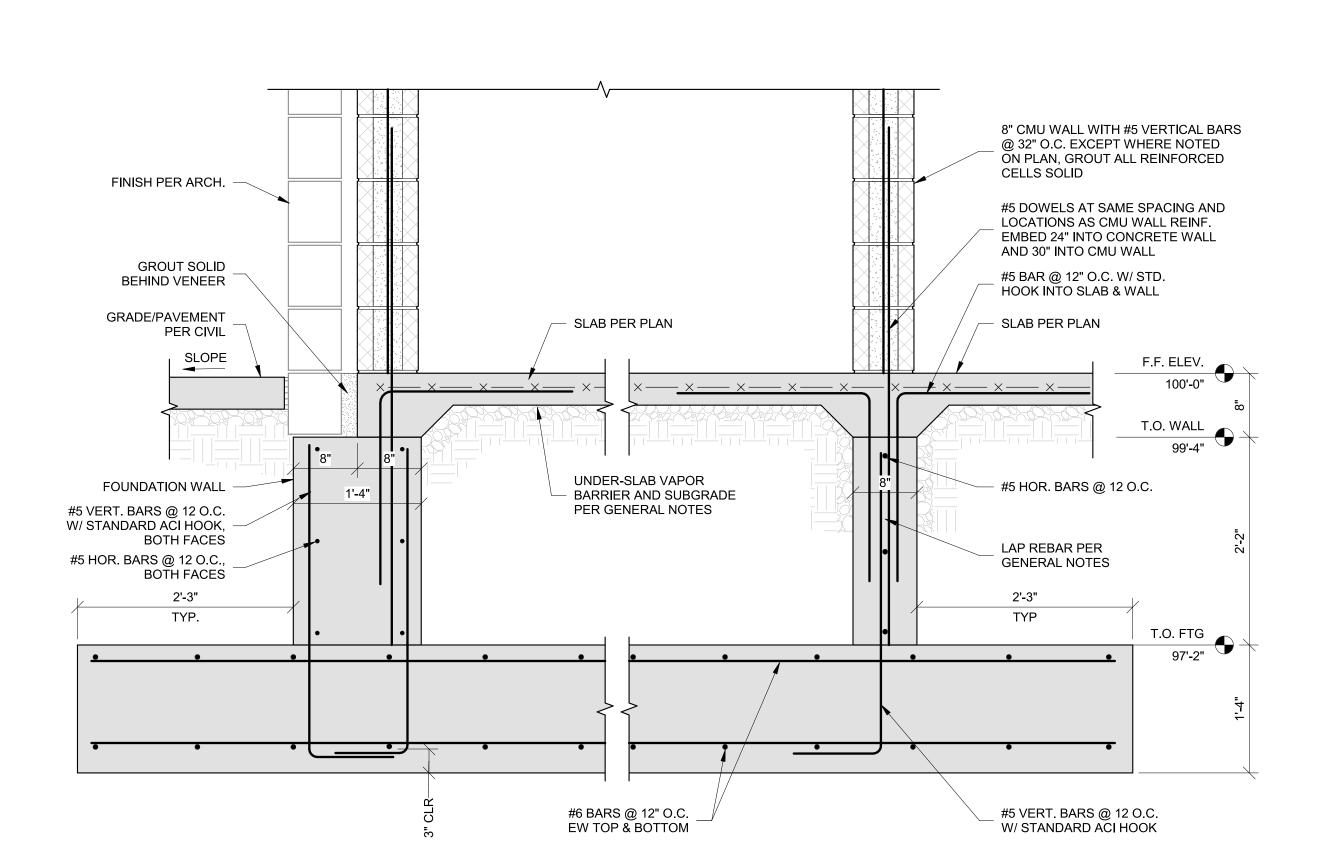

4 SECTION AT WEST STAIR FOUNDATION S502 1" = 1'-0"

OVERY 92 EE

PRINTS ISSUED

01/25/2024 - CITY SUBMITTAL


REVISIONS:

1 10/21/2024 Addendum #1 2 11/11/2024 Addendum #2 3 12/26/2024 Addendum #3 4 01/23/2025 Addendum #4 Stair Elevation Coordination

M^cCLURE^{TA} 2001 W Broadway Columbia, MO 65203 P 573-814-1568 McClure Engineering Co. is not responsible or liable for any issues, claims, damages, or losses (collectively, "Losses") which arise from failure to follow these Plans, Specifications, and the engineering intent they convey, or for

Losses which arise from failure to obtain and/or follow the engineers' or surveyors' guidance with respect to any alleged errors, omissions, inconsistencies, ambiguities, or conflicts contained within the Plans or Specifications.

MISSOURI CERTIFICATE OF AUTHORITY NO. E-2006023253 EXPIRES: DECEMBER 31, 2024

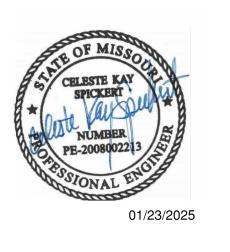

ШS

SHEET TITLE FOUNDATION DETAILS

DEEP FOUNDATION DETAILS REPLACE WITH NEW SHALLOW

FOUNDATION DETAILS

PROJECT NUMBER: 2023000333

SHEET NUMBER:

EXTERIOR 12" CMU WALL WITH #5 VERTICAL BARS @ 24" O.C. EXCEPT

GROUT SOLID BEHIND VENEER

GRADE/PAVEMENT PER CIVIL

#5 HOR. BARS @ 12 O.C.,

FOUNDATION WALL

3 SECTION AT EAST STAIR FOUNDATION

#5 VERT. BARS @ 12 O.C. W/ STANDARD ACI HOOK, BOTH FACES

BOTH FACES

1'-4"

TYP.

1'-8"

T.O. WALL 96'-8"

S502 1" = 1'-0"

SLOPE


LOWEST (3) COURSES)

FINISH PER ARCH.

WHERE NOTED OTHERWISE ON PLAN,

GROUT ALL REINFORCED CELLS SOLID

WATERPROOF AND GROUT SOLID ALL CMU BELOW GRADE (AT MINIMUM

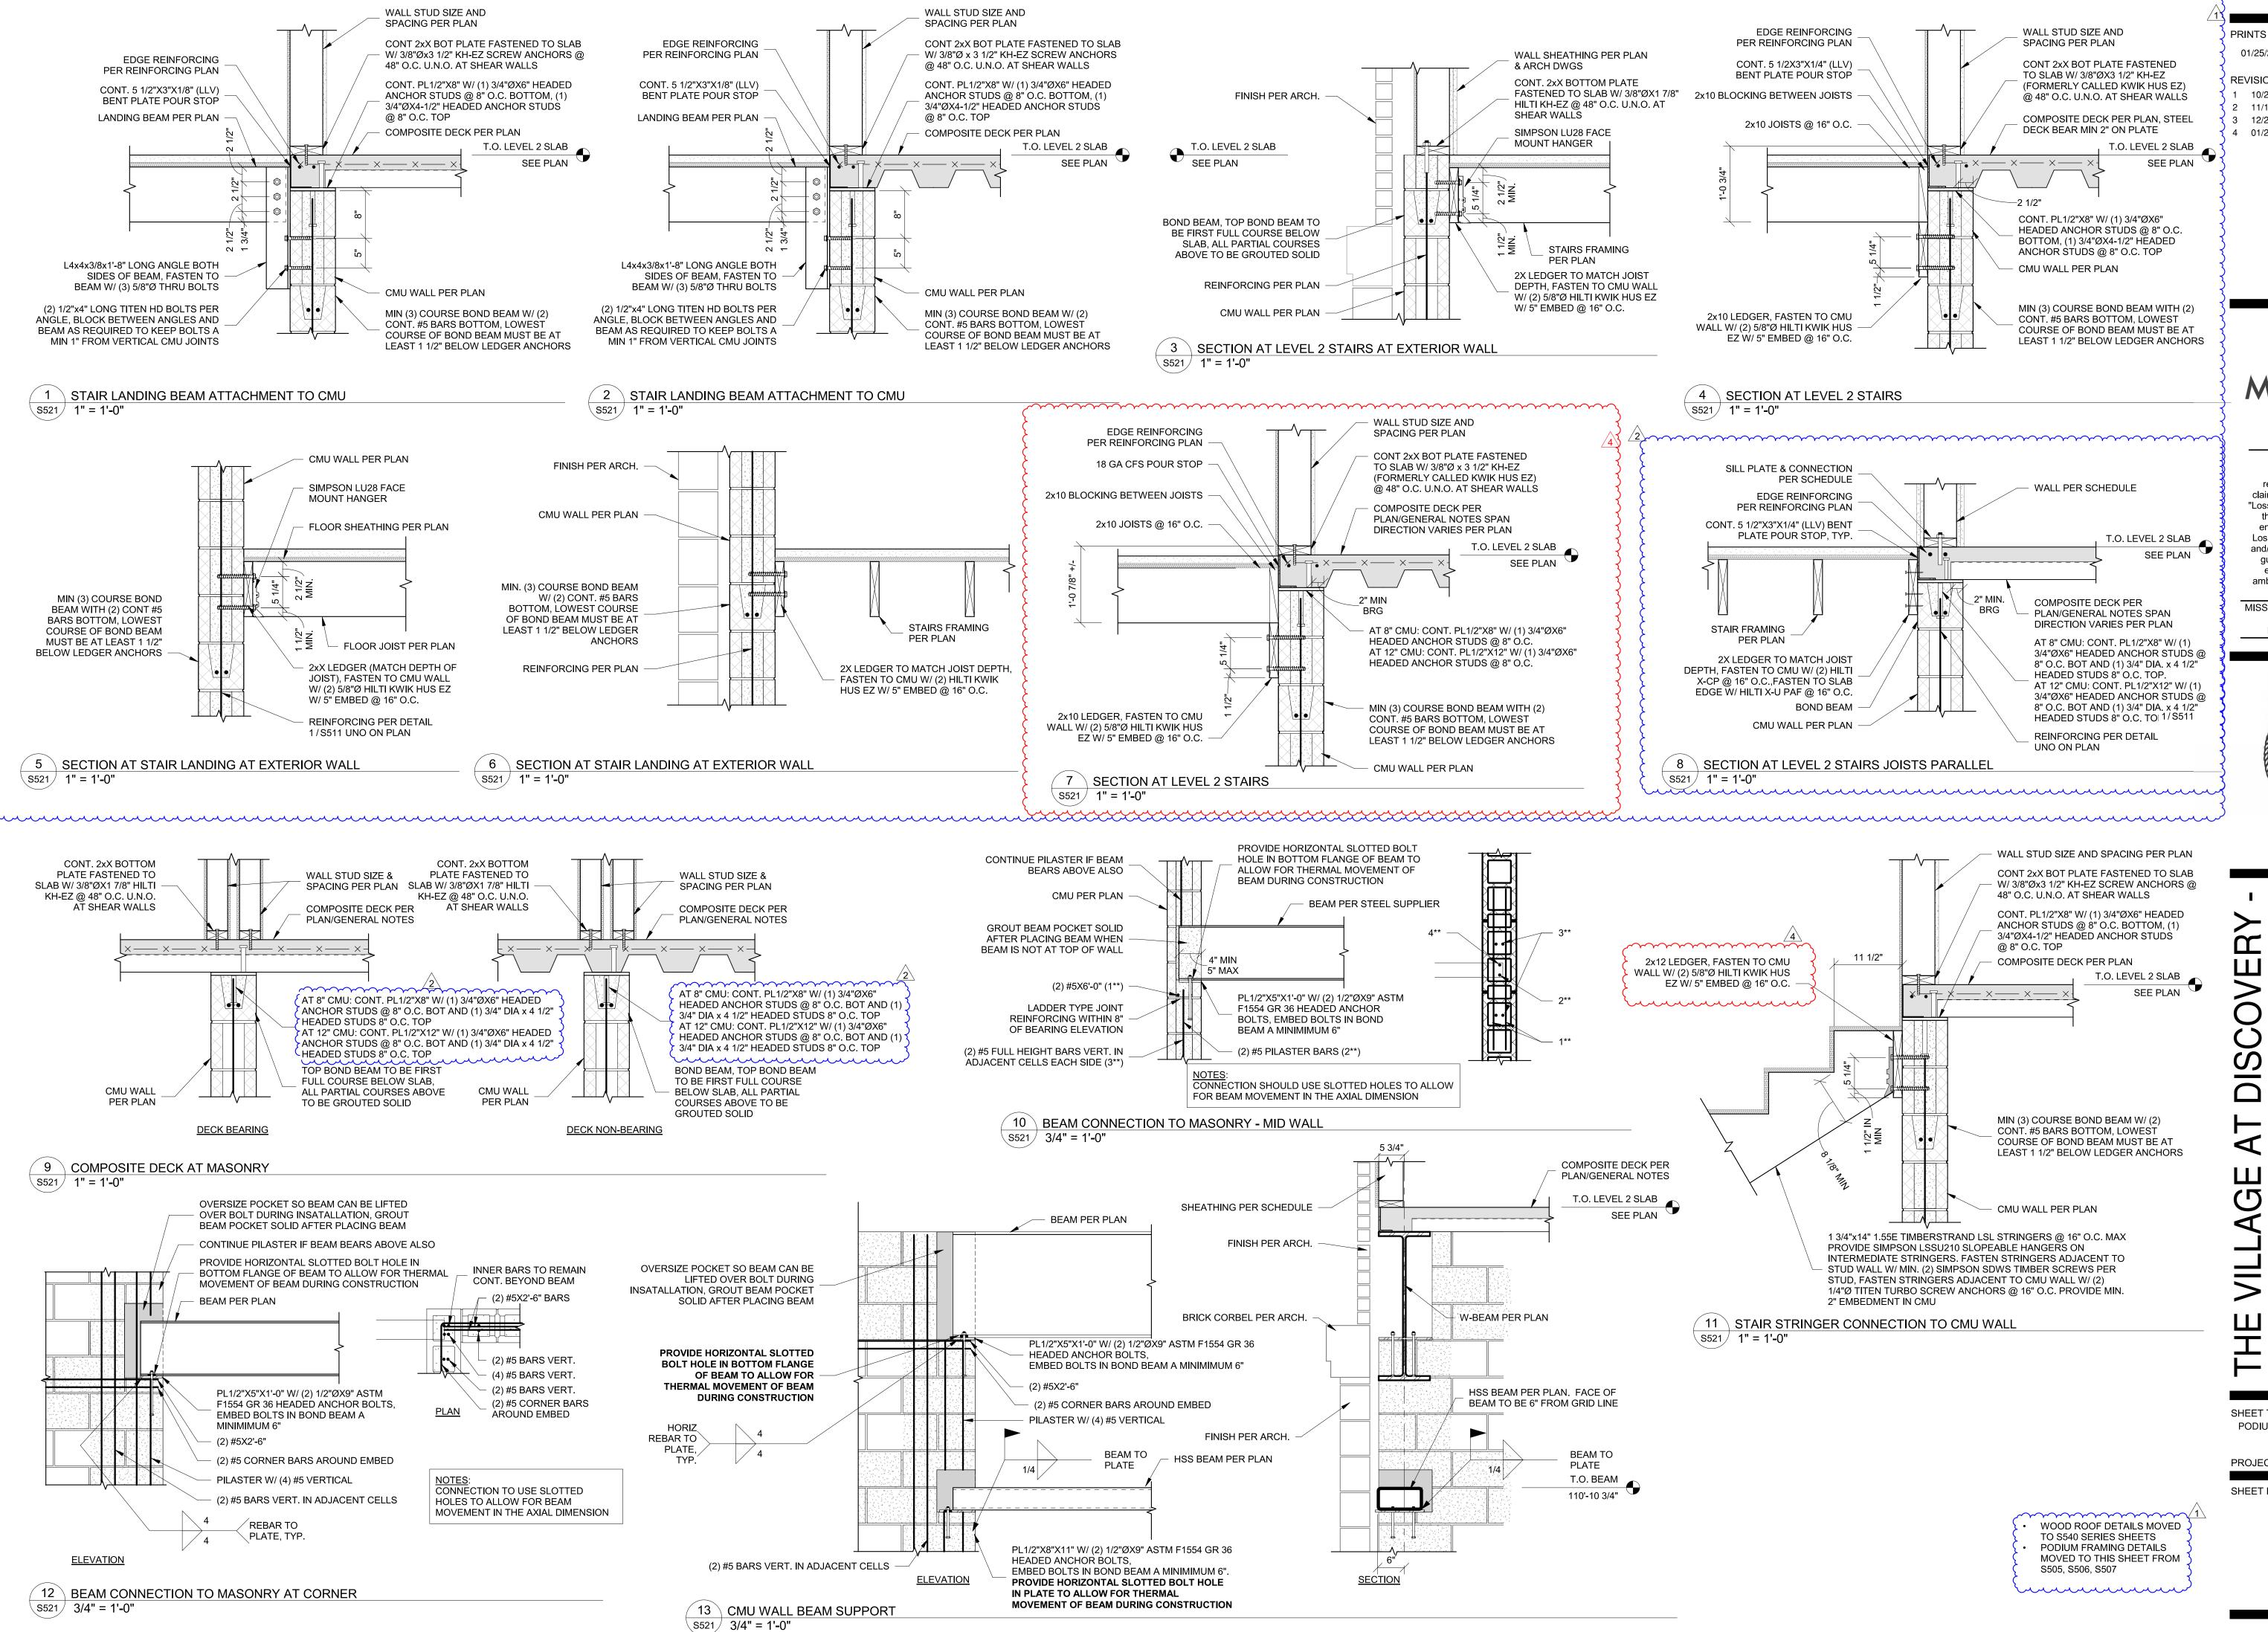

PRINTS ISSUED

01/25/2024 - CITY SUBMITTAL

**REVISIONS:** 

10/21/2024 Addendum #1 2 11/11/2024 Addendum #2 12/26/2024 Addendum #3 01/23/2025 Addendum #4 Stair Elevation


Coordination

2001 W Broadway Columbia, MO 65203 P 573-814-1568

McClure Engineering Co. is not responsible or liable for any issues, claims, damages, or losses (collectively "Losses") which arise from failure to follow these Plans, Specifications, and the

engineering intent they convey, or for Losses which arise from failure to obtain and/or follow the engineers' or surveyors guidance with respect to any alleged errors, omissions, inconsistencies, ambiguities, or conflicts contained within the Plans or Specifications.

MISSOURI CERTIFICATE OF AUTHORITY NO. E-2006023253 EXPIRES: DECEMBER 31, 2024

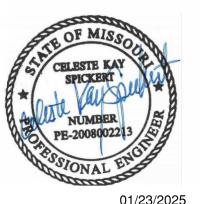


01/23/2025

M O

SHEET TITLE PODIUM FRAMING DETAILS


PROJECT NUMBER: 2023000333

SHEET NUMBER:

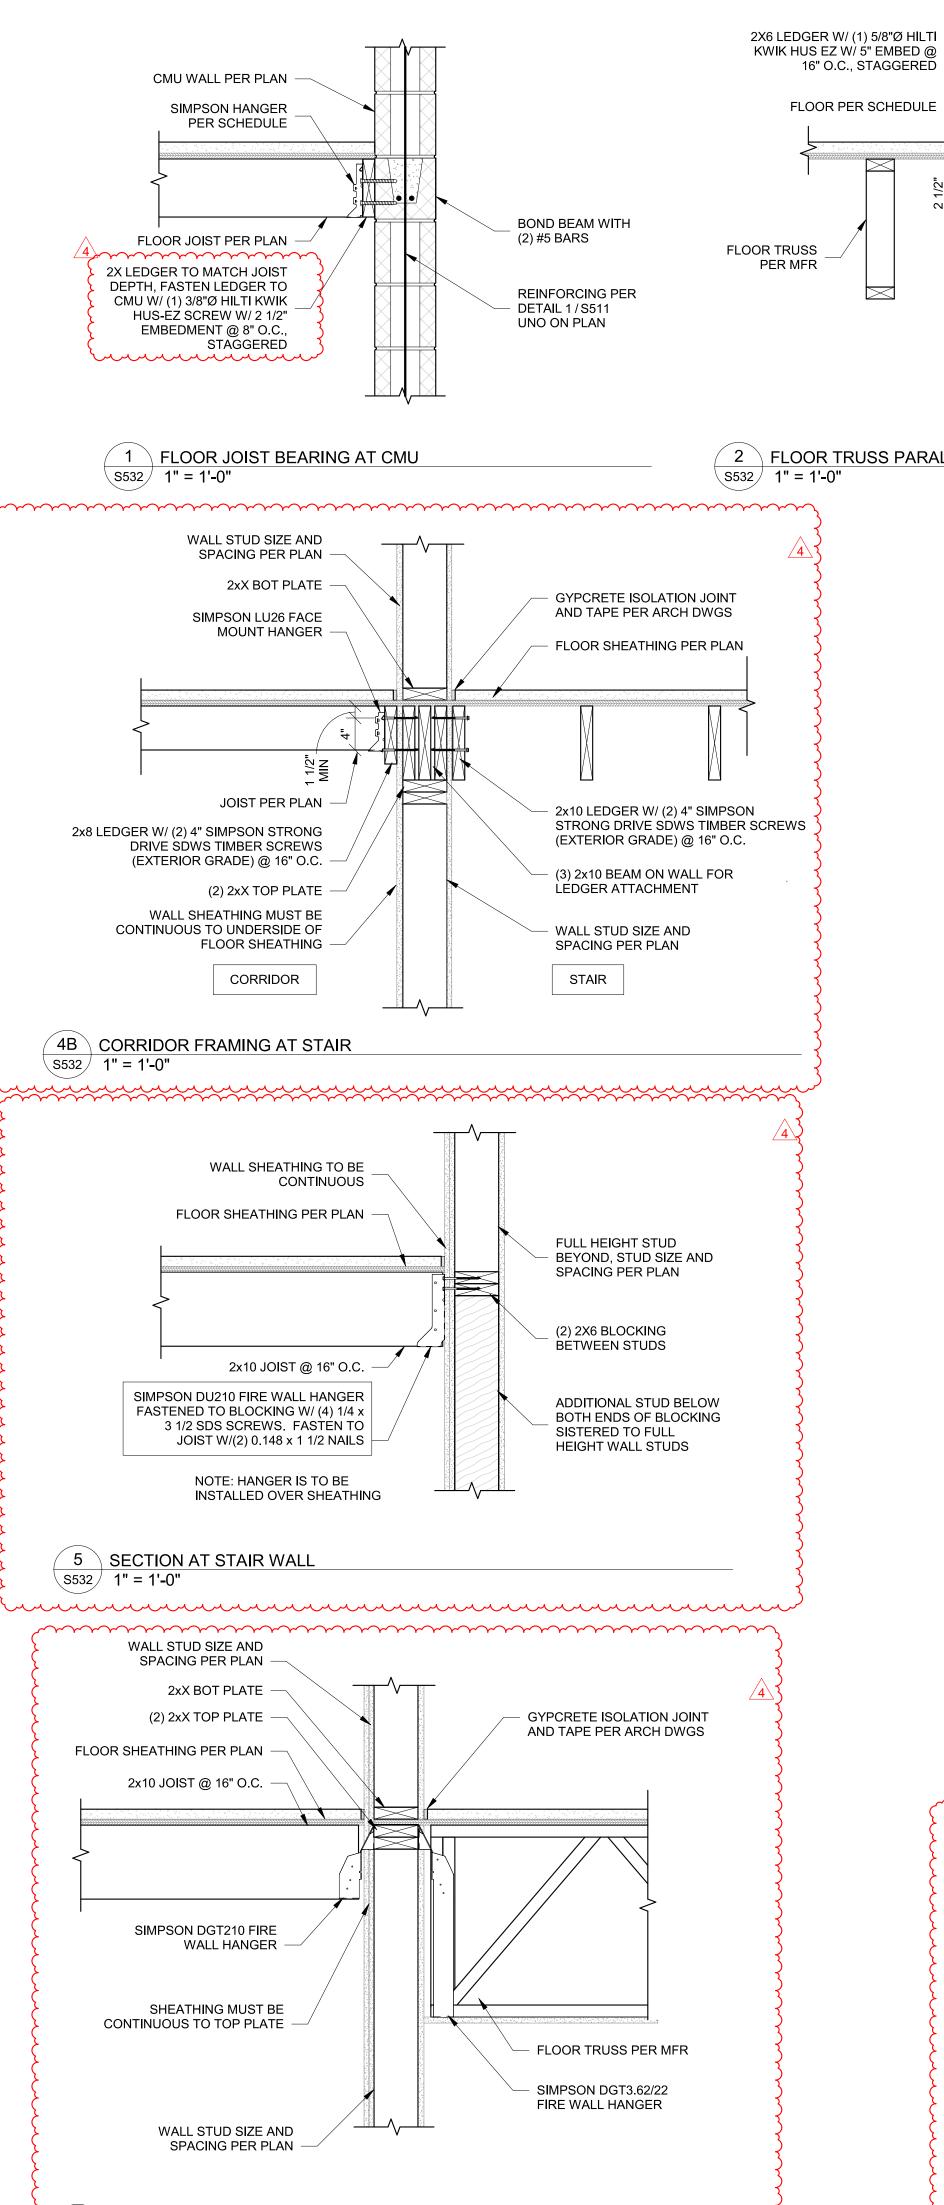

6 SECTION AT STAIR WALL - TRUSS BEARING

\S532 / 1" = 1'-0"

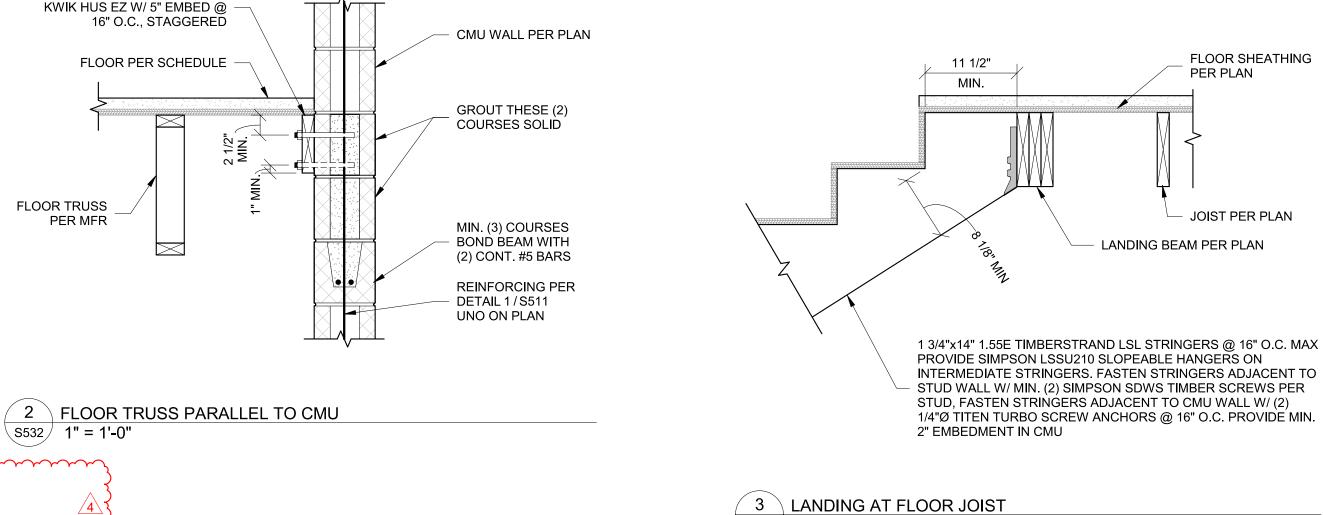

\S532 \ 1 1/2" = 1'-0"

(5) 1 3/4"x7 1/4"

\s532 / 3/4" = 1'-0"

LVL PLATES


2x8 STUDS @ 12" O.C.

WALL NOT BRACED BY

MAIN FLOOR FRAMING

9 STAIR FRAMING SECTION


∖s532 / 1" = 1'-0"

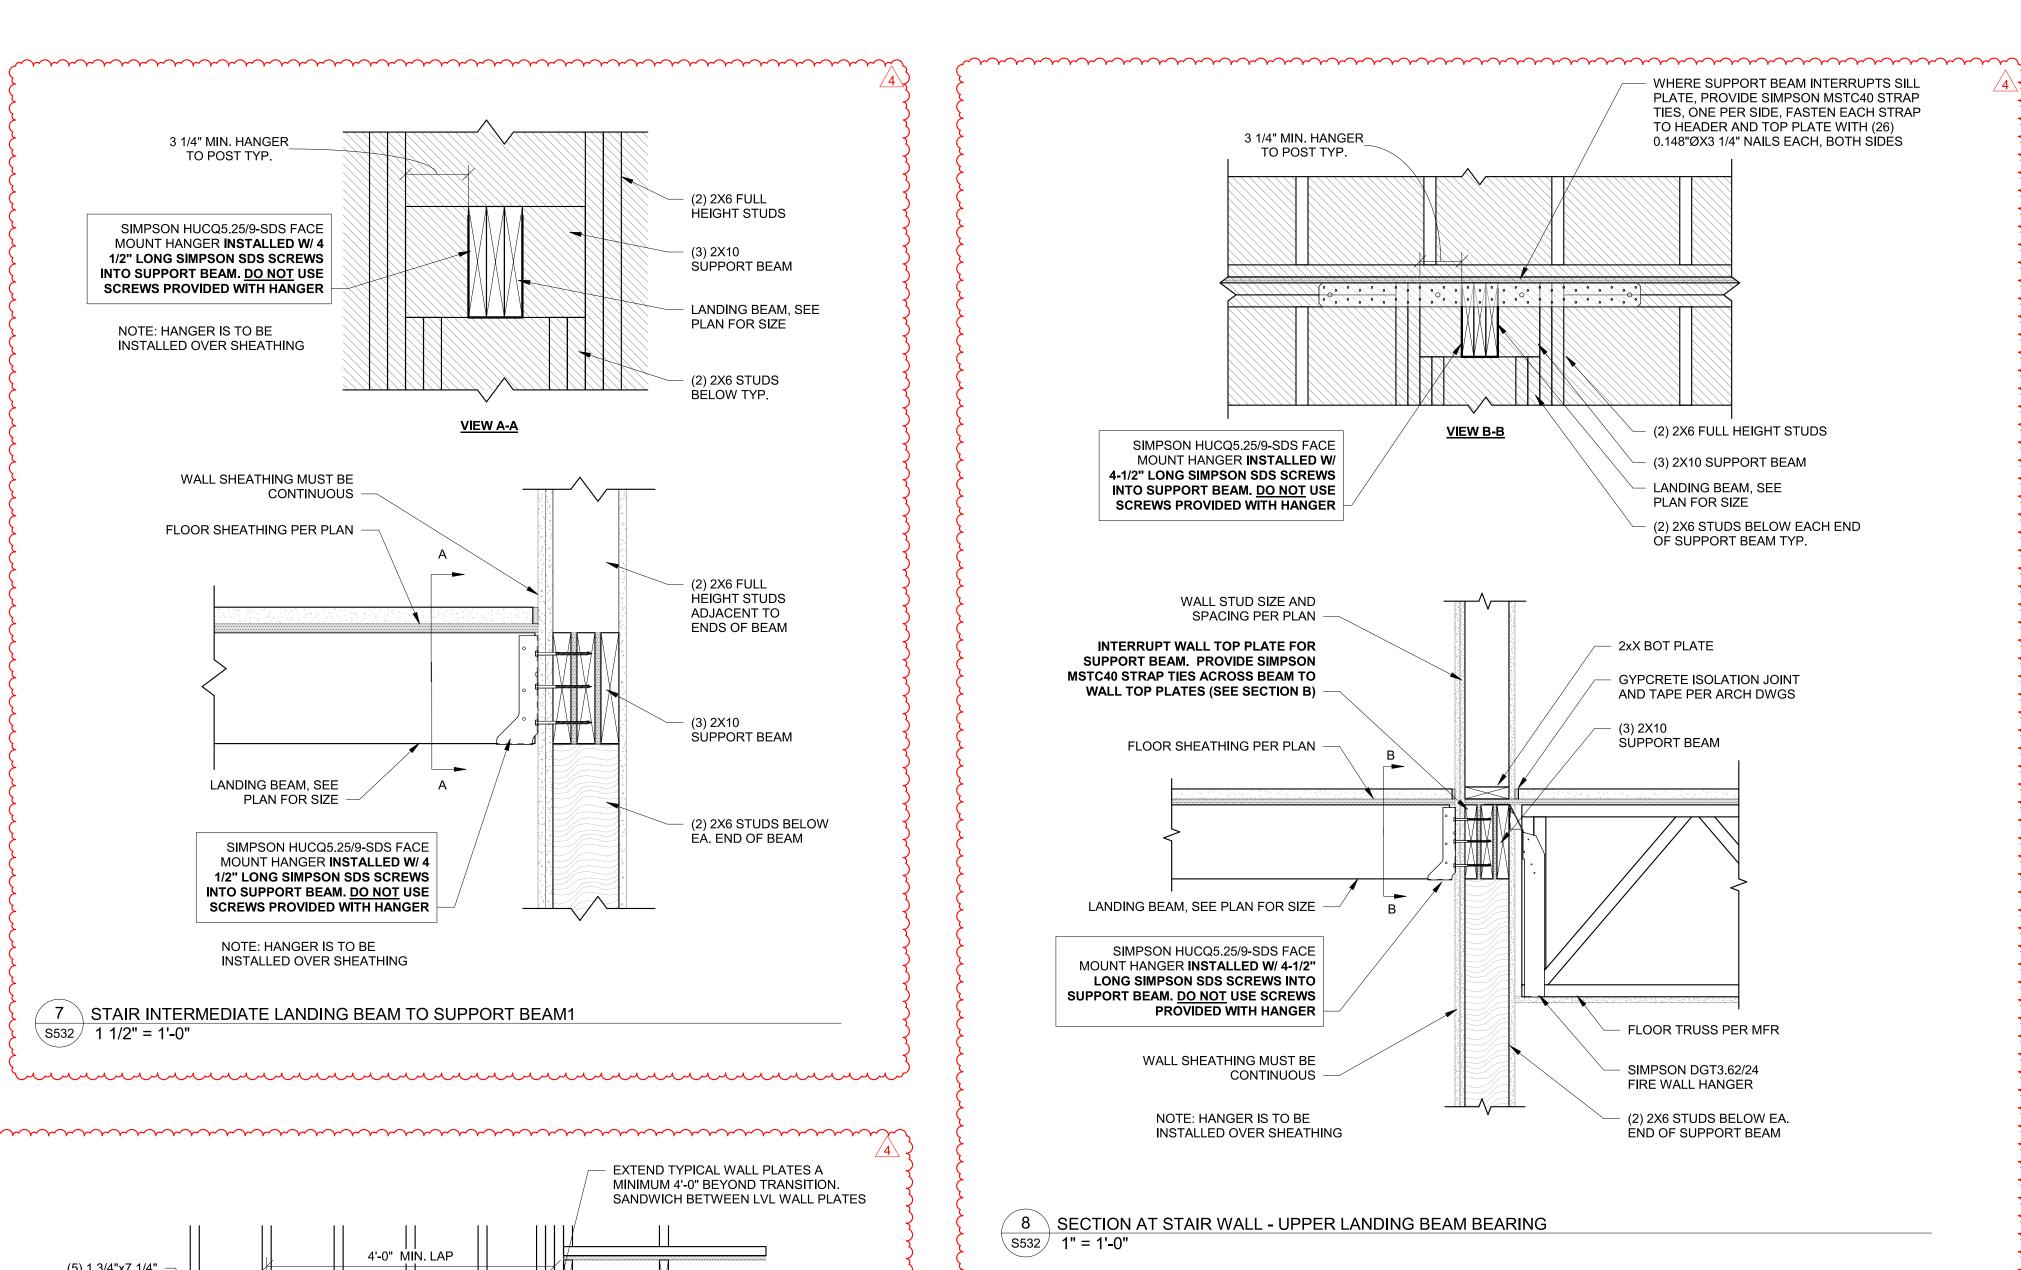


STUD WALL SUPPORTING/

BRACED BY FLOOR

FRAMING

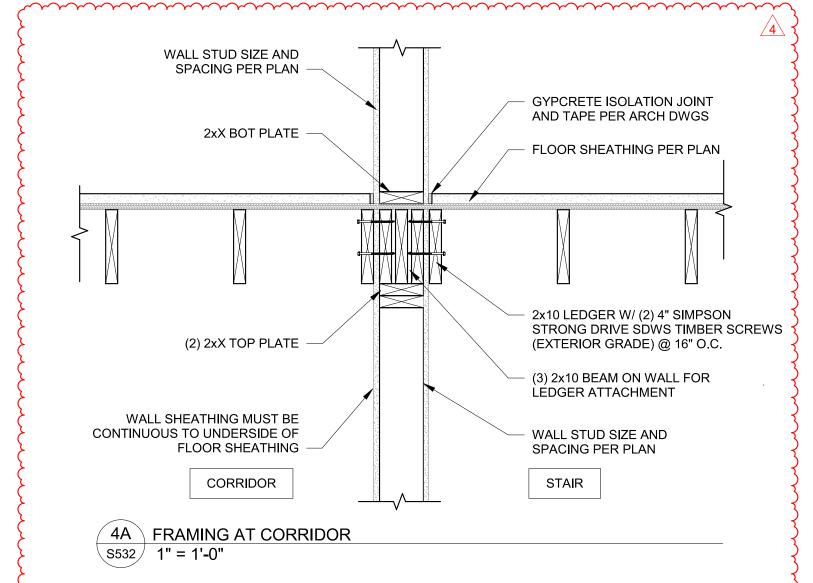

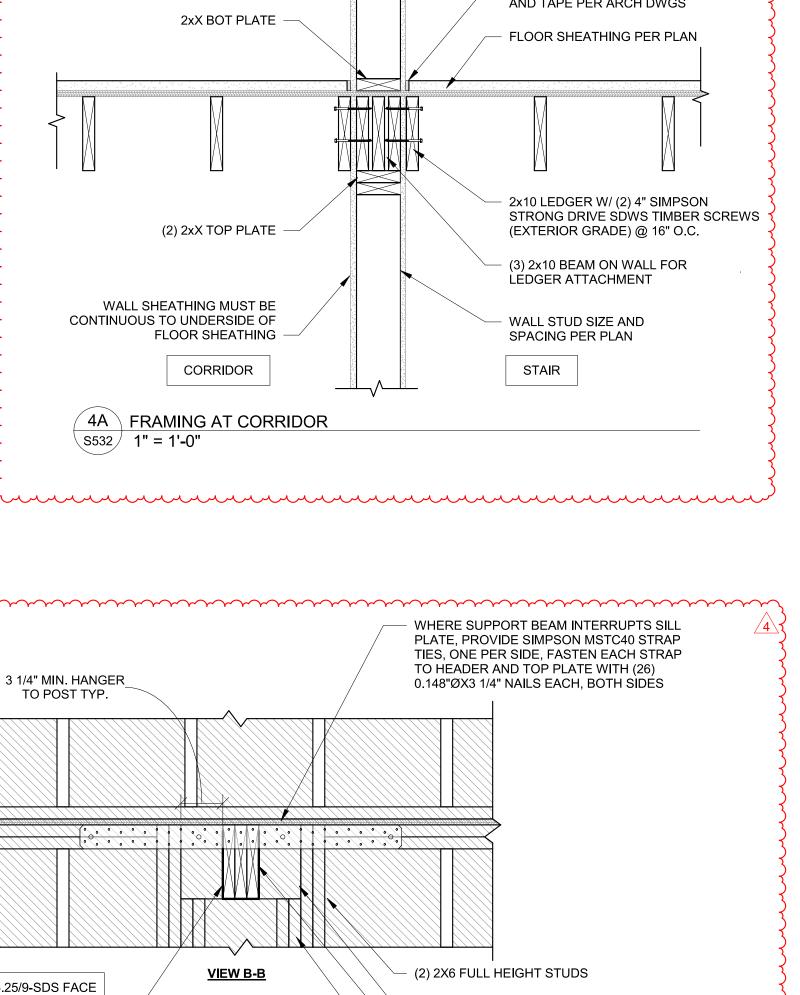

 $\exists$ 

PRINTS ISSUED

REVISIONS:

01/25/2024 - CITY SUBMITTAL

1 10/21/2024 Addendum #1

2 11/11/2024 Addendum #2 3 12/26/2024 Addendum #3

4 01/23/2025 Addendum #4 Stair Elevation Coordination

Columbia, MO 65203

P 573-814-1568

McClure Engineering Co. is not responsible or liable for any issues, claims, damages, or losses (collectively "Losses") which arise from failure to follow these Plans, Specifications, and the

engineering intent they convey, or for

Losses which arise from failure to obtain

and/or follow the engineers' or surveyors'

guidance with respect to any alleged

errors, omissions, inconsistencies,

ambiguities, or conflicts contained within

the Plans or Specifications.

MISSOURI CERTIFICATE OF AUTHORITY

NO. E-2006023253

EXPIRES: DECEMBER 31, 2024

SHEET TITLE WOOD FLOOR FRAMING DETAILS

PROJECT NUMBER: 2023000333

SHEET NUMBER:

(FORMERLY S511) mmmm