


Greystone - Masterplan

Address: 2623 SW Firefly Lane, Lees Summit, MO
Lot: 168 Hook Farms 2nd Plat

Sheet List	
Sheet No	Sheet Name
00	Cover Sheet
A101	Front Elevations
A301	Side Elevations - Full Basement
A302	Side Elevations - Daylight Basement
A303	Side Elevations - Walkout Basement
A401	Floor Plan - Main Level
A501	RCP/Electrical Plan
A601	Roof Plan
A602	Roof Plan
A701	POD Options
A702	Floor Plan - Basement
A801	Details
A802	Details
A803	Details

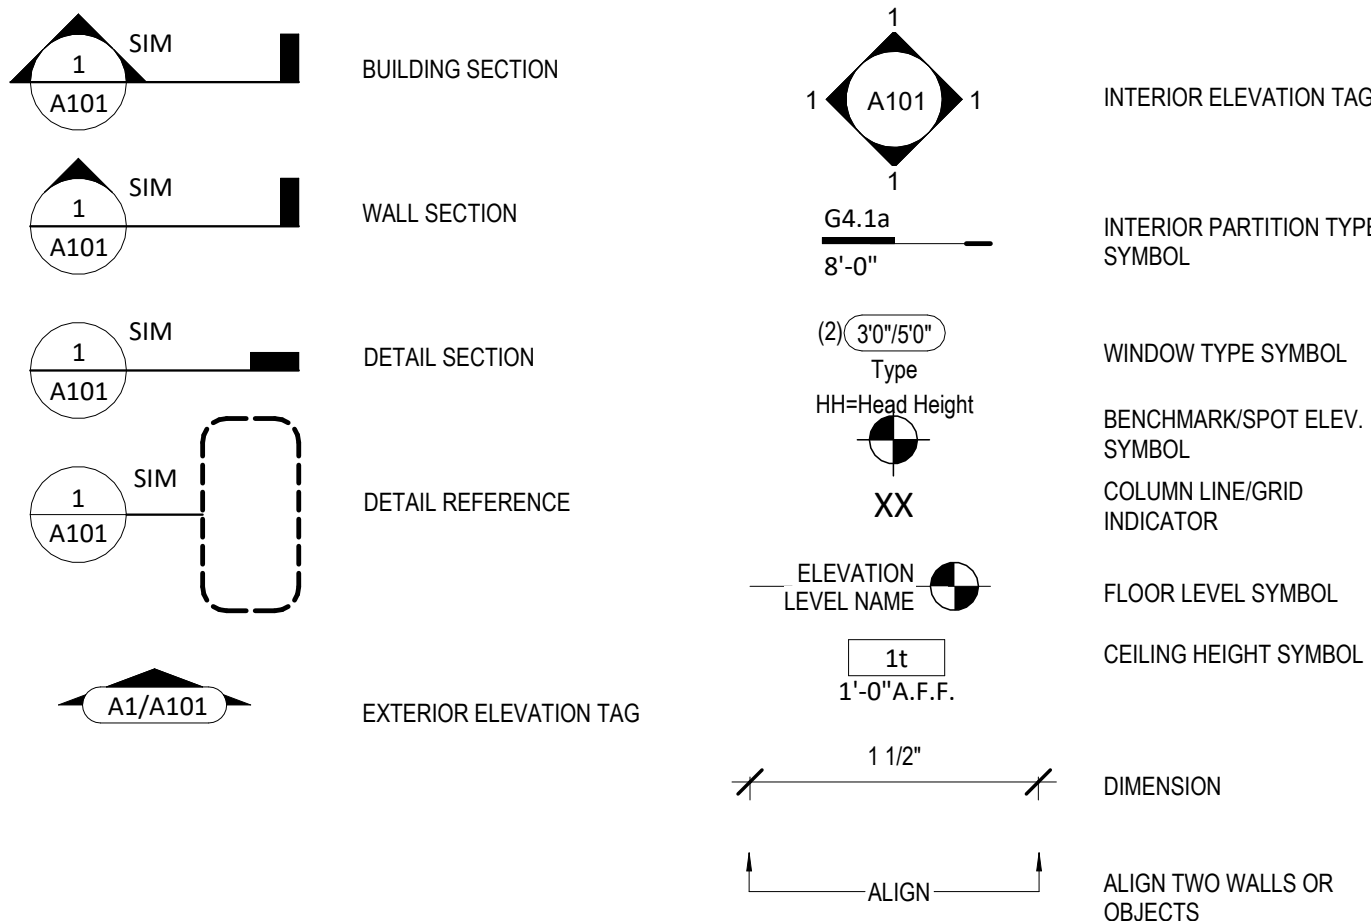

Area - W/ Extended pantry	
Name	Area
Basement Finished	1238 SF
Living Area	1401 SF
	2639 SF
Basement Unfinished	164 SF
Deck	152 SF
Front Porch	24 SF
Garage	599 SF
Patio	152 SF
	1094 SF
	939 SF

Address: 2623 SW Firefly Lane, Lees Summit, MO
Lot: 168 Hook Farms 2nd Plat

General Information

2018 Interior Energy Cons. Code (Table N1102.1.2)	
Doors & Windows:	U-0.32 MAX
Glazing SHGF:	0.40
Skylights:	U-0.55 MAX
Roof	
Attic Ceilings:	R-49 MIN
Vaults:	R-38 MIN
Vaults < 500sf:	R-30 MIN
Wood Frame Walls:	R-20 or R-13 + 5 MIN
Basement Walls:	R-13 or R-10 Continuous
Floor (over unconditioned):	R-19 MIN
Slab on Grade:	R-10 for 24" MIN
Ductwork:	R-8 MIN
Fuel Fired Furnace:	90% AFUE MIN
Electric Furnace:	No Minimum
Cooling System:	13 SEER MIN
Water Heater	
Gas Fired Storage:	0.67 EF MIN
Gas Fired Instant:	0.62 EF MIN
Electric Storage:	0.97 EF MIN
Electric Instant:	0.93 EF MIN

An energy efficient certificate is required to be posted in or on the electrical panel before the final inspection. The certificate will be provided with all new residential permits. It is the permit holder/contractor's responsibility to ensure the certificate has accurate information and is posted before final inspection - Owner/Contractor is responsible for meeting the prescriptive requirements of IRC chapter 11 unless a HER Index Analysis for Performance Compliance based on the plans is submitted to the AHJ for approval.

IRC 2018	
Ground Snow Load:	20PSF
Wind Speed:	115mph
Topography Effects:	No
Seismic Design Category:	A
Damage From Weather:	Severe
Frost Line Depth:	36 inches
Termite:	Moderate to Heavy
Winter Design Temperature:	6 F
Ice Barrier Underlayment:	Yes
Flood Hazard:	
Air Freezing Index:	927 or less
Mean Annual Temperature:	55.5 F

- Whole House Mechanical Ventilation System is required for any dwelling with air infiltration at a rate of less than 5 air changes per hour (at ACH50 standard R303.4).
- Carbon monoxide detectors required (R315)
- Steel columns shall be minimum schedule 40 (R507.2)
- Deck Ledger attachment to house shall be per Tables 507.9.1.3.
- New provisions for attachment of rafters, trusses and roof beams. (R802.3 and R802.11)
- Programmable thermostat required (N1103.1.1)
- Air handlers shall be rated for Maximum 2% air leakage rate (N1103.2.2.1)
- Building cavities used as return air plenums shall be sealed to prevent leakage across the thermal envelope. (N1103.2.3)
- Certain hot water pipes shall be insulated (N1103.4)
- All exhaust fans shall terminate to the building exterior (M1507.2)
- Makeup air system required for kitchen exhaust hoods that exceed 400 CFM M1503.4
- Building cavities in a thermal envelope wall (including the wall between the house and garage) shall not be used as return air plenums (unless the required insulation and air barrier are maintained) (M1601.1.1.#7.5)
- An air handling system shall not serve both the living space and the garage (M1601.6)
- A concrete-Encased grounding electrode (UFER Ground) connection complies with the requirements of the 2018 IRC Section E3608.1.2 in providing a connection with no less than the required minimum of steel.
- Compliance with the requirements and show connection as needed for roof beam, trus, rafter, and girder connections for uplift per IRC 802.11
- Garage Door Rating: DASMA 115 MPH Rated

RELEASE FOR CONSTRUCTION
AS NOTED FOR PLAN REVIEW
DEVELOPMENT SERVICES
LEE'S SUMMIT, MISSOURI
01/30/2025



Greystone - Masterplan

Original Issue Date:		Permit Set
10/1/2021		
REVISIONS		
Number	Description	Date




JANUARY 1, 2025

Permit Set

PLAN DESCRIPTION: Cover Sheet

00

Project No.

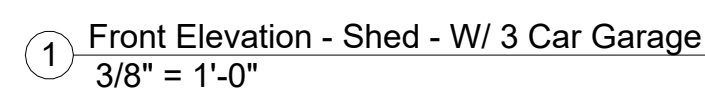

UNLESS A PROFESSIONAL SEAL WITH SIGNATURE AND DATE IS
AFFIXED, THIS DOCUMENT IS PRELIMINARY AND IS NOT INTENDED
CONSTRUCTION, RECORDING PURPOSES OR IMPLEMENTATION



PROJECT


Address: 2623 SW Firefly Lane,
Lees Summit, MO
Lot: 168 Hook Farms 2nd Plat

DATE ISSUED

DRAWING NUMBER


A706.2

Greystone - Masterplan

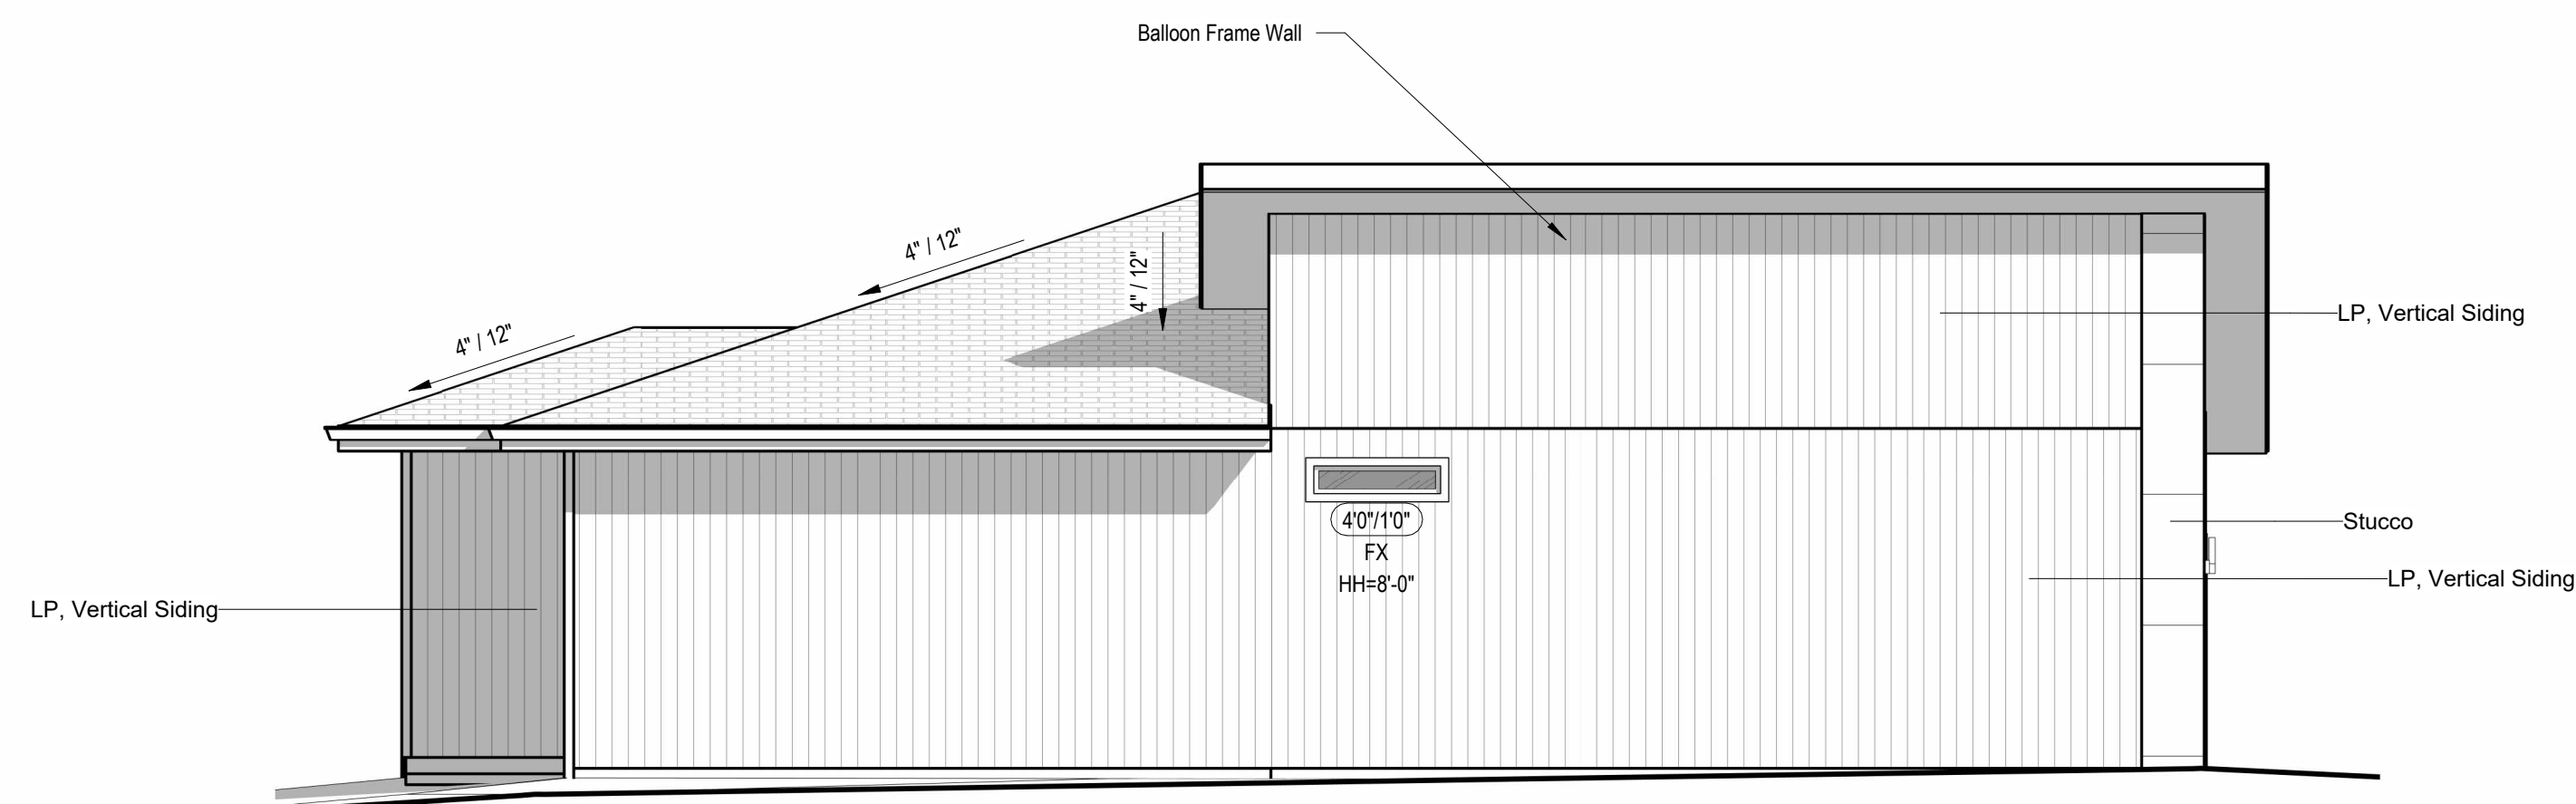


See A709 for added 3rd car garage

③ Right Elevation - Full Basement - Shed
3/16" = 1'-0"

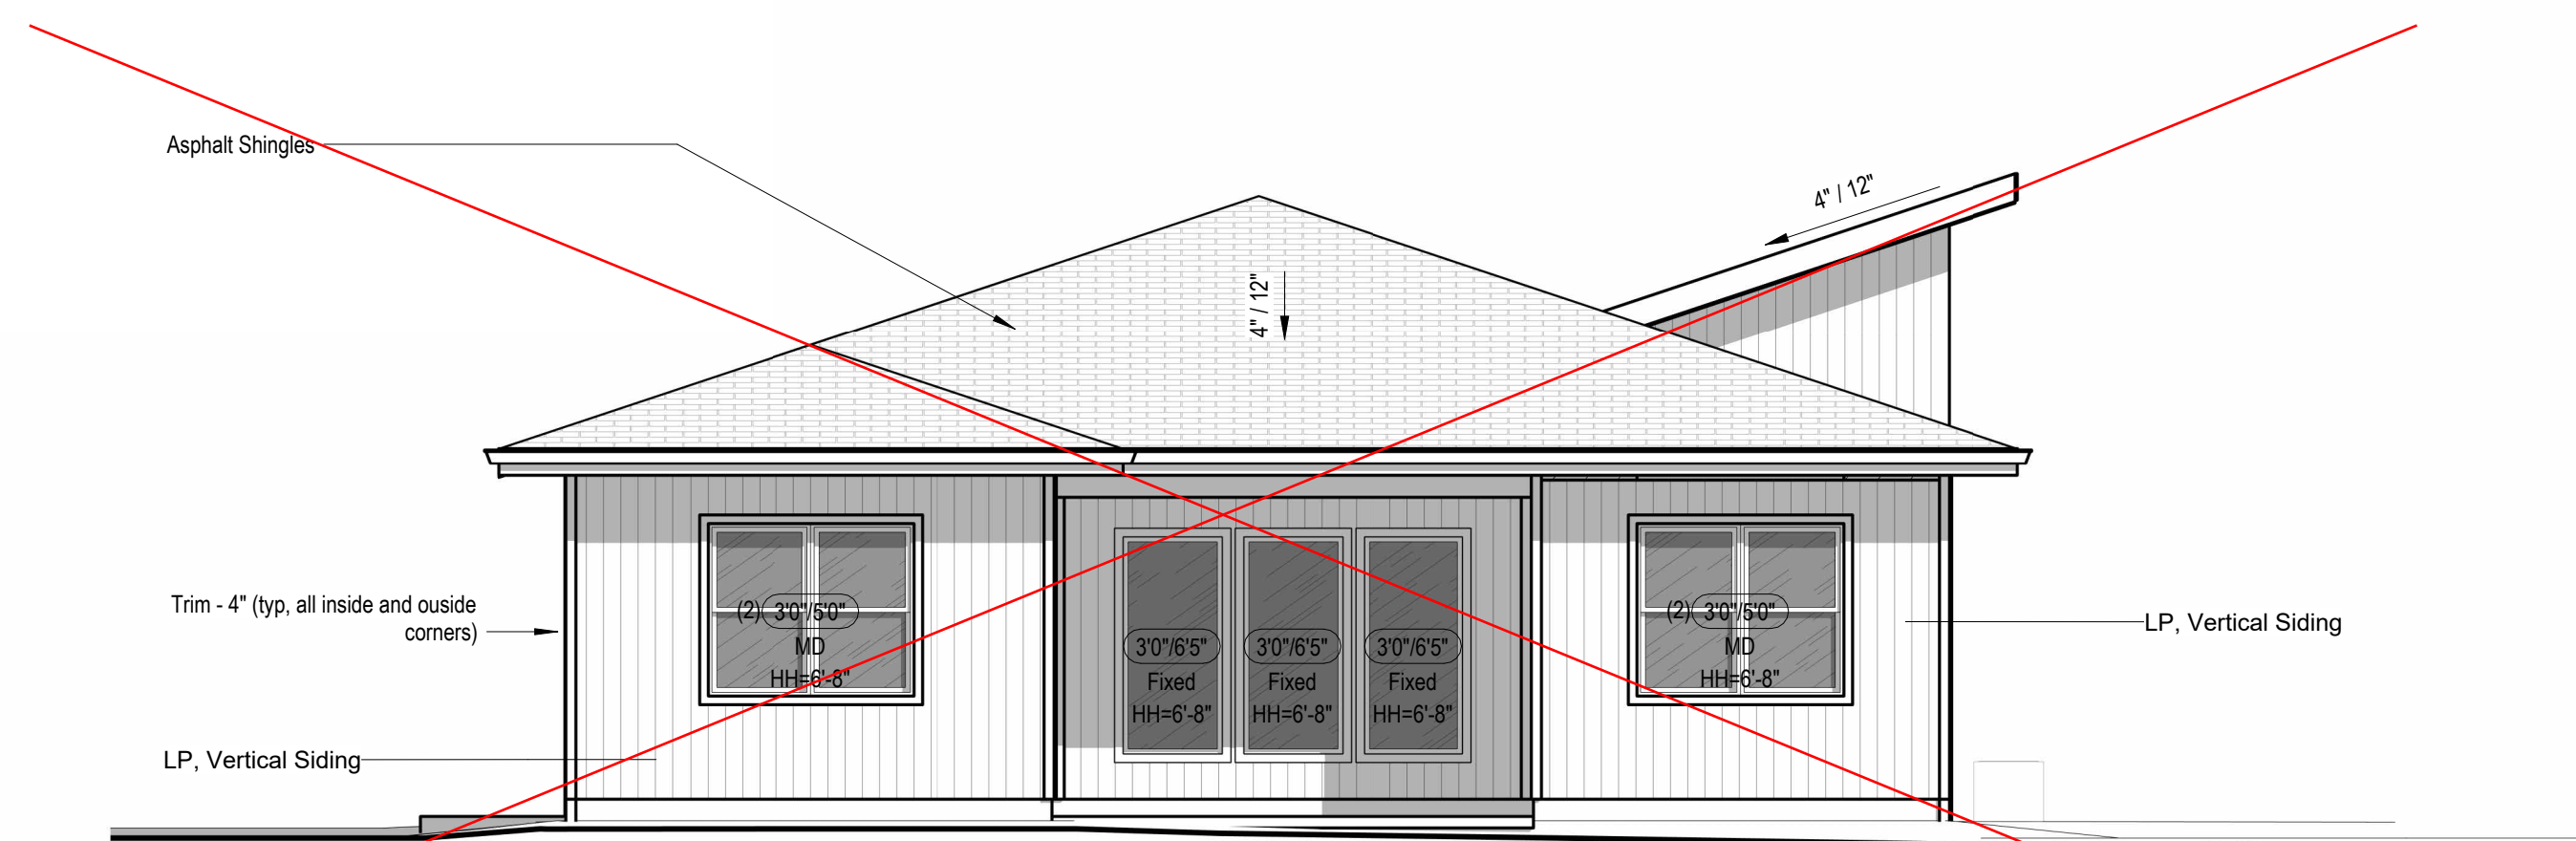

See page A503.1 for fully covered patio option

④ Back Elevation - Full Basement - Shed
3/16" = 1'-0"

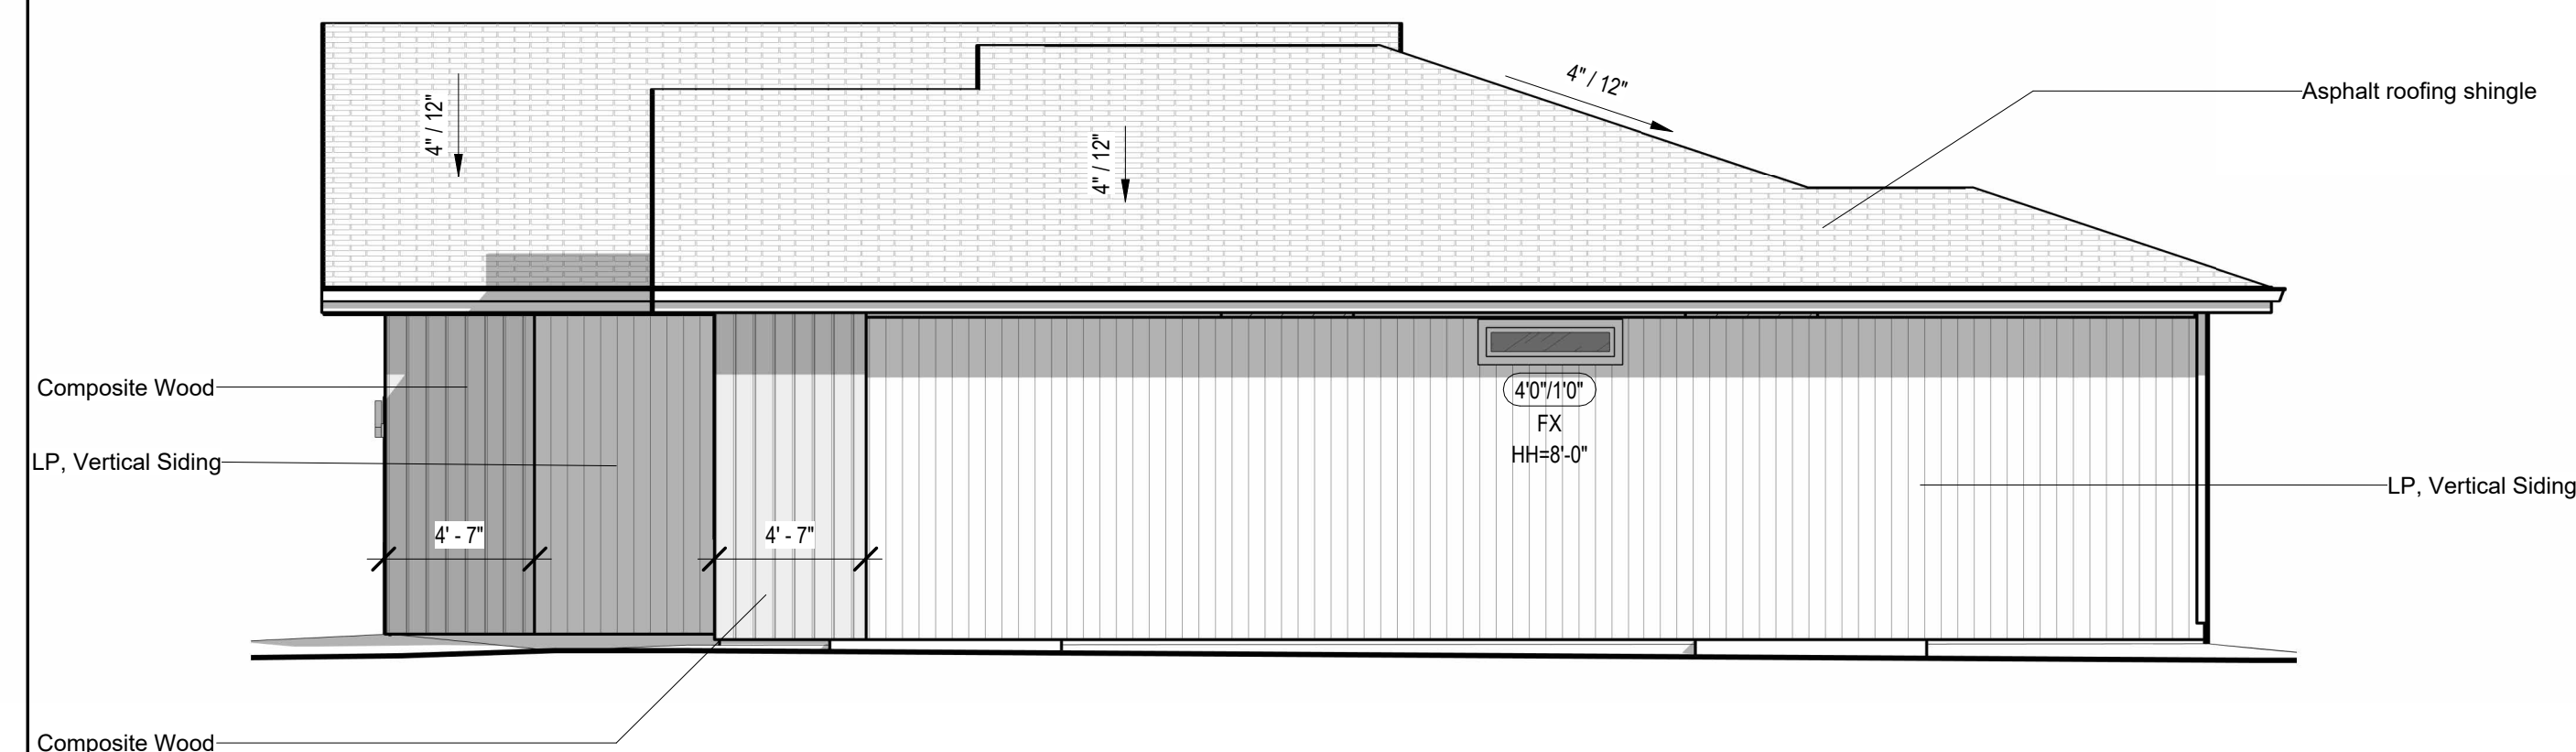

① Left Elevation - Full Basement - Shed
3/16" = 1'-0"

architect:
Elevate Design + Build
1040 SW Luttrell Road
Blue Springs, MO 64015
816.622.8826 voice
www.elevatedesignbuildkc.com

UNLESS A PROFESSIONAL SEAL WITH SIGNATURE AND DATE IS
AFFIXED, THIS DOCUMENT IS PRELIMINARY AND IS NOT INTENDED
CONSTRUCTION, RECORDING PURPOSES OR IMPLEMENTATION



JANUARY 1, 2025

[illegible]

PROJECT

Address: 2623 SW Firefly Lane,
Lees Summit, MO
Lot: 168 Hook Farms 2nd Plat

DRAWING TITLE
Side Elevations - Full Basement -
Shed

DATE ISSUED

DRAWING NUMBER

A301.1

Structural Foundation Schedule					
Type	Width	Length	Depth	Reinforcing	Comments
Footings					
F1	3' - 0"	3' - 0"	1' - 0"	Reinf w/ (6) #4's, rebar count is each way, equal centers	
F2	4' - 0"	4' - 0"	1' - 4"	Reinf w/ (8) #4's, rebar count is each way, equal centers. (8) #4's, vertical rebar count in ped column. Hold ped down 12" Min below gar. door block-down and/or bottom of slab.	GARAGE PEDISTAL
Wall Foundation					
FTG-1	1' - 4"	<varies>	0' - 8"	Reinf w/ (2) #4 bot. eq. spaced. Dowel into wall w/ (1) #4 turned up @ 12" o.c.	<varies>
Foundation Wall Schedule					
Type	Width			Reinforcing	Comments
C8	0' - 8"			Reinf. w/ #4 vert. @ 12" oc./ (3) #4 hor. equally spaced.	<varies>

FOOTING FOUNDATION & CONCRETE NOTES

1. TO ADDRESS DIFFERENTIAL SETTLEMENT, ALL INTERIOR BARRERS AND EXTERIOR BARRERS SHALL BE PLACED IN THE CENTER OF THE WALLS. WALLS INTO UNDISBURBED NATURAL SOIL.

2. ALL WALLS TO BE PLACED MIN. 30 INCHES BELOW FIN. GRADE.

3. DESIGN IS BASED ON MIN. OF 2,500 PSI CONCRETE STRENGTHS TO ACHIEVE THE FOLLOWING BARRING SCHEDULE:

 A. 3.000 FOR EXTERIOR FOUND. WALLS & 12" O.C. VERT. TOP REIN.

 B. 3.000 FOR GARAGE FLOOR.

4. CONC. EXPOSED TO WEATHER SHALL HAVE 6%-(1%) AIR ENTRAINMENT.

5. REINFORCING BARS SHALL BE 4" O.C. WALLS & 12" O.C. VERT. TOP REIN. OVER PERESTALS AS INDICATED (4" X 7" IF 4" O.C. V. & 12" O.C. H. & 6" V. MAJOR OVER PERESTALS).

6. REINFORCE EXTERIOR EXPOSED WALLS WITH 4" O.C. V. REINFORCE W/ #2 @ 40" INT. BARRING.

7. PROVIDE 4" X 4" (1) @ 40" DEGREES W/ REINFORCEMENT CORNERS.

8. 1/2"X12" LASTA ANCHOR BOLTS 36" @ 40" O.C. EXTER. WALLS.

9. PROVIDE 2"X4" INTERIOR PLATE BLS @ 40" O.C. BATTING WALLS 1/2" X 12" X 12" L. REIN. PERESTALS.

10. PROVIDE 2" LAPS MIN. INCLUDING CORNERS.

11. INSTALL FLOORING OVER GARAGE FLOOR. PROVIDE 2" MIN. FLOORING ON PLAN.

12. PROVIDE SUBTANTIAL DRAIN-PROOFING AT FOUNDATION WALLS.

13. SOIL BEARING CAPACITY NOT ASSUMED TO BE GREATER THAN 2,000 PSF IN THE CURRENT FOUNDATION DESIGN. ALL COMPLETED FILL SHALL REQUIRE A SPECIAL INSPECTION.

- STEEL COLUMNS & OTHER BASEMENT FOUNDATION NOTES
1. ALL STEEL PIPE COLUMNS TO BE (3" (OR 3 1/2") SCHEDULE 40 GRADE
2. INTER BEARING WALLS & COLUMNS SHALL BE ISOLATED FROM THE BASEMENT FLOOR SLAB
3. INTER NON-BEARING WALLS, OTHER THAN THOSE RESTING DIRECTLY ON THE FOOTING, SHALL BE ISOLATED FROM THE FLOOR FRAMING ABOVE
4. AT WALKOUT FOUNDATION AREAS, REINFORCE THE SLAB FROM THE FOUNDATION WALL TO 2 FEET BEYOND THE OVERDIG AREA WITH #4 BARS AT 24 INCHES O.C. PERPENDICULAR AND HORIZONTAL TO THE WALL, MAXIMUM 4-FOOT OVERDIG.
5. AT WALKOUTS THE FOUNDATION WALL SHALL BE INSULATED WITH A MINIMUM R-6 INSULATION FOR A MINIMUM OF 2 FEET BELOW THE BOTTOM OF THE SLAB
6. WHERE FLOOR JOISTS ARE PARALLEL TO THE WALL, THE WALL SHALL BE SUPPORTED LATERALLY AT THE TOP BY SOLID BLOCKING FOR MINIMUM OF TWO JOIST SPACES, SPACED NOT MORE THAN 4 FEET O.C.

Diagram illustrating the components of a wall section:

- Partition Material Type
- Nominal Stud/Partition Thickness
- Fire Rating or other modifier
- Partition Height. Omitted at walls spanning full height

Note:
Basement Walls Framed 1" Short
Below Beams and Joists.

See 3 Car Garage option A709

2" Water Sleeve 16"
below footing

Note: Run water main to
furnace room under footing

6" Sewer sleeve
below footing
Ext. cleanout in li
w/ Sewer sleeve

Note: Run water main to furnace room under footing. DO not drill wall.

① Foundation Plan - Full Basement
1/4" = 1'-0"

Greystone - Masterplan

architect:
Elevate Design + Build
1040 SW Luttrell Road
Blue Springs, MO 64015
816.622.8826 voice
www.elevatedesignbuildkc.com

UNLESS A PROFESSIONAL SEAL WITH SIGNATURE AND DATE IS
AFFIXED, THIS DOCUMENT IS PRELIMINARY AND IS NOT INTENDED FOR
CONSTRUCTION. PROCEED AT YOUR OWN RISK.



JANUARY 1, 2025

REVISIONS

[illegible]

PROJECT

Address: 2623 SW Firefly Lane,
Lees Summit, MO
Lot: 168 Hook Farms 2nd Plat

DRAWING TITLE

Foundation Plan - Full Basement

DATE ISSUED

DRAWING NUMBER

A401.1

RELEASE FOR CONSTRUCTION
File:Greystone Master Plan.pdf
AS NOTED FOR PLAN REVIEW
DEVELOPMENT SERVICES
LEE'S SUMMIT, MISSOURI
01/30/2025

Slab Schedule	
Type	Description
S4.1	4" MIN CONC SLAB REINF. W/ #4'S E.W. @ 18" O.C. OVER COMPACTED FILL AND GRAVEL 24"
S8.1	8" MIN CONC SLAB REINF. W/ #4'S E.W. @ 18" O.C. OVER COMPACTED FILL AND GRAVEL 24"

Structural Foundation Schedule						
Type	Width	Length	Depth	Reinforcing	Comments	
Footing						
F1	3'-0"	3'-0"	1'-0"	Reinf w/ (6) #4's, rebar count is each way, equal centers		
F2	4'-0"	4'-0"	1'-4"	Reinf w/ (8) #4's, rebar count is each way, equal centers, (8) #4's, vertical rebar count in ped column. Hold ped down 12" Min below gar. door block-down and/or bottom of slab.		GARAGE PEDISTAL
Wall Foundation						
FTG-1	1'-4"	<varies>	0'-8"	Reinf w/ (2) #4 bot. eq. spaced, Dowel into wall w/ (1) #4 turned up @ 12" o.c.	<varies>	


Foundation Wall Schedule			
Type	Width	Reinforcing	Comments
C8	0' - 8"	Reinf. w/ #4 vert. @ 12" oc / (3) #4 hor. equally spaced.	<varies>

Foundation Notes:

- FOOTINGS/FOUNDATION & CONCRETE NOTES
- 1. TO ADDRESS DIFFERENTIAL SETTLEMENT, ALL INTERIOR BEARING AND EXTERIOR BEARING WALLS TO BE PLACED MIN. 30" BELOW FINISHED GRADE TO UNDISTURBED NATURAL SOIL.
 - 2. EXIST. FOOTING TO BE PLACED MIN. 30" BELOW FINISHED GRADE.
 - 3. PROVIDE 1" MIN. CONCRETE SLAB ON GRADE WITH REINFORCING TO ACHIEVE THE FOLLOWING BASE LOADS:
 - 1,000 PSF FOR FLOORS, FOUND. WALLS & VERT. SURFACES
 - 3,000 PSF FOR GARAGE FLOOR
 - 4. CONCRETE EXPOSED TO WEAR SHALL HAVE 6%+1% IN PLACE OR EQUIVALENT PROTECTIVE SURFACING. PROVIDE 1" MIN. CONCRETE SLAB ON GRADE TO ACHIEVE THE FOLLOWING BASE LOADS AS INDICATED (4" X 7" X 8" C.O.C. E.W. E-1 TRANSFORMER 6" MILL VAPOR BARRIER).
 - 5. PROVIDE EXTERIOR FOOTING WALLS WITH #4 E.W. REINFORCE W/ 2" C-NT. AT JOINT.
 - 6. PROVIDE #4 X 12" @ 45 DEGREES @ REINTEGRANT CORNERS.
 - 7. 12"X12" ASTMA A36 STEEL BEAMS @ 48" C.O.C. @ EXIST. WALLS.
 - 8. PROVIDE 2" STEEL TREATED PLATE @ 12" C-NT BEARING WALLS W/ 12" X 4" X 12" HLT.
 - 9. PROVIDE 2" LAPS MIN. INCLUDING CORNERS.
 - 10. INSTALL HOLDING ANCHORS AS INDICATED ON PLAN.
 - 11. PROVIDE SETTING BOLTS AS INDICATED ON PLAN.
 - 12. SOIL BEARING CAPACITY IS NOT ASSUMED TO BE GREATER THAN 2,000 PSF. PER THE CURRENT FOUNDATION DESIGN, ALL COMPLETED FILL AREAS REQUIRE A SPECIAL INSPECTION.


- STEEL COLUMNS & OTHER BASEMENT/FOUNDATION NOTES
1. ALL STEEL PIPE COLUMNS TO BE 3" (OR 3 1/2") SCHEDULE 40 GRADE
 2. INTER BEARING WALLS & COLUMNS SHALL BE ISOLATED FROM THE BASEMENT FLOOR SLAB
 3. INTER NON-BEARING WALLS, OTHER THAN THOSE RESTING DIRECTLY ON THE FOOTING, SHALL BE ISOLATED FROM THE FLOORING ABOVE
 4. AT WALKOUT FOUNDATION AREAS, REINFORCE THE SLAB FROM THE FOUNDATION WALL TO 2 FEET BEYOND THE OVERHANG AREA WITH #4 BARS AT 24 INCHES O.C. PERPENDICULAR AND HORIZONTAL TO THE WALL; MAXIMUM 4-FOOT OVERC.D.
 5. AT WALKOUTS THE FOUNDATION WALL SHALL BE INSULATED WITH A MINIMUM R-8 INSULATION FOR A MIN 9 FEET BELOW THE BOTTOM OF THE SLAB
 6. WALKOUT FOUNDATION WALLS SHALL BE ISOLATED FROM THE FOUNDATION WALL TO BE SUPPORTED LATERALLY AT THE TOP BY SLID BLOCKING FOR MINIMUM OF TWO JOBS SPACES, SPACED NOT MORE THAN 4 FEET O.C.

Interior Partition Naming Convention

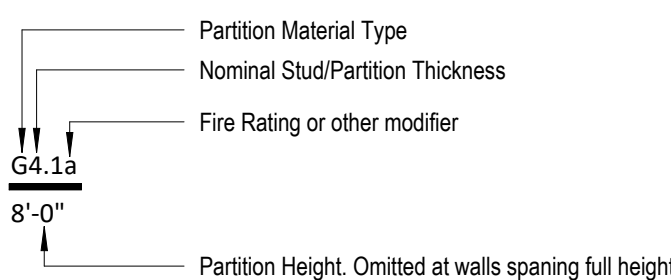

Deck Ledger Attachment

1. (2) Lags required at EA end 2" from ends.
2. Provide 1x4 treated spaced behind EA lag.
3. Provide lags in EA joist space w/ (2) every other space, 2" from edges.
4. Min. size lag is 1/2" diam x 6" length
5. Provide flashing between rim joist and ledger.

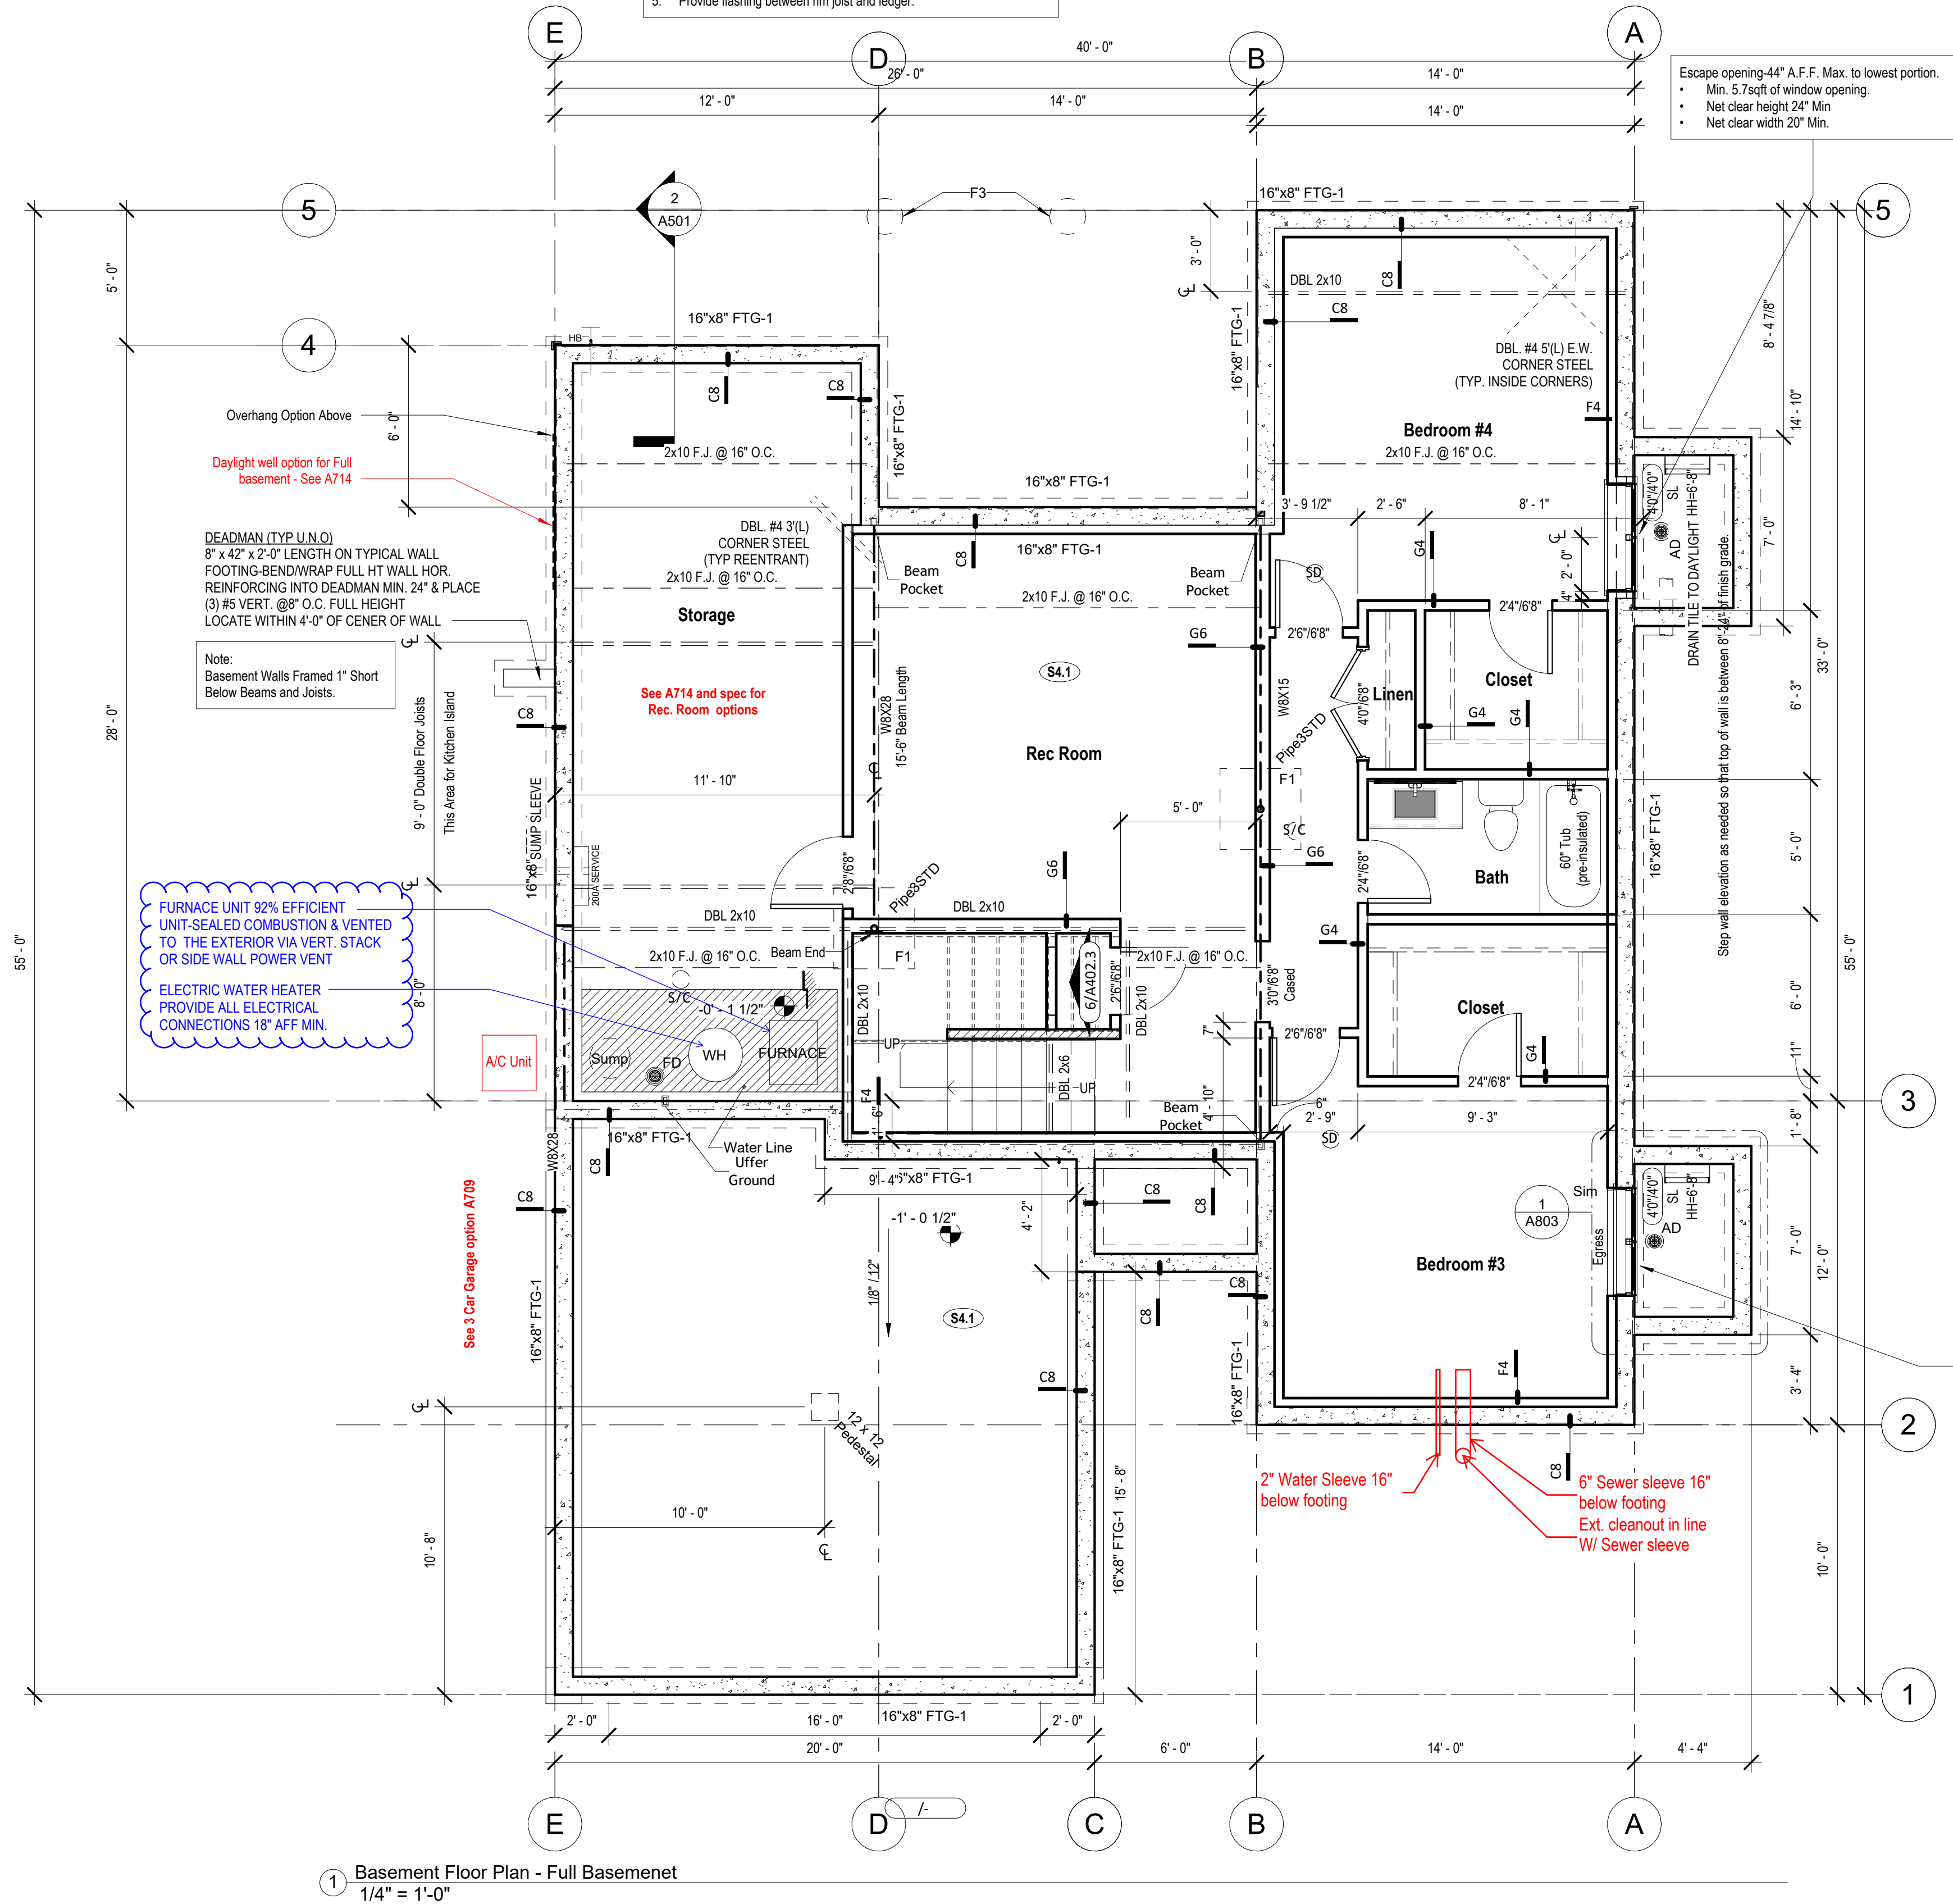

1 Basement Floor Plan - Full Basement
1/4" = 1'-0"



ELEVATE DESIGN + BUILD
Elevating the Homebuilding Experience

Greystone - Masterplan

architect:
Elevate Design + Build
1040 SW Luttrell Road
Blue Springs, MO 64015
816.622.8826 voice
www.elevatedesignbuild.com

UNLESS A PROFESSIONAL SEAL WITH SIGNATURE AND DATE IS
AFFIXED, THIS DOCUMENT IS PRELIMINARY AND IS NOT INTENDED FOR



JANUARY 1, 2025

REVISIONS

[illegible]

PROJECT

Address: 2623 SW Firefly Lane,
Lees Summit, MO
Lot: 168 Hook Farms 2nd Plat

DRAWING TITLE

Floor Plan - Full Basement

DATE ISSUED

DRAWING NUMBER

A402.1

RELEASE FOR CONSTRUCTION
 AS NOTED FOR PLAN REVIEW
 DEVELOPMENT SERVICES
 LEE'S SUMMIT, MISSOURI
 01/30/2025

A circular professional seal for Aaron A. Brown, a Registered Architect in the State of Missouri. The seal features the text "STATE OF MISSOURI" at the top, "AARON A. BROWN" in the center, "NUMBER A-7215" below the name, and "REGISTERED ARCHITECT" at the bottom. A stylized signature is written over the seal.


REVISIONS

[illegible]

DATE ISSUED

A501


01/30/2025

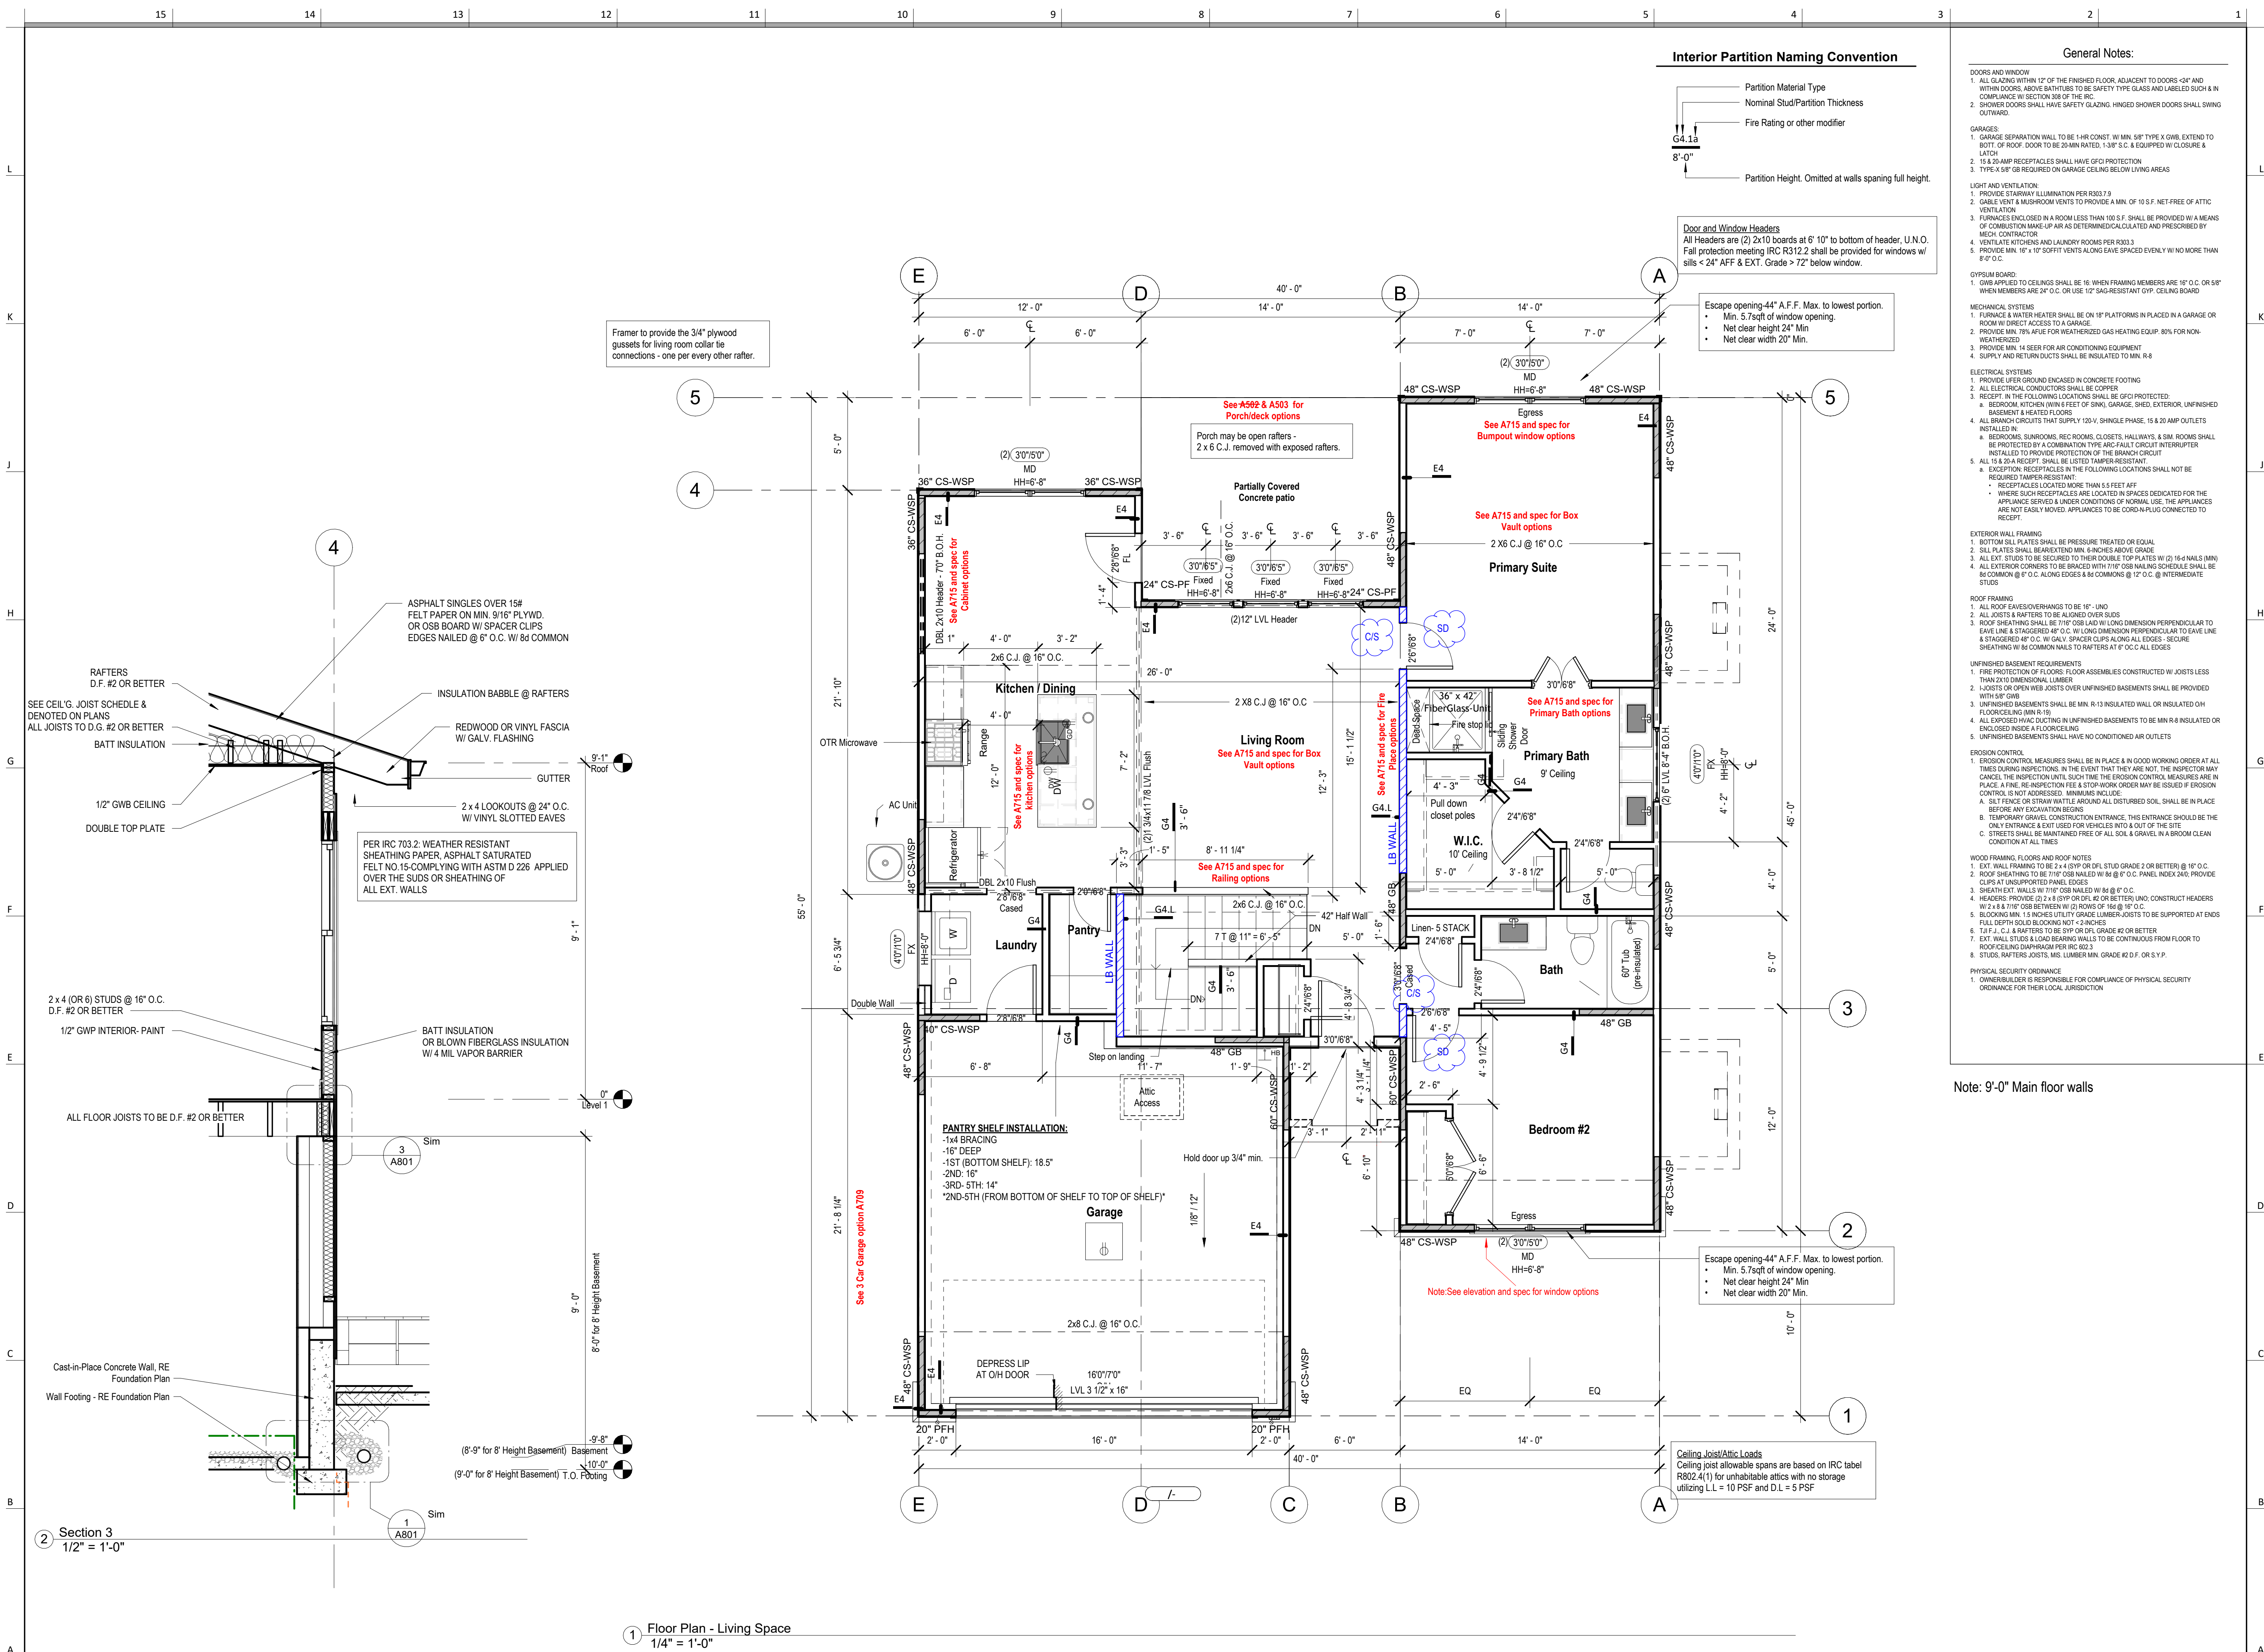


Greystone - Masterplan




Back Elevation - Deck for Walkout Basement - shed - Full covered Deck
 ⑥ $3/16" = 1'-0"$

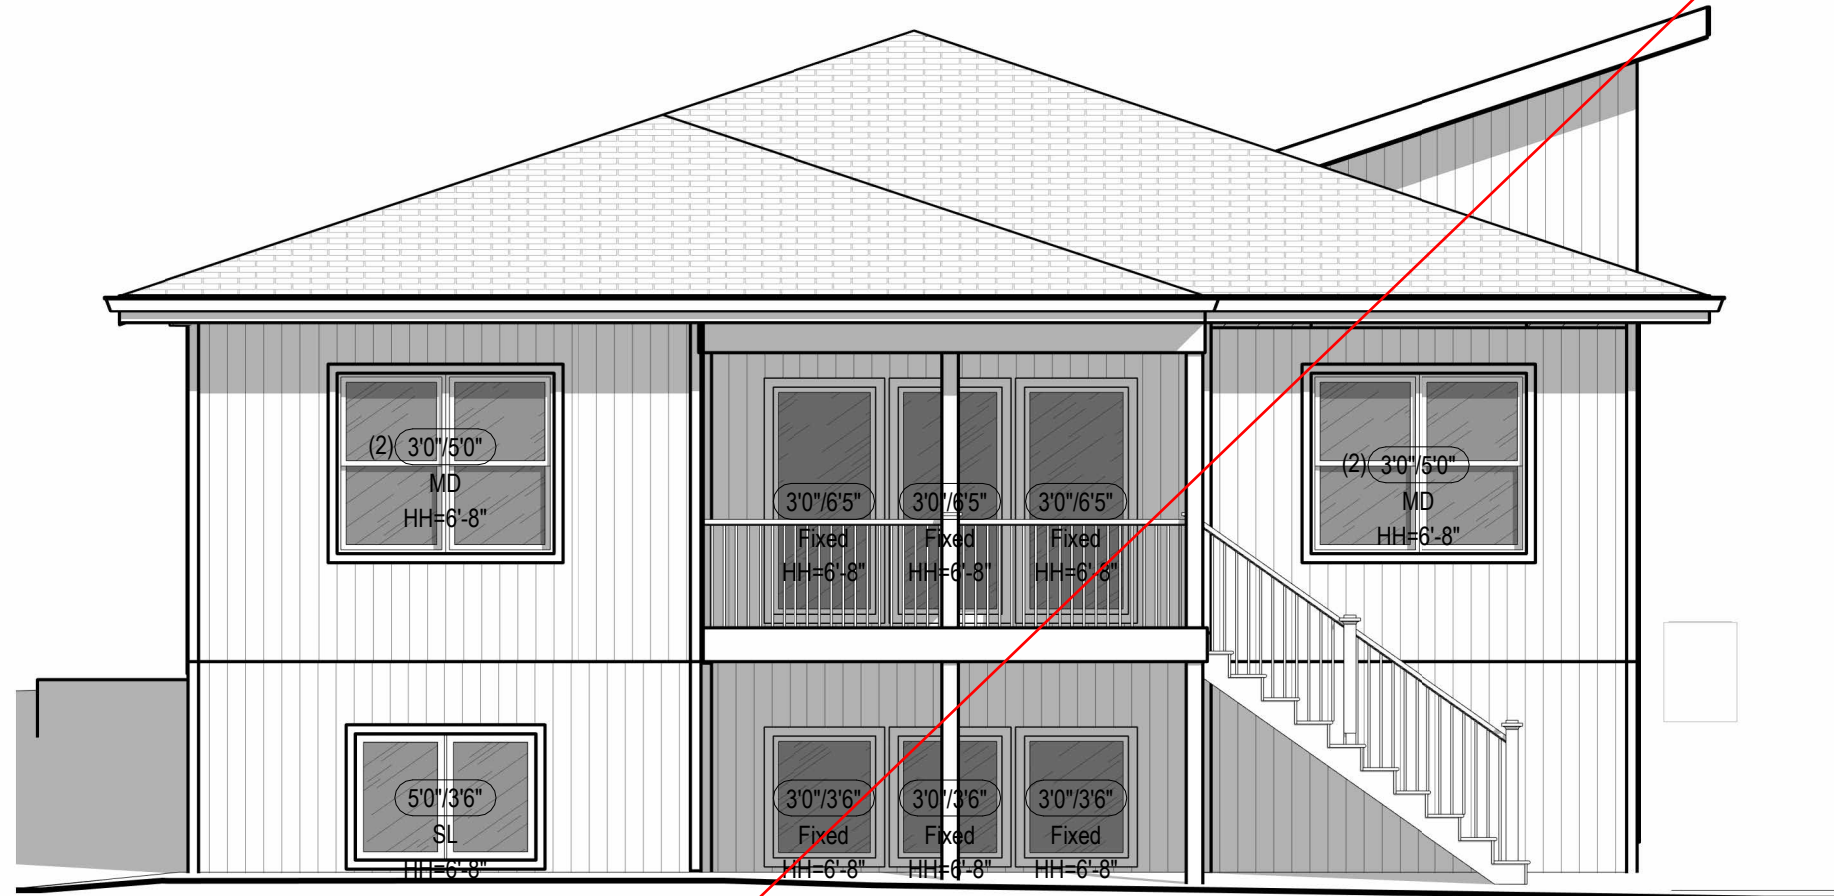


5 ~~Back Elevation - Deck for Daylight Basement - shed - Full covered Deck~~
 ~~$3/16" = 1'-0"$~~

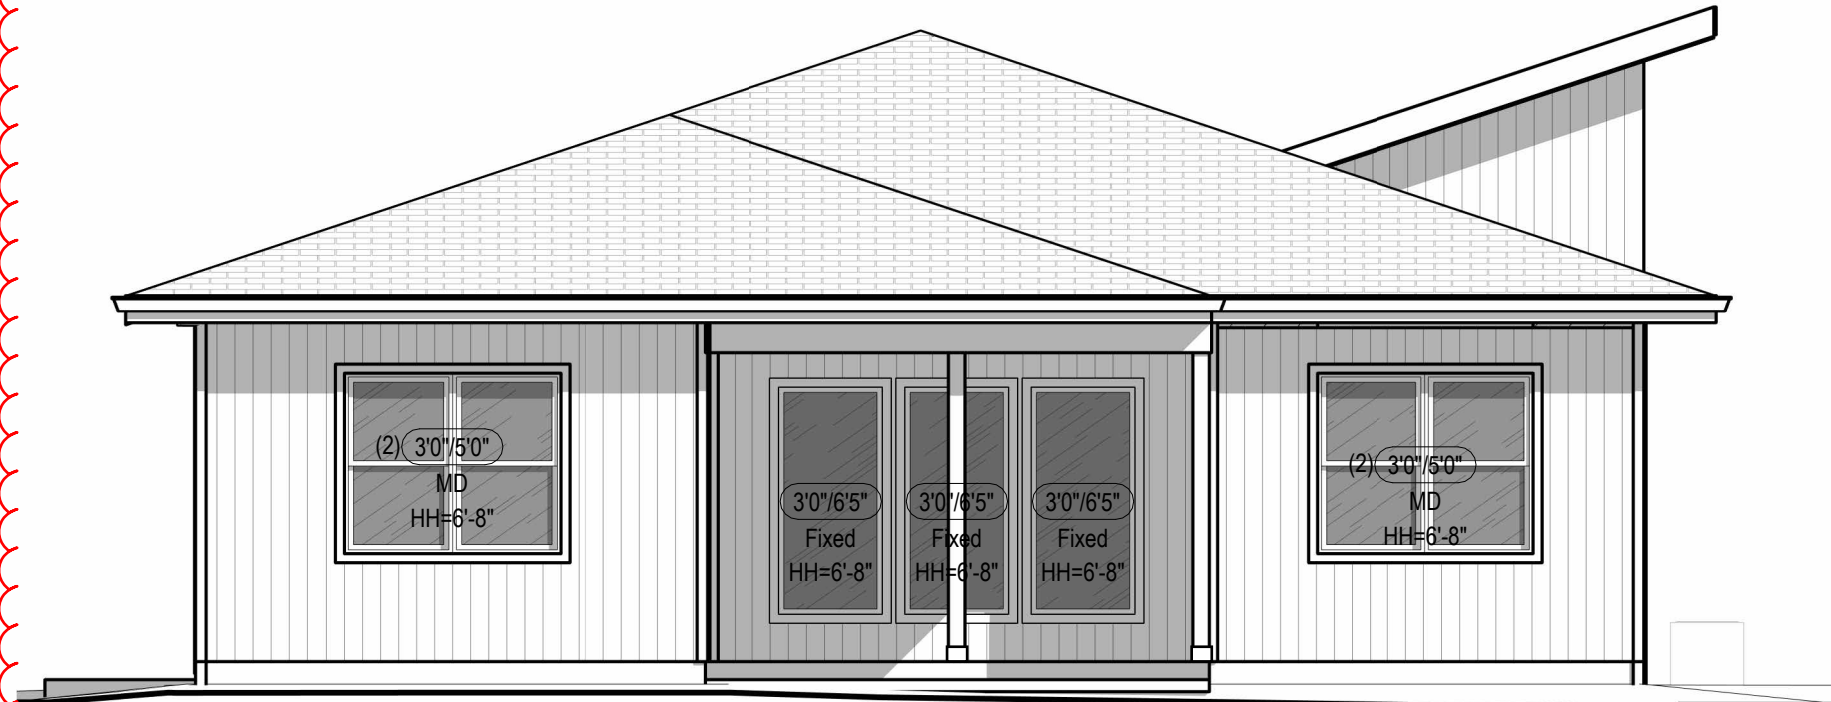


4 Back Elevation - Patio for Full Basement - shed - Full covered Deck
3/16" = 1'-0"

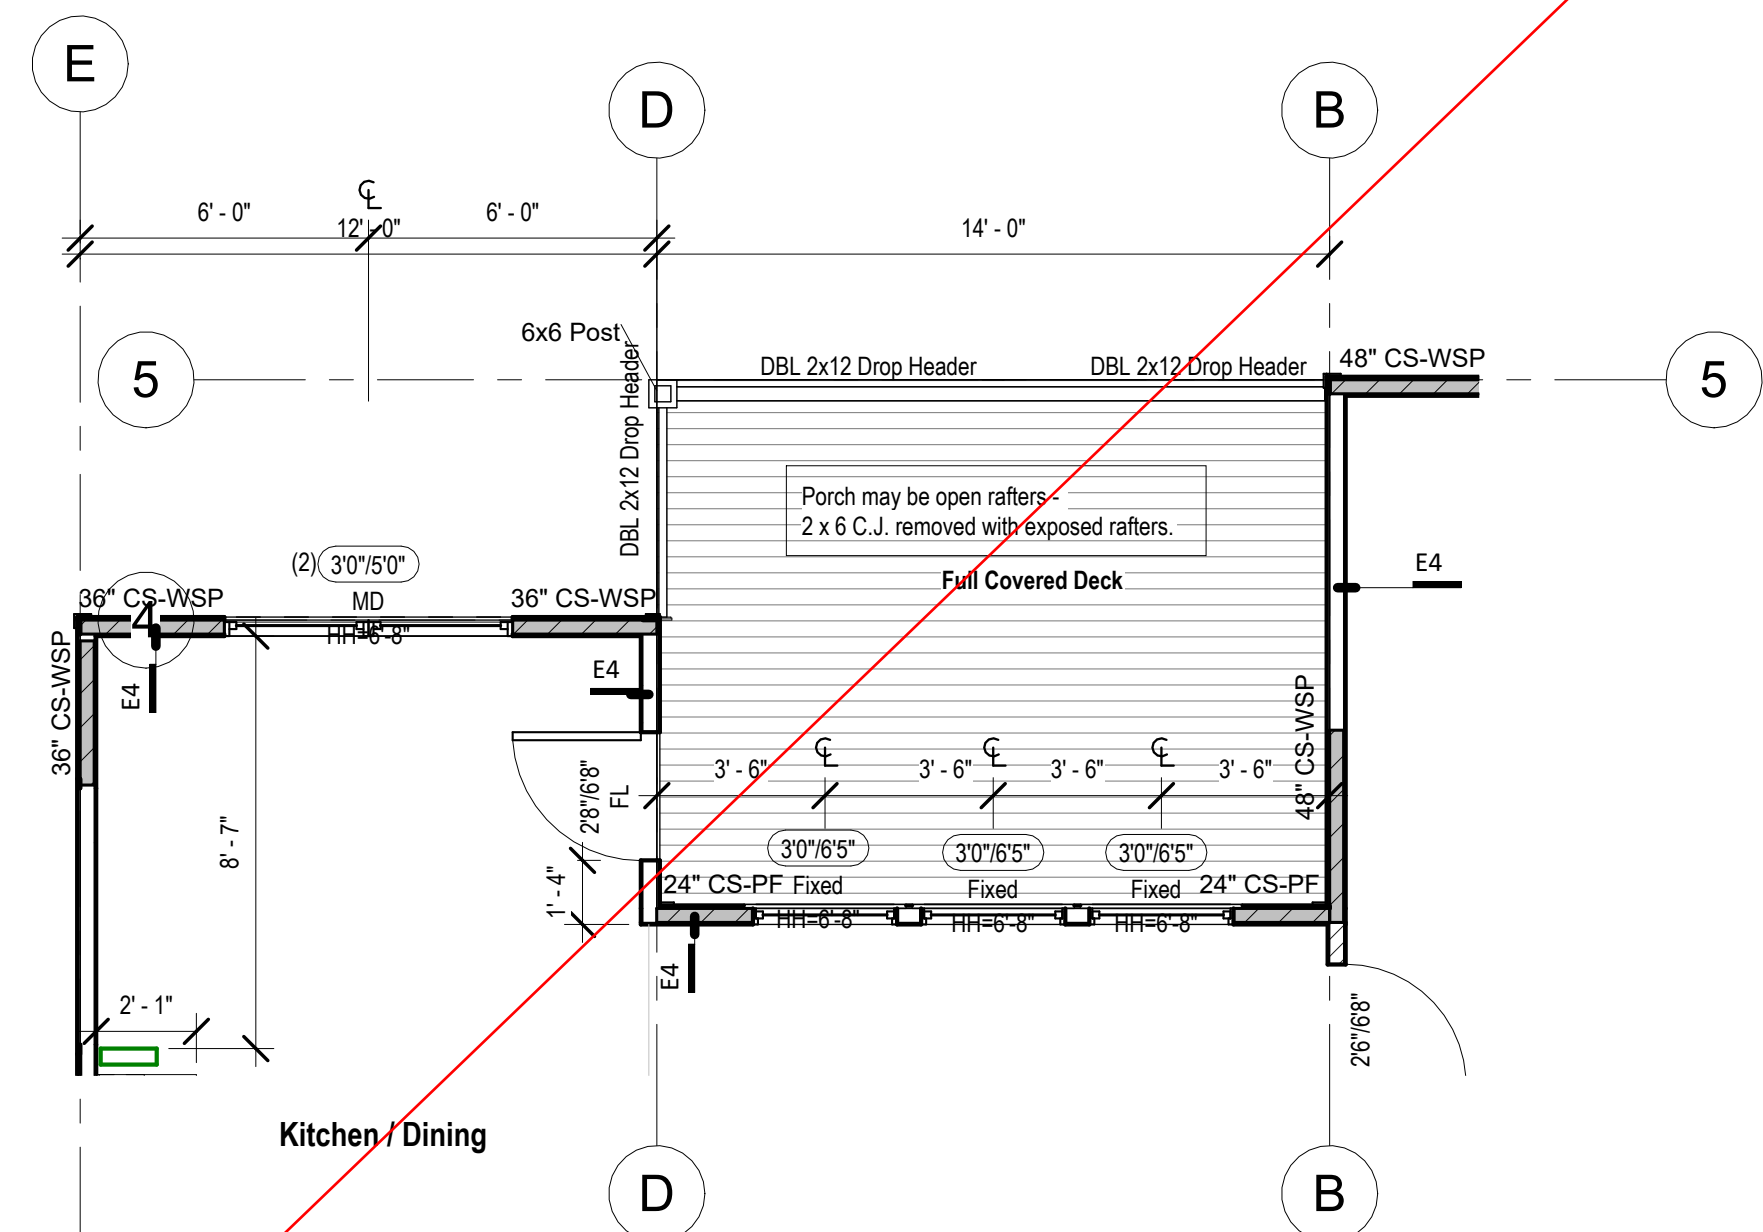

3 Floor Plan - Living Space - Deck for Walkout Basement - shed - Full covered Deck
1/4" = 1'-0"

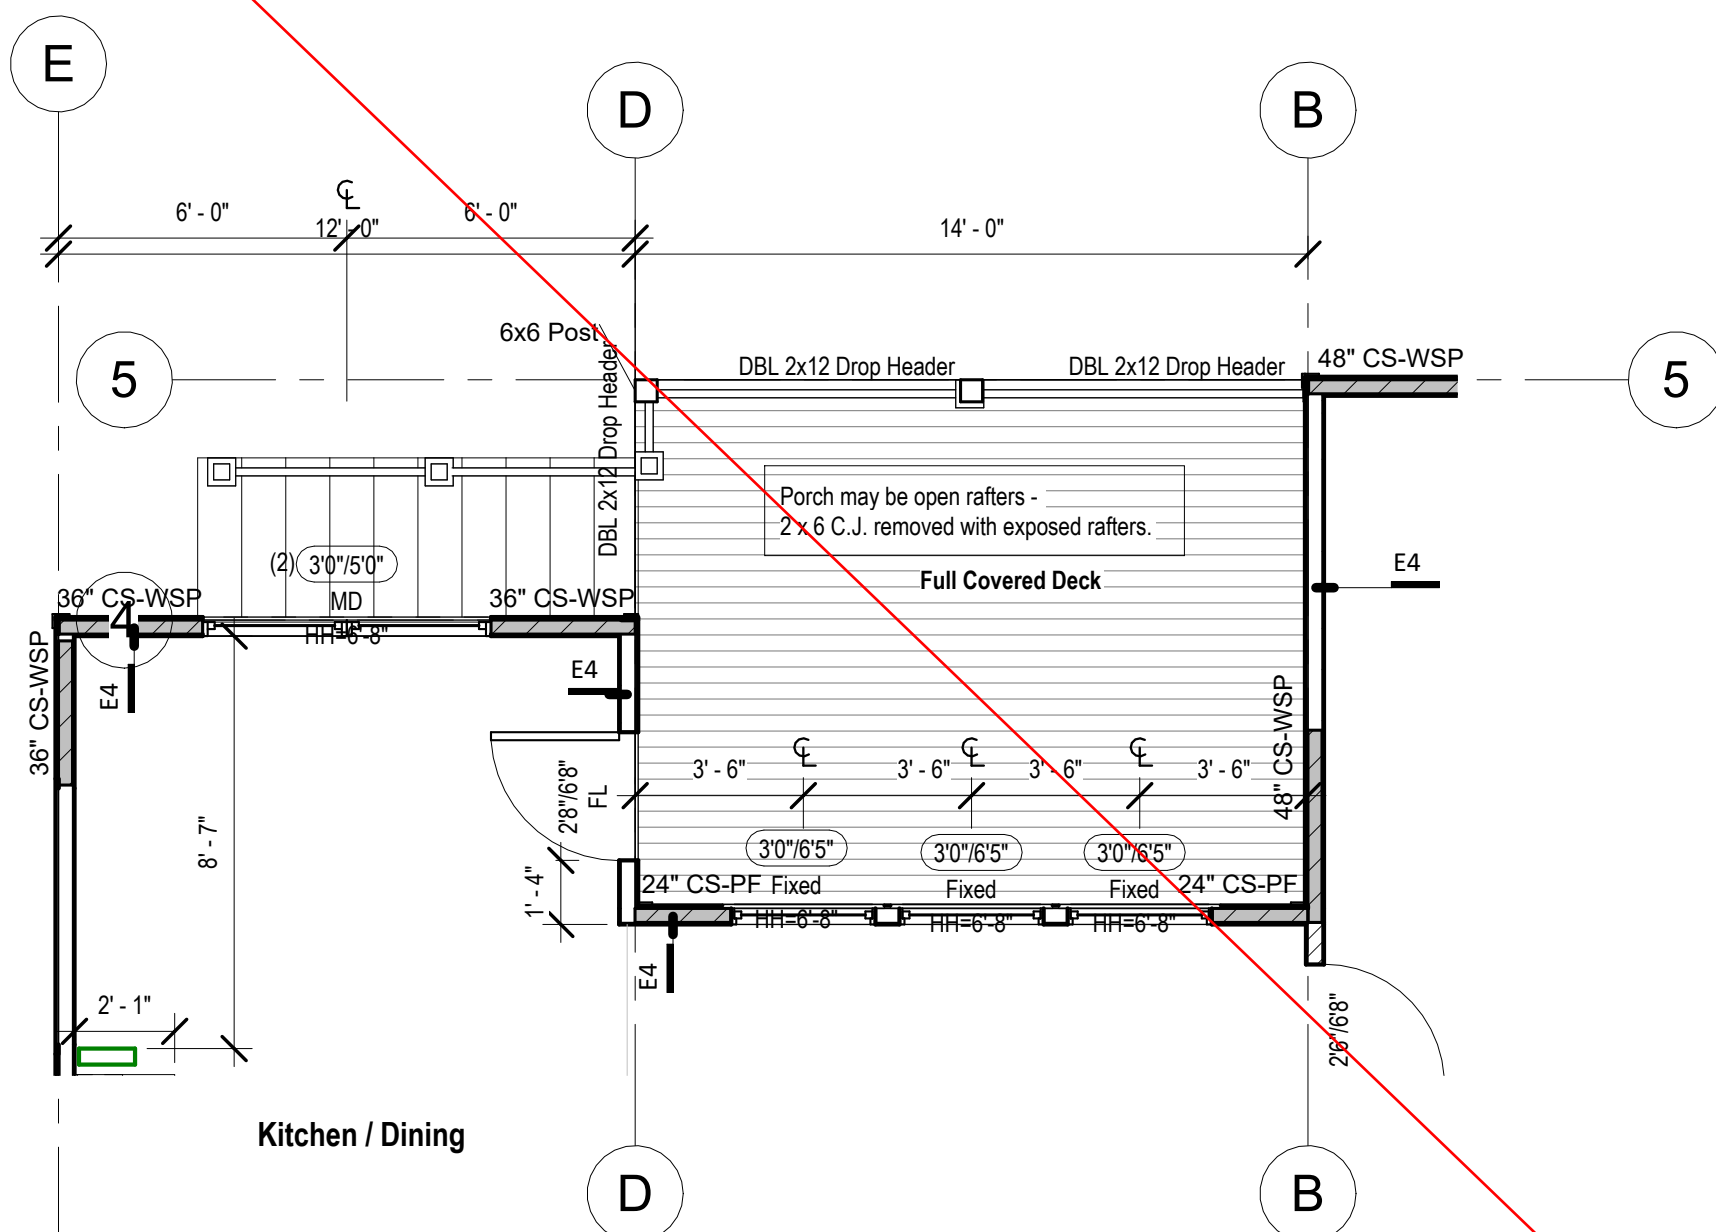

2 Floor Plan - Living Space - Deck for Daylight Basement - shed Copy 1
1/4" = 1'-0"

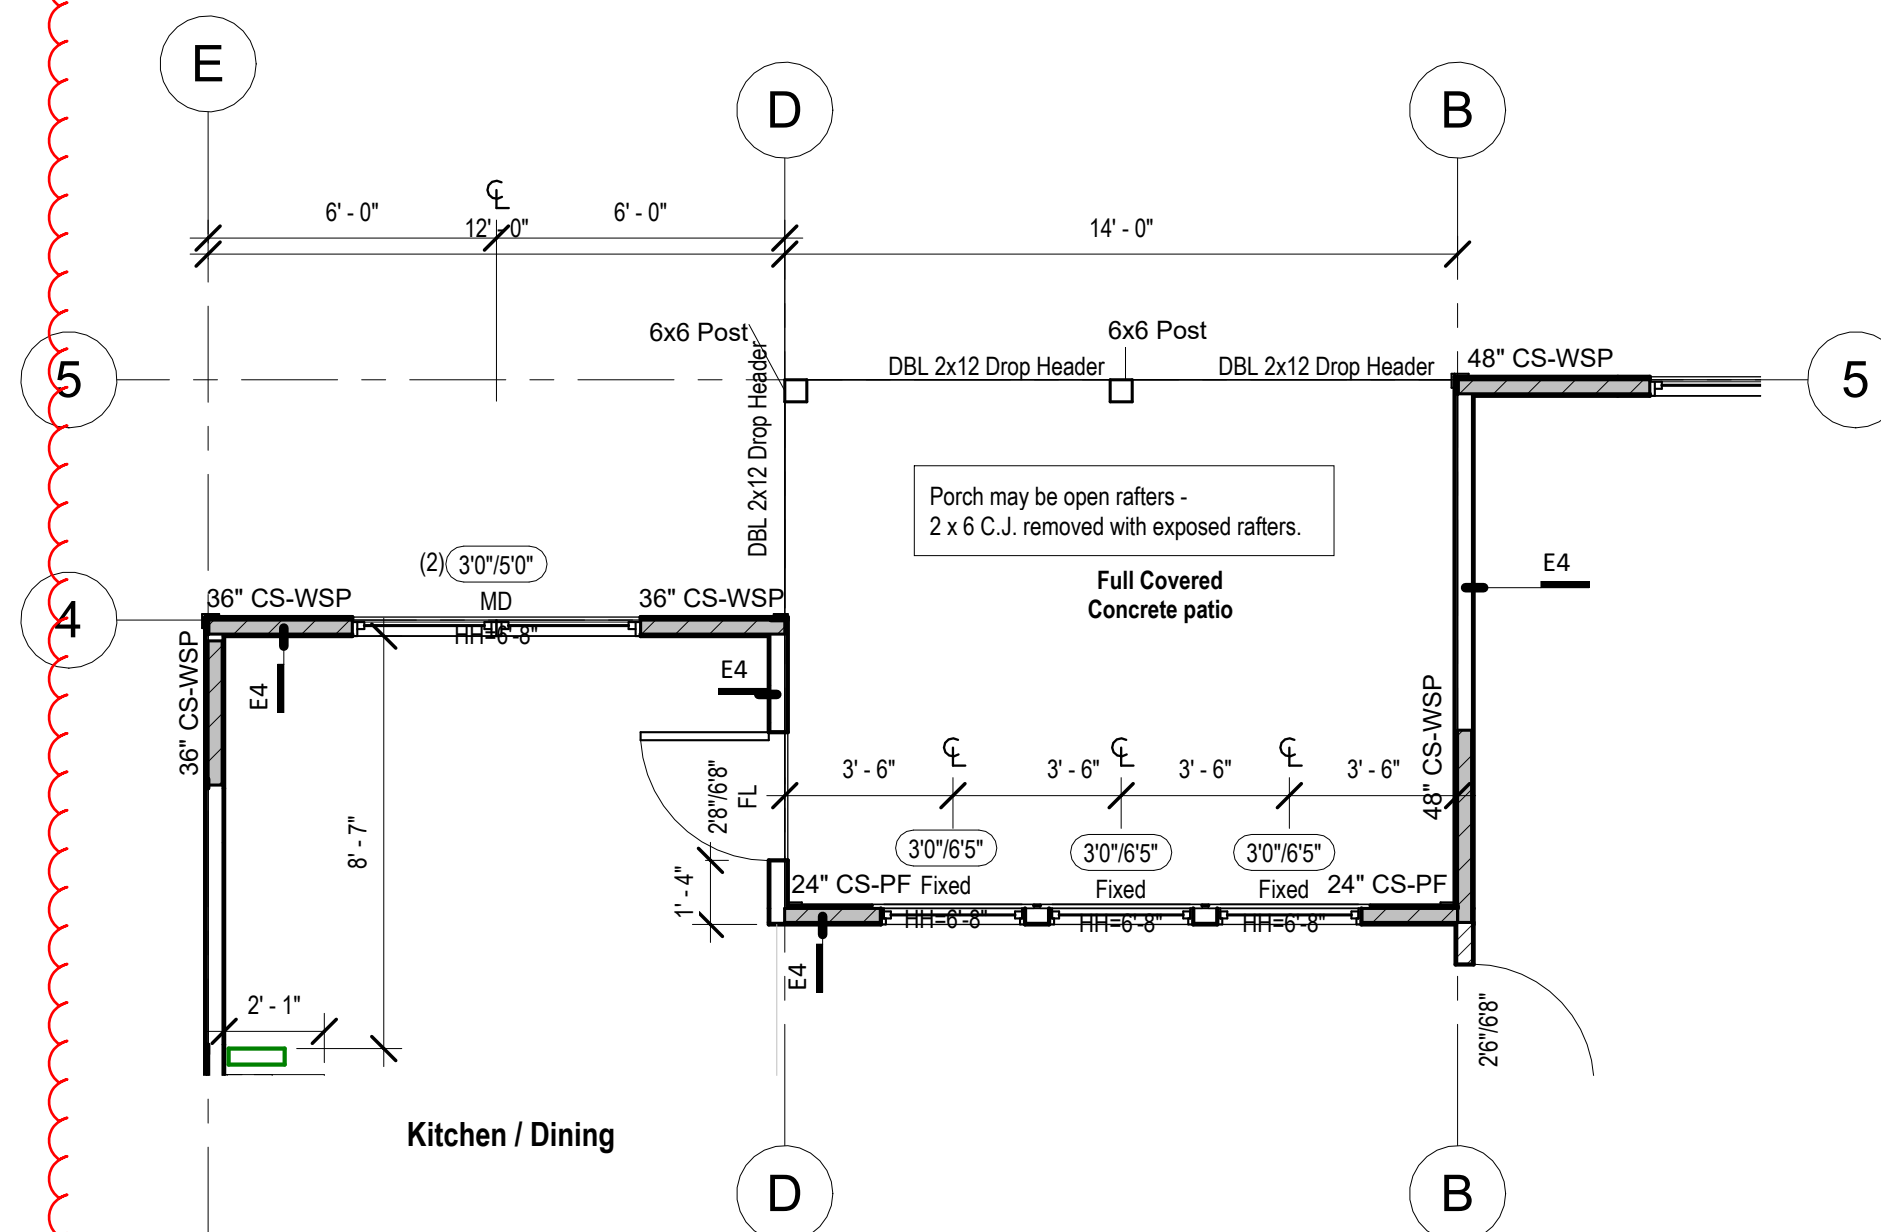

1 Floor Plan - Living Space - Patio for Full Basement - shed - Full covered Deck
1/4" = 1'-0"

architect:
Elevate Design + Build
1040 SW Luttrell Road
Blue Springs, MO 64015
316.622.8826 voice
www.elevatedesignbuildkc.com

UNLESS A PROFESSIONAL SEAL WITH SIGNATURE AND DATE IS
AFFIXED, THIS DOCUMENT IS PRELIMINARY AND IS NOT INTENDED FOR
CONSTRUCTION, RECORDING PURPOSES OR IMPLEMENTATION



JANUARY 1, 2025

[illegible]

PROJECT

Address: 2623 SW Firefly Lane,
Lees Summit, MO
Lot: 168 Hook Farms 2nd Plat

DRAWING TITLE
Floor Plan - Main Level Deck &
Patio - shed - Full covered Deck

DATE ISSUED _____

DRAWING NUMBER

A503.1

UNLESS A PROFESSIONAL SEAL WITH SIGNATURE AND DATE IS
AFFIXED, THIS DOCUMENT IS PRELIMINARY AND IS NOT INTENDED
CONSTRUCTION, RECORDING PURPOSES OR IMPLEMENTATION



PROJECT

Address: 2623 SW Firefly Lane,
Lees Summit, MO
Lot: 168 Hook Farms 2nd Plat

DATE ISSUED

A602.1








PROJECT
Address: 2623 SW Firefly Lane,
Lees Summit, MO
Lot: 168 Hook Farms 2nd Plat

DATE ISSUED _____

DRAWING NUMBER

A709

RELEASE FOR CONSTRUCTION
AS NOTED FOR PLAN REVIEW
DEVELOPMENT SERVICES
LEE'S SUMMIT, MISSOURI
01/30/2022

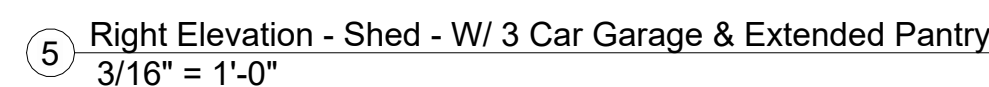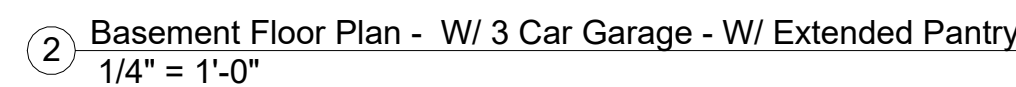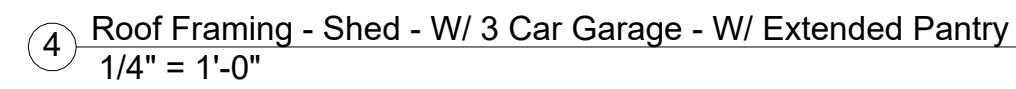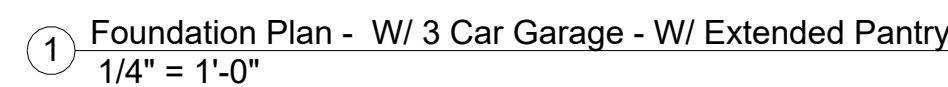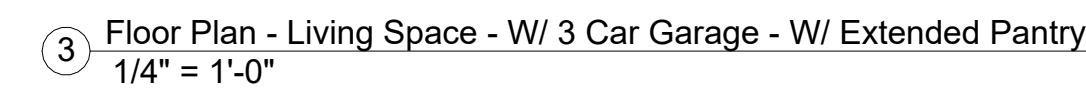

Greystone - Masterplan

architect:
Elevate Design + Build
1040 SW Luttrell Road
Blue Springs, MO 64015
816.622.8826 voice
www.elevatedesignbuildkc.com

UNLESS A PROFESSIONAL SEAL WITH SIGNATURE AND DATE IS
AFFIXED, THIS DOCUMENT IS PRELIMINARY AND IS NOT INTENDED
CONSTRUCTION, RECORDING PURPOSES OR IMPLEMENTATION



JANUARY 1, 2025

[illegible]

PROJECT

Address: 2623 SW Firefly Lane,
Lees Summit, MO
Lot: 168 Hook Farms 2nd Plat


DRAWING TITLE
POD Options

DATE ISSUED


DRAWING NUMBER

A714

RELEASE FOR CONSTRUCTION
AS NOTED FOR PLAN REVIEW
DEVELOPMENT SERVICES
LEE'S SUMMIT, MISSOURI
01/30/2020

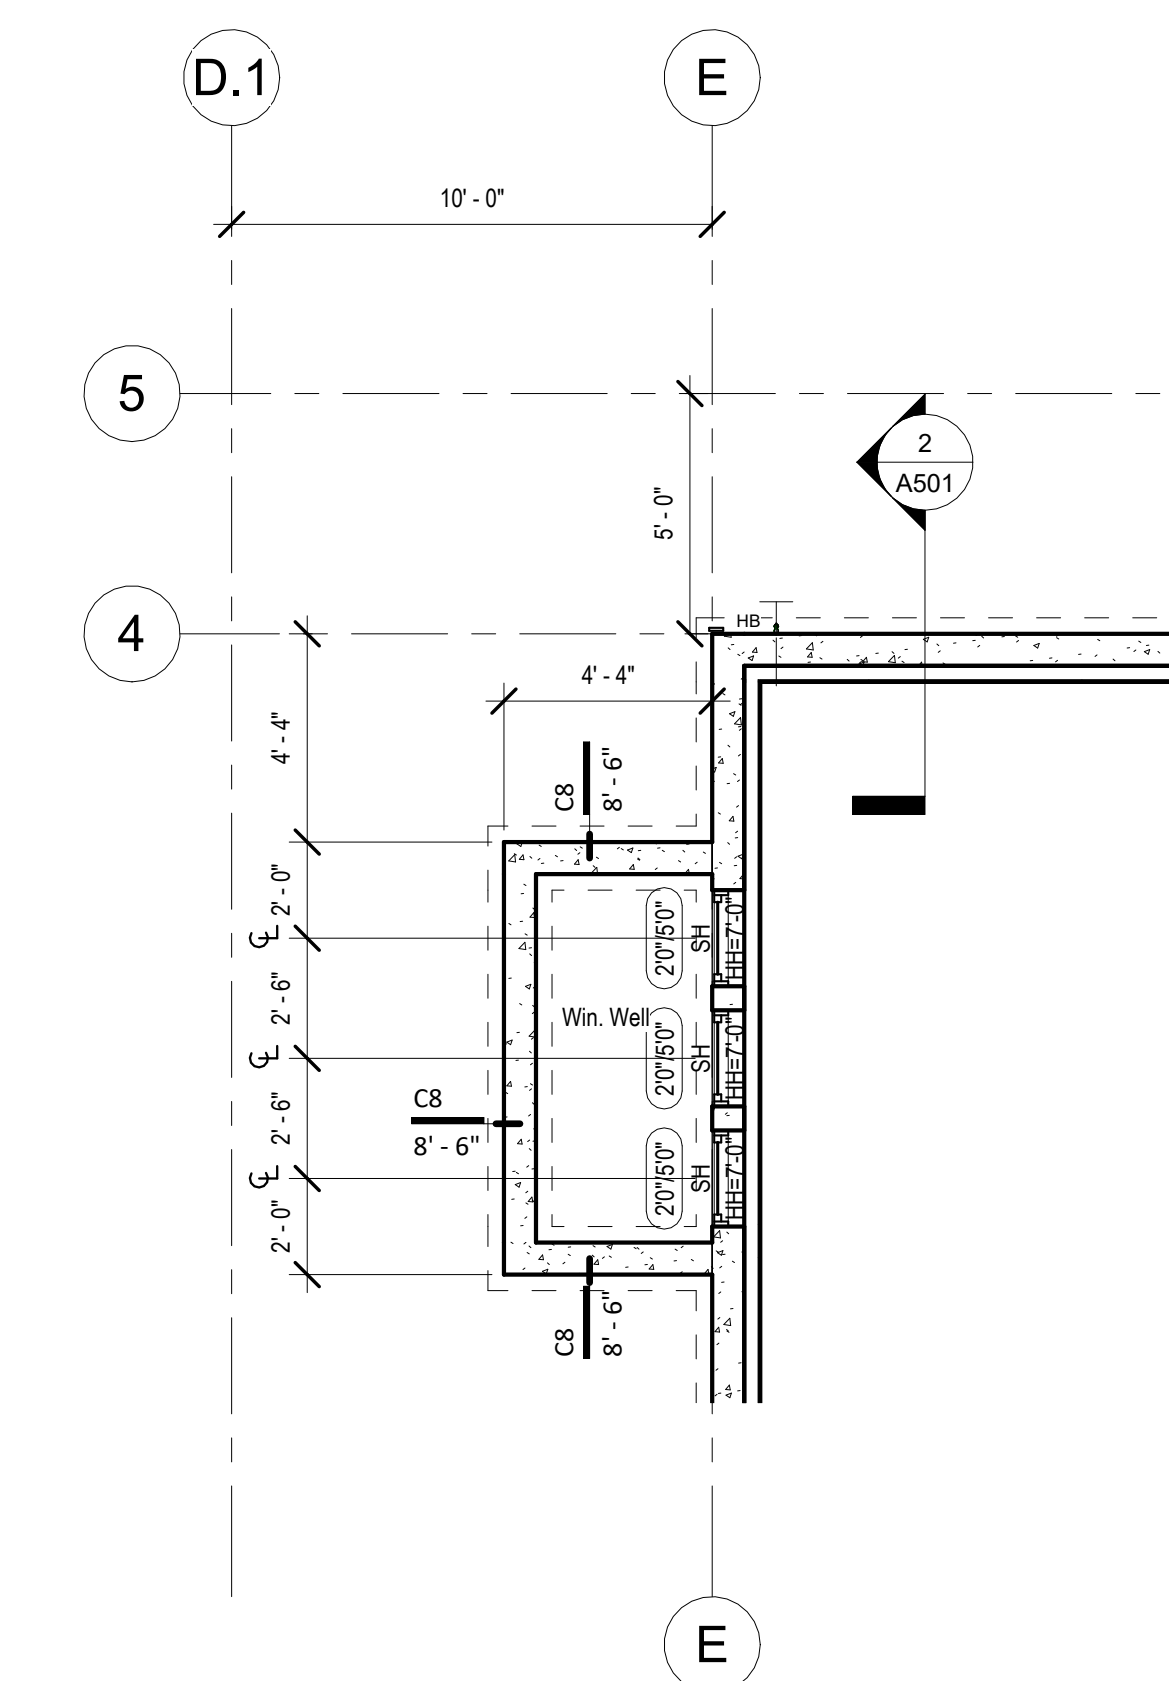

4 Basement Floor Plan - Extended Rec. Room - Design With Daylight well
1/4" = 1'-0"

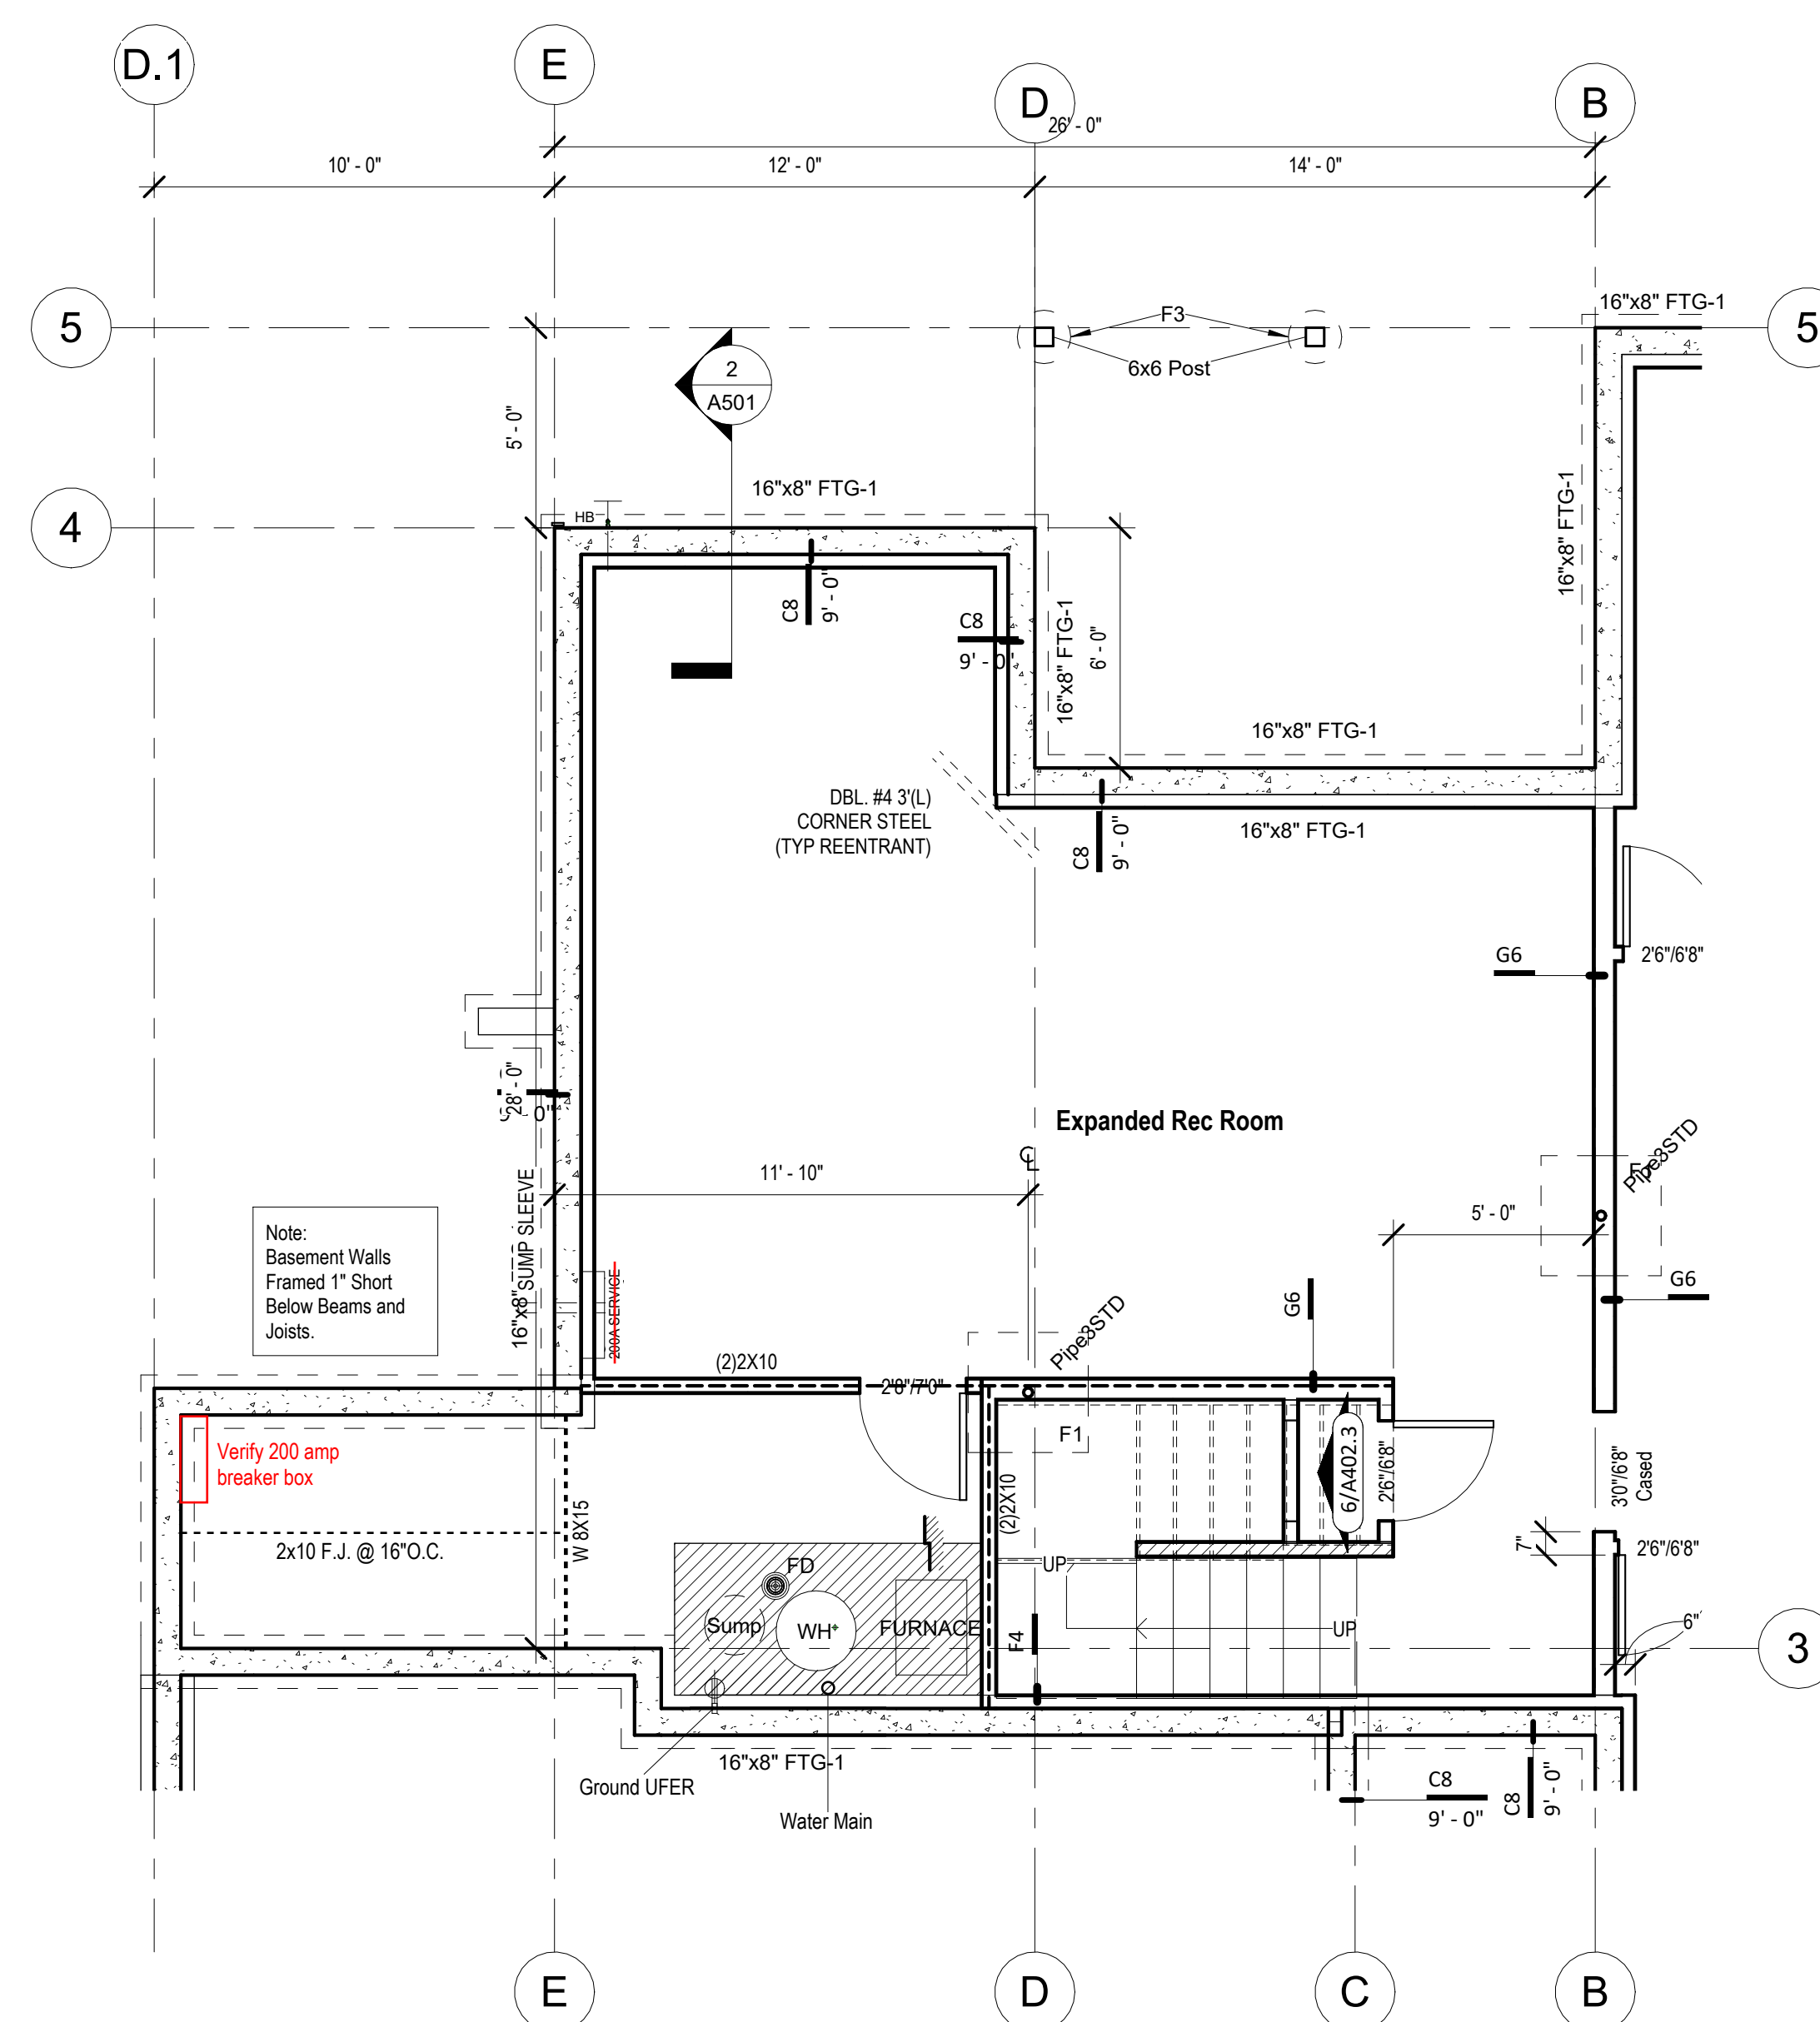

① Basement Floor Plan - Extended Rec. Room - Design
1/4" = 1'-0"



Greystone - Masterplan

architect:
Elevate Design + Build
1040 SW Luttrell Road
Blue Springs, MO 64015
816.622.8826 voice
www.elevatedesignbuildkc.com

UNLESS A PROFESSIONAL SEAL WITH SIGNATURE AND DATE IS
AFFIXED, THIS DOCUMENT IS PRELIMINARY AND IS NOT INTENDED
CONSTRUCTION, RECORDING PURPOSES OR IMPLEMENTATION



JANUARY 1, 2025

[illegible]

PROJECT

Address: 2623 SW Firefly Lane,
Lees Summit, MO
Lot: 168 Hook Farms 2nd Plat


DRAWING TITLE
POD Options

DATE ISSUED


DRAWING NUMBER

A715


RELEASE FOR CONSTRUCTION
AS NOTED FOR PLAN REVIEW
DEVELOPMENT SERVICES
LEE'S SUMMIT, MISSOURI
01/30/2020

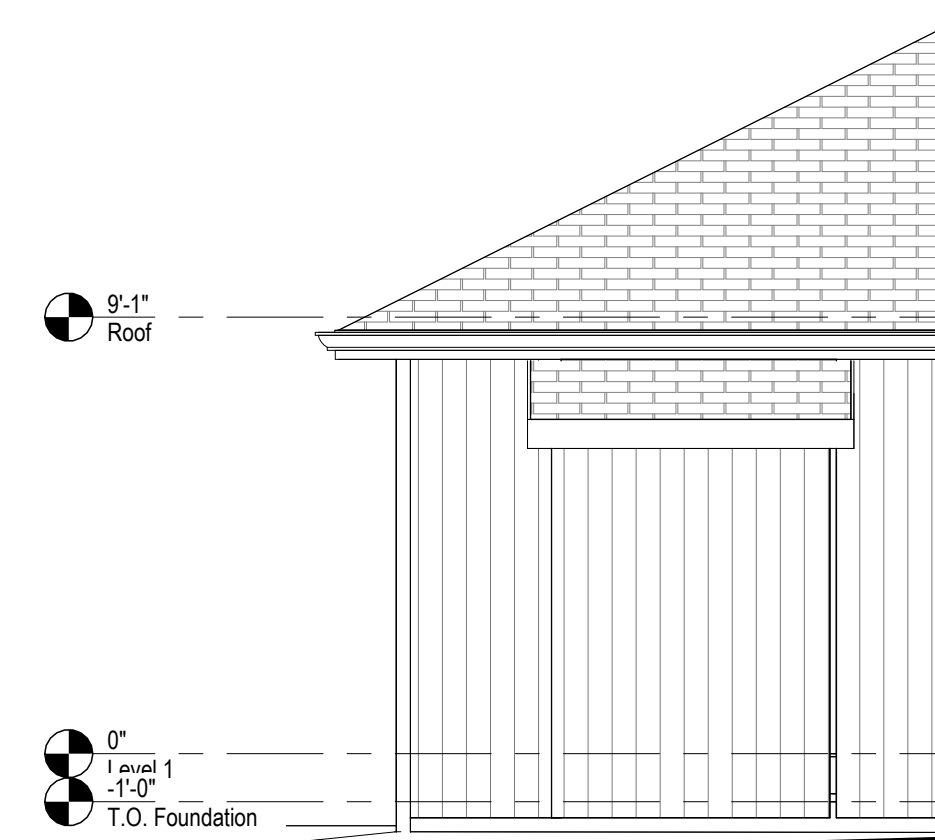


14 Front Elevation - Main Level - Dining - Bumpout Option
1/4" = 1'-0"

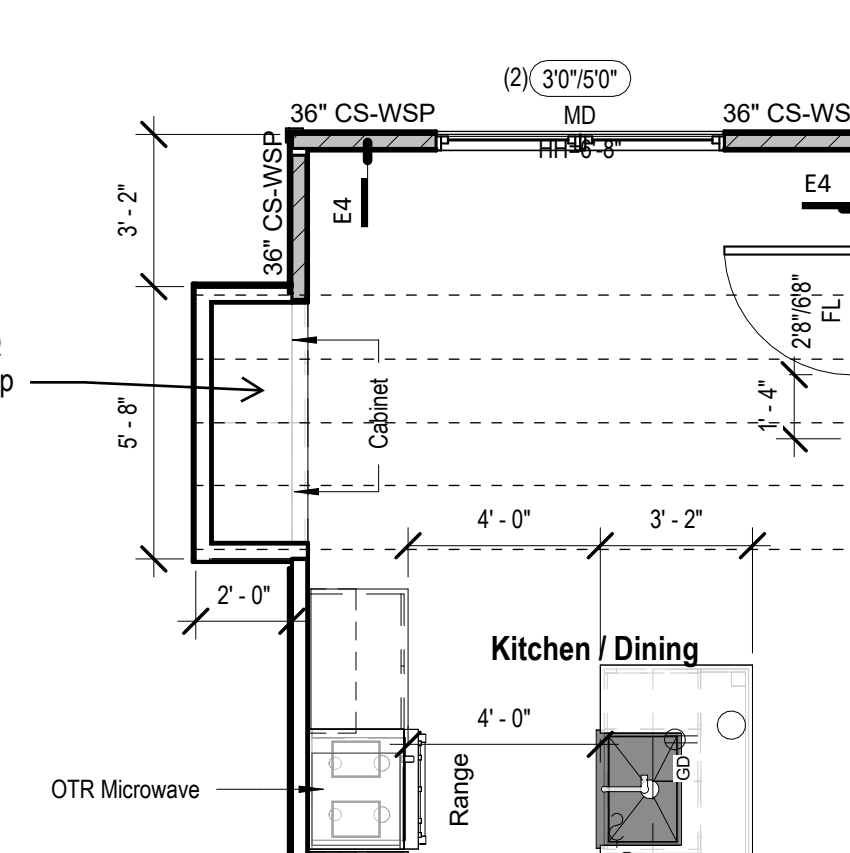


6 Front Elevation - Main Level - Dining - Bumpout Option
1/4" = 1'-0"

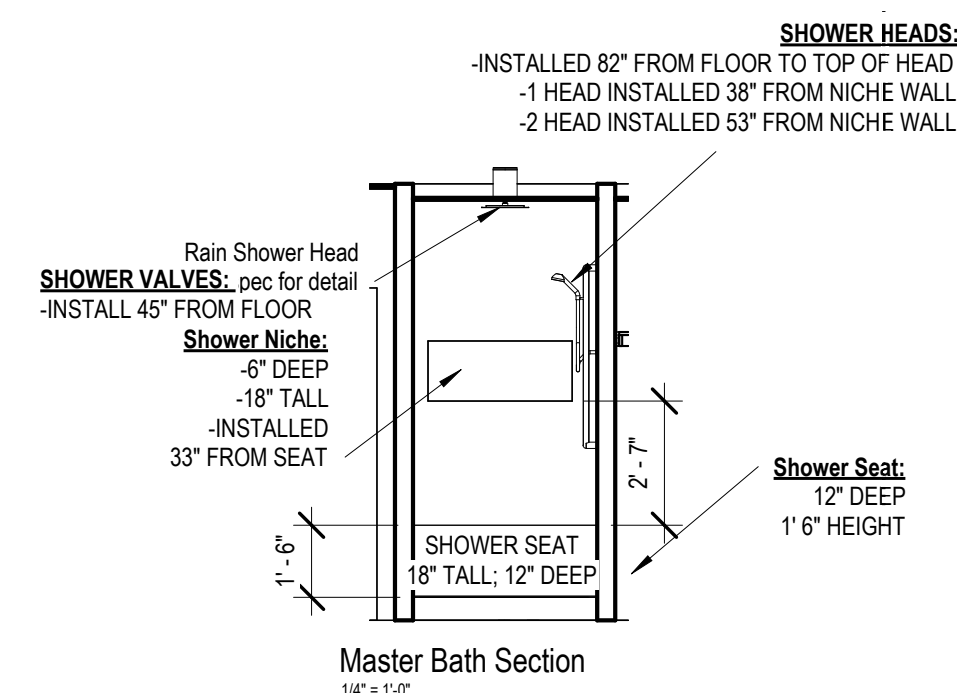


Master Bath Section
1/4" = 1'-0"

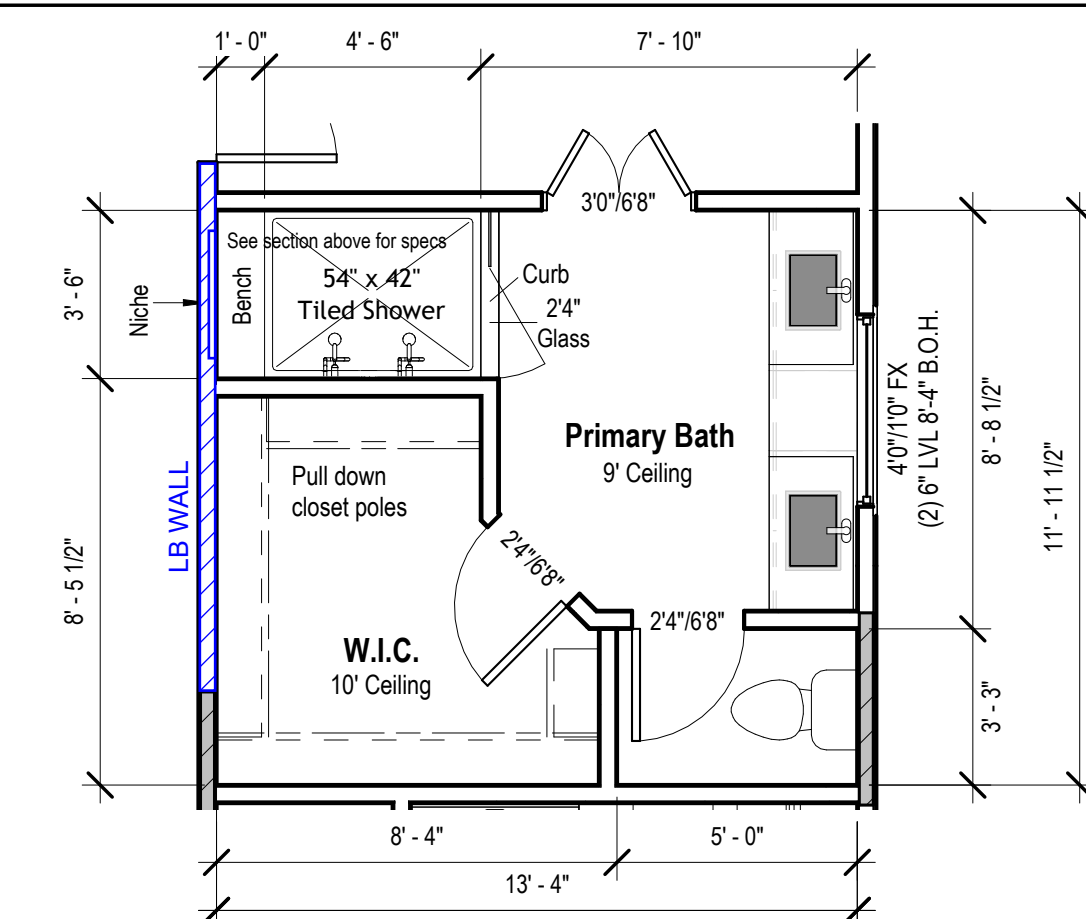


10 Main Level - Primary Bath - Design
1/4" = 1'-0"

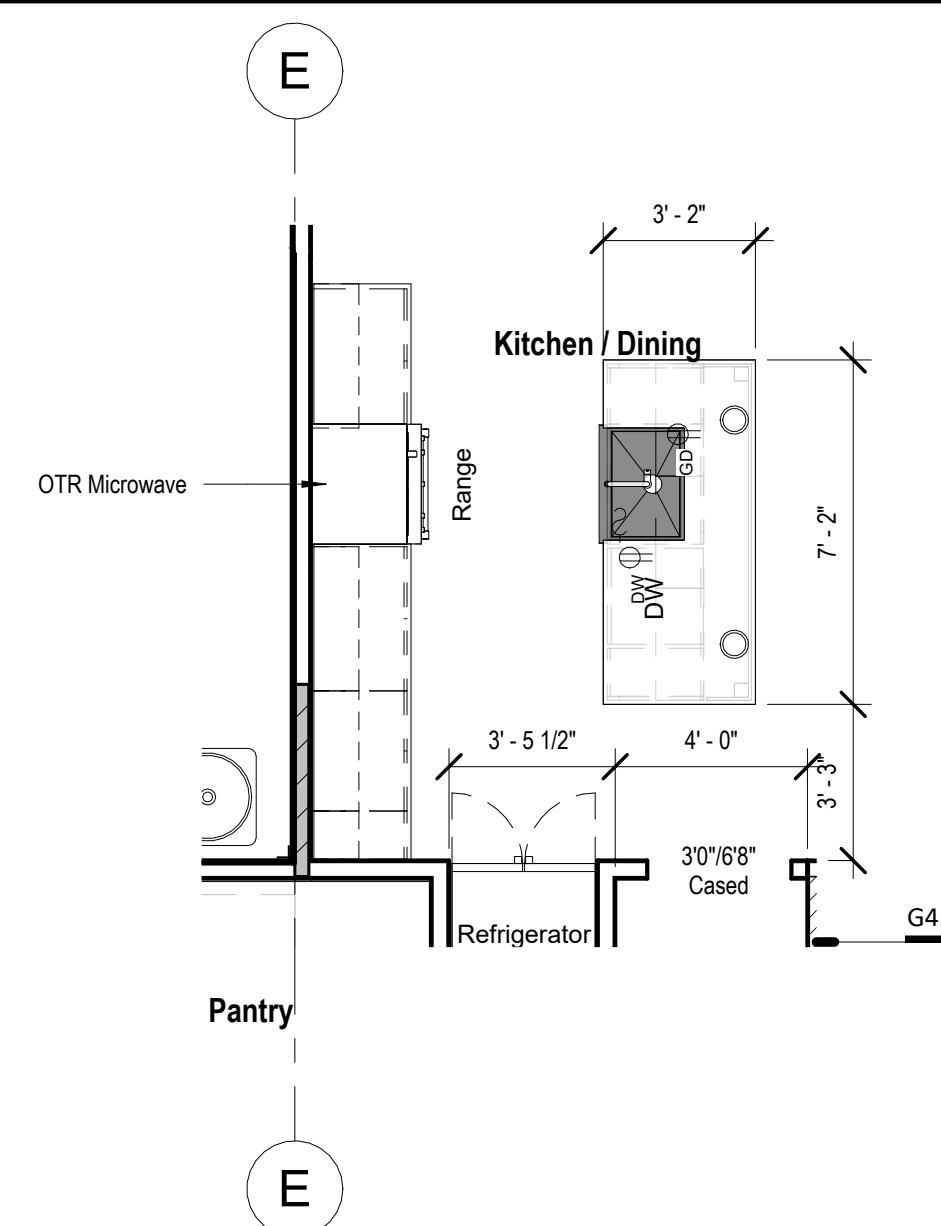


⑤ Floor Plan - Kitchen - W/ 3 Car Garage - W/ Extended Pantry
1/4" = 1'-0"

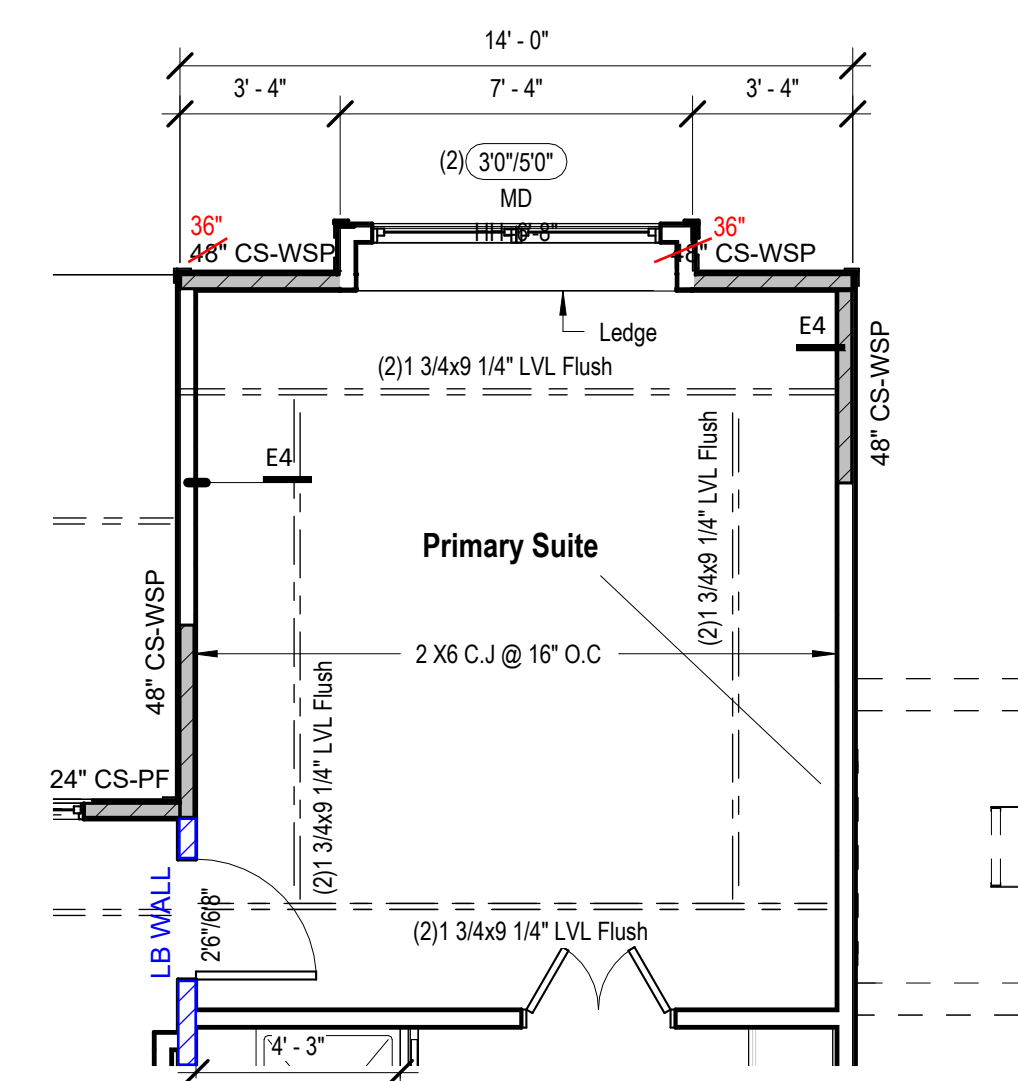

② Floor Plan - Main Level - Primary Suite - Box Vault
1/4" = 1'-0"

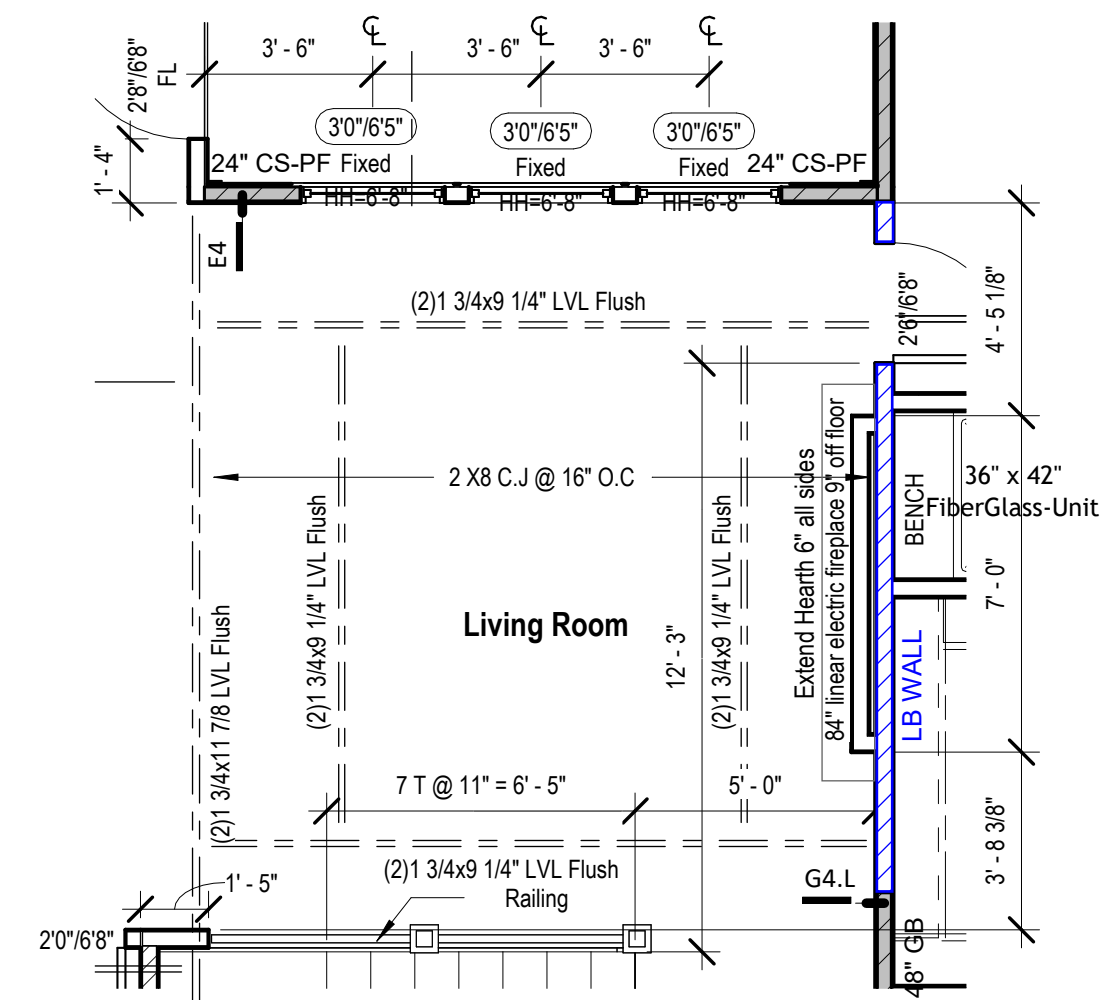

4 Floor Plan - Main Level - Living area - Box Vault & Fire Place Option
1/4" = 1'-0"

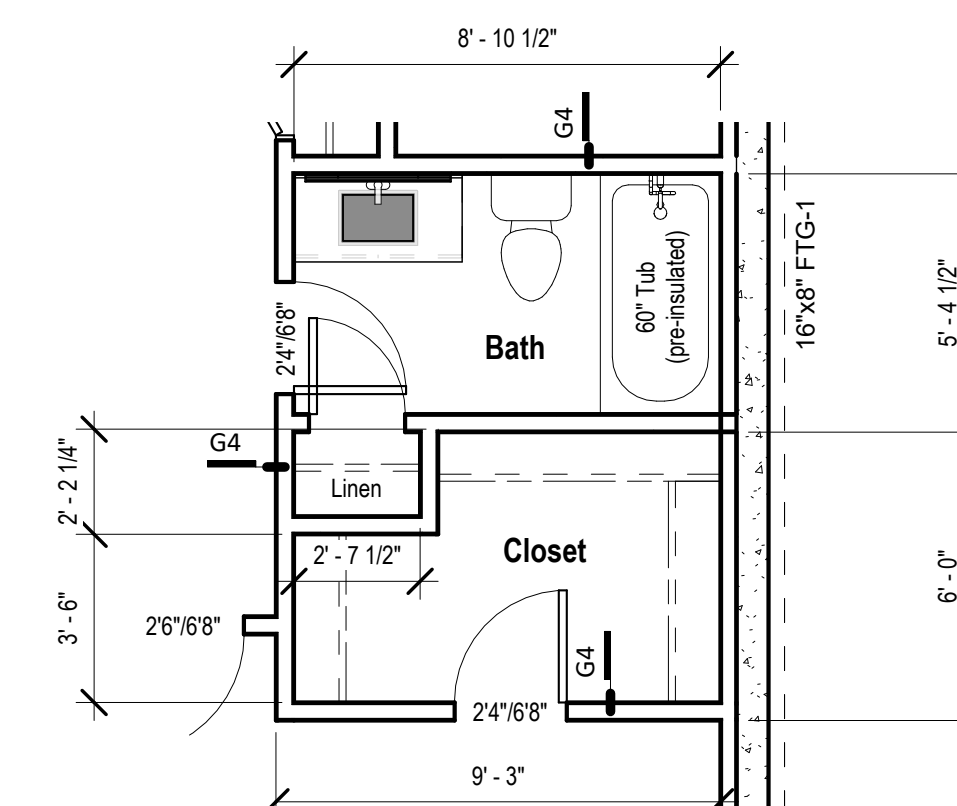

① Basement Floor Plan - Closet POD Option
1/4" = 1'-0"



PROJECT

Address: 2623 SW Firefly Lane,
Lees Summit, MO
Lot: 168 Hook Farms 2nd Plat

DATE ISSUED _____

DRAWING NUMBER

RELEASE FOR CONSTRUCTION
AS NOTED FOR PLAN
DEVELOPMENT SER
LEE'S SUMMIT, MISS

Technical drawings illustrating the construction details of a door threshold and sill plate assembly.

Top Detail (Circular View):

- 6" Saddle Threshold
- Weather resistant sheathing paper lap over flashing.
- Sealant between stoop and flashing.
- EPDM, lap over threshold.
- Metal Flashing lap over EPDM.
- Reinforcement
- Lap EPDM to properly seal around reinforcement.

Bottom Detail (Cross-section):

- Wood Door Frame
- RE elevation for exterior finish
- RE specs for finish floor material
- 3/4" Plywood Subfloor T&G - In perpendicular to floor joists
- Batt Insulation
- Rim Joists (Cont.)
- 2x6 Sill Plate
- 5/8" x 10" (L) "I" SHAPED ANCHORS @ 36" O.C. PROVIDE A.B. WITHIN 21" @ END OF PLATE/CORNERS
- 1" Gap
- Slope 1/4" per 12"
- 6" MIN

Diagram illustrating the cross-section of a wall assembly, showing the exterior finish, insulation, and structural components. The diagram includes the following labeled parts:

- Gypsum Board
- RE elevation for exterior finish
- Blown Fiberglass Insulation
- Weather resistant sheathing paper
- 5/8" x 3 1/2" Base Molding
- 3/4" Plywood Subfloor T&G - Installed perpendicular to floor joists
- Carpet
- 3" Rigid Insulation
- Rim Joists (Cont.)
- 2x6 Sill Plate
- 5/8" x 10" (L) "J" SHAPED ANCHORS @ 36" O.C. PROVIDE A.B. WITHIN 21" @ END OF PLATE/CORNERS
- 8" MIN (Dimension indicating the minimum thickness of the exterior finish)

PER IRC: THE MAX. RISE ALLOWED IS 7.75 INCHES AND THE MIN TEAD IS 10 INCHES MEASURED NOSE TO NOSE

6'-0" MIN HEAD HEIGHT

DOUBLE JOISTS FRAMING AROUND STAIR OPENING

2 x 12 STRINGERS EA. SIDE-PROVIDE MIDDLE STRINGER FOR STAIRS OVER 60" WIDE

1 1/2" DIAM. MIN (2-5/8" MAX) HANDRAIL, SUPPORTED BY WALL BRACKETS @ 48" O.C. MAX.

2'-10"

2 x 4 KNEE WALL W/ 1/2" TYP FOR OCCUPIED SPACE UNDER STAIR

15 RISERS @ 7" = 8'-10"

DOUBLE JOISTS FRAMING AROUND STAIR OPENING

MIN. NOSE OF 3/4" (MAX = 1-1/4")

1. WALL MAY OR MAY NOT BE TAPERED AT THE TOP
 2. MAXIMUM LENGTH OF THIS DESIGN IS 12'-0" AT FULL HT.
 3. LENGTH INCREASE 2'-0" / 12" DROP (TAPER)

7'-0" MAX HT

1'-0" 1'-0"

6" 1'-0"

REIN. W/(1) #4 VERT. @ 4' O.C. / (1) #4 HOR. @ 16' O.C.

#4 E.W. @ 8" O.C. DOWEL L W/ (1) #4 TURNED UP @ 16"

4" PERFORATED PVC DRAIN @ PERIMETER-WRAP IN FIL & GRAVEL SURROUND-RUN DAYLIGHT

ALIGNMENT BEAD

FASTEN 6" ALONG THE EDGES
FASTEN 6" IN THE FIELD

1/8" GAP

Diagram illustrating the roof edge detail with the following components and specifications:

- 4" OC NAIL SPACING
- H2A SIMPSON CONNECTION AT EA OUTLOOKER
- 4" PERIMETER ZONE PANEL FIELD NAILING
- 4" PERIMETER ZONE PANEL EDGE NAILING
- RE: PLAN
- MIN 2x4 OUTLOOKER AT 24" OC
- REQUIRED BLOCKING
- LESSER OF 1/2" OR Z
- 2x GABLE END WALL

Deck Ledger Attachment

- (2) Lags required at EA, and 2" from ends.
- Provide 1 X 4 treated spaced behind EA. lag.
- Provide lags in EA, joist space w/ (2) every other space, 2" from edges.
- MIN size lag is 1/2" diam x 6" length.
- Provide flashing between rim joists & ledger.

Labels:

- Siding
- Flashing
- Lag
- Lag Bolt
- weather to solid blocking
- 2x Blocking
- Blown Fiberglass Insulation
- Gypsum Board
- 2x Cont Plate
- Joists, RE Plan
- 3/4" Plywood Subfloor T&G - Install perpendicular to floor joists
- 3" Rigid Insulation
- Rim board at perimeter (provide 1-1/2" wide member at all deck ledgers)
- Double Top Plate
- Blown Fiberglass Insulation
- Exterior load bearing wall, RE Plan
- 2x Blocking
- Deck pier dia, RE Plan

Dimensions:

- 2'-0"
- 2'-0"

Notes:

- Sheathing shall be continuous at floor with no splices within 2' of top and bottom plates.
- Siding, RE Elevation
- Weather resistant sheathing paper
- P.T. Beam, RE Plans
- Provide Galvanized (GMAX) STD joist hangers at ledger. (All flush connections). Screw hangers to ledger.
- Ledger

Diagram illustrating the structural details of a roof ridge cross-section. The diagram shows two rafters meeting at a central ridge. The ridge is constructed with a 1" AIR SPACE above the rafters, a STRUCTURAL RIDGE PER PLAN, and 2x FURRING (REF SCHEDULE BELOW) on the rafters. A 1/2" PLYWOOD GUSSET AT 36" OC WITH (6) 8D NAILS (3) is shown connecting the rafters. The rafters are labeled Rafter Per Plan.

11 Deck Railing
1/2" = 1'-0"

Technical drawing of a post and beam connection. The drawing shows a cross-section of a wooden post with a beam resting on top. The post is labeled 'P.T. Wood Post, RE Plans'. The beam is labeled 'P.T. Beam, RE Plans'. The connection is secured with bolts and washers. The following dimensions and components are indicated:

- (6) 8d x 1 1/2"
- A35 Angle for beam to beam connection.
- P.T. Beam, RE Plans
 - 2x6 @ 16" o.c. spans to a max 8'-8"
 - 2x6 @ 16" o.c. spans to a max 11'-1"
 - 2x10 @ 16" o.c. spans to a max 13'-7"
- (6) 8d x 1 1/2"
- P.T. Beam, RE Plans
 - (2)2x6 @ Max span 4'-2" between supports
 - (2)2x8 @ Max span 5'-4" between supports
 - (2)2x10 @ Max span 6'-6" between supports
- (4) 8d x 1 1/2"
- (4) 8d x 1 1/2"
- (4) 8d x 1 1/2"
- (4) 8d x 1 1/2"
- A34 Angle at top of post for uplift support.
- (4) 8d x 1 1/2"
- (4) 8d x 1 1/2"
- A34 Angle under each beam for top of post connection and sharing of uplift.
- P.T. Wood Post, RE Plans

[illegible]

Note

- Where adjacent grade is 2'-0" or less a guard is not required.
- Where joist span exceeds 7'-0", provide bridging @ mid-span (as shown)

Note:

All wood used in construction of all decks & railings, etc. to be pressure treated. Apply building paper between decking & joists.

[illegible]

A802



BEAM POCKET DETAIL



WINDOW EGRESS REQUIREMENTS

BEDROOM WINDOW EGRESS MINIMUM FOR A DOUBLE HUNG WINDOW IS 34" CLEAR WIDTH MIN. AND 24" CLEAR HEIGHT MIN. WITH A CLEAR OPENABLE AREA OF 5.7 SQUARE FEET MIN. A CASEMENT OR SLIDER WINDOW MIN. IS 20" CLEAR WIDTH MIN. AND 41" CLEAR HEIGHT MIN. WITH A MIN. 5.7 SQUARE FOOT OF OPENABLE AREA.
OPENING OF EGRESS WINDOW NOT MORE THAN 42" FROM THE FLOOR

SAFETY GLAZING REQUIRED WHERE THE NEAREST EXPOSED EDGE OF THE GLAZING IS WITHIN 24 INCHES OF EITHER VERTICAL EDGE OF THE DOOR IN A CLOSED POSITION AND WHERE THE BOTTOM EXPOSED EDGE OF THE GLAZING IS LESS THAN 60 INCHES ABOVE A WALKING SURFACE, SAFETY OR TEMPERED GLAZING IS REQUIRED.

WINDOWS ARE TO HAVE FALL PROTECTION PER IRC 312.2

1. DWELLING / GARAGE OPENINGS BETWEEN GARAGES AND SLEEPING PURPOSES SHALL NOT BE PERMITTED. OTHER OPENINGS SHALL BE EQUIPPED WITH SOLID WOOD OR STEEL DOORS NOT LESS THAN 1-3/8" THICK OR 20 MIN. DEEP, DOORS, WITH SELF CLOSING DEVICES REQUIRED FOR GARAGE / DWELLING SEPARATION DOORS R302.2.1
2. WHOLE HOUSE MECHANICAL VENTILATION SYSTEM IS REQUIRED FOR ANY DWELLING IN COMPLIANCE WITH IRC M 1505
3. CARBON MONOXIDE DETECTORS REQUIRED IRC R 315
4. STEEL COLUMNS SHALL BE MINIMUM SCHEDULE 40 R407.3
5. DECK SHALL BE BUILT PER TABLES 507.2, 507.2.1, 507.3, 507.6, 507.5.1(2) & (2), 507.5, AND 507.6
6. STUDS SHALL BE CONTINUOUS BETWEEN FLOOR, CEILING AND OR ROOF DIAGRAM R602.3
7. ADDED REQUIREMENTS FOR WINDOW FALL PROTECTION R312.2
8. NEW PROVISIONS FOR ATTACHMENT OF RAFTERS, TRUSSES AND ROOF BEAMS R802.3.1 AND R802.11
9. INSULATION REQUIRED FOR ALL BASEMENT WALLS (INCLUDING UNFINISHED BASEMENTS) N1102.1
10. EXTERIOR WINDOWS / DOORS SHALL HAVE U-FACTOR 0.35 AND GLAZING SHALL HAVE SOLAR HEIGHT GAIN FACTOR OF 0.40 N1102.1
11. HOUSE LEAKAGE AND DUCT LEAKAGE PERFORMANCE STANDARDS EFFECTIVE JANUARY 1, 2014. A SAMPLE TESTING PROGRAM WILL BE IMPLEMENTED OCTOBER 1, 2012 KCBRC N1102.4.1.2 AND N1103.2.2
12. LIGHTING FIXTURES PENETRATING THE THERMAL ENVELOPE (E.G. CAN LIGHTS IN ATTIC) SHALL BE IC-RATED, LEAKAGE-RATED AND SEALED TO THE GYPSUM WALLBOARD N1102.4.4
13. PROGRAMMABLE THERMOSTAT REQUIRED N1103.1.1
14. AIR HANDLING SHALL BE RATED FOR MAXIMUM 2% AIR LEAKAGE RATE N1103.2.2.1
15. BUILDING CAVITIES USED AS RETURN AIR PLENUMS SHALL BE SEALED TO PREVENT LEAKAGE ACROSS THE THERMAL ENVELOPE KCBRC N1103.2.2
16. CERTAIN HOT WATER PIPES SHALL BE INSULATED N1103.4
17. ALL EXHAUST FANS SHALL TERMINATE TO BUILDING EXTERIOR M1507.2
18. MAKEUP AIR SYSTEM REQUIRED FOR KITCHEN EXHAUST HOODS THAT EXCEED 400CFM M1503.4
19. BUILDING CAVITIES IN A THERMAL ENVELOPE WALL (INCLUDING THE WALL BETWEEN THE HOUSE AND THE GARAGE) SHALL NOT BE USED AS RETURN AIR PLENUMS
20. AN AIR HANDLING SYSTEM SHALL NOT SERVE BOTH THE LIVING SPACE AND THE GARAGE M1601.6
21. A CONCRETE - ENCASED GROUNDING ELECTRODE ('UFER' GROUND) CONNECTIONS SHALL BE PROVIDED TO THE ELECTRICAL SERVICE E3608.1
22. COMPLIANCE WITH THE REQUIREMENT AND SHOW CONNECTION AS NEEDED FOR ROOF BEAM, TRUSS, RAFTER AND GROUND CONNECTION FOR UPLIFT PER IRC 802.11. ALL RAFTERS MUST BE IN COMPLIANCE WITH IRC 802.11 AMENDED RAYMORE CODE.

OVERHEAD GARAGE
MEET DASMA 115
REQUIREMENTS

A diagram showing the elevation of a rectangular object. The object is a square with a width of 3'-0" and a height of 3'-0". The dimensions are indicated by arrows and text labels.

EGRESS WINDOW WELL AS NEEDED PER
SECTION 308 MIN. 3'-0" X 3'-0" WITH LADDER

ALL POINT LOADS SHALL HAVE A MINIMUM OF 2 STUDS UNLESS NOTED OTHERWISE



SECTION

PORTAL FRAME WITH HOLD DOWN

CEILING JOISTS AND RAFTER CONNECTIONS
CEILING JOISTS AND RAFTERS SHALL BE TIED TO ONE ANOTHER PER TABLES R602.3(1)
AND R802.5.1(9) AND THE ASSEMBLY SHALL BE NAILED TO THE TOP PLATE PER R602.3(1)
CEILING JOIST NOT PARALLEL TO RAFTERS USE SUBFLOORING OR METAL STRAPS ATTACHED
TO END OF THE RAFTERS TO PROVIDE A CONT. TIE ACROSS THE STRUCTURE

TABLE 802.5.1(2) THE MAX RAFTER SPAN FOR D.F.L. 2 x 6 RAFTERS #2 GRADE = 14'-1" AND IS THE BASIS OF DESIGN FOR PURLIN PLACEMENT


RAFTER TIES:
1. REQUIRED AT ALL RAFTERS
2. MIN. OF 2 x 4 AND SPACED
NO GREATER THAN 48" O.C.

FOR FULL VAULT

PURLINS:

1. PURLINS NO SMALLER THAN THE RAFTERS THEY SUPPORT
2. PURLINS TO BE CONTINUOUS
3. BRACES SPACED NO MORE THAN 4'-0" O.C.
4. UNBRACED LENGTH OF BRACES SHALL NOT > 8'-0"

ISTS PERP. TO RAFTERS

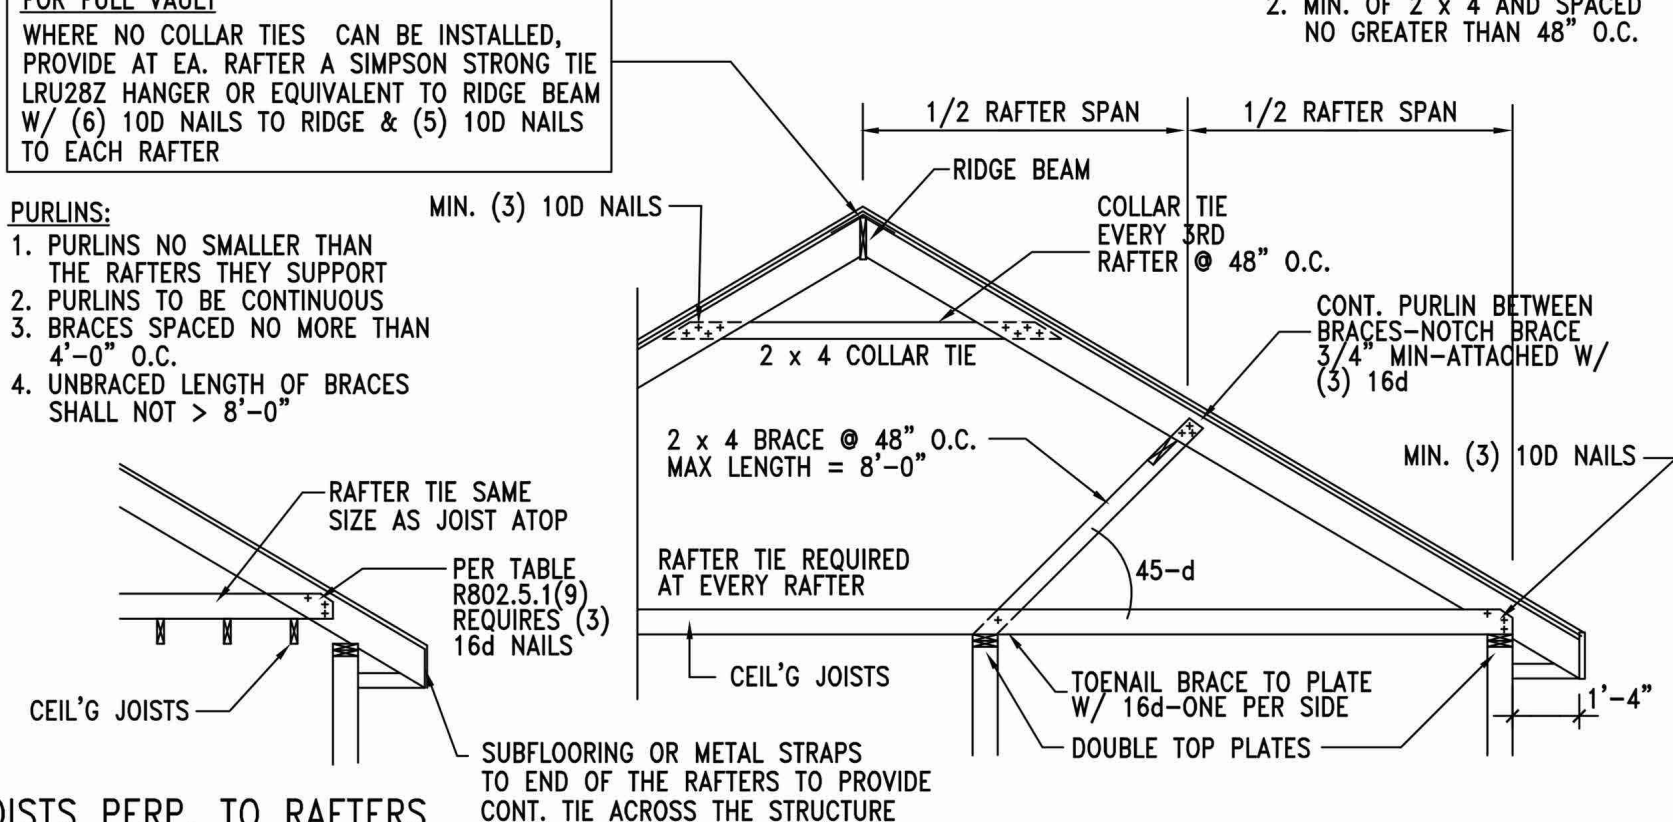

RAFTER/CEILING JOIST HEEL CONNECTIONS
 PROVIDE (5) 16D NAILS AT EACH HEEL JOINT
 (RAFTER-JOIST, RAFTER-TIE) CONNECTION.
 ALSO DENOTED IN DETAIL FOR TYP. ROOF/
 RAFTER FRAMING. THIS MEETS/EXCEEDS TABL
 802.5.1(9) FOR ROOF SPANS UP TO 28'-0"
 MAX. 9/12 PITCH AND RAFTERS 16" O.C.

ALL RIDGE BEAMS TO BE 2 x 12 OR 2 x 10
RAFTER TIES/COLLARS REQUIRED AT ALL LOCATIONS

ROOF FRAMING CONNECTION TO BEAMS

ROOF FRAMING CONNECTION TO BEAMS
WHERE LVL IS BE INSTALLED IN PLANE, PROVIDE SIMPSON STRONG TIE LRU2HZ RAFTER HANGERS EA. RAFTER TO LVL. EACH END OF LVL TO BE SECURED TO SUPPORTING CONSTRUCTION WITH SST LSTA15 OR EQUIVALENT STRAP W/ 1100 LBS. CAPACITY. STRAPPING SHALL BE REQUIRED AT ALL NON-CONT. MEMBERS BETWEEN BEAM & TOP OF FLOOR

TYP. ROOF/RAFTER FRAMING

NTS

UNLESS A PROFESSIONAL SEAL WITH SIGNATURE AND DATE IS
AFFIXED, THIS DOCUMENT IS PRELIMINARY AND IS NOT INTENDED
CONSTRUCTION, RECORDING PURPOSES OR IMPLEMENTATION



JANUARY 1, 2025

REVISIONS

Number	DESCRIPTION	DATE
--------	-------------	------

PROJECT

Address: 2623 SW Firefly Lane,
Lees Summit, MO
Lot: 168 Hook Farms 2nd Plat

DRAWING TITLE

Details

DATE ISSUED

DRAWING NUMBER

A803

01/30/2022

UNLESS A PROFESSIONAL SEAL WITH SIGNATURE AND DATE IS
AFFIXED, THIS DOCUMENT IS PRELIMINARY AND IS NOT INTENDED
CONSTRUCTION, RECORDING PURPOSES OR IMPLEMENTATION



PROJECT


Address: 2623 SW Firefly Lane,
Lees Summit, MO
Lot: 168 Hook Farms 2nd Plat

DATE ISSUED _____

DRAWING NUMBER

A804

RELEASE FOR CONSTRUCTION
 AS NOTED FOR PLAN REVIEW
 DEVELOPMENT SERVICES
 LEE'S SUMMIT, MISSOURI
 01/30/2025

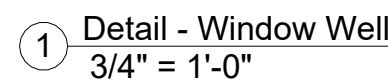

NOTES:

1. PROVIDE MOISTURE RESISTANT GWB IN WET AREAS
2. EXTEND ALL FIRE RATED WALLS STRUCTURE TO STRUCTURE.
3. USE TYPE "X" GWB FOR ALL FIRE RATED PARTITIONS
4. REFER TO ELEVATIONS FOR LOCATIONS WHERE WALL IS NOT FULL HEIGHT. IN THESE CASES CAP THE TOP OF THE WALL WITH A LAYER OF 1/2" GYPSUM BOARD U.N.O.



NOTES:

1. REFER TO ELEVATIONS FOR LOCATIONS WHERE WALL IS NOT FULL HEIGHT. IN THESE CASES CAP THE TOP OF THE WALL WITH A LAYER OF 1/2" GYPSUM BOARD U.N.O.



NOTES:

1. REFER TO ELEVATIONS FOR LOCATIONS WHERE WALL IS NOT FULL HEIGHT. IN THESE CASES CAP THE TOP OF THE WALL WITH A LAYER OF 1/2" GYPSUM BOARD U.N.O.



PARTITION IDENTIFICATION PLAN SYMBOL	E4
BASE PARTITION THICKNESS	4"
STUD SPACING (O.C.)	16"
STUD SIZE	2x4
GWB THICKNESS	1/2"
JOINT SEALANT	Yes
FIRE RATING (HRS)	-
FIRE TEST NUMBER	-
FIRE TEST NUMBER (HEAD OF WALL)	-
FIRE RESISTIVE JOINTS	-
ACOUSTIC RATING (STC)	-
ACOUSTICAL TEST NUMBER	-
	-
INSULATION	Yes
ACOUSTICAL JOINTS	-
	-
	-
	-
REMARKS:	* SEE NOTE #1

