

ORDERED BY: MCFARLAND DALTON BUILDERS LLC

PROPERTY ADDRESS: 2354 SW RIVER TRAIL ROAD

DESCRIPTION: Lot 711, EAGLE CREEK, SIXTEENTH PLAT, a subdivision in the City of Lee's Summit, Jackson County, Missouri.

MDP Lot Designation: Standard / Full Basement


LAND SURVEY COMPANY

Quality since 1959  
P.O. BOX 528, GRANDVIEW, MISSOURI 64030  
PHONE: (816) 966-0839 FAX: (816) 763-1761

RELEASE FOR CONSTRUCTION  
AS NOTED ON PLANS REVIEW  
DEVELOPMENT SERVICES  
LEE'S SUMMIT, MISSOURI  
03/12/2025 4:10:06

CONSTRUCTION STAKE PLOT PLAN  
Lee's Summit Final Grading Certification

6' Privacy fence (xxx)

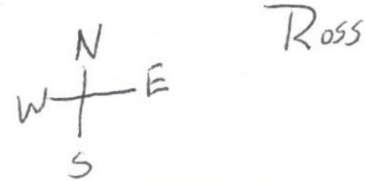

Note:  
Deck approval is required prior to (Future) deck construction.


"AS-GRADED PLOT PLAN IS REQUIRED  
Prior to Sodding"

RELEASE FOR CONSTRUCTION  
AS NOTED FOR PLAN REVIEW  
DEVELOPMENT SERVICES  
LEE'S SUMMIT, MISSOURI  
02/13/2025

Legally signed by  
Brandon Kiewer  
DN: cn=Brandon  
Kiewer, o=Lee's Summit,  
ou=Lee's Summit,  
dc=Lee's Summit, dc=Lee's Summit,  
c=US  
Date: 2025.02.13  
12:41:08 -0600

Brandon Kiewer

Equipment Piled 35' from Pool

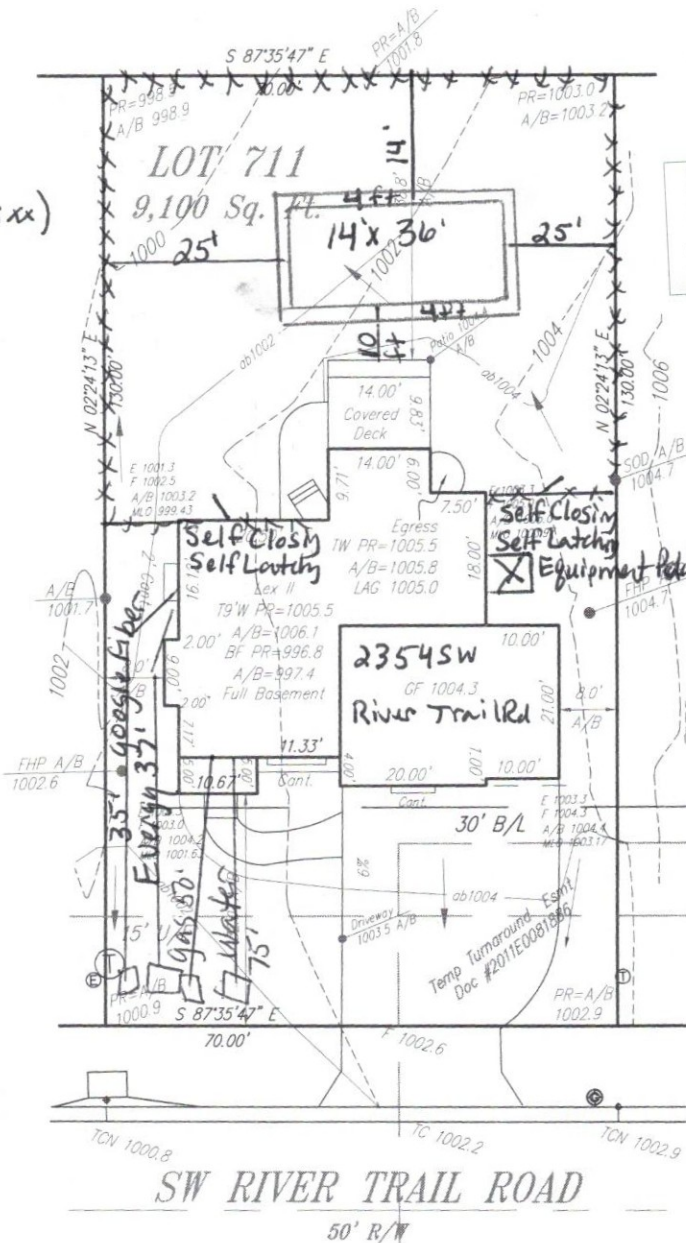

SW RIVER TRAIL ROAD

50' R/W



SCALE: 1"=20'  
DATE: 8/21/23  
FINAL: 2/12/25



J. BERNARD BALDUS, MPLS # 2445

Attention: This Plot Plan was prepared for use before and during foundation construction ONLY. This house is staked as shown on this drawing. The Contractor is to check and verify house dimensions and elevations at the job site. We are not responsible for unknown or unplatted easements of any kind unless we are furnished with the description of said easement prior to our field work being performed. Elevations shown hereon are for a guide only, and final elevations are the responsibility of the on-site Contractor. Unless otherwise noted, THIS IS NOT AN AS-BUILT SURVEY and we can not guarantee the construction of anything shown on this "Plan". Boundary and Improvement Surveys and "As-Built" Grading Certifications serve the purpose of showing "Actual" construction.