



AS GRADED PLOT PLAN

Ordered by: Elevate Design and Build
 Description: Lot 177 Hook Farms 2nd Plat, Lee's Summit, MO.
 Address: 2619 SW Barley Field Dr.
 Lot Area 10140 sf

RELEASE FOR CONSTRUCTION
 AS NOTED FOR PLAN REVIEW
 DEVELOPMENT SERVICES
 LEE'S SUMMIT, MISSOURI
 03/31/2025

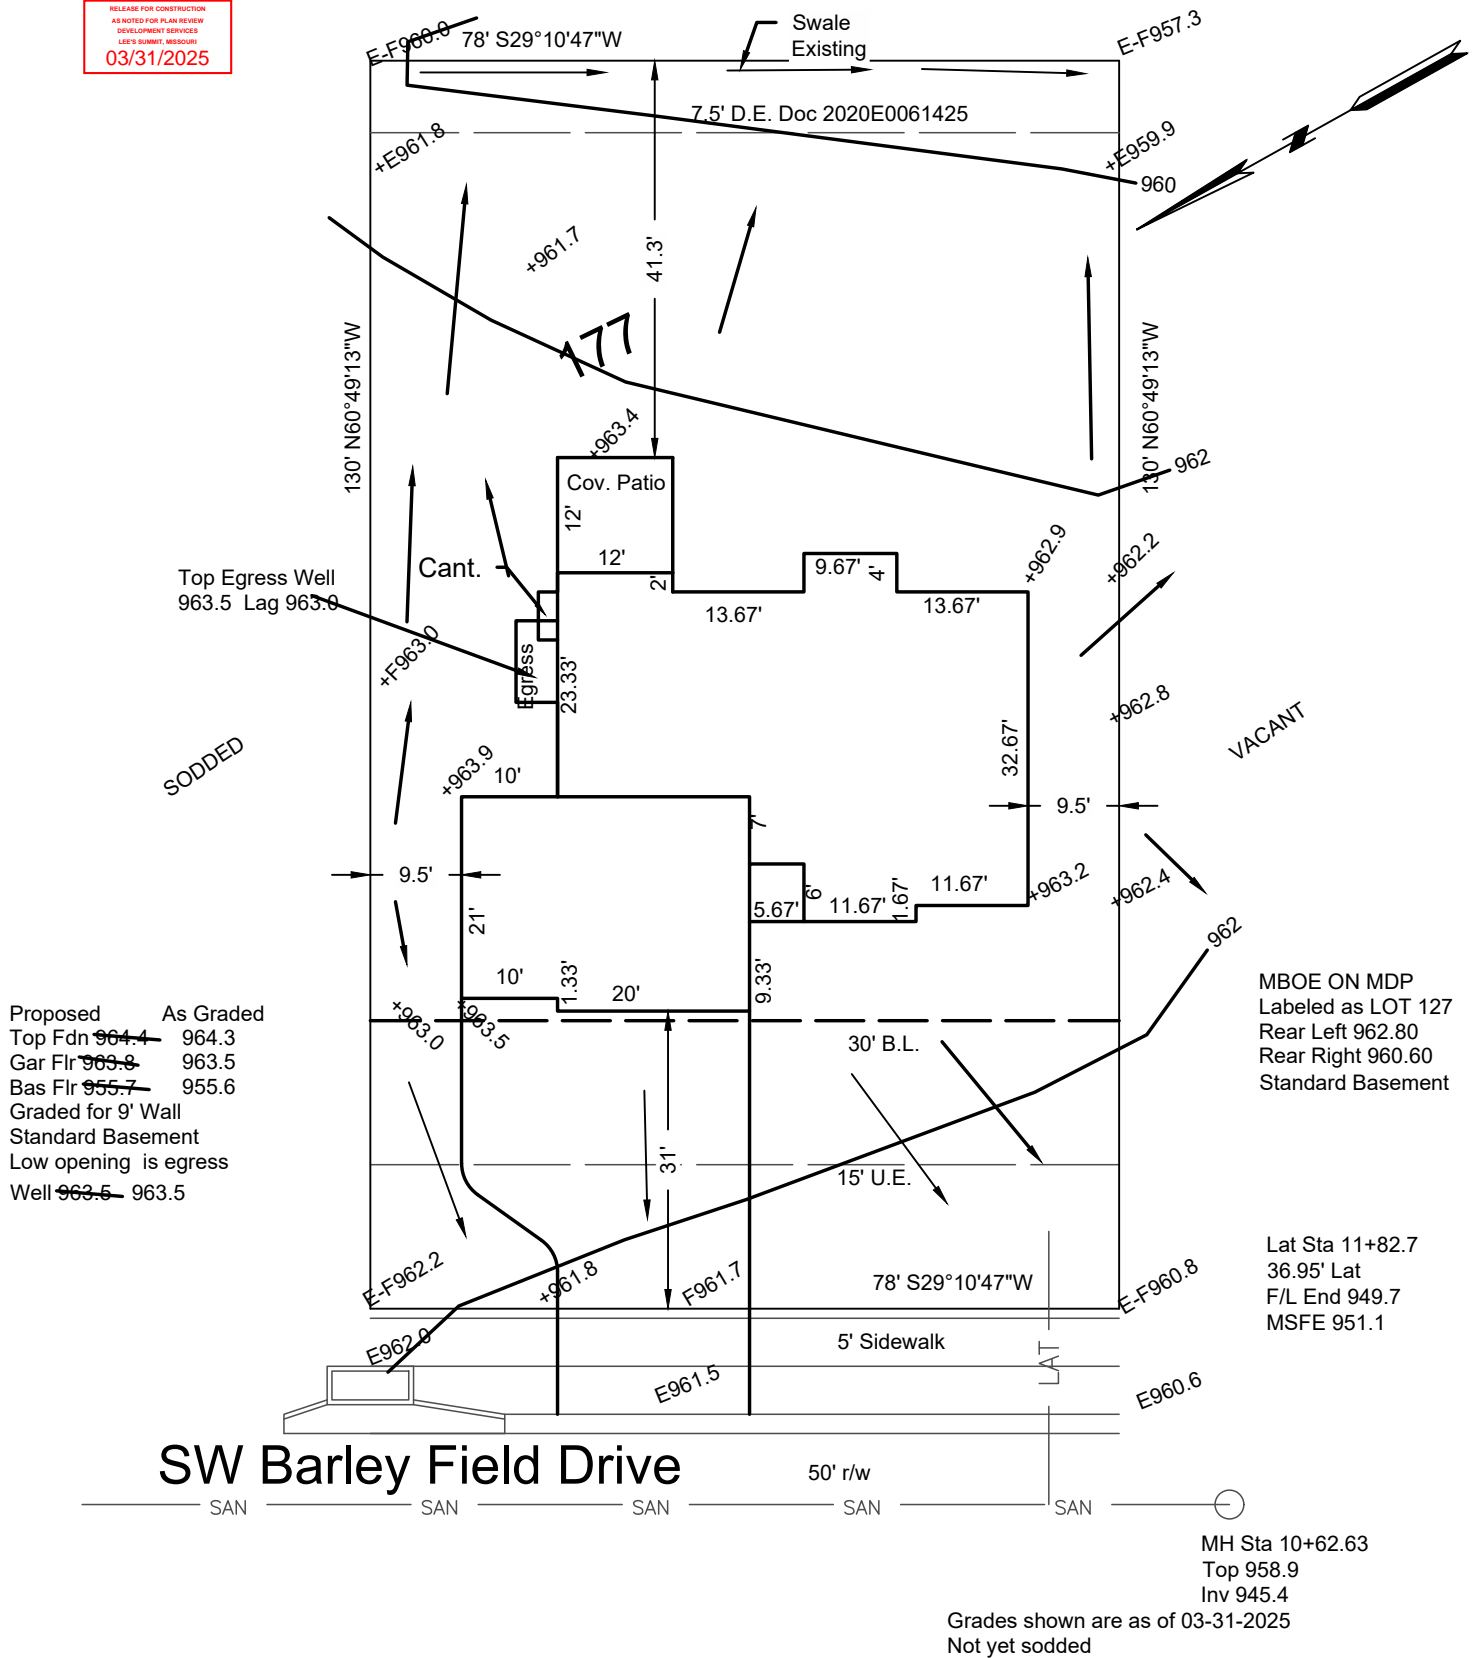

→ = DRAINAGE PATTERN

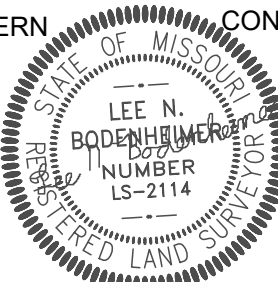

CONSTRUCTION ENGINEERING SERVICES, INC.
 16810-C East 40 Highway
 Independence, MO 64055
 (816)478-2323
 lee@engineeringkc.com
 SCALE: 1"=20'
 DATE: 10/14/2024 & 03-31-2025
 JOB NO: 19238 & 19385

LEE BODENHEIMER, L.S.
 Land Surveyor