


AS GRADED PLOT PLAN

Ordered by: Elevate Design and Build

Description: Lot 208, The Retreat at Hook Farms, Second Plat, Lee's Summit, MO.

Address: 2230 SW Heartland Court

Lot Area 13746 sf

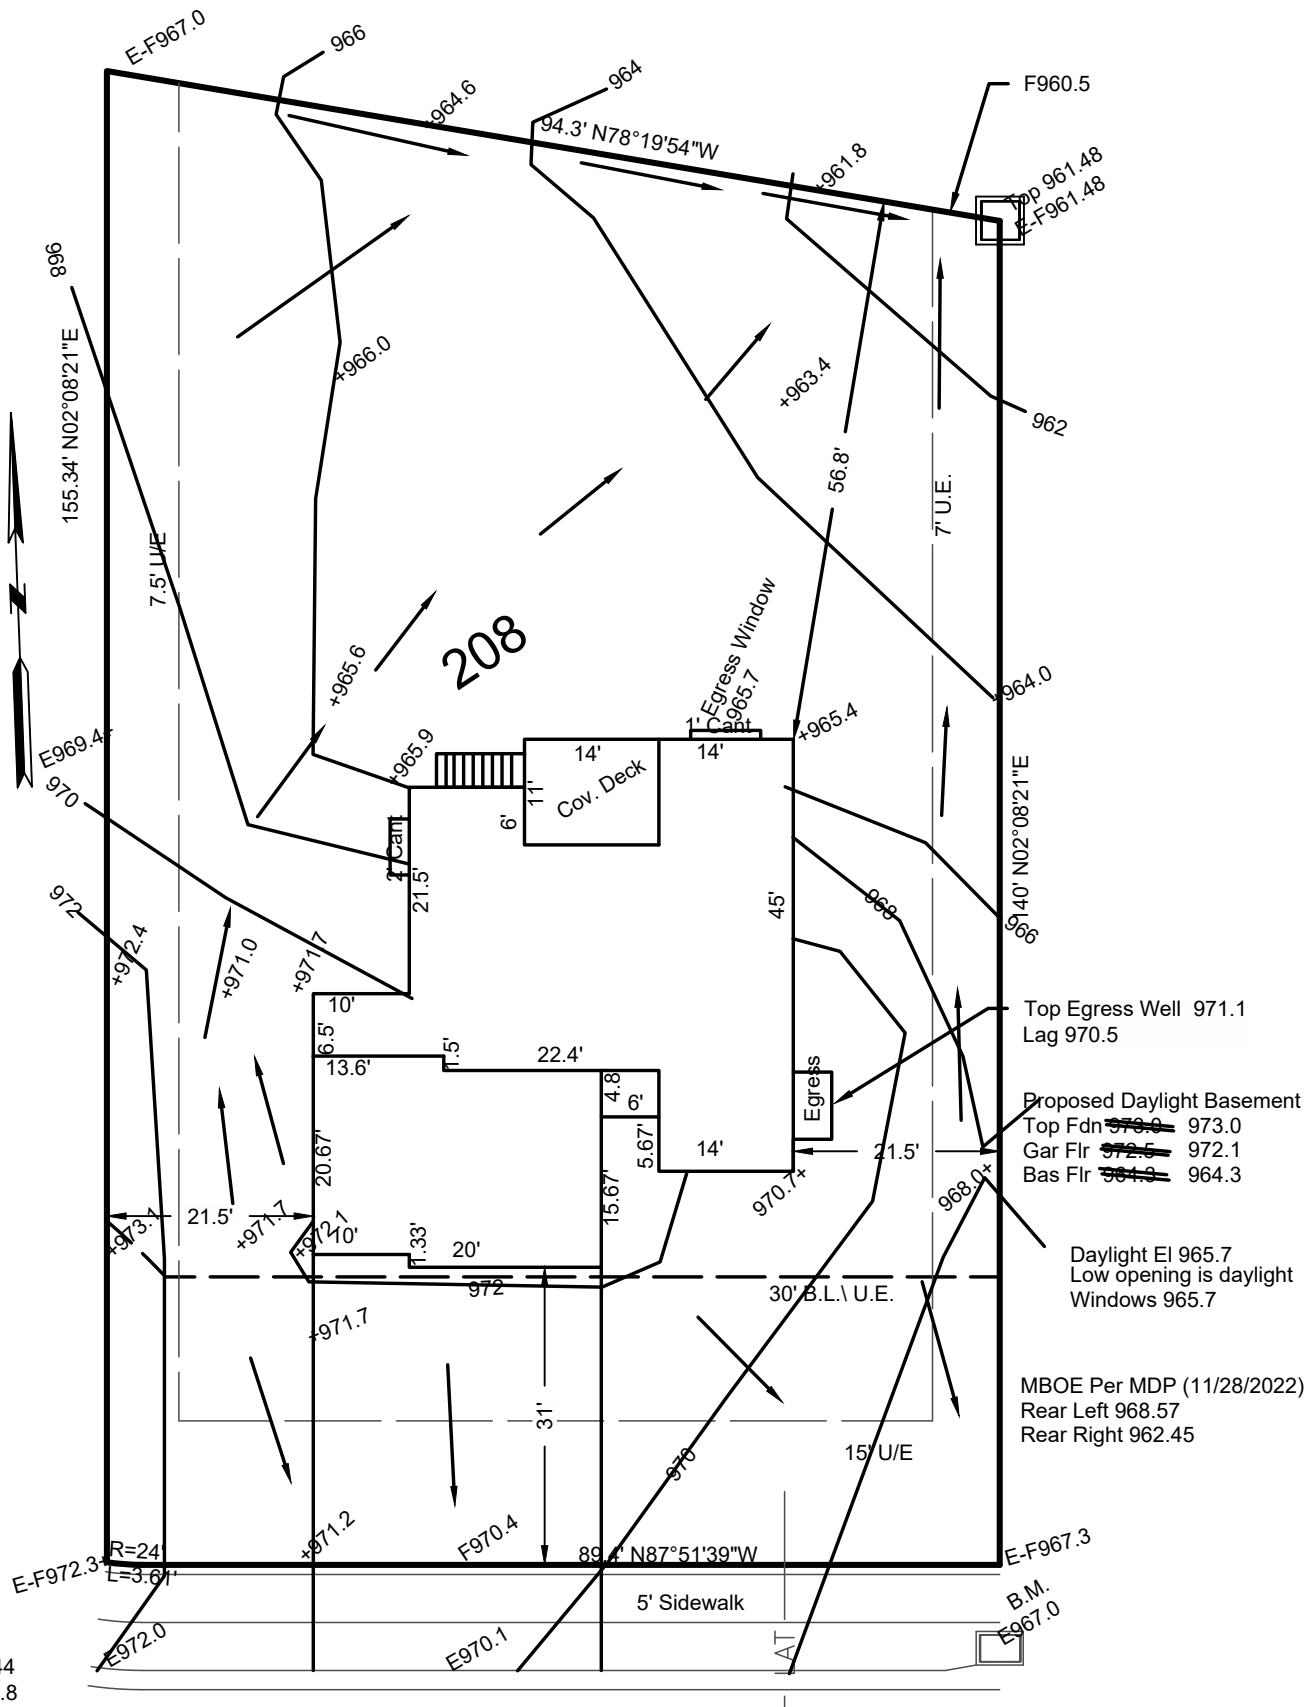


RELEASE FOR CONSTRUCTION
AS NOTED FOR PLAN REVIEW
DEVELOPMENT SERVICES
LEE'S SUMMIT, MISSOURI
04/22/2025

MH Sta 15+25.44
Top 974.59-975.8
Inv 958.69

SW Heartland Court

Lat Sta 13+95.89
40' Lat
MSFE 961.24

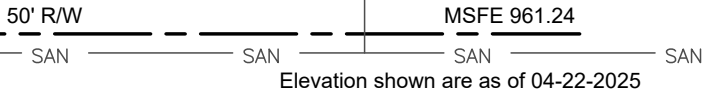


→ = DRAINAGE PATTERN

CONSTRUCTION ENGINEERING SERVICES, INC.

16810-C East 40 Highway
Independence, MO 64055
(816)478-2323
lee@engineeringkc.com

SCALE: 1"=20'
DATE: 10-29-2024 & 04-22-2025
JOB NO: 19202 19411

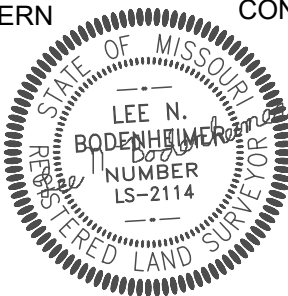

LEE BODENHEIMER, L.S.
Land Surveyor