GENERAL NOTES:

ALL FITTINGS CONFORM TO SECTION 2-4 OF NFPA PAMPHLET 13.

VALVES ON CONNECTIONS TO WATER SUPPLIES, SECTIONAL CONTROL VALVES AND OTHER VALVES IN SUPPLY PIPES TO SPRINKLERS SHALL BE SUPERVISED OPEN BY AN APPROVED METHOD.

IT IS THE OWNERS RESPONSIBILITY TO PROVIDE ADEQUATE HEAT TO KEEP THE SPRINKLER SYSTEM FROM FREEZING.

ALL ELECTRICAL WIRING OF ALARM BELLS, FLOW SWITCHES AND TAMPER SWITCHES (IF REQUIRED) TO BE DONE BY OTHERS.

THE SPRINKLER SYSTEM TO BE INSTALLED IN ACCORDANCE WITH NFPA 13.

HANGERS TO BE SPACED TO MEET NFPA REQUIREMENTS

PER NFPA 13, SECTION 8.6.3.2.4, WITHIN SMALL ROOMS AS DEFINED IN SECTION 3.3.20, SPRINKLERS SHALL BE PERMITTED TO BE LOCATED NOT MORE THAN 9 FT. FROM ANY SINGLE WALL, AND SPRINKLER SPACING LIMITATIONS OF SECTION 8.6.3 AND AREA LIMITATIONS OF TABLE 8.6.2.2.1(a) SHALL NOT BE EXCEEDED. JFS MAY MODIFY HEADS SHOWN ON THIS DRAWING TO COMPLY WITH THIS RULE.

€ = CENTER LINE OF PIPE BELOW TOP OF STEEL

EL = CENTER LINE OF PIPE ABOVE FINISHED FLOOR

DESIGN CRITERIA:

BUILDING CODE: 2018 IBC
OCCUPANCY TYPE: B
CONSTRUCTION TYPE: 2-B
OFFICE/BATHROOMS / DINNING AREAS
PER NFPA 13, 2016 EDITION:
LIGHT HAZARD
225 S.F. SPRINKLER SPACING

STORAGE/EQUIPMENT ROOMS, KITCHEN AREAS, ETC... PER NFPA 13, 2016 EDITION: ORDINARY HAZARD GROUP 2 MAXIMUM 130 S.F. SPRINKLER SPACING

CONSTRUCTION:


STEEL BEAM AND BAR JOISTS

PLAN NOTES:

- 1. ALL GROOVED MAIN PIPING IS TO BE SCHED. 10 PIPE
- ALL GROOVED BRANCHLINE PIPING TO BE SCH. 10 PIPE
 ALL THREADED PIPING TO BE SCH. 40 PIPE
- 4. ALL FITTINGS TO BE DUCTILE IRON
- 5. THIS RENOVATION WILL NOT ALTER THE EXISTING CALCULATIONS THEREFORE NEW CALCULATIONS WILL NOT BE NEEDED.

HANGER SPACING TABLE


NOMINAL PIPE SIZE	34"	1"	1¼"	1½"	2"	2½"	3"	3½"	4"	5"	6"	8"
STEEL PIPE EXCEPT THREADED LIGHTWALL	N/A	12-0	12-0	15-0	15-0	15-0	15-0	15-0	15-0	15-0	15-0	15-0
THREADED LIGHTWALL STEEL PIPE	N/A	12-0	12-0	12-0	12-0	12-0	12-0	N/A	N/A	N/A	N/A	N/A
COPPER TUBE	8-0	8-0	10-0	10-0	12-0	12-0	12-0	15-0	15-0	15-0	15-0	15-0
CPVC	5-6	6-0	6-6	7-0	8-0	9-0	10-0	N/A	N/A	N/A	N/A	N/A

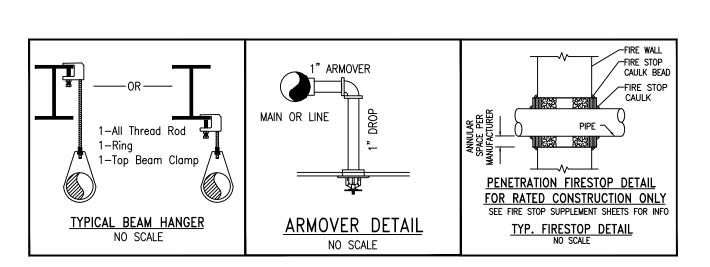

RELEASED FOR CONSTRUCTION

As Noted on Plan Review

Lee's Summit Fire Department Lee's Summit, Missouri 04/25/2025

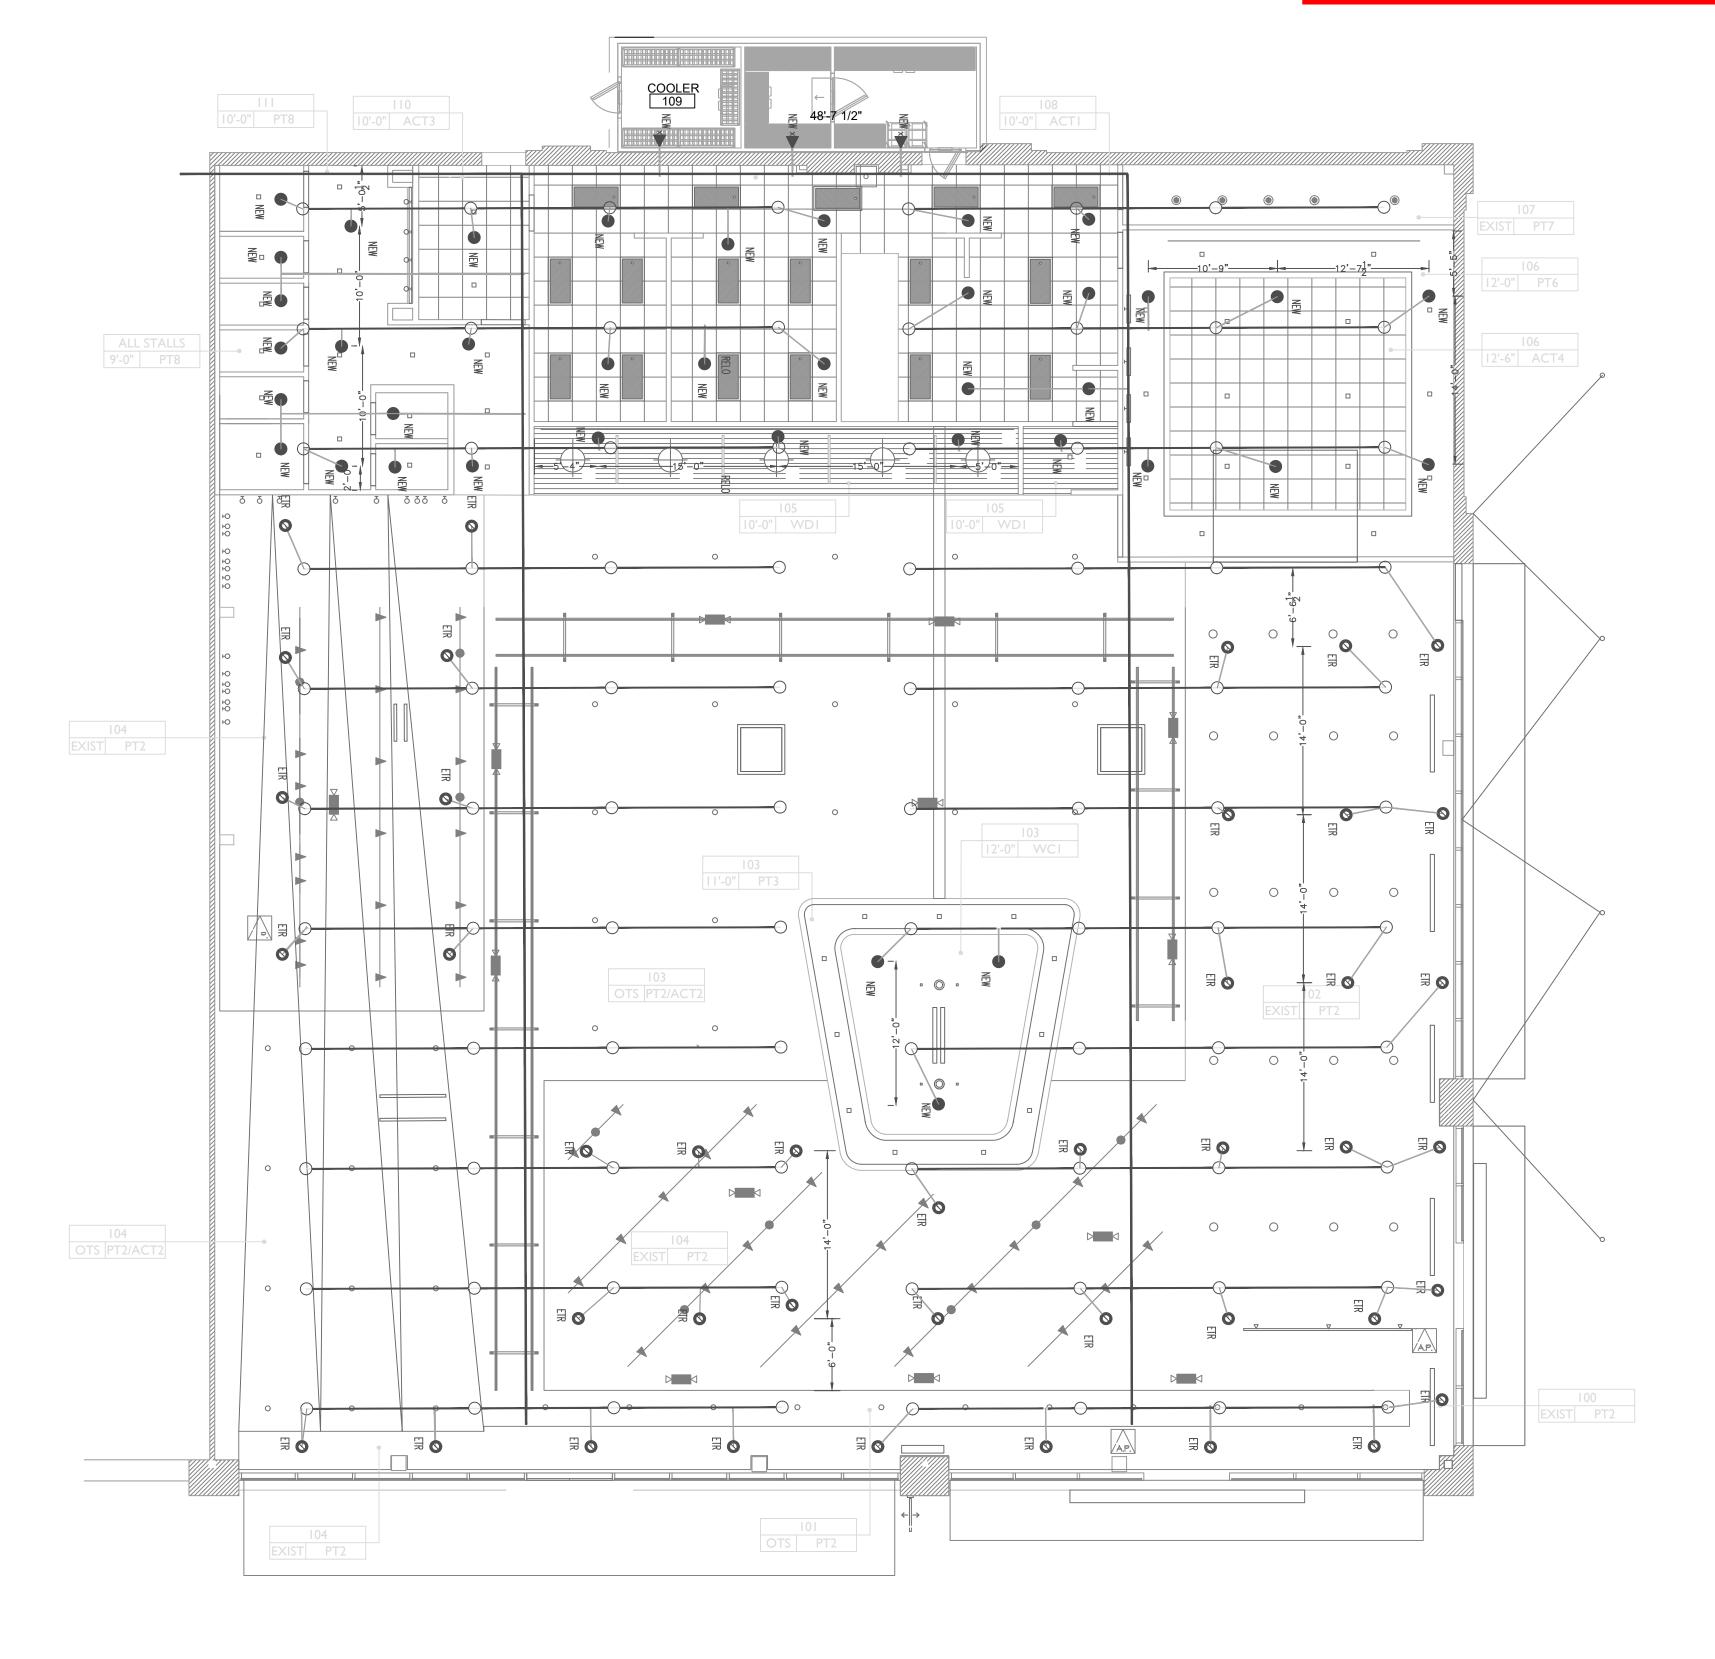



mepengineeringgroup@gmail.com (816)778-1195


	Q								
	Revisions:								
	12 1	Contract No.	Drawn By	D.M.	0 - 10, 7	Scale 1/8" = 1-0	Dc+c 10.17.2024		
COUNT	39	3							
ORIFICE K-FACTOR	5.6	5.6							
ORIFICE	1/2"	1/2"	1/2"	1/2"					
TEMP	155	155	155*	155°					
FINISH	WHITE	WHITE	BRASS	WHITE					
# NIS	RA3415	VS1							
Description	RELIABLE G5-56 QR CONCEALED PENDENT	X VICTOLIC FLEX DRY SIDEWALL	EXISTING UPRIGHT TO REMAIN	EXISTING CONCEALED PENDANT TO REMAIN					
Symbol	•	×							
Description	Hydraulic Reference Points	Elev. Below Top of Steel	Elev. Above Finished Floor	(TOS 20-0) Elev. of Top of Steel	Ceiling Height	Denotes Hanger Location	Rise up or down		
Symbol	0	18 Bts]	[8-6]	(TOS 20-0)	(-0) +	+	0		

All Pipe Locations are to be Field Measured Prior to Fabriand Installation by Sprinkler Contractor.
 All Pipe Dimensions Shown are Center to Center.
 High Temperature Heads are to be Field Located Where Ret.
 All Pipes and Hangers are to be Installed per NFPA #13.
 Hangers are to be U.L. Listed and F.M. Approved.

CKAFI PUII

840-M NW BLUE PARKWAY
LEE'S SUMMIT, MO. 64086

13906 CENTURY LANE
CRAND VIEW, MO 64030
(816) 737-9991

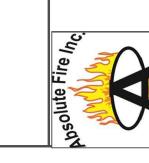

SHEET<u>1</u>OF<u>1</u>

 $\frac{FLOOR \ Plan}{SCALE: \ 1/8" = \ 1'-0"} \qquad \bigcirc$

