


PROPOSED
CONTOURS
AS-GRADED
CONTOURS

X=###.## = Actual asbuilt ground shots
taken on April 16, 2025

Contours shown are asbuilt.

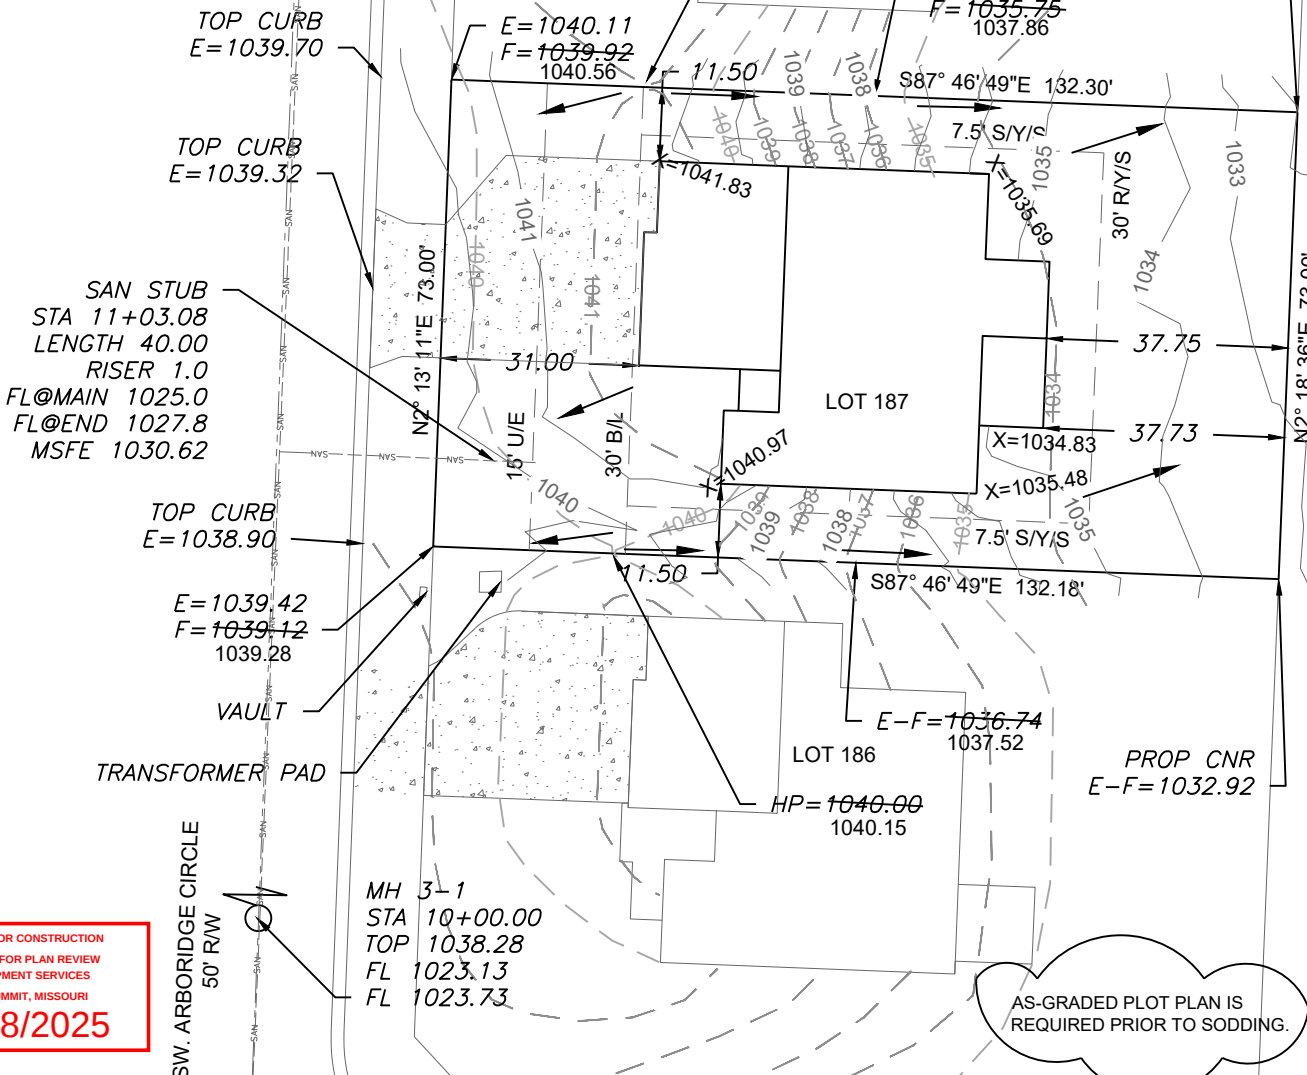

RELEASE FOR CONSTRUCTION
AS NOTED FOR PLAN REVIEW
DEVELOPMENT SERVICES
LEE'S SUMMIT, MISSOURI
04/28/2025

SW. ARBORIDGE CIRCLE
50' RW

LEGEND

- Gas Meter
- Telephone or Fiber-Optic Pedestal
- Cable TV Pedestal
- Electric Pedestal
- Light Pole
- Mailbox
- Fire Hydrant
- Water Valve

PROPOSED HOUSE

TOP FOUNDATION = 1042.50
GARAGE FLOOR = 1041.50
TOP FOOTING = 1034.50
BASEMENT FLOOR = 1034.83
DRIVE SLOPE = 6.3%


E = EXISTING ELEVATION
F = PROPOSED FINAL ELEVATION
G = ADJACENT GRADE AT EGRESS
U/E = UTILITY EASEMENT
B/L = BUILDING LINE
S/Y/S = SIDE YARD SETBACK
R/Y/S = REAR YARD SETBACK

NOTES

- BUILDER TO VERIFY ALL BUILDING ELEVATIONS AND DIMENSIONS.
- THIS PLOT PLAN DOES NOT CONSTITUTE A BOUNDARY SURVEY.
- THE EASEMENTS SHOWN ON THIS PLOT PLAN ARE TAKEN FROM THE FINAL PLAT. EASEMENTS MAY EXIST.

EXTENDED LOT AREA = 10,456.60 SF
DRIVE AREA = 964.1 SF
APPROACH AREA = 239.1 SF
SIDEWALK AREA = N/A


AS-GRADED PLOT PLAN IS
REQUIRED PRIOR TO SODDING.

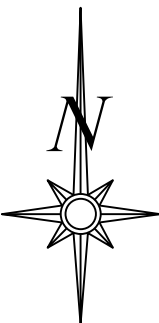

Scale 1"=30'

LOT INFORMATION

9,653 SQ. FT.
REAR LEFT MBOE = 1032.64
REAR RIGHT MBOE = 1033.55
MSFE = 1030.62
ADDRESS
3219 SW ARBORIDGE CIR
LEGAL DESCRIPTION
LOT 187, HAWTHORN RIDGE 3RD
PLAT, A SUBDIVISION AS
RECORDED IN LEE'S SUMMIT,
JACKSON COUNTY, MISSOURI.

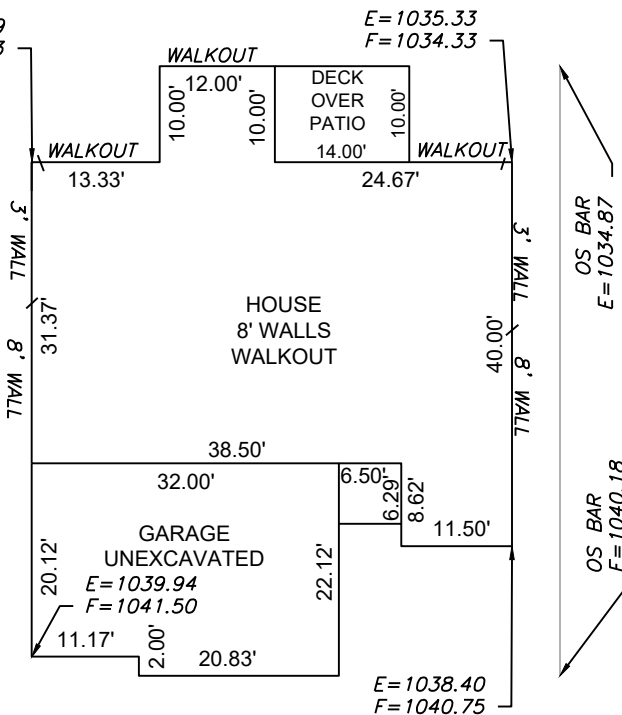


PLAN: SHEFFIELD

Scale 1"=20'

ENGINEERING
ENGINEERING & SURVEYING
SOLUTIONS

50 SE 30TH STREET
LEE'S SUMMIT, MO 64082
P: (816) 623-9888 F: (816) 623-9849
WWW.ENGINEERINGSSOLUTIONS.COM

THIS DRAWING IS NOT VALID UNLESS THE SIGNATURE, DATE AND SEAL OF
THE ENGINEER WHO SUPERVISED THE PREPARATION OF THIS DRAWING HAS
BEEN AFFIXED HERETO.

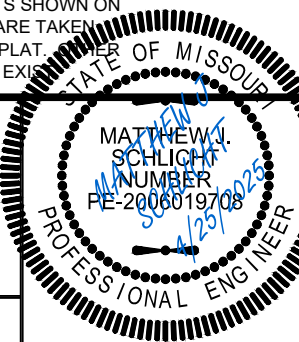

AS-GRADED PLOT PLAN - LOT 187

HAWTHORN RIDGE 3RD PLAT
LEE'S SUMMIT, JACKSON COUNTY, MISSOURI

SUMMIT HOMES
120 SE 30TH STREET
LEE'S SUMMIT, MO 64082

PROJECT NO.	FILE NAME	DATE	SHEET	OF
1	LOT 187, HAWTHORN RIDGE	8/27/24	1	1