# Copyright:

The following documents are the sole property of davidson architecture & engineering, llc for the specific purpose of construction of said building. These documents are considered confidential and subject to davidson architecture & engineering llc's copyright protection. Neither receipt nor possession transfers any rights to reproduce these documents or any part thereof. Any re-use of these documents without the express written permission of davidson architecture & engineering, llc is strictly prohibited and shall confer no liability to davidson architecture & engineering, Ilc.

### Disclaimer:

These documents are accurate to the best of davidson architecture & engineering, Ilc's professional knowledge. In the event a discrepancy in the documents is encountered, it is the responsibility of that party to notify davidson architecture & engineering in a timely manner, for corrections and/or explanation of the documents.

### Site Plan:



# Code Synopsis:

The enclosed documents are reviewed utilizing the currently adopted code for this References to the international existing building code and current equivalents have been noted as applicable.

Governing Municipality:	Lee's Summit, Missouri
Governing Code:	2018 International Building Cor 2018 International Fire Code 2018 International Mechanical 2018 International Plumbing C 2018 International Fuel Gas Co 2017 NEC (w/ Part 8 Rules) ICC/ANSI A117.1-2009

Stories:	one
Building Height:	35'-0"
Building Square Footage:	70,129 s.f.
Tenant Square Footage:	10,128 s.f.
Construction Type:	IIB

Fire Suppression: Occupancy Group:

Unlimited Based on 507.4 Allowable Area:

Occupant Load:
Business 1/150 s.f.
Total:

Drinking Fountain

Exit Width Required:	13.6" (68 x 0.2")

Exit wiath Provided:	4 doors @ 34" clear (2 double doors) = 13
Exit Distance for B Occupancy:	less than 300' (as allowed in sec. 1017.2)

WC requi	ired		WC provi	ded		Tot
men's	women's	unisex	men's	women's	unisex	
1.36	1.36		4	4	1	9
Lavatory required			Lavatory	To		
men's	women's	unisex	men's	women's	unisex	
0.85	0.85		3	3	1	7
1 required	d		1 provide	d		
	men's 1.36 Lavatory men's 0.85	WC required men's women's 1.36 1.36  Lavatory required men's women's	WC required men's women's unisex 1.36 1.36  Lavatory required men's women's unisex 0.85 0.85	WC required WC proving men's women's unisex 1.36 1.36 4  Lavatory required Lavatory men's women's unisex 0.85 0.85 3	WC required women's unisex 1.36 1.36 WC provided men's women's 4 4  Lavatory required men's women's unisex 0.85 0.85 S 3 3	WC required women's unisex 1.36 1.36 WC provided men's women's unisex 4 4 1  Lavatory required Lavatory provided men's women's unisex 0.85 0.85 3 3 3 1

2 provide (1 high-low)

**CS - Planned Commercial Services** 

### Sheet Index:

**Electrical Specifications** 

Electrical Lighting Plan

Electrical Power Plan

E1.1

E2.1

Floor Plan, Reflected Ceiling Plan, Restroom Plan, and Notes Mechanical Specifications Mechanical Plan Mechanical Schedules and Details Plumbing Plan

### Client:

Kidz First Therapy, LLC 2706 NE Independence Ave, Lee's Summit, Missouri 64064 p: 816.446.9018

### Architect:

Powell Minnis, AIA Davidson Architecture & Engineering 4301 Indian Creek Parkway Overland Park, Kansas 66207 p: 913.451.9390

# Mechnical/Plumb. Engineer:

Steve Pond, PE BC Engineers 5720 Reeder Street Shawnee, Kansas 66203 p: 913.262.1772

## Electrical Engineer:

Darin Seidel, PE BC Engineers 5720 Reeder Street Shawnee, Kansas 66203 p: 913.262.1772

### General Contractor:

Capital Construction Services 2642 NE Hagan Road Lee's Summit, Missouri 64064 p: 816.525.0482

# 04.04.2025


architecture&engineering


CONSTRUCTION
As Noted on Plans Review

finish

**AO.O** cover sheet

## Tenant Plan:

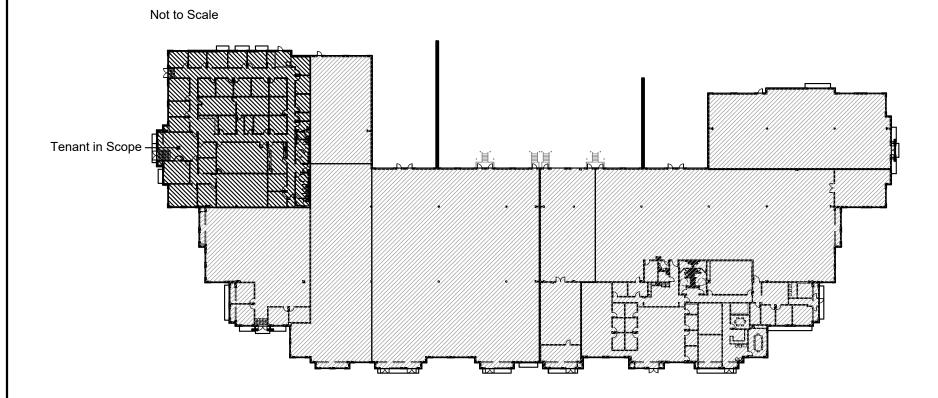

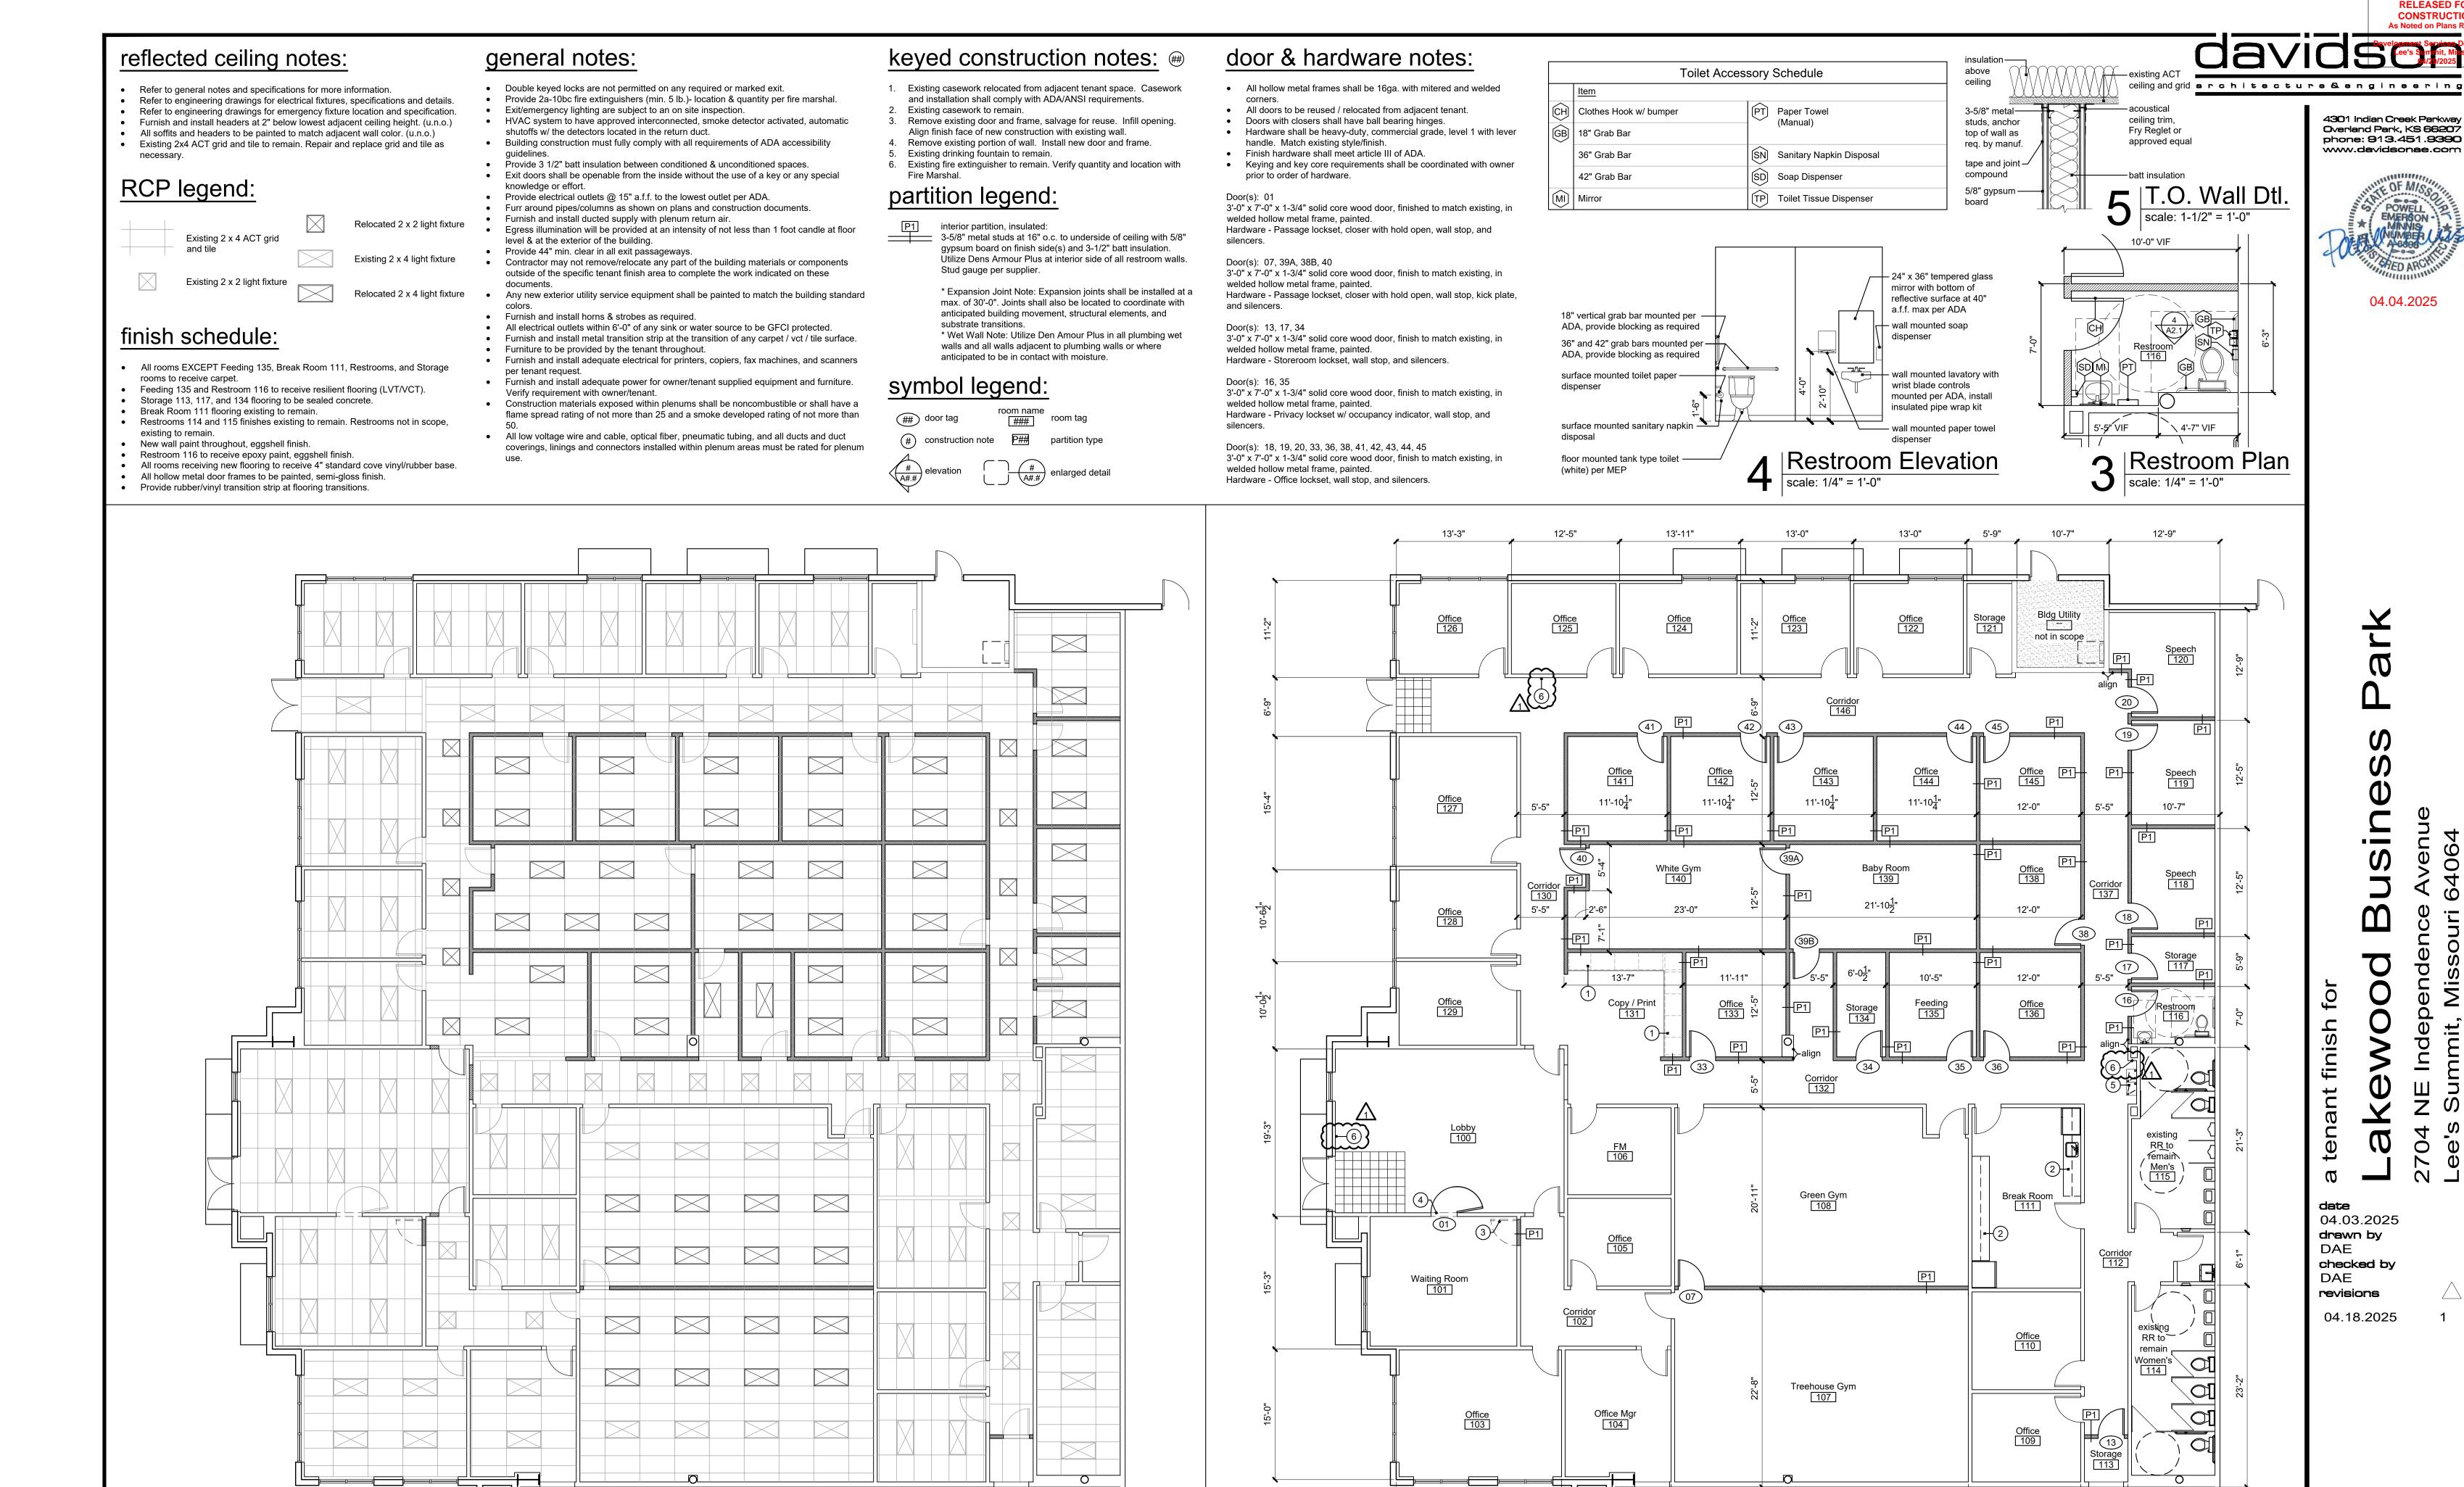

2 Reflected Ceiling Plan scale: 1/8" = 1'-0" north

19'-0"

12'-7"

34'-2"

12'-11"

5'-5"

10'-7"

1 | Floor Plan | scale: 1/8" = 1'-0" | north

04.18.2025 sheet number

CONSTRUCTION As Noted on Plans Review

4301 Indian Creek Parkway

Overland Park, KS 66207

phone: 913.451.9390

www.davidsonae.com

**date** 04.03.2025

**checked by** DAE

revisions

<del>drawn by</del> DAE

**drawing type** permit

A. PROVIDE ALL LABOR, MATERIALS, EQUIPMENT, NECESSARY FOR THE COMPLETE INSTALLATION OF THE

E. DURING CONSTRUCTION, ALL FIXTURES, EQUIPMENT, PIPE, DUCT, ETC, SHALL BE COVERED, PLUGGED.

F. PROVIDE ALL NECESSARY CUTTING AND PATCHING OF WALLS. FLOORS. CEILINGS. AND ROOFS AS

OR CAPPED AS REQUIRED TO KEEP CLEAN AND UNDAMAGED. ALL DAMAGED ITEMS SHALL BE RESTORED

TO ORIGINAL CONDITION OR REPLACED. ALL PROTECTIVE COVERING SHALL BE REMOVED BEFORE FINAL

NECESSARY. PATCH AROUND ALL OPENINGS SHALL MATCH ADJACENT AREA. COORDINATE ALL ROOFING

G. CONTRACTOR SHALL GUARANTEE ALL WORK AND MATERIALS AGAINST DEFECTS FOR A PERIOD OF ONE YEAR

WORK WITH OWNER OR RESPONSIBLE PARTY, SO THAT THE EXISTING ROOFING WARRANTY WILL BE

A. DURING THE COURSE OF CONSTRUCTION, COLLECT AND COMPILE OPERATING INSTRUCTIONS, WIRING

B. ALL LITERATURE AND INSTRUCTIONS SHIPPED WITH THE EQUIPMENT SHALL BE SAVED FOR INCLUSION

C. ALL LITERATURE LISTED ABOVE AND ALL PAPERS LISTING WARRANTIES, ETC. SHALL BE BOUND IN A

A. MANUFACTURERS, MODEL NUMBERS, ETC. INDICATED OR SCHEDULED ON THE DRAWINGS SHALL BE

INTERPRETED AS HAVING ESTABLISHED A STANDARD OF QUALITY AND SHALL NOT BE CONSTRUED AS

BE ACCEPTABLE, SUBJECT TO STRUCTURAL AND ELECTRICAL CONSTRAINTS OF THE PROJECT DESIGN,

LIMITING COMPETITION. ARTICLES, FIXTURES, ETC. OF EQUAL QUALITY BY MANUFACTURERS SHALL

A. ALL PIPING SHALL BE TESTED FOR LEAKS BEFORE BEING CONCEALED IN WALL CONSTRUCTION OR

C. FIRE PROTECTION PIPING SHALL BE TESTED IN ACCORDANCE WITH THE REQUIREMENTS OF NEPA.

B. SEWER AND VENT PIPING SHALL BE HYDROSTATICALLY TESTED WITH NO LESS THAN 10 FEET OF HEAD FOR A PERIOD OF NOT LESS THAN 15 MINUTES, PER THE LOCAL PLUMBING CODE, WITH NO LEAKS.

D. DOMESTIC WATER PIPING SHALL BE HYDROSTATICALLY TESTED AT A PRESSURE OF NOT LESS THAN 1-1/2 TIMES THE OPERATING PRESSURE, BUT NOT LESS THAN 60 PSI, FOR A PERIOD OF NOT LESS THAN 2

E. DUCTWORK AND PIPING SHALL BE BALANCED BY QUALIFIED INDEPENDENT BALANCING PERSONNEL WHO HAVE PREVIOUS EXPERIENCE WITH BALANCING PROCEDURES AND ARE CERTIFIED BY THE ASSOCIATED AIR BALANCE

3-RING BINDER AND LABELED WITH THE PROJECT NAME, ADDRESS, ARCHITECT, ENGINEER,

A. PROVIDE THERMAL OVERLOAD PROTECTION FOR EACH MOTOR PROVIDED BY THIS WORK.

DIAGRAMS, CATALOG CUTS, LUBRICATION AND PREVENTIVE MAINTENANCE INSTRUCTIONS, PARTS LISTS,

C. ALL WORK SHALL BE PERFORMED IN ACCORDANCE WITH ALL APPLICABLE LAWS, CODES AND REGULATIONS

B. OBTAIN ALL PERMITS, FEES, LICENSES, INSPECTIONS, AND CERTIFICATES OF COMPLIANCE OR

D. ALL TESTING REQUIRED BY AUTHORITIES SHALL BE CONSIDERED PART OF THIS WORK.

1. GENERAL PROVISIONS

FROM FINAL ACCEPTANCE.

CONTRACTORS, ETC.

UNLESS NOTED OTHERWISE.

5. TESTING, BALANCING, AND CLEANING:

HOURS, WITH NO LEAKS.

3. MANUFACTURERS:

2. OPERATION AND MAINTENANCE MANUALS:

PLUMBING AND MECHANICAL SYSTEMS OUTLINED.

APPROVAL AS REQUIRED BY THE AUTHORITIES.

OF THE GOVERNMENTAL BODIES HAVING JURISDICTION OVER THE SITE.

ETC. FOR ALL EQUIPMENT FURNISHED UNDER THIS CONTRACT.

IN THE OPERATION AND MAINTENANCE MANUALS.

erchitecture & engineering

4301 Indian Creek Parkway Overland Park, KS 66207 phone: 913.451.9390 www.devideonee.com



CONSTRUCTION As Noted on Plans Review

4/3/25

04.03.2025 drewn by checked by ek/ds revisions

project number

sheet number

disclosure of information contained herein without prior written consent of the Engineer is strictly prohibited. © 2025 BC Engineers, Inc.

14. REMODELING WORK:
A. DEMOLITION: DISCONNECT, DEMOLISH, AND REMOVE ABANDONED MECHANICAL MATERIALS AND EQUIPMENT INDICATED TO BE REMOVED AND NOT INDICATED TO BE SALVAGED OR REMAIN.

B. EQUIPMENT TO BE SALVAGED: 1) DISCONNECT AND REMOVE, EXISTING MECHANICAL EQUIPMENT INDICATED TO BE REMOVED AND SALVAGED. DELIVER EQUIPMENT TO THE LOCATION DESIGNATED BY THE OWNER FOR STORAGE 2) ALL MATERIALS AND EQUIPMENT DESIGNATED TO BE REUSED OR RELOCATED SHALL BE CAREFULLY REMOVED, AND STORED UNTIL NEEDED FOR REMODELING WORK. ALL ITEMS SHALL BE RESTORED TO "LIKE NEW" CONDITION WITH RUST OR CORROSION REMOVED, SURFACE PAINT TOUCHED UP OR REPAINTED AS REQUIRED TO MATCH NEW CONSTRUCTION, AND THOROUGHLY CLEANED AND INSPECTED

ANY ITEMS WHICH BECOME DAMAGED BEYOND REPAIR AS A RESULT OF CONSTRUCTION OR DEMOLITION ACTIVITY SHALL BE REPLACED WITH NEW MATERIAL EQUIVALENT IN EVERY RESPECT . DISPOSAL AND CLEANUP: REMOVE FROM THE SITE AND LEGALLY DISPOSE OF DEMOLISHED MATERIALS AND EQUIPMENT NOT INDICATED TO BE SALVAGED.

D. PROTECT ADJACENT MATERIALS INDICATED TO REMAIN. INSTALL AND MAINTAIN DUST AND NOISE BARRIERS TO KEEP DIRT, DUST, AND NOISE FROM BEING TRANSMITTED TO ADJACENT AREAS. REMOVE PROTECTION AND BARRIERS AFTER REMODELING OPERATIONS ARE COMPLETE.

E. LOCATE, IDENTIFY, AND PROTECT MECHANICAL SERVICES PASSING THROUGH REMODELING AREA AND SERVING OTHER AREAS OUTSIDE THE REMODELING LIMITS. MAINTAIN SERVICES TO AREAS OUTSIDE REMODELING LIMITS. WHERE MECHANICAL SERVICES ARE LOCATED IN A WALL, ETC. TO BE DEMOLISHED, REROUTE PIPING TO NEW OR EXISTING CONSTRUCTION TO MAINTAIN CONTINUITY OF THE SYSTEM. WHEN SERVICES MUST BE INTERRUPTED, INSTALL TEMPORARY SERVICES FOR AFFECTED AREAS. F. REMOVE ALL PIPING TO BE DEMOLISHED BACK TO PIPE MAIN OR EDGE OF PROJECT AREA, AND CAP

G. PIPING AND DUCTS EMBEDDED IN FLOORS, WALLS, AND CEILINGS MAY REMAIN IF SUCH MATERIALS DO NOT INTERFERE WITH NEW INSTALLATIONS. PIPING AND DUCTS TO REMAIN SHALL BE APPROVED BY THE ARCHITECT. REMOVE MATERIALS ABOVE ACCESSIBLE CEILINGS. DRAIN AND CAP PIPING AND DUCTS ALLOWED TO REMAIN ABOVE CEILING OR BELOW FLOOR, CONCEALED FROM VIEW, EXCEPT AS OTHERWISE NOTED. PATCH FLOOR TO MATCH EXISTING.

H. PIPE AND DUCT SHALL BE CONCEALED WITH NEW OR EXISTING CONSTRUCTION WHENEVER POSSIBLE, UNLESS INDICATED OTHERWISE

5) PLUMBING VENTS: FLASH ROOF VENT INTO ROOFING SYSTEM AS REQUIRED BY THE ROOFING CONTRACTOR TO MAINTAIN EXISTING ROOF WARRANTY. ALL PLUMBING VENT TERMINALS SHALL ERMINATE A MINIMUM OF 12" ABOVE ROOF OR EQUAL TO HEIGHT OF PARAPET, WHICHEVER IS GREATER. G. PROVIDE CHROME PLATED ESCUTCHEONS ON ALL PIPE ENTERING FINISHED AREAS.

ELCEN. HANGER SPACING SHALL BE IN ACCORDANCE WITH MSS-SP-69.

SAFING AND CAULK AT EACH END WITH FIRE RESISTANT SEALANT.

8 INSULATION AND DUCT LINING: A. ALL INSULATIONS AND ACCESSORIES SHALL HAVE A FIRE HAZARD CLASSIFICATION WITH A FLAME SPREAD RATING OF NOT OVER 25, A FUEL CONTRIBUTION RATING OF NOT OVER 50, AND A SMOKE

DEVELOPED RATING OF NOT OVER 50, IN ACCORDANCE WITH NFPA. B. PIPE INSULATION - ABOVE GRADE: ) THE PIPING INSULATION USED SHALL HAVE A THERMAL CONDUCTIVITY OF 0.27 Btu PER in/hr\*sqft\*F° OR LESS. 2) FIBERGLASS INSULATION WITH FACTORY APPLIED VAPOR BARRIER, ASJ JACKET, FACTORY APPLIED PRESSURE SEALING LONGITUDE LAP JOINT NO STAPLES ZESTON PREMOLDED PVC FITTING COVERS. INSTALLATION SHALL BE IN ACCORDANCE WITH MANUFACTURER'S RECOMMENDATIONS

3) FLEXIBLE CLOSED CELL ELASTOMERIC THERMAL INSULATION, UNSLIT OR PRESLIT WITH PRESSURE

E. ALL PIPE HANGERS AND SUPPORTS SHALL BE STANDARD PRODUCTS OF GRINNELL, FEE AND MASON, OR

F. SLEEVES

1) PROVIDE, SET, AND PROPERLY LOCATE PIPE SLEEVES AS REQUIRED FOR THIS WORK. ALL SLEEVES

AND TO ACCOMMODATE PIPE INSULATION.
2) INTERIOR PARTITIONS: 16 GAGE GALVANIZED STEEL, PACK BETWEEN PIPE AND SLEEVE WITH FIRE

SHALL BE TWO SIZES GREATER THAN THE PIPE PASSING THOUGH THE WALL OR FOOTING.

SHALL BE OF SUFFICIENT SIZE TO PERMIT PIPE MOVEMENT DUE TO EXPANSION AND CONTRACTION

3) ROOF: PROSET OR EQUAL, MANUFACTURED PVC SCHEDULE 40 PIPE SLEEVE WITH WATERPROOF SEAL.

COORDINATE WITH ROOFING CONTRACTOR AND FLASH AS REQUIRED TO MAINTAIN ROOF WARRANTY.

4) PROTECTION AGAINST CONTACT: METALLIC PIPING, EXCEPT FOR CAST IRON. DUCTILE IRON AND GALVANIZED

STEEL SHALL NOT BE PLACED IN DIRECT CONTACT WITH STEEL FRAMING MEMBERS, CONCRETE, OR CINDER WALLS

AND FLOORS OR OTHER MASONRY. METALLIC PIPING SHALL NOT BE PLACED IN DIRECT CONTACT WITH CORROSIV

SOIL. SHEATHING USED TO PREVENT DIRECT CONTACT SHALL HAVE A THICKNESS OF GREATER THAN .008: AND THE

SHEATHING SHALL BE MADE OF PLASTIC. ANY PIPE THAT PASSES THROUGH A FOUNDATION WALL OR FOOTING SHAL

BE PROVIDED WITH A RELIEVING ARCH, OR A PIPE SLEEVE SHALL BE BUILT INTO THE FOUNDATION WALL. THE SLEEVE

SENSITIVE ADHESIVE SYSTEM FOR CLOSURE AND VAPOR SEALING, EQUAL TO ARMSTRONG AP ARMAFLEX OR ARMAFLEX 2000. 4) FOR NON CIRCULATING SYSTEMS, THE FIRST 8 FEET OF INLET AND OUTLET PIPING BETWEEN THE TANK AND THE HEAT TRAP (INCLUDING THE HEAT TRAP) MUST BE INSULATED. 5) FOR CIRCULATING SYSTEMS, ALL HOT WATER PIPING IN THE CIRCULATION LOOP MUST BE INSULATED AS SPECIFIED BELOW.

6) INSULATION SCHEDULE: a) DOMESTIC COLD WATER b) DOMESTIC HOT WATER

(1) ROUND SUPPLY DUCT

C DUCTWORK: THERMAL INSULATION 1) DUCT COVERING: 3/4 LB/CF, FIBERGLASS BLANKET WITH FACTORY APPLIED VAPOR BARRIER AND FACING, THICKNESS AS SCHEDULED, INSTALLATION IN ACCORDANCE WITH MANUFACTURERS a) DUCT COVERING SCHEDULE: MINIMUM R-6

(2) RECTANGULAR SUPPLY DUCT DUCTWORK:
 A. ALL DUCTWORK, UNLESS OTHERWISE INDICATED, SHALL BE FABRICATED FROM GALVANIZED SHEET STEEL COMPLYING WITH ASTM A 653, LOCKFORMING QUALITY, WITH G 90 ZINC COATING IN ACCORDANCE WITH ASTM A 924; AND MILL PHOSPHATIZED FOR EXPOSED LOCATIONS. B. WHERE DUCTWORK IS INDICATED TO BE EXPOSED TO VIEW IN OCCUPIED SPACES, PROVIDE MATERIALS WHICH ARE FREE FROM VISUAL IMPERFECTIONS INCLUDING PITTING, SEAM MARKS, ROLLER MARKS, STAINS AND DISCOLORATIONS, AND OTHER IMPERFECTIONS, INCLUDING THOSE WHICH WOULD IMPAIR

C. DUCTWORK, METAL GAUGES, REINFORCING, ETC. SHALL BE CONSTRUCTED IN ACCORDANCE WITH SMACNA "HVAC DUCT CONSTRUCTION STANDARDS," LATEST EDITION FOR A 2 INCH WATER GAUGE STATIC PRESSURE.
1) RECTANGULAR DUCT: a) ELBOWS, UNLESS INDICATED OTHERWISE SHALL BE CONSTRUCTED WITH CENTERLINE RADIUS OF

NOT LESS THAN 1.5 DUCT WIDTH OR SQUARE ELBOW WITH DOUBLE WALL STREAMLINE VANES. b) RETURN AIR ACOUSTICAL ELBOWS AND SOUND BOOTS SHALL BE A SQUARE ELBOW WITH NO c) SLOPES FOR TRANSITIONS OR OTHER CHANGES IN DIMENSIONS SHALL BE MINIMUM 1 TO 3. 2) ROUND AND OVAL SPIRAL SEAM DUCT: a) PROVIDE RADIUS TYPE FITTINGS FABRICATED OF MULTIPLE SECTIONS WITH MAXIMUM 15 DEGREE CHANGE OF DIRECTION PER SECTION. UNLESS SPECIFICALLY DETAILED OTHERWISE, USE 45 DEGREE LATERALS FOR BRANCH TAKEOFF CONNECTIONS. WHERE 90 DEGREE BRANCHES ARE INDICATED PROVIDE CONICAL TYPE TEES.

b) SLOPES FOR TRANSITIONS OR OTHER CHANGES IN DIMENSIONS SHALL BE MINIMUM 1 TO 3. E) AS AN OPTION, PROVIDE FACTORY-FABRICATED DUCT AND FITTINGS, IN LIEU OF SHOP FABRICATED DUCT AND FITTINGS. (1) ELBOWS: ONE PIECE CONSTRUCTION FOR 90 DEGREES AND 45 DEGREE ELBOW 14" AND SMALLER. PROVIDE MULTIPLE GORE CONSTRUCTION FOR LARGER DIAMETERS WITH STANDING SEAM CIRCUMFERENTIAL JOINT.

(2) DIVIDED FLOW FITTINGS: 90 DEGREE TEES, CONSTRUCTED WITH SADDLE TAP SPOT

WELDED AND BONDED TO DUCT FITTING BODY. d) ROUND LONGITUDINAL SEAM DUCT. USE FOR RIGID METAL DUCT ON LEAVING SIDE OF DUCT IN CONCEALED LOCATIONS FOR EXTENSION TO FLEX FOR DIFFUSERS, UNLESS OTHERWISE INDICATED D. DUCT SIZES SHOWN ON THE DRAWINGS ARE SHEETMETAL SIZES, ALLOWANCE FOR DUCT LINER HAS BEEN

MADE WHERE APPLICABLE. E. INSTALLATION OF METAL DUCTWORK: GENERAL: ASSEMBLE AND INSTALL DUCTWORK IN ACCORDANCE WITH RECOGNIZED INDUSTRY PRACTICES WHICH WILL ACHIEVE AIR-TIGHT SYSTEMS (MAXIMUM 5% LEAKAGE). WITH NO OBJECTIONABLE NOISE, AND CAPABLE OF PERFORMING INDICATED SERVICE. INSTALL EACH RUN WITH MINIMUM NUMBER OF JOINTS. ALIGN DUCTWORK ACCURATELY WITH INTERNAL SURFACES SMOOTH. SUPPORT DUCTS RIGIDLY WITH SUITABLE STRAPS, BRACES, HANGERS AND ANCHORS IN ACCORDANCE WITH SMACNA "HVAC DUCT CONSTRUCTION STANDARDS" LATEST EDITION. DUCT HANGERS SHALL BE OF THE TYPE WHICH WILL HOLD DUCTS TRUE-TO-SHAPE AND TO PREVENT

BUCKLING. SUPPORT VERTICAL DUCTS AT EVERY FLOOR. AUXILIARY STEEL: PROVIDE AUXILIARY STEEL AS REQUIRED TO ADEQUATELY SUPPORT DUCTWORK. 3) ROUTING: LOCATE DUCTWORK RUNS, EXCEPT AS OTHERWISE INDICATED, VERTICALLY AND HORIZONTALLY AND AVOID DIAGONAL RUNS WHEREVER POSSIBLE. LOCATE RUNS AS INDICATED BY DIAGRAMS, DETAILS AND NOTATIONS OR, IF NOT OTHERWISE INDICATED, RUN DUCTWORK IN SHORTEST ROUTE WHICH DOES NOT OBSTRUCT USABLE SPACE OR BLOCK ACCESS FOR SERVICING BUILDING AND ITS EQUIPMENT. HOLD DUCTS CLOSE TO WALLS, OVERHEAD CONSTRUCTION, COLUMNS, AND OTHER STRUCTURAL AND PERMANENT ENCLOSURE ELEMENTS OF BUILDING. WHEREVER POSSIBLE IN FINISHED AND OCCUPIED SPACES. CONCEAL DUCTWORK FROM VIEW. BY LOCATING IN MECHANICAL SHAFTS, HOLLOW WALL CONSTRUCTION OR ABOVE SUSPENDED CEILINGS. DO NOT ENCASE HORIZONTAL RUNS IN SOLID PARTITIONS, EXCEPT AS SPECIFICALLY SHOWN. COORDINATE LAYOUT WITH SUSPENDED CEILING AND LIGHTING LAYOUTS AND SIMILAR FINISHED WORK. 4) DO NOT ROUTE DUCTWORK THROUGH ELECTRICAL EQUIPMENT SPACES AND ENCLOSURES, UNLESS

INDICATED OTHERWISE. 5) PENETRATIONS: a) WHERE DUCTS PASS THROUGH INTERIOR PARTITIONS OR EXTERIOR WALLS, AND ARE EXPOSED TO VIEW, CONCEAL SPACE BETWEEN OPENING AND DUCT OR DUCT INSULATION WITH SHEET METAL FLANGES OF SAME GAGE AS DUCT. OVERLAP OPENING ON 4 SIDES BY AT LEAST 1-1/2". FASTEN TO DUCT AND WALL.

b) WHERE DUCTS PASS THROUGH FIRE-RATED FLOORS, WALLS, OR PARTITIONS, PROVIDE FIRESTOPPING BETWEEN DUCT AND WALL. 6) COORDINATION: COORDINATE DUCT INSTALLATIONS WITH INSTALLATION OF ACCESSORIES DAMPERS, COIL FRAMES, EQUIPMENT, CONTROLS, AND OTHER ASSOCIATED WORK OF THE DUCTWORK 7) INSTALLATION: INSTALL METAL DUCTWORK IN ACCORDANCE WITH SMACNA "HVAC DUCT CONSTRUCTION STANDARDS", LATEST EDITION.

F. EQUIPMENT CONNECTIONS: I) CONNECT METAL DUCTWORK TO EQUIPMENT AS INDICATED, PROVIDE FLEXIBLE CONNECTION FOR EACH DUCTWORK CONNECTION TO EQUIPMENT MOUNTED ON VIBRATION ISOLATORS, AND/OR EQUIPMENT CONTAINING ROTATING MACHINERY. PROVIDE ACCESS DOORS AS REQUIRED. G. SEAL ALL CONCEALED DUCTWORK JOINTS WITH NON-HARDENING, NON-MIGRATING MASTIC SEALANT, AS

RECOMMENDED FOR SEALING SEAMS AND JOINTS IN DUCTWORK. OIL BASE CAULKING AND GLAZING COMPOUNDS SHALL NOT BE ACCEPTABLE. DUCTS SHALL BE SEALED TO THE CLASS LEVEL LISTED BELOW. 1) UNCONDITIONED SPACES CLASS B CLASS A CLASS C CLASS B 2) CONDITIONED SPACES (PLENUM) CLASS C CLASS B CLASS B CLASS C SUPPLY < 2" W.C. SUPPLY > 2" W.C. EXHAUST/DRYER RETURN

10. FLEXIBLE DUCT: A. ATCO #086 (R-6), OR EQUAL. B. FACTORY APPLIED INSULATION AND VAPOR BARRIER.

A. CENTRIFUGAL CEILING EXHAUSTERS SHALL BE ELECTRICALLY POWERED CENTRIFUGAL TYPE FAN SUITABLE FOR MOUNTING IN THE CEILING WITH A PERFORATED OFF-WHITE METAL GRILLE WITH A THUMBSCREW ATTACHMENT FOR EASY ACCESS TO FAN HOUSING. UNIT SHALL CONSIST OF A GALVANIZED STEEL HOUSING LINED WITH ACOUSTICAL INSULATION AND SHALL INCLUDE AN INTEGRAL BACKDRAFT DAMPER ON FAN DISCHARGE. MOTOR SHALL BE A PERMANENT SPLIT-CAPACITOR TYPE MOTOR, PERMANENTLY LUBRICATED, WITH THERMAL OVERLOAD PROTECTION. PROVIDE DISCONNECT SWITCH OR OTHER MEANS OF DISCONNECT AT MOTOR IN FAN HOUSING.

12. SMOKE DETECTORS: A. UNITS MOUNTED IN THE DUCTWORK SHALL BE A DUCT MOUNTED UL LISTED PHOTO-ELECTRIC SELF-CONTAINED SMOKE DETECTOR WITH HOUSING. UNITS SHALL BE EQUAL TO SIMPLEX #4098-9687. THE SAMPLING TUBE SHALL BE #2098-9804, LENGTH AS REQUIRED FOR DUCT B. DUCT DETECTOR REMOTE TEST STATION SHALL BE SIMPLEX #4098-9842 WITH REMOTE ALARM INDICATOR,

POWER-ON INDICATOR, TONE-ALERT, TONE-ALERT SILENCE SWITCH, AND TEST/RESET SWITCH.

1) DEVICES SHALL BE MOUNTED IN APPROVED LOCATION AS INDICATED ON THE FLOOR PLANS OR AS DIRECTED BY LOCAL AUTHORITY HAVING JURISDICTION. C. PROVIDE AND INSTALL A PHOTO-ELECTRIC SMOKE DETECTOR IN THE RETURN AIR DUCT FOR EACH HVAC UNIT AS INDICATED ON THE FLOOR PLANS. DETECTORS ARE TO BE PROVIDED WITH A SUB-BASE CONTAINING AUXILIARY RELAY CONTACTS. RELAY CONTACTS SHALL BE WIRED INTO UNIT CONTROL WIRING, SO AS TO SHUT UNIT DOWN IN THE CASE OF SMOKE DETECTION. PROVIDE ALL

CONTROL WIRING. ELECTRICAL CONTRACTOR SHALL PROVIDE 120 VOLT POWER TO EACH DETECTOR.

D. SMOKE DETECTORS SHALL BE INTERLOCKED. IN ALARM CONDITION OF A SINGLE DETECTOR ALL UNITS SHALL SHUT DOWN.

A. ELECTRICAL WIRING AND WIRING CONNECTIONS REQUIRED FOR THE INSTALLATION OF THE TEMPERATURE CONTROL SYSTEM, SHALL BE PROVIDED BY THIS CONTRACTOR, UNLESS SPECIFICALLY SHOWN ON THE

ELECTRICAL DRAWINGS OR SPECIFICATIONS.
B. INSTALL CONTROL WIRING, WITHOUT SPLICES BETWEEN TERMINAL POINTS, COLOR CODED. INSTALL IN NEAT WORKMANLIKE MANNER, SECURELY FASTENED. INSTALL IN ACCORDANCE WITH NATIONAL ELECTRICAL CODE AND THE ELECTRICAL SPECIFICATIONS. 1) INSTALL CIRCUITS OVER 25 VOLT WITH COLOR CODED NUMBER 12 WIRE. 2) INSTALL CIRCUITS UNDER 25 VOLT WITH COLOR CODED NUMBER 18 WIRE WITH 0.031 INCH HIGH FEMPERATURE 105 DEGREES F PLASTIC INSULATION ON EACH CONDUCTOR AND PLASTIC SHEATH OVER

3) INSTALL ELECTRONIC CIRCUITS WITH COLOR CODED NUMBER 22 WIRE WITH 0.023 INCH POLYETHYLENE INSULATION ON EACH CONDUCTOR WITH PLASTIC JACKETED COPPER SHIELD OVER

4) INSTALL LOW VOLTAGE CIRCUITS, LOCATED IN CONCRETE SLABS AND MASONRY WALLS, OR EXPOSED IN OCCUPIED AREAS. IN ELECTRIC CONDUIT. 5) ALL WIRING IN AREAS USED AS AIR PLENUMS SHALL BE IN ELECTRIC CONDUIT EXCEPT THAT LOW VOLTAGE WIRING MAY BE TEFLON COATED, ALUMINUM SHEATHED CABLE OR OTHER WIRE SPECIFICALLY APPROVED FOR INSTALLATION IN AIR PLENUMS, WHERE ACCEPTABLE BY LOCAL

6) ALL WIRING IN AREAS NOT USED FOR AIR MOVEMENT SHALL BE IN ELECTRIC METALLIC TUBING EXCEPT LOW VOLTAGE WIRING MAY BE IN APPROVED SIGNAL CABLE WHERE ACCEPTED BY LOCAL

THERMOSTATIC CONTROLS TO HAVE A 5°F DEADBAND AND SETPOINT OVERLAP RESTRICTIONS 1) TEMPERATURE CONTROLS SETBACK TO BE 55°F (HEAT) AND 85° (COOL), 2-HOUR OCCUPANT OVERRIDE, BC PROJECT #: 25215 MISSOURI PE COA #2009003629 This drawing has been prepared by the Engineer, or under his supervision. This drawing is provide n instrument of service by the Designer/Engineer and is intended for use on this project only. Pursua to the Architectural Works Copyright Protection Act of 1990, all drawings, specifications, ideas and lesigns, including the overall form, arrangement and composition of spaces ar herein, constitute the original, copyrighted work of the Designer/Engineer. Any reproduction, use, or

INCORPORATED 5720 Reeder Shawnee, KS 66203 (913)262-177

COUNCIL (AABC) OR NATIONAL ENVIRONMENTAL BALANCING BUREAU (NEBB). 1) BALANCING SHALL INCLUDE THE BALANCING OF THE EQUIPMENT AND AIR DISTRIBUTION SYSTEMS TO PROVIDE DESIGN QUANTITIES INDICATED AND VERIFICATION OF PERFORMANCE OF ALL EQUIPMENT AND AUTOMATIC CONTROLS. 2) WITH IN 30 DAYS OF THE COMPLETION OF THE TESTING AND BALANCING WORK, SUBMIT THE TEST AND BALANCING REPORT BEARING THE SIGNATURE OF THE TEST AND BALANCE ENGINEER. THE REPORTS SHALL BE CERTIFIED PROOF THAT THE SYSTEMS HAVE BEEN TESTED, ADJUSTED, AND BALANCED IN ACCORDANCE WITH THE REFERENCED STANDARDS; ARE AN ACCURATE REPRESENTATION OF HOW THE SYSTEMS HAVE BEEN INSTALLED AND ARE OPERATING. REPORTS SHALL BE BOUND IN A VINYL BINDER AND THE BINDER LABELED OR MAY BE AN ELECTRONIC PDF SUBMITTAL F. BEFORE DOMESTIC WATER PIPING IS PLACED IN SERVICE, ALL DOMESTIC WATER DISTRIBUTION SYSTEMS. INCLUDING THOSE FOR COLD WATER AND HOT WATER SYSTEMS. SHALL BE FLUSHED. STERILIZED AND CHLORINATED IN ACCORDANCE WITH HEALTH DEPARTMENT REGULATIONS. THE SYSTEMS SHALL BE THOROUGHLY FLUSHED OF ALL DIRT AND FOREIGN MATTER, THEN FILLED WITH WATER TREATED WITH 50 PPM OF CHLORINE. DURING THE FILLING PROCESS, VALVES AND FAUCETS SHALL BE OPENED SEVERAL TIMES TO ASSURE TREATMENT OF THE ENTIRE SYSTEM. THE TREATED WATER SHALL BE LEFT IN THE SYSTEM FOR 24 HOURS AFTER WHICH TIME THE SYSTEM SHALL BE FLUSHED: IF THE RESIDUAL CHLORINE IS NOT LESS THAN 10 PPM, THE FLUSHING SHALL BE REPEATED. AFTER STERILIZATION, SAMPLES OF WATER IN THE SYSTEM SHALL BE APPROVED BY THE BOARD OF HEALTH. A. PROVIDE AN APPROVED WATER HAMMER ARRESTOR FOR EACH PLUMBING FIXTURE SUPPLY AS B. ALL EXPOSED WASTE PIPE SHALL BE CHROME PLATED BRASS PIPE, NO FERROUS PIPE. C. PROVIDE CLEANOUTS AT EACH CHANGE OF DIRECTION AND AT 100 FOOT INTERVALS IN STRAIGHT RUNS. D. PROVIDE ACCESS PANELS FOR ALL CONCEALED VALVES AND TRAPS. E. CLEANOUTS: 1) VINYL TILE FLOOR: JR SMITH #4140, OR EQUAL 2) QUARRY TILE FLOOR: JR SMITH #4200, OR EQUAL. 3) CARPETED FLOOR: JR SMITH #4020-Y, OR EQUAL. 4) UNFINISHED FLOOR: JR SMITH #4020, OR EQUAL 5) WALL: JR SMITH #4472, OR EQUAL, 24" ABOVE THE FLOOR. F. PROVIDE DIELECTRIC UNIONS WITH APPROPRIATE END CONNECTIONS TO MATCH THE PIPE SYSTEM IN WHICH INSTALLED (SCREWED, SOLDERED, OR FLANGED). PROVIDE DIELECTRIC UNIONS ON ALL PIPING CONNECTIONS TO HOT WATER HEATERS AND EXPANSION TANKS. G. WATER HEATERS 1) EVERY WATER HEATER SHALL HAVE AN APPROVED MEANS INSTALLED ON THE COLD WATER SUPPLY LINE ABOVE THE EQUIPMENT TO PREVENT SIPHONING OF A STORAGE WATER HEATER OR TANK. 2) BOTTOM FED WATER HEATERS AND TANKS CONNECT TO WATER HEATERS SHALL HAVE A VACCUM RELIEF VALVE INSTALLED. ANSI Z21.22. 3) STORAGE HEATERS OPERATING ABOVE ATMOSPHERIC PRESSURE SHALL HAVE AN APPROVED PRESSURE RELIEF VALVE AND/OR TEMPERATURE RELIEF VALVE. H. ALL SEWER PIPING LOCATED INSIDE THE BUILDING SHALL BE INSTALLED WITH THE FOLLOWING SLOPES. 1) INSTALL 2-1/2" AND SMALLER PIPE AT 1/4" PER FOOT FALL 2) INSTALL 3" AND LARGER PIPE AT 1/8" PER FOOT FALL. A. DOMESTIC COLD, HOT, AND HOT WATER RECIRCULATING (ABOVEGROUND). 1) TYPE L HARD DRAWN COPPER TUBING, ASTM B-88. a) WROUGHT COPPER SOLDERED FITTINGS, ASTM B75 ALLOY C12200. ANSI B16.22. MSS SP-104. b) MECHANICAL PRESS COPPER FITTINGS FOR USE IN PLUMBING OR MECHANICAL APPLICATIONS. ASME B16.22, ASME B16.51, or ASME B16.18. MECHANICAL PRESS COPPER FITTINGS SHALL CONFORM TO IAPMO PS-117 OR 2) PEX, HIGH-DENSITY CROSS-LINKED POLYETHYLENE TUBING SHALL BE MANUFACTURED TO THE REQUIREMENTS OF ASTM F876 AND MEET THE STANDARD GRADE HYDROSTATIC PRESSURE RATINGS FROM PLASTIC PIPE INSTITUTE IN ACCORDANCE WITH TR-4/03.

(MUST BE INSTALLED PER THE MANUFACTURERS REQUIREMENTS FOR PLENUM USE) a) PEX-A AND PEX-B MEETING ANSI/NSF61 AND ANSI/NSF372 STANDARDS FOR POTABLE WATER SAFETY AND LEAD-FREE STANDARDS AND MUST BE MARKED WITH "PW-G", "NSF-61-G" OR OTHER NSF-APPROVED MARKING. ASTM F2023 FOR USE WITH CHLORINATED WATER. (MUST BE INSTALLED PER THE MANUFACTURERS REQUIREMENTS FOR PLENUM USE) b) PEX MECHANICAL, CRIMP/INSERT OR EXPANSION FITTINGS INSTALLED IN ACCORDANCE WITH MANUFACTURER'S INSTRUCTIONS. PIPE SIZES GIVEN ON THE DRAWINGS ARE NOMINAL COPPER PIPE SIZE, INCREASE PEX PIPING SIZE TO EQUAL OR EXCEED COPPER PIPE INSIDE DIAMETER FOR SUPPLY MAINS. (MUST BE INSTALLED PER THE MANUFACTURERS REQUIREMENTS FOR PLENUM USE) a) TO BE INSTALLED ON THE FIXTURE SUPPLY TO EACH PLUMBING FIXTURE. b) TO BE INSTALLED ON THE WATER SUPPLY SIDE TO EACH APPLIANCE OR MECHANICAL EQUIPMENT. 1. GATE VALVE: JOMAR T/S-301G OR EQUAL. LEAD-FREE NSF 61, ANSI B1.20.1. 2. GLOBE VALVE: JOMAR TGG OR EQUAL. 3. BALL VALVE: JOMAR JP100PxP OR EQUAL COMPACT LEAD FREE BRASS BALL VALVE. UL842, CSA 3371-12 & 3371-92, FM, CALIFORNIA CODE AB1953, NSF61 ANNEX G APPROVED. 4. BALL VALVE: JOMAR T-100NE OR EQUAL. UL842, FM, CSA, NSF 61-8, MSS SP-110

1) PIPE AND PIPE FITTINGS, INCLUDING VALVES AND FAUCETS, UTILIZED IN THE WATER SUPPLY SYSTEM SHALL

DRINKING OR COOKING PURPOSES SHALL COMPLY WITH NSF 372 AND SHALL HAVE A WEIGHTED AVERAGE

ABS PIPE AND FITTINGS: ABS PIPE AND FITTINGS SHALL COMPLY WITH NSF 14, "PLASTICS PIPING SYSTEMS

COMPONENTS AND RELATED MATERIALS," FOR PLASTIC PIPING COMPONENTS. INCLUDE MARKING WITH

"NSF-DWV" FOR PLASTIC DRAIN, WASTE, AND VENT PIPING AND "NSF-SEWER" FOR PLASTIC SEWER PIPING.

SOLID-WALL ABS PIPE: ASTM D 2661, SCHEDULE 40. ABS SOCKET FITTINGS: ASTM D 2661, MADE TO ASTM D

PVC PIPE AND FITTINGS: PVC PIPE AND FITTINGS SHALL COMPLY WITH NSF 14. "PLASTICS PIPING SYSTEMS

COMPONENTS AND RELATED MATERIALS." FOR PLASTIC PIPING COMPONENTS. INCLUDE MARKING WITH

MANUFACTURED FROM GRAY CAST IRON AND SHALL CONFORM TO ASTM A 888 AND CISPI STANDARD 301.

ABS PIPE AND FITTINGS: ABS PIPE AND FITTINGS SHALL COMPLY WITH NSF 14, "PLASTICS PIPING SYSTEMS

SOLID-WALL ABS PIPE: ASTM D 2661, SCHEDULE 40, CELLULAR-CORE ABS PIPE: ASTM F 628, SCHEDULE 40, ABS

SOCKET FITTINGS: ASTM D 2661, MADE TO ASTM D 3311, DRAIN, WASTE, AND VENT PATTERNS. SOLVENT

PVC PIPE AND FITTINGS: PVC PIPE AND FITTINGS SHALL COMPLY WITH NSF 14, "PLASTICS PIPING SYSTEMS

"NSF-DWV" FOR PLASTIC DRAIN, WASTE, AND VENT PIPING AND "NSF-SEWER" FOR PLASTIC SEWER PIPING.

SOLID-WALL PVC PIPE: ASTM D 2665, DRAIN, CELLULAR-CORE PVC PIPE: ASTM F 891, SCHEDULE 40, WASTE.

HUBLESS CAST IRON SOIL PIPE AND FITTINGS: HUBLESS CAST IRON PIPE AND FITTINGS SHALL BE

BE MANUFACTURED FROM GRAY CAST IRON AND SHALL CONFORM TO ASTM A 74.

MANUFACTURED FROM GRAY CAST IRON AND SHALL CONFORM TO ASTM A 888 AND CISPI STANDARD 301

HUBLESS COUPLINGS SHALL CONFORM TO CISPI STANDARD 310 AND BE CERTIFIED BY NSF® INTERNATIONAL

HUB AND SPIGOT CAST IRON SOIL PIPE AND FITTINGS: HUB AND SPIGOT CAST IRON PIPE AND FITTINGS SHALL

AND VENT. PVC SOCKET FITTINGS: ASTM D 2665, MADE TO ASTM D 3311, DRAIN, WASTE, AND VENT PATTERNS AND TO FIT SCHEDULE 40 PIPE. ADHESIVE PRIMER: ASTM F 656. SOLVENT CEMENT: ASTM D 2564.

COMPONENTS AND RELATED MATERIALS." FOR PLASTIC PIPING COMPONENTS. INCLUDE MARKING WITH

COMPONENTS AND RELATED MATERIALS," FOR PLASTIC PIPING COMPONENTS. INCLUDE MARKING WITH "NSF-DWV" FOR PLASTIC DRAIN WASTE AND VENT PIPING AND "NSF-SEWER" FOR PLASTIC SEWER PIPING

HUBLESS COUPLINGS SHALL CONFORM TO CISPI STANDARD 310 AND BE CERTIFIED BY NSF® INTERNATIONAL 4) HUB AND SPIGOT CAST IRON SOIL PIPE AND FITTINGS: HUB AND SPIGOT CAST IRON PIPE AND FITTINGS SHALL

3) HUBLESS CAST IRON SOIL PIPE AND FITTINGS: HUBLESS CAST IRON PIPE AND FITTINGS SHALL BE

BE MANUFACTURED FROM GRAY CAST IRON AND SHALL CONFORM TO ASTM A 74.

"NSF-DWV" FOR PLASTIC DRAIN, WASTE, AND VENT PIPING AND "NSF-SEWER" FOR PLASTIC SEWER PIPING.

SOLID-WALL PVC PIPE: ASTM D 2665, DRAIN, WASTE, AND VENT. PVC SOCKET FITTINGS: ASTM D 2665, MADE TO ASTM D 3311, DRAIN, WASTE, AND VENT PATTERNS AND TO FIT SCHEDULE 40 PIPE. ADHESIVE PRIMER: ASTM F

2) PIPE, PIPE FITTINGS, JOINTS, VALVES, FAUCETS, AND FIXTURE FITINGS UTILIZED TO SUPPLY WATER FOR

3311, DRAIN, WASTE, AND VENT PATTERNS. SOLVENT CEMENT: ASTM D 2235.

B. LEAD CONTENT OF WATER SUPPLY PIPE AND FITTINGS:

LEAD CONTENT OF 0.25% OR LESS.

(UNDERGROUND, INTERIOR TO THE BUILDING).

656. SOLVENT CEMENT: ASTM D 2564.

(ABOVE GROUND, INTERIOR TO THE BUILDING).

NOT FOR USE IN A RETURN AIR PLENUM)

(NOT FOR USE IN A RETURN AIR PLENUM)

C. SANITARY SEWER AND VENTS.

D. SANITARY SEWER AND VENTS.

NOT HAVE MORE THAN 8% LEAD CONTENT.

### MECHANICAL GENERAL NOTES:

- COORDINATE ALL WORK WITH OTHER TRADES AND EXISTING CONDITIONS AS REQUIRED TO PROPERLY INSTALL ALL SYSTEMS AS INTENDED, WITHIN THE CONFINES OF THE SPACES AVAILABLE, AND WITHOUT
- 2. THIS CONTRACTOR SHALL PERFORM ALL WORK INDICATED AND/OR AS REQUIRED FOR THE PROPER INSTALLATION AND OPERATION OF THE MECHANICAL SYSTEMS.
- 3. REFER TO ARCHITECTURAL REFLECTED CEILING PLANS FOR EXACT LOCATIONS OF DIFFUSERS.
- 4. INSTALL ALL DUCT, PIPE, ETC. AS HIGH AS POSSIBLE.
- 5. DUCT SIZES SHOWN ARE ACTUAL SHEET METAL SIZES AND INCLUDE AN ALLOWANCE FOR DUCT LINER WHERE APPLICABLE.
- 6. PROVIDE FLEXIBLE CONNECTION BETWEEN DUCTWORK AND ROOFTOP UNITS, EXHAUST FANS, AND OTHER MOTORIZED EQUIPMENT.
- 7. NO DUCT SHALL BE ROUTED OVER THE TOP OF ELECTRICAL PANELS.
- 8. ALL MECHANICAL SYSTEMS SHALL BE BALANCED BY A CERTIFIED BALANCING CONTRACTOR. REFER TO SPECIFICATIONS FOR DETAILS.

### MECHANICAL SYMBOLS

NEW SUPPLY DIFFUSER NEW RETURN AIR GRILLE EXHAUST GRILLE/FAN

THERMOSTAT, MOUNTED AT 48" AFF

DUCT-MOUNTED SMOKE DETECTOR

SIZE OF RECTANGULAR DUCT SIZE OF ROUND DUCT FLEXIBLE DUCTWORK

> FLEXIBLE CONNECTION TO FAN FLOOR PLAN NOTE DESIGNATION

RETURN AIR EXHAUST AIR

TRANSITION IN DUCT SIZE

ELBOW WITH TURNING VANES

MANUAL VOLUME DAMPER MANUAL VOLUME DAMPER

MOTORIZED CONTROL DAMPER

SPLITTER DAMPER WITH HORIZONTAL REGULATOR

SUPPLY AIR DUCT UP/DOWN RETURN AIR DUCT UP/DOWN

EXHAUST AIR DUCT UP/DOWN CHANGE IN ELEVATION UP (UP) DOWN (DN)

**MECHANICAL PLAN NOTES:** 


AND/OR REPLACE AS REQUIRED.

MINIMUM OUTDOOR AIR DAMPER ON UNIT AS REQUIRED.


SCHEDULED MECHANICAL EQUIPMENT EXIST'G DUCT TO REMAIN

**— — —** EXIST'G DUCT TO BE REMOVED EXISTING FLEXIBLE DUCTWORK

SIZE OF EXISTING DUCT 32"x14"E EXISTING SUPPLY DIFFUSER

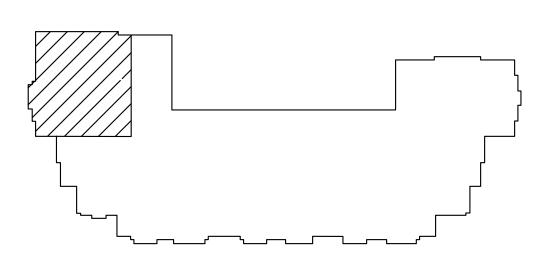



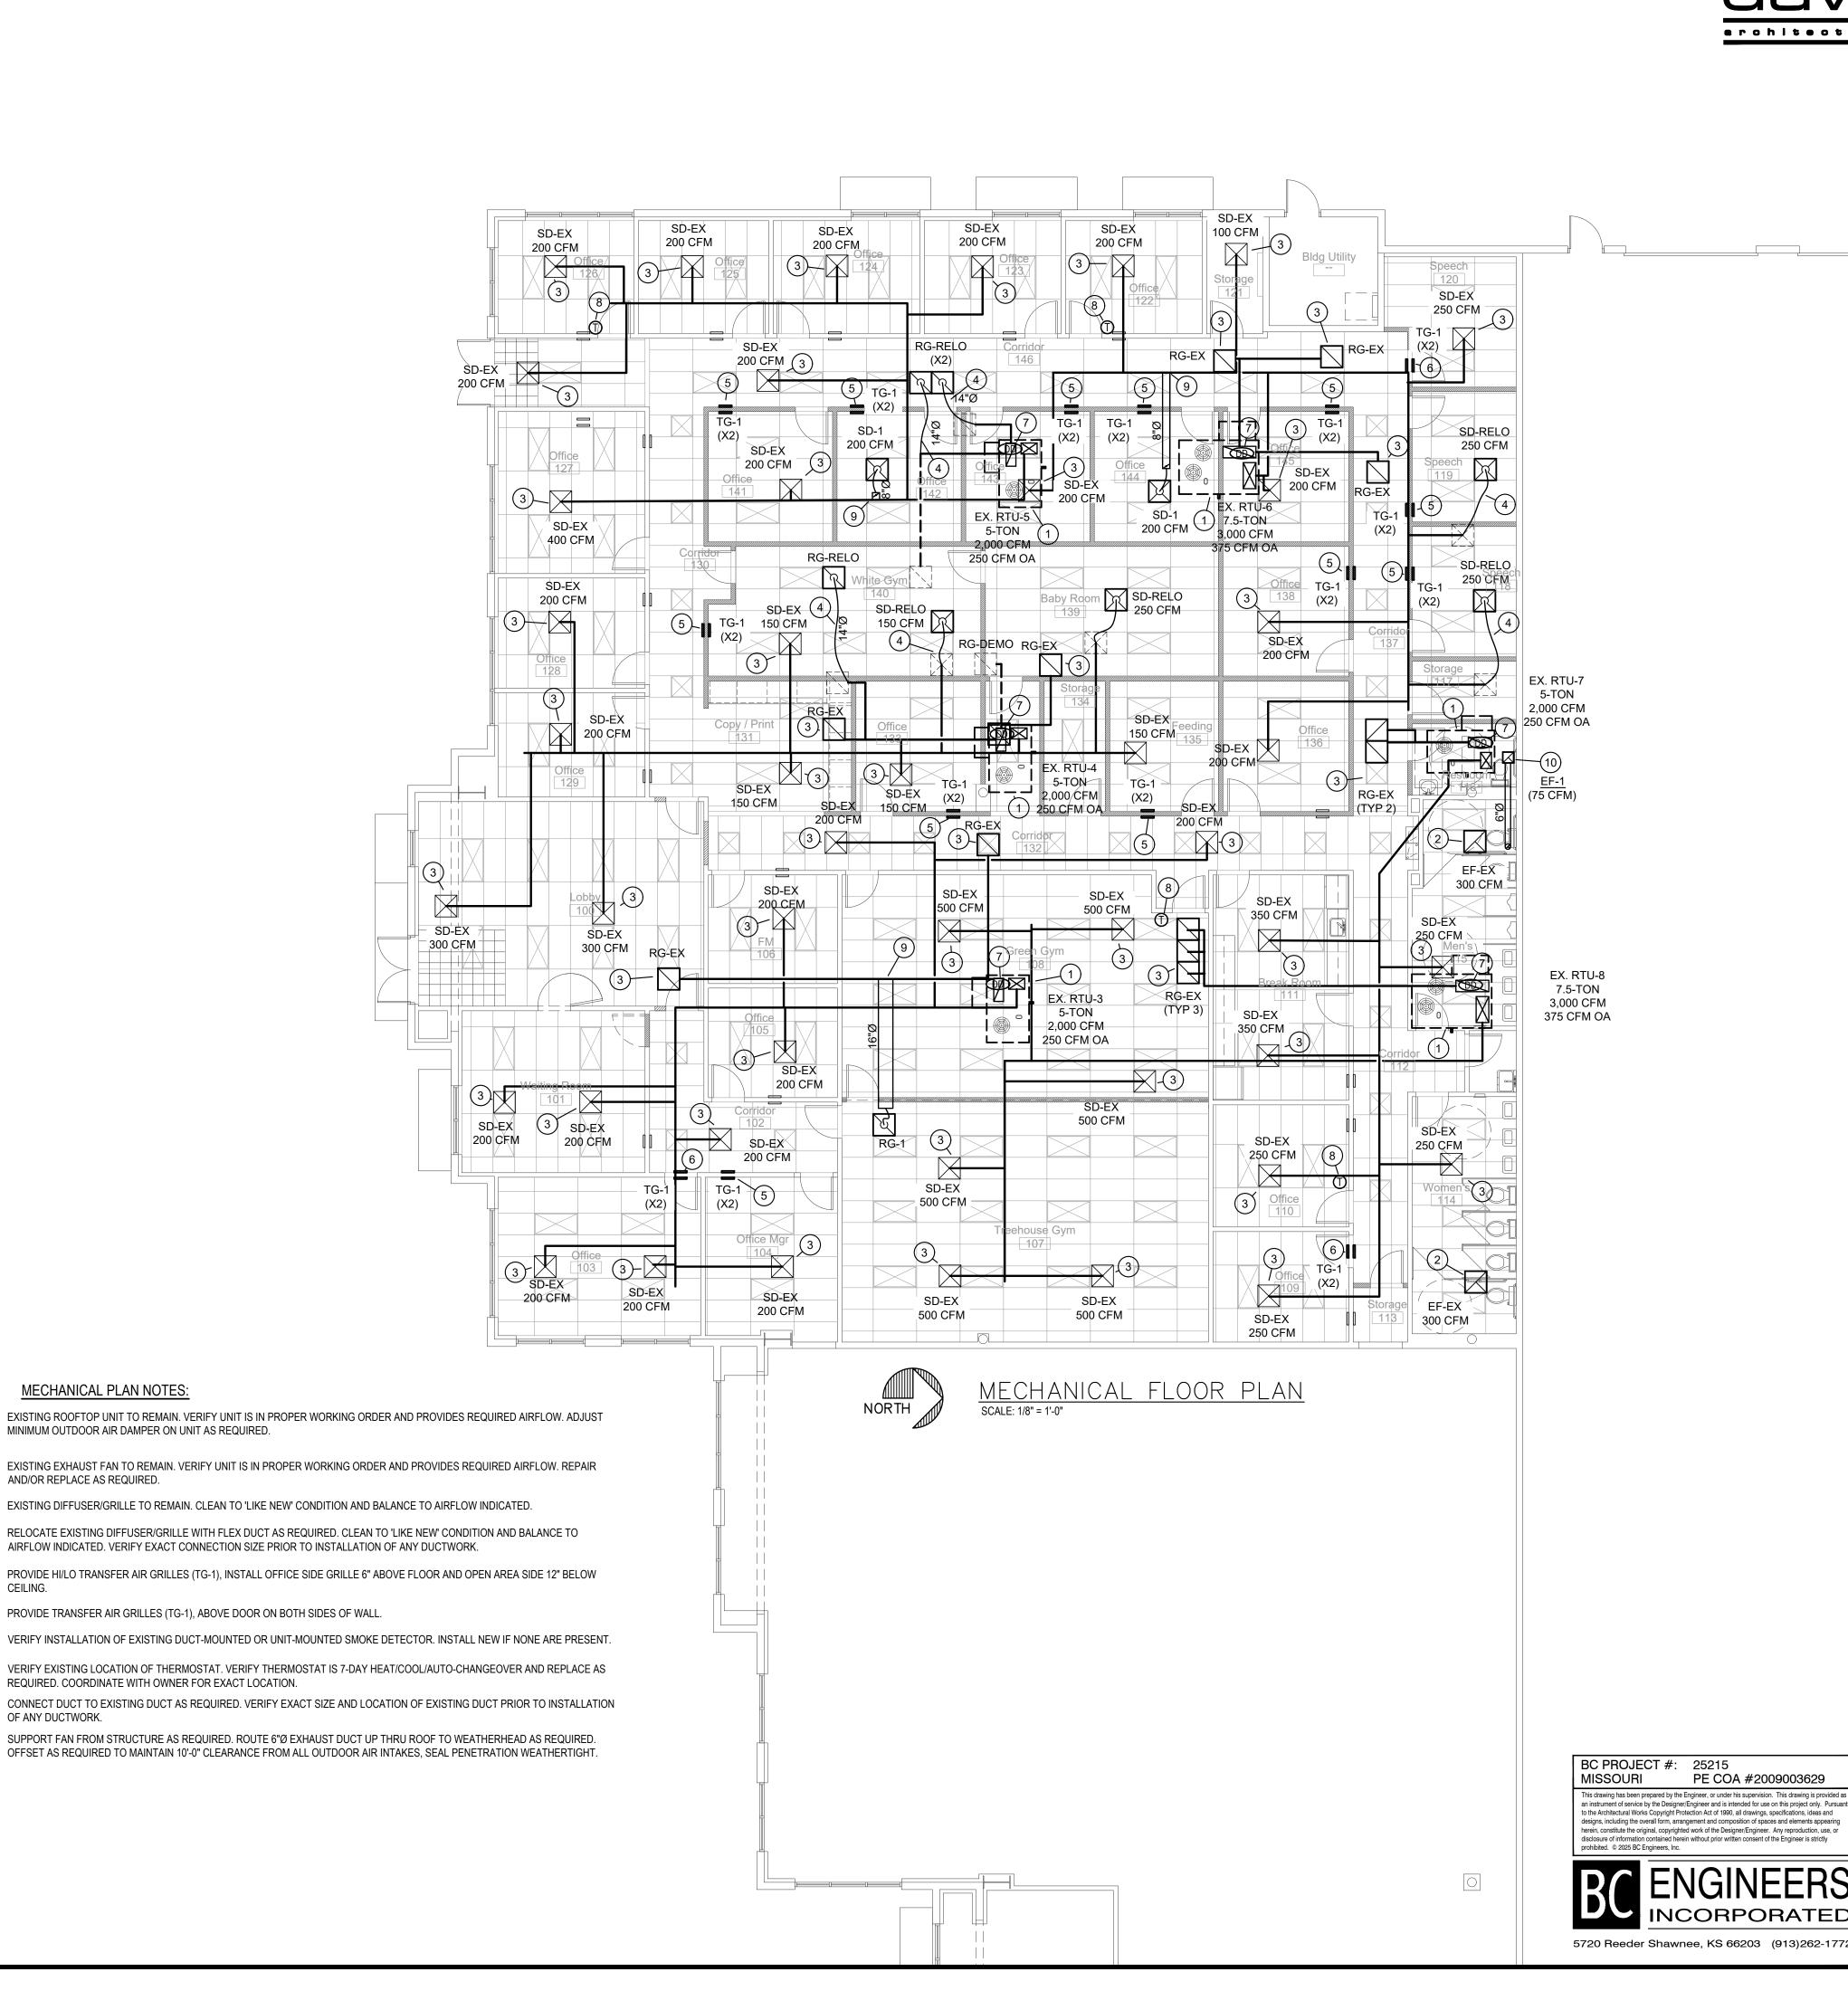

4301 Indian Creek Parkway Overland Park, KS 66207 phone: 913.451.9390 www.devideonee.com



dete 04.03.2025 drawn by sp/rc checked by ek/ds revisions

sheet number drawing type

project number

PE COA #2009003629

RELEASED FOR


	4/3/25	
	4/3/25  4/3/25  MISOF MISO  STEVEN S.  POND	William Control
i REG	STEVEN S. POND	
	NUMBER PE-2004000070	
	WINDESS LUNG	


UNIT	Area (sqft)	OCCUPANCY CLASSIFICATION	Occupant Density #/1000 sqft	People outdoor airflow rate in breathing zone, (Rp) cfm/person	Area outdoor airflow rate in breathing zone, (Ra) cfm/sqft	Exhaust airflow rate cfm/sqft	Breathing zone outdoor airflow (Vbz)	Zone air distribution effectivene ss (Ez)	Zone outdoor airflow (cfm)
		Education							
	255	Day care (through age 4)	25	10	0.18		110	0.8	137
	430	Classrooms (ages 58)	25	10	0.12		159	0.8	199
		Offices							
	3110	Office spaces	5	5	0.06		264	0.8	330
XISTING	260	Reception areas	30	5	0.06		55	0.8	68
RTU-3 THRU	255	Break Room	25	5	0.06		47	0.8	59
RTU-7	490	Main entry lobbies	10	5	0.06		54	0.8	67
		Public spaces							
	1450	Corridors	0	0	0.06		87	0.8	109
	530	Toilet rooms public	0	0	0	50/70	0	0.8	0
		Sports and amusement							
	1710	Gym, stadium, arena (play area)	7	20	0.18		547	0.8	684
								Total	1654


	EXHAUST FAN SCHEDULE												
				EXTERNAL		ELECTRICA	AL.						
MARK	MFGR	MODEL	CFM	STATIC P. IN. WG.	RPM	VOLT/Ø/HZ	PWR	FAN TYPE	CONTROLS	NOTES			
EF-1	СООК	GC-128	75	0.25	750	120/1/60	29 W	CEILING EXH.	SWITCH	1			


NOTES: 1. PROVIDE CEILING GRILLE, INTEGRAL BACK DRAFT DAMPER, VARI-SPEED CONTROLLER (NEAR FAN AND ABOVE CEILING), FACTORY MEANS OF DISCONNECT AND WEATHER

	DIFFUSER SCHEDULE													
MARK	MFGR		MODEL	BORDE	R TYPE	NECK SIZE	FACE SIZE	FINISH		FINISH		DAMPER	ACCESSORIES	NOTES
SD-1	TIT	TUS	TMS	;	3	8"Ø	24"x24"	WHITE		WHITE		-	-	-
RG-1			PAR			16"Ø	24"x24"			-	-	-		
TG-1		<b>†</b>	350RL	1	1	14"x8"	ı	١		-	-	-		

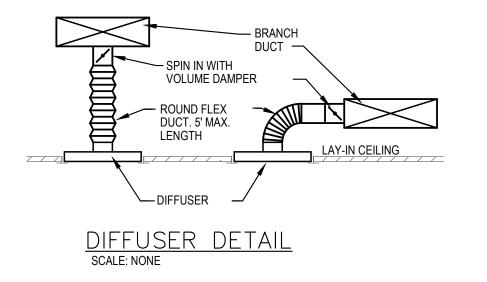

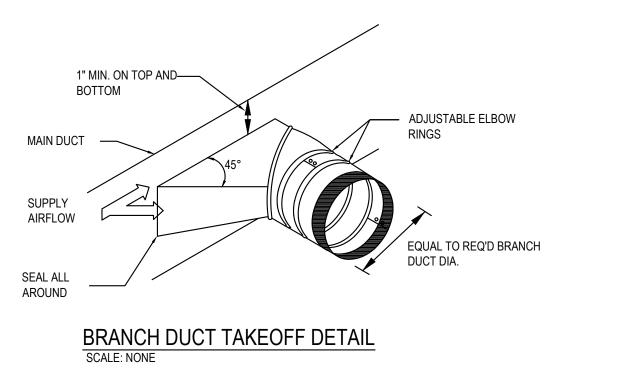

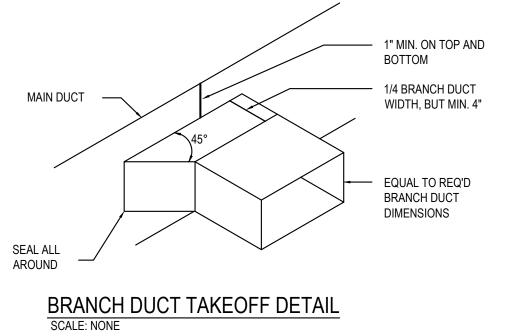


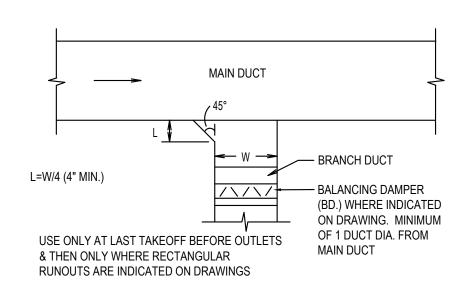

BRANCH DUCT TAKEOFF DETAIL
SCALE: NONE

BC PROJECT #: 25215 MISSOURI PE COA #2009003629 This drawing has been prepared by the Engineer, or under his supervision. This drawing is provided as an instrument of service by the Designer/Engineer and is intended for use on this project only. Pursuant to the Architectural Works Copyright Protection Act of 1990, all drawings, specifications, ideas and designs, including the overall form, arrangement and composition of spaces and elements appearing herein, constitute the original, copyrighted work of the Designer/Engineer. Any reproduction, use, or disclosure of information contained herein without prior written consent of the Engineer is strictly prohibited. © 2025 BC Engineers, Inc.



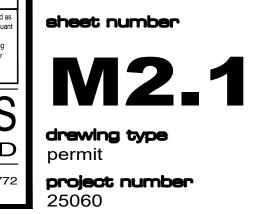

tenant finish for

**date** 04.03.2025

drawn by sp/rc checked by ek/ds

revisions

INTERFERENCES.

MATCH EXISTING.

1. INSTALL ALL PIPE, ETC. AS HIGH AS POSSIBLE.

SYSTEMS FROM THE STRUCTURE.

PLUMBING SYMBOLS

- $\times$ 200 $\times$ -

FD ⊘

FCO 🔘

Bldg Utility

Office 138

Office 110

PLUMBING PLAN NOTES:

INSTALLATION OF ANY PIPING.

119

LAW-EX

LÁV-EX

LAV-EX v <del>WÇEX</del>S

HWC-EX

EXTEND AND CONNECT 3" WASTE TO EXISTING WASTE PIPING AS REQUIRED. VERIFY EXACT LOCATION, DEPTH AND DIRECTION OF FLOW OF EXISTING WASTE PIPE PRIOR TO INSTALLATION OF ANY PIPING.

EXTEND AND CONNECT 3/4" CW TO EXISTING DOMESTIC CW AS REQUIRED. VERIFY EXACT LOCATION PRIOR TO INSTALLATION OF ANY PIPING.

EXTEND AND CONNECT  $\frac{1}{2}$ " HW TO EXISTING DOMESTIC HW AS REQUIRED. VERIFY EXACT LOCATION PRIOR TO INSTALLATION OF ANY PIPING.

EXTEND AND CONNECT 2" VENT TO EXISTING VENT PIPING AS REQUIRED. VERIFY EXACT LOCATION PRIOR TO

EXISTING PLUMBING FIXTURE TO REMAIN. CLEAN TO 'LIKE NEW' CONDITION. VERIFY LAVATORY HAS ASSE 1070

BC PROJECT #: 25215

PE COA #2009003629

INCORPORATED

to the Architectural Works Copyright Protection Act of 1990, all drawings, specifications, ideas and

5720 Reeder Shawnee, KS 66203 (913)262-17

MISSOURI

EXISTING PLUMBING FIXTURE TO REMAIN. CLEAN TO 'LIKE NEW' CONDITION.

LISTED MIXING VALVE (SET TO 110°F), INSTALL NEW IF NONE ARE PRESENT.

COORDINATE EXACT ROUTING OF PIPING TO AVOID EXISTING COLUMN/FOOTING.

Office 124

White Gym

Copy / Print

106

Corridor 102

Office Mgr

104

PLUMBING FLOOR PLAN
SCALE: 1/8" = 1'-0"

Office 127

Office 128

129

100

Waiting Room

Office 103

Office 123

 $\square \boxtimes$ 

Treehouse Gym 107

Office 122

Baby Room

Feeding

135

4301 Indian Creek Parkway Overland Park, KS 68207

phone: 913.451.9390 www.devideonee.com

CONSTRUCTION As Noted on Plans Review



dete 04.03.2025 drewn by sp/rc checked by ek/ds revisions

This drawing has been prepared by the Engineer, or under his supervision. This drawing is provided an instrument of service by the Designer/Engineer and is intended for use on this project only. Pursu sheet number designs, including the overall form, arrangement and composition of spaces and elements appearing herein, constitute the original, copyrighted work of the Designer/Engineer. Any reproduction, use, or drawing type

project number

FIRE PROTECTION NOTES:

- 1. THE EXISTING SPACE IS PROTECTED WITH AN EXISTING WET PIPE SPRINKLER SYSTEM. RELOCATE AND PROVIDE ADDITIONAL SPRINKLER HEADS AND PIPING AS REQUIRED FOR THE NEW CONSTRUCTION. SPRINKLER HEADS IN FINISHED CEILINGS SHALL BE SEMI-RECESSED PENDENT TYPE (VERIFY FINISH). SPRINKLER HEADS IN ROOMS WITHOUT CEILINGS SHALL BE UPRIGHT BRASS TYPE HEADS.
- 2. SPRINKLER WORK SHALL BE PERFORMED BY A LICENSED SPRINKLER CONTRACTOR PRE-APPROVED BY THE OWNER/LANDLORD.
- 3. REFER TO ARCHITECTURAL DRAWINGS FOR NEW WALL CONSTRUCTION.
- 4. SPRINKLER PIPING SHALL MATCH EXISTING AND COMPLY WITH NFPA 13.
- 5. SPRINKLER SYSTEM (SHOP DRAWINGS) SHALL BE APPROVED BY THE LOCAL FIRE AUTHORITY AND OWNER'S/LANDLORD'S INSURANCE CARRIER PRIOR TO START OF WORK.

### 6. NO PIPING SHALL BE ROUTED OVER THE TOP OF ELECTRICAL PANELS.

7. ALL MATERIALS WITHIN PLENUMS SHALL BE NONCOMBUSTIBLE OR SHALL HAVE A FLAME SPREAD INDEX OF NOT MORE THAN 25 AND A SMOKE-DEVELOPED INDEX OF NOT MORE THAN 50 WHEN TESTED IN ACCORDANCE WITH ASTM E 84.

2. COORDINATE ALL WORK WITH OTHER TRADES AND EXISTING CONDITIONS AS REQUIRED TO PROPERLY

3. REFER TO ARCHITECTURAL DRAWINGS FOR EXACT LOCATIONS AND MOUNTING HEIGHTS OF FIXTURES.

4. REFER TO ARCHITECTURAL & STRUCTURAL DRAWINGS FOR REQUIREMENTS FOR SUPPORTING PIPING,

5. SAWCUT EXISTING FLOOR AS REQUIRED FOR INSTALLATION OF UNDERFLOOR PIPING. PATCH FLOOR TO

INSTALL ALL SYSTEMS AS INTENDED, WITHIN THE CONFINES OF THE SPACES AVAILABLE, AND WITHOUT

EQUIPMENT, ETC. FROM THE STRUCTURE. PROVIDE ADDITIONAL STEEL AS REQUIRED TO PROPERLY SUPPORT

- 8. CONTRACTOR TO TEST WATER PRESSURE ON SITE AND PROVIDE PRESSURE REDUCING VALVE ON WATER SERVICE IF PRESSURE IS OVER 80 PSI.
- ALL WATER SERVICE INSTALLATIONS INCLUDING BACKFLOW DEVICES ARE SUBJECT TO FIELD VERIFICATION AND APPROVAL BY THE WATER DEPARTMENT INSPECTOR.

SOIL AND WASTE PIPING BELOW FLOOR/GRADE

SOIL AND WASTE PIPING ABOVE FLOOR/GRADE

SANITARY VENT PIPING ABOVE GRADE

SANITARY VENT PIPING BELOW GRADE

DOMESTIC COLD WATER PIPING

DOMESTIC HOT WATER PIPING

EQUIPMENT DRAIN LINE

PIPING TURNING DOWN

PIPING TURNING UP

TEE TOP CONNECTION

BACKFLOW PREVENTER

FLOOR DRAIN

FLOOR CLEAN OUT

WALL CLEAN OUT

BALANCING VALVE

SOLENOID VALVE

CHECK VALVE

DIAGRAM

PRESSURE REGULATOR

CONNECT TO EXISTING

INVERT ELEVATION OF PIPE


MATCH MARKS ON PLUMBING RISER


### PLUMBING FIXTURE SCHEDULE:

- HWC HANDICAP WATER CLOSET: TOTO, #CST744SL, "DRAKE CLOSE COUPLED TOILET", 1.6 GALLON FLUSH, 16-1/2" HIGH ELONGATED BOWL, FLOOR MOUNTED, FLOOR OUTLET, TANK TYPE, VITREOUS CHINA, SIPHON-JET ACTION, #SC534 OPEN FRONT SEAT WITH CHECK HINGE AND LESS COVER, CHROME PLATED ANGLE STOP AND RISER. HANDLE ON WIDE SIDE OF FIXTURE.
- HANDICAP LAVATORY, WALL HUNG: AMERICAN STANDARD, #0355.012, "LUCERNE", 20"X 18", VITREOUS CHINA, FRONT OVERFLOW, #2385.130 VANDAL-RESISTANT FAUCET WITH SINGLE METAL LEVER HANDLE #7723.018 OFFSET GRID ELBOW DRAIN AND 1-1/4" TAILPIECE, CHROME PLATED CAST BRASS P-TRAP WITH CLEANOUT (MOUNTED PARALLEL WITH WALL), CHROME PLATED ANGLE STOPS AND RISERS, AND CONCEALED ARM FLOOR MOUNTED FIXTURE SUPPORT. INSULATE EXPOSED DRAIN, WATER SUPPLIES, AND VALVES WITH PROWRAP SEAMLESS MOLDED CLOSED CELL VINYL INSULATION.
- FLOOR DRAIN: JR SMITH, #2005-A, CAST IRON FLOOR DRAIN WITH ADJUSTABLE TOP, 6" NIKALOY STRAINER. PROVIDE WITH #2692 QUAD CLOSE TRAP SEAL DEVICE.
- MIXING VALVE: WATTS, #LFUSG-B, THERMOSTATIC CONTROLLED MIXING VALVE, LEAD FREE BRONZE BODY, LOCKED TEMPERATURE ADJUSTMENT CAP (VANDAL RESISTANT), COPPER ENCAPSULATED THERMOSTAT ASSEMBLY WITH BRASS SHUTTLE, STAINLESSSTEEL SPRINGS, INTEGRAL CHECK VALVES ON HOT AND COLD INLETS. (SET TO 110°F).

PLUMBING FIXTURE BRANCH PIPING SCHEDULE								
FIXTURE	WASTE	VENT	CW	HW				
WATER CLOSET (TANK TYPE)	3"	2"	1/2"					
LAVATORY	1-1/4"	1-1/4"	1/2"	1/2"				
FLOOR DRAIN	2"	2"						

NOTE: INDIVIDUAL VENTS FOR FIXTURES ON PLANS AND RISER DIAGRAMS HAVE BEEN INCREASED WHERE HORIZONTAL VENT LENGTH IS IN EXCESS OF THE MAXIMUM DISTANCE INDICATED BY THE CODE.

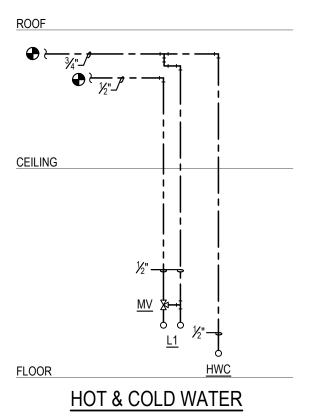

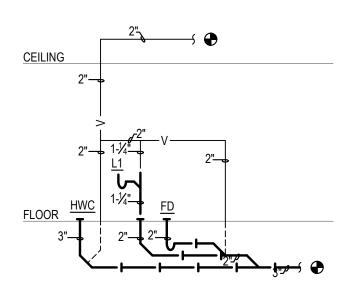

PLUMBING RISER DIAGRAMS

# KEYPLAN scale: none

WASTE & VENT

C. ALL WORK SHALL BE PERFORMED IN ACCORDANCE WITH THE LATEST APPROVED EDITION OF THE NATIONAL ELECTRIC CODE (NEC), AND ALL APPLICABLE LAWS, CODES AND REGULATIONS OF THE

D. ALL TESTING REQUIRED BY AUTHORITIES SHALL BE CONSIDERED PART OF THIS WORK.

GOVERNMENTAL BODIES HAVING JURISDICTION OVER THE SITE.

E. DURING CONSTRUCTION, ALL FIXTURES, EQUIPMENT, CONDUIT, ETC. SHALL BE COVERED, PLUGGED, OR CAPPED AS REQUIRED TO KEEP CLEAN AND UNDAMAGED. ALL DAMAGED ITEMS SHALL BE RESTORED TO ORIGINAL CONDITION OR REPLACED. ALL PROTECTIVE COVERING SHALL BE REMOVED BEFORE FINAL

F. PROVIDE ALL NECESSARY CUTTING AND PATCHING OF WALLS, FLOORS, CEILINGS, AND ROOFS AS NECESSARY. PATCH AROUND ALL OPENINGS SHALL MATCH ADJACENT AREA. COORDINATE ALL ROOFING WORK WITH OWNER OR RESPONSIBLE PARTY, SO THAT THE EXISTING ROOFING WARRANTY

G. CONTRACTOR SHALL GUARANTEE ALL WORK AND MATERIALS AGAINST DEFECTS FOR A PERIOD OF

H. CONTRACTOR SHALL PROVIDE ACCESS PANELS WHERE NECESSARY FOR CONCEALED ELECTRICAL

. CONTRACTOR SHALL PROMPTLY CALL ENGINEERS ATTENTION TO ANY APPARENT CONTRADICTIONS, AMBIGUITIES, ERRORS, DISCREPANCIES, OR OMISSIONS IN THE PLANS OR SPECIFICATIONS.

2. OPERATION AND MAINTENANCE MANUALS:

A. DURING THE COURSE OF CONSTRUCTION, COLLECT AND COMPILE OPERATING INSTRUCTIONS, WIRING AGRAMS, CATALOG CUTS, LUBRICATION AND PREVENTIVE MAINTENANCE INSTRUCTIONS, PARTS LISTS, ETC. FOR ALL EQUIPMENT FURNISHED UNDER THIS CONTRACT.

B. ALL LITERATURE AND INSTRUCTIONS SHIPPED WITH THE EQUIPMENT SHALL BE SAVED FOR INCLUSION IN THE OPERATION AND MAINTENANCE MANUALS.

C. ALL LITERATURE LISTED ABOVE AND ALL PAPERS LISTING WARRANTIES, ETC. SHALL BE COLLATED AND LABELED WITH THE PROJECT NAME, ADDRESS, ARCHITECT, ENGINEER, CONTRACTORS, ETC. DOCUMENTS SHALL BE COMPILED AND BOUND IN DIGITAL FILE OR 3 RING BINDER.

A. MANUFACTURERS. MODEL NUMBERS. ETC. INDICATED OR SCHEDULED ON THE DRAWINGS SHALL BE INTERPRETED AS HAVING ESTABLISHED A STANDARD OF QUALITY AND SHALL NOT BE CONSTRUED AS LIMITING COMPETITION. ARTICLES, FIXTURES, ETC. OF EQUAL QUALITY BY MANUFACTURERS SHALL BE ACCEPTABLE, SUBJECT TO STRUCTURAL AND ELECTRICAL CONSTRAINTS OF THE PROJECT DESIGN,

4. TESTING, AND BALANCING:

A. ALL CIRCUITS SHALL BE TESTED FOR CONTINUITY, SHORTS, AND GROUNDS BEFORE CONNECTING TO THE PROPER PHASE AS DESIGNED TO BALANCE THE LOADING BETWEEN PHASES.

B. POWER AND LIGHTING PANELS SHALL BE PROPERLY PHASED TO DISTRIBUTE THE LOAD AND SHALL BE CONNECTED AND ADJUSTED TO OPERATE AS SPECIFIED.

C. ALL MOTORS AND SIMILAR EQUIPMENT SHALL BE CHECKED FOR PROPER PHASE ROTATION AND OPERATION.

A. CONDUIT INSIDE THE BUILDING SHALL BE METALLIC TUBING (EMT), BEARING THE UL LABEL, WITH COMPRESSION TYPE FITTINGS OR SCREW SET FITTINGS

B. CONDUIT EXPOSED TO THE WEATHER, INSTALLED UNDERGROUND, IN CONCRETE, OR USED FOR SERVICE ENTRANCE SHALL BE STANDARD RIGID CONDUIT (GALVANIZED) WITH THREADED FITTINGS.

C. UNDERGROUND CONDUIT MAY BE POLYVINYL CHLORIDE WITH A DEFLECTION TEMPERATURE, UNDER LOAD AT 264 PSI, OF 78 DEGREES C, AND A TENSILE STRENGTH OF 5,200 PSI. JOINTS SHALL BE FLUSH SOLVENT WELDED IN ACCORDANCE WITH THE MANUFACTURER'S INSTRUCTIONS. CONDUIT SHALL BE EQUAL TO CARLON POWER AND COMMUNICATIONS DUCT TYPE DB (DIRECT BURIAL). CONDUIT AND FITTINGS SHALL BE PRODUCED BY THE SAME MANUFACTURER.

D. FLEXIBLE METAL CONDUIT SHALL ONLY BE USED FOR CONNECTIONS TO MOTORS. TRANSFORMERS, AND LIGHT FIXTURES. MAXIMUM LENGTH SHALL BE 6'-0".

A. WIRES SHALL BE CONTINUOUS WITHOUT SPLICES OR TAPS IN CONDUIT RUNS. ALL SPLICES SHALL BE MADE IN JUNCTION, PULL, OR OUTLET BOXES. ALL WIRE SHALL BE INSTALLED IN CONDUIT, WIREWAYS, OR OTHER PROTECTIVE COVER SANCTIONED BY CODES.

B. CONDUCTORS FOR LIGHTING AND POWER SHALL BE COPPER, MINIMUM NO. 12 A.W.G., 600 VOLT.

C. NO. 10 GAUGE AND SMALLER CONDUCTORS SHALL BE TYPE THWN (WET LOCATIONS) OR THHN (DRY LOCATIONS), SOLID CONDUCTOR, UNLESS OTHERWISE INDICATED.

D. NO. 8 GAUGE AND LARGER CONDUCTORS SHALL BE TYPE THWN (WET LOCATIONS) OR THHN (DRY LOCATIONS), STRANDED, UNLESS OTHERWISE INDICATED.

E. SERVICE ENTRANCE AND PANEL FEEDER CONDUCTORS, NO. 3 GAUGE AND LARGER SHALL BE TYPE

A. MC CABLE SHALL CONSIST OF INTERLOCK ARMORED CABLE MADE OF THREE OR FOUR TYPE THHN SOLID (#8 AWG AND LARGER MAY BE STRANDED) COPPER CONDUCTORS RATED 90°C FOR DRY LOCATIONS, WITH NYLON OR EQUIVALENT UL LISTED JACKET, PER UL STANDARD 83

THE THREE CONDUCTORS SHALL BE TWISTED TOGETHER WITH THE COPPER GROUNDING CONDUCTOR SUITABLE FILLERS AND WRAPPED IN BINDER TAPE. THE ASSEMBLY SHALL BE

ARMORED WITH SPIRALLY WRAPPED INTERLOCKED ARMOR OF ALUMINUM OR GALVANIZED

B. CABLES SHALL BE TESTED IN ACCORDANCE WITH UL STANDARD 1569 FOR TYPE MC CABLE AND RATED AT 600 VOLTS, 90 DEG. C FOR DRY LOCATIONS AND 75 DEG. C FOR WET LOCATIONS.

A. WALL SWITCHES SHALL BE SPECIFICATION GRADE, QUIET TYPE, FLUSH TOGGLE SWITCH, RATED FOR 20 AMPS, WITH THERMOPLASTIC COVER PLATES.

1) SINGLE POLE: HUBBELL #CS1221-X, OR EQUAL.

2) THREE WAY: HUBBELL #CS1223-X, OR EQUAL. 3) AS SPECIFIED ON PLANS

B. RECEPTACLES SHALL BE SPECIFICATION GRADE, DUPLEX, GROUNDING, THREE-WIRE TYPE, RATED FOR 20 AMPS, WITH THERMOPLASTIC COVER PLATES. HUBBELL #CR5352-X, OR EQUAL.

C. GROUND FAULT INTERRUPTER RECEPTACLES (GFI) SHALL BE HUBBELL #GF20-XL. DEVICE COVER PLATES SHALL BE AS HEREINBEFORE SPECIFIED.

D. ISOLATED GROUND RECEPTACLES (IG) SHALL BE HUBBELL #CR5352IG, ORANGE COLOR. DEVICE

COVER PLATES SHALL BE AS HEREINBEFORE SPECIFIED. E. RECEPTACLES OUTSIDE BUILDING AND WHERE NOTED AS WEATHERPROOF, SHALL BE LISTED 'WEATHER-RESISTANT' HUBBEL #GFTR20-X OR EQUAL AND SHALL BE INSTALLED IN A WEATHERPROOF ENCLOSURE

WHICH SHALL BE INTERMATIC #WP1010MXD OR #WP1010HMXD DIECAST METAL WEATHERPROOF RECEPTACLE COVER. COVER SHALL BE WEATHER PROOF RATED WHILE IN USE.

A. HOT DIPPED GALVANIZED STEEL BOXES. PROVIDE TYPE TO SUIT CONDITIONS FOR INSTALLATION.

B. ALL BOXES SHALL BE FLUSH MOUNTED, UNLESS INDICATED OTHERWISE.

F. VERIFY DEVICES AND DEVICE COVERPLATES COLOR AND STYLE WITH ARCHITECT.

10. PANELBOARDS:

A. PANELBOARDS ARE EXISTING AND SHALL BE REUSED. PROVIDE ADDITIONAL BREAKERS AS REQUIRED TO CONNECT CIRCUITS AS SHOWN ON THE DRAWINGS. ADDITIONAL BREAKERS SHALL BE THERMAL MAGNETIC QUICK-BREAK BOLT ON CIRCUIT BREAKERS WITH ONE HANDLE FOR SINGLE OR MULTI-POLE RATINGS AND

B. COMPLETE EXISTING DIRECTORY AS REQUIRED TO IDENTIFY NEW CIRCUIT, LISTING LOAD SERVED AND

A. DISCONNECTS SHALL BE EXTERNALLY OPERATED. QUICK-MAKE. QUICK-BREAK. SAFETY. WITH PROVISIONS FOR PAD LOCKING. FUSED AND NON-FUSED DISCONNECT SWITCHES SHALL BE PROVIDED AS INDICATED.

B. INDOOR SWITCHES SHALL BE NEMA I AND OUTDOOR SWITCHES SHALL BE NEMA 3R, UNLESS INDICATED 12. FUSES:

A. FUSES PROTECTING CIRCUIT BREAKER PANELS SHALL BE CURRENT LIMITING U.L. CLASS RK-1 FUSES WITH 200,000 AMPERES RMS SYM INTERRUPTING CAPACITY. FUSING ELEMENTS SHALL BE SILVER FOR

B. ALL OTHER FUSES SHALL BE U.L. CLASS RK-5, DUAL-ELEMENT WITH A MINIMUM TIME-DELAY OF 10 SECONDS AT 500% RATING. FUSES SHALL HAVE CURRENT-LIMITING SHORT-CIRCUIT LINKS AND 200,000 AMPERES RMS SYM INTERRUPTING CAPACITY. FUSING ELEMENTS SHALL BE COPPER.

13. LIGHT FIXTURES:

A. WHERE LIGHT FIXTURES ARE MOUNTED IN A LAY-IN CEILING, PROVIDE A MINIMUM OF 2 SUPPORT WIRES ATTACHED DIRECTLY BETWEEN EACH LIGHT FIXTURE AND THE BUILDING STRUCTURE. SUPPORT WIRES SHALL BE A MINIMUM OF 12 GAUGE GALVANIZED STEEL WIRE, SOFT ANNEALED.

B. FIXTURES ARE REQUIRED AT ALL LIGHTING OUTLETS SHOWN ON THE DRAWINGS. APPROVED LIGHTING FIXTURE WIRE IS REQUIRED IN ALL FIXTURES AND FIXTURE RACEWAYS. WEATHERPROOF WIRING IS REQUIRED FOR EXTERIOR FIXTURES. ALL PARTS OF FIXTURES AND WIRING SHALL BE IN ACCORDANCE

WITH NEC REQUIREMENTS. C. ALL FIXTURES SHALL CARRY UL AND ETL LABELS.

### ELECTRICAL SPECIFICATIONS (CONTINUED)

A. PROVIDE, SET, AND PROPERLY LOCATE PIPE SLEEVES AS REQUIRED FOR THIS WORK.

B. INTERIOR PARTITIONS: 16 GAGE GALVANIZED STEEL, PACK BETWEEN CONDUIT AND SLEEVE WITH FIRE SAFING AND CAULK AT EACH END WITH FIRE RESISTANT SEALANT.

C. ROOF: PROSET OR EQUAL, MANUFACTURED PVC SCHEDULE 40 PIPE SLEEVE WITH WEATHERPROOF SEAL COORDINATE WITH ROOFING CONTRACTOR AND FLASH AS REQUIRED TO MAINTAIN ROOF WARRANTY.

A. GROUND ALL ELECTRICAL APPARATUS IN ACCORDANCE WITH THE NATIONAL ELECTRIC CODE (NEC) 250, AND ANY LOCAL REQUIREMENTS. INSURE CONTINUOUS BOND WHERE FLEXIBLE CONDUIT IS USED. PROVIDE BONDING JUMPER INSIDE ALL FLEXIBLE CONDUIT.

B. BOND METAL PIPING SYSTEMS IN COMPLIANCE WITH NEC 250.4(A)(4).

16. REMODELING WORK:

A. DEMOLITION: DISCONNECT, DEMOLISH AND REMOVE ABANDONED ELECTRICAL MATERIALS AND EQUIPMENT INDICATED TO BE REMOVED AND NOT INDICATED TO BE SALVAGED OR REMAIN.

B. EQUIPMENT TO BE SALVAGED:

1) DISCONNECT AND REMOVE EXISTING ELECTRICAL EQUIPMENT INDICATED TO BE REMOVED AND SALVAGED. DELIVER EQUIPMENT TO THE LOCATION DESIGNATED BY THE OWNER FOR STORAGE.

2) ALL MATERIALS AND EQUIPMENT DESIGNATED TO BE REUSED OR RELOCATED SHALL BE CAREFULLY REMOVED, AND STORED UNTIL NEEDED FOR REMODELING WORK. ALL ITEMS SHALL BE RESTORED TO "LIKE NEW" CONDITION WITH RUST OR CORROSION REMOVED. SURFACE PAINT TOUCHED UP OR REPAINTED AS REQUIRED TO MATCH NEW CONSTRUCTION, AND THOROUGHLY CLEANED AND INSPECTED. ANY ITEMS WHICH BECOME DAMAGED BEYOND REPAIR AS A RESULT OF CONSTRUCTION OR DEMOLITION ACTIVITY SHALL BE REPLACED WITH NEW MATERIAL EQUIVALENT IN EVERY RESPECT.

C. DISPOSAL AND CLEANUP: REMOVE FROM THE SITE AND LEGALLY DISPOSE OF DEMOLISHED MATERIALS AND EQUIPMENT NOT INDICATED TO BE SALVAGED.

D. PROTECT ADJACENT MATERIALS INDICATED TO REMAIN. INSTALL AND MAINTAIN DUST AND NOISE BARRIERS TO KEEP DIRT, DUST, AND NOISE FROM BEING TRANSMITTED TO ADJACENT AREAS. REMOVE PROTECTION AND BARRIERS AFTER REMODELING OPERATIONS ARE COMPLETE.

E. PROVIDE ALL ALTERATIONS AND REWORK INDICATED AND/OR REQUIRED FOR THE PROPER INSTALLATION AND OPERATION OF ALL EXISTING ELECTRICAL SYSTEMS, INTEGRATING THE NEW AND EXISTING AREAS. LOCATE, IDENTIFY, AND PROTECT ELECTRICAL SERVICES PASSING THROUGH REMODELING AREA AND SERVING OTHER AREAS OUTSIDE THE REMODELING LIMITS. MAINTAIN SERVICES TO AREAS OUTSIDE REMODELING LIMITS. WHEN SERVICES MUST BE INTERRUPTED, INSTALL TEMPORARY SERVICES FOR

1) ABANDONED CONDUIT SHALL HAVE WIRE REMOVED AND SHALL BE CAPPED. ABANDONED OUTLETS IN WALLS OR PARTITIONS SHALL HAVE DEVICES AND WIRE REMOVED, AND SHALL BE COVERED.

2) WHERE EXISTING CONDUITS TERMINATE AT AN EXISTING OUTLET IN A WALL, CEILING, OR FLOOR TO BE REMOVED, DISCONNECT AND REMOVE DEVICE AND WIRE FROM CONDUIT. CONDUIT SHALL BE CUT BACK AND CAPPED (BELOW THE FLOOR OR ABOVE THE CEILING) SO NOT TO CREATE AN OBSTRUCTION. PATCH FLOOR TO MATCH EXISTING.

3) WHERE EXISTING CIRCUITS EXTEND BEYOND THE OUTLET IN THE EXISTING WALL, CEILING, OR FLOOR TO BE REMOVED, FURNISH AND INSTALL NEW CONDUIT AND WIRE TO EITHER REPOUTE THE CIRCUIT OR FEED THE REMAINING OUTLET(S) FROM ANOTHER ELECTRICAL SOURCE, BUT IN SUCH A MANNER AS NOT TO REVISE THE CIRCUIT. ALL REROUTED CONDUIT SHALL BE APPROVED BY THE

4) WHERE EXISTING OUTLETS IN A WALL, CEILING, OR FLOOR TO BE REMOVED ARE ESSENTIAL TO MAINTAIN OPERATION OF OTHER REMAINING OUTLETS, RELOCATE THE OUTLET TO A NEW CONVENIENT LOCATION. EXISTING WIRING DEVICES SHALL NOT BE REUSED, UNLESS OTHERWISE INDICATED.

5) WHERE LIGHTING FIXTURES ARE INDICATED TO BE DEMOLISHED, REMOVE ALL WIRE AND MODIFY THE EXISTING CONDUIT (IF APPLICABLE) FOR THE NEW LIGHTING. ALL UNUSED CONDUIT SHALL BE

6) WHERE A TELEPHONE CIRCUIT EXTENDS BEYOND AN OUTLET IN AN EXISTING WALL, CEILING, OR FLOOR TO BE REMOVED, PROVIDE NECESSARY EMPTY CONDUIT AND NOTIFY THE OWNER WHO WILL REQUEST THE OWNER TO ARRANGE WITH THE TELEPHONE COMPANY FOR NEW WIRING TO OUTLETS THAT

7) WHERE EXISTING CONDUIT AND WIRE RUNS ARE LOCATED IN OR ATTACHED TO AN EXISTING WALL, CEILING OR FLOOR TO BE REMOVED, THEY SHALL BE REROUTED IN EITHER NEW OR EXISTING CONSTRUCTION TO MAINTAIN CONTINUITY OF CIRCUITS UNLESS OTHERWISE INDICATED.

8) CONDUIT SHALL BE CONCEALED WITHIN THE EXISTING BUILDING CONSTRUCTION WHEREVER POSSIBLE, EXCEPT WHERE OTHERWISE INDICATED.

9) EXISTING WIRE SHALL BE DISCONNECTED AND REMOVED WHEREVER EXISTING CIRCUITS ARE

A. OUTLET BOXES THAT DO NOT EXCEED 16 SQUARE INCHES AND INSTALLED IN FIRE RATED WALLS SHALL NOT BE INSTALLED CLOSER THAN 24" HORIZONTAL INCHES TO OTHER OUTLET BOXES.

PROTECTED WITH LISTED PUTTY PADS, 3M FIRE BARRIER MOLDABLE PUTTY + OR EQUAL.

B. IF BOXES MUST BE INSTALLED WITHIN 24" OF EACH OTHER THAN BOTH OUTLET BOXES SHALL BE

**ELECTRICAL SYMBOLS LIST** 

CIRCUITING & NOTES +46" SPECIAL MOUNTING HEIGHT FOR ASSOCIATED DEVICE (CENTERLINE OF DEVICE)

GFI GROUND FAULT CIRCUIT INTERRUPTER DEVICE WP WEATHERPROOF ENCLOSURE ON DEVICE

R EXISTING DEVICE TO BE RELOCATED EXISTING DEVICE TO REMAIN

PARTIAL HOMERUN. REFER TO PLANS FOR ADDITIONAL DEVICES CONNECTED TO THIS

ELECTRICAL FLOOR PLAN NOTE WITH DESIGNATION CONDUIT CONCEALED WHERE POSSIBLE OR AS NOTED, ARROWS INDICATE HOME RUN TO

PANEL. CIRCUIT NUMBERS INDICATED #12 WIRE IN CONDUIT, UNLESS NOTED OTHERWISE ON DRAWINGS OR SPECIFICATION GROUNDING CONDUCTOR, #12 WIRE UNLESS NOTED OTHERWISE ON DRAWINGS OR

SPECIFICATION CONDUIT ROUTED UNDER FLOOR/GRADE

EMERGENCY TWIN HEAD LIGHT FIXTURE **121** EXIT LIGHT WITH DIRECTIONAL ARROWS INDICATED

STRIP FIXTURE WITH TYPE DESIGNATION RECESSED OR SURFACE MOUNTED FIXTURE WITH TYPE DESIGNATION

NIGHT LIGHT, CONNECT TO UNSWITCHED CIRCUIT

A CEILING OR RECESSED FIXTURE WITH TYPE DESIGNATION

WALL MOUNTED FIXTURE WITH TYPE DESIGNATION

DUPLEX RECEPTACLE, BOTTOM OF BOX AT 16" AFF, UNLESS NOTED OTHERWISE

FOURPLEX RECEPTACLE, BOTTOM OF BOX AT 16" AFF, UNLESS NOTED OTHERWISE

DEVICE MOUNTED ABOVE COUNTER AND/OR SPLASH GUARD HEAVY DUTY OUTLET - NEMA CONFIGURATION SIZE PER EQUIPMENT MANUFACTURER'S RECOMMENDATION

PANEL BOARD, TOP OF BOX 6'-0" AFF JUNCTION BOX

NON-FUSED DISCONNECT SWITCH FUSED DISCONNECT SWITCH

MOTOR WITH DESIGNATION

S SINGLE POLE WALL SWITCH, TOP OF BOX AT 48" AFF THREE-WAY WALL SWITCH, TOP OF BOX AT 48" AFF

S m MANUAL MOTOR STARTER WITH OVERLOADS

FIRE ALARM - FIRE ALARM SYSTEM IS EXISTING TO REMAIN. PROVIDE ADDITIONAL COMPATIBLE DEVICES AND CONNECT TO EXISTING SYSTEM AS REQUIRED.

SD | CEILING MOUNT SMOKE DETECTOR

DD DUCT MOUNT SMOKE DETECTOR

HD CEILING MOUNT HEAT DETECTOR

FIRE ALARM PULL STATION, TOP OF BOX AT 48" AFF

FIRE ALARM AUDIBLE/VISUAL COMBINATION SIGNAL, CENTERLINE AT 6'-8" AFF

FIRE ALARM AUDIBLE/VISUAL COMBINATION SIGNAL, CEILING MOUNTED

FIRE ALARM VISUAL STROBE, CENTERLINE AT 6'-8" AFF

FIRE ALARM VISUAL STROBE, CEILING MOUNTED

**ELECTRICAL GENERAL NOTES:** 

MATCH EXISTING SURFACE AS REQUIRED.

ACCORDANCE WITH ASTM E 84.

NEC ARTICLE 406.

1. COORDINATE ALL WORK WITH OTHER TRADES AND EXISTING CONDITIONS AS REQUIRED TO PROPERLY

INSTALL ALL SYSTEMS AS INTENDED, WITHIN THE CONFINES OF THE SPACES AVAILABLE, AND WITHOUT

2. WHERE CONDUIT IS SHOWN UNDER FLOOR, VERIFY IF FLOOR IS STRUCTURAL SLAB OR SLAB ON GRADE. IF

SAW CUT EXISTING FLOOR SLAB AS REQUIRED FOR INSTALLATION OF UNDER FLOOR CONDUIT. NO

3. IT IS THE ELECTRICAL CONTRACTORS RESPONSIBILITY TO PROPERLY BALANCE ALL BRANCH CIRCUITS

4. ALL EXPOSED RACEWAYS SHALL BE EMT CONDUIT, MC CABLE IS NOT PERMITTED IN EXPOSED AREAS.

ELECTRICAL CONTRACTOR SHALL REMOVE ALL EXISTING ELECTRICAL EQUIPMENT, FIXTURES, SYSTEMS,

6. ELECTRICAL CONTRACTOR TO COORDINATE MANUFACTURER ELECTRICAL REQUIREMENTS FOR HVAC

7. REFER TO ARCHITECTURAL DRAWINGS FOR EXACT LOCATION OF LIGHT FIXTURES AND DEVICES.

CONSTRUCTION. MAINTAIN PROPER OPERATION OF ALL EXISTING ELECTRICAL.

10. EACH BRANCH CIRCUIT SHALL HAVE A DEDICATED NEUTRAL PER NEC 210.4.

WITHOUT APPROVAL OF THE ARCHITECT OR ENGINEER.

EQUIPMENT BEING FURNISHED WITH MECHANICAL CONTRACTOR PRIOR TO ROUGH-IN. EQUIPMENT

DISCONNECTS TO BE PROVIDED BY ELECTRICAL CONTRACTOR UNLESS NOTED OTHERWISE IN MECHANICAL

8. ALL ELECTRICAL DEVICES ARE EXISTING AND TO REMAIN UNLESS NOTED OTHERWISE OR CONFLICT WITH NEW

9. ALL MATERIALS EXPOSED WITHIN PLENUMS SHALL BE NONCOMBUSTIBLE OR SHALL HAVE A FLAME SPREAD

11. FIRE ALARM SYSTEM IS SHOWN FOR SCHEMATIC PURPOSES. THE FIRE ALARM CONTRACTOR IS RESPONSIBLE

12. PLANS INDICATE MINIMUM WIRE SIZES PER NEC. ALL BRANCH CIRCUITS SHALL BE SIZED TO ALLOW FOR A

DROP. ELECTRICAL CONTRACTOR SHALL VERIFY WIRING INDICATED IS SUFFICIENT AND INCREASE

13. RECEPTACLES IN DWELLING, GUEST ROOMS, AND CHILD CARE FACILITIES SHALL BE TAMPER RESISTANT PER

SURFACE MOUNTED CONDUIT IN FINISHED SPACES MUST BE APPROVED BY THE ENGINEER OR ARCHITECT

15. PER NEC RECEPTACLES IN THE FOLLOWING ROOMS SHALL BE TAMPER RESISTANT: TREEHOUSE GYM 107,

PRIOR TO INSTALLATION. EXTERIOR CONDUIT SHALL NOT BE RUN EXPOSED IN PUBLICLY VISIBLE AREAS

GREEN GYM 108, WAITING 101, LOBBY 100, ALL CORRIDORS, FEEDING 135, BABY ROOM 139, WHITE GYM 140,

CONDUCTOR SIZE AS REQUIRED BASED OFF ACTUAL INSTALLED LENGTH OF CONDUCTORS.

WHEREVER POSSIBLE, CONDUIT SHALL BE RUN CONCEALED WITHIN WALLS, CEILINGS, SOFFITS, ETC.

FOR PROVIDING DESIGN AND SHOP DRAWINGS SUBMITTAL TO FIRE MARSHAL FOR APPROVAL AS REQUIRED BY

MAXIMUM OF 3% VOLTAGE DROP. ALL FEEDERS SHALL BE SIZED TO ALLOW FOR A MAXIMUM OF 2% VOLTAGE

THE FIRE MARSHAL. IT IS THE CONTRACTORS RESPONSIBILITY TO PROVIDE ADDITIONAL DEVICES, POWER

INDEX OF NOT MORE THAN 25 AND A SMOKE-DEVELOPED INDEX OF NOT MORE THAN 50 WHEN TESTED IN

BETWEEN THE PHASES OF THE SYSTEM REGARDLESS OF CIRCUITING INDICATED.

CONDUIT AND WIRE, ETC. NOT BEING REUSED. DO NOT JUST ABANDON.

STRUCTURAL ELEMENTS SHALL BE CORE DRILLED OR SAW CUT. WHEN SAW CUTTING, PATCH FLOOR TO

STRUCTURAL SLAB, CORE DRILL PENETRATION, AND ROUTE CONDUIT IN SPACE BELOW. IF SLAB ON GRADE,

erohitecture & engineering

4301 Indian Creek Parkway Overland Park, KS 66207 phone: 913.451.9390 www.devidsones.com

CONSTRUCTION As Noted on Plans Review

4/3/2025

04.03.2025

checked by

drewn by

sp/rc

ek/ds revisions

sheet number

5720 Reeder Shawnee, KS 66203 (913)262-177

BC PROJECT #: 25215 MISSOURI PE COA #2009003629 This drawing has been prepared by the Engineer, or under his supervision. This drawing is provided to the Architectural Works Copyright Protection Act of 1990, all drawings, specifications, ideas and designs, including the overall form, arrangement and composition of spaces and elements appearing herein, constitute the original, copyrighted work of the Designer/Engineer. Any reproduction, use, or

rohibited. © 2025 BC Engineers, Inc.

disclosure of information contained herein without prior written consent of the Engineer is strictly

4301 Indian Creek Parkway Overland Park, K8 68207 phone: 913.451.9390 www.davidsonae.com




LIGHTING PLAN NOTES:

1 RECONNECT TO EXISTING 20A/1P LIGHTING CIRCUIT IN AREA WITH #12 WIRE.

2 CONNECT TO SWITCHED LIGHTING CIRCUIT IN AREA #12 WIRE, EMERGENCY LIGHT SHALL BE UNSWITCHED. 3 RECONNECT TO EXISTING LIGHTING CIRCUIT IN ROOM WITH #12 WIRE.


		LIG	HT FIX	TURE SCHEDULE	
MARK N0.	MANUFACTURER & CATALOG NUMBER	VOLTS WATTS	LIGHT SOURCE	DESCRIPTION	EQUIVALENT MANUFACTURERS
<b>Ø</b>	DUAL-LITE EVE-U-R-W-E	UNV 1	INCL	EXIT LIGHT WITH LED LAMPS, RED LETTERS ON WHITE BACKGROUND, UNIVERSAL MOUNT, BATTERY BACKUP	SURE-LITES LITHONIA OR EQUAL

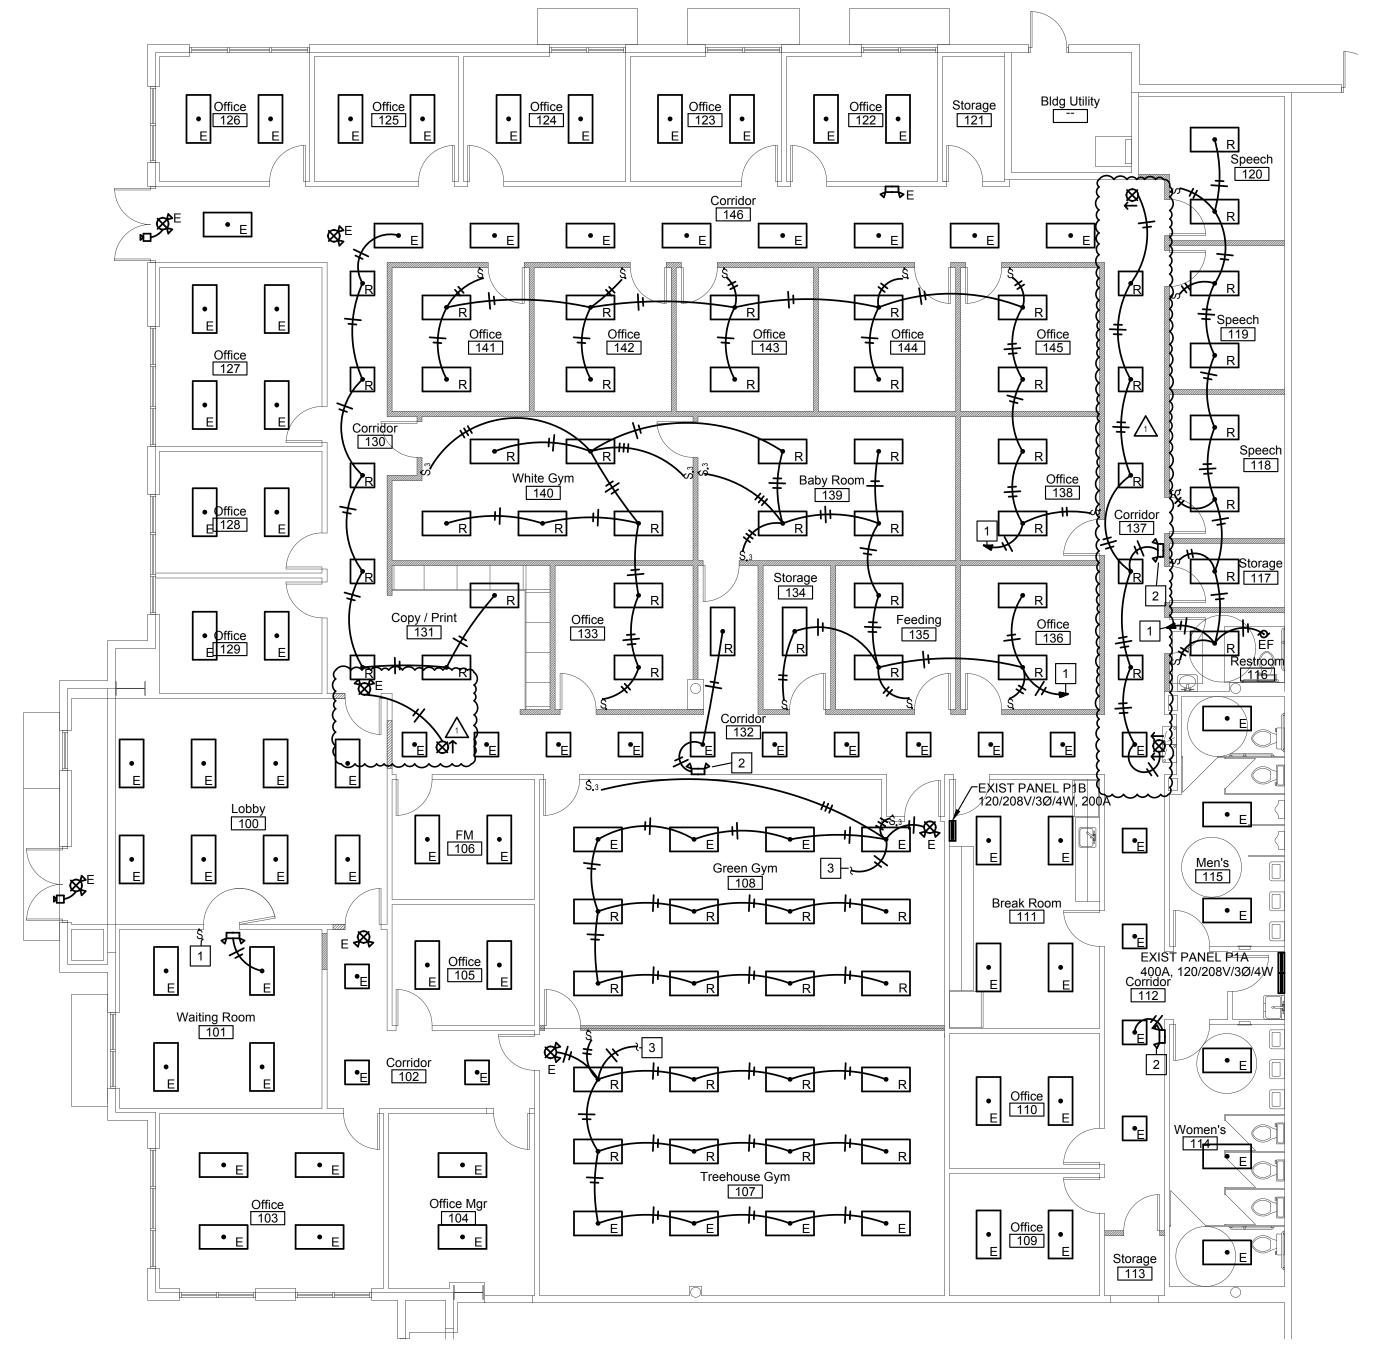



BC PROJECT #: 25215 MISSOURI PE COA #2009003629 This drawing has been prepared by the Engineer, or under his supervision. This drawing is provided a an instrument of service by the Designer/Engineer and is intended for use on this project only. Pursua to the Architectural Works Copyright Protection Act of 1990, all drawings, specifications, ideas and designs, including the overall form, arrangement and composition of spaces and elements appearing herein, constitute the original, copyrighted work of the Designer/Engineer. Any reproduction, use, or



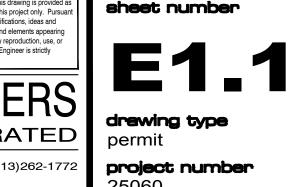

tenant finish for

 $\boldsymbol{\omega}$ 

date

ek/ds revisions

04.03.2025

checked by

04.18.2025


drewn by sp/rc

disclosure of information contained herein without prior written consent of the Engineer is strictly prohibited. © 2025 BC Engineers, Inc.

POWER PLAN NOTES:

1 CONNECT TO EXISTING 120 VOLT RECEPTACLE CIRCUIT IN AREA WITH #12 WIRE.

2 CONNECT TO SPARE 20 AMP 1 POLE BREAKER IN EXISTING PANEL INDICATED WITH #12 WIRE. REUSE ABANDONED CIRCUITS FROM MODULAR FURNITURE.

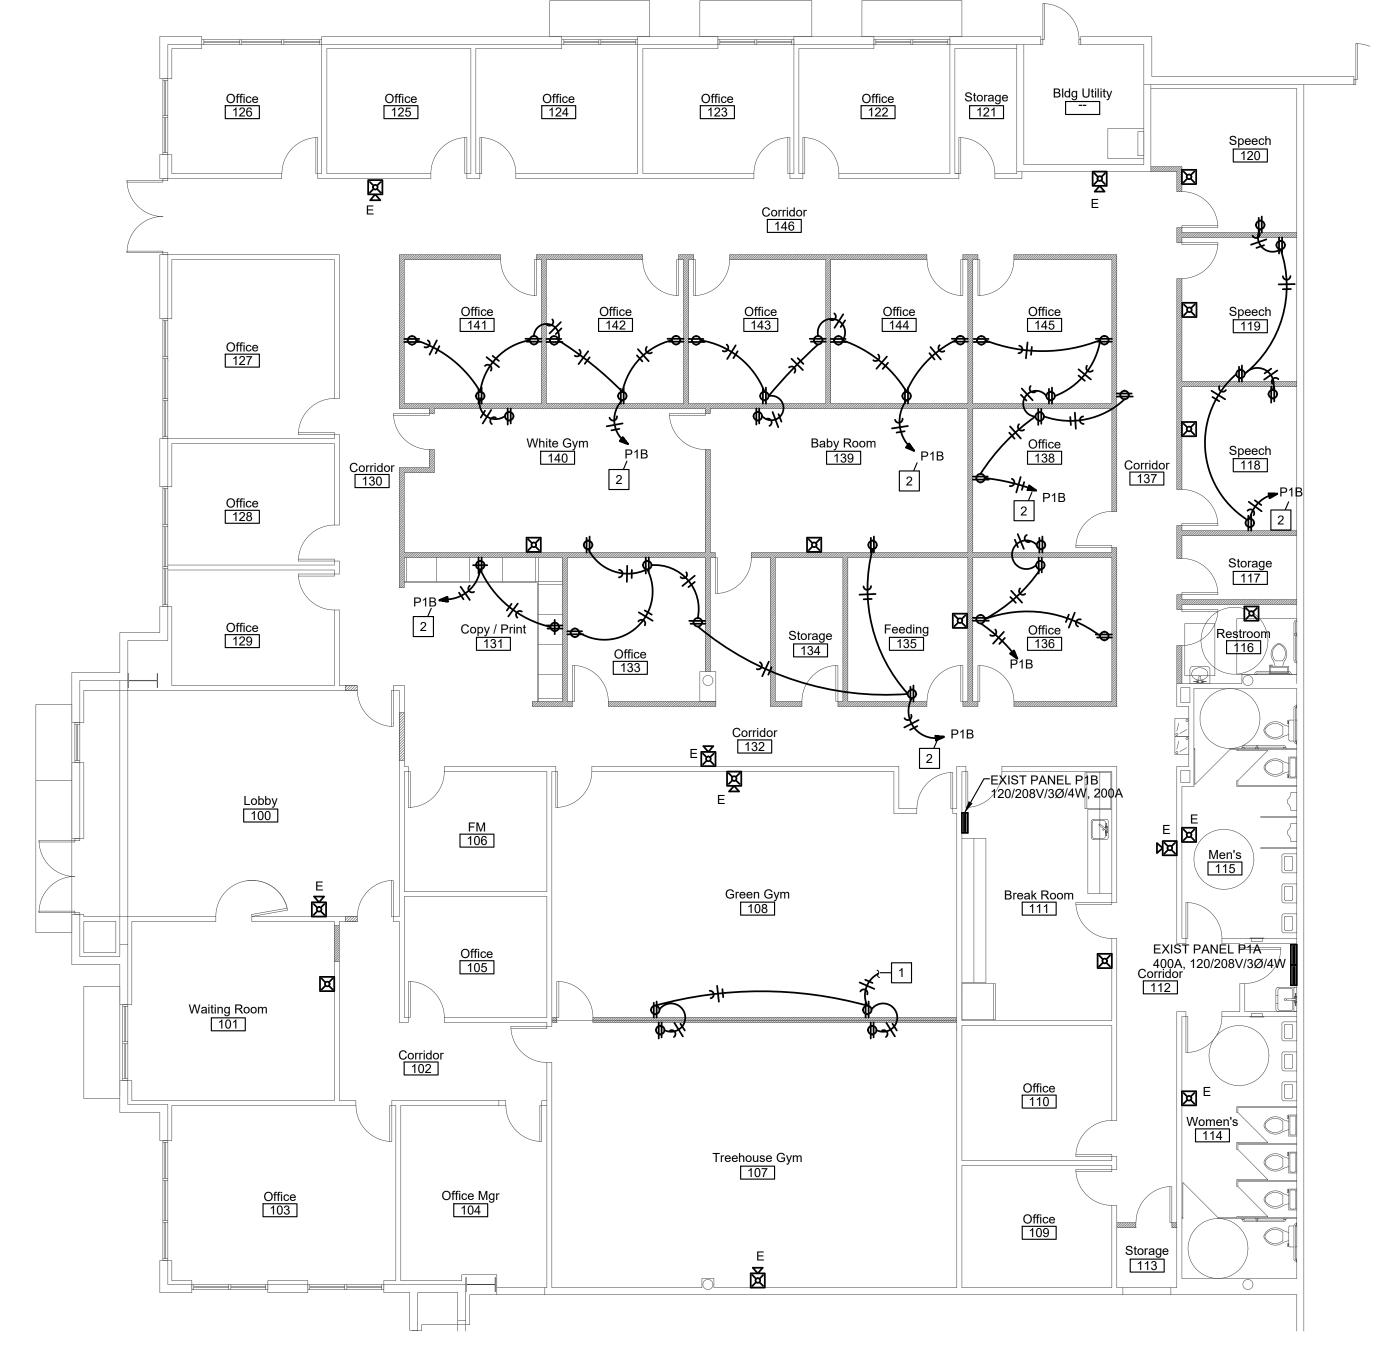



BC PROJECT #: 25215 MISSOURI PE COA #2009003629 This drawing has been prepared by the Engineer, or under his supervision. This drawing is provided as an instrument of service by the Designer/Engineer and is intended for use on this project only. Pursuant to the Architectural Works Copyright Protection Act of 1990, all drawings, specifications, ideas and designs, including the overall form, arrangement and composition of spaces and elements appearing herein, constitute the original, copyrighted work of the Designer/Engineer. Any reproduction, use, or disclosure of information contained herein without prior written consent of the Engineer is strictly prohibited. © 2025 BC Engineers, Inc.





**date** 04.03.2025

checked by

sheet number

drewn by sp/rc

ek/ds revisions