


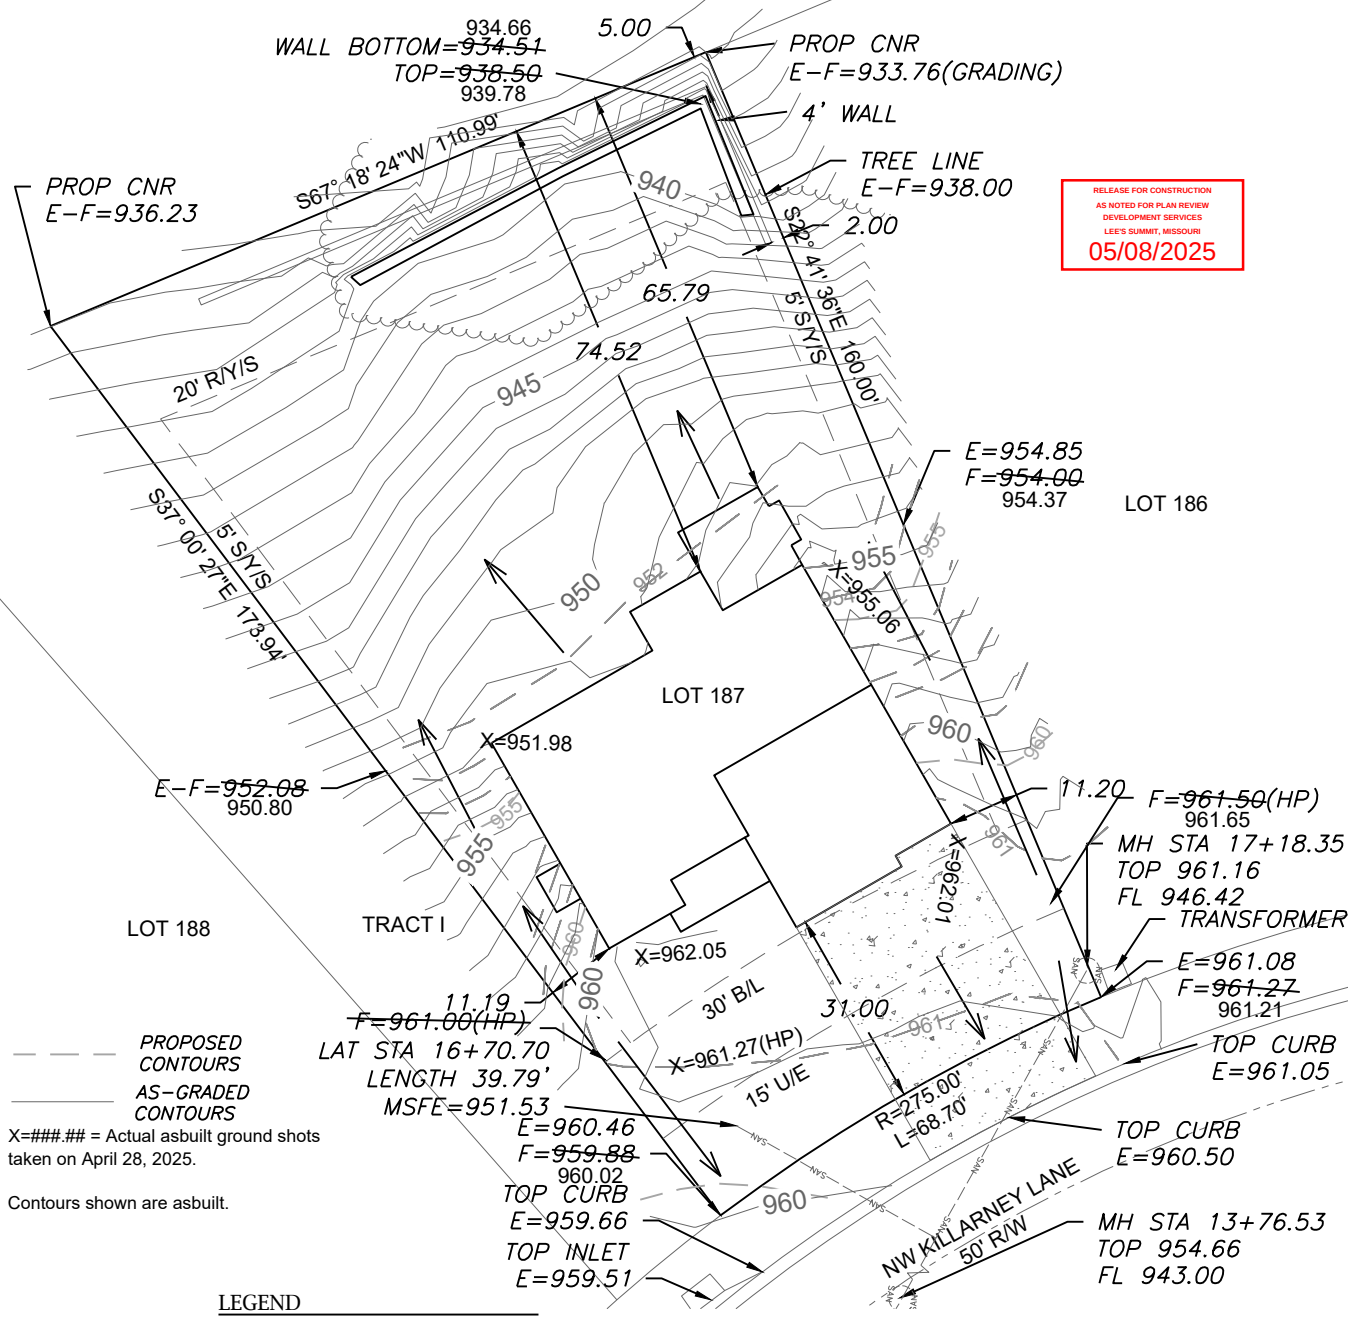

RELEASE FOR CONSTRUCTION
AS NOTED FOR PLAN REVIEW
DEVELOPMENT SERVICES
LEE'S SUMMIT, MISSOURI
05/08/2025

--- PROPOSED CONTOURS
--- AS-GRADED CONTOURS
X=###.## = Actual asbuilt ground shots taken on April 28, 2025.
Contours shown are asbuilt.

- LEGEND**
- Gas Meter
 - Telephone or Fiber-Optic Pedestal
 - Cable TV Pedestal
 - Electric Pedestal
 - Light Pole
 - Mailbox
 - Fire Hydrant
 - Water Valve


PROPOSED HOUSE
TOP FOUNDATION = 963.00
GARAGE FLOOR = 962.00
TOP FOOTING = 953.00
BASEMENT FLOOR = 953.33
DRIVE SLOPE = 4.1%

E = EXISTING ELEVATION
F = PROPOSED FINAL ELEVATION
G = ADJACENT GRADE AT EGRESS
U/E = UTILITY EASEMENT
B/L = BUILDING LINE
S/Y/S = SIDE YARD SETBACK
R/Y/S = REAR YARD SETBACK

NOTES

- BUILDER TO VERIFY ALL BUILDING ELEVATIONS AND DIMENSIONS.
- THIS PLOT PLAN DOES NOT CONSTITUTE A BOUNDARY SURVEY.
- THE EASEMENTS SHOWN ON THIS PLOT PLAN ARE TAKEN FROM THE FINAL PLAT. OTHER EASEMENTS MAY EXIST.

AS-GRADED PLOT PLAN IS REQUIRED PRIOR TO SODDING.

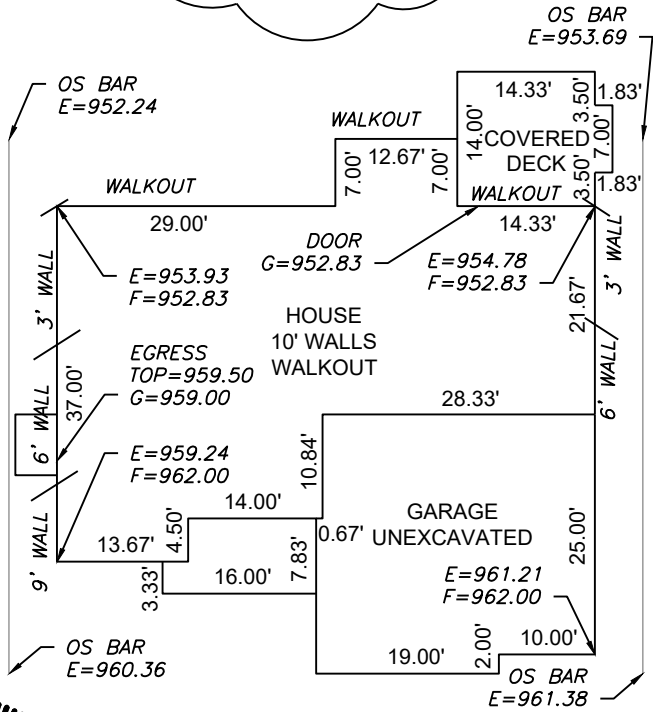

LOT INFORMATION

14,695 SQ. FT.
MSFE= 951.53
MBOE (REAR LEFT) = 936.96
MBOE (REAR RIGHT) = 934.36
ADDRESS
2218 NW KILLARNEY LANE

LEGAL DESCRIPTION

LOT 187, WOODSIDE RIDGE 2ND PLAT, A SUBDIVISION AS RECORDED IN LEE'S SUMMIT, JACKSON COUNTY, MISSOURI.

ENGINEERING SOLUTIONS
ENGINEERING & SURVEYING
50 SE 30TH STREET
LEE'S SUMMIT, MO 64082
P:(816) 623-9888 F:(816) 623-9849
WWW.ENGINEERINGSOLUTIONSKC.COM

MATTHEW J. SCHLICHT
PROFESSIONAL ENGINEER
PE-2006019708
5/8/2025

AS-GRADED PLOT PLAN - LOT 187

WOODSIDE RIDGE 2ND PLAT
LEE'S SUMMIT, JACKSON COUNTY, MISSOURI

JPE CONSTRUCTION, INC.
1314 SW MARKET ST
LEE'S SUMMIT, MO 64081

PROJECT NO.	FILE NAME	DATE	SHEET	OF
1	LOT 187, WOODSIDE RIDGE	4/22/24	1	1

THIS DRAWING IS NOT VALID UNLESS THE SIGNATURE, DATE AND SEAL OF THE ENGINEER WHO SUPERVISED THE PREPARATION OF THIS DRAWING HAS BEEN AFFIXED HERETO.