

Clayton Properties

Basswood - Transitional


1221 SE Cronin St.


Kyle Clifford

Michael Dueker

5/13/2025 | P250368 3/16" = 1' ROOF TRUSS PLACEMENT DIAGRAM

RELEASE FOR CONSTRUCTION AS NOTED FOR PLAN REVIEW DEVELOPMENT SERVICES LEE'S SUMMIT, MISSOURI 05/19/2025

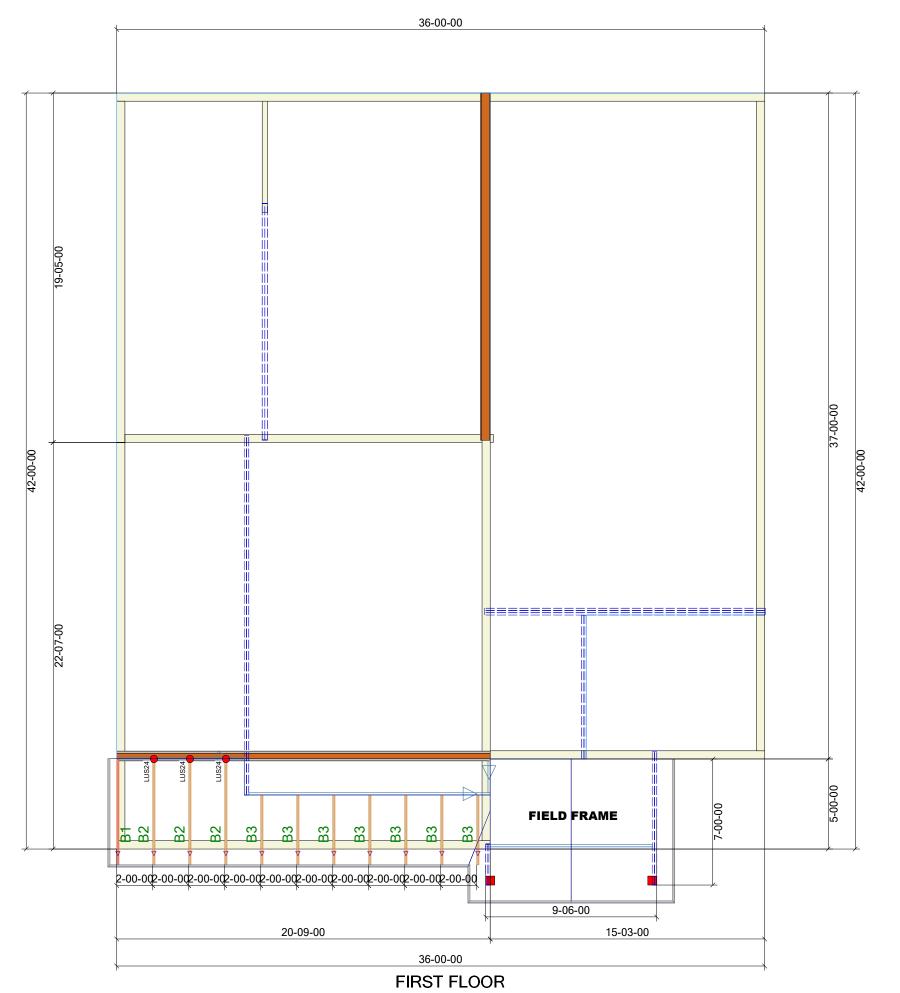

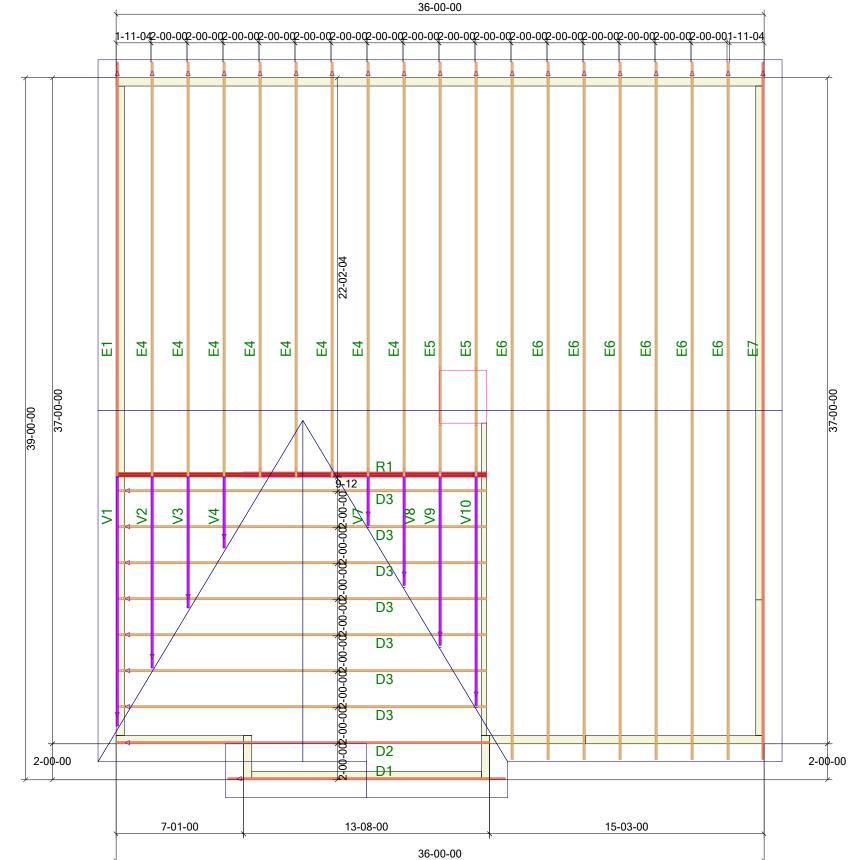

SECOND FLOOR

- EL EXTREMO IZQUIERDO DE LOS TRUSSES (VEA LOS PERFILES)

TODAS LAS DIMENSIONES PARA LAS TRUSSES SON DE FUERA DE LA MADERA ESTABLECER LOS TRUSSES NIVELADAS CON LA ESTRUCTURA (u.n.o.)

- LEFT END OF TRUSS (SEE TRUSS PROFILES)

ALL ROOF TRUSS DIMENSIONS ARE FROM OUTSIDE EDGE OF STUD (u.n.o.) SET ROOF TRUSSES FLUSH WITH FRAMING (u.n.o.)

WARNING: Trusses must be handled with care to prevent damage and injury.

This truss placement diagram is to be used only as Inis truss placement diagram is to be used only as an installation aid; it is not a structural diagram. These trusses are designed as individual building components to be incorporated into the building design at the the specification of the building designer. See individual design sheets for each truss design identified on the placement drawing.

Professional advice should be sought regarding handling, installation, temporary and permanent bracing before erecting trusses. Temporary and permanent bracing is required during installation of trusses to prevent possible collapse.

For general guidance regarding bracing, consult "BCSI-06" available jointly from WTCA & TPI.

Premier Building Supply must be notified of any issues requiring a back charge prior to any work being done. Premier Building Supply reserves the right to use it's service staff in lieu of being back charged.

EVERSTEAD SHOP DRAWINGS/SUBMITTAL REVIEW

SUBMITTAL WAS REVIEWED FOR DESIGN CONFORMITY AND GENERAL CONFORMANCE TO CONTRACT DOCUMENTS ONLY. THE CONTRACTOR IS RESPONSIBLE FOR CONFIRMING AND CORRELATING DIMENSIONS AT JOBSITE FOR TOLERANCE, CLEARANCE, QUANTITIES, FABRICATION, COORDINATION OF HIS OR HER WORK WITH OTHER TRADES, AND FULL COMPLIANCE WITH CONTRACT DOCUMENTS.

> STATUS: **APPROVED**

> > 05/16/2025

REVIEWED BY:

HCJ ENGINEER, EVERSTEAD ENGINEERING & DESIGN LLC ROOF PITCH FRONT TO BACK: 4/12, 6/12 SOFFIT DESIGNED FOR 12" O.H HEEL HEIGHT: 6", 8"

ROOF PITCH LEFT TO RIGHT: 8/12 SOFFIT DESIGNED FOR 12" O.H

HEEL HEIGHT: 10"

ALL CEILINGS ARE FLAT UNLESS OTHERWISE

1 - SDWC 15600 REQUIRED AT ALL BEARING LOCATIONS (u.n.o.) ALL TRUSS TO TRUSS CONNECTIONS = 'NAILED" (u.n.o.)

- SDWC 15600 NECESARIO EN TODO LOS PUNTOS DE APOYO (u.n.o.)

TODAS LAS CONEXIONES DE TRUSS A TRUSS = 'CLAVADAS " (u.n.o.)

HANGER

SCHEDULE

▲ HHUS26-2 ▲ HGUS26-2

▲ HGUS28-2

THJA26

TJC37

THJU26 HUS28 HUS28-2 | | HHUS210-2 ▲ HHUS28-2

> LUS28 SUL24

SUL26

SUR24 SUR26

THA422 THA426 THAC422 THAC426

THASL29 THASR29

TBE4

TBE6

LGT2

LUS24

LUS26 HUS26 QUANTI

ΤY

0

0

2

NOTED ROTATE ATTIC ACCESS TO ALIGN WITH TRUSS

HORIZONTAL OVERHANGS: HIP LINES: 0 RAKED OVERHANGS: 145 RIDGE LINES: 62 VALLEY LINES: 48

TRUSS QUANTITY: 54

ROOF AREA: 1,899

GABLE AREA: 488

SEE PLACEMENT PLAN FOR ADDITIONAL

DIRECTION.