



AS GRADED PLOT PLAN

Ordered by:Elevated Design and Build
Description:Lot 202 Retreat at Hook Farms Second Plat, Lee's Summit, MO.
Address:2229 SW Crown Drive
Lot Area = 13895 sf

RELEASE FOR CONSTRUCTION
AS NOTED FOR PLAN REVIEW
DEVELOPMENT SERVICES
LEE'S SUMMIT, MISSOURI
05/30/2025

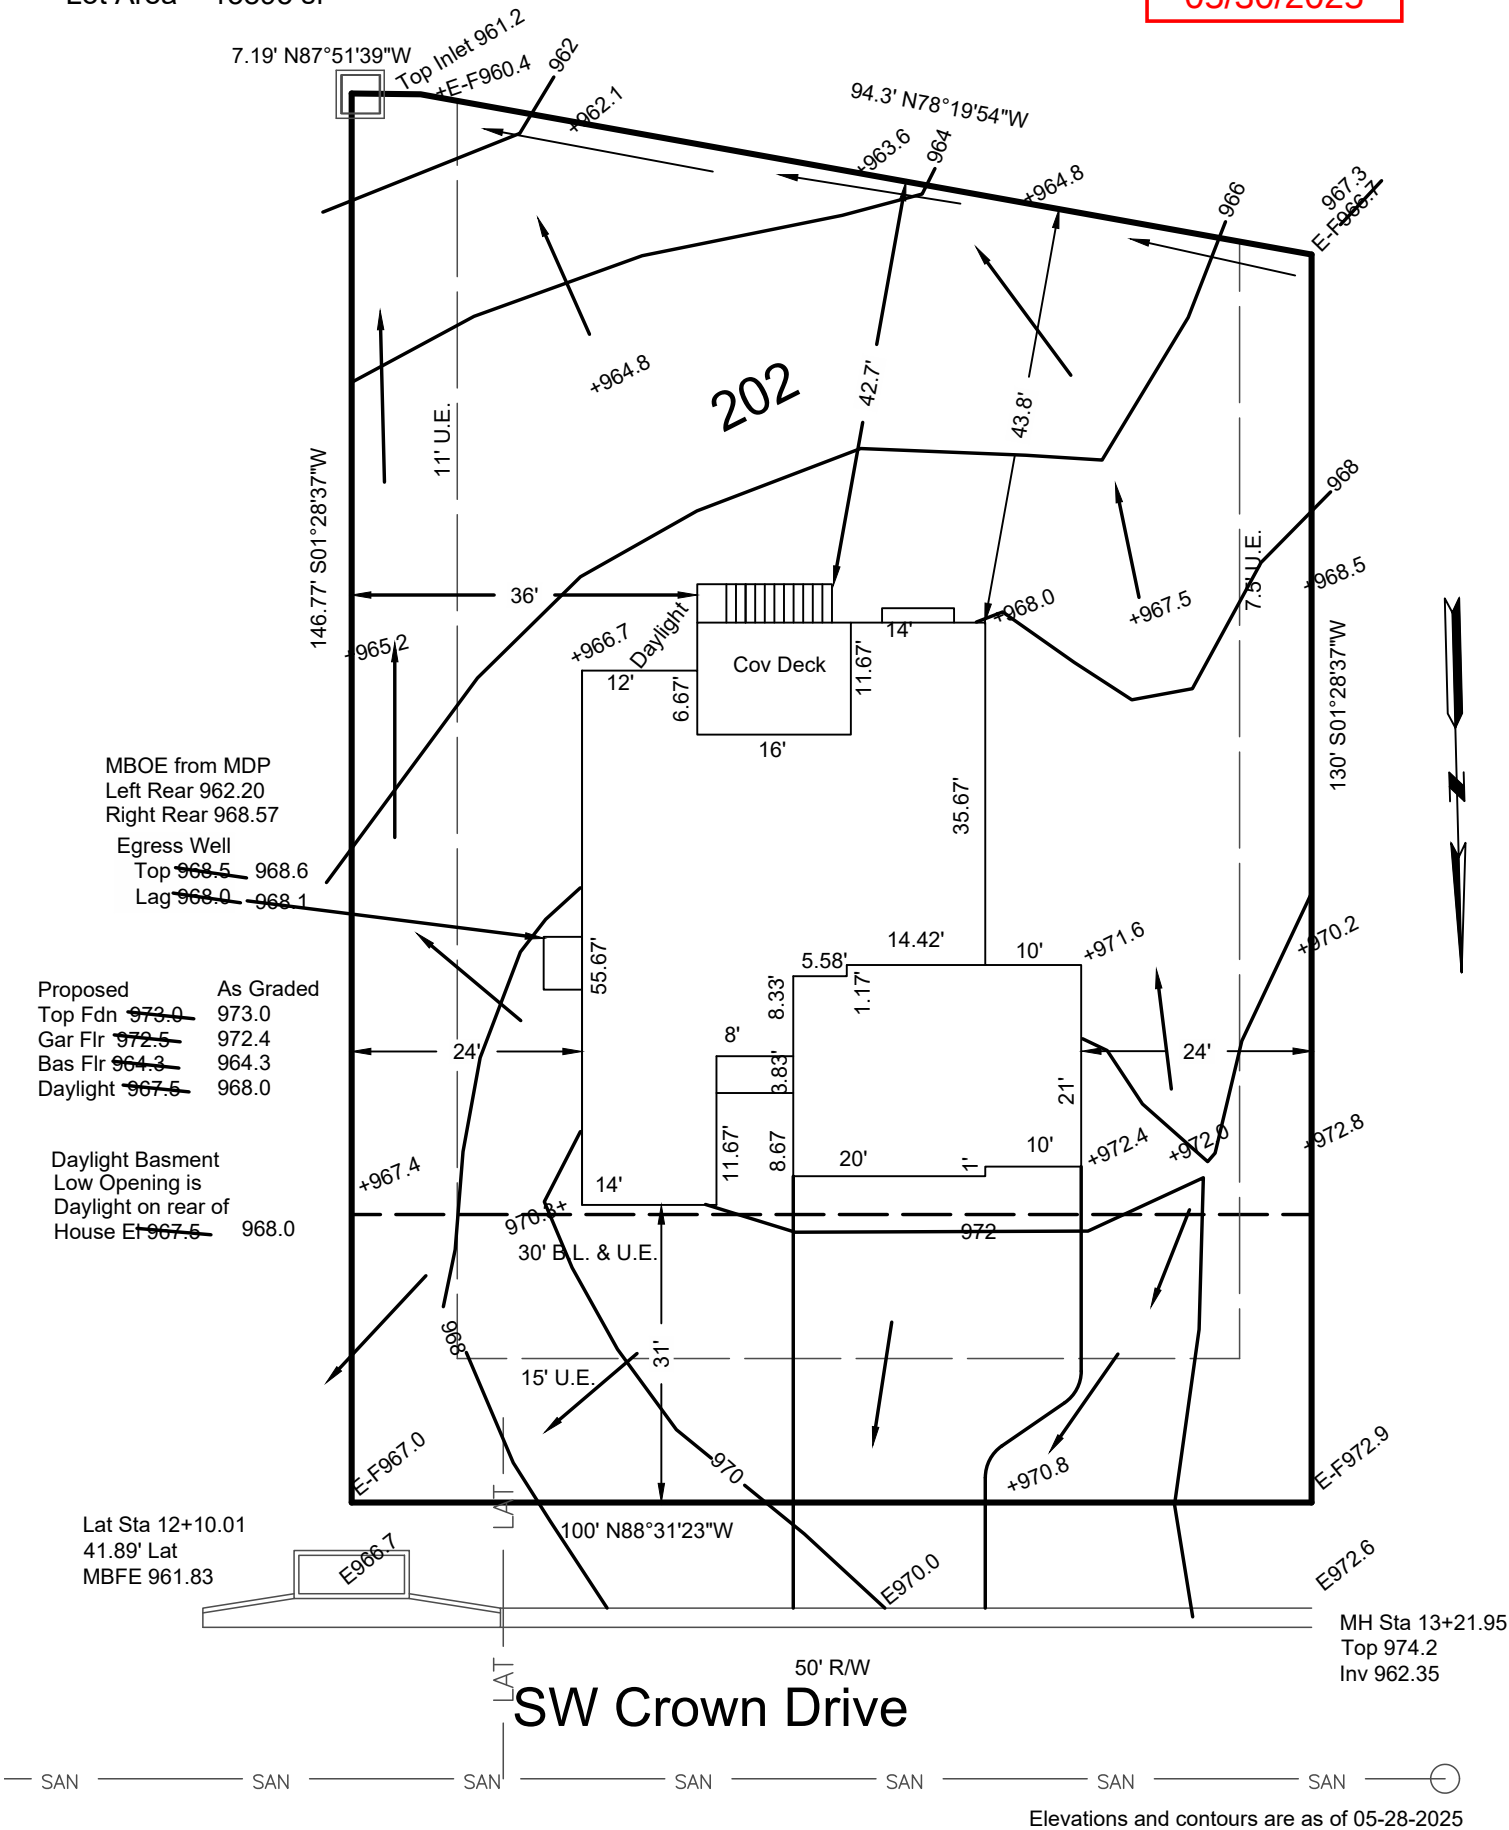

→ = DRAINAGE PATTERN

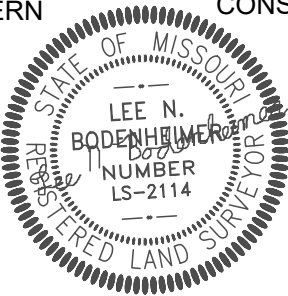

CONSTRUCTION ENGINEERING SERVICES, INC.
16810-C East 40 Highway
Independence, MO 64055
(816)478-2323
lee@engineeringkc.com
SCALE: 1" = 20'
DATE: 11-19-2024 & 05-28-2025
JOB NO: 19259 & 19456

LEE BODENHEIMER, L.S.
Land Surveyor